

INACTIVE


NOV 19 1969

R.O.W. OBTAINED ON PROJECT FAP 279-D

DEPARTMENT OF HIGHWAYS AS CONSTRUCTED STATE OF COLORADO REVISED DATE DEC 1 1969

FEDERAL ROAD DISTRICT NO.	DIVISION	PROJECT NO.	SHEET NO.
9	COLORADO	F 017-3(13)	1

CONVENTIONAL SIGNS

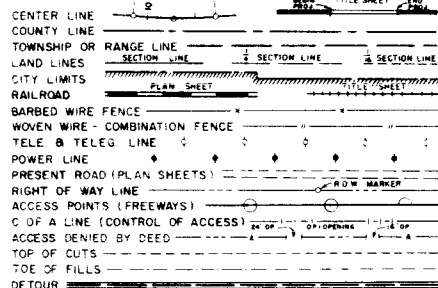


PLAN AND PROFILE OF PROPOSED FEDERAL AID PROJECT NO. F 017-3(13) STATE HIGHWAY NO. 8 CHEYENNE COUNTY

SCALES OF ORIGINAL DRAWINGS
ON PLAN: 1 IN. = 100 FT.
ON PROFILE: 1 IN. = 100 FT. HORIZONTAL
1 IN. = 10 FT. VERTICAL
GRADE LINE ON PROFILE IS SHOWN AS GRADE OF FINISHED ROAD
GROSS LENGTH OF PROJECT 7.19,000 FT. = 3.599 MILES
NET LENGTH OF PROJECT 3.19,000 FT. = 1.359 MILES

CONTRACTOR: ASPHALT PAVING CO.
PROJECT ENGR: ROBERT W. DOLLARD
DATE COMPLETED: DECEMBER 1, 1968

INDEX OF SHEETS

SHEET NO.	TITLE PAGE AND SKETCH MAP
1	TITLE PAGE AND SKETCH MAP
2	TYPICAL SECTIONS, GENERAL NOTES, AND TABULATION OF LENGTH & DESIGN DATA
3A-3K	SUMMARY OF APPROXIMATE QUANTITIES (FINAL)
4K	LIST OF STRUCTURES
5-5K	TABULATIONS OF SUBBASE, SURFACING, APPROACH SLABS, GUARD RAIL AND DELINEATORS
6	PIT LOCATION
7	SUMMARY OF EARTHWORK QUANTITIES AND MAINTENANCE OF DETOURS
8	GENERAL NOTES, SURFACE FINISH DETAILS, PIER NOSE DETAILS AND RIPRAP DETAIL
9-13	DETAILS OF BRIDGE, STA. 545+
14-19	DETAILS OF BRIDGE, STA. 620+
20-23	ALIGNMENT PLAN & PROFILE
24-46	CROSS SECTIONS
	<i>"As Constructed NO Revisions"</i> <i>Sheets 6, 8, 10 thru 18 and 15 thru 19</i> <i>"VOID By Construction"</i> <i>Sheet 3 and 4</i>
M-203-B	APPROACH ROADS, FLARING CUT SLOPE TREATMENT, BRIDGE & CREST WIDENING
M-203-C	DITCH TYPES
M-206-A	EXCAVATION AND BACKFILL FOR STRUCTURES (2 SHEETS)
M-412-B	CONCRETE PAVEMENT BRIDGE APPROACH SLAB
M-500-A	LETTERS AND FIGURES FOR STRUCTURE NUMBERS
M-603-C	HEADWALLS AND END SECTIONS FOR C&H CULVERTS
M-603-M	METAL CULVERT PIPE
M-606-AA	GUARD RAIL, TYPE 3 (3 SHEETS)
M-607-A	WIRE FENCES AND GATES (2 SHEETS)
M-612-A	MARKER POSTS AND BENCH MARKS
M-612-C	DELINEATORS (2 SHEETS)
M-612-A	TIMBER BARRICADES
M-612-A	CONSTRUCTION IDENTIFICATION SIGNS
M-612-B	TRAFFIC SIGNING FOR HIGHWAY CONSTRUCTION (3 SHEETS)
	7-1-65 7-1-65 3-17-67 1-24-67 7-1-65 7-1-65 5-20-67 8-1-67 12-8-66, 2-6-67 5-2-66 7-1-65, 5-4-67 7-1-65 5-19-67 7-12-67

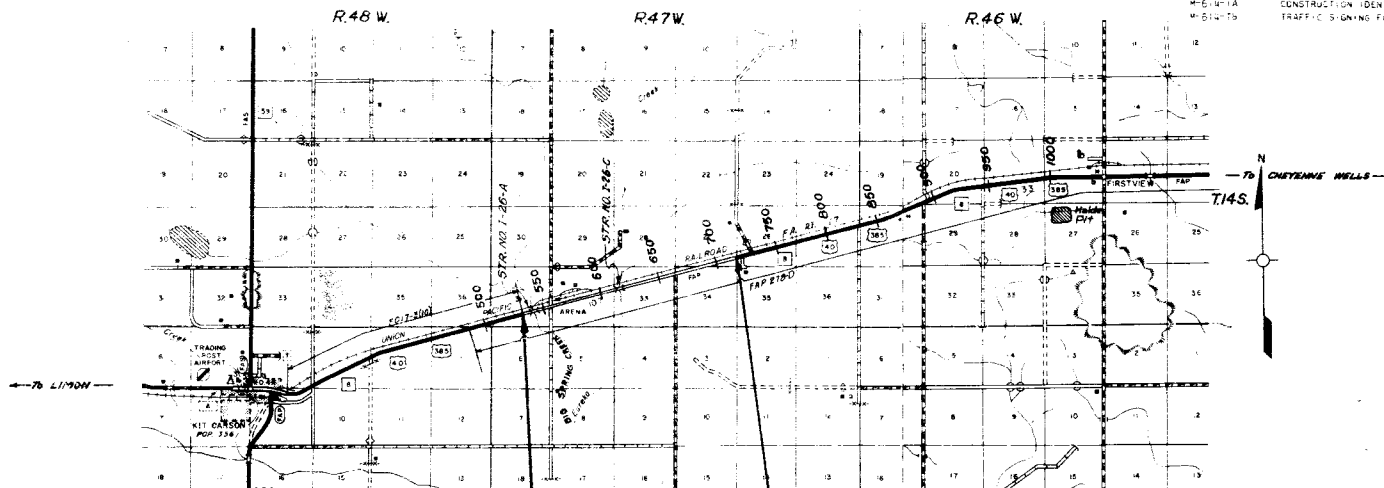

STA. 535+00 AH. BEGIN F 017-3(13)=
STA. 1535+00BK. END F 017-3(10)

STA. 725+00-END F 017-3(13)=
STA. 1725+00 ON FAP 279D

SCALE OF MILES

H. G. JOHNSON
W. E. MITCHELL

SEE SPECIAL PROVISIONS FOR
NOTICE TO BIDDERS

DEPARTMENT OF HIGHWAYS STATE OF COLORADO	
APPROVED:	DATE
<i>John E. Shuman</i>	10-27-67
CHIEF ENGINEER	DATE
BY: <i>L. J. Brown</i>	DEPUTY CHIEF ENGINEER
DEPARTMENT OF TRANSPORTATION FEDERAL HIGHWAY ADMINISTRATION BUREAU OF PUBLIC ROADS	
APPROVED:	DATE
DIVISION ENGINEER	
W.E.M.	

NOTE:
See Standards for Details of Cut Slope
Treatment, Flaring & Widening

TYPICAL SECTION A

Sta 535+00 to Sta. 536+50
Sta 554+50 to Sta. 604+50
Sta. 613+50 to End of project

Contractor will be required to place
Aggregate Base Course (class 7)(Special)
to this line after completion of paving
operation.

FILL SLOPES

"H"	SLOPE
3' or less	4:1
Over 3'	2:1

SIDE SLOPE DIMENSIONS FOR SUBBASE MATERIAL

SUBBASE THICKNESS	SLOPE 6:1	
	A	A ₁
8"	4.5'	0.8'

AS CONSTRUCTED

REVISED DATE DEC 1 1988

GENERAL NOTES

For preliminary plan quantities of Bituminous Materials
the following rates were used:

See I/R/1
Tabulations

Prime Coat MC	0.40	Gals. per sq. yd.
Tack Coat	0.10	Lbs. per sq. yd.

Any layer of bituminous pavement that is to have a succeeding
layer placed thereon shall be completed full width before
succeeding layer is placed.

Road approaches which require bituminous pavement shall be
primed and a thickness of pavement equivalent to that of the bottom
layer of the mainline placed as follows:

Public approaches and entrances to buildings or residences shall
be paved 50 ft. out from edge of shoulder or to the Right of Way
line whichever is less. Field entrances shall be paved 4 ft. out
from edge of shoulder.

Shoulder areas, excavation area sta. 604+ to sta. 613+ and approaches to
bridges shall be constructed with moisture and density control to a
depth of 1 foot below the subgrade. Excavation required for
compaction of this area will be considered subsidiary to that
operation and will not be paid for separately.

Standard compaction will be required on this project.

It is estimated that 1078 Hours of Flagging for controlling traffic
will be required for this project.

WORK BY MAINTENANCE FORCES


Removing Guard Posts, cleaning culverts and regrading of
drainage ditches will be accomplished by State Maintenance Forces
at no cost to project.

TABULATION OF LENGTH AND DESIGN DATA

STATION	ROADWAY	BRIDGE
	LIN. FT.	LIN. FT.
535+00 AH.- BEGIN FOIT-3(13)= 1535+00 BK.- END FOIT-3(10)	978.3	
544+78.3 Big Spring Creek 545+59.8	7,370.2	81.5
619+30.0 Eureka Creek 620+11.5	1,048.5	81.5
725+00- END FOIT-3(13)= 1725+00 ON FAP 270D		
TOTALS	18,837.0	163.0
SUMMARY	LIN. FT.	MILES
ROADWAY	18,837.0	3.568
BRIDGES	163.0	0.031
ROADWAY (NET B. GROSS)	19,000.0	3.599
DESIGN DATA		
MAXIMUM DEGREE OF CURVE	TANGENT	
MAXIMUM GRADE	2.10%	
MINIMUM SSD - HORIZONTAL	TANGENT	
MINIMUM SSD - VERTICAL	615'	
MAXIMUM DESIGN SPEED	70 M.P.H.	


TYPICAL SECTION B

Sta 536+50 to Sta. 554+50
Sta. 604+50 to Sta. 613+50

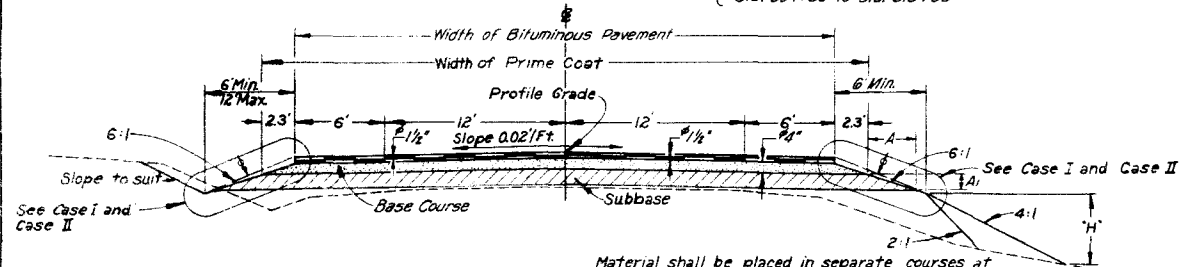


Material shall be placed in separate courses at
the following rates per 100 linear feet of roadway
Bituminous Pavement
Top layer 1 1/2" ----- 31 Tons
Bottom layer 1 1/2" ----- 31 Tons
Base Course ----- 82 Tons

CASE I (Bottom of Subbase ABOVE Superelevation
Control Line Intersection)

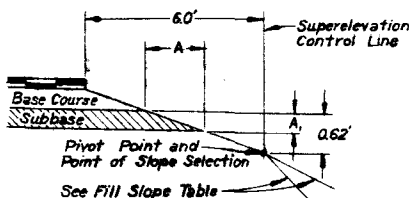

CASE II (Bottom of Subbase BELOW Superelevation
Control Line Intersection)

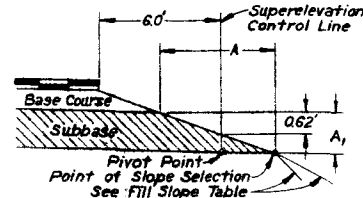

SUMMARY OF APPROXIMATE QUANTITIES

FEDERAL ROAD SECTION NO.	DIVISION	PROJ. NO.	SHEET NO.	TOTAL SHEETS
1	COLORADO	F017-3(13)	3	

ITEM NO.	ITEM	UNIT	ROADWAY	BRIDGE STA. 545± STR. NO. I-26-A	BRIDGE STA. 620± STR. NO. I-26-C	PROJECT TOTALS
202	Removal of Structure	Each	1			1
202	Removal of Asphalt Mat	Sq. Yd.	80			80
202	Removal of Bridge	Each		1	1	2
202	Plug Culvert	Each	3			3
203	Unclassified Excavation	Cu. Yd.	14,950		50	15,000
203	Borrow	Cu. Yd.	4,000			4,000
203	Embankment (Standard)	Cu. Yd.	33,000			33,000
204	Haul	Yd. Mi.	45,100			45,100
204	Haul	Ton Mi.	228,700			228,700
206	Structure Excavation (Haul)	Cu. Yd.	80	120	160	360
206	Structure Backfill (Class 3) (Haul)	Cu. Yd.	40	60	50	150
209	Wellting	M. Gal.	1,630			1,630
304	Aggregate Base Course (Class 2)	Ton	5,800			5,800
304	Aggregate Base Course (Class 7) (Special)	Ton	11,500			11,500
403	Hot Bituminous Pavement (Grading F) (Hydrated Lime)	Ton	12,400			12,400
411	Asphalt Cement (85-100 pen)	Ton	900			900
411	Emulsified Asphalt (SS-K)	Gal.	80,200			80,200
411	Liquid Asphaltic Material (MC-70)	Gal.	19,900			19,900
412	Concrete Pavement (10 Inch)	Sq. Yd.	320			320
502	Steel Piling (10 BP42)	Lin. Ft.		780	675	1,455
506	Riprap	Cu. Yd.		270	100	370
509	Structural Steel	Lump Sum		•	•	•
509	Structural Steel (Galvanized)	Lump Sum		•	•	•
516	Dampproofing (Linseed Oil)	Sq. Yd.		550	550	1,100
518	Bridge Compression Joint Sealer (Type A)	Lin. Ft.	160			160
601	Concrete Class A	Cu. Yd.		68	59	127
601	Concrete Class D	Cu. Yd.		124	124	248
602	Reinforcing Steel	Lb.	15,200	44,400	44,000	103,600
603	18 Inch Corrugated Steel Pipe	Lin. Ft.	82			82
603	24 Inch Corrugated Steel Pipe	Lin. Ft.	82			82
603	24 Inch Steel End Section	Each	2			2
606	Guard Rail Type 3	Lin. Ft.	1,400			1,400
609	Curb Type 2 (Section-Variable)	Lin. Ft.	160			160
612	Delineator (Type III)	Each	4			4
614	Flagging	Hour	1,500			1,500
620	Field Laboratory	Each	1			1
620	Sanitary Facility	Each	1			1
621	Maintenance of Detours	Lump Sum	•			•
626	Mobilization	Lump Sum	•			•
STATE FORCES						
	Furnishing and Installing Identification Sign	Each	2			2
NON FEDERAL AID (STATE FORCES)						
	Signing and Striping Entire Project	Lump Sum				•

LIST OF STRUCTURES

FEDERAL ROAD DISTRICT NO.	DIVISION	PROJECT NO.	SHEET NO.
9	COLORADO	F 017-3(13)	4

LOCATION	REMOVAL OF STRUCTURES	UNCLASSIFIED EXCAVATION CUBIC YARDS			STRUCTURE EXCAVATION CUBIC YARDS	STRUCTURE BACKFILL CUBIC YARDS	AGGREGATE BASE COURSE CLASS-7 TONS	HOT BITUMINOUS PAVE. TONS	PLUG CULVERTS EACH	CORR. STEEL PIPE LINEAR FEET						"H" OVER CULV. FT.	STEEL END SECTIONS FOR C.S.P. CULVERTS		MISCELLANEOUS
		NO.	UNCL.	EMB.						DITCH	18"	24"	24"						
535±																	1-Identification Sign. (State Forces) ✓		
545±																	Maintenance of Detours. ✓		
541+50 - 549+00																			
546+60			40				11	2											
555+75			80				110	42											
568+15			20		27	10	22	4				28		2					
580+60			40		20	9	22	4				28		1					
585+00	1			2	3	4						14		5		1			
601+75			10				11	2				6		5					
602+00									1										
610+25							11	2									Maintenance of Detours. ✓		
615+50 - 623+50																			
620±																			
620+75							11	2											
635+09									1										
663+80							11	2											
664+97.4			40				55	14											
667+72									1										
680+ - 682+		80			2	30	Δ	Δ				62		2		1	75 Sq. Yds. Removal of Asphalt Mat. ✓		
681+06																			
687+00							11	2											
719+71.8							11	2											
725+50							22	4											
725±																	1-Identification Sign. (State Forces) ✓		
725+00 - 726+00							Δ	Δ											
TOTALS	1	80	230	4	80	39	308	82	3			82	82		2				

Δ- Quantities Incl. in Subbase and/or Surfacing Plan.

APPROACH SLABS

STATION	ABUTMENT	SKEW	WIDTH	CONCRETE PAVEMENT (10 INCH)	REINFORCING STEEL	CURB TYPE (SECTION VARIABLE)	BRIDGE COMPRESSION JOINT SEALER TYPE A
				SQ. YD.	LB.	LIN. FT.	LIN. FT.
544 +		90° 00'	36'	80	3796	40	38
545 +		90° 00'	36'	80	3796	40	38
619 +		90° 00'	36'	80	3796	40	38
620 +		90° 00'	36'	80	3796	40	38
Totals				320'	15184'	160'	152'

GUARD RAIL TYPE 3

STATION	SIDE	LIN. FT.
542 +29 to 544 +79	Rt.	250
543 +79 to 544 +79	Lt.	100
545 +59 to 546 +59	Rt.	100
545 +59 to 548 +09	Lt.	250
616 +81 to 619 +31	Rt.	250
618 +31 to 619 +31	Lt.	100
620 +11 to 621 +11	Rt.	100
620 +11 to 622 +61	Lt.	250
Totals		1400'

DELINEATOR (TYPE III)

STATION	SIDE	EACH
544 +78	Rt.	1
545 +60	Lt.	1
619 +30	Rt.	1
620 +12	Lt.	1
Totals		4

AS CONSTRUCTED

REVISED DATE DEC 1 1968

FEDERAL ROAD DESIGN NO.	DISTRICT	PROJ. NO.	SHEET NO.	TOTAL SHEETS
1	COLORADO	F-017-3(13)	5	

SUBBASE PLAN

See Sheet 5x4

STATION TO STATION	SOURCE	THICKNESS	AGGREGATE BASE COURSE		HAUL	
			CLASS 2	CLASS 2	TONS	TON MILE
535+00 to 538+00		8"	396			3,100
538+00 to 544+78.3		8"	1,364			12,459
545+59.8 to 552+00		8"	1,287			11,575
552+00 to 554+00		8"	224			1,997
604+50 to 613+50		8"	1,809			14,207
Estimated for:						
Correcting Irregularities			502			4,334
Stabilizing present roadway Sta. 680+ to Sta. 682+		8"	200			1,300
TOTALS			5,722'			48,972

Based on Design Curve "D"

SURFACING PLAN

See Sheet 5x


STATION TO STATION	SOURCE	QUANTITY - TONS				HAUL - TON MILE			
		AGGREGATE BASE COURSE (CLASS 7)		HOT BITUMINOUS PAVEMENT (GRADING F)		AGGREGATE BASE COURSE (CLASS 7)		HOT BITUMINOUS PAVEMENT (GRADING F)	
		(SPECIAL)	CLASS 7	BOTTOM LAYER	TOP LAYER	(SPECIAL)	CLASS 7	BOTTOM LAYER	TOP LAYER
535+00 to 536+50		59		47	47	545		434	434
536+50 to 544+78.3		680		257	257	6221		2351	2351
545+59.8 to 554+50		730		276	276	6548		2476	2476
554+50 to 604+50		1950		1550	1550	16404		13039	13039
604+50 to 613+50		738		279	279	5796		2191	2191
613+50 to 619+30.0		226		180	180	1743		1388	1388
620+11.5 to 725+00		4091		3252	3252	27205		21626	21626
From List of Structures		308			82	2296			611
Appr. to Proj., Sta. 725 +		20			30	113			169
Estimated For:									
Correcting Irregularities		633		503		4590		3649	
Stabilizing present roadway Sta. 680+ to Sta. 682+		80		30		519			195
Shoulder Slope Finishing		1884				14032			
TOTALS		11,399		6374	5953	86012		47154	44480

PIT LOCATION

FEDERAL ROAD REGION NO.	DISTRICT	PROJ. NO.	SHEET NO.	TOTAL SHEETS
8	COLORADO	F 017-3(13)	6	

HALDE PIT

LOCATION ----- A portion of the N.W. 1/4, Sec. 27, T14S, R. 46W.
 OWNERS ----- John R. Halde
 QUANTITY AVAILABLE ----- 40,000+ Cu. Yds.
 HAUL DISTANCE ----- 0.6 Mile to Sta. 992+
 PROPOSED USE ----- Surfacing
 ESTIMATED FOR STRIPPING ----- 1000 Cu. Yds.
 SAMPLE NO. ----- 4725

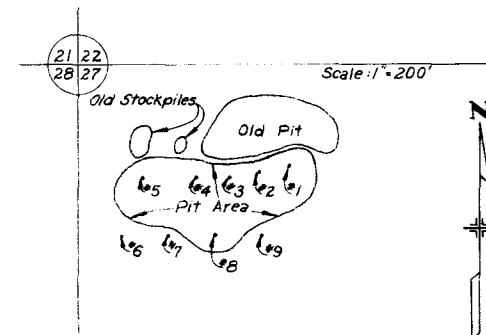

LOG OF THE PIT


Test No.	From	To	Description
1 1A 1B	0' 10' 13'	10' 13' 17'	Silt - tan Sand - very fine grained to gravel Gravel - brown clean coarse
2 2A 2B	0' 8.5' 9.5'	8.5' 9.5' 15'	Silt - tan Sand - very fine grained Sand & Gravel - clean coarse
3 3A 3B	0' 5' 7'	5' 7' 15'	Silt (similar to *2) Sand - fine grained with trace of gravel Gravel with med. grained sand
4 4A	0' 35'	3.5' 12'	Silt (similar to *2) Sand & Gravel
5 5A	0' 5.5'	5.5' 13'	Silt (similar to *2) Gravel (similar to *4A)
6 6A	0' 11'	11' 15'	Silt (similar to *2) Sand - med. to coarse grained
7 7A	0' 5'	5' 15'	Silt (similar to *2) Gravelly Sand - clean
8 8A	0' 9'	9' 16'	Silt - tan Sand & Gravel - clean - coarse
9 9A	0' 9'	9' 15'	Silt (similar to *8) Sand - fine

MAINTENANCE OF DETOURS

STATION	EARTHWORK		GRAVEL SURFACING TONS		REMOVE FENCE LIN. FT.	B.W. FENCE WITH METAL POSTS LIN. FT.	RESET B.W. FENCE WITH METAL POSTS LIN. FT.
	EXCAV. CU. YDS.	EMB. CU. YDS.					
541+50 to 549+00, Rt.	450	1800	300		600	700	600
615+50 to 623+50, Rt.	1200	2400	330		600	700	600

Note: Estimated quantities are for information only.

TYPICAL SECTION OF DETOUR

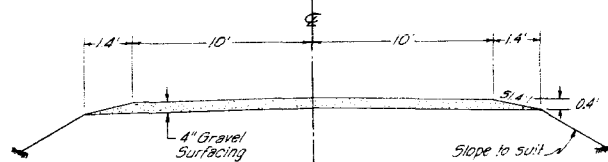

The contractor shall build fence before beginning construction of detour.
Adequate drainage structures shall be supplied by the contractor.

AS CONSTRUCTED

REVISED DATE DEC. 1, 1968

FEDERAL ROAD REGION NO.	DISTRICT	PROJ. NO.	SHEET NO.	TOTAL SHEETS
5	COLORADO	F 017-3(13)	7	

SUMMARY OF EARTHWORK QUANTITIES

UNCLASSIFIED EXCAVATION

Roadway (From Cross Sections)	17,350	12,263	Cu. Yds.
Est. for Subsidence		1,226	
Structure Quantities as Emb.		230	
Structure Quantities as Excav.		0	
Stripping (Removing Overburden)	4,795	1,000	

TOTAL 22,145 ~~14,003~~ Cu. Yds.

BORROW

From Hold Pit	3,336	Cu. Yds.
Est. for Subsidence	334	

TOTAL 3,670 Cu. Yds.

EMBANKMENT (STANDARD) (Moisture and Density Control)

Embankment (Net)	10,870	10,395	Cu. Yds.
Base of Cuts and Fills	23,303	28,070	

TOTAL 34,173 ~~38,465~~ Cu. Yds.

HAUL

From Mass Diagram	15,637	40,314	Yd. Mi.
Est. for Subsidence		4,091	

TOTAL 15,637 ~~45,005~~ Yd. Mi.


ROADWAY QUANTITIES BALANCE (For Information Only)

EXCAVATION	12,263	Cu. Yds.
Unclassified	3,336	
Borrow		
TOTAL	15,599	Cu. Yds.

EMBANKMENT x FACTOR


TOTAL 15,599 Cu. Yds.

DESIGN NO.	DIVISION	PROJECT NO.	SHEET	TOTAL SHEETS
9	C.O.D.	F017-3(13)	8	

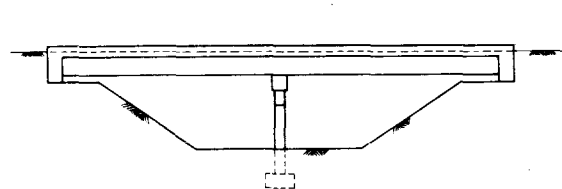


RURAL STREAM CROSSING


DETAILS SHOWING PORTIONS OF
STRUCTURE TO RECEIVE CLASS 2
SURFACE FINISH.

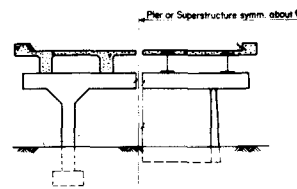


PIER AND SUPERSTRUCTURE

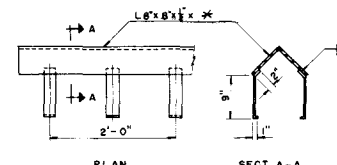

Anchors $2\frac{1}{2} \times \frac{1}{2} \times 1'-0"$ welded @ 12" ctrs. to alternate legs.

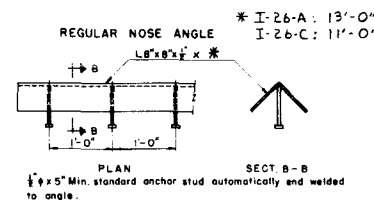

PIER NOSE ANGLE DETAILS

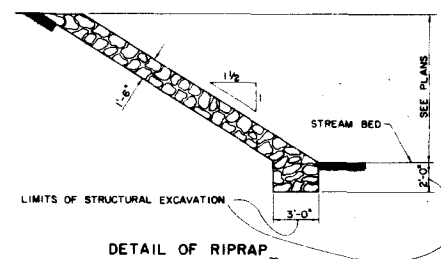

DETAIL OF RIPRAP

GENERAL NOTES

ALL WORK SHALL BE DONE ACCORDING TO THE STANDARD SPECIFICATIONS OF THE DEPARTMENT OF HIGHWAYS, STATE OF COLORADO, APPLICABLE TO THE PROJECT.

ALL REINFORCING STEEL SHALL BE INTERMEDIATE GRADE STEEL OF A DEFORMED TYPE. EACH BAR SHALL BE TAGGED WITH THE BAR DESIGNATION, STRUCTURE NUMBER, AND STATION OF THE PROJECT.

IF BY PERMISSION OF THE ENGINEER PRIMARY BARS ARE SPliced, THEY SHALL LAP 4 MINIMUM OF 40 DIAMETERS FOR BARS NEAR TOPS OF BEAMS HAVING MORE THAN 12 INCHES OF CONCRETE UNDER THE BARS, AND 20 DIAMETERS FOR BARS NEAR THE BOTTOM OF MEMBERS. SECONDARY BARS WHEN SPliced SHALL LAP 20 DIAMETERS.

DIMENSIONS FOR REINFORCING STEEL NOT SHOWN AS CLEAR SHALL BE TO THE CENTERLINE OF THE BAR.

ALL CONCRETE SURFACES MARKED WITH THE SYMBOLS SHOWN ON SHEET NO. 82 SHALL RECEIVE CLASS 2 SURFACE FINISH.

ALL CONCRETE CHAMFERS TO BE $3/4"$ UNLESS OTHERWISE NOTED.

EXPANSION JOINT MATERIAL SHALL MEET AASHTO SPEC. M-153-SH UNLESS OTHERWISE NOTED.

SOUNDINGS AND DEPTH OF FOOTINGS ARE IN ACCORDANCE WITH THE BEST AVAILABLE DATA. WHEN DIFFERENT CONDITIONS ARE ENCOUNTERED, THE BRIDGE ENGINEER WILL INSPECT AND DETERMINE IF REDESIGN IS NECESSARY.

WHEN TREATED TIMBER PILING IS SHOWN ON THE PLANS, THE PRESERVATIVE FOR TREATMENT SHALL BE CREOSOTE OIL.

WHEN EXCAVATING FOR FOOTINGS, THE FINAL ONE FOOT IN DEPTH SHALL BE DONE BY HAND-LABOR METHODS.

FOR DETAILS OF STRUCTURAL EXCAVATION AND STRUCTURE BACKFILL, SEE STANDARD M-206-A.

ALL STRUCTURAL STEEL NOT OTHERWISE NOTED SHALL BE AASHTO M-183.

WELDING SHALL CONFORM TO THE LATEST EDITION OF THE A.W.S. STANDARD SPECIFICATIONS FOR WELDING HIGHWAY BRIDGES AS AMENDED.

ALL STRUCTURAL STEEL SHALL BE PAINTED IN ACCORDANCE WITH SECTION 509 FOR "BLUING-W" PAINT.

BOLTS SHALL BE FURNISHED IN THE AMOUNT OF TWO PERCENT IN EXCESS OF THE NOMINAL NUMBER REQUIRED FOR EACH SIZE AND LENGTH.

LOADING DATA

Live Load: A.A.S.H.O. HS 20-44

Deadload assumes 15 Lbs. per Sq. Ft. Additional Wearing Surface which includes the 1/2-inch Concrete Mortar and Wearing Surface shown.

DESIGNING DATA

A.A.S.H.O. Unit Stresses except as noted:

Reinforcing Steel $f_s = 20000$ Lbs. per Sq. inch
 A7 Structural Steel $f_s = 18000$ Lbs. per Sq. inch
 A36 Structural Steel $f_s = 20000$ Lbs. per Sq. inch
 Concrete $f_c = 2000$ Lbs. per Sq. inch
 $\phi = 10$


*I-26-A STA. 544+78.250 To 545+59.750
 I-26-C STA. 619+30.000 To 620+11.500

STRUCTURE NO. *
 SHEET NO. B-2 OF 12


DEPARTMENT OF HIGHWAYS STATE OF COLORADO	
GENERAL NOTES	
SURFACE FINISH DETAILS	
PIER NOSE DETAILS	
RIPRAP DETAIL	
Drawn by K. L. CARSON	Scale T. 19.5' = 1"
Designed by F. L. CARSON	Approved by R. L. CARSON
Made by R. A. CARSON	Checked by
Date: Oct 13, 1967	

FED. ROAD DIST. NO.	DIVISION	PROJECT NO.	SHEET NO.	TOTAL SHEETS
9	COLO.	F 017-3(13)	9	

AS CONSTRUCTED
REVISED DATE DEC 1 1982

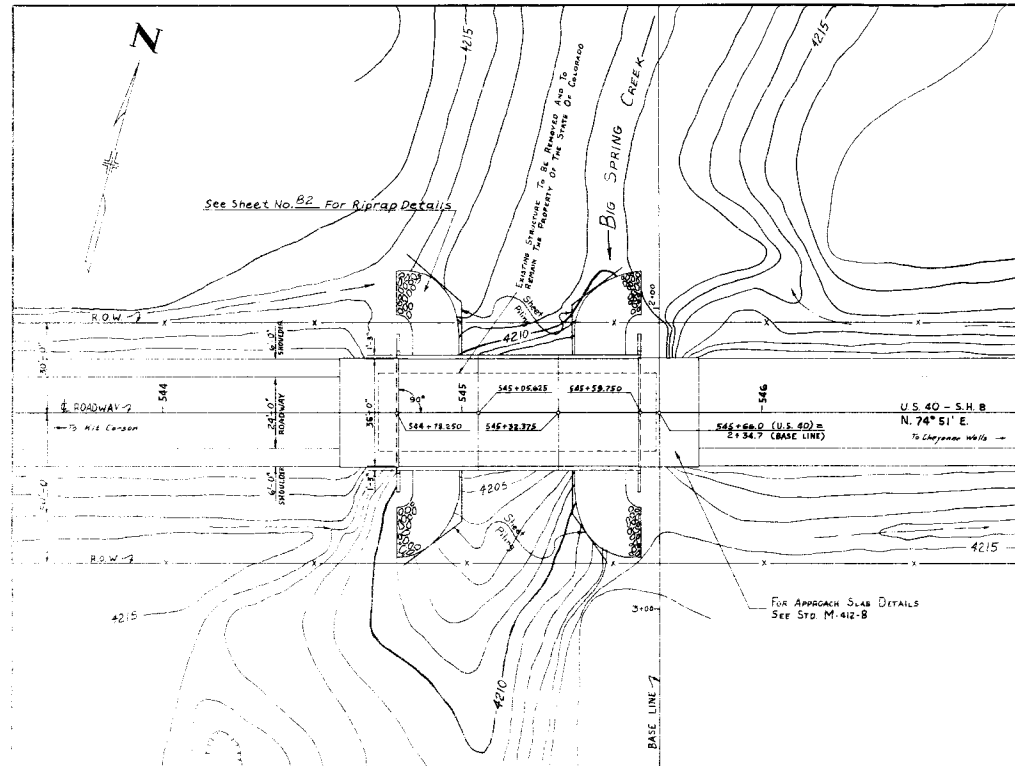

SITUATION PLAN

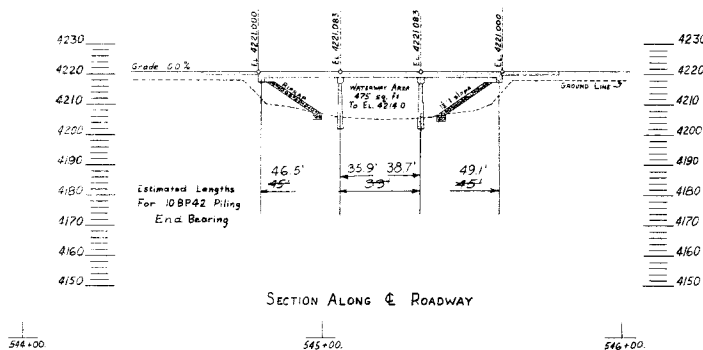

SECTION ALONG & ROADWAY

GENERAL LAYOUT

SUMMARY OF QUANTITIES

ITEM NO.	DESCRIPTION	UNIT	SUPER-STRUCT.	ABUT. NO. 1	PIER NO. 2	PIER NO. 3	ABUT. NO. 4	TOTALS
202	Removal of Bridge	Ea.						1
206	Structure Excavation	Cu. Yd.		28	30	30	27	115
206	Structure Backfill (Class 3)	Cu. Yd.		12	18	18	12	60
① 502	Steel Piling (10BP42)	Lin. Ft.		247.7	179.4	193.7	245.1	866.9
506	Riprap	Cu. Yd.		225	165	165	225	780
509	Structural Steel	L. S.		65.8			140	205.8
509	Structural Steel (Galvanized)	L. S.						Lump Sum
516	Damproofing (Linseed Oil)	Sq. Yd.	540.32					540.32
601	Concrete, Class A	Cu. Yd.				34.6	34	69.2
601	Concrete, Class D	Cu. Yd.	102.8	10.6			10.6	124
602	Reinforcing Steel	Lb.	38,147	841	2,240	2,240	841	44,309

NOTES

- ① 10WF45 may be used in lieu of 10BP42
- ② Design Weight = 760 lb.
- ③ Design Weight = 6,315 lb.
- ④ Includes 160 sq yds for 2 Approach Slabs.

** Note: 6 Cu. Yd. Poured as a foundation for Pier No. 2

Note	Abut. No. 1	Pier No. 2	Pier No. 3	Abut. No. 4
Length Driven	232'-7"	179'-4"	178'-7"	230'-4"
Welds (5)	15'-0"	(0) 0'-0"	(5) 15'-0"	(5) 15'-0"
	247'-7"	179'-4"	193'-7"	245'-4"
Cutoff Less Than 6'	0	23'-0"	21'-9"	19'-8"
	64'-5"	of Cutoff Less Than 6'		


Sheet Piling Covered by Work Order # 10880 (3000 Lin Ft.)

FOR GENERAL NOTES
SHEET NO. B2


DEPARTMENT OF HIGHWAYS
STATE OF COLORADO
GENERAL LAYOUT AND
SUMMARY OF QUANTITIES
3 SPANS (26' EACH) CONCRETE
& GIRDER BRIDGE
36' Roadway ~ 1-3' Curb ~ 90' Area
Across BIG SPRING CREEK
Sta. 544+18.50 to 547+59.75
Near KIT CARSON Sec. 31 T. 42 S. R. 47 E.
Designed by P.L. Bridge Engineer
Made by R.R.A. Bridge Engineer
Checked by Date 12/13/82

1. HIGHWAY
2. FOLDABLE
3. 11 1/2"

FED. ROAD REG. NO.	DIVISION	PROJECT NO.	SHEET NO.	TOTAL SHEETS
9	CDLO.	FO17-3 (13)	10	

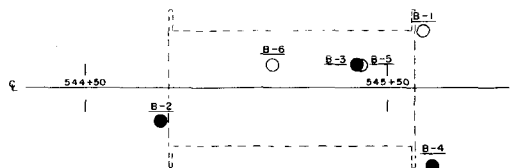

544+75 545+12 545+40 545+41.5 545+65 545+62
11' RT. 7.5' LT. 7.5' LT. 7.5' LT. 26' RT. 19' LT.

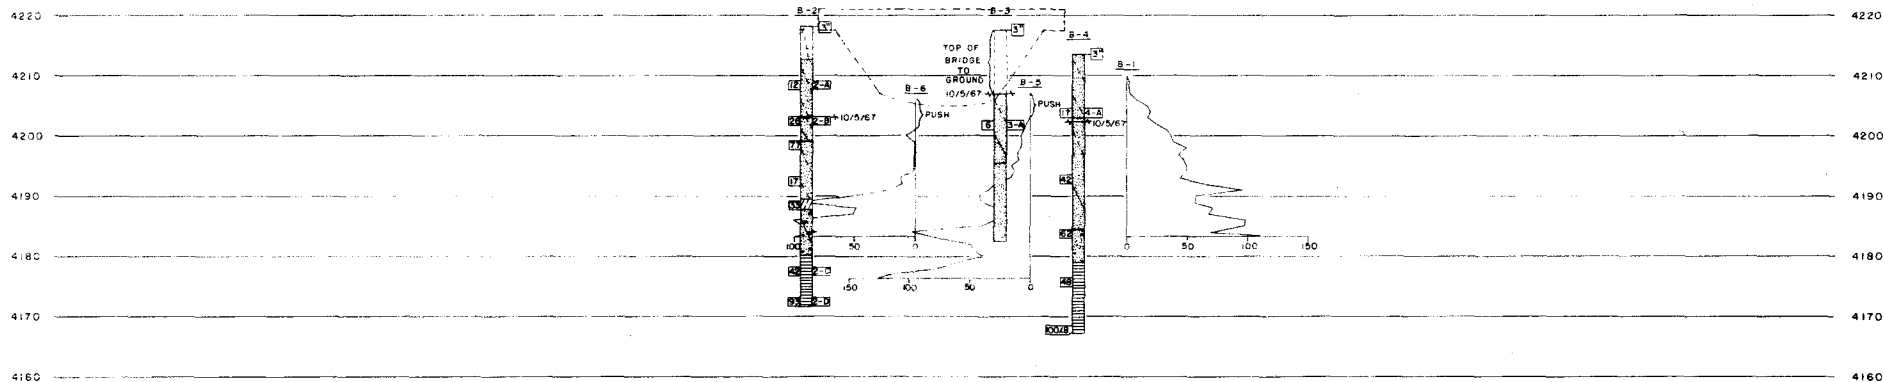


SUMMARY OF TEST RESULTS

Sample No.	Depth	Class/Location	Cone of Regn.	443RD	Grading Analysis				Atterberg Limits				Moist. Cont.	Moist. Unit	Unconf. Comp.	Triaxial Shear Strength				Dist. Of Sample (inches)
					Gravel	Sand	Silt	Clay	Liquid Limit	Plasticity Index	Shrinkage	Weight				Strength	Unconf. Comp.	Consolidated	Time	
2-A	9.0-10.5	Silty Sand	A-2-4(10)	0	18	62	20	NV	NP	NP	10.6									
2-B	15.0-16.5	Silty Sandy Clay	A-6(2)	0	11	44	45	25	14	11	12.7									
2-C	40.0-41.5	Shale	A-7-6(20)	0	0	1	99	70	25	45	22.6/26.3	4.3								1.4
2-D	45.0-46.5	Shale	A-7-6(17)	3	3	1	93	53	28	25	27.2									
3-A	15.0-16.5	Sandy Clay	A-7-6(11)	0	8	57	55	45	18	27	19.1									
4-A	9.0-10.5	Silty Sand	A-2-4(10)	0	12	69	19	NV	NP	NP	17.2									

TYPE OF MATERIAL

- SAND, SILTY, TAN
- SAND, SILTY, CLAYEY, TAN
- SAND, TAN
- SAND, CLAYEY, GRAVELLY, TAN
- SAND W/SOME PEA GRAVEL, TAN
- CLAY, SILTY, TAN
- SHALE, GRAY

LEGEND

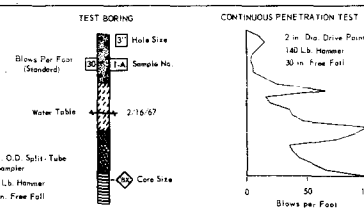

DEPARTMENT OF HIGHWAYS STATE OF COLORADO ENGINEERING GEOLOGY

Across: BIG SPRINGS CREEK
Sta. 544+18.0 to 545+19.5
Near: K.T. CARLSON, Dec. 31, 1966, p. 172
Geologist: E.C. Approved by: [Signature]
Made by: G.C.P. Bridge Engineer
Checked by: J.B.G. Date: Oct 13, 1967


STRUCTURE NO. 1-26-A
SHT. NO. B-3 OF 12

BAR LIST - SUPERSTRUCTURE						
MARK	SIZE	REQ'D	LENGTH	TYPE	DIMENSIONS	
					ft	in
401	1/2" # 102	2'-7"	11	0'-10"	0'-11"	
402	1/2" # 112	3'-5"	14	1'-1/2"	0'-6"	
403	1/2" # 700	4'-11"	11	1'-8"	0'-11"	
404	1/2" # 48	4'-8"	1	1'-2"	0'-10"	
501	1/2" # 164	38'-1"	511			
502	1/2" # 81	39'-0"	XV			
503	1/2" # 258	26'-5"	511			
801	1" # 8	32'-10"	511			
802	1" # 8	38'-2"	511			
1101	1 1/2" # 40	27'-0"	511			
1102	1 1/2" # 60	23'-0"	511			
1103	1 1/2" # 20	24'-5"	511			
1104	1 1/2" # 20	7'-6"	511			
BAR SUMMARY						
4,467 lin ft 1/2" # 0.668 #/ft = 2,984 lb						
16,274 lin ft 1/2" # 1.043 #/ft = 16,979 lb						
568 lin ft 1" # 2.670 #/ft = 1,517 lb						
3,138 lin ft 1 1/2" # 5.313 #/ft = 16,672 lb						
Total 38,147 lb						

BAR LIST - ABUT No 1 (ABUT No 4 SIMILAR)						
MARK	SIZE	REQ'D	LENGTH	TYPE	DIMENSIONS	
					ft	in
405	1/2" # 38	8'-3"	V			
406	1/2" # 12	8'-6"	511			
407	1/2" # 2	3'-1"	511			
408	1/2" # 2	3'-8"	511			
409	1/2" # 4	6'-3"	511			
410	1/2" # 4	4'-4"	11	1'-10"		
70	1/2" # 2 Ea	8y 4" Ea	11	8y 2" Ea	0'-8"	
416	1/2" # 6	6'-4"	11	2'-10"		
504	1/2" # 2	38'-2"	511			
803	1" # 4	38'-2"	511			
BAR SUMMARY						
529 lin ft 1/2" # 0.668 #/ft = 353 lb						
76 lin ft 1/2" # 1.043 #/ft = 79 lb						
153 lin ft 1" # 2.670 #/ft = 409 lb						
Total 841 lb						

BAR LIST - PIER No 2 (PIER No 3 SIMILAR)						
MARK	SIZE	REQ'D	LENGTH	TYPE	DIMENSIONS	
					ft	in
418	1/2" # 24	33'-6"	511			
419	1/2" # 34	5'-1"	XVI			
420	1/2" # 4	4'-4"	VIII	1'-8"	1'-8"	
421	1/2" # 4	4'-0 1/2"		1'-0 1/2"	1'-5"	
70	1/2" # 2 Ea	8y 1 1/2" Ea	VIII	8y 3/4" Ea	8y 1" Ea	
430	1/2" # 4	2'-10 1/2"		0'-5 3/4"	0'-8"	
505	1/2" # 34	33'-7 1/2"	X			
506	1/2" # 2	16'-4"	511			
804	1" # 2	33'-6"	511			
805	1" # 20	2'-4"	511			
BAR SUMMARY						
1,063 lin ft 1/2" # 0.668 #/ft = 710 lb						
1,175 lin ft 1/2" # 1.043 #/ft = 1,226 lb						
114 lin ft 1" # 2.670 #/ft = 304 lb						
Total 2,240 lb						


REVISED SHEET NO.	DIVISION	PROJECT NO.	SHEET NO.	TOTAL SHEETS
9	COLO.	FO17-3(13)	11	

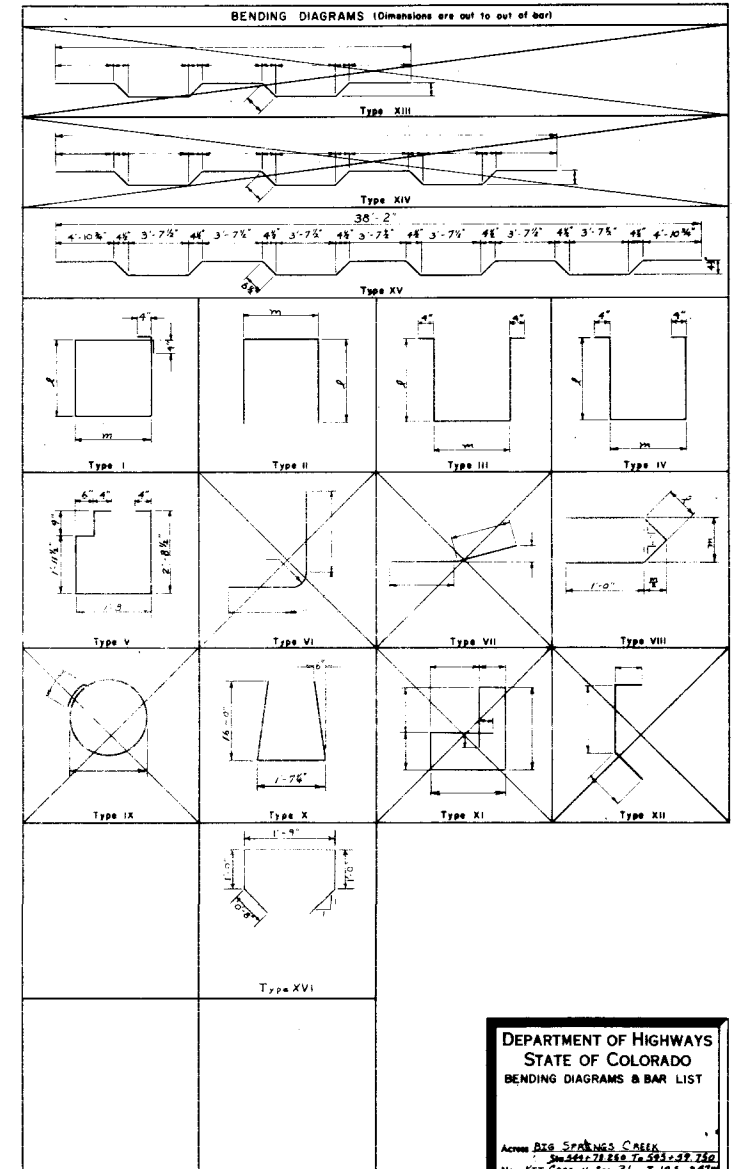

DEPARTMENT OF HIGHWAYS
STATE OF COLORADO
BENDING DIAGRAM & BAR LIST

Across Big SPARKS CREEK
SHEET No. 2188 T. 59 S. R. 76 E.
Main KIT. Channel Sec. 31, T. 19 S. R. 77 E.
Designed by F.L. Approved by R.L. (Signature)
Made by C.T.C. Bridge Engineer
Checked by Date: Oct 13, 1967

FED. ROAD SEQ. NO.	DIVISION	PROJECT NO.	SHEET NO.	TOTAL SHEETS
9	COLO.	F017-3(13)	12	

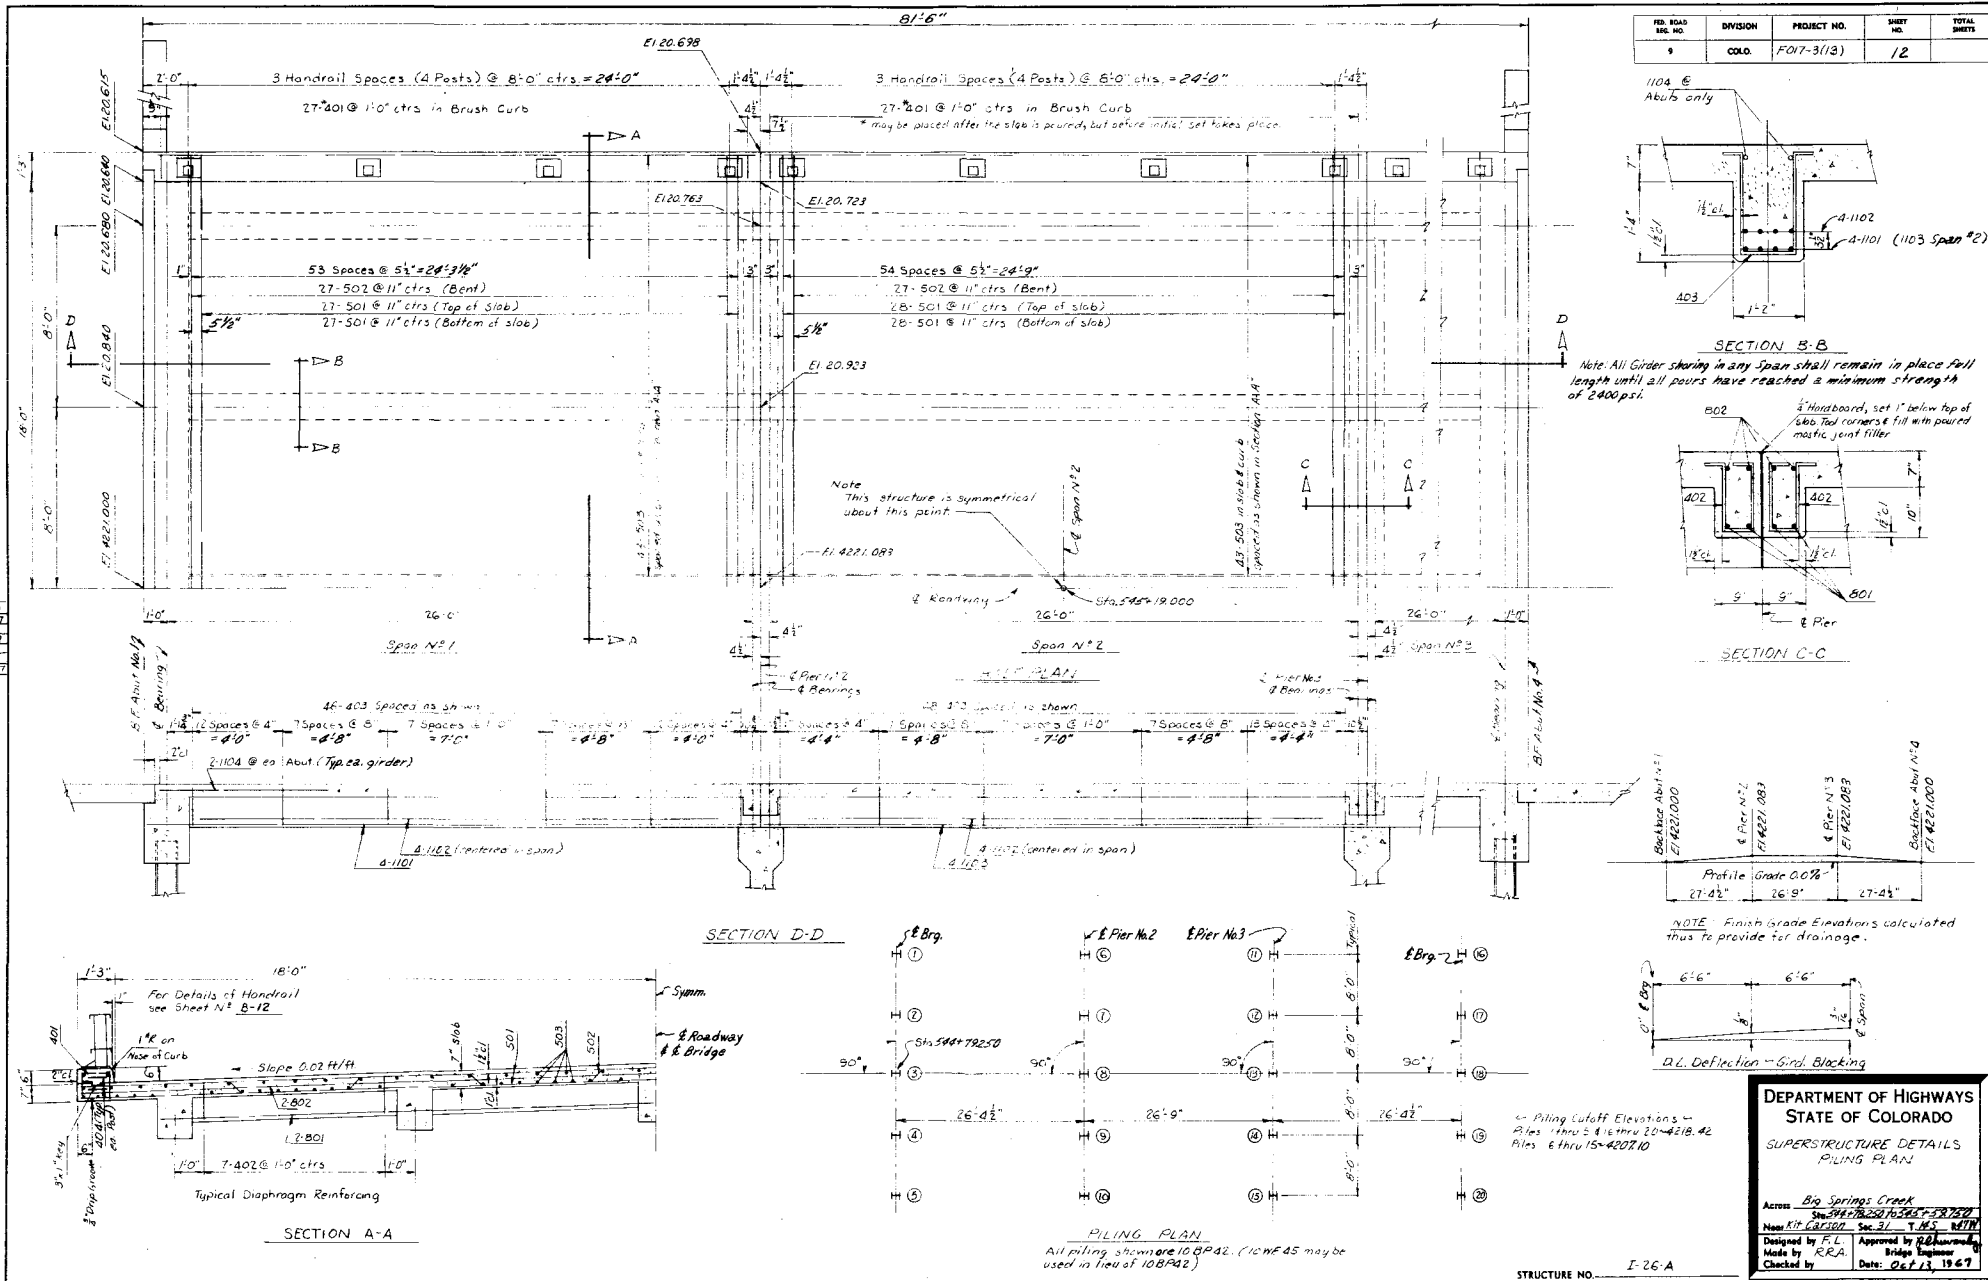


DEPARTMENT OF HIGHWAYS
STATE OF COLORADO
SUPERSTRUCTURE DETAILS
PILING PLAN


Across Big Springs Creek
Sta. 544+78.250 to 545+58.750
Near Kit Carson Sec. 31 T. 14S R. 17W

Designed by <u>F.L.</u>	Approved by <u>Rehman</u>
Made by <u>RRA.</u>	Bridge Engineer
Checked by	Date: <u>Oct 13 1967</u>



FED. ROAD REG. NO.	DIVISION	PROJECT NO.	SHEET NO.	TOTAL SHEETS
9	COLORADO	FOI7-3(13)	13	

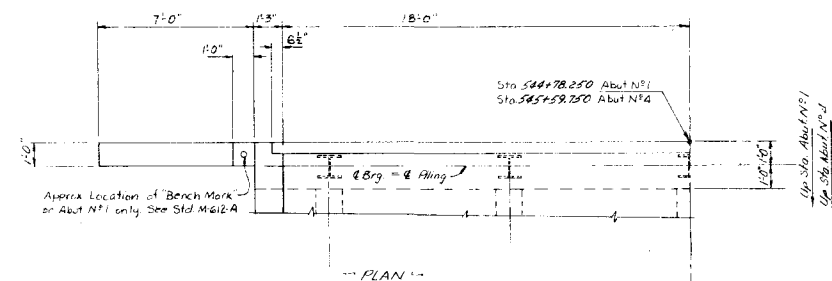


PLAN

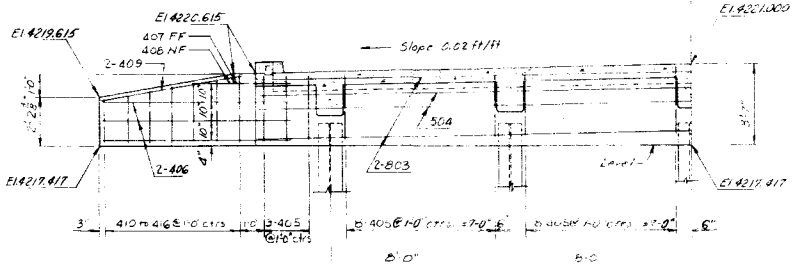


~ ELEVATION ~

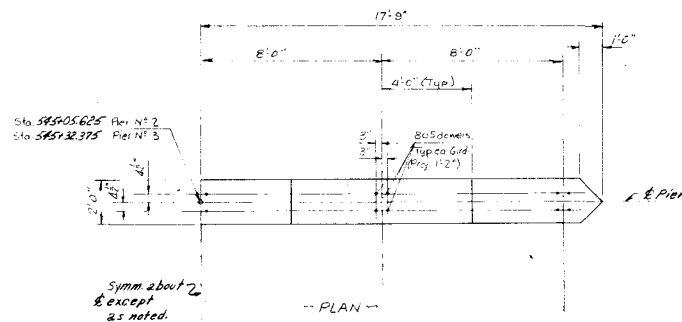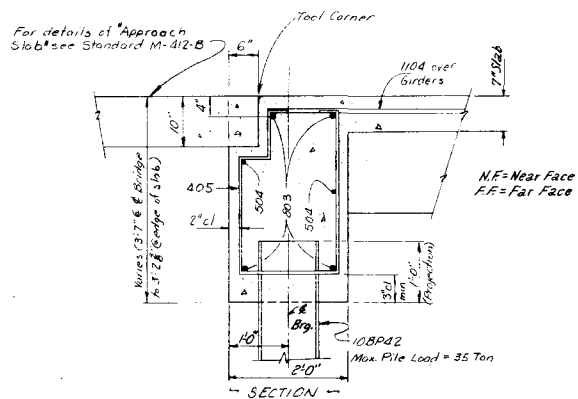

Symm. about z
except
as noted.

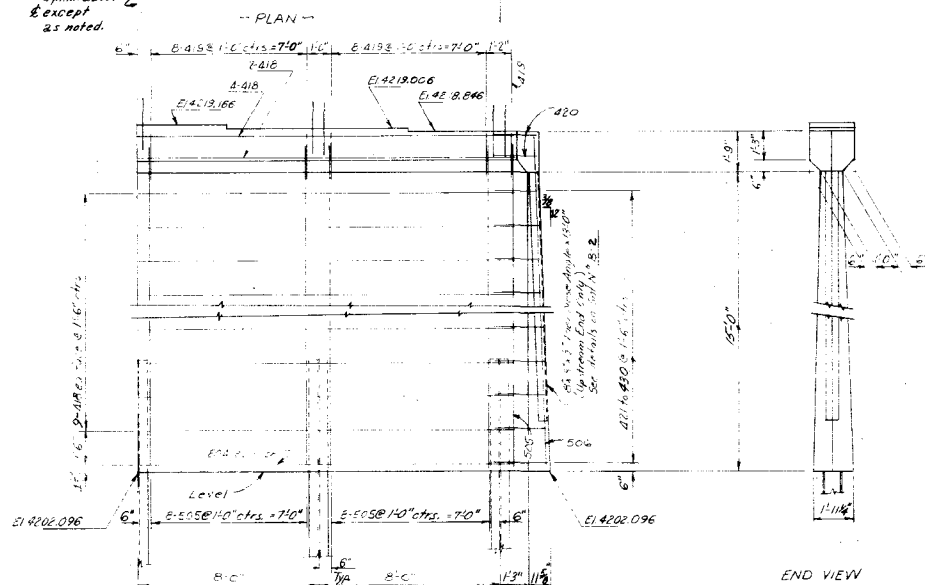

END VIEW

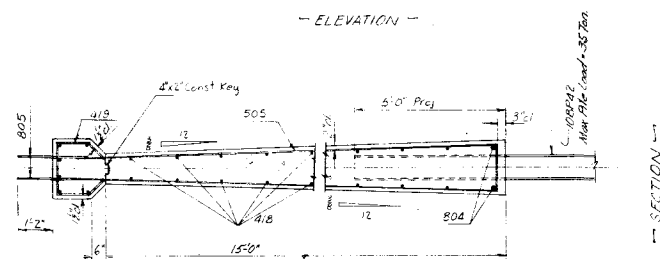

- ELEVATION -

DEPARTMENT OF HIGHWAYS
STATE OF COLORADO
— DETAILS —
ABUTMENTS &
PIERS

Across Big Springs Creek
Sta 545+78.250 to 545+58.750
Near K-1 Carson Sec 31 T.4S. R.7W.


Designed by <u>F.L.</u>	Approved by <u>Rehman</u>
Made by <u>R.R.A.</u>	Bridge Engineer
Checked by	Date: <u>Oct. 13, 1967</u>

STRUCTURE NO. I-26-A

Sheet N° 8-6 of 12

FED. ROAD REG. NO.	DIVISION	PROJECT NO.	SHEET NO.	TOTAL SHEETS
9	COLO.	FOI-3(13)	14	

AS CONSTRUCTED
REVISED DATE DEC 1 1968

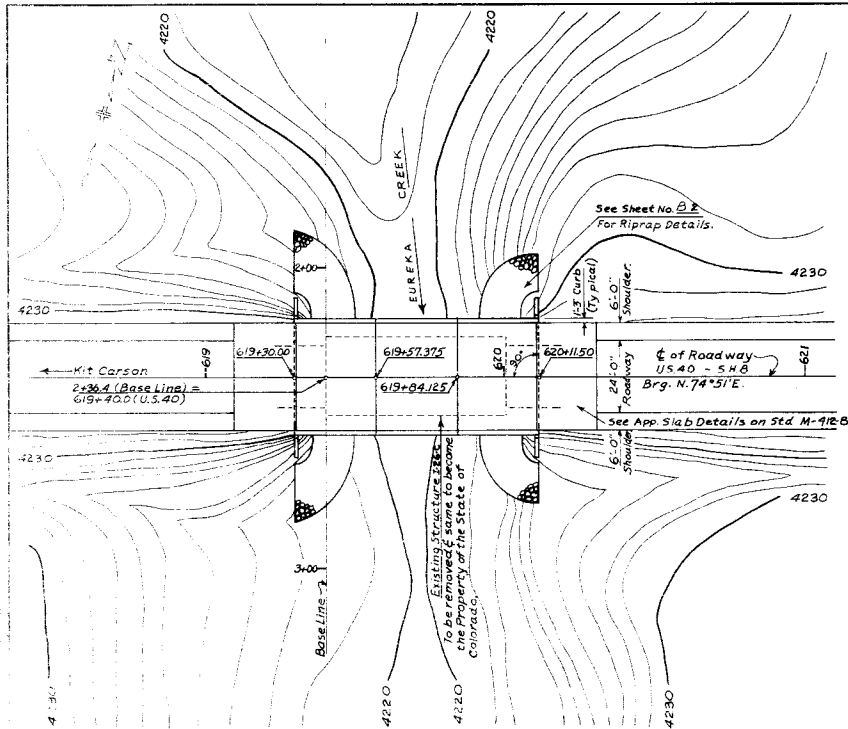


SUMMARY OF QUANTITIES									
ITEM No.	DESCRIPTION	UNIT	SUPER-STRUCT.	ABUT. No. 1	PIER No. 2	PIER No. 3	ABUT. No. 4	TOTAL	
202	Removal of bridge	Each	—	—	—	—	—	1	
203	Unclassified Excavation	Cu. Yd.	—	—	—	—	—	15.0	Included in Roadway Mass
206	Structure Excavation	Cu. Yd.	—	50	30	30	50	160	
206	Structure Backfill (Class 3)	Cu. Yd.	—	5	20	20	5	50	
① 502	Steel Piling (10BP 42)	Lin. Ft.	—	225'-1"	154'-10"	170'-10"	230'-10"	780'-1"	*
506	Riprap	Cu. Yd.	—	100	175	130	190	675	*
② 509	Structural Steel	Lump Sum	—	88.1	—	—	133.0	L.S.	**
③ 509	Structural Steel (Galv.)	Lump Sum	—	—	—	—	—	L.S.	
④ 516	Dampproofing (Linseed Oil)	Sq. Yds.	540.32	—	—	—	—	540.32	Curb Only
601	Concrete, Class A	Cu. Yd.	—	—	29.5	29.5	—	59	
601	Concrete, Class D	Cu. Yd.	102.8	10.6	—	—	10.6	124	
602	Reinforcing Steel	Lb.	38,147	841	2044	2044	841	43,917	

- ① 10W45 May be used in lieu of 10BP 42.
② Design Weight = 640 Lbs.
③ Design Weight = 6315 Lbs.
④ Includes 160 Sq. Yds. for 2 Approach Slabs.

* Note
Length Driven
Wells
Cutoff Less Than 6'
20'-4" of Cutoff Less Than 6'

Abut. No. 1	Pier No. 2	Pier No. 3	Abut. No. 4
210'-1"	151'-10"	155'-10"	215'-10"
(5) 15'-0"	(5) 3'-0"	(5) 15'-0"	(5) 15'-0"
225'-1"	154'-10"	170'-10"	230'-10"
10'-1"	3'-11"	3'-0"	3'-4"

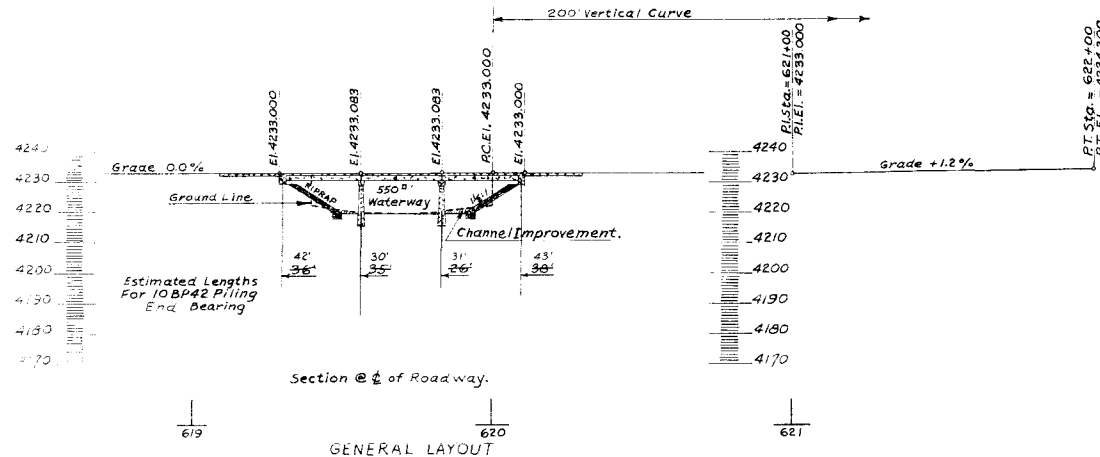


FOR GENERAL NOTES
SHEET No. B-2


COLORADO
DEPARTMENT OF HIGHWAYS
GENERAL LAYOUT AND
SUMMARY OF QUANTITIES
3 SPAN (26' EACH) CONC. SLAB
AND GIRDER BRIDGE
36' ROADWAY - 90'S SKEW - 13' CURBS
Across EUREKA CREEK
Sta. 619+30.000 to 620+11.500
Near Kitt Carson Sec. 33 T. 14 S. R. 47 W.
Designed by F.L. Approved by R.R.A. Bridge Engineer
Made by R.R.A. Checked by DSM/CH Date Oct. 13 1967

OF HIGHWAYS
1. 6. 2. 3. 4. 100.

| FED. ROAD
REG. NO. | DIVISION | PROJECT NO. | SHEET
NO. | TOTAL
SHEETS |
|-----------------------|----------|-------------|--------------|-----------------|
| 9 | COLO. | FO17-3(13) | 15 | |

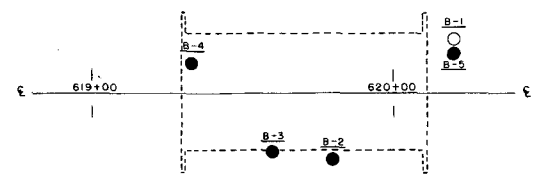

619+33 619+60 619+80 620+10 620+10
10' LT. 19.5' RT. 22' RT. 13' LT. 18' LT.

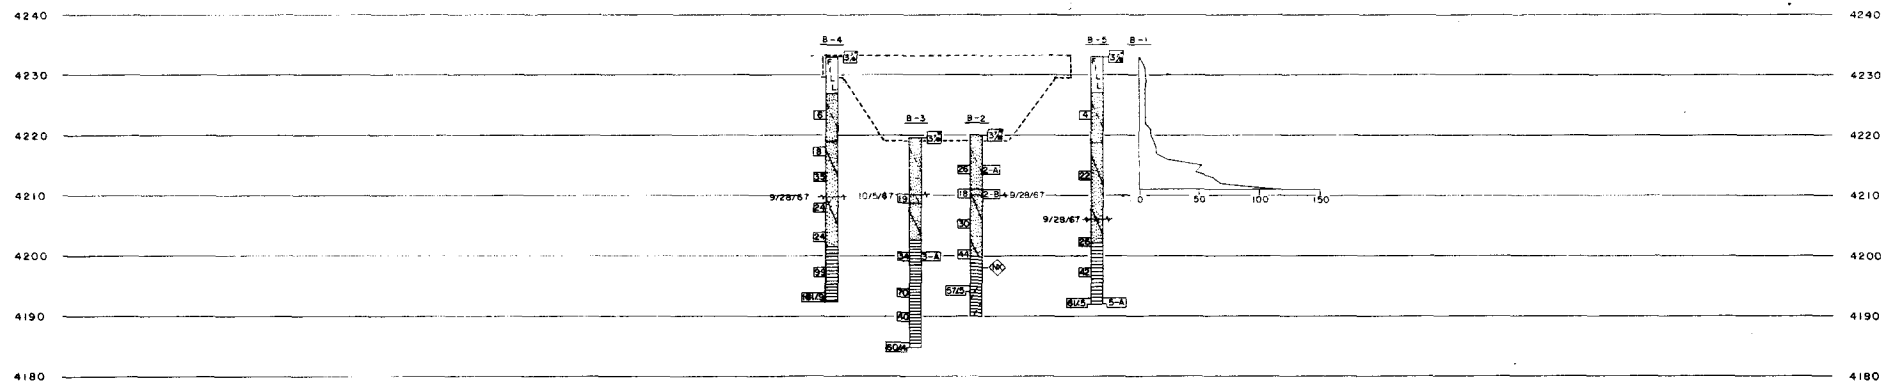


SUMMARY OF TEST RESULTS

| Sample No. | Depth | Classification | Coring Analysis | Atterberg Limits | | Liquid Limit (%) | Plasticity Index (%) | Shrinkage (%) | Moisture Content (%) | Organic Content (%) | Triaxial Shear Strength | Dis. of Sample |
|------------|-----------|----------------|-----------------|------------------|----|------------------|----------------------|---------------|----------------------|---------------------|-------------------------|----------------|
| | | | | LL | PI | | | | | | | |
| 2-4 | 5.0-6.5 | Silty Sand | A-2-4(0) | 0 | 20 | 53 | 27 | 23 | 17 | 6 | 11.0 | |
| 2-8 | 9.0-10.5 | Sandy Clay | A-6(6) | 0 | 15 | 31 | 54 | 32 | 16 | 16 | 17.8 | |
| 3-4 | 19.0-20.5 | Shale | A-7-6(20) | 0 | 2 | 98 | 68 | 25 | 43 | 25.0 | 25.4 | 2.4 |
| 5-4 | 40.0-41.0 | Shale | A-7-6(20) | 0 | 1 | 99 | 68 | 23 | 45 | 21.5 | | |

TYPE OF MATERIAL

- SAND, SILTY, TAN
- SAND, CLAYEY, TAN
- SHALE, LT. BROWN TO GRAY
- SHALE, SILTY, GRAY

LEGEND

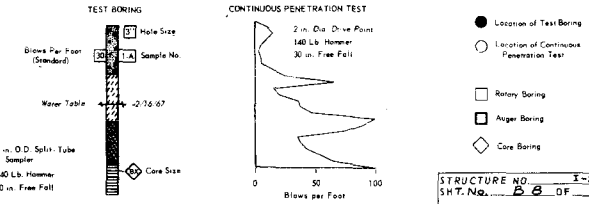

DEPARTMENT OF HIGHWAYS
STATE OF COLORADO
ENGINEERING GEOLOGY
Access: EUREKA CREEK
Sta. 619+30.00 to 620+10.00
Near: K&T CARSON Sec. 33 T. 14S R. 47W
Geologist: E.C. Approved: J.B.G.
Made by: G.C.P. Bridge Engineer
Checked by: J.B.G. Date: Oct 12 1967


STRUCTURE NO. I-26-C
SHT. No. 28 OF 12 SHEETS

| FED. ROAD
REG. NO. | DIVISION | PROJECT NO. | SHEET
NO. | TOTAL
SHEETS |
|-----------------------|----------|-------------|--------------|-----------------|
| 9 | COLO. | FO17-3(13) | 16 | |

| BAR LIST - SUPERSTRUCTURE | | | | | | |
|---|-----------------|-------|---------|------|------------|--------|
| MARK | SIZE | REQ'D | LENGTH | TYPE | DIMENSIONS | |
| | | | | | ℓ | vm |
| 401 | $\frac{1}{2}$ " | 162 | 2'-7" | 11 | 0'-10" | 0'-11" |
| 402 | $\frac{1}{2}$ " | 112 | 3'-5" | 12 | 1'-1 1/2" | 0'-6" |
| 403 | $\frac{1}{2}$ " | 700 | 4'-11" | 11 | 1'-5" | 0'-11" |
| 404 | $\frac{1}{2}$ " | 48 | 4'-8" | 1 | 1'-3" | 0'-10" |
| 501 | $\frac{1}{2}$ " | 144 | 38'-3" | 5rr | | |
| 502 | $\frac{1}{2}$ " | 81 | 39'-6" | XV | | |
| 503 | $\frac{1}{2}$ " | 200 | 24'-5" | 5rr | | |
| 801 | 1" | 8 | 32'-10" | 5rr | | |
| 802 | 1" | 8 | 30'-2" | 5rr | | |
| 1101 | $\frac{1}{2}$ " | 40 | 27'-0" | 5rr | | |
| 1102 | $\frac{1}{2}$ " | 60 | 23'-0" | 5rr | | |
| 1103 | $\frac{1}{2}$ " | 20 | 24'-5" | 5rr | | |
| 1104 | $\frac{1}{2}$ " | 20 | 7'-6" | 5rr | | |
| BAR SUMMARY | | | | | | |
| 4 467 lin ft $\frac{1}{2}$ " ϕ @ 0.668 $\frac{1}{ft}$ = 2,984 lb | | | | | | |
| 16,274 lin ft $\frac{1}{2}$ " ϕ @ 1.043 $\frac{1}{ft}$ = 16,974 lb | | | | | | |
| 568 lin ft 1" ϕ @ 2.670 $\frac{1}{ft}$ = 1,517 lb | | | | | | |
| 3,138 lin ft $\frac{1}{2}$ " ϕ @ 5.313 $\frac{1}{ft}$ = 16,672 lb | | | | | | |
| Total 38,147 lb | | | | | | |

| BAR LIST - ABUT. No. 1 (ABUT. No. 4 SIMILAR) | | | | | | |
|---|-----------------|-------|----------|------|------------|-------|
| MARK | SIZE | REQ'D | LENGTH | TYPE | DIMENSIONS | |
| | | | | | ℓ | vm |
| 405 | $\frac{1}{2}$ " | 38 | 8'-3" | V | | |
| 406 | $\frac{1}{2}$ " | 12 | 8'-6" | 5rr | | |
| 407 | $\frac{1}{2}$ " | 2 | 3'-1" | 5rr | | |
| 408 | $\frac{1}{2}$ " | 2 | 3'-8" | 5rr | | |
| 409 | $\frac{1}{2}$ " | 4 | 6'-3" | 5rr | | |
| 410 | $\frac{1}{2}$ " | | 4'-4" | | 1'-10" | |
| 70 | $\frac{1}{2}$ " | 2 Ea | 8'-4" To | 11 | 8'-2" To | 0'-8" |
| 416 | $\frac{1}{2}$ " | | 6'-4" | | 2'-10" | |
| 504 | $\frac{1}{2}$ " | 2 | 38'-2" | 5rr | | |
| 803 | 1" | 4 | 38'-2" | 5rr | | |
| BAR SUMMARY | | | | | | |
| 529 lin ft $\frac{1}{2}$ " ϕ @ 0.668 $\frac{1}{ft}$ = 353 lb | | | | | | |
| 76 lin ft $\frac{1}{2}$ " ϕ @ 1.043 $\frac{1}{ft}$ = 79 lb | | | | | | |
| 153 lin ft 1" ϕ @ 2.670 $\frac{1}{ft}$ = 409 lb | | | | | | |
| Total 841 lb | | | | | | |

| BAR LIST - PIER No. 2 (PIER No. 3 SIMILAR) | | | | | | |
|--|-----------------|-------|--------------|------|------------|-----------|
| MARK | SIZE | REQ'D | LENGTH | TYPE | DIMENSIONS | |
| | | | | | ℓ | vm |
| 418 | $\frac{1}{2}$ " | 22 | 33'-6" | 5rr | | |
| 419 | $\frac{1}{2}$ " | 34 | 5'-3" | XVI | | |
| 420 | $\frac{1}{2}$ " | 4 | 4'-4" | VIII | 1'-2" | 1'-8" |
| 421 | $\frac{1}{2}$ " | | 3'-10 3/4" | | 0'-11 3/8" | 1'-3 3/8" |
| To | $\frac{1}{2}$ " | 2 Ea | 8'-1 1/4" To | VIII | 8'-1/4" To | 8'-1" To |
| 429 | $\frac{1}{2}$ " | | 2'-10 3/4" | | 0'-5 3/8" | 0'-7 3/8" |
| 505 | $\frac{1}{2}$ " | 34 | 29'-6" | X | | |
| 506 | $\frac{1}{2}$ " | 2 | 1'-7" | 5rr | | |
| 804 | 1" | 2 | 33'-6" | 5rr | | |
| 805 | 1" | 20 | 2'-4" | 5rr | | |
| BAR SUMMARY | | | | | | |
| 994 lin ft $\frac{1}{2}$ " ϕ @ 0.668 $\frac{1}{ft}$ = 664 lb | | | | | | |
| 1032 lin ft $\frac{1}{2}$ " ϕ @ 1.043 $\frac{1}{ft}$ = 1,076 lb | | | | | | |
| 114 lin ft 1" ϕ @ 2.670 $\frac{1}{ft}$ = 304 lb | | | | | | |
| Total: 2,044 lb | | | | | | |

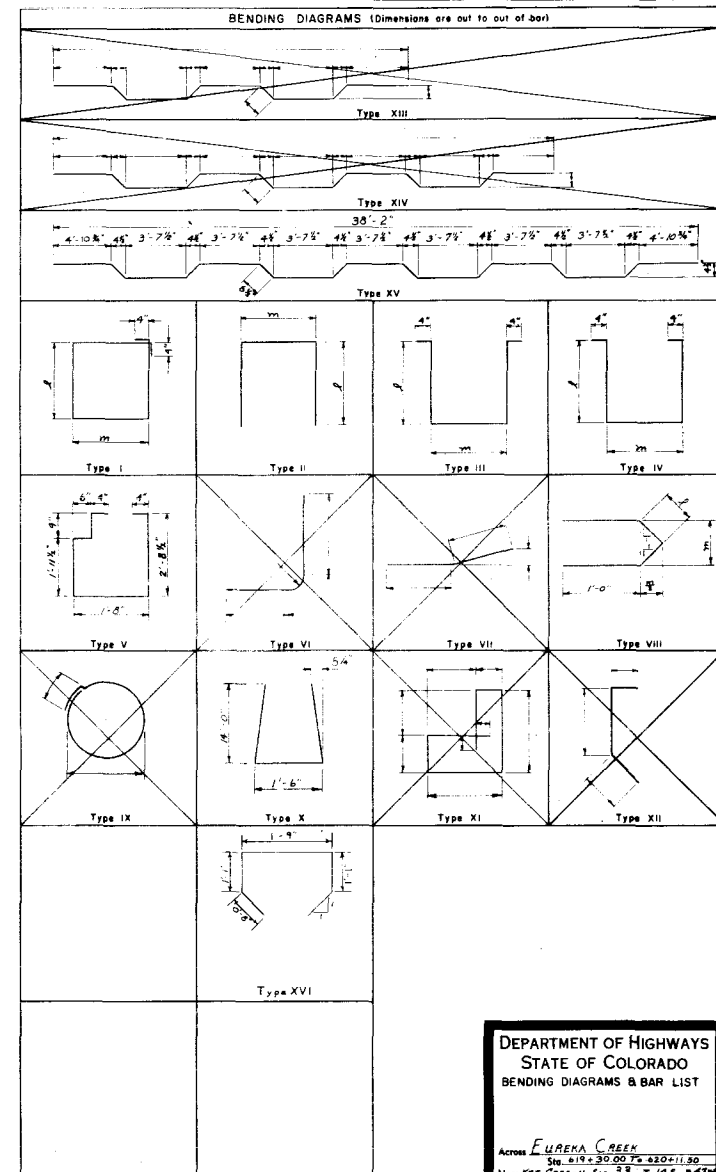

DEPARTMENT OF HIGHWAYS
STATE OF COLORADO
BENDING DIAGRAMS & BAR LIST

Across FLURENA CREEK
Sta. 619+30.00 To 620+11.00
New K.T. CREAN Sec. 33 T.19S. R.12E
Designed by F.L. Approved by W.D.
Made by C.T.C. Bridge Engineer
Checked by Date: Oct. 13, 1967

1104 @
Abuts only

7'-0"

1'-4"

1'-2"

4-1102

4-1101

403

1'-2"

(1103 in Span N°2)

SECTION B-B

NOTE: Girder shoring shall remain in place full length in any span until all piers have reached a min. strength of 2400 PSI. in that span.

4" Hardboard, set 1" below top of slab. Tool corners & fill with poured mastic joint filler

SECTION C-C

SECTION D-D

SECTION A-A

PILING PLAN



All piling shown are 10 BP42 (10 WF 45 may be used in lieu of 10 BP42)

STRUCTURE NO. I-26-C
Sheet No 810 of 12

DEPARTMENT OF HIGHWAYS
STATE OF COLORADO
SUPERSTRUCTURE DETAILS
PILING PLAN

| | |
|--------------------------------------|--|
| Across <u>Eureka Creek</u> | |
| Sta. <u>618+90.000 to 620+11.500</u> | |
| Near <u>Kit Carson</u> | Sec. <u>33</u> T. <u>14S</u> R. <u>47W</u> |
| Designed by <u>F.L.</u> | Approved by <u>Charnely</u> |
| Made by <u>R.R.A.</u> | Bridge Engineer |
| Checked by | Date: <u>Oct 13, 1967</u> |

| | Initial | Date |
|------------|---------|------|
| SIGNED BY | F.L. | 8-67 |
| CHECKED BY | | |
| AWN BY | RRA | 8-67 |
| CHECKED BY | DSM | 9-67 |
| ACED BY | | |
| CHECKED BY | GJC | 9-67 |

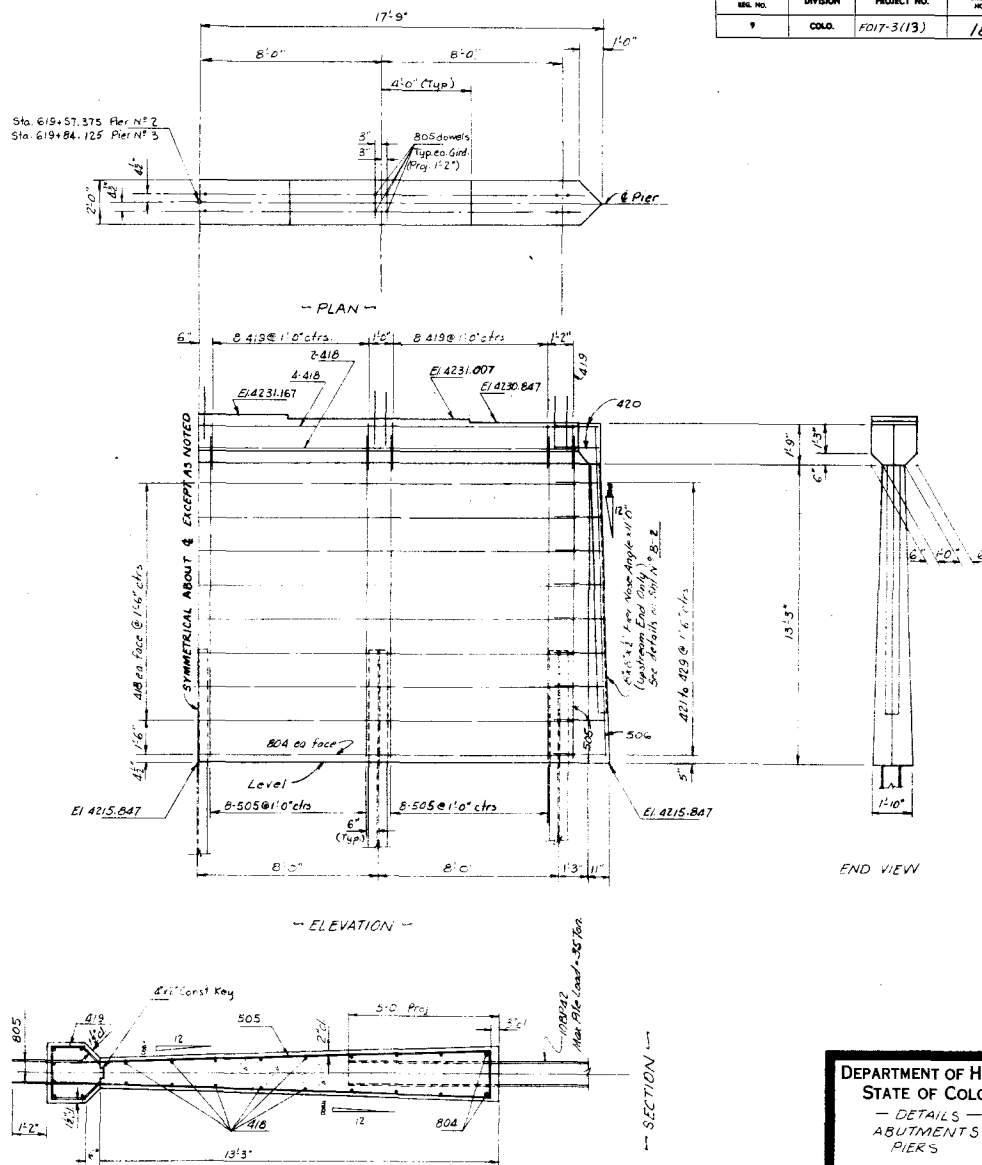
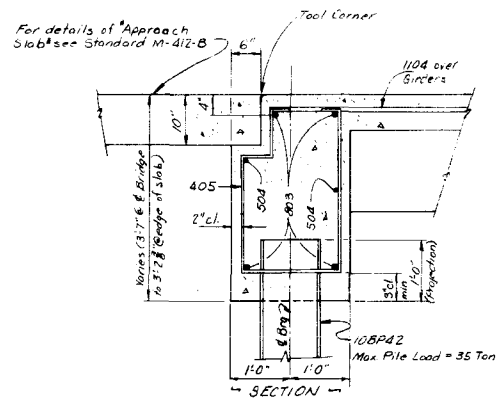


Across Eureka Creek
Sta. 619130.000 to 620+11.500
Near Kitt Carson Sec. 33 T. 14S R. 10W
Designed by F.L. Approved by R. E. Howard
Made by R.R.A. Bridge Engineer
Checked by _____ Date: Oct. 13, 1967


STRUCTURE NO. I-26-C
Sheet N° B-11 of 12

See detail for
fastening bridge
rail to transition
guardrail

| FED. ROAD
BEG. NO. | DIVISION | PROJECT NO. | SHEET
NO. | TOTAL
SHEETS |
|-----------------------|----------|-------------|--------------|-----------------|
| 9 | COLO. | F017-3(13) | 19 | |

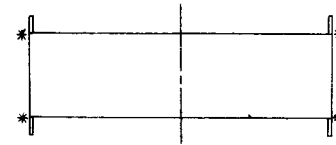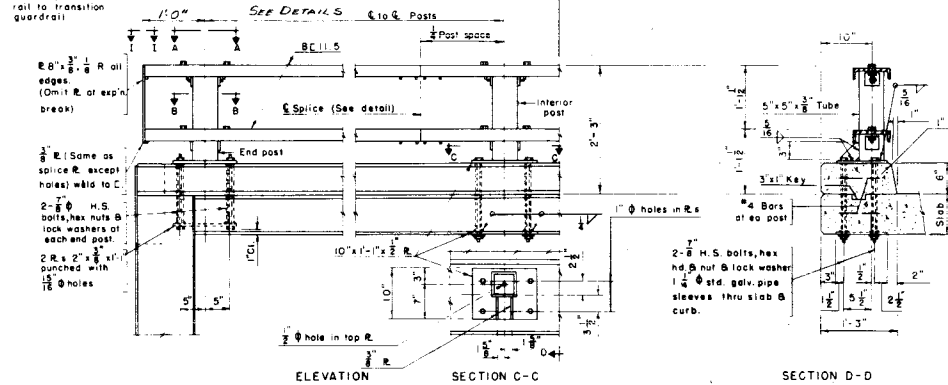


* DIAGRAM SHOWING LOCATION OF DETAILS
OF END CONNECTION FOR FASTENING
BRIDGE RAIL TO TRANSITION GUARD RAIL

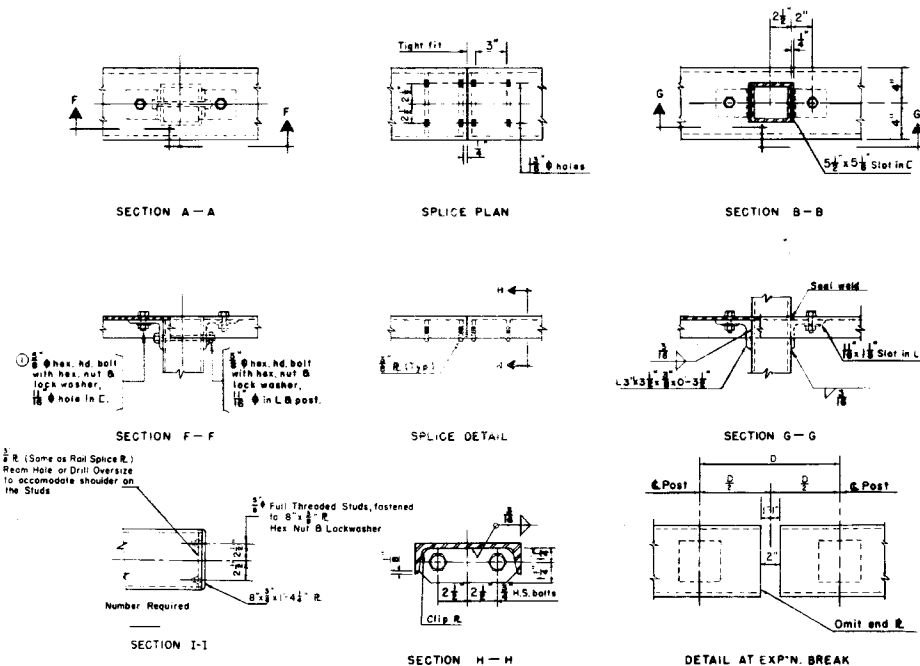

Notes:

- Posts to be perpendicular to the grade and slope of deck.
- All rail elements to be galvanized after fabrication in accordance with specifications.
- A.I.S.I. 1144 steel rods may be used in lieu of H.S. bolts shown. 10" wedge test not required for either bolts or rods used in rail assembly.
- 3/8" standard full threaded studs welded to the channel may be used. Increase size of slot in the angle to 13/16" x 1/4".
- Channels to be continuous over 3 or 4 posts before splicing.

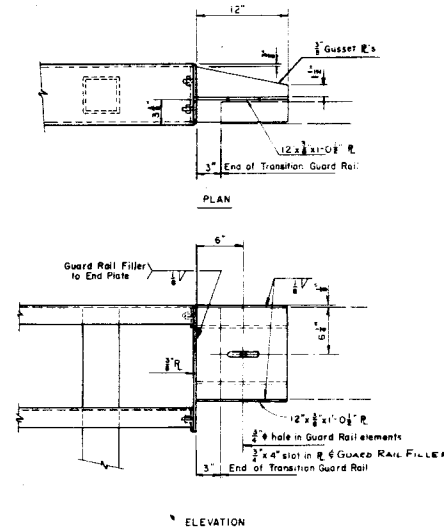

DETAILS OF END CONNECTION FOR FASTENING BRIDGE RAIL TO TRANSITION GUARD RAIL

(Complete Unit to be galvanized after fabrication)
Detail Shown is For: Right Hand Rail
Opposite Hand For Left Hand Rail

* I-26-A STA 544+78.250 To 545+59.750
I-26-C STA 619+30.000 To 620+11.500


STRUCTURE NO. *
SHEET NO. 12 of 12

DEPARTMENT OF HIGHWAYS
STATE OF COLORADO
HANDRAIL DETAILS

Across Sta. *
Near KITT Canyon Sec. T. 13 S. R. 42 E.
Designed by F. L. Bridge Engineer
Made by R. R. Bridge Engineer
Checked by Date Oct 13, 1967


AS CONSTRUCTED REVISED DATE DEC 1 1968

| FED. ROAD DIST. NO. | STATE | PROJ. NO. | SHEET NO. | TOTAL SHEETS |
|---------------------|-------|-------------|-----------|--------------|
| 3 | COLO. | F 017-3(13) | 20 | |

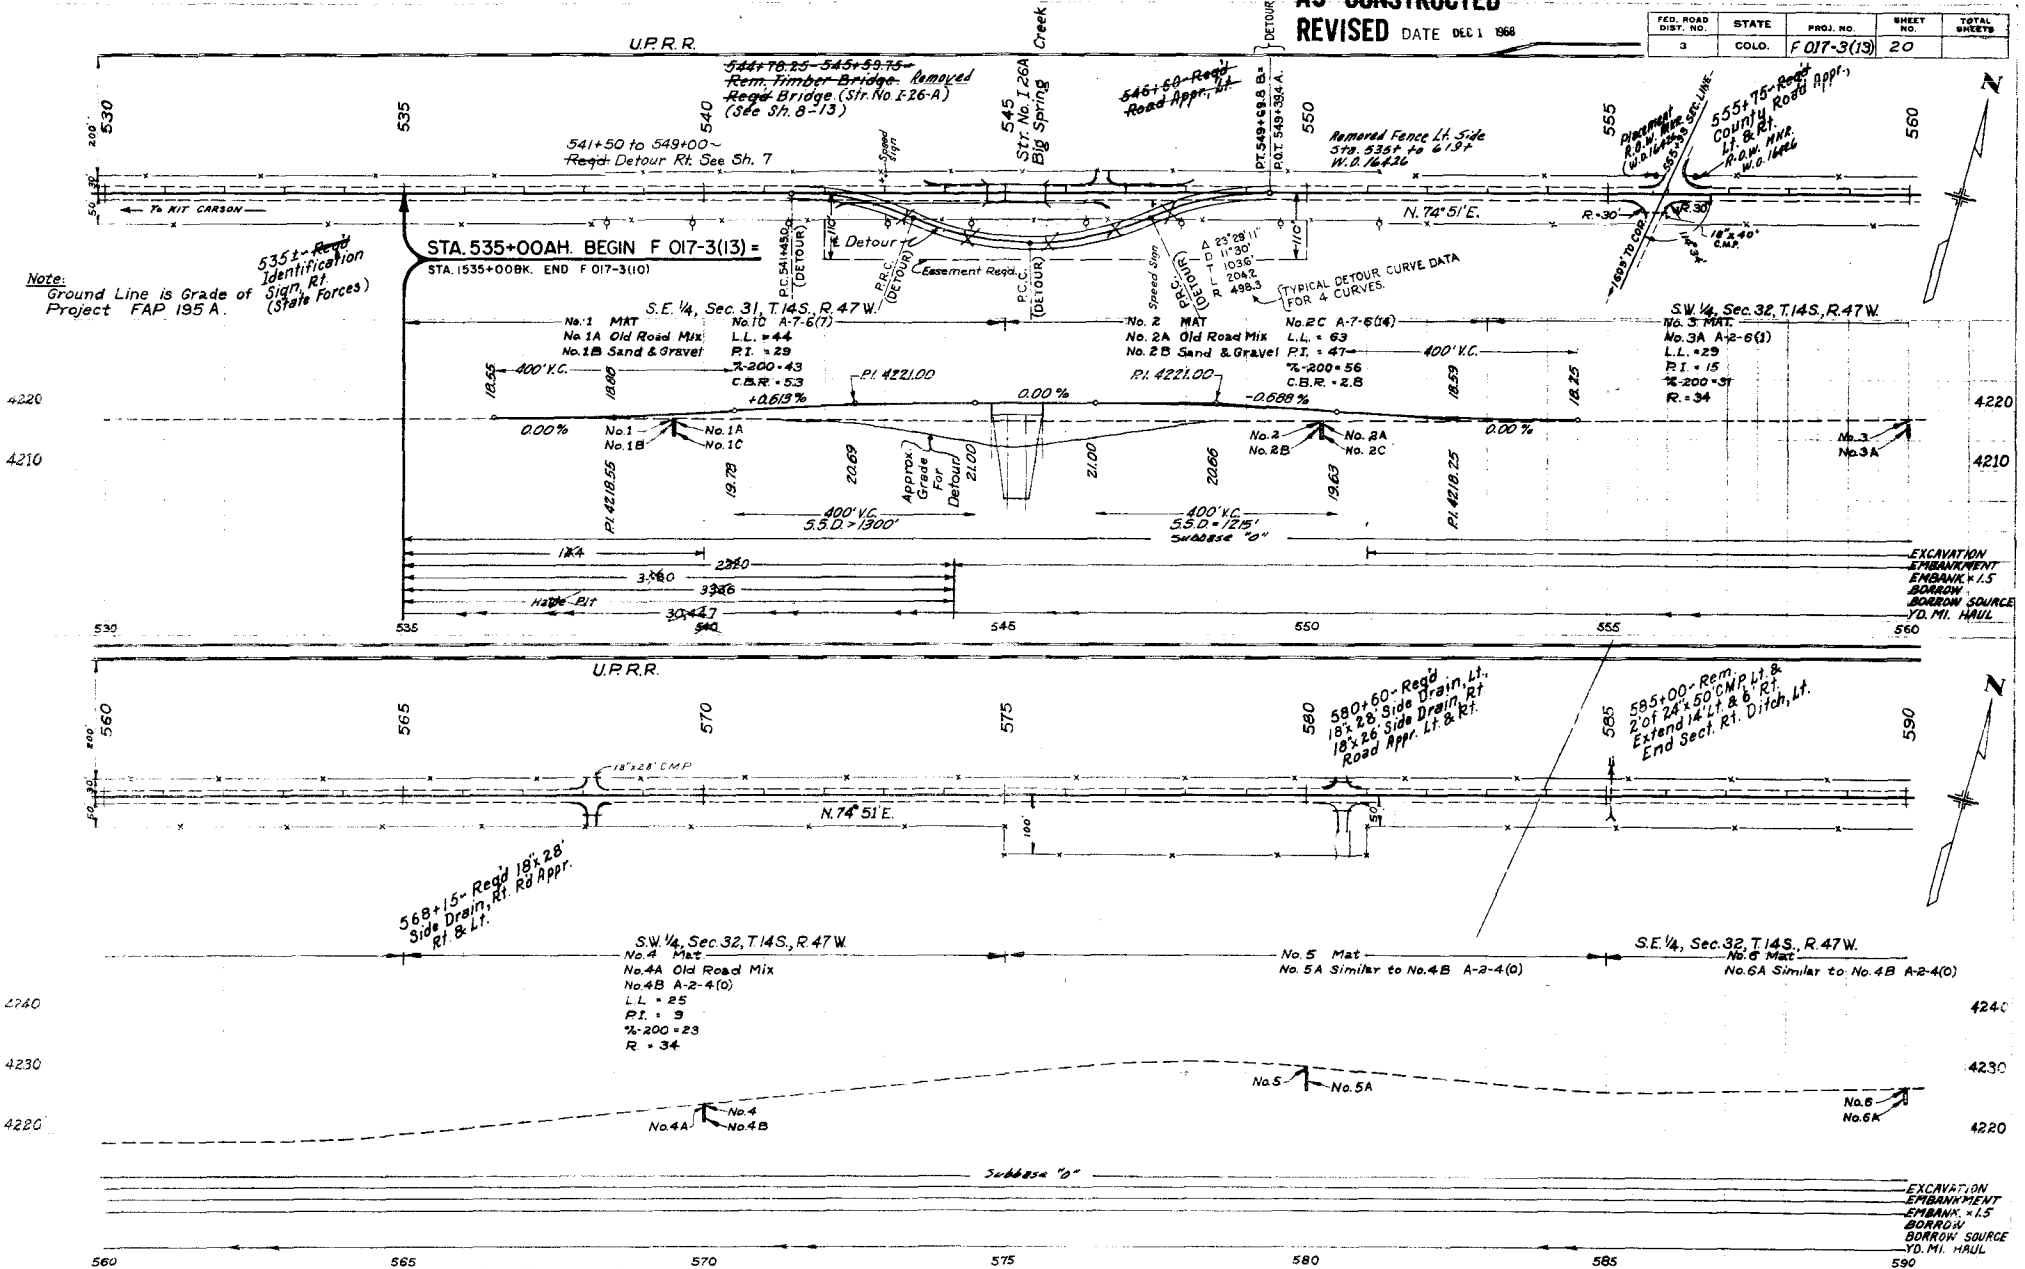


| FED. ROAD DIST. NO. | STATE | PROJ. NO. | SHEET | TOTAL SHEETS |
|---------------------|-------|-------------|-------|--------------|
| 3 | COLO. | F 017-3(13) | 22 | |

AS CONSTRUCTED
REVISED DATE DEC 1 1966

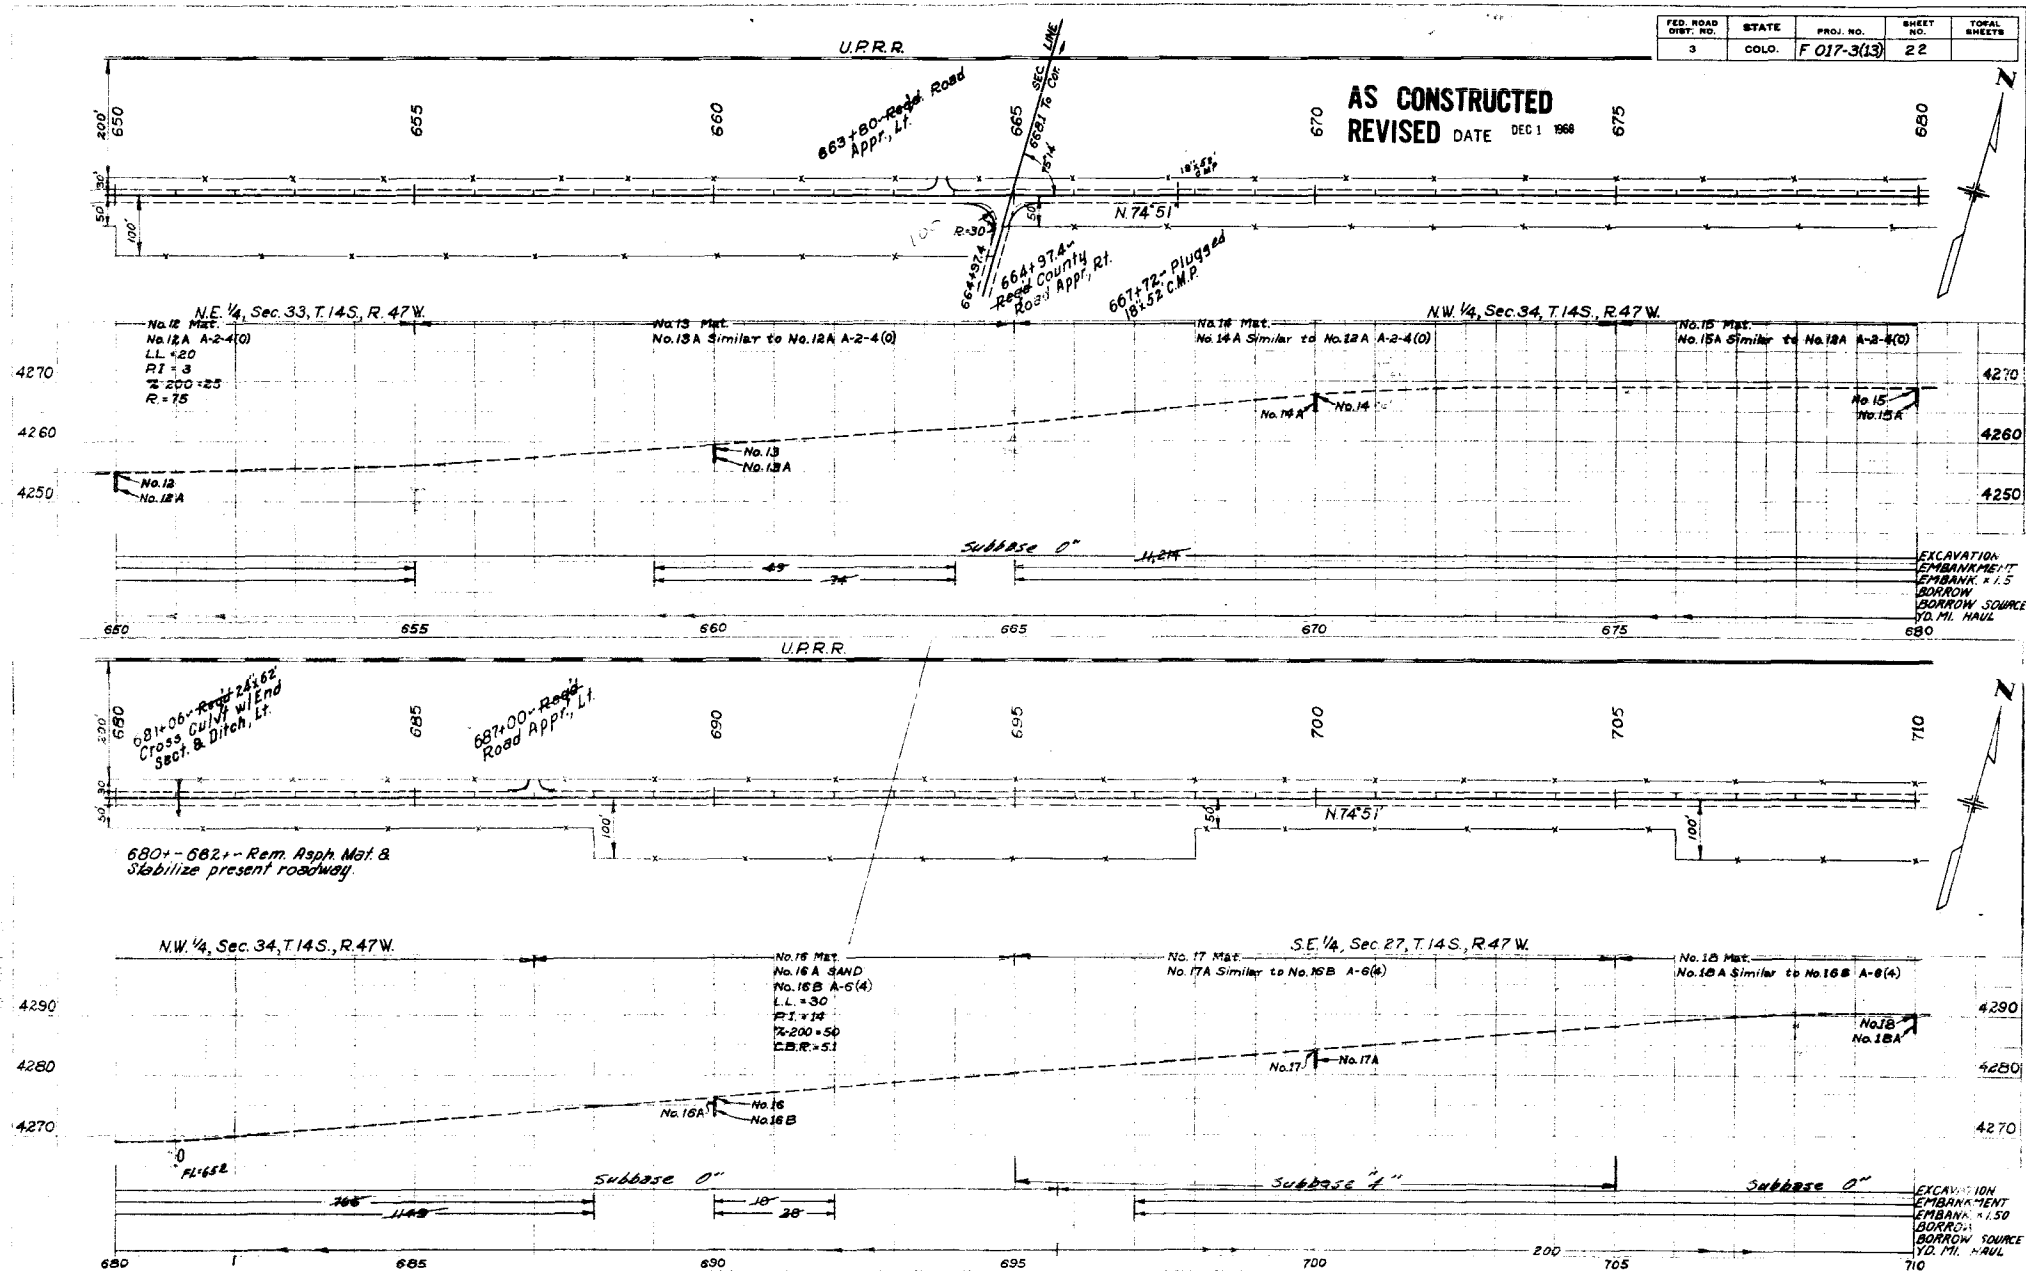

| FED BLDG
DIST NO | STATE | FED AID
PROJ NO | SHEET
NO | TOTAL
SHEETS |
|---------------------|-------|--------------------|-------------|-----------------|
| 3 | CALIF | F 017-363 | 23 | |

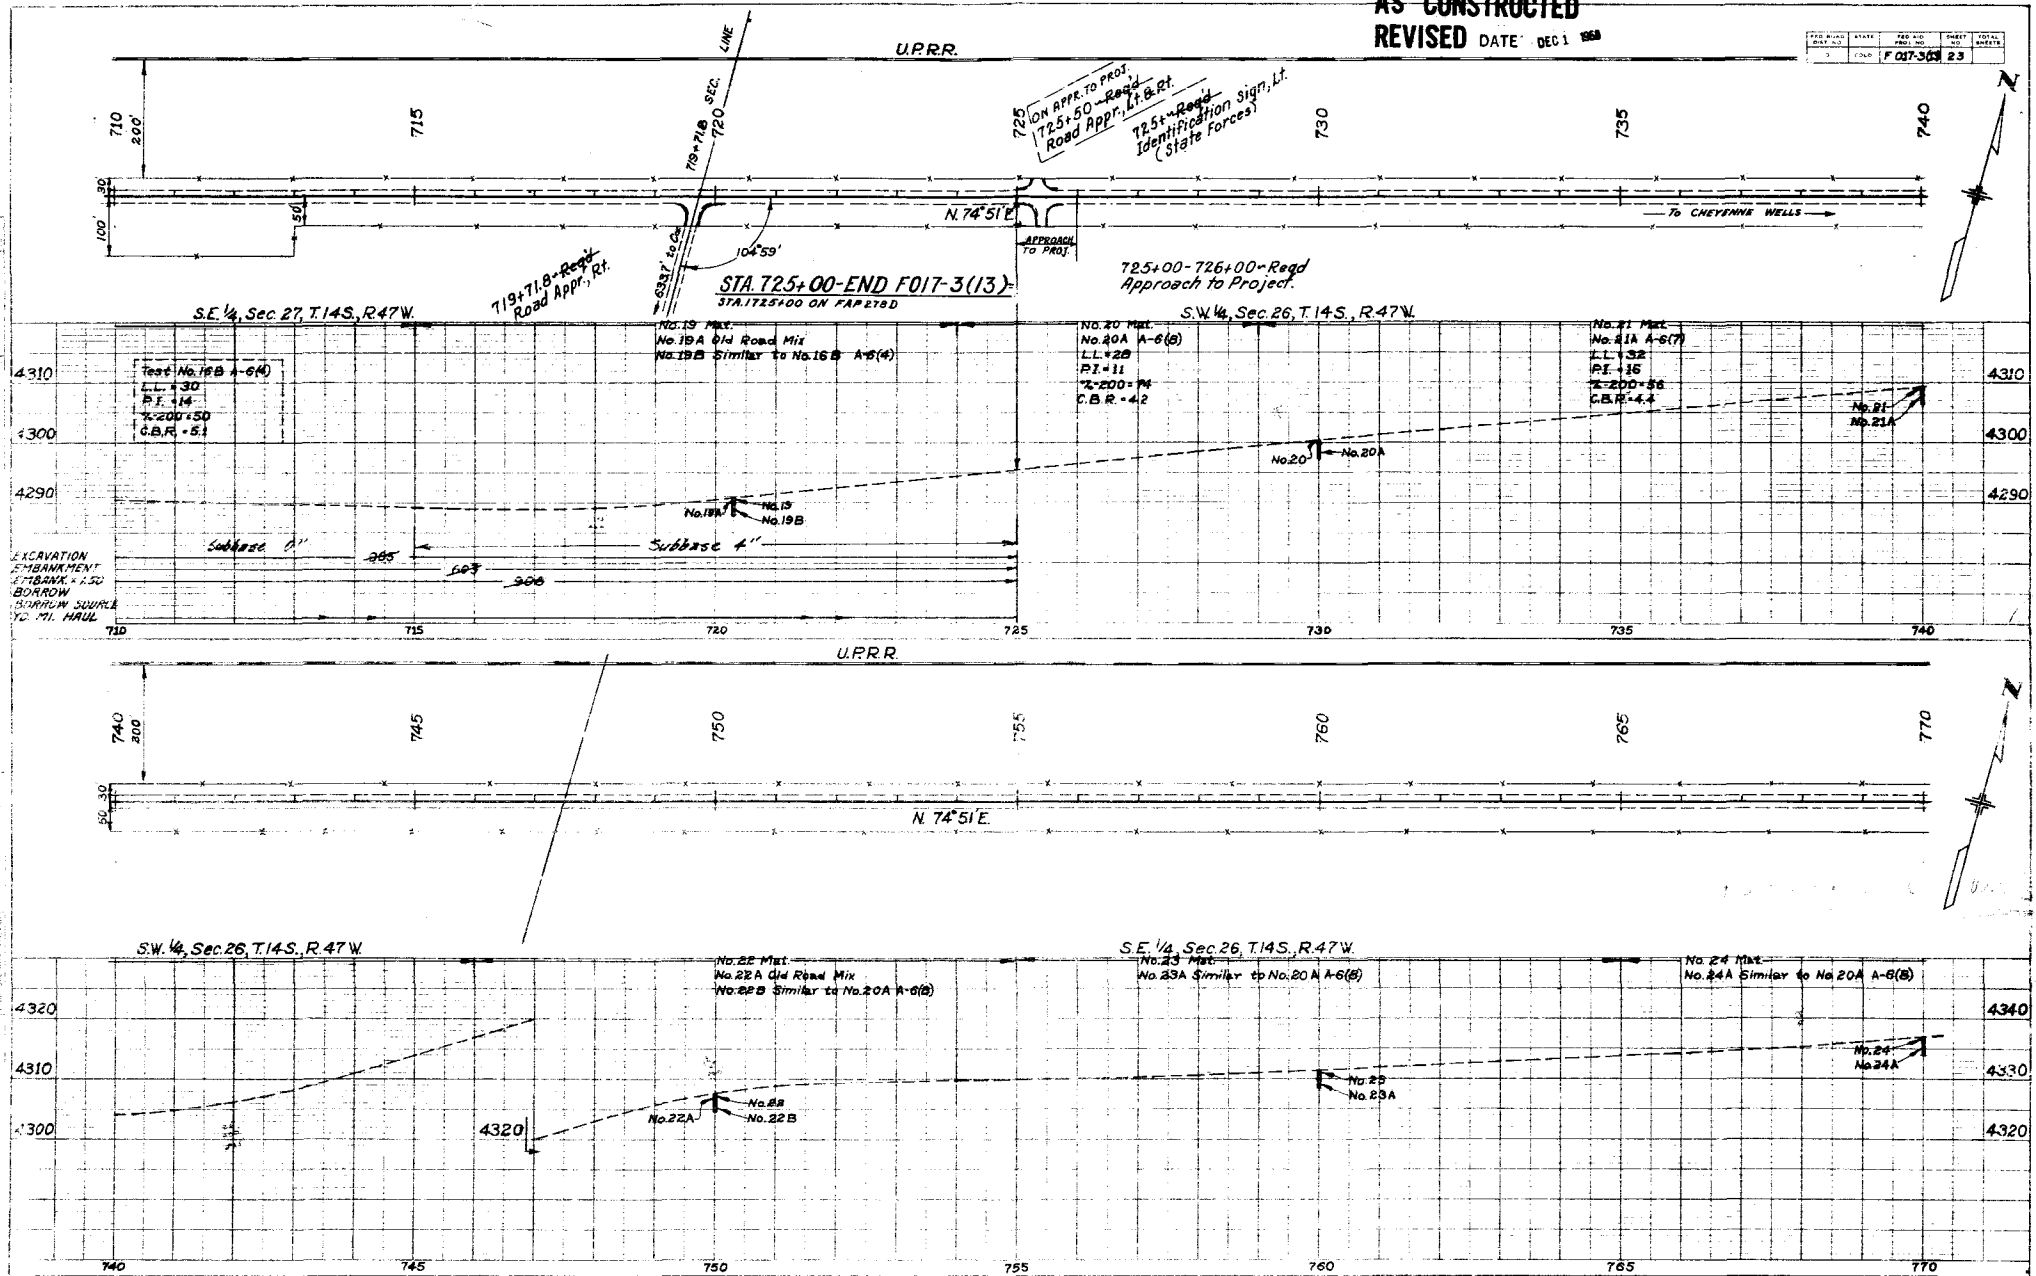


STANDARD SIDE APPROACH ROADS, FLARING, CUT SLOPE TREATMENT & WIDENING AT BRIDGES AND AT CREST OF GRADES

STANDARD M-203-B
(JULY 1, 1965)

| FED. ROAD DIST. NO. | DIVISION | PROJECT NO. | SHEET NO. |
|---------------------|----------|-------------|-----------|
| 1 | COLORADO | | |


GENERAL DETAILS FOR FLARING OF EARTH CUTS, CUT SLOPE TREATMENT & WIDENING AT BRIDGES

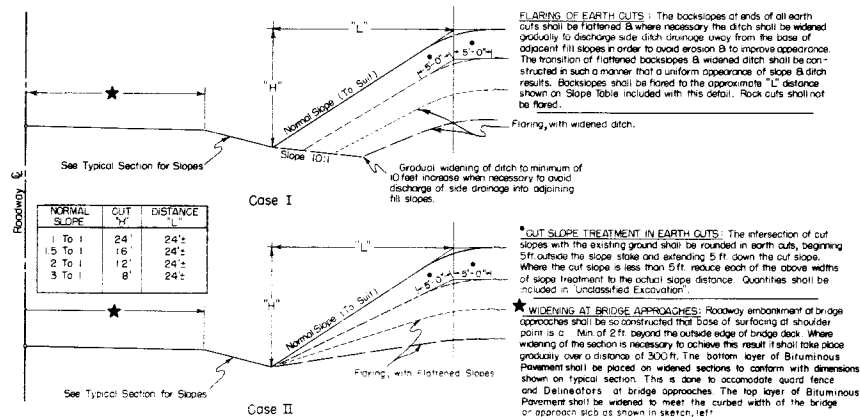


TYPICAL PLANS FOR SIDE APPROACH ROADS

Where practical Side Drains are to be placed in line with the roadway ditches.


50' Radii to be used on all intersecting roads except private approaches. Radii may be varied to suit field conditions.

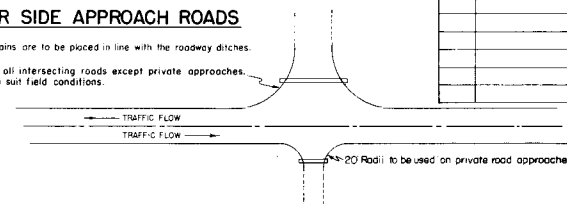

STANDARD CROWNED SECTION

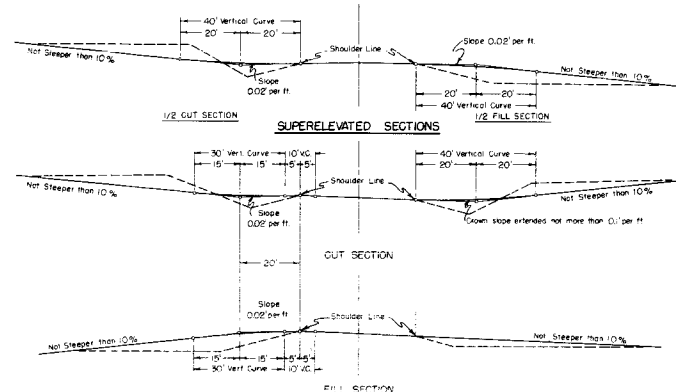


TYPICAL SECTION FOR APPROACH

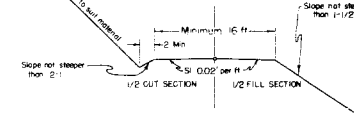

NOTE:
Road Approaches shall conform to the above details unless otherwise indicated on plans. The width of the crowned section shall not be less than the width of the crowned section of the existing approach road and the new construction shall not be less than 16 feet in width.

DETAILS FOR DITCH & WIDENED SHOULDERS AT CREST OF GRADES

(TO BE USED ONLY WHERE SIGHT DISTANCE AT CREST OF GRADE IS 600 FT. OR LESS)

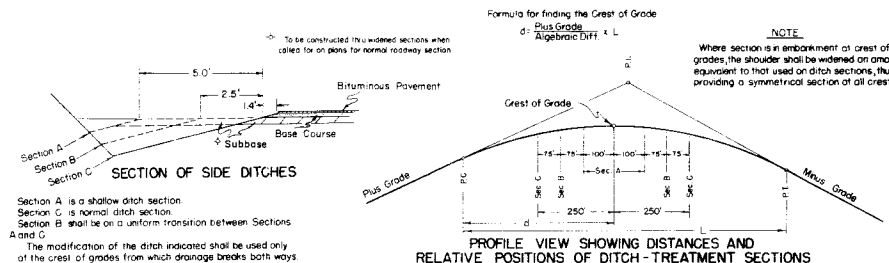

GENERAL NOTES

All work shall be done in accordance with the Standard Specifications applicable to the Project.

All side approach roads to the Project shall be Gravel Surfaced with a 4 inch thickness of Aggregate Base Course extending approximately to the Right of Way Line. Estimated tonnage and class of material required for this operation are shown in the Aggregate Base Course Plan.

The maximum grades shown are to be the limiting grades for all road approaches. Modifications of grades will be permitted where adherence to the grades as shown would cause damage to property or create other unsatisfactory conditions. Grades less than the maximum shown are to be used wherever feasible.

DEPARTMENT OF HIGHWAYS
STATE OF COLORADO

APPROACH ROADS,
FLARING, CUT SLOPE TREATMENT,
BRIDGE & CREST WIDENING

Designed by A. Z.
Made by J. M. B. A. B.
Checked by C. R. S.

Approved by J. E. D. W. A. M.
Staff Design Engr.
Date: 7-1-1965


STANDARD TYPES *of* DITCHES *and* CONSTRUCTION METHODS

STANDARD M-203-C
(JULY 1, 1965)

| FED. ROAD DIST. NO. | DIVISION | PROJECT NO. | SHEET NO. |
|---------------------|----------|-------------|-----------|
| 5. | COLO. | | 15 |

DETAILS *for* CONTOUR INTERCEPTING DITCHES

Typical Section for Contour Intercepting Ditches

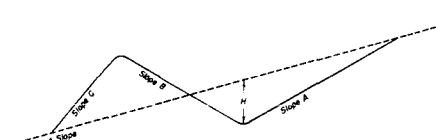

PURPOSE & USE OF THE TABLE
The primary purpose of the information for Contour and Intercepting Ditches shown on this sheet is to serve as a guide in construction and to readily arrive at yardages of excavation involved.
Foremost consideration in constructing these ditches is given first to the natural ground line slope confronted in construction, thence to the other values shown on the Typical Section.
By properly arriving at the combination of values shown on the Typical Section and in the Table for a specified condition, the number of cubic yards of excavation per 100 lin ft. of ditch may be read under the appropriate column for this item.

Typical Construction Layouts


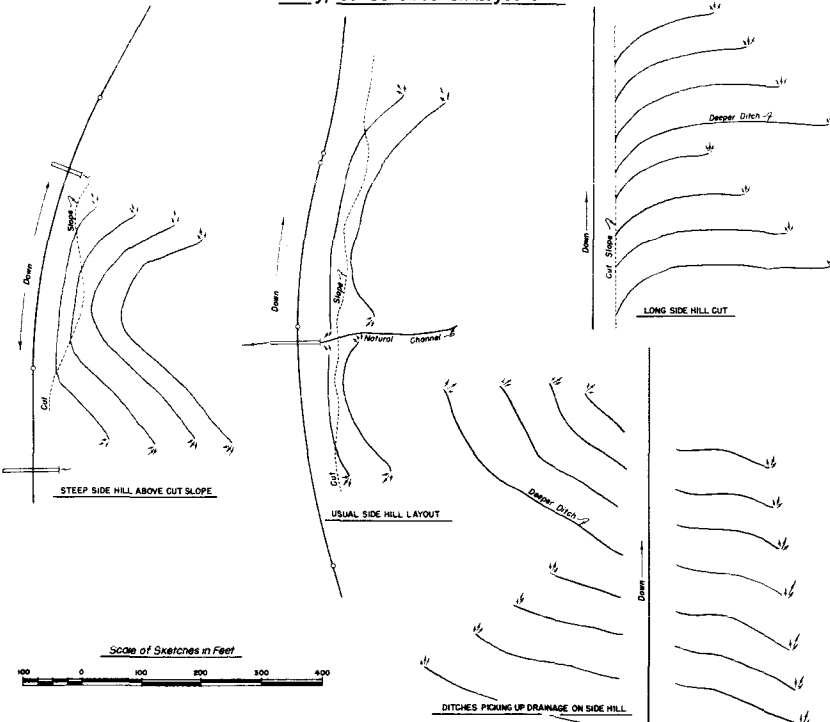


Table of Slopes and Yardages


| ▲ SLOPES | | | | H | Cubic Yards per 100 lin ft. of Ditch |
|-------------------|---------|-----|---------|-----|--------------------------------------|
| Ground | A | B | C | | |
| 5:1
Or Flatter | 2:1 | 4:1 | 2:1 | 15" | 16 |
| | | | | 18" | 23 |
| | | | | 21" | 32 |
| | | | | 15" | 15 |
| | | | | 18" | 22 |
| | | | | 21" | 30 |
| | | | | 15" | 14 |
| | | | | 18" | 20 |
| | | | | 21" | 27 |
| | | | | 15" | 13 |
| | 1-1/2:1 | 4:1 | 1-1/2:1 | 18" | 19 |
| | | | | 21" | 25 |
| | | | | 15" | 12 |
| | | | | 18" | 18 |
| | | | | 21" | 25 |
| | | | | 15" | 12 |
| | | | | 18" | 17 |
| | | | | 21" | 23 |
| | | | | 15" | 10 |
| | | | | 18" | 15 |
| | 2:1 | 4:1 | 2:1 | 21" | 20 |
| | | | | 15" | 10 |
| | | | | 18" | 14 |
| | | | | 21" | 19 |
| | | | | 15" | 17 |
| | | | | 18" | 25 |
| | | | | 21" | 34 |
| | | | | 15" | 17 |
| | | | | 18" | 24 |
| | | | | 21" | 32 |
| | 1-1/2:1 | 4:1 | 1-1/2:1 | 15" | 15 |
| | | | | 18" | 21 |
| | | | | 21" | 29 |
| | | | | 15" | 13 |
| | | | | 18" | 18 |
| | | | | 21" | 25 |
| | | | | 15" | 12 |
| | | | | 18" | 17 |
| | | | | 21" | 23 |
| | | | | 15" | 11 |
| | 2:1 | 4:1 | 2:1 | 18" | 16 |
| | | | | 21" | 21 |
| | | | | 15" | 10 |
| | | | | 18" | 14 |
| | | | | 21" | 20 |
| | | | | 15" | 22 |
| | | | | 18" | 31 |
| | | | | 21" | 43 |
| | | | | 15" | 21 |
| | | | | 18" | 30 |
| | 1-1/2:1 | 4:1 | 1-1/2:1 | 21" | 41 |
| | | | | 15" | 20 |
| | | | | 18" | 29 |
| | | | | 21" | 40 |
| | | | | 15" | 13 |
| | | | | 18" | 19 |
| | | | | 21" | 26 |
| | | | | 15" | 12 |
| | | | | 18" | 17 |
| | | | | 21" | 24 |
| | 2:1 | 4:1 | 2:1 | 15" | 12 |
| | | | | 18" | 17 |
| | | | | 21" | 23 |
| | | | | 15" | 20 |
| | | | | 18" | 29 |
| | | | | 21" | 40 |
| | | | | 15" | 13 |
| | | | | 18" | 19 |
| | | | | 21" | 26 |
| | | | | 15" | 12 |
| | 1-1/2:1 | 4:1 | 1-1/2:1 | 18" | 17 |
| | | | | 21" | 24 |
| | | | | 15" | 12 |
| | | | | 18" | 17 |
| | | | | 21" | 23 |
| | | | | 15" | 20 |
| | | | | 18" | 29 |
| | | | | 21" | 40 |
| | | | | 15" | 13 |
| | | | | 18" | 19 |
| | 2:1 | 4:1 | 2:1 | 21" | 26 |
| | | | | 15" | 12 |
| | | | | 18" | 17 |
| | | | | 21" | 23 |
| | | | | 15" | 20 |
| | | | | 18" | 29 |
| | | | | 21" | 40 |
| | | | | 15" | 13 |
| | | | | 18" | 19 |
| | | | | 21" | 26 |
| | 1-1/2:1 | 4:1 | 1-1/2:1 | 15" | 9 |
| | | | | 18" | 13 |
| | | | | 21" | 17 |
| | | | | 15" | 8 |
| | | | | 18" | 12 |
| | | | | 21" | 16 |
| | | | | 15" | 11 |
| | | | | 18" | 16 |
| | | | | 21" | 21 |
| | | | | 15" | 11 |

▲ Slopes are approximate and may be varied to suit conditions encountered during construction.

TYPICAL SECTIONS *for* DRAINAGE, IRRIGATION DITCHES *and* CHANNEL CHANGES

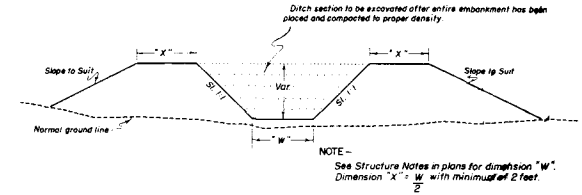

For Embankment Sections
(Generally for use in Irrigation Ditches & Channel Changes)

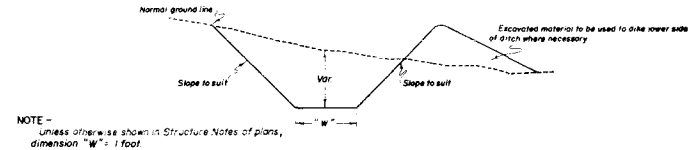

For Cut Sections
NOTE - Unless otherwise shown in Structure Notes of plans, dimension "W" = 1 foot.

GENERAL NOTES


All work shall be done in accordance with the Standard Specifications applicable to the Project.
All ditches are to be constructed to lines and grades as staked by the Engineer using the ditch section shown on plans or as ordered by the Engineer.
CONTOUR INTERCEPTING DITCHES: Ditches are to be laid out along the ground contour on a grade of not over 1% (Type of soil shall govern the grade).
Ends of ditches are to be lined up so that concentration of flow from a higher contour ditch into one of lower contour is, as far as possible avoided. The use of a deeper ditch is recommended where this condition is encountered.
The following horizontal spacing of ditches is recommended:
4% to 6% Approximately 70' Centers
8% to 10% Approximately 60' Centers
20% to 4:1 Slope Approximately 55' Centers
30% to 1-1/2:1 Slope Approximately 50' Centers
Where ditch checks are required the intervening ditch between one set of ditch checks shall not exceed a grade of .10%. Details of checks will be shown on plans when required.

DEPARTMENT OF HIGHWAYS
STATE OF COLORADO

DITCH TYPES



Designed by CGM
Made by CGM
Checked by
Approved by J. C. Chen
Staff Design Eng.
Date: July 1, 1965

CONCRETE BOX CULVERTS & WINGWALLS

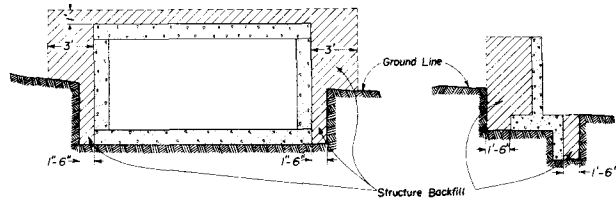

PIERS, ABUTMENTS, RETAINING WALLS ETC.

All material that is to be compacted shall be placed in horizontal layers not more than 6" inches in depth and compacted before the next layer is placed. For Arches, Rigid Frames and Box Culverts the fill shall be brought up uniformly on both sides of the center of structure to avoid stresses in the structure caused by unsymmetrical loading.

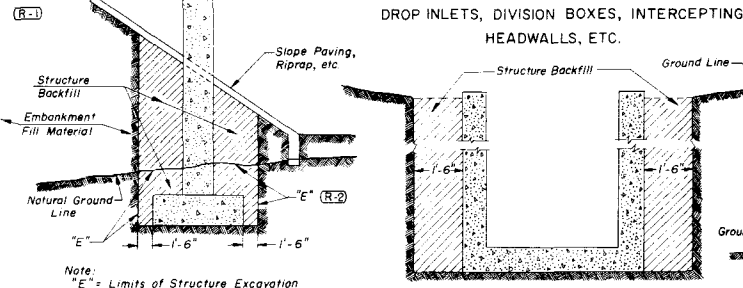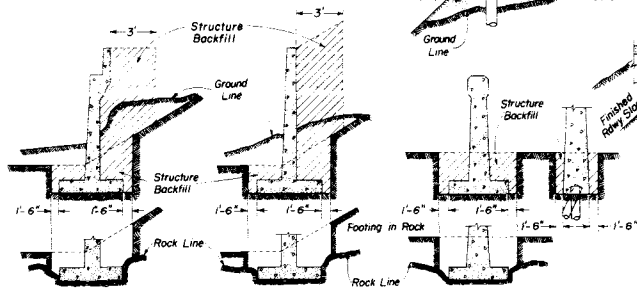


STANDARD M-206-A


(JULY 1, 1965)
(SHEET 1 OF 2 SHEETS)

| FED. ROAD DIST. NO. | DIVISION | PROJECT NO. | SHEET NO. |
|---------------------|----------|---------------------------|-----------|
| 8 | COLO. | | |
| REVISION | | | |
| (R-1) | 10-20-65 | ADDED PIER VIEW | M.R.H. |
| (R-2) | 12-7-66 | STR. EXCV. | M.R.H. |
| (R-3) | 4-25-66 | Class 2 Backfill (Trench) | M.R.H. |
| (R-4) | 3-17-67 | Conduit, Underdrn, Box | M.R.H. |


CIRCULAR CONDUIT

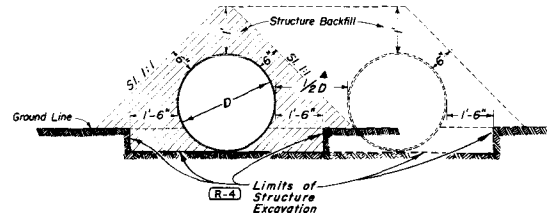

SIPHONS OR CONDUIT IN TRENCH

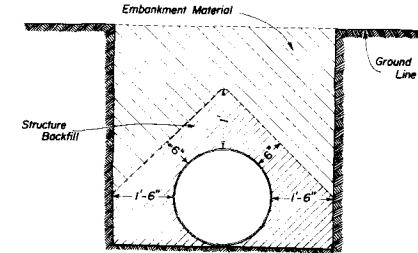

ELLIPTICAL OR ARCH CONDUIT

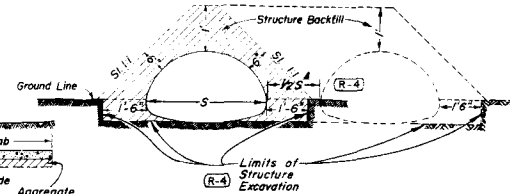

(R-4) NOTES:

When two or more conduits are laid side by side they shall be spaced so that adjacent sides of pipe shall be $\frac{1}{2}$ the Diameter or Span or 3 feet apart whichever is less. Minimum spacing shall not be less than 1 foot. For additional culvert installation details see M Standards for metal, concrete, or structural plate pipe culverts.

(R-4)

GENERAL NOTES

All work shall be done according to the Standard Specifications applicable to the Project.



Where the roadway cross section is in fill, excavation for concrete footings (except those in rock or those on piles) and for box culverts shall be done according to the following:

Embankment shall be built up and compacted to a point one foot above the flowline of the box or the top of the footing. The trench shall then be excavated to accommodate construction of the box or footing.

Excavation and backfill patterns different from those indicated on these sheets will be shown elsewhere on the plans.

(R-4) Excavation for structure installation shall be classified as "Structure Excavation" unless otherwise shown on plans.

HEADWALLS AND END OF CULVERTS

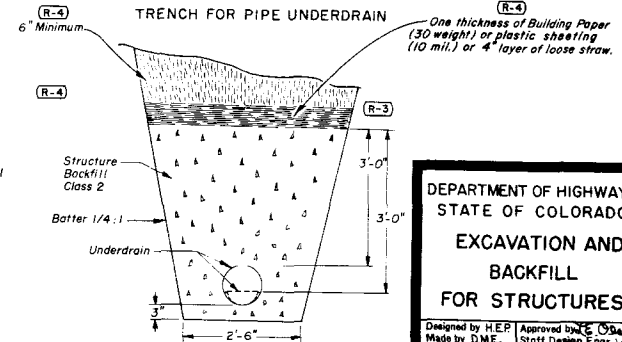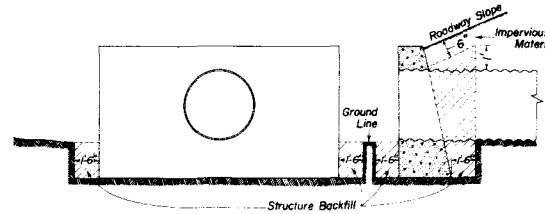

DEPARTMENT OF HIGHWAYS
STATE OF COLORADO
EXCAVATION AND
BACKFILL
FOR STRUCTURES

Designed by HEP Approved by D.W.E.
Made by D.W.E. Staff Design Eng.
Checked by L.E.O. Date: July 1, 1965


STANDARD M-206-A

(SHEET 2)
(JULY 1, 1965)


| FEDERAL ROAD REGION NO. | DISTRICT | PROJ. NO. | SHEET NO. | TOTAL SHEETS |
|-------------------------|----------|-----------|-----------|--------------|
| # | COLORADO | | | |

| REVISIONS: | |
|------------|---|
| (R-1) | 3-17-67 I. D. on Pipe Culvert Spdn or O. M. R. H. |
| | |
| | |
| | |
| | |


STRUCTURE EXCAVATION MEASUREMENT FOR PIPE CULVERTS

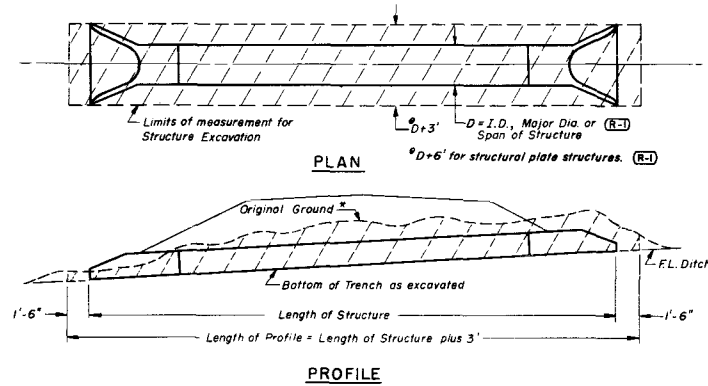


STRUCTURE EXCAVATION MEASUREMENT FOR DIVERSION OR DIVISION BOXES

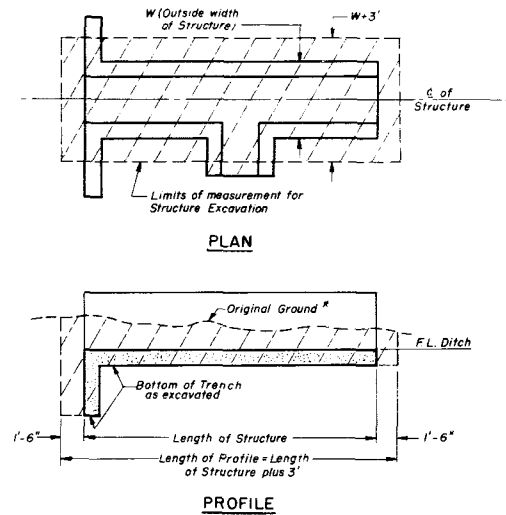


STRUCTURE EXCAVATION MEASUREMENT FOR CONCRETE BOX CULVERTS

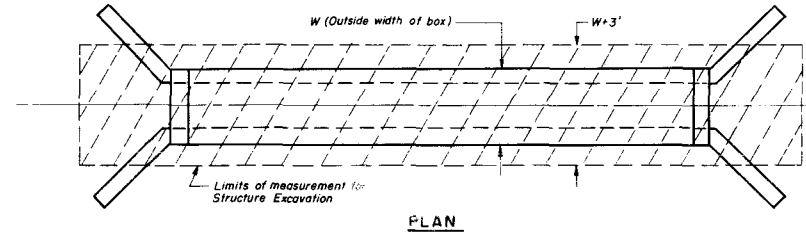

Without Channel Change or Channel Improvement

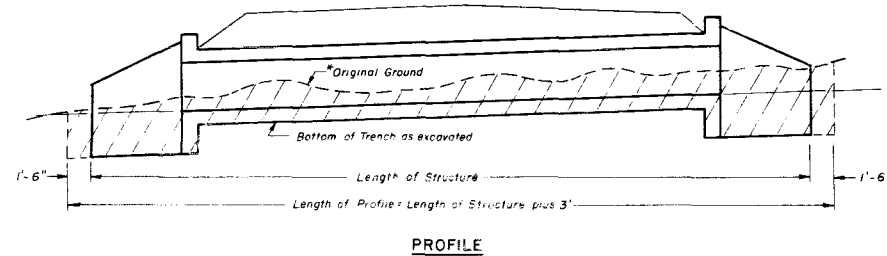

With Channel Change or Channel Improvement

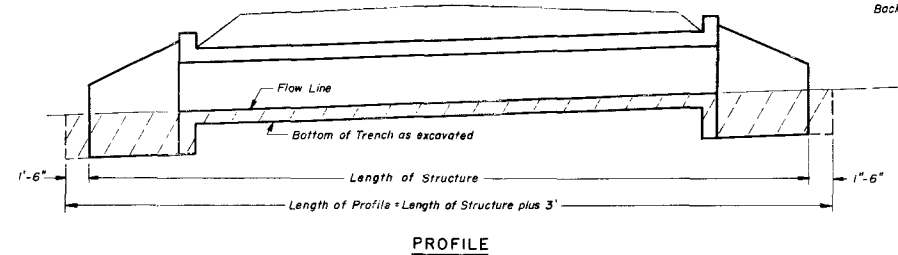

NOTE:
See Sheet 1 for General Notes and Backfilling Details.


* Along C. of Structure

Areas to be used for Structure Excavation computations.

DEPARTMENT OF HIGHWAYS
STATE OF COLORADO


EXCAVATION AND
BACKFILL
FOR STRUCTURES

Designed by: M.R.H. | Approved by: *[Signature]*
Made by: H.P.B. | Staff Design Eng.
Checked by: | Date: July 1, 1965

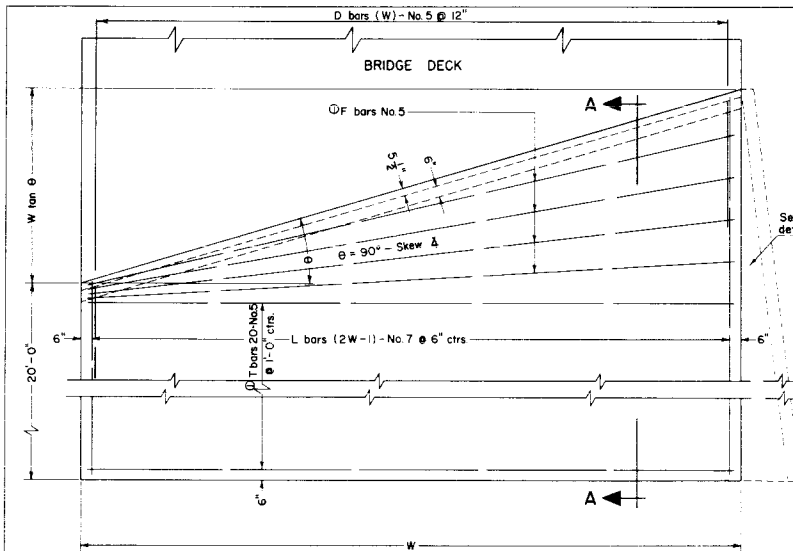

① Note: One T or F bar to be placed near top of slab at each end of D bars.

APPROACH SLAB - PLAN

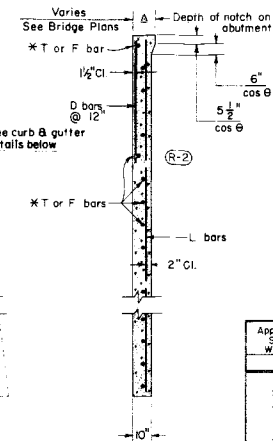

SECTION A-A

* Includes 2 T or F bars placed in top of slab as shown.

STANDARD M-412-B


(JULY 1, 1965)

| FEDERAL ROAD SECTION NO. | DISTRICT | PROJ. NO. | SHEET NO. | TOTAL SHEETS |
|--------------------------|----------|-----------|-----------|--------------|
| 9 | COLORADO | | | |

Quantity of Compression Joint Sealer Material for one Approach Slab

SAFETY CURB

$\frac{W+1}{\cos \theta} + 2' = \text{--- LINEAR FEET}$

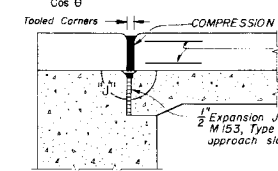

BRUSH CURB

$\frac{W}{\cos \theta} + 1' = \text{--- LINEAR FEET}$

2- No. 5 dowels x 2'-0" (incl. in unit price bid for curb)

$$\frac{AW}{\cos \theta} + d = \frac{167W}{\cos \theta} = \text{--- ft}^2 \text{ Expansion Joint Material}$$

DETAIL AT BRIDGE ABUTMENT


EXPANSION JOINT MATERIAL

(R-2) Bar List and Quantities required for one Approach Slab

| Approach Slab Width | T No. 5, Str. | D No. 5, Str. | L No. 7, Str. | F No. 5, Str. | Reinforcing Steel (Lbs.) | | | Additional Steel for Skew (Lbs.) | | Concrete Pavement (Sq Yds.) | | | |
|---------------------|---------------|---------------|---------------|---------------|--------------------------|----------|--------|----------------------------------|-------|-----------------------------|------------|------------|---------------------|
| W | No. | Length | No. | Length | No. | Length | T Bar | D Bar | L Bar | F Bar | L Bar | | |
| 20 | 20 | 19'-6" | 20 | 5'-0" | 39 | 10 tan @ | 19'-6" | 411 | 105 | 1570 | 205 tan @ | 765 tan @ | 44.4 + 22.2 tan @ |
| 22 | 22 | 21'-6" | 22 | 5'-0" | 43 | 11 tan @ | 21'-6" | 452 | 116 | 1731 | 249 tan @ | 932 tan @ | 48.9 + 26.9 tan @ |
| 24 | 24 | 23'-6" | 24 | 5'-0" | 47 | 12 tan @ | 23'-6" | 494 | 126 | 1892 | 297 tan @ | 1116 tan @ | 53.3 + 32.0 tan @ |
| 26 | 26 | 25'-6" | 26 | 5'-0" | 51 | 13 tan @ | 25'-6" | 537 | 137 | 2053 | 349 tan @ | 1316 tan @ | 57.8 + 37.6 tan @ |
| 28 | 28 | 27'-6" | 28 | 5'-0" | 55 | 14 tan @ | 27'-6" | 580 | 147 | 2214 | 406 tan @ | 1533 tan @ | 62.2 + 43.6 tan @ |
| 30 | 30 | 29'-6" | 30 | 5'-0" | 59 | 15 tan @ | 29'-6" | 621 | 158 | 2375 | 466 tan @ | 1766 tan @ | 66.7 + 50.0 tan @ |
| 32 | 32 | 31'-6" | 32 | 5'-0" | 63 | 16 tan @ | 31'-6" | 663 | 169 | 2536 | 531 tan @ | 2006 tan @ | 71.1 + 56.9 tan @ |
| 34 | 34 | 33'-6" | 34 | 5'-0" | 67 | 17 tan @ | 33'-6" | 706 | 179 | 2697 | 600 tan @ | 2247 tan @ | 75.6 + 64.2 tan @ |
| 36 | 36 | 35'-6" | 36 | 5'-0" | 71 | 18 tan @ | 35'-6" | 748 | 190 | 2858 | 673 tan @ | 2564 tan @ | 80.0 + 72.0 tan @ |
| 38 | 38 | 37'-6" | 38 | 5'-0" | 75 | 19 tan @ | 37'-6" | 790 | 200 | 3019 | 751 tan @ | 2884 tan @ | 84.4 + 80.6 tan @ |
| 40 | 40 | 39'-6" | 40 | 5'-0" | 79 | 20 tan @ | 39'-6" | 832 | 211 | 3180 | 833 tan @ | 3204 tan @ | 88.9 + 89.9 tan @ |
| 42 | 42 | 41'-6" | 42 | 5'-0" | 83 | 21 tan @ | 41'-6" | 874 | 222 | 3341 | 918 tan @ | 3513 tan @ | 93.3 + 98.0 tan @ |
| 44 | 44 | 43'-6" | 44 | 5'-0" | 87 | 22 tan @ | 43'-6" | 916 | 232 | 3502 | 1008 tan @ | 3862 tan @ | 97.8 + 107.6 tan @ |
| 46 | 46 | 45'-6" | 46 | 5'-0" | 91 | 23 tan @ | 45'-6" | 958 | 242 | 3663 | 1102 tan @ | 4227 tan @ | 102.2 + 117.6 tan @ |
| 48 | 48 | 47'-6" | 48 | 5'-0" | 95 | 24 tan @ | 47'-6" | 1001 | 253 | 3824 | 1201 tan @ | 4609 tan @ | 106.7 + 128.0 tan @ |
| 50 | 50 | 49'-6" | 50 | 5'-0" | 99 | 25 tan @ | 49'-6" | 1043 | 263 | 3985 | 1304 tan @ | 5007 tan @ | 111.1 + 138.9 tan @ |
| 52 | 52 | 51'-6" | 52 | 5'-0" | 103 | 26 tan @ | 51'-6" | 1084 | 274 | 4146 | 1411 tan @ | 5422 tan @ | 115.6 + 150.2 tan @ |
| 54 | 54 | 53'-6" | 54 | 5'-0" | 107 | 27 tan @ | 53'-6" | 1127 | 284 | 4307 | 1522 tan @ | 5854 tan @ | 120.0 + 162.0 tan @ |

19'-6" by 16" tan @ 19'-6" + (W-1) tan @


(R-4) Lengths shown include 1 percent for overrun.

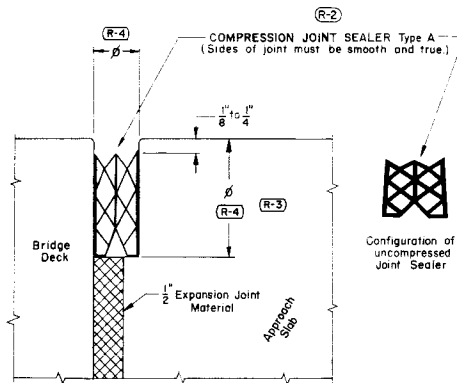




(R-4) Dimension of groove to be proportionate with compression joint sealer supplied.

DETAIL "J"


Width to match curb and gutter for roadway (Max. 2'-6")

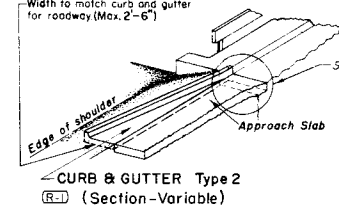




PROFILE

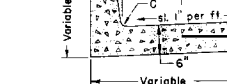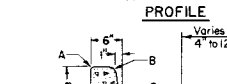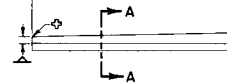


SECTION A-A

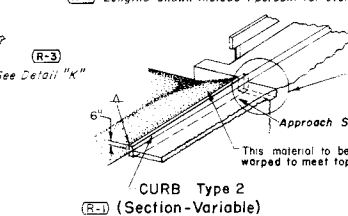


PROFILE

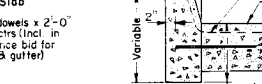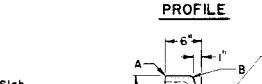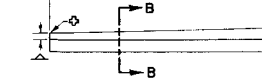

SECTION B-B

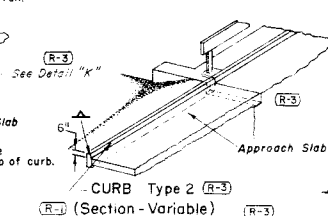

PROFILE

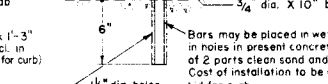

SECTION C-C

GENERAL NOTES

Concrete for Approach slabs shall be Class "P" (R-1)
 Approach slab shall be paid for under Section 412 as Concrete Pavement of the specified thickness.
 Reinforcing Steel required in Approach Slab will be paid for under Section 602.
 Class "A" concrete aggregate may be used in the pavement.

6" min. curb height when no curb is used on abutting roadway (R-1)
 4" where Bituminous Curb is used (Shape bituminous curb to meet concrete curb.)
 6" to meet concrete Curb or Curb and Gutter (R-1)
 Use 1/2 R when no bituminous or concrete curb is to be met. No radius required when meeting bituminous or concrete curb.

| LEGEND FOR RADII | |
|------------------|----------|
| A | = 1/8" |
| B | = 1" |
| C | = 1 1/2" |

DESIGNED BY J. G. G. Bridge Engineer
 MADE BY R. F. Bridge Engineer
 CHECKED BY P. C. Bridge Engineer
 DATE: JULY 1, 1965

DEPARTMENT OF HIGHWAYS
 STATE OF COLORADO
 CONCRETE PAVEMENT
 BRIDGE APPROACH
 SLAB

STANDARD M-500-A


(JULY 1, 1965)

| FED. ROAD
DIST. NO. | DIVISION | PROJECT NO. | SHEET
NO. |
|------------------------|----------|-------------|--------------|
| 1 | COLO. | | |




abcdefghijklmnopqrstuvwxyz


White Background

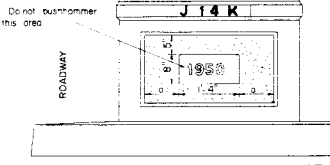


TYPICAL FOR CONCRETE END POST

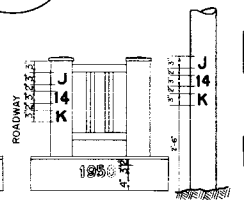


TYPICAL FOR STEEL HANDRAIL END POST

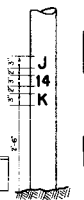

TYPICAL FOR SIGN POSTS

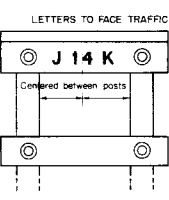

TYPICAL FOR TIMBER WING HANDRAIL

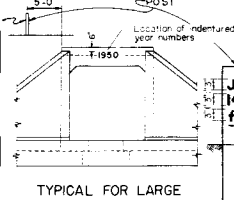

TYPICAL FOR LARGE BOX CULVERTS & STRUCTURES WITHOUT END POSTS

SAMPLE BRIDGE NUMBER

GENERAL NOTES

SAMPLE YEAR NUMBER

ALL WORK SHALL BE DONE IN ACCORDANCE WITH THE STANDARD SPECIFICATIONS APPLICABLE TO THE PROJECT. THE SIZE, SHAPE AND SPACING OF THE LETTERS AND FIGURES SHALL BE IN ACCORDANCE WITH THE FULL SIZE SHOWN ON THIS SHEET. ADDITIONAL COPIES OF THIS FULL SIZE SHEET CAN BE OBTAINED FROM THE DEPARTMENT WITHOUT CHARGE.

THE YEAR NUMBERS ARE RECESSED IN CONCRETE TO THE MINIMUM AS SHOWN INTO THE HAVEL OF THE ENDPOST ON THE RIGHT HAND SIDE OF EACH BRIDGE END AND INTO THE FACE OF THE CONCRETE HANDRAIL OF CULVERTS AS SHOWN ON PLAN DETAILS. NUMBERS TO BE MADE OF WOOD, METAL OR OTHER SUITABLE MATERIAL AND ATTACHED TO THE FORMS BEFORE CONCRETE IS POURED. THE YEAR NUMBER OF EACH STRUCTURE SHALL CORRESPOND WITH THE YEAR IN WHICH THE CONCRETE IS POURED.

THE STRUCTURE NUMBER SHALL BE STENCILED ON THE RIGHT HAND SIDE OF EACH BRIDGE END AS SHOWN ON THIS STANDARD AND AS SPECIFIED WHERE THE STRUCTURE HAS NO END POSTS. THE NUMBER SHALL BE PLACED ON A POST ON THE RIGHT HAND SIDE OF THE ROAD AS SHOWN. FOR SIGNS THE NUMBER SHALL BE PLACED ON SIGN POSTS ON THE RIGHT HAND SIDE OF THE ROADWAY.

THE CORRECT NUMBER FOR EACH BRIDGE OR SIGN IS SHOWN ON THE PLANS.

THE NUMBERS FOR MAJOR STRUCTURES OF OVER 20 FEET CLEAR SPAN SHALL BE UPPER CASE LETTERS. THE NUMBERS FOR MINOR STRUCTURES OF 12 TO 20 FEET CLEAR SPAN SHALL BE LOWER CASE LETTERS. LETTERS AND NUMBERS SHALL BE CONSIDERED AS MAJOR STRUCTURES.

2 PROPER WHITE BACKGROUND RECTANGULAR IN SHAPE AND EXTENDING THREE INCHES BEYOND THE LIMITS OF THE NUMBER SHALL BE PAINTED WITH TWO COATS OF ACCEPTABLE WHITE PAINT UNLESS AN APPROVED WHITE CONCRETE PAINT IS USED. BEFORE PAINTING THE SURFACE MUST BE THOROUGHLY CLEANED AND PROPERLY SIZED OR TAMPED HANDRAILS. THE WHITE PAINT USED ON THE BRIDGE WILL BE SATISFACTORY.

AFTER THE WHITE BACKGROUND HAS DRIED SUFFICIENTLY, THE CORRECT STRUCTURE NUMBER SHALL BE CAREFULLY STENCILED WITH "EXTERIOR BLACK PAINT" FILLED IN BY HAND TO MAKE SOLID FIGURES.

THE COST OF PAINTING OF STRUCTURE NUMBERS AND PLACING POSTS FOR STRUCTURE NUMBERS SHALL BE CONSIDERED SUBSIDIARY WORK AND SHALL BE INCLUDED IN THE ORIGINAL CONTRACT ITEMS AND WILL NOT PAID FOR AS SEPARATE ITEMS.

THE LENGTH OF SPAN OF STRUCTURE SHALL BE MEASURED ALONG CENTER LINE OF ROADWAY. IN CASE OF DOUBLE OR MULTIPLE BOX CULVERTS THE CENTER WALL OR WALLS SHALL BE DISREGARDED AND CLEAR SPAN MEASURED FROM INSIDE OF END WALLS.

IN ADDITION TO THE REQUIREMENTS STATED ABOVE, STRUCTURE NUMBERS FOR HIGHWAYS PASSING UNDER CROSSROADS ARE TO BE PLACED AT THE FOLLOWING POINTS:

1. FOR STRUCTURES OF 3 OR MORE SPANS, THE STRUCTURE NUMBER SHALL BE STENCILED, FACING TRAFFIC, ON THE OUTSIDE FACE OF THE END COLUMN OF THE RIGHT-HAND PIER.

2. FOR 2-SPAN STRUCTURES, THE STRUCTURE NUMBER SHALL BE STENCILED, FACING TRAFFIC, ON THE OUTSIDE FACE OF EACH END COLUMN IN THE CENTER PIER.

| REVISIONS | |
|-----------|--|
| | |
| | |
| | |
| | |

**DEPARTMENT OF HIGHWAYS
STATE OF COLORADO**

**LETTERS AND FIGURES
FOR
STRUCTURE NUMBERS**

| | |
|--------------------------------------|--|
| Designed by
Made by
Checked by | Approved by <i>E. H. Hartsell</i>
Bridge Engineer
Date: July 1, 1965 |
|--------------------------------------|--|



 


Table of Dimensions and Quantities

| Type E | | | | Both Types | | | | Type F | | | |
|--------|--------|------------------------------|--------|------------|--|--|--|-----------------------------------|----|--------|-----|
| D | T | Concrete
in Two Headwalls | W | H | | | | Mortar Rubber
in Two Headwalls | T | D | |
| 15" | 1'-6" | 2.4 | 7'-6" | 3'-9" | | | | 3.1 | CU | 2'-0" | 15" |
| 18" | 1'-7" | 3.0 | 8'-6" | 4'-0" | | | | 3.8 | DO | 2'-1" | 18" |
| 24" | 1'-10" | 4.4 | 10'-6" | 4'-6" | | | | 5.5 | DO | 2'-4" | 24" |
| 30" | 2'-0" | 6.1 | 12'-9" | 5'-0" | | | | 7.5 | DO | 2'-6" | 30" |
| 36" | 2'-2" | 8.1 | 15'-0" | 5'-6" | | | | 10.0 | DO | 2'-8" | 36" |
| 42" | 2'-5" | 10.8 | 17'-3" | 6'-0" | | | | 12.8 | DO | 2'-10" | 42" |
| 48" | 2'-7" | 13.6 | 19'-6" | 6'-6" | | | | 16.3 | DO | 3'-0" | 48" |


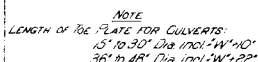


Splices to be the lap riveted type

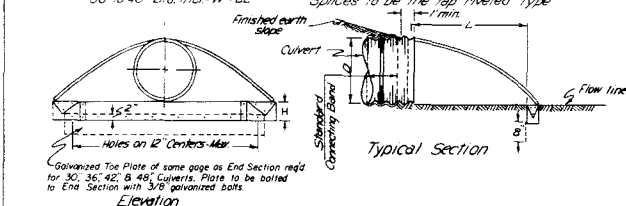

STANDARD END SECTIONS FOR ROUND ANNULAR OR HELICALLY CORRUGATED STEEL PIPE CULVERTS


ALTERNATE CONNECTIONS

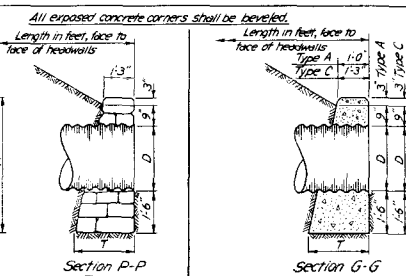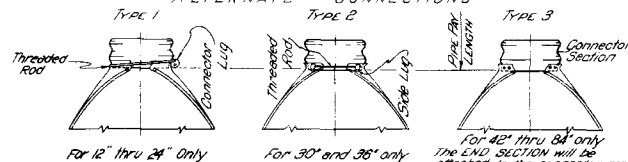


STANDARD HEADWALLS FOR SINGLE CORRUGATED STEEL PIPE CULVERTS

Table of Dimensions and Quantities

| Type A | | | Both Types | | | Type C | | | |
|-----------|-------|--------------------------------|------------|-------|--|--------|---------------|--------|-----------|
| D
Diam | T | % Concrete
in two Headwalls | W | H | | Mortar | Rebar Meshing | T | D
Diam |
| 15" | 1-6 | 1.8 Cu.Yds | 5'-3" | 3'-9" | | 2-2 | Cu.Yds. | 2'-0" | 15" |
| 18" | 1-7 | 2.2 DO | 6'-0" | 4'-0" | | 2.8 | DO | 2'-1" | 18" |
| 24" | 1-10 | 3.3 DO | 7'-6" | 4'-6" | | 4.1 | DO | 2'-4" | 24" |
| 30" | 2'-0" | 4.5 DO | 9'-0" | 5'-0" | | 5.6 | DO | 2'-6" | 30" |
| 36" | 2'-2" | 6.0 DO | 10'-6" | 5'-6" | | 7.4 | DO | 2'-8" | 36" |
| 42" | 2'-5" | 8.0 DO | 12'-0" | 6'-0" | | 9.2 | DO | 2'-10" | 42" |
| 48" | 2'-7" | 10.0 DO | 13'-6" | 6'-6" | | 11.5 | DO | 3'-0" | 48" |

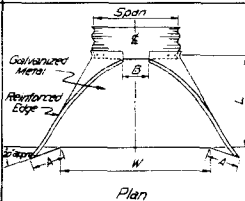


Note: Length of Toe Plate for Pipe-Arch Culverts
with rise of 11" to 27" incl. = $W + 10$ "
31" to 44" incl. = $W + 18$ "

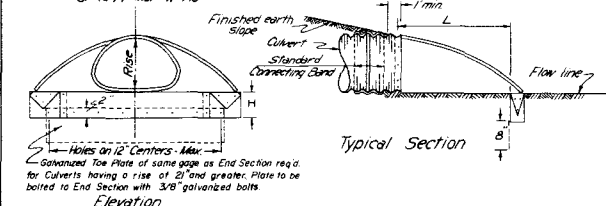

STANDARD END SECTIONS FOR CORRUGATED STEEL PIPE ARCH CULVERTS


ALTERNATE CONNECTIONS

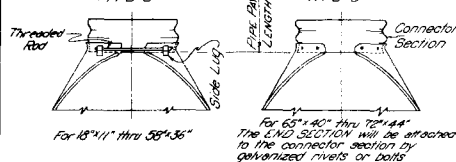

(JULY 1, 1965)

| FEDERAL ROAD
REG. NO. | DIVISION | PROJECT NO. | SHEET
NO. |
|--------------------------|----------|-------------|--------------|
| 9 | COLORADO | | |


| REVISIONS | |
|-----------|--|
| | |
| | |
| | |

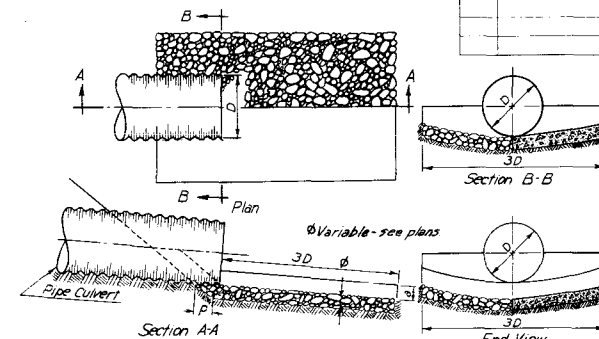

CONCRETE OR GROUTED RUBBLE APRON FOR PIPE CULVERT

Square Yards of Slope and Ditch Paving

| Fill
Slope | D | 15" | 18" | 24" | 30" | 36" | 42" | 48" | 54" | 60" | 66" | 72" | 78" | 84" |
|---------------|-------|-----|-----|-----|-----|-----|-----|-----|-----|-----|-----|-----|-----|-----|
| 1/2-1 | 2'-0" | 3 | 4 | 6 | 9 | 12 | 17 | 21 | 27 | 33 | 39 | 46 | 54 | 62 |
| 2-1 | 2'-0" | 3 | 4 | 7 | 10 | 13 | 18 | 22 | 28 | 34 | 41 | 49 | 57 | 66 |
| 3-1 | 3'-0" | 3 | 4 | 7 | 11 | 15 | 20 | 25 | 31 | 38 | 45 | 54 | 63 | 72 |
| 4-1 | 4'-0" | 3 | 4 | 8 | 12 | 16 | 22 | 28 | 34 | 42 | 50 | 59 | 69 | 79 |

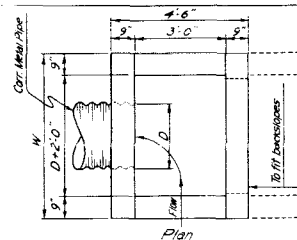


Quantities of *Concrete
or Cement Rubble Masonry

| Size of Pipe | Width of Wall | Height of Wall | Quantities in One Headwall |
|--------------|---------------|----------------|----------------------------|
| D | W | H | Cu. Yds. |
| 15" | 4'-9" | 3'-9" | 1.48 |
| 18" | 5'-0" | 4'-0" | 1.64 |
| 24" | 5'-6" | 4'-6" | 1.99 |
| 30" | 6'-0" | 5'-0" | 2.34 |
| 36" | 5'-6" | 5'-6" | 2.72 |

Note: Backfill to be eliminated and end walls connected to back slope where ordered by the Engineer. Floor slab is to be extended with side walls if in common material and is to be omitted when inlet is in rock. Actual quantities involved in such operation shall be allowed and paid for.

* See plan sheets for concrete classification

INTERCEPTING HEADWALLS

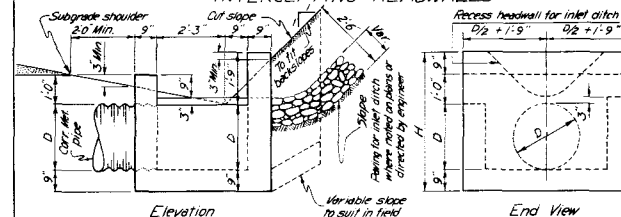

General Notes for All Structures
All work shall be done according to the Standard Specifications
applicable to the Project

All construction joints shall be thoroughly cleaned before fresh concrete is poured.

When culvert is skewed, headwalls shall be placed parallel to E of roadway.

DEPARTMENT OF HIGHWAYS
STATE OF COLORADO

HEADWALLS AND END SECTIONS FOR C.S.P. CULVERTS

| | |
|----------------------------|----------------------------|
| Designed by <i>PSB-GHD</i> | Approved by <i>PSB-GHD</i> |
| Made by <i>HGR</i> | Staff Design Engr. |
| Checked by <i>M.W.M.</i> | Date: July 1, 1965 |

[illegible]

TABLE I
CORRUGATED STEEL PIPE (2" x 1/2") OR (2-2/3" x 1/2") CORRUGATIONS

TABLE II
CORRUGATED STEEL PIPE ARCH
(2"x1/2") OR (2-2/3"x1/2") CORRUGATIONS

L_2 = Length of pipe to be measured when placed in accordance with Section 603.

TABLE IV
CORRUGATED STEEL PIPE 3" x 1" CORRUGATIONS
SPOT WELDED OR BOLTED (WELDED OR BOLTED) FABRICATION

TABLE V
CORRUGATED STEEL PIPE ARCH 3" x 1"

NOTE: Spacing for multiple pipe installations shall conform to the details shown on M Standard for Excavation and Backfill for Structures.

TABLE VII
CORRUGATED ALUMINUM PIPE ARCH
2-2/3" x 1/2" CORRUGATIONS

Variations from corner radii shown will be acceptable provided the pipe is of sufficient strength to support its designated fill height. (Tables II, V, and VII)

STANDARD M-606-AA


(MAY 26, 1967)
(SHEET 1 OF 3)

| FEDERAL ROAD REGION NO. | DISTRICT | PROJ. NO. | SHEET NO. | TOTAL SHEETS |
|-------------------------|----------|-----------|-----------|--------------|
| 9 | COLORADO | | | |

| REVISIONS | | | |
|-----------|---------|---------------------------------|--------|
| (R-1) | 6-26-67 | Added rail for 2-lane bridges | M.R.H. |
| (R-2) | 8-1-67 | Guard Rail of Bridges, Post Sp. | R.S.M. |


8" for all wood blocks and posts

See Sheet No. 3, "Typical Post Locations" for these dimensions.

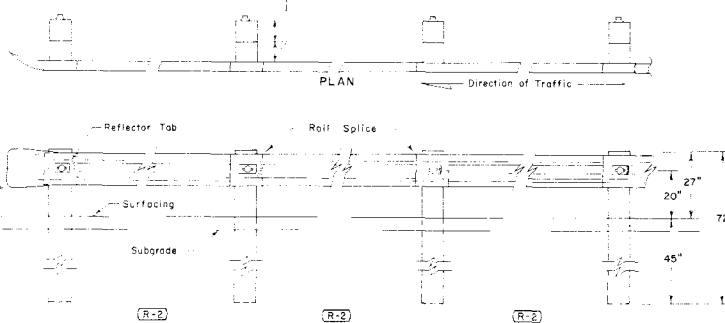


TYPICAL GUARD RAIL FOR ROADWAYS

L = 75'-0" PARABOLIC FLARE

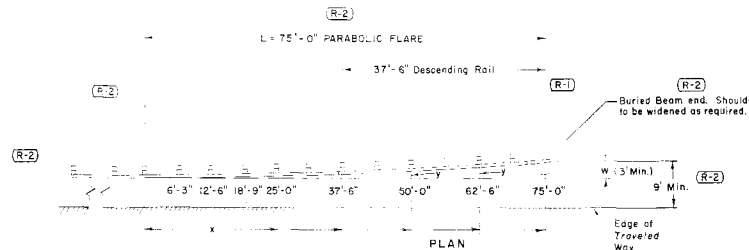


PARABOLIC TRANSITION & END TREATMENT

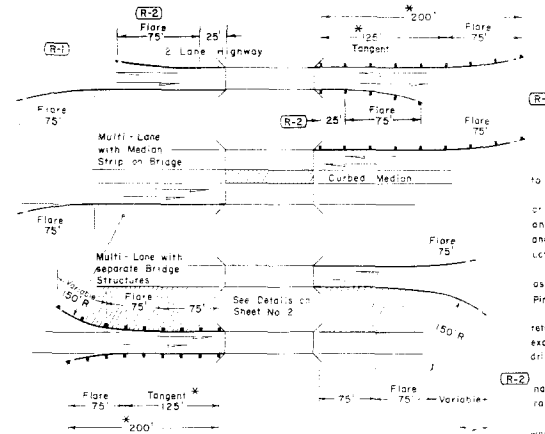

* NOTE:
250' Over 60 mph.
200' Up to 60 mph.
Up to 60 mph. 125' Tangent
75' Flare
Over 60 mph. 175' Tangent
75' Flare

37'-6" Descending Rail at end of Guard Rail.

BRIDGE APPROACH GUARD RAIL

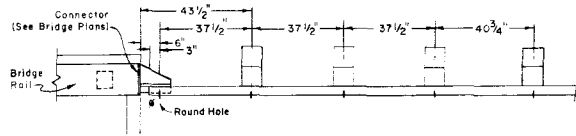

* NOTE:
The first rail panel section shall require holes and additional posts as indicated.
Factory punch 3/4" hole in center of rail 3' from this end. Omit rail splice holes at this end.

GUARD RAIL AT BRIDGES

GENERAL NOTES

All work shall be done in accordance with the Standard Specifications applicable to the project.

All timber shall be close grained Douglas fir or the Coast Region, Dense Longleaf or Shortleaf Southern Pine, or Lodgepole Pine. Timber shall be free of heart centers and shall conform to Construction Grade, Paragraph 125B of Standard No. 15 Grading and Dressing Rules of West Coast Douglas Fir (1956) or Dense Structural S&B and L Structural 5B, Paragraph 285 of 1956 Grading Rules for Southern Pine.

All timber shall be square edged, full sawn, and the tops of posts shall be beveled as shown. Blocks and posts shall be 6"x6" except that posts fabricated from Lodgepole Pines shall be 6"x10" (install with 6" face parallel to roadway center line).

Timber shall be incised and pressure treated with Grade 1 Creosote to a net retention of 8 pounds per cubic foot with a minimum penetration of 3/16 of an inch, except that blocks need not be incised before treatment. All bolt holes are to be drilled 1/8" larger than diameter of bolt before treatment is applied.

Posts shall be spaced at 6'-3" center to center except when otherwise designated by note or in the guardrail tabulation on the plans, and except for the first rail section adjacent to the bridge as shown hereon.

Where pedestrian hazards exist, sidewalks are to be constructed on the roadway shoulder. Guard rail shall be placed between the sidewalk and the edge of traffic lane.

Guard rail plate shall not be lighter than No. 12 U.S. Standard Gauge. 25' long elements will be permitted.

Metal plate guard rail shall be painted in accordance with standard specifications.

Metal plate guard rail galvanized in accordance with AASHTO Designation M-111 or with Coating Class 2, 50 of Table 1 of ASTM Designation A525 may be furnished in lieu of painting requirements.

Standard galvanized wrought steel washers shall be used under all bolt heads.

Or nuts coming in contact with wood posts.

LEGEND

W = Full Parabolic Offset.
L = Length of Parabolic Transition.
x = Distance - L x of Posts from E of first Post at beginning of Flare.
y = Offset of each Post = $W \sqrt{\frac{x}{L}}$

TABLE OF OFFSETS FOR 75' PARABOLIC FLARES

| FLARE | W | W/2 | W/3 | W/4 | W/5 | W/6 | W/7 | W/8 | W/9 |
|--------|------|------|------|------|------|------|-----|-----|-----|
| 6'-3" | 0.02 | 0.03 | 0.03 | 0.04 | 0.05 | 0.06 | | | |
| 12'-6" | 0.08 | 0.11 | 0.14 | 0.17 | 0.19 | 0.22 | | | |
| 18'-9" | 0.19 | 0.25 | 0.31 | 0.37 | 0.44 | 0.50 | | | |
| 25'-0" | 0.33 | 0.44 | 0.56 | 0.67 | 0.78 | 0.89 | | | |
| 31'-3" | 0.52 | 0.69 | 0.87 | 1.04 | 1.22 | 1.39 | | | |
| 37'-6" | 0.75 | 1.00 | 1.25 | 1.50 | 1.75 | 2.00 | | | |
| 43'-9" | 1.02 | 1.36 | 1.70 | 2.04 | 2.38 | 2.72 | | | |
| 50'-0" | 1.33 | 1.78 | 2.22 | 2.67 | 3.11 | 3.56 | | | |
| 56'-3" | 1.69 | 2.25 | 2.81 | 3.36 | 3.94 | 4.50 | | | |
| 62'-6" | 2.08 | 2.78 | 3.47 | 4.17 | 4.86 | 5.56 | | | |
| 68'-9" | 2.52 | 3.36 | 4.20 | 5.04 | 5.88 | 6.72 | | | |
| 75'-0" | 3.00 | 4.00 | 5.00 | 6.00 | 7.00 | 8.00 | | | |

DEPARTMENT OF HIGHWAYS
STATE OF COLORADO


GUARD RAIL
TYPE 3

Designed by M.R.H. Approved by R.S.M.
Made by R.S.M. Staff Design Engineer
Checked by R.S.M. Date MAY 26, 1967

STANDARD M-606-AA



(MAY 26, 1967)
(SHEET 2)

| FEDERAL ROAD DISTRICT | PROJ. NO. | SHEET NO. | TOTAL SHEETS |
|-----------------------|-----------|-----------|--------------|
| 3 COLORADO | | | |

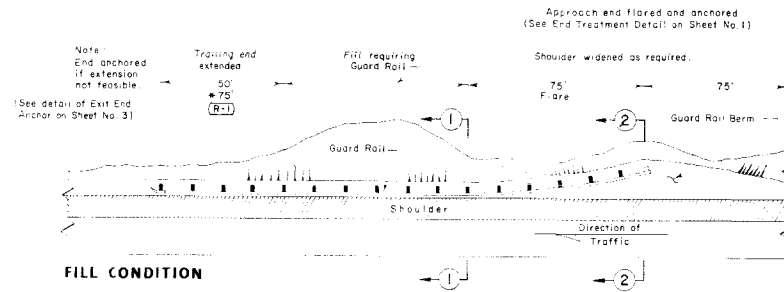

(R-1) NOTE:


* For 2-lane roadways, the exit end is to be flared and anchored the same as approach end.

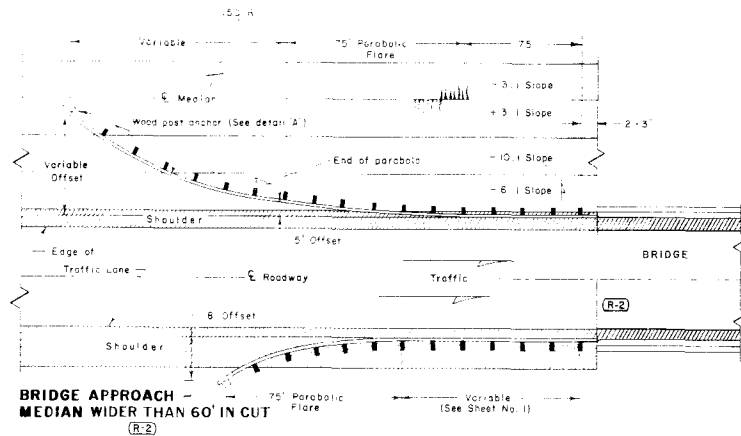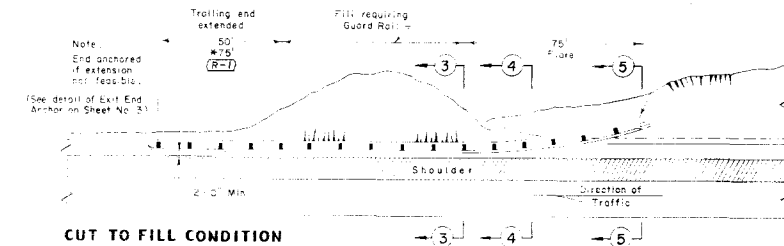

(R-2)

Medians wider than 60' in fill — Treat as separate roadways with Guard Rail on both sides.

GUARD RAIL END TREATMENT

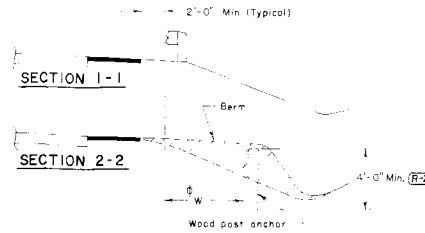

W = Offset distance
(See End Treatment Detail on Sheet No. 1)



SECTION 3-3

SECTION 4-4


SECTION 5-5

(R-1)

NOTE: Flare side ditch, as shown in Section 2-2 above, where practicable.

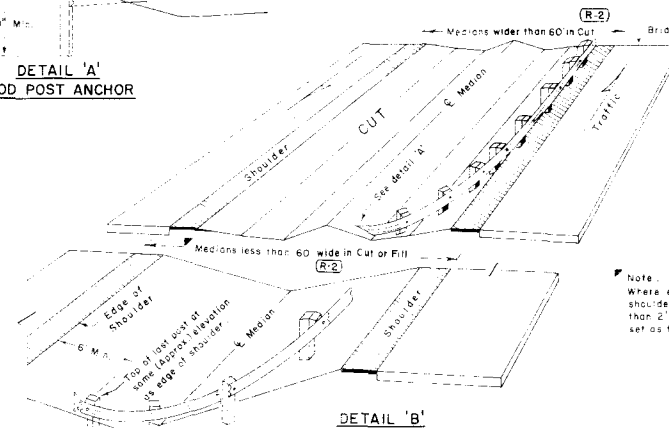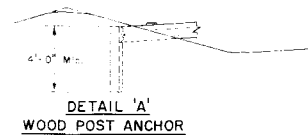

MULTI-LANE WITH SEPARATE BRIDGE STRUCTURES (R-2)

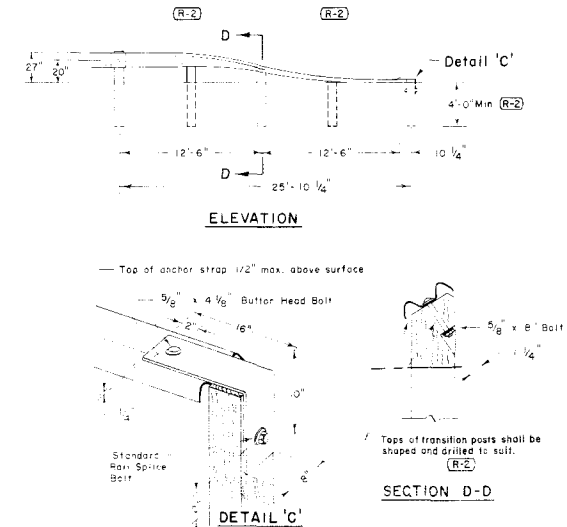

ALTERNATE END TREATMENT - 90° TWISTED BEAM

| REVISIONS | | |
|-----------|---------|--|
| (R-1) | 6-26-67 | Added note for 2-lane, Ditch flare. M.R.H. |
| (R-2) | 8-1-67 | Bridge Approach, End Treatment R.S.M. |

Note:
Where elevations of paved shoulders differ by more than 2', Guard Rail shall be set as for separate roadways.

DEPARTMENT OF HIGHWAYS
STATE OF COLORADO

GUARD RAIL TYPE 3

Designed by M.R.H. Approved: [Signature]
Made by R.S.M. Staff Design Engineer
Checked by R.S.M. Date: MAY 26, 1967


STANDARD M-606-AA

(MAY 26, 1967)
(SHEET 3)


| FEDERAL ROAD REGION NO. | DISTRICT | PROJ. NO. | SHEET NO. | TOTAL SHEETS |
|-------------------------|----------|-----------|-----------|--------------|
| 4 | COLORADO | | | |

REVISIONS:

(R-2) B 1: 67 Guard Rail for Obstr. @ Medians R.S.M.



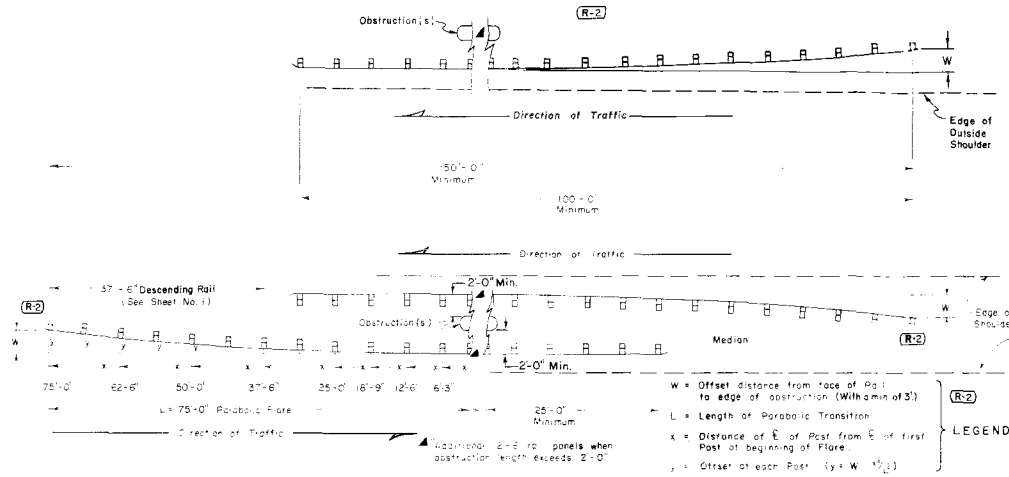


TYPICAL GUARD RAIL FOR OBSTRUCTIONS

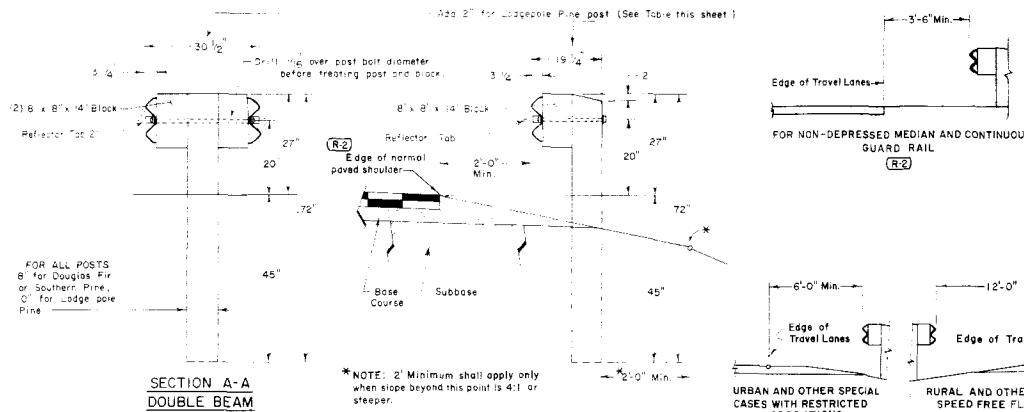


TYPICAL POST INSTALLATIONS

EXIT END ANCHOR (Concrete)

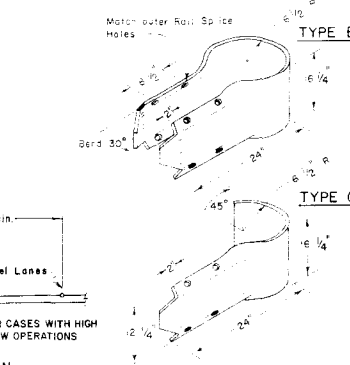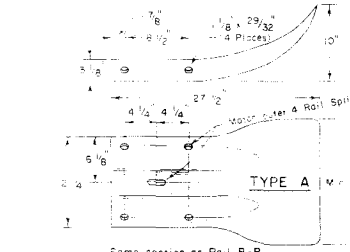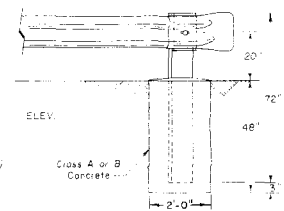


DETAILS OF TERMINAL SECTIONS

SECTION C-C

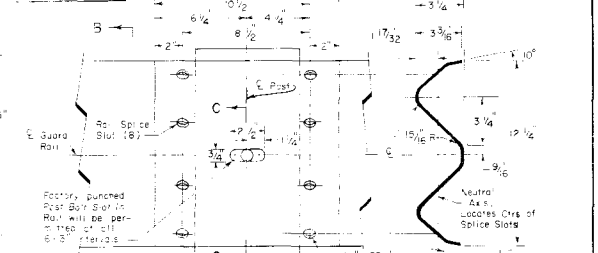

DETAIL OF RAIL SPLICE (Reflector Tab, Bolts Not Shown)

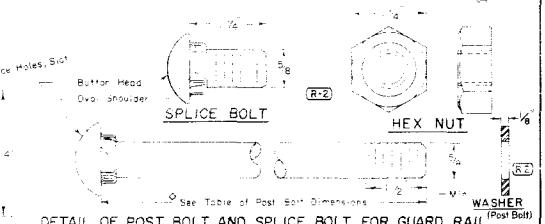


DETAIL OF POST BOLT AND SPLICE BOLT FOR GUARD RAIL

| TYPE POST | BOLT SIZE |
|----------------------|----------------|
| 6" x 8" Double Rail | 5/8" x 25 3/4" |
| 6" x 8" Single Rail | 5/8" x 17 1/2" |
| 6" x 10" Double Rail | 5/8" x 27 3/4" |
| 6" x 10" Single Rail | 5/8" x 19 1/2" |

Number Splice Bolts Required
8 per Splice or B Terminal, 4 per A or C Term.

TABLE OF POST BOLT DIMENSIONS

 INSTALLATION DETAILS OF REFLECTOR TAB



DEPARTMENT OF HIGHWAYS
STATE OF COLORADO

GUARD RAIL
TYPE 3

Designed by M.R.H.
Made by R.S.M. Staff Design Engineer
Checked by R.S.M. Date MAY 26, 1967

STANDARD M-607-A


(SHEET 1 OF 2 SHEETS)
(JULY 1, 1965)

| FED. ROAD
REC. NO. | DIVISION | PROJECT NO. | SHEET
NO. |
|-----------------------|----------|-------------|--------------|
| 9 | COLORADO | | |


| REVISIONS | | |
|-----------|---------------------------------|--------|
| NO. | DESCRIPTION | DATE |
| 8-2-66 | Vertical Dimensions and Note | M.R.H. |
| 12-8-66 | Vert. Dims., Std. and Alternate | M.R.H. |

(R-1) NOTE:
See Sheet 2
for General Notes.


BARBED WIRE FENCE WITH WOODEN POSTS

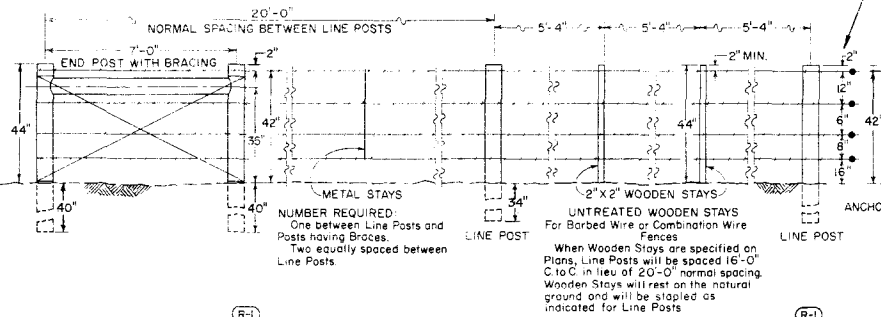

BARBED WIRE FENCE WITH METAL POSTS

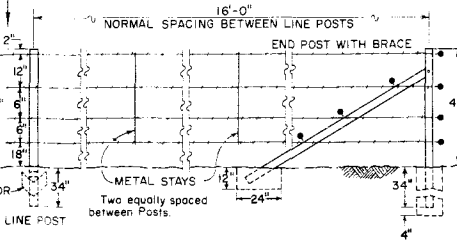


CROSS BRACE DOWELING DETAIL



 


Bore a 3/8" x 2" Hole in each Post and Brace to receive the Pins. Wrap the ends of the Braces tightly with several turns of 12/12 gal. smooth Galv. Wire to prevent splitting or Natch Post and Nail with 40 d Common Nails.

COMBINATION WIRE FENCE WITH WOODEN POSTS

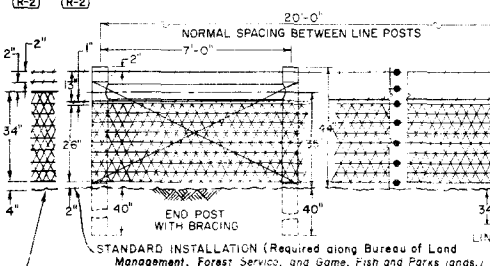


COMBINATION WIRE FENCE WITH METAL POSTS

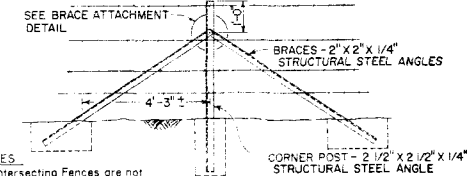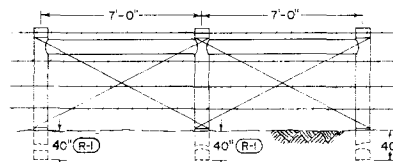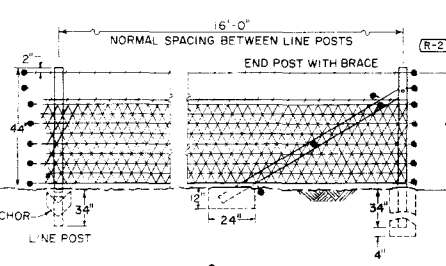


TYPICAL CORNER POST INSTALLATION

TYPICAL INSTALLATION AT FENCE INTERSECTIONS

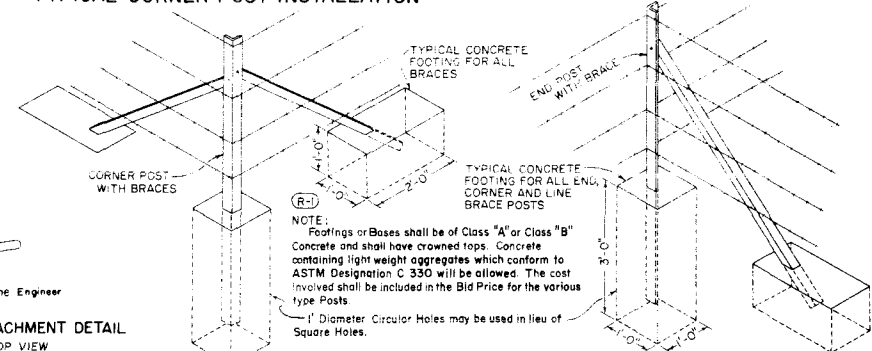


ILLUSTRATIVE SKETCH SHOWING TYPICAL EXAMPLES FOR CONSTRUCTING FENCES

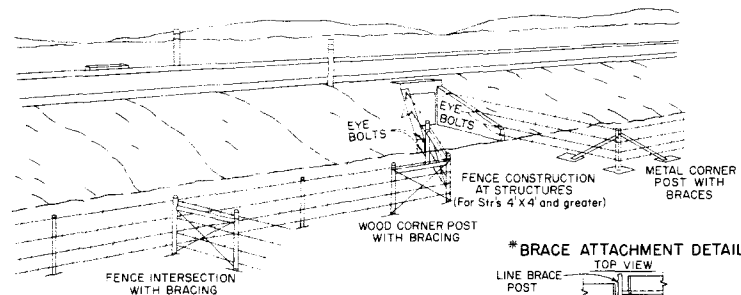


NOTE:
At all structures of 4' x 4' and over, the fence shall be ended at eye-bolts in the wings of the structure. Where the type of structure prohibits the use of eye-bolts, an end post with brace shall be used. Eye-bolts shall be made of 1/2" round bars with a minimum of six (6) inches of body length embedded in the concrete and a minimum of 1" inside eye diameter.
Eye-bolts shall be furnished and installed by the Contractor. Cost of eye bolts will be included in the contract price for fencing.

ACCEPTABLE WIRE SPLICE

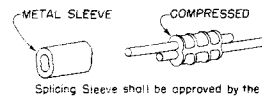

*ALTERNATE BRACE ATTACHMENT DETAIL TOP VIEW

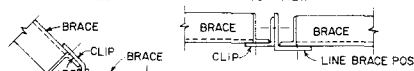

*BRACE ATTACHMENT DETAIL TOP VIEW



*BRACE ATTACHMENT DETAIL FRONT ELEV.




Holes in Posts, Braces and Clips shall accommodate 1/2" dia. Galvanized Machine Bolts

*Alternate attachment methods, acceptable to the Engineer, may be used.

ALTERNATE POST

(FOR END, CORNER OR LINE BRACE POSTS)

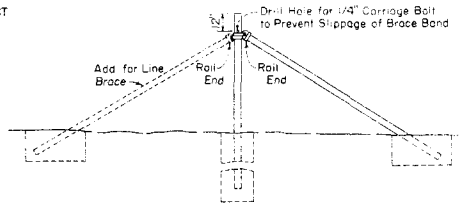

DEPARTMENT OF HIGHWAYS
STATE OF COLORADO
WIRE FENCES
AND
GATES


Designed by L.E.O. Approved by T.E.F. Staff Des. Engr.
Checked by E.O.I. Date: July 1, 1965

RIGHT OF WAY MARKER POST STANDARD M-612-A

(JULY 1, 1965)

| FEDERAL ROAD REG. NO. | DIVISION | PROJECT NO. | SHEET NO. |
|-----------------------|----------|-------------|-----------|
| 8 | COLORADO | | |

| REVISIONS | | |
|-----------|---------------------------|-------|
| NO. | DESCRIPTION | DATE |
| 1 | 5-2-66 R.O.W. Marker Note | M R H |

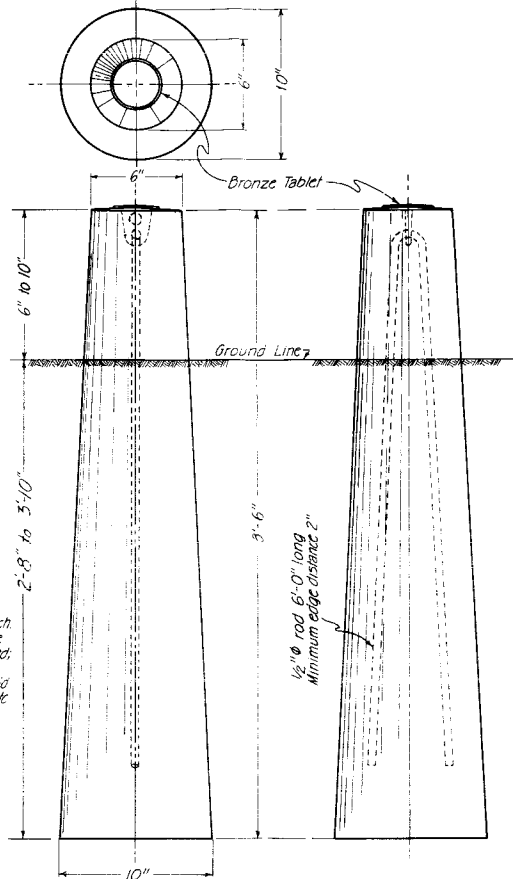



NOTES FOR R.O.W. MARKER POSTS

All work shall be done in accordance with the Standard Specifications applicable to the project.


Posts shall be made of class 'A' Concrete. The upper 12 inches of marker posts shall be rubbed free of form marks, and the top surface of the post must be constructed to drain thoroughly.

(R-1) Light weight aggregate conforming to ASTM designation C-530 will be allowed.

All exposed surfaces of the bronze tablet are to be ground to a smooth surface. All letters are to be depressed a minimum of $\frac{1}{16}$ inch. Information on the bronze tablet indicated by pin lines is to be stamped in field by the engineering party after post is placed. $\frac{3}{16}$ inch letters and figures to be used. Project designations on tablets shall be properly shown (i.e., I for Fed Aid Interstate, F for Fed Aid Primary, S for Fed Aid Secondary, etc. C for State Projects. see detail below.)

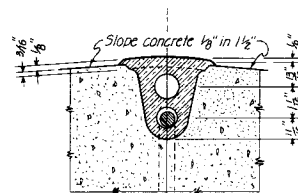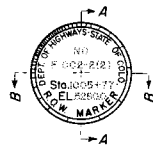

SECTION B-B

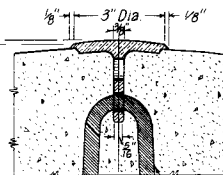

SECTION A-A

Omit and use 12"x 1/2" bar for Bench Mark Tablet

DETAIL OF BRONZE TABLET FOR RIGHT OF WAY MARKER POST AND BENCH MARK



BENCH MARK

All work shall be done in accordance with Standard Specifications applicable to the project.

All exposed surfaces of the bronze tablet are to be ground to a smooth surface. All letters are to be depressed a minimum of $\frac{1}{16}$ inch. Information on the bronze tablet indicated by pin lines is to be stamped in field by the engineering party after marker is placed. $\frac{3}{16}$ inch letters and figures to be used. Project designation on tablets shall be properly shown (i.e., I for Fed Aid Interstate, F for Fed Aid Primary, S for Fed Aid Secondary, etc. C for State Projects. See details below.)

Bronze Bench Mark Tablets will be furnished by the Department at no expense to the Contractor.

Installation of Bronze Bench Mark Tablets will not be paid for directly, but shall be included in the price bid for Concrete.

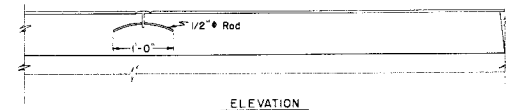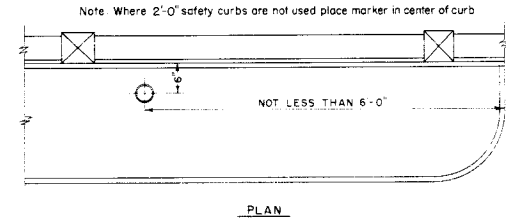

One marker to be placed on Bridges as shown. The station shown on marker shall be the centerline stationing directly opposite the marker.

DEPARTMENT OF HIGHWAYS
STATE OF COLORADO

MARKER POSTS AND BENCH MARKS


Designed by R.E.L. Approved by R.E.L.
Made by E.E.G. Staff Design Eng.
Checked by R.E.L. Date: July 1, 1965

STANDARD M-612-C

(SHEET 1 OF 2 SHEETS)
JULY 1, 1965

| FED. ROAD REG. NO. | DIVISION | PROJECT NO. | SHEET NO. |
|--------------------|----------|-------------|-----------|
| 9 | COLORADO | | |

| REVISIONS |
|-----------|
| |
| |
| |
| |

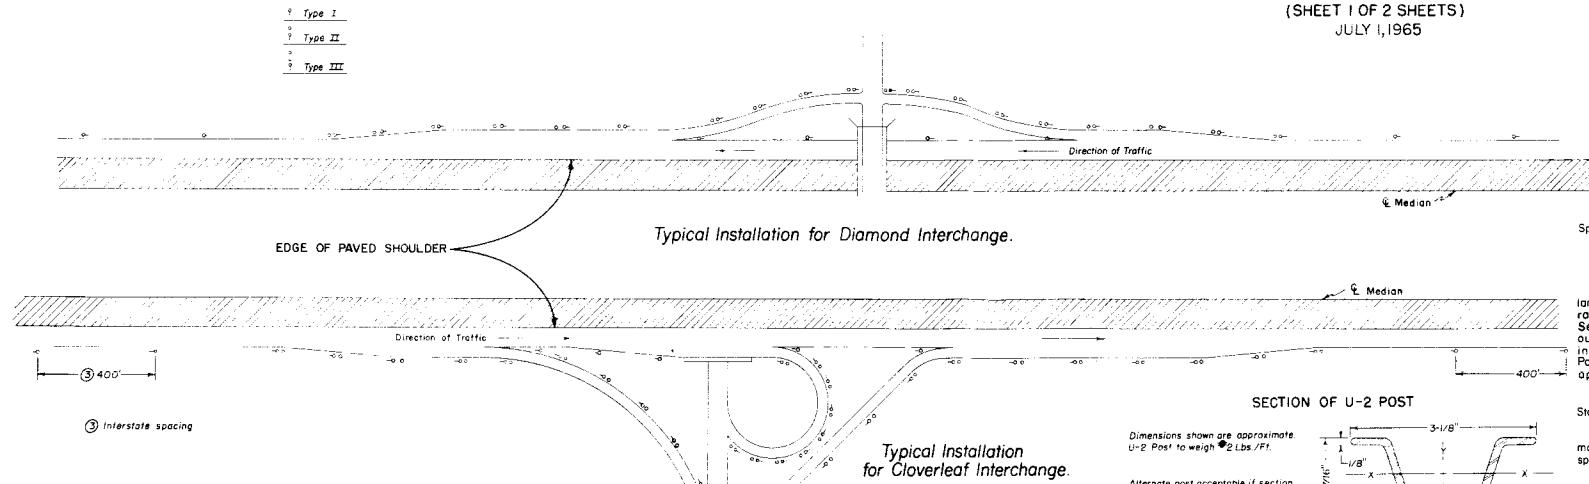

GENERAL NOTES

All work shall be done in accordance with the Standard Specifications applicable to the project.

See tabulation in plans for delineator post requirements.

Spacing between Posts on acceleration and deceleration lanes and on relatively straight portions of interchange ramps shall be 100' on Interstate and 200' on Primary and Secondary Projects. Spacing between Posts on the outside of interchange ramp curves shall be as indicated in table for the appropriate degree of curve with a 24 min. spacing. Post spacing in advance and beyond curve shall not apply to ramp curves.

Posts shall meet requirements of Part 4.5 of U.S. Dept. of Commerce Commercial Standard 184-51. Acceptable material includes re-rolled railroad rails.

When normal delineator spacing falls on a road approach or crossroad, move delineator either direction a distance not to exceed 1/4 normal spacing.


Type, location and spacing of delineators for tunnels and snow sheds shall be as directed by the Engineer.

Delineator Posts are not to be placed along Frontage Roads.

Color of Posts shall be Interstate Green.

SECTION OF U-2 POST

Dimensions shown are approximate
U-2 Post to weigh 2 Lbs./Ft.

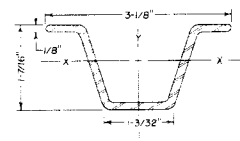

Alternate post acceptable if section modulus is at least 0.200 in.³ about X-X axis or at least 0.250 in.³ about Y-Y axis.

A mill tolerance of minus 3 1/2 % of the weight of any one post will be allowed.


SPACING FOR DELINEATOR POSTS ON HORIZONTAL CURVES

| DEGREE OF CURVE | RADIUS | SPACING IN ADVANCE OF AND BEYOND CURVE | | | | DEGREE OF CURVE | RADIUS | SPACING IN ADVANCE OF AND BEYOND CURVE | | | |
|-----------------|---------|--|-------------|--------------|-------------|-----------------|--------|--|-------------|--------------|-------------|
| | | ON CURVE | FIRST SPACE | SECOND SPACE | THIRD SPACE | | | ON CURVE | FIRST SPACE | SECOND SPACE | THIRD SPACE |
| 0°30' | 11480.0 | 200 | 200 | 200 | 200 | 8°00' | 716.3 | 52 | 94 | 156 | 200 |
| 1°00' | 5730.0 | 151 | 200 | 200 | 200 | 8°30' | 674.1 | 50 | 90 | 150 | 200 |
| 1°30' | 3820.0 | 123 | 200 | 200 | 200 | 9°00' | 636.7 | 48 | 86 | 144 | 200 |
| 2°00' | 2865.0 | 106 | 191 | 200 | 200 | 9°30' | 603.2 | 47 | 85 | 141 | 200 |
| 2°30' | 2292.0 | 95 | 171 | 200 | 200 | 10°00' | 573.0 | 46 | 83 | 136 | 200 |
| 3°00' | 1910.0 | 86 | 155 | 200 | 200 | 10°30' | 545.7 | 45 | 81 | 131 | 200 |
| 3°30' | 1637.1 | 80 | 144 | 200 | 200 | 11°00' | 520.9 | 43 | 77 | 129 | 200 |
| 4°00' | 1432.5 | 74 | 133 | 200 | 200 | 11°30' | 498.3 | 42 | 76 | 126 | 200 |
| 4°30' | 1273.3 | 70 | 126 | 200 | 200 | 12°00' | 477.5 | 41 | 74 | 123 | 200 |
| 5°00' | 1146.0 | 66 | 119 | 198 | 200 | 15°00' | 382.0 | 36 | 65 | 108 | 200 |
| 5°30' | 1041.8 | 63 | 113 | 189 | 200 | 18°00' | 318.3 | 33 | 59 | 99 | 198 |
| 6°00' | 955.0 | 60 | 108 | 180 | 200 | 21°00' | 272.9 | 30 | 54 | 90 | 180 |
| 6°30' | 881.5 | 58 | 104 | 174 | 200 | 25°00' | 223.2 | 27 | 49 | 81 | 162 |
| 7°00' | 818.6 | 55 | 99 | 165 | 200 | 30°00' | 191.0 | 24 | 43 | 72 | 144 |
| 7°30' | 764.0 | 53 | 95 | 159 | 200 | | | | | | |

$S = 2 \sqrt{R - 50}$ 1-ST. SPACE = 1 BS 2-ND. SPACE = 3 S 3-RD. SPACE = 6 S
NO SPACES TO EXCEED 200 FT.


① Omit third space on Secondary and Primary Routes and double the distance on the curve and in advance of and beyond curve.
For curves less than 2 degrees on interstate through roadways use Interstate tangent spacing.

Typical Installation at Bridge Approaches

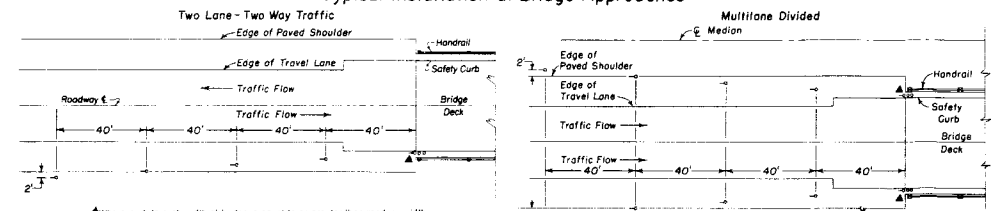

Where curb to curb width of bridge is equal to or greater than roadway width plus usable shoulder width, use this delineator only and omit all others.
Note: Where guard rail is present, place delineators outside of guard rail and at height which will permit clear view of all three Delineator buttons.

When approach slab has curb, place Type III delineator immediately behind curb.

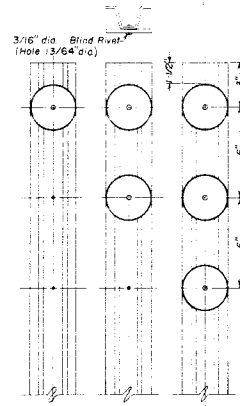


TYPE I
1-3" dia.
Crystal
Reflector
on U-2 Post

TYPE II
2-3" dia.
Yellow
Reflectors
on U-2 Post

TYPE III
3-3" dia.
Yellow
Reflectors
on U-2 Post

Min. 3 holes in all posts required as shown.

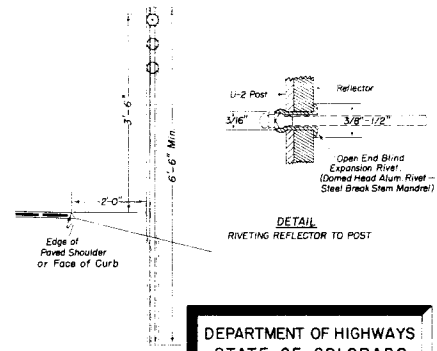

DEPARTMENT OF HIGHWAYS
STATE OF COLORADO
DELINEATORS

Designed by CKM
Made by WNC
Checked by LEO

Approved by [Signature]
Staff Design Eng.
Date: July 1, 1965


STANDARD M-612-C

(SHEET 2)
(JULY 1, 1965)

| FED. ROAD DIST. NO. | DIVISION | PROJECT NO. | SHEET NO. |
|---------------------|----------|-------------|-----------|
| 9 | COLORADO | | |

| REVISIONS | | |
|-----------|--------|--------------------------------------|
| (R-1) | 5-4-67 | Median and Island Delineators M.R.H. |
| | | |
| | | |
| | | |


TYPICAL INSTALLATION FOR CHANNELIZED INTERSECTION

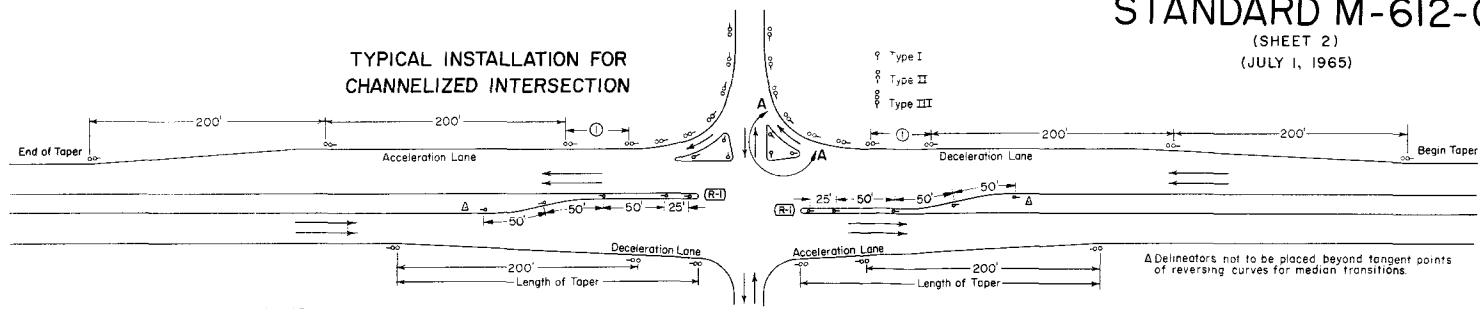


GENERAL NOTES

For Radii greater than 200 Feet, use spacing from Table included on Sheet 1 of this Standard.
For additional General Notes, see Sheet 1 of this Standard.
Place face of button at 90° to $\bar{C}$ of roadway.
Lengths of speed change lanes including tapers shall be as shown on plans.

TYPICAL INSTALLATION FOR CLIMBING LANE TRANSITION

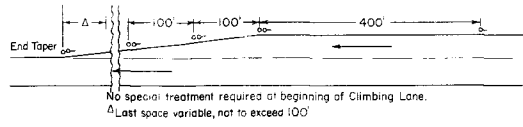


4 LANE DIVIDED (INTERSTATE)

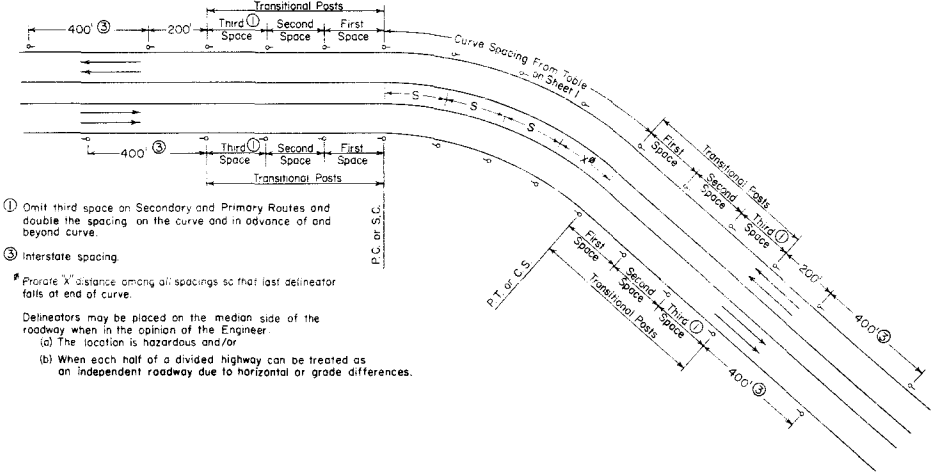

- ① Omit third space on Secondary and Primary Routes and double the spacing on the curve and in advance of and beyond curve.
 - ② Interstate spacing.
 - * Provide "X" distance among all spacings so that last delineator falls at end of curve.
- Delineators may be placed on the median side of the roadway when in the opinion of the Engineer:
(a) The location is hazardous and/or
(b) When each half of a divided highway can be treated as an independent roadway due to horizontal or grade differences.

TYPE III DELINEATOR PLACEMENT AT HAZARDOUS MINOR STRUCTURES

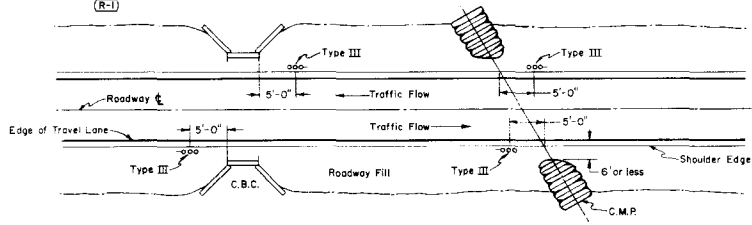

Type III Delineators shall be placed as shown to mark hazardous ends of culverts and other minor structures. These structures are considered hazardous when the exposed barrel of the culvert or the roadway side of headwall or box is 6' or less from the edge of travel lane.


DEPARTMENT OF HIGHWAYS
STATE OF COLORADO

DELINEATORS


Designed by C.K.M. Approved by J.E. O'Brien
Made by T.E.F. Staff Design Eng.
Checked by L.E.O. Date: July 1, 1965

CLASS I BARRICADES (3 RAILS)

MOVABLE



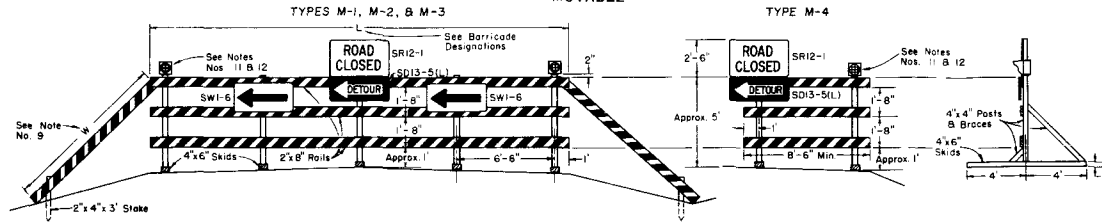


FIXED

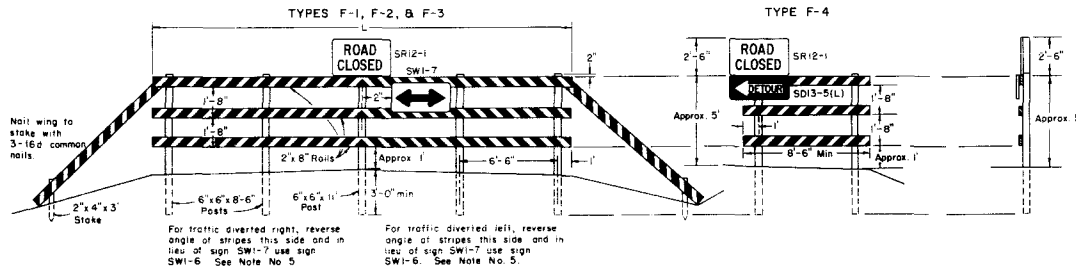


CLASS II BARRICADE (1 RAIL)

FIXED
TYPE F-6

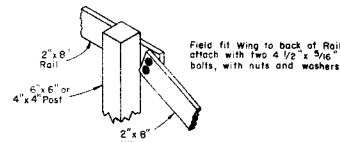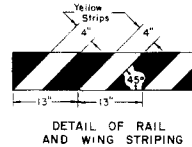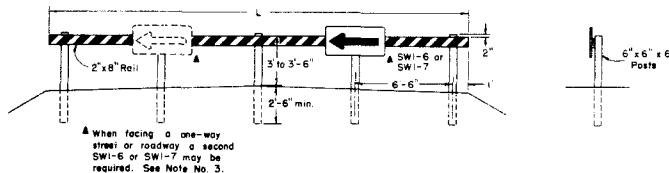

REAR VIEW OF BARRICADE
SHOWING WING ATTACHED
(See Note No. 9)

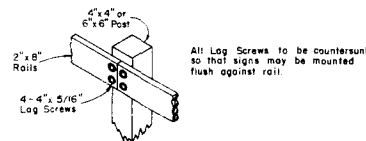


METHOD OF ATTACHING PLANKING
TO POSTS AT JOINTS

SITUATION A

SITUATION B

SITUATION C

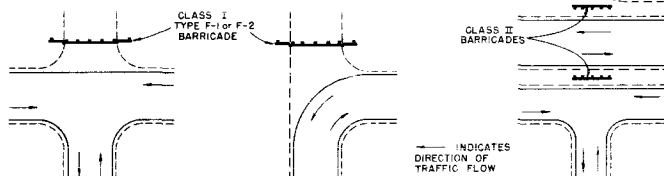

STANDARD M-614-A

(JULY 1, 1965)

| FEDERAL ROAD REGION NO. | DISTRICT | PROJECT NO. | SHEET NO. |
|-------------------------|----------|-------------|-----------|
| 9 | COLORADO | | |
| REVISIONS | | | |
| | | | |
| | | | |
GENERAL NOTES

- All work shall be done in accordance with the Standard Specifications applicable to the Project.
- All signs and sign materials shall conform to the standards set forth in the "Manual on Uniform Traffic Control Devices for All Classes of Streets and Highways" published by the Department of Highways and this standard.
- The various types and combinations of approved Signs and Beacons for Barricades required for each project shall be governed by field conditions and subject to approval by the Engineer. All traffic controls shall be placed for best visibility and legibility and maintained in good condition at all times. Oversigning is to be avoided.
- Painting shall conform with Subsection 508.08 of the Standard Specifications. All skids, braces, and posts shall be painted with 2 coats of "Exterior Black Paint." Planking and wings on all barricades shall be painted with 2 coats of "Exterior Black Paint" on all sides before adding reflective strips. Reflective strips shall be cut from smooth surface yellow reflective sheeting of type approved by the Department.
- Each barricade rail shall be striped on the face side only with reflective yellow stripes slanting downward at a 45° angle toward the side to which traffic is to turn or pass. See "DETAIL OF RAIL AND WING STRIPING."
- When barricades are designated on plans the portion of the posts below ground line shall either be dipped in or painted with hot creosote oil. The portion of the post above ground line shall be painted with 2 coats of "Exterior Black Paint."
- All skids, braces, and posts shall be nailed together with No. 20d nails. All screws, bolts, nuts, and washers shall be galvanized or cadmium plated. Skids (bases) of movable barricades shall be weighted where necessary to provide stability.
- All timber used shall conform to the Standard Specifications for Miscellaneous Untreated Timber S4S. Timber shall conform to Construction grade Paragraph 1238 or 125B of Standard No. 15 Grading & Dressing Rule for West Coast Douglas Fir (1956) or Dense Structural 5B and LL Structural 5B Paragraph 284 or 285 of 1956 Grading Rules for Southern Pine.
- Detachable extension wings for bypassing of construction equipment are permitted. "W" is variable, length shall be adequate to provide closing of borrow pit and/or shoulder as required.
- Alternate materials or other reflective elements on Traffic signs or Barricades will be permitted only after approval of such material by the Department in writing.
- A Flashing Beacon for use on Barricades is a section of a standard traffic signal head or a similar-type device having a yellow lens in the face, which is illuminated by intermittent flashes. Where commercial power is not available, the beacon may be adapted to operate from storage batteries. Each signal unit lens shall have a visible diameter of not less than 8 inches. Each unit complete shall be of such design as to render the lens when illuminated clearly visible to traffic facing the signal at all distances up to 1000 feet under all atmospheric conditions except dense fog. The color of the yellow lens for caution shall be in accordance with Technical Report No. 1 of the Institute of Traffic Engineers. All beacon flashers shall be equipped with filters for suppression of radio interference. The illuminating element in a flashing yellow beacon shall be flashed at a rate of not less than 50 times nor more than 60 times per minute. The illuminated period of each flash shall be not less than half and not more than two-thirds of the total cycle. The use of Flashing Beacons will be governed by field conditions. Flashing Beacons when warranted generally should be operated continuously throughout the 24 hours of the day. Warrant for Flashing Beacons may be found in Sec. 3G of the "Manual on Uniform Traffic Control Devices for Streets and Highways" published by the U.S. Department of Commerce, Bureau of Public Roads, June, 1961 (or latest revision).
- Flashers are portable, power-operated, lens-directed, enclosed lights, illuminated by rapid intermittent flashes of short duration. Flashers may be used in connection with barricades when approved by the Engineer. An array of random flashers which tends to obscure rather than delineate the traveled way will not be permitted. The use of flashers on a job will be governed by Sec. 5D of the "Manual on Uniform Traffic Control Devices for Streets and Highways" published by the U.S. Department of Commerce, Bureau of Public Roads, June, 1961 (or latest revision). The color of the light emitted by a flasher shall be yellow.
- Flashing Beacons and Flashers, when used, shall be positioned above the top rail of the barricades to produce the most effective results.
- Barricades used as "Traffic Controls for Highway Construction" are not to be paid for separately.
- Barricades will be paid for separately when designated on plans as bid items.
- For additional general information on control of traffic through work areas refer to the "Manual on Uniform Traffic Control Devices for Streets and Highway", Part V, published by the U.S. Department of Commerce, Bureau of Public Roads, June, 1961 (or latest revision).

| BARRICADE DESIGNATIONS | | | | | |
|------------------------|------|-------|---------------|---------------------|---|
| Class | Type | Fixed | Roadway Width | L | Description |
| I | M-1 | F-1 | 25'-34' | 28' | Barricade complete with SR12-1 sign and SW1-6 or SW1-7 signs as required. |
| I | M-2 | F-2 | 35'-44' | 41' | Barricade complete with SR12-1 sign and SW1-6 or SW1-7 signs as required. |
| I | M-3 | F-3 | Variable | 28' | Barricade (without extension wings) complete with SR12-1 sign and SW1-6 or SW1-7 signs as required. |
| I | M-4 | F-4 | Variable | Variable 8'-6" min. | Wing Barricade (signs only as appropriate). |
| II | | F-6 | Variable | 28' | Barricade complete with appropriate signs. |

DEPARTMENT OF HIGHWAYS
STATE OF COLORADO


TIMBER
BARRICADES

Designed By: D.R.W.
Made By: J.S.
Checked By: J.B.
Approved By: *[Signature]*
Date: JULY 1, 1965


TYPICAL SIGNS STANDARD M-614-IA

(JULY 1, 1965)


INTERSTATE SYSTEM

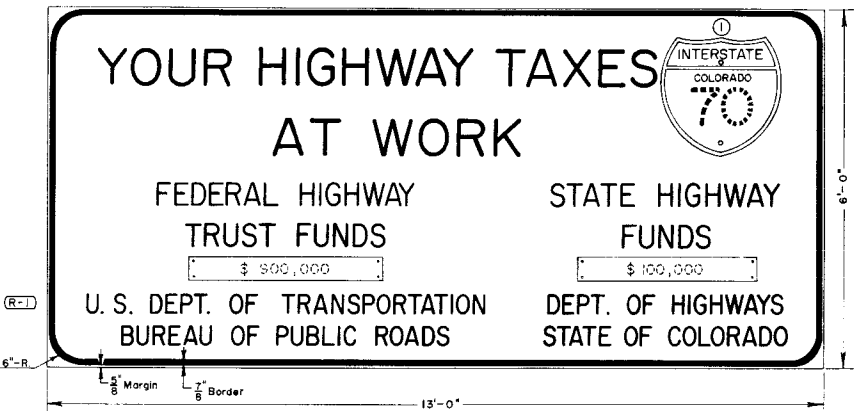

PRIMARY & SECONDARY SYSTEM

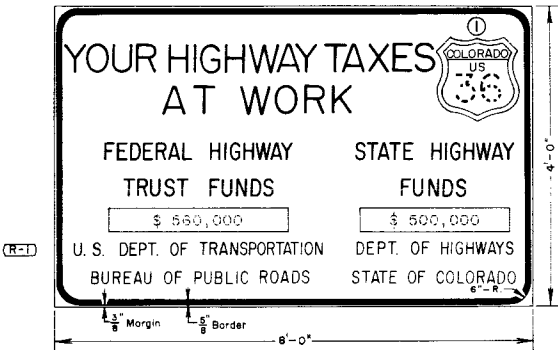

INSTALLATION DETAIL

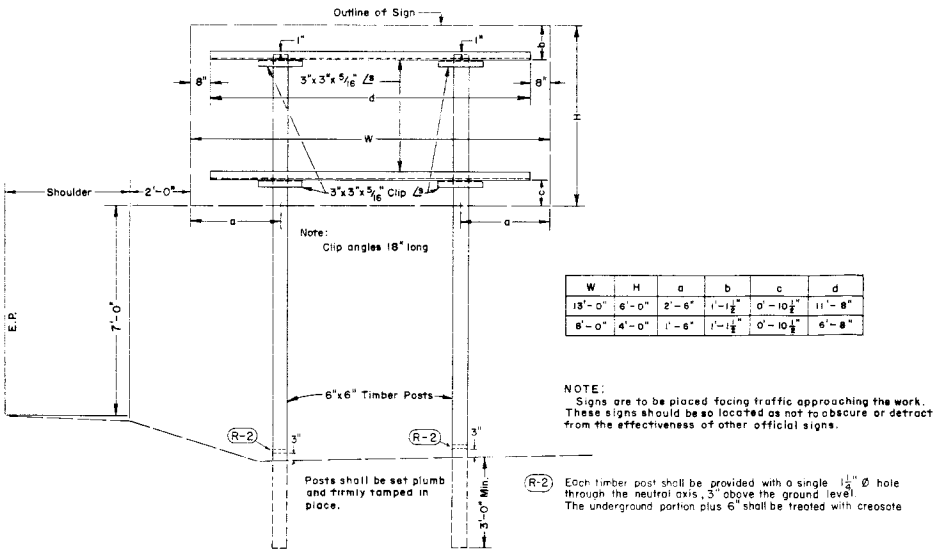

GENERAL NOTES

All work shall be done in accordance with the Standard Specifications applicable to the project.

Signs shall be made of 3/4" Plywood or other material approved by the Department.

When a third governmental agency is participating its official name should be included centrally in lines 6 and 7.

Posts shall be 6" x 6" S4S timber or other material approved by the Department and shall be painted white.

Signs are to be non-reflectORIZED, black letters, numerals, and border on plain white background. Route Marker plaques to be the appropriate standard colors, non-reflectORIZED.

Layout of signs will be furnished by the Traffic Engineering Section indicating the details as to letter size, symbols, spacing, figure for amount of funds, etc. which are required for these signs.

These signs will be furnished and installed by State Forces.

DEPARTMENT OF HIGHWAYS
STATE OF COLORADO
CONSTRUCTION
IDENTIFICATION
SIGNS

Designed by B.F.R. Approved by [Signature]
Made by D.U.B. Traffic Engineer
Checked by M.R.H. Date: July 1, 1965


(SHEET 1 OF 3 SHEETS)

(JULY 1, 1965)

11

00

NOTE:
See Sheet 2 for detailed drawings of signs.
See Sheet 3 for General Notes applicable to
Sheets 1 and 2.

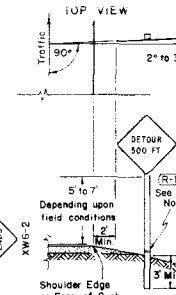

Sign Placement

DEPARTMENT OF HIGHWAYS
STATE OF COLORADO
TRAFFIC SIGNING
FOR HIGHWAY
CONSTRUCTION

| | |
|-----------------------|---------------------------------|
| Designed By: D. R. W. | Approved By: <i>[Signature]</i> |
| Made By: JLS | Traffic Engineer |
| Checked By: J.B. | Date AUGUST 9, 1965 |

STANDARD M-614-TB

(SHEET 2 OF 3 SHEETS)




(JULY 1, 1965)

WARNING SIGNS

See Note No. 10

| FEDERAL ROAD REGION NO. | DIVISION | PROJECT NO. | SHEET NO. |
|-------------------------|----------|-------------|-----------|
| 8 | COLORADO | | |
| REVISIONS | | | |
| (47) | 7-12-67 | | M.R.H. |
| | | | |
| | | | |
| | | | |

REGULATORY SIGNS
See Note No. 9

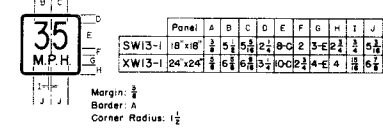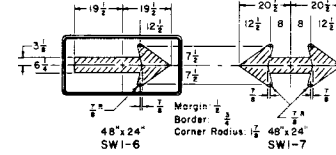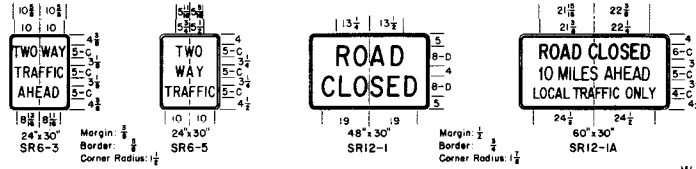

WARNING SIGNS
See Note No. 10




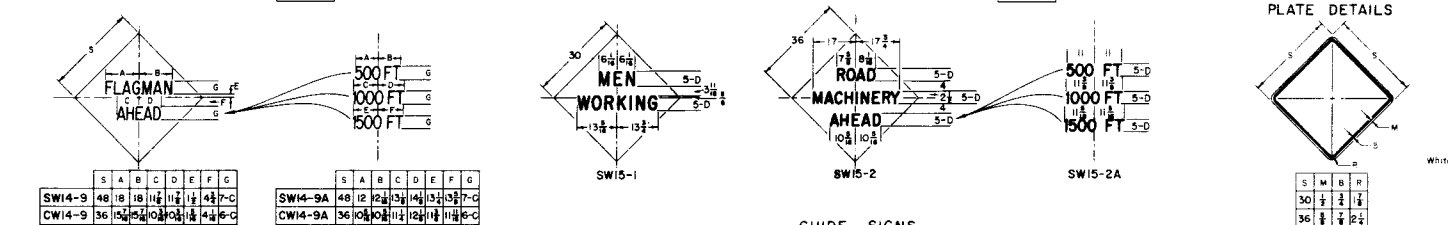


PLATE DETAILS

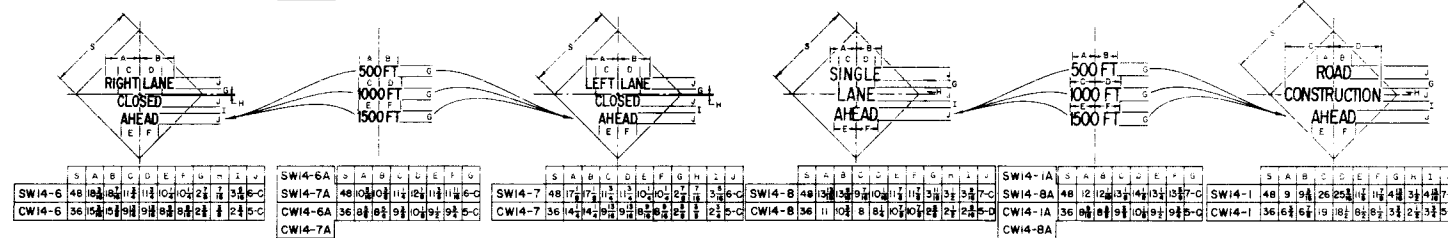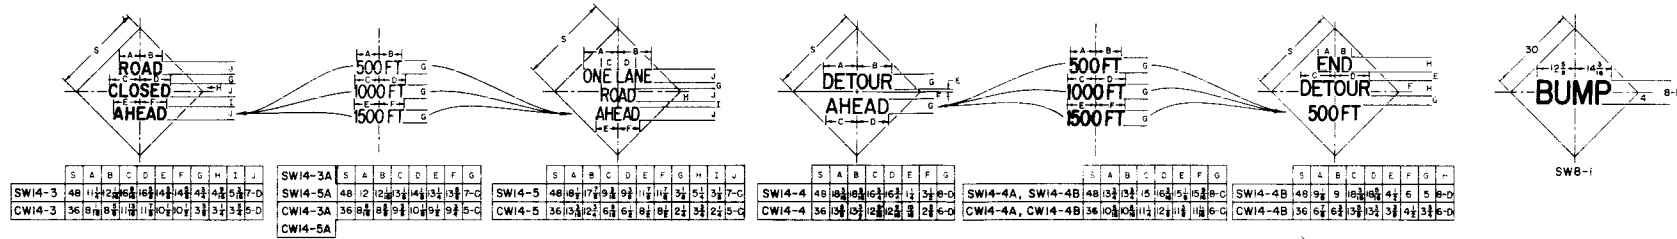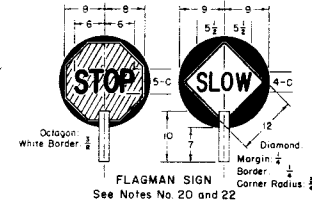


NOTES:

SEE SHEET 1 FOR TYPICAL SIGNING AND SIGN PLACEMENT
SEE SHEET 3 FOR GENERAL NOTES APPLICABLE TO SHEETS 1 AND 2.

ALL DIMENSIONS ARE IN INCHES.

GUIDE SIGNS
See Note No. 11

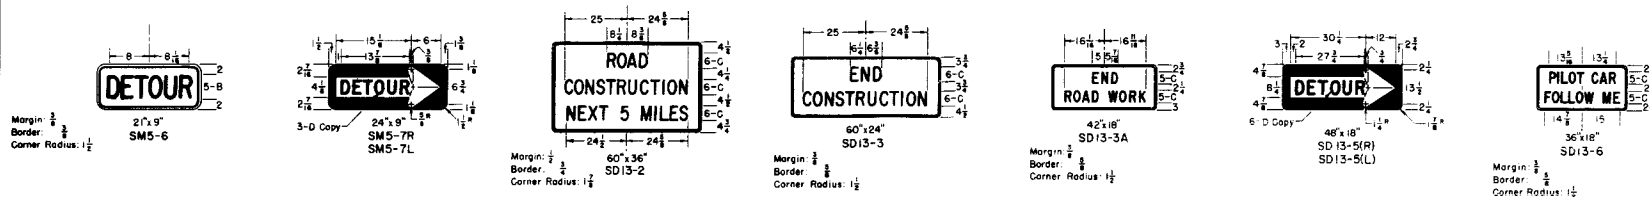

DEPARTMENT OF HIGHWAYS
STATE OF COLORADO
TRAFFIC SIGNING
FOR HIGHWAY
CONSTRUCTION

Designed By D.R.W.
Made By M.S.D.
Checked By J.B.
Date AUGUST 9, 1965

STANDARD M-614-TB

(SHEET 3 OF 3 SHEETS)

(JULY 1, 1965)

GENERAL NOTES

1. All work shall be done in accordance with: (a) the Standard Specifications applicable to the Project, and (b) the "Manual on Uniform Traffic Control Devices for all Classes of Streets and Highways" published by the Department of Highways.
2. Where traffic is maintained through or over any part of the Project, the Contractor will be required to mark all hazards within the limits of the Project (including connecting roads) with well-maintained Barricades, Warning, and Guide Signs. All Barricades and Signs shall be moved, added to, changed or removed as required during the progress of construction and removed entirely when the Project is completed.
3. Where traffic is prohibited from the Project the Detour will be marked by the Department except that the Contractor shall provide, erect and maintain Barricades, complete, (when required) at the ends of the Project, ends of the Detour and connecting roads. All U.S. or State Route Markers required for the Project will be furnished and installed by the Department. The location and positioning of Warning Signs, Barricades, and Regulatory Signs shall be as recommended by the appropriate District Engineering Forces of the Department.
4. Work on the Project shall not be started until all required signs are in place and approved by the Engineer. Where speed control appears necessary such speed control shall be requested from the Engineer by the Contractor. Control of speed through a construction zone may be achieved by Advisory Speed plates in conjunction with Warning Signs (SW13-1 for use with 30" Warning Signs and XW13-1 for use with 36" and 48" Warning Signs). The Advisory Speed plate is to be posted only at those locations where the safe speed is lower than the imposed Regulatory speed limit.
5. All Signs and Barricades shall be placed for best visibility and legibility, maintained in good condition and kept clean and free of dirt at all times. Contractor's and Engineer's vehicles and equipment must be parked so that signs and barricades are visible to approaching traffic at all times.
6. Where two identical signs are used for dual posting they are to be staggered on the two sides of the roadway for a minimum distance of 75' to avoid a tunneling effect.
7. Examples for marking Projects, as shown on Sheet 1, are typical of signs required and are subject to alteration to fit actual conditions encountered in the field. Locations for control devices are to be staked by the Engineer. In all cases Warning signs are to be placed well in advance of the hazard, the distance depending on topography and existing approach speeds. Additional markings and any special signs required for the guidance and protection of traffic will be placed as required on the Project at the Contractor's expense.
8. Desirable sizes for signs are shown on Sheet 1 of this Standard. Larger or smaller signs shall be used where warranted. Detailed dimensions for signs normally used in connection with construction are shown on Sheet 2 of this Standard. For information on standard roadway signs not detailed on this Standard see the "Manual on Uniform Traffic Control Devices for all Classes of Streets and Highways" published by the Department of Highways.
9. Signs with the prefix "R" in the sign code are Regulatory signs and as such impose legal compulsions or restrictions on drivers and should only be used as authorized by the Engineer.
10. Signs with the prefix "W" in the sign code are Warning signs and are used to alert traffic to existing or potentially hazardous conditions.
11. Signs with the prefix "D" or "M" in the sign code are Guide signs. Those with the prefix "D" convey general information and those with the prefix "M" are used for marking the traffic route.
12. All signs shall be reflectorized unless otherwise specified on plans. Regulatory and Guide signs (unless otherwise specified) shall have a screen processed black legend and border on a white flexible reflective sheeting, non-exposed lens background. The back side of Regulatory and Guide signs shall be painted with two coats of "Exterior Sign White Paint." Warning signs shall have a screen processed black legend and border on a highway yellow flexible reflective sheeting, non-exposed lens background. The back side of Warning signs shall be painted with two coats of "Federal Yellow Synthetic Sign Enamel."
13. Painting for wood surfaces shall conform with Section 508 of the Standard Specifications.
14. Posts for regulatory, warning, and guide signs will normally be 4"x4" or 6"x6" and shall conform to the Standard Specifications for Untreated Timber-S4S. Timber shall conform to Construction grade Paragraph 123B or 125B of Standard No. 15 Grading & Dressing Rules for West Coast Douglas Fir (1956) or Dense Structural 5B and LL Structural 5B Paragraph 284 or 285 of 1956 Grading Rules for Southern Pine. Posts shall be painted with one coat of "White Wood Primer" and one coat of "Outside White Paint."
15. Sign panels furnished by the Contractor for use only during construction may be fabricated from plywood, aluminum, steel or other suitable material but shall be stable and durable enough to meet other requirements of this Standard.
16. All material shall be sound and durable. Barricades, signs, symbols, and lettering shall be of good workmanship. Uneven lettering will not be accepted.
17. Alternate methods of processing signs or the substitution of symbols or other reflecting elements for painted symbols will be permitted only after approval by the Department.
18. Torches and Lanterns shall be either of the fuel-burning or battery-powered type approved by the Department. Particular care shall be taken to protect all signs and barricades from smoke and smudge.
19. Barricades, Flashing Beacons and Flashers - Refer to appropriate "M" Standard (Timber Barricades) for details.
20. Flagman Sign - This sign shall have a black painted background on both sides to form a contrast for the octagonal Stop sign and the diamond Warning sign. The "STOP" sign shall be fabricated by reverse screen process using transparent red paint on smooth surface silver reflective sheeting. The "SLOW" side of the Flagman Sign shall be black process paint on smooth surface yellow reflective sheeting. Handle to be grooved on one side to indicate reading of sign to Flagman.
21. Sign "A": This is the first advance warning sign and shall be placed 1,500 feet ahead of Barricade or project terminal. Postings are required on both sides of the roadway on divided highways. Dual posting is required where warranted on two-lane, two-way highways.
Sign "B": This is the second advance warning sign and shall be placed 1,000 feet ahead of barricade or project terminal. Postings are required on both sides of the roadway on divided highways and singly on two-lane, two-way highways.
Sign "C": This is the third advance warning sign in cases where barricades are used and shall be placed 500 to 750 feet ahead of barricade or potentially hazardous condition. Postings are required on both sides of the roadway on divided highways and singly on two-lane, two-way highways.
Sign "D": SD13-2 - This sign shall be placed to mark the beginning of a Project of more than 2 miles in extent, where traffic is maintained through the project. It shall be placed singly and near the beginning of construction.
Sign "E": SD13-3 - This sign shall be placed to mark the end of the Project. It shall be placed singly and may be placed opposite barricade if desirable.
Sign "F": Construction identification signs shall be furnished and installed by the Department on all Federal-Aid and Forest Highway Projects where actual construction is in progress and visible to highway users. These signs should be located so as not to obscure or detract from the effectiveness of other official signs. Where two or more projects are contiguous the appropriate data may be included in one set of signs. Refer to appropriate "M" Standard (Identification Signs) for sign details.
Signs A through F shall be furnished, installed and maintained by the Department.
22. When Flags are used in lieu of the Flagman Sign, they shall be a minimum of 18"x18", made of a good grade of bright red material, and fastened securely to a staff of approximately 3 foot length. The free edge should be weighted to insure that the flag will hang vertically, even in heavy winds.
- (R-1) 23. Each timber post shall be provided with a single hole drilled through the neutral axis normal to the roadway 3" above the ground level. The holes shall be 1 1/4" Ø for 6"x6" and 1" Ø for 4"x4" timber posts. The underground portion plus 6" shall be treated with creosote.

SPECIAL NOTE: Requirements of this Standard are optional to those of Standard M-614-TA through 12-31-65. Following that date Standard M-614-TA will be obsolete.

DEPARTMENT OF HIGHWAYS
STATE OF COLORADO

TRAFFIC SIGNING
FOR HIGHWAY
CONSTRUCTION

Designed By D.R.W.
Made By J.L.S.
Checked By J.B.
Approved By [Signature]
Traffic Engineer
Date AUGUST 9, 1965