


TITLE SHEET

CONVENTIONAL SIGNS

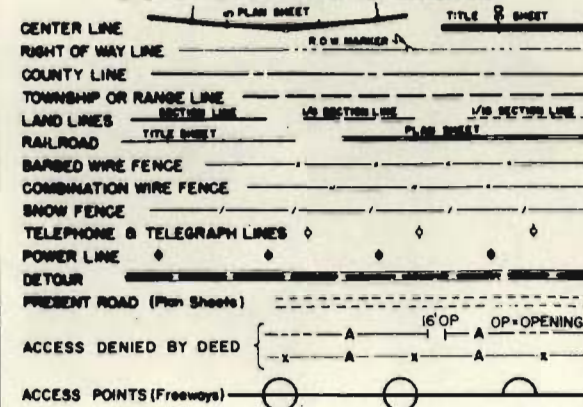

COLORADO DEPARTMENT OF HIGHWAYS

PLAN AND PROFILE OF PROPOSED FEDERAL AID PROJECT NO. ~~CS 02 0050 01~~ F 050-3 (5) Sec. I STATE HIGHWAY NO. 50A PUEBLO COUNTY

FEDERAL ROAD REGION NO.	DIVISION	PROJ. NO.	SHEET NO.	TOTAL SHEETS
8	COLORADO	F 050-3(5) Sec. I	1	17

REVISIONS	

RIGHT OF WAY
PUEBLO - WEST

INDEX OF SHEETS


- SHEET NO. 1 TITLE SHEET
2 TABULATION OF PROPERTIES
3-14 LINE SHEETS
15-17 OWNERSHIP MAPS

SCALES OF ORIGINAL DRAWINGS

ON PLAN 1 IN 100 FT
ON PROFILE 1 IN 100 FT HORIZONTAL
1 IN 10 FT VERTICAL
GRADE LINE ON PROFILE IS SHOWN AS GRADE OF FINISHED ROAD

NET LENGTH OF PROJECT = 6.35 MILES

RIGHT OF WAY

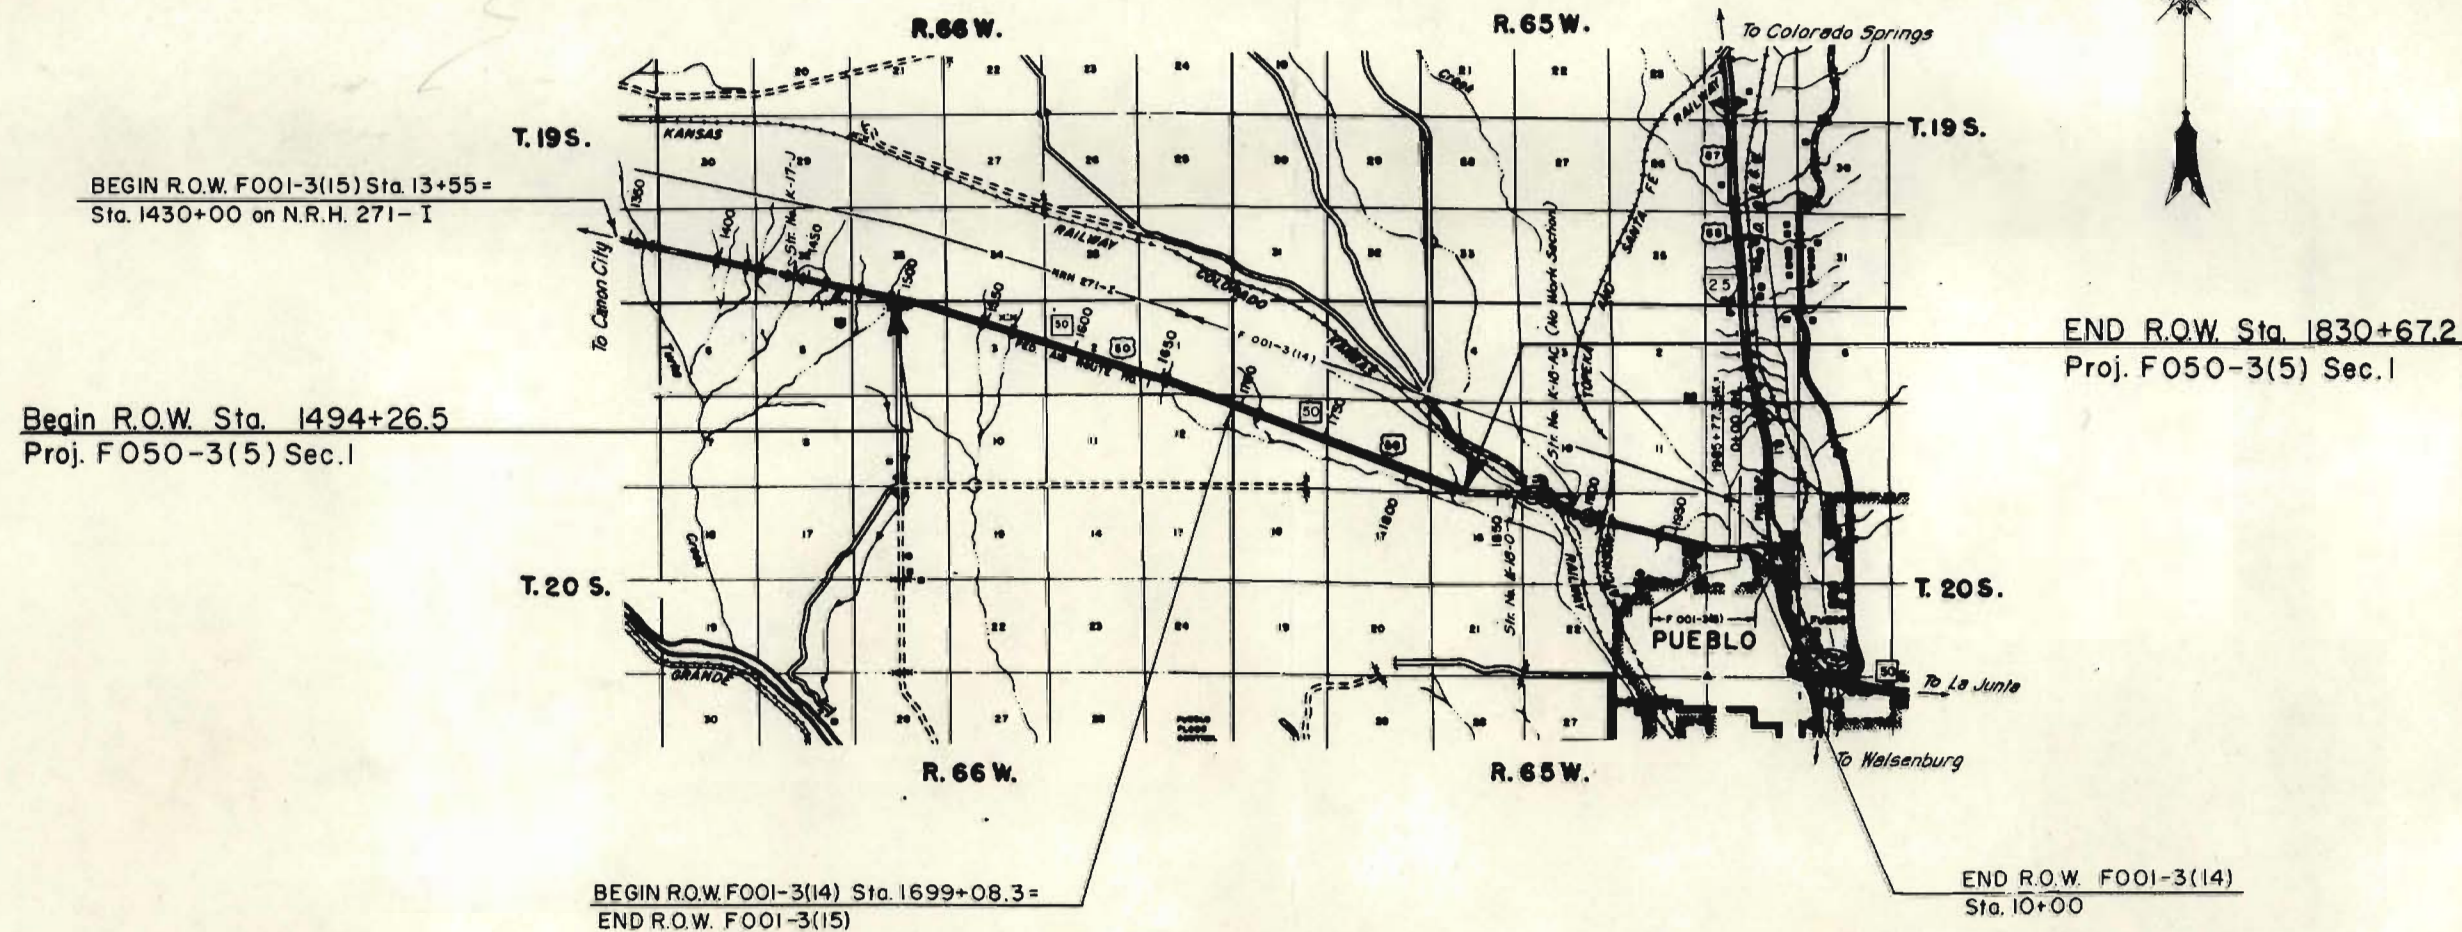

SCALE OF MILES



FILE COPY
DO NOT REMOVE

R. O. W. TABULATION OF PROPERTIES IN PUEBLO

COUNTY

S.H. No. 50


PROJ.

~~CS 02-0050-01~~
F 050-3(5)Section 1

FEDERAL ROAD DIVISION NO.	DISTRICT	PROJ. NO.	SHEET NO.	TOTAL SHEETS
8	COLORADO	F 050-3(5)Sec. 1	2	17

RIGHT OF WAY: PUEBLO - WEST

PARCEL NO.	OWNER	ADDRESS	LOCATION	AREA IN ACRES			PURCHASE DATA					REMARKS	NO.
				PARCEL	TO BE ACQUIRED	REMAINDER	LAND	IMPROVEMENTS	DAMAGE	MISC.	TOTAL		
			T.20 S. R.66 W. 6th PM.										
73 A	McCULLOCH PROPERTIES INC.		N 1/2 SEC. 3	4.48	4.48								
73 B	McCULLOCH PROPERTIES INC.		NW 1/4 SEC. 3	5.41	5.41								
73 C	McCULLOCH PROPERTIES INC.		NW 1/4 SEC. 3	3.28	3.28								
74 A	McCULLOCH PROPERTIES INC.		S 1/2 SEC. 2	5.76	5.76								
74 B	McCULLOCH PROPERTIES INC.		S 1/2 SEC. 2	5.19	5.19								
74 C	McCULLOCH PROPERTIES INC.		W 1/2 SE 1/4 SEC. 2	3.16	3.16								
75 A	McCULLOCH PROPERTIES INC.		S 1/2 SEC. 2	2.78	2.78								
75 B	McCULLOCH PROPERTIES INC.		N 1/2 SE 1/4 SEC. 2	5.68	5.68								
75 C	McCULLOCH PROPERTIES INC.		NW 1/4 SE 1/4 SEC. 2	3.55	3.55								
78 A	McCULLOCH PROPERTIES INC.		S 1/2 SEC. 1	2.13	2.13								
79 A	McCULLOCH PROPERTIES INC.		N 1/2 SEC. 12	2.45	2.45								
88 A	McCULLOCH PROPERTIES INC.		NW 1/4 SEC. 4	0.68	0.68								
			T.20 S. R. 65 W.										
76 A	McCULLOCH PROPERTIES INC.		N 1/2 & SE 1/4 SEC. 7, SW 1/4 SEC. 8	4.83	4.83								
76 B	McCULLOCH PROPERTIES INC.		E 1/2 SEC. 7 & SW 1/4 SEC. 8	5.64	5.64								
76 C	McCULLOCH PROPERTIES INC.		E 1/2 SEC. 7	3.15	3.15								
77 A	McCULLOCH PROPERTIES INC.		N 1/2 & SE 1/4 Sec. 7, W 1/2 SEC. 8	2.74	2.74								
77 B	McCULLOCH PROPERTIES INC.		SE 1/4 NE 1/4 SEC. 7, & W 1/2 SEC. 8	5.10	5.10								
77 C	McCULLOCH PROPERTIES INC.		SE 1/4 NE 1/4 SEC. 7	3.55	3.55								
188 A	McCULLOCH PROPERTIES INC.		SW 1/4 SEC. 8	0.67	0.67								
188 B	McCULLOCH PROPERTIES INC.		S 1/2 SEC. 8	3.06	3.06								
188 C	McCULLOCH PROPERTIES INC.		SW 1/4 SEC. 9	1.25	1.25								

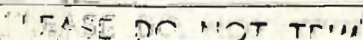[illegible]


"73-A"
"73-B" McCULLOCH PROPERTIES INC.
"73-C"

SE 1/4 SEC. 33
T. 19 S., R. 66 W.


FEDERAL ROAD REGION NO.	DIVISION	PROJ. NO.	SHEET NO.	TOTAL SHEETS
8	COLORADO	05-02-0000-01 F 050-3(5) Sec. 1	4	17

REVISIONS


REVISION

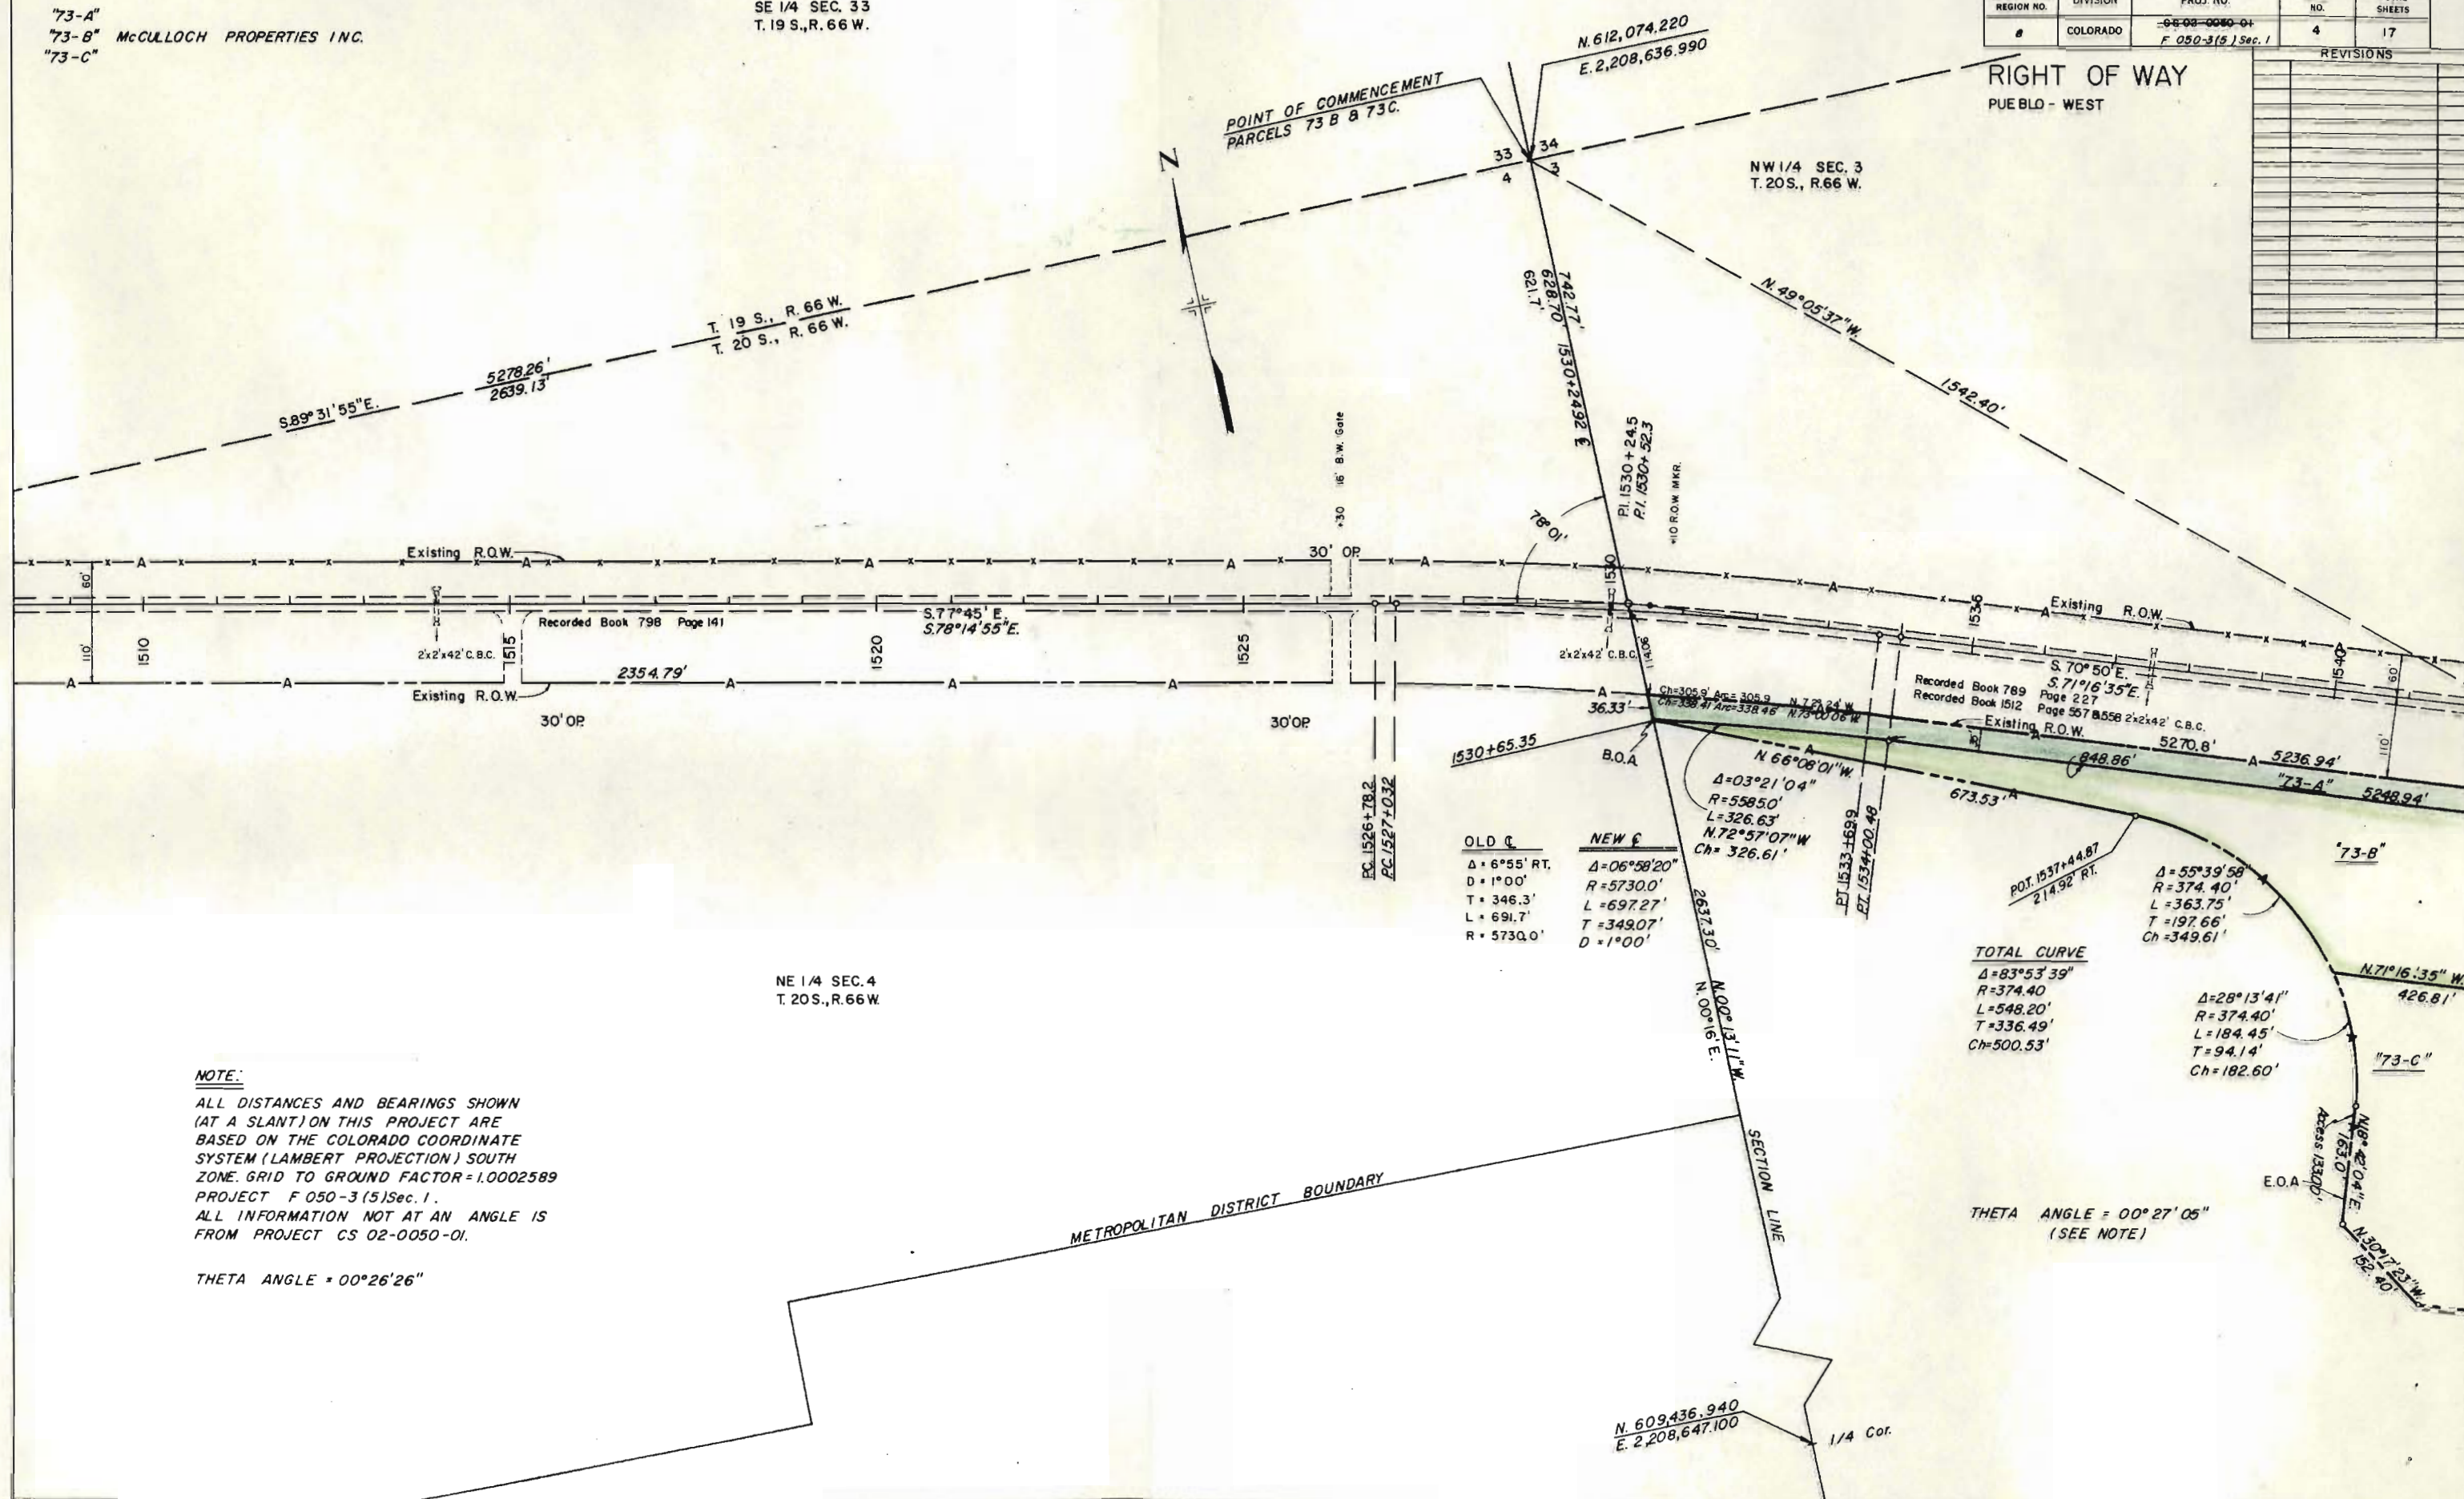


REVISIONS

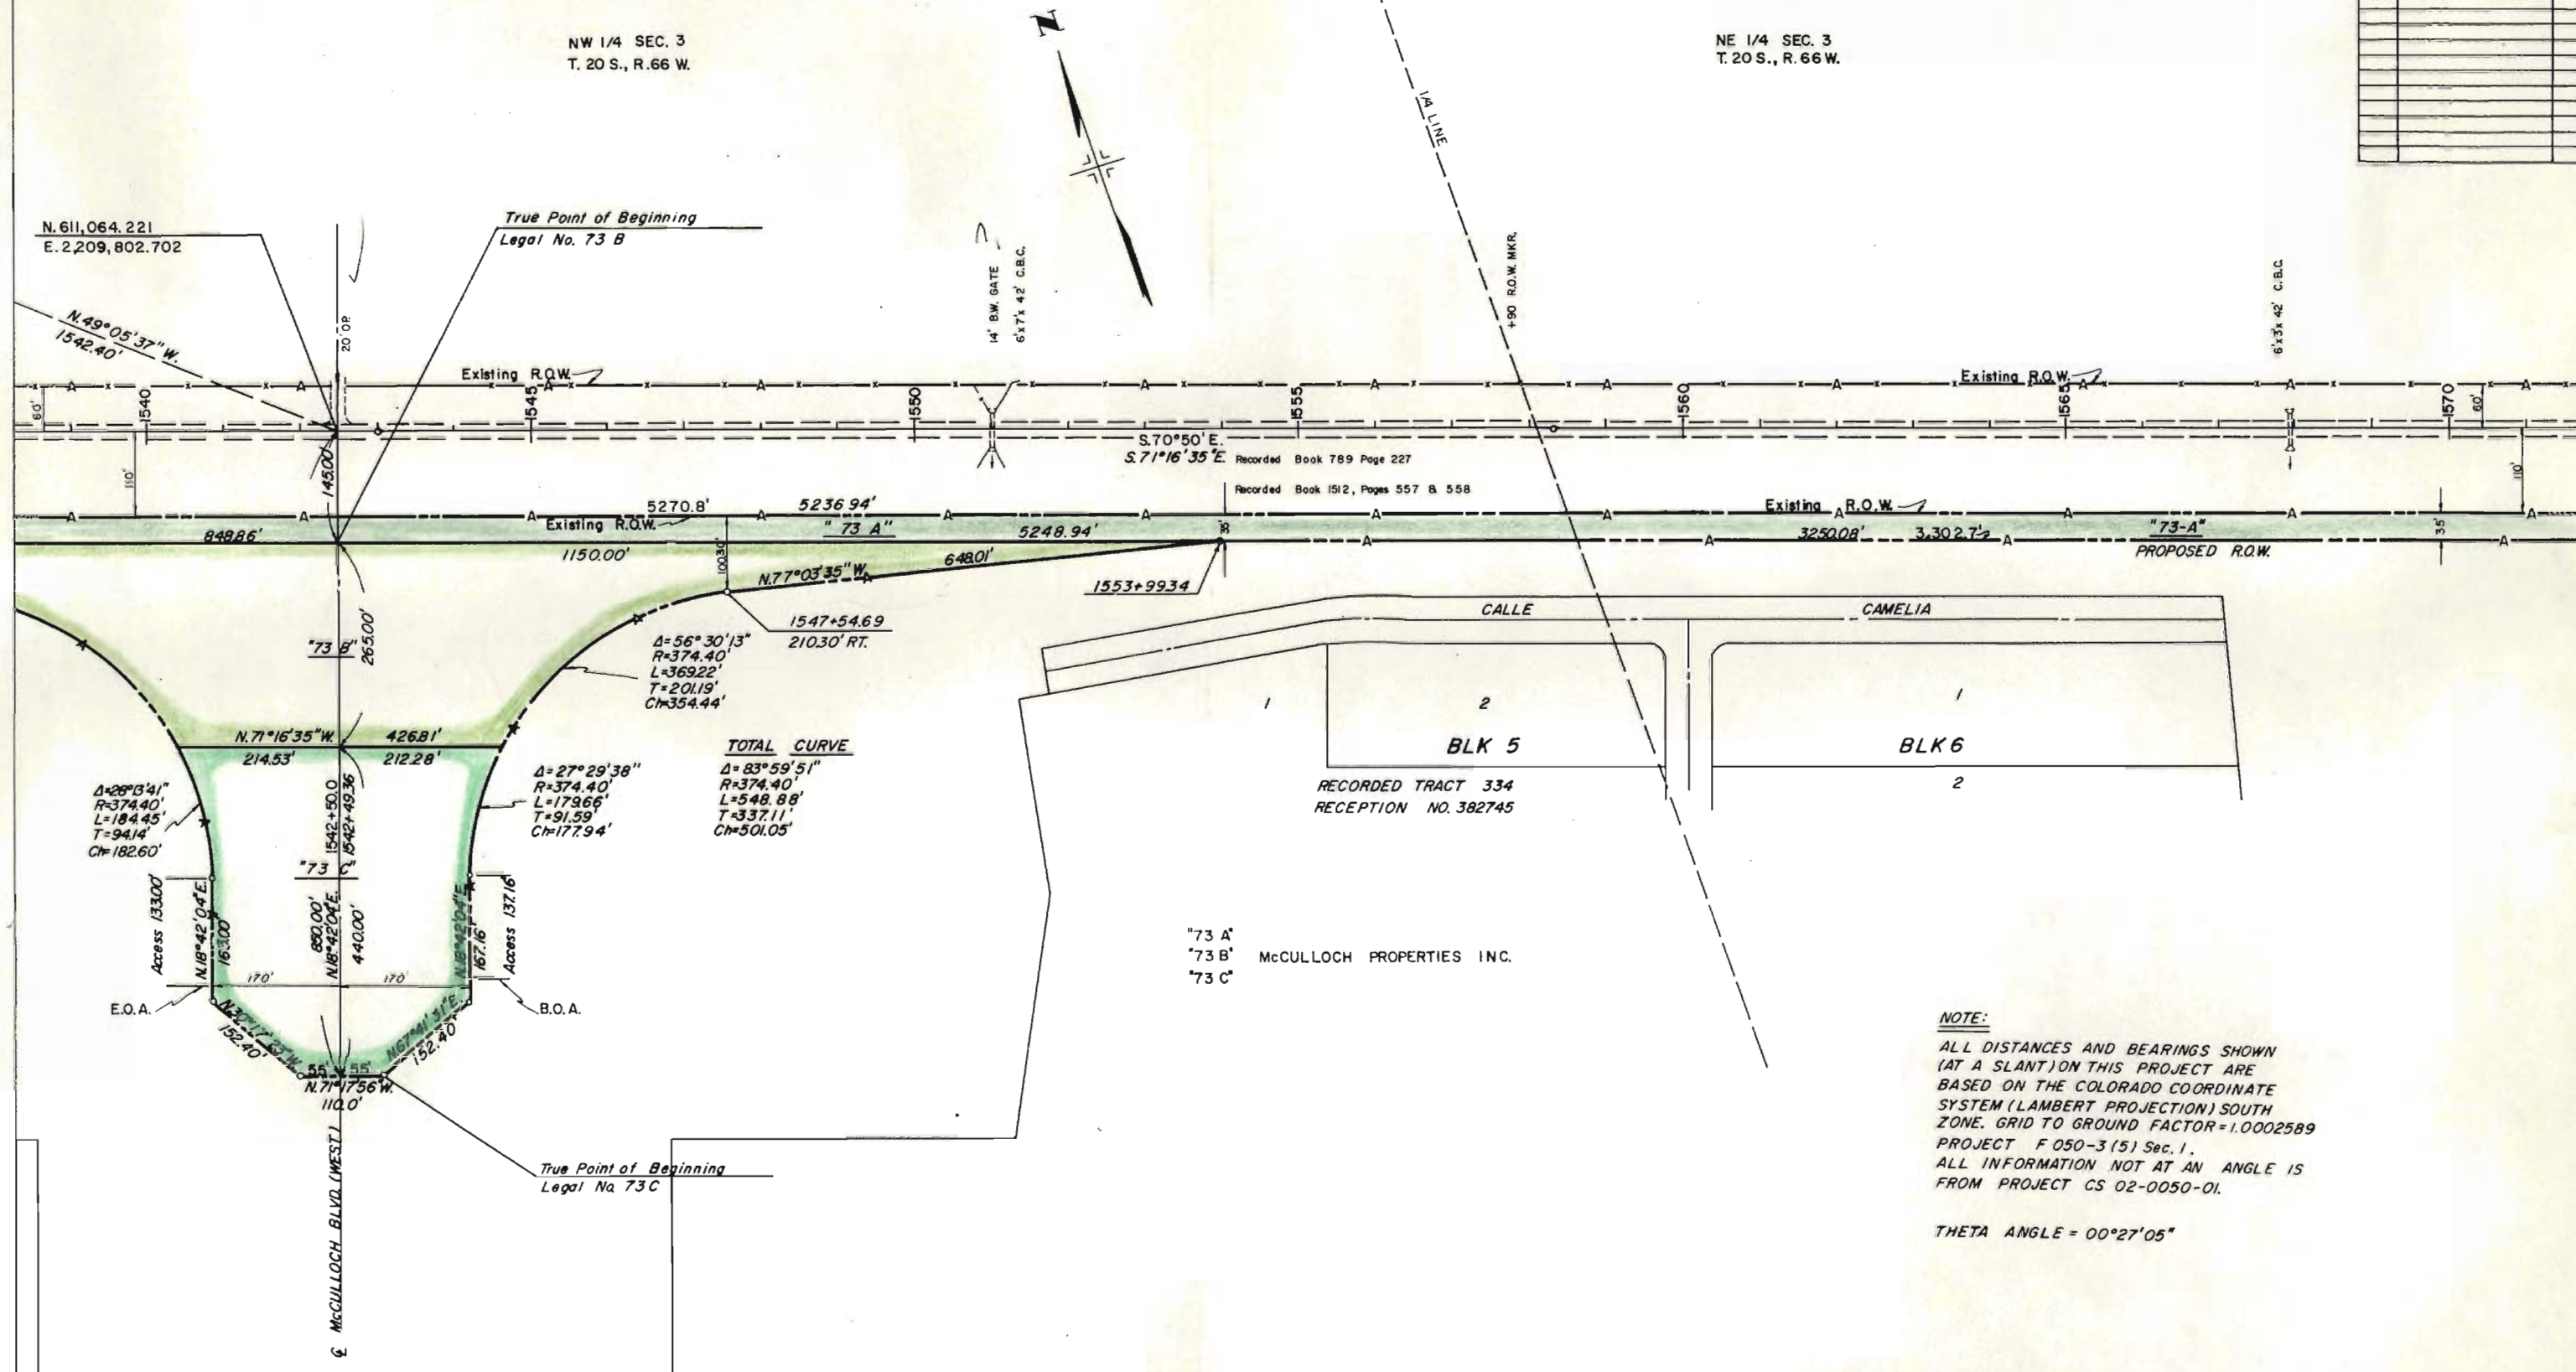[illegible]

RIGHT OF WAY	REVISIONS
PUEBLO WEST	

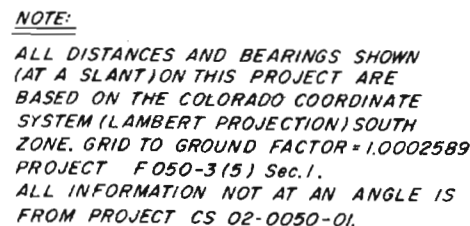


THETA ANGLE= 00°27'05"

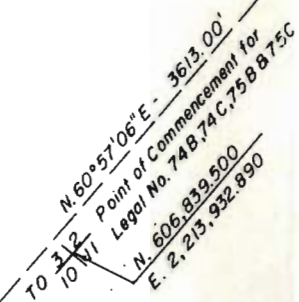[illegible]

REVISIONS	
-----------	--


REVISIONS

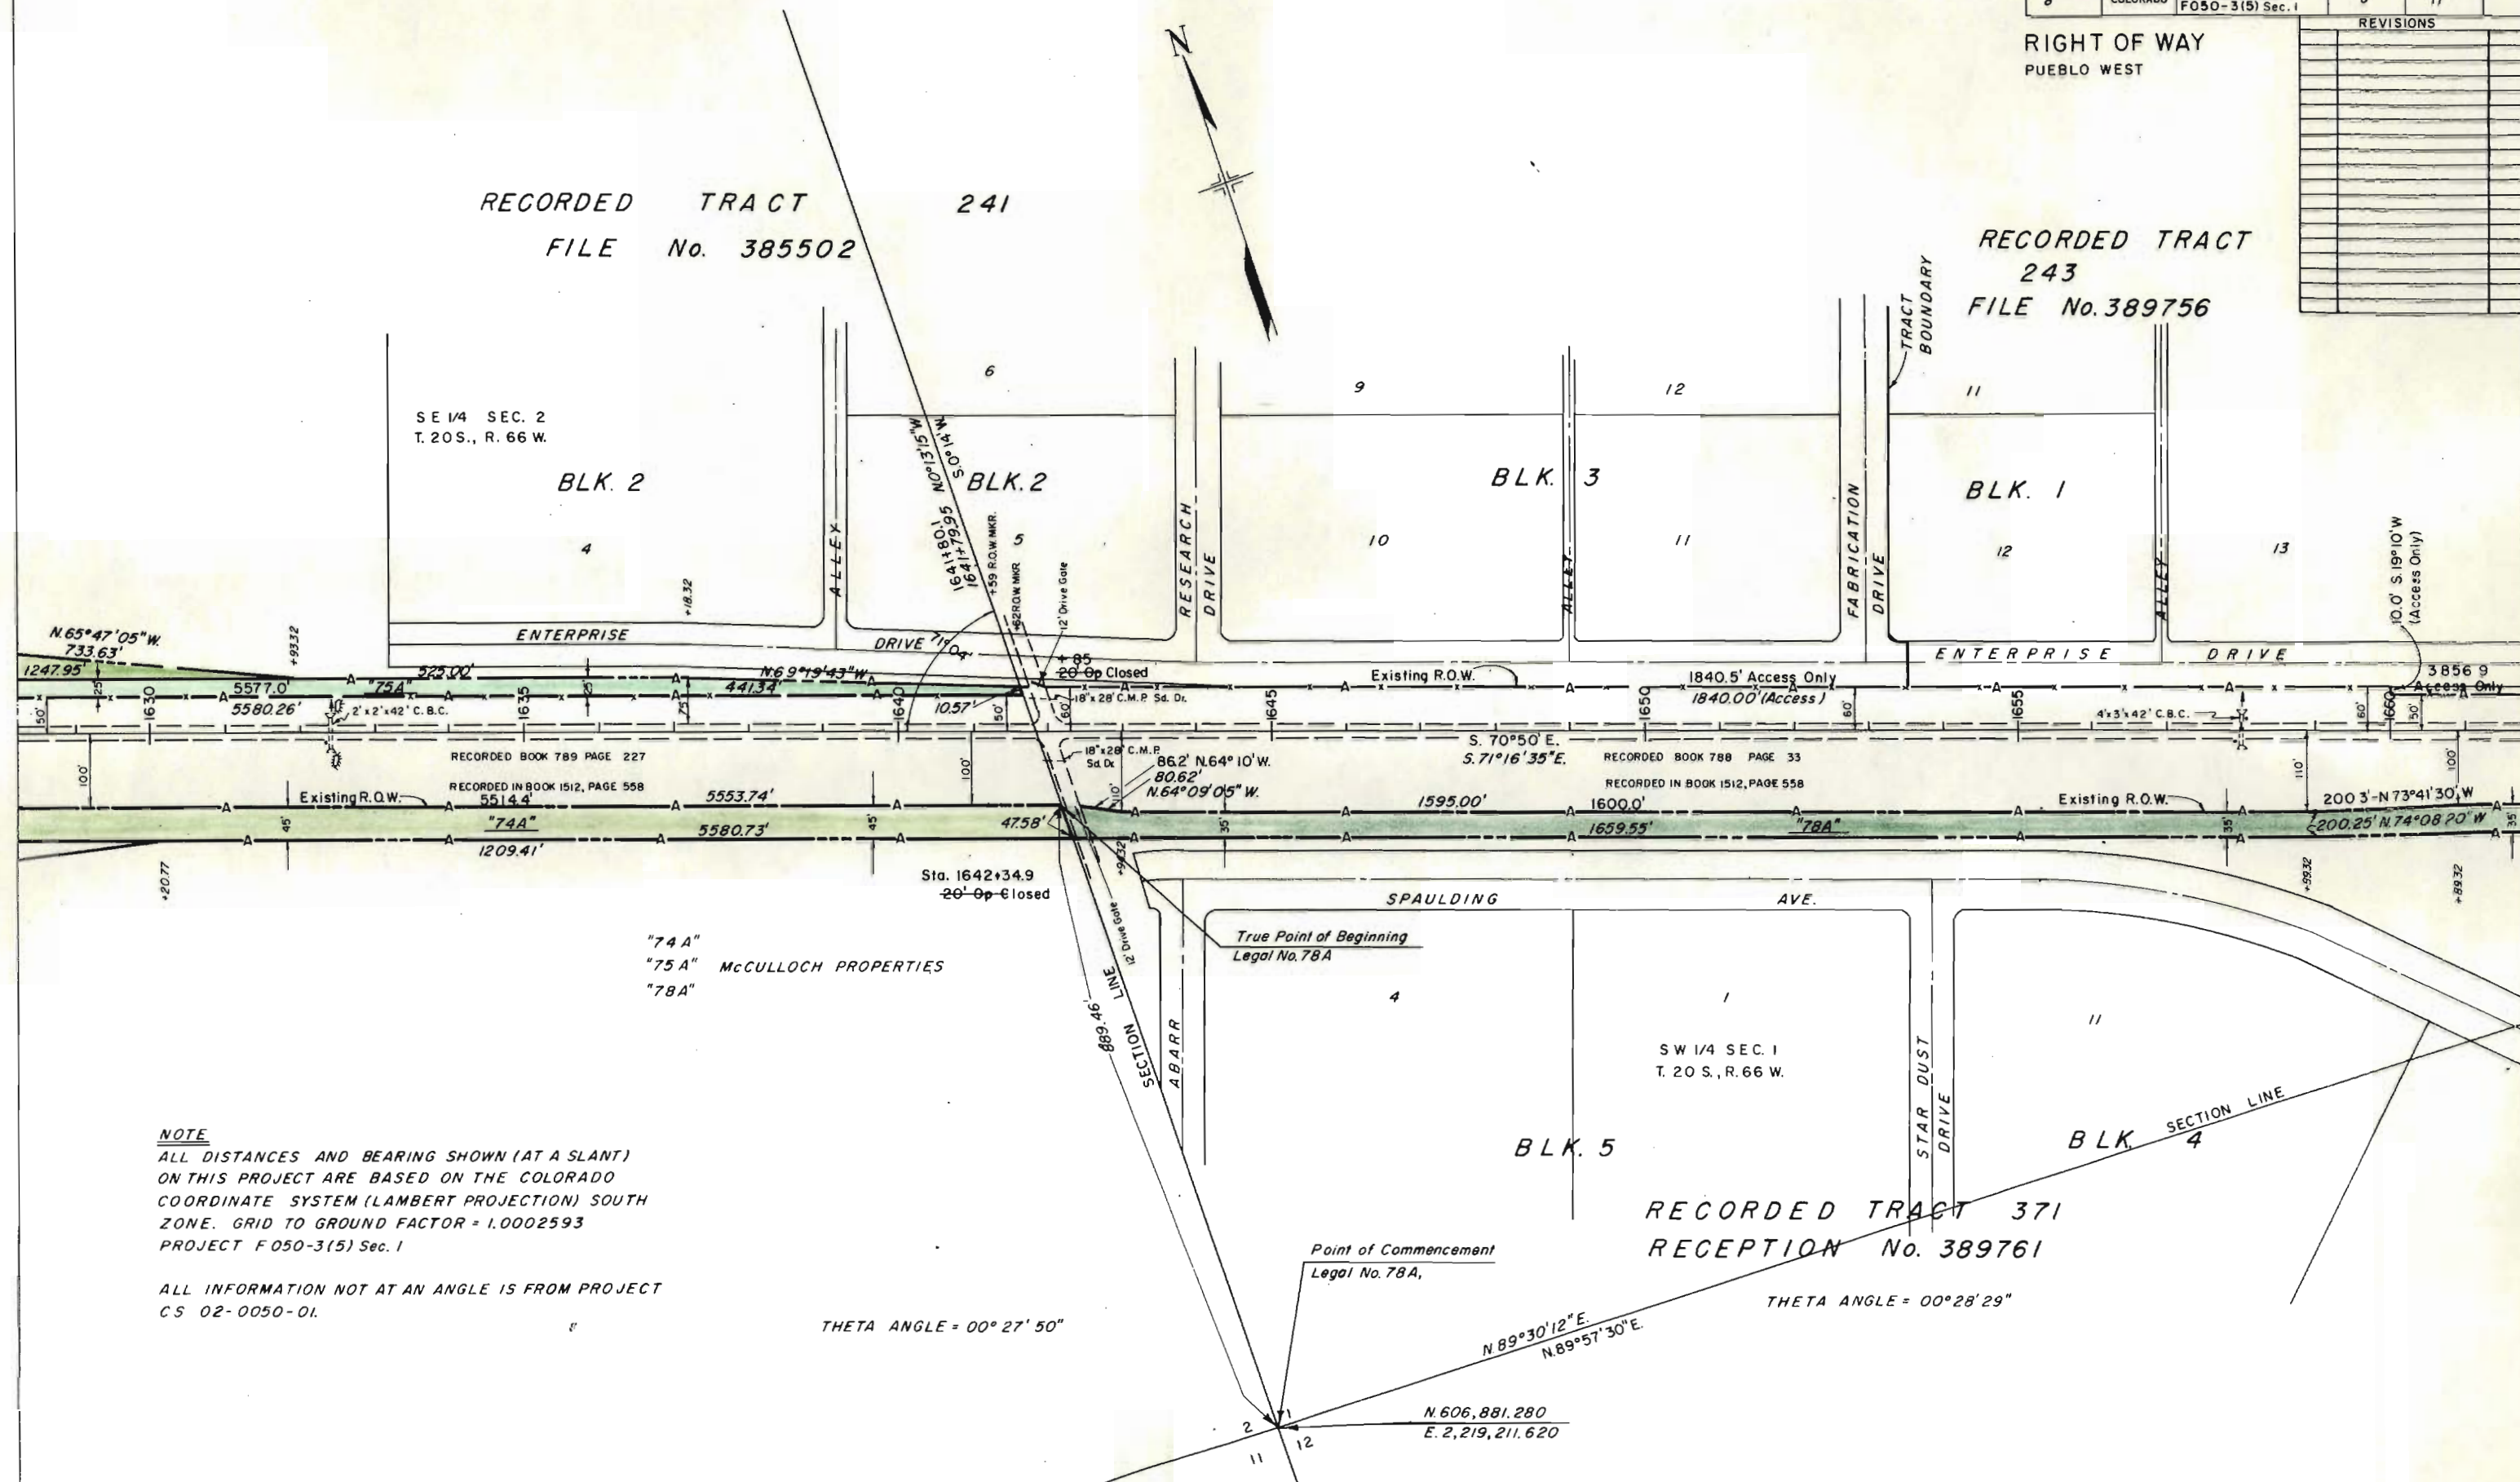[illegible]



FEDERAL ROAD REGION NO.	DIVISION	PROJ. NO.	SHEET NO.	TOTAL SHEETS
8	COLORADO	CS 02-0050-01 F 050-3(5) Sec. 1	9	17

RIGHT OF WAY
PUEBLO WEST

REVISIONS

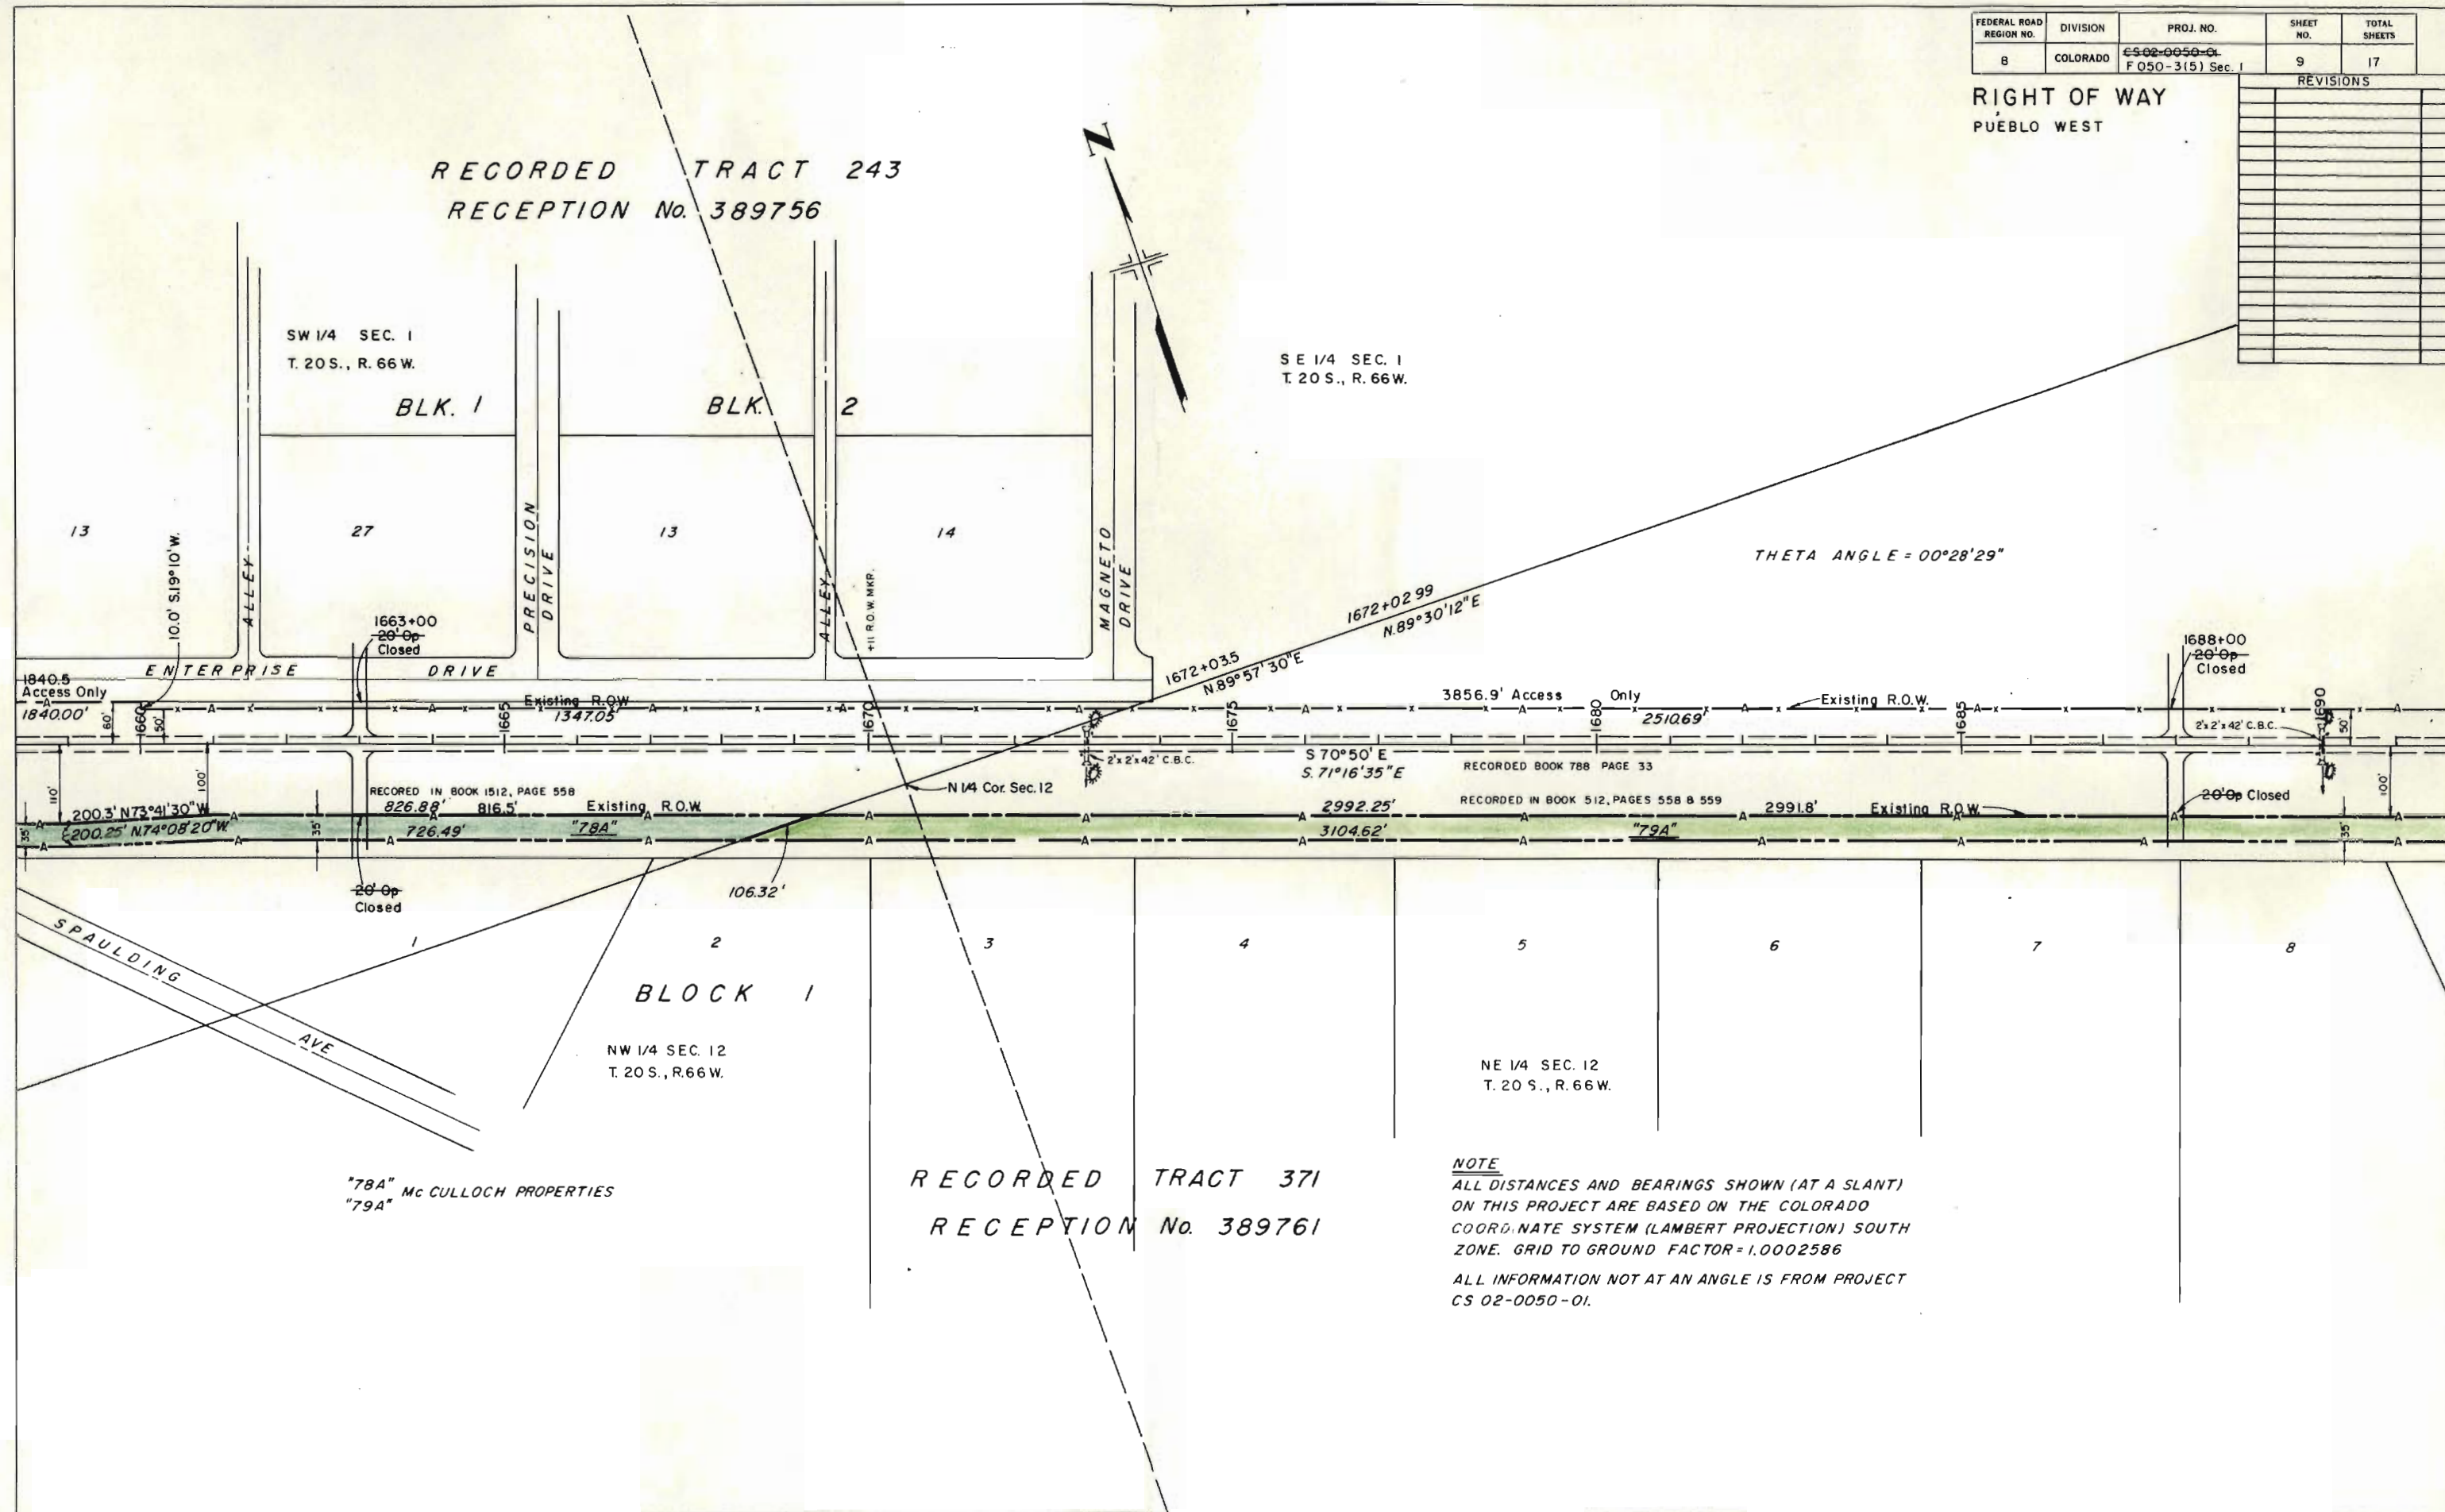


REVISIONS

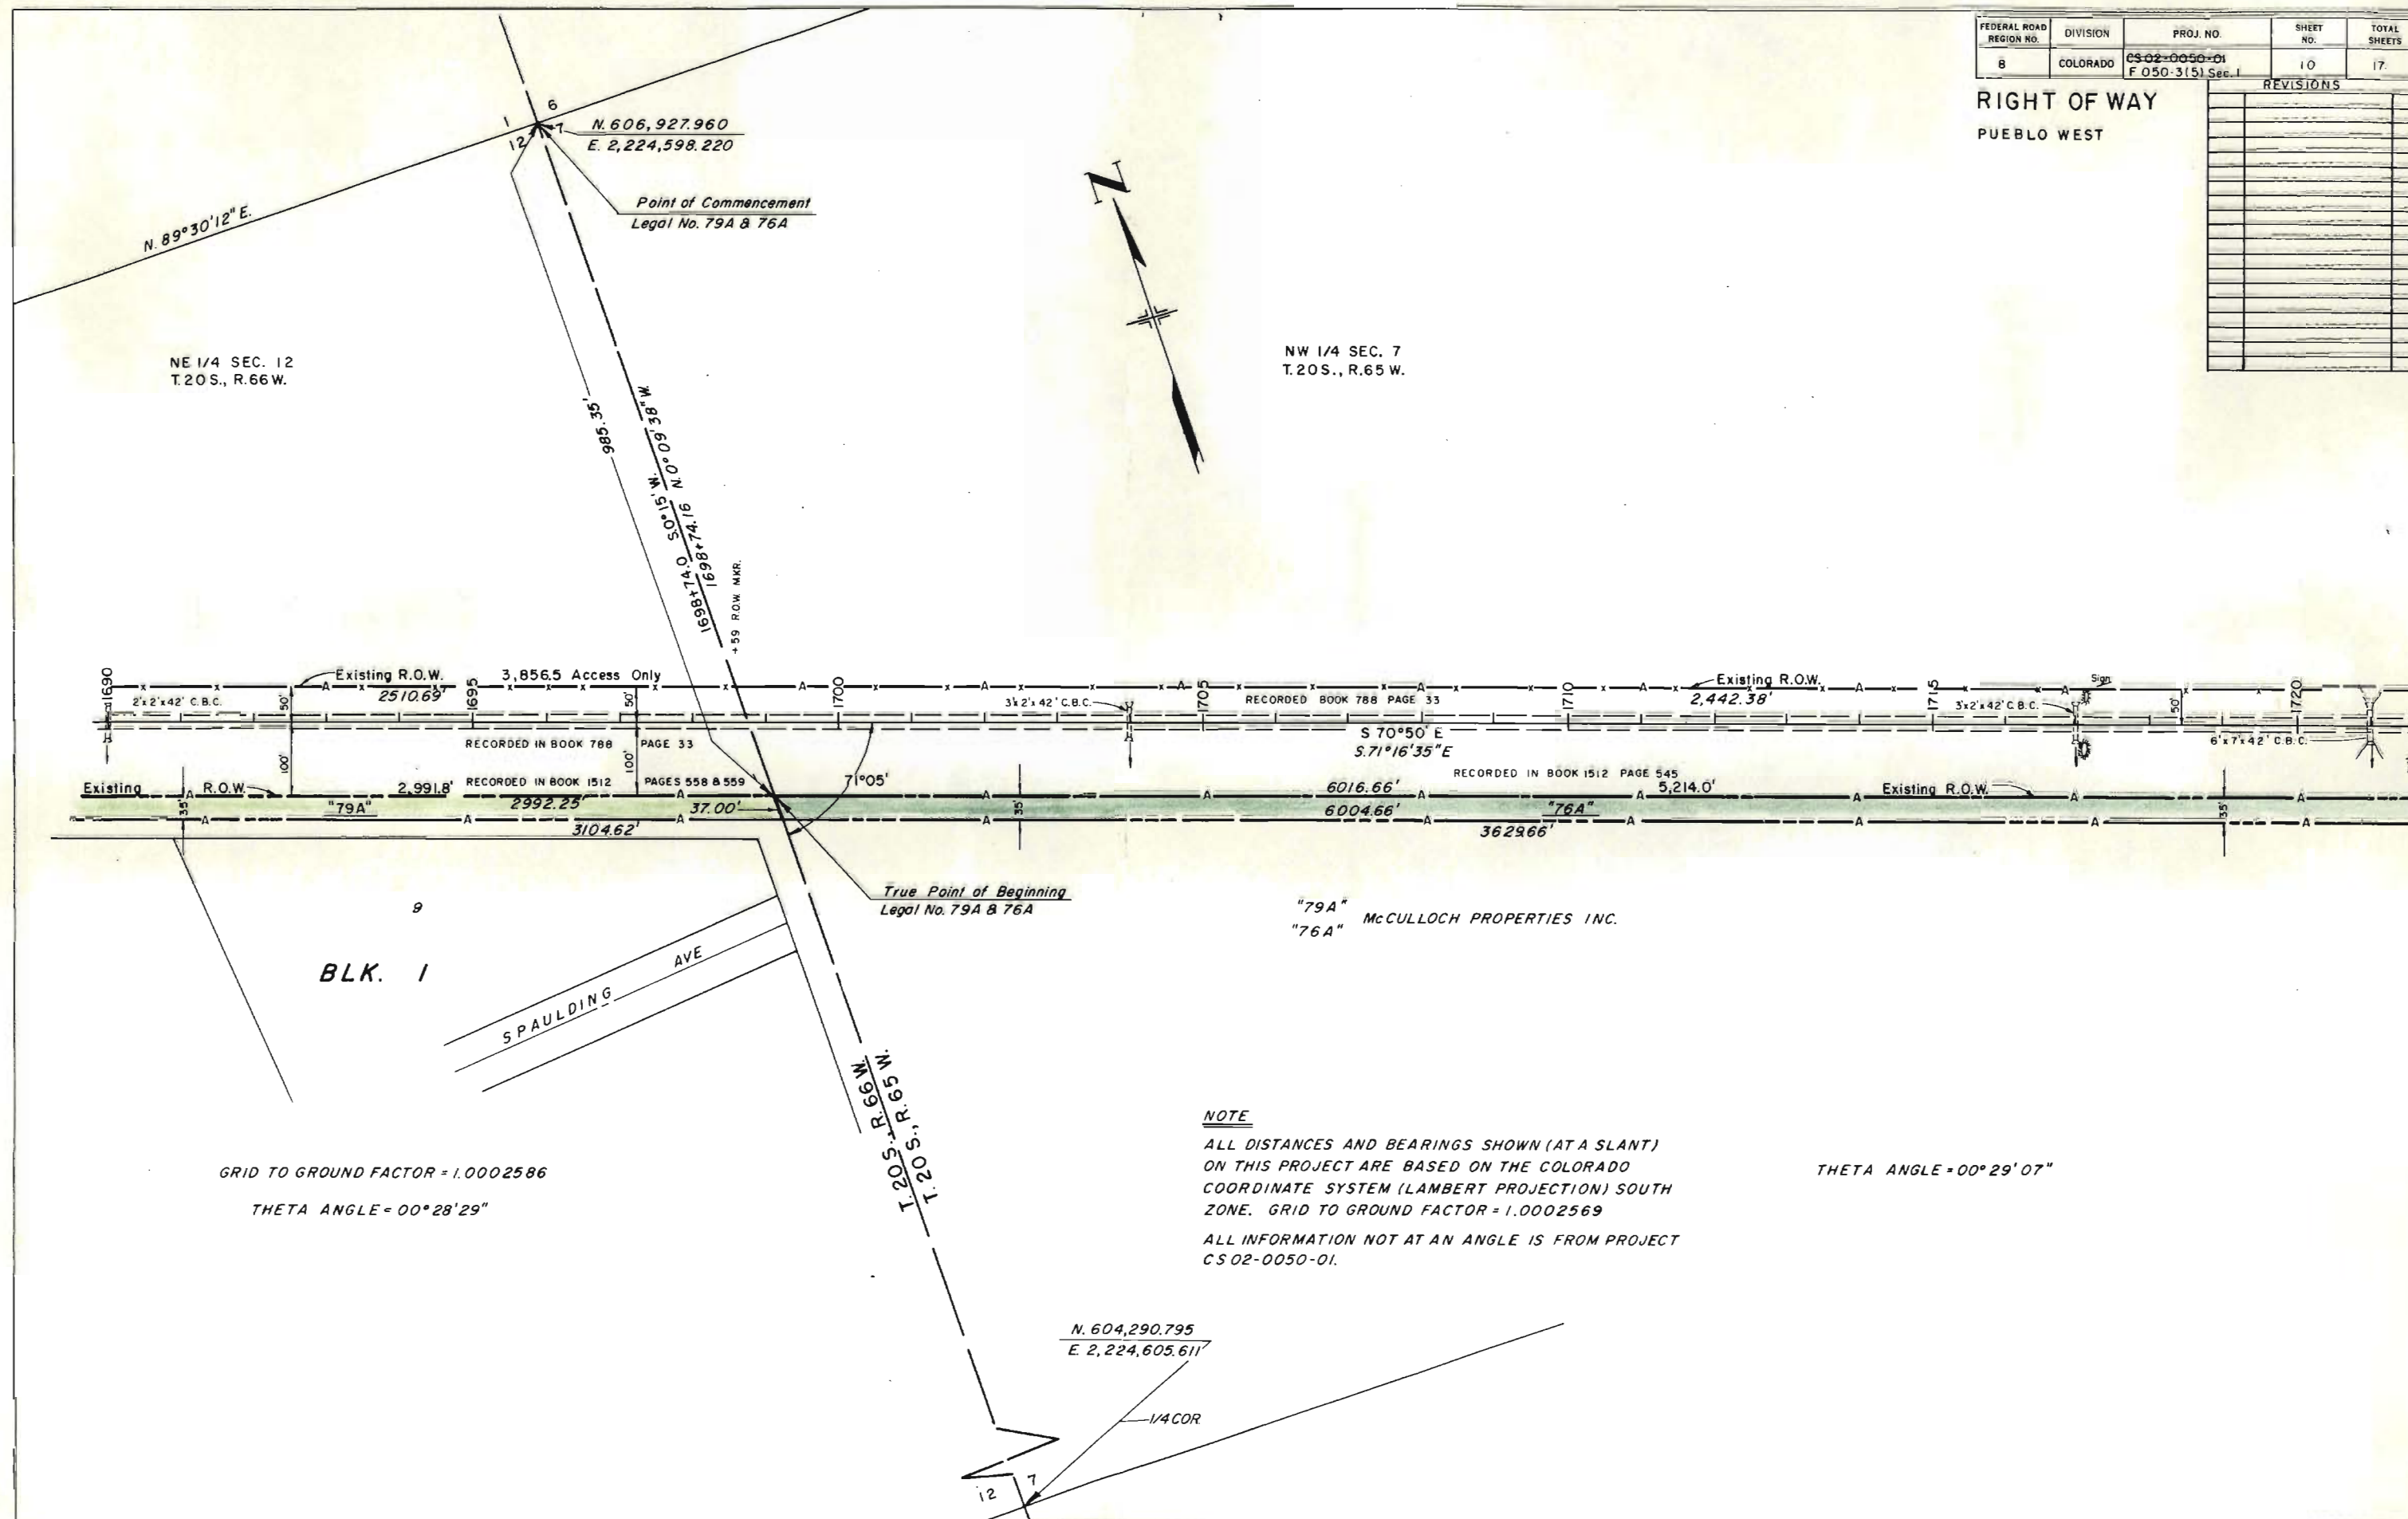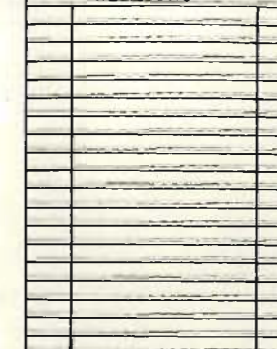

[illegible]


FEDERAL ROAD REGION NO.	DIVISION	PROJ. NO.	SHEET NO.	TOTAL SHEETS
8	COLORADO	C 02-0050-01 F 050-3(5) Sec. 1	11	17


RIGHT OF WAY
PUEBLO WEST

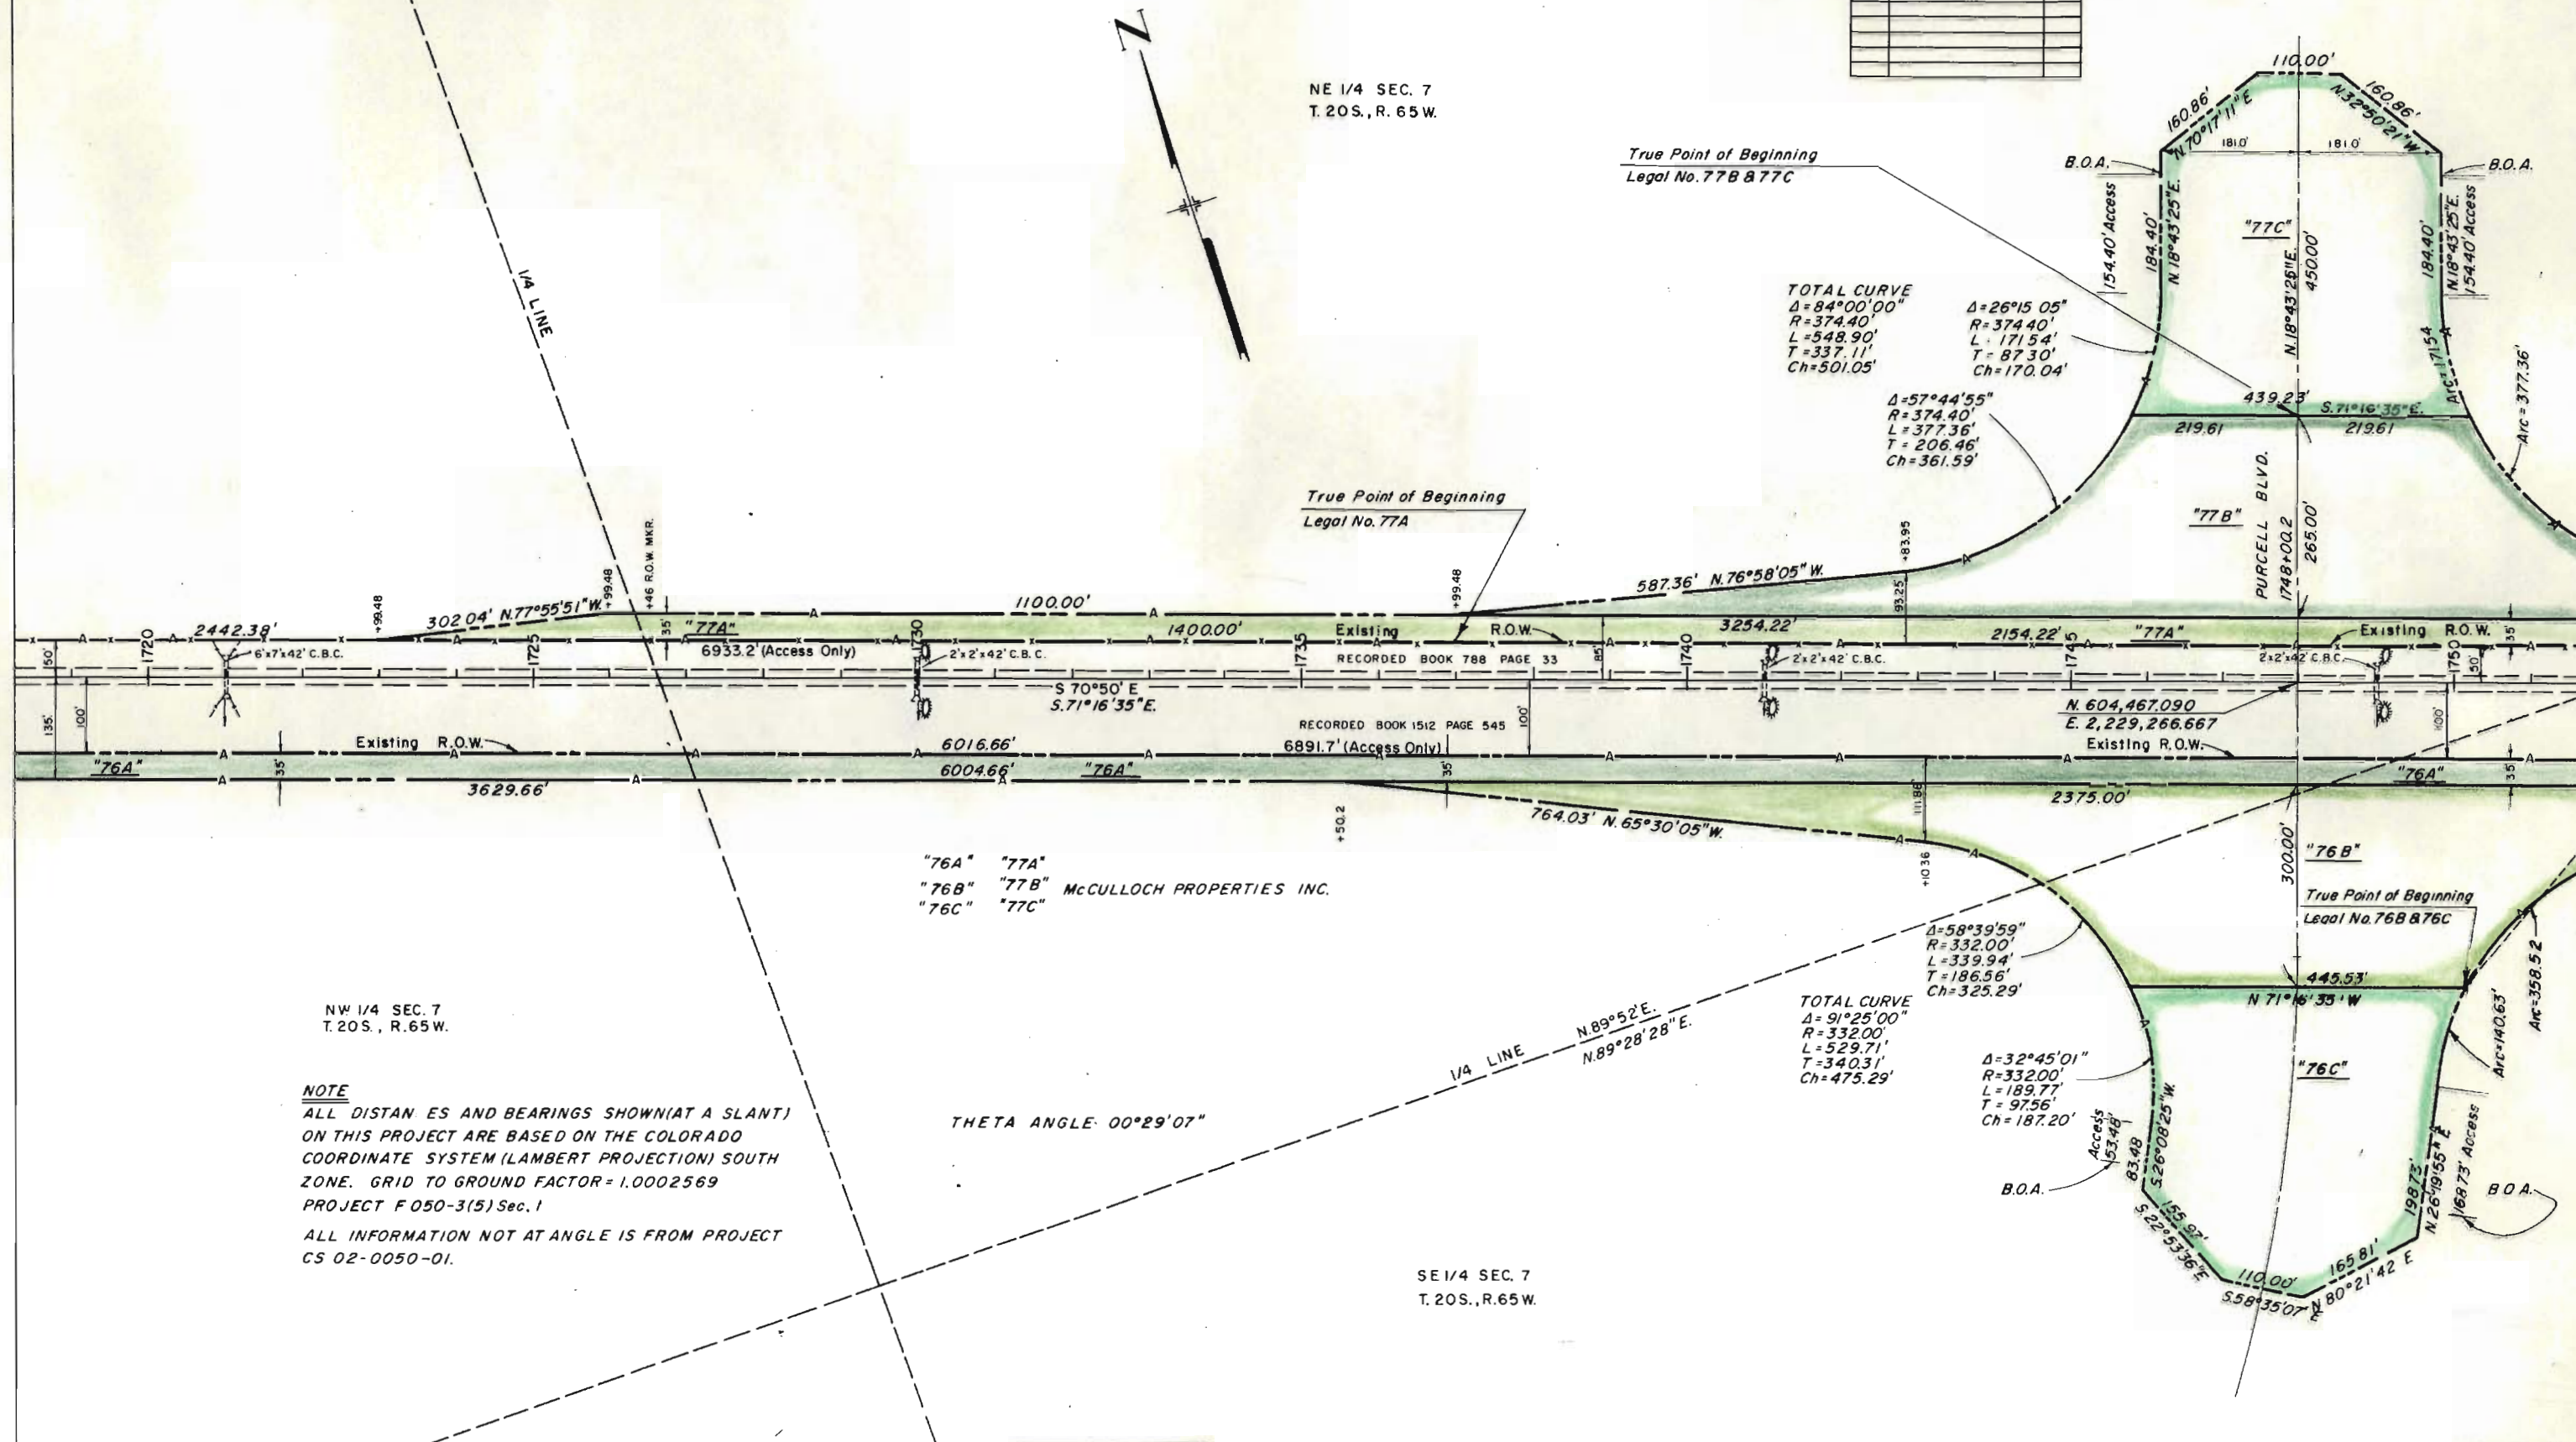

FEDERAL ROAD REGION NO.	DIVISION	PROJ. NO.	SHEET NO.	TOTAL SHEETS
8	COLORADO	CS-02-0050-01 FO50-3(5)Sec.1	12	17

RIGHT OF WAY
PUEBLO WEST

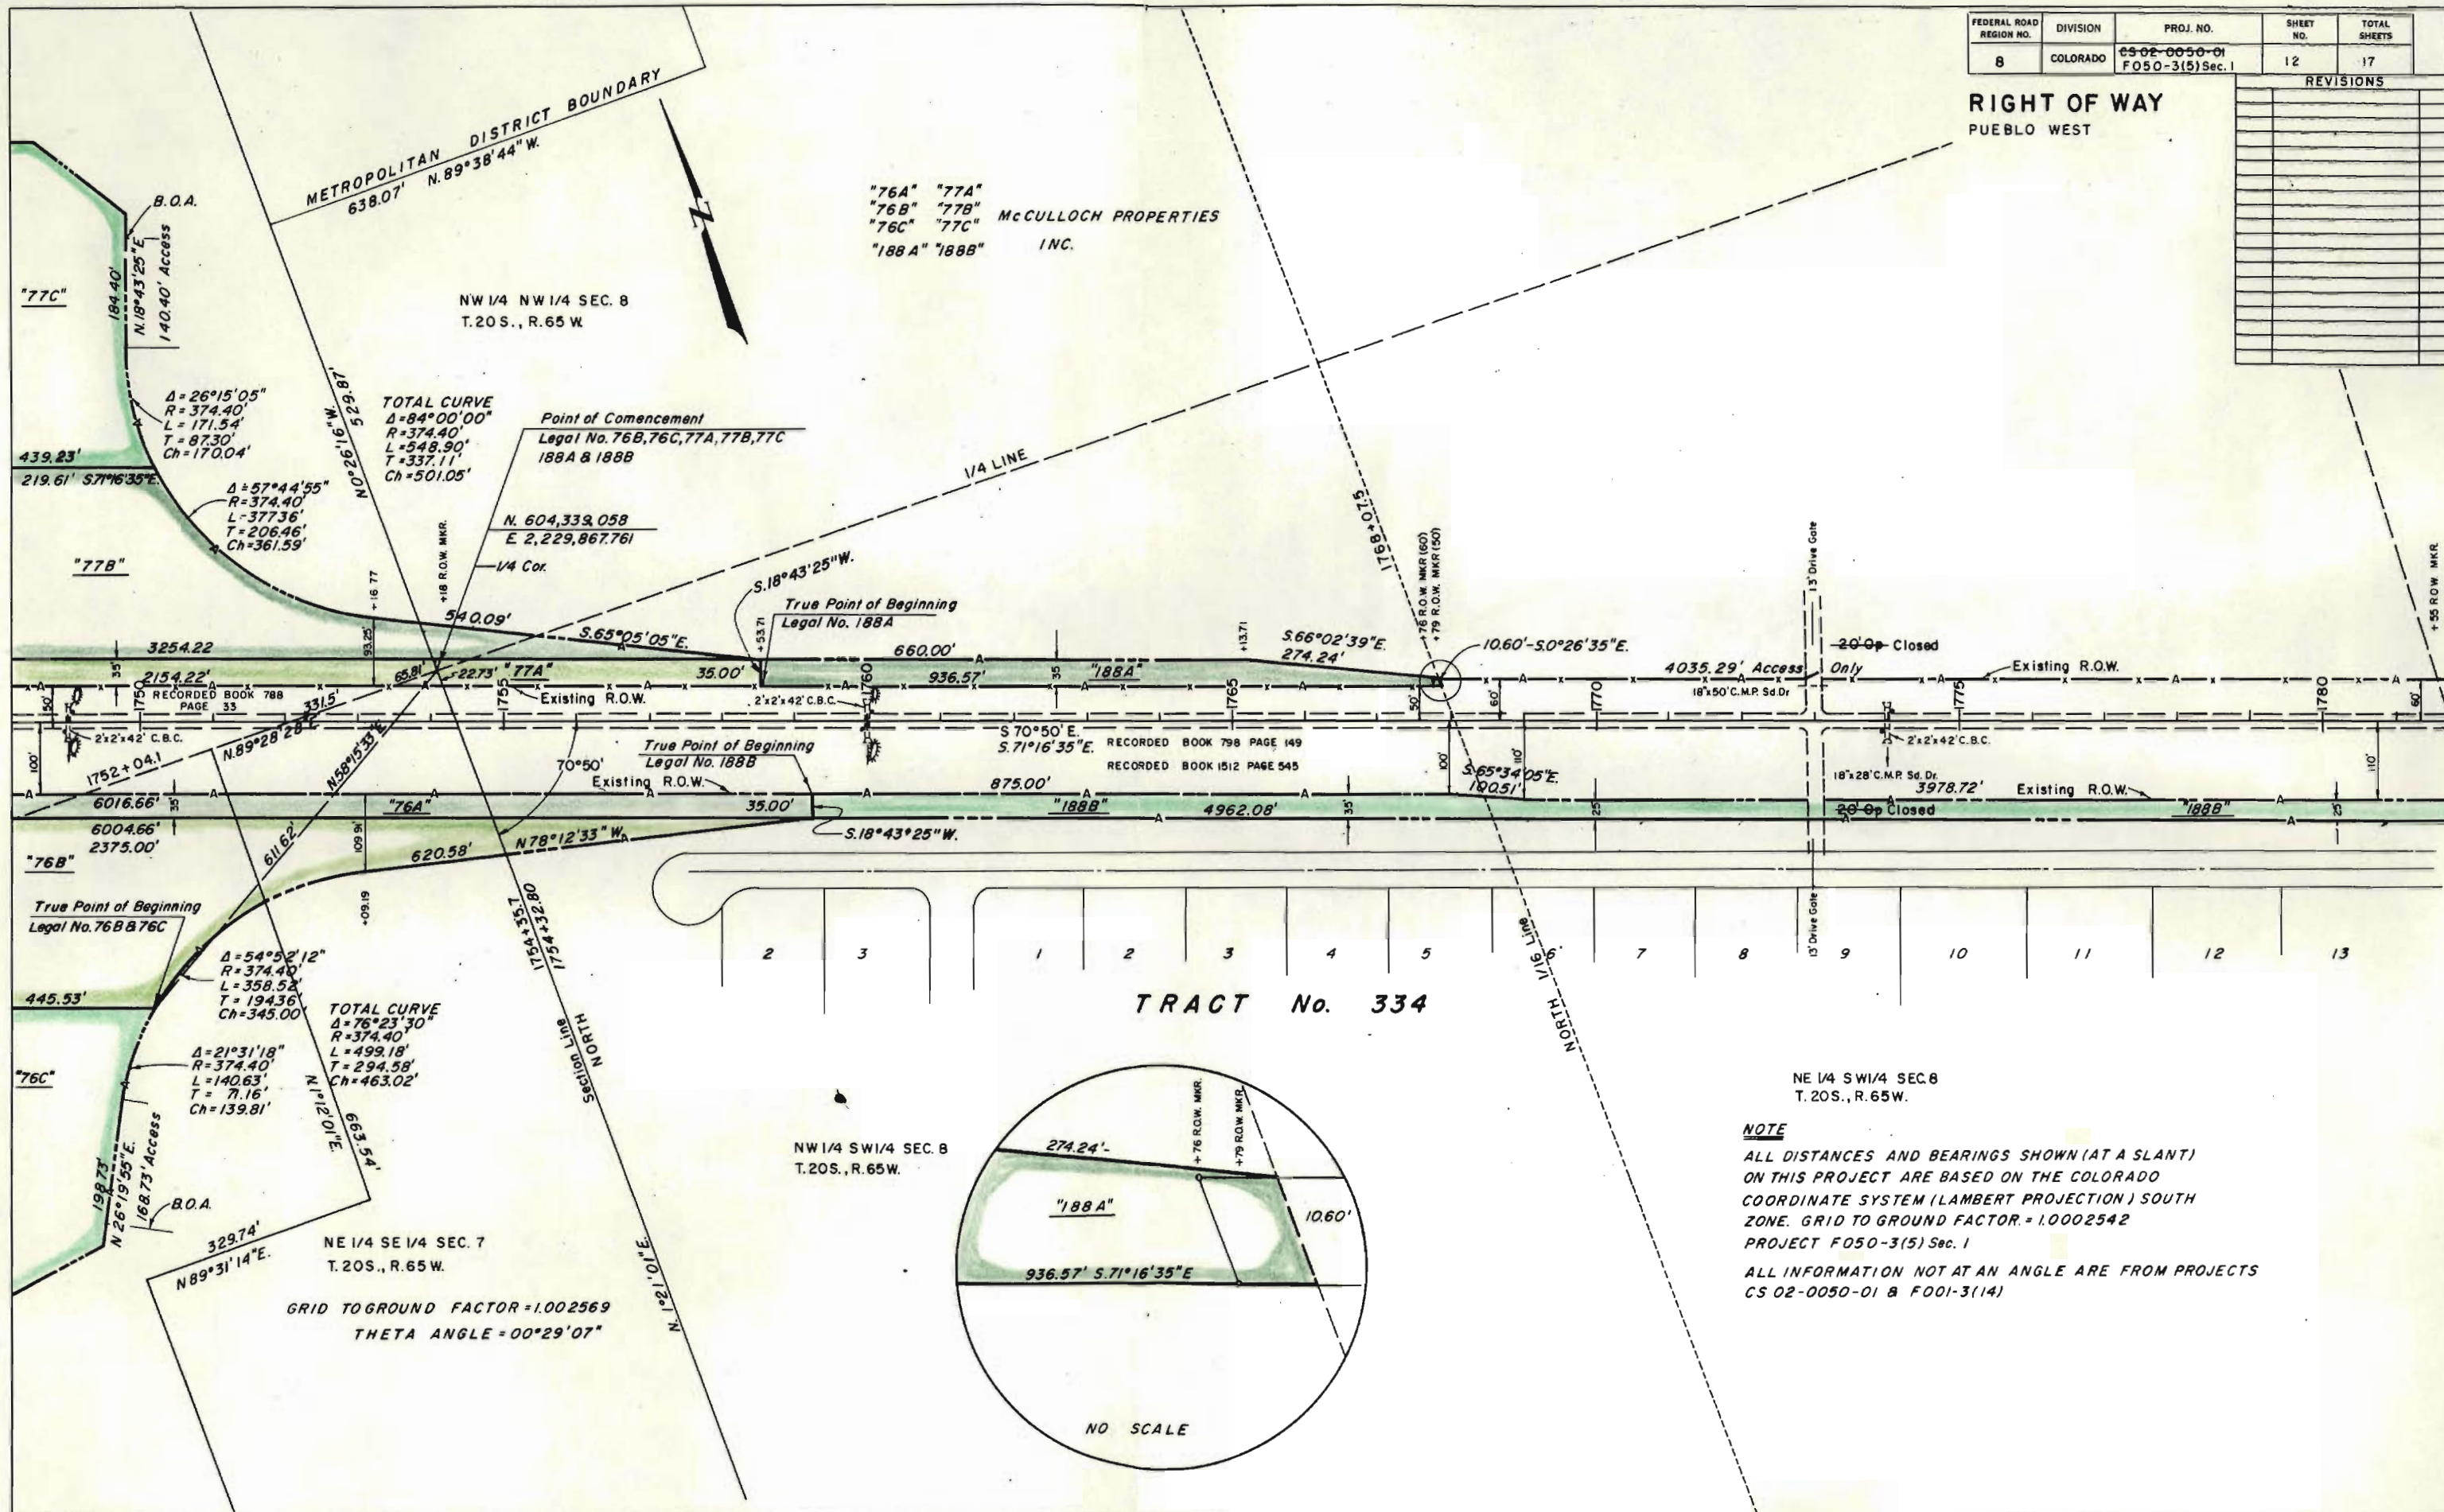[illegible]

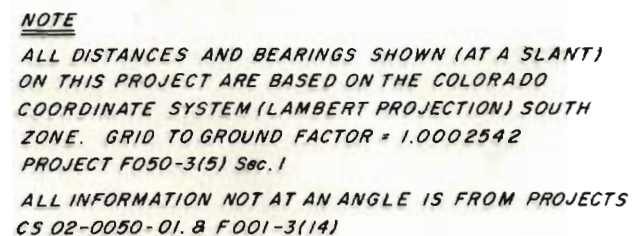

[illegible]

ALL DISTANCES AND BEARINGS SHOWN (AT A SLANT)
ON THIS PROJECT ARE BASED ON THE COLORADO
COORDINATE SYSTEM (LAMBERT PROJECTION) SOUTH
ZONE. GRID TO GROUND FACTOR= 1.0002542
PROJECT F050-3(5) Sec.1


ALL INFORMATION NOT AT AN ANGLE ARE FROM PROJECTS
CS 02-0050-01 & F001-3(14)

FEDERAL ROAD DIVISION NO.	DISTRICT	PROJ. NO.	SHEET NO.	TOTAL SHEETS
8	COLORADO	48-58-0000-01 F 0 50-3 (5) Sec. 1	15	17

RIGHT OF WAY OWNERSHIP MAP PLAT

SHOWING CLAIMANTS WITH
REGARD TO RIGHT OF WAY
FOR PROJECT
ORIGINAL SCALE 1" = 400'

REVISIONS

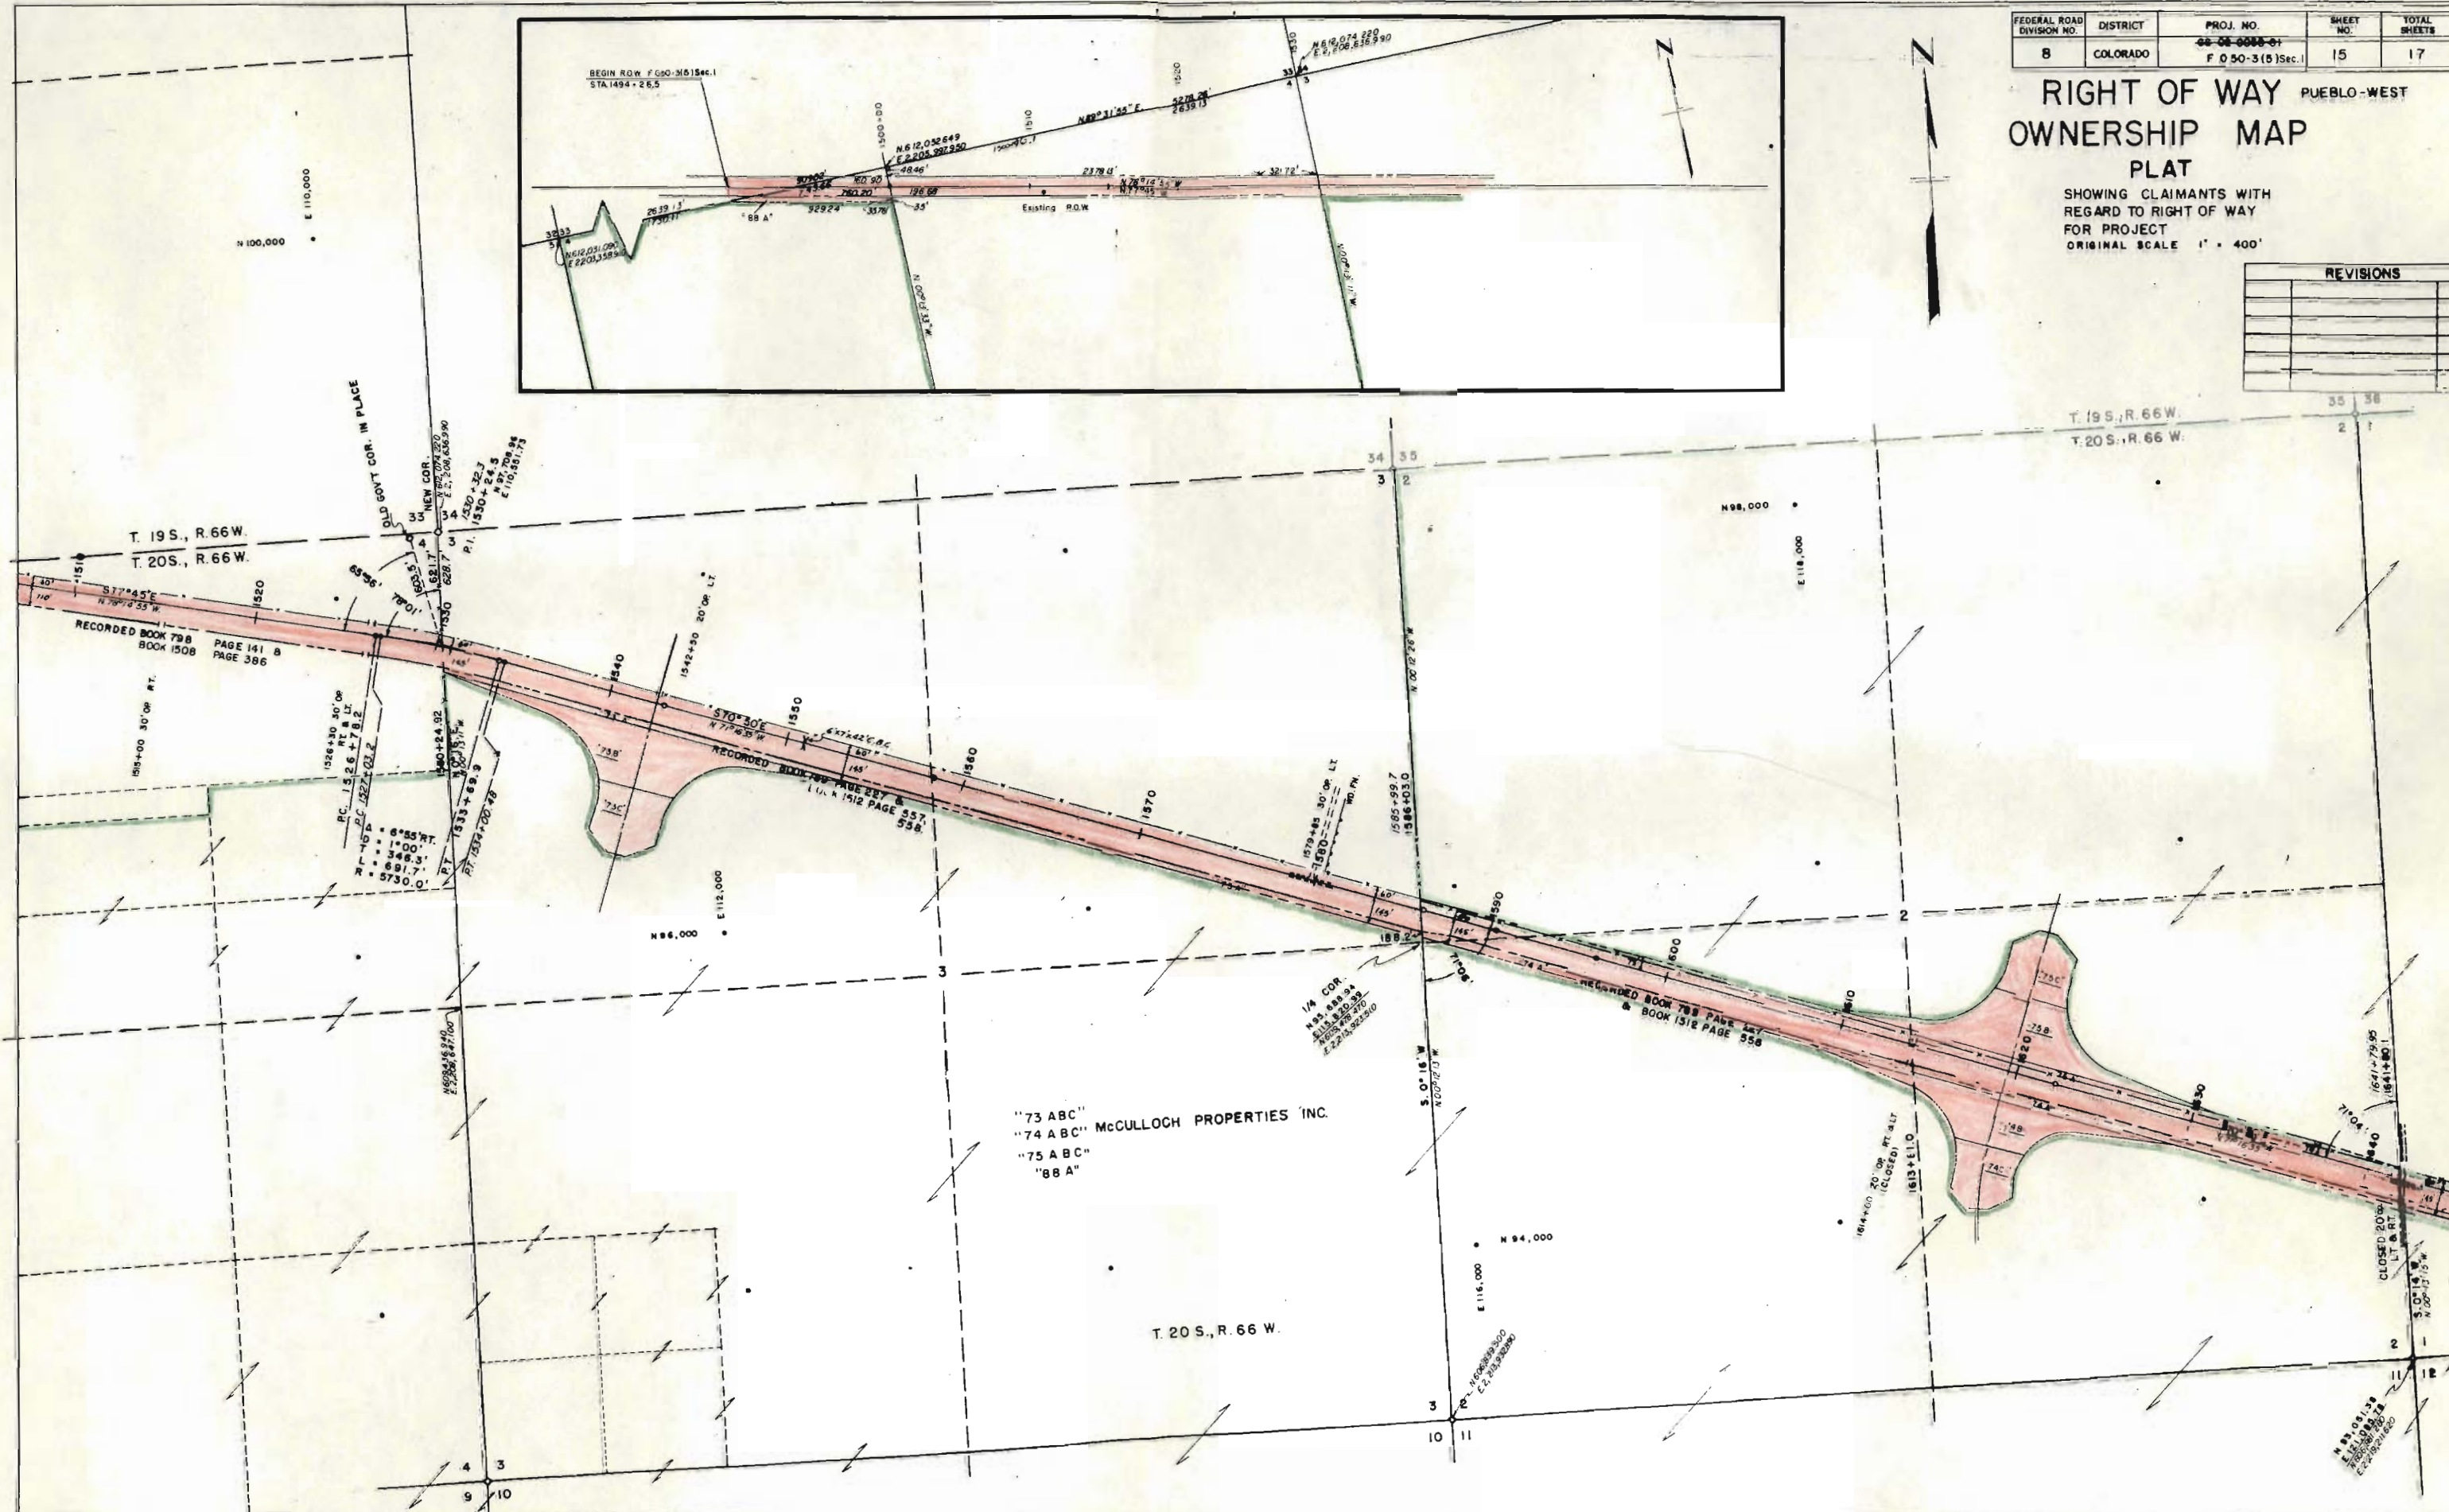


FEDERAL ROAD DIVISION NO.	DISTRICT	PROJ. NO.	SHEET NO.	TOTAL SHEETS
8	COLORADO	F 080-3 (5) Sec. 1	16	17

RIGHT OF WAY OWNERSHIP MAP PLAT

SHOWING CLAIMANTS WITH
REGARD TO RIGHT OF WAY
FOR PROJECT
ORIGINAL SCALE 1" = 400'

REVISIONS

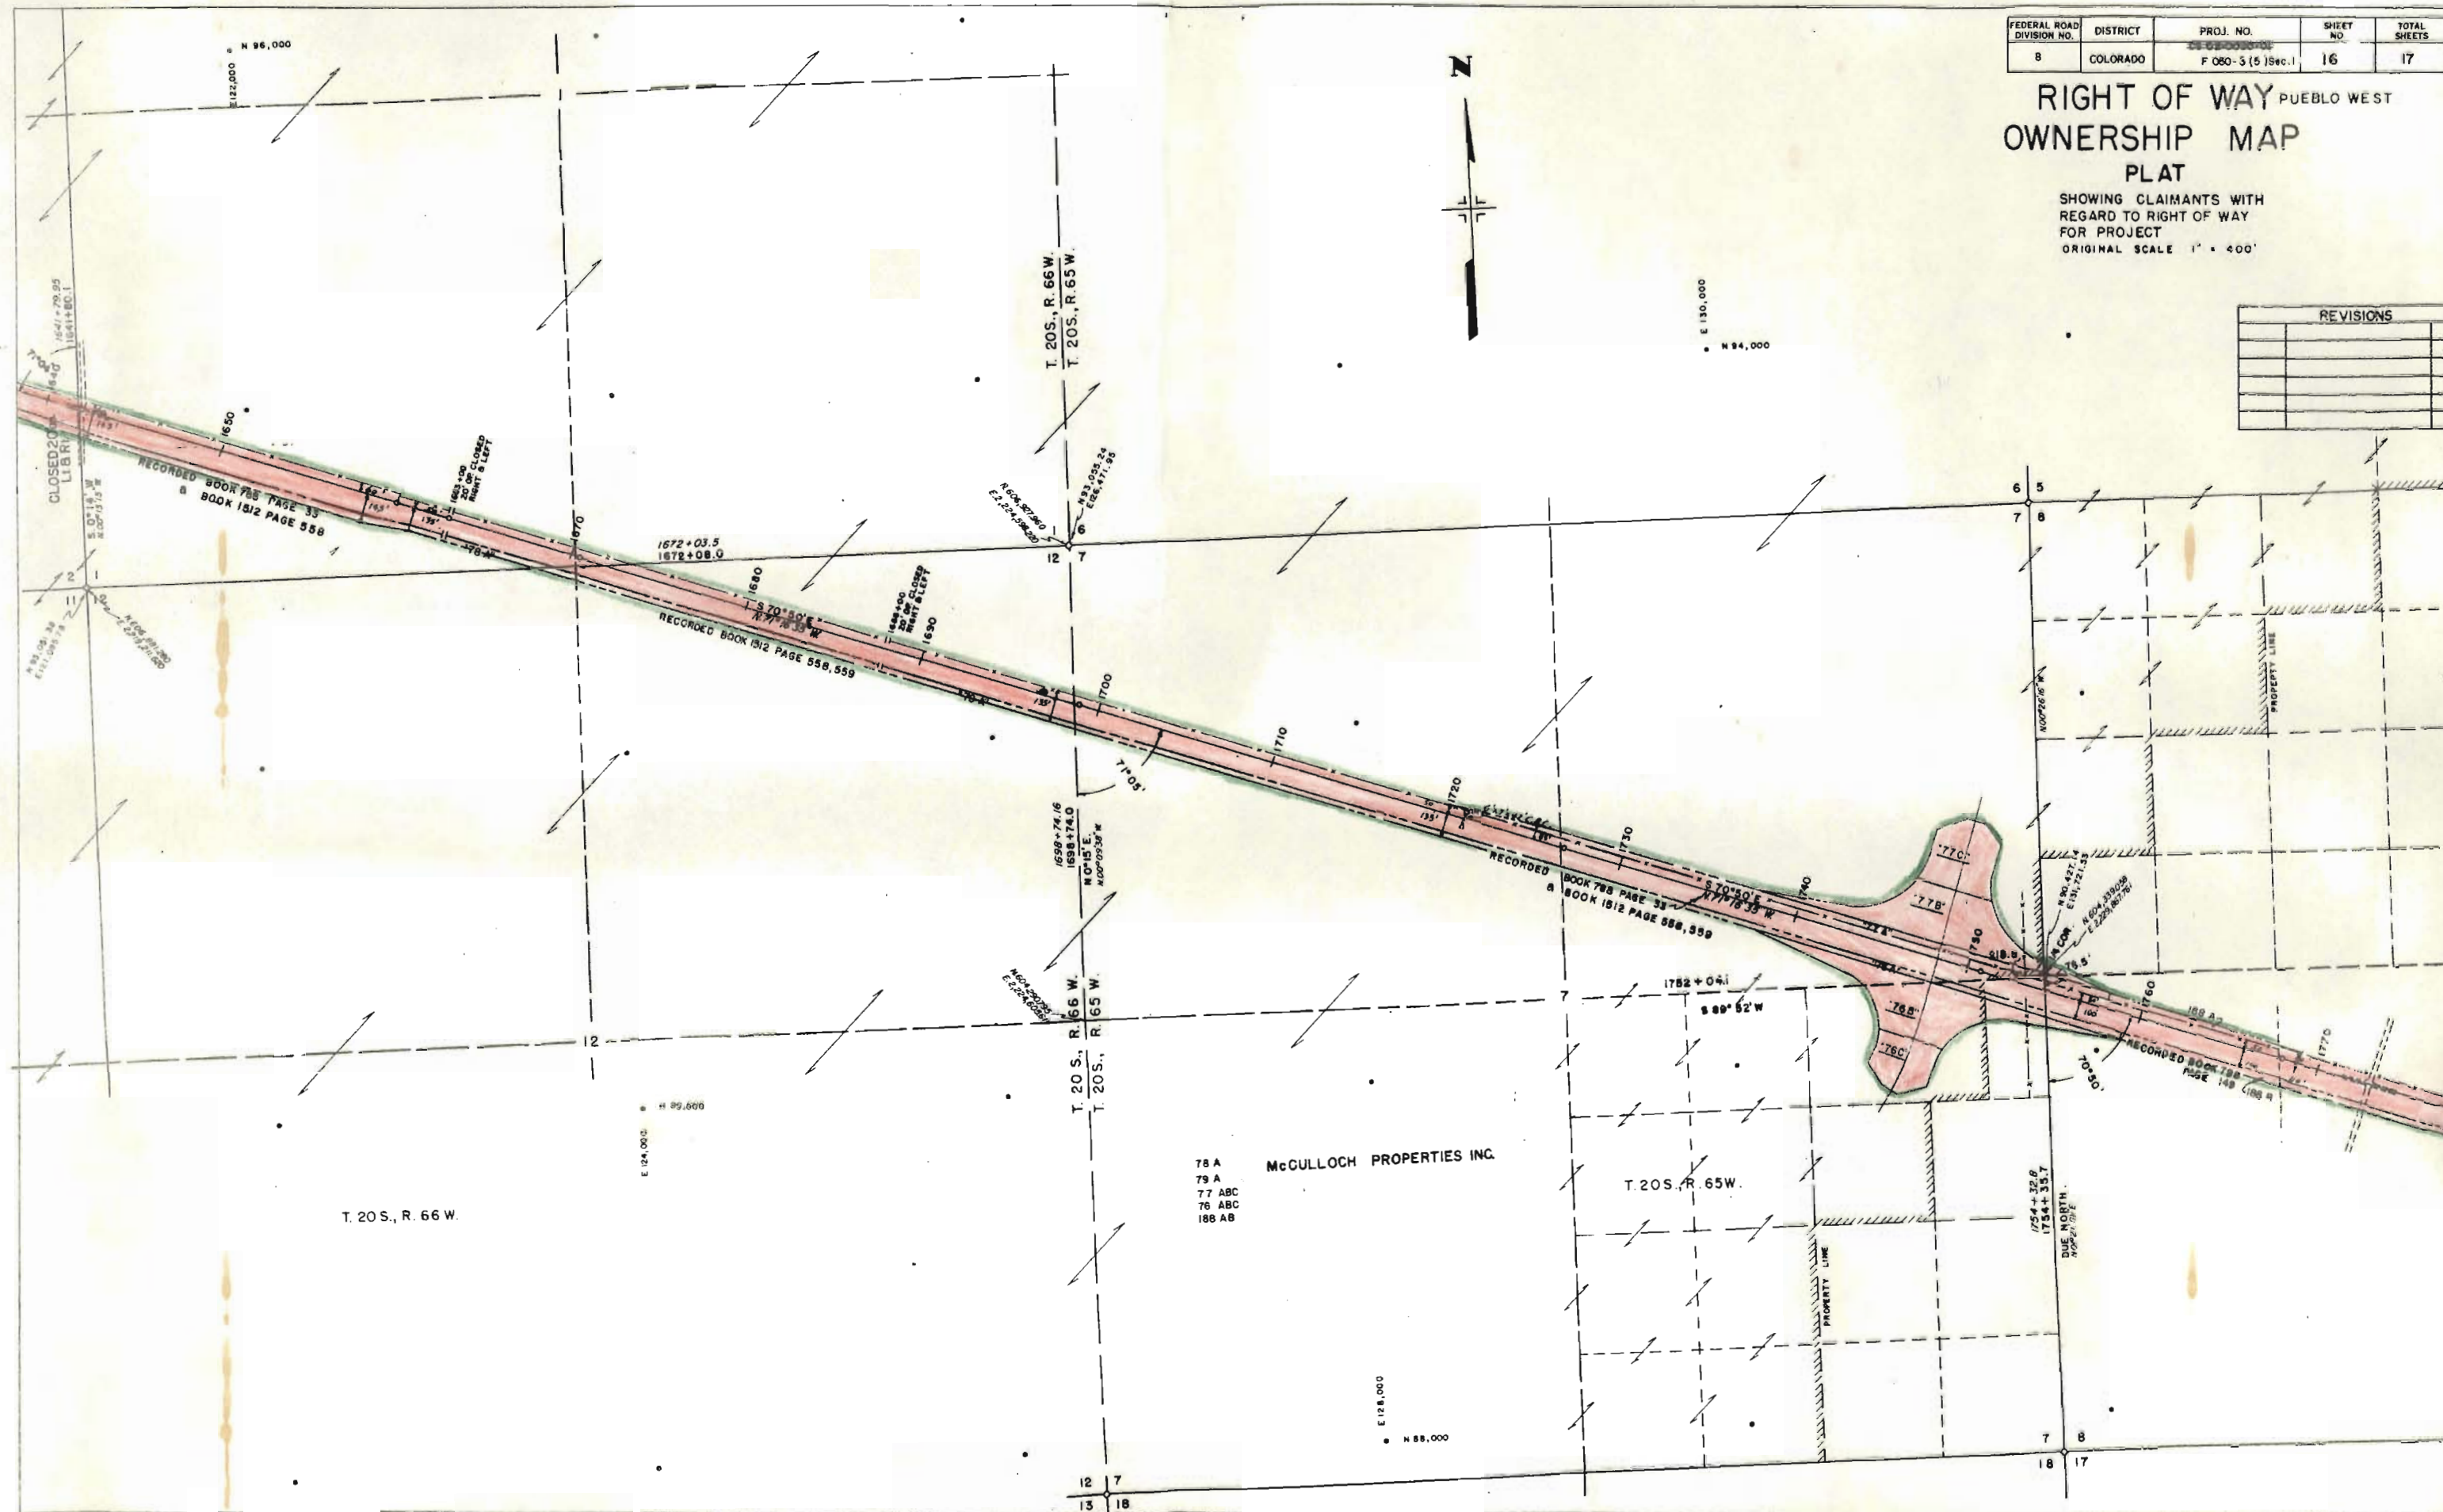

FEDERAL ROAD REGION NO.	DIVISION	PROJ. NO.	SHEET NO.	TOTAL SHEETS
VIII	COLORADO	CS 02-0050-01 F 050-3(5)Sec.1	17	17

RIGHT OF WAY
PUEBLO - WEST
OWNERSHIP MAP
scale = 1" = 400'

[illegible]