

TITLE SHEET

CENTER LINE PLAN SHEET TITLE SHEET

RIGHT OF WAY LINE ROW MARKER

COUNTY LINE CITY LIMITS

TOWNSHIP OR RANGE LINE 1/4 SECTION LINE 1/2 SECTION LINE

LAND LINES PLAN SHEET TITLE SHEET

RAILROAD NEW EXIST

BARBED WIRE FENCE

CHAIN LINK FENCE

BEAM TYPE GUARD RAIL

TELEPHONE & TELEGRAPH POLES

POWER POLES

DETOUR DETOUR

PRESENT ROAD (Plan Sheets)

CONTROL OF ACCESS LINE

ACCESS DENIED BY DEED A A E.O.A. (END OF ACCESS)

GAS LINE

WATER LINE

TELEPHONE CONDUIT

CURB AND GUTTER (TYPE 2 SEC. 1B) 

CURB AND GUTTER (TYPE 2 SEC. 1B) 

CURB AND GUTTER (TYPE 2 SEC. 1M) 

CURB AND GUTTER (TYPE 2 SEC. 1M) 

GUTTER TYPE 2 (4 FOOT) 

CURB TYPE 6 (SECTION M) 

EXISTING CURB AND GUTTER
EXISTING SANITARY SEWERS
EXISTING STORM SEWERS
NEW STORM SEWER CONSTRUCTION
TIMBER GUARD POSTS
DELINEATORS

SCALES OF ORIGINAL DRAWINGS
 ON PLAN, 1" = 50 FT
 ON PROFILE, { 1" = 50 FT HORIZONTAL
 1" = 10 FT VERTICAL
 GRADE LINE ON PROFILE IS SHOWN AS GRADE OF FINISHED ROAD
 GROSS LENGTH OF PROJECT 16,723.51 FT = 3.167 MILES
 NET LENGTH OF PROJECT 16,332.48 FT = 3.095 MILES

CONTRACTOR: L. H. KILGROE CONST. CO
RESIDENT ENGINEER: FRANK ABEL
DATE OF COMPLETION: DECEMBER 2, 1972
APPROVED BY: R. L. Chisney 6-20-73
DISTRICT CONSTRUCTION ENGINEER

FEDERAL ROAD REGION NO	DIVISION	PROJECT NO	SHEET NO
9	COLORADO	F 058-1(2)	1

R-1 - Rev. Index & Length. 12-29-70 WEM
R-2 - Rev. Title Block 1-3-71 WEM

INDEX OF SHEETS

SHEET NO.

DEC 2, 1972

1. SKETCH MAP AND TITLE PAGE
- 2-3. TYPICAL SECTIONS, GENERAL NOTES, TABULATION OF LENGTH AND DESIGN AND SUMMARY OF EARTHWORK QUANTITIES
- 4-5. SUMMARY OF APPROXIMATE QUANTITIES
6. TABULATION OF DRAINAGE & LIST OF STRUCTURES
7. TABULATION OF SURFACING, FENCING, GUARD RAIL, APPROACH SLABS, DELINEATORS, RIGHT OF WAY MARKERS AND DETOUR QUANTITIES
8. TYPICAL ENTRANCE RAMP MERGING DETAIL
- 9-18. DETAILS OF BRIDGE STRUCTURE NO. E-16-HQ
- 19-31. DETAILS OF COORS STRUCTURE
- 32-46. ALIGNMENT PLAN & PROFILE
- 47-82. ~~CROSS SECTIONS~~ - Void By Construction - See IBM Sheets

82AX Structure Excavation & Backfill - 36" RCP - Juchem Ditch

M-203-A-I	SUPERELEVATION OF CURVES-DIVIDED HIGHWAYS	7-30-68
M-203-B	APPROACH ROADS, FLARING, CUT SLOPE TREATMENT, BRIDGE & CREST WIDENING	4-27-70
M-206-A	EXCAVATION AND BACKFILL FOR STRUCTURES	(2 sheets) 9-23-70
M-500-A	LETTERS AND FIGURES FOR STRUCTURE NUMBERS	7-1-65
M-601-A	SINGLE AND DOUBLE CONCRETE BOX CULVERT	10-25-68
M-601-C	WINGWALLS FOR CONCRETE BOX CULVERTS - 4:1 SIDE SLOPES	(2 Sheets) 10-25-68
M-603-CA	CONCRETE AND METAL END SECTIONS	7-23-68
M-603-RC	REINFORCED CONCRETE PIPE	7-23-68
M-604-BA	INLET, TYPE C	7-19-68
M-604-D	STEPS FOR MANHOLES AND INLETS	7-23-68
M-606-AB	GUARD RAIL, TYPE 3	(3 Sheets) 11-25-70
M-607-B	CHAIN LINK FENCE	(2 Sheets) 12-11-70
M-609-A	CURBS AND GUTTERS	5-21-69
M-612-A	MARKER POSTS AND BENCH MARKS	7-24-68
M-612-C	DELINEATORS	(2 Sheets) 7-11-68
M-614-A	TIMBER BARRICADES	4-23-69
M-614-IC	STANDARD CONSTRUCTION IDENTIFICATION SIGNS	(2 Sheets) 9-25-70
M-614-TB	TRAFFIC SIGNING FOR HIGHWAY CONSTRUCTION	(3 Sheets) 12-24-68

As Constructed No. 200113
Shells 8, 11, 12, 13, 25, 29-31
and 41

INACTIVE

JUL 31 1974

R. L. MAYER

~~W. E. MITCHELL~~

APPROVED  12-17-77
CHIEF ENGINEER DATE

DEPARTMENT OF TRANSPORTATION	
FEDERAL HIGHWAY ADMINISTRATION	
APPROVED _____	DATE _____
DIVISION ENGINEER	

W.E.M.

NOTES:
SEE STANDARDS FOR DETAILS OF CUT SLOPE
TREATMENT, FLARING, & WIDENING.

TYPICAL SECTIONS

STA. 141 +00 to STA. 166+00

FILL SLOPES		
"H"	CURVES	TANGENTS
4' OR LESS	6:1	6:1
4' to 10'	4:1	4:1
OVER 10'	3:1	3:1

AS CONSTRUCTED

REVISED DATE
DEC 2, 1972

FEDERAL ROAD REGION NO.	DISTRICT	PROJ. NO.	SHEET NO.	TOTAL SHEETS
8	COLORADO	F058-1(2)	2	

R-1 REV. 12-29-70 W.E.M.

GENERAL NOTES

FOR PRELIMINARY PLAN QUANTITIES OF BITUMINOUS MATERIALS
THE FOLLOWING RATES OF APPLICATION WERE USED:

PRIME COAT, (MC-70) @ 0.40 GALS. PER SQ. YD.
TACK COAT, EMUL. ASPH. (SS-1h) @ 0.10 GALS. PER SQ. YD.
BITUMINOUS PAVEMENT @ 110 LBS PER SQ. YD. PER INCH
RATES OF APPLICATION SHALL BE AS DETERMINED BY THE ENGINEER AT TIME
OF APPLICATION.

DEPTH OF MOISTURE-DENSITY CONTROL FOR THIS PROJECT SHALL BE AS FOLLOWS:
FULL DEPTH OF ALL EMBANKMENTS.

BASES OF CUTS 1 FOOT EXCAVATION REQUIRED FOR COMPACTION OF BASES OF
BASES OF FILLS 1 FOOT CUTS AND FILLS WILL BE CONSIDERED AS SUBSIDIARY TO
THAT OPERATION AND WILL NOT BE PAID FOR SEPARATELY.

Seeding and Mulching Will Be Provided Within Right-Of-Way Limits On All
Trenches Across For Seeding. The Following Rates Shall Be Used:

COMMON NAME	BOTANICAL NAME	PERCENT PURITY	PERCENT GERMINATION	RATE PLS / ACRE	HYD. MULCH
Smooth Brome	Bromus Tectorius	85	85	5	
Russian Wildrye	Elymus Junceus	90	85	5	1 1/2 TONS PER ACRE
Intermediate Wheatgrass	Thymophora Intermedia	90	85	5	
Chenopod Wildrye	Chenopodium Wildrye	90	85	5	
Blue Grama	Bouteloua Gracilis	35	60	1	

WHEN ORDERED BY THE ENGINEER, A TACK COAT (SS-1h) IS TO BE APPLIED BETWEEN
PAVEMENT COURSES TO IMPROVE BOND.

R-1 Plain water shall be used as a dust palliative where required. Locations
shall be as ordered.

EARTH SLOPES SHALL BE DISCED, OR ROUGHENED BY OTHER APPROVED METHODS
FOR MULCHING OR EROSION PROTECTION.

ALL QUANTITIES ON PRELIMINARY PLANS ARE TO BE CONSIDERED APPROXIMATE ONLY.

WETTING (EMBANKMENT STD.) 40 GAL PER CU. YD.
WETTING (SUBBASE & BASE COURSE) 15 GAL PER TON

ANY LAYER OF BITUMINOUS PAVEMENT THAT IS TO HAVE A SUCCEEDING LAYER
PLACED THEREON SHALL BE COMPLETED FULL WIDTH BEFORE SUCCEEDING LAYER IS
PLACED.

WATER LINES, SEWER LINES, GAS LINES, ETC., AS SHOWN ON PLAN AND PROFILE ARE
PLOTED FROM THE BEST AVAILABLE INFORMATION. THE CONTRACTOR'S ATTENTION IS
DIRECTED TO PARAGRAPH 105.04 OF THE STANDARD SPECIFICATIONS CONCERNING UTILITIES.

MATERIAL ABOVE THE SUBGRADE IS TO BE CONSTRUCTED OF AGGREGATE MATERIAL AT
LOCATIONS DESIGNATED IN THE SURFACING TABULATION. ESTIMATED QUANTITIES
INVOLVED IN THIS OPERATION AND THICKNESS OF MATERIAL REQUIRED ARE TABULATED
IN THE SURFACING MATERIAL PLAN.

TOPSOIL IS AVAILABLE WITHIN THE LIMITS OF CONSTRUCTION OF THIS PROJECT.
CONTRACTOR SHALL STRIP, STOCKPILE AND PLACE ON
SLOPES. NO SEPARATE PAYMENT WILL BE MADE FOR HAULING TOPSOIL. TOPSOIL
WILL BE PLACED TO A MINIMUM THICKNESS OF 4 INCHES.

THE TYPE OF COMPACTION FOR STRUCTURE BACKFILL SHALL BE STANDARD.


R-1 Ski Type Device at least 30 Feet in length and Short Ski or Shoe shall be furnished with
each bituminous paver equipped with an automatic control system.

R-1 Concrete pipe for this project shall be furnished with metal joint fasteners as
shown on M Standard. Joint fasteners shall be installed on the last 3
connections at the outlet end of each culvert.

IT IS ESTIMATED THAT 1,000 HOURS OF FLAGGING FOR CONTROLLING TRAFFIC
WILL BE REQUIRED FOR THIS PROJECT.

HENNINGSON, DURHAM & RICHARDSON
ENGINEERS, PLANNERS, CONSULTANTS
CIVIL, LIFE CENTER
DENVER, COLORADO

THE DEPTH AND WIDTH OF THE SIDE DITCH
SHALL BE VARYED WHERE NECESSARY IN ORDER
TO PROVIDE PROPER DRAINAGE AND / OR
ENTRANCE TO DRAINAGE
STRUCTURES.

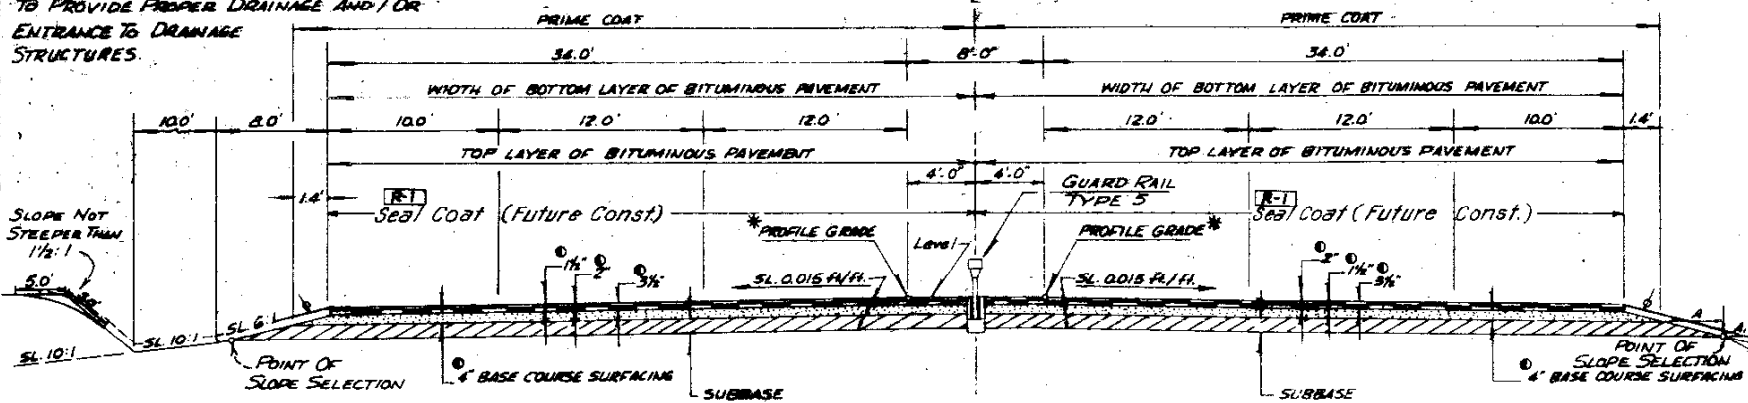

BREAK POINTS ON SLOPES AND IN BOTTOMS
OF DITCHES SHALL BE ROUNDED ON
CONSTRUCTION FOR PLEASING APPEARANCE.

TRANSITION FROM NON-DEPRESSED TO
DEPRESSED MEDIAN STA. 166+00
TO STA. 175+00

NOTE: TRENCH FOR PIPE UNDERDRAIN DETAIL SEE M 206-A

R-1 FUTURE CONSTRUCTION NOTE:
All construction above the subgrade on the Main Line,
Ramps & Service Road, will not be a part of this project.
Main Line, Ramps & Service Road will be stabilized and
paved as future construction.


* CONTRACTOR WILL BE REQUIRED TO PLACE
TOP SOIL TO THIS LINE AFTER COMPLETION
OF PAVING OPERATIONS.

* PROFILE GRADE IS AT CENTERLINE FROM STATION
141 +00 TO STATION 155+98-R-1

A. A. VARY TO MATCH FILL SLOPE THAT IS ACTUALLY
CONSTRUCTED.

○ APPROXIMATE THICKNESS

STA. 175+00 to STA. 303+60

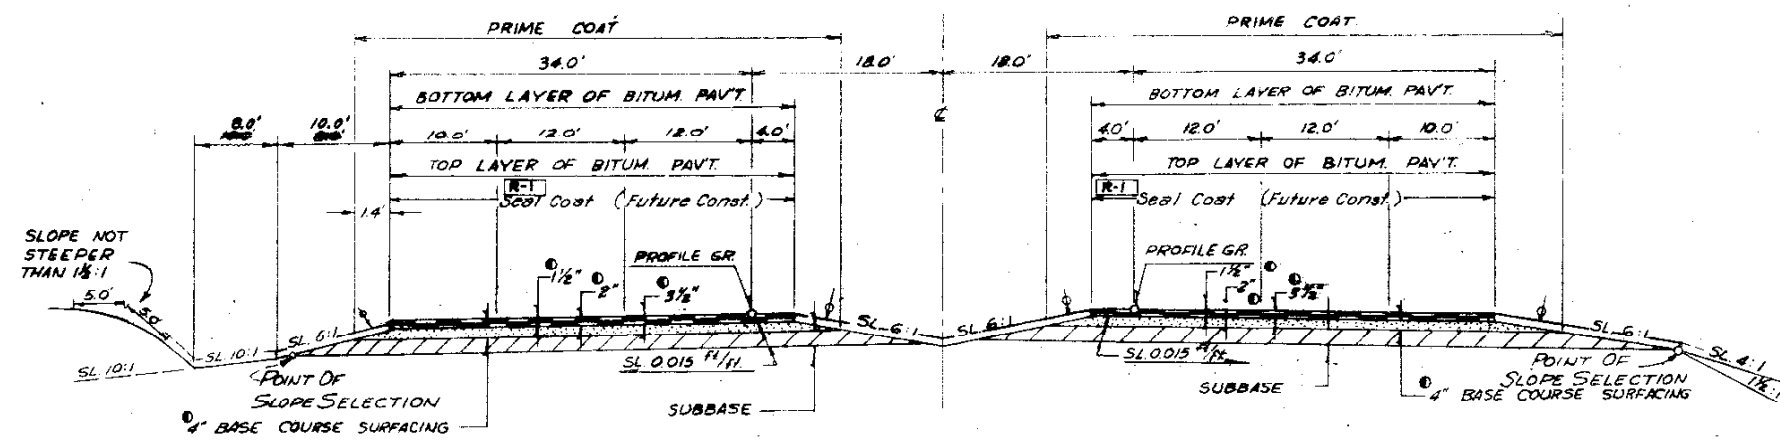


AS CONSTRUCTED
REVISED DATE DEC 2, 1972

FEDERAL ROAD DISTRICT	PROJECT NO.	SHEET NO.	TOTAL SHEETS
0	058-1(2)	3	

Rev. 12-29-70 WEM

MCINTYRE ST. STA. 0+00 TO STA. 19+00

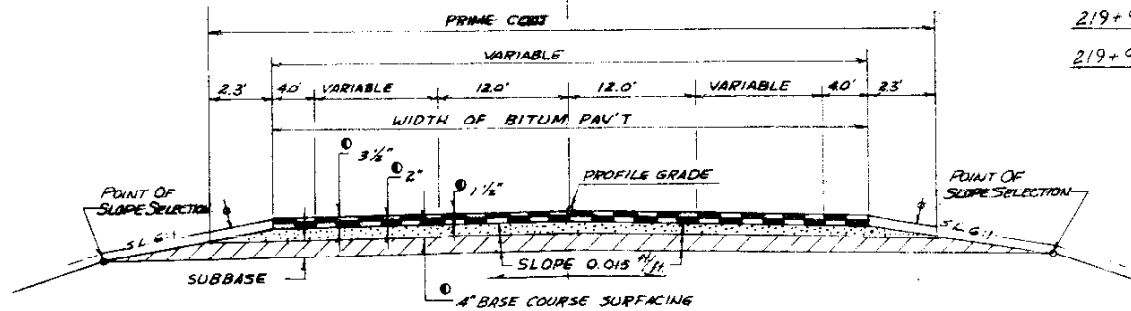


219+91.84 BK
219+90.64 AH


STATION	ROADWAY LIN. FT.	NO. WORK SECTION LIN. FT.
141+00 BEG. F058-1(2)AH=		
141+00 F032-1(10)BK	431.59	
145+31.59		383.83
149+1542		
196+19.56 BK. EQUA.	4704.14	
197+00.35 AH. EQUA.	2,291.49	
218+76.3 BK. EQUA.	2,291.49	
218+70.6 AH. EQUA.	3,885.66	
308+97.40 END	3026.80	
F058-1(2) =		
R.O.S.T. 298+09.86		
I 70-3(47)271		
TOTALS	16,339.68	383.83
	16,339.68	
SUMMARY		
ROADWAY LENGTH (NET)	16,339.68	3.095
NO. WORK SECTION (STRUCTURE)	383.83	0.073
GROSS LENGTH PROJECT	16,339.68	3.167
	16,723.51	
MAXIMUM DEGREE OF CURVE	3°00'	
MINIMUM S.S.D. VERTICAL	7600'	
MAXIMUM DESIGN SPEED	70 MPH	
MAXIMUM GRADE	6.00%	
MINIMUM S.S.D. HORIZONTAL	800'	

1989 DESIGN TRAFFIC VOLUME { 11,480 ADT
1,260 DHV


RAMP MCINTYRE ST. INTERCHANGE

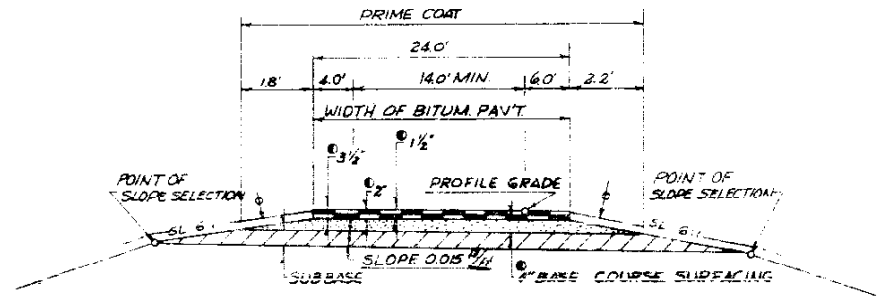

RAMPS A & B YOUNGFIELD ST. INTERCHANGE

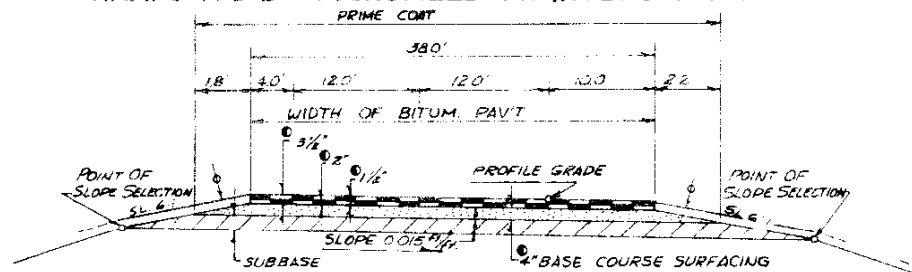

SERVICE ROAD

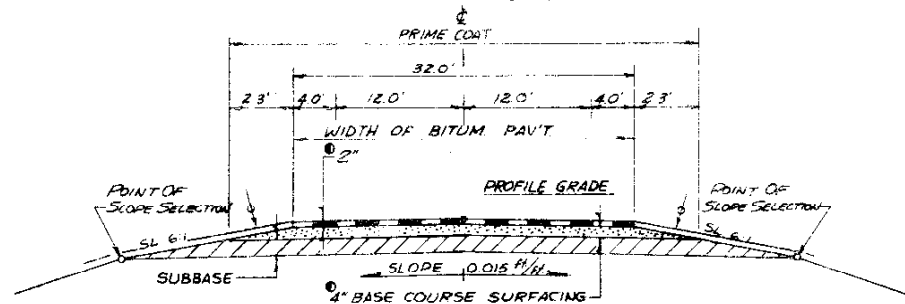

AS CONST. EARTHWORK QUANTITIES

EMBANKMENT MATERIAL (Haul & Compaction)	ROADWAY FED. AID CU. YD.	ROADWAY NON-FED. AID CU. YD.	PROJECT TOTAL CU. YD.
Mainline 221+50-307+50	198,864		198,864
McIntyre St. 0+00-22+00	77,901	53,731	131,632
Channel Change 160+ - 162+	2,767		2,767
Pond Area Lt 161+	1,581		1,581
Grade Change NW Ramp	936		936
Staking Error NE Ramp	3,975		3,975
PROJECT TOTAL	286,024	53,731	339,755
Remove Muck (Haul)	40,405		
W.O. #21470			
Ramp to Revised Parcel 127		12,531	

NOTE: Quantities From Computer Output

SUMMARY OF EARTHWORK QUANTITIES

	ROADWAY FED. AID CU. YD.	ROADWAY NON-FED. AID CU. YD.	PROJECT TOTAL CU. YD.
EMBANKMENT MATERIAL (Haul & Compaction)			
Replace Topsoil	22,300		22,300
from Cross sections	357,825	51,171	408,996
Ditch 160+ Estimated	500		500
Muck Removal	30,000		30,000
PROJECT TOTAL	410,625	51,171	461,796
Remove Muck (Haul)	30,000		

Estimated 226,876 Cu Yds. Excavation available within Project Limits.

HENNINGSON, DURHAM & RICHARDSON
ENGINEERS - PLANNERS - CONSULTANTS
CAPTOL LIFE CENTER
DENVER, COLORADO

SUMMARY OF APPROXIMATE QUANTITIES

AS CONSTRUCTED

REVISED DATE DEC 2, 1972

R-1 Rev. 12-29-70 W.E.M.
R-2 Rev. 1-7-71 W.E.M.

FEDERAL ROAD DISTRICT NO.	DIVISION	PROJ. NO.	SHEET NO.	TOTAL SHEETS
1	COLORADO	F 058-1(2)	4	

CONTRACT ITEM NO.	CONTRACT ITEM	UNIT	ROADWAY	ROADWAY AS CONST.	ROADWAY (NON FED. AID)	ROADWAY AS CONST. (N.F.A.)	STR. NO. E-16-HQ	STR. *E-16-HQ AS CONST.	*COORS STR. (NON FED. AID)	COORS STR. AS CONST. (N.F.A.)	REFERENCE BOOK	REFERENCE PAGE	PROJECT TOTALS	AS CONST.	+	-
201	Clearing and Grubbing	L.S.	•	•							1	7	•	•		
202	Removal of Structures and Obstructions	L.S.	•	•							1	9	•	•		
202	Removal of Fence	Lin. Ft.	9,100	8,850							1	11	9,100	8,850		250
203	Muck Excavation (Haul)	Cu. Yd.	30,000	40,405							1	15	30,000	40,405	10,405	
203	Embankment Material (Haul and Compaction)	Cu. Yd.	411,000	286,024	52,000	53,731					1	18	463,000	339,755		123,245
203	Embankment Material (Haul and Compaction) W.O. # 21472	Cu. Yd.				12,531					1	18		12,531	12,531	
206	Structure Excavation (Haul)	Cu. Yd.	4,500	3,501			210	210	1,530	1,524	1	22	6,340	5,235		1,105
206	Structure Backfill (Class 2) (Haul)	Cu. Yd.	350	0							1	23	350	0		350
206	Structure Backfill (Class 3) (Haul)	Cu. Yd.	670	1,242			40	40	1,170	1,162	1	23	1,880	2,444	564	
207	Topsoil (Haul) - Quantities From Computer Output	Cu. Yd.	10,500	3,938	1,000	896					1	30	14,500	4,834		6,765
208	Seeding Deleted by W.O. # 21472	Acre	19	0	2	0							21	0		21
208	Mulching Deleted by W.O. # 21472	Acre	19	0	2	0							21	0		21
209	Wetting A,	M. Gal.	16,550	4,002	2,120	435					1	30/40	18,670	4,437		14,233
304	Aggregate Base Course (Class 1) (Haul)	Ton	7,000	6,705.26	3,700	3,452.81					1	41/42	10,700	10,158.06		541.94
304	Aggregate Base Course (Class 6) (Haul)	Ton	1,600	2,206.56	900	977.82					1	43/44	2,500	3,184.38	684.38	
403	Hot Bituminous Pavement (Grading E) (Haul and Asphalt)	Ton	1,600	1,249.20	800	811.74					1	45/46	2,400	2,060.94		339.06
411	Emulsified Asphalt (SS-1H)	Gal.	900	175	400	0					1	47	1,300	175		1,125
411	Liquid Asphaltic Material (MC-70)	Gal.	3,400	1,044	1,500	853					1	49	4,900	1,837		3,063
412	Concrete Pavement (10 inch)	Sq. Yd.	409	409	347	347					1	51/52	756	756		
503	Drilled Caissons (36 inch) (*W.O. 4 Lin. Ft. @ Bid Price + 10%)	Lin. Ft.					746	**764.50	738	744.40	1	53/54	1,484	1,508.90	24.90	
507	Concrete Slope and Ditch Paving (Reinforced)	Cu. Yd.	0	24.4			227	135.89	208	282.08	1	56/60	435	442.54	12.53	
509	Structural Steel	Lb.							453,500	453,425	1	61	453,500	453,425		75
509	Structural Steel (Galvanized)	Lb.					6,300	15,630	18,900	18,883	1	62	25,200	34,513	3,313	
512	Bronze Bearing Plates	Lb.							846	846	1	63	846	846		
516	Dampproofing (Linseed Oil)	Sq. Yd.					2,450	2,442	2,720	2,712	1	64	5,170	5,154		16
518	Bridge Compression Joint Sealer (Type A)	Lin. Ft.							82	82	1	66	82	82		
601	Concrete Class A 102 Cu Yd.s Deleted by W.O. # 21456	Cu. Yd.	102	0			40	39.91	186	220.42	1	68/69	328	220.38		67.67
601	Concrete Class D	Cu. Yd.					1,203	1,202.83	762	726.12	1	71	1,965	1,928.95		36.05
602	Reinforcing Steel 8,855 Lb.s Reinforcing Steel Deleted by W.O. # 21456	Lb.	28,100	19,240	16,500	16,460	438,300	453,553	231,000	230,613	1	74/75	713,900	719,864	5,964	
603	12 inch Vitrified Clay Pipe, Extra Strength	Lin. Ft.	20	30							2	7	20	30	10	
603	15 inch Reinforced Concrete Pipe	Lin. Ft.	536	645							2	9	636	645	109	
603	18 inch Reinforced Concrete Pipe	Lin. Ft.	1,902	2,870							2	13	1,802	2,870	768	
603	24 inch Reinforced Concrete Pipe	Lin. Ft.	450	270							2	17	450	270		180
603	36 inch Reinforced Concrete Pipe W.O. # 21456	Lin. Ft.	0	386							2	19	0	386		386
603	15 inch Reinforced Concrete End Section	Each	10	8							2	21	10	8		2
603	18 inch Reinforced Concrete End Section	Each	10	24							2	23	10	24	14	
603	24 inch Reinforced Concrete End Section	Each	3	1							2	25	3	1		2
604	Inlet Type C (5 Foot)	Each	10	19							2	27	10	19	9	
604	Inlet Type C (10 Foot)	Each	4	2							2	29	4	2		
604	36 inch Reinforced Concrete End Section - W.O. # 21456	Each	0	2							2	30	0	2		2
604	Inlet Type C (15 Foot)	Each	2	1							2	33	2	1		1
605	8 inch Perforated Corrugated Steel Pipe Deleted by W.O. # 05105	Lin. Ft.	840	0									840	0		840

* THE DIVISION OF HIGHWAYS TO BE REIMBURSED BY COORS CO. FOR THIS WORK.

REVISED DATE DEC 2, 1972

R-1 - Rev 12-29-70 W.E.M.
R-2 - Rev 1-7-71 W.E.M.

FEDERAL ROAD REGION NO.	DIVISION	PROJ. NO.	SHEET NO.	TOTAL SHEETS
9	COLORADO	F 058-1(2)	5	

* THE DIVISION OF HIGHWAYS TO BE REIMBURSED BY COORS CO. FOR THIS WORK.

AS CONSTRUCTED

REVISED DATE DEC 2, 1972

TABULATION OF DRAINAGE & LIST OF STRUCTURES

FEDERAL ROAD REGION NO.	DIVISION	PROJECT NO.	SHEET NO.	DATE
9	CO-ONADO	F058-1(2)	6	

Rev. 12-28-70 WGM

INDEX			LOCATION	TYPE	HEIGHT	ELEVATION		ITEM# 605 PERFORATED CORRUGATED STEEL PIPE - SIZE & LENGTH					ITEM# 605A-1 CONC. CULV. PIPE SIZE & LENGTH					V.C.P.	HEIGHT	STR. EXC.	STR. B'K'F.L. CLASS 3	STR. B'K'F.L. CLASS 2	RESET RIPRAP #	REINF. STEEL	CLASS A CONC.	FLOW LINE ELEVATIONS		FITTINGS		LINE		GRADE	MISCELLANEOUS			
BOOK	PAGE	SHEET				RIM	INVERT	#	15"	18"	24"	36"	48"	12"	CU. YDS.	CU. YDS.	CU. YDS.									CU. YDS.	LBS.	CU. YDS.	IN	OUT	ANGLE BENDS			CONC. END SECTION	FROM	TO
			175+00 175+50 E	C	2.9	82.77	80.92						71.4					33	40.8	16.9						80.42	78.86		1-15"	175	End Sect.	2.00	* To be included in Bid price for Culvert Pipe			
			183+00 E	C	2.3	71.06	69.23						169.2					50	141.8	42.2						69.23	58.10			183	Creek	11.00				
			191+00 E Lt.-Rt.	C	3.6	57.12	54.00						144.4					74	241.0	48.5						54.00	44.59		1-15"	191	Creek	1.00				
			198+12 Rt.	C	8.5	47.60	39.60						171.7					8.5	320.8	44.6						39.99	39.00			198	Creek	0.54				
			198+12 Med.	C	11.2	50.71	39.99						171.7					8.5	320.8	44.6						39.99	39.00			198	Creek	0.54				
			208+00 Lt.-Rt.	C	7.5	40.83	33.87						92.1					8.2	455.7	98.0						38.00	33.87		1-24"	208	End Sect.	1.00				
			210+50 E	C	8.0	38.00	30.00						192.9					9.2	257	44						33.87	27.86			208	Creek	1.00				
			218+93 Lt.	C	3.4	34.67	31.81						66.8					4.7	48.9	14.5						31.81	31.48		1-15"	218	End Sect.	0.50				
			218+93 E	C	3.7	34.73	31.51						67.8					4.7	49.0	14.6						31.81	31.48			218	End Sect.	0.50				
			218+93 Rt.	C	3.4	34.67	31.81						67.8					4.7	49.0	14.6						31.81	31.48			218	End Sect.	0.50				
			219+00 Rt.	C	3.50	34.67	25.80						67.8					4.7	49.0	14.6						31.81	31.48			219	End Sect.	0.50				
			225+00 E	C	4.7	28.00	22.01						52					3.0	41	70						22.01	22.01		1-18"	225	End Sect.	2.10				
			227+00 E	C	3.6	28.12	22.01						52					3.0	41	70						22.01	22.01			227	End Sect.	2.10				
			227+00 Rt.	C	4.8	25.00	20.70						52					3.0	41	70						22.01	22.01			227	End Sect.	2.10				
			227+00 Lt.	C	4.8	25.00	20.70						52					3.0	41	70						22.01	22.01			227	End Sect.	2.10				
			230+00 Lt.	C	2.5	21.00	19.00						41.6					2.9	28.4	10.4						19.00	18.60		1-15"	230	End Sect.	1.04				
			230+00 Lt. & Rt.	C	4.3	12.13	08.34						41.6					2.9	28.4	10.4						19.00	18.60		1-15"	230	End Sect.	1.04				
			236+05 Rt. Ser. Rd.	C	2.90	03.45	01.07						52					2.7	37.8	20.3						04.50	04.50			236	End Sect.	0.72				
			245+05 Lt.-Rt.	C	2.90	03.45	01.07						52					2.7	37.8	20.3						04.50	04.50			236	End Sect.	0.72				
			245+05 Lt.-Rt.	C	2.90	03.45	01.07						52					2.7	37.8	20.3						04.50	04.50			236	End Sect.	0.72				
			245+05 Rt. Ser. Rd.	C	2.90	03.45	01.07						52					2.7	37.8	20.3						04.50	04.50			236	End Sect.	0.72				
			250+00 E	C	2.8	02.00	01.00						52					2.7	37.8	20.3						04.50	04.50			236	End Sect.	0.72				
			252+40 Lt.-Rt.	C	2.8	02.00	01.00						52					2.7	37.8	20.3						04.50	04.50			236	End Sect.	0.72				
			252+40 Rt. Ser. Rd.	C	2.8	02.00	01.00						52					2.7	37.8	20.3						04.50	04.50			236	End Sect.	0.72				
			250+00 Lt.	C	2.8	02.00	01.00						52					2.7	37.8	20.3						04.50	04.50			236	End Sect.	0.72				
			261+00 Lt.-Rt.	C	2.8	02.00	01.00						52					2.7	37.8	20.3						04.50	04.50			236	End Sect.	0.72				
			261+00 Rt. Ser. Rd.	C	2.8	02.00	01.00						52					2.7	37.8	20.3						04.50	04.50			236	End Sect.	0.72				
			267+00 E	C	2.8	02.00	01.00						52					2.7	37.8	20.3						04.50	04.50			236	End Sect.	0.72				
			268+50 Lt.-Rt.	C	2.8	02.00	01.00						52					2.7	37.8	20.3						04.50	04.50			236	End Sect.	0.72				
			268+50 Rt. Ser. Rd.	C	2.8	02.00	01.00						52					2.7	37.8	20.3						04.50	04.50			236	End Sect.	0.72				
			273+31 Lt. & Rt.	C	2.8	02.00	01.00						52					2.7	37.8	20.3						04.50	04.50			236	End Sect.	0.72				
			273+31 Lt. & Rt.	C	2.8	02.00	01.00						52					2.7	37.8	20.3						04.50	04.50			236	End Sect.	0.72				
			273+31 Lt. & Rt.	C	2.8	02.00	01.00						3																							

TABULATION OF SURFACING

STATION	STATION	LENGTH	AGGREGATE BASE COURSE CLASS 1		AGGREGATE BASE COURSE CLASS 6		HOT BITUMINOUS PAVEMENT GRADING "E"		LIQUID ASPHALTIC MATERIAL (MC-70)		EMULSIFIED ASPHALT (SS-1h)	
			AS CONST.	TONS	AS CONST.	TONS	AS CONST.	TONS	AS CONST.	GALS.	AS CONST.	GALS.
McIntyre St 0+00 7+79.50 Sta 142+	7+79.50 21+27.97 Approach Slabs	779.50 1348.47	3452.81 6349.50 355.75	3624** 6554 400	977.82 1560.16 646.40	865** 1343 200	811.74 1,249.20 200	737** 1597	853** 1,044	1,415** 3,372	0 175	383** 829
TOTALS			10,158.06	10,578	3,184.38	2,408	2,060.94	2,334	1,897	4,787	175	1212

* Subbase Estimated at 14 inch Thickness
** Non-Federal Aid
* Includes Haul
* Includes Haul and Asphalt

TABULATION OF FENCING

STATION to STATION	SIDE	REMOVE FENCE	BUILD CHAIN LINK FENCE	CORNER & LINE BRACE POST CHAIN LINK	END POSTS CHAIN LINK
		LIN. FT.	LIN. FT.	EACH	EACH
146+60 to 155+00	Rt.		730	1	1
149+75 to 155+00	Lt.		520		
155+00 to 170+00	Rt.		1,500	4	
155+00 to 170+00	Lt.		1,510	5	
170+00 to 185+00	Rt.		1,530	4	
170+00 to 185+00	Lt.		1,490	5	
185+00 to 200+00	Rt.		1,409	3	
185+00 to 200+00	Lt.		1,450	4	
200+00 to 210+50	Rt.		1,060	2	
200+00 to 210+50	Lt.		1,065	2	
210+50 to 230+00	Rt.		2,345	6	2
210+50 to 230+00	Lt.		1,050	1	1
230+00 to 238+83	Rt.	1,011	1,500	4	
230+00 to 245+00	Lt.		1,510	3	
230+00 to 245+00	Rt.		1,500	4	
232+50 to 238+83	Rt-Lt	1,011	1,500	5	
245+00 to 260+00	Lt.		1,500	4	
245+00 to 260+00	Rt.		1,500	4	
245+98 to 271+00	Rt-Lt	2,557			
260+00 to 275+00	Lt.		1,532	4	
260+00 to 275+00	Rt.		1,505	3	
271+00 to 290+	Rt-Lt	3,581			
275+00 to 290+10	Lt.		1,510	4	
275+00 to 290+10	Rt.		1,510	3	
291+34.51 to 304+30	Lt.		1,360	2	1
291+34.51 to 304+30	Rt.		1,365	1	1
PROJECT TOTALS		9012	30,451	68	7
AS CONST. TOTALS		8,850	29,772	98	12

TABULATION OF GUARD RAIL

STATION to STATION	ONE AS CONST.	TYPE 3	TYPE 5	RESET GUARD RAIL TYPE 3
		LIN. FT.	LIN. FT.	LIN. FT.
McIntyre Street NON FED AID	914 1,050	1,400* 1,080*		
PROJECT TOTALS		2,480		
* 12'-6" Spacing * Non-Federal Aid				
AS CONST. TOTALS		1,964		

FEDERAL ROAD REGION NO.	DIVISION	PROJ. NO.	SHEET NO.	TOTAL SHEETS
9	COLORADO	F058-1(2)	7	

(R-1) Deleted R.O.W. Markers 12-29-70 W.E.M.

AS CONSTRUCTED
REVISED DATE DEC 2, 1972

TABULATION OF DELINEATORS

LOCATION	SIDE	TYPE I EACH	TYPE II EACH	TYPE III EACH
McIntyre Street		* 6 4	3 #	* 4 #
PROJECT TOTALS		4	#	#
* 2-Type I, and 2-Type III Delineators Non-Federal Aid				
AS CONST. TOTALS		* 6	3	* 4

TABULATION OF APPROACH SLABS

STRUCTURE NO.	NUMBER OF SLABS	WIDTH	SKEW	10" CONCRETE PAVEMENT	REINFORCING STEEL
		FT.		SQ. YDS.	LBS.
E-16-HQ McIntyre St. Clear Creek	4	39	10°20'30"	408.4 ✓	19,240 ✓
	4	39	0°	346.8* ✓	16,460* ✓
AS CONST. PROJECT TOTALS				755.2	35,700
* Non-Federal Aid				346.8*	16,460*
AS CONST. TOTALS				409.0	19,240
PROJECT TOTALS				755.8	35,700

DETOUR QUANTITIES

ITEM NO.	DESCRIPTION	UNIT	AMOUNT	AS CONST.
203	Embankment Material (Haul & Compaction)	Cu. Yd.	11,000	L.S.
209	Wetting	M. Gal.	480	L.S.
304	Aggregate Base Course (Class 6) (Haul)	Ton	2,168	L.S.
403	Hot Bituminous Pavement (Grading E) (Haul & Asph)	Ton	684	L.S.
411	Liquid Asphaltic Material (MC-70)	Gal.	3,318	L.S.

Δ Detour Quantities to be Paid for under Pay Item
621 Maintenance of Detours (Lump Sum).

TABULATION OF RIGHT OF WAY MARKERS

STATION	SIDE	EACH
196+19.56 BL 233+00	Rt-Lt Rt-Lt	2 2
257+23.07 259+19.77	Rt-Lt Rt-Lt	2 2
290+10 BL 297+49.8	Rt-Lt Rt-Lt	2 2
PROJECT TOTAL		12



TYPICAL ENTRANCE RAMP MERGING DETAIL

SCALE OF ORIGINAL DRAWING 1"=20'

AS CONSTRUCTED
NO REVISION DATE


DEC 2 1972

FEDERAL ROAD REGION NO.	DISTRICT	PROJ. NO.	SHEET NO.	TOTAL SHEETS
9	COLORADO	F 058-1 (2)	8	

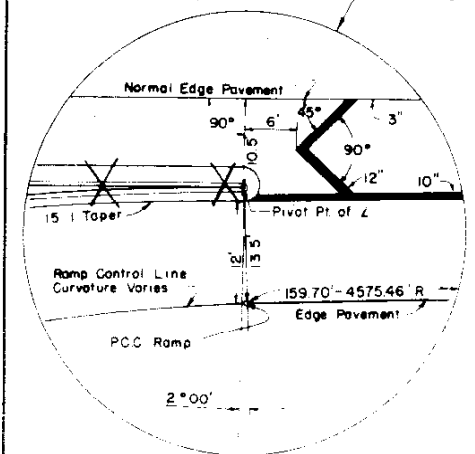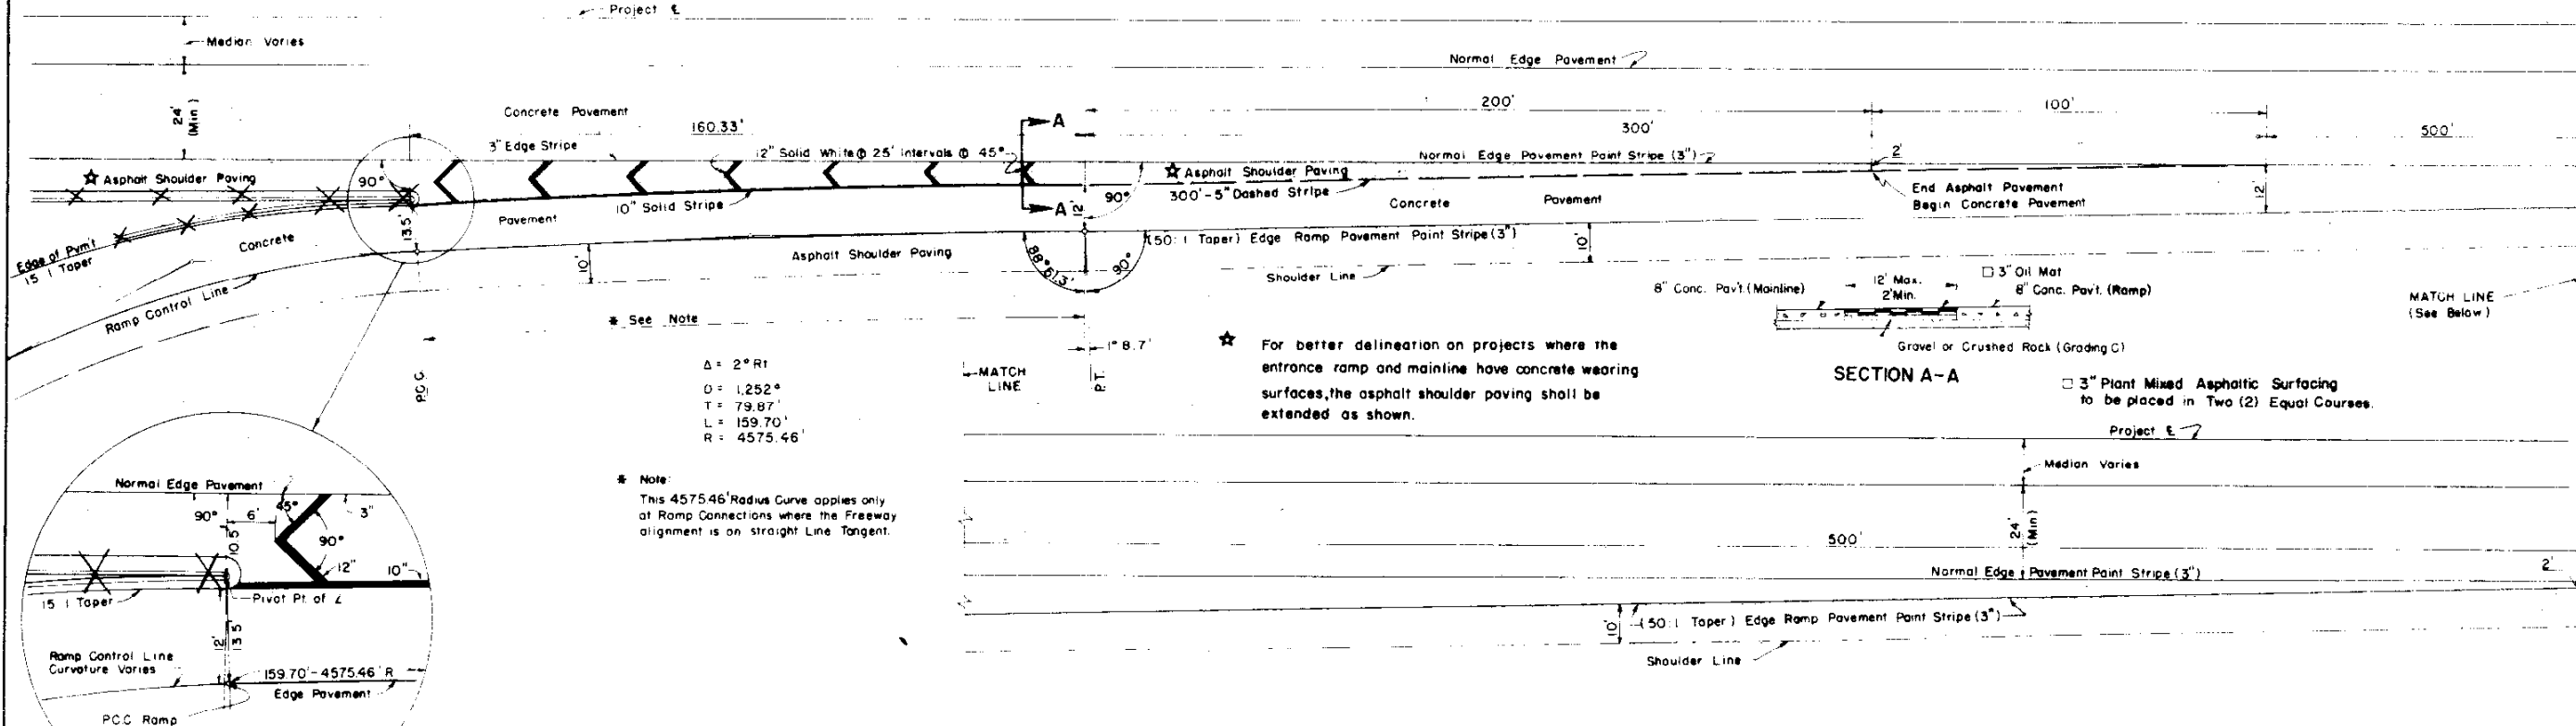


Typical One Lane Entrance Ramp to Freeway


* 150' Curb & Gutter (Type II)

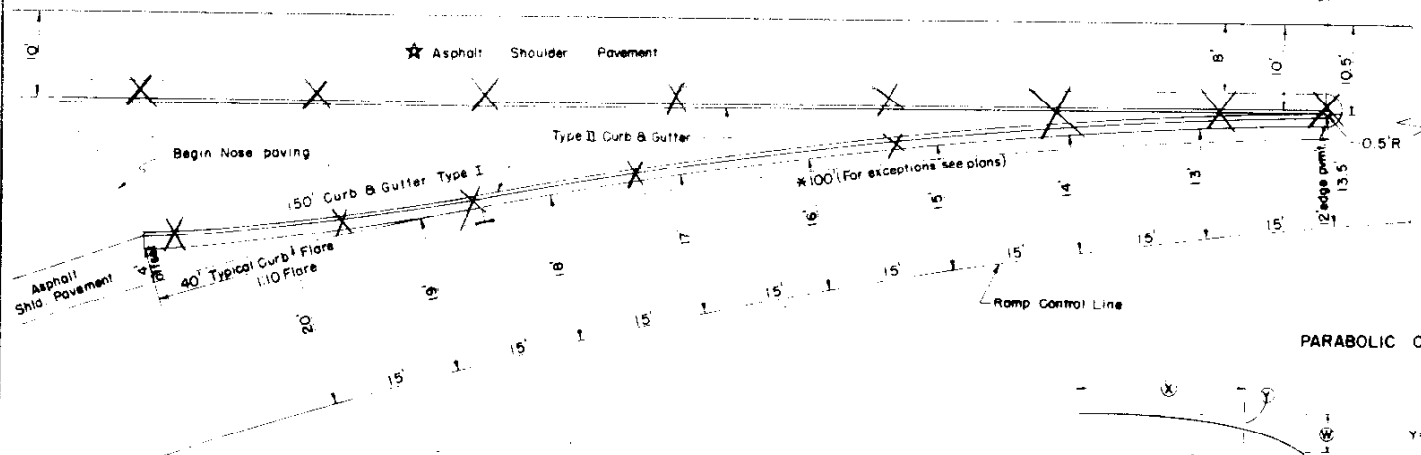

Typical One Lane Exit Ramp from Freeway

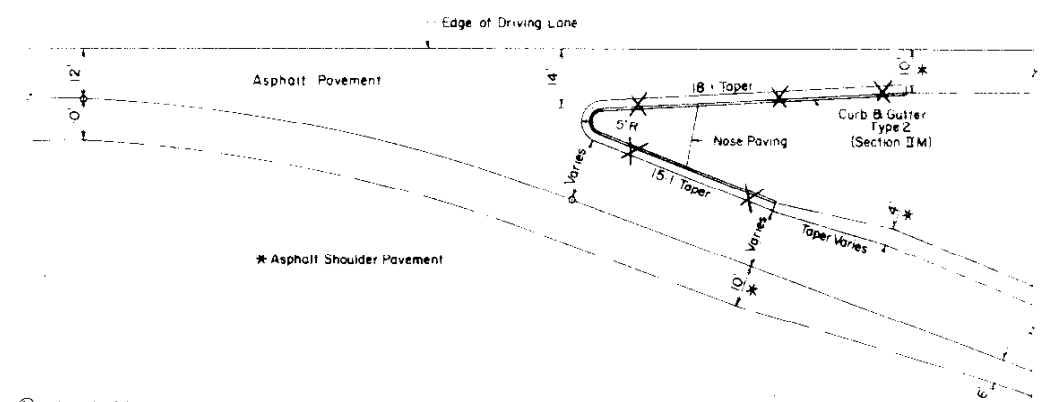

PARABOLIC CURB FLARES

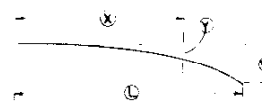

- L = Length of flare in feet.
- W = Maximum offset in feet.
- X = Distance along control line in feet.
- Y = Offset from control line in feet.

* Note:
In the event ramp alignment will not allow enough distance (20' or more) between the pavement edges of the main highway and the ramp to accommodate typical curved flares, the curb and gutter will be lengthened along tangent to facilitate typical flared requirements as per table shown on this sheet.

		OFFSET IN FEET FOR GIVEN X DISTANCE																
Distance (X)	Length of Flare (L)	10	20	30	40	45	50	60	70	75	80	90	100	110	120	130	140	150
1:10 Flares																		
40		0.25	1.00	2.25	4.00													
60		0.17	0.67	1.47	2.67		4.17	6.00										
1:15 Flares																		
150		0.04	0.18	0.40	0.72	1.11	1.60	2.18	2.84	3.60	4.44	5.36	6.40	7.51	8.72	10.00		

Use 1:10 Flare when approach speed is 60 mph or less.
Use 1:15 Flare when approach speed is more than 50 mph.

NOTE: All References to Concrete Pavement, Curb and Gutter do not apply to this Contract.

FED. ROAD DIST. NO.	DIVISION	PROJECT NO.	SHEET NO.	TOTAL SHEETS
9	COLD.	F 058-1 (2)	9	




(R2) REVISED QUANTITIES T.C.F. 1-7-71

AS CONSTRUCTED

REVISED DATE 1-2-72

(R2) SEE SHEET 10 FOR GENERAL NOTES

6-4" Electrical Conduits.
Project 30'-0" From Back Face of Abutments (Typical)
The Contractor Shall Notify The M.S.T.F. Co. And Arrange Inspection of 4" Conduit Placement Before Pouring. Work To Be By Contractor (Non-Federal Aid).

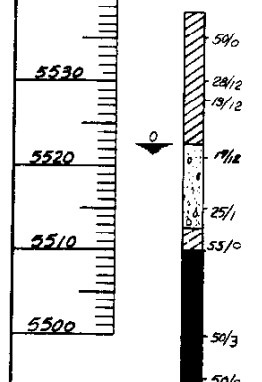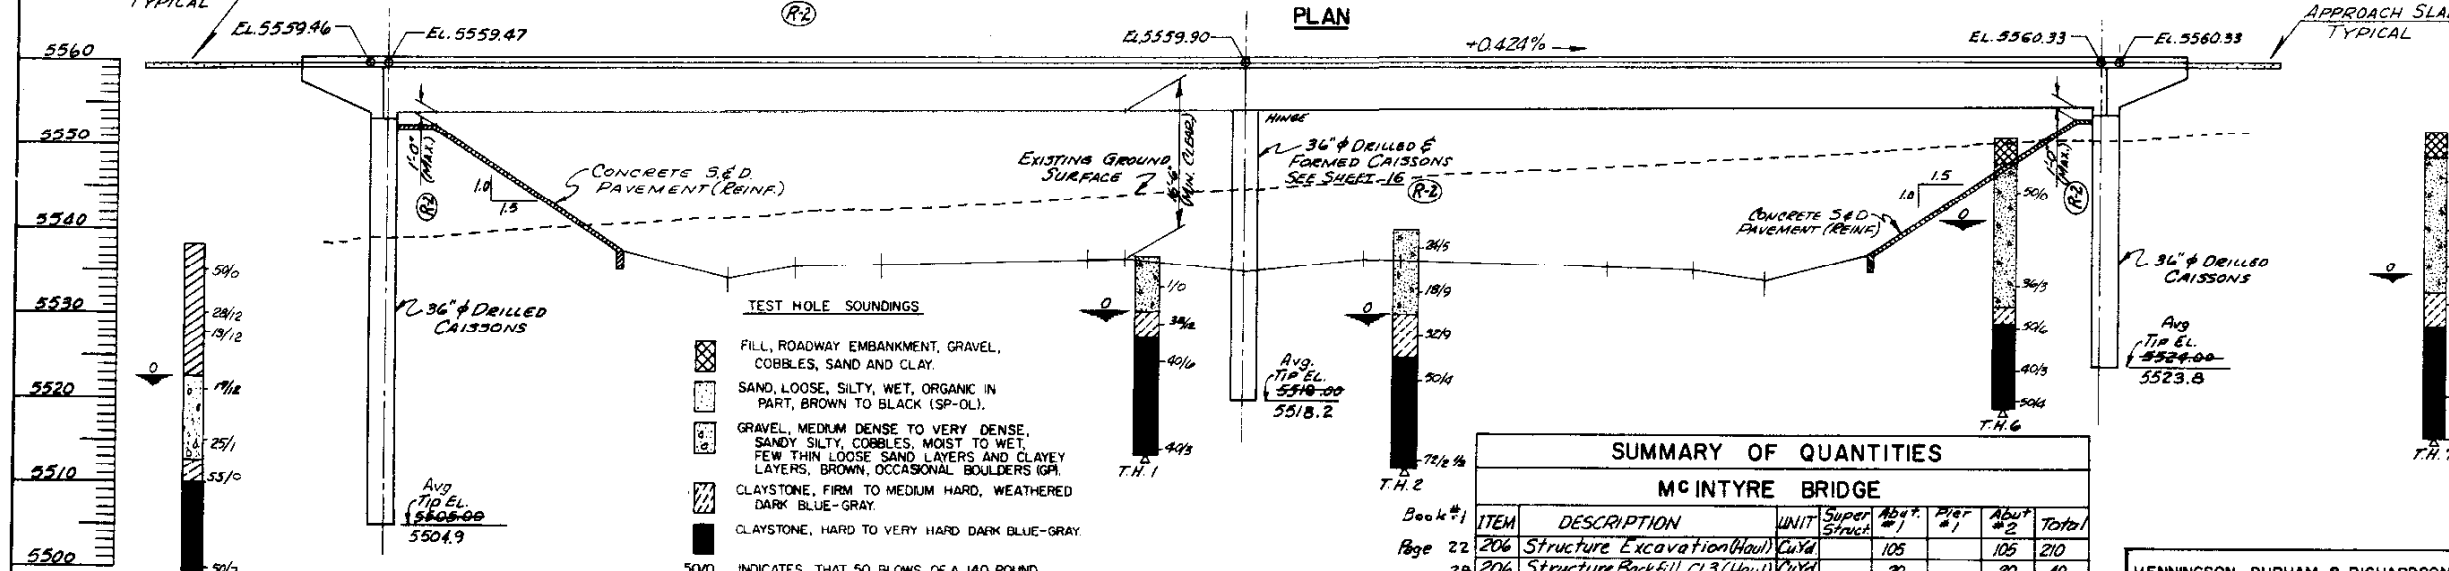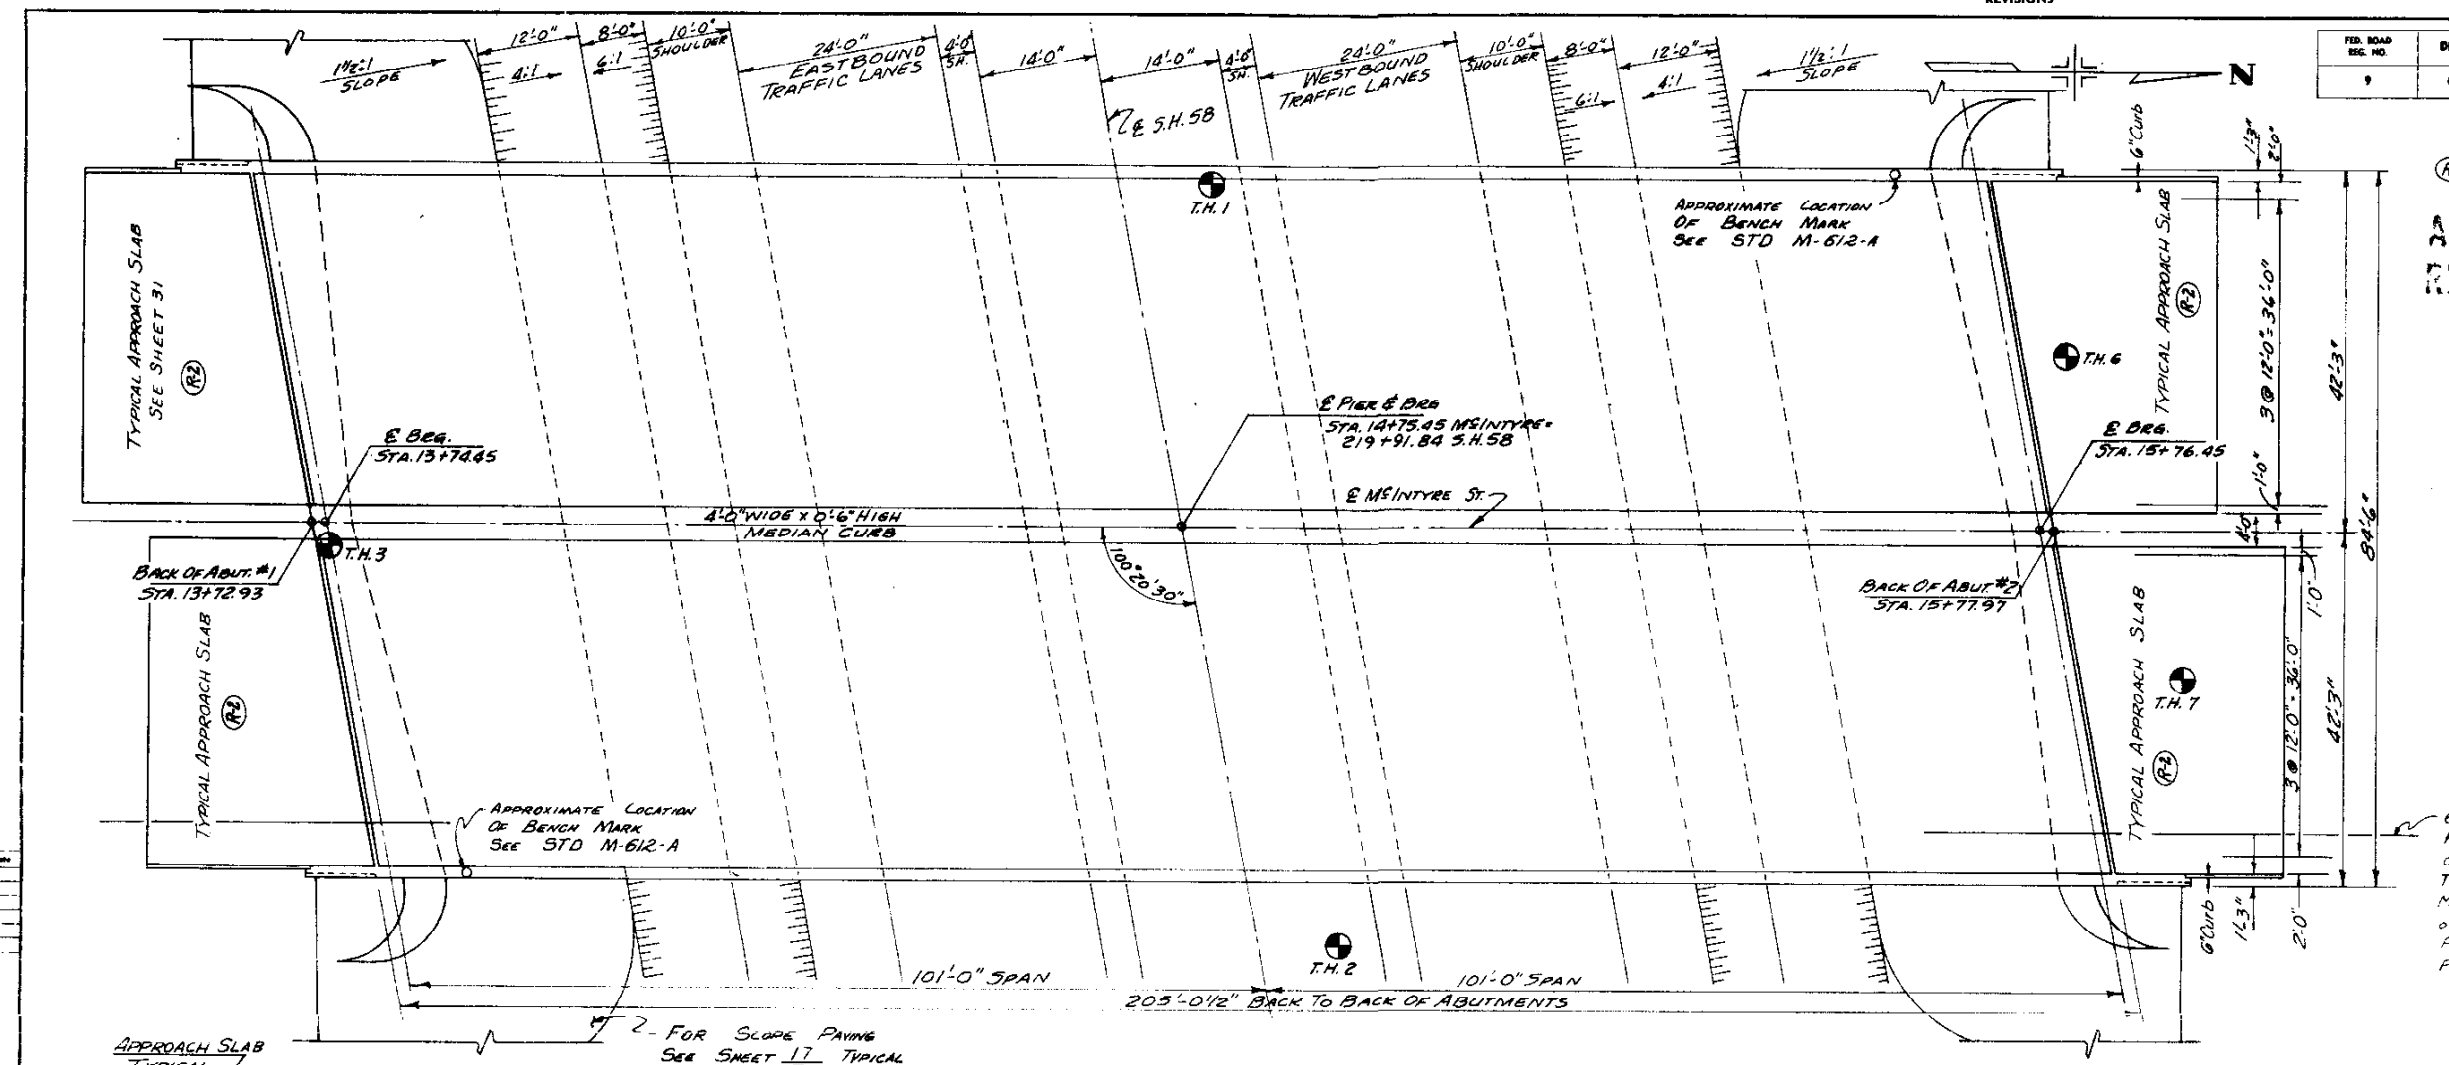

NOTE: CAISSONS DESIGNED FOR 40,000 p.s.f. END BEARING AND 3000 p.s.f. SIDE SHEAR FOR THE PORTION OF THE CAISSON IN HARD TO VERY HARD DARK BLUE-GRAY CLAYSTONE. DRILL CAISSONS MINIMUM OF 5'-0" INTO VERY HARD CLAYSTONE AT ABUTMENTS & 6'-0" INTO VERY HARD CLAYSTONE AT PIER.

- TEST HOLE SOUNDINGS**
- FILL, ROADWAY EMBANKMENT, GRAVEL, COBBLES, SAND AND CLAY.
 - SAND, LOOSE, SILTY, WET, ORGANIC IN PART, BROWN TO BLACK (SP-OL).
 - GRAVEL, MEDIUM DENSE TO VERY DENSE, SANDY SILTY, COBBLES, MOIST TO WET, FEW THIN LOOSE SAND LAYERS AND CLAY LAYERS, BROWN, OCCASIONAL BOULDERS (GP).
 - CLAYSTONE, FIRM TO MEDIUM HARD, WEATHERED DARK BLUE-GRAY.
 - CLAYSTONE, HARD TO VERY HARD DARK BLUE-GRAY.
- INDICATES THAT 50 BLOWS OF A 140 POUND HAMMER FALLING 30 INCHES WERE REQUIRED TO DRIVE A 2-INCH DIAMETER SAMPLER 0 INCHES.
- FREE WATER LEVEL & NUMBER OF HOURS AFTER DRILLING THAT MEASUREMENT WAS TAKEN.

ELEVATION

**SUMMARY OF QUANTITIES
MCINTYRE BRIDGE**

ITEM	DESCRIPTION	UNIT	Super	Abut #1	Abut #2	Total
206	Structure Excavation (Haul)	Cu Yd		105	105	210
206	Structure Backfill, C13 (Haul)	Cu Yd		20	20	40
503	Drilled Caissons (36" dia.)	Lin Ft	135.05	30.12	120.00	285.17
507	Conc. Slope & Ditch Ave (Reinf.)	Cu Yd	236.55			236.55
509	Structural Steel (Galv.)	Lbs	6225	15630		21855
516	Dampproofing (Unseed Oil)	Sq Yd	2442			2442
601	Concrete Class 2"	Cu Yd	415.016	39.91		454.926
601	Concrete Class 2"	Cu Yd	105.753	54.25	54.25	214.253
602	Reinforcing Steel	Lbs	30076	4100		40176
613	1 1/2" Electrical Conduit	Lin Ft	410	500		910
613	4" Electrical Conduit	Lin Ft	1599	1516		3115

HENNINGSON, DURHAM & RICHARDSON
ENGINEERS - PLANNERS - CONSULTANTS
CAPITOL LIFE CENTER
DENVER, COLORADO

**DEPARTMENT OF HIGHWAYS
STATE OF COLORADO**

GENERAL LAYOUT

UNDER MCINTYRE ST.
Sta. 219 + 91.84
Near GOLDEN Sec. 24 T. 3 S. R. 20W

Designed by R.E.R. Approved by
Made by A.T.
Checked by W.A.S. Date: 19

(1) Non-Federal Aid: Mountain States TeleTel Company To Reimburse The Colorado Division of Highways For This Work. All work Necessary To Accomplish This Item Shall Be Incl. In The Bid Price For Item 613 & 614.

STRUCTURE NO. E-16-H Q

FED. ROAD REG. NO.	DIVISION	PROJECT NO.	SHEET NO.	TOTAL SHEETS
9	COLD.	F058-1 (2)	10	

(R-2) Rev. Notes D.J.S. 1-7-71

GENERAL NOTES

All work shall be done according to the Standard Specifications of the Colorado Department of Highways applicable to the project.

Concrete shall be Class "A" or Class "D."

All reinforcing steel shall be intermediate grade steel of a deformed type. Each bar shall be tagged with the bar designation and station number of the project.

Dimensions for reinforcing steel not shown as clear shall be to the centerline of the bar.

Soundings and depth of footings are in accordance with the best available data and when different conditions are encountered the Bridge Engineer will inspect and determine if redesign is necessary.

For details of structural excavation and structure backfill, see Standard M-206-A
All concrete surfaces marked with the symbol S as shown on Sht No. 29 shall receive
class 2" surface finish.

If by permission of the Engineer primary bars are spliced, they shall lap a minimum of 40 diameters for bars near the top of beams having more than 12 inches of concrete under the bars, and 24 diameters for bars near the bottom of members. Secondary bars when spliced shall lap 24 diameters of the bar.

All concrete chomfers to be $\frac{3}{4}$ " unless otherwise noted.

All structural steel not otherwise noted shall be AASHTO M-183.

All welding shall conform to the latest edition of the AWS Standard Specifications for welding highway bridges as amended.

Bolts shall be furnished in the amount of two percent in excess of the nominal number required for each size and length.

Girder shoring shall remain in place until slab has been poured and concrete has reached a minimum compressive strength of 2400 psi or 14 days lapsed time. All shoring shall be collapsed prior to opening bridge to traffic.

Shoring diagrams shall be furnished to the Engineer.

BAR LISTS

PIER NO. 1				
MARK	SIZE	SHAPE	NO. REQ'D.	LENGTH
H 1101	11	—	80	5'-0"
P 1101	11	—	208	18'-11"
P 1001	10	—	24	37'-0"
P 401	4		151	9'-5"
P 801	8	—	4	37'-0"
P 501	5	—	12	37'-0"
P 402	4		152	16'-6"

ABUTMENT NO. 1 & 2				
A 501	5	—	40	37'-0"
A 901	9	—	24	37'-0"
A 401	4		152	18'-5"
A 402	4	—	40	4'-3"
A 403	4	—	32	5'-3"
A 502	5	—	8	2'-3"
A 503	5	—	8	2'-6"
A 504	5	—	8	3'-0"
A 505	5	—	8	3'-3"
A 506	5	—	8	3'-6"
A 507	5	—	8	4'-0"
A 508	5	—	8	4'-3"
A 509	5	—	8	4'-9"
A 510	5	—	8	5'-0"
A 511	5	—	8	5'-3"
A 512	5	—	8	5'-6"
A 513	5	—	8	6'-0"
A 514	5	—	8	6'-3"
A 515	5	—	8	6'-6"
A 516	5	—	8	6'-3"

A 517	5		4	4'-0"
A 518	5		4	5'-6"
A 519	5		4	6'-9"
A 520	5		4	8'-0"
A 521	5		4	9'-3"
A 522	5		4	10'-6"
A 523	5		16	11'-5"
A 524	5		4	2'-9"

ABUTMENT NO. 1 & 2 (Con't)				
MARK	SIZE	SHAPE	NO. REQ'D.	LENGTH
A 525	5		60	2'-11"
A 526	5		4	4'-0"
A 527	5		4	5'-6"
A 528	5		4	6'-9"
A 529	5		4	8'-0"
A 530	5		4	9'-3"
A 531	5		4	10'-6"
A 532	5		16	11'-5"
A 533	5		4	2'-9"
A 534	5		4	4'-0"

DECK SLAB				
MARK	SIZE	SHAPE	NO. REQ'D.	LENGTH
S 501	5	—	8	7'-3"
S 502	5	—	8	10'-6"
S 503	5	—	8	12'-9"
S 504	5	—	8	14'-9"
S 505	5	—	8	17'-6"
S 506	5	—	8	20'-9"
S 507	5	—	8	23'-6"
S 508	5	—	8	26'-0"
S 509	5	—	8	29'-0"
S 510	5	—	8	32'-0"
S 511	5	—	8	34'-6"
S 512	5	—	8	38'-0"
S 513	5	—	8	40'-0"
S 514	5	—	1636	40'-6"
S 515	5	—	8	4'-0"
S 516	5	—	8	8'-0"
S 517	5	—	8	12'-0"
S 518	5	—	8	16'-0"
S 519	5	—	8	21'-0"
S 520	5	—	8	24'-6"
S 521	5	—	8	29'-0"

BAR LISTS

DECK SLAB (Con't)				
MARK	SIZE	SHAPE	NO. REQ'D.	LENGTH
S522	5	————	8	33'-0"
S523	5	————	8	35'-0"
S524	5	————	988	36'-6"
S525	5	————	72	11'-0"
S526	5	————	360	40'-0"
S527	5	————	300	40'-0"
S528	5	————	60	11'-0"
S542	5		52	4'-8"
CW401	4		206	8'-7"
CW402	4	————	20	40'-0"
CW403	4	————	4	10'-0"
C401	4		103	4'-4"
C402	4	————	15	40'-0"
C403	4	————	3	10'-0"
C601	6		205	4'-0"
B401	4		988	4'-0"
B402	4		744	4'-3"

Plan
error

GIRDERS

MARK	SIZE	SHAPE	NO. REQ'D.	LENGTH
G401	4	—	240	40'-0"
G402	4	—	96	8'-3"
G403	4		2,904	11'-11"
G404	4		160	12'-6"
G405	4	—	144	3'-6"
G501	5	—	32	36'-6"
G801	8	—	72	60'-0"
G802	8	—	48	18'-6"
G1105	11	—	48	60'-0"
G1101	11	—	48	20'-0"
G1102	11	—	32	26'-0"
G1103	11	—	32	38'-0"
G1104	11	—	32	50'-0"
G1105	11	—	112	60'-0"
G1106	11	—	64	7'-0"
G1107	11	—	48	22'-0"
G1108	11	—	32	17'-0"
G1109	11	—	24	35'-6"
G1110	11	—	8	43'-0"
G1111	11	—	8	50'-6"
G1112	11	—	32	38'-0"
G1113	11	—	32	50'-0"
G1114	11	—	32	59'-0"
G1115	11	—	32	60'-0"
G1116	11	—	32	60'-0"

GIRDERS (Con't)

MARK	SIZE	SHAPE	NO. REQ'D	LENGTH
G1117	11	—	64	60'-0"
G1118	11	—	16	41'-0"
G1119	11	—	16	57'-9"
G1120	11	—	16	60'-0"
G1121	11	—	32	60'-0"
G1122	11	—	32	17'-0"
G1123	11	—	64	18'-6"
G1124	11	—	32	16'-0"
G1125	11	—	16	13'-9"
S529	5	—	144	60'-0"
S530	5	—	16	37'-0"
S531	5	—	8	28'-0"
S532	5	—	16	16'-0"
S533	5	—	16	28'-0"
S534	5	—	16	37'-0"
S535	5	—	24	13'-6"
S536	5	—	24	27'-0"
S537	5	—	24	36'-0"
S538	5	—	80	17'-0"
S539	5	—	40	9'-6"
S540	5	—	136	60'-0"
S541	5	—	4	56'-0"
DRILLED CAISSONS			FOR INFORMATION ONLY	
ABUTMENT NO. 1				
A902	9	—	192	26'-11"
A404	4		380	9'-5"
ABUTMENT NO. 2				
A903	9	—	96	31'-9"
A404	4		235	9'-5"
PIER				
P1102	11	—	208	13'-6"
P401	4		128	9'-5"
P1102	11	—	26	13'-0"

BAR SUMMARY

PIER NO. 1

<u>3930</u>	L.F. #4 @ 0.668 #/ft. =	<u>2625.2</u>	10b
<u>444</u>	L.F. #5 @ 1043 #/ft. =	<u>463.1</u>	10b
<u>148</u>	L.F. #8 @ 2670 #/ft. =	<u>395.2</u>	10b
<u>888</u>	L.F. #10 @ 4303 #/ft. =	<u>3821.1</u>	10b
<u>4335</u>	L.F. #11 @ 5313 #/ft. =	<u>23031.9</u>	10b
	TOTAL PIER = 1-	<u>30396.5</u>	10b

ABUTS. NO. 1 & 2

<u>3.137</u>	LF #4 @ 0.668 #/ft *	<u>2095.5</u>	lb.
<u>2.959</u>	LF #5 @ 1.043 #/ft *	<u>3086.2</u>	lb.
<u>888</u>	LF #9 @ 3.400 #/ft *	<u>3019.2</u>	lb.
TOTAL ABUTS #1 @ #2		<u>8200.9</u>	lb.

DECK SLAB

<u>9,562</u>	L.F. #4 @ 0.668 "/FT. =	<u>6,387.4</u>	10
<u>134,327</u>	L.F. #5 @ 1.043 "/FT. =	<u>140,103.1</u>	10
<u>820</u>	L.F. #6 @ 1.502 "/FT. =	<u>1,231.6</u>	10
TOTAL DECK SLAB		<u>147,722.1</u>	10

GIRDERS

47.502	L.F. #4 @ 0.668 %/FT.	31.731 3	16
23.880	L.F. #5 @ 1.043 %/FT.	24.906 8	16
5.208	L.F. #8 @ 2.470 %/FT.	13.805 4	(65)
34.152	L.F. #10 @ 5.313 %/FT.	181.443 6	16
37.032	TOTAL GIRDERS	266.000 7	16
		267.294	



Drilled CAISSON STEEL IS NOT INCLUDED
IN BAR SUMMARY. PRICE OF
Drilled CAISSON STEEL TO BE INCLUDED
IN PRICE OF ITEM 503.

HENNINGSON, DURHAM & RICHARDSON
ENGINEERS · PLANNERS · CONSULTANTS
CAPITOL LIFE CENTER
DENVER, COLORADO


DEPARTMENT OF HIGHWAYS
STATE OF COLORADO
REINFORCING BAR LIST
SUMMARY OF QUANTITIES
AND GENERAL NOTES

UNDER McINTYRE ST.	
Sta. 219+91.84	
Near GOLDEN	Sec. 24 T.3S R.70W
Designed by R.E.R.	Approved by
Made by D.A.S.	
Checked by W.A.S.	Date: 19

26 13'-0" E-16-HQ
STRUCTURE NO.

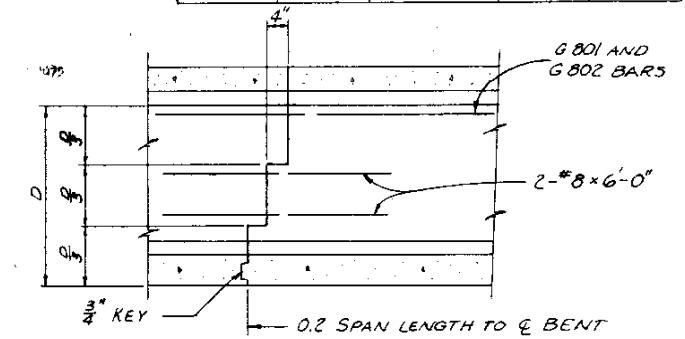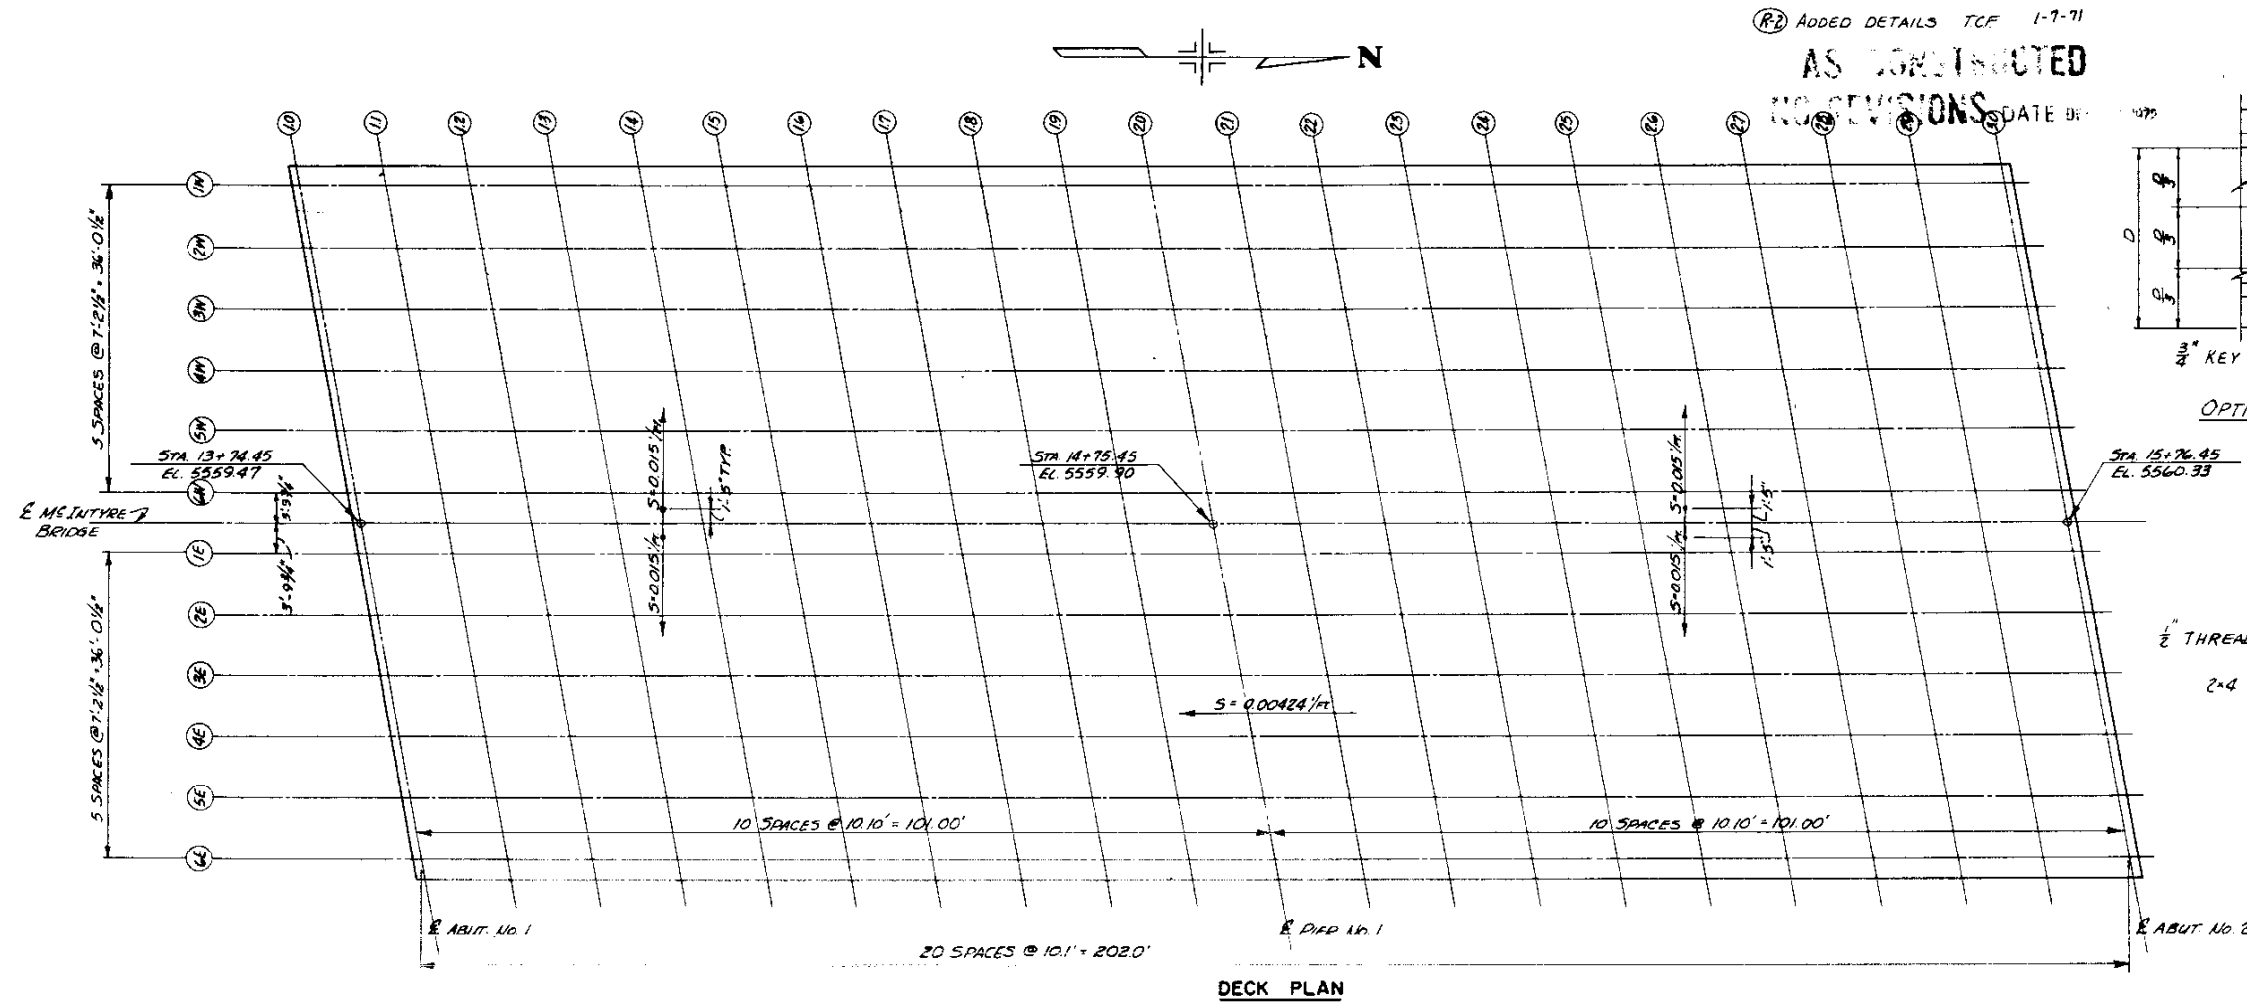


OPTIONAL GIRDER CONSTRUCTION JOINT (R-2)

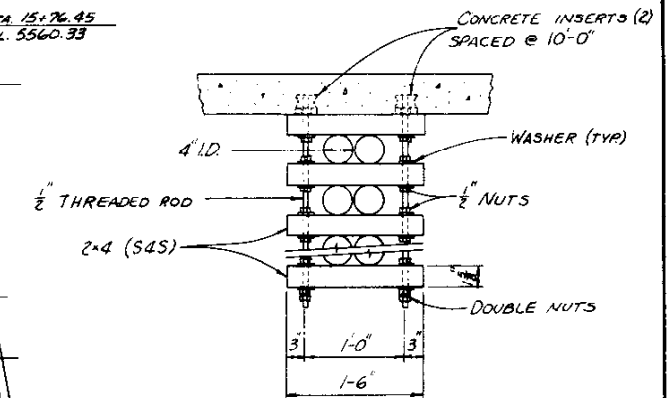

SUSPENDED TELEPHONE
CONDUIT DETAILS (R-2)

TOP OF DECK - ELEVATION 5500.00±																																																																																																																																																																																																																																																																																																																																																																																																																																																																																																																																																																																																																																																																																																																																																																																																																																																																																																																																																																																																																																																																																																																																																																																																																																																																																																																																																																																														
	SPAN No. 1 = 101'-0"															SPAN No. 2 = 101'-0"																																																																																																																																																																																																																																																																																																																																																																																																																																																																																																																																																																																																																																																																																																																																																																																																																																																																																																																																																																																																																																																																																																																																																																																																																																																																																																																																																																														
SHORER NO.	10	11	12	13	14	15	16	17	18	19	20	21	22	23	24	25	26	27	28	29	30																																																																																																																																																																																																																																																																																																																																																																																																																																																																																																																																																																																																																																																																																																																																																																																																																																																																																																																																																																																																																																																																																																																																																																																																																																																																																																																																																																									

NOTE: ALL ELEVATIONS INCLUDE DEAD LOAD DEFLECTIONS.

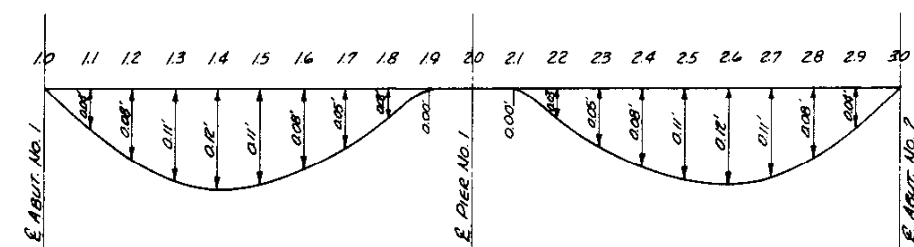

LOAD DEFLECTION DIAGRAM

Ⓜ NOTE:

NOTE: KEEP THE LEADING EDGE OF THE CONCRETE PARALLEL TO THE ABUTMENTS SO THAT THE GIRDERS WILL BE LOADED EVENLY DURING THE POURING AND SCREEDING OPERATIONS. AN APPROVED RETARDER SHALL BE USED WHEN NECESSARY IN ORDER TO RETAIN THE WORKABILITY OF THE CONCRETE.




DEPARTMENT OF HIGHWAYS
STATE OF COLORADO
DECK ELEVATIONS
AND LOAD
DEFLECTION DIAGRAM

UNDER MCINTYRE ST.
Sta. 219+91.84
Near GOLDEN Sec. 24 T. 3S. R. 70W
Designed by R.E.R. Approved by
Made by D.A.S.
Checked by W.A.S. Date: 19

HENNINGSON, DURHAM & RICHARDSON
ENGINEERS · PLANNERS · CONSULTANTS
CAPITOL LIFE CENTER
DENVER, COLORADO

STRUCTURE NO. E - 16 - HQ

44WAYS

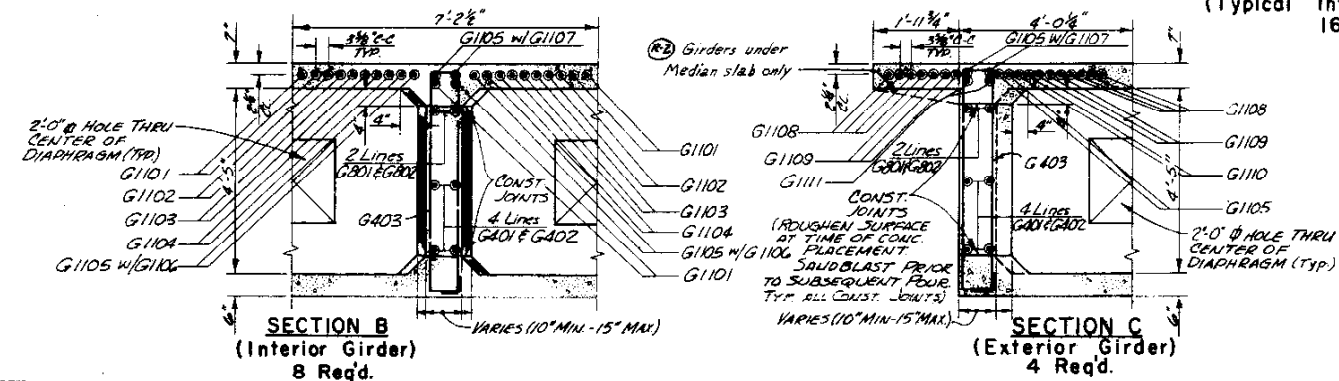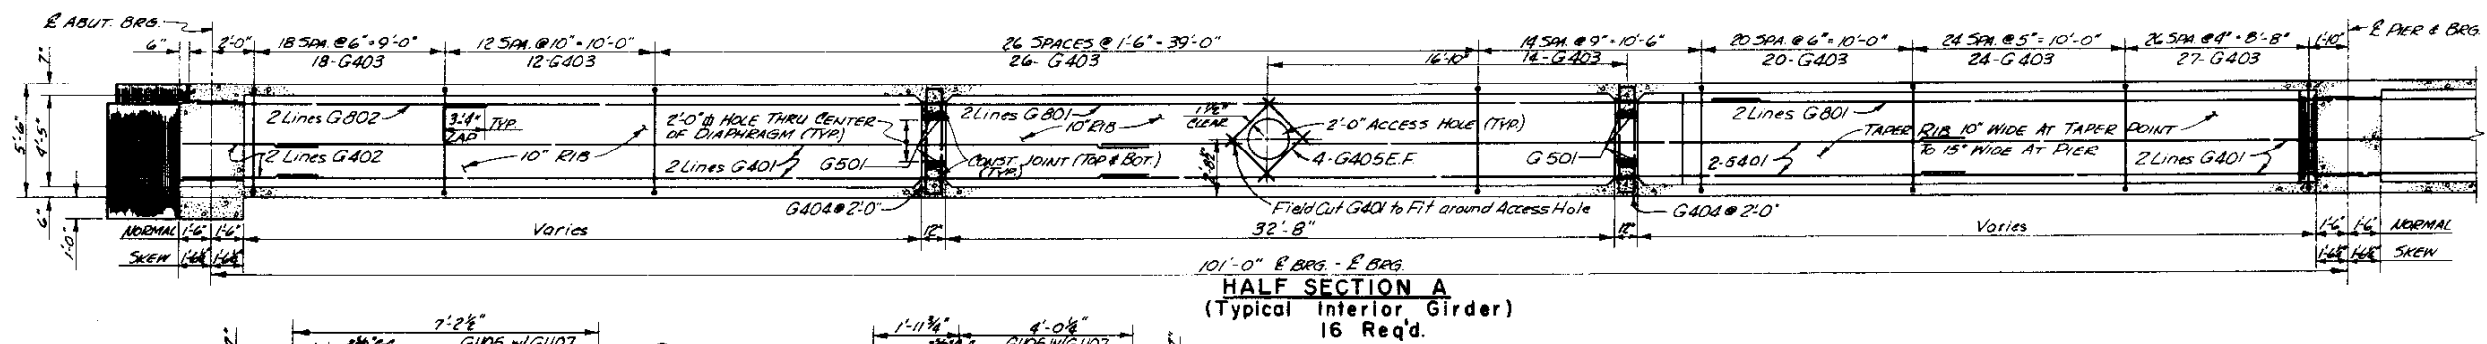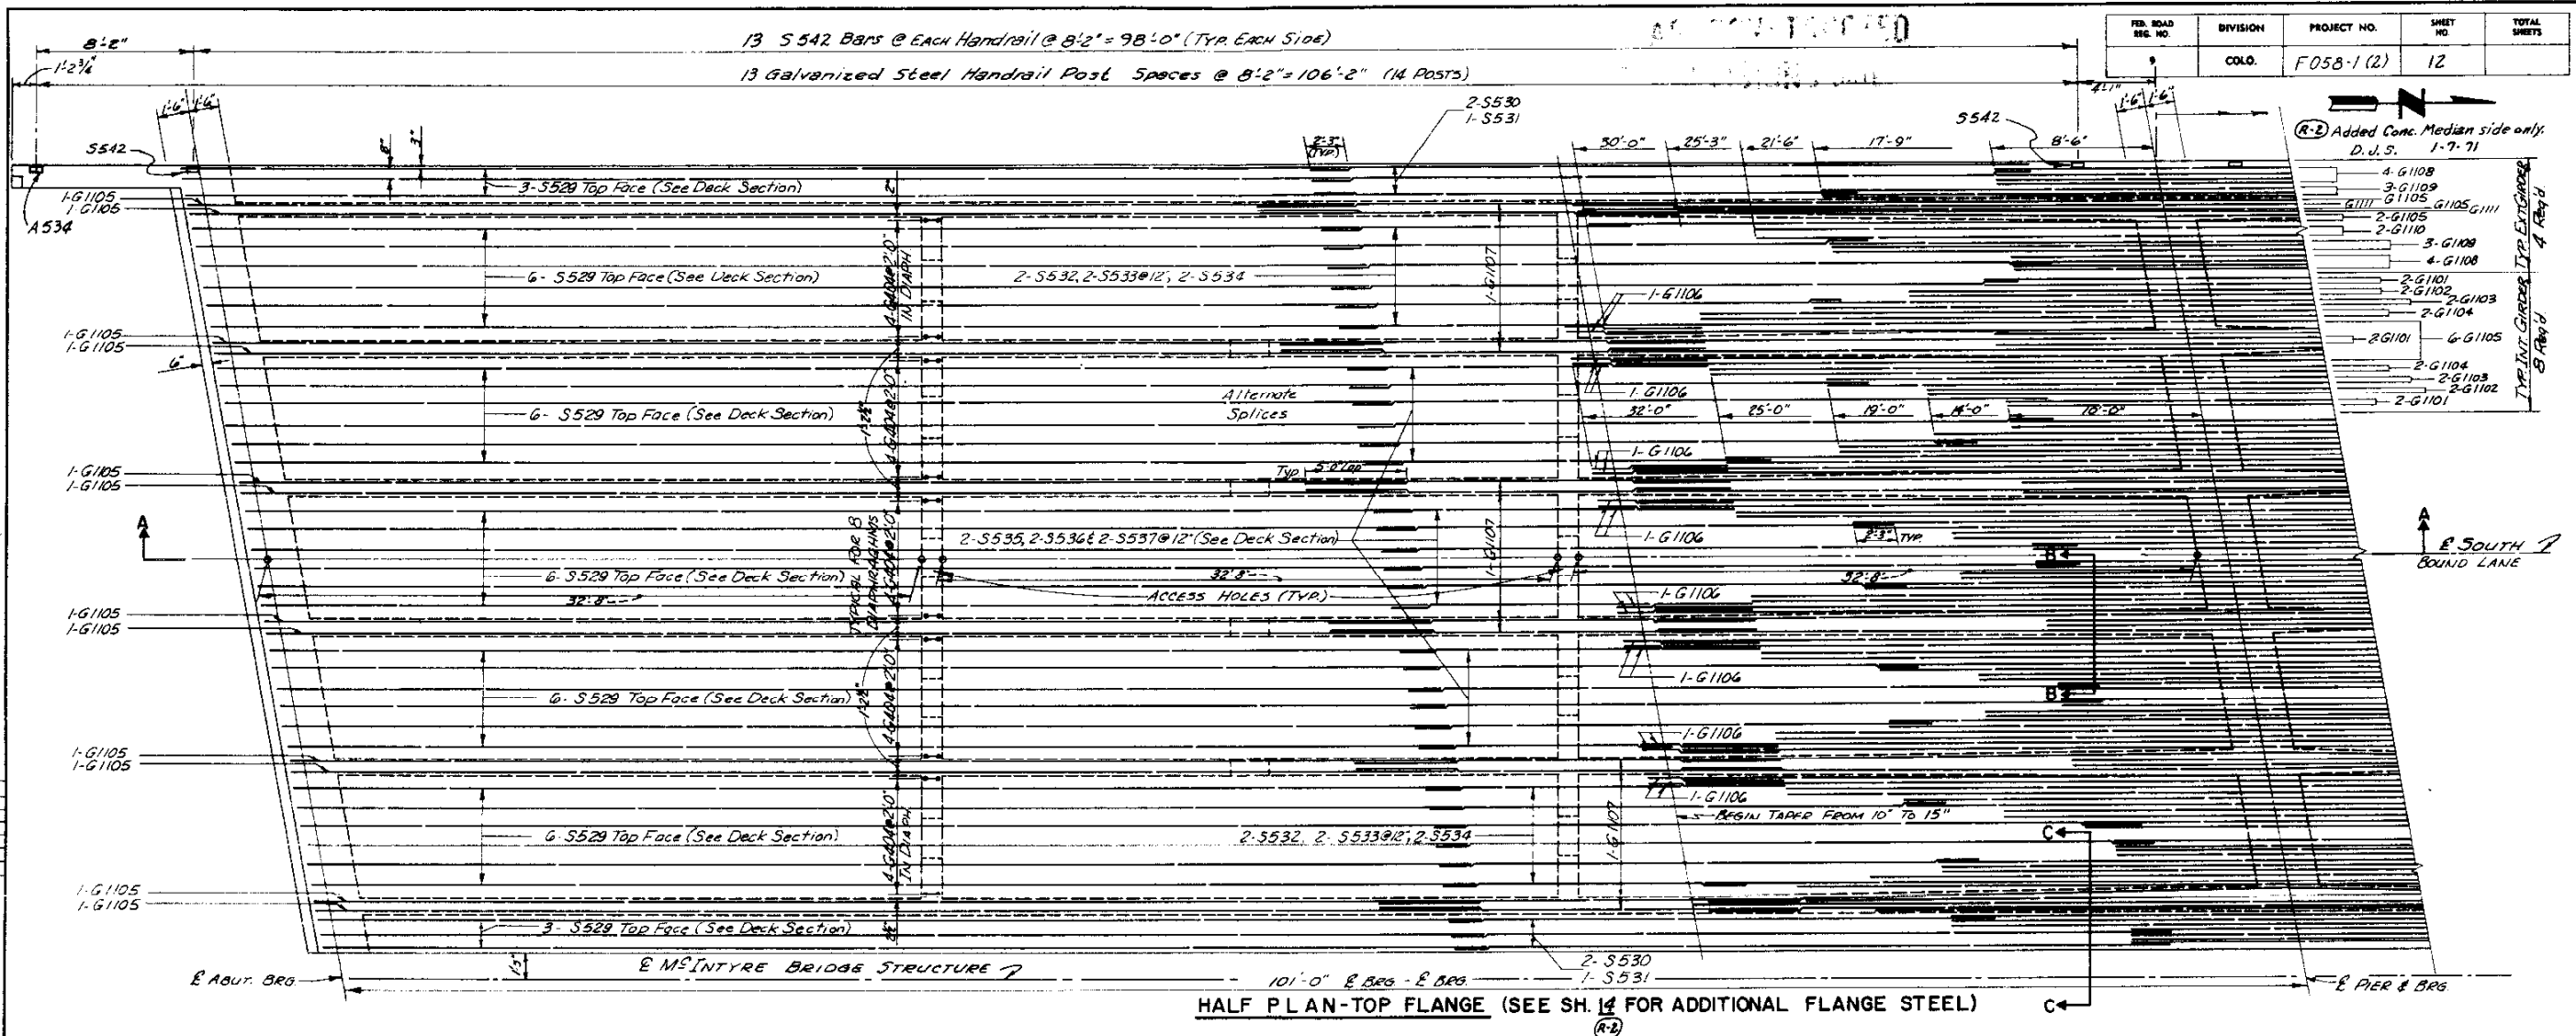

LAGOUT BRS.	1	2	3	4	5	6	7	8	9	£ PIER
0	0.04	0.08	0.11	0.12	0.11	0.08	0.05	0.02	0	0

DEAD LOAD DEFLECTION (FT.)

HENNINGSON, DURHAM & RICHARDSON
ENGINEERS · PLANNERS · CONSULTANTS
CAPITOL LIFE CENTER
DENVER, COLORADO

STRUCTURE NO. E-16-HQ

DEPARTMENT OF HIGHWAYS
STATE OF COLORADO
GIRDER DETAILS
TOP FLANGE


UNDER MCINTYRE ST.	
Sta. 219+91.84	
Neat.	GOLDEN Sec. 24 T. 3 S. R. 70 W.
Designed by R.E.R.	Approved by
Made by D.A.S.	
Checked by W.A.S.	Date: 19

REVISIONS



REVISIONS

FED. ROAD DIST. NO.	DIVISION	PROJECT NO.	SHEET NO.	TOTAL SHEETS
9	COLO.	F 058-1 (2)	13	

(R3) Deleted Notes, Added Note,
Added Concrete, D.J.S. 1-7-71

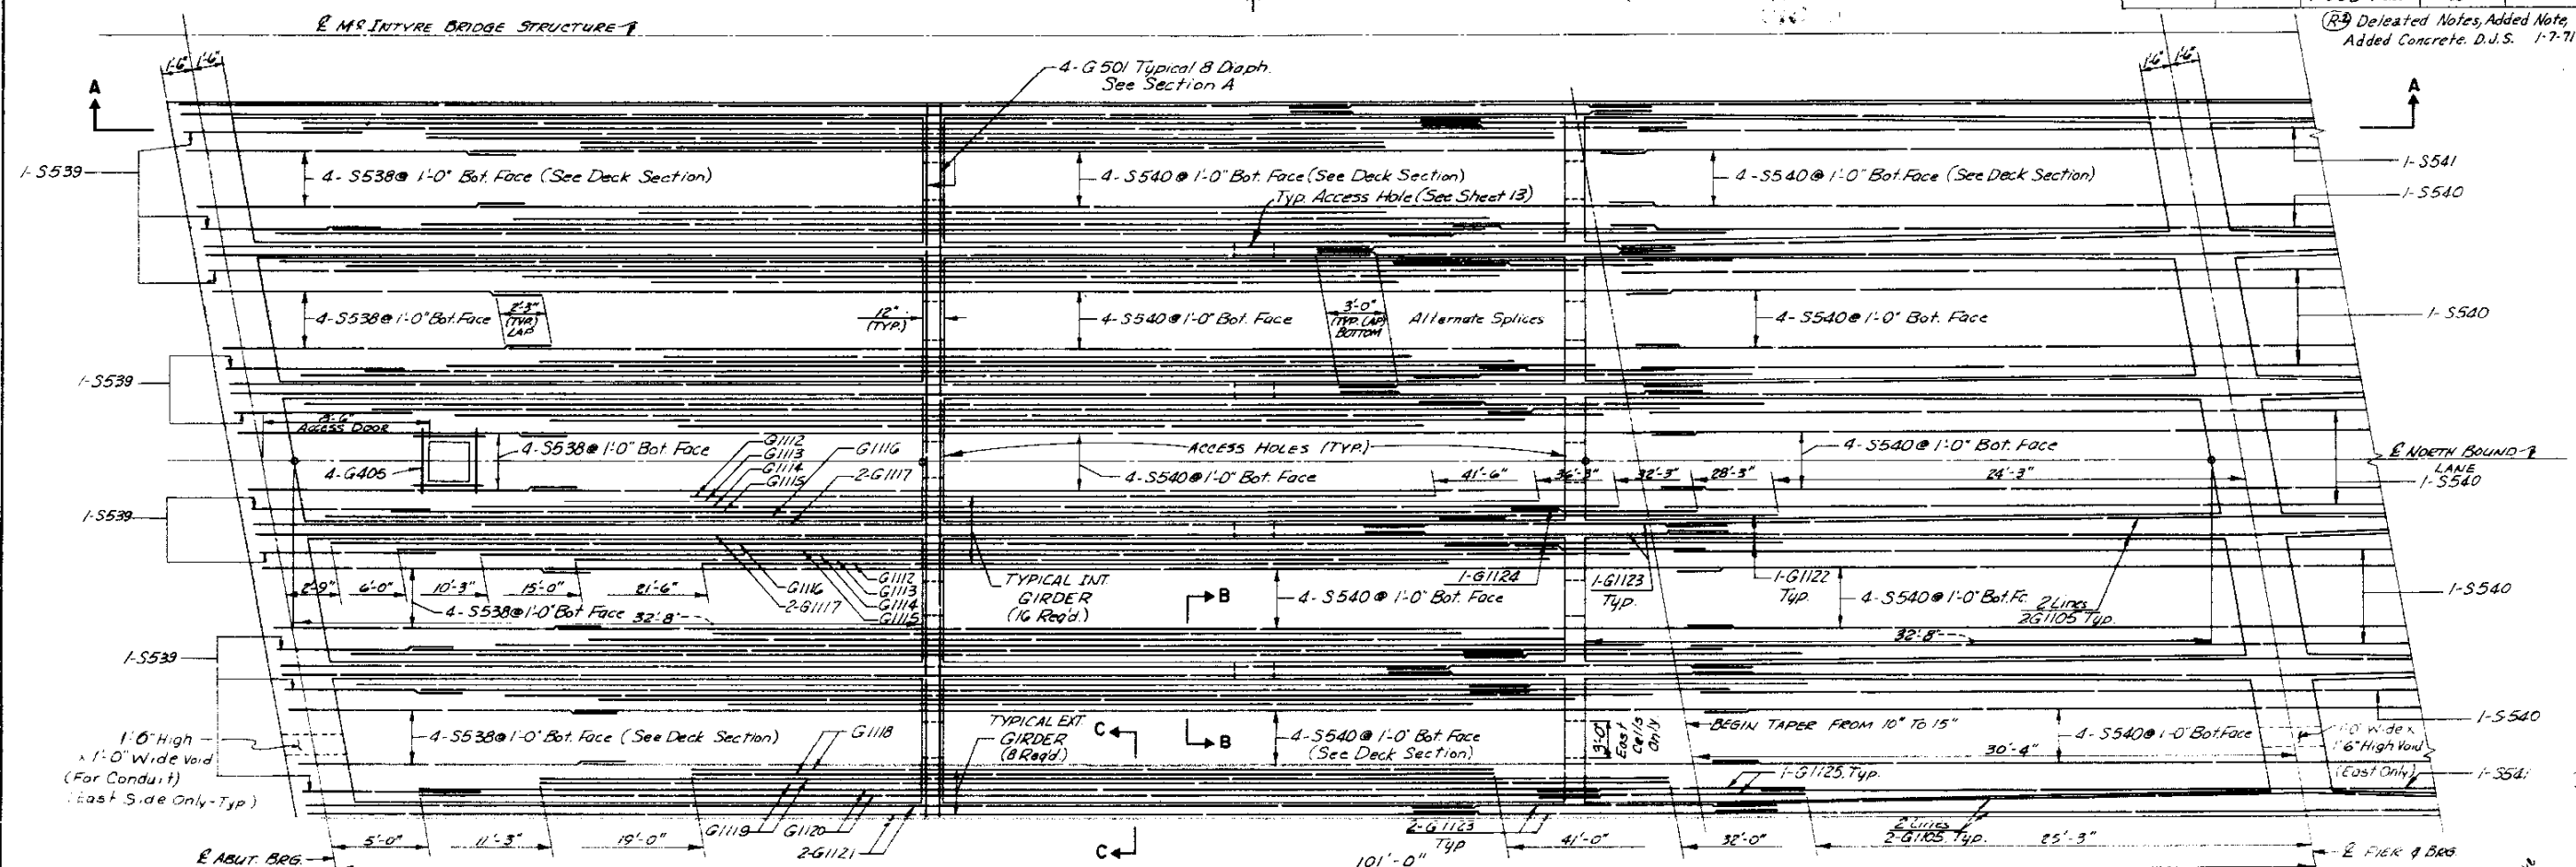


HALF PLAN BOTTOM FLANGE (SEE SH. 14 FOR ADDITIONAL FLANGE STEEL)

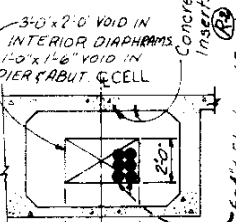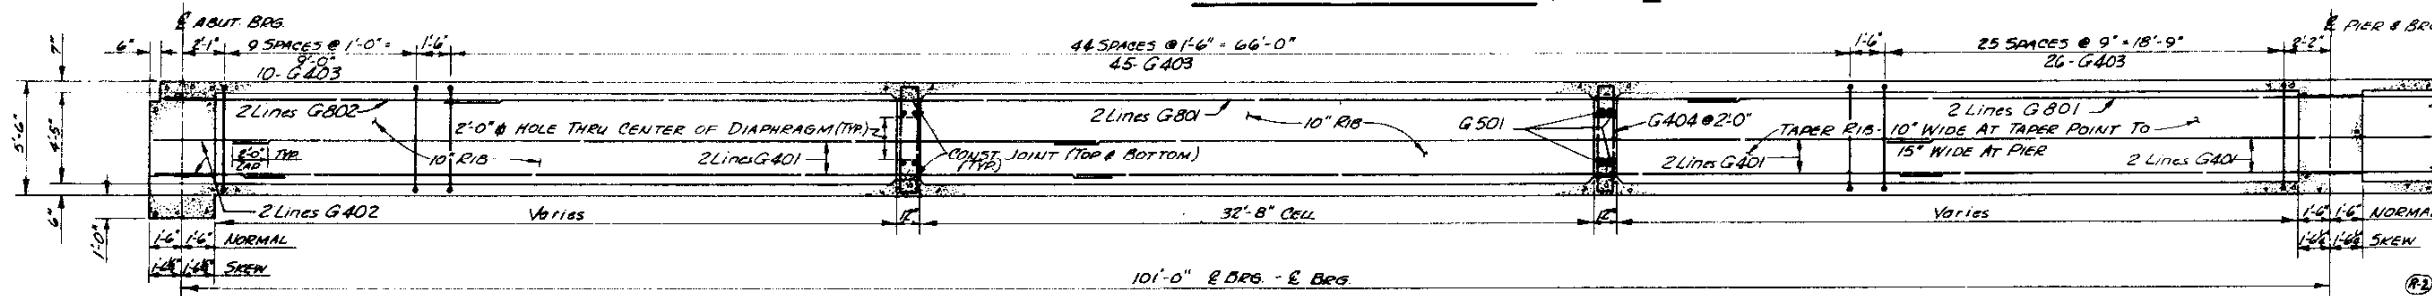



SECTION THRU
EAST CELL
(See Sheet 11 for
hanger Details)

HALF SECTION A
(TYPICAL EXTERIOR GIRDER)
8 REQD.

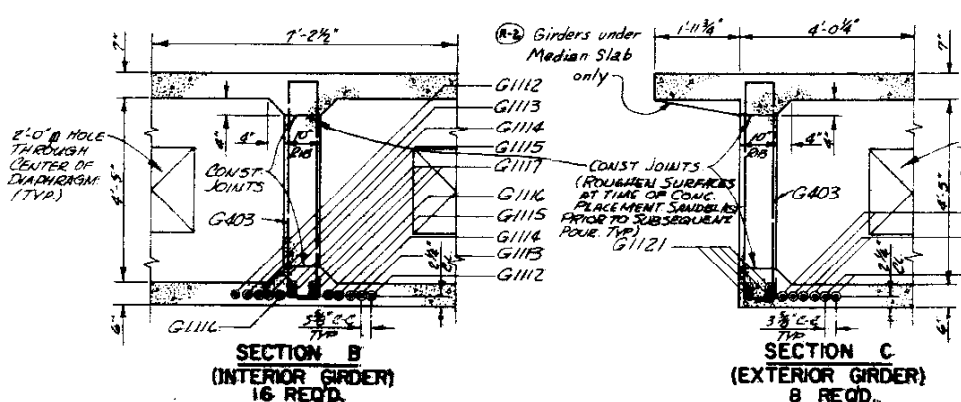

Access Door Notes:

Set hinge end nearest to and parallel to abutments. Door, frame and hardware to be galvanized.
Bottom slab and girder reinforcing which interferes with access doors or holes may be field bent or cut to clear.
(Price of Access Doors and Framing Included in Bid Price for Item 601 Concrete, Class D)

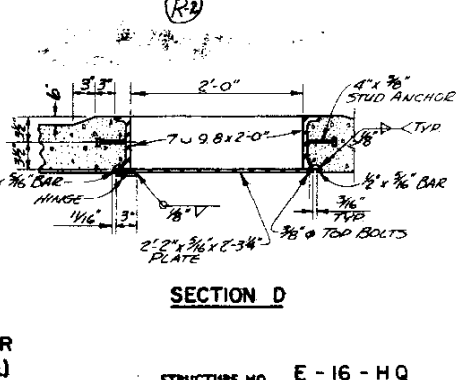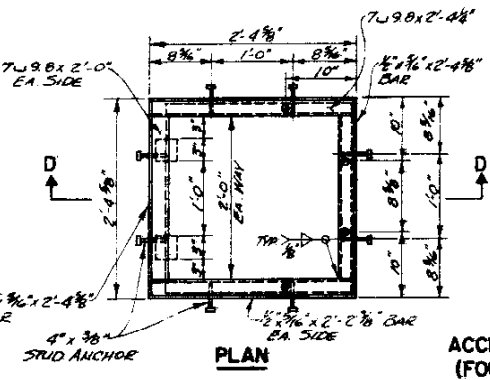

SECTION D

HENNINGSON, DURHAM & RICHARDSON
ENGINEERS - PLANNERS - CONSULTANTS
CAPITOL LIFE CENTER
DENVER, COLORADO

DEPARTMENT OF HIGHWAYS
STATE OF COLORADO
GIRDER DETAILS
BOTTOM FLANGE

UNDER MCINTYRE ST
Sta. 219+91.84
Near GOLDEN Sec. 24 T. 35 R. 70W
Designed by R.E.R. Approved by
Made by D.A.S. Checked by W.A.S. Date: 19



STRUCTURE NO. E-16-HQ

REVISIONS


NOT REVISIONED

REV. NO.	DESCRIPTION	PROJECT NO.	SHEET NO.	TOTAL SHEETS
1	COLO.	F058-1 (2)	14	

ADDED DETAILS T.C.F. 1-7-71

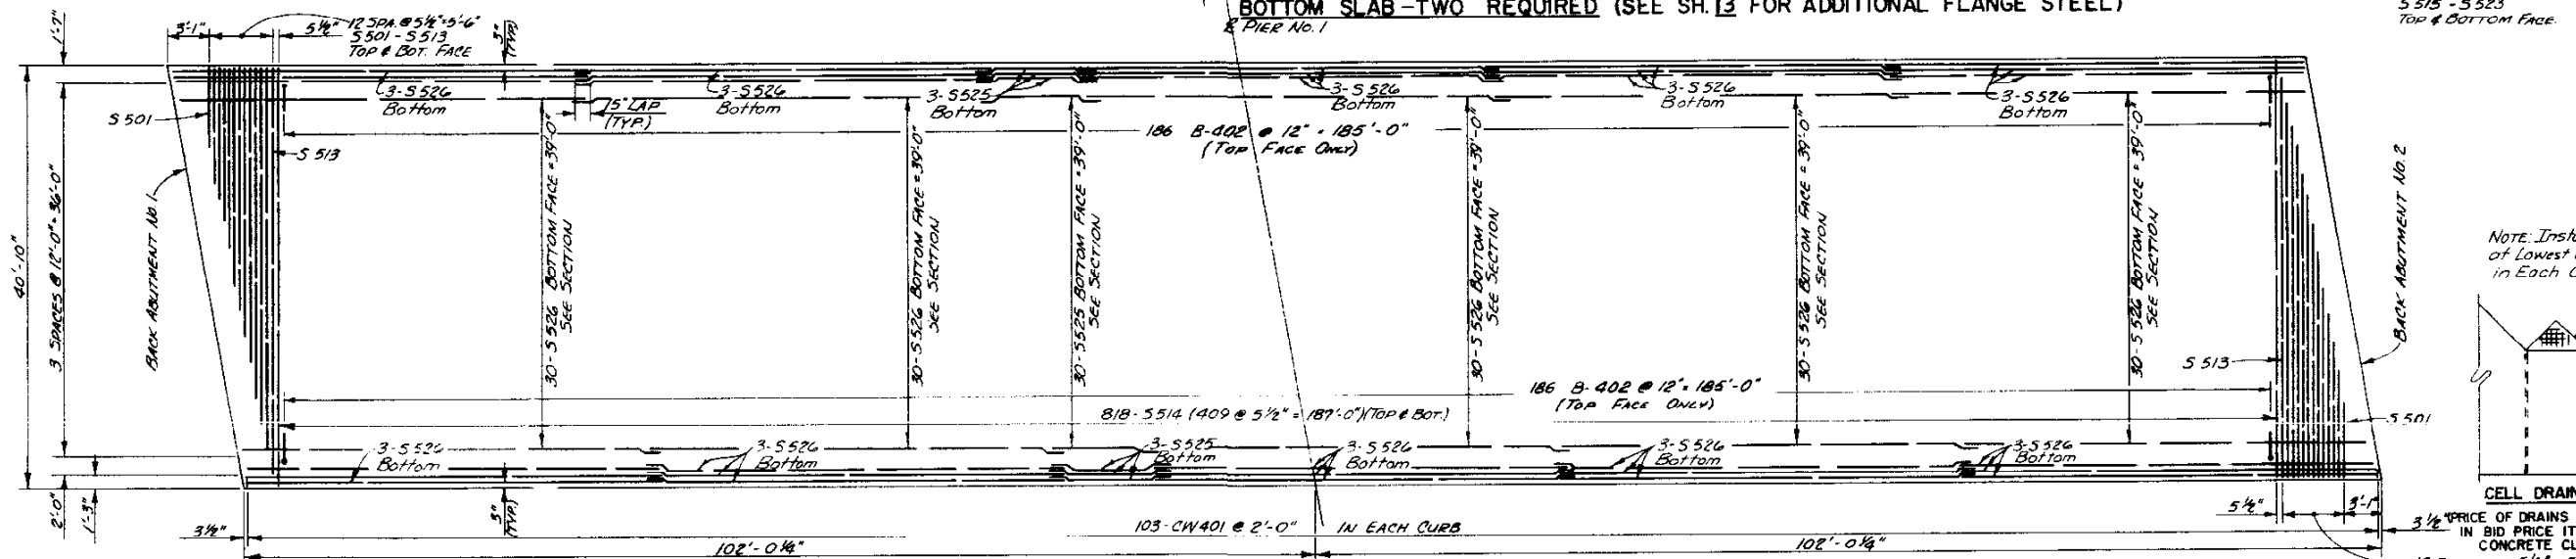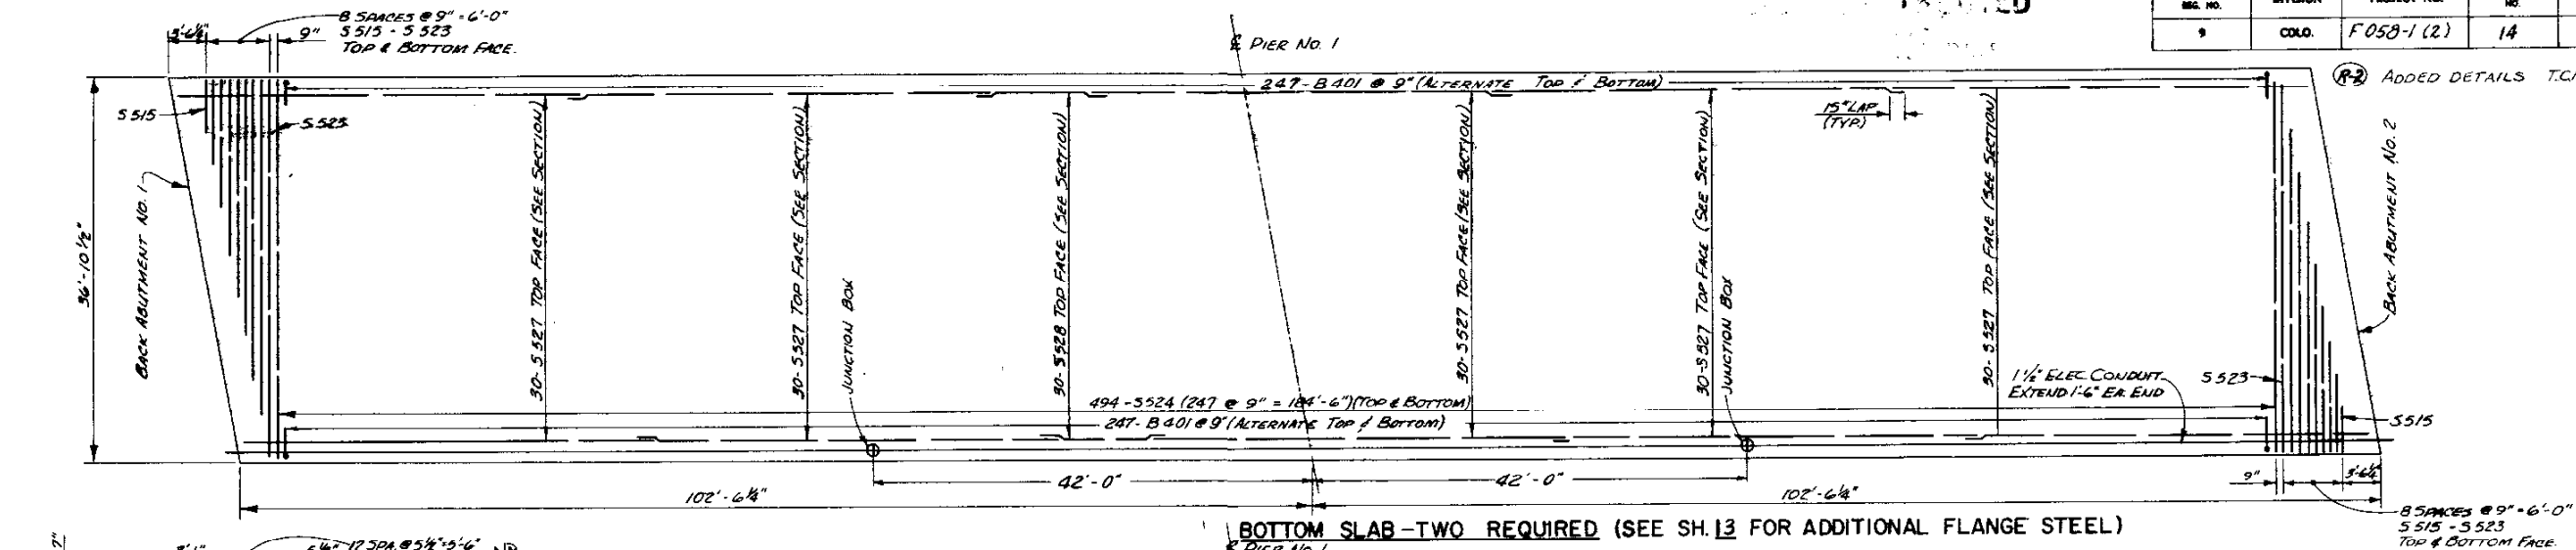


NOTE: Install Drains of Lowest Elevation in Each Cell

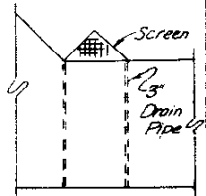

CELL DRAIN DETAIL

3/4\"/>

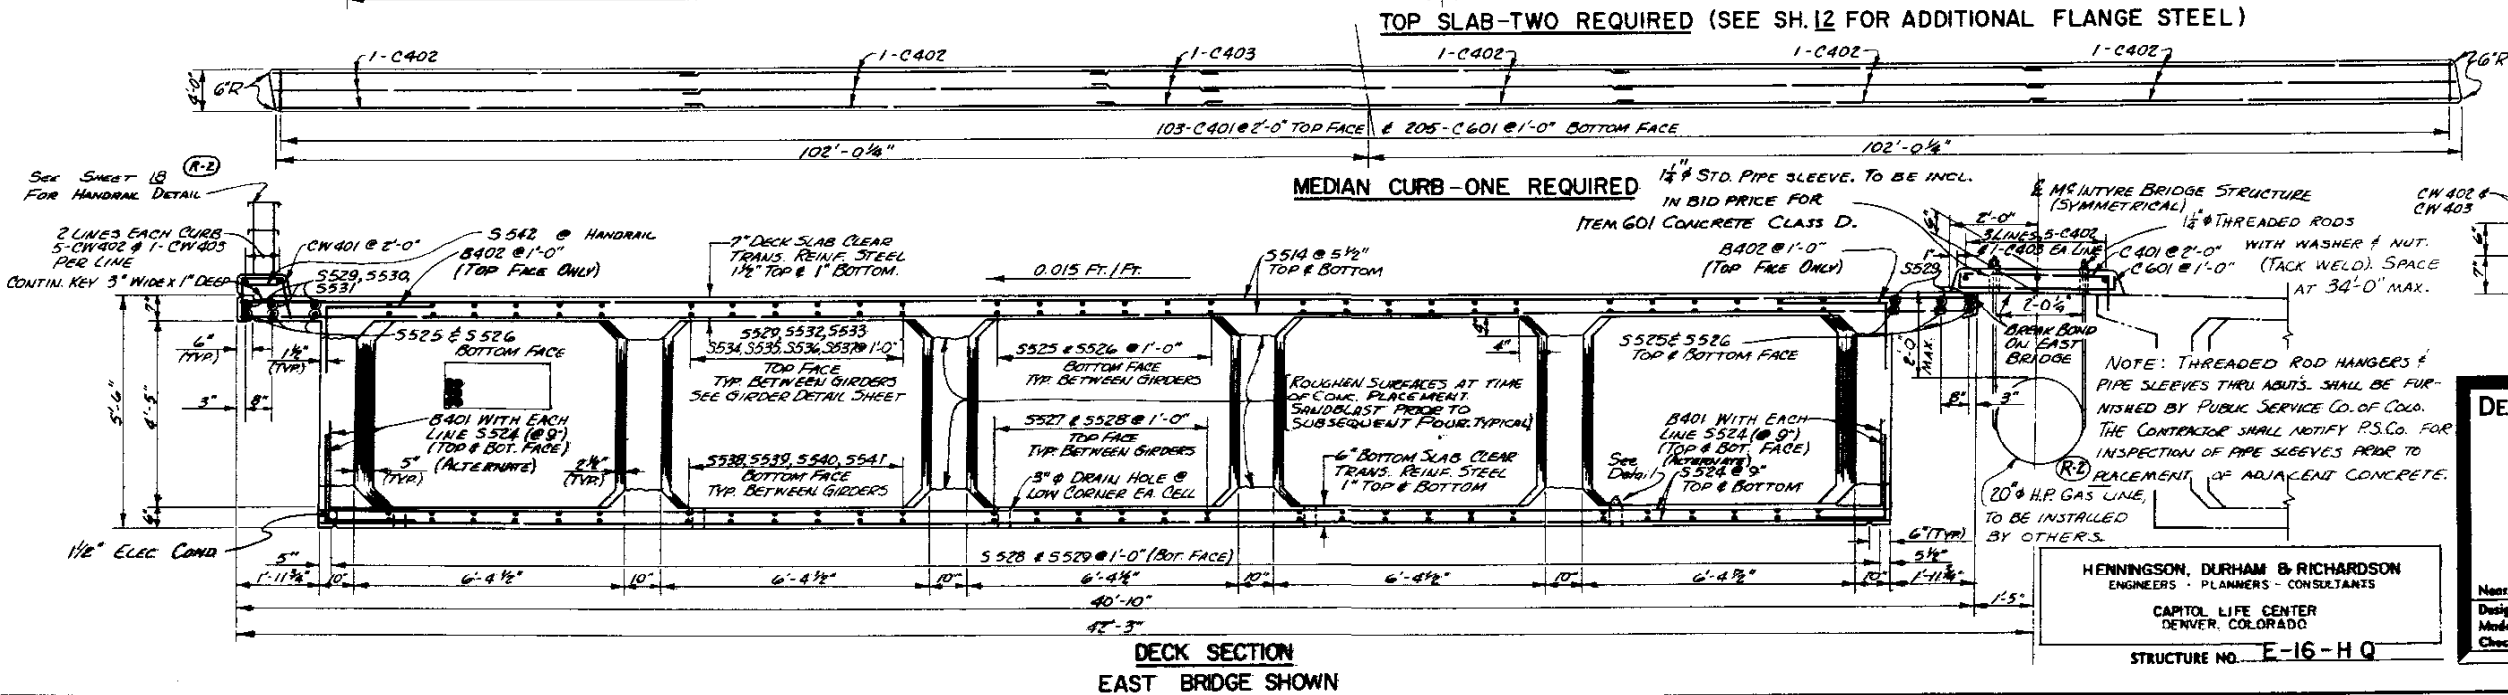

See SHEET 13 (R-2) FOR HANDRAIL DETAIL

2 LINES EACH CURB 5-CW402 @ 1'-0\"/>

CONTIN. KEY 3\"/>

5'-6\"/>

5'-0\"/>

5'-0\"/>

5'-0\"




REVISIONS

FED. ROAD DIST. NO.	DIVISION	PROJECT NO.	SHEET NO.	TOTAL SHEETS
9	COLD.	F058-1 (2)	15	

Added Concrete, Added 20" H.P. Gas Line, D.I.S. 1-7-71

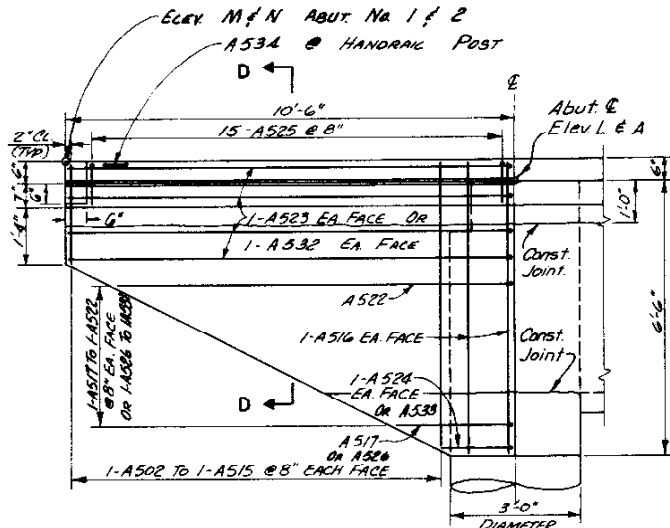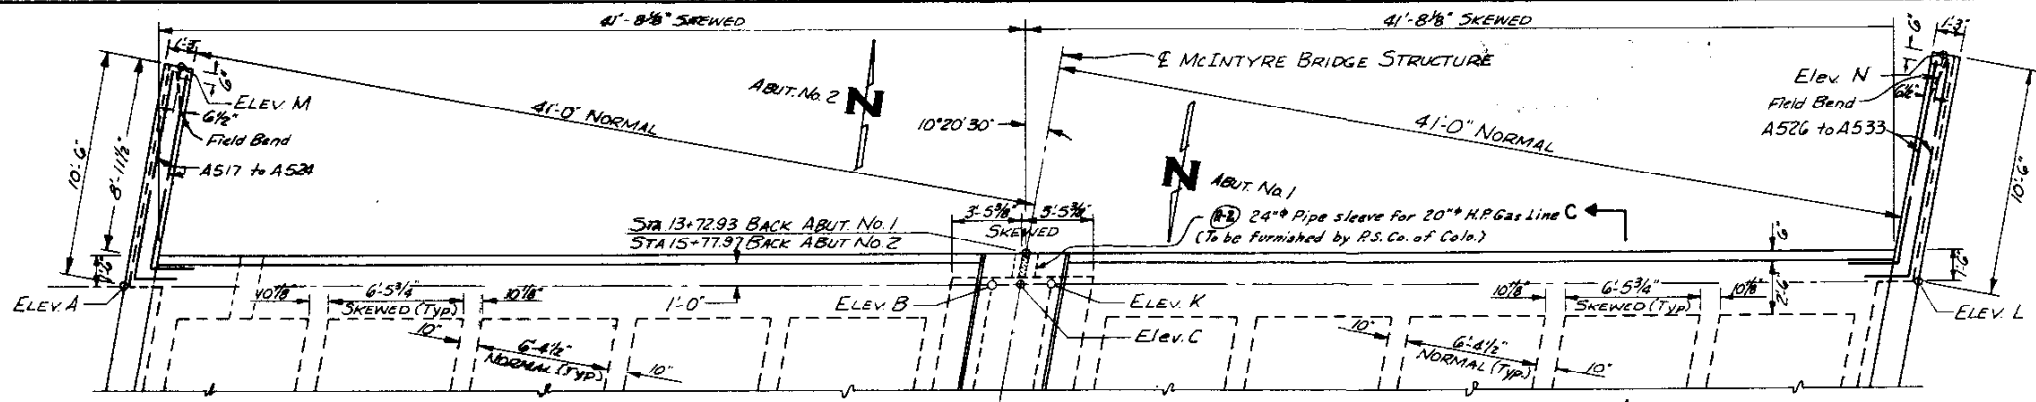

NOTE: DIMENSIONS SHOWN ON ELEVATION ARE SKEWED DIMENSIONS.

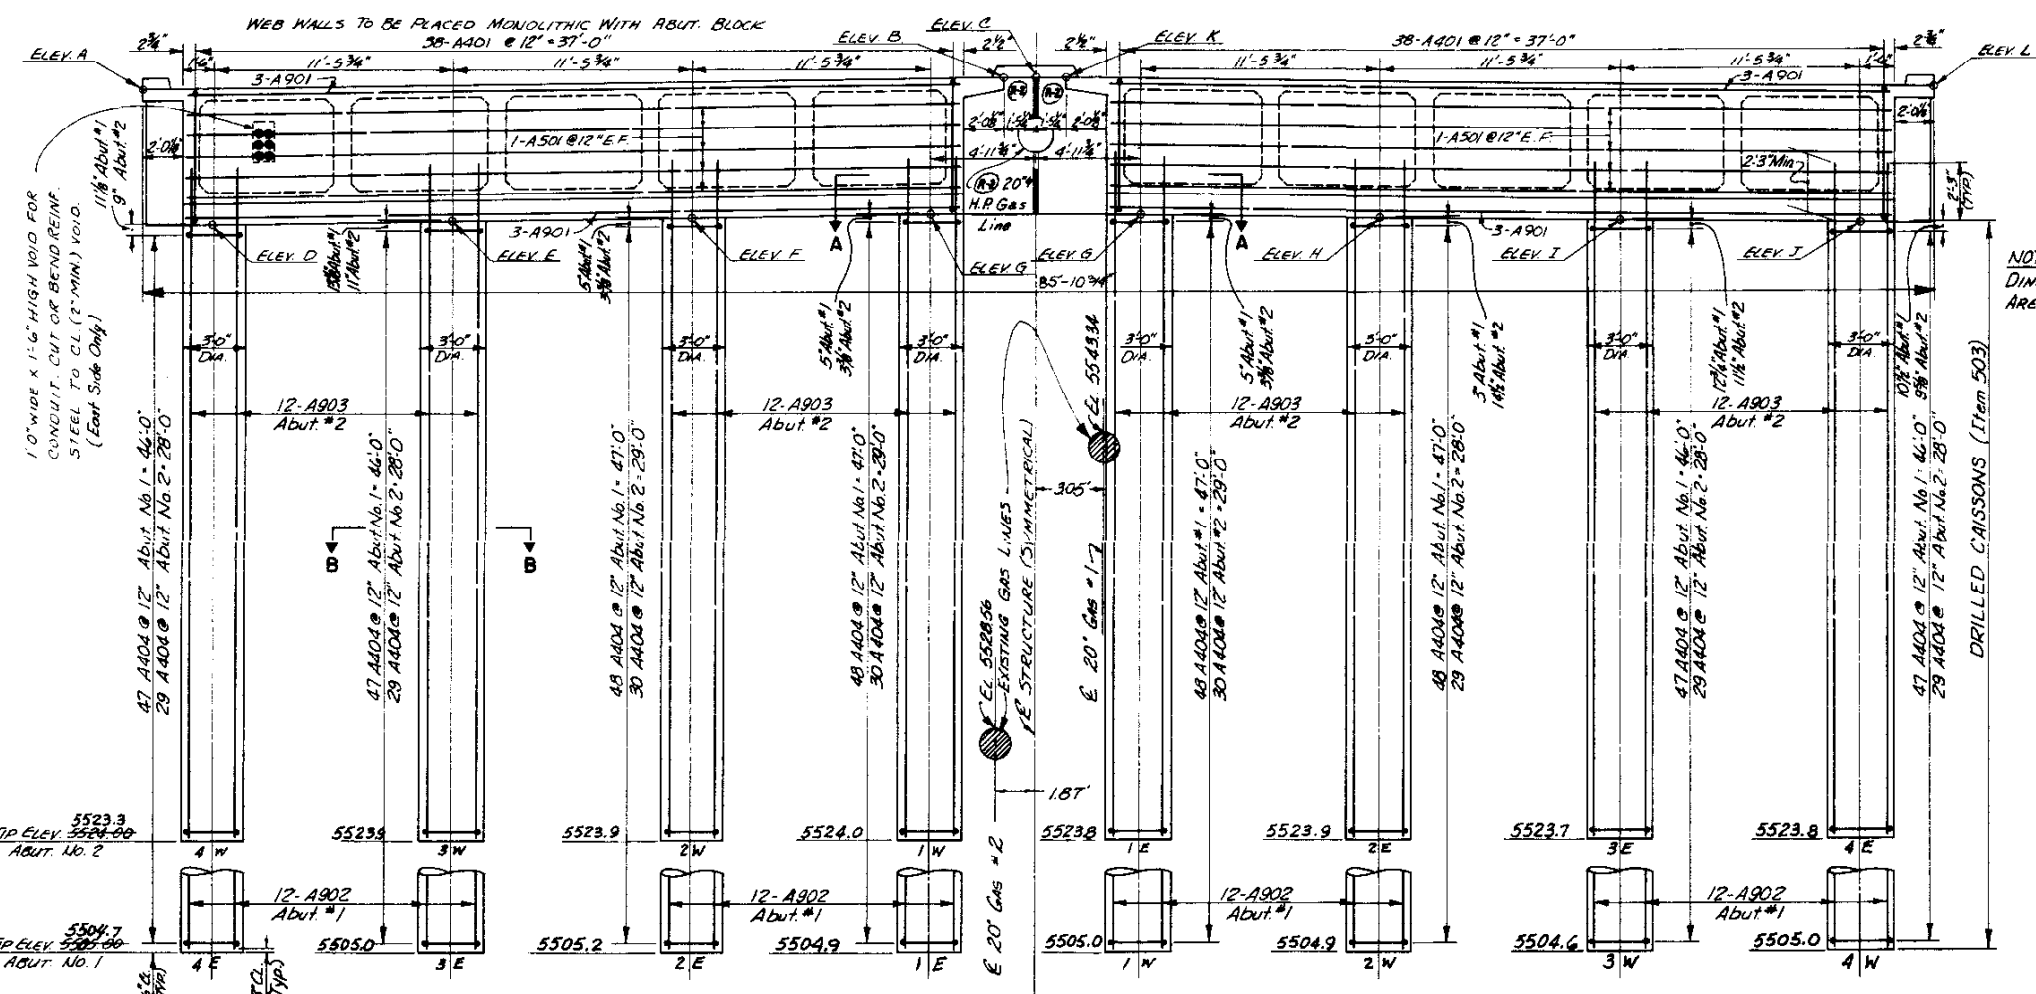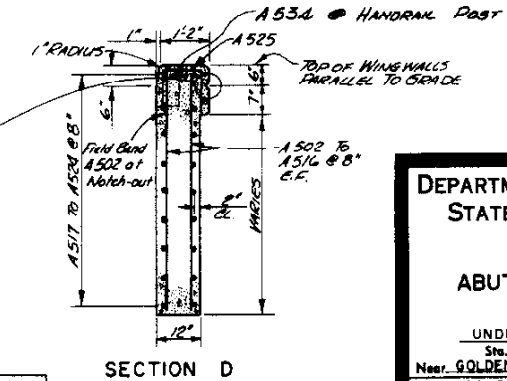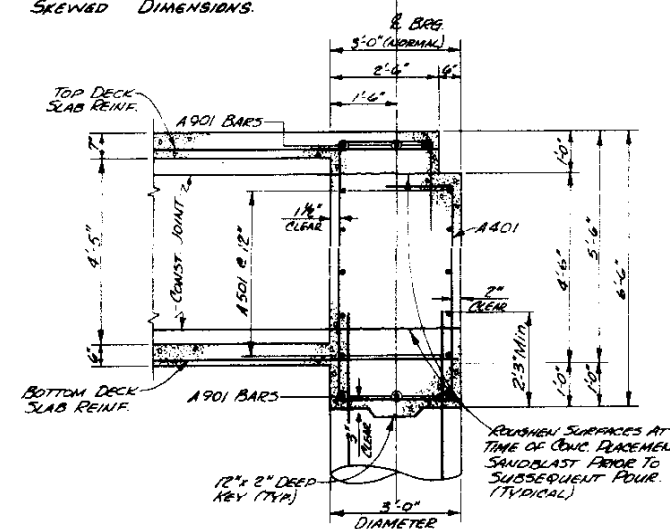

ELEV.	ABUT. NO. 1	ABUT. NO. 2	ELEV.	ABUT. NO. 1	ABUT. NO. 2
A	5558.89	5559.69	K	5559.47	5560.33
B	59.47	60.53	L	50.09	59.75
C	59.49	60.35	M	59.35	60.83
D	52.44	53.24	N	5559.29	5560.29
E	52.60	53.42			
F	52.76	53.60			
G	52.92	53.78			
H	52.74	53.62			
I	52.56	53.46			
J	5552.38	5553.30			

HENNINGSON, DURHAM & RICHARDSON
ENGINEERS - PLANNERS - CONSULTANTS
CAPITOL LIFE CENTER
DENVER, COLORADO


DEPARTMENT OF HIGHWAYS
STATE OF COLORADO
ABUTMENT DETAILS
UNDER MCINTYRE ST.
S.M. 219+91.84
Near GOLDEN, Sec. 24, T. 35, R. 70W
Designed by R.E.R. Approved by
Made by D.A.S.
Checked by W.A.S. Date: 19

REVISIONS


FED. ROAD DIST. NO.	DIVISION	PROJECT NO.	SHEET NO.	TOTAL SHEETS
9	COLD.	F 058-1(2)	16	

(R-2) Added Concrete, Added 20" H.P. Gas Line, D.J.S. 1-7-71


AS CONSTRUCTED

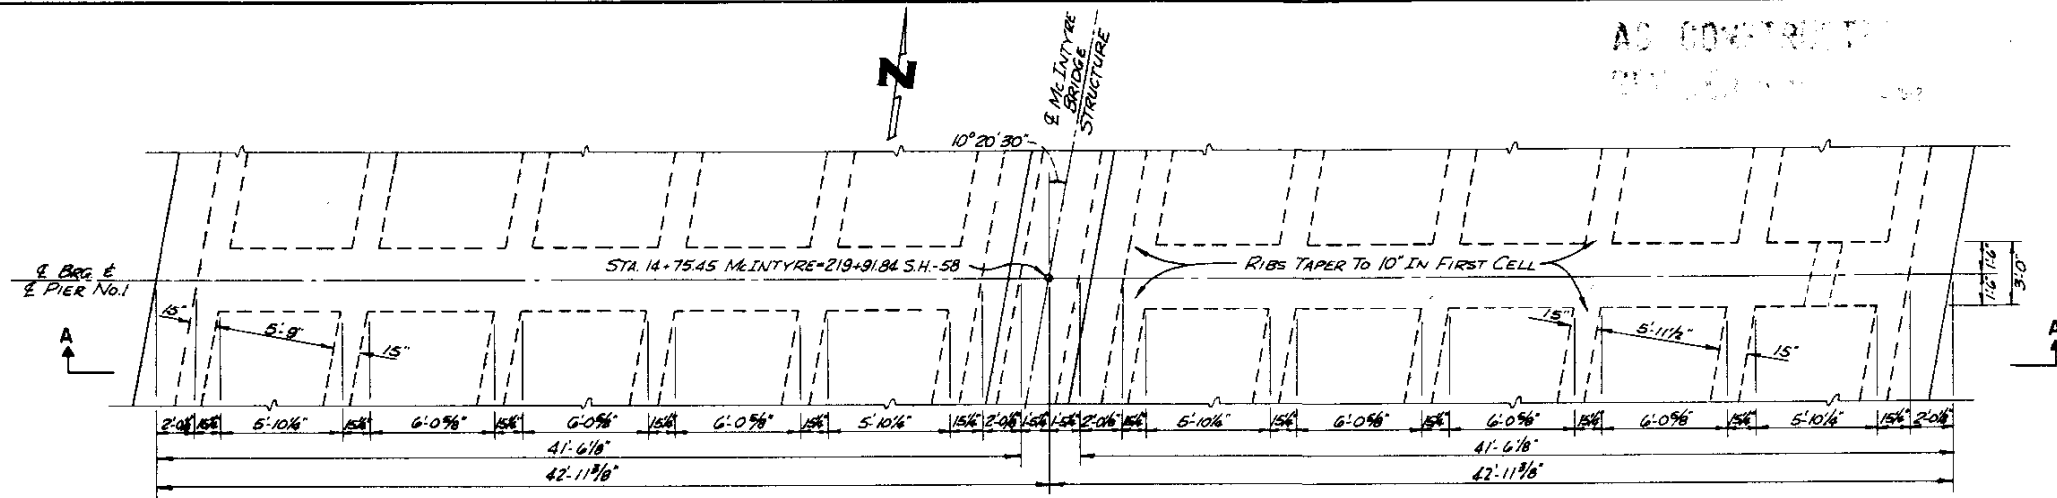


PLAN

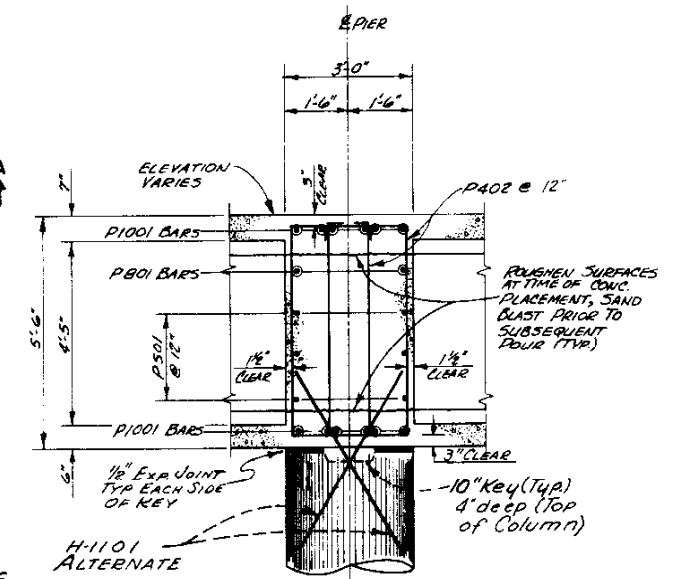


SECTION B

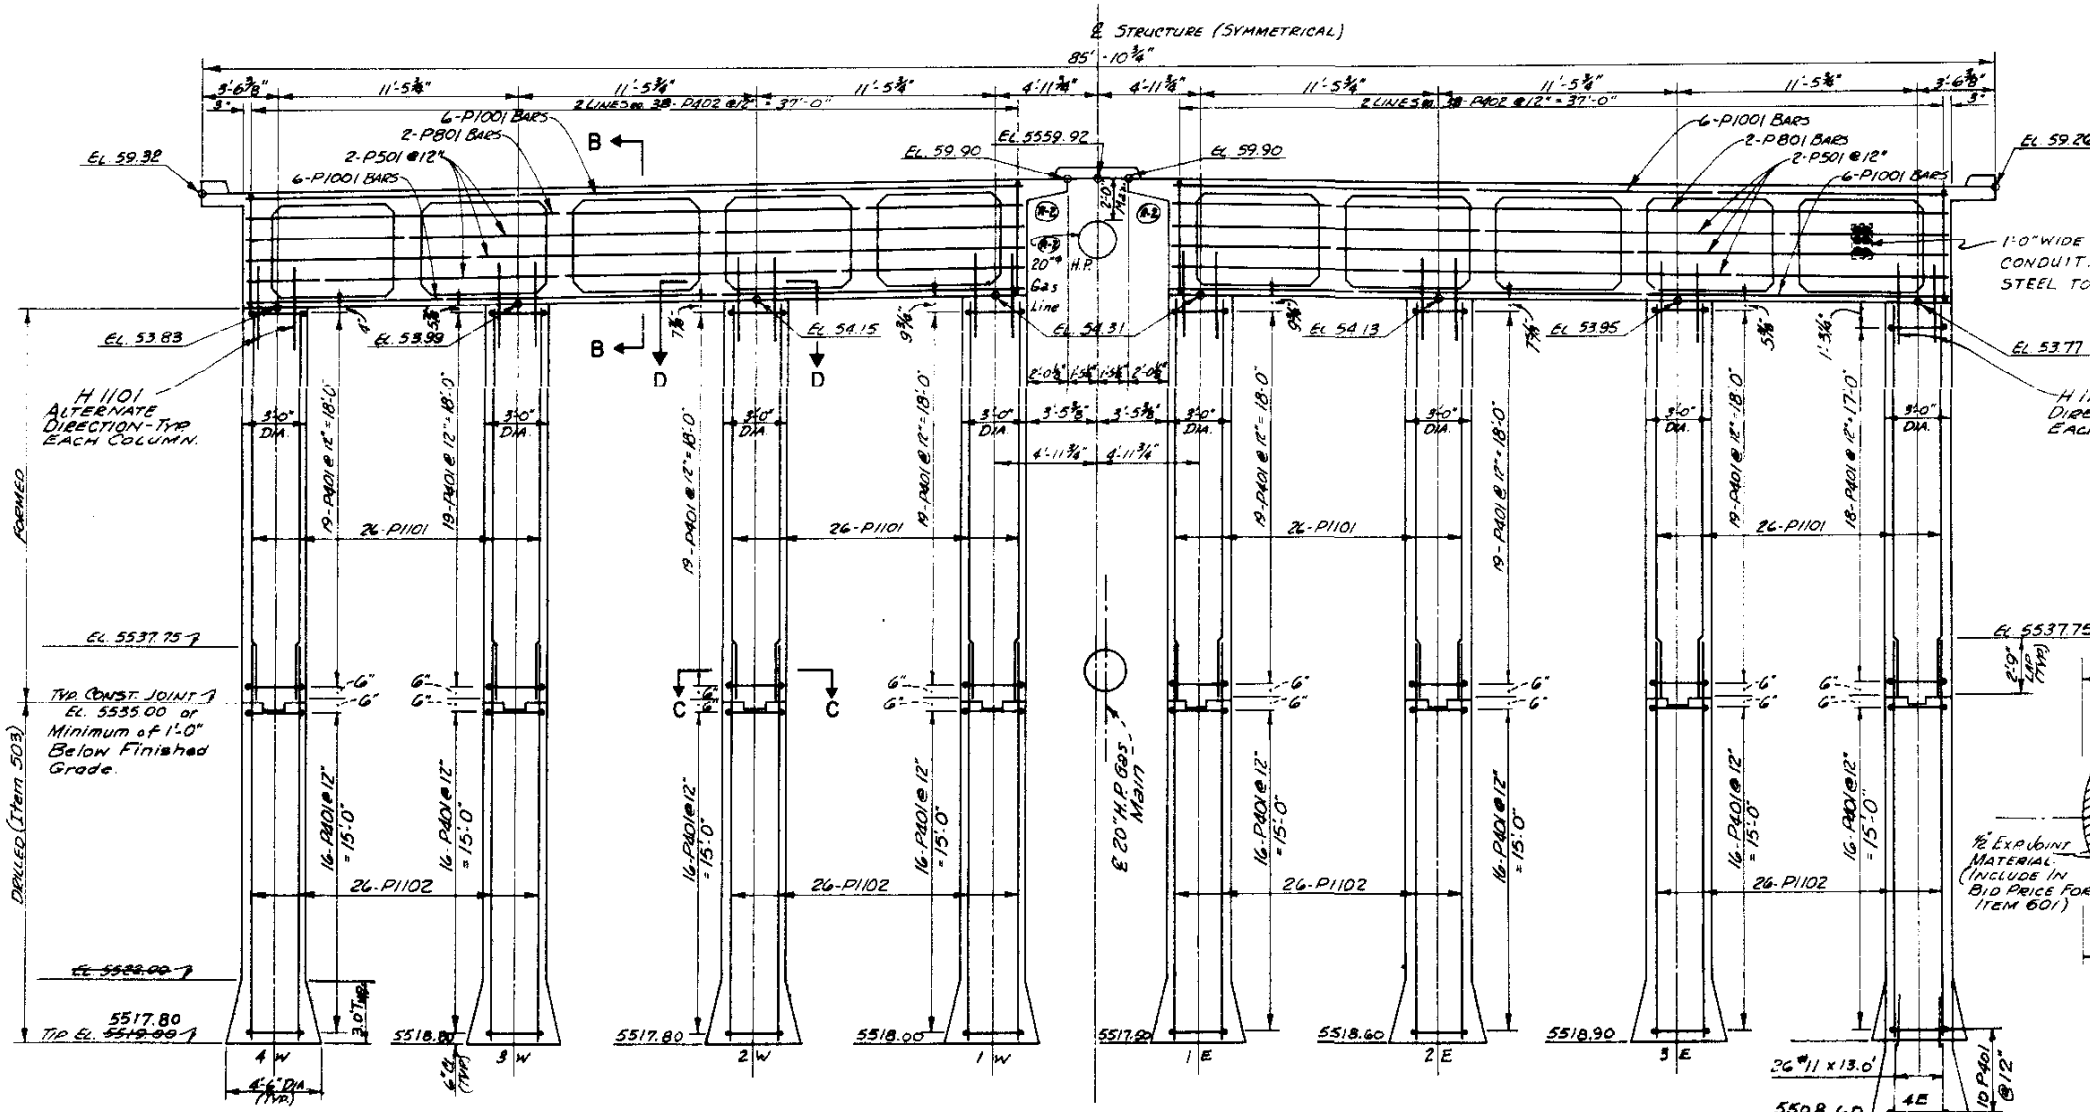

SECTION ELEVATION A
AT SKEW ANGLE 10° 20' 30"

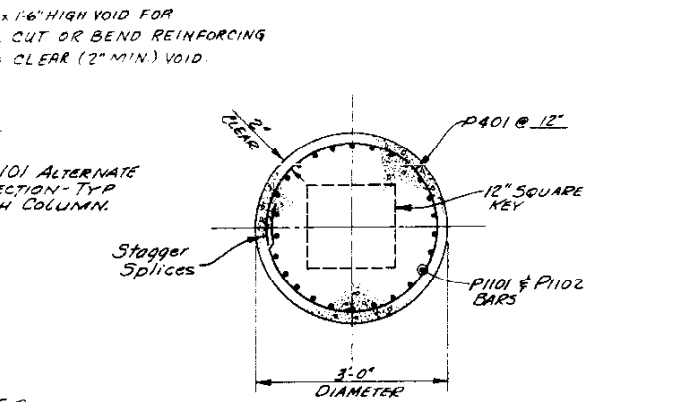

SECTION C

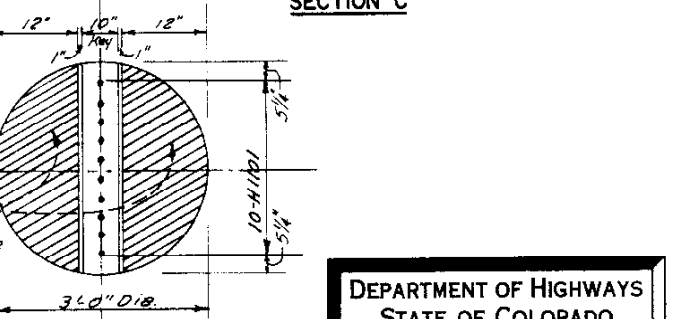

SECTION D

HENNINGSON, DURHAM & RICHARDSON
ENGINEERS - PLANNERS - CONSULTANTS
CAPITOL LIFE CENTER
DENVER, COLORADO

STRUCTURE NO. E-16-HQ

DEPARTMENT OF HIGHWAYS
STATE OF COLORADO

PIER DETAILS

UNDER MCINTYRE ST.
Sta. 219+91.84

Neat: GOLDEN Sec. 24 T. 35 R. 70W

Designed by RER. Approved by
Made by D.A.S. Checked by W.A.S. Date: 19

	Initial	Date
DESIGNED BY		
CHECKED BY		
DRAWN BY	DSM	10/67
CHECKED BY		
DESIGNED BY		
CHECKED BY		



HENNINGSON, DURHAM & RICHARDSON
ENGINEERS • PLANNERS • CONSULTANTS

CAPITOL LIFE CENTER
DENVER, COLORADO

17 B (10-20-67)

DEPARTMENT OF HIGHWAYS
STATE OF COLORADO

SLOPE PAVING DETAILS

UNDER McINTYRE ST.


Sec. 219+91.84
Near GOLDEN Sec. 24 T. 35 R. 70W

Designed by	Approved by
Made by	Bridge Engineer
Checked by	Date: 19

STRUCTURE NO. E-16-HQ


AS CONSTRUCTED
NO REVISIONS

FED. ROAD REG. NO.	DIVISION	PROJECT NO.	SHEET NO.	TOTAL SHEETS
9	COLO.	F053-1 (2)	18	

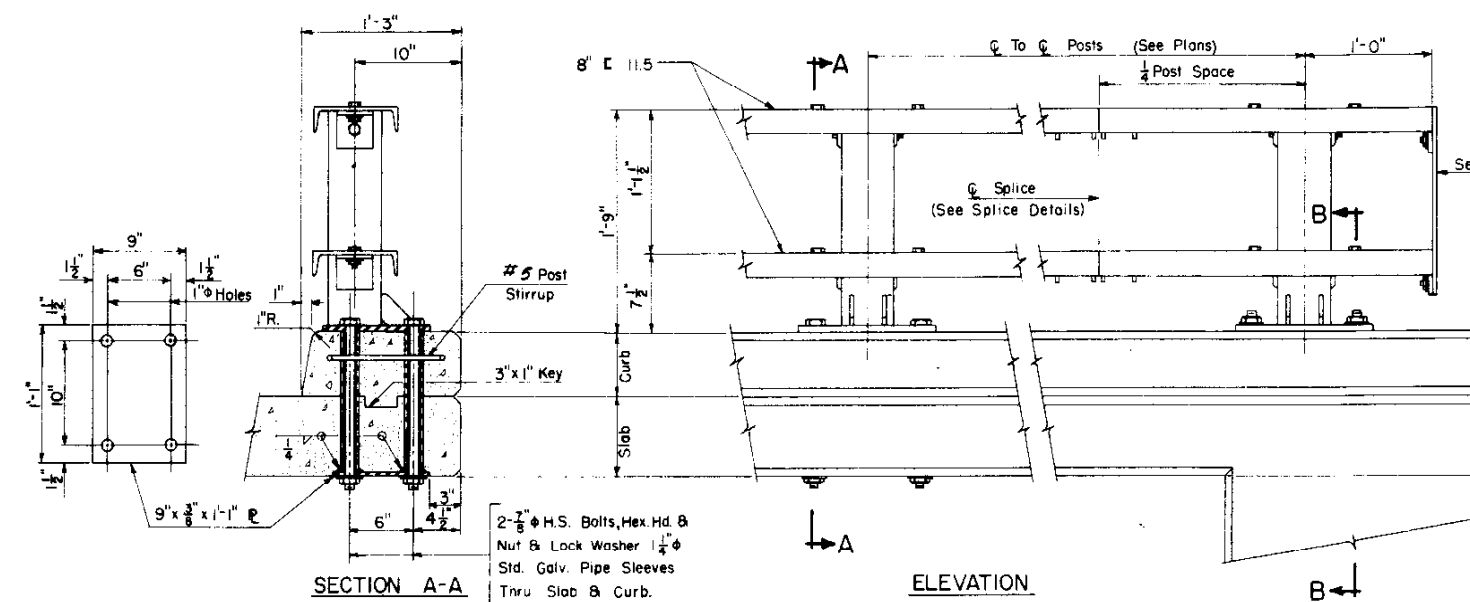


THRU SLAB MOUNTED POST
NO. OF THRU SLAB MOUNTED POSTS REQ'D

McIntyre St.- SH-5B	52
McIntyre St.- Clear Creek	62
Total	114

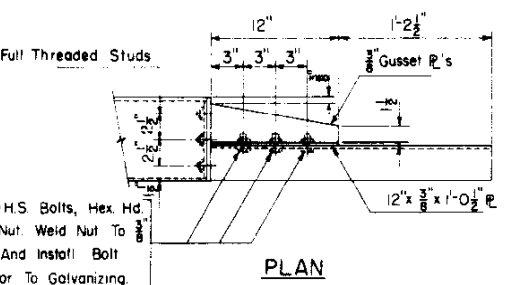

PLAN

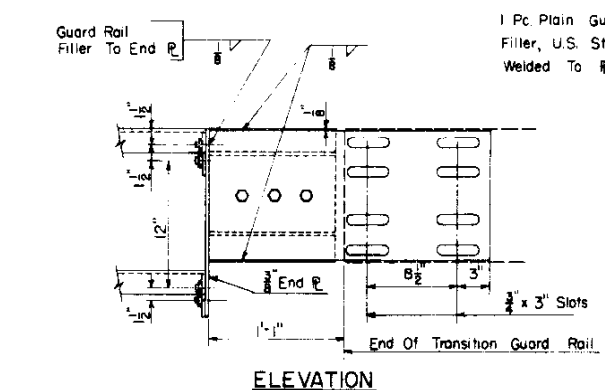


DETAIL OF END CONNECTION FOR FASTENING BRIDGE RAIL
TO TRANSITION GUARD RAIL


Complete Unit Shall Be Galvanized After Fabrication
Detail Shown Is For Right Hand Rail.
Opposite Hand For Left Hand Rail.

NO. OF GUARD RAIL TRANSITION CONNECTIONS REQ'D

McIntyre St.- SH-5B	4
McIntyre St.- Clear Creek	4
Total	8

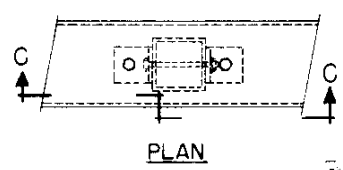


PLAN

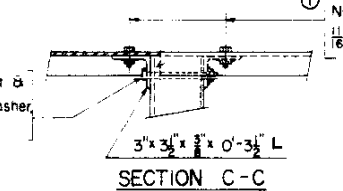


SECTION C-C

DETAIL AT TOP RAIL

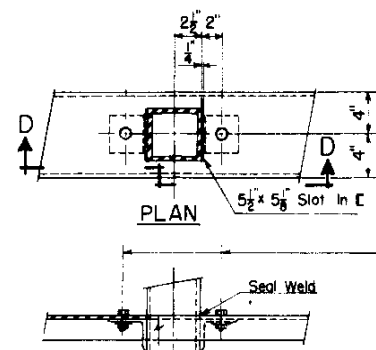

SECTION D-D


DETAIL AT BOTTOM RAIL

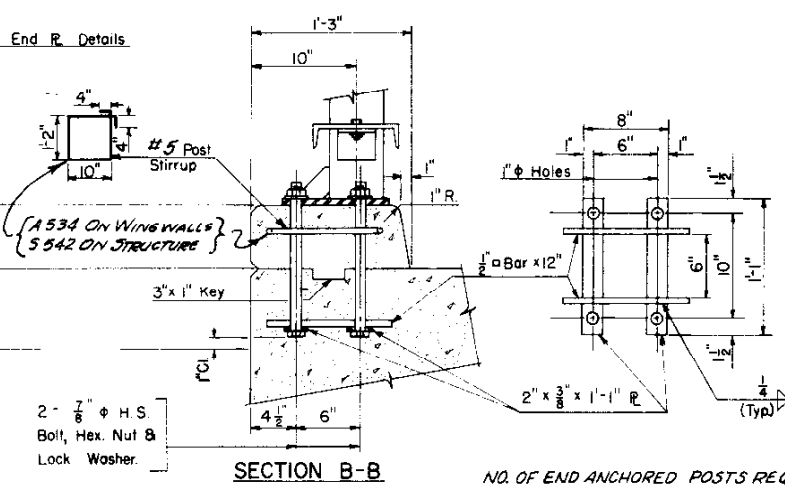

SECTION B-B
END ANCHORED POST

NO. OF END ANCHORED POSTS REQ'D


McIntyre St.- SH-5B	8
McIntyre St.- Clear Creek	8
Total	16

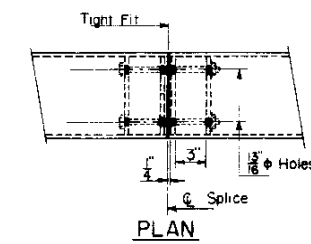


PLAN

ELEVATION

SPlice DETAIL

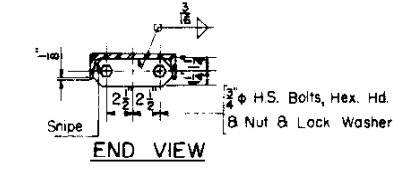


END VIEW

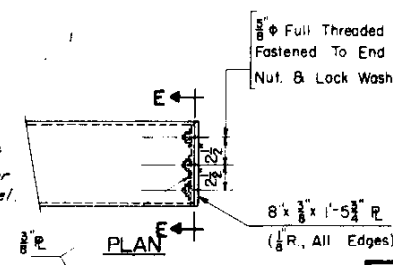


PLAN

END PLATE DETAIL

NO. OF END R REQ'D	
McIntyre St.- SH-5B	4
McIntyre St.- Clear Creek	4
Total	8

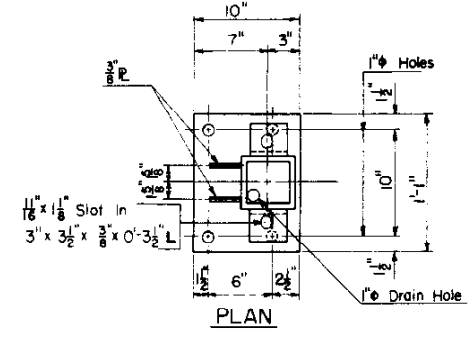


PLAN

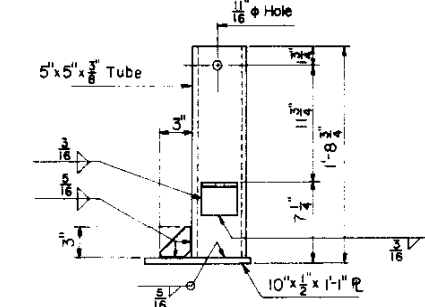

ELEVATION

POST DETAIL

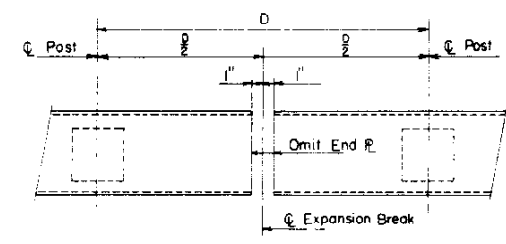

DETAIL AT EXPANSION BREAK



NOTES:

- Posts Shall Be Perpendicular To The Grade And Slope Of Deck.
- All Rail Elements Shall Be Galvanized After Fabrication In Accordance With Specifications.
- AISI 1144 Steel Rods May Be Used In Lieu Of H.S. Bolts Shown. 10° Wedge Test Not Req. For Either Bolts Or Rods Used In Rail Assembly.
- Standard Full Threaded Studs Welded To The Channel May Be Used. Increase Size Of Slot In The Angle To 1 1/2" x 1 1/2".
- Channels Shall Be Continuous Over 3 Or 4 Posts Before Splicing.

4 (5-14-68)

DEPARTMENT OF HIGHWAYS
STATE OF COLORADO
GALVANIZED STEEL
HANDRAIL
ACROSS CLEAR CREEK ON MCINTYRE ST.
and
UNDER MCINTYRE ST.
Sta. 219 + 91.84
Near GOLDEN Sec. 24 T. 36 R. 70W
Designed by
Made by RMM
Checked by
Approved by
Bridge Engineer
Date: 19

HENNINGSON, DURHAM & RICHARDSON
ENGINEERS - PLANNERS - CONSULTANTS
CAPITOL LIFE CENTER
DENVER, COLORADO

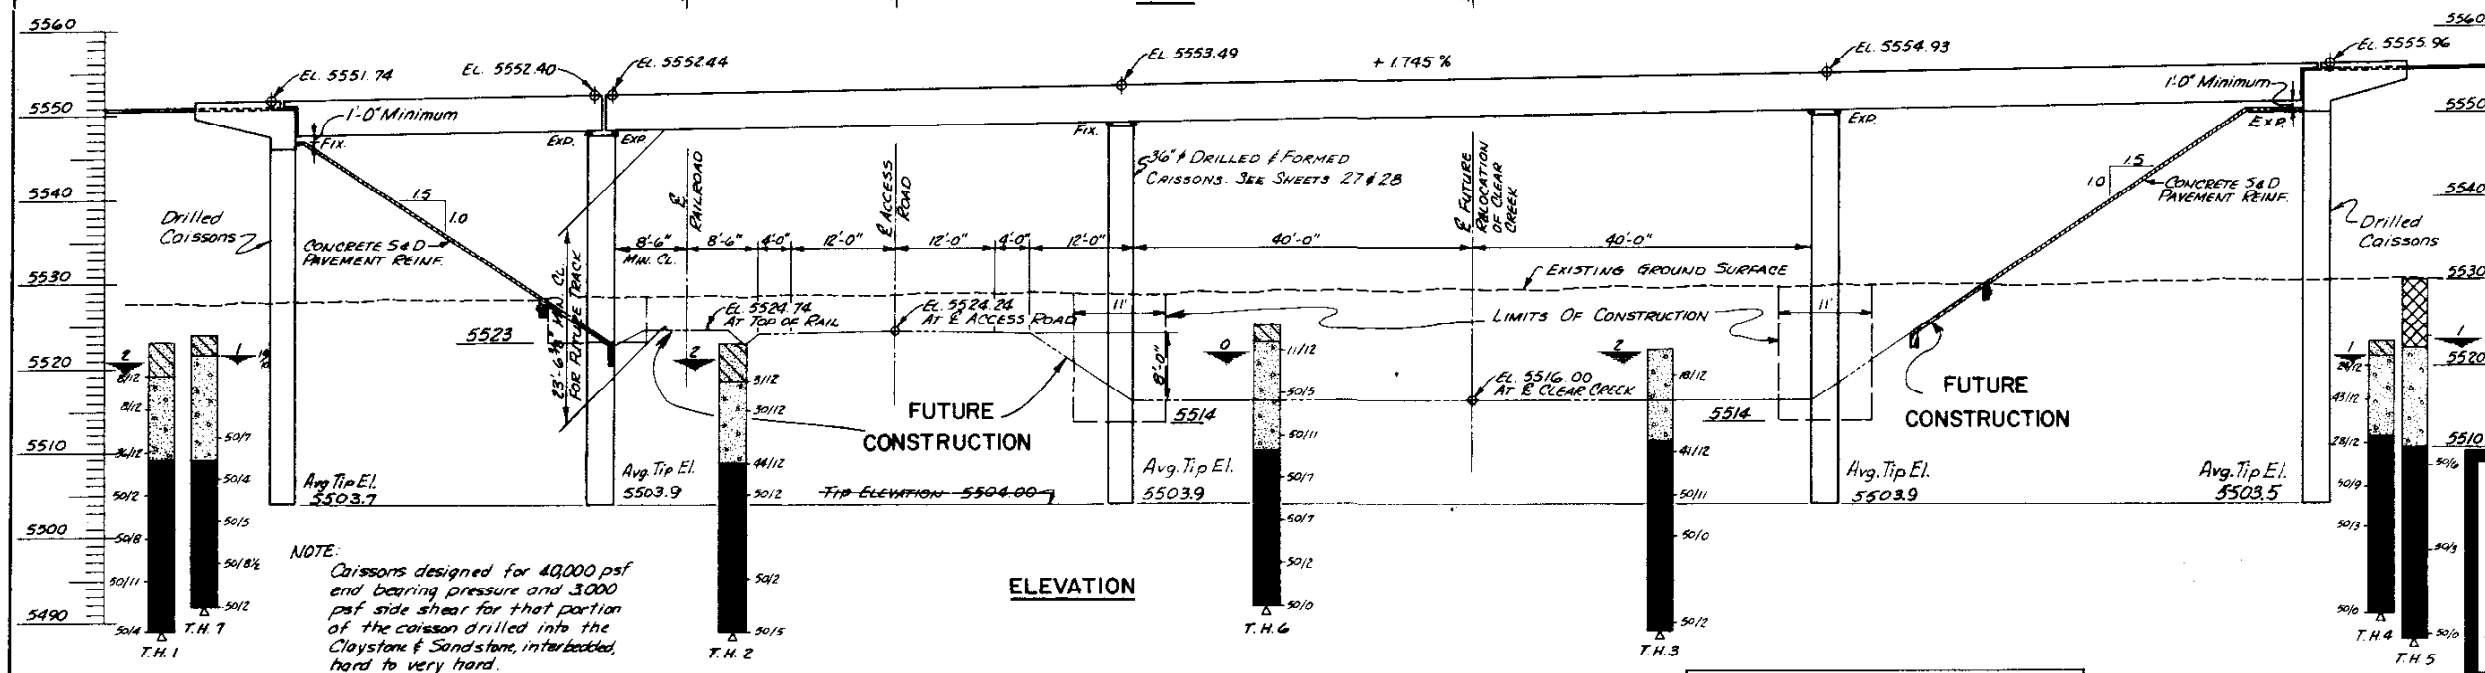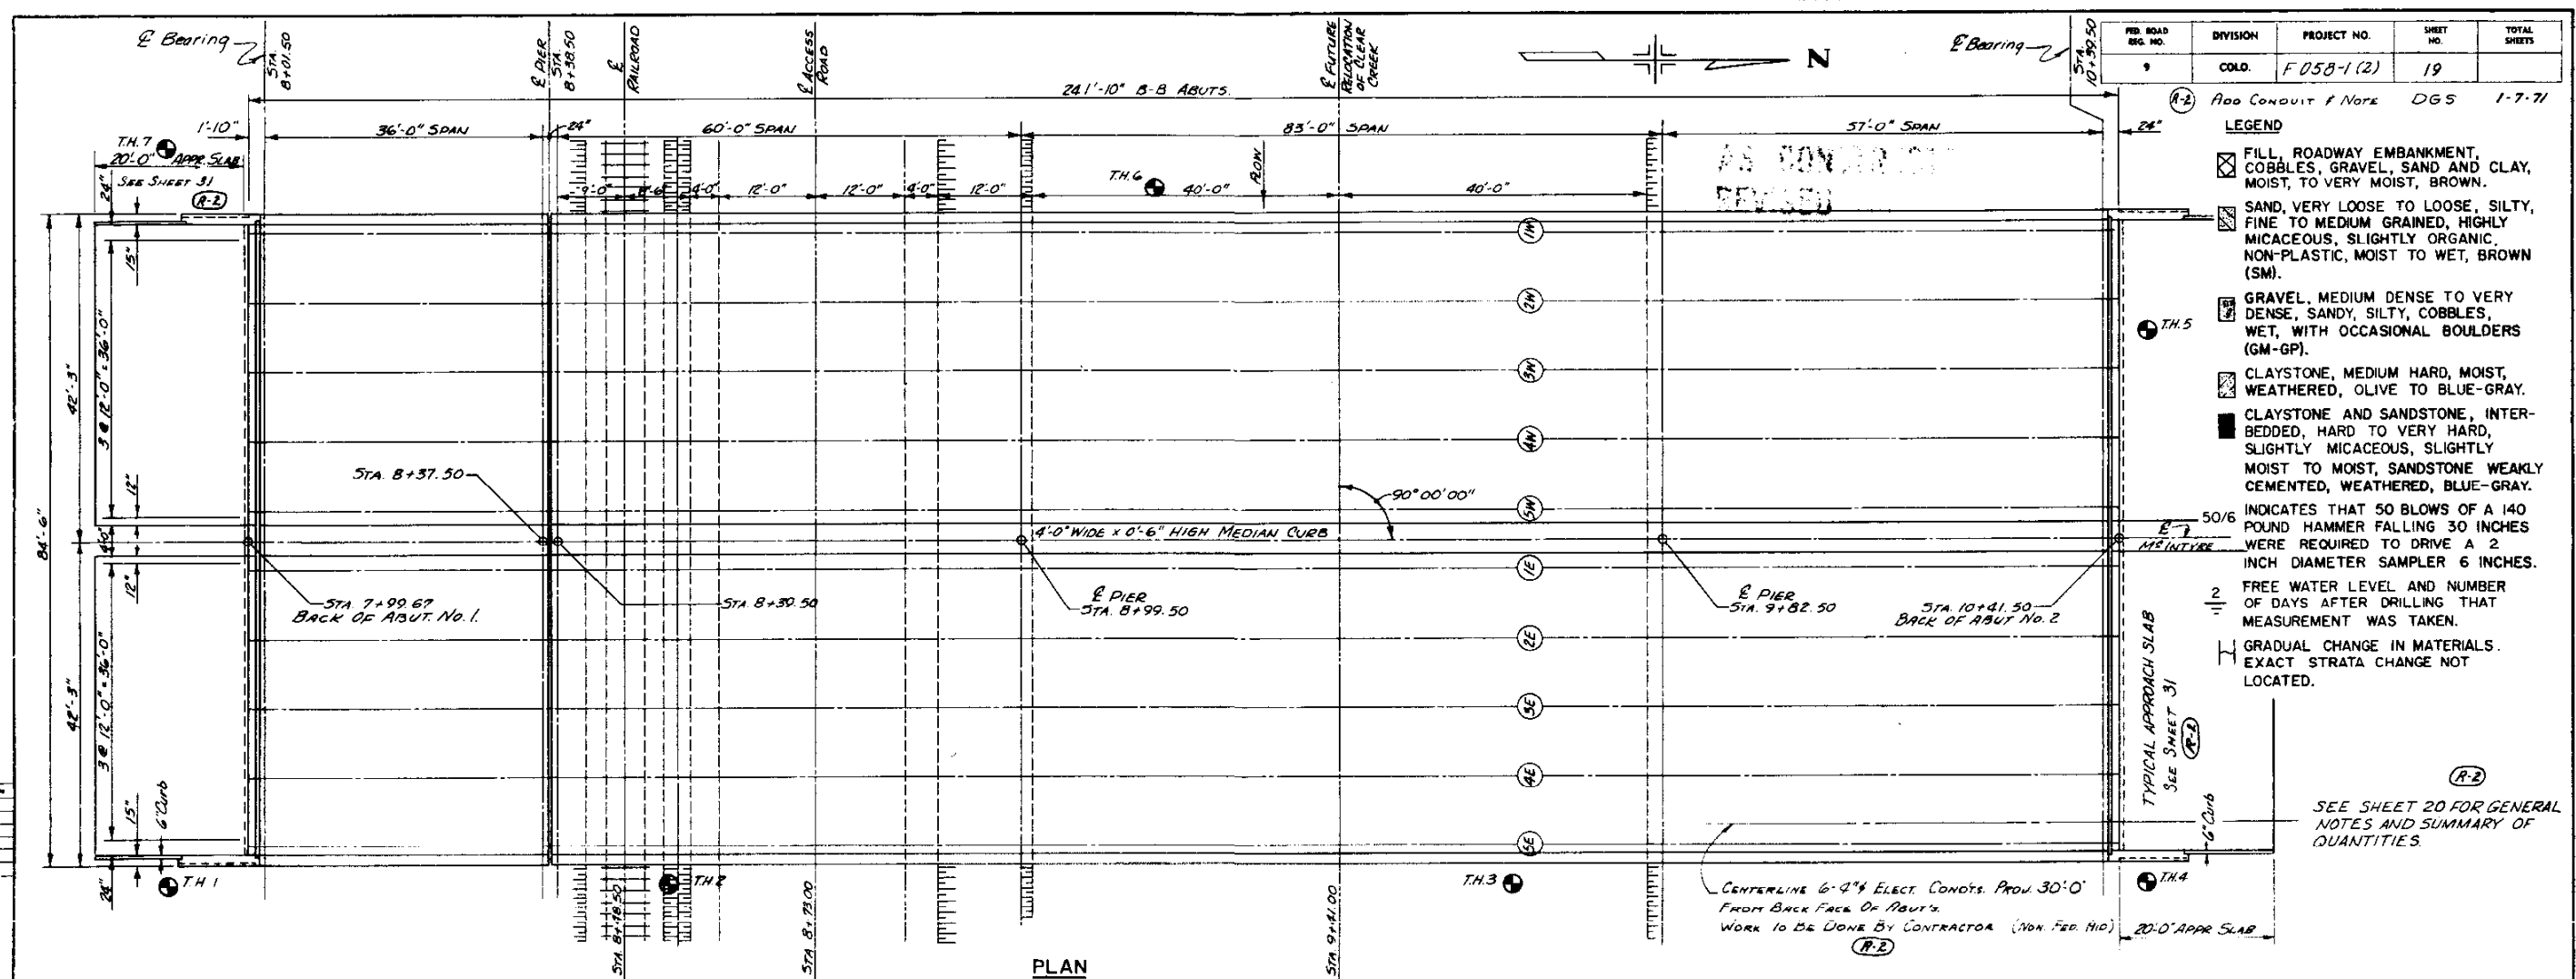

NOTE:
Caissons designed for 40,000 psf
end bearing pressure and 3,000
psf side shear for that portion
of the caisson drilled into the
Claystone & Sandstone, interbedded,
hard to very hard.

DEPARTMENT OF HIGHWAYS STATE OF COLORADO LAYOUT

RELOCATED CLEAR CREEK, Cross <u>COOKS ACCESS ROAD & RAILROAD</u> Sta. <u>9+41.0 MCINTYRE ST</u>	
Near <u>GOLDEN</u>	Sec. <u>24</u> T. <u>3S</u> R. <u>70W</u>
Designed by <u>R.E.R.</u> Made by <u>D.S.</u> Checked by <u>W.A.S.</u>	Approved by _____ Date: _____ 19__

HENNINGSON, DURHAM & RICHARDSON
ENGINEERS · PLANNERS · CONSULTANTS
CAPITOL LIFE CENTER
DENVER, COLORADO

1-7-71 (R-2) Revised bar list & Summary of Quan. TDB

FED. ROAD DIST. NO.	DIVISION	PROJECT NO.	SHEET NO.	TOTAL SHEETS
9	COLD.	F 058-1 (2)	20	

GENERAL NOTES

- ALL WORK SHALL BE DONE ACCORDING TO THE STANDARD SPECIFICATIONS OF THE COLORADO DEPARTMENT OF HIGHWAYS APPLICABLE TO THE PROJECT.
- ALL REINFORCING STEEL SHALL BE INTERMEDIATE GRADE STEEL OF A DEFORMED TYPE. EACH BAR SHALL BE TAGGED WITH THE BAR DESIGNATION AND STATION NUMBER OF THE PROJECT.
- IF BY PERMISSION OF THE ENGINEER, PRIMARY BARS ARE SPICED, THEY SHALL LAP 24 DIAMETERS EXCEPT BARS NEAR THE TOP OF BEAMS AND GIRDERS HAVING MORE THAN 12 INCHES OF CONCRETE UNDER THE BARS, IN WHICH CASE THE SPICE SHALL BE 40 DIAMETERS.
- DIMENSIONS FOR REINFORCING STEEL ARE SHOWN AS CLEAR DIMENSIONS.
- SOUNDINGS & DEPTH OF FOOTINGS ARE IN ACCORDANCE WITH THE BEST AVAILABLE DATA, AND WHEN DIFFERENT CONDITIONS ARE ENCOUNTERED THE BRIDGE ENGINEER WILL INSPECT AND DETERMINE IF REDESIGN IS NECESSARY.
- FOR DETAILS OF STRUCTURAL EXCAVATION AND STRUCTURE BACKFILL SEE STANDARD M-296-A.
- ALL CONCRETE SURFACES MARKED WITH THE SYMBOL ∇ AS SHOWN ON SHEET NO. 29 SHALL RECEIVE CLASS "2" SURFACE FINISH.
- ALL STRUCTURAL STEEL SHALL BE PAINTED IN ACCORDANCE WITH SECTION 509 FOR GREEN PAINT.
- BOLTS SHALL BE FURNISHED IN THE AMOUNT OF TWO PERCENT IN EXCESS OF THE NOMINAL NUMBER REQUIRED FOR EACH SIZE AND LENGTH.
- WELDING SHALL CONFORM TO THE LATEST EDITION OF THE A.W.S. STANDARD SPECIFICATIONS FOR WELDING HIGHWAY BRIDGES.
- ALL STRUCTURAL STEEL SHALL BE A.S.T.M. A36-62T.
- ALL CONCRETE CHAMFERS TO BE $3/4"$ UNLESS OTHERWISE NOTED.

SUMMARY OF QUANTITIES

ITEM NO.	DESCRIPTION	UNIT	SUPER STRUCT.	ABUT NO. 1	PIER NO. 1	PIER NO. 2	PIER NO. 3	ABUT NO. 2	TOTAL	Book #1
206	STRUCTURE EXCAVATION (Haul)	CU. YDS.		176	174	487	489	190	1524	Page 23
206	STRUCTURE BACKFILL (CLASS 3) (Haul)	CU. YDS.		29	167	467	467	32	1162	29
503	DRILLED CAISSONS (36" ϕ)	LIN. FT.		240.72	114.40	60.80	60.80	263.10	735.82	54-55
507	CONCRETE SLOPE & DITCH PAVING (REINFORCED)	CU. YDS.		242.41	114.40	60.80	60.80	263.10	741.51	56-57
509	STRUCTURAL STEEL	LBS.		453,425					453,425	61
509	STRUCT. STEEL GALVANIZED	LBS.		18,883					18,883	62
512	BRONZE BEARING PLATES	LBS.		846					846	63
516	DAMPPOOFING (LINSEED OIL)	SQ. YDS.		2712					2712	64
518	BRIDGE COMPRESSION JOINT SEALER (TYPE A)	LIN. FT.		81.67				353.12	81.67	66
601	CONCRETE (CLASS "A")	CU. YDS.			33.49	74.71	76.91	17.332	105.11	220.42 68
601	CONCRETE (CLASS "D")	CU. YDS.		528.10	509.1	488.8	408.5	40.45	2044.4	726.12 75
602	REINFORCING STEEL	LBS.		196,294	193,415	184,886	275,552	275,552	1,041,717	230,613
613	1/2" EXP. JT. MATERIAL (TYPE 3)	SQ. FT.		8					8	
613	4" Electrical Conduit	LIN. FT.		1451					1451	Book #2 Pg 61
				1836					1836	

QUANTITY FOOTNOTES

- INCLUDES APPROACH SLAB
- INCLUDED IN ITEM 601
- Non Federal Aid: Mountain States Tel. & Tel. Co. to reimburse the Colorado Division of Highways for this work. All work necessary to accomplish this item shall be included in the bid price for item 613.

STRUCTURAL STEEL NOTES

- ENDS OF GIRDERS & ALL END BEARING PLATES SHALL BE VERTICAL.
- EXCEPT AS NOTED ALL SHOP FILLET WELDS FOR DIAPHRAGMS AND CLIP PLATES SHALL BE $1/4"$.
- ALL FIELD CONNECTIONS SHALL BE $7/8"$ HIGH STRENGTH BOLTS EXCEPT AS SHOWN.
- SUB PUNCH HOLES TO $13/16"$ ϕ & REAM TO $15/16"$ ϕ WITH PARTS ASSEMBLED IN CORRECT POSITION EXCEPT AS SHOWN.

DESIGN SPECIFICATION

- 1965 A.A.S.H.O. AND SUBSEQUENT REVISIONS.
- LIVE LOAD HS20-44
- DEAD LOAD CONCRETE = 150 P.C.F.
- WEIGHT OF EARTH 120 P.C.F.
- EQUIVALENT FLUID PRESSURE 30 P.C.F.
- CONCRETE:
 $f_c = 3,000$ p.s.i. $f_t = 1,200$ p.s.i.
 f_s (REINF.) = 20,000 p.s.i.
- STRUCTURAL STEEL:
 f_s (A36) = 20,000 p.s.i.

BAR SUMMARY

ABUTMENT NO. 1 & 2

10,627 L.F. *5 @ 1.043*/ft. = 11,086 LBS.
2,848 L.F. *9 @ 3.400*/ft. = 9,683 LBS.
Total Abut. *1 & *2 = 20,769 LBS.

PIER NO. 1, 2 & 3

9,759 L.F. *4 @ 0.668*/ft. = 6,519 LBS.
8,197 L.F. *5 @ 1.043*/ft. = 8,549 LBS.
3,696 L.F. *10 @ 4.303*/ft. = 15,904 LBS.
8,014 L.F. *11 @ 5.313*/ft. = 42,578 LBS.
Total Pier *1, *2 & *3 = 73,550 LBS.

DECK

52,306 L.F. *4 @ 0.668*/ft. = 34,940 LBS.
289 L.F. *5 @ 1.043*/ft. = 302 LBS.
67,278 L.F. *6 @ 1.502*/ft. = 101,052 LBS.
Total Deck = 136,294 LBS.

TOTAL REINFORCING STEEL 230,613 LBS.

BAR LIST - ABUT. NO. 1 & NO. 2

MARK	SIZE	SHAPE	NO. REQ'D No. 1 No. 2	LENGTH
A501	5		168 168	13'-8"
A502	5		32 32	40'-0"
A503	5		16 16	6'-3"
A504	5		166 166	4'-6"
A505	5		83 83	3'-4"
A506	5		166 166	5'-0"
A507	5		20 20	3'-7"
A508	5		4 4	3'-9"
A509	5		12 12	2'-9"
A510	5		4 4	9'-0"
A511	5		8 8	9'-8"
A512	5		8 8	5'-0"
A513	5		4 4	3'-3"
A514	5		4 4	7'-9"
A515	5		8 8	11'-9"
A516	5		4 4	3'-7"
A517	5		4 4	3'-5"
A518	5		4 4	3'-4"
A519	5		4 4	3'-3"
A520	5		4 4	3'-3"
A521	5		4 4	3'-2"
A522	5		4 4	3'-1"
A523	5		4 4	2'-10"
A524	5		4 4	2'-9"
A525	5		4 4	2'-7"
A526	5		4 4	2'-5"
A527	5		4 4	2'-3"
A534	5		4 4	4'-8"
A901	9		32 32	40'-0"
A902	9		16 16	9'-0"

DRILLED CAISSON BARS*

A 401	4		504	9'-5"
A 1101	11		156	23'-8"
A 1102	11		156	25'-6"

BAR LIST - PIER NO. 1

MARK	SIZE	SHAPE	NO. REQ'D	LENGTH
P401	4		8	34'-6"
P402	4		4	15'-5"
P403	4		100	13'-4"
P404	4		126	9'-5"
P501	5		6	34'-6"
P502	5		3	15'-11"
P503	5		110	7'-8"
P1001	10		28	38'-0"
P1002	10		14	12'-0"
P1101	11		78	24'-4"

DRILLED CAISSON BARS*

P405	4		114	9'-5"
P1102	11		78	23'-4"

* NOTE:

Drilled Caisson Bars Are Shown For Information Only To Be Paid For Under Item 503 Drilled Caissons.

BAR LIST - PIER NO. 2 & NO. 3

MARK	SIZE	SHAPE	NO. REQ'D No. 2 No. 3	LENGTH
P401	4		8 8	34'-6"
P402	4		4 4	15'-5"
P403	4		100 100	13'-4"
P404	4		180 180	9'-5"
P501	5		131 131	10'-3"
P502	5		88 88	15'-0"
P503	5		44 44	5'-0"
P504	5		11 11	3'-0"
P505	5		44 44	7'-0"
P506	5		22 22	14'-8"
P1001	10		28 28	38'-0"
P1002	10		14 14	12'-0"
P1101	11		39 39	22'-9"
P1102	11		39 39	24'-6"
P1103	11		78 78	15'-7"

DRILLED CAISSON BARS*

P405	4		120	9'-5"
P1104	11		156	14'-10"

BAR LIST - DECK

MARK	SIZE	SHAPE	NO. REQ'D	LENGTH
D401	4		480	2'-7"
D402	4		24	40'-0"
D403	4		6	40'-0"
D404	4		6	37'-0"
D405	4		240	5'-4"
D406	4		6	6'-6"
S542	5		62	4'-8"
D601	6		240	4'-3"
S401	4		910	40'-0"
S402	4		166	6'-6"
S403	4		166	37'-0"
S404	4		168	28'-0"
S601	6		1636	40'-6"

DEPARTMENT OF HIGHWAYS
STATE OF COLORADO
GENERAL NOTES
SUMMARY OF QUANTITIES &
REINFORCING BAR LIST

RELOCATED CLEAR CREEK,
ACROSS COOR'S ACCESS ROAD & RAILROAD
Sta. 9+41.0 MCINTYRE ST.
Near GOLDEN Sec. 24 T. 35 R. 70W.
Designed by RFR Approved by
Made by DS
Checked by WAS Date: 19


HENNINGSON, DURHAM & RICHARDSON
ENGINEERS - PLANNERS - CONSULTANTS
CAPITOL LIFE CENTER
DENVER, COLORADO

FED. ROAD DIST. NO.	DIVISION	PROJECT NO.	SHEET NO.	TOTAL SHEETS
9	COLO.	F058-1(2)	21	


(R-2) ADDED DETAIL TCF 1-7-71

OPTION "A"
ANY COMBINATION OF POURS
① CAN BE MADE SIMULTANEOUSLY. POURS ② SHALL BE MADE AFTER ADJACENT POURS ① ARE COMPLETED.


OPTION "B"
CONTINUOUS POUR WITHOUT CONSTRUCTION JOINTS.

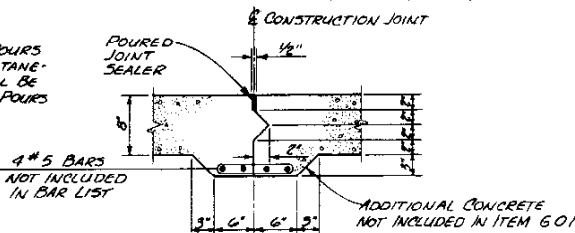


DETAIL OF SLAB CONSTRUCTION JOINT

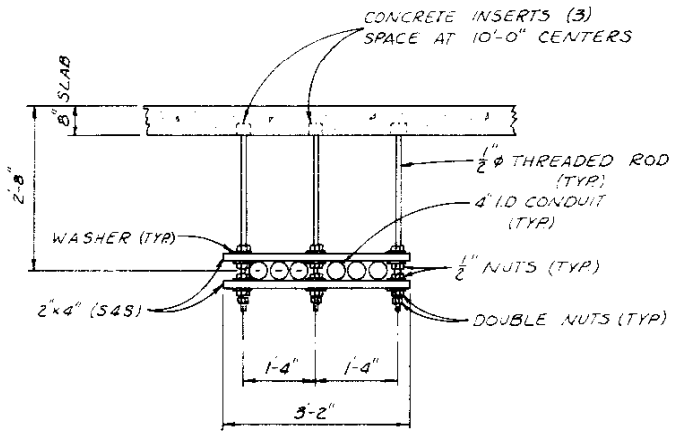


SUSPENDED TELEPHONE CONDUIT DETAILS (R-2)

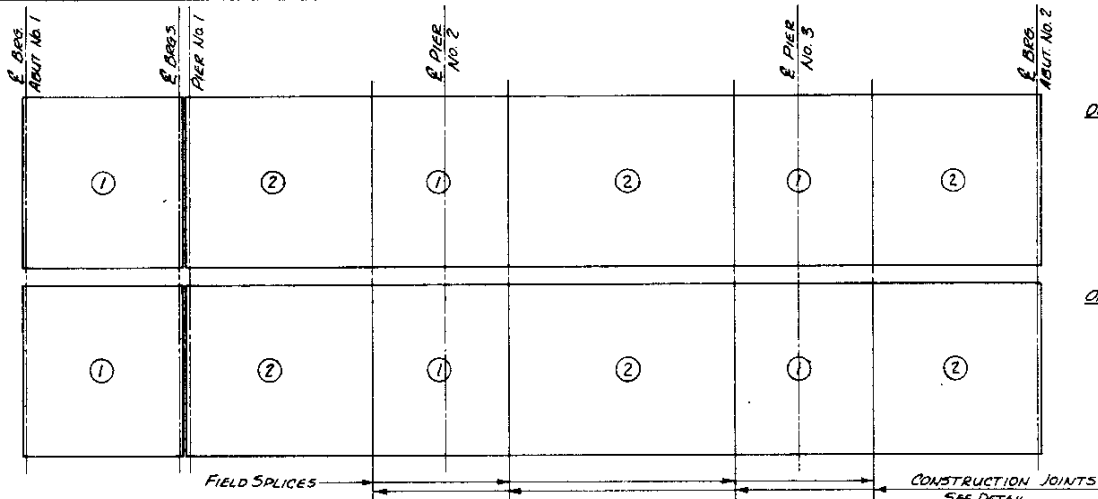

POURING SCHEDULE

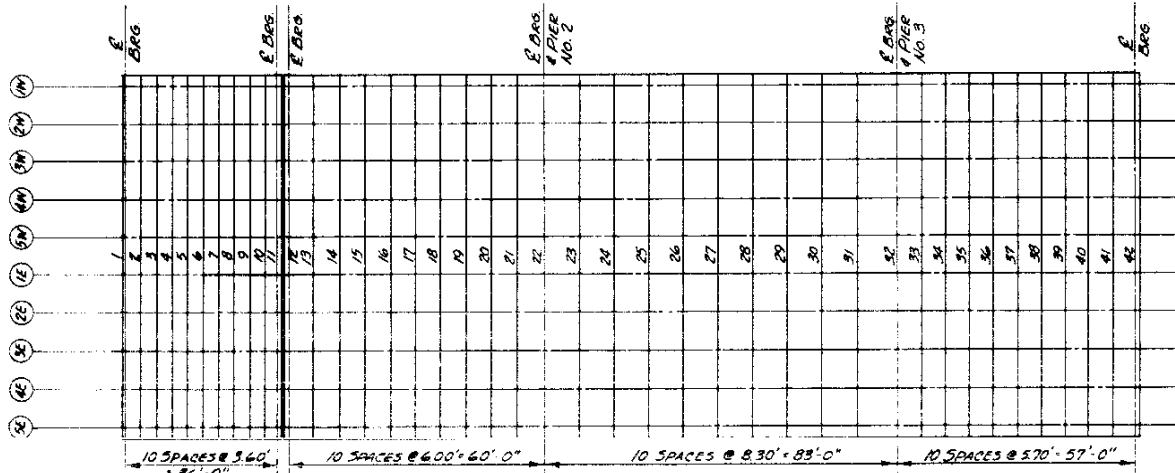

DECK PLAN

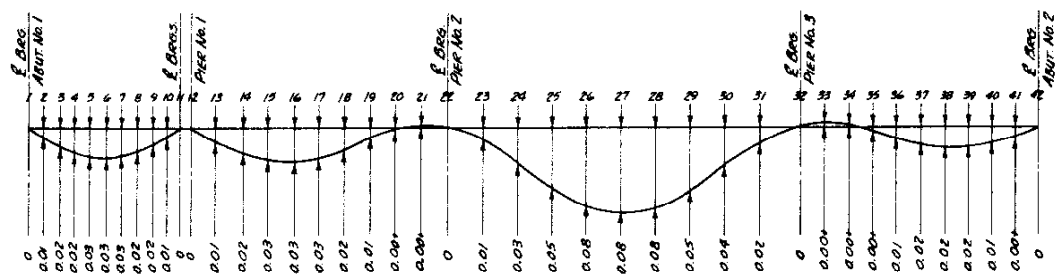

DEAD LOAD DEFLECTION DIAGRAM

TOP OF DECK - ELEVATION 5500.00 +																																											
GIRDER No.	SPAN NO. 1 = 36'-0"											SPAN NO. 2 = 60'-0"											SPAN NO. 3 = 83'-0"											SPAN NO. 4 = 57'-0"									
	1	2	3	4	5	6	7	8	9	10	11	12	13	14	15	16	17	18	19	20	21	22	23	24	25	26	27	28	29	30	31	32	33	34	35	36	37	38	39	40	41	42	
1W	51.21	51.28	51.36	51.42	51.49	51.55	51.62	51.67	51.73	51.78	51.84	51.87	51.93	52.10	52.22	52.32	52.42	52.52	52.61	52.71	52.81	52.92	53.07	53.24	53.40	53.58	53.72	53.87	53.98	54.12	54.24	54.37	54.47	54.57	54.67	54.77	54.88	54.98	55.08	55.17	55.26	55.36	
2W	51.34	51.42	51.49	51.55	51.63	51.69	51.75	51.80	51.87	51.92	51.97	52.01	52.12	52.24	52.35	52.46	52.56	52.66	52.75	52.85	52.95	53.05	53.21	53.37	53.54	53.71	53.86	54.00	54.12	54.25	54.38	54.50	54.60	54.70	54.80	54.91	55.02	55.12	55.22	55.31	55.40	55.50	
3W	51.48	51.55	51.62	51.69	51.76	51.82	51.89	51.94	52.00	52.05	52.11	52.14	52.25	52.37	52.49	52.59	52.69	52.79	52.88	52.98	53.08	53.19	53.34	53.51	53.67	53.85	53.99	54.14	54.25	54.39	54.51	54.64	54.74	54.84	54.94	55.04	55.15	55.25	55.35	55.44	55.53	55.63	
4W	51.61	51.69	51.76	51.82	51.90	51.96	52.02	52.07	52.14	52.19	52.26	52.28	52.39	52.51	52.62	52.73	52.83	52.93	53.02	53.12	53.22	53.32	53.48	53.64	53.81	53.98	54.13	54.27	54.39	54.52	54.65	54.77	54.87	54.97	55.07	55.18	55.29	55.39	55.49	55.58	55.67	55.77	
5W	51.75	51.82	51.90	51.96	52.03	52.09	52.16	52.21	52.27	52.32	52.38	52.41	52.53	52.64	52.76	52.86	52.96	53.06	53.15	53.25	53.35	53.46	53.61	53.78	53.94	54.12	54.26	54.41	54.52	54.66	54.78	54.91	55.01	55.11	55.21	55.31	55.42	55.52	55.62	55.71	55.80	55.90	
1E	51.75	51.82	51.90	51.96	52.03	52.09	52.16	52.21	52.27	52.32	52.38	52.41	52.53	52.64	52.76	52.86	52.96	53.06	53.15	53.25	53.35	53.46	53.61	53.78	53.94	54.12	54.26	54.41	54.52	54.66	54.78	54.91	55.01	55.11	55.21	55.31	55.42	55.52	55.62	55.71	55.80	55.90	
2E	51.61	51.69	51.76	51.82	51.90	51.96	52.02	52.07	52.14	52.19	52.26	52.28	52.39	52.51	52.62	52.73	52.83	52.93	53.02	53.12	53.22	53.32	53.48	53.64	53.81	53.98	54.13	54.27	54.39	54.52	54.65	54.77	54.87	54.97	55.07	55.18	55.29	55.39	55.49	55.58	55.67	55.77	
3E	51.48	51.55	51.62	51.69	51.76	51.82	51.89	51.94	52.00	52.05	52.11	52.14	52.25	52.37	52.49	52.59	52.69	52.79	52.88	52.98	53.08	53.19	53.34	53.51	53.67	53.85	53.99	54.14	54.25	54.39	54.51	54.64	54.74	54.84	54.94	55.04	55.15	55.25	55.35	55.44	55.53	55.63	
4E	51.34	51.42	51.49	51.55	51.63	51.69	51.75	51.80	51.87	51.92	51.97	52.01	52.12	52.24	52.35	52.46	52.56	52.66	52.75	52.85	52.95	53.05	53.21	53.37	53.54	53.71	53.86	54.00	54.12	54.25	54.38	54.50	54.60	54.70	54.80	54.91	55.02	55.12	55.22	55.31	55.40	55.50	
5E	51.21	51.28	51.36	51.42	51.49	51.55	51.62	51.67	51.73	51.78	51.84	51.87	51.93	52.10	52.22	52.32	52.42	52.52	52.61	52.71	52.81	52.92	53.07	53.24	53.40	53.58	53.72	53.87	53.98	54.12	54.24	54.37	54.47	54.57	54.67	54.77	54.88	54.98	55.08	55.17	55.26	55.36	

NOTE: ALL ELEVATIONS INCLUDE DEAD LOAD DEFLECTION

FINISH DECK ELEVATIONS AT 1/2 OF GIRDERS

HENNINGSON, DURHAM & RICHARDSON
ENGINEERS - PLANNERS - CONSULTANTS
CAPITOL LIFE CENTER
DENVER, COLORADO

DEPARTMENT OF HIGHWAYS
STATE OF COLORADO

MISCELLANEOUS
DETAILS

RELOCATED CLEAR CREEK,
ACROSS COOR'S ACCESS ROAD & RAILROAD
Sta. 9+41.0 MCINTYRE, ST.


Near GOLDEN, CO. Sec. 24, T. 33, R. 70W

Designed by R.E.R. Approved by
Made by U.S. Date: 19
Checked by M.S.S.


REVISIONS

FED. ROAD DIST. NO.	DIVISION	PROJECT NO.	SHEET NO.	TOTAL SHEETS
9	COLO.	F050-1(2)	22	

AS CONSTRUCTED
NO. 10-11-01 DATE

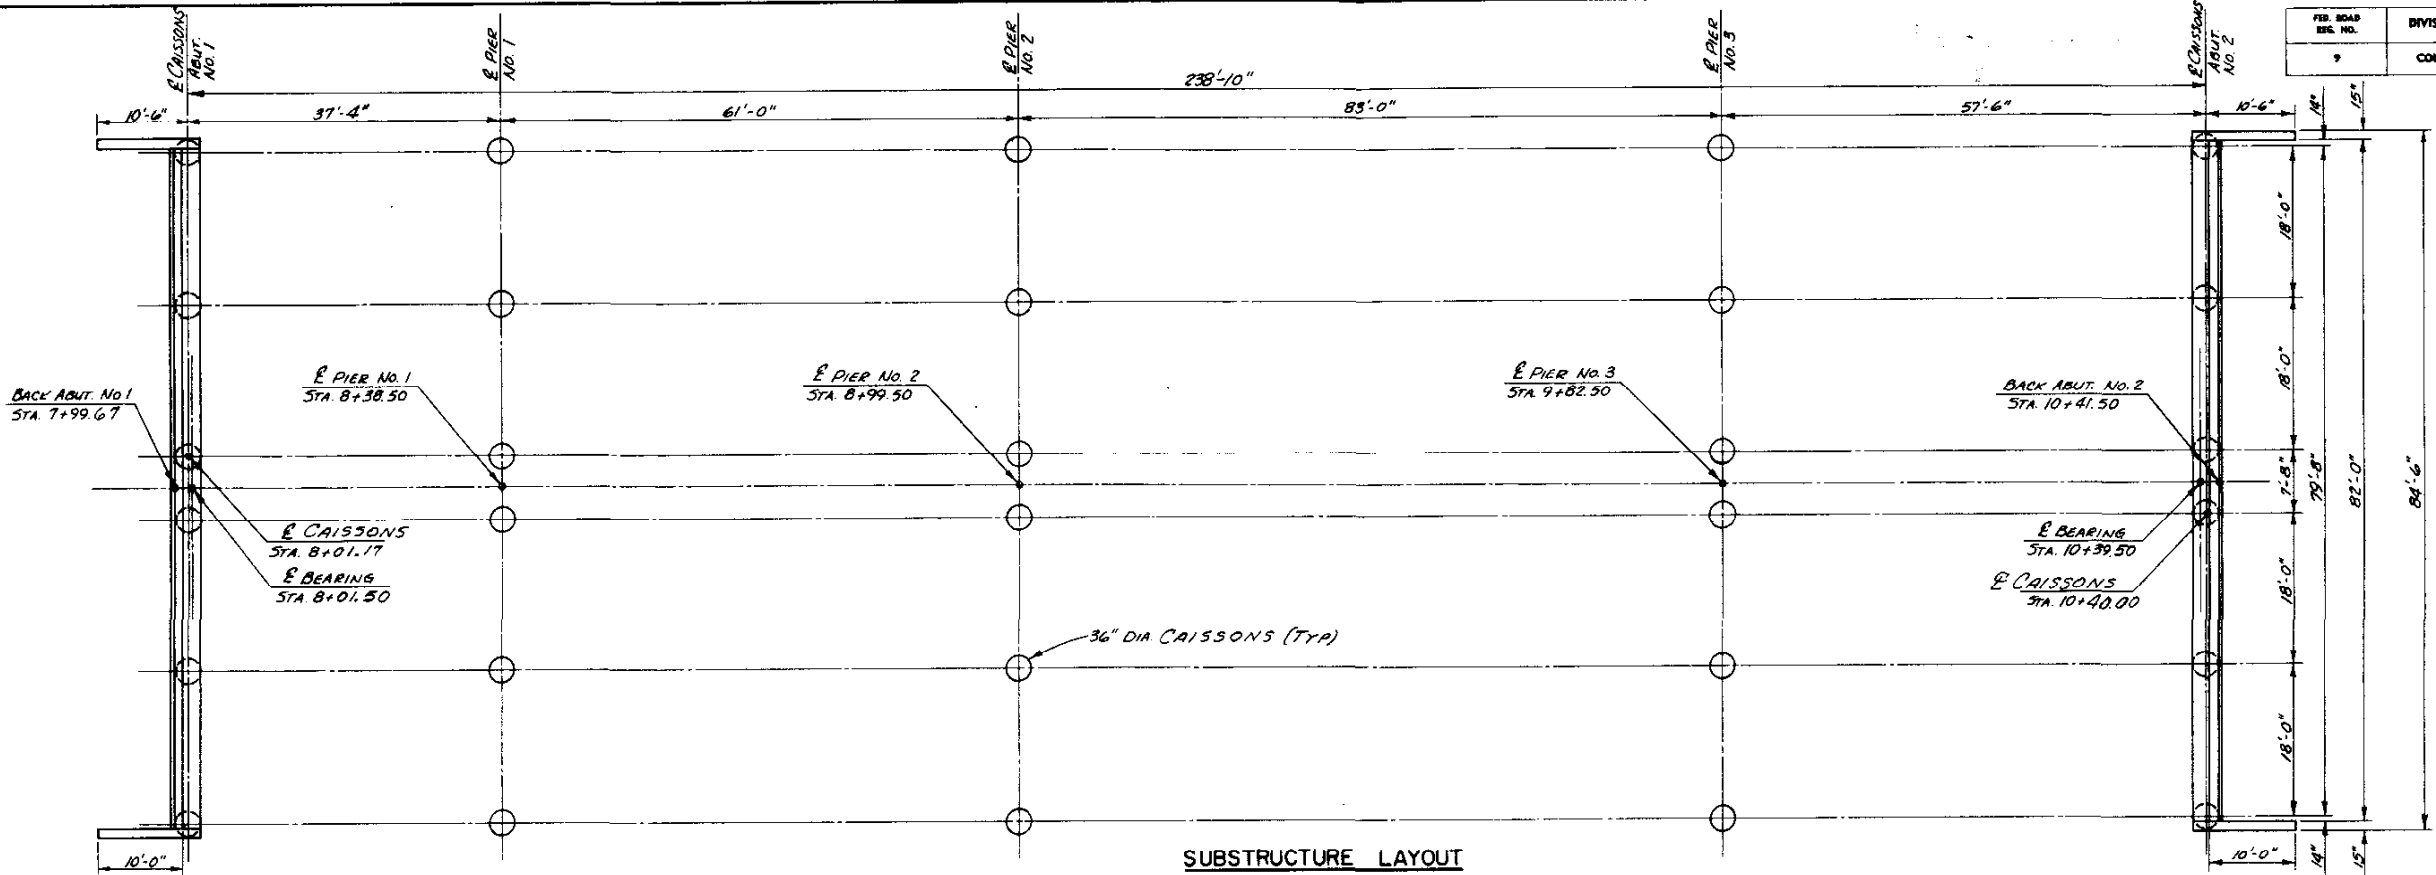

SUBSTRUCTURE LAYOUT

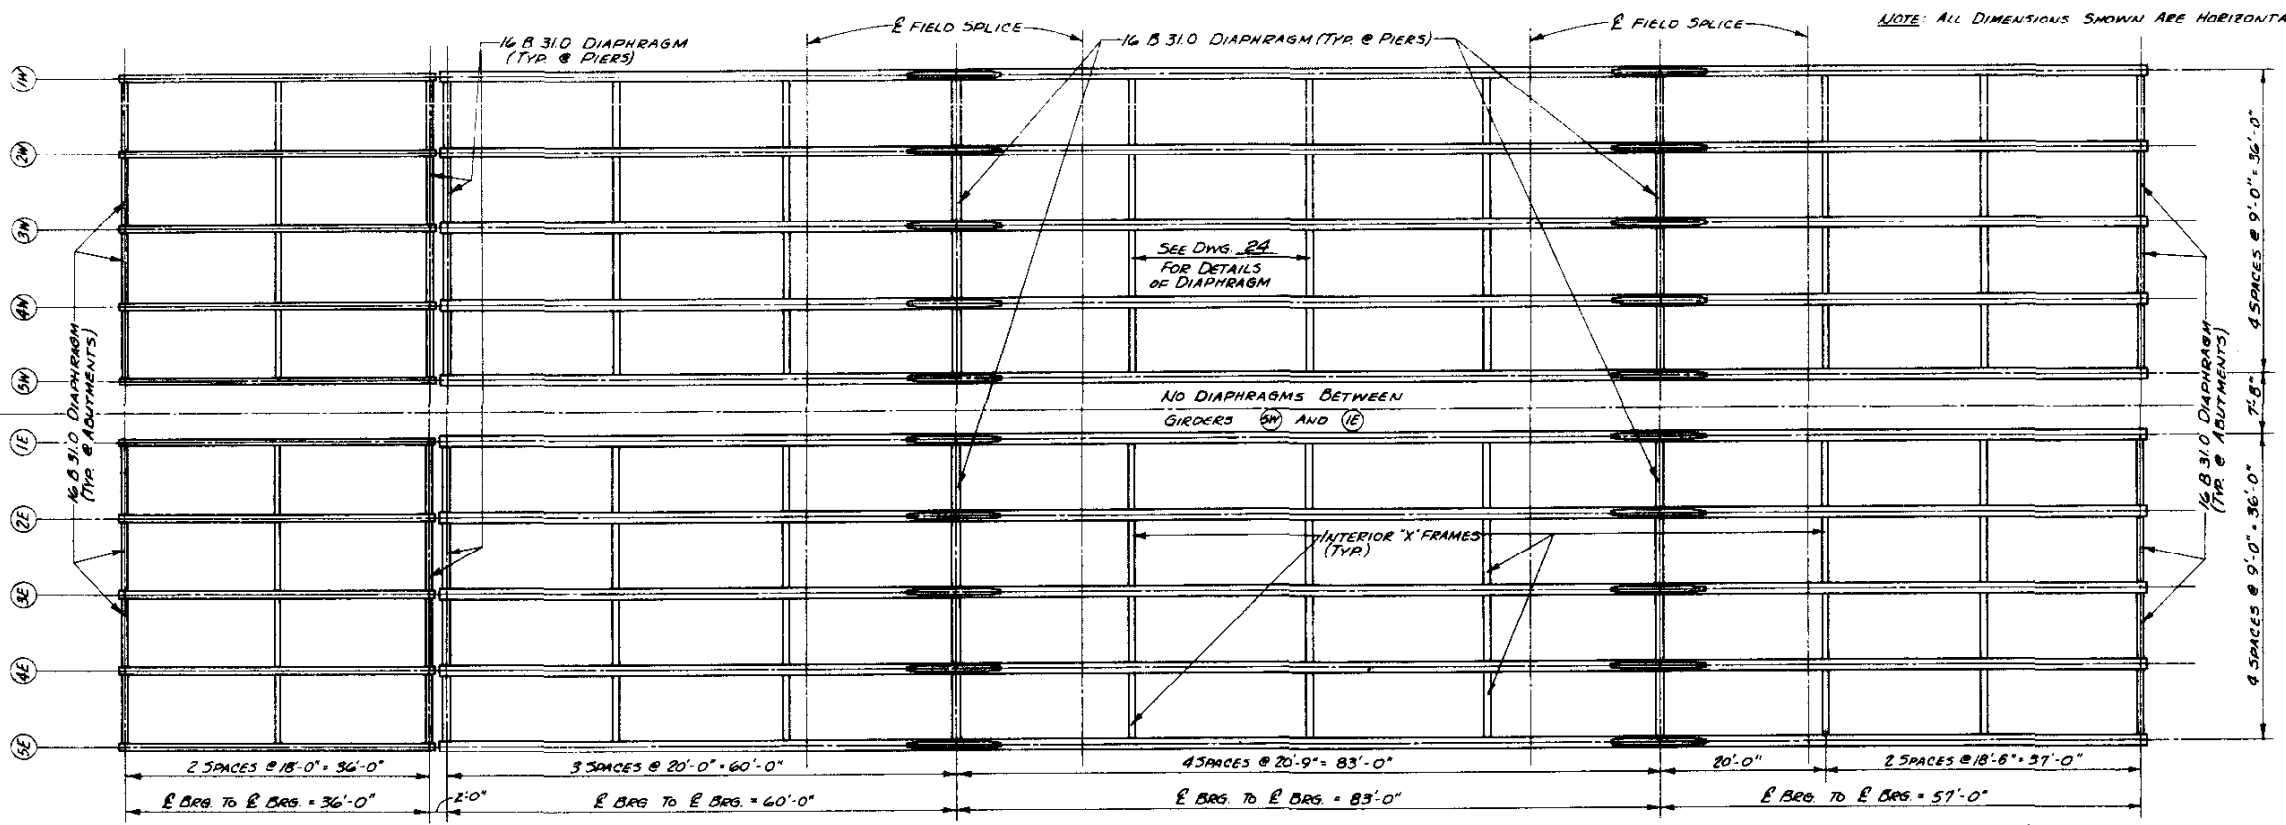

GIRDER FRAMING PLAN

HENNINGSON, DURHAM & RICHARDSON
ENGINEERS - PLANNERS - CONSULTANTS
CAPITOL LIFE CENTER
DENVER, COLORADO


DEPARTMENT OF HIGHWAYS
STATE OF COLORADO
SUBSTRUCTURE LAYOUT
&
GIRDER FRAMING PLAN
RELOCATED CLEAR CREEK,
Across COOR'S ACCESS ROAD & RAILROAD
Sta. 9+41.0 MCINTYRE ST.
Near GULCH Sec. 24 T. 35 R. 20W
Designed by R.E.R. Approved by
Made by D.S. Checked by W.A.S. Date: 19

FED. ROAD SEG. NO.	DIVISION	PROJECT NO.	SHEET NO.	TOTAL SHEETS
9	COLO.	F058-1 (2)	23	


Ⓡ2 ADD GAS LINE TELE CONDUIT & NOTE DGS
1-7-71

AS COMPLETED


ACKNOWLEDGMENTS

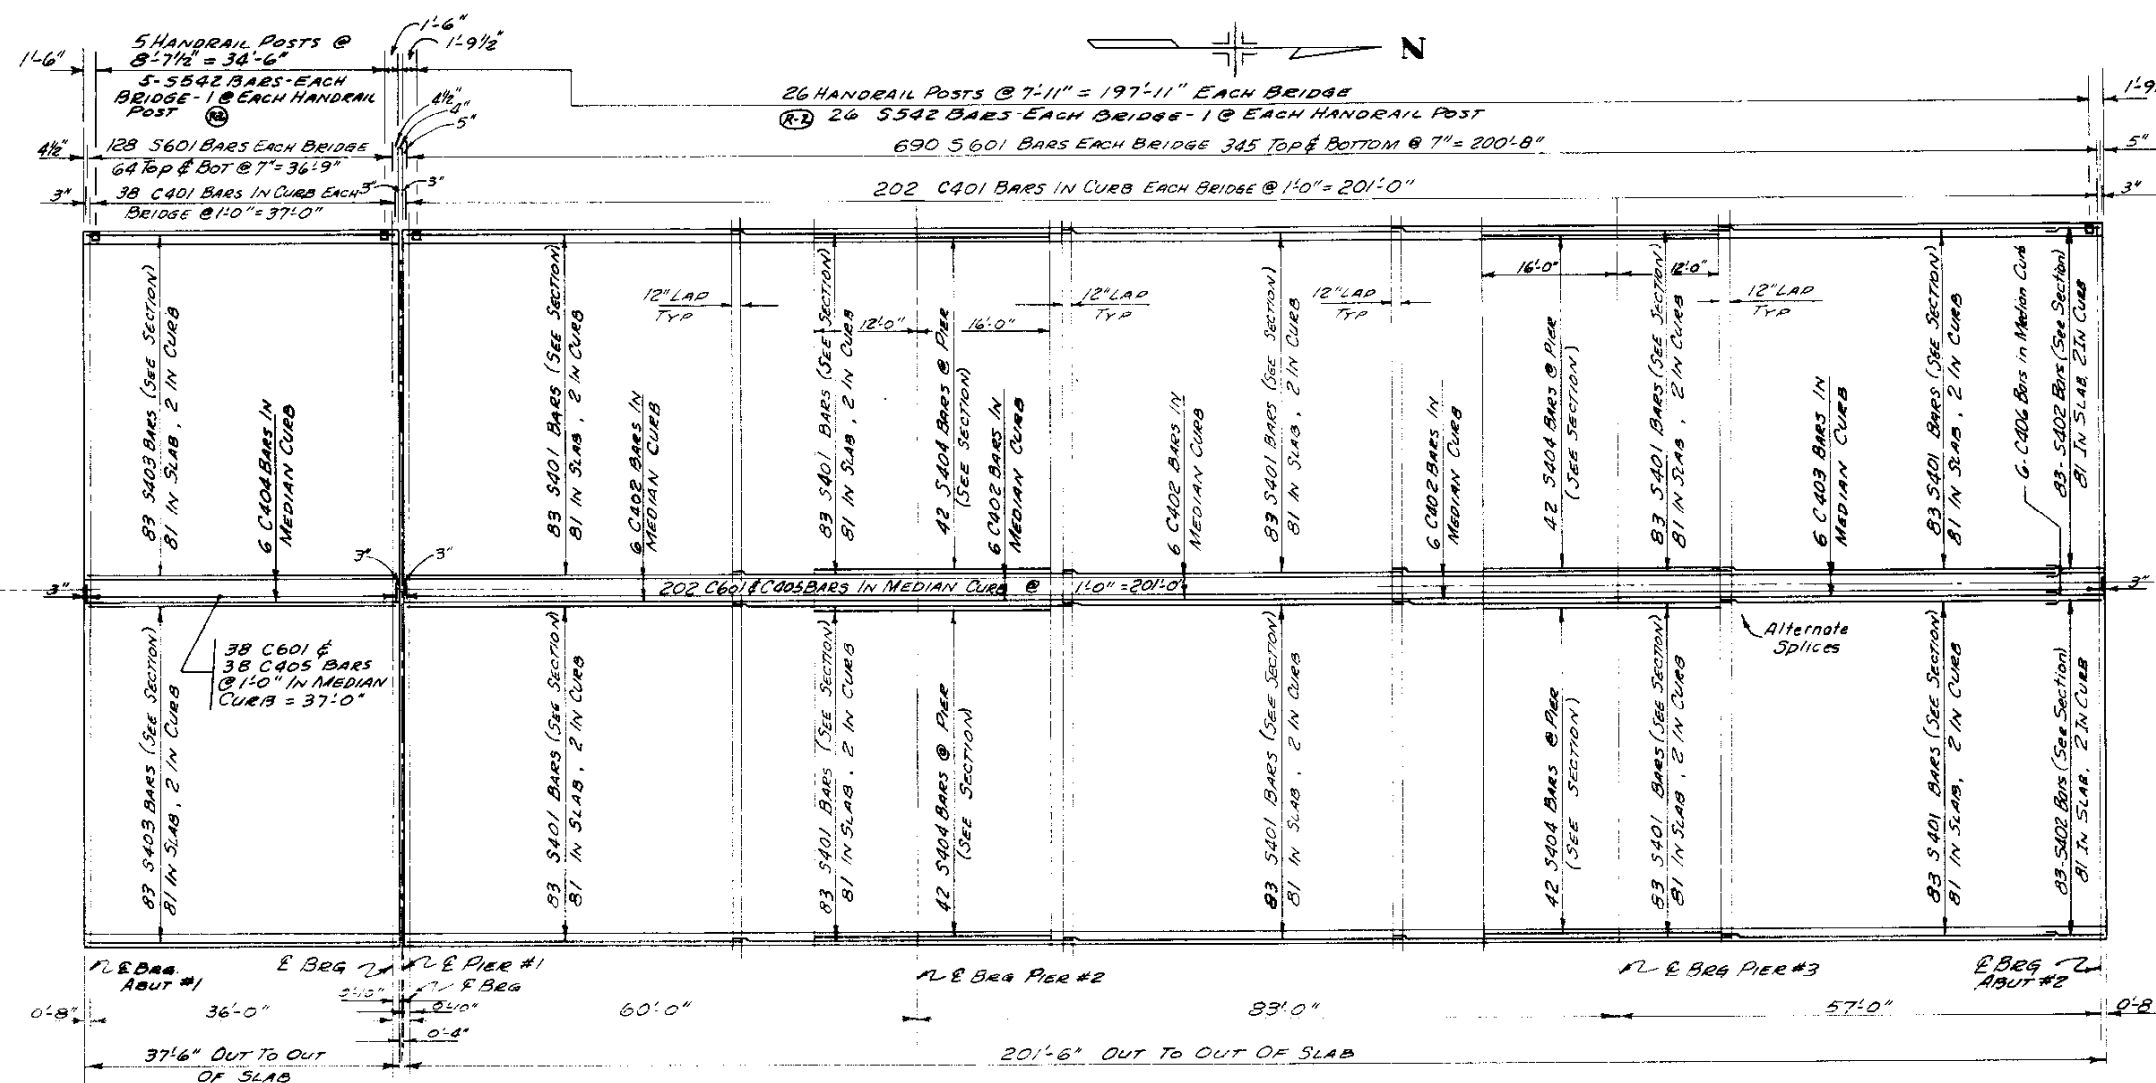


PLAN

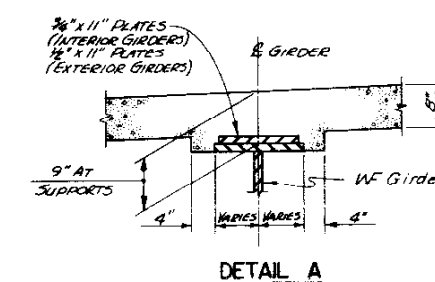

DETAIL A

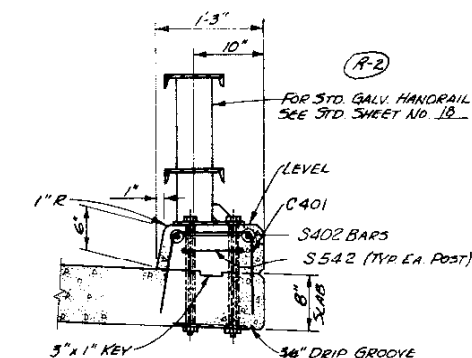

TYPICAL CURB SECTION

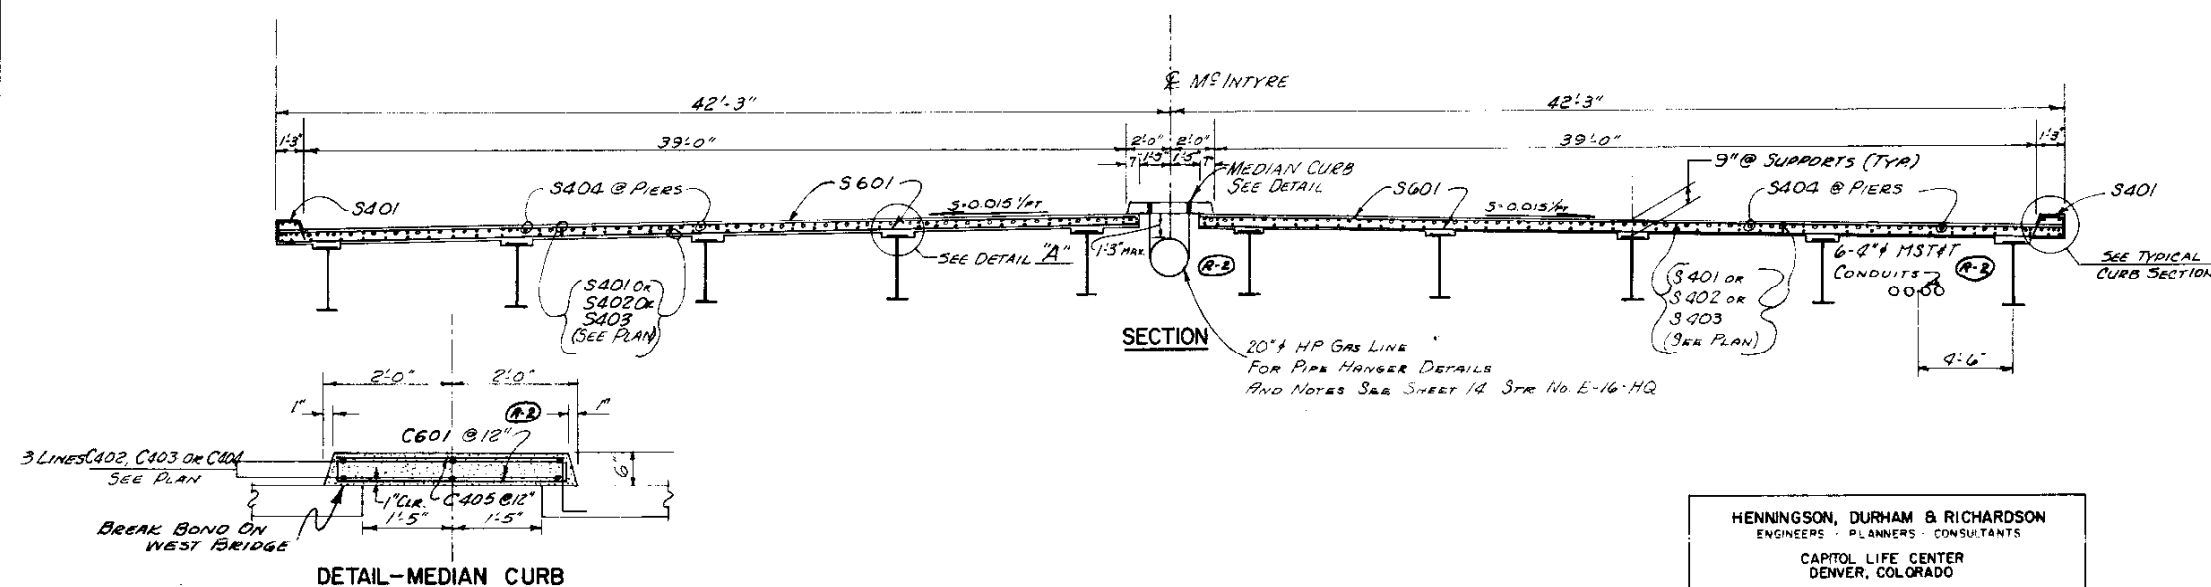

HENNINGSON, DURHAM & RICHARDSON
ENGINEERS • PLANNERS • CONSULTANTS
CAPITOL LIFE CENTER
DENVER, COLORADO



DEPARTMENT OF HIGHWAYS
STATE OF COLORADO
DECK
PLAN & SECTION

RELOCATED CLEAR CREEK,
Across COOP'S ACCESS ROAD & RAILROAD
Sta. 9+41.0 MCINTYRE ST.
Near GOLDEN Sec. 24 T. 35 R. 30W


Designed by R.E.R.	Approved by
Made by A.T.	
Checked by W.A.S.	Date: 19

FED. ROAD REG. NO.	DIVISION	PROJECT NO.	SHEET NO.	TOTAL SHEETS
9	COLO.	F058-1 (2)	24	


(R-2) 1-7-71 Shear Conn. Spacing, Conduits, and note CJC

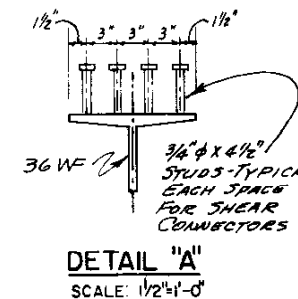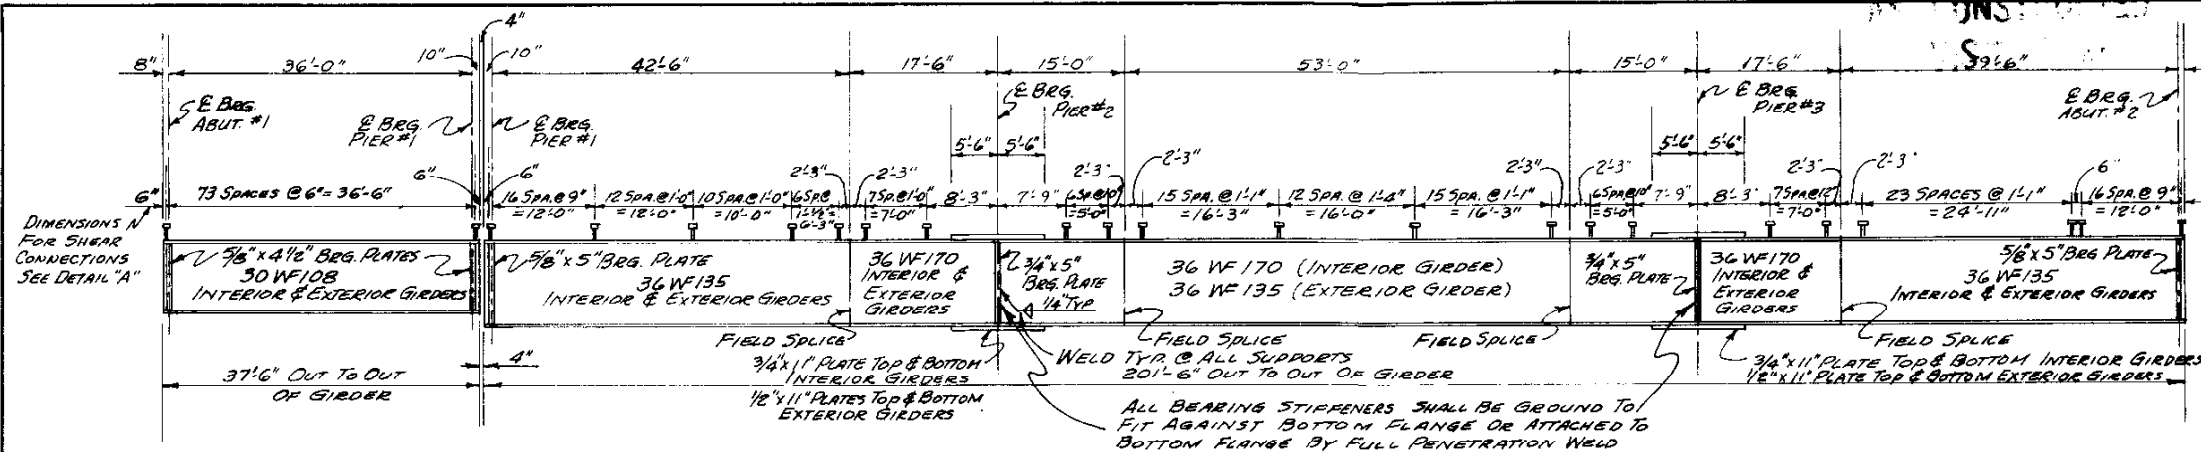


DETAIL EXTERIOR & INTERIOR GIRDERS

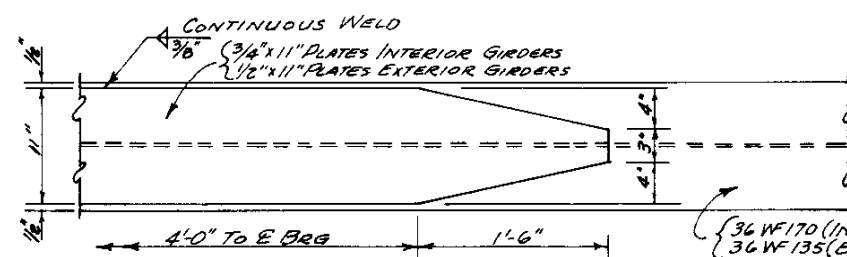

COVER PLATE DETAILS
SCALE: $1\frac{1}{2}" = 1'-0"$

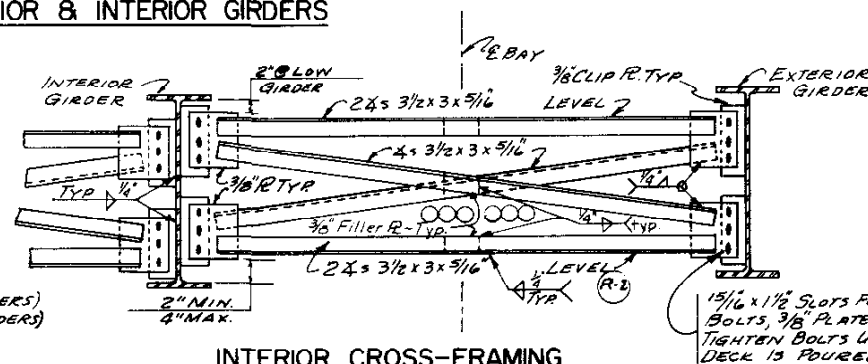


INTERIOR CROSS-FRAMING
SCALE: 3/4"=1'-0" 1/8"

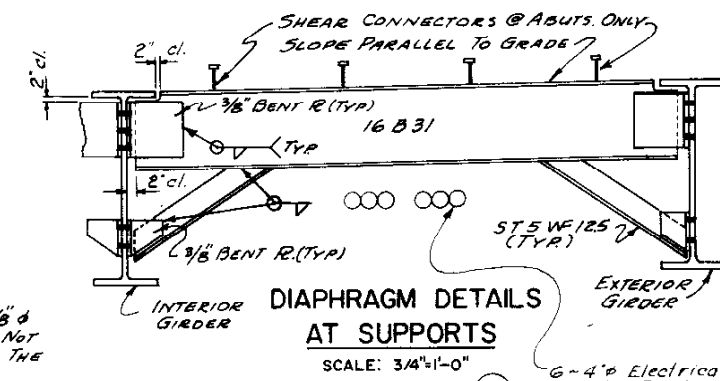


DIAPHRAGM DETAILS
AT SUPPORTS
SCALE: $\frac{3}{4}" = 1'-0"$


(R-2) 6-4" Electrical
conduits. For hanger
details, see Sheet #21

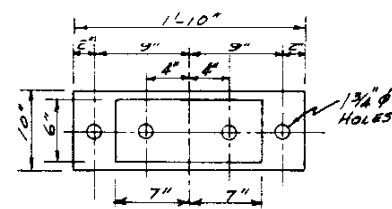


PLAN

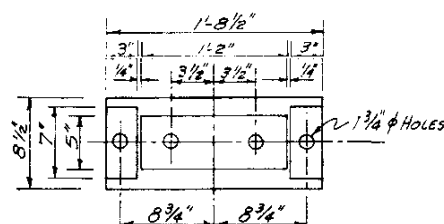

PLAN

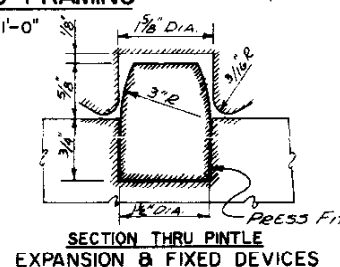


SECTION THRU PINTLE
EXPANSION & FIXED DEVICES

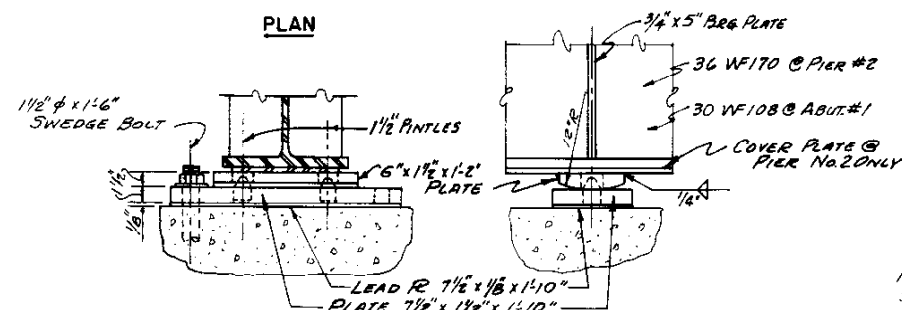

ELEVATION

END VIEW

FIXED BEARING DEVICE
AT PIER NO. 2 & ABUT. NO. 1
SCALE: 1/2"=1'-0"

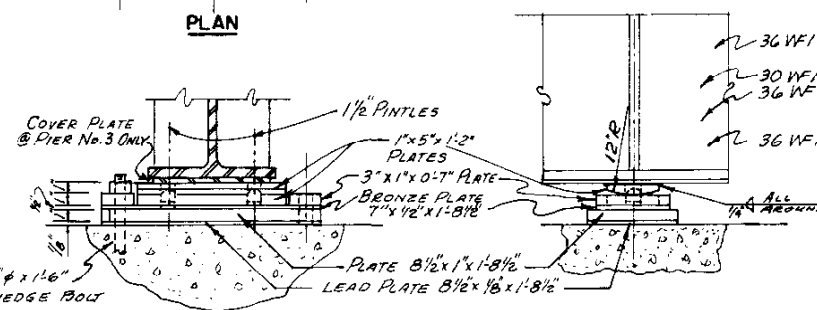


ELEVATION

END VIEW

EXPANSION BEARING DEVICE
AT PIERS NO. 1 & NO. 3 & ABUT. NO. 2

Note: All anchor bolts shall be smuggled and jammed. (R-2)

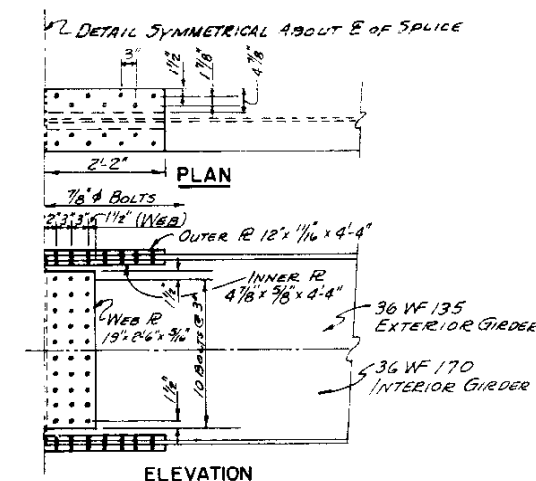

ELEVATION
FIELD SPLICE DETAIL
SCALE: 3/4"=1'-0"

DEPARTMENT OF HIGHWAYS
STATE OF COLORADO

GIRDER DETAILS

RELOCATED CLEAR CREEK,
 Access COOR'S ACCESS ROAD & RAILROAD
Sta. 9 + 41.0 MCINTYRE ST.
 Near GOLDEN Sec. 24 T. 35 R. 70W

Designed by <u>R.E.R.</u>	Approved by
Made by <u>A.T.</u>	
Checked by <u>W.A.S.</u>	Date: <u>19</u>


HENNINGSON, DURHAM & RICHARDSON
ENGINEERS · PLANNERS · CONSULTANTS

CAPITOL LIFE CENTER
DENVER, COLORADO

REVISIONS

AS CONSTRUCTED


FED. ROAD DIST. NO.	DIVISION	PROJECT NO.	SHEET NO.	TOTAL SHEETS
9	COLO.	F058-1(2)	25	

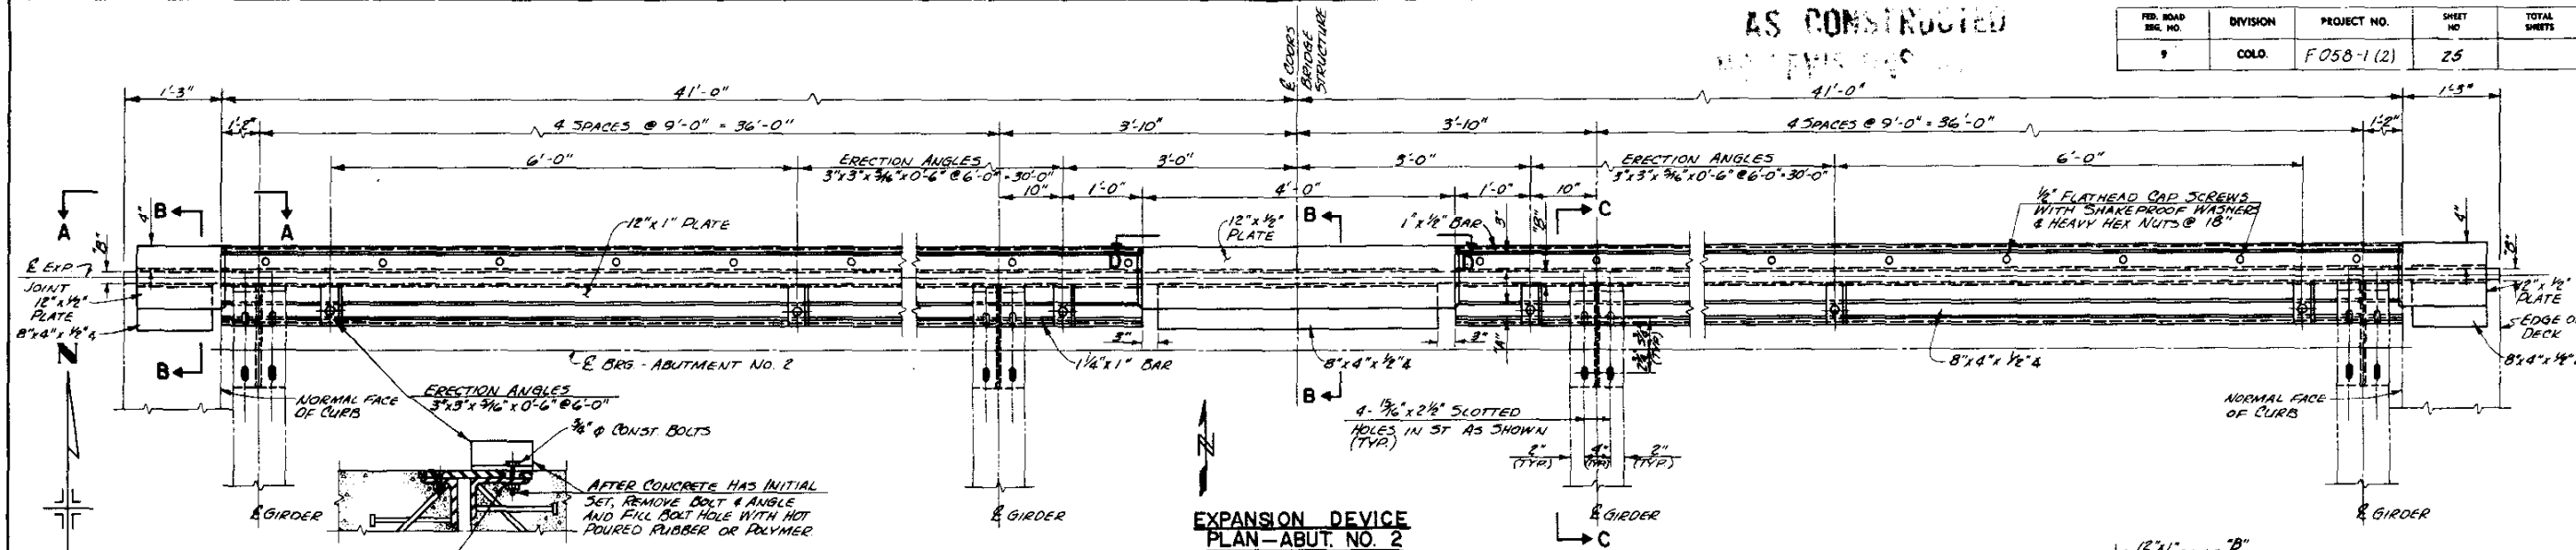


PART SECTION

EXPANSION DEVICE
PLAN-ABUT. NO. 2


TEMPERATURE °F	DIMENSION "A" PIER NO. 1	DIMENSION "B" ABUT. NO. 2
40°	4 7/8"	4 7/8"
60°	4"	4"
80°	3 7/8"	3 7/8"
100°	3 1/4"	3 1/4"

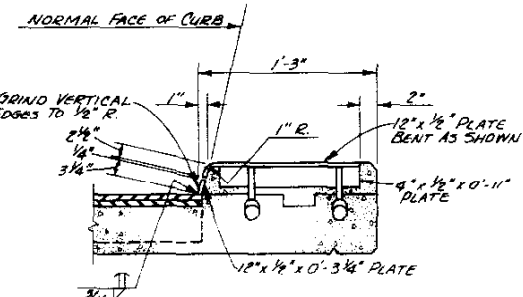


SECTION A
ABUT. NO. 2
PIER NO. 1

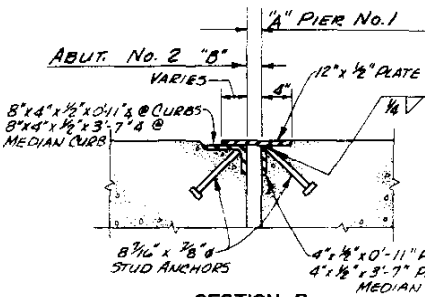

SECTION B
ABUT. NO. 2
PIER NO. 1

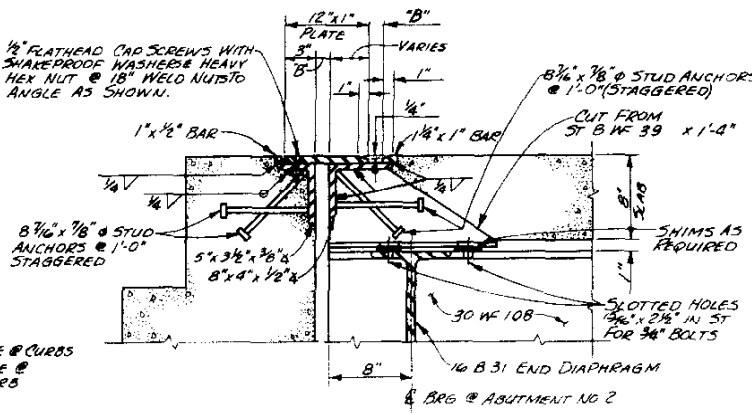


SECTION C
ABUT. NO. 2

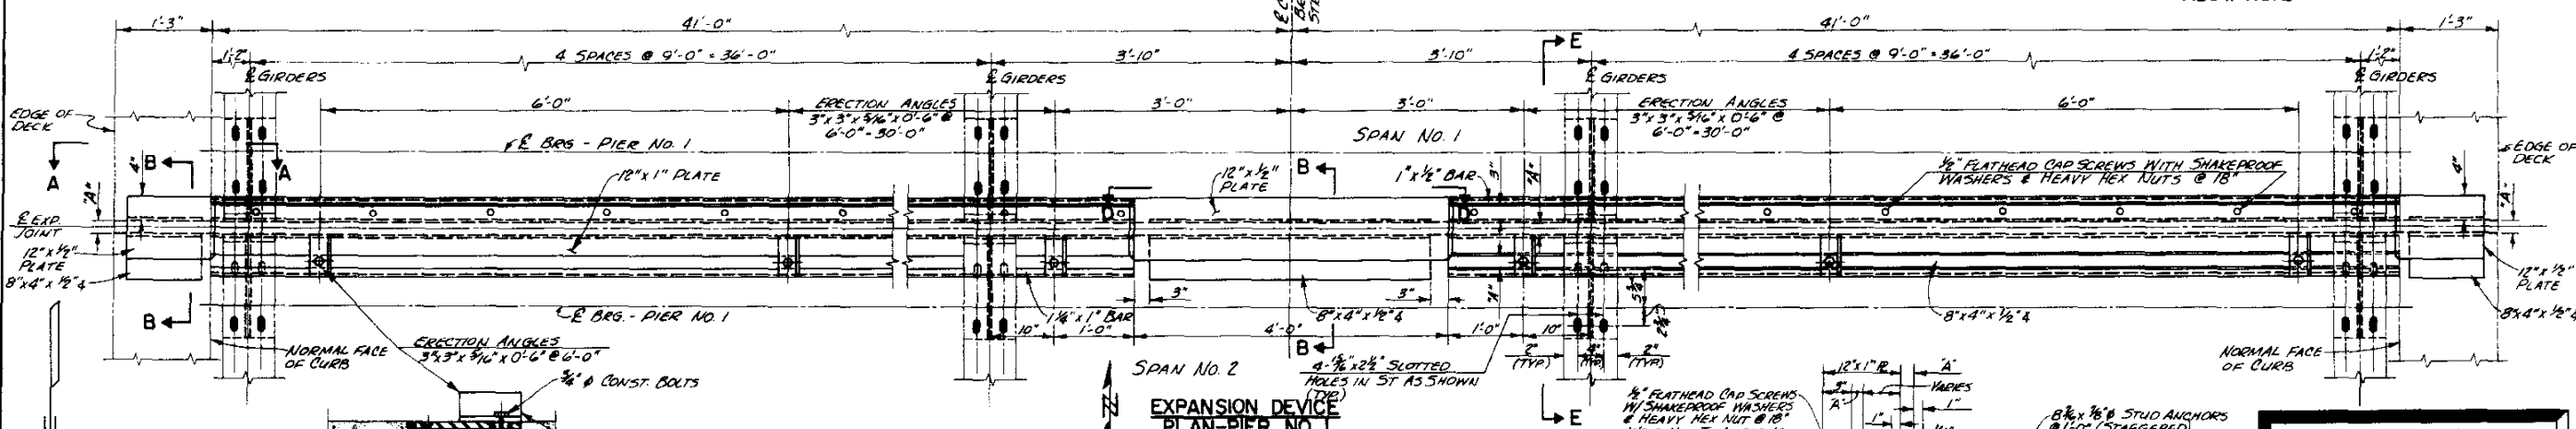


PART SECTION

EXPANSION DEVICE
PLAN-PIER NO. 1

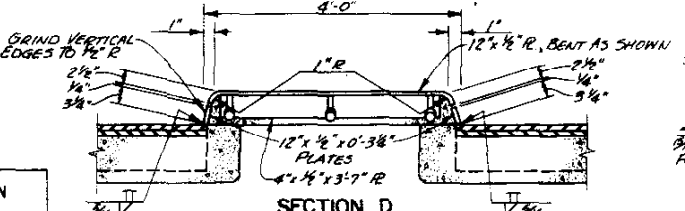

SECTION D
ABUT. NO. 2 & PIER NO. 1

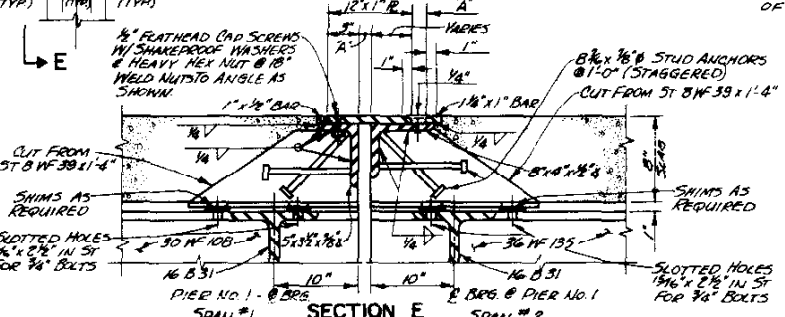

SECTION E
PIER NO. 1

HENNINGSON, DURHAM & RICHARDSON
ENGINEERS PLANNERS CONSULTANTS
CAPITOL LIFE CENTER
DENVER, COLORADO

**DEPARTMENT OF HIGHWAYS
STATE OF COLORADO
DECK EXPANSION
DEVICES AND DETAILS**


RELOCATED CLEAR CREEK,
Across COOR'S ACCESS ROAD & RAILROAD
Sta. 9+41.0 MCINTYRE ST.
Near GULDEN Sec. 24 T. 35 R. 30W.

Designed by R.E.R. Approved by
Made by D.S.
Checked by W.A.S. Date: 19


ELEV	ABUT. No. 1	ABUT. No. 2
A	5547.71	5551.35
B	5547.84	5551.49
C	5547.98	5551.62
D	5548.11	5551.76
E	5548.25	5551.89
F	5551.19	5553.34
G	5551.78	5555.93
H	5544.12	5547.85

1-7-71	Gas line
1-7-71	Reinforcing Steel


FED. ROAD EST. NO.	DIVISION	PROJECT NO.	SHEET NO.	TOTAL SHEETS
9	COLD.	F058-1(2)	26	

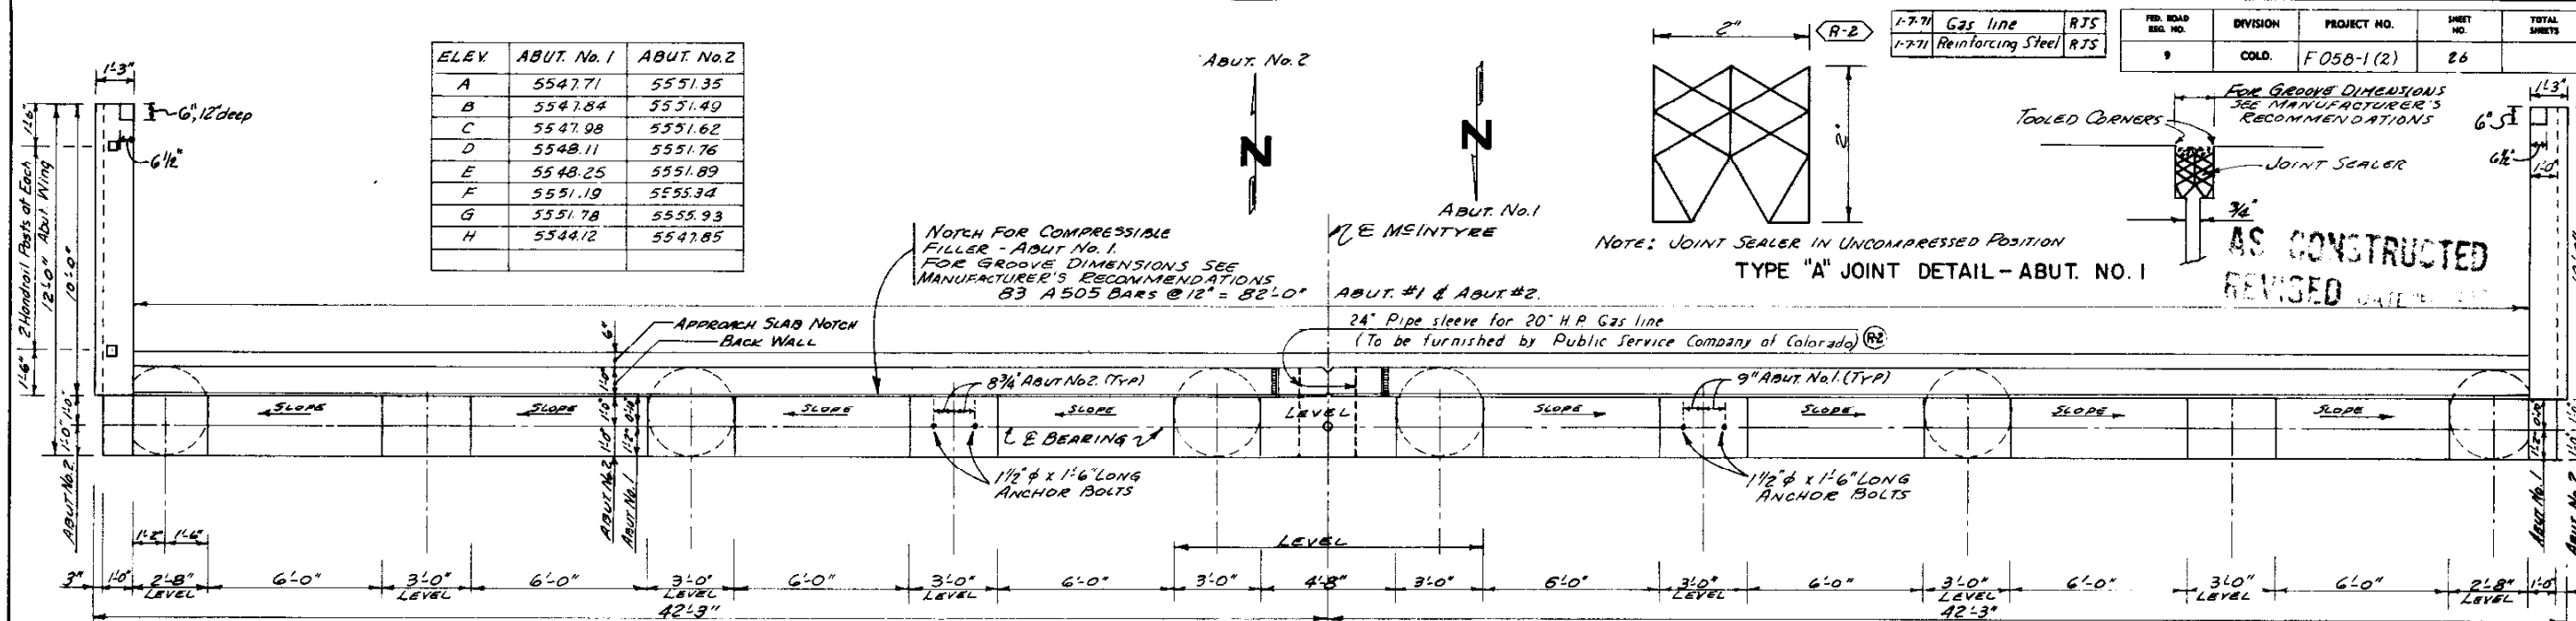

PLAN ABUT. NO. 1 & ABUT. NO. 2

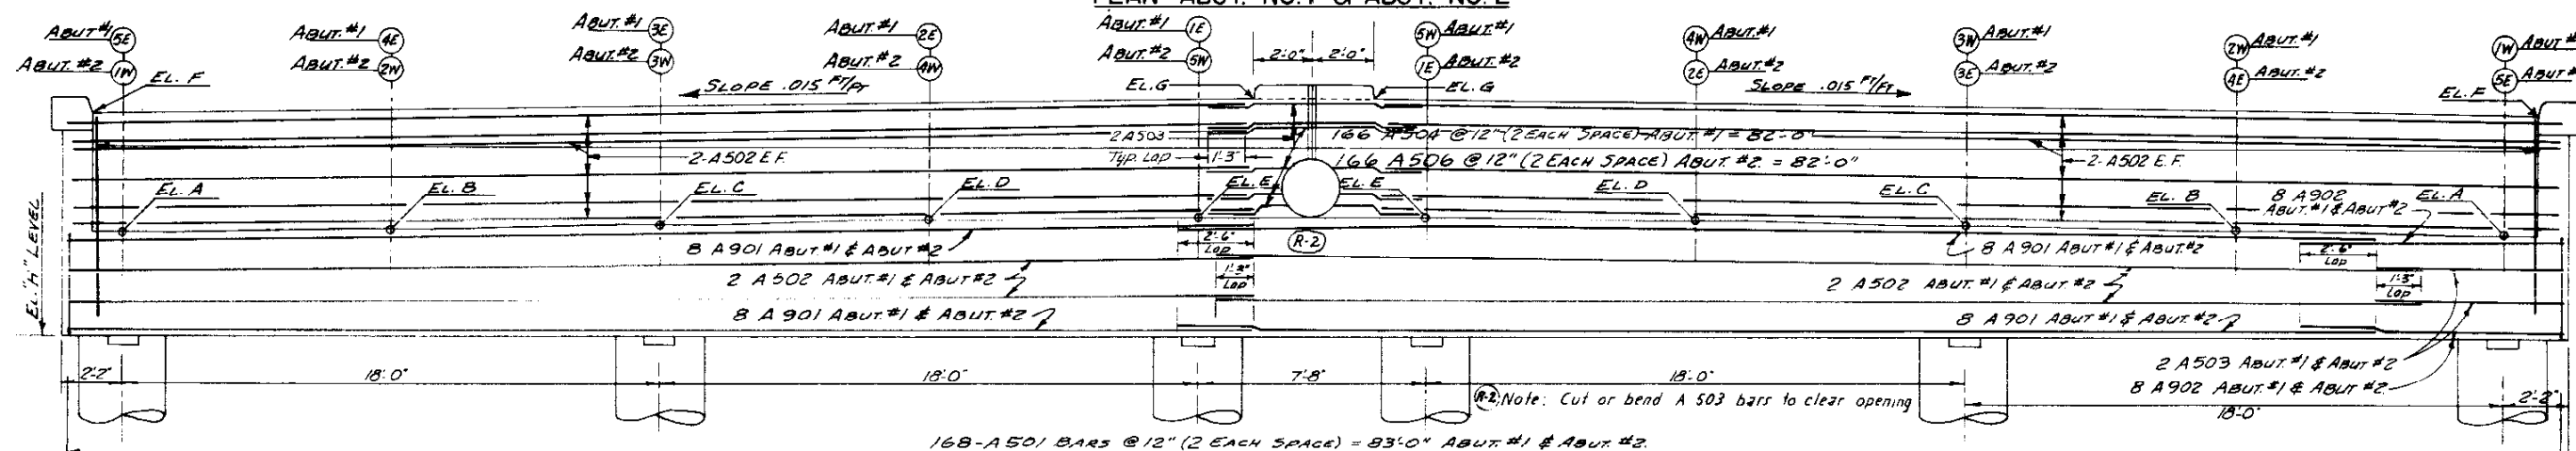


ELEVATION ABUT. NO.1 & ABUT. NO. 2

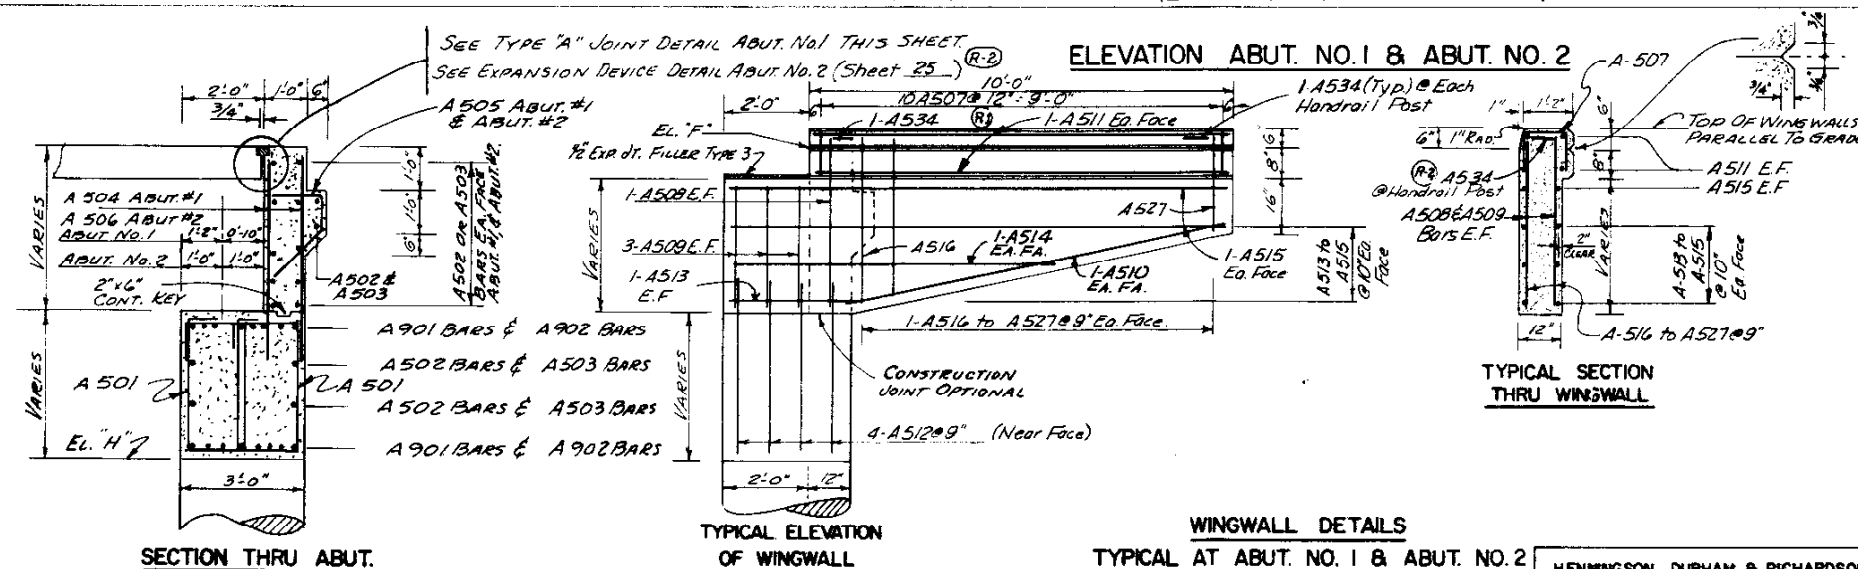

TYPICAL SECTION
THRU WINDOW WALL

WINGWALL DETAILS
TYPICAL AT ABUT. NO. 1 & ABUT. NO. 2

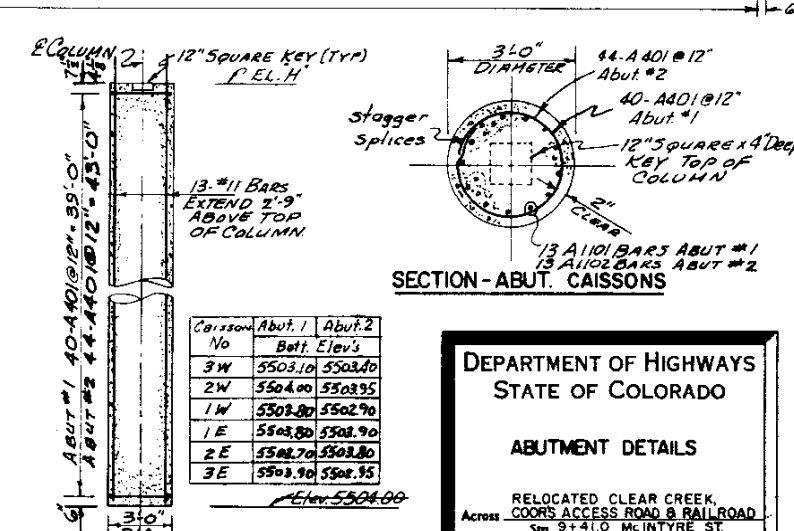

TYPICAL ABUT. CAISSON
12 REQD.

DEPARTMENT OF HIGHWAYS
STATE OF COLORADO


ABUTMENT DETAILS

RELOCATED CLEAR CREEK,
COOR'S ACCESS ROAD & RAILROAD
Sta. 9+41.0 MCINTYRE ST.
Near GOLDEN Sec. 24 T. 3S R. 70W


Designed by RER.	Approved by
Made by AJ.	
Checked by WAS	Date: 19

FED. ROAD DIST. NO.	DIVISION	PROJECT NO.	SHEET NO.	TOTAL SHEETS
9	COLO.	F 050-1 (2)	27	


AS BUILT
PIER NO. 1

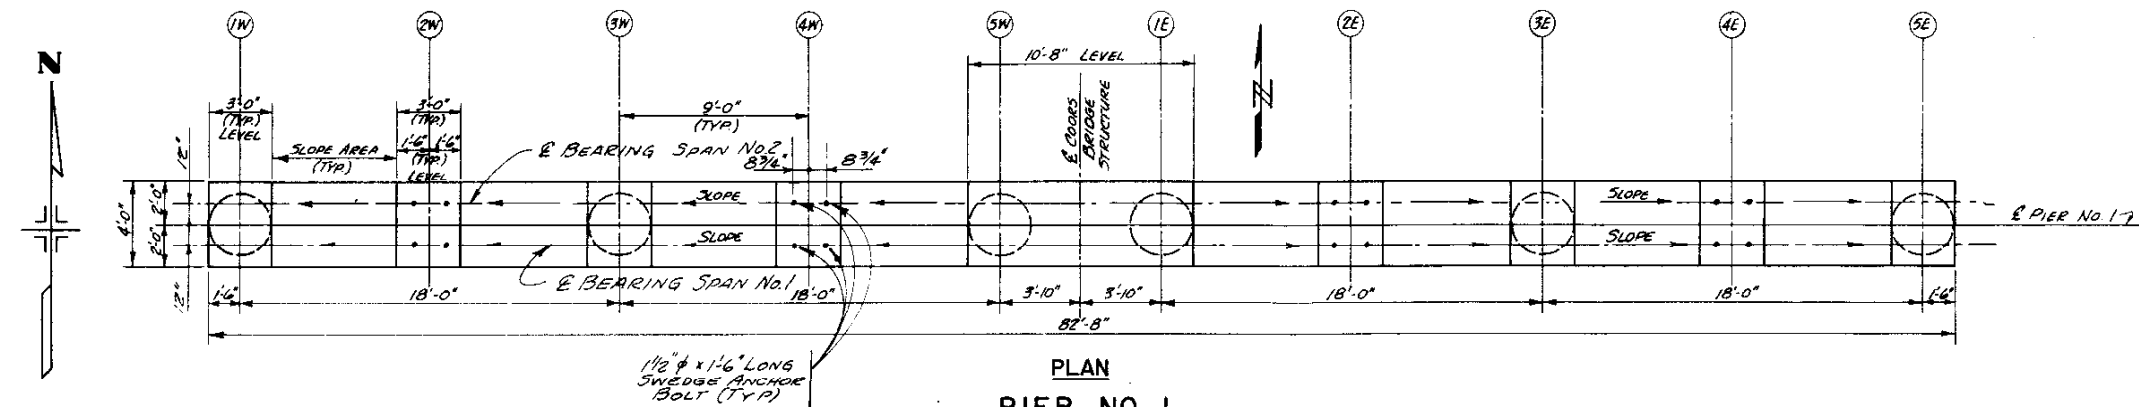


PLAN
PIER NO. 1

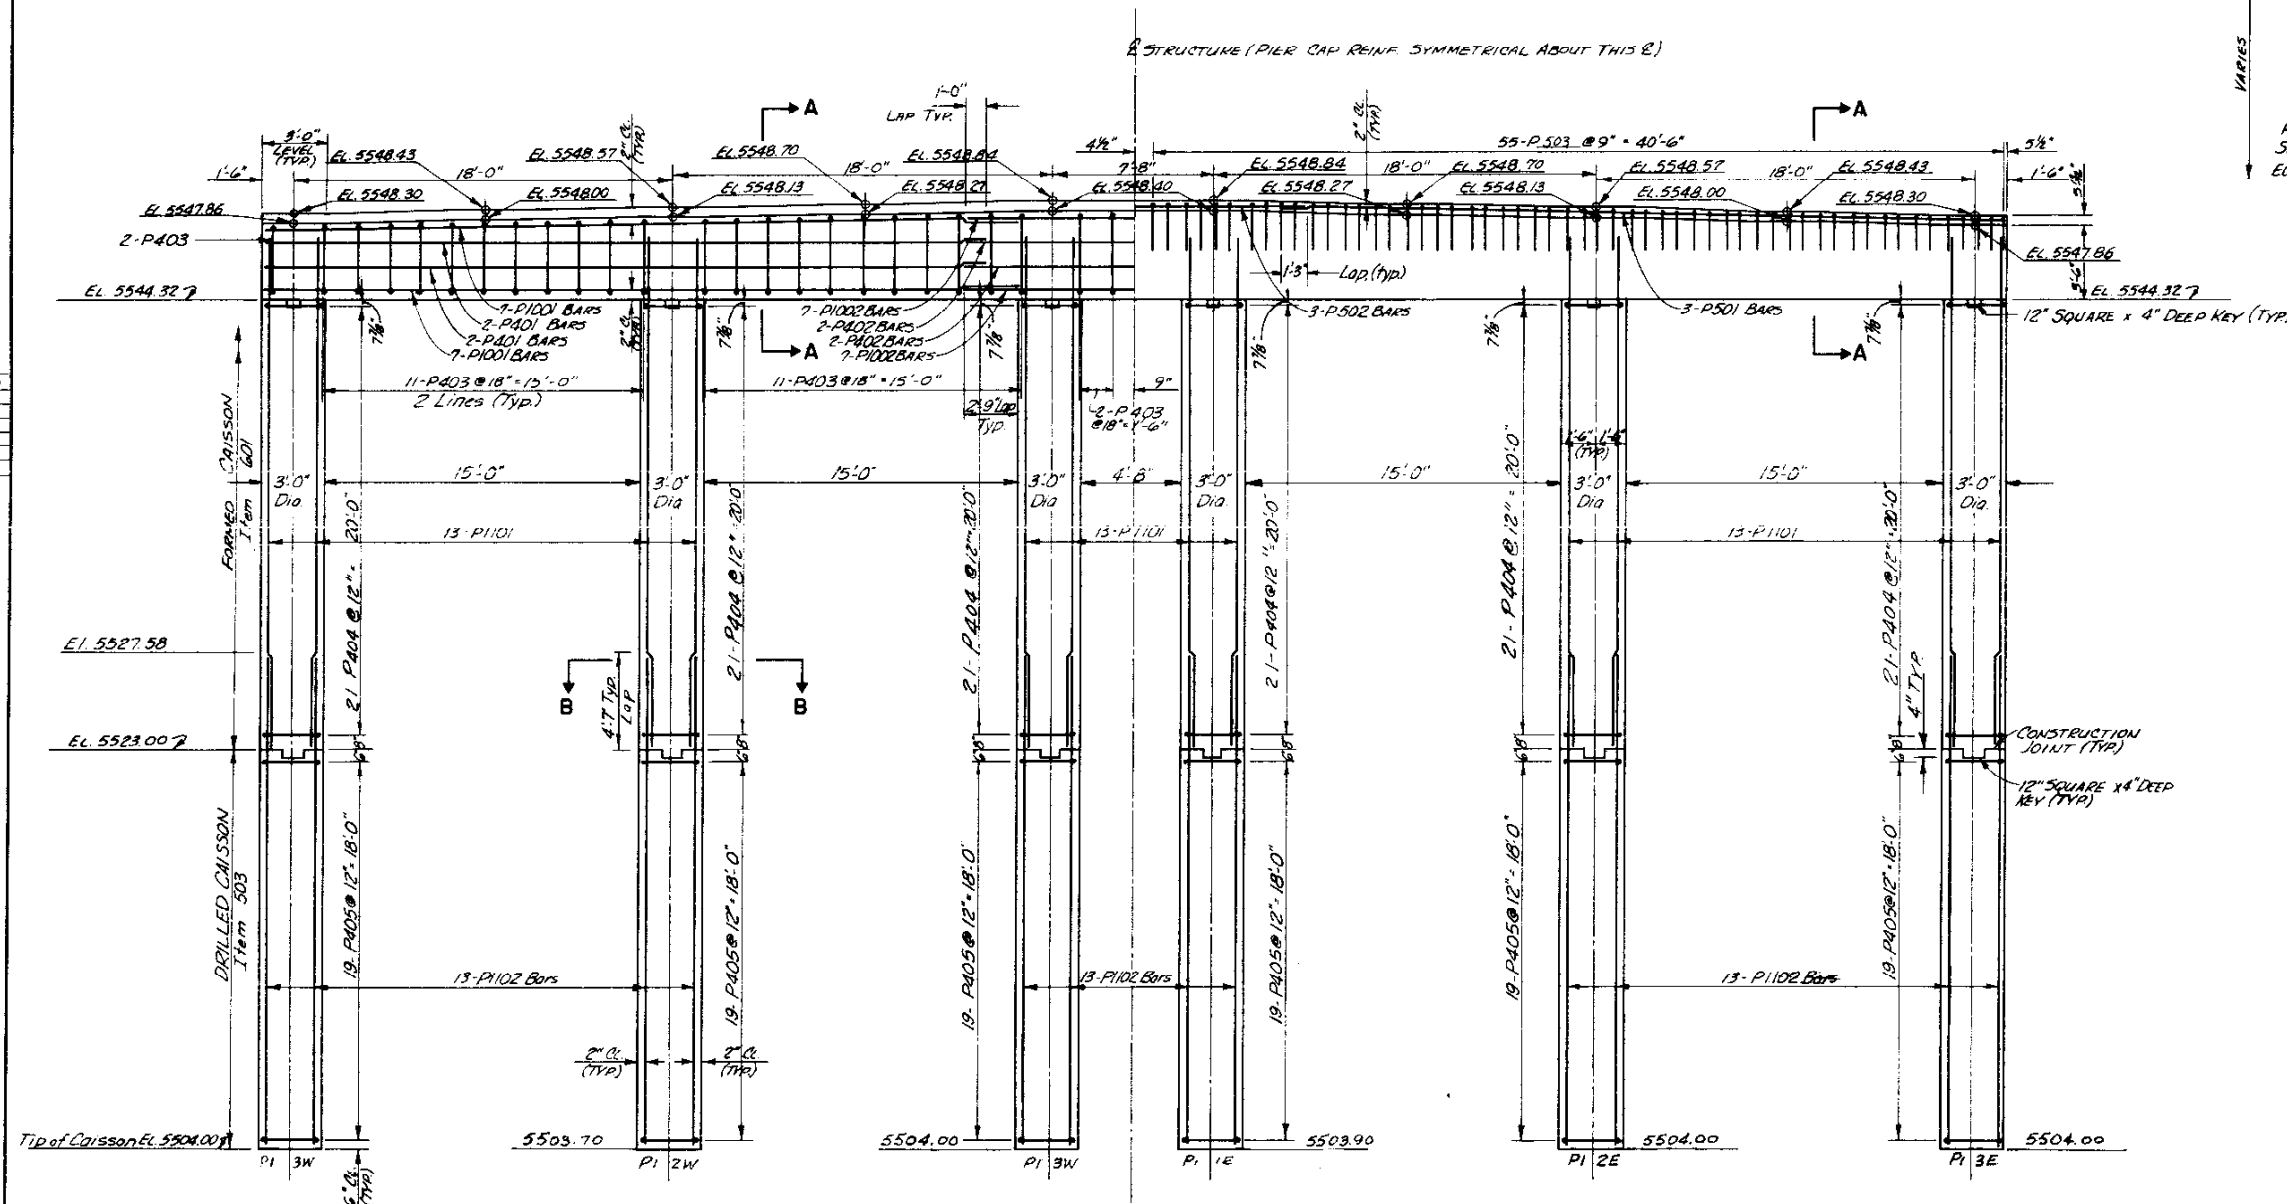

ELEVATION
PIER NO. 1

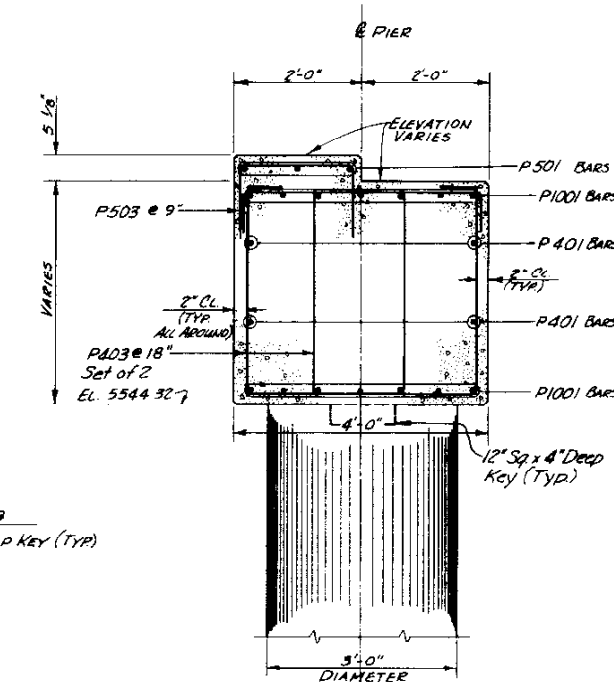

SECTION A

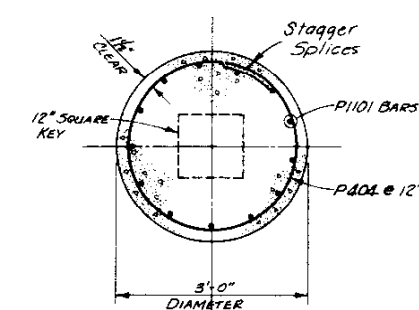

SECTION B

DEPARTMENT OF HIGHWAYS
STATE OF COLORADO

PIER NO. 1
DETAILS








RELOCATED CLEAR CREEK,
Across COOR'S ACCESS ROAD & RAILROAD
Sta. 9+41.0 MCINTYRE ST.
Near GOLDEN, Sec. 24 T. 35 R. 70W
Designed by PER Approved by
Made by R.S.
Checked by W.A.S. Date: 19

HENNINGSON, DURHAM & RICHARDSON
ENGINEERS - PLANNERS - CONSULTANTS
CAPITOL LIFE CENTER
DENVER, COLORADO

PER. BOARD REG. NO.	DIVISION	PROJECT NO.	SHEET NO.	TOTAL SHEETS
9	COLD.	F 058-1(2)	28	

ALL INFORMATION CONTAINED
HEREIN IS UNCLASSIFIED

PIER CAP ELEVATIONS		
ELEV	PIER No.2	PIER No.3
A	5545.36	5546.71
B	5548.85	5550.81
C	5548.96	5550.53
D	5549.10	5550.31
E	5549.23	5550.61
F	5549.37	5550.76

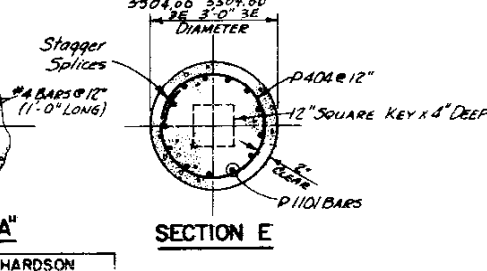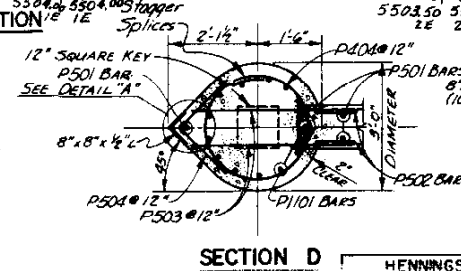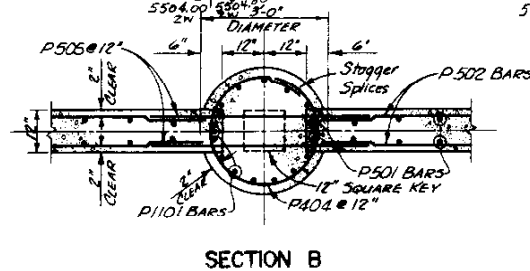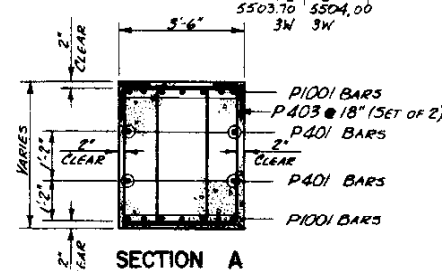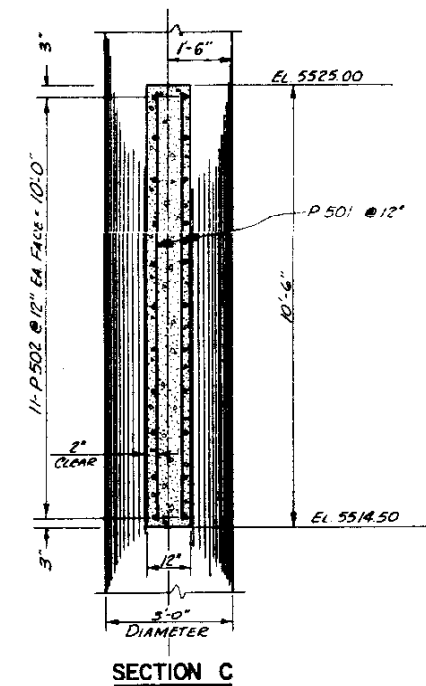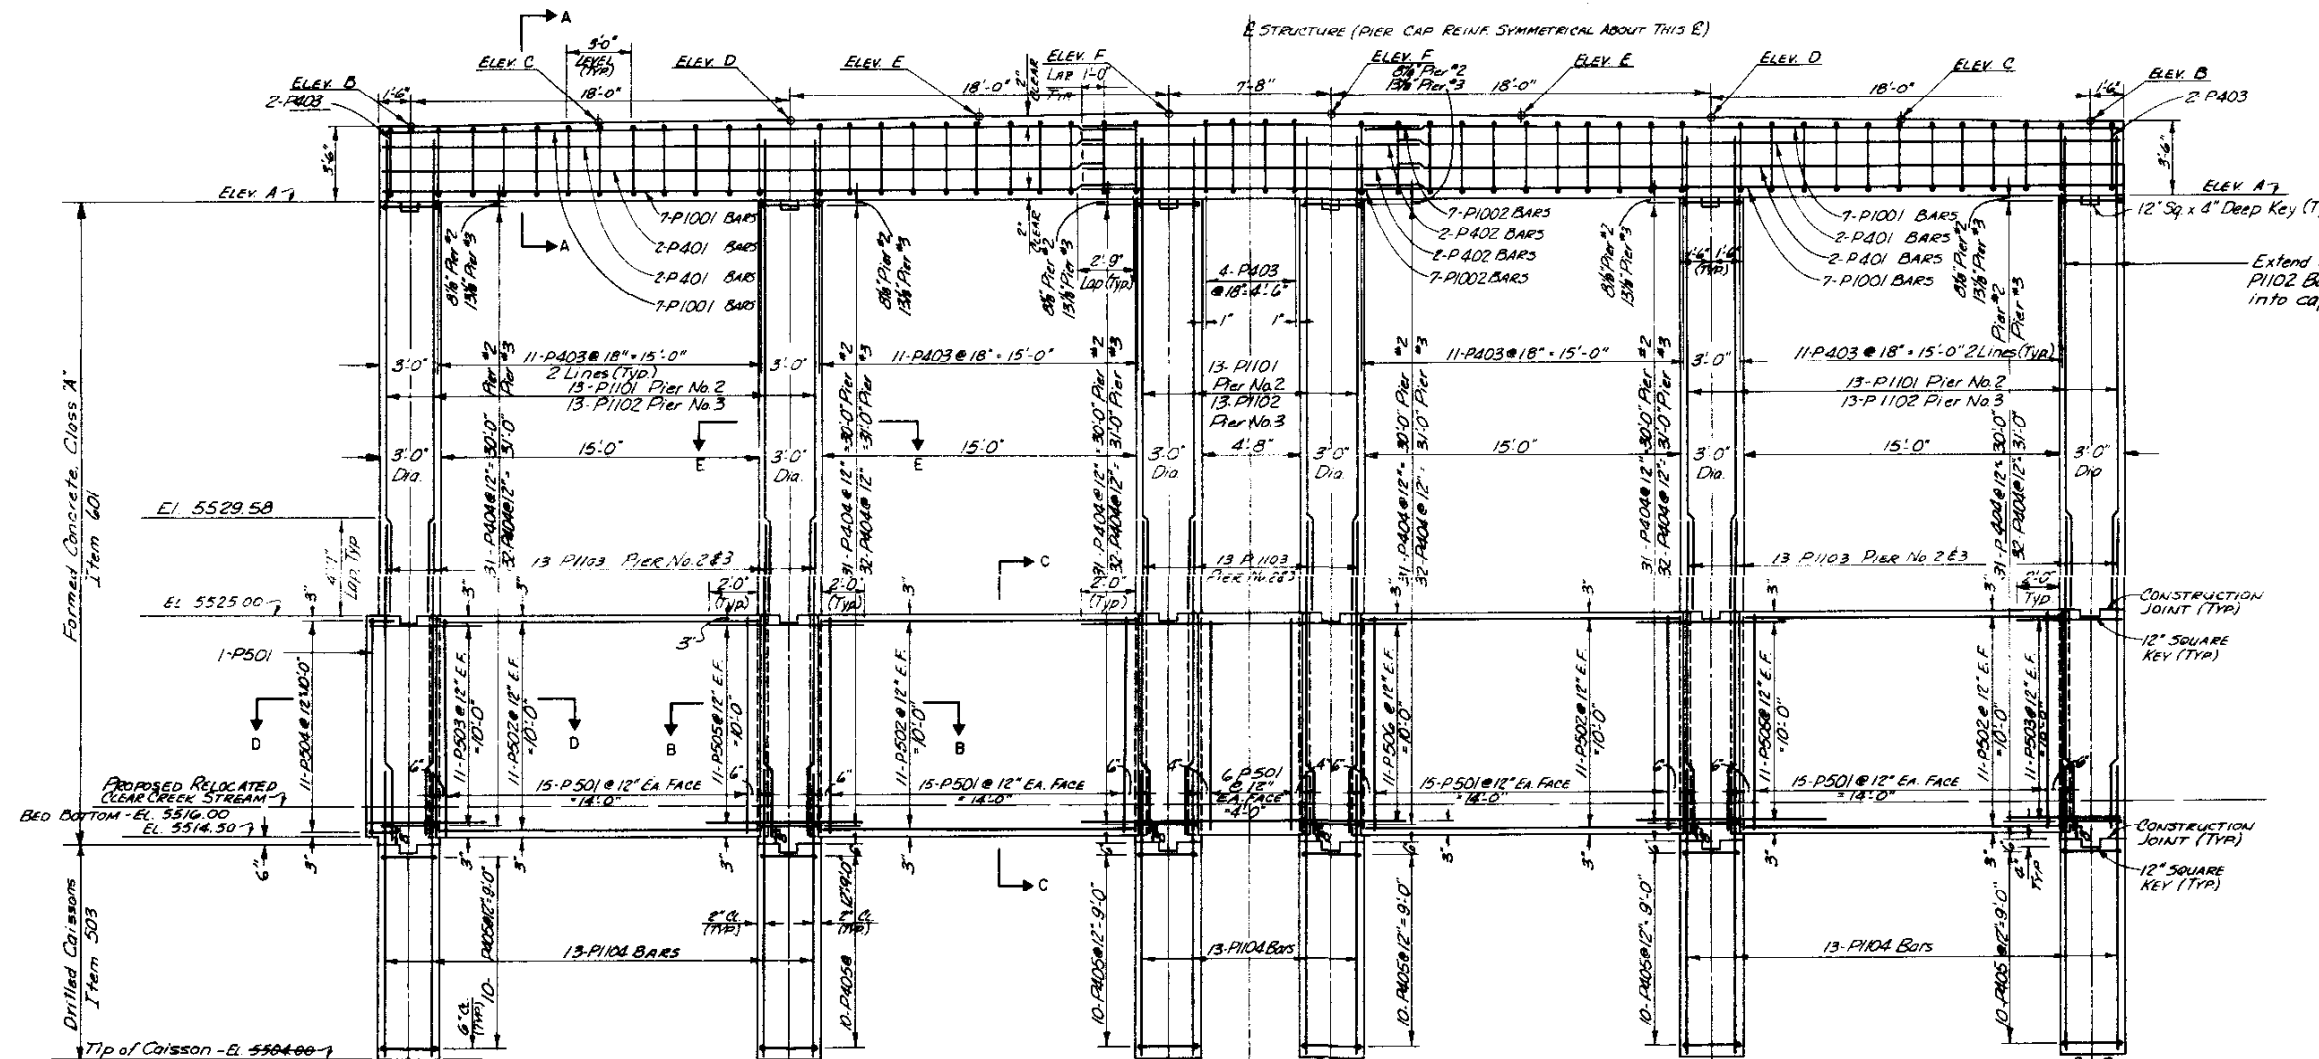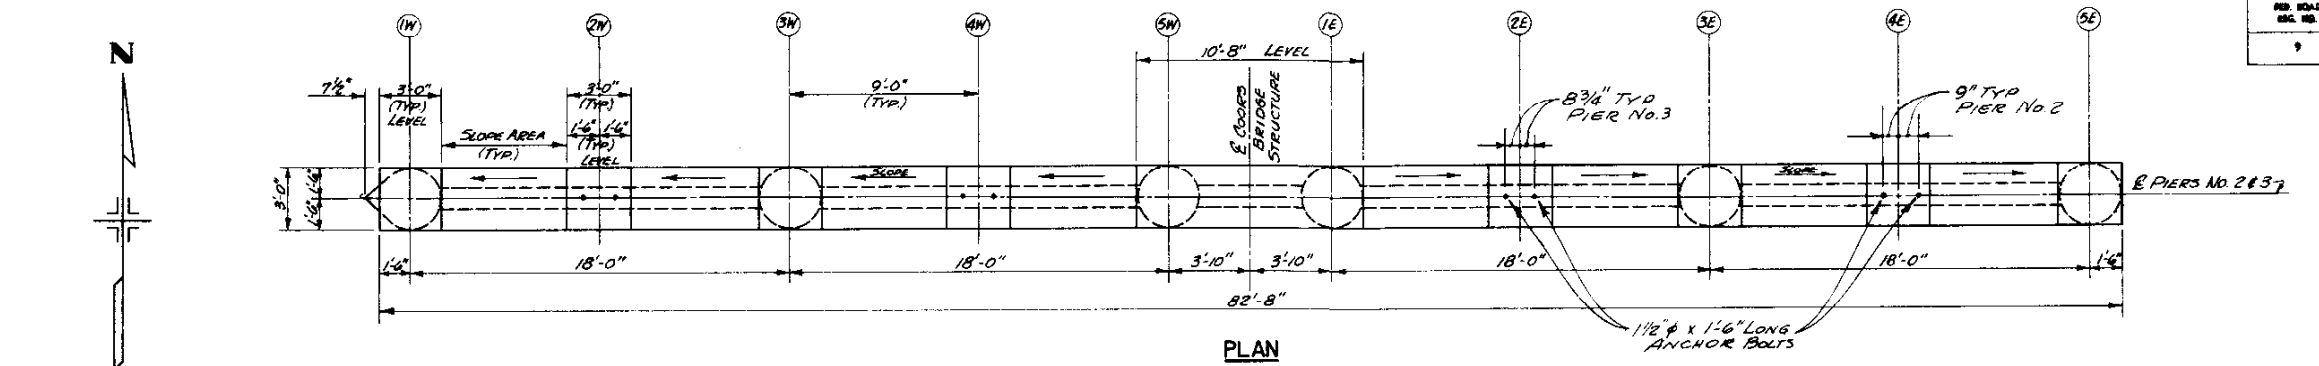

HENNINGSON, DURHAM & RICHARDSON
ENGINEERS - PLANNERS CONSULTANTS
CAPITOL LIFE CENTER
DENVER, COLORADO

DEPARTMENT OF HIGHWAYS
STATE OF COLORADO

PIER NO. 2 & 3
DETAILS

RELOCATED CLEAR CREEK,
COOR'S ACCESS ROAD & RAILROAD

Across

Sta. 9+41.0 MCINTYRE ST


Near GOLDEN Sec. 24 T. 35 R. 70W

Designed by R.E.R.
Made by D.S.
Checked by W.A.S.


Approved by
Date: 19

REVISIONS



FED. ROAD REGION NO.	DIVISION	PROJECT NO.	SHEET NO.	TOTAL SHEETS
9	COLO.	F 058-1(2)	29	

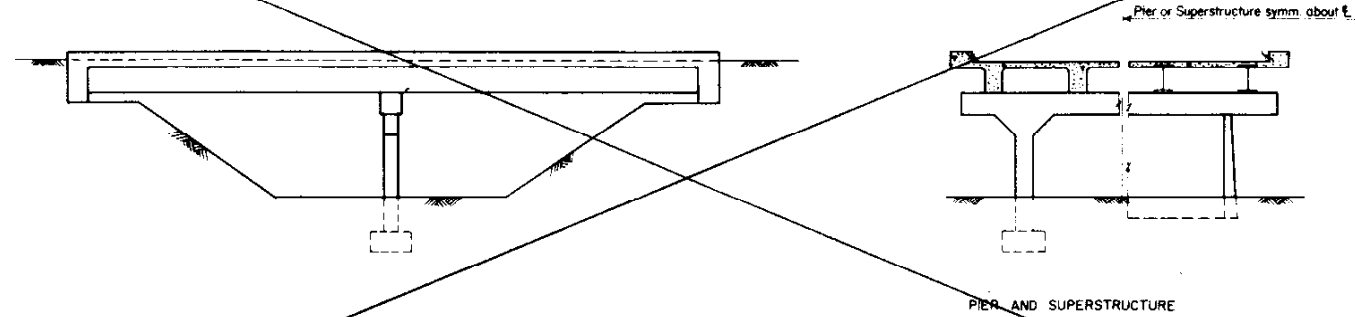

RURAL STREAM CROSSING


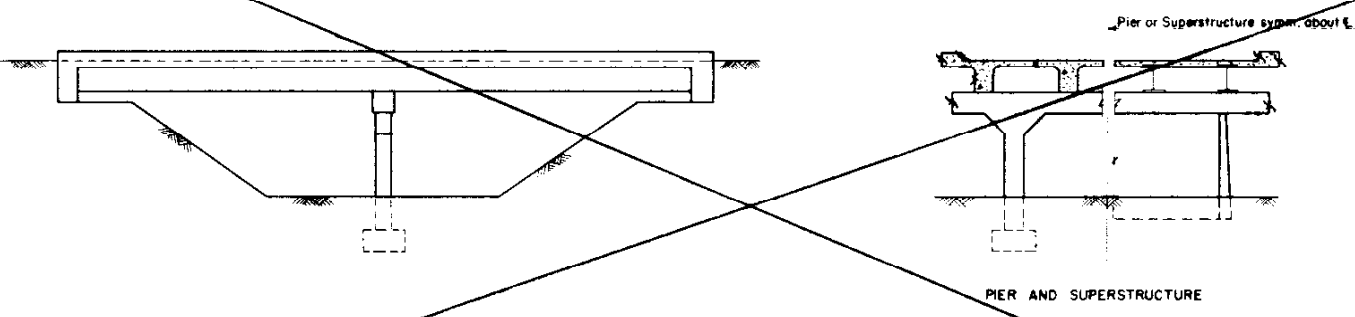


STREAM CROSSING IN OR NEAR URBAN AREA

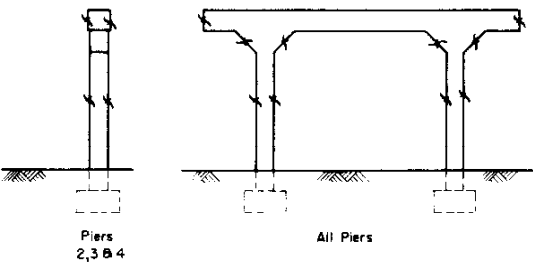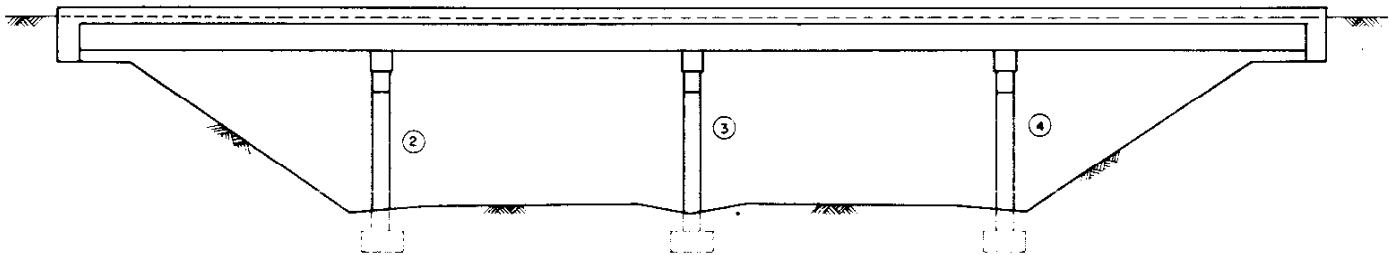


In case of round columns the whole column shall receive Class 2 finish on all Piers


UNDERPASS

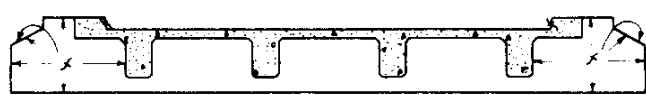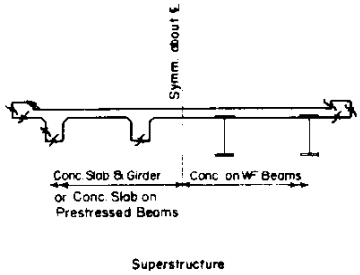

STUB ABUTMENTS
(Underpass Only)

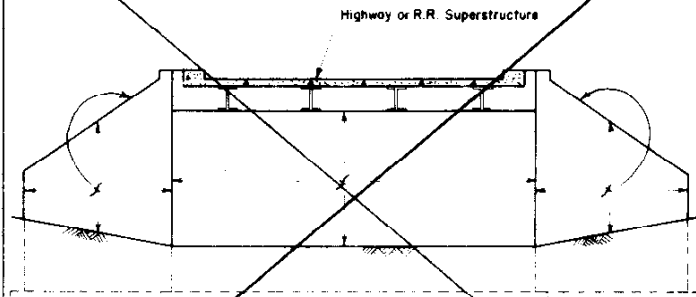

CANTILEVER ABUTMENTS
(Underpass Only)

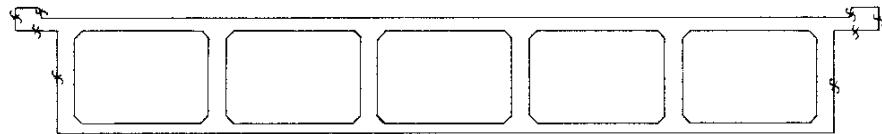

SUPERSTRUCTURE - BOX GIRDER



UNDER MCINTYRE ST BRIDGE STRUCTURE NO. *Coors Str. &* E-16-HQ

HENNINGSON, DURHAM & RICHARDSON
ENGINEERS - PLANNERS - CONSULTANTS
CAPITOL LIFE CENTER
DENVER, COLORADO

16 (10-20-67)

COLORADO
DEPARTMENT OF HIGHWAYS


DETAILS SHOWING PORTIONS OF
STRUCTURE TO RECEIVE CLASS 2
SURFACE FINISH.
Across CLEAR CREEK ON MCINTYRE ST
and
UNDER MCINTYRE ST.
Sta. 219 + 91.84
Near GOLDEN Sec. 24 T. 3S. R. 70W.
Designed by A.D.N. Approved by R.R.A.-J.B.
Made by W.A.S. Bridge Engineer
Checked by W.A.S. Date: 19

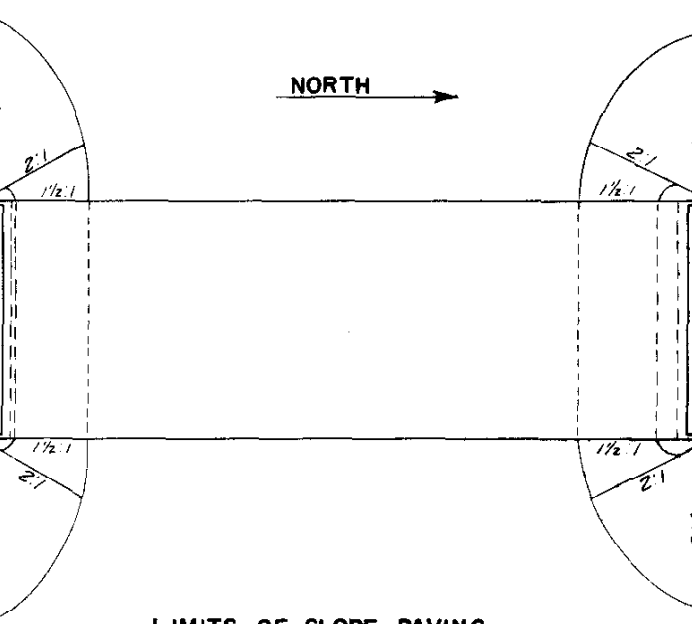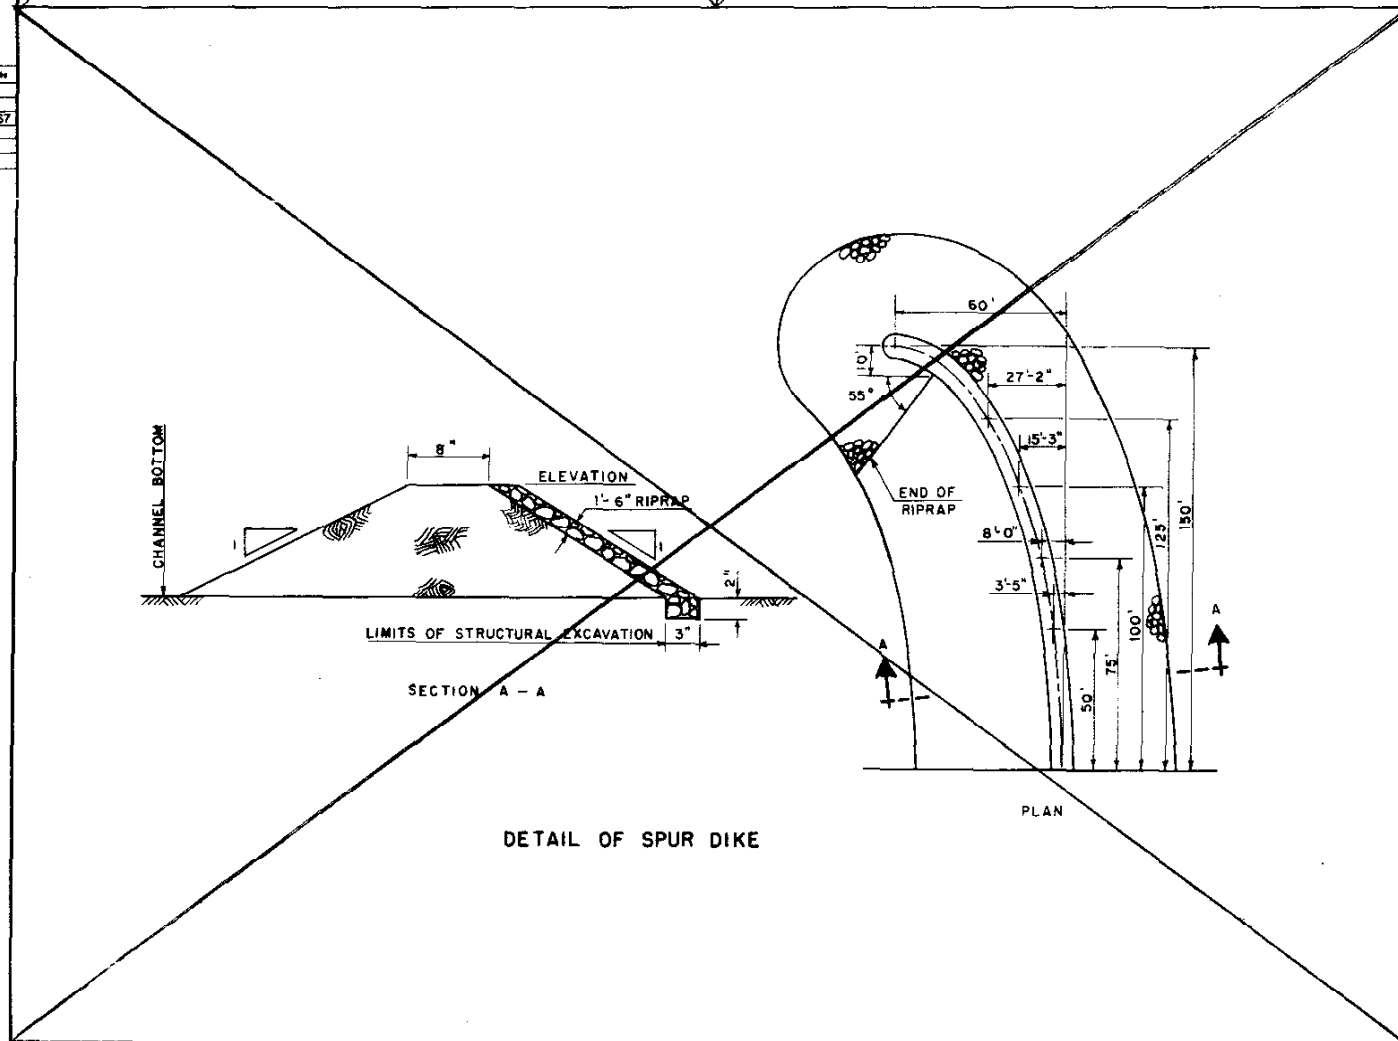

LIMITS OF SLOPE PAVING
SCALE: 1" = 30'

FED. ROAD DIST. NO.	DIVISION	PROJECT NO.	SHEET NO.	TOTAL SHEETS
9	COLO.	F 058-1(2)	30	

NO REVISIONS

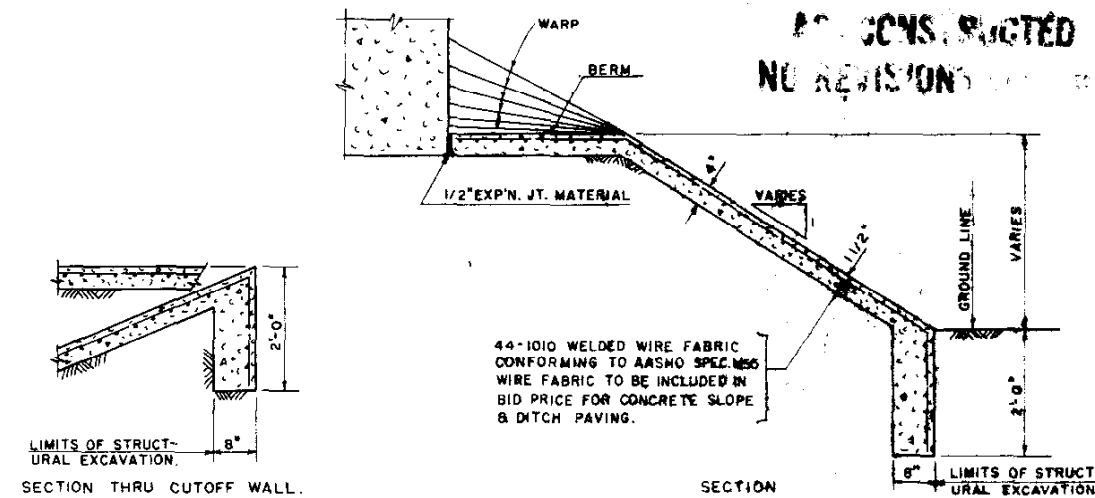

DETAIL OF SLOPE PAVING

NOTES:

WIRE FABRIC SHALL BE 2" FROM THE END OF JOINTS AND SHALL LAP 4" AT SPLICES.

SLOPE PAVING SHALL BE POURED IN 10 FT. TRANSVERSE SECTIONS WITH A TOOLED CONSTRUCTION JOINT AT EACH SECTION.

WHERE SLOPE OR BERM PAVING BUTTS AGAINST THE ABUTMENT OR WINGS, SEPARATE WITH 1/2" EXP'D. JT. MAT'L. TYPE III.

(INCLUDE IN BID PRICE FOR ITEM 507).

TRANSITION ENDS OF SLOPE PAVING MAY BE MODIFIED BY THE ENGINEER TO FIT CONDITIONS ENCOUNTERED IN THE FIELD.

ALL WORK NECESSARY BY THESE REQUIREMENTS SHALL BE INCLUDED IN THE BID PRICE FOR ITEM NUMBER 507.

CONCRETE SHALL CONFORM TO THE REQUIREMENTS OF SECTION 601. CONCRETE SHALL BE CLASS "D".

17 A (10-20-67)

DEPARTMENT OF HIGHWAYS
STATE OF COLORADO

SLOPE PAVING
DETAILS

RELOCATED CLEAR CREEK
CROSS ACCESS ROAD & RAILROAD
Sta. 9+410 MEETING ST.

Mo. GOLDEN Sec. 24 T. 25 R. 70W


Designed by R.E.R.
Made by D.S.
Checked by A.S.

Approved by
Bridge Engineer
Date: 79

STANDARD M-412-B (JULY 1, 1965)


FEDERAL ROAD REGION NO.	DIVISION	PROJ. NO.	SHEET NO.	TOTAL SHEETS
9	COLORADO	F058-1(2)	31	

REVISIONS		
(R-1)	11-16-65	Curb subtitles
(R-2)	4-6-66	T & F Bars and * Note
(R-3)	12-8-66	Exp. Joint Mat'l. - Detail "K"
(R-4)	1-24-67	Exp. Joint Mat'l. - Ø Note
Continued Below		

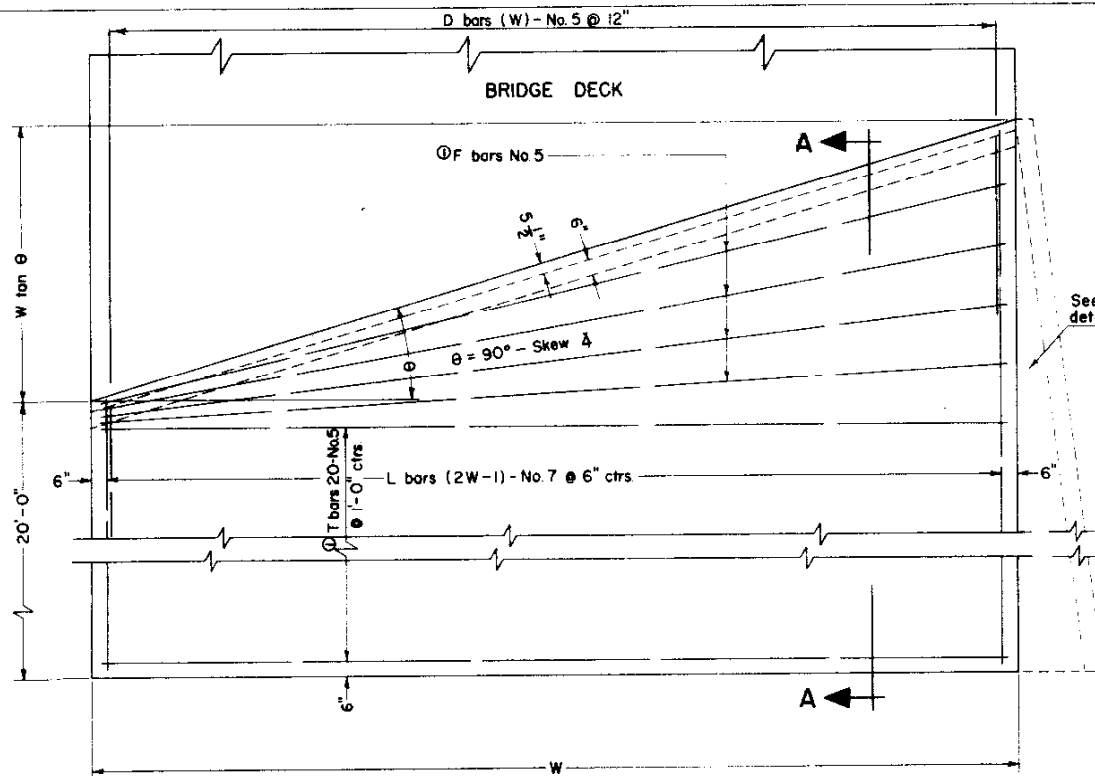

① Note: One T or F bar to be placed near top of slab at each end of D bars.


APPROACH SLAB - PLAN

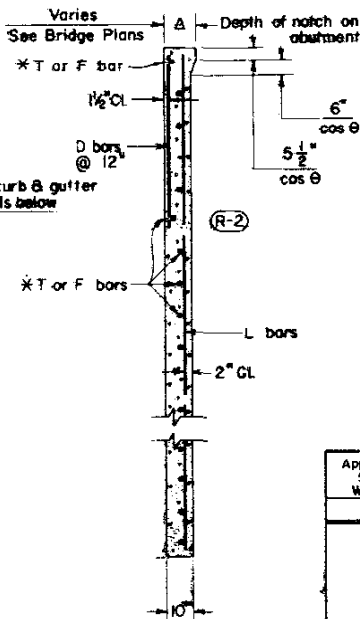


SECTION A-A

* Includes 2 T or F bars placed at top of slab as shown.

SAFETY CURB BRUSH CURB

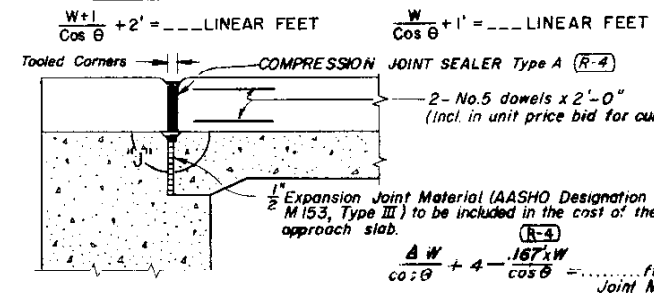

DETAIL AT BRIDGE ABUTMENT

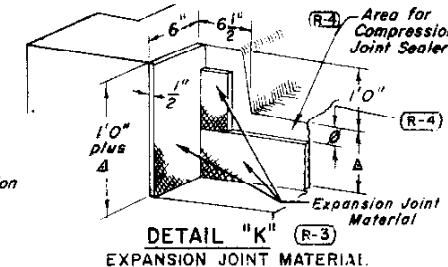


DETAIL "K" EXPANSION JOINT MATERIAL.


Bar List and Quantities required for one Approach Slab

Approach Slab Width	T = No. 5, Str.		D = No. 5, Str.		L = No. 7, Str.		F = No. 5, Str.		Reinforcing Steel (Lbs.)			Additional Steel for Skew (Lbs.)		Concrete Pavement (Sq. Yds.)
	W	Length	No.	Length	No.	Length	* No.	Length	T Bar	D Bar	L Bar	F Bar	L Bar	
20	20	19'-6"	20	5'-0"	39		10 tan θ	19'-6"	411	105	1570	205 tan θ	765 tan θ	44.4 + 22.2 tan θ
22	22	21'-6"	22		43		11 tan θ	21'-6"	452	116	1731	249 tan θ	932 tan θ	48.9 + 26.9 tan θ
24	24	23'-6"	24		47		12 tan θ	23'-6"	494	126	1892	297 tan θ	1116 tan θ	53.3 + 32.0 tan θ
26	26	25'-6"	26		51		13 tan θ	25'-6"	537	137	2053	349 tan θ	1316 tan θ	57.8 + 37.6 tan θ
28	28	27'-6"	28		55		14 tan θ	27'-6"	580	147	2214	406 tan θ	1533 tan θ	62.2 + 43.6 tan θ
30	30	29'-6"	30		59		15 tan θ	29'-6"	621	158	2375	466 tan θ	1766 tan θ	66.7 + 50.0 tan θ
32	32	31'-6"	32		63		16 tan θ	31'-6"	663	169	2536	531 tan θ	2016 tan θ	71.1 + 56.9 tan θ
34	34	33'-6"	34		67		17 tan θ	33'-6"	706	179	2697	600 tan θ	2282 tan θ	75.6 + 64.2 tan θ
36	36	35'-6"	36		71		18 tan θ	35'-6"	748	190	2858	673 tan θ	2565 tan θ	80.0 + 72.0 tan θ
38	38	37'-6"	38		75		19 tan θ	37'-6"	790	200	3019	751 tan θ	2864 tan θ	84.4 + 80.2 tan θ
40	40	39'-6"	40		79		20 tan θ	39'-6"	832	211	3180	832 tan θ	3180 tan θ	88.9 + 88.9 tan θ
42	42	41'-6"	42		83		21 tan θ	41'-6"	874	221	3341	918 tan θ	3513 tan θ	93.3 + 98.0 tan θ
44	44	43'-6"	44		87		22 tan θ	43'-6"	916	232	3502	1008 tan θ	3862 tan θ	97.8 + 107.6 tan θ
46	46	45'-6"	46		91		23 tan θ	45'-6"	958	242	3663	1102 tan θ	4227 tan θ	102.2 + 117.6 tan θ
48	48	47'-6"	48		95		24 tan θ	47'-6"	1001	253	3824	1201 tan θ	4609 tan θ	106.7 + 128.0 tan θ
50	50	49'-6"	50		99		25 tan θ	49'-6"	1043	263	3985	1304 tan θ	5007 tan θ	111.1 + 138.9 tan θ
52	52	51'-6"	52		103		26 tan θ	51'-6"	1084	274	4146	1411 tan θ	5422 tan θ	115.6 + 150.2 tan θ
54	54	53'-6"	54		107		27 tan θ	53'-6"	1127	284	4307	1522 tan θ	5854 tan θ	120.0 + 162.0 tan θ


(R-4) Lengths shown include 1 percent for overrun.

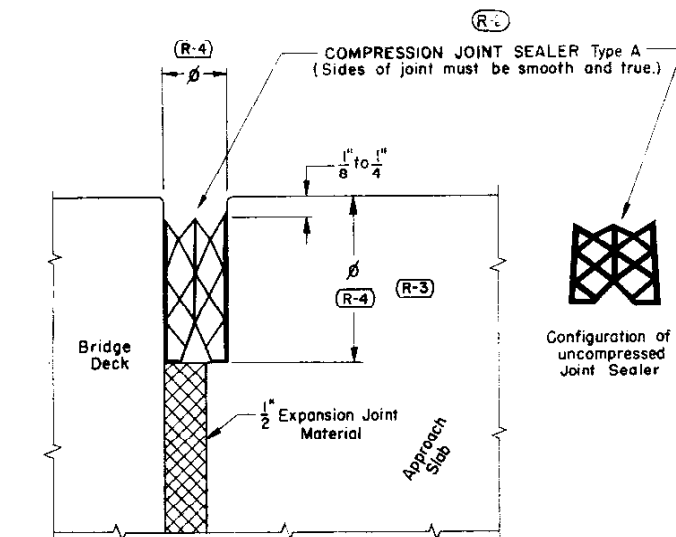


DETAIL "J"

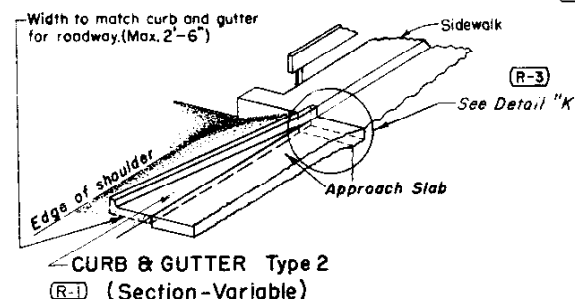


PROFILE

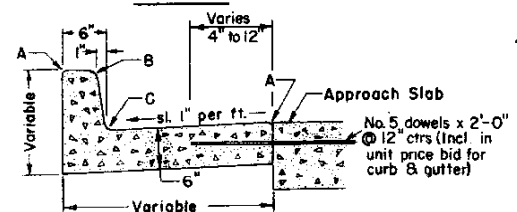


SECTION A-A

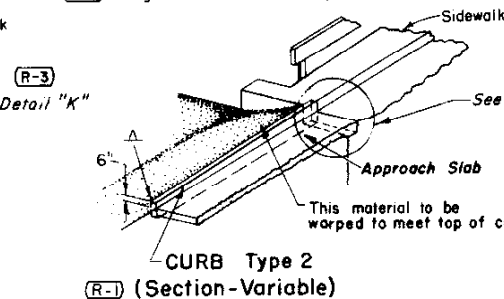

PROFILE

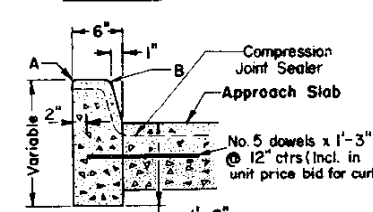

SECTION B-B

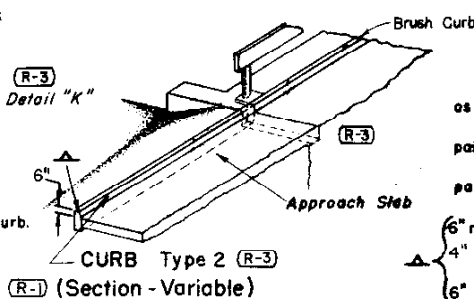

PROFILE

(R-5)
(R-6)

GENERAL NOTES

- Concrete for Approach slabs shall be Class "P" (R-1)
- Approach slab shall be paid for under Section 412 as "Concrete Pavement" of the specified thickness.
- Reinforcing Steel required in Approach Slab will be paid for under Section 602.
- Class "A" concrete aggregate may be used in the pavement.
- 6" min. curb height when no curb is used on abutting roadway. (R-1)
- 4" where Bituminous Curbing is used. (Shape bituminous curb to meet concrete curb.)
- 6" To meet concrete Curb or Curb and Gutter. (R-1)
- Use 1/2 R. when no bituminous or concrete curb is to be met. No radius required when meeting bituminous or concrete curb.

LEGEND FOR RADII	
A	= 1/8"
B	= 1"
C	= 1 1/2"


REVISIONS		
5-7-68	Delete Detail	M.R.H.
7-23-68	Depl. Name	M.R.H.


DEPARTMENT OF HIGHWAYS
STATE OF COLORADO
DIVISION OF HIGHWAYS

CONCRETE PAVEMENT
BRIDGE APPROACH
SLAB


Designed by U.S.D. Approved by *[Signature]*
Made by R.F. Bridge Engineer
Checked by R.C. Date: July 1, 1965

(R-1) Rev. Curve Data 12-29-70 W.E.M.

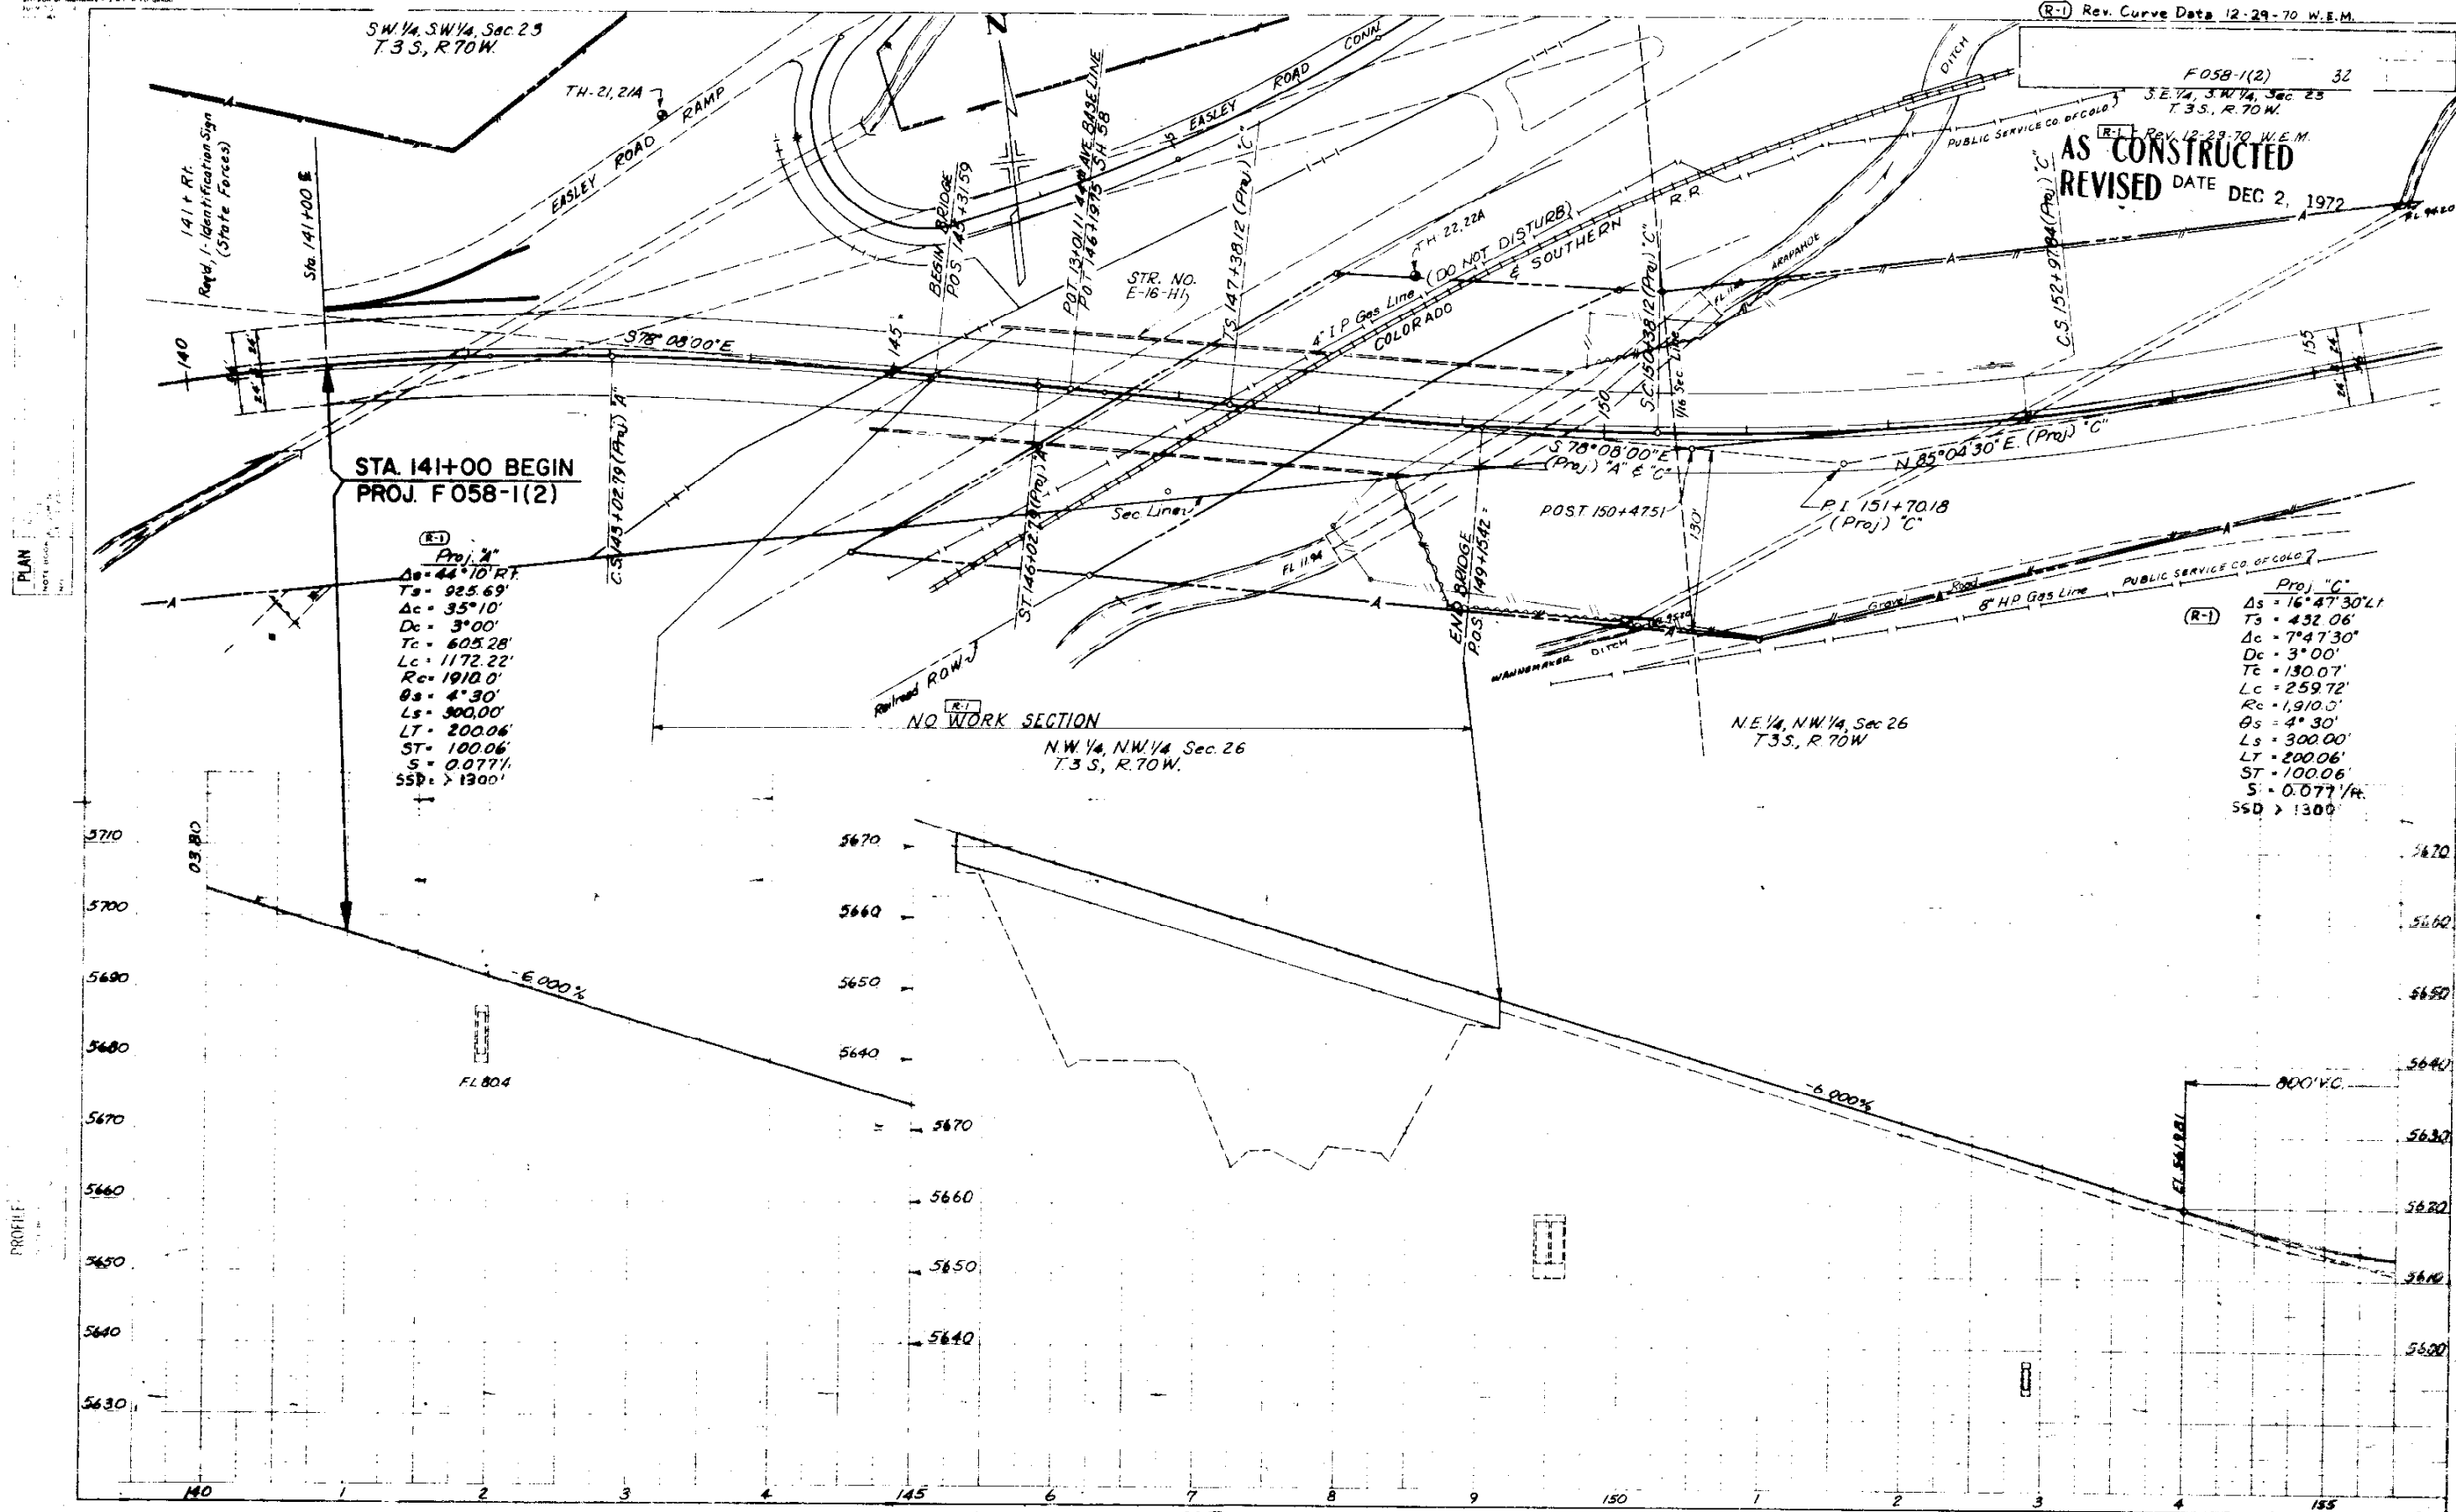


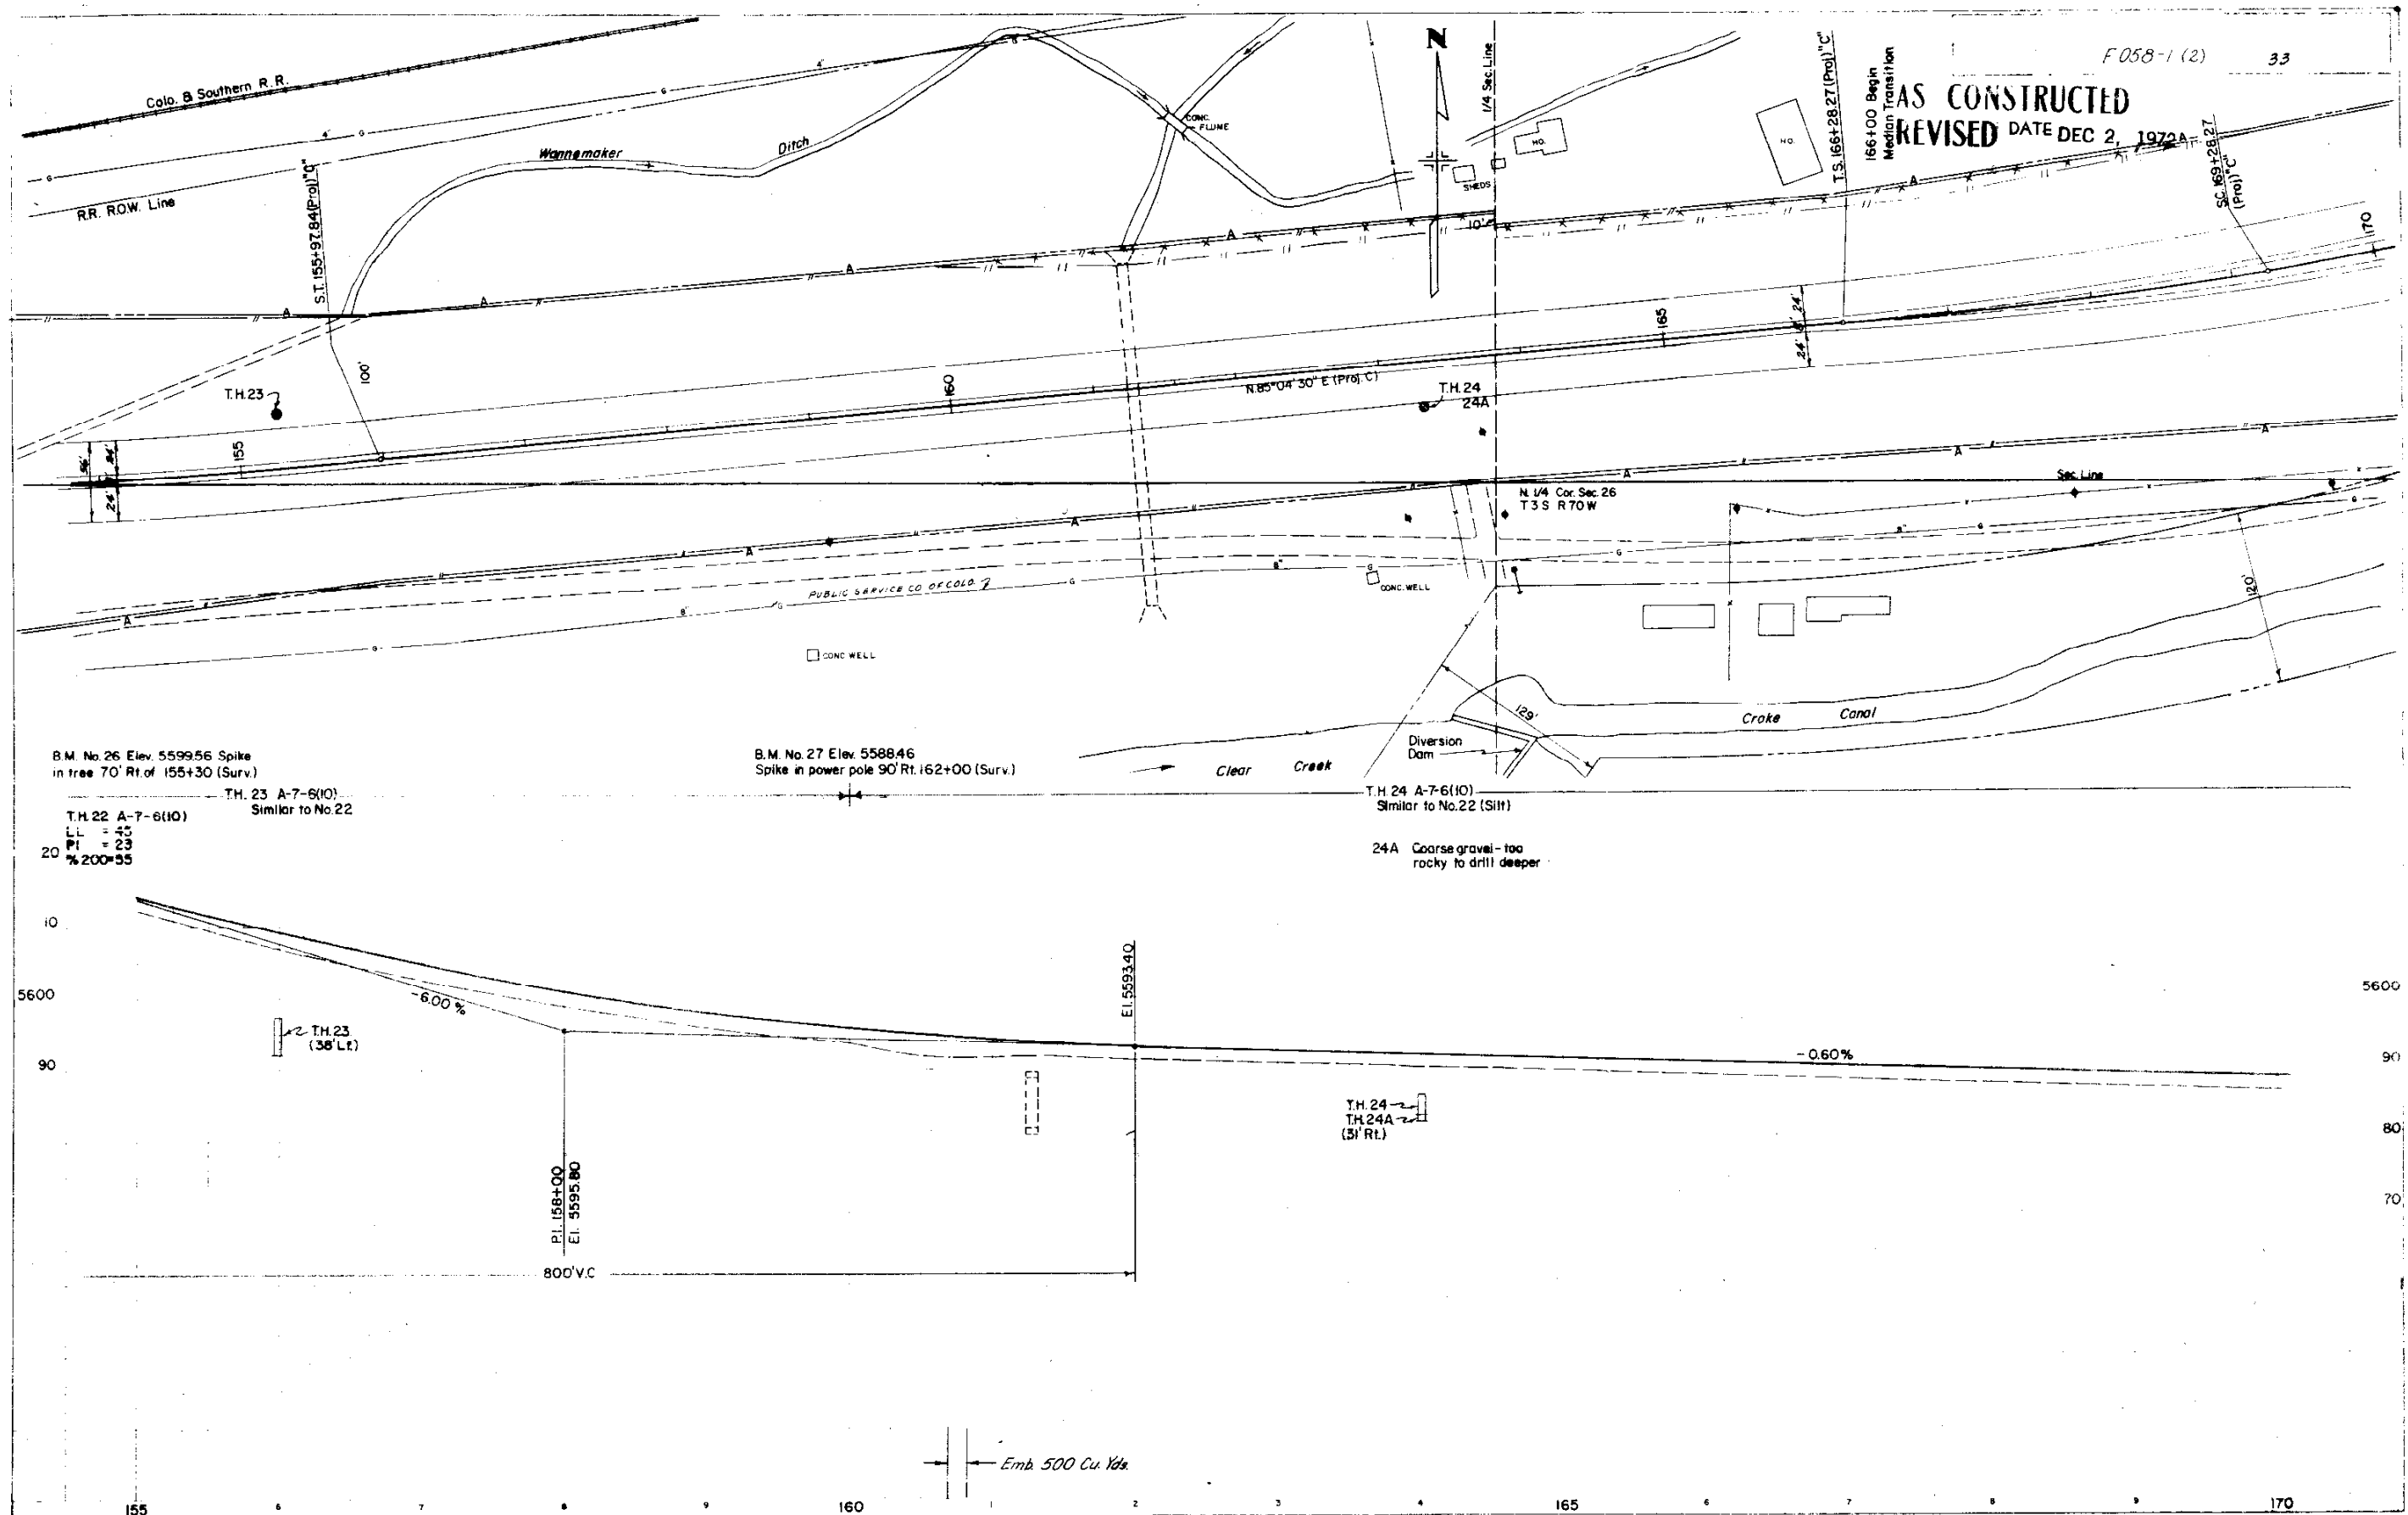

AS CONSTRUCTED
REVISED DATE DEC 2, 1972

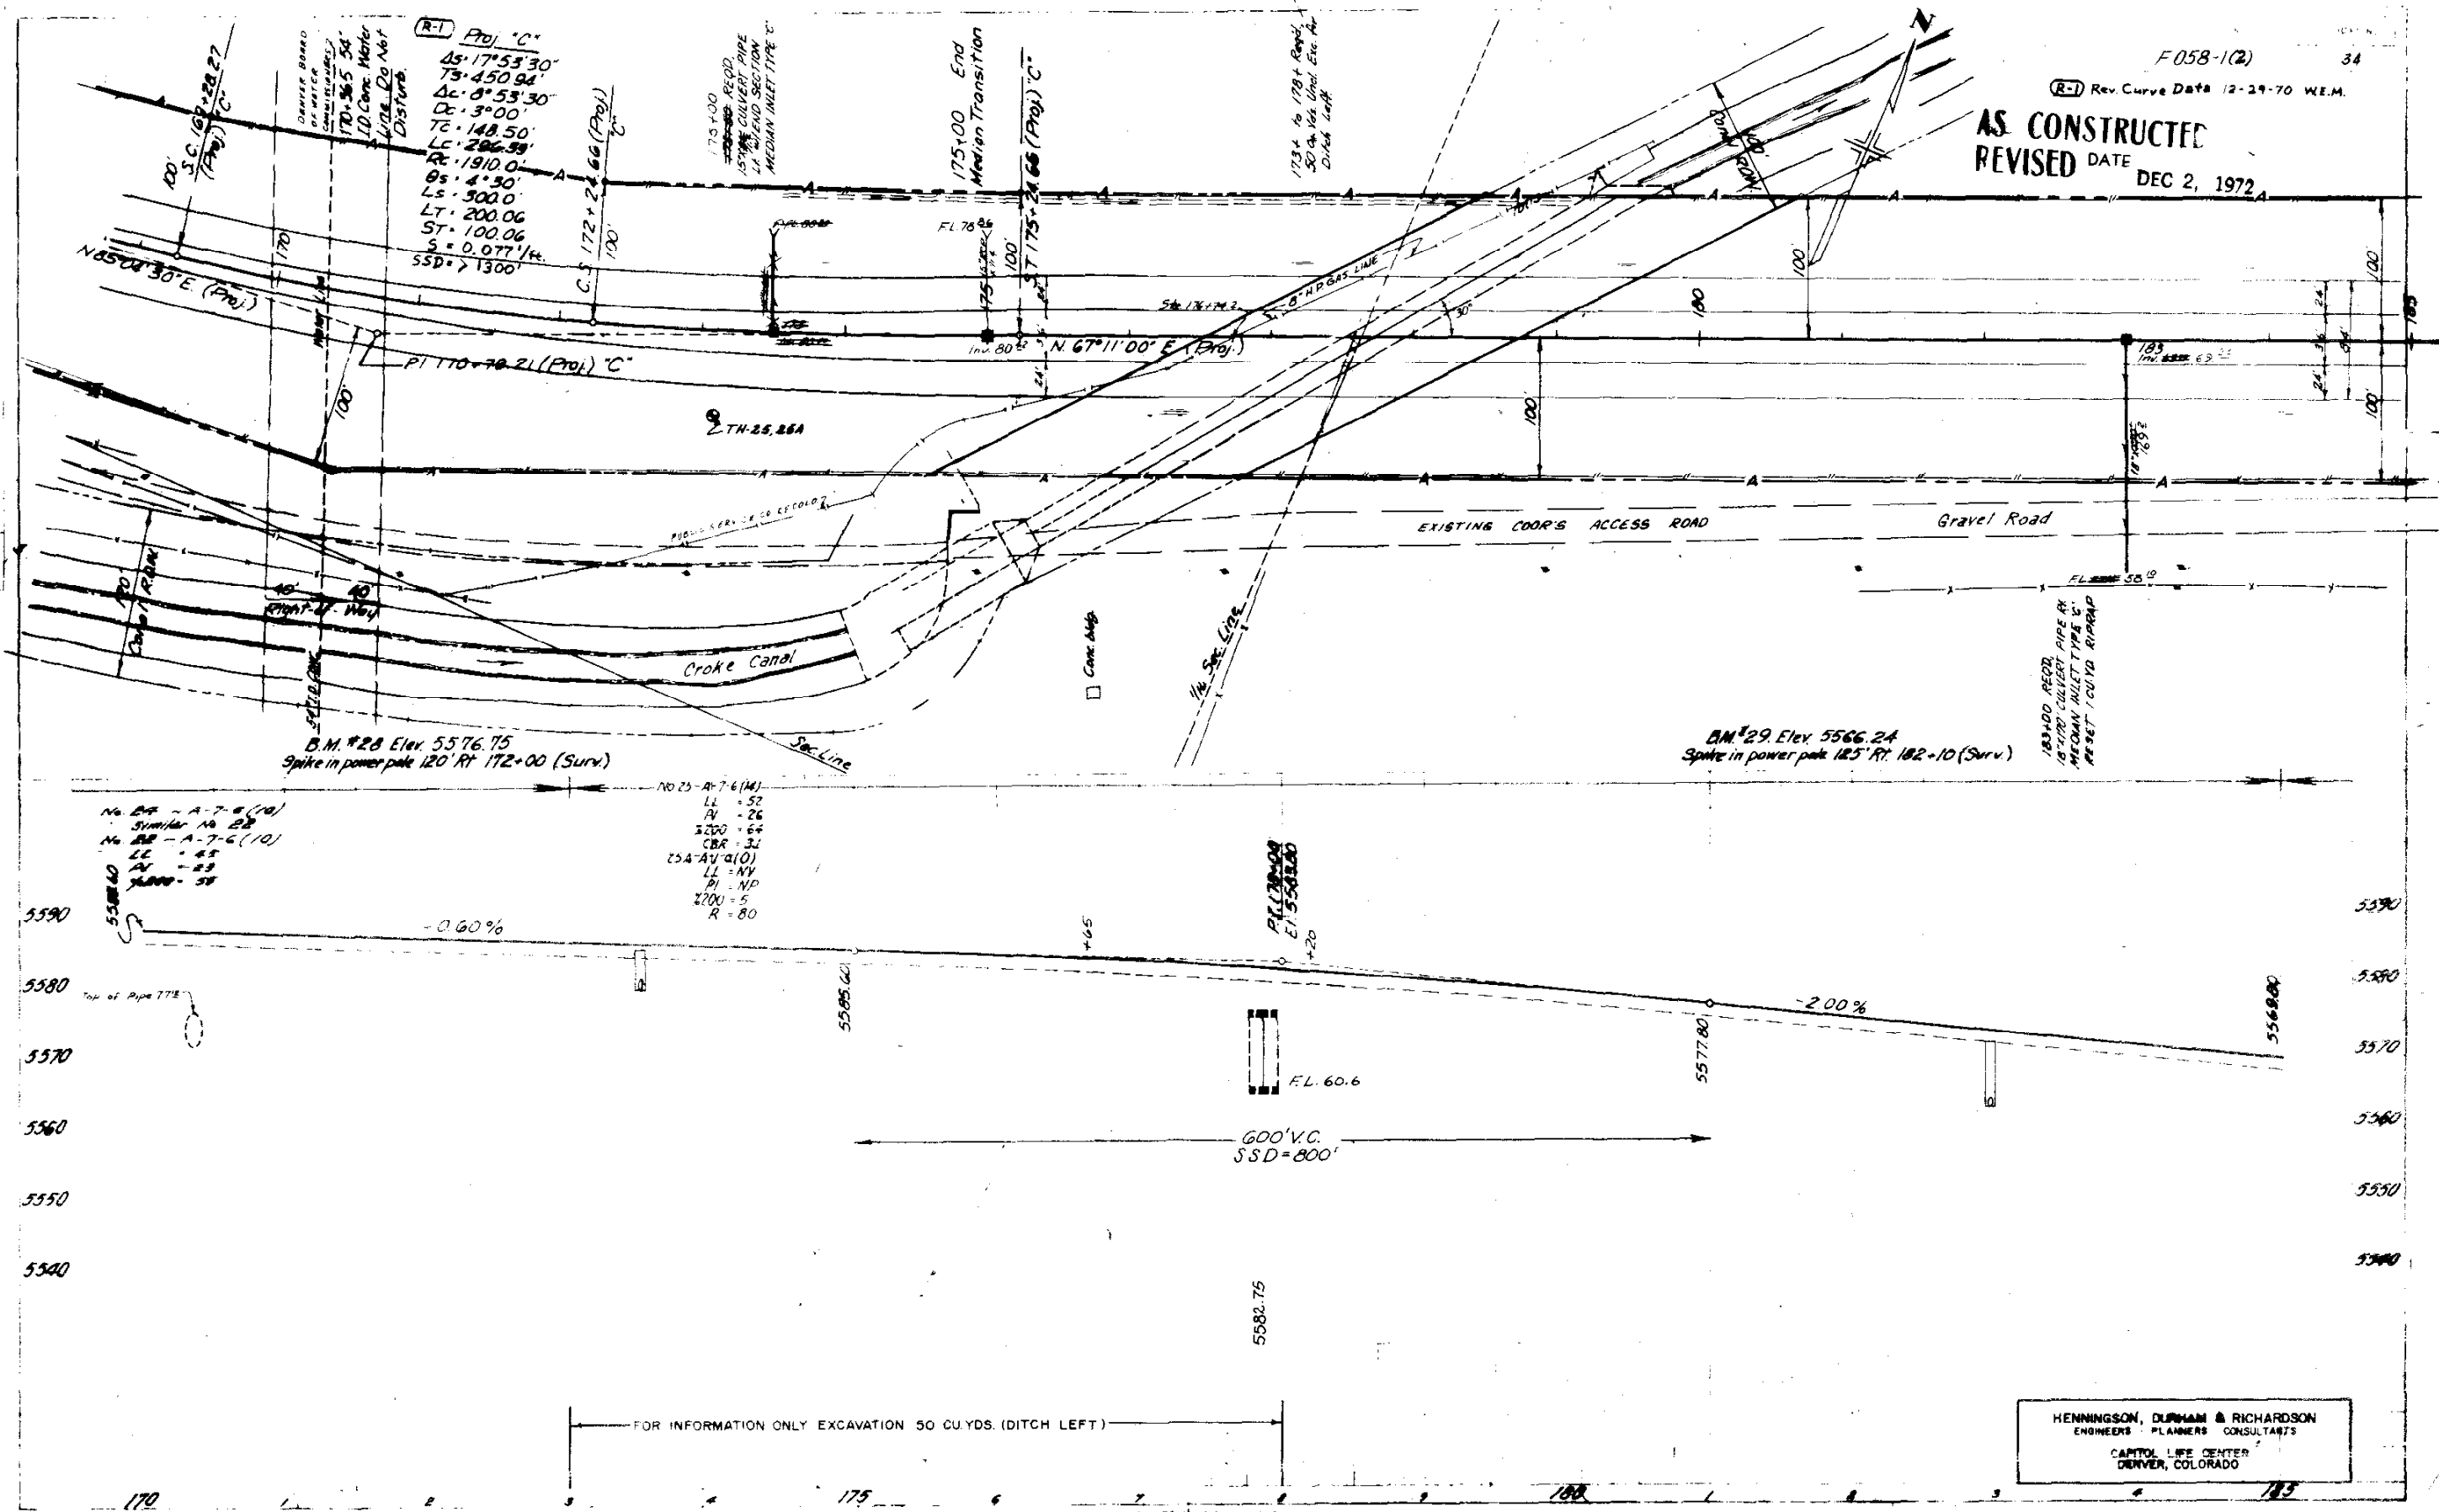

HENNINGSON, DURHAM & RICHARDSON
ENGINEERS · PLANNERS · CONSULTANTS
CAPITOL LIFE CENTER
DENVER, COLORADO

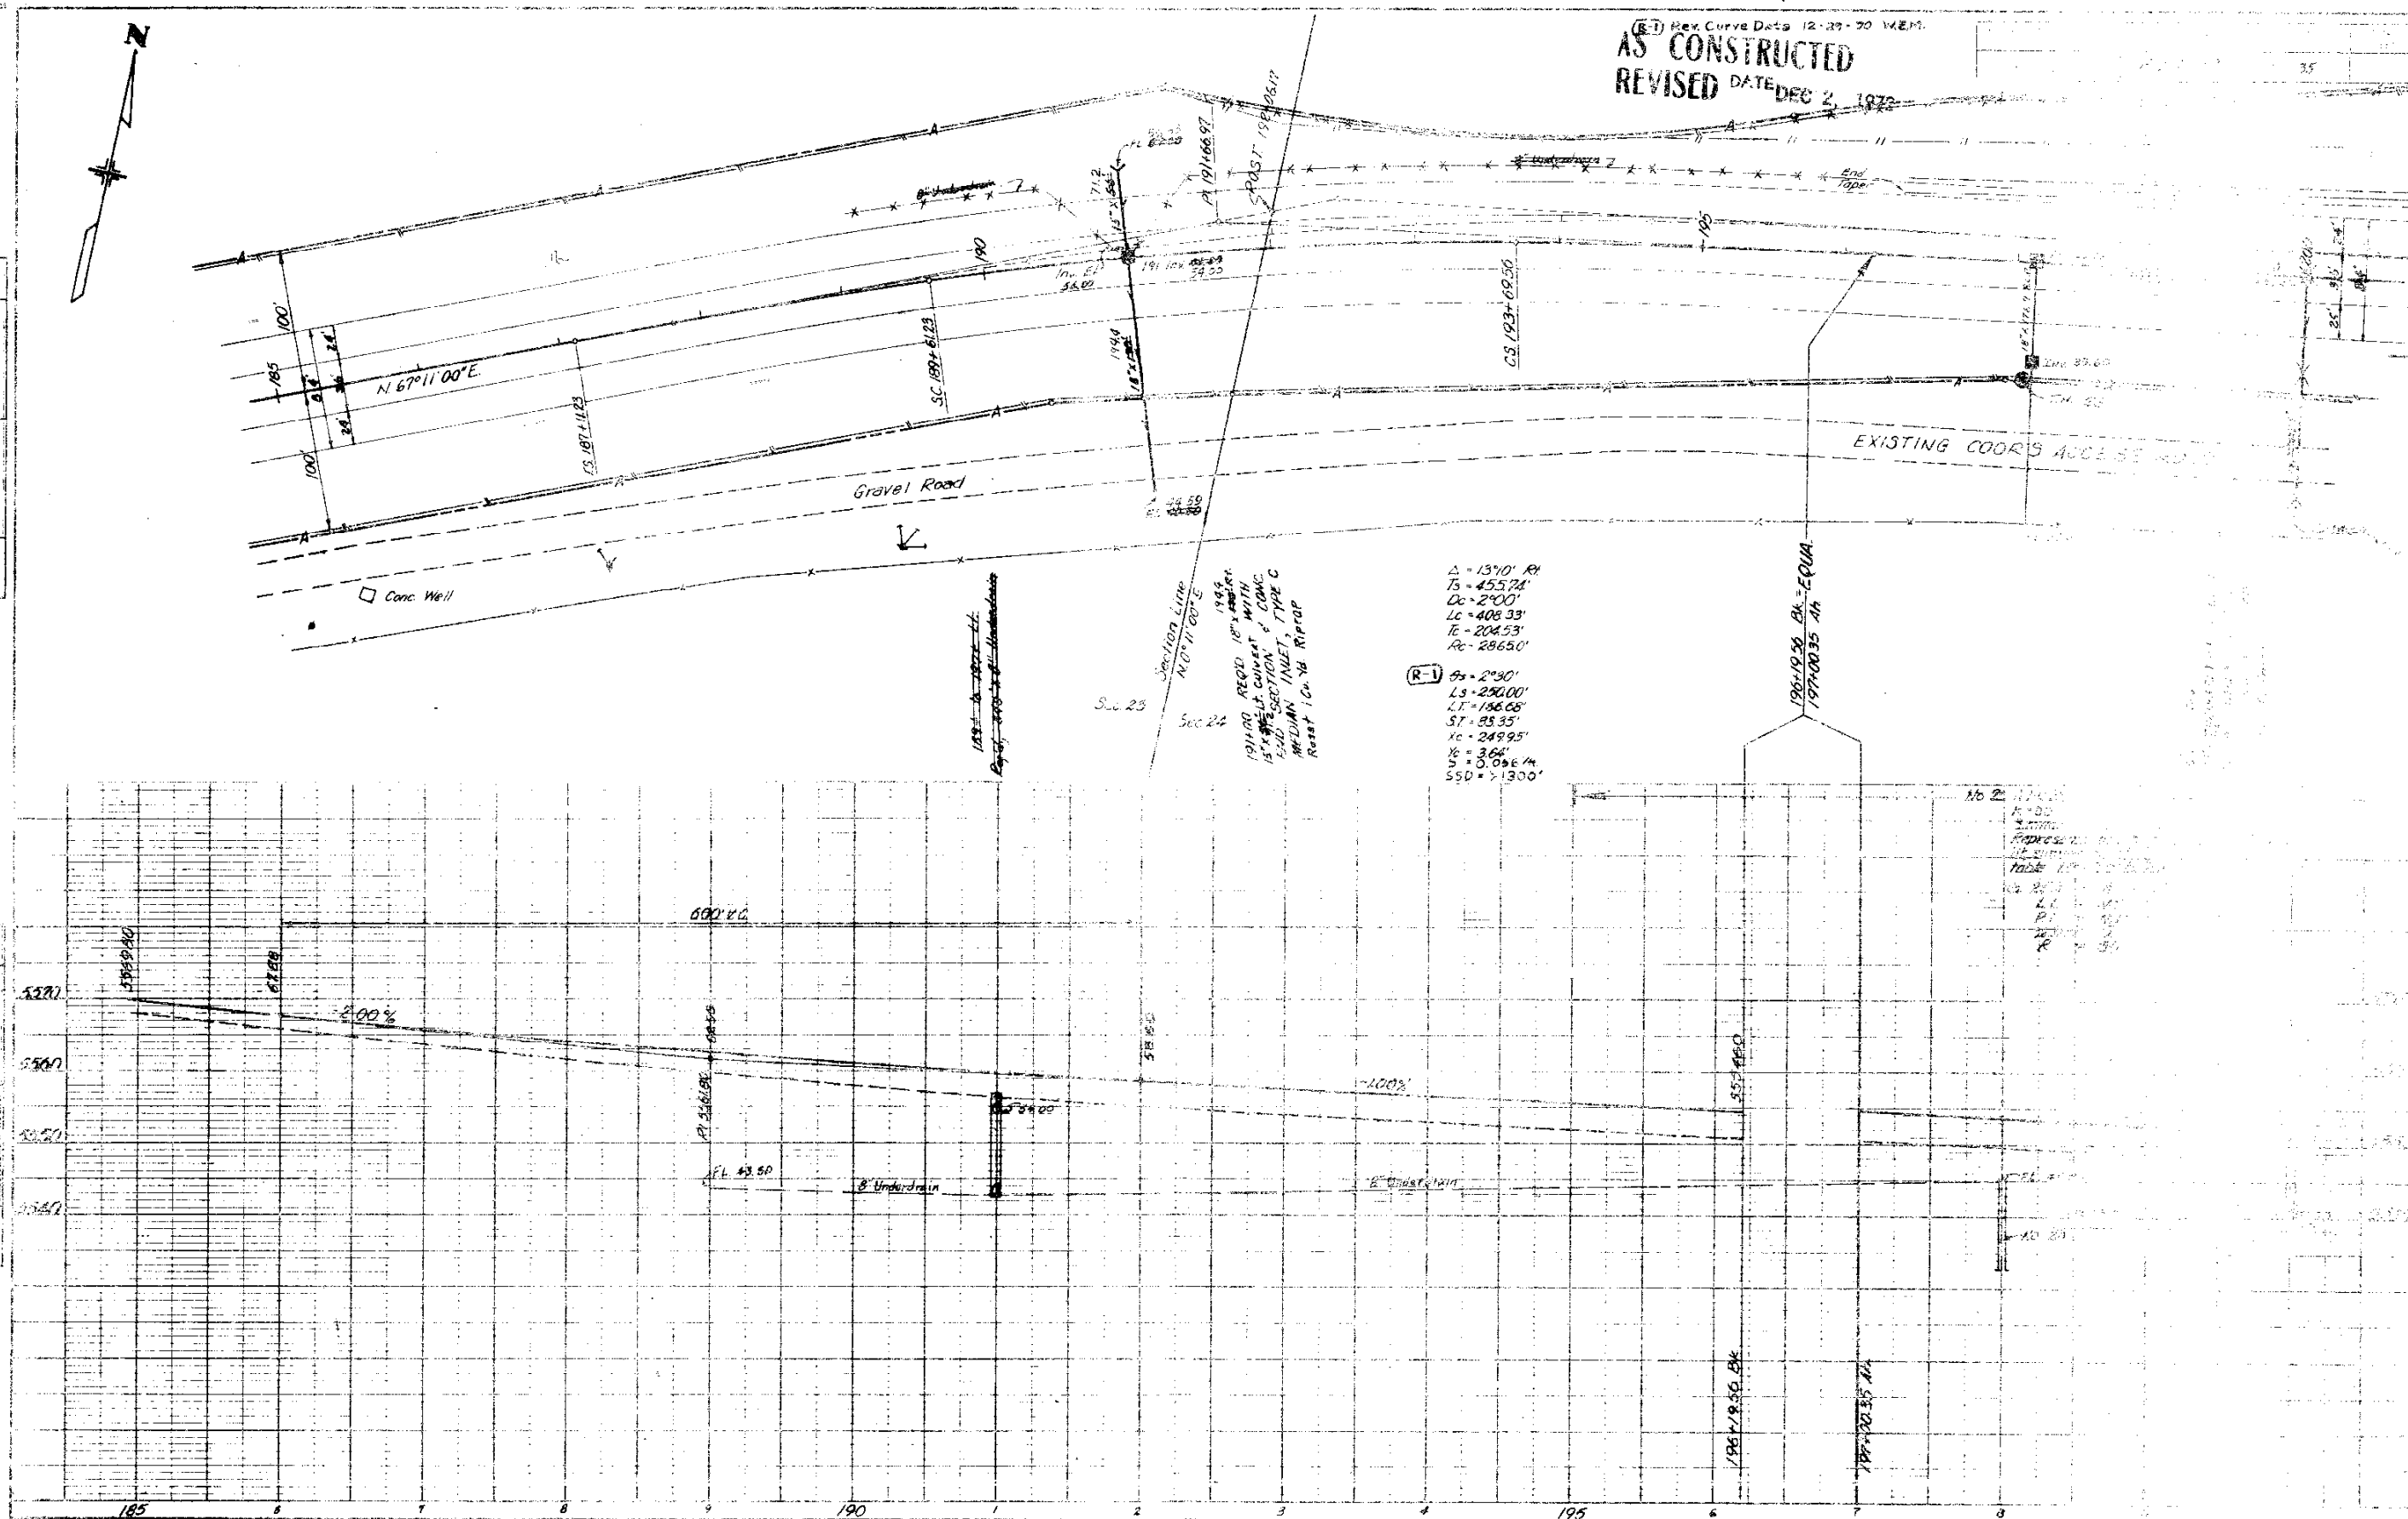

SW 1/4 Sec 24
T.3S, R.70W.

PROJECT NO.	SECTION	DATE
F058-1(2)	36	

(R-1) Rev Str Note 12-25-70 M.E.M.

SW RAMP
 $\Delta = 12^{\circ}03'15''$ RT
 $D = 2^{\circ}56'25''$
 $T = 205.76'$
 $L = 409.98'$
 $R = 1948.85'$


NW RAMP
 $\Delta = 4^{\circ}07'52''$ RT
 $D = 0^{\circ}49'35''$
 $T = 250.00'$
 $L = 499.84'$
 $R = 6952.89'$

AS CONSTRUCTED
REVISED DATE


DEC 2, 1976




PLAN
COURTESY
NOTES
BY
DATE

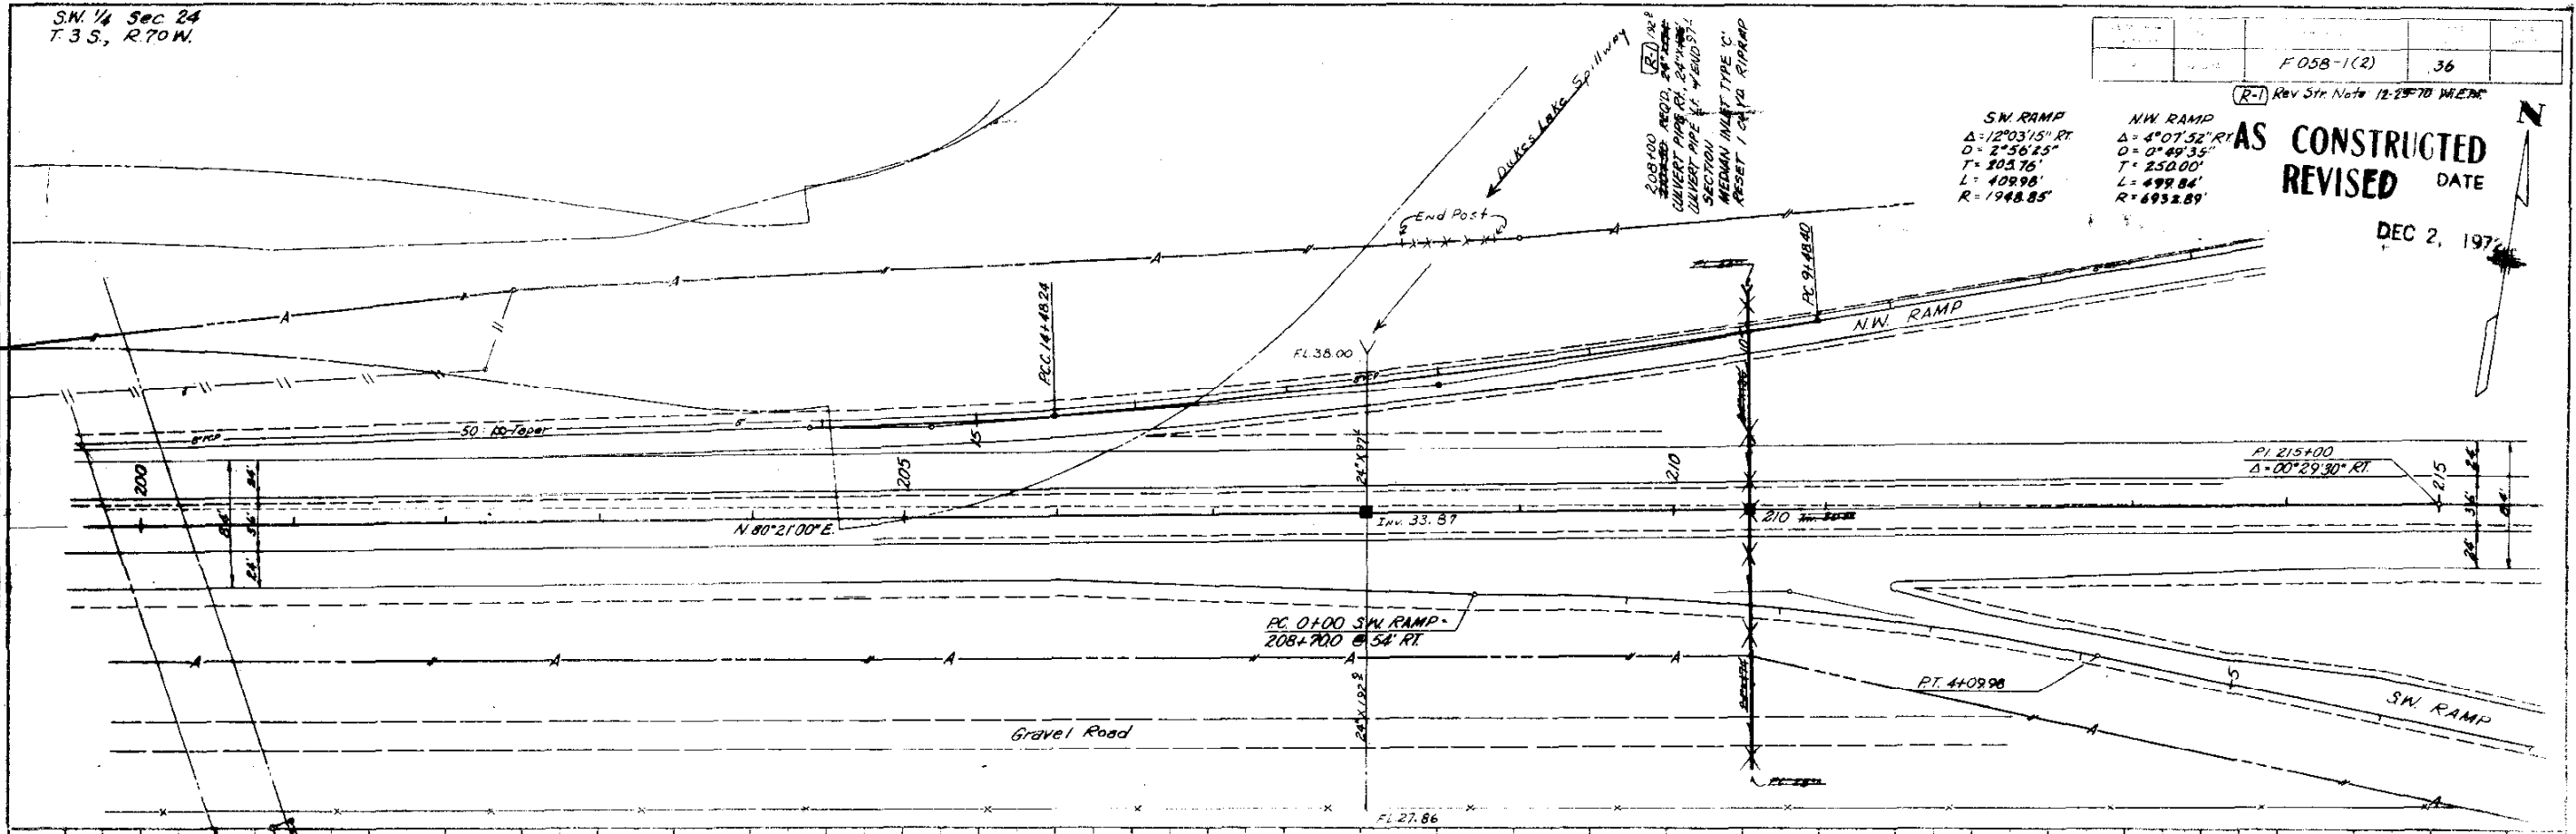

PROFILE
COURTESY
NOTES
BY
DATE

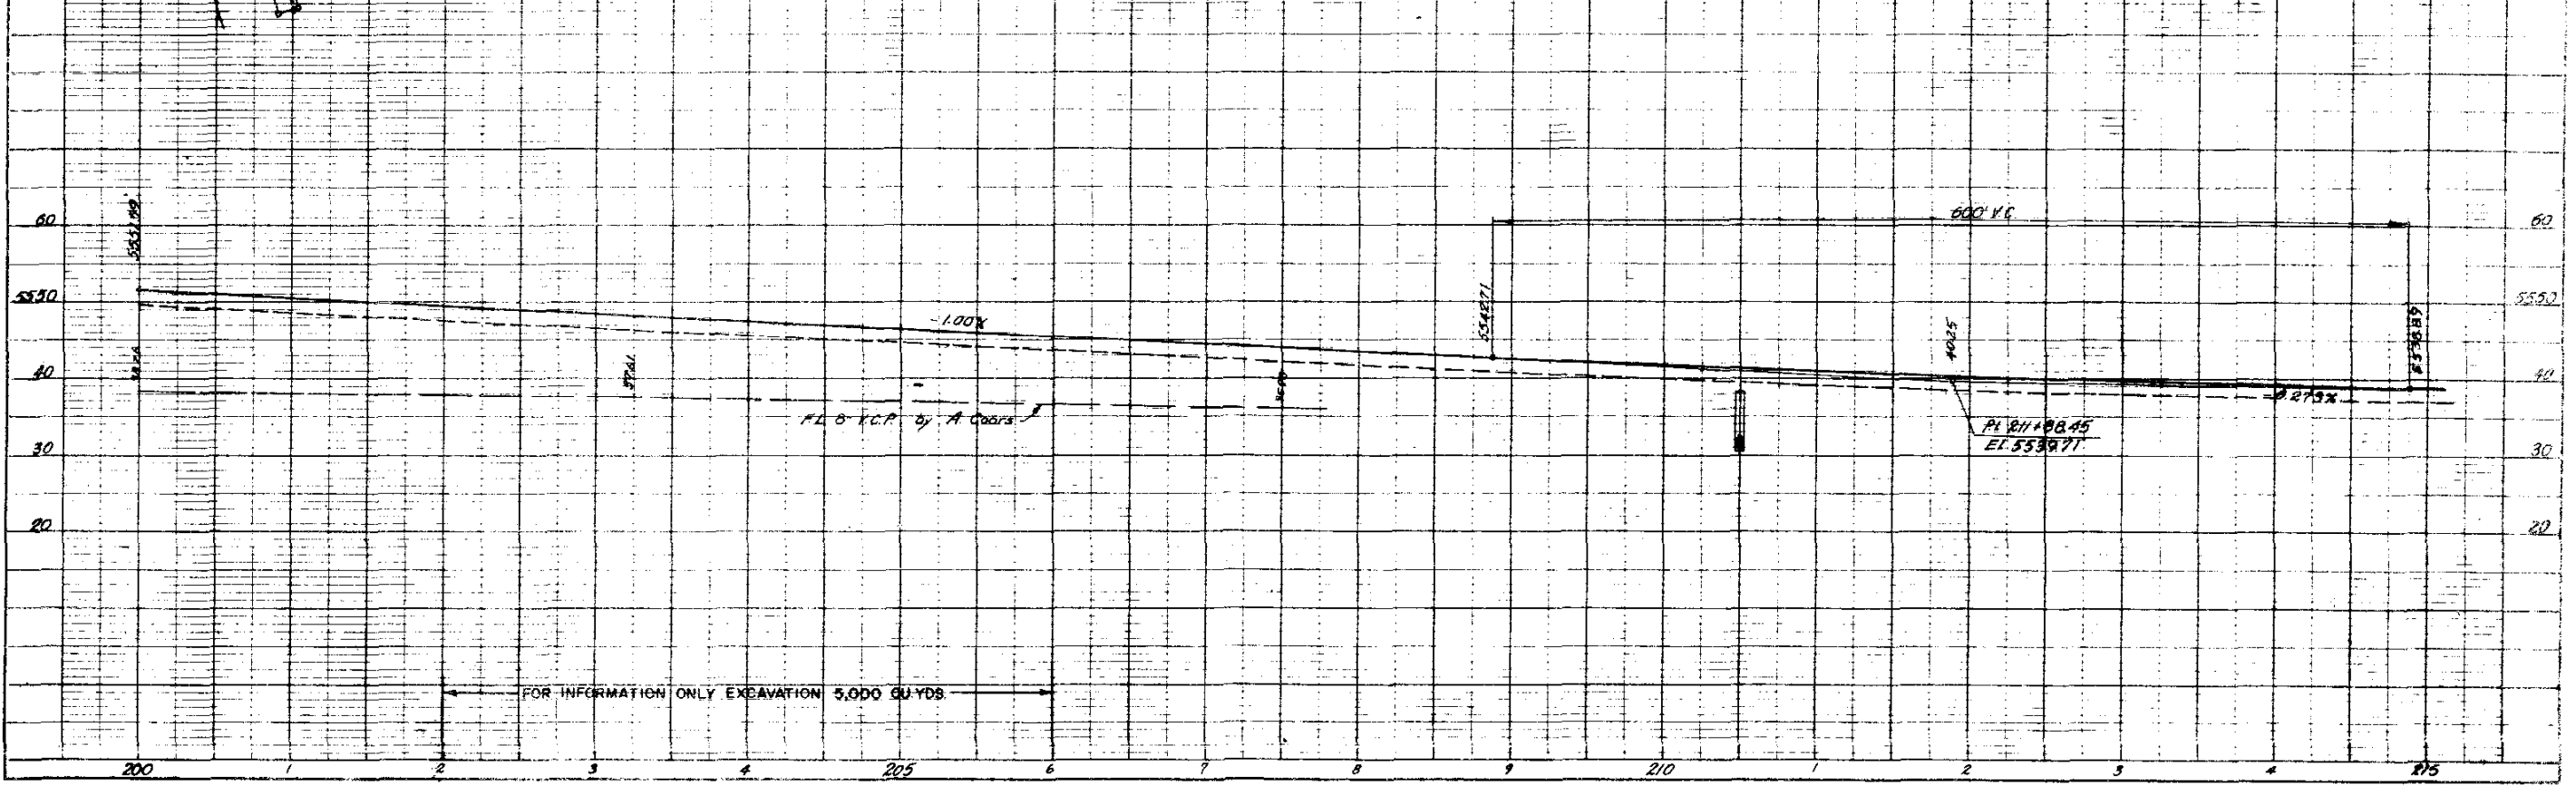

PLAN
SURVEYED BY
NOTED: SEE SHEET 36 FOR
ALIGNED CHECK
NOTED: SEE SHEET 36 FOR
ALIGNED CHECK

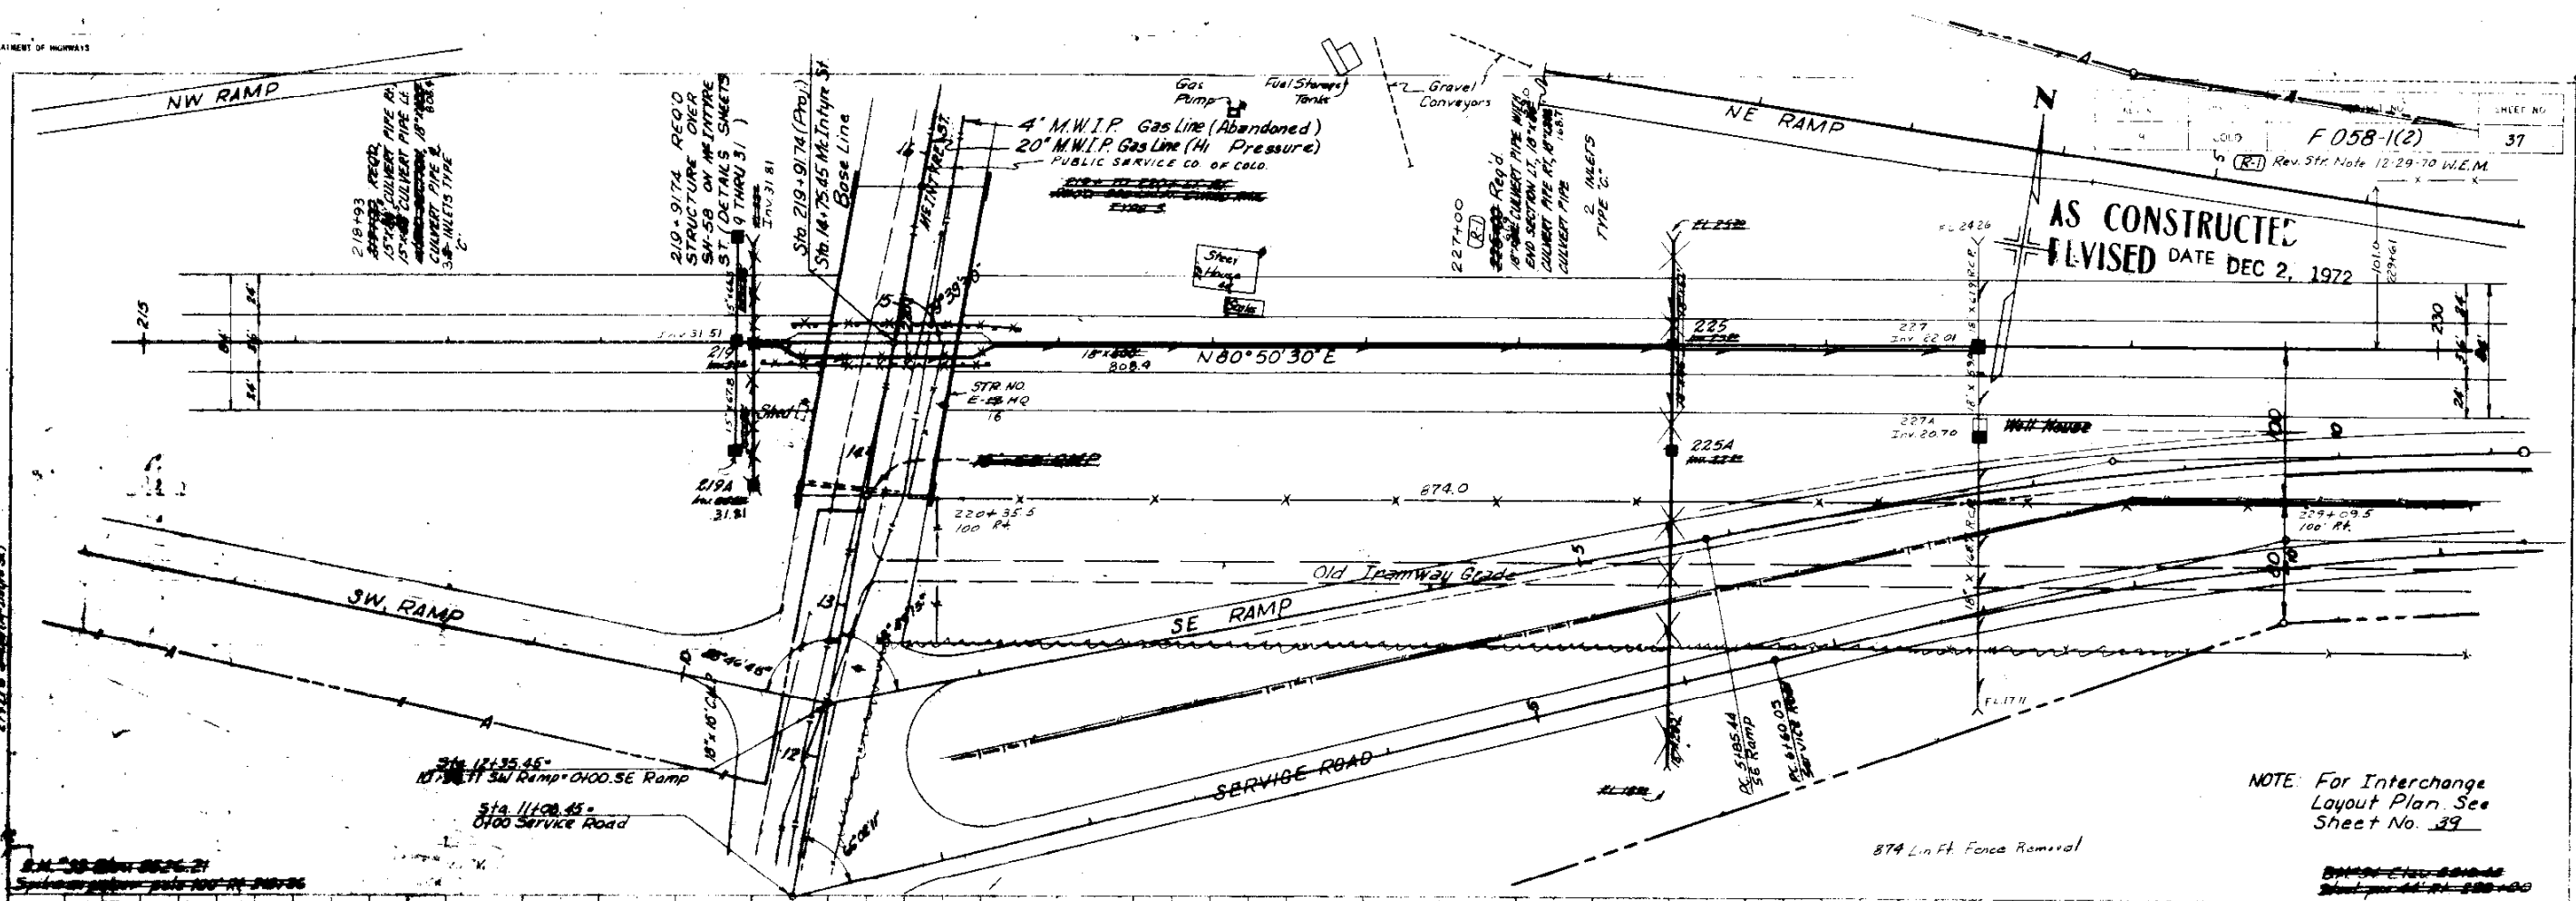


AS CONSTRUCTED
REVISED DATE DEC 2, 1972

F 058-1(2)


37

NOTE: For Interchange
Layout Plan See
Sheet No. 39

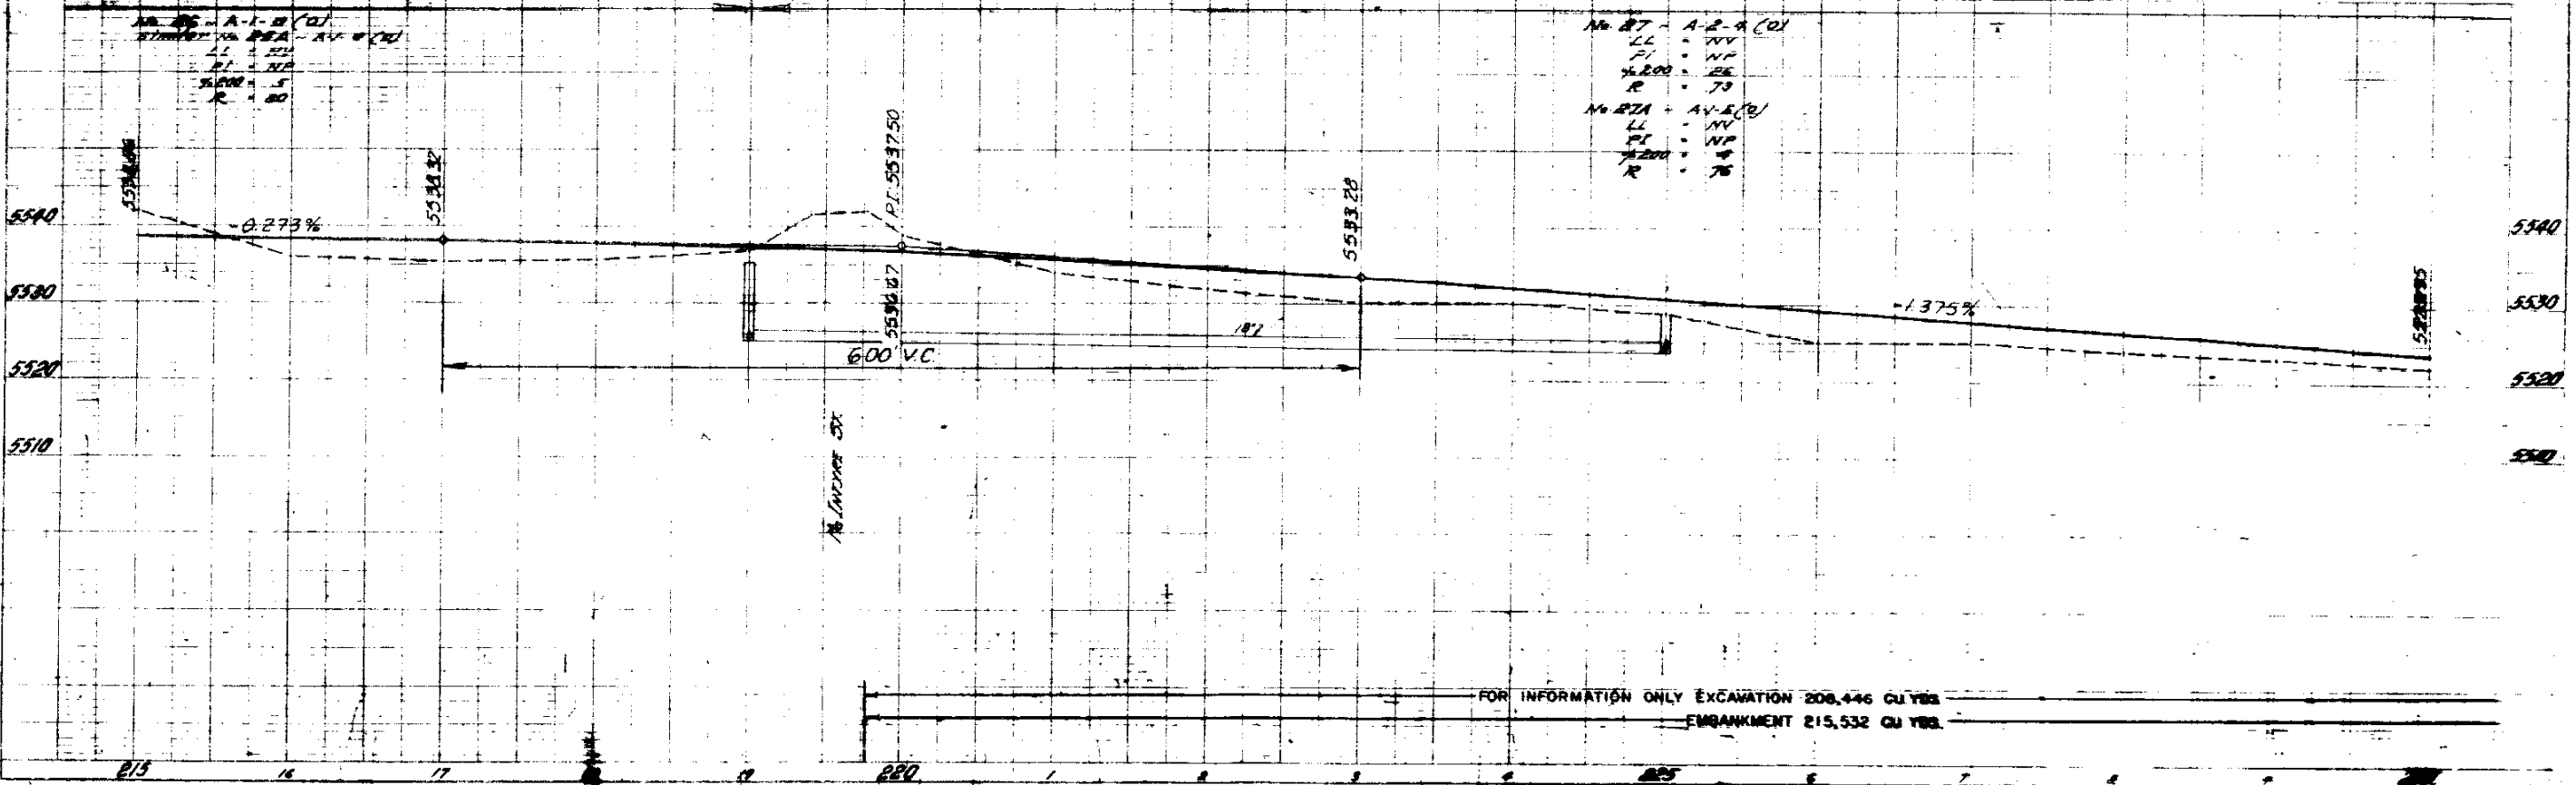

K-E

PLAN
NOTE BOOK

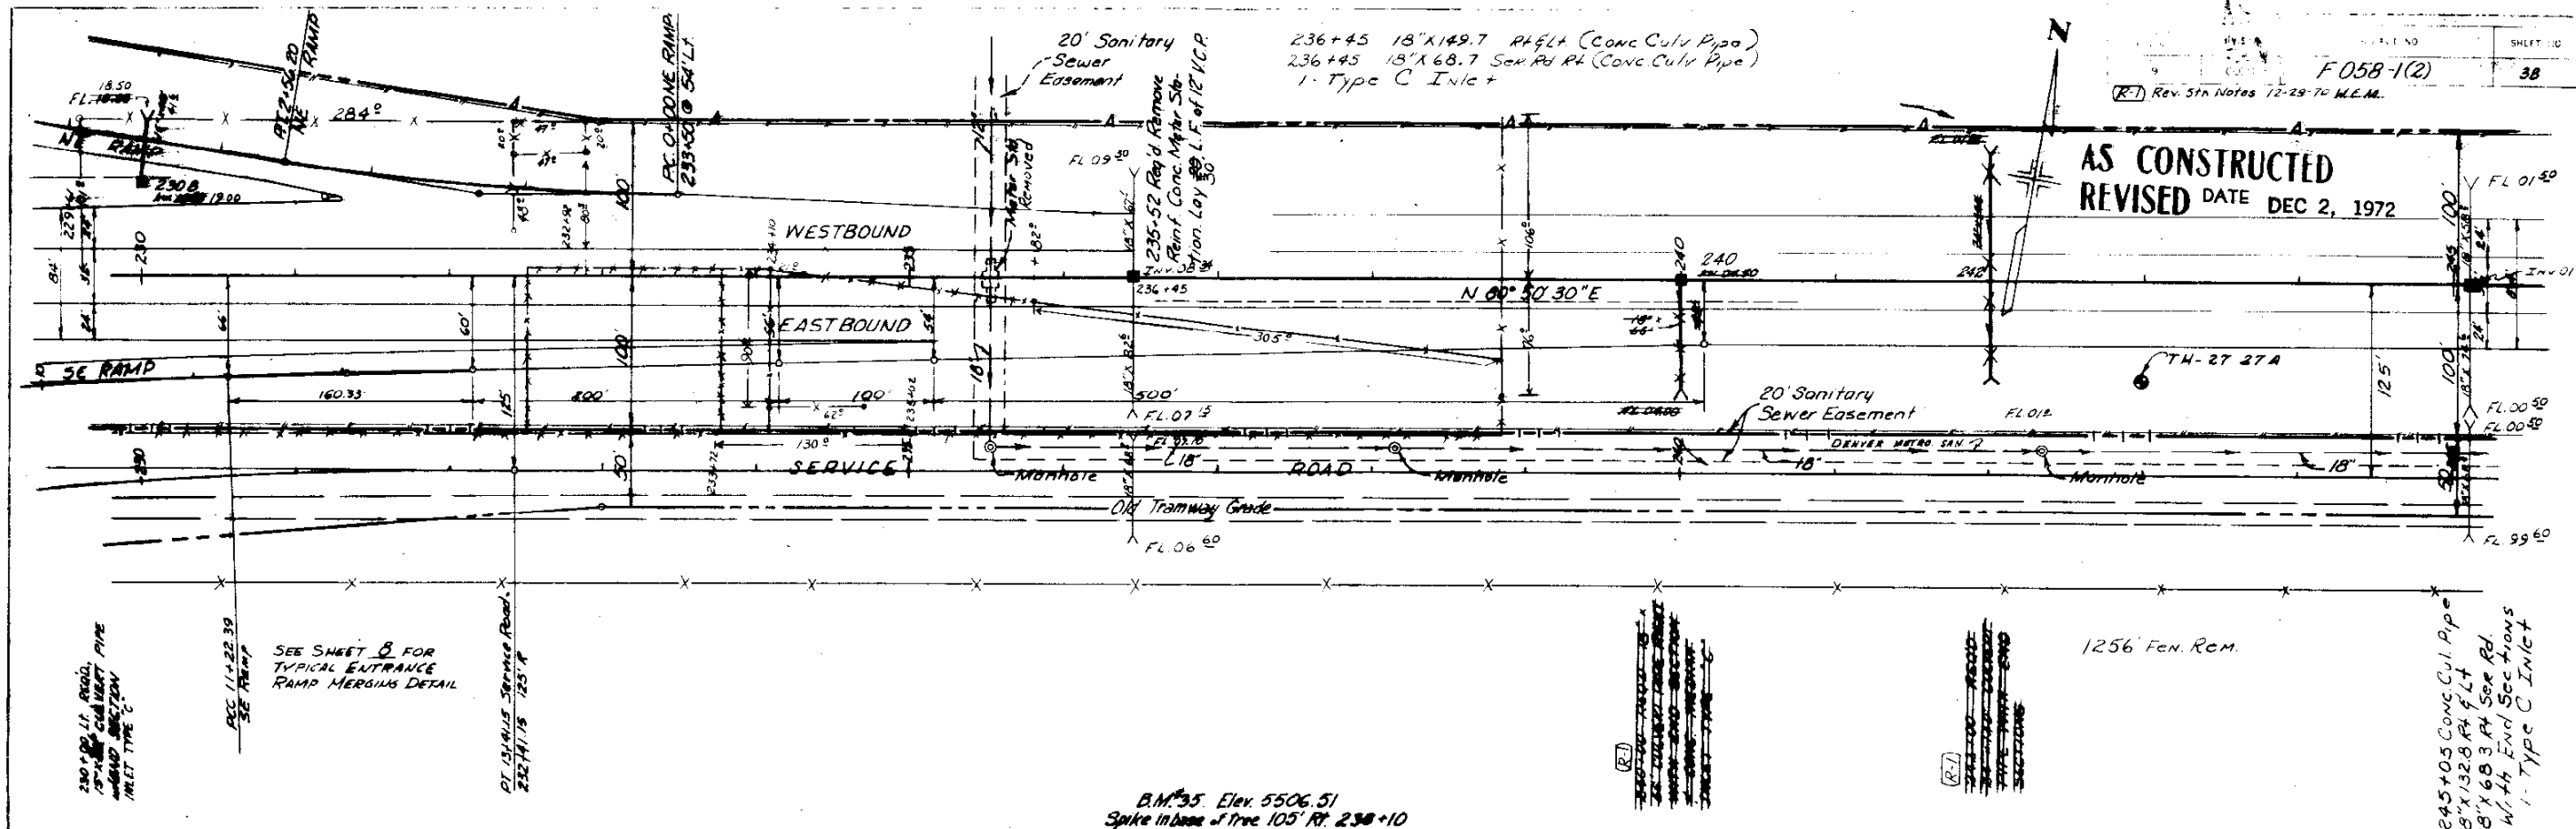


AS CONSTRUCTED
REVISED DATE DEC 2, 1972

PROJECT NO. F 058-1(2)
SHEET NO. 38
Rev. 5th Notes 12-29-70 M.E.M.

B.M. #35 Elev. 5506.51
Spike in base of tree 105' Rt. 230+10

No. 27-A-2-4(0)
LL - NV
PI - NP
%200 - 26
R - 73
27A-A-1-B(0)
LL - NV
PI - NP
%200 - 4
R - 76
Marshy channel sand, similar to
No. 27A Rt & Lt of old tram road
bed. Water at 5.

PROFILE
25194

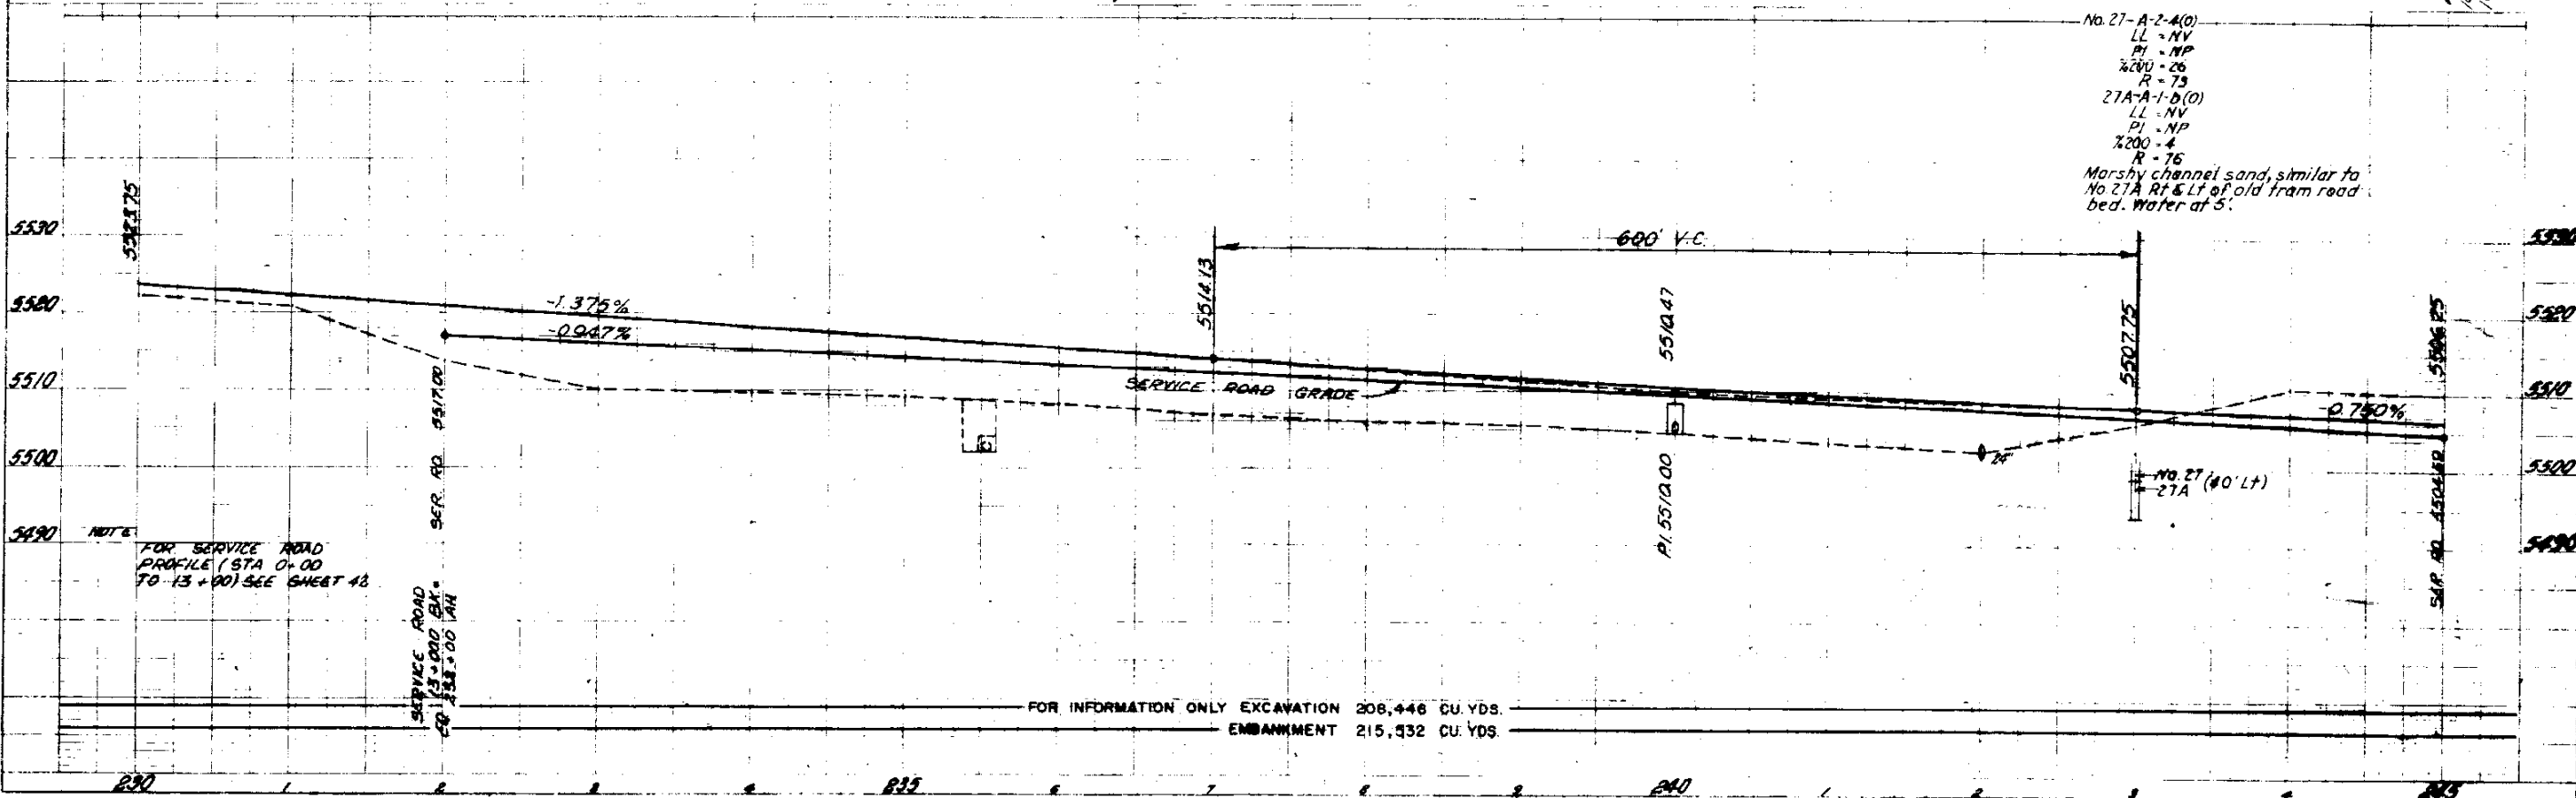

NOTE
FOR SERVICE ROAD
PROFILE (STA 0+00
TO 13+00) SEE SHEET 43

SERVICE ROAD
13+000 EX.
CO. 230+00 1/4"


FOR INFORMATION ONLY EXCAVATION 208,446 CU. YDS.
EMBANKMENT 215,932 CU. YDS.

FEDERAL ROAD REGION NO.	DISTRICT	PROJ. NO.	SHEET NO.	TOTAL SHEETS
9	COLORADO	F058-1(2)	39	

(R-1) Rev. 5th No. 12-29-70 W.E.M.

AS CONSTRUCTED
REVISED DATE DEC 2, 1972

LEGEND

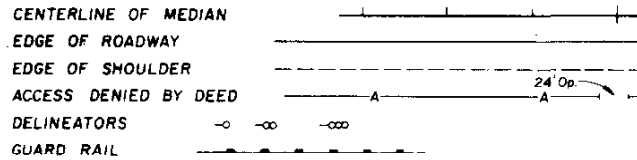

CURVE DATA

CURVE	Δ	D	T	L	R
①	13°37'19"	2°00'	342.19'	681.10'	2865'
②	8°50'15"	1°38'47"	269.25'	536.95'	3480.96'
③	8°43'22"	3°24'17"	128.35'	256.20'	1,682.88'
④	4°07'52"	0°49'35"	250.00'	499.84'	6,932.89'
⑤	12°03'15"	2°56'25"	205.76'	409.98'	1,948.85'
⑥	25°01'	8°17'	150.00'	302.70'	693.29'
⑦	25°01'	6°13'	200.00'	403.61'	924.39'
⑧	28°59'	9°52'	150.00'	293.57'	580.35'
⑨	28°11'	14°22'	100.00'	196.20'	398.36'


INTERCHANGE LAYOUT

TRAFFIC LEGEND

637 = 1984 DHV

HENNINGSON, DURHAM & RICHARDSON
ENGINEERS, PLANNERS & CONSULTANTS
CAPITOL LIFE CENTER
DENVER, COLORADO

GRAPHIC SCALE

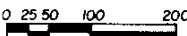


AS CONSTRUCTED
REVISED DATE DEC 2, 1972

FEDERAL ROAD REGION NO.	DISTRICT	PROJ. NO.	SHEET NO.	TOTAL SHEETS
9	COLORADO	F058-1(2)	40	




FINAL SURVEY	REVISED SURVEY	NOTED BOOK	NO.

ORIGINAL SURVEY	REVISED SURVEY	NOTED BOOK	NO.

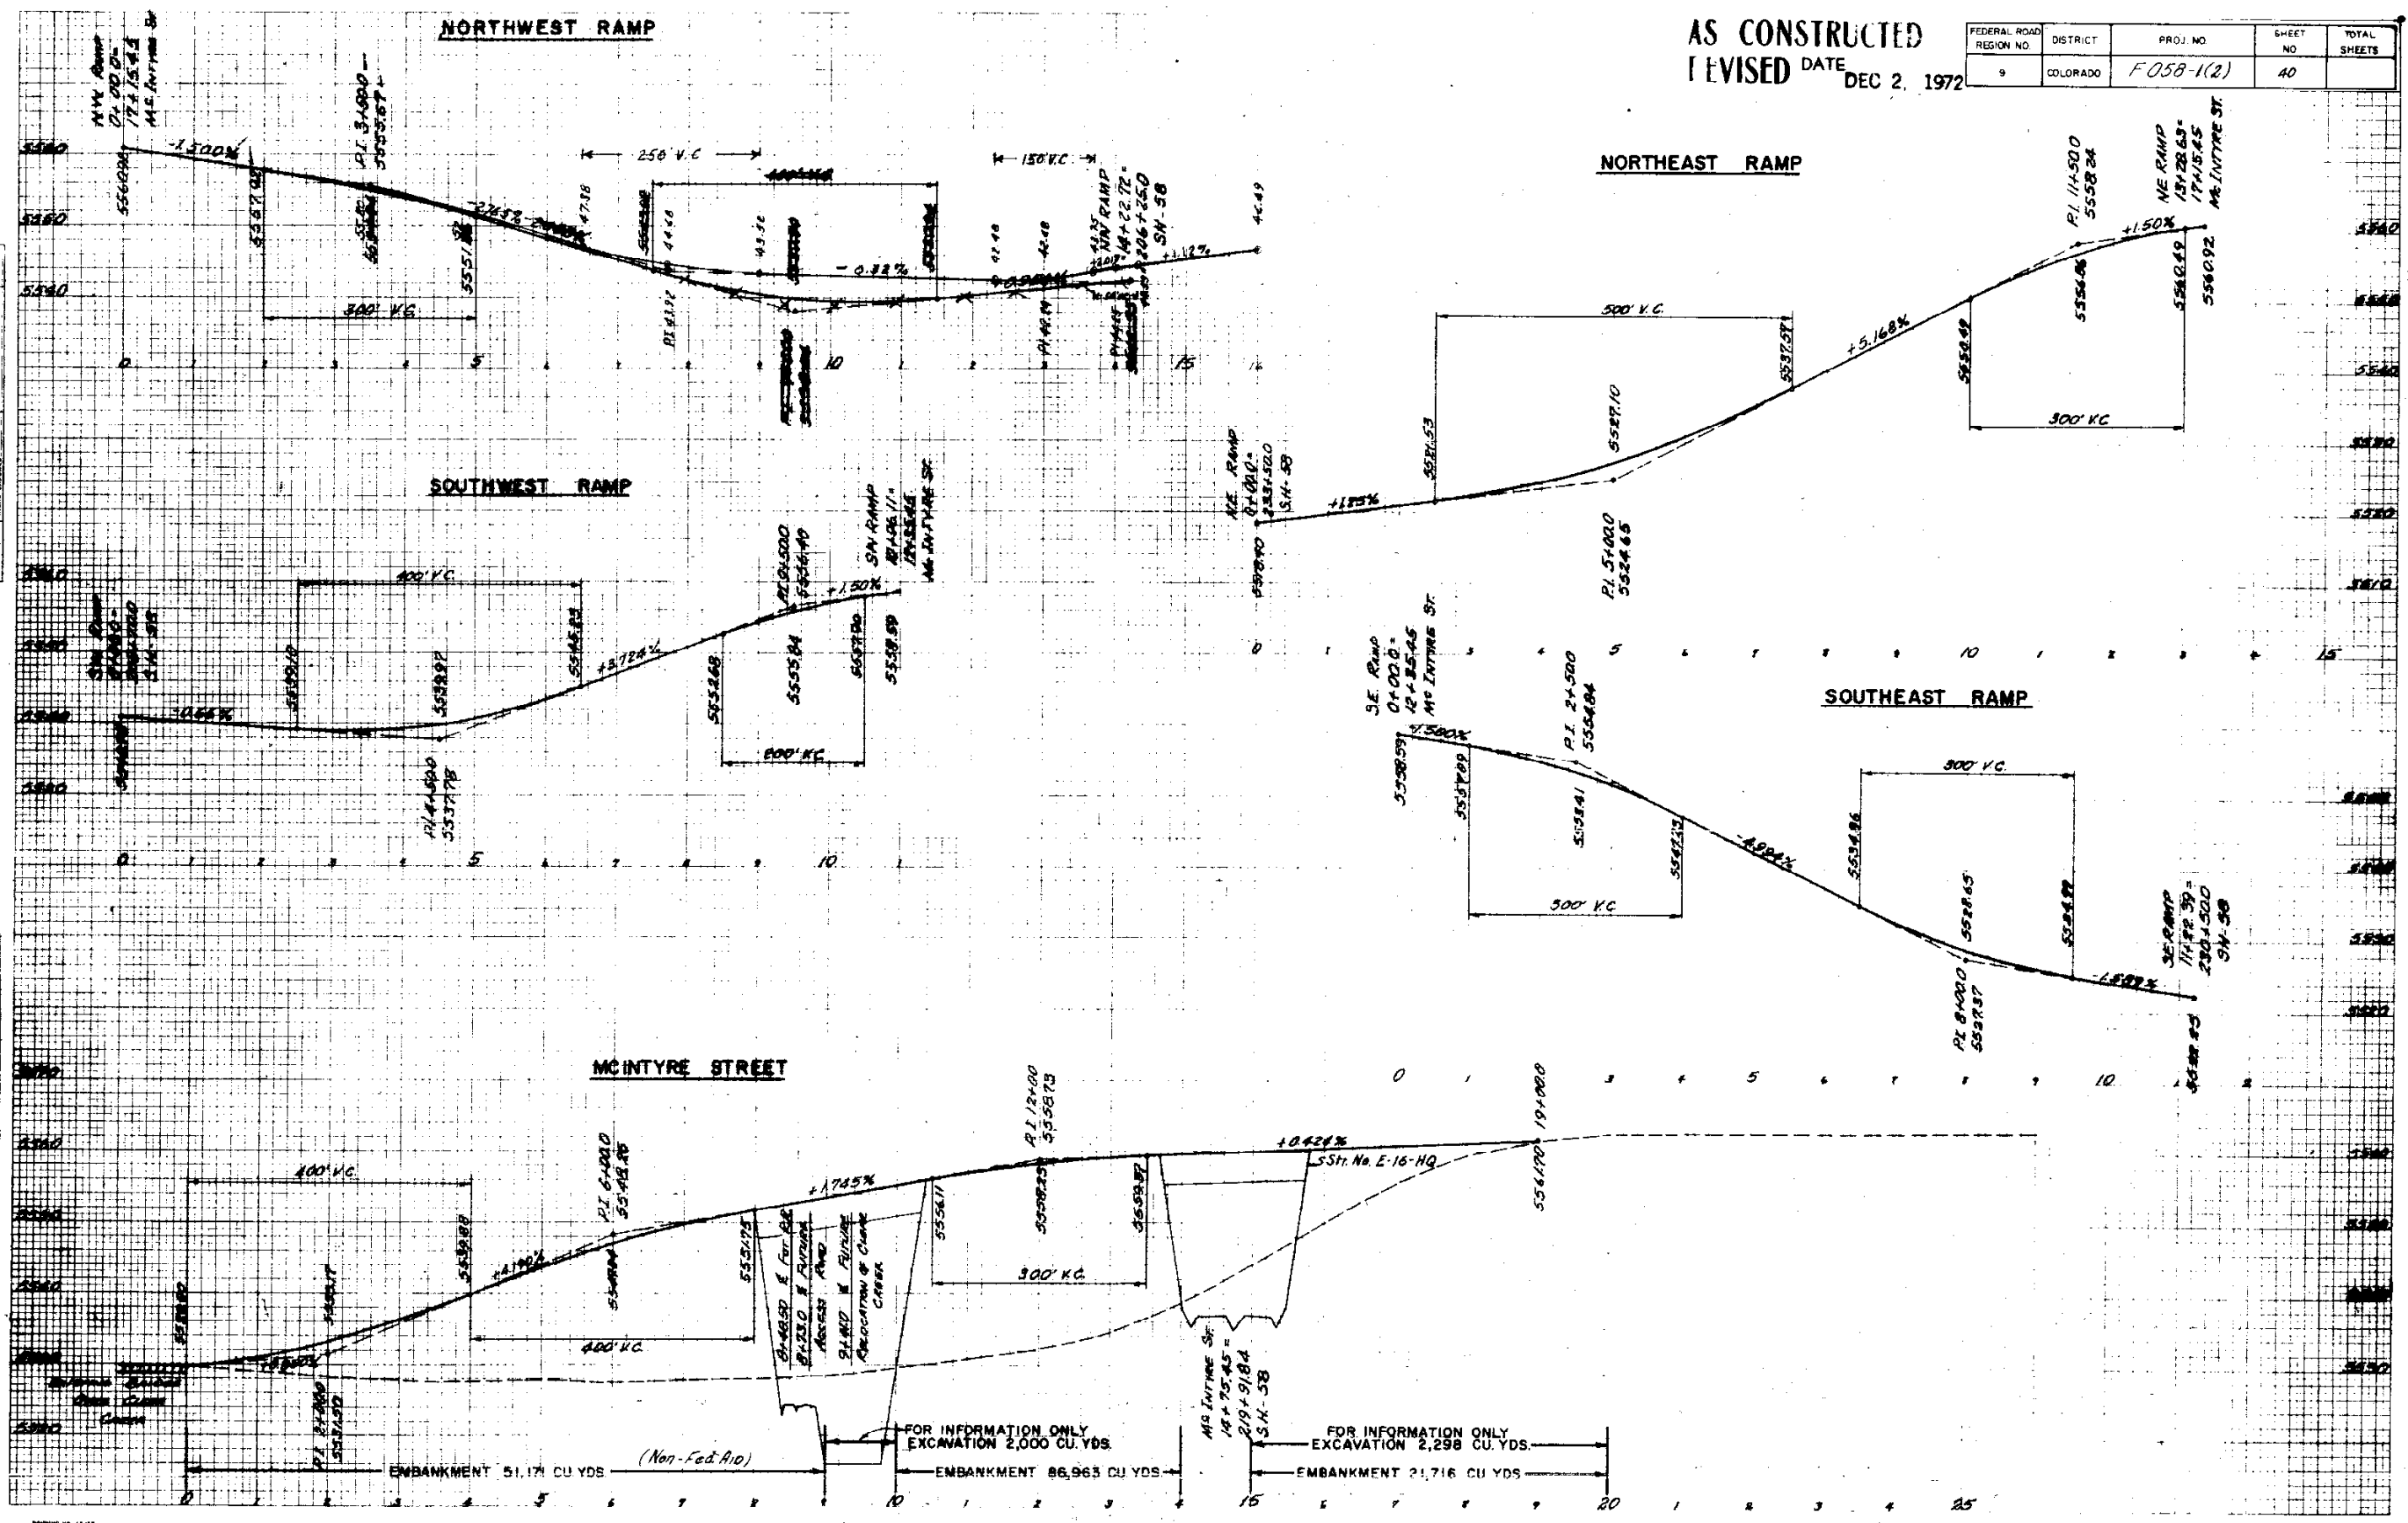

FEDERAL ROAD REGION NO.	DISTRICT	PROJ. NO.	SHEET NO.	TOTAL SHEETS
9	COLORADO	F058-1(2)	41	

AS CONSTRUCTED
NO REVISIONS DATE DEC 2, 1972

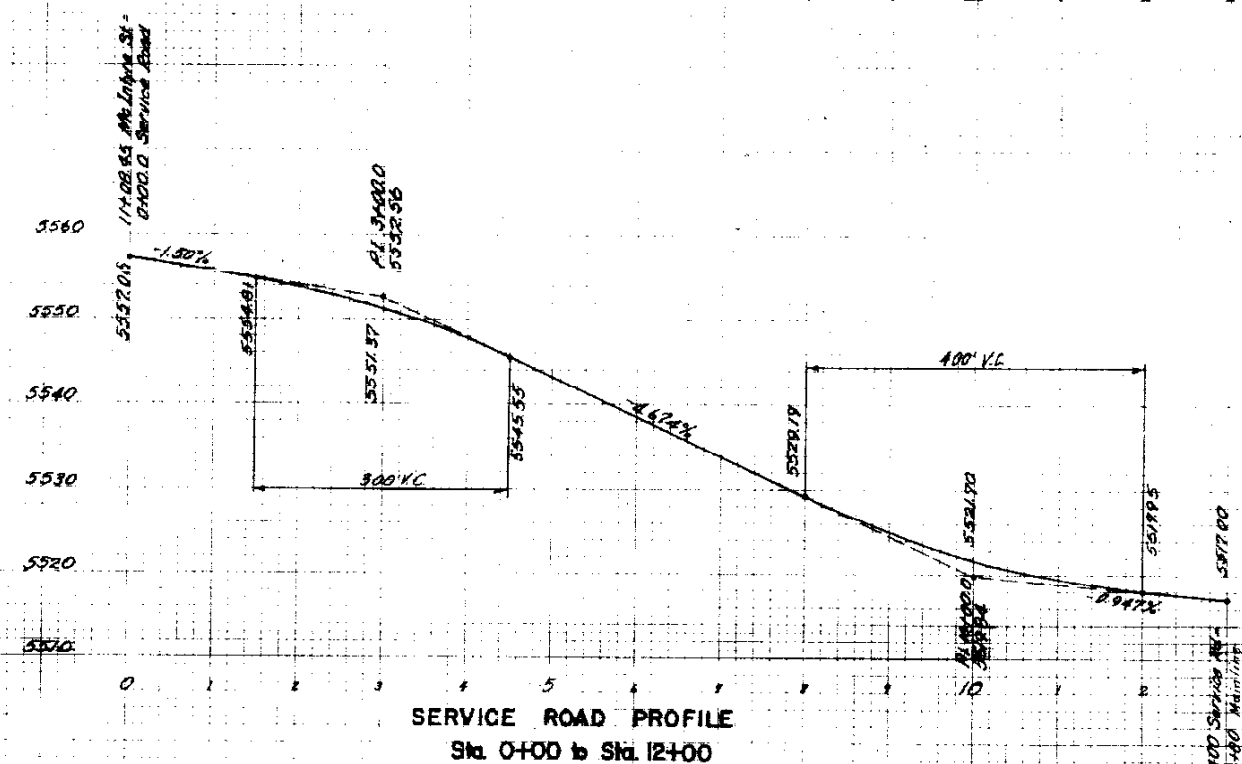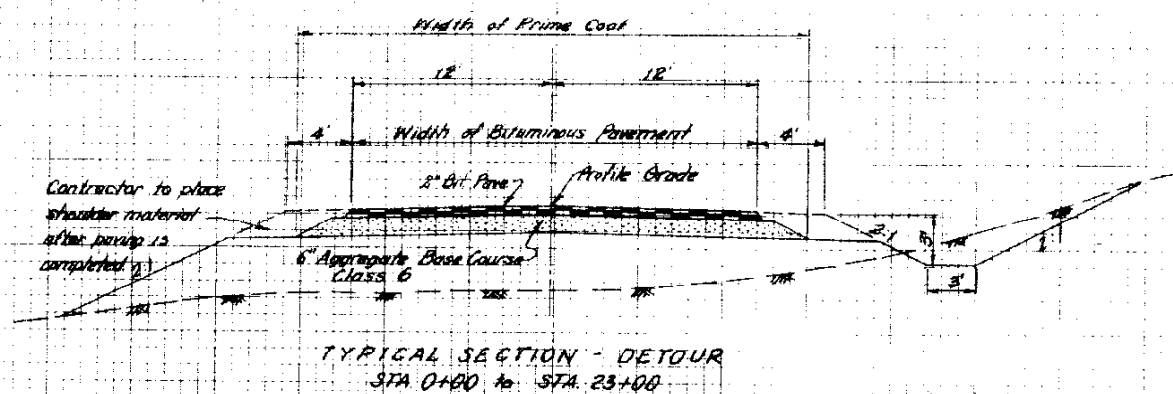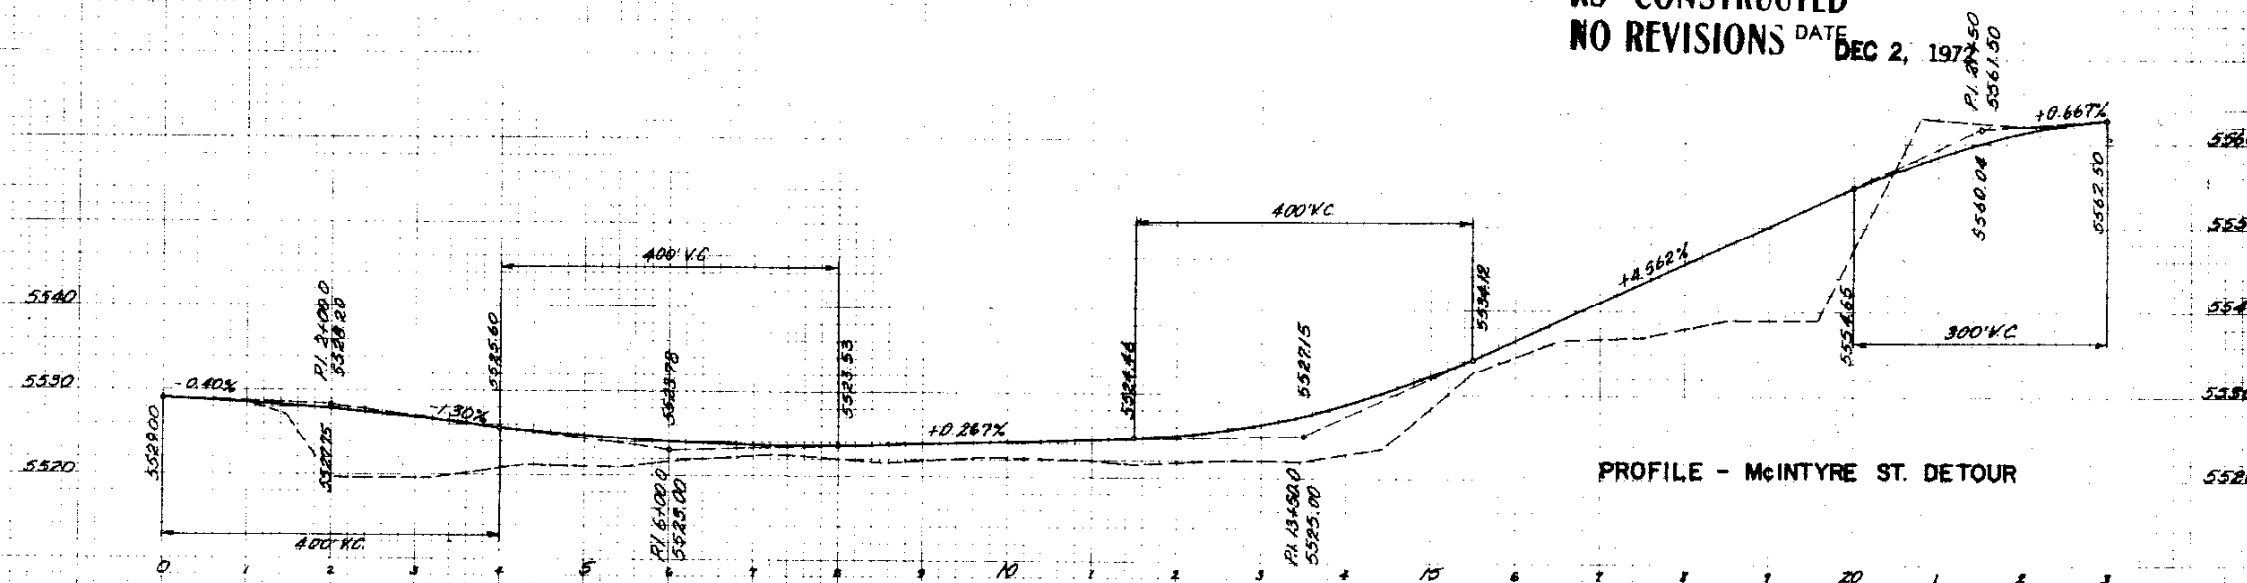


F 058-1(2)

42

(R-1) Rev. Str. Notes 12-29-76 N.E.M.

AS CONSTRUCTED
REVISED DATE DEC 2 1972

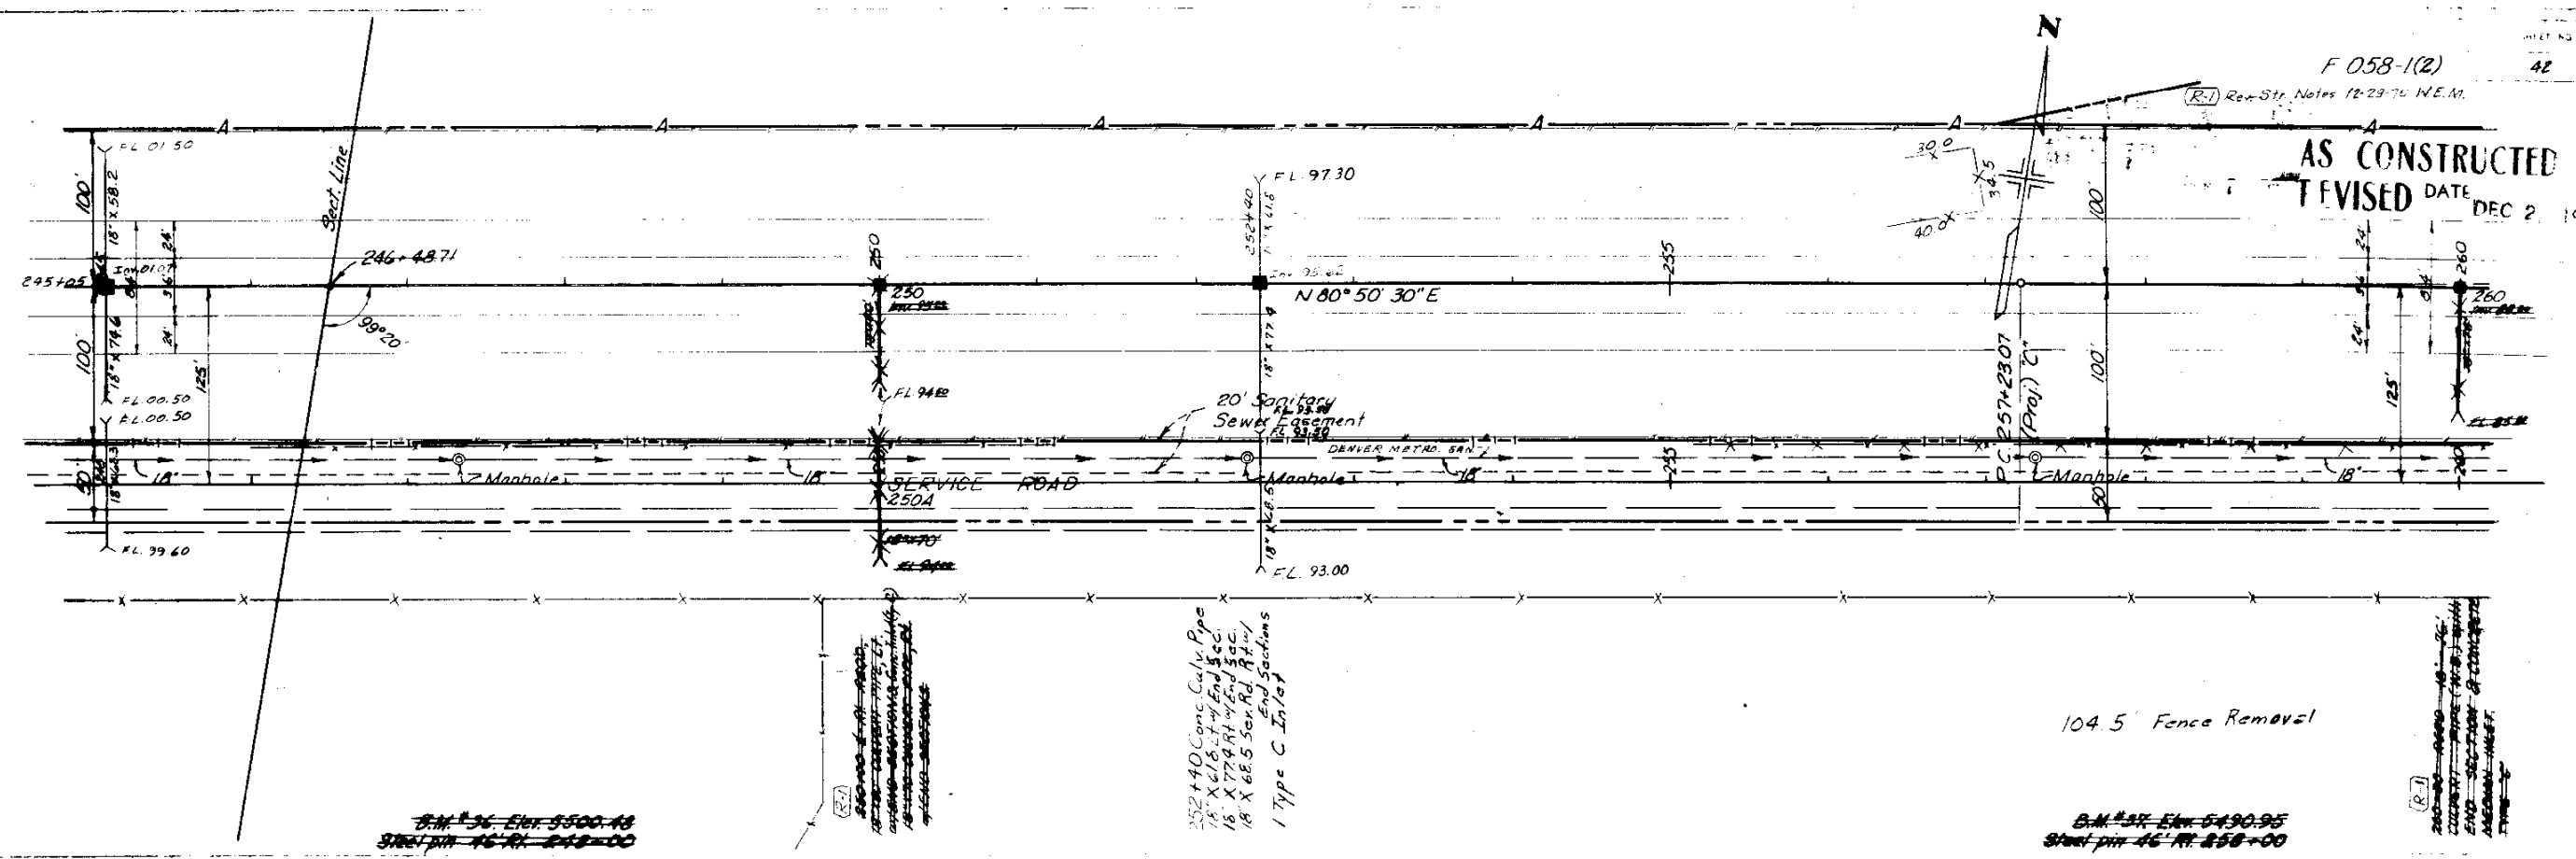



B.M. #36 Elev. 5500.48
Steel pin 16" R.L. 245+00

252+40 Conc. Culv. Pipe
18" x 36" x 15' Sec.
15' x 72" R.L. 252+40
18" x 36" 5' Sec. R.L. 252+40
1 Type C Inlet

B.M. #37 Elev. 5490.95
Steel pin 16" R.L. 258+00

No. 87 - A-2-4(0)
LL = NY
PI = NP
K200 = 86
R = 78
No. 87A - A-4-B(0)
LL = NY
PI = NP
K200 = 4
R = 76


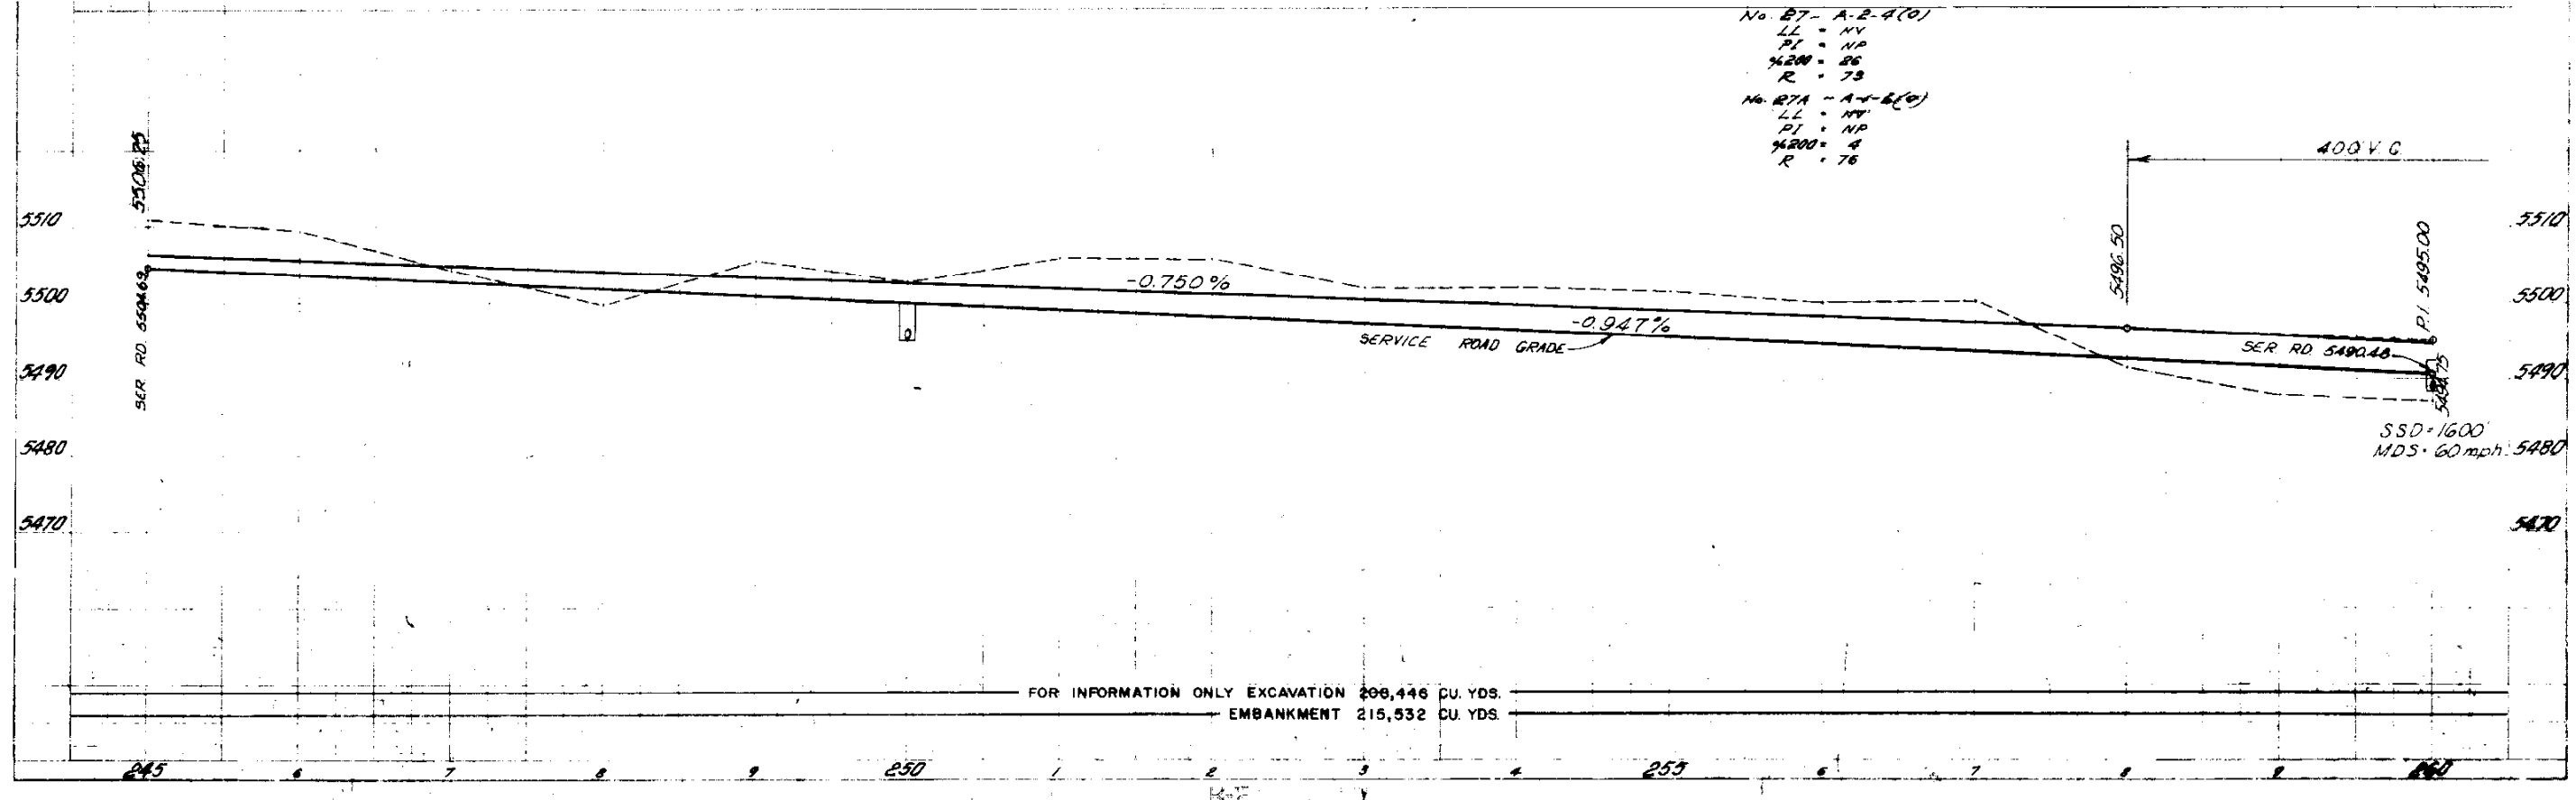


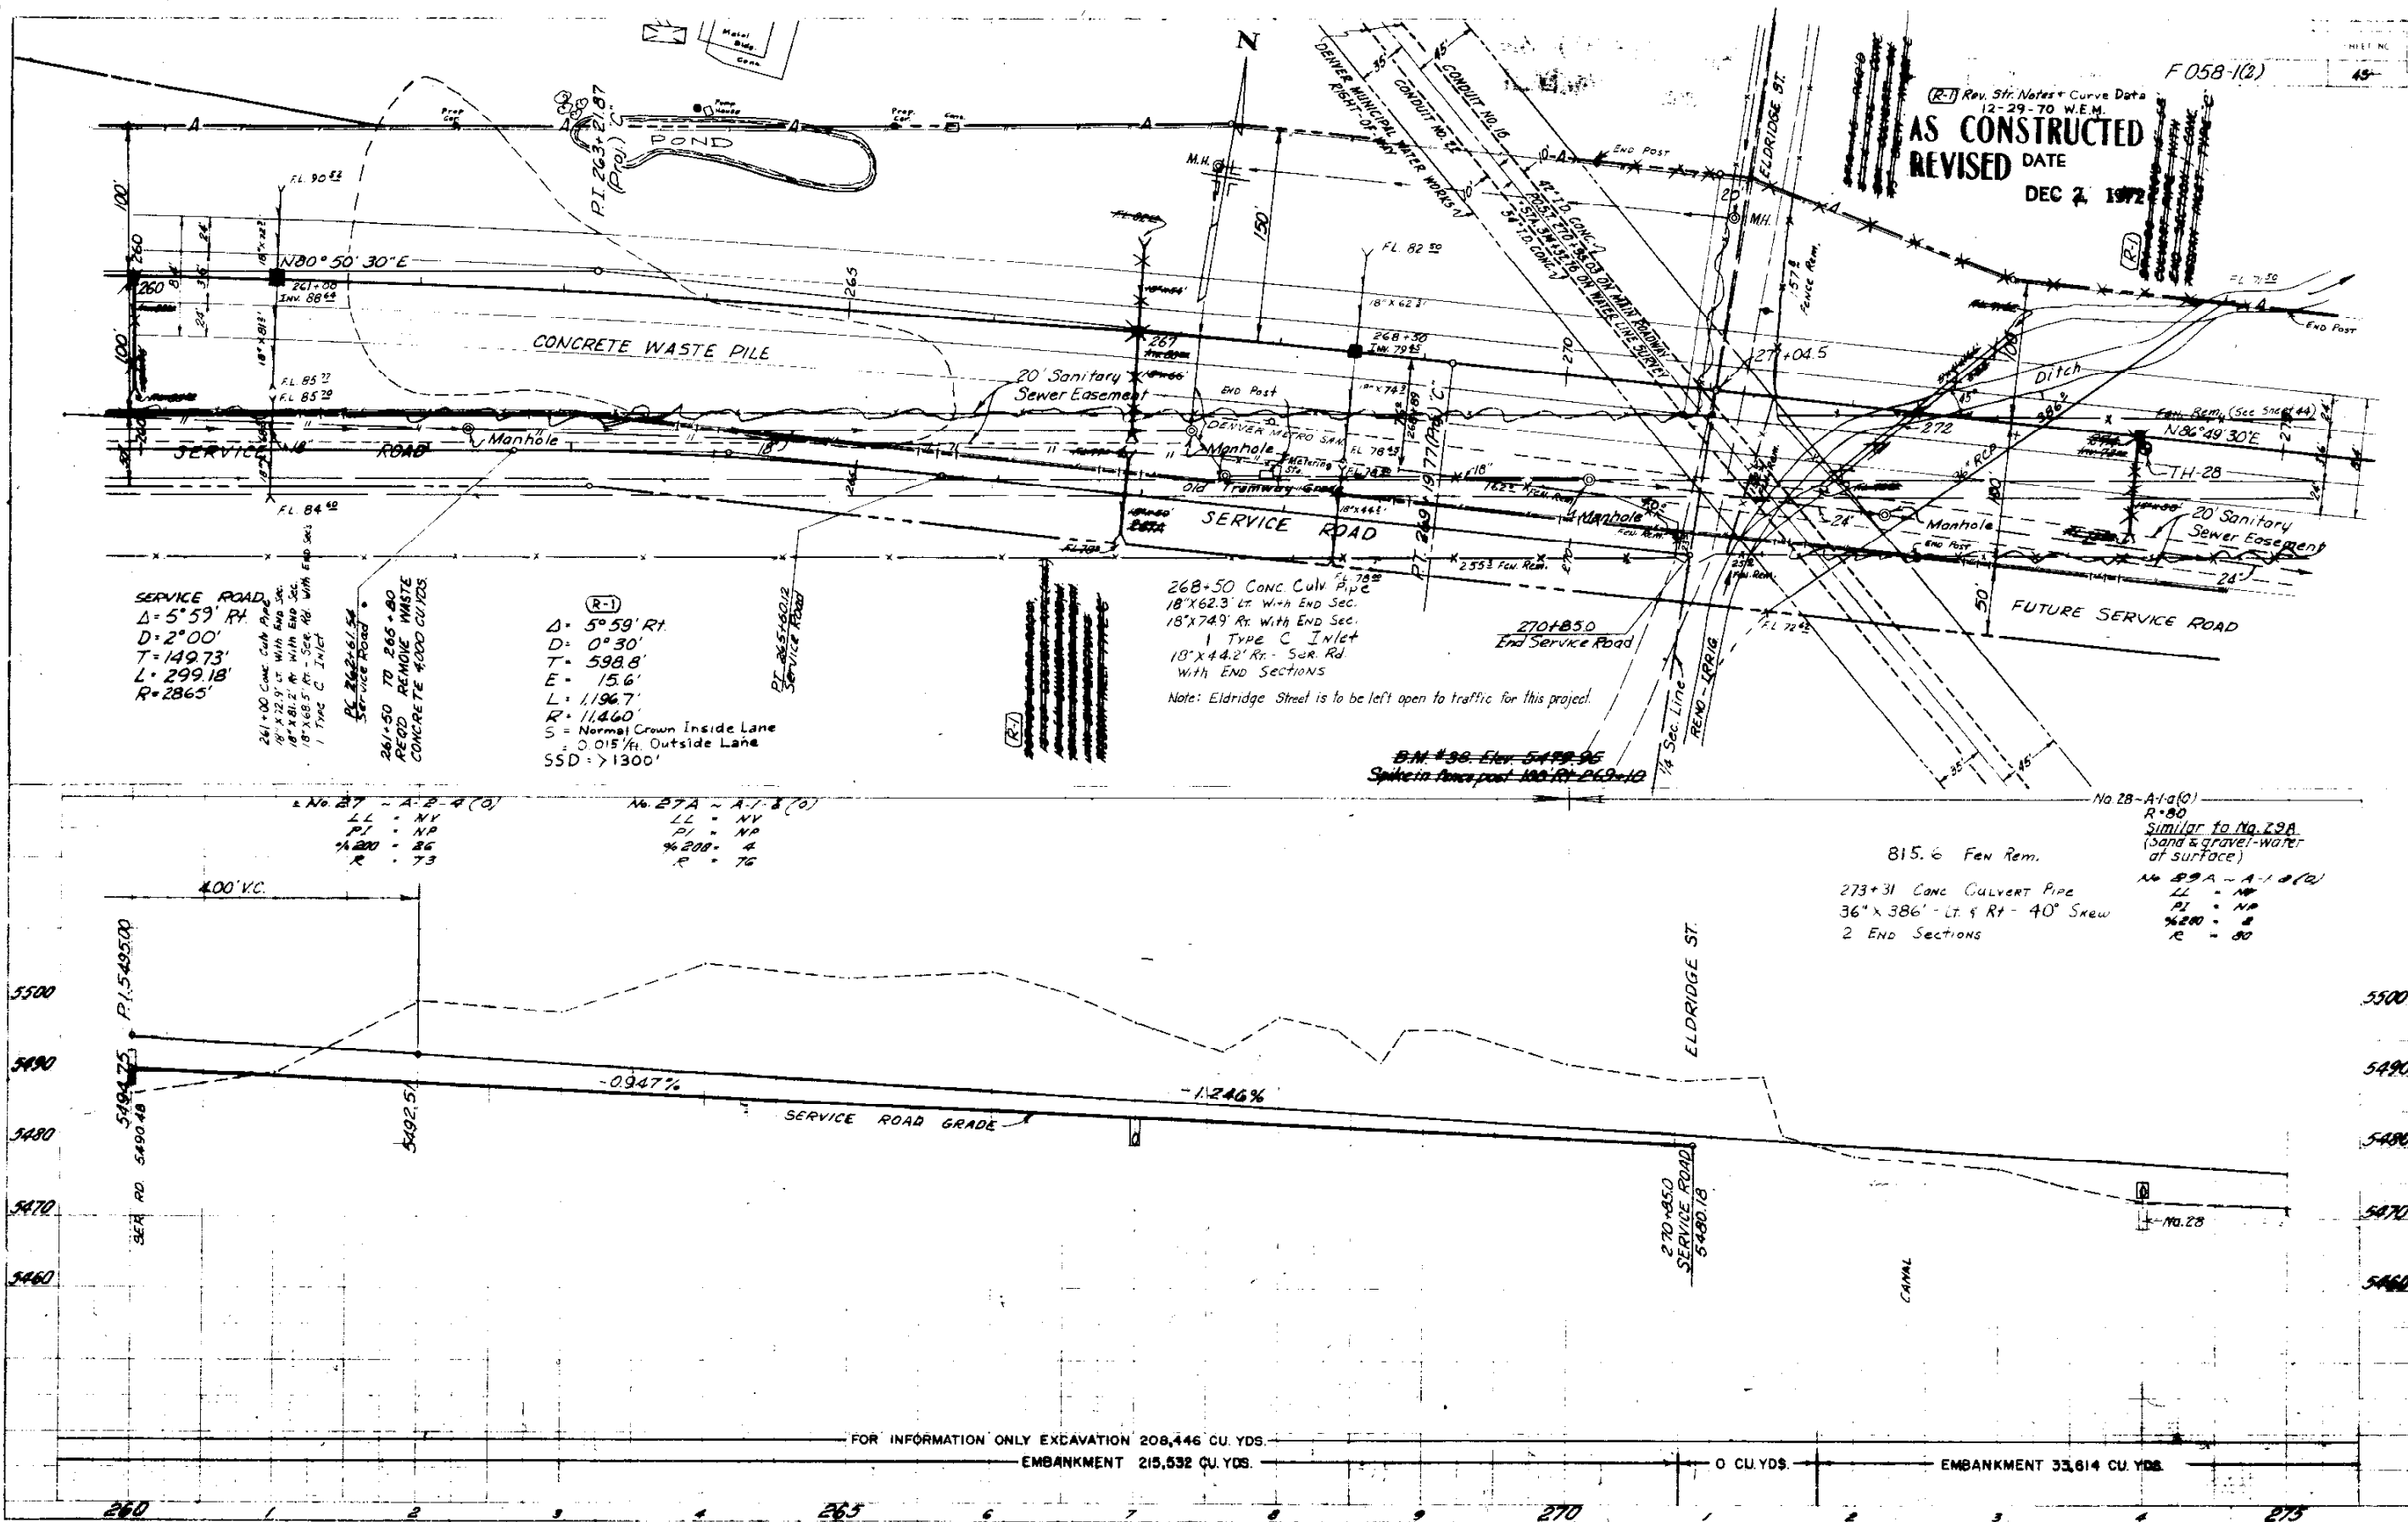


AS CONSTRUCTED
REVISED DATE DEC 2, 1972


F058-K(2)
(R-1) Rev. Str Notes 12-29-70 W.E.M.

44

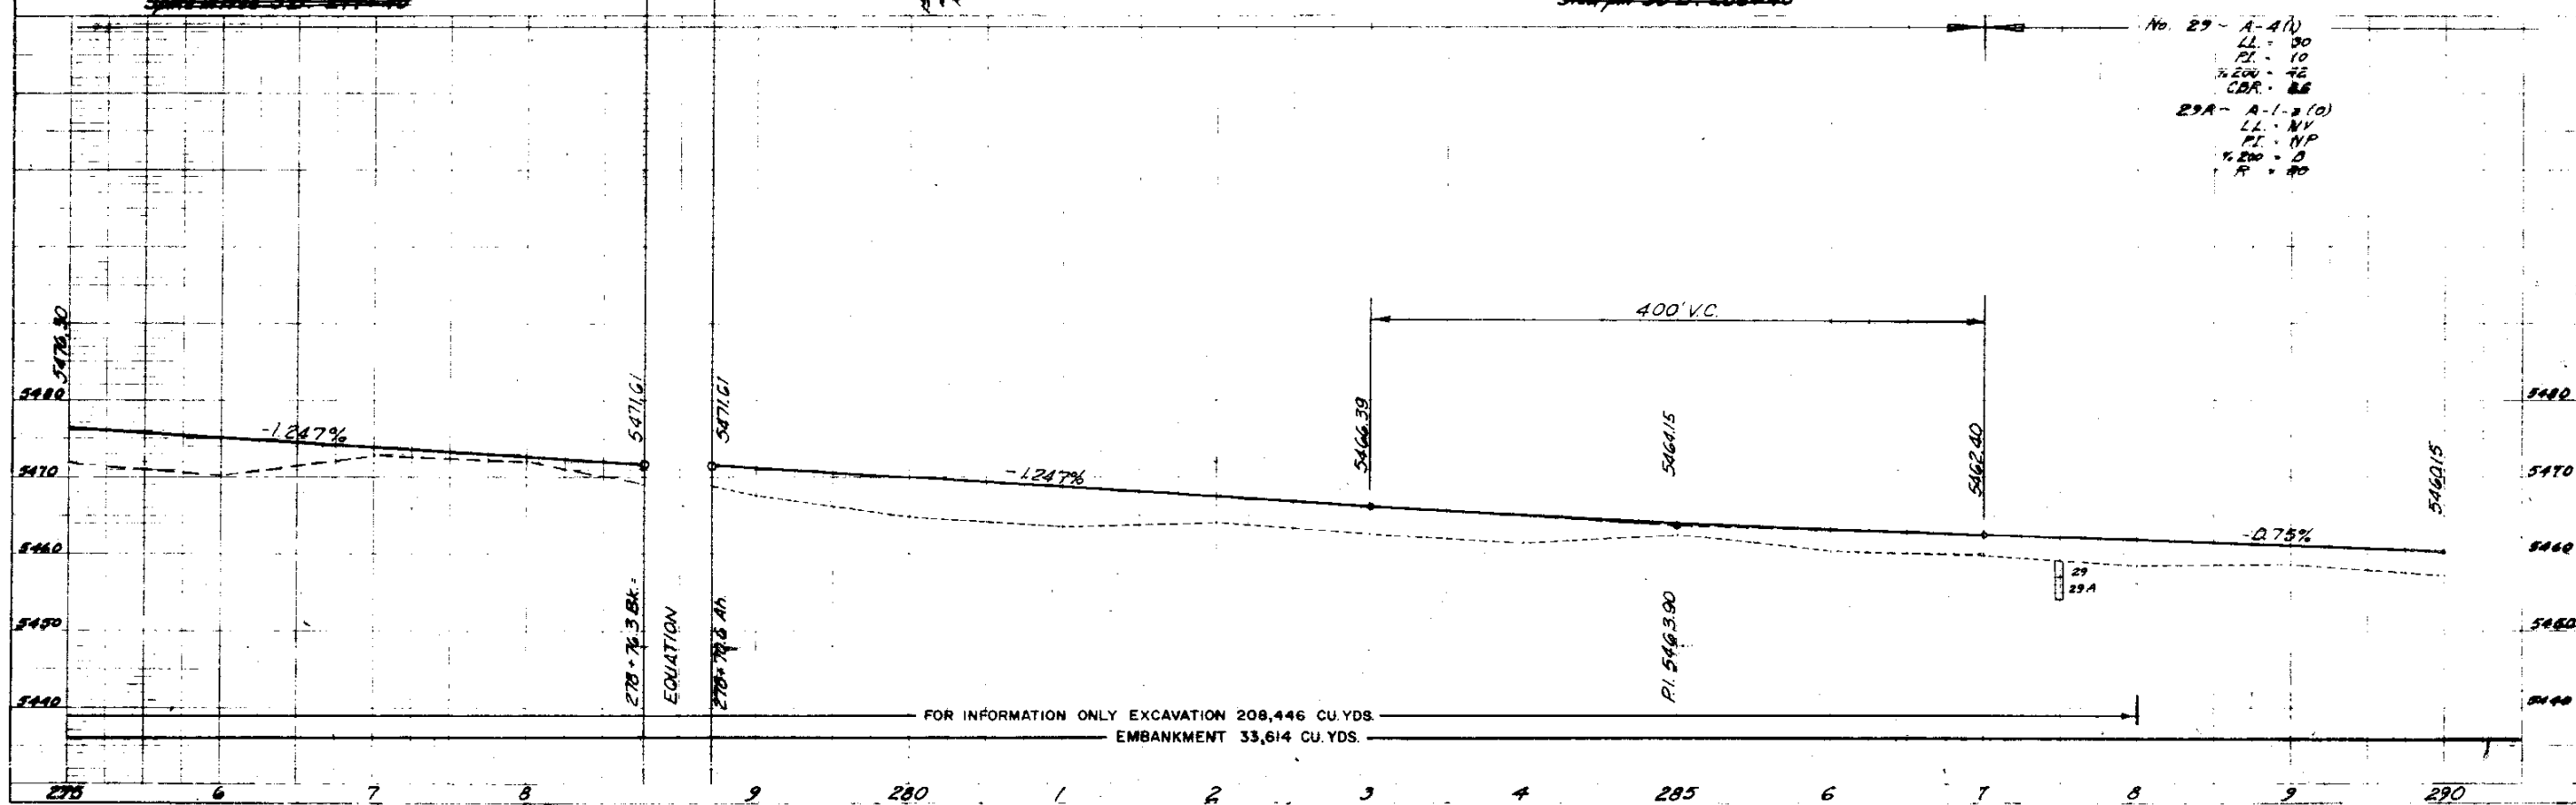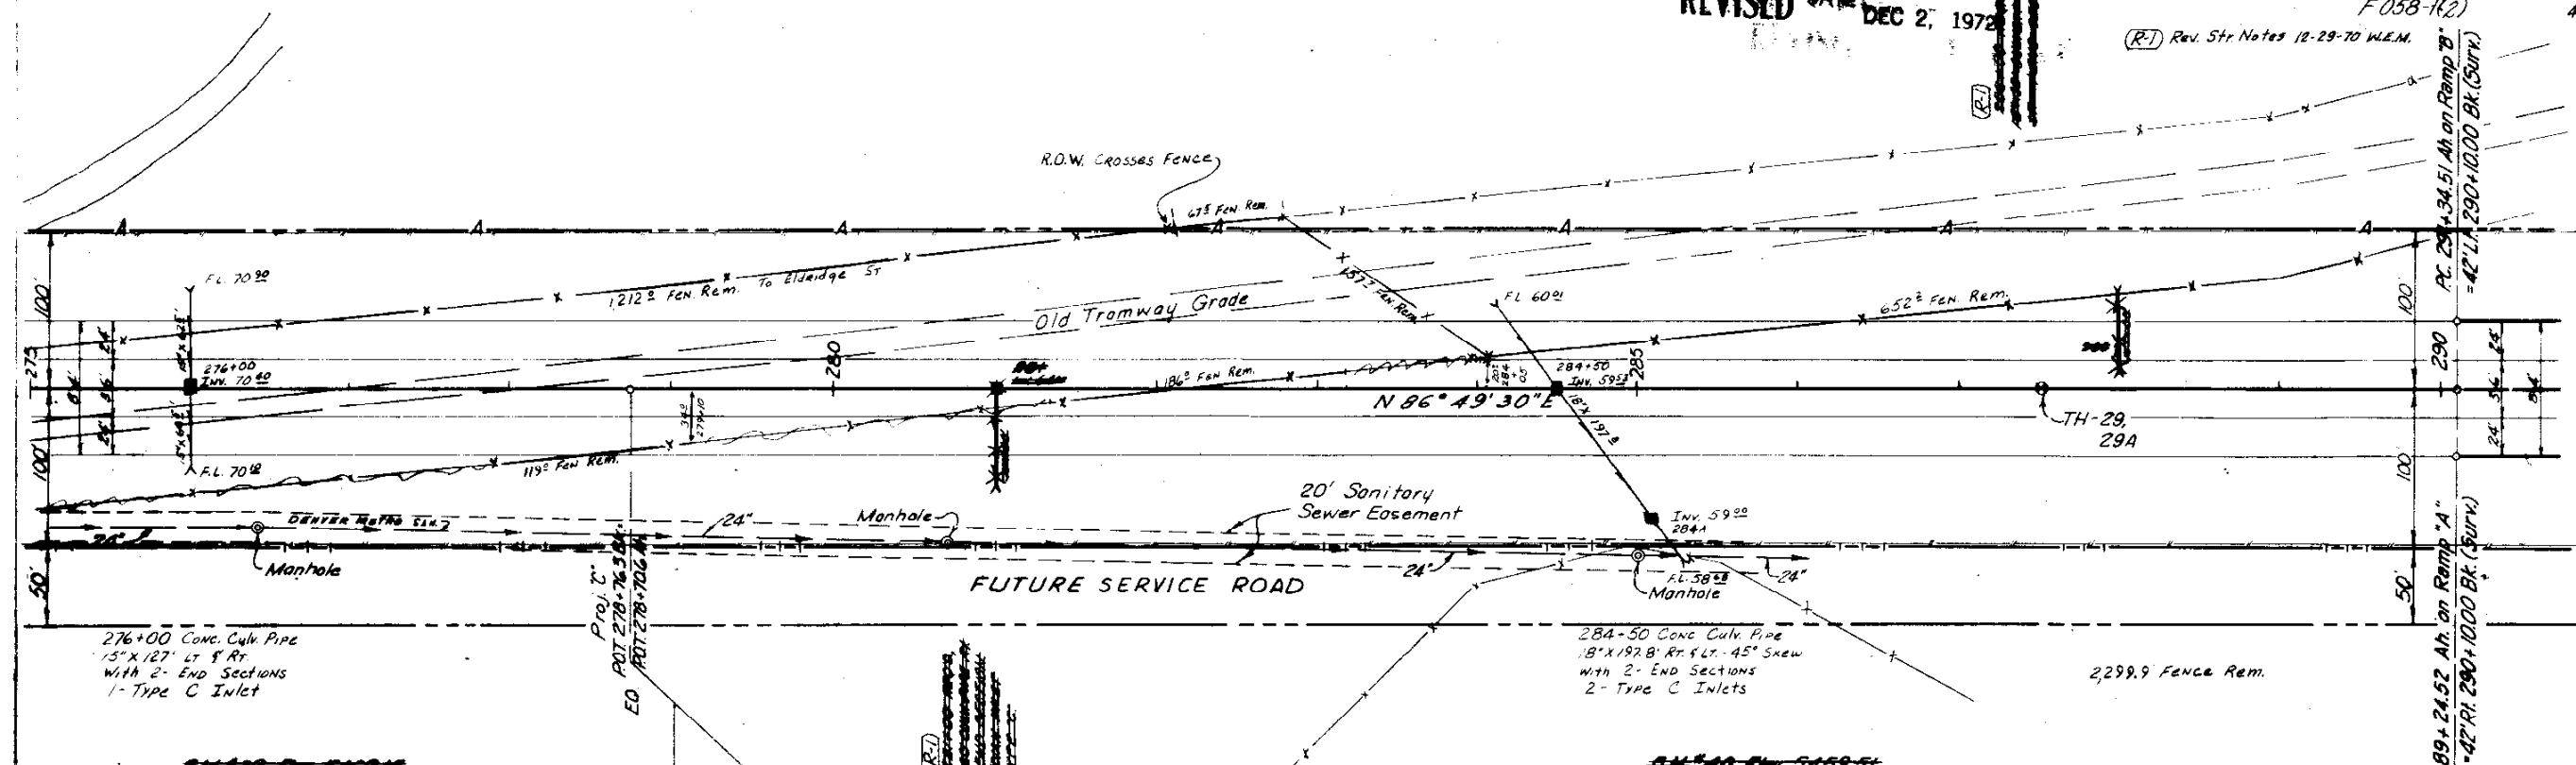

No. 29 - A-4(1)
 LL = 30
 PI = 10
 EQ = 72
 CBR = 86
 29A - A-1-2(0)
 LL = NY
 PI = NP
 EQ = 0
 R = 40

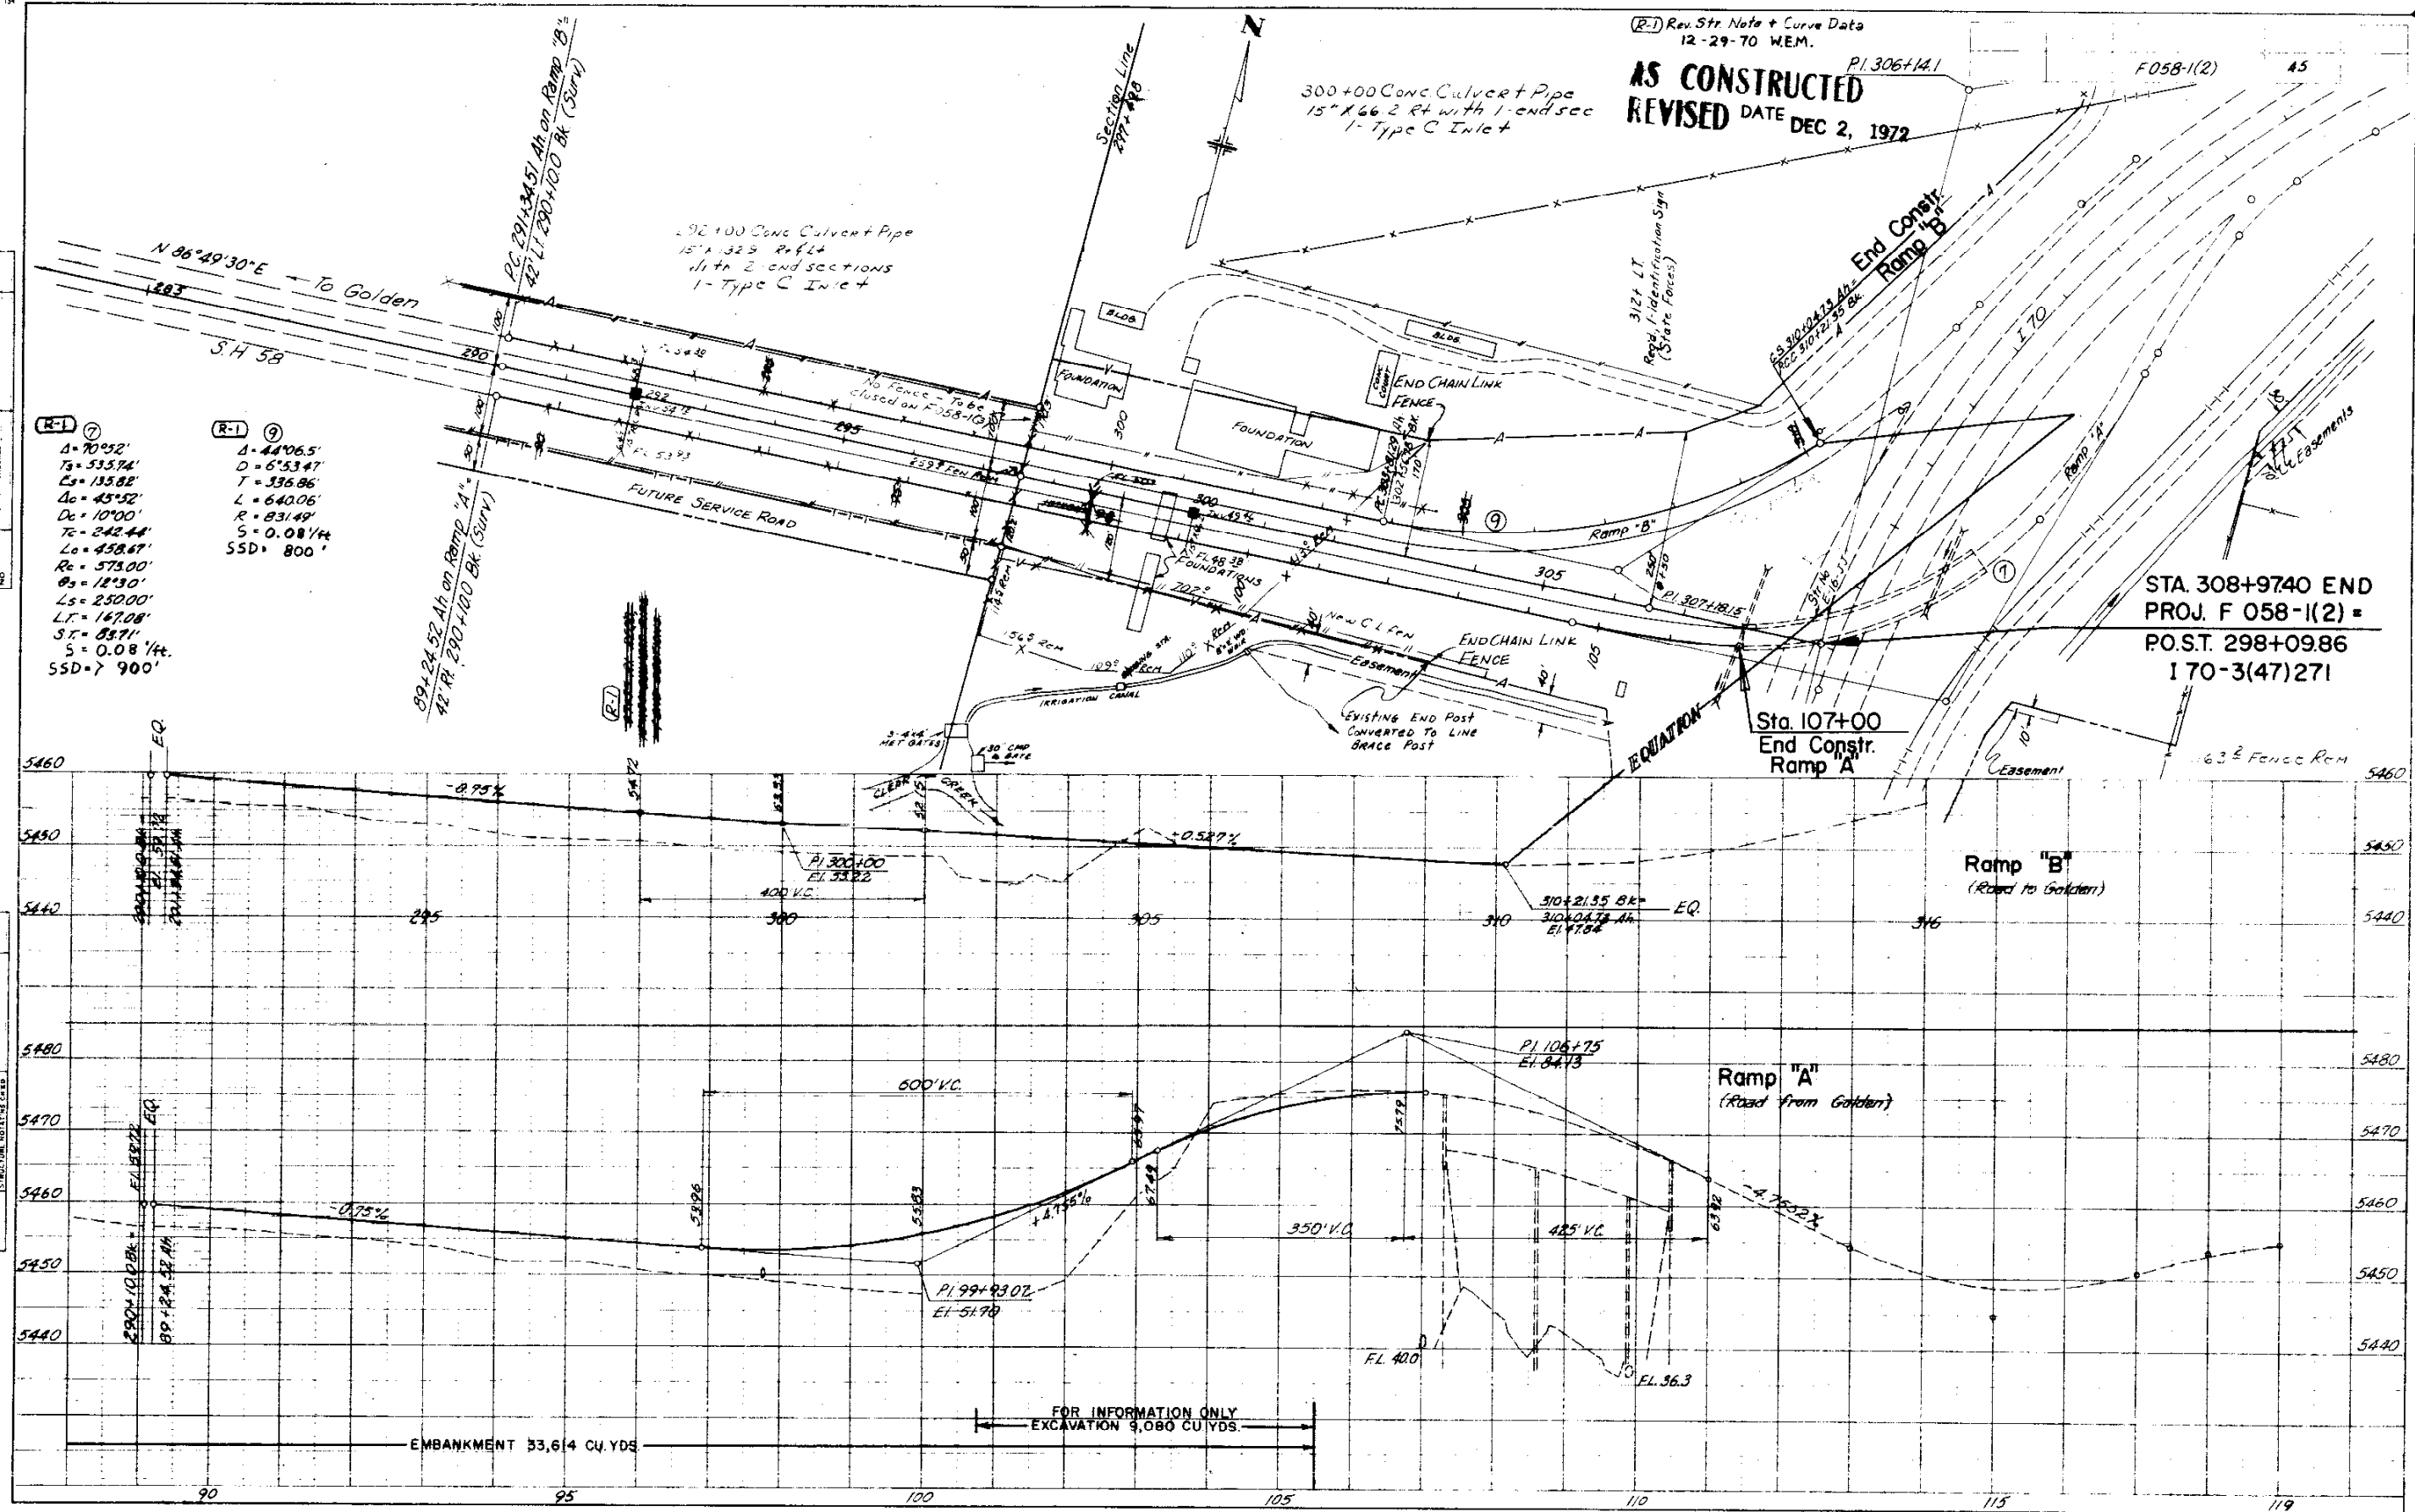

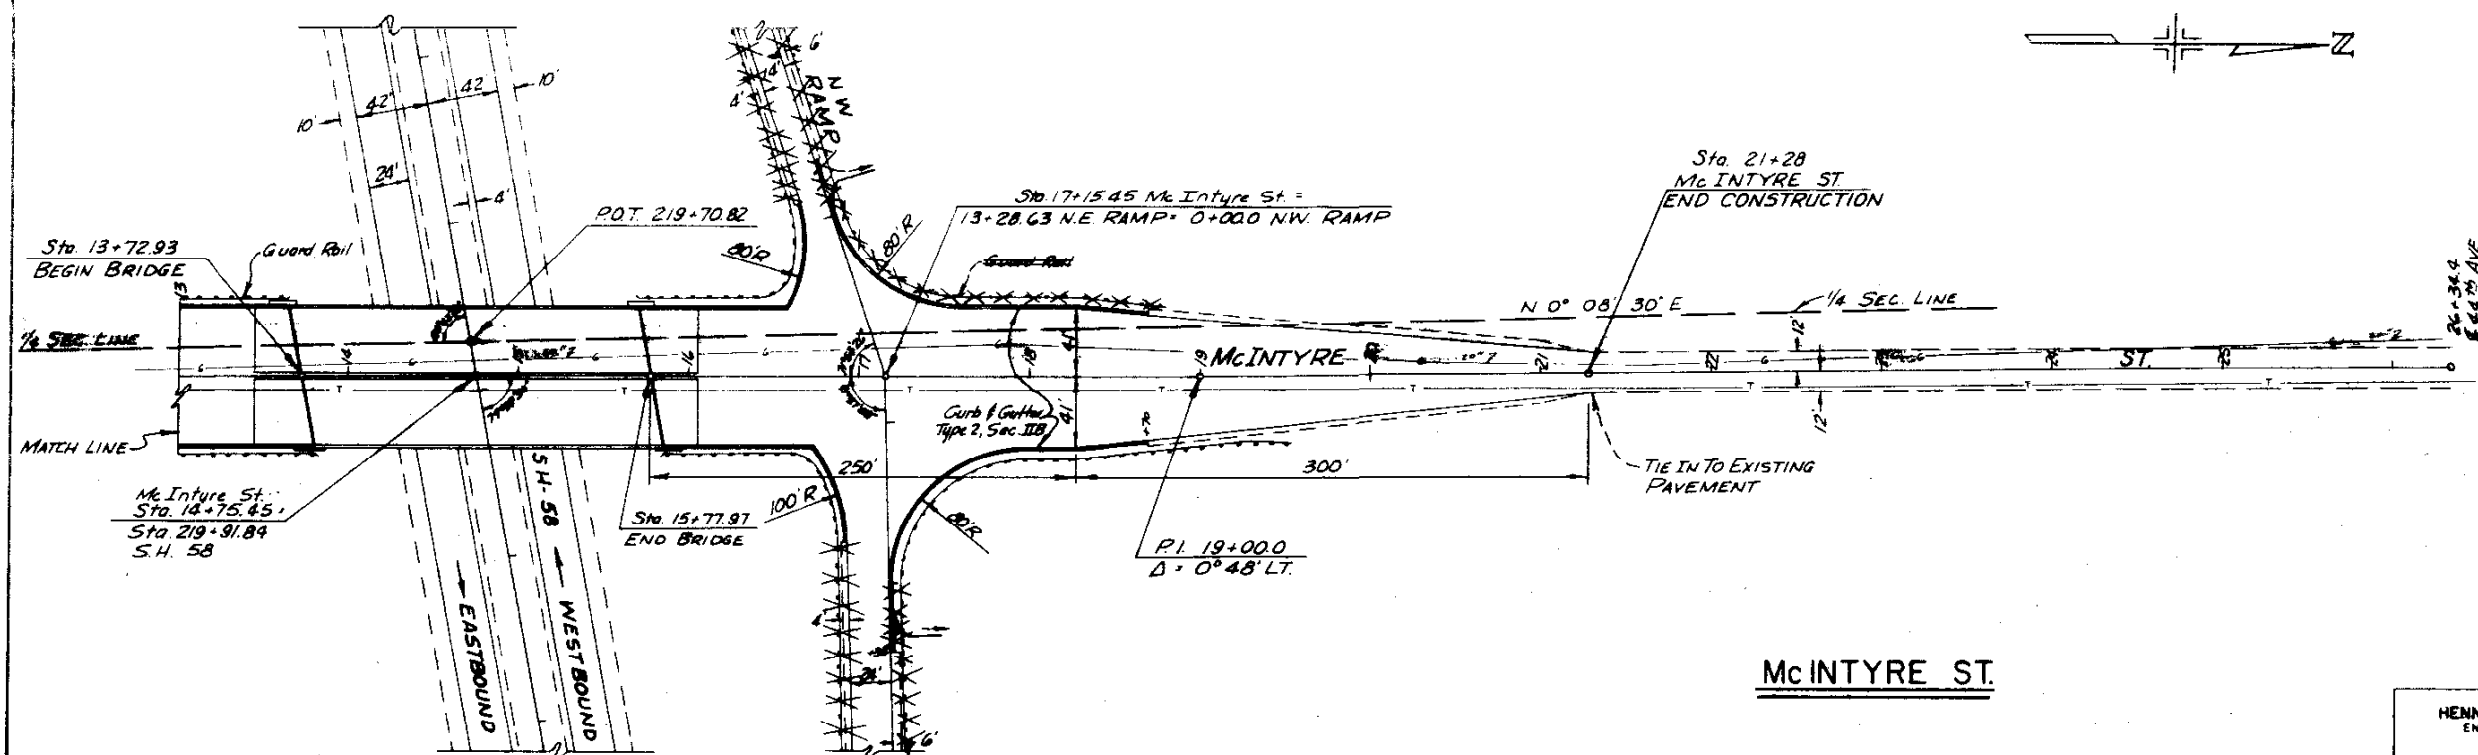
[illegible]

McINTYRE ST.


HENNINGSON, DURHAM & RICHARDSON
ENGINEERS · PLANNERS · CONSULTANTS
CAPITOL LIFE CENTER
DENVER, COLORADO

STANDARD M-203-A-1
(JULY 1, 1965)


FEDERAL ROAD REGION NO.	DIVISION	PROJECT NO.	SHEET NO.
9	COLORADO		

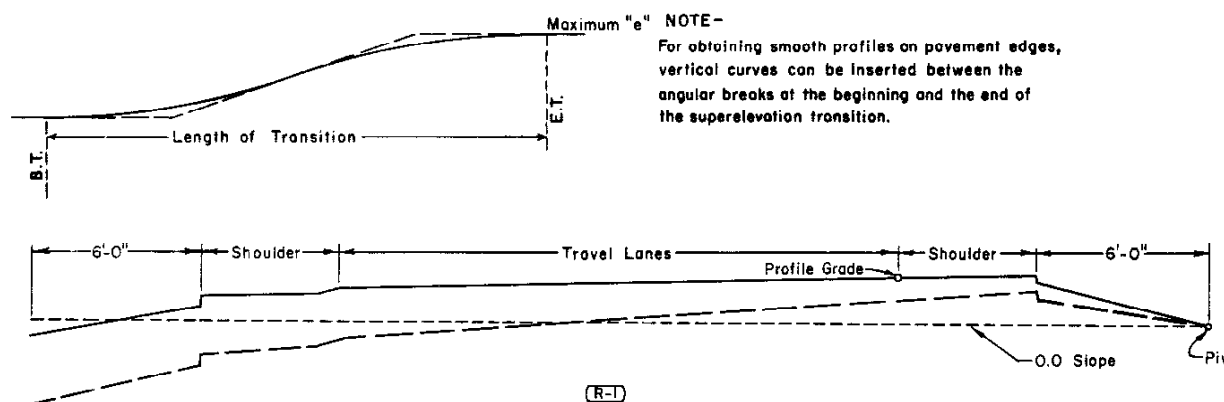


NOTE -
For obtaining smooth profiles on pavement edges, vertical curves can be inserted between the angular breaks at the beginning and the end of the superlevation transition.

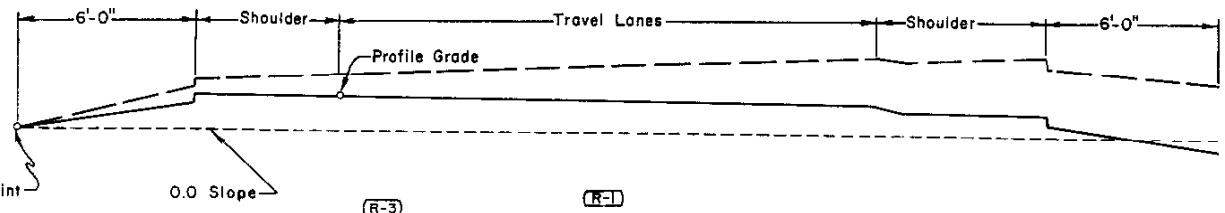

NOTE: Rate of Superlevation is applied from 0.0 slope line.
In case of narrow (non-depressed) median, the normal location of pivot point will be at the centerline of the median.

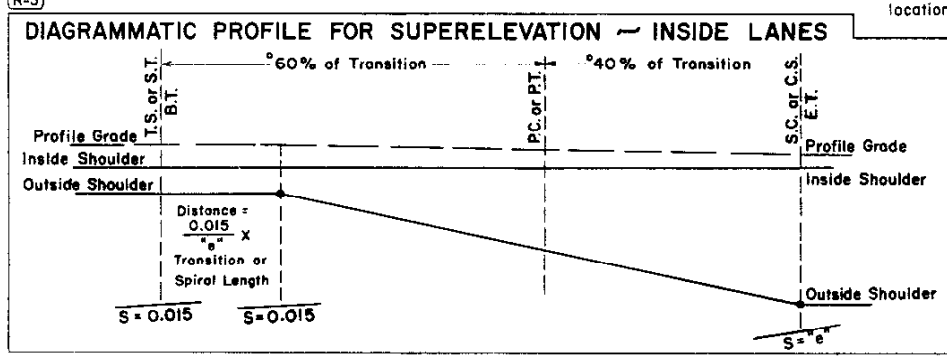

DIAGRAMMATIC PROFILE FOR SUPERELEVATION - OUTSIDE LANES

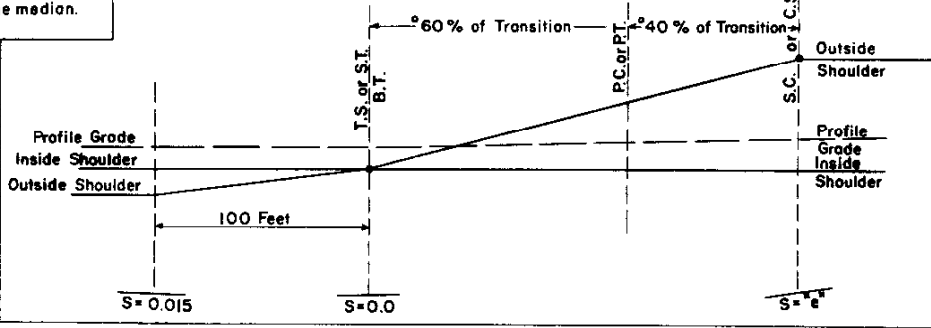

REVISIONS			
1	5-26-67	Supersed Template	M.R.H.
2	7-26-67	Median note	R.S.M.
3	7-30-68	Dpt. Name, Tables, Note	M.R.H.

TABLE 1
SUPERELEVATION RATES FOR FOUR LANE DIVIDED HIGHWAYS

Degree of Curve	Maximum Superlevation = 0.08			Maximum Superlevation = 0.10		
	Super. Rate Ft./Ft.	Maximum Design Speed M.P.H.	Minimum Transition or Spiral Length	Super. Rate Ft./Ft.	Maximum Design Speed M.P.H.	Minimum Transition or Spiral Length
0° 15'	0.015	70	200'	0.015	70	200'
0° 30'	0.015	70	200'	0.015	70	200'
0° 45'	0.021	70	200'	0.020	70	200'
1° 00'	0.028	70	200'	0.028	70	200'
1° 30'	0.042	70	200'	0.042	70	200'
2° 00'	0.056	70	250'	0.055	70	250'
2° 30'	0.069	70	250'	0.069	70	250'
3° 00'	0.077	70	250'	0.083	70	300'
3° 30'	0.080	70	300'	0.096	70	350'
4°	0.080	65	300'	0.100	70	350'
5°	0.080	60	300'	0.100	65	350'
6°	0.080	55	250'	0.100	55	300'
7°	0.080	50	250'	0.100	55	300'
8°	0.080	50	250'	0.100	50	300'
9°	0.080	45	250'	0.100	45	300'
10°	0.080	45	250'	0.100	45	300'
11°	0.080	40	200'	0.100	40	250'
12°	0.080	40	200'	0.100	40	250'
13°	0.080	35	200'	0.100	40	250'
14°	0.080	35	200'	0.100	35	200'
15°	0.080	35	150'	0.100	35	200'
16°	0.080	35	150'	0.100	35	200'
17°	0.080	30	150'	0.100	35	200'
18°	0.080	30	150'	0.100	35	200'
19°	0.080	30	150'	0.100	30	200'
20°	0.080	30	150'	0.100	30	200'
21°	0.080	30	150'	0.100	30	200'
22°	0.080	30	150'	0.100	30	200'
23°	0.080	30	150'	0.100	30	200'
24°	0.080	30	150'	0.100	30	200'
25°	0.080	30	150'	0.100	30	200'

NOTES - Plains Areas use 0.10 Maximum Superlevation Rate.
Mountainous Areas & areas where icing conditions frequently exist, use 0.08 Maximum Superlevation Rate.

TABLE 2 - SUPERELEVATION RATES FOR SPECIAL CASES

Degree of Curve	25 M.P.H.				30 M.P.H.				35 M.P.H.				40 M.P.H.				45 M.P.H.				50 M.P.H.				55 M.P.H.				60 M.P.H.				Degree of Curve
	Required Super. Rate Ft./Ft.		Minimum Length of Transition or Spiral	Required Super. Rate Ft./Ft.		Minimum Length of Transition or Spiral	Required Super. Rate Ft./Ft.		Minimum Length of Transition or Spiral	Required Super. Rate Ft./Ft.		Minimum Length of Transition or Spiral	Required Super. Rate Ft./Ft.		Minimum Length of Transition or Spiral	Required Super. Rate Ft./Ft.		Minimum Length of Transition or Spiral	Required Super. Rate Ft./Ft.		Minimum Length of Transition or Spiral	Required Super. Rate Ft./Ft.		Minimum Length of Transition or Spiral	Required Super. Rate Ft./Ft.		Minimum Length of Transition or Spiral						
3° 30'	NS	NS	0	NS	NS	0	NS	NS	0	NS	NS	0	NS	NS	0	NS	NS	0	NS	NS	0	NS	NS	0	NS	NS	0	3° 30'					
4°	NS	NS	0	NS	NS	0	NS	NS	0	NS	NS	0	NS	NS	0	NS	NS	0	NS	NS	0	NS	NS	0	NS	NS	0	4°					
5°	NS	NS	0	NS	NS	0	NS	NS	0	NS	NS	0	NS	NS	0	NS	NS	0	NS	NS	0	NS	NS	0	NS	NS	0	5°					
6°	NS	NS	0	NS	NS	0	NS	NS	0	NS	NS	0	NS	NS	0	NS	NS	0	NS	NS	0	NS	NS	0	NS	NS	0	6°					
58°	NS	NS	0	NS	NS	0	NS	NS	0	NS	NS	0	NS	NS	0	NS	NS	0	NS	NS	0	NS	NS	0	NS	NS	0	58°					
59°	NS	NS	0	NS	NS	0	NS	NS	0	NS	NS	0	NS</																				

NOTES - Transition or Spiral Lengths are shown in the tables for 4 Lane Divided Highways.
For 6 Lane Divided Highways use 1.2 times the lengths shown, rounded to the nearest 50 feet.

Table 2 data may be used for City Streets & Interchanges.
NS = Normal Slope section.
Do nothing to inside lanes. Superelevate outside lanes at rate shown in tables.

DEPARTMENT OF HIGHWAYS
STATE OF COLORADO
DIVISION OF HIGHWAYS

SUPERELEVATION
OF CURVES
DIVIDED HIGHWAYS

Designed by S.B.L. Approved by S.B.L.
Made by S.B.L. Staff Design Engr.
Checked by L.F.O. Date July 1, 1965


STANDARD SIDE APPROACH ROADS, FLARING, CUT SLOPE TREATMENT & WIDENING AT BRIDGES AND AT CREST OF GRADES

STANDARD M-203-B
(JULY 1, 1965)

FED. ROAD RES. NO.	DIVISION	PROJECT NO.	SHEET NO.
9	COLO.		


REVISIONS			
(R-1)	2-6-68	Median Cross Over	MRH
(R-2)	7-30-68	Dept. Name	MRH
(R-3)	4-1-69	Widening for Guard Rail	MRH
(R-4)	4-27-70	Cut Slope and Note	MRH

GENERAL DETAILS FOR FLARING OF EARTH CUTS, CUT SLOPE TREATMENT & WIDENING AT BRIDGES

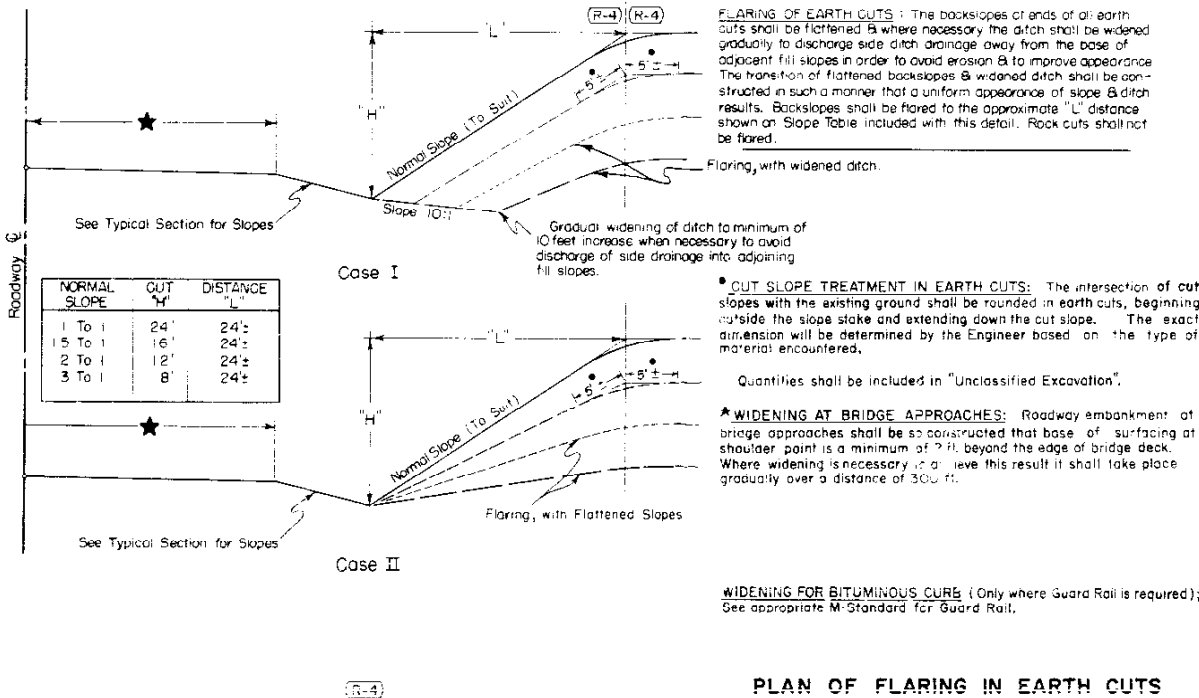


PLAN OF FLARING IN EARTH CUTS

TYPICAL PLANS FOR SIDE APPROACH ROADS AND EMERGENCY MEDIAN CROSS OVERS

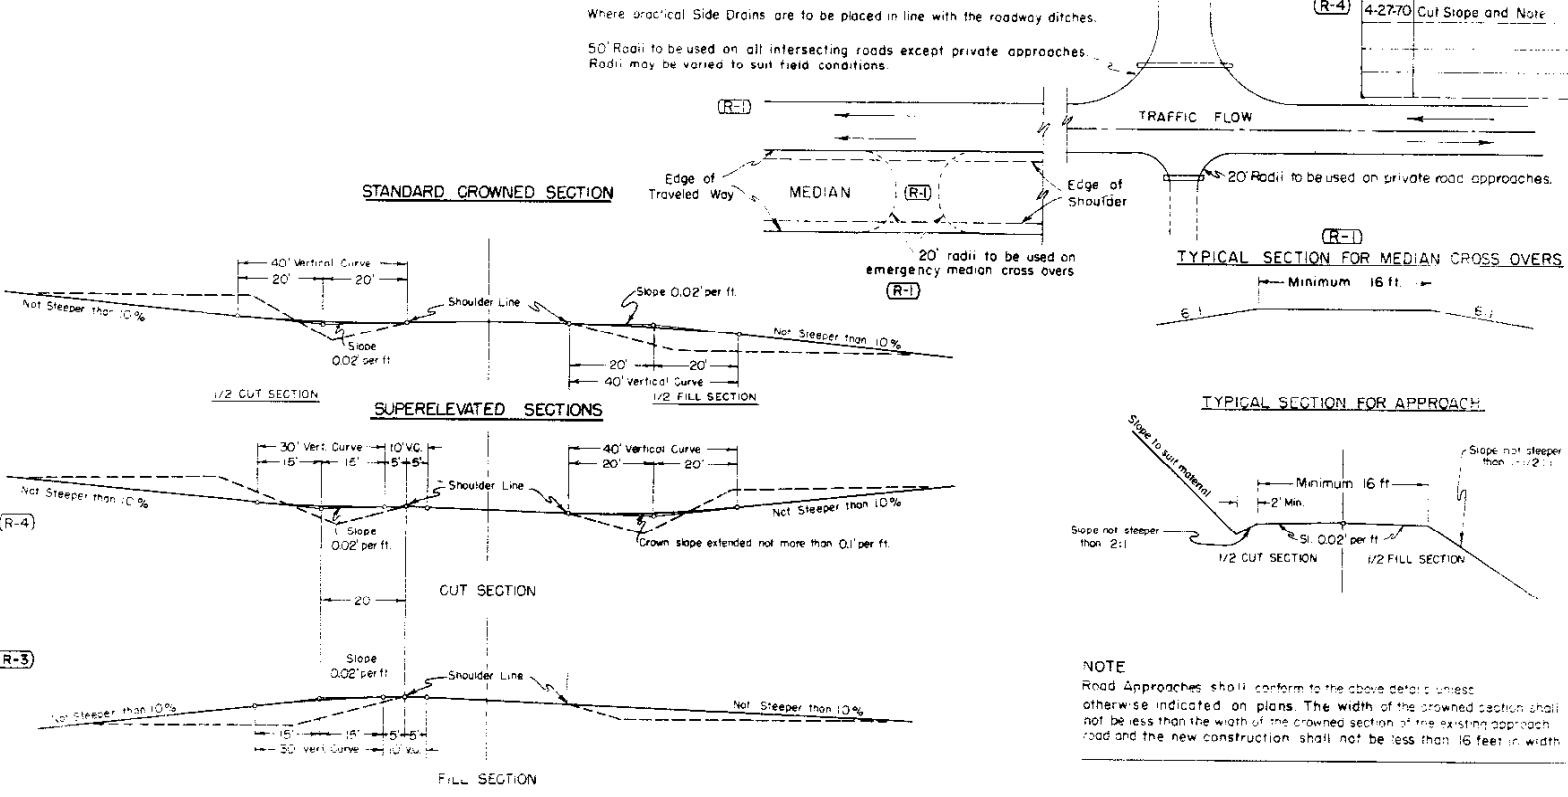

DETAILS FOR DITCH & WIDENED SHOULDERS AT CREST OF GRADES
(TO BE USED ONLY WHERE SIGHT DISTANCE AT CREST OF GRADE IS 600 FT. OR LESS)

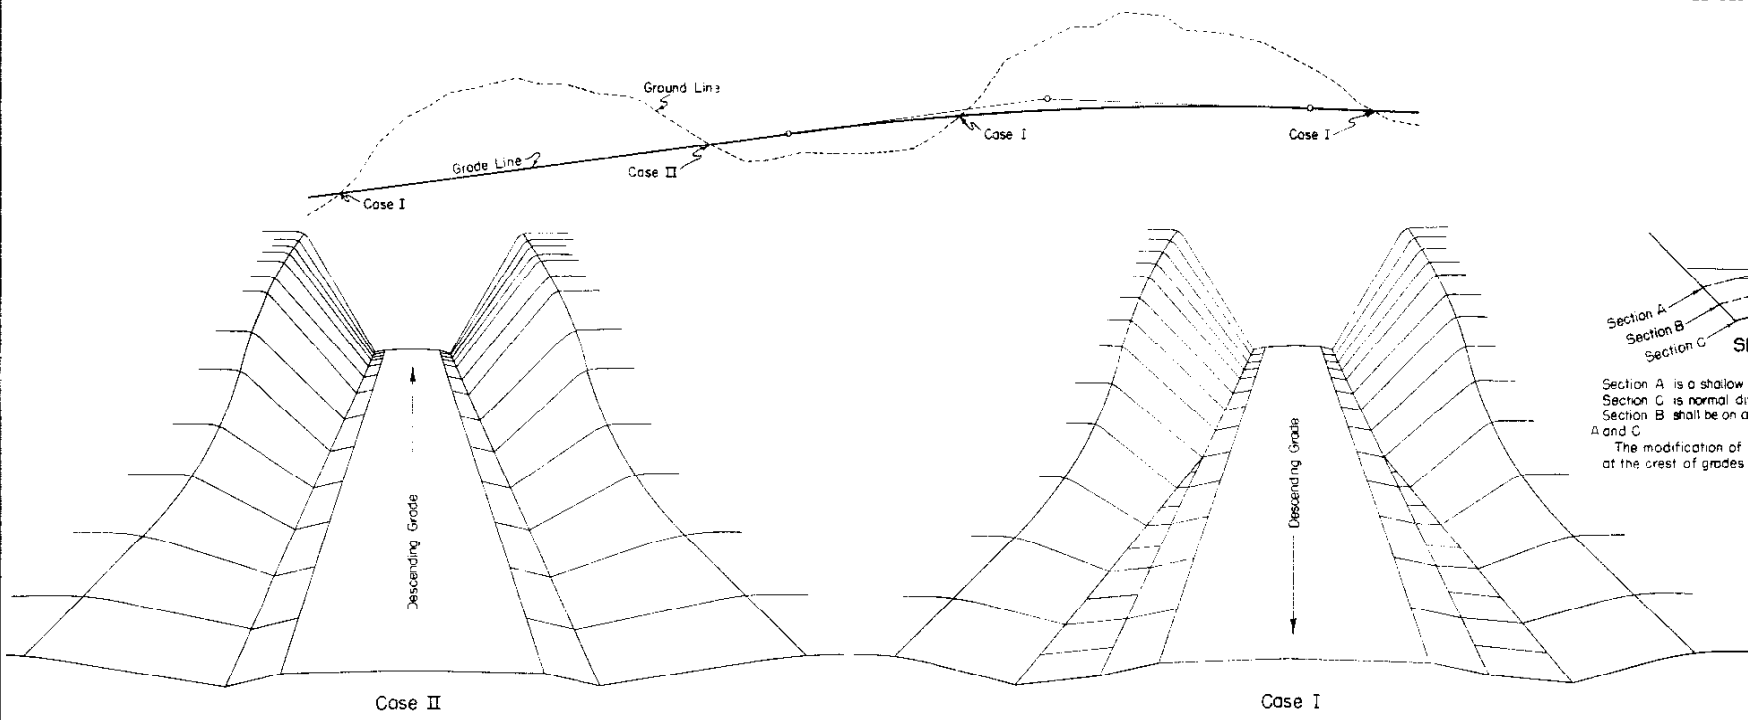

GENERAL NOTES

All work shall be done in accordance with the Standard Specifications applicable to the Project.


All side approach roads to the Project shall be Gravel Surfaced with a 4 inch thickness of Aggregate Base Course extending approximately to the Right of Way Line. Estimated tonnage and class of material required for this operation are shown in the Aggregate Base Course Plan.

The maximum grades shown are to be the limiting grades for all road approaches. Modifications of grades will be permitted where adherence to the grades as shown would cause damage to property or create other unsatisfactory conditions. Grades flatter than the maximum shown are to be used wherever feasible.

DEPARTMENT OF HIGHWAYS
STATE OF COLORADO
DIVISION OF HIGHWAYS
APPROACH ROADS,
FLARING, CUT SLOPE TREATMENT,
BRIDGE & CREST WIDENING


Designed by A. Z. [Signature]
Made by J. M. G. [Signature]
Checked by G. S. [Signature]
Approved by [Signature]
Staff Design Engr.
Date: 3-21-71, 1965.

CONCRETE BOX CULVERTS & WINGWALLS

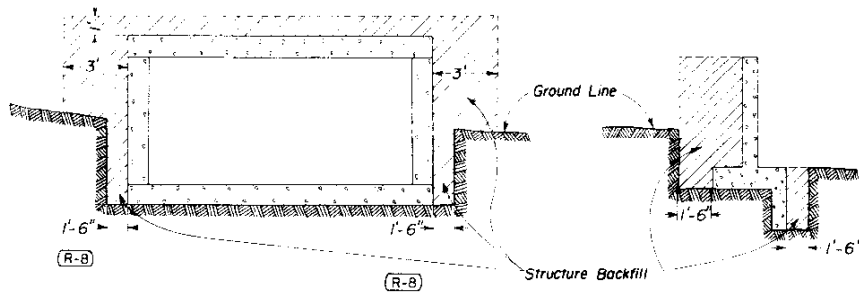


PIERS, ABUTMENTS, RETAINING WALLS ETC.


All material that is to be compacted shall be placed in horizontal layers not more than 6" inches in depth and compacted before the next layer is placed. For Arches, Rigid Frames and Box Culverts the fill shall be brought up uniformly on both sides of the center of structure to avoid stresses in the structure caused by unsymmetrical loading.

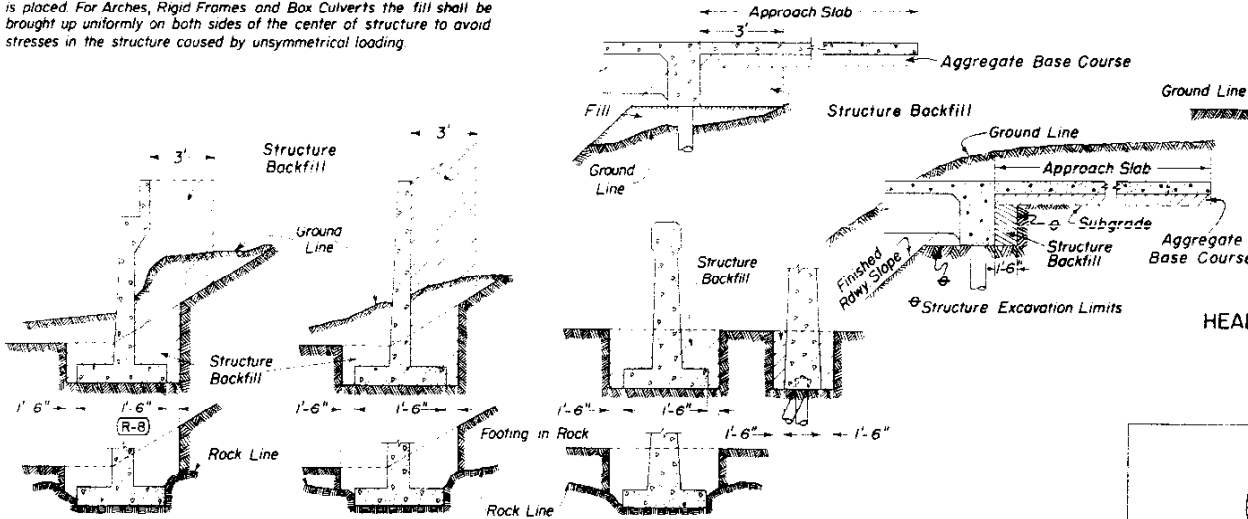


DROP INLETS, DIVISION BOXES, INTERCEPTING HEADWALLS, ETC.

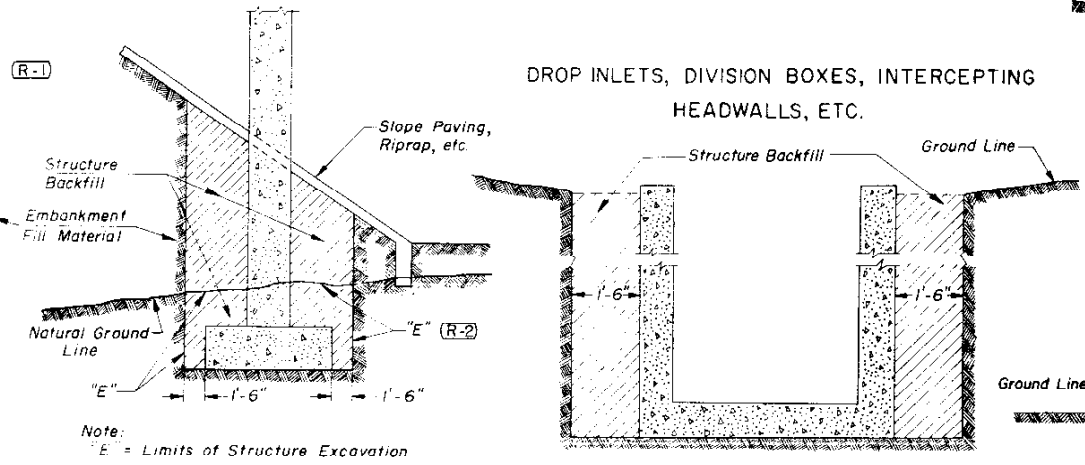


CIRCULAR CONDUIT

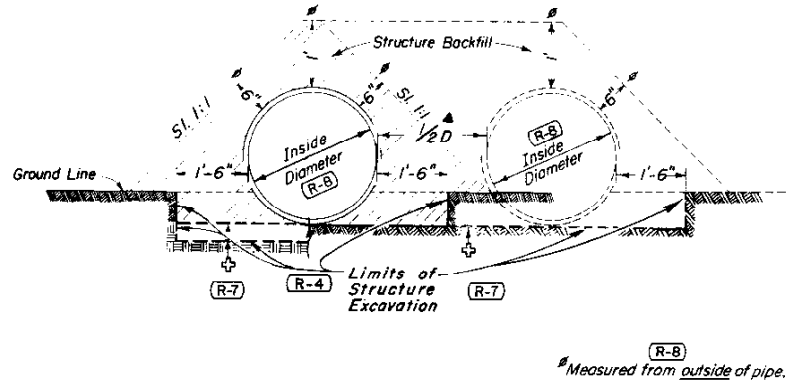

ELLIPTICAL OR ARCH CONDUIT

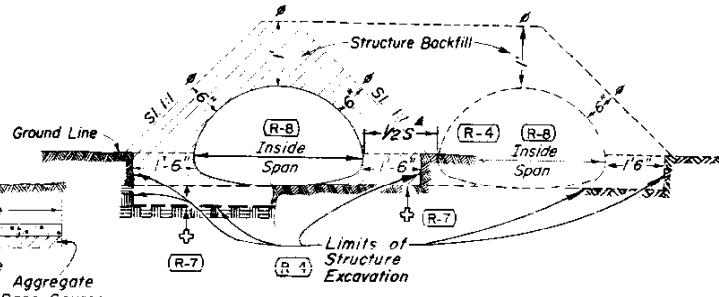

HEADWALLS AND END OF CULVERTS

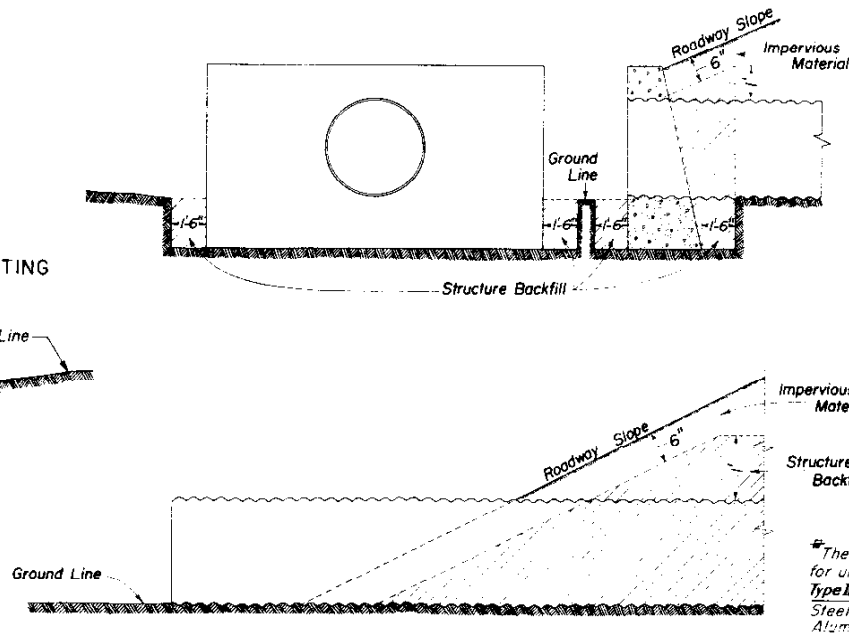


STANDARD M-206-A
(JULY 1, 1965)
(SHEET 1 OF 2 SHEETS)

FED. ROAD REGION NO.	DIVISION	PROJECT NO.	SHEET NO.
9	COLO.		

REVISION		
(R-1)	10-20-65 ADDED PIER VIEW	M.R.H.
(R-2)	12-7-65 STR. EXCV.	M.R.H.
(R-3)	4-25-66 Class 2 Backfill (Trench)	M.R.H.
(R-4)	3-17-67 Conduit, Underdrain, Box	M.R.H.
(R-5)	4-26-68 Limit Str. Excavation	M.R.H.
(R-6)	7-23-68 Dept. Name, Gen'l. Note	M.R.H.
(R-7)	11-1-68 Limit Str. Excavation	M.R.H.
(R-8)	9-23-70 Dimensions & Pipe Gage	M.R.H.

SIPHONS OR CONDUIT IN TRENCH

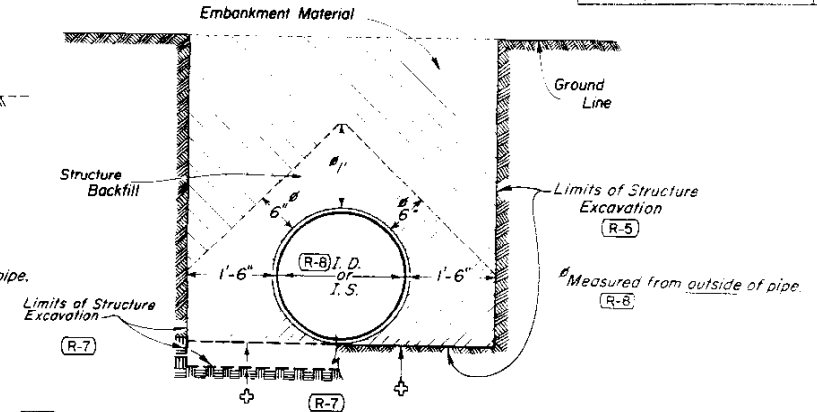


- (R-4) NOTES:
- When two or more conduits are laid side by side they shall be spaced so that the adjacent pipes will be $\frac{1}{2}$ I.D., $\frac{1}{2}$ I.S. or 3 feet apart (including wall thickness), whichever is less. Minimum spacing shall be not less than 1 foot between outside walls of pipe.
 - For additional conduit installation details see M Standards for metal, concrete, or structural plate pipe culverts.
 - Bottom of trench as excavated. For applicable limits of Structure Excavation, see bedding details on standards for metal, reinforced concrete, and structural plate pipe culverts.

GENERAL NOTES

- All work shall be done according to the Standard Specifications applicable to the Project.
- Where the roadway cross section is in fill, excavation for concrete footings (except those in rock or those on piles) and for box culverts shall be done according to the following:
 - Embankment shall be built up and compacted to a point one foot above the bottom of the box or one foot above the bottom of the footing. The trench shall then be excavated to accommodate construction of the box or footing.
- Excavation and backfill patterns different from those indicated on these sheets will be shown elsewhere on the plans.
- Excavation for structure installation shall be classified as "Structure Excavation" unless otherwise shown on plans.

TRENCH FOR PIPE UNDERDRAIN

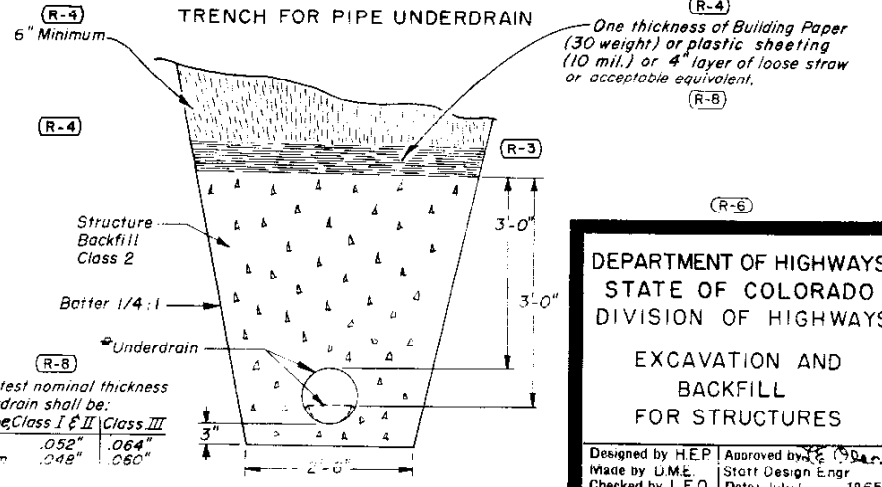

DEPARTMENT OF HIGHWAYS
STATE OF COLORADO
DIVISION OF HIGHWAYS
EXCAVATION AND
BACKFILL
FOR STRUCTURES

Designed by HEP
Made by D.M.E.
Checked by L.E.O.

Approved by [Signature]
Start Design Engr
Date: July 1, 1965


STANDARD M-206-A

(SHEET 2)
(JULY 1, 1965)


FEDERAL ROAD REGION NO.	DIVISION	PROJ. NO.	SHEET NO.	SHEETS
9	COLORADO			

REVISIONS:			
(R-1)	3-17-67	I. D. on Pipe Culvert Span or D.	M.R.H.
(R-2)	4-26-68	Structure Excavation in Fill	M.R.H.
(R-3)	7-23-68	Dept. Name & Detail	M.R.H.
(R-4)	11-1-68	Limit Str. Excavation	M.R.H.
(R-5)	9-23-70	Re-define "D" for Pipe culvert	M.R.H.


STRUCTURE EXCAVATION MEASUREMENT FOR PIPE CULVERTS

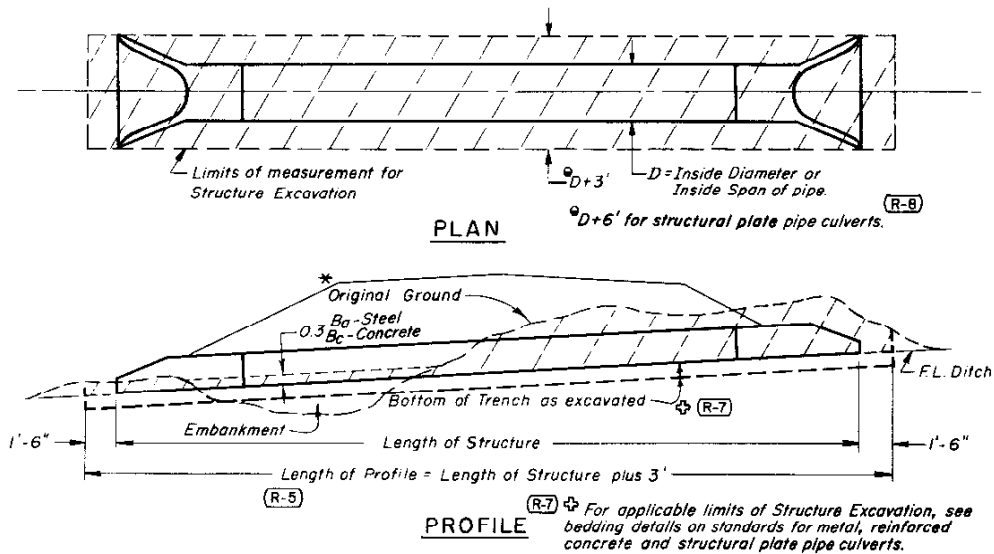


STRUCTURE EXCAVATION MEASUREMENT FOR CONCRETE BOX CULVERTS

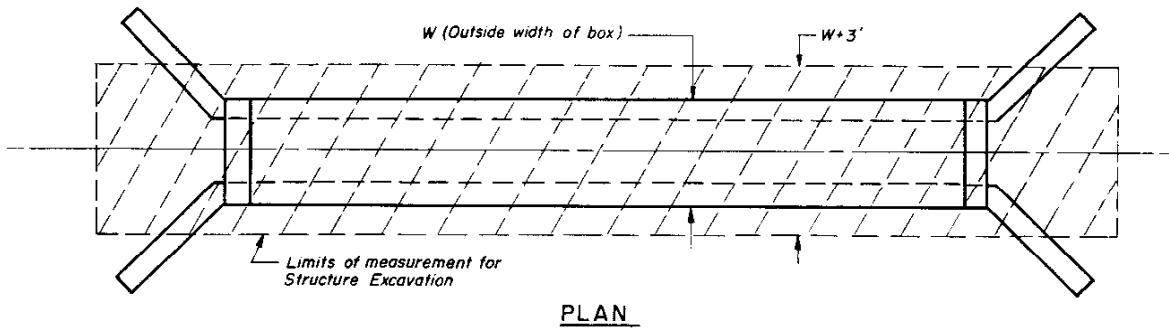

Without Channel Change or Channel Improvement

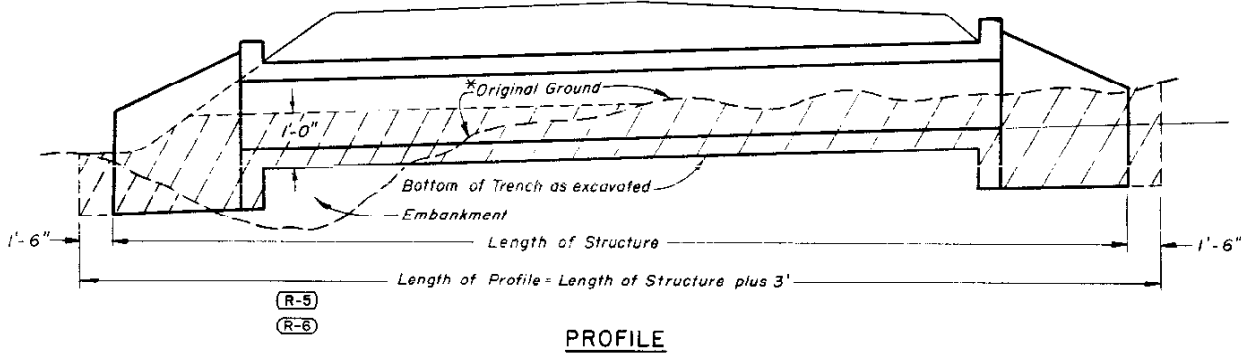


With Channel Change or Channel Improvement

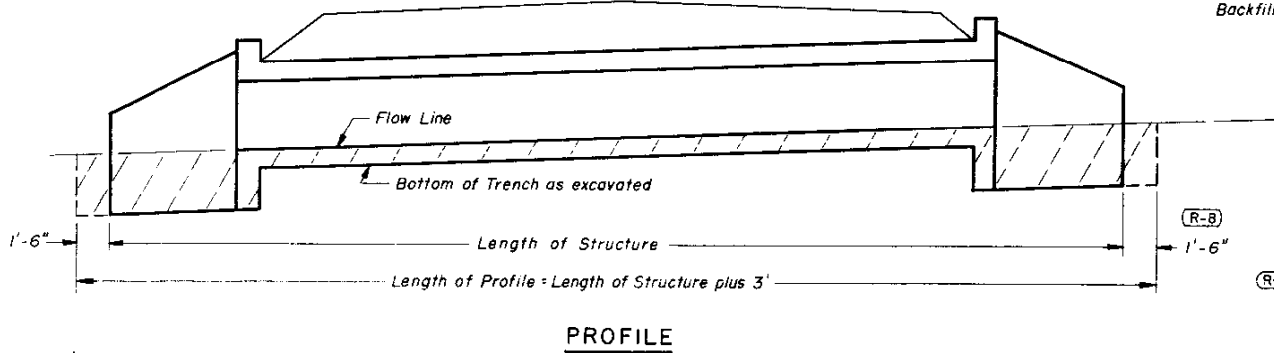

NOTE:
See Sheet 1 for General Notes and Backfilling Details.

STRUCTURE EXCAVATION MEASUREMENT FOR DIVERSION OR DIVISION BOXES

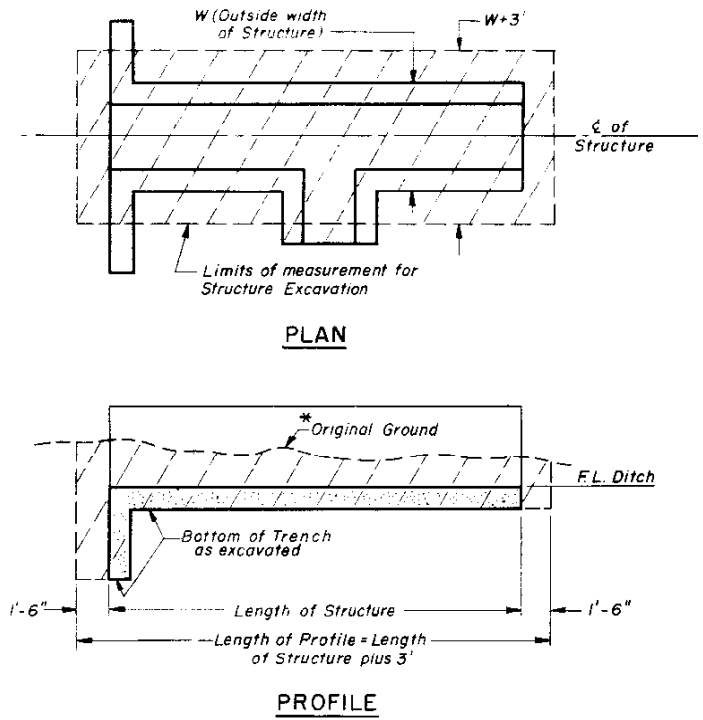

* Along $\bar{C}$ of Structure

Areas to be used for Structure Excavation computations.

DEPARTMENT OF HIGHWAYS
STATE OF COLORADO
DIVISION OF HIGHWAYS

EXCAVATION AND
BACKFILL
FOR STRUCTURES

Designed by: M.R.H. | Approved by: *[Signature]*
Made by: H.P.B. | Staff Design Engr.
Checked by: | Date: July 1, 1965

STANDARD M-500-A
(JULY 1, 1965)

FED. ROAD REG. NO.	DIVISION	PROJECT NO.	SHEET
8	COLO.		1



abcdefghijklmnopqrstuvwxyz

White Background

SAMPLE BRIDGE NUMBER

GENERAL NOTES

SAMPLE YEAR NUMBER

REVISIONS


ALL WORK SHALL BE DONE IN ACCORDANCE WITH THE STANDARD SPECIFICATIONS APPLICABLE TO THE PROJECT.
THE SIZE SHAPE AND SPACING OF THE LETTERS AND FIGURES SHALL BE IN ACCORDANCE WITH THE FULL SIZE SHOWN ON THIS SHEET. ADDITIONAL COPIES OF THIS FULL SIZE SHEET CAN BE OBTAINED FROM THE DEPARTMENT WITHOUT CHARGE.
THE YEAR NUMBERS ARE RECESSED IN CONCRETE 3/8" MINIMUM AS SHOWN INTO THE PANEL OF THE ENDPST ON THE RIGHT HAND SIDE OF EACH BRIDGE END AND INTO THE FACE OF THE DOWNSTREAM HEADWALL OR CULVERTS AS SHOWN ON PLAN DETAILS. NUMBERS TO BE MADE OF WOOD, METAL OR OTHER SUITABLE MATERIAL AND ATTACHED TO THE FORMS BEFORE CONCRETE IS POURED. THE YEAR NUMBER OF EACH STRUCTURE SHALL CORRESPOND WITH THE YEAR IN WHICH THE CONCRETE IS POURED.
THE STRUCTURE NUMBER SHALL BE STENCILED ON THE RIGHT HAND SIDE OF EACH BRIDGE END AS SHOWN ON THIS STANDARD AND AS SPECIFIED WHERE THE STRUCTURE HAS NO END POSTS THE NUMBER SHALL BE PLACED ON A POST ON THE RIGHT HAND SIDE OF THE ROAD AS SHOWN. FOR SIGNS THE NUMBER SHALL BE PLACED ON SIGN POSTS ON THE RIGHT HAND SIDE OF THE ROADWAY.

THE CORRECT NUMBER FOR EACH BRIDGE OR SIGN IS SHOWN ON THE PLANS.
THE NUMBERS FOR MAJOR STRUCTURES OF OVER 20 FEET CLEAR SPAN SHALL BE UPPER CASE LETTERS. THE NUMBERS FOR MINOR STRUCTURES OF 12 TO 20 FEET CLEAR SPAN SHALL BE LOWER CASE LETTERS. SIGN BRIDGES SHALL BE CONSIDERED AS MAJOR STRUCTURES.
A PROPER WHITE BACKGROUND RECTANGULAR IN SHAPE AND EXTENDING THREE INCHES BEYOND THE LIMITS OF THE NUMBER SHALL BE PAINTED WITH TWO COATS OF ACCEPTABLE WHITE PAINT UNLESS AN APPROVED WHITE CONCRETE PAINT IS USED BEFORE PAINTING THE SURFACE MUST BE THOROUGHLY DRIED, CLEANED AND PROPERLY SIZED ON TIMBER HANDRAILS THE WHITE PAINT USED ON THE BRIDGE WILL BE SATISFACTORY.
AFTER THE WHITE BACKGROUND HAS DRIED SUFFICIENTLY, THE CORRECT STRUCTURE NUMBER SHALL BE CAREFULLY STENCILED WITH "EXTERIOR BLACK PAINT" AS SPECIFIED IN SECTION 708 - PAINTS, OR AN ACCEPTABLE EQUIVALENT. THE BRACES OF THE STENCILED LETTERS AND FIGURES SHALL BE CAREFULLY FILLED IN BY HAND TO MAKE SOLID FIGURES.
SUFFICIENT TIME BETWEEN SUCCESSIVE COATS SHALL BE ALLOWED TO PERMIT THORO DRYING.


THE COST OF PAINTING OF STRUCTURE NUMBERS AND FURNISHING AND PLACING POSTS FOR STRUCTURE NUMBERS SHALL BE CONSIDERED SUBSIDIARY WORK AND SHALL BE INCLUDED IN THE ORIGINAL CONTRACT ITEMS AND WILL NOT PAID FOR AS SEPARATE ITEMS.

THE LENGTH OR SPAN OF STRUCTURE SHALL BE MEASURED ALONG CENTER LINE OF ROADWAY. IN CASE OF DOUBLE OR MULTIPLE BOX CULVERTS THE CENTER WALL OR WALLS SHALL BE DISREGARDED AND CLEAR SPAN MEASURED FROM INSIDE OF END WALLS.


IN ADDITION TO THE REQUIREMENTS STATED ABOVE, STRUCTURE NUMBERS FOR HIGHWAYS PASSING UNDER CROSSROADS ARE TO BE PLACED AT THE FOLLOWING POINTS:
1A) FOR STRUCTURES OF 3 OR MORE SPANS, THE STRUCTURE NUMBER SHALL BE STENCILED, FACING TRAFFIC, ON THE OUTSIDE FACE OF THE END COLUMN OF THE RIGHT-HAND PIER.
1B) FOR 2-SPAN STRUCTURES, THE STRUCTURE NUMBER SHALL BE STENCILED, FACING TRAFFIC, ON THE OUTSIDE FACE OF EACH END COLUMN IN THE CENTER PIER.

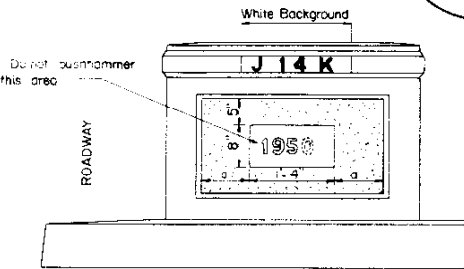


TYPICAL FOR CONCRETE END POST

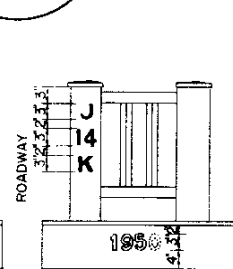


TYPICAL FOR STEEL HANDRAIL END POST

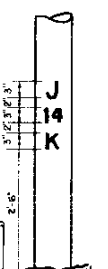

TYPICAL FOR SIGN POSTS

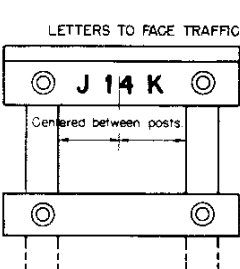

TYPICAL FOR TIMBER WING HANDRAIL

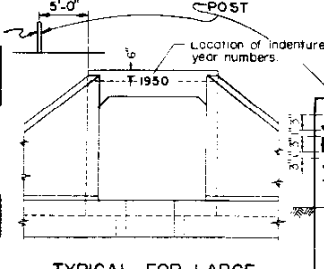

TYPICAL FOR LARGE BOX CULVERTS & STRUCTURES WITHOUT END POSTS

DEPARTMENT OF HIGHWAYS
STATE OF COLORADO

LETTERS AND FIGURES
FOR
STRUCTURE NUMBERS

Designed by _____
Made by _____
Checked by _____
Approved by _____
Bridge Engineer
Date: July 1, 1965

FED ROAD REG NO.	DIVISION	PROJECT NO.	SHEET NO.
9	COLORADO		

Designed by: WWD	Approved by: <i>W.D. Newbold</i>
Made by: WWD	Bridge Engineer
Checked by: T.J.M.	Date: July 17, 1965

SECTION E-E

STANDARD M-601-C

(SHEET 1 OF 2 SHEETS)
(JULY 1, 1965)


FED. ROAD REG. NO.	DIVISION	PROJECT. NO.	SHEET NO.
9	COLO.		

TABLE SHOWING VALUES OF K & M WHEN θ & H ARE GIVEN

θ	α	ϕ	θ	H=2'-0"		H=3'-0"		H=4'-0"		H=5'-0"		H=6'-0"	
				K	M	K	M	K	M	K	M	K	M
45°	45°	67°30'	22°30'	3-3"	6-0"	4-6"	11-0"	6-0"	14-6"	7-6"	18-0"	8-9"	21-0"
60°	30°	60°	30°	3-6"	6-0"	5-0"	8-6"	6-6"	11-3"	8-0"	14-0"	9-3"	16-0"
75°	15°	52°30'	37°30'	3-9"	5-0"	5-6"	7-0"	7-3"	9-3"	8-9"	11-6"	10-0"	13-3"
90°	0°	45°	45°	4-3"	4-3"	6-0"	8-0"	8-0"	10-0"	10-0"	11-6"	11-6"	11-6"
105°	15°	37°30'	52°30'	5-0"	3-9"	7-0"	5-6"	9-3"	7-3"	11-6"	8-9"	13-3"	10-0"
120°	30°	30°	60°	6-0"	3-6"	8-6"	5-0"	11-3"	6-6"	14-0"	8-0"	16-0"	9-3"
135°	45°	22°30'	67°30'	6-0"	3-3"	11-0"	4-6"	14-6"	6-0"	18-0"	7-6"	21-0"	8-9"

θ equals the angle between ϕ of culvert & ϕ of roadway. α equals the angle between ϕ of culvert and a line normal to ϕ of roadway. (R-3)
 ϕ and θ are angles between the wingwall and a line parallel with the ϕ of roadway.

EXAMPLE FOR USING THE ABOVE TABLE: Suppose a stream makes an angle of $\theta = 65^\circ$ with the ϕ of roadway, then from the table, select the nearest angle, $\theta = 60^\circ$, then α, ϕ, θ equal $30^\circ, 60^\circ$ & 30° respectively. If the desired height H of culvert is 6'-0", then K & M will be 9-3" and 16'-0". Locate the WING DETAIL WHEN $H=6'-0"$ on this sheet.

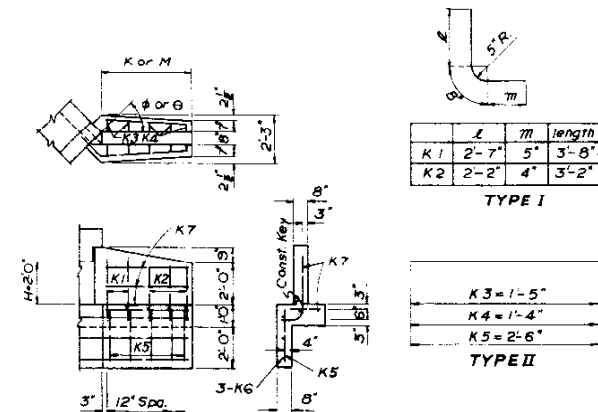

STANDARD M-60I-C

(SHEET 2)
(JULY 1, 1965)


FED. ROAD REG. NO.	DIVISION	PROJECT NO.	SHEET NO.
9	COLO.		

TABLE SHOWING VALUES OF K & M WHEN β & H ARE GIVEN


H	β	ϕ	θ	H=7'-0"		H=8'-0"		H=9'-0"		H=10'-0"	
				K	M	K	M	K	M	K	M
45'	45'	67°30'	22°30'	10'-0"	23'-9"	11'-0"	26'-9"	12'-3"	29'-6"	13'-6"	32'-3"
60'	30'	60°	30°	10'-6"	18'-3"	11'-9"	20'-6"	13'-0"	23'-9"	14'-3"	24'-9"
75'	15'	52°30'	37°30'	11'-6"	15'-0"	13'-0"	16'-9"	14'-3"	18'-6"	15'-9"	20'-3"
90'	0'	45°	45°	13'-0"	13'-0"	14'-6"	14'-6"	16'-0"	16'-0"	17'-6"	17'-6"
105'	15'	37°30'	52°30'	15'-0"	11'-6"	16'-9"	13'-0"	18'-6"	14'-3"	20'-3"	15'-9"
120'	30'	30°	60°	18'-3"	10'-6"	20'-6"	11'-9"	23'-9"	13'-0"	24'-9"	14'-3"
135'	45'	22°30'	67°30'	23'-9"	10'-0"	26'-9"	11'-0"	29'-6"	12'-3"	32'-3"	13'-6"

β equals the angle between ϕ of culvert and ϕ of roadway. α equals the angle between ϕ of culvert and a line normal to ϕ of roadway. ϕ and θ are angles between the wingwall and a line parallel with the ϕ of roadway.

EXAMPLE FOR USING THE ABOVE TABLE: Suppose a stream makes an angle of $\beta=65^\circ$ with ϕ of roadway, then, from the table, select the nearest angle $\beta=60^\circ$, then $\phi=60^\circ$ and $\theta=30^\circ$ respectively. If the desired height "H" of culvert is 8'-0", then "K" & "M" will be 11'-9" & 20'-6". Locate the WING DETAIL WHEN H=8'-0" on this sheet.

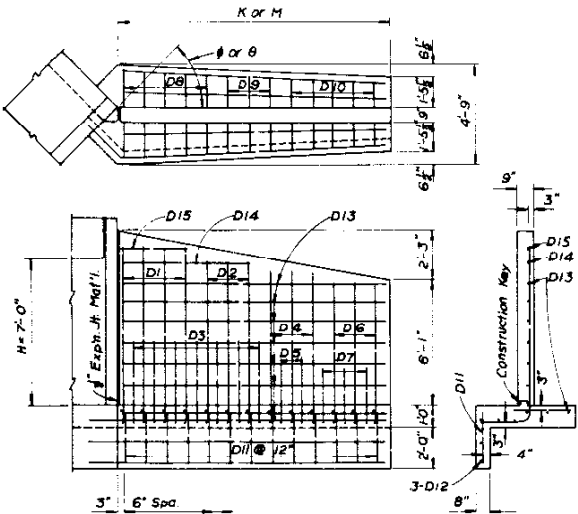

WING DETAIL WHEN H=7'-0"

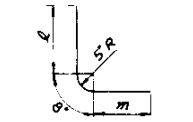

D1	D2	D3	D4	D5	D6	D7	D8	D9	D10	D11
7'-11"	1'-6"	10'-3"	7'-4"	1'-6"	9'-6"	3'-4"	1'-0"	5'-0"	6'-9"	1'-5"
5'-0"	2'-8"	10'-4"	2'-2"	9'-3"	8'-2"	2'-2"	9'-3"	8'-2"	2'-2"	9'-3"


TYPE I

D8=2'-8"	D9=2'-6"	D10=2'-4"	D11=2'-6"
----------	----------	-----------	-----------


TYPE II

When ϕ or θ equals	Number of bars required											Length of bars				Quantities for One Wing	
	D1	D2	D3	D4	D5	D6	D7	D8	D9	D10	D11	3-D12	1-D13	1-D14	1-D15	Concrete Cu Yd	Steel Lb.
	Type I	Type I	Type I	Type I	Type I	Type I	Type I	Type II	Type II	Type II	Type II	Type II	Type II	Type II	Type II		
22°30'	7	6	2	6	6	5	5	8	7	9	24	27'-4"	23'-5"	12'-2"	6'-2"	9.62	592
30°	5	5	9	5	5	4	4	6	6	7	19	20'-11"	17'-11"	9'-2"	4'-2"	7.39	457
37°30'	4	4	8	4	3	3	3	5	5	5	15	17'-2"	14'-8"	7'-2"	3'-2"	6.07	368
45°	4	3	7	3	2	3	3	5	5	5	13	14'-10"	12'-8"	6'-2"	3'-2"	5.26	321
52°30'	3	3	6	3	2	3	3	4	4	4	12	13'-10"	11'-2"	5'-2"	2'-2"	4.66	287
60°	3	3	5	3	3	2	2	4	3	4	11	12'-3"	10'-2"	5'-2"	2'-2"	4.25	262
67°30'	3	3	5	2	3	2	2	4	3	3	10	11'-4"	9'-8"	5'-2"	2'-2"	4.05	245

BAR LIST & QUANTITIES FOR ONE WING WHEN H=7'-0"

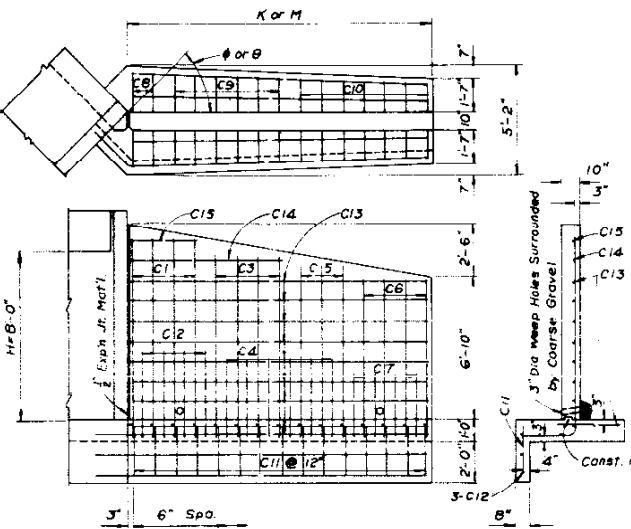

WING DETAIL WHEN H=8'-0"

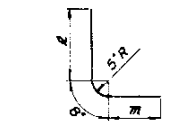

C1	C2	C3	C4	C5	C6	C7	C8	C9	C10	C11
8'-10"	1'-11"	11'-5"	3'-8"	1'-2"	5'-6"	8'-3"	1'-9"	10'-8"	3'-4"	1'-1"
5'-1"	7'-9"	1'-8"	10'-0"	7'-0"	1'-6"	9'-2"	2'-7"	1'-4"	4'-2"	


TYPE I

C8=3'-0"	C9=2'-9"	C10=2'-6"	C11=2'-6"
----------	----------	-----------	-----------

TYPE II

When θ or ϕ equals	Number of bars required										Length of bars				Quantities for One Wing	
	A1	A2	A3	A4	A5	A6	A7	A8	A9	A10	3-A11	13-A12	1-A13	1-A14	Concrete Cu Yd.	Steel Cu Yd.
	Type I	Type I	Type I	Type I	Type I	Type I	Type II	Type II	Type II	Type II	Type II	Type II	Type II	Type II		
22°30'	9	16	8	8	16	8	10	12	11	33	36'-10"	31'-11"	16'-2"	8'-2"	19.74	1224
30°	7	12	6	6	12	6	7	10	8	25	28'-2"	24'-5"	12'-2"	6'-2"	15.14	930
37°30'	6	10	5	5	10	5	6	8	7	21	23'-1"	19'-11"	10'-2"	5'-2"	12.39	775
45°	5	9	4	4	8	4	5	7	6	18	19'-9"	17'-2"	8'-2"	4'-2"	10.71	665
52°30'	5	8	3	3	6	4	5	6	5	16	18'-9"	15'-5"	7'-2"	4'-2"	9.63	597
60°	4	7	3	3	5	4	4	5	4	15	16'-6"	13'-11"	7'-2"	3'-2"	8.72	543
67°30'	4	7	3	3	4	3	4	5	4	14	15'-2"	13'-2"	6'-2"	3'-2"	8.26	515


BAR LIST & QUANTITIES FOR ONE WING WHEN H=10'-0"

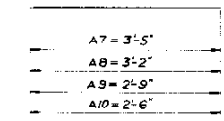


TYPE II

A1	A2	A3	A4	A5	A6	A7	A8	A9	A10
10'-8"	2'-5"	13'-9"	4'-1"	1'-6"	6'-3"	8'-1"	2'-3"	12'-10"	9'-2"
2'-1"	11'-11"	3'-7"	1'-4"	5'-7"	8'-5"	1'-11"	11'-0"		


TYPE I

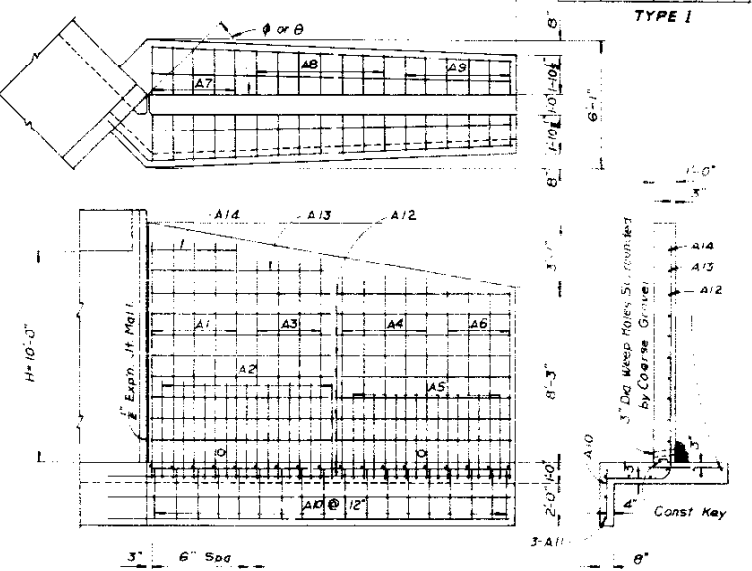

WING DETAIL WHEN H=10'-0"

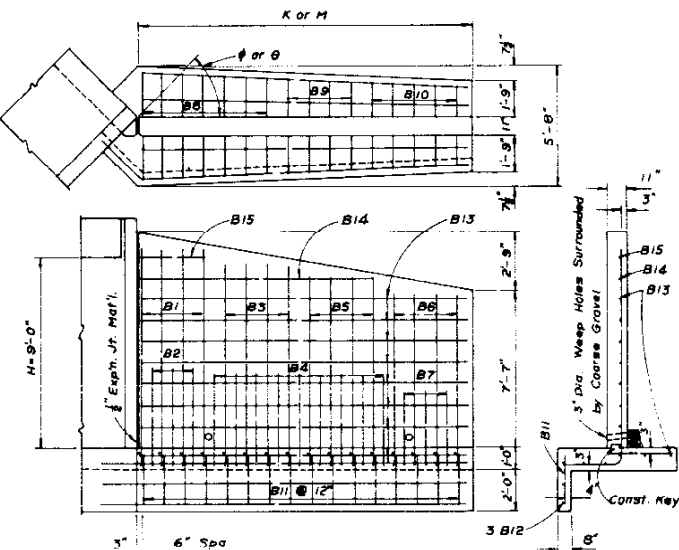

WING DETAIL WHEN H=9'-0"

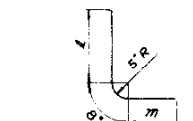

B1	B2	B3	B4	B5	B6	B7	B8	B9	B10	B11
9'-11"	2'-3"	12'-10"	4'-2"	1'-4"	6'-2"	9'-2"	2'-1"	11'-11"	3'-11"	1'-3"
5'-10"	8'-5"	1'-10"	10'-11"	7'-9"	1'-9"	10'-2"	3'-1"	1'-1"	4'-10"	

TYPE I

B8=3'-3"	B9=2'-9"	B10=2'-7"	B11=2'-6"
----------	----------	-----------	-----------

TYPE II

When ϕ or θ equals	Number of bars required											Length of bars				Quantities for One Wing		
	C1 $\frac{1}{2}\phi$ Type I	C2 $\frac{1}{2}\phi$ Type I	C3 $\frac{1}{2}\phi$ Type I	C4 $\frac{1}{2}\phi$ Type I	C5 $\frac{1}{2}\phi$ Type I	C6 $\frac{1}{2}\phi$ Type I	C7 $\frac{1}{2}\phi$ Type I	C8 $\frac{1}{2}\phi$ Type II	C9 $\frac{1}{2}\phi$ Type II	C10 $\frac{1}{2}\phi$ Type II	C11 $\frac{1}{2}\phi$ Type II	3-C12 $\frac{1}{2}\phi$ Type II	1-C13 $\frac{1}{2}\phi$ Type II	1-C14 $\frac{1}{2}\phi$ Type II	1-C15 $\frac{1}{2}\phi$ Type II	Concrete Cu Yd	Steel Lb.	
22°30'	8	7	6	12	6	7	7	5	10	12	27	30'-8"	26'-5"	13'-2"	7'-2"	2.53	779	
30°	6	5	5	10	4	6	5	4	7	10	21	23'-5"	20'-2"	10'-2"	5'-2"	9.60	601	
37°30'	5	4	4	8	4	4	4	3	6	8	17	19'-1"	16'-5"	8'-2"	4'-2"	7.84	487	
45°	4	4	4	6	3	4	4	2	6	7	15	16'-6"	14'-2"	7'-2"	3'-2"	6.79	424	
52°30'	4	3	3	6	3	3	3	2	5	6	13	15'-6"	12'-8"	6'-2"	3'-2"	6.08	374	
60°	4	3	2	6	3	3	2	2	4	6	12	13'-8"	11'-5"	5'-2"	3'-2"	5.50	341	
67°30'	3	3	3	5	2	3	2	2	4	5	11	12'-5"	10'-8"	5'-2"	2'-2"	5.15	315	

BAR LIST & QUANTITIES FOR ONE WING WHEN H=8'-0"

When θ equals	Number of bars required											Length of bars					Quantities for	
	B1	B2	B3	B4	B5	B6	B7	B8	B9	B10	B11	3-B12	1-B13	1-B14	1-B15	Ote	Wing	
	$\frac{1}{2}\phi$	$\frac{1}{2}\phi$	$\frac{1}{2}\phi$	$\frac{1}{2}\phi$	$\frac{1}{2}\phi$	$\frac{1}{2}\phi$	$\frac{1}{2}\phi$	$\frac{1}{2}\phi$	$\frac{1}{2}\phi$	$\frac{1}{2}\phi$	$\frac{1}{2}\phi$	Type II	Type II	Type II	Type II	Concrete	Steel	
	Type I	Type I	Type I	Type I	Type I	Type I	Type I	Type II	Type II	Type II	Type II	Type II	Type II	Type II	Type II	Cu Yd.	Lb.	
22°30'	7	6	8	16	8	7	7	13	8	8	30	33'-9"	29'-2"	22'-2"	6'-2"	15.93	930	
30°	5	5	7	13	6	6	5	10	7	7	24	27'-0"	23'-5"	17'-2"	4'-2"	12.82	742	
37°30'	4	4	5	10	5	5	4	8	5	6	19	21'-1"	18'-2"	13'-2"	3'-2"	9.98	580	
45°	4	3	4	5	4	4	4	3	7	4	16	18'-2"	15'-8"	11'-2"	3'-2"	8.63	495	
52°30'	3	3	4	6	4	4	3	6	4	5	15	17'-0"	13'-11"	10'-2"	2'-2"	7.69	453	
60°	3	3	4	7	3	3	2	6	3	4	13	15'-1"	12'-8"	9'-2"	2'-2"	7.01	406	
67°30'	3	2	3	7	4	3	3	5	3	5	13	13'-9"	11'-11"	9'-2"	2'-2"	6.61	385	

BAR LIST & QUANTITIES FOR ONE WING WHEN H=9'-0"

REVISIONS		
R-2	7-15-68	Dept. Name M.R.H.
R-3	10-25-68	Table Note M.R.H.

DEPARTMENT OF HIGHWAYS
STATE OF COLORADO
DIVISION OF HIGHWAYS
WINGWALLS FOR
CONCRETE BOX CULVERT
4:1 SIDE SLOPES

Designed by: J. D. P.
Made by: W. M. R. L.
Checked by: J. D. P.
Approved by: J. D. P.
Bridge Engineer
Date: July 1, 1965


STRUCTURE NO.

STANDARD M-603-CA




(NOVEMBER 10, 1967)

FEDERAL ROAD DISTRICT NO.	DIVISION	PROJ. NO.	SHEET NO.	TOTAL SHEETS
9	COLORADO			

REVISIONS	
(R-1)	4-19-68 Welding—Conc. Arch, Ellipt. Con. Notes M.R.H.
(R-2)	7-23-68 Dept. Name M.R.H.

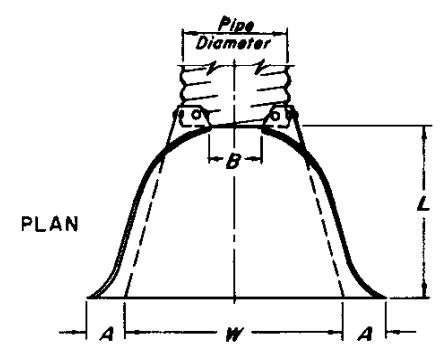


PIPE DIAM. in.	GAGE	D I M E N S I O N S					
		A (1"±) in.	B (Max.) in.	H (1"±) in.	L (11/2"±) in.	N (2"±) in.	T in.
12	16	6	6	6	21	24	34
15	16	7	8	6	26	30	40
18	16	8	10	6	31	36	46
21	16	9	12	6	36	42	52
24	16	10	13	6	41	48	58
30	14	12	16	8	51	60	70
36	14	14	19	9	60	72	84
42	12	16	22	11	69	84	106
48	12	18	27	12	78	90	112
54	12	18	30	12	84	102	124
60	12	18	33	12	87	114	136
66	12	18	36	12	87	120	142
72	12	18	39	12	87	126	148
78	12	18	42	12	87	132	154
84	12	18	45	12	87	138	160

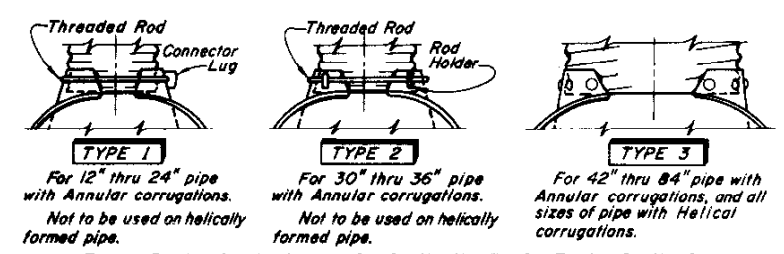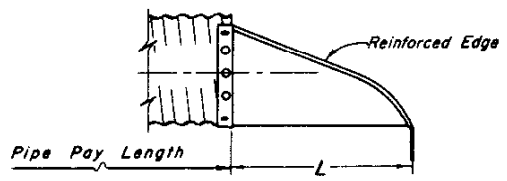
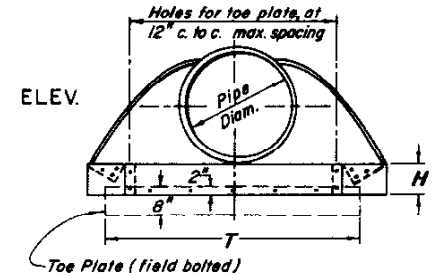


NOTE:
Type 3 connections shall consist of an end section shop attached to a minimum 2 ft. of pipe with galvanized rivets or bolts, or by welding. (R-1)

END SECTION AND CONNECTION DETAILS FOR ROUND CORRUGATED STEEL PIPE CULVERTS

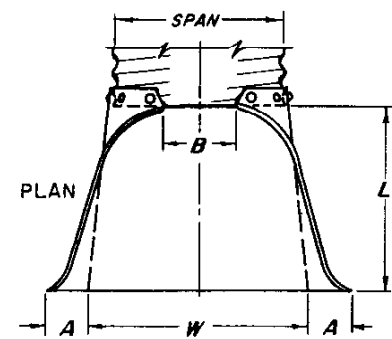


PIPE ARCH SPAN - RISE in. in.	GAGE	D I M E N S I O N S					
		A (1"±) in.	B (Max.) in.	H (1"±) in.	L (11/2"±) in.	N (2"±) in.	T in.
18 x 11	16	7	9	6	19	30	40
22 x 13	16	7	10	6	23	36	46
25 x 16	16	8	12	6	28	42	52
29 x 18	16	9	14	6	32	48	58
36 x 22	14	10	16	6	39	60	70
43 x 27	14	12	18	8	46	75	85
50 x 31	12	13	21	9	53	85	103
58 x 36	12	18	26	12	63	90	108
65 x 40	12	18	30	12	70	102	120
72 x 44	12	18	33	12	77	114	132

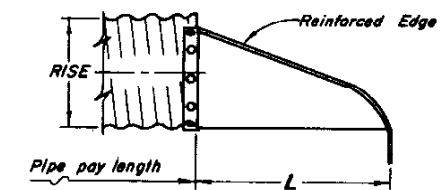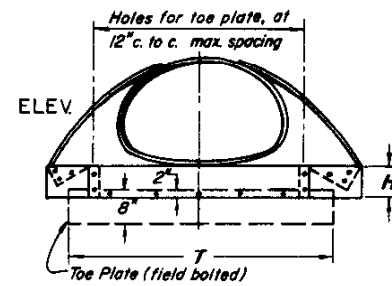


NOTE:
End sections for pipe arches shall be shop attached to a minimum 2 ft. of pipe with galvanized rivets or bolts, or by welding. (R-1)

END SECTION AND CONNECTION DETAIL FOR CORRUGATED STEEL PIPE ARCH CULVERT


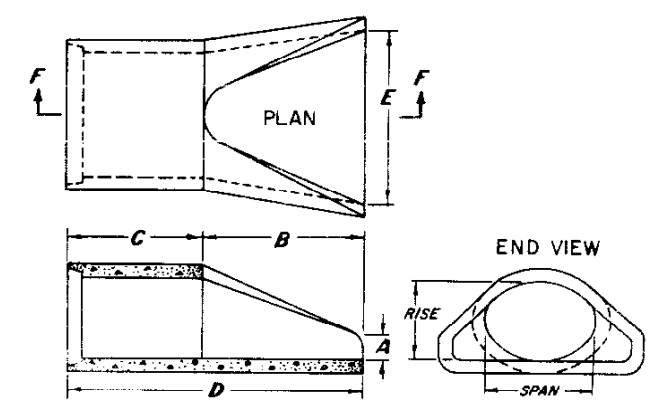


EQUIVALENT CIRCULAR DIAM. (inches)	NOMINAL (in.) SPAN	RISE	D I M E N S I O N S (inches)				
			A	B	C	D	E
24	30	19	8 1/2	39	33	72	48
30	38	24	9 1/2	54	18	72	60
36	45	29	11 1/4	60	24	84	72
42	53	34	15 3/4	60	36	96	78
48	60	38	21	60	36	96	84
54	68	43	25 1/4	60	36	96	90
60	76	48	30	60	36	96	96


END SECTION FOR REINFORCED CONCRETE ELLIPTICAL PIPE (R-1)

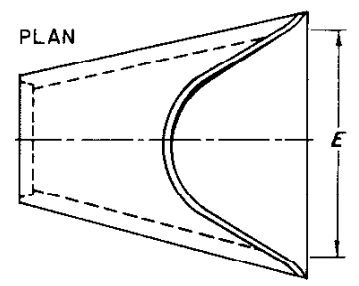


PIPE I. D. in.	D I M E N S I O N S				
	A in.	B in.	C in.	D in.	E in.
12	5 1/2	23	49	72	24
15	7	26	47	73	29
18	11 1/2	26	48	74	36
24	12	43	54	97	48
30	17	53	43	96	60
36	18	60	37	97	71
42	24	61	36	97	78
48	28	70	28	98	84
54	27	65	35	100	90
60	36	58	40	98	96
72	34 1/2	75	21	96	108

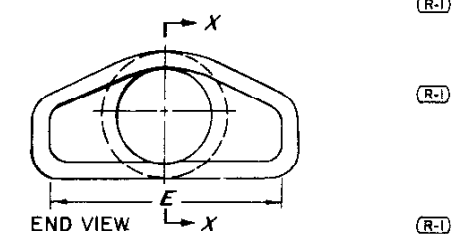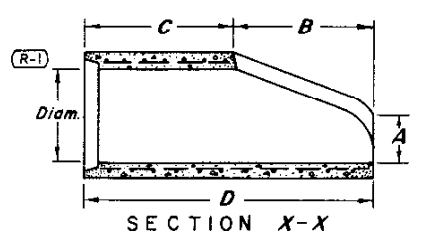

END SECTION FOR REINFORCED CONCRETE CIRCULAR PIPE (R-1)

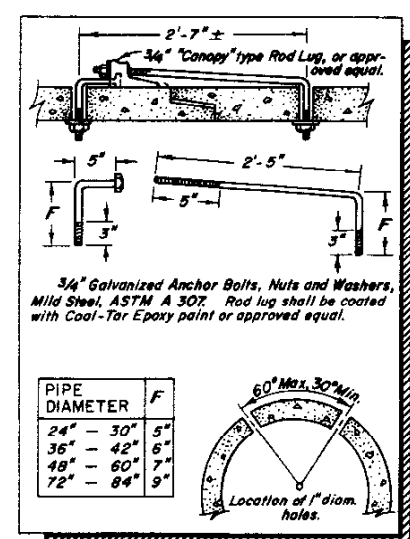

CONCRETE JOINT FASTENER
NOTE:
This assembly, or approved equal, shall be used for joining sections where shown on plans.

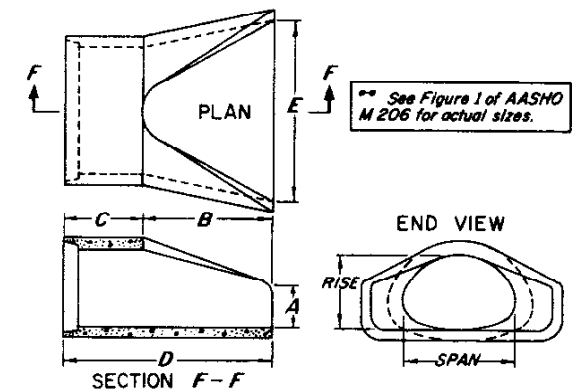

EQUIVALENT CIRCULAR DIAM. (inches)	NOMINAL (in.) SPAN	RISE	D I M E N S I O N S (inches)				
			A	B	C	D	E
24	29	18	8 1/2	39	33	72	48
30	36	22	9 1/2	50	46	96	60
36	43	27	11 1/4	60	36	96	72
42	50	31	15 3/4	60	36	96	78
48	58	36	21	60	36	96	84
54	65	40	25 1/2	60	36	96	90
60	72	44	31	60	36	96	96
72	88	54	31	60	39	99	120

END SECTION FOR REINFORCED CONCRETE ARCH PIPE (R-1)

DESIGNED BY M. R. H. APPROVED BY M. R. H.
MADE BY J. R. G. START DESIGN ENGINEER (5/5/7)
CHECKED BY R. S. M. DATE: NOVEMBER 10, 1967

STANDARD M-603-RC

(MARCH 20, 1967)

FEDERAL ROAD REGION NO.	DIVISION	PROJ. NO.	SHEET NO.	SHEET'S
9	COLORADO			

REVISIONS			
NO.	DATE	DESCRIPTION	BY
(R-1)	4-19-68	Add Arch and Elliptical Pipe Gen. Notes	M.R.H.
(R-2)	7-23-68	Dept. Name	M.R.H.


(R-1)
NOTE: B_c is the outside dimension for diameter, span or rise.

DIMENSIONS FOR REINFORCED CONCRETE PIPE

(For Information Only)

CIRCULAR				ARCH				(VE) VERTICAL ELLIPTICAL				(HE) HORIZONTAL ELLIPTICAL				
A PIPE SIZE B_o (In. I.D.)	Wall Thickness (Inches)	0.3 B_c (Outside Dia.) (Feet)	ϕ Span (Inches)	ϕ Rise (Inches)	Wall Thickness (Inches)	0.3 Outside Rise (Feet)	Span (Inches)	Rise (Inches)	Wall Thickness (Inches)	0.3 Outside Rise (Feet)	Span (Inches)	Rise (Inches)	Wall Thickness (Inches)	0.3 Outside Rise (Feet)		
12	2	0.40														
15	2-1/4	0.49	18	11	2-1/4	0.39										
18	2-1/2	0.58	22	13	2-1/2	0.45							23	14	2-3/4	0.49
21	2-3/4	0.66	25	16	2-3/4	0.54										
24	3	0.75	29	18	3	0.60							30	19	3-1/4	0.66
27	3-1/4	0.84											34	22	3-1/2	0.73
30	3-1/2	0.92	36	22	3-1/2	0.73							38	24	3-3/4	0.79
33	3-3/4	1.01											42	27	3-3/4	0.86
36	4	1.10	43	27	4	0.88	29	45	4-1/2	1.35	45	29	4-1/2	0.95		
39																
42	4-1/2	1.28	50	31	4-1/2	1.00	32	49	4-3/4	1.46	49	32	4-3/4	1.04		
48	5	1.45	58	36	5	1.15	34	53	5	1.58	53	34	5	1.10		
							38	60	5-1/2	1.78	60	38	5-1/2	1.23		
54	5-1/2	1.62	65	40	5-1/2	1.28	43	68	6	2.00	68	43	6	1.38		
60	6	1.80	72	44	6	1.40	48	76	6-1/2	2.23	76	48	6-1/2	1.53		
66	6-1/2	1.97					53	83	7	2.43	83	53	7	1.68		
72	7	2.15	88	54	7	1.70	58	91	7-1/2	2.65	91	58	7-1/2	1.83		
78	7-1/2	2.32					63	98	8	2.85	98	63	8	1.98		
84	8	2.50	102	62	8	1.95	68	106	8-1/2	3.08	106	68	8-1/2	2.13		
90	8-1/2	2.68	115	72	8-1/2	2.23	72	113	9	3.28	113	72	9	2.25		
96	9	2.85	122	77	9	2.38	77	121	9-1/2	3.50	121	77	9-1/2	2.40		
102	9-1/2	3.02					82	128	9-3/4	3.69	128	82	9-3/4	2.54		
108	10	3.20	138	87	10	2.68	87	136	10	3.90	136	87	10	2.68		


Also equivalent round dimension for Arch and Elliptical pipe.
 ϕ Sizes shown are for identification purposes only. Actual sizes shall conform to those listed in Fig. 1 of ASTM Spec. C 506.

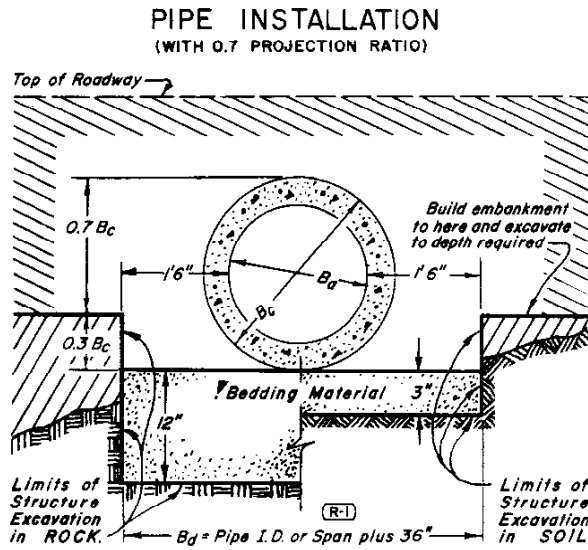

IMPERFECT TRENCH PIPE INSTALLATION


(WITH 0.7 PROJECTION RATIO)

Complete embankment to here, then excavate and fill as shown.

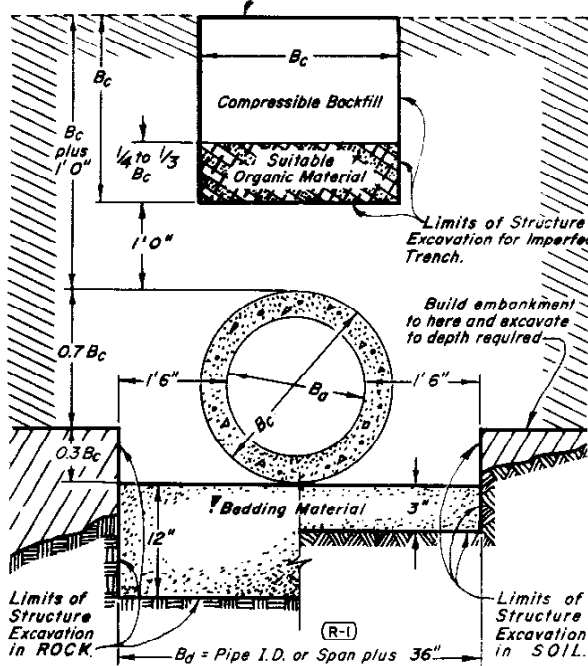


Bedding Material for SOIL shall be 3" loose thickness Structure Backfill Class 3.
 Bedding Material for ROCK shall be 12" loose thickness Structure Backfill Class 1.

CONCRETE CULVERT WITH END SECTIONS

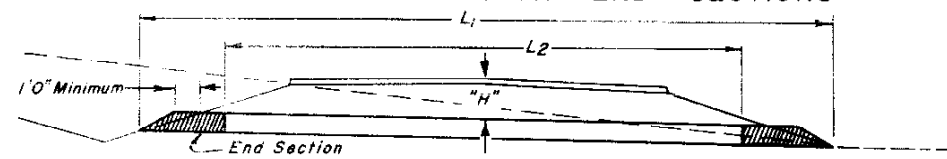

CONCRETE CULVERT WITHOUT END SECTIONS

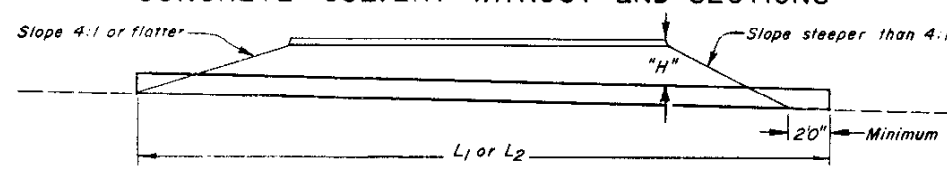

"H" = Maximum height of fill over top of Culvert, including pavement.
 L_1 = Length of Culvert to be measured when placed in accordance with Section 617.
 L_2 = Length of Pipe to be measured when placed in accordance with Section 603.

(R-1) Length of extension, when placed in accordance with Section 617, shall be the actual number of feet of new culvert required.

HEIGHTS OF FILL OVER REINFORCED CONCRETE PIPE

ALL SIZES

TYPE OF PIPE	HEIGHT OF FILL OVER TOP OF PIPE IN FEET					
	CLASS OF PIPE (0.01" Crack D-Load)					
	Class II Class VE II Class HE II 1000 D	Class III Class VE III Class HE III 1350 D	Class IV Class VE IV Class HE IV 2000 D	Class V Class VE V Class HE V 3000 D	Class VI Class VE VI Class HE VI 4000 D	
PIPE INSTALLATION WITH 0.7 PROJECTION RATIO						
CIRCULAR	Min. to 18	Min. to 25	25+ to 37	37+ to 45		
ARCH	Min. to 18	Min. to 25	25+ to 37			
VERTICAL ELLIPTICAL	Min. to 18	Min. to 25	25+ to 37	37+ to 45	45+ to 50	
HORIZONTAL ELLIPTICAL	Min. to 18	Min. to 25	25+ to 37			
PIPE INSTALLATION WITH IMPERFECT TRENCH						
ALL TYPES	up to 35	up to 48	48+ to 75	75+ to 96		

GENERAL NOTES

All work shall be done in accordance with the Standard Specifications applicable to the project.
 Minimum cover excluding pavement shall be 1 foot.
 Fill heights greater than maximum allowed in the Heights of Fill Table on this sheet, require special design of structure.
 Pipe design is based on safety factor of 1.33 on ultimate strength.
 The heights of fill, at top of pipe are based on unit weight of soil of 120 lbs. per cubic foot.
 Pipe Class is determined from 0.01 inch crack D-load.
 Class II pipe shall not be placed on main roadway but is permissible in medians, road approaches and other roads not subject to repeated traffic loads.
 Changes in design factors will require compensating change in pipe design.
 Minimum wall thickness dimensions are based on AASHTO Designation M 170 (Wall B) for Circular Pipe, AASHTO Designation M 206 for Arch Pipe and AASHTO Designation M 207 for Elliptical Pipe.
 Spacing for multiple pipe installations shall conform to the details shown on M Standard for Excavation and Backfill for Structures.
 When a culvert is to be installed with pipe of different material, the connection shall conform to the detail on plans or details.


DESIGNED BY M. R. H. APPROVED BY R. S. M.
 MADE BY J. R. B. STAFF DESIGN ENGR.
 CHECKED BY R. S. M. DATE: 4-19-68

STANDARD M-604-BA


(JUNE 1, 1967)

FEDERAL ROAD REGION NO.	DIVISION	PROJ. NO.	SHEET NO.
9	COLORADO		



REVISIONS			
(R-1)	9-13-67	Grate Detail & Quant.	M.R.H.
(R-2)	12-18-67	Connect to skewed culvert, General Note	M.R.H.
(R-3)	7-19-68	Note & Dept. Name	M.R.H.

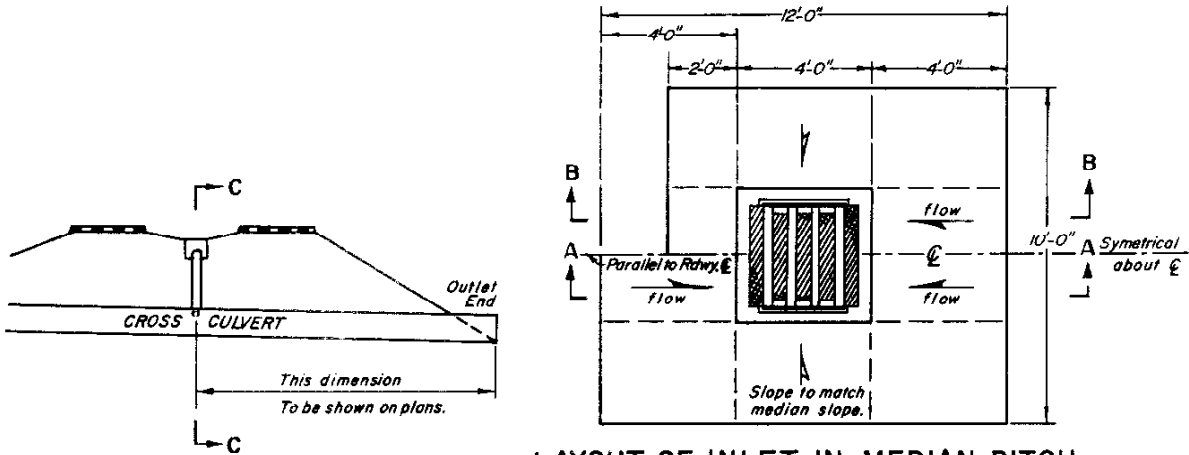


LAYOUT OF INLET IN MEDIAN DITCH

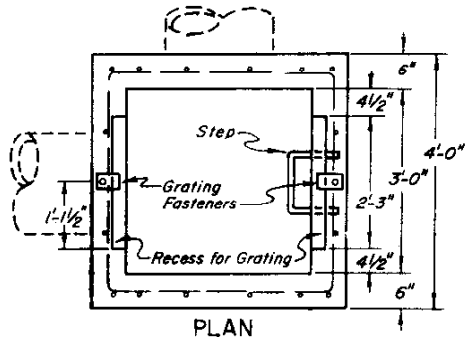

PLAN

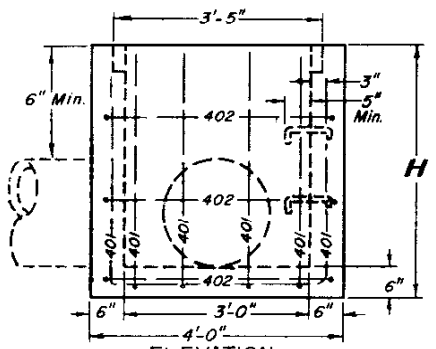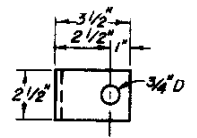

ELEVATION
CONCRETE INLET

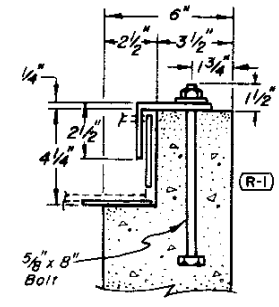

SECTION D-D (R-1)
DETAIL OF RECESS AND
GRATING FASTENER
(2 REQUIRED)

QUANTITIES FOR ONE INLET

H	CLASS "A" CONCRETE (CU. YDS.)	REINF. STEEL (LBS.)	NO. STEPS REQ'D.
3'-0"	1.0	83	0
3'-6"	1.1	89	0
4'-0"	1.2	105	0
4'-6"	1.4	111	1
5'-0"	1.5	127	2
5'-6"	1.6	134	2
6'-0"	1.7	150	2
6'-6"	1.9	157	3
7'-0"	2.0	172	3
7'-6"	2.1	178	3
8'-0"	2.3	194	4
8'-6"	2.4	201	4
9'-0"	2.5	217	4
9'-6"	2.7	223	5
10'-0"	2.8	239	5
11'-0"	3.0	261	6
12'-0"	3.3	283	6

BAR LIST FOR H=3' AND BENDING DIAGRAM

MARK	NO. REQ'D	HGT. "U"	LENGTH
401	9	2'-7"	8'-8"
402	3		15'-4"

No. 401 U


Increase dimension "U" 6" for each 6" increase of H above 3'-0".

No. 402

Add one bar for each foot increase of H above 3'-0".


* Note: Includes Volume occupied by pipes. (R-3)

All bars to be 1/2" Dia. - Cut or bend around pipes as required.

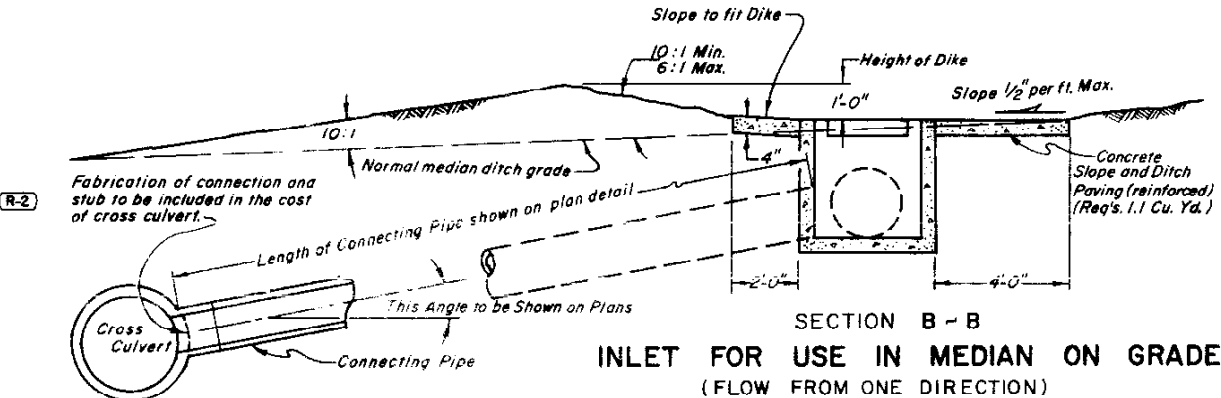


SECTION B-B
INLET FOR USE IN MEDIAN ON GRADE
(FLOW FROM ONE DIRECTION)

SECTION C-C DETAIL SHOWING MEDIAN INLET CONNECTED TO A CROSS CULVERT

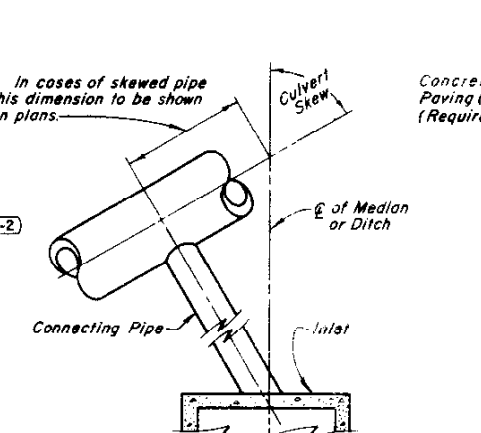

SECTION A-A
INLET FOR USE IN MEDIAN
AT BOTTOM OF VERTICAL CURVE

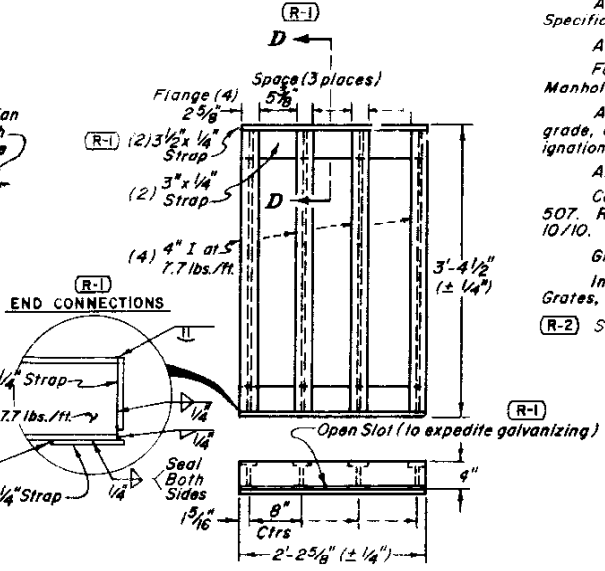

DETAIL OF GRATING

GENERAL NOTES

- All work shall be done in accordance with the Standard Specifications applicable to the project.
- All concrete shall be Class "A" or Class "D".
- For detail of Inlet Step, see M-Standard "Steps for Manholes and Inlets".
- All reinforcing bars shall be deformed, at intermediate grade, and shall be tagged with the station number and bar designation.
- All edge distances not marked "clear" are to $\bar{c}$ of bar.
- Concrete slope and ditch paving shall conform to Section 507. Reinforcement for concrete slope paving shall be 4 x 4, 10/10.
- Grating shall conform to Section 604.
- Inlet grating shall be galvanized as described for Frames, Grates, Covers and Steps in Section 712.
- (R-2) Steps or ladder will be required when inlet depth exceeds 3'-6"

MATERIAL LIST FOR GRATING, FASTENERS

PART	NO. REQ'D.	SIZE	LBS. PER UNIT	WEIGHT - LBS.
Strap Iron	2	3 1/2" x 1 1/4" x 2'-2 1/2"	2.98/lb.	13.2
Strap Iron	2	3 1/4" x 1 1/4" x 2'-2 1/2"	2.67/lb.	11.5
Beam	4	4 1/2" x 3'-4"	7.7/lb.	102.7
Fastener	2	6" x 1/4" x 2 1/2"	1.0 ea.	2.0
Bolt	2	5/8" x 8"	0.8 ea.	1.6
Washer	2		0.1 ea.	0.2
TOTAL WEIGHT				131.2

DEPARTMENT OF HIGHWAYS STATE OF COLORADO DIVISION OF HIGHWAYS


INLET, TYPE C

Designed by D. B. R. Approved by J. E. R.
Made by J. R. B. Staff Design Engineer
Checked by R. S. M. Date: JUNE 1, 1967

STANDARD M-604-D
(JULY 1, 1965)

FEDERAL ROAD REGION NO.	DIVISION	PROJ. NO.	SHEET NO.	TOTAL SHEETS
9	COLORADO			

REVISIONS		
(R-1)	7-23-68	Dept. Name. M.R.H.


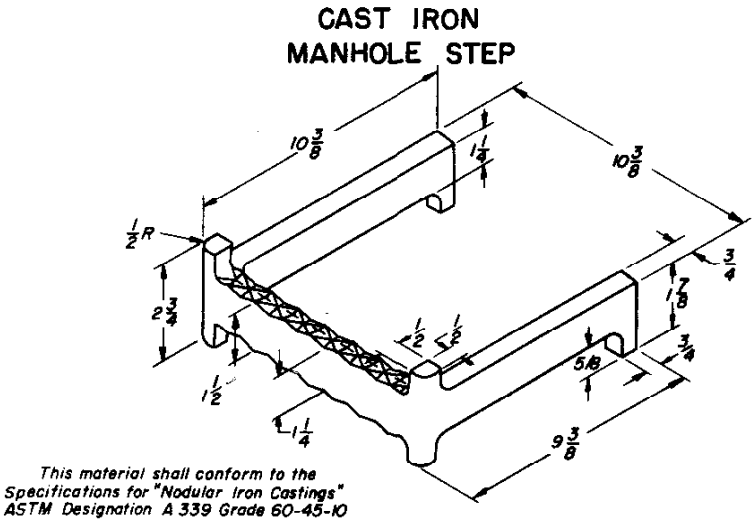


GENERAL NOTES

All work shall be done according to the Standard Specifications applicable to the project.

Steps shall be included in the cost of "Manholes" or "Inlets".

All dimensions shown in inches.

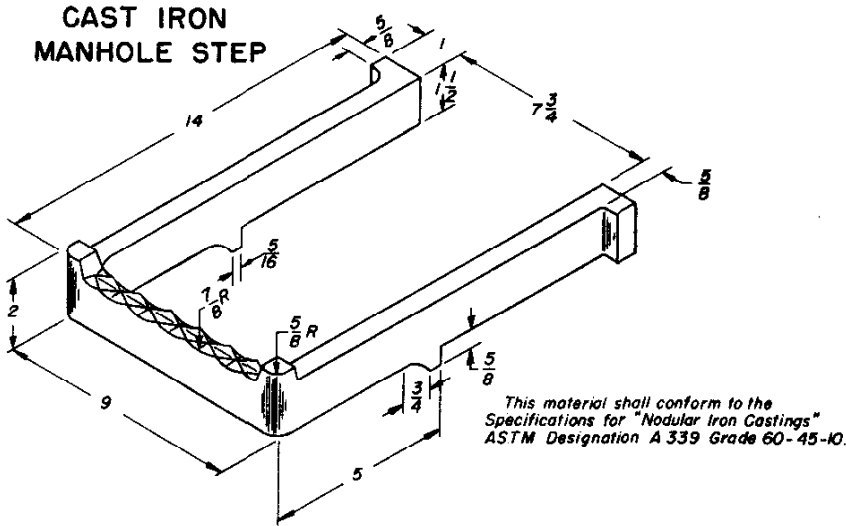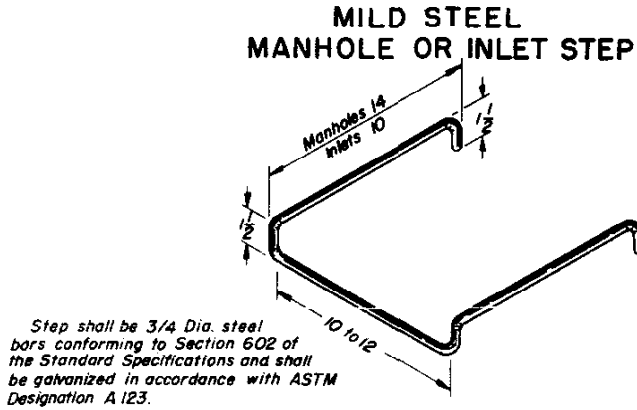

(R-1)

DEPARTMENT OF HIGHWAYS
STATE OF COLORADO
DIVISION OF HIGHWAYS

STEPS FOR MANHOLES
AND INLETS

Designed by: M.R.H. | Approved by: [Signature]
Made by: H.P.B. | Staff Design Engr.
Checked by: [Signature] | Date: July 1, 1965

STANDARD M-606-AB

(MARCH 1, 1968)
(SHEET 1 OF 3)


FEDERAL ROAD REGION NO.	DIVISION	PROJ. NO.	SHEET NO.	TOTAL SHEETS
9	COLORADO			

REVISIONS			
(R-1)	7-10-68	Add typical post & obstruct	M.R.H.
(R-2)	4-1-69	Widening, Bevel, Gen. notes	M.R.H.
(R-3)	2-18-70	Pay length, Blocks, Gen. Notes	M.R.H.
(R-4)	11-25-70	Timber, Hole and Gen. Notes	M.R.H.



TABLE OF OFFSETS
FOR 75' PARABOLIC FLARES

x	W=4'	W=5'	W=6'	W=7'	W=8'	W=9'	W=10'	W=11'	W=12'	W=13'	W=14'	W=15'	W=16'
12'-6"	0.11	0.14	0.28	0.33	0.39	0.44							
25'-0"	0.44	0.55	1.11	1.33	1.56	1.78							
37'-6"	1.00	1.25	2.50	3.00	3.50	4.00							
50'-0"	1.78	2.22	4.44	5.33	6.25	7.11							
62'-6"	2.78	3.48	6.95	8.34	9.73	11.11							
75'-0"	4.00	5.00	10.00	12.00	14.00	16.00							


LEGEND
W = Full parabolic offset.
L = Length of parabolic transition.
X = Longitudinal dist. from beginning of flare.
Y = Offset = $W \cdot \frac{X^2}{L^2}$

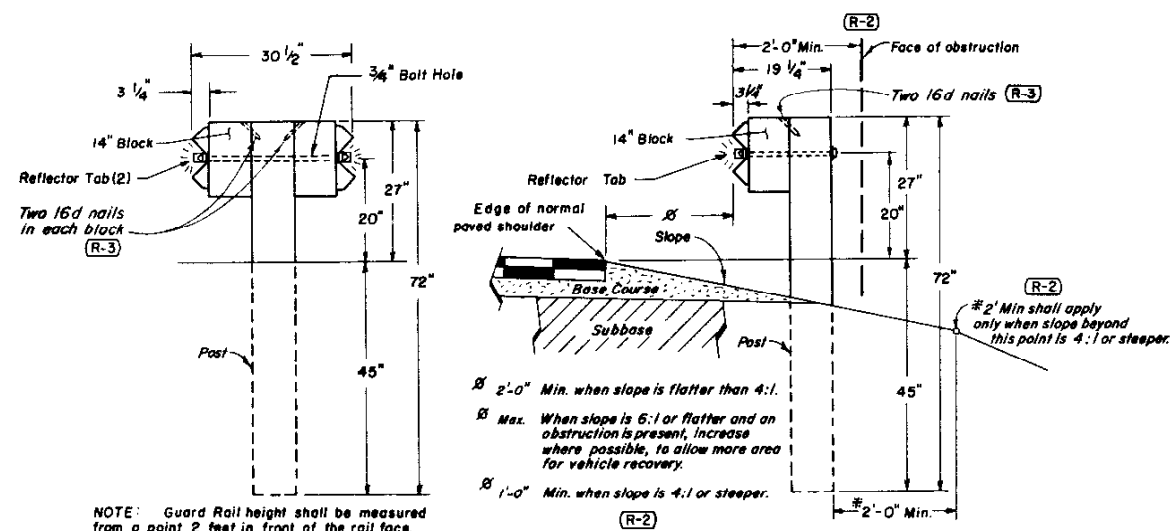

TYPICAL POST INSTALLATIONS
(See Table for Post & Block Cross Section)

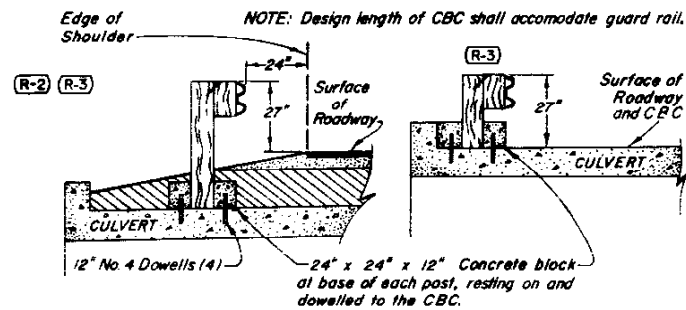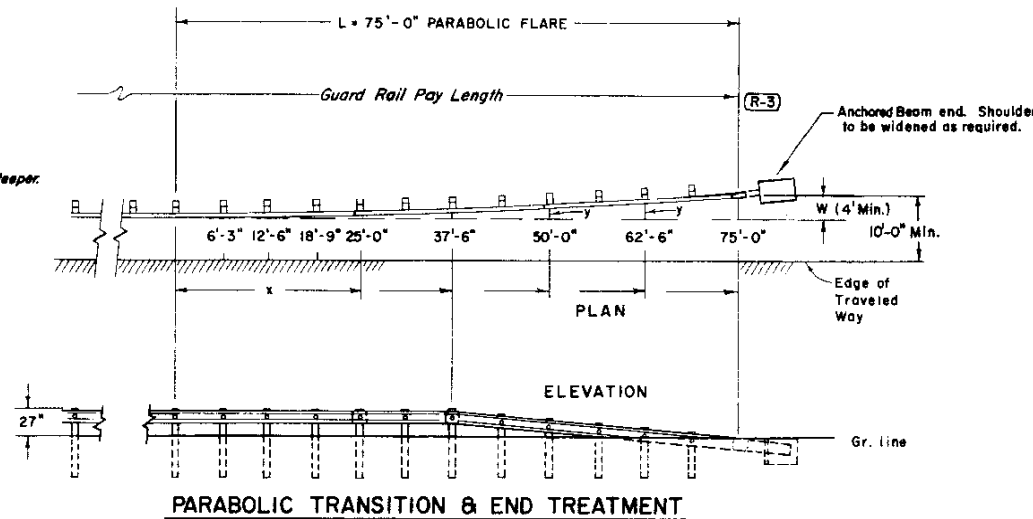

GUARD RAIL ACROSS CONCRETE BOX CULVERT

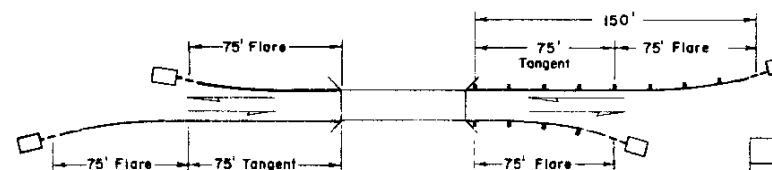

2-LANE HIGHWAY
BRIDGE APPROACH GUARD RAIL

NOTE: For divided highways see Sheet No. 2.

GENERAL NOTES

All work shall be done in accordance with the Standard Specifications applicable to the project.

All timber shall be close grained Douglas Fir of the Coast Region, Dense Longleaf or Shortleaf Southern Pine, Lodgepole Pine, Ponderosa Pine, Western Hemlock, or Larch, and shall conform to the following grading specifications and requirements:

SPECIES	POST & BLOCK CROSS SECTION	FOHC	GRADING RULES
West Coast D. F.	6" x 8"	Yes	WCLA Par. 125 b
West Coast Hemlock	6" x 8"	Yes	WCLA Par. 225 b
Larch	6" x 8"	Yes	WWPA Par. 80.11
Southern Pine	6" x 8"	No	SPA Par. 253
Lodgepole Pine	8" x 8"	No	WWPA Par. 80.11
Ponderosa Pine	8" x 8"	No	WWPA Par. 80.11

WCLA - Standard Grading Rule 15, Grading and Dressing Rules of West Coast Douglas Fir, issued by the West Coast Lumber Inspection Bureau.
WWPA - Standard Grading Rules, published by Western Wood Products Association.
SPA - Standard Grading Rules for Southern Pine Lumber, issued by the Southern Pine Inspection Bureau.
FOHC - Free of Heart Centers. See paragraph 612 c of WCLA.

NOTE - 6" x 8" Posts and Blocks shall be installed with the 6" dimension parallel to the roadway.

All timber shall be rough, square cut and full sawn.

At the time the post or block is installed, any seasoning check which extends the full length of the piece shall not exceed one-quarter inch in width at its maximum width.

Blocks shall be cut from timber of the same cross section and species as the posts.

Timber shall be incised and pressure treated in accordance with AASHTO Designation M133, except that blocks need not be incised. Post bolt holes are to be drilled before treatment is applied.

The preservative shall be either (a) Creosote or (b) Pentachlorophenol in a petroleum carrier (liquid or L.P. gas).

Posts shall be spaced at 6'-3" center-to-center except when otherwise designated on this Standard or in the guardrail tabulation on the plans.

Where pedestrian hazard exists and sidewalk is constructed on the roadway shoulder, guard rail shall be placed between the sidewalk and the edge of traffic lane.

Guard rail plate shall not be lighter than No. 12 U.S. Standard Gage. 25' length of rail panels will be permitted.

Metal plate guard rail shall be painted in accordance with standard specifications or shall be galvanized in accordance with AASHTO Designation M-111 or with ASTM Designation A 525, Coating Class 2.50.


Posts used for vertical transition shall be adjusted in length so that a minimum of 45" will be buried.

Standard galvanized wrought steel washers shall be used under all bolt heads or nuts coming in contact with wood posts.


Concrete shall be Class "A" or Class "B".

Blocks shall be toenailed to posts with two 16 penny galvanized nails in the top of each block.


If posts are cut in the field, cut ends shall receive 2 coats of hot creosote.

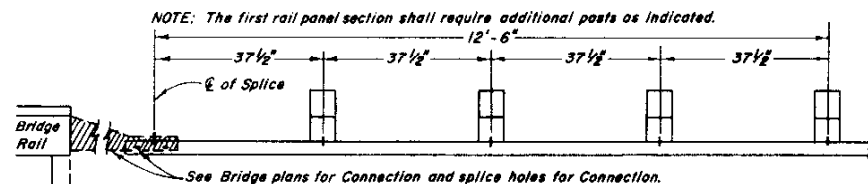

GUARD RAIL AT BRIDGES

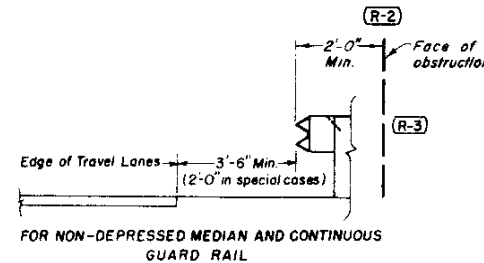

GUARD RAIL FOR OBSTRUCTIONS IN MEDIAN
(See Sheet No. 3)

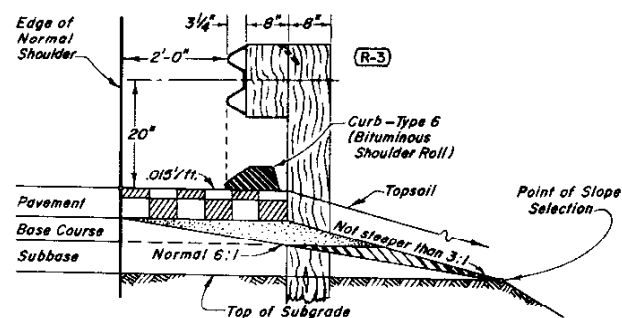

GUARD RAIL WITH BITUMINOUS CURB
(Showing Typical Shoulder Widening)

DEPARTMENT OF HIGHWAYS
STATE OF COLORADO
DIVISION OF HIGHWAYS
GUARD RAIL
TYPE 3


Designed by M.R.H. Approved by J.B. by Staff Design Engineer
Made by J.B. by Staff Design Engineer
Checked by R.S.M. Date: March 1, 1968

STANDARD M-606-AB

(MARCH 1, 1968)
(SHEET 2)


FEDERAL ROAD REGION NO.	DIVISION	PROJ. NO.	SHEET NO.	TOTAL SHEETS
9	COLORADO			

REVISIONS			
(R-1)	7-10-68	Add end anchorage	M.R.H.
(R-2)	4-1-69	Bridge exit guard rail note	M.R.H.
(R-3)	2-18-70	Pay length	M.R.H.
(R-4)	11-25-70	Timber dimension	M.R.H.

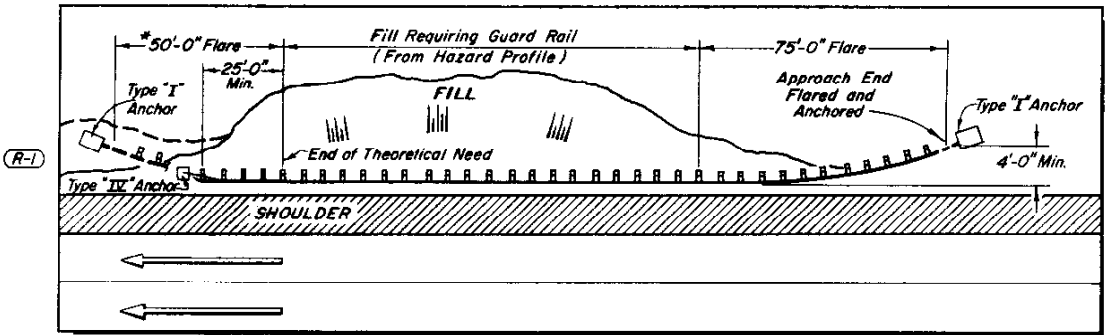


GUARD RAIL INSTALLATION ————— ROADSIDE FILL CONDITION


NOTES:
* 2-Lane Highways — The exit end of Guard Rail shall extend 50 feet past the end of theoretical need and shall be flared and anchored.

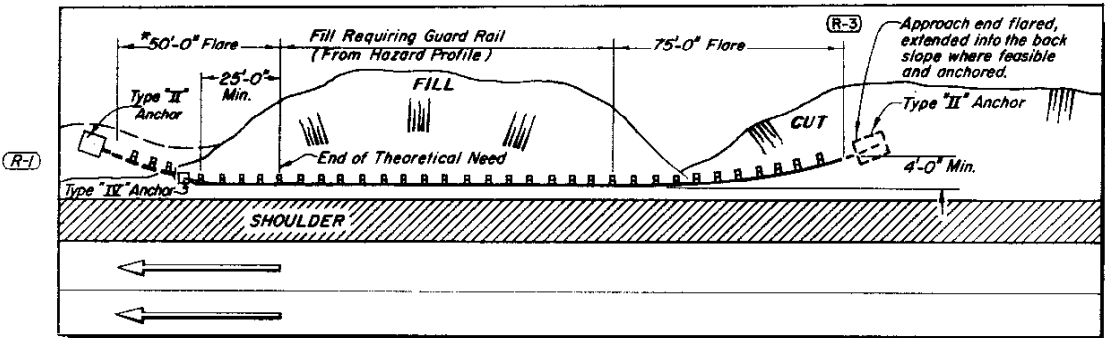

GUARD RAIL INSTALLATION ————— ROADSIDE CUT TO FILL CONDITION

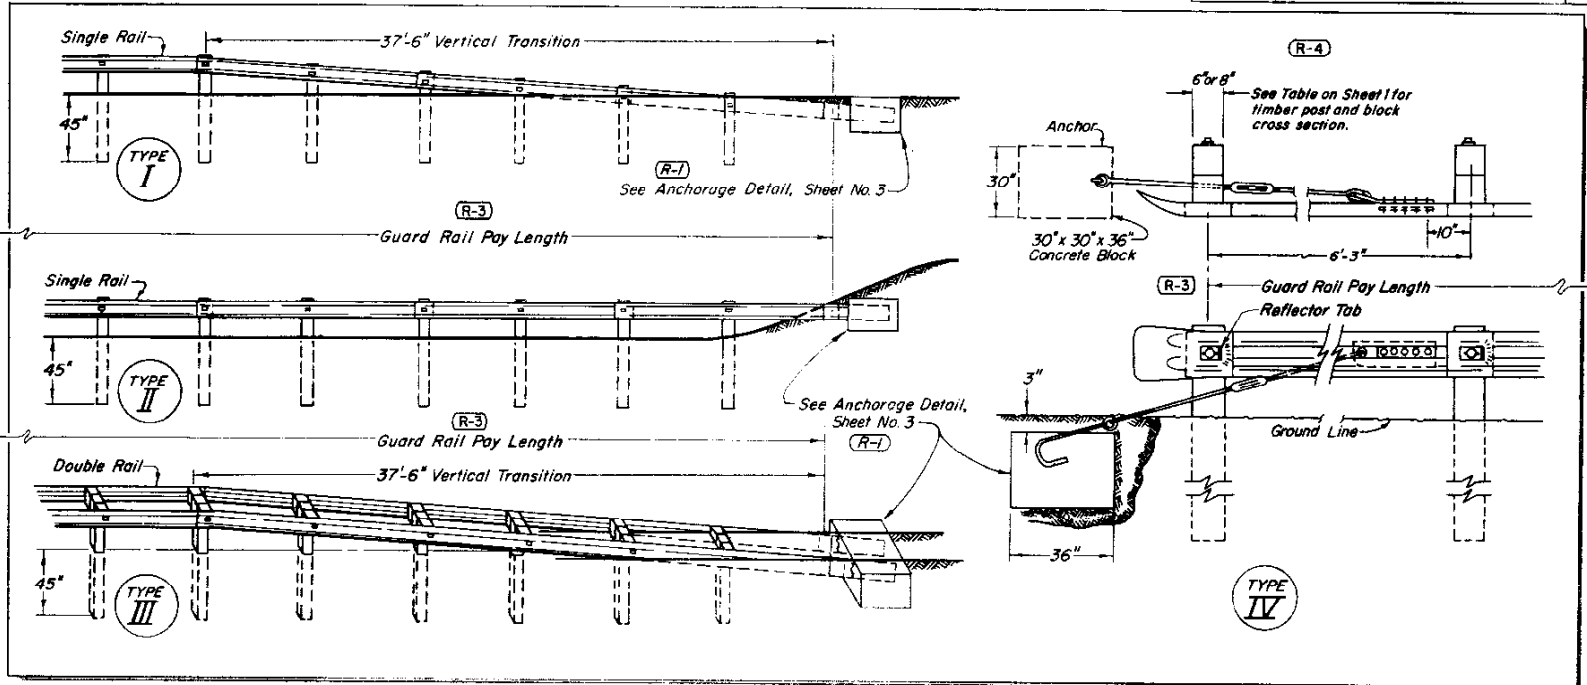

TYPICAL END ANCHORAGE

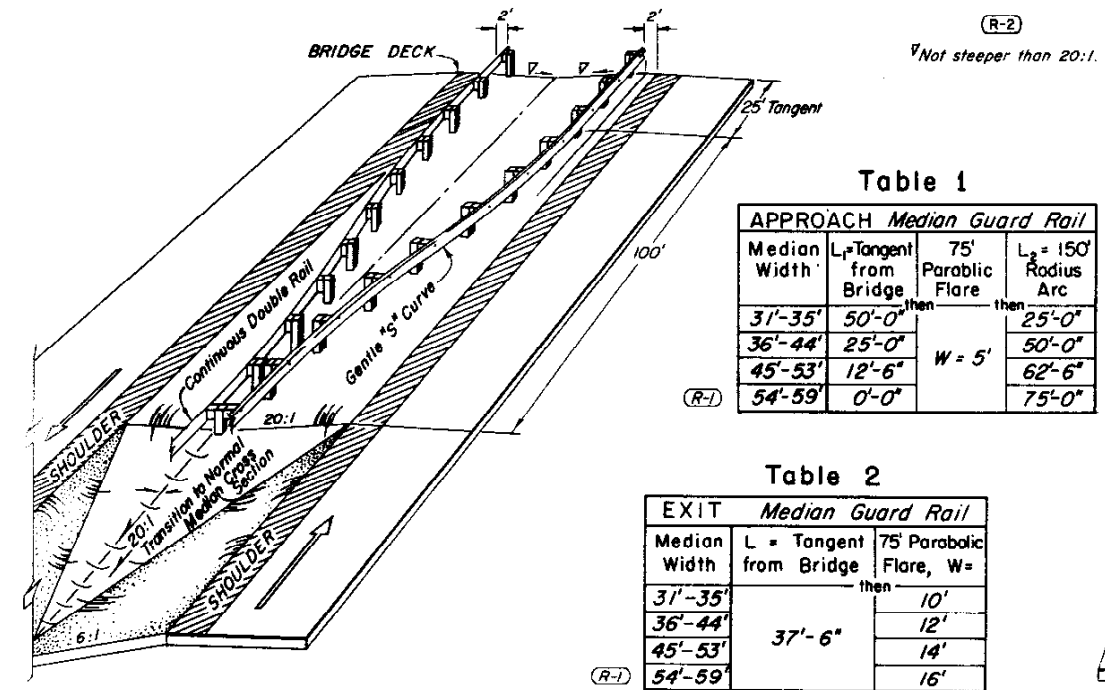


21' to 30' MEDIAN


Table 1 APPROACH Median Guard Rail			
Median Width	L ₁ Tangent from Bridge	75' Parabolic Flare, W = 5'	L ₂ = 150' Radius Arc
31'-35'	50'-0"	then	25'-0"
36'-44'	25'-0"		50'-0"
45'-53'	12'-6"		62'-6"
54'-59'	0'-0"		75'-0"

Table 2 EXIT Median Guard Rail		
Median Width	L = Tangent from Bridge	75' Parabolic Flare, W =
31'-35'	then	10'
36'-44'		12'
45'-53'	37'-6"	14'
54'-59'		16'

GUARD RAIL AT BRIDGE APPROACH

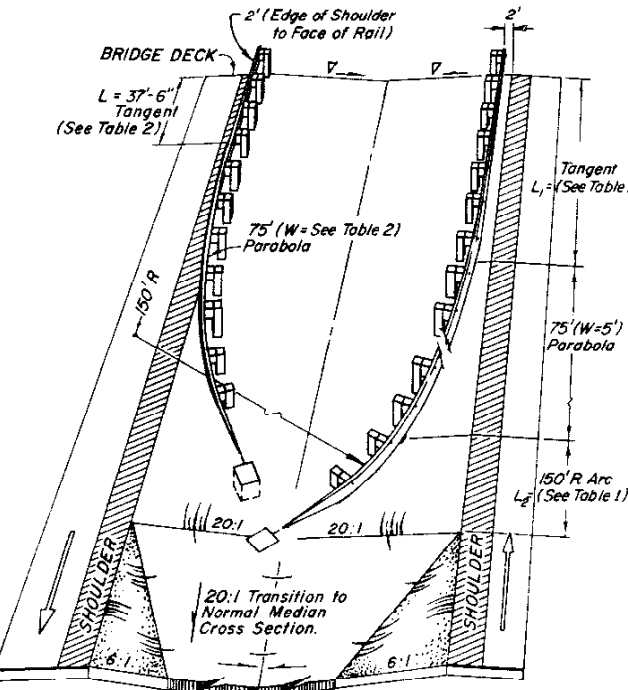

31' to 59' MEDIAN

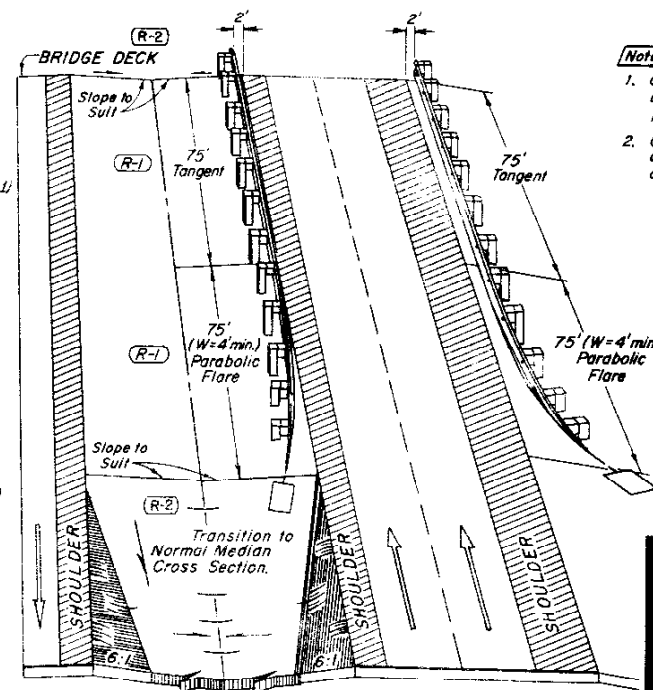

MEDIAN 60' AND OVER

- NOTE: EXIT FROM BRIDGES:
- Guard rail for OUTSIDE shoulders at exit end of bridges on divided highways to be determined from hazard profile.
 - Guard rail for INSIDE shoulders at exit end of bridges on divided highways with medians 60' and over to be determined from hazard profile.

DEPARTMENT OF HIGHWAYS
STATE OF COLORADO
DIVISION OF HIGHWAYS



GUARD RAIL
TYPE 3

Designed by M.R.H. Approved by J.R.B.
Made by J.R.B. Staff Design Engineer
Checked by R.S.M. Date: March 1, 1968











STANDARD M-607-B

(JULY 1, 1965)
(SHEET 1 OF 2)

FED. ROAD REG. NO.	DIVISION	PROJECT NO.	SH. NO.
9	COLORADO		

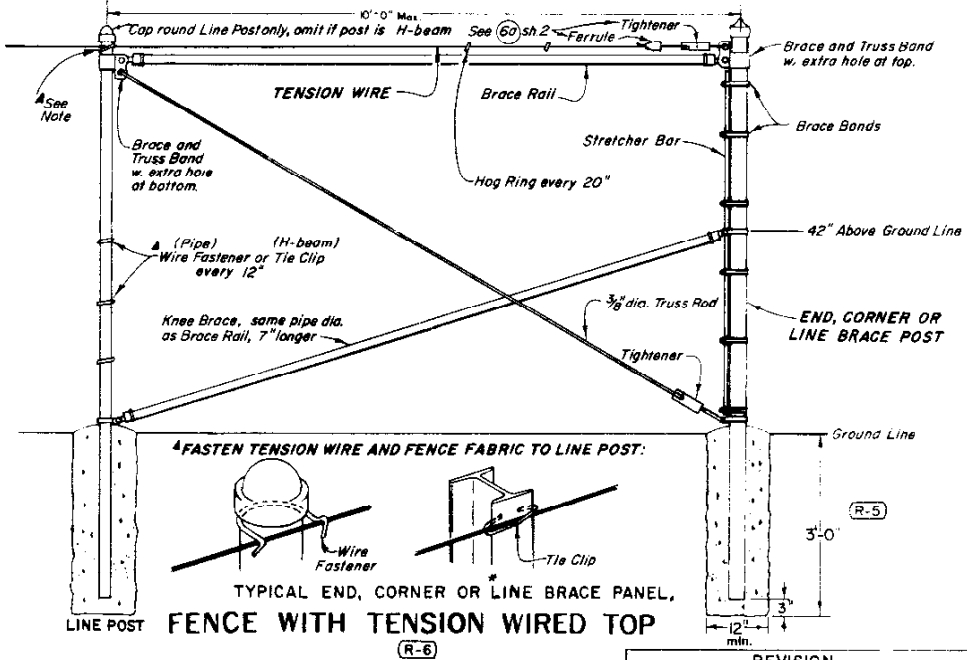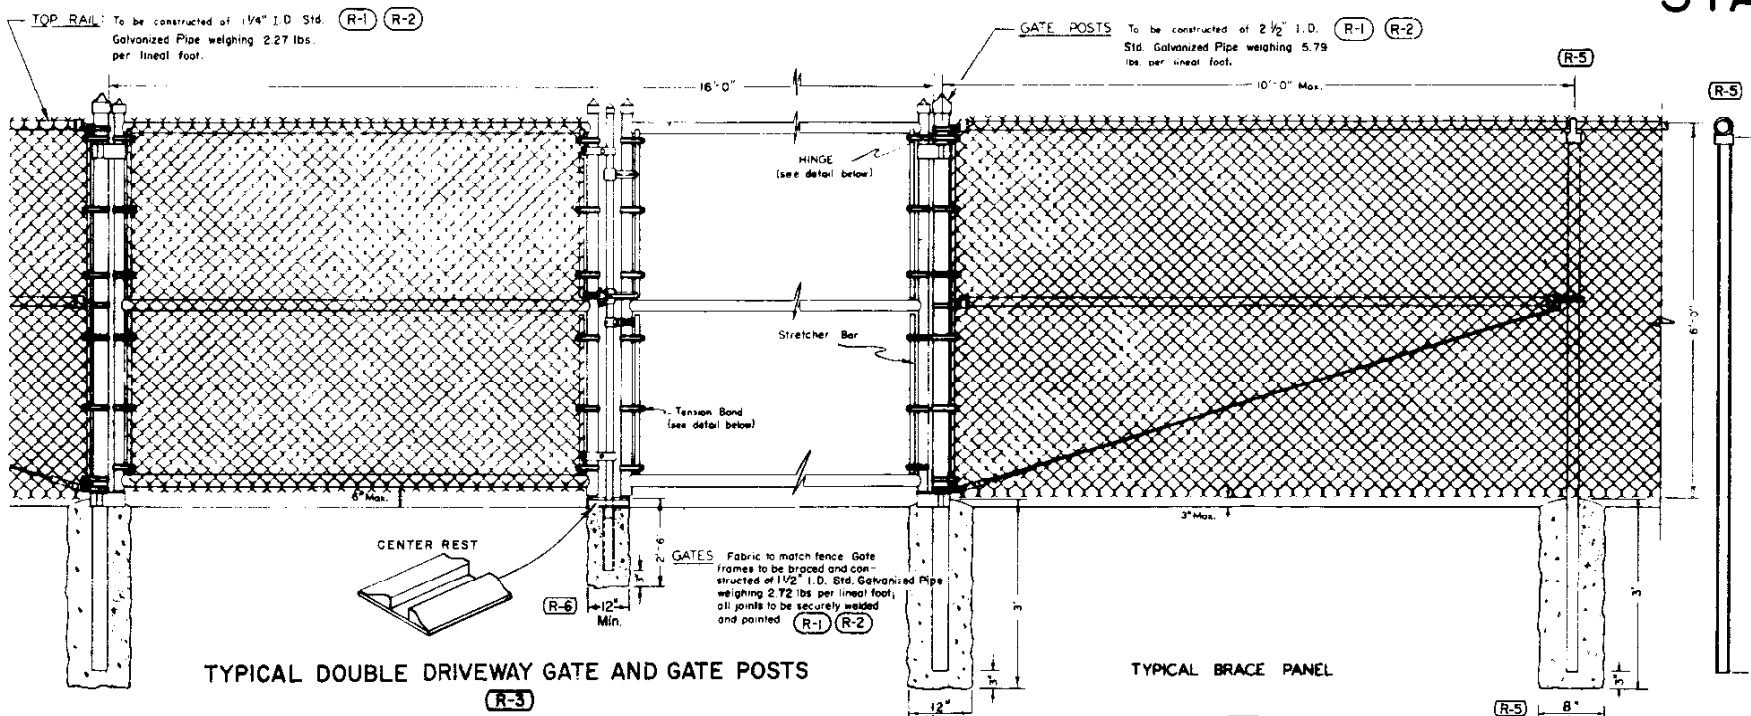

REVISION	DATE	DESCRIPTION	BY	CHKD.
(R-1)	3-28-66	Pipe, Fence height & Gen'l. Notes	M.R.H.	
(R-2)	4-7-66	Pipe diameters clarified	M.R.H.	
(R-3)	2-6-67	Delete spec. No's.; add Gen. Notes	M.P.H.	
(R-4)	7-24-68	Dept. Name	M.R.H.	
(R-5)	7-13-70	Post titles & tops. Line brace. Gates	M.R.H.	
(R-6)	12-11-70	Add details for tension wire	M.R.H.	

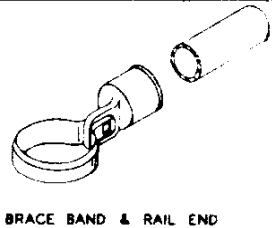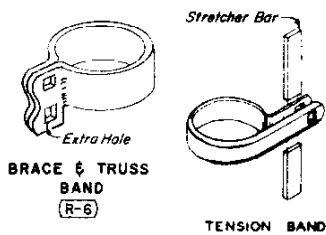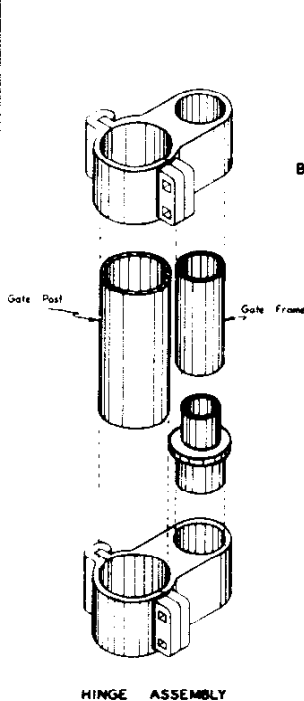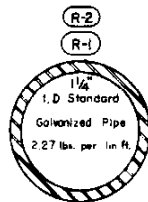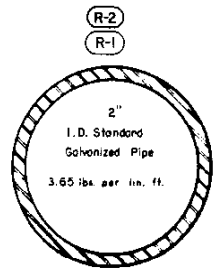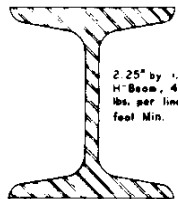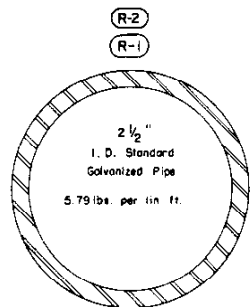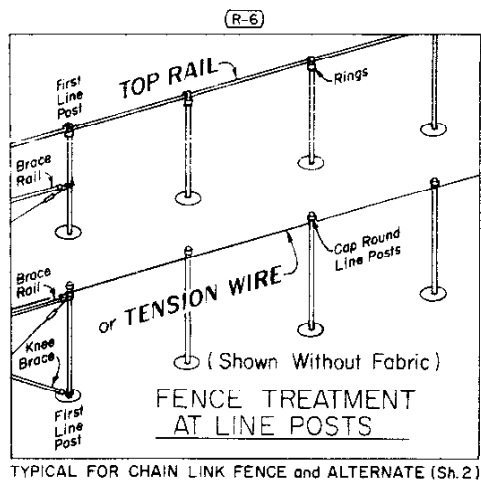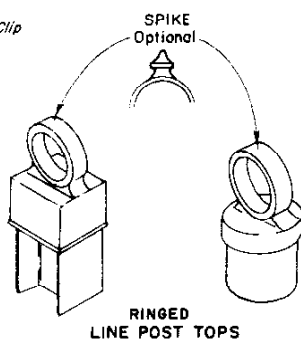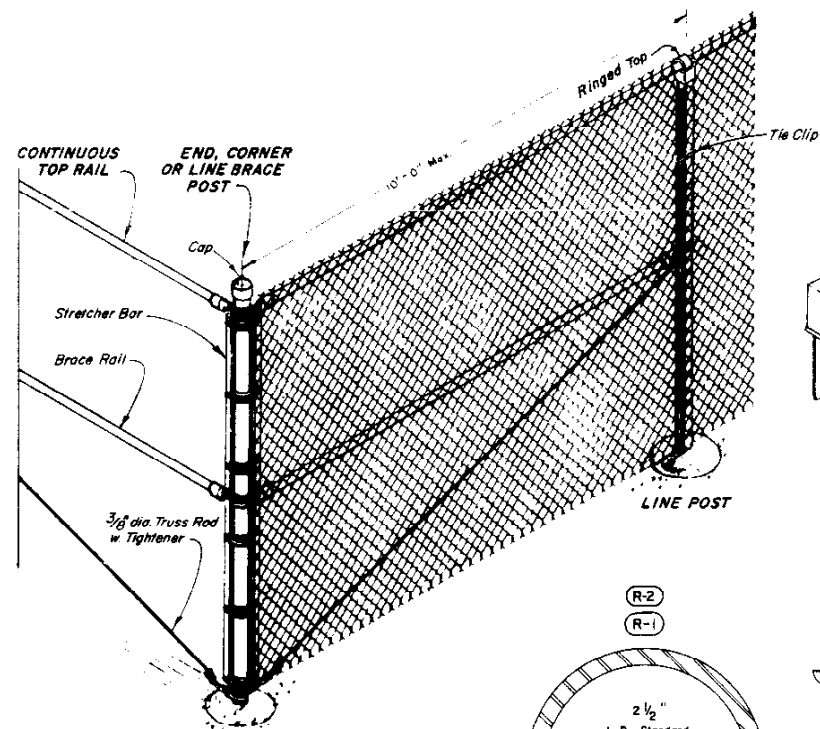

GENERAL NOTES

All work shall be done in accordance with the Standard Specifications applicable to the Project.

Weights of pipe as shown are nominal for the diameter designated. Pipe for posts shall conform to ASTM Designation A 120, Series 40.

Alternate equivalent standard fittings, gates, posts, and rails other than as shown may be used subject to approval by the Engineer.

Chain Link Fabric shall be No. 9 gage wire securely fastened to all Line Posts, Rails and Braces with No. 7 (B&S) gage aluminum wire and/or No. 12 1/2 (W&M) gage galvanized steel wire spaced at a minimum of 6 per 10 feet horizontally and one per foot vertically. Suitable attachment bands shall be used on all gate posts, End Posts, Braces, and stretcher bars.

Chain Link Fabric for use on rock slopes or in conjunction with rock bolts shall be No. 6 gage wire.

Maximum Line Post spacing shall be 10' (c to c). Concrete shall be Class "A" or "B".

Lightweight aggregate conforming to ASTM C 330 will be allowed in concrete.

Concrete footings shall have crowned tops.

Toprail or tension wire shall be used as shown on the plans.

Tension wire shall be continuous between end or corner post and line brace post. A turnbuckle or other approved tightening device shall be used for each continuous span of tension wire.

Tension wire shall be 7 gage galvanized coil spring steel, or approved equal.

Termination of fence at bridges or other structures shall be as shown on the plans.

DEPARTMENT OF HIGHWAYS
STATE OF COLORADO
DIVISION OF HIGHWAYS
CHAIN LINK FENCE


Designed by: V.L.A. Approved by: E.L.H.
Made by: E.L.H. Staff Design Eng.
Checked by: Date: July 1, 1965

STANDARD M-607-B

(SHEET 2)
(JULY 13, 1970)


FEDERAL ROAD REGION NO.	DIVISION	PROJ. NO.	SHEET NO.	TOTAL SHEETS
9	COLORADO			

REVISIONS			
R-5	7-13-70	Entire sheet.	M.R.H.
R-6	12-11-70	Add details 6a and 13.	M.R.H.

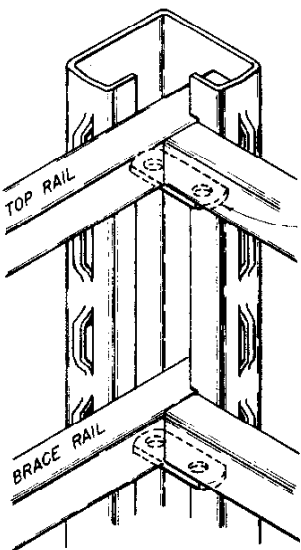

CORNER POST TREATMENT
①

CONNECTOR PLATE
②

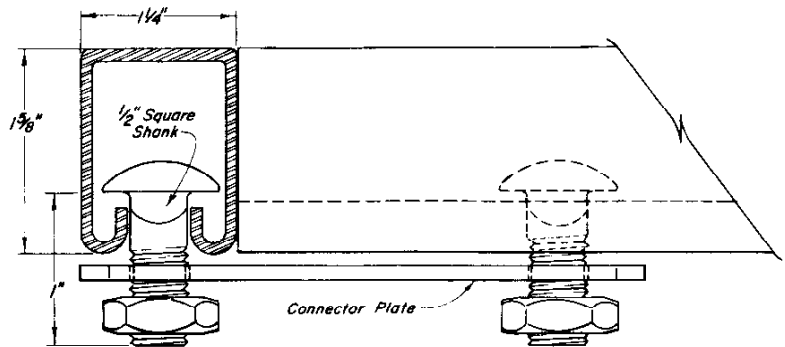

RAIL (Showing Corner Assembly)
③
14 GAGE ROLL FORMED STEEL, 20' LENGTHS, 1.35 LB. PER LIN. FT.





BARBED SELVAGE
⑧




VIEW C

RAIL SPLICE INSERT
⑫

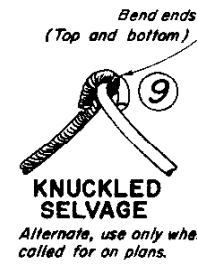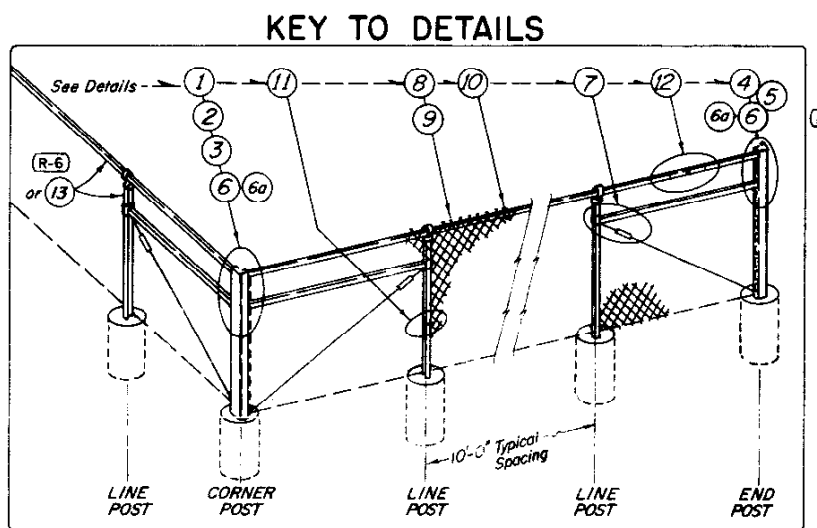


KNUCKLED SELVAGE
⑨


Every 20' horizontally, on Top Rail

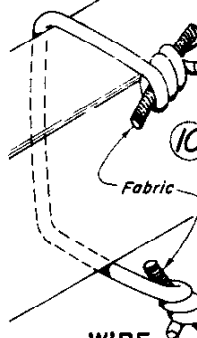


WIRE FASTENER
⑩

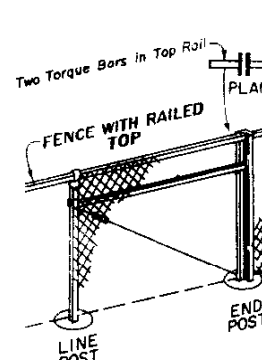


LINE BRACE
400 FT. INTERVALS
(R-6)

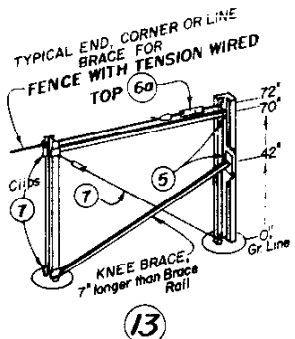


⑬

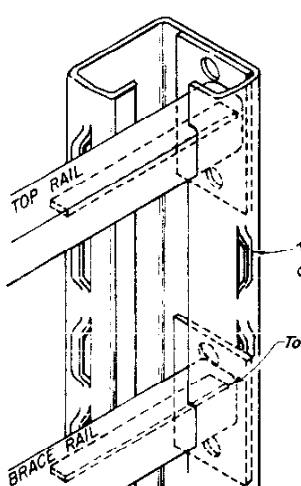


END POST TREATMENT
④

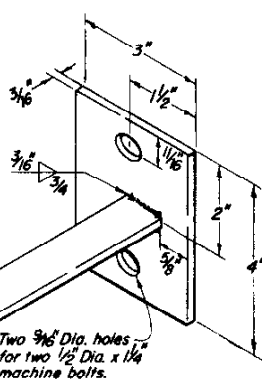



TORQUE BAR
⑤

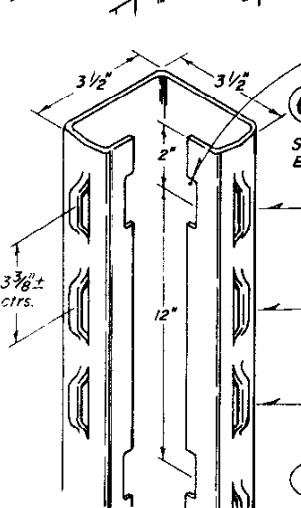



END POST OR CORNER POST
10 GAGE ROLL FORMED STEEL, 5.14 LB. PER LINEAR FOOT

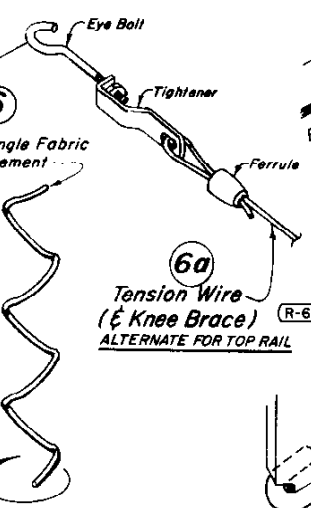

6a
Tension Wire (Knee Brace)
ALTERNATE FOR TOP RAIL
(R-6)

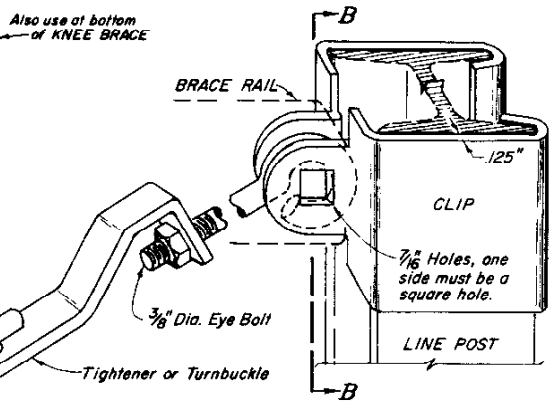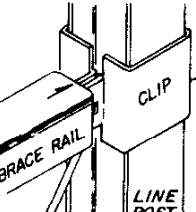

TYPICAL BRACING
⑦

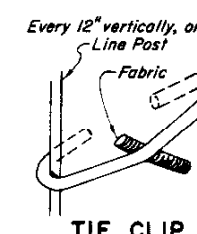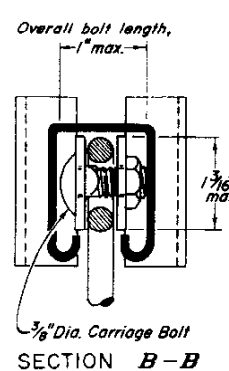

TIE CLIP
⑪

WIRE WORK

DEPARTMENT OF HIGHWAYS
STATE OF COLORADO
DIVISION OF HIGHWAYS
CHAIN LINK FENCE
(ALTERNATE)

Designed by M. R. H. Approved by J. F. S.
Made by J. F. S. Staff Design Engineer
Checked by R. S. M. Date: JULY 13, 1970

STANDARD CURBS AND GUTTERS


STANDARD M-609-A

(JULY 1, 1965)


FED. ROAD REG. NO.	DIVISION	PROJECT NO.	SHEET NO.
9	COLO.		

REVISIONS			
(R-1)	11-16-65	Subtitles	M.R.H.
(R-2)	2-14-66	General Notes	M.R.H.
(R-3)	7-19-68	Dept. Name and Rev. Gen'l. Note	M.R.H.
(R-4)	5-21-69	Provide variable width on conc. gr.	M.R.H.


CONCRETE PAVEMENT (DRIVEWAYS)

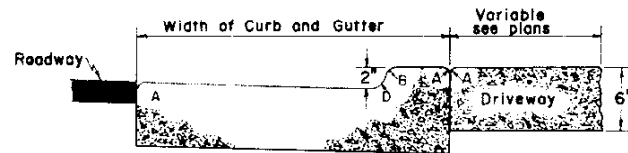


CONCRETE SIDEWALK

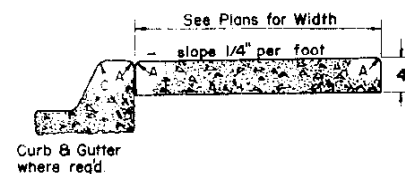

GUTTER Type 2

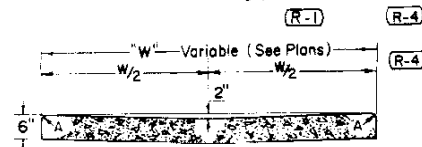


CURB AND GUTTER Type 2 (6" Barrier - 1' Gutter) (Section IB)

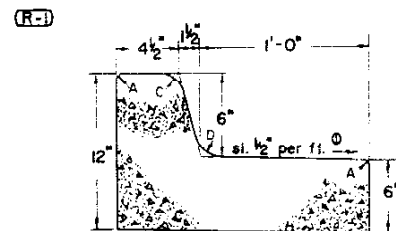


LEGEND FOR RADII	
A	= 1/8"
B	= 1"
C	= 1 1/2"
D	= 1 1/2" to 2"


CURB AND GUTTER (Type 2) (4" Mountable with Sidewalk) (Section MS)

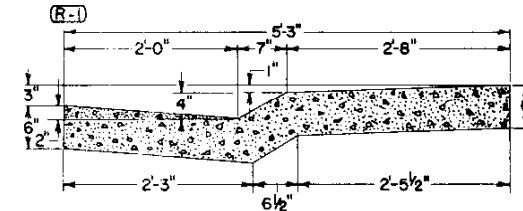


DETAIL OF CURB CUT FOR DRIVEWAYS

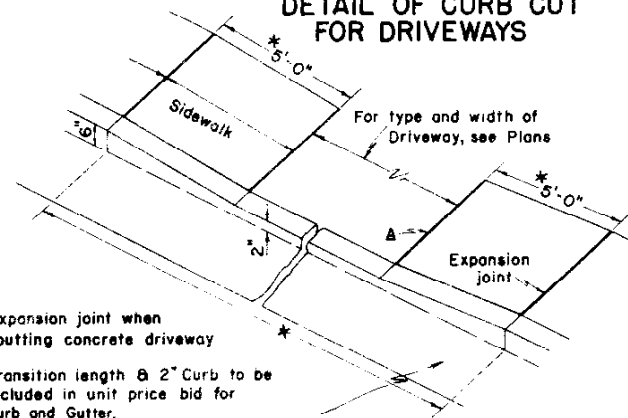

CURB Type 4 (6" Barrier) (Section B) CURB Type 4 (6" Mountable) (Section M)

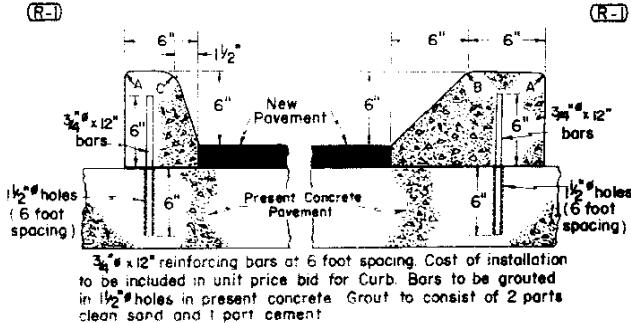


CURB AND GUTTER Type 2 (6" Mountable - 1' Gutter) (Section IM)

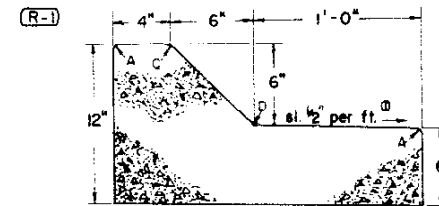


① Slope in opposite direction when required to fit field conditions.

CURB AND GUTTER Type 2 (6" Barrier - 2' Gutter) (Section IB)

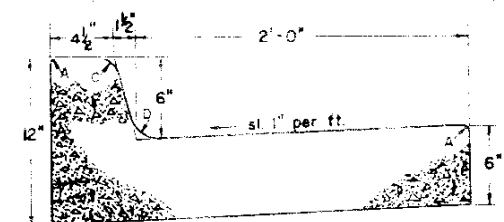


CURB AND GUTTER Type 2 (6" Mountable - 2' Gutter) (Section IM)

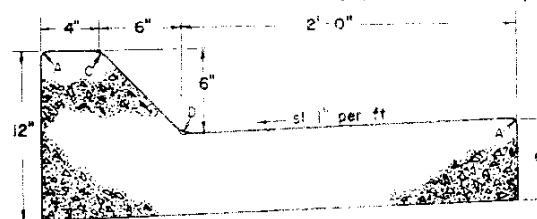

SIDEWALK EXPANSION JOINT




TRANSVERSE CONTRACTION JOINT FOR CONCRETE PAVEMENT (DRIVEWAYS)

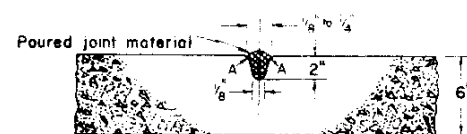


This joint required where length of slab exceeds 15 feet.

CONSTRUCTION OF CONCRETE GUTTERS AT INTERSECTIONS

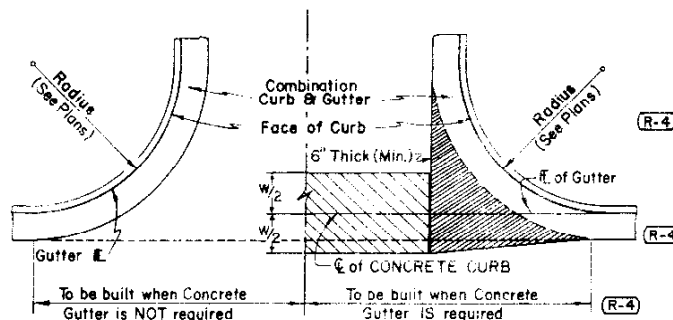

This area shall be poured monolithically with curb and gutter and paid for as Concrete Pavement of specified thickness.

CURB Type 6 (4" Mountable) (Section M)

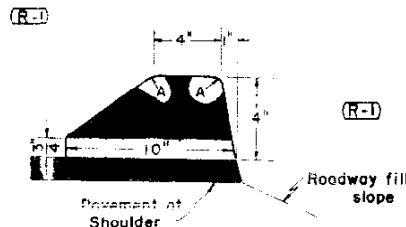

GENERAL NOTES

All work shall be done in accordance with the Standard Specifications applicable to the project.

On Curves 3 degrees and sharper, Curbs and/or Gutters are to be placed on the Arc of the Curve unless otherwise noted on plans. A maximum chord length of 10 feet may be used when the degree of curve is less than 3 degrees.

Expansion joints shall be installed between concrete curb and any fixed structure, sidewalk or bridge. Expansion joint material shall be 1/2" thick and shall extend the full depth of contact surface.

Concrete shall be Class "A" or Class "B".

DEPARTMENT OF HIGHWAYS
STATE OF COLORADO
DIVISION OF HIGHWAYS

CURBS AND GUTTERS


Designed by *[Signature]* Approved by *[Signature]*
Made by *[Signature]* Staff Design Engr.
Checked by *[Signature]* Date: July 1, 1965

RIGHT OF WAY MARKER POST STANDARD M-612-A

(JULY 1, 1965)

FEDERAL ROAD REG. NO.	DIVISION	PROJECT NO.	SHEET NO.
1	COLORADO		

REVISIONS			
R-1	5-2-66	R.O.W. Marker Note	M.R.H.
R-2	7-24-68	Dept. Name	M.R.H.

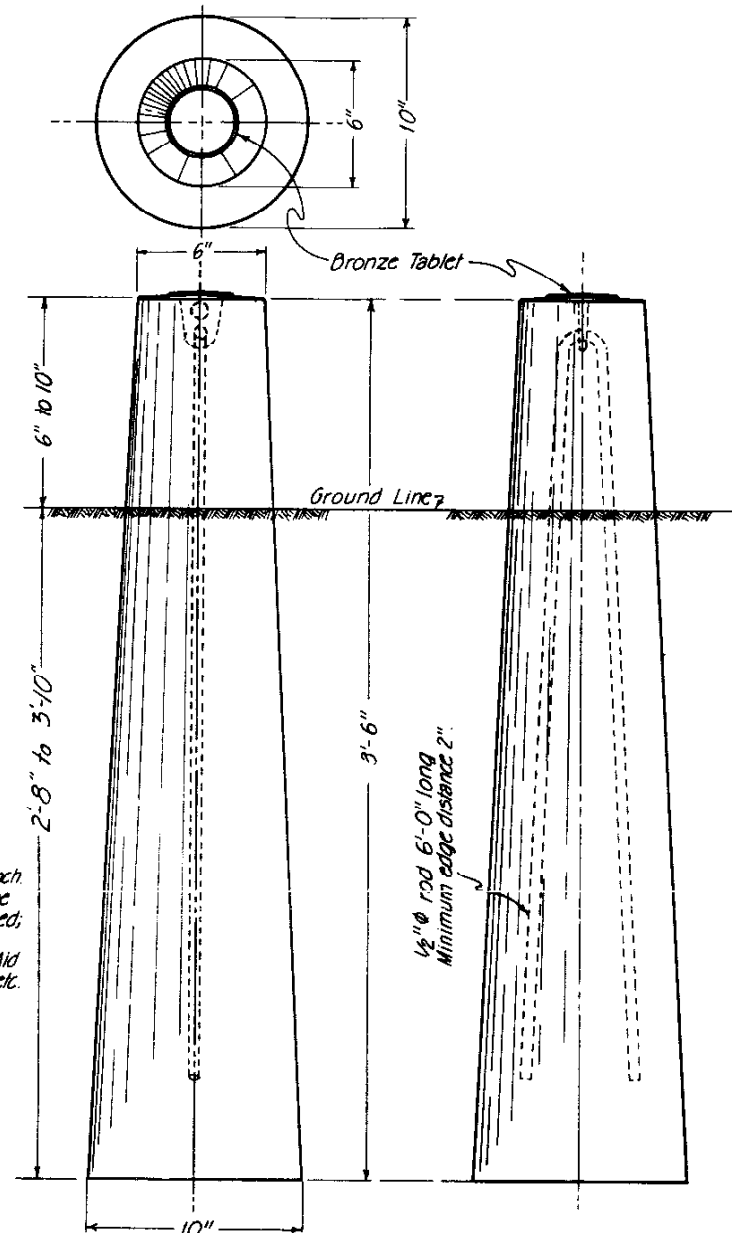



NOTES FOR R.O.W. MARKER POSTS

All work shall be done in accordance with the Standard Specifications applicable to the project.


Posts shall be made of class 'A' Concrete. The upper 12 inches of marker posts shall be rubbed free of form marks, and the top surface of the post must be constructed to drain thoroughly.

(R-1) Light weight aggregate conforming to ASTM Designation C-330 will be allowed.

All exposed surfaces of the bronze tablet are to be ground to a smooth surface. All letters are to be depressed a minimum of 1/16 inch. Information on the bronze tablet indicated by pin lines is to be stamped in field by the engineering party after marker is placed. 3/16 inch letters and figures to be used. Project designations on tablets shall be properly shown (i.e.; I for Fed. Aid Interstate; F for Fed. Aid Primary; S for Fed. Aid Secondary, etc. & C for State Projects, see detail below.)

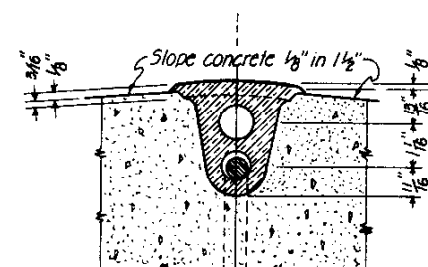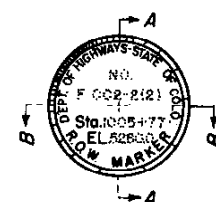

SECTION B-B

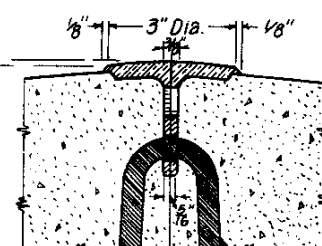

SECTION A-A

DETAIL OF BRONZE TABLET FOR RIGHT OF WAY MARKER POST AND BENCH MARK

Omit and use 12" x 1/2" bar for Bench Mark Tablet

BENCH MARK


All work shall be done in accordance with Standard Specifications applicable to the project.

All exposed surfaces of the bronze tablet are to be ground to a smooth surface. All letters are to be depressed a minimum of 1/16 inch. Information on the bronze tablet indicated by pin lines is to be stamped in field by the engineering party after marker is placed. 3/16 inch letters and figures to be used. Project designation on tablets shall be properly shown (i.e.; I for Fed. Aid Interstate, F for Fed. Aid Primary, S for Fed. Aid Secondary, etc. & C for State Projects. See details below).


Bronze Bench Mark Tablets will be furnished by the Department at no expense to the Contractor.

Installation of Bronze Bench Mark Tablets will not be paid for directly, but shall be included in the price bid for Concrete

Note: Where 2'-0" safety curbs are not used place marker in center of curb.

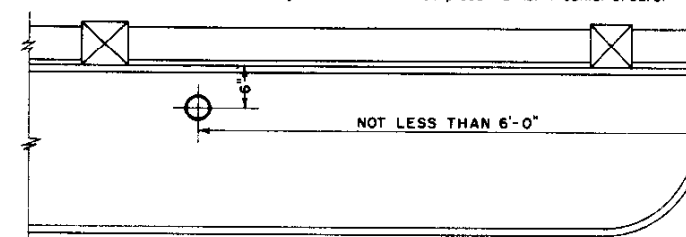

PLAN

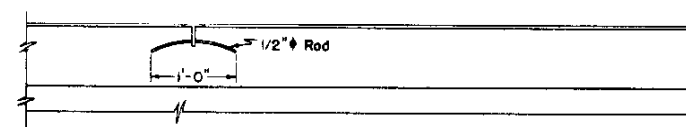

ELEVATION



One marker to be placed on Bridges as shown. The station shown on marker shall be the center-line stationing directly opposite the marker.

(R-2)

DEPARTMENT OF HIGHWAYS
STATE OF COLORADO
DIVISION OF HIGHWAYS

MARKER POSTS
AND
BENCH MARKS

Designed by R.E.L. Approved by R.E.L.
Made by E.E.G. Staff Design Engr.
Checked by R.E.L. Date: July 1, 1965

STANDARD M-612-C

(SHEET 2)
(JULY 1, 1965)

FED. ROAD DIST. NO.	DIVISION	PROJECT NO.	SHEET NO.
9	COLORADO		

REVISIONS			
(E-1)	9-4-67	Median and Island Delineators	M.R.H.
(E-2)	1-9-68	Median Crossover	M.R.H.
(E-3)	7-11-68	Division Name	M.R.H.


GENERAL NOTES

For Radii greater than 200 Feet, use spacing from Table included on Sheet 1 of this Standard.


For additional General Notes, see Sheet 1 of this Standard.

Place face of button at 90° to C of roadway.


Lengths of speed change lanes including tapers shall be as shown on plans.

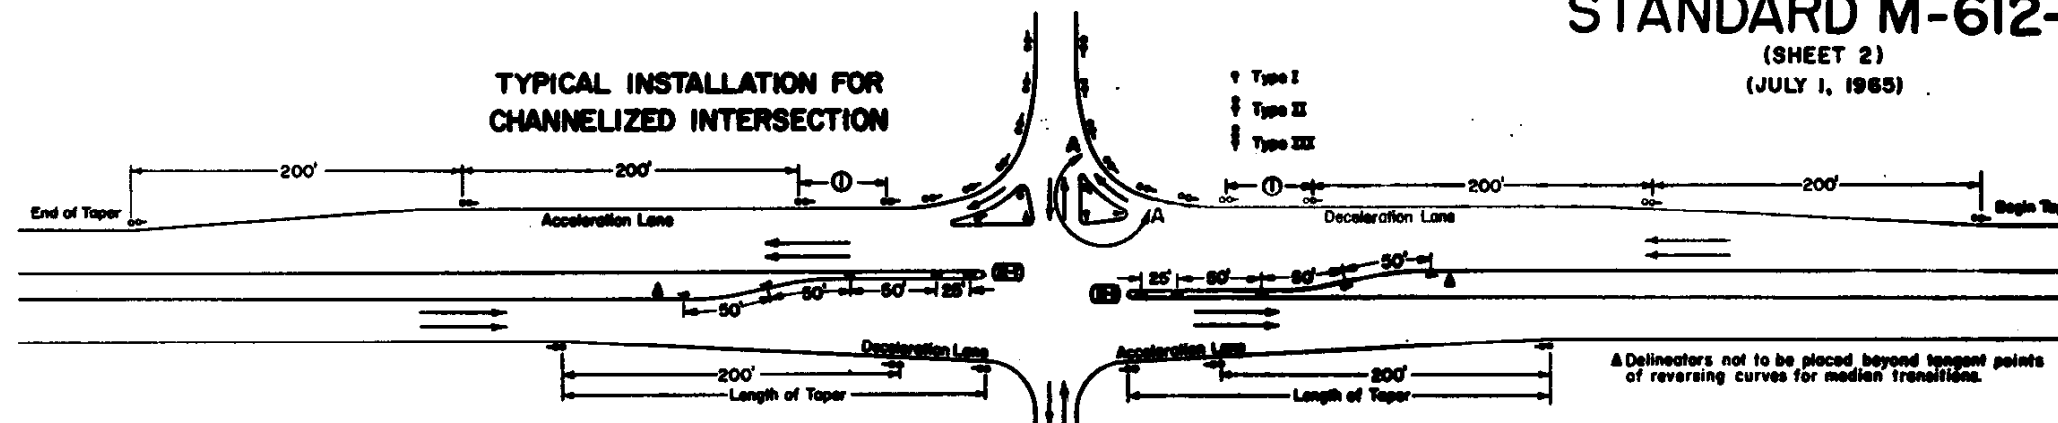


TYPICAL INSTALLATION FOR CLIMBING LANE TRANSITION

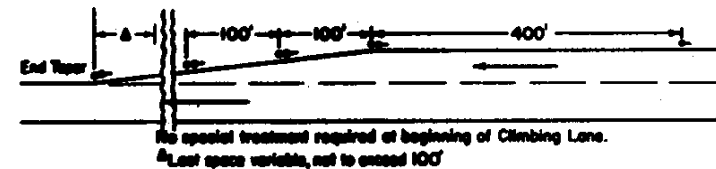

4 LANE DIVIDED (INTERSTATE)

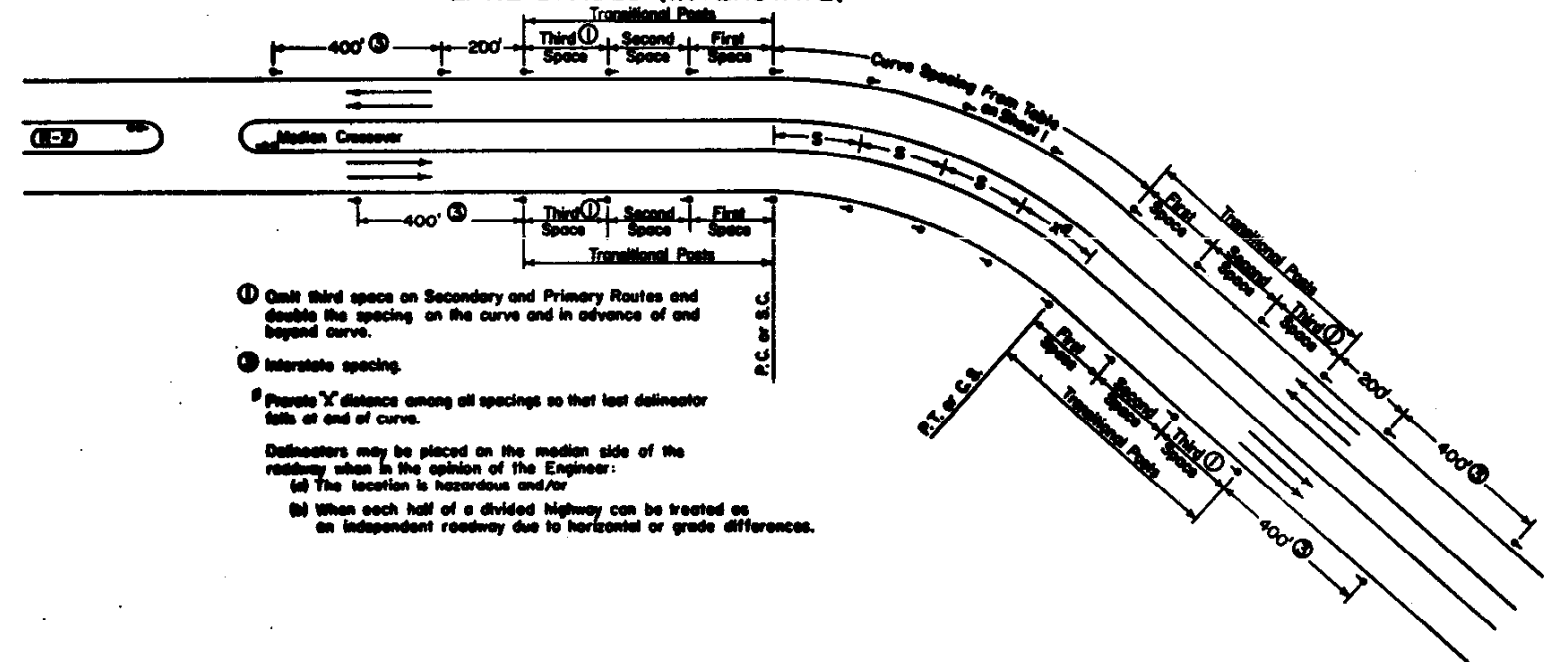

- ① Omit third space on Secondary and Primary Routes and double the spacing on the curve and in advance of and beyond curve.
 - ② Interstate spacing.
- Place "X" distance among all spacings so that last delineator falls at end of curve.
- Delineators may be placed on the median side of the roadway when in the opinion of the Engineer:
- (a) The location is hazardous and/or
 - (b) When each half of a divided highway can be treated as an independent roadway due to horizontal or grade differences.

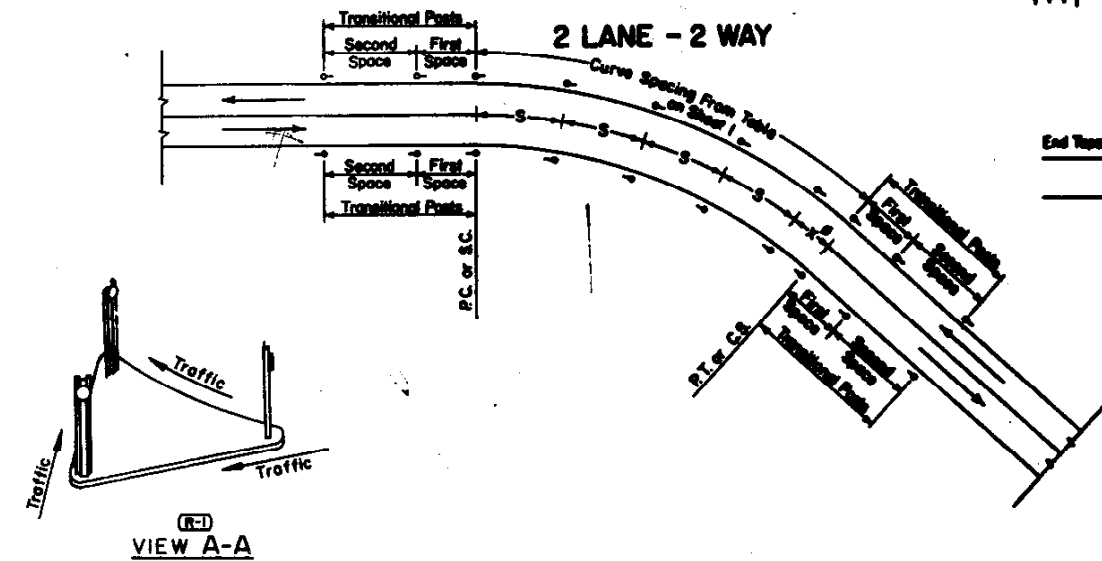

DEPARTMENT OF HIGHWAYS
STATE OF COLORADO
DIVISION OF HIGHWAYS

DELINEATORS


Designed by C.R.M.
Made by T.E.F.
Checked by L.E.O.

Approved by J.E. Ogawa
Staff Design Eng.
Date: July 1, 1965

STANDARD M-612-C
(SHEET 1 OF 2 SHEETS)
JULY 1, 1965

FED. ROAD REG. NO.	DIVISION	PROJECT NO.	SHEET NO.
9	COLORADO		

REVISIONS			
R-2	1-9-68	Median Crossover, Genl. Note	M.R.H.
R-3	7-11-68	Division Name	M.R.H.

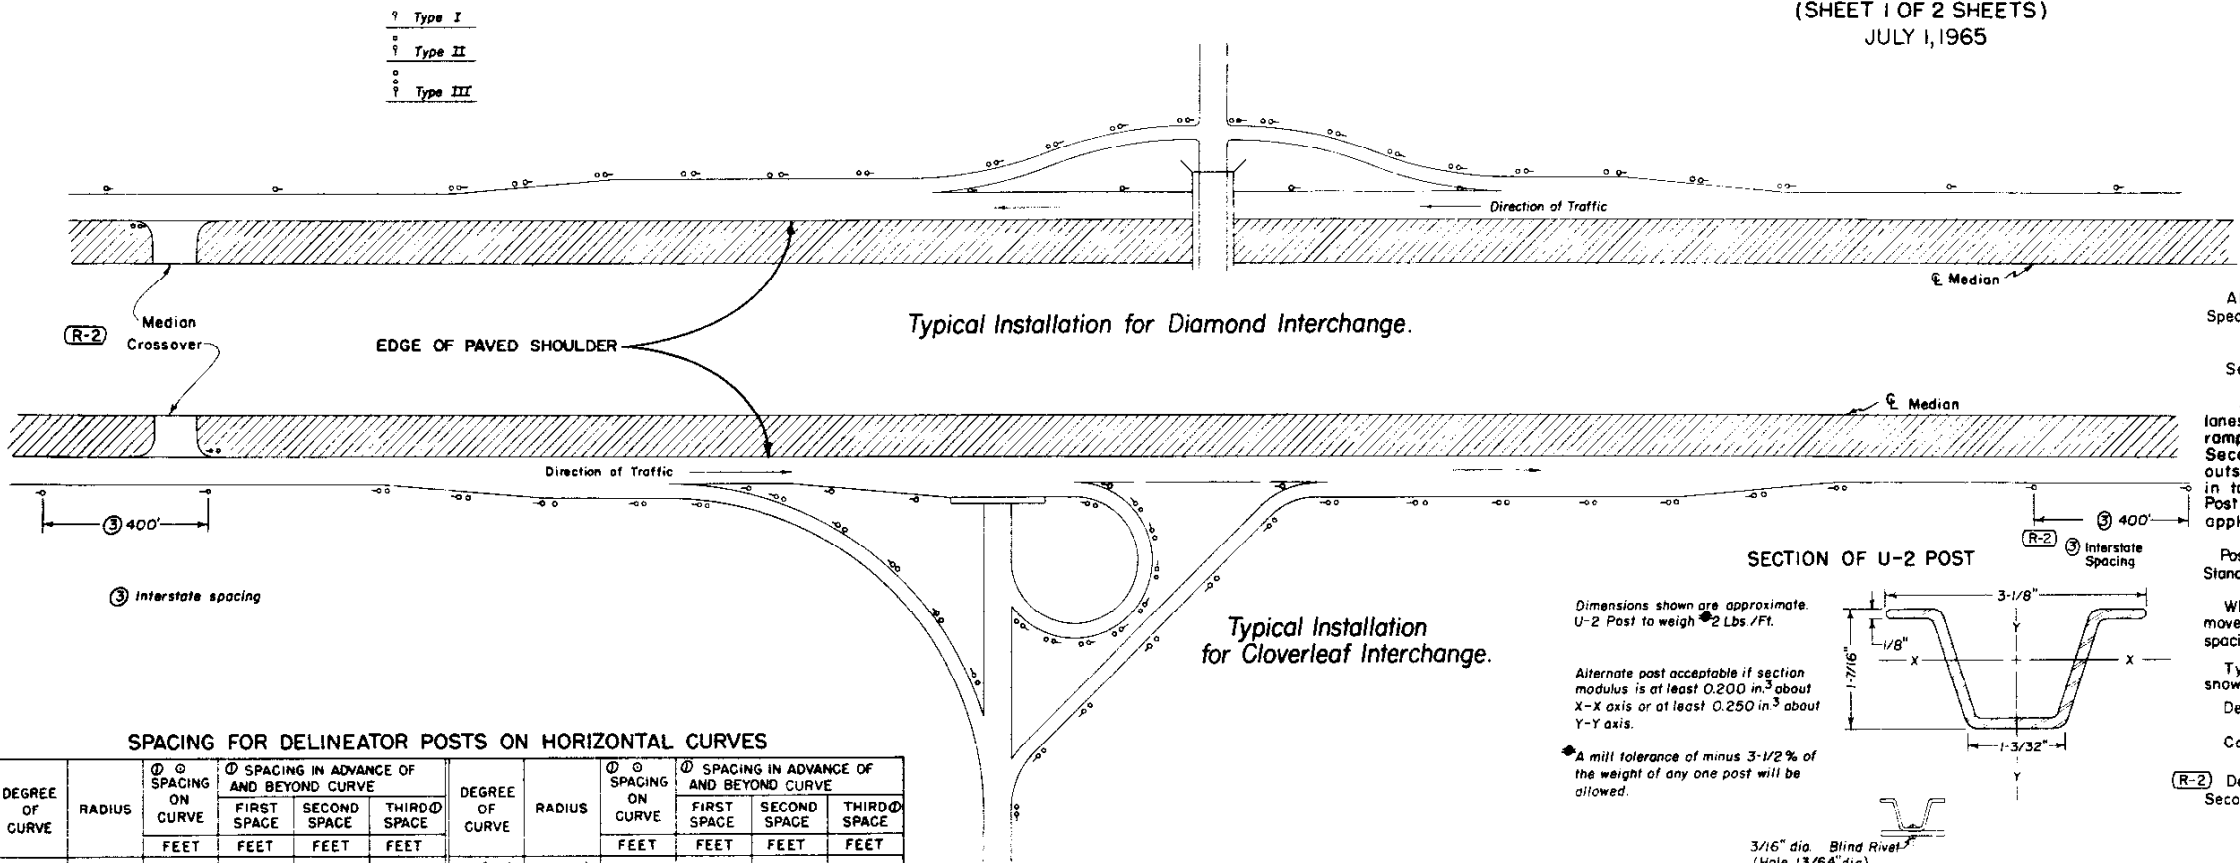

GENERAL NOTES

All work shall be done in accordance with the Standard Specifications applicable to the project.

See tabulation in plans for delineator post requirements.

Spacing between Posts on acceleration and deceleration lanes and on relatively straight portions of interchange ramps shall be 100' on Interstate and 200' on Primary and Secondary Projects. Spacing between Posts on the outside of interchange ramp curves shall be as indicated in table for the appropriate degree of curve with a 24' min. spacing. Post spacing in advance and beyond curve shall not apply to ramp curves.

Posts shall meet requirements of Par. 4.5 of U.S. Dept. of Commerce Commercial Standard 184-51. Acceptable material includes re-railroad rails.




When normal delineator spacing falls on a road approach or crossover, move delineator either direction a distance not to exceed 1/4 normal spacing.

Type, location and spacing of delineators for tunnels and snow sheds shall be as directed by the Engineer.

Delineator Posts are not to be placed along Frontage Roads.

Color of Posts shall be Interstate Green.

(R-2) Delineators will not be required on tangents for Primary and Secondary roadways.

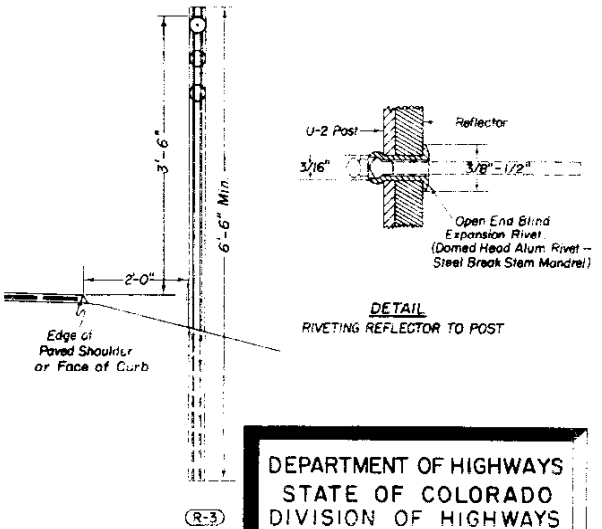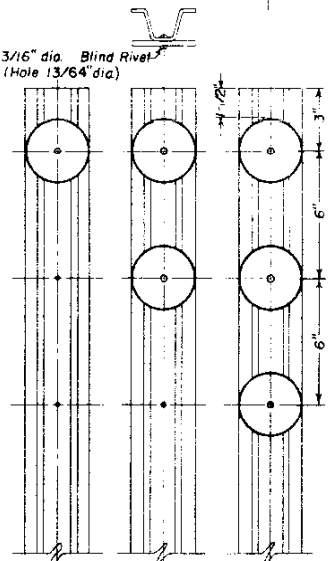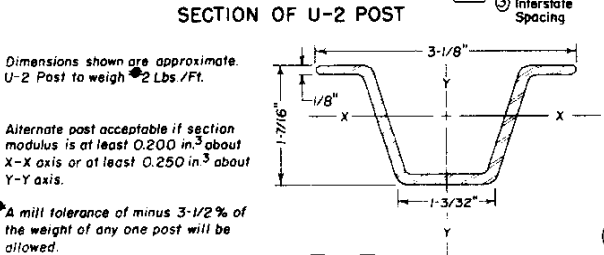


SPACING FOR DELINEATOR POSTS ON HORIZONTAL CURVES

DEGREE OF CURVE	RADIUS	SPACING IN ADVANCE OF AND BEYOND CURVE				DEGREE OF CURVE	RADIUS	SPACING IN ADVANCE OF AND BEYOND CURVE			
		1ST SPACE	2ND SPACE	3RD SPACE	4TH SPACE			1ST SPACE	2ND SPACE	3RD SPACE	4TH SPACE
0°30'	11460.0'	200	200	200	200	8°00'	716.3'	52	94	156	200
1°00'	5730.0'	151	200	200	200	8°30'	674.1'	50	90	150	200
1°30'	3820.0'	123	200	200	200	9°00'	636.7'	48	86	144	200
2°00'	2865.0'	106	191	200	200	9°30'	603.2'	47	85	141	200
2°30'	2292.0'	95	171	200	200	10°00'	573.0'	46	83	138	200
3°00'	1910.0'	86	155	200	200	10°30'	545.7'	45	81	135	200
3°30'	1637.1'	80	144	200	200	11°00'	520.9'	43	77	129	200
4°00'	1432.5'	74	133	200	200	11°30'	498.3'	42	76	126	200
4°30'	1273.3'	70	126	200	200	12°00'	477.5'	41	74	123	200
5°00'	1146.0'	66	119	198	200	15°00'	382.0'	36	65	108	200
5°30'	1041.8'	63	113	189	200	18°00'	318.3'	33	59	99	198
6°00'	955.0'	60	108	180	200	21°00'	272.9'	30	54	90	180
6°30'	881.5'	58	104	174	200	25°00'	229.2'	27	49	81	162
7°00'	818.6'	55	99	165	200	30°00'	191.0'	24	43	72	144
7°30'	764.0'	53	95	159	200						

$S = 2 \sqrt{R - 50}$ 1-ST. SPACE = 1.85 2-ND. SPACE = 3.5 3-RD. SPACE = 6.5
NO SPACES TO EXCEED 200 FT.

① Omit third space on Secondary and Primary Routes and double the distance on the curve and in advance of and beyond curve. For curves less than 2 degrees on Interstate through roadways use Interstate tangent spacing.

Typical Installation at Bridge Approaches

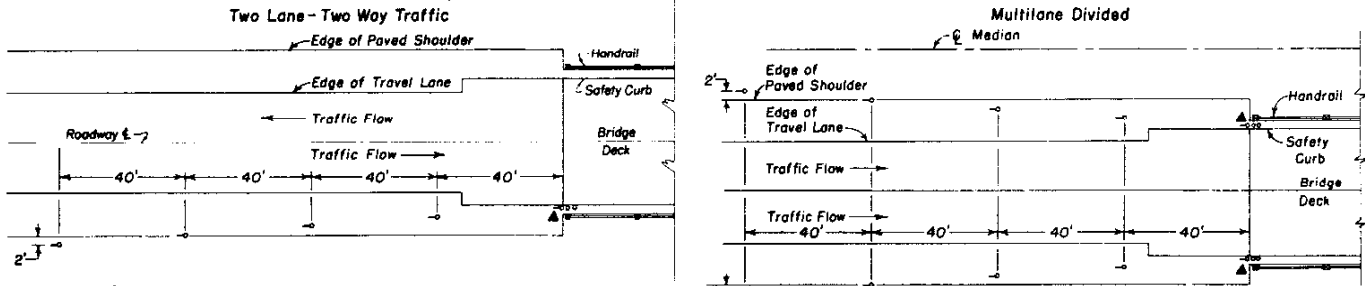

Where curb to curb width of bridge is equal to or greater than roadway width plus usable shoulder width, use this delineator only and omit all others.
Note: Where guard rail is present, place delineators outside of guard rail and at height which will permit clear view of all three Delineator buttons.

When approach slab has curb, place Type III delineator immediately behind curb.


DEPARTMENT OF HIGHWAYS
STATE OF COLORADO
DIVISION OF HIGHWAYS

DELINEATORS


Designed by CKM
Made by WNC
Checked by LLS
Approved by E. Olson
Staff Design Engr.
Date: July 1, 1965

CLASS I BARRICADES
(3 RAILS)

MOVABLE





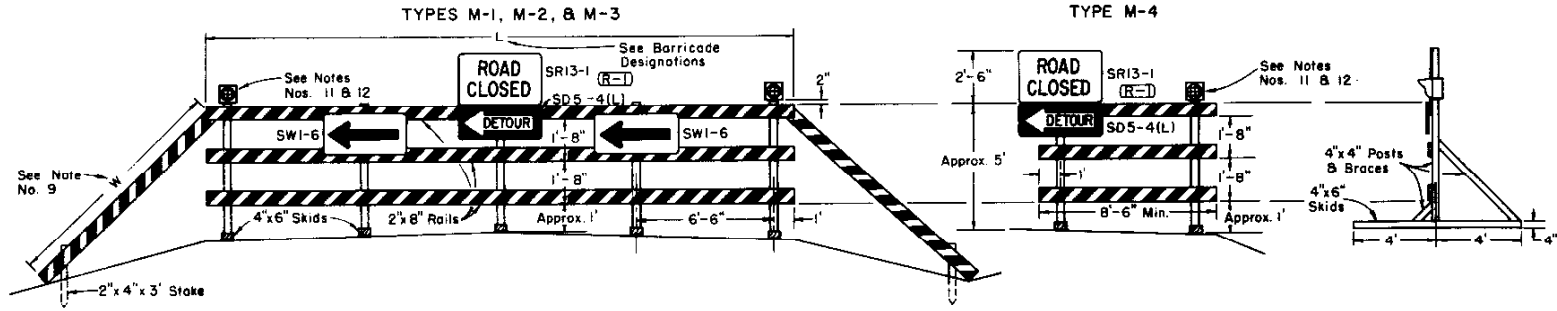


FIXED

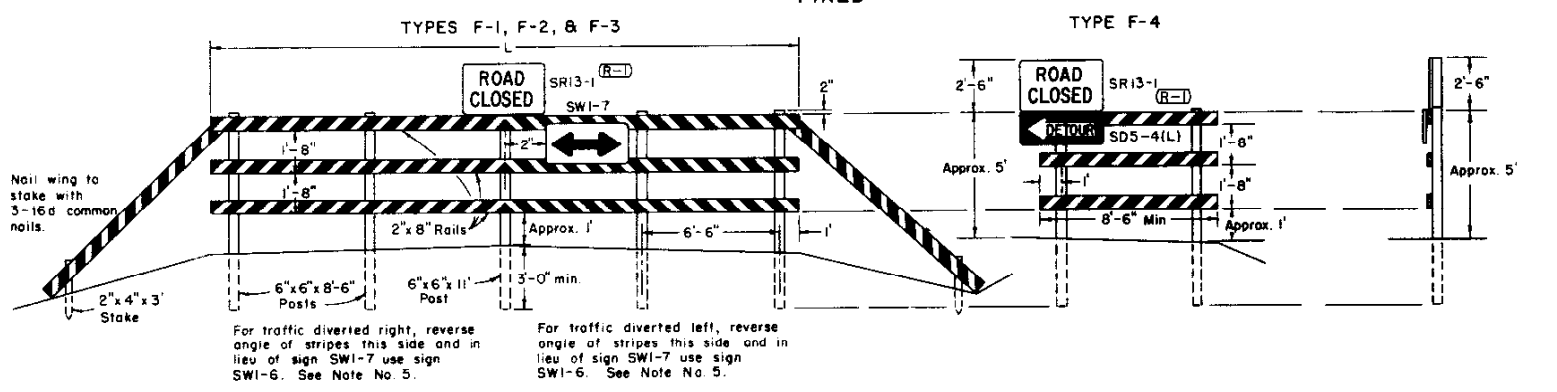

CLASS II BARRICADE
(1 RAIL)

FIXED
TYPE F-6

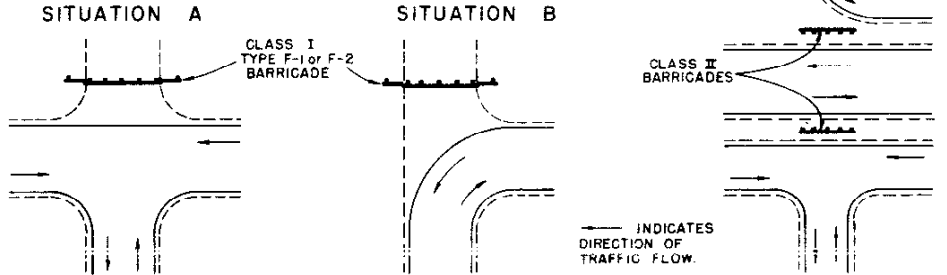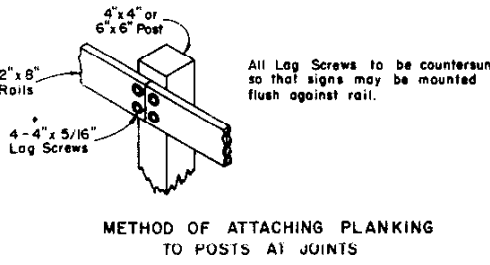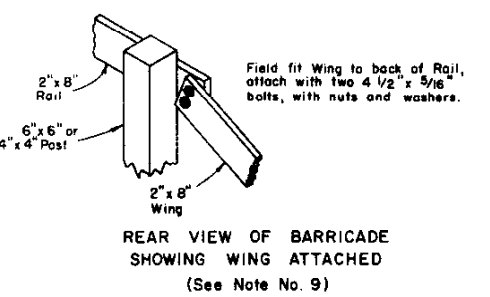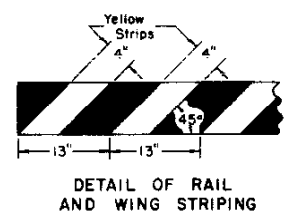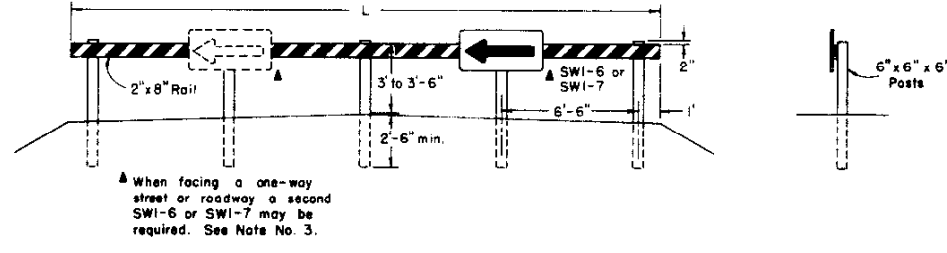

STANDARD M-614-A
(JULY 1, 1965)

FEDERAL ROAD REGION NO.	DISTRICT	PROJECT NO.	NO.
9	COLORADO		
REVISIONS			
(R-1)	11-15-68	Rev. Dept. Name & Code Nos.	JLS
(R-2)	4-23-69	Rev. Code No. & Notes	JLS

GENERAL NOTES

- All work shall be done in accordance with the Standard Specifications applicable to the Project.
- All signs and sign materials shall conform to the standards set forth in the "Manual on Uniform Traffic Control Devices for All Classes of Streets and Highways" published by the Division of Highways and this standard.
- The various types and combinations of approved Signs and Beacons for Barricades required for each project shall be governed by field conditions and subject to approval by the Engineer. All traffic controls shall be placed for best visibility and legibility and maintained in good condition at all times. Oversigning is to be avoided.
- Painting shall conform with Subsection 508.08 of the Standard Specifications. All skids, braces, and posts shall be painted with 2 coats of "Exterior Black Paint." Planking and wings on all barricades shall be painted with 2 coats of "Exterior Black Paint" on all sides before adding reflective strips. Reflective strips shall be "cut from smooth surface yellow reflective sheeting" of a type approved by the Division.
- Each barricade rail shall be striped on the face side only with reflective yellow strips slanting downward at a 45° angle toward the side to which traffic is to turn or pass. See "DETAIL OF RAIL AND WING STRIPING."
- When barricades are designated on plans the portion of the posts below ground line shall either be dipped in or painted with hot creosote oil. The portion of the post above ground line shall be painted with 2 coats of "Exterior Black Paint."
- All skids, braces, and posts shall be nailed together with No. 20d nails. All screws, bolts, nuts, and washers shall be galvanized or cadmium plated. Skids (bases) of movable barricades shall be weighted where necessary to provide stability.
- All timber shall be Standard Grade or better, S4S, Douglas Fir or Larch, as described in the 1965 Standard Grading Rules published by the Western Wood Products Association, and shall conform to paragraph 123c for the rails and paragraphs 122c and 125c for the posts.
- Detachable extension wings for bypassing of construction equipment are permitted. "W" is variable, length shall be adequate to provide closing of borrow pit and/or shoulder as required.
- Alternate materials or other reflective elements on Traffic signs or Barricades will be permitted only after approval of such material by the Division in writing.
- A Flashing Beacon for use on Barricades is a section of a standard traffic signal head or a similar-type device having a yellow lens in the face, which is illuminated by intermittent flashes. Where commercial power is not available, the beacon may be adapted to operate from storage batteries. Each signal unit lens shall have a visible diameter of not less than 8 inches. Each unit complete shall be of such design as to render the lens when illuminated clearly visible to traffic facing the signal at all distances up to 1000 feet under all atmospheric conditions except dense fog. The color of the yellow lens for caution shall be in accordance with Technical Report No. 1 of the Institute of Traffic Engineers. All beacon flashers shall be equipped with filters for suppression of radio interference. The illuminating element in a flashing yellow beacon shall be flashed at a rate of not less than 50 times nor more than 60 times per minute. The illuminated period of each flash shall be not less than half and not more than two-thirds of the total cycle. The use of Flashing Beacons will be governed by field conditions. Flashing Beacons when warranted generally should be operated continuously throughout the 24 hours of the day. Warrant for Flashing Beacons may be found in Sec. 3G of the "Manual on Uniform Traffic Control Devices for Streets and Highways" published by the U.S. Department of Commerce, Bureau of Public Roads June, 1961 (or latest revision).
- Flashers are portable, power-operated, lens-directed, enclosed lights, illuminated by rapid intermittent flashes of short duration. Flashers may be used in connection with barricades when approved by the Engineer. An array of random flashers which tends to obscure rather than delineate the traveled way will not be permitted. The use of flashers on a job will be governed by Sec. 5D of the "Manual on Uniform Traffic Control Devices for Streets and Highways" published by the U.S. Department of Commerce, Bureau of Public Roads, June, 1961 (or latest revision). The color of the light emitted by a flasher shall be yellow.
- Flashing Beacons and Flashers, when used, shall be positioned above the top rail of the barricades to produce the most effective results.
- Barricades used as "Traffic Controls for Highway Construction" are not to be paid for separately.
- Barricades will be paid for separately when designated on plans as bid items.
- For additional general information on control of traffic through work areas refer to the "Manual on Uniform Traffic Control Devices for Streets and Highway", Part X, published by the U.S. Department of Commerce, Bureau of Public Roads, June, 1961 (or latest revision).

BARRICADE DESIGNATIONS						
Class	Type		Roadway Width	L		Description
	Movable	Fixed				
(R-1)	I	M-1	F-1	26'-34'	28'	Barricade complete with SR13-1 sign and SWI-6 or SWI-7 signs as required.
(R-2)	I	M-2	F-2	35'-44'	41'	Barricade complete with SR13-1 sign and SWI-6 or SWI-7 signs as required.
(R-1)	I	M-3	F-3	Variable	28'	Barricade (without extension wings) complete with SR13-1 sign and SWI-6 or SWI-7 signs as required.
	I	M-4	F-4	Variable	Variable 8'-6" min	Wing Barricade (signs only as appropriate).
	II	-	F-6	Variable	28'	Barricade complete with appropriate signs.

DEPARTMENT OF HIGHWAYS
STATE OF COLORADO
DIVISION OF HIGHWAYS

TIMBER BARRICADES


Designed By: D.R.W.
Made By: JLS
Checked by: J.B.

Approved By:
Date: JUL 1, 1965


STANDARD M-614-IC

JULY 5, 1968
(SHEET 1 OF 2 SHEETS)

FEDERAL ROAD REGION NO.	DISTRICT	PROJ NO	SHEET NO.	SHEETS
9	COLORADO			
REVISIONS				
(R-1)	7-26-68	Rev Legend and Notes	G.W.F.	
(R-2)	5-20-69	Rev. Lateral Placement	J. J. B.	
(R-3)	9-25-70	Rev. Legend	J. J. B.	

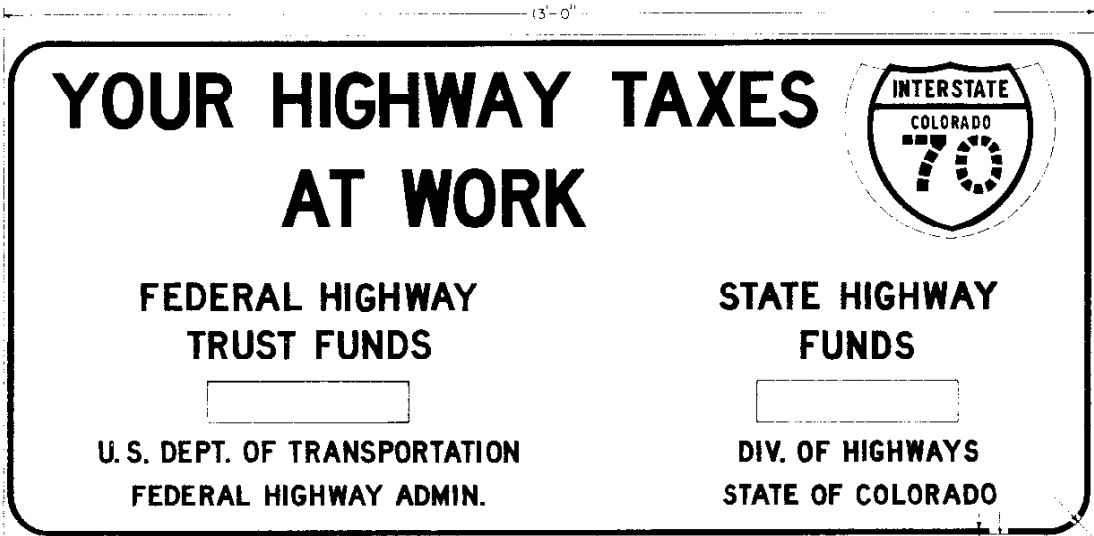


ALTERNATE LEGEND
4" D FEDERAL FUNDS

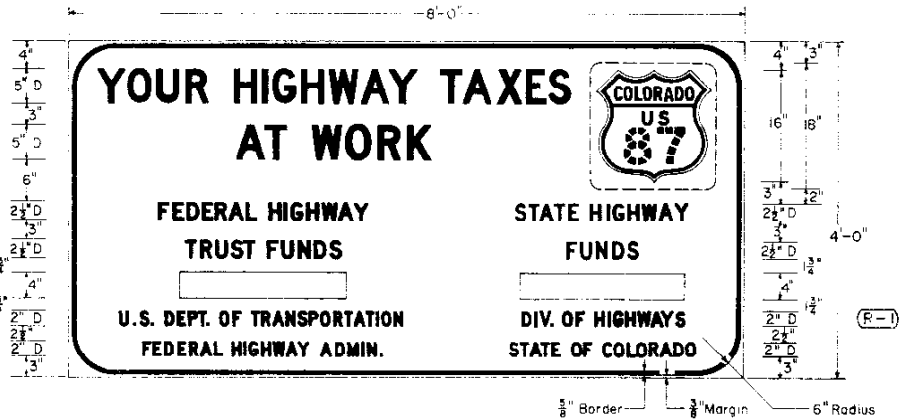

ALTERNATE LEGEND
2 1/2" D FEDERAL FUNDS

FABRICATION DETAILS

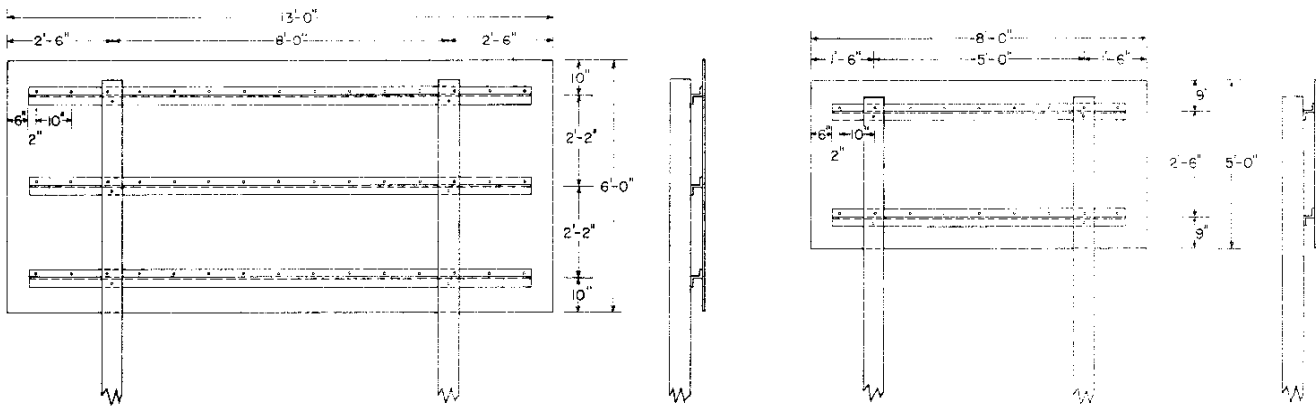


"AMOUNT OF FUNDS" PLAQUE DETAILS



GENERAL NOTES

- These signs shall be furnished and installed by state forces.
- All work shall be done in accordance with Standard Specifications applicable to the Project.
- Signs are to be placed facing traffic approaching the Project. They shall be installed at a location where they will not obscure or detract from the effectiveness of other official signs.
- The lateral placement may be reduced to a minimum of 2 ft. outside of the shoulder edge where necessary to fit field conditions.
- When these signs are used on Beautification Projects, the words "HIGHWAY" and "TRUST" in lines 3 and 4 shall be deleted and the words "FEDERAL" and "FUNDS" shall be used in accordance with the spacing as shown under "Alternate Legend".
- Sign panel shall be fabricated with 3/4" plywood.
- Route Marker plaques and "Amount of Funds" plaques shall be sheet aluminum 0.080" min. thickness.
- Signs shall have a screen processed black legend and border on a plain white background. "Amount of Funds" plaques shall have a screen processed black legend on a plain white background.
- Route Marker plaques shall be plain as indicated on the applicable standards.
- Backing zeos shall be 3" x 2 3/4" x 1/4". Steel zeos shall weigh 6.7 lbs. per ft. and aluminum zeos shall be of 6061-T6 alloy weighing 2.33 lbs. per ft.
- Posts shall be 6"x6", S4S timber, painted white.
- Each timber post shall be provided with two 2" diameter holes through the neutral axis, one at 6" and one at 18" above the ground level. The inside portion of each 2" diameter hole shall be painted white.
- Panels shall be fastened to backing zeos with 1/4" thrust head lockbolt fasteners.
- Backing zeos shall be fastened to posts with 3/8" machine bolts.
- Route Marker plaques and "Amount of Funds" plaques shall be fastened to the sign panels with 5/8" #9 round head wood screws.
- Exposed lockbolt fastener heads and wood screw heads on the face of the sign shall be dipped or painted to match the surrounding color.
- The underground portion of each timber post shall be treated with creosote.
- Where a third governmental agency is shown as participating, its official name should be included centrally in lines 6, 7, and 8.
- It will not be necessary to change DEPT to DIV. on any existing signs.

INSTALLATION DETAIL

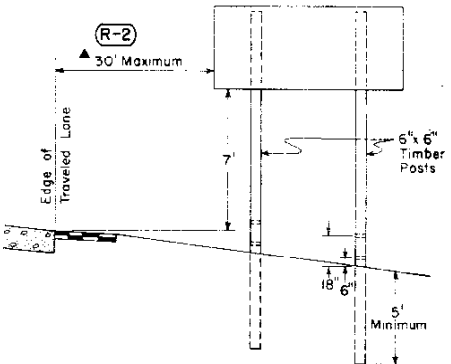


DEPARTMENT OF HIGHWAYS
STATE OF COLORADO
DIVISION OF HIGHWAYS
STANDARD
CONSTRUCTION
IDENTIFICATION
SIGNS

Designed By: J. L. S. Approved By: J. J. B.
Made By: F. J. B. Traffic Engineer
Checked By: J. W. F. Date: 10-12-70

STANDARD M-614-IC

JULY 5, 1968
(SHEET 2 OF 2 SHEETS)

DISTRICT	PROJ. NO.	SHEET NO.	TOTAL SHEETS
4			
COLORADO			
REVISIONS			
R-1	7-26-68	Rev. Legend	G.W.F.
R-2	5-20-69	Rev. Lateral Placement	J.J.B.
R-3	9-25-70	Rev. Legend	J.J.B.

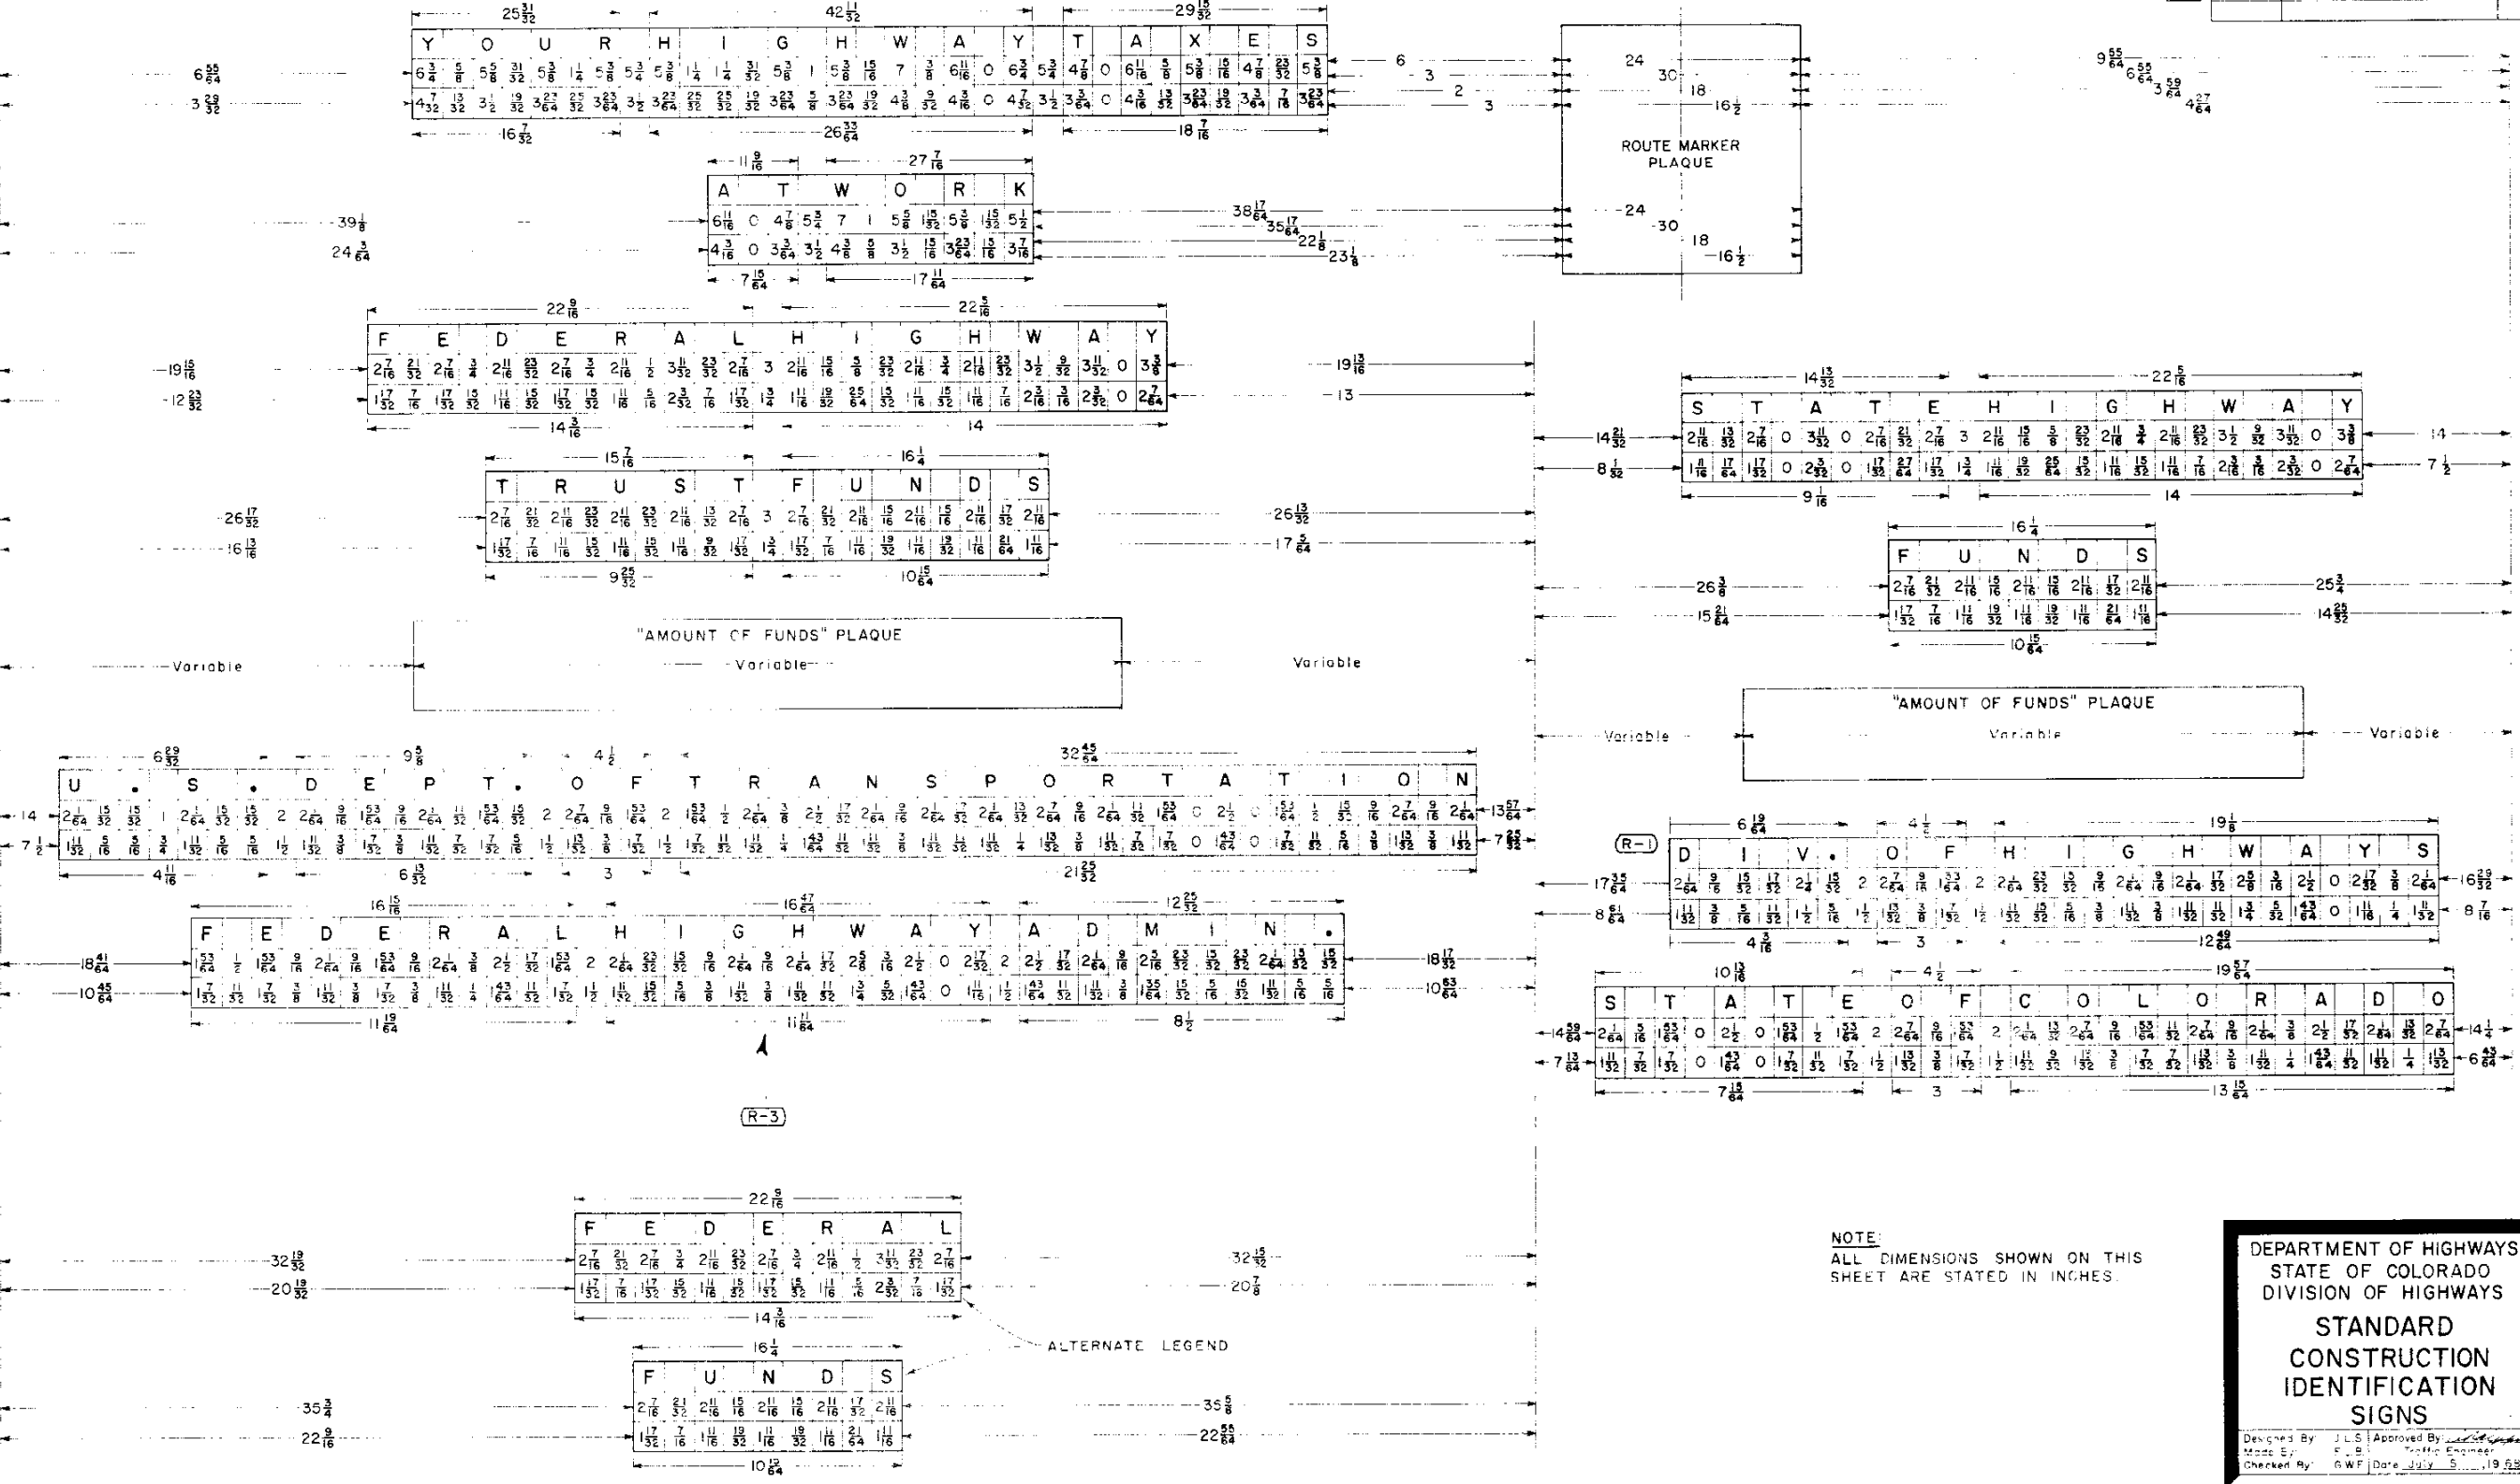

NOTE:
ALL DIMENSIONS SHOWN ON THIS
SHEET ARE STATED IN INCHES.

DEPARTMENT OF HIGHWAYS
STATE OF COLORADO
DIVISION OF HIGHWAYS

**STANDARD
CONSTRUCTION
IDENTIFICATION
SIGNS**

Designed By: J.L.S. Approved By: [Signature]
Made By: F.B. Traffic Engineer
Checked By: G.W.F. Date: July 5, 1968


STANDARD M-614-TB

(SHEET 2 OF 3 SHEETS)


(JULY 1, 1965)

REGULATORY SIGNS


See Note No. 9

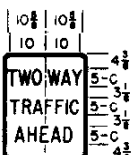


Two Way Traffic Ahead
24"x30"
SR6-3
Margin: 1/8"
Border: 1/8"
Corner Radius: 1 1/2"

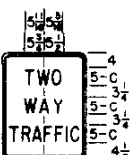

Two Way Traffic
24"x30"
SR6-5
Margin: 1/8"
Border: 1/8"
Corner Radius: 1 1/2"

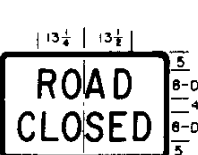


Road Closed
48"x30"
SR13-1
Margin: 1/8"
Border: 1/8"
Corner Radius: 1 1/2"

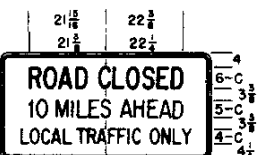


Road Closed 10 Miles Ahead
Local Traffic Only
60"x30"
SR13-1A
Margin: 1/8"
Border: 1/8"
Corner Radius: 1 1/2"

WARNING SIGNS


See Note No. 10

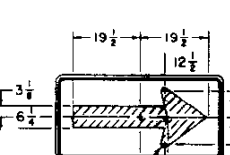

Warning Sign SW1-6
48"x24"
SW1-6
Margin: 1/8"
Border: 1/8"
Corner Radius: 1 1/2"

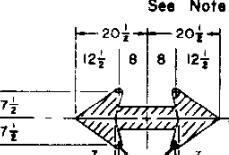

Warning Sign SW1-7
48"x24"
SW1-7
Margin: 1/8"
Border: 1/8"
Corner Radius: 1 1/2"

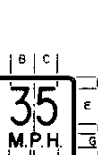


35 M.P.H.
36"x24"
SW13-1
Margin: 1/8"
Border: 1/8"
Corner Radius: 1 1/2"


FEDERAL ROAD REGION NO.	DIVISION	PROJECT NO.	SHEET NO.
9	COLORADO		
REVISIONS			
(R-1)	7-12-67		M.R.H.
(R-2)	7-8-68	Rev. Code No. & Dept. Name	G.W.F.
(R-3)	12-24-68	Added Notes	J.L.S.

WARNING SIGNS


See Note No. 10

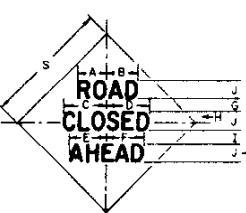


Road Closed Ahead
SW14-3
CW14-3
SW14-4
CW14-4

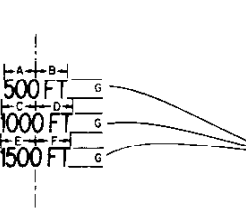


500 FT
1000 FT
1500 FT
SW14-3A
SW14-4A
CW14-3A
CW14-4A

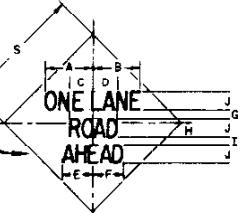


One Lane Road Ahead
SW14-4
CW14-4

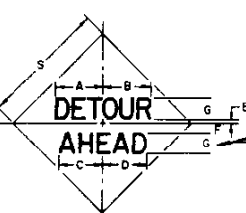


Detour Ahead
SW14-2
CW14-2

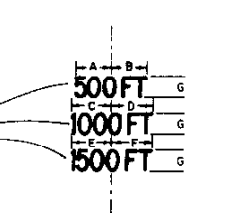


500 FT
1000 FT
1500 FT
SW14-2A
CW14-2A

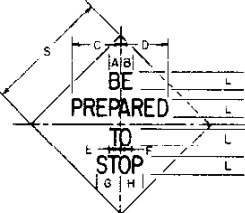


Be Prepared to Stop
SW14-7B
CW14-7B

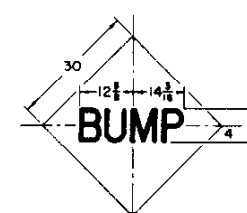


Bump
SW8-1

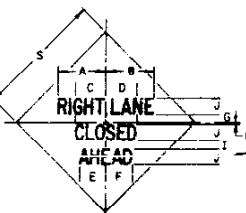


Right Lane Closed Ahead
SW14-6(R)
CW14-6(R)

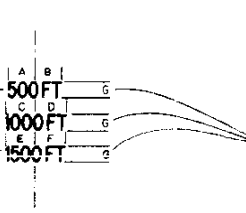


500 FT
1000 FT
1500 FT
SW14-6A(L)
CW14-6A(L)

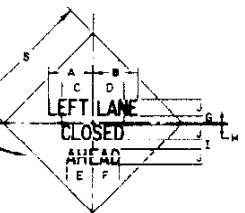


Left Lane Closed Ahead
SW14-6(L)
CW14-6(L)

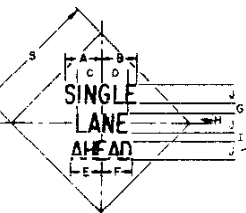


Single Lane Ahead
SW14-5
CW14-5

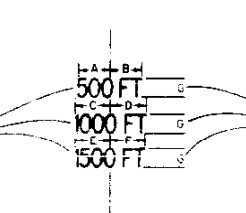


500 FT
1000 FT
1500 FT
SW14-5A
CW14-5A

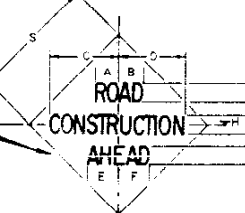


Road Construction Ahead
SW14-1
CW14-1

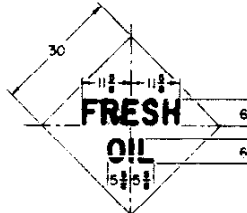


Fresh Oil
SW8-6

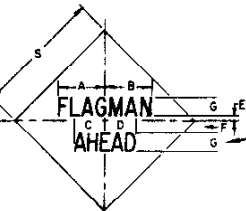


Flagman Ahead
SW14-7
CW14-7

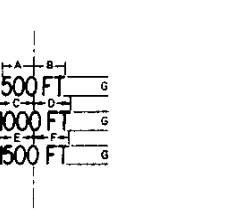


500 FT
1000 FT
1500 FT
SW14-7A
CW14-7A

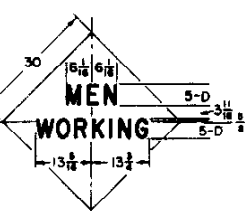

Men Working
SW15-1

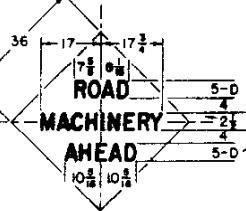

Road Machinery Ahead
SW15-2

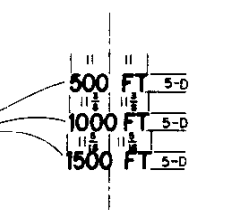

500 FT
1000 FT
1500 FT
SW15-2A

PLATE DETAILS


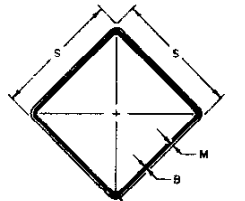


Plate Details
SW15-2A

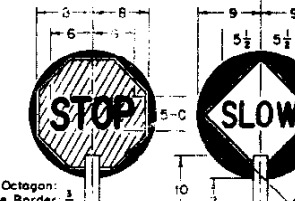


Flagman Sign
Slow
See Notes No. 20 and 22

NOTES:
SEE SHEET 1 FOR TYPICAL SIGNING AND SIGN PLACEMENT.
SEE SHEET 3 FOR GENERAL NOTES APPLICABLE TO SHEETS 1 AND 2.
ALL DIMENSIONS THAT ARE NOT LABELED ARE IN INCHES.

GUIDE SIGNS


See Note No. 11

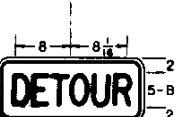


Detour
21"x9"
SM5-6
Margin: 1/8"
Border: 1/8"
Corner Radius: 1 1/2"



Detour
24"x9"
SM5-7(R)
SM5-7(L)
3-D Copy
(R-3) Reverse Dimensions for Left Designation

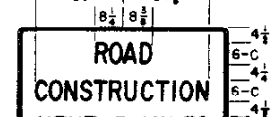


Road Construction Next 5 Miles
60"x36"
SD5-2
Margin: 1/8"
Border: 1/8"
Corner Radius: 1 1/2"

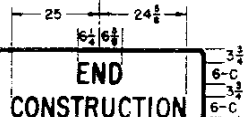

End Construction
60"x24"
SD5-3
Margin: 1/8"
Border: 1/8"
Corner Radius: 1 1/2"



End Road Work
42"x18"
SD5-3A
Margin: 1/8"
Border: 1/8"
Corner Radius: 1 1/2"

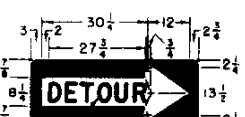

Detour
48"x18"
SD5-4(R)
SD5-4(L)
6-D Copy
(R-3) Reverse Dimensions for Left Designation




Pilot Car Follow Me
36"x24"
SD5-5
Margin: 1/8"
Border: 1/8"
Corner Radius: 1 1/2"

DEPARTMENT OF HIGHWAYS
STATE OF COLORADO
DIVISION OF HIGHWAYS
TRAFFIC SIGNING
FOR HIGHWAY
CONSTRUCTION


Designed By: D.R.W.
Made By: H.R.D.
Checked By: J.B.
Approved By: [Signature]
Date: AUGUST 2, 1965

STANDARD M-614-TB
(SHEET 1 OF 3 SHEETS)
(JULY 1, 1965)

FEDERAL ROAD REGION NO.	DIVISION	PROJECT NO.	Sheet NO.
9	COLORADO		
REVISIONS			
(R-1)	7-12-67	Note 23	G.W.F.
(R-2)	7-8-68	Rev. Break-away, Placement, Code No.s, & Dept. Name	G.W.F.
(R-3)	12-24-68	Rev. U.S. Shields	J.L.S.

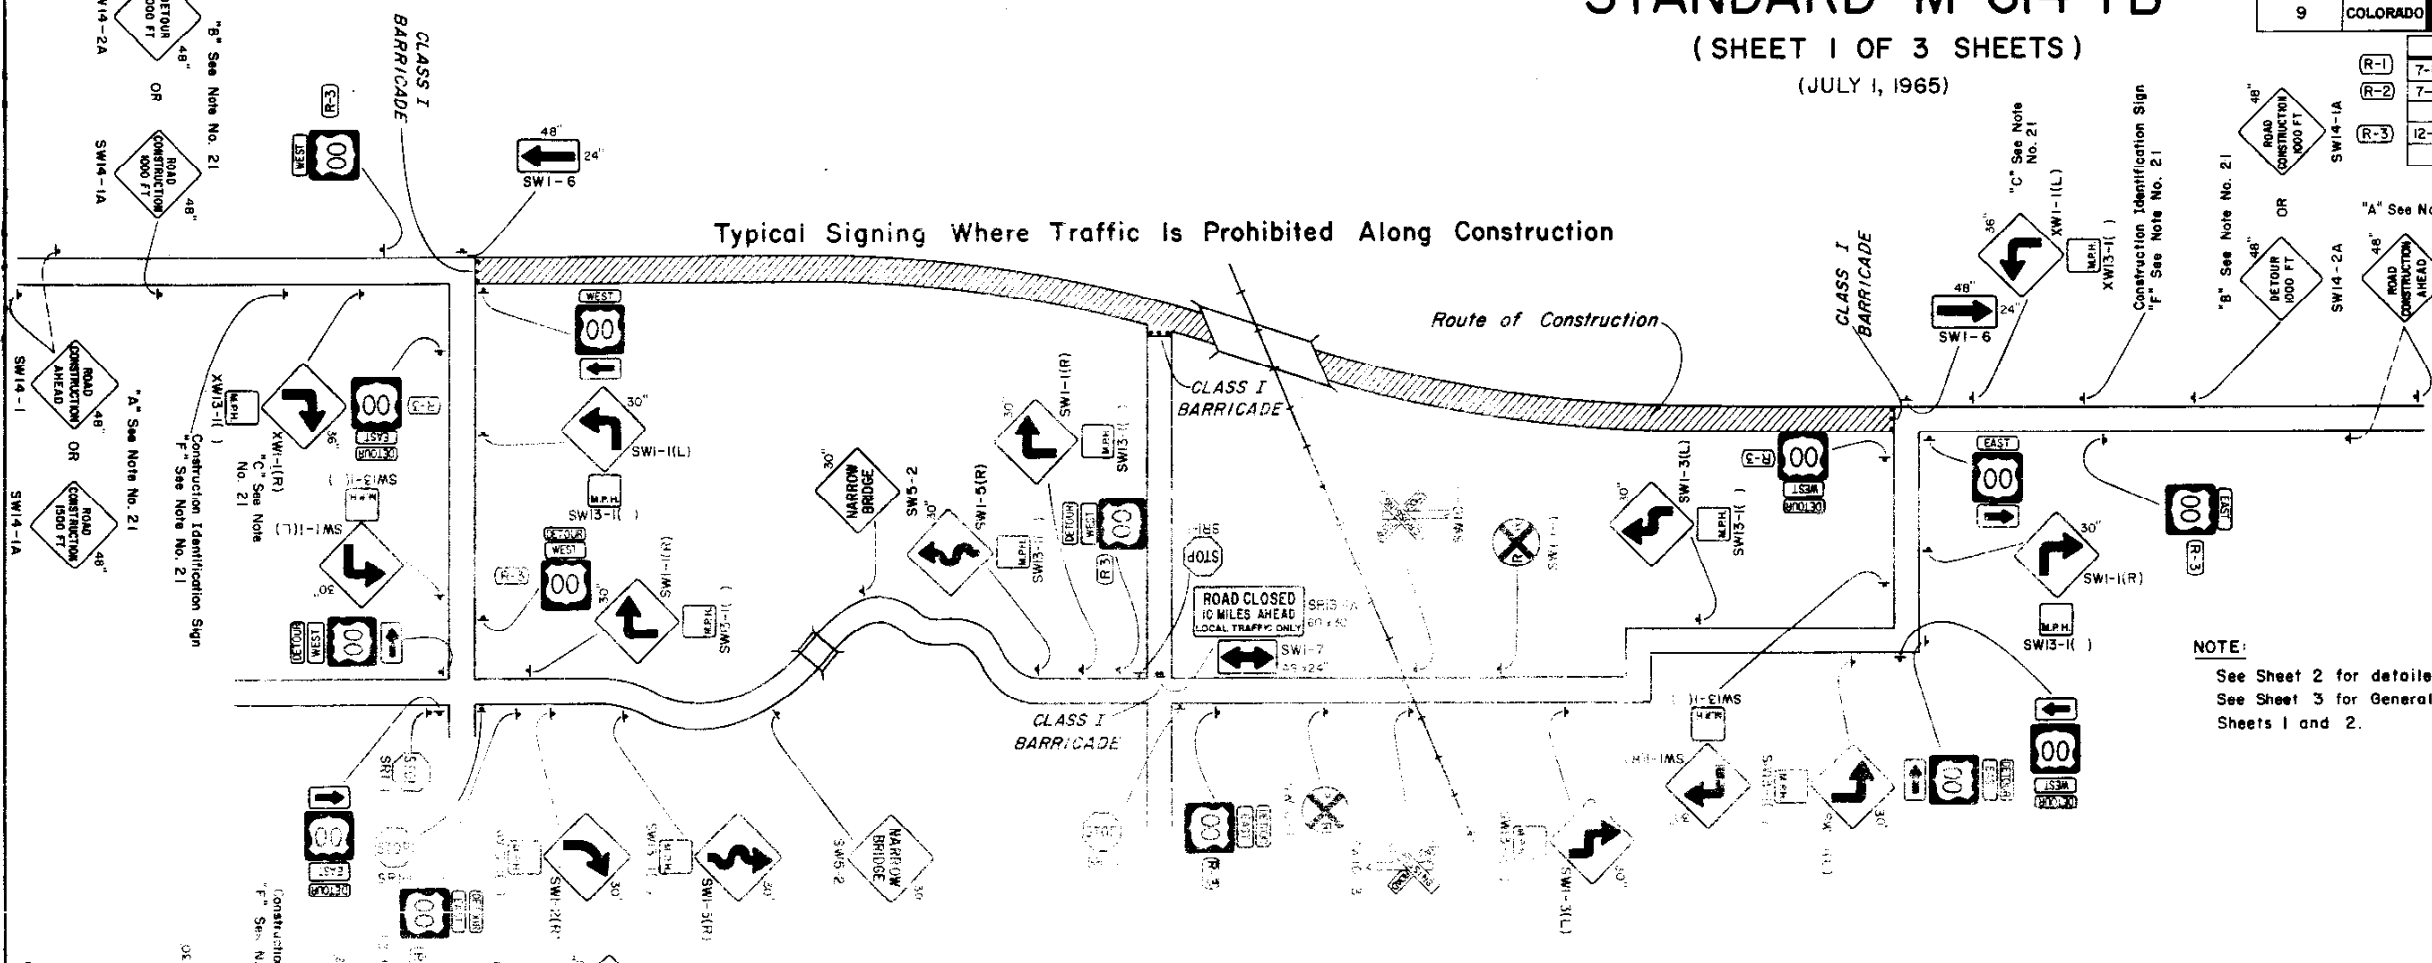


Typical Signing Where Traffic Is Prohibited Along Construction

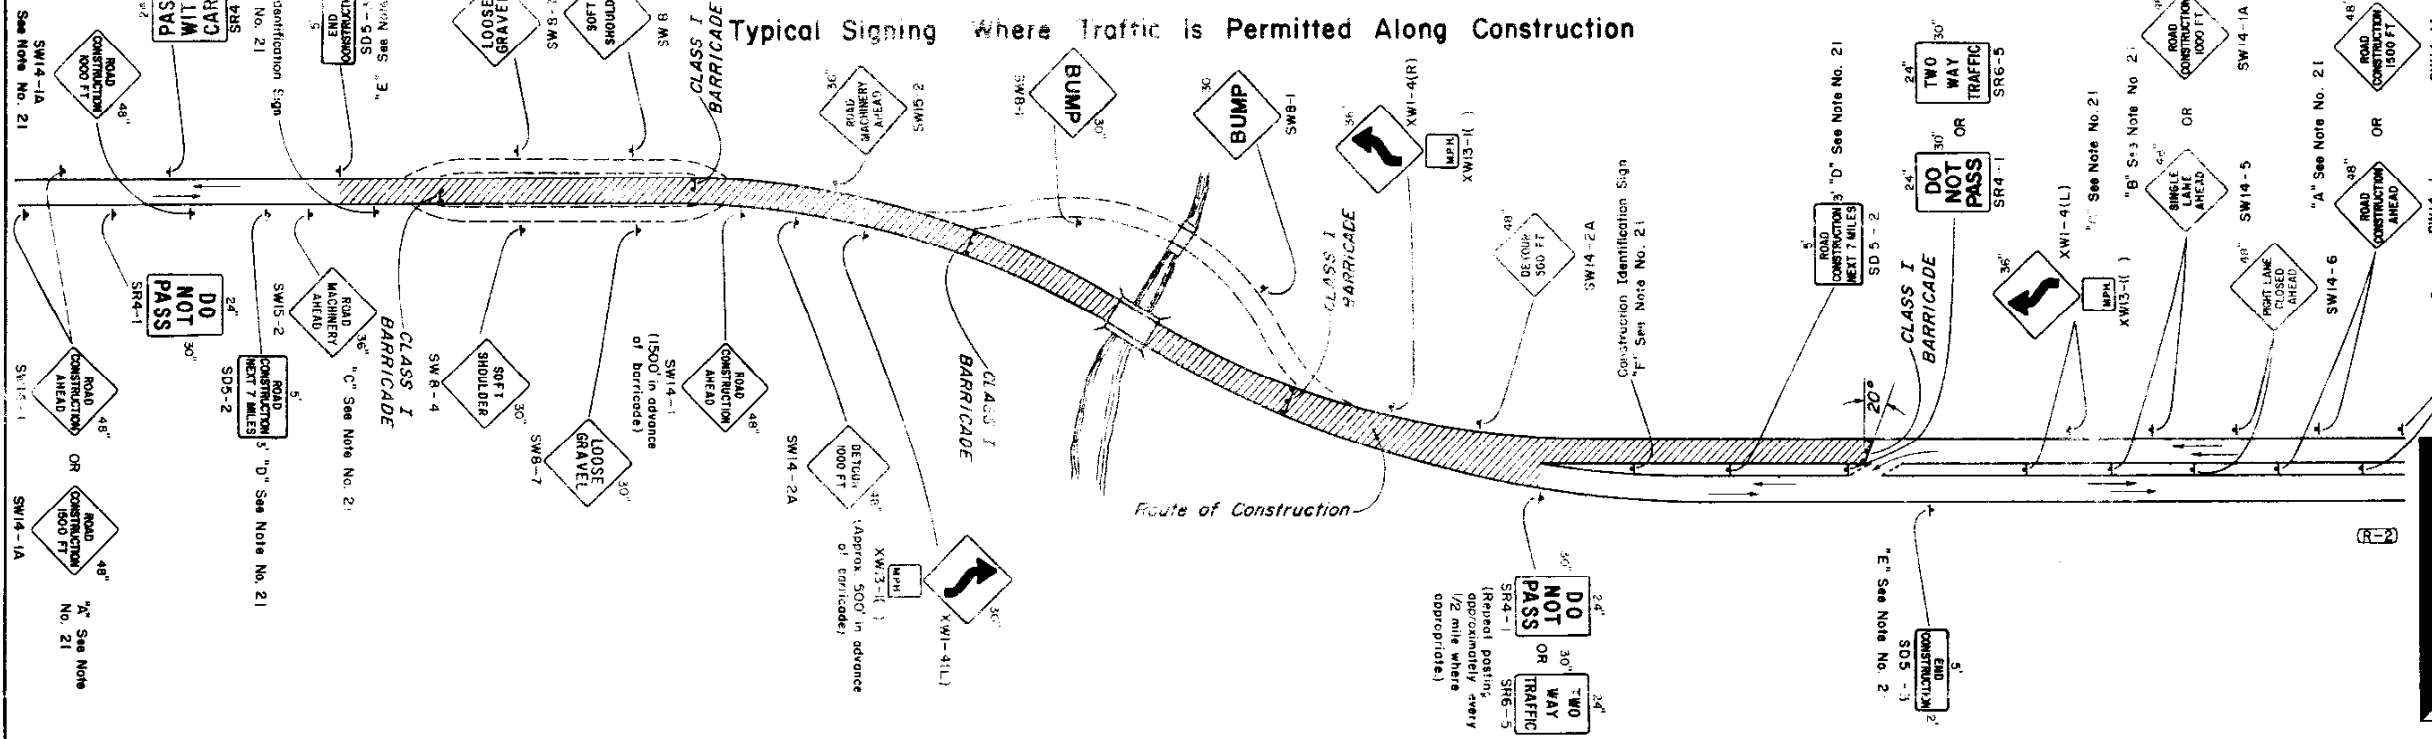

Typical Signing Where Traffic Is Permitted Along Construction

NOTE:
See Sheet 2 for detailed drawings of signs.
See Sheet 3 for General Notes applicable to Sheets 1 and 2.

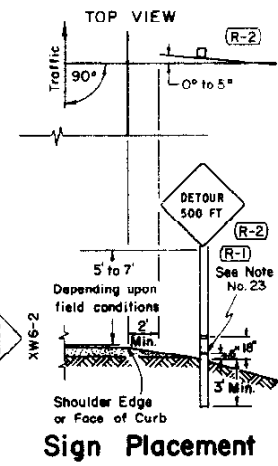

DEPARTMENT OF HIGHWAYS
STATE OF COLORADO
DIVISION OF HIGHWAYS
TRAFFIC SIGNING
FOR HIGHWAY
CONSTRUCTION

Designed By: D.R.W.
Made By: JLS
Checked By: J.B.

Approved By: [Signature]
Traffic Engineer
Date: AUGUST 9, 1965

STANDARD M-614-TB
(SHEET 3 OF 3 SHEETS)
(JULY 1, 1965)

FEDERAL ROAD REGION NO.	DIVISION	PROJECT NO.	S
8	COLORADO		
REVISIONS			
(R-1)	7-12-67	Added Note 23	
(R-2)	7-8-68	Rev. Note 23 & Dept Name - Deleted Note	
(R-3)	12-24-68	Rev. Note No. 18	

GENERAL NOTES

- All work shall be done in accordance with: (a) the Standard Specifications applicable to the Project, and (b) the "Manual on Uniform Traffic Control Devices for all Classes of Streets and Highways" published by the Department of Highways.
- Where traffic is maintained through or over any part of the Project the Contractor will be required to mark all hazards within the limits of the Project (including connecting roads) with well-maintained Barricades, Warning, and Guide Signs. All Barricades and Signs shall be moved, added to, changed or removed as required during the progress of construction and removed entirely when the Project is completed.
- Where traffic is prohibited from the Project the Detour will be marked by the Department except that the Contractor shall provide, erect and maintain Barricades, complete, (when required) at the ends of the Project, ends of the Detour and connecting roads. All U.S. or State Route Markers required for the Project will be furnished and installed by the Department. The location and positioning of Warning Signs, Barricades, and Regulatory Signs shall be as recommended by the appropriate District Engineering Forces of the Department.
- Work on the Project shall not be started until all required signs are in place and approved by the Engineer. Where speed control appears necessary such speed control shall be requested from the Engineer by the Contractor. Control of speed through a construction zone may be achieved by Advisory Speed plates in conjunction with Warning Signs (SW13-1 for use with 30" Warning Signs and XW13-1 for use with 36" and 48" Warning Signs). The Advisory Speed plate is to be posted only at those locations where the safe speed is lower than the imposed Regulatory speed limit.
- All Signs and Barricades shall be placed for best visibility and legibility, maintained in good condition and kept clean and free of dirt at all times. Contractor's and Engineer's vehicles and equipment must be parked so that signs and barricades are visible to approaching traffic at all times.
- Where two identical signs are used for dual posting they are to be staggered on the two sides of the roadway for a minimum distance of 75' to avoid a tunneling effect.
- Examples for marking Projects, as shown on Sheet 1, are typical of signs required and are subject to alteration to fit actual conditions encountered in the field. Locations for control devices are to be staked by the Engineer. In all cases Warning signs are to be placed well in advance of the hazard, the distance depending on topography and existing approach speeds. Additional markings and any special signs required for the guidance and protection of traffic will be placed as required on the Project at the Contractor's expense.
- Desirable sizes for signs are shown on Sheet 1 of this Standard. Larger or smaller signs shall be used where warranted. Detailed dimensions for signs normally used in connection with construction are shown on Sheet 2 of this Standard. For information on standard roadway signs not detailed on this Standard see the "Manual on Uniform Traffic Control Devices for all Classes of Streets and Highways" published by the Department of Highways.
- Signs with the prefix "R" in the sign code are Regulatory signs and as such impose legal compulsions or restrictions on drivers and should only be used as authorized by the Engineer.
- Signs with the prefix "W" in the sign code are Warning signs and are used to alert traffic to existing or potentially hazardous conditions.
- Signs with the prefix "D" or "M" in the sign code are Guide signs. Those with the prefix "D" convey general information and those with the prefix "M" are used for marking the traffic route.
- All signs shall be reflectorized unless otherwise specified on plans. Regulatory and Guide signs (unless otherwise specified) shall have a screen processed black legend and border on a white flexible reflective sheeting, non-exposed lens background. The back side of Regulatory and Guide signs shall be painted with two coats of "Exterior Sign White Paint." Warning signs shall have a screen processed black legend and border on a highway yellow flexible reflective sheeting, non-exposed lens background. The back side of Warning signs shall be painted with two coats of "Federal Yellow Synthetic Sign Enamel."
- Painting for wood surfaces shall conform with Section 508 of the Standard Specifications.
- Posts for regulatory, warning, and guide signs will normally be 4"x4" or 6"x6" and shall conform to the Standard Specifications for Untreated Timber-S4S. Timber shall conform to Construction grade Paragraph 123B or 125B of Standard No. 15 Grading & Dressing Rules for West Coast Douglas Fir (1956) or Dense Structural 5B and LL Structural 5B Paragraph 284 or 285 of 1956 Grading Rules for Southern Pine. Posts shall be painted with one coat of "White Wood Primer" and one coat of "Outside White Paint."
- Sign panels furnished by the Contractor for use only during construction may be fabricated from plywood, aluminum, steel or other suitable material but shall be stable and durable enough to other requirements of this Standard.
- All material shall be sound and durable. Barricades, signs, symbols, and lettering shall be of workmanship. Uneven lettering will not be accepted.
- Alternate methods of processing signs or the substitution of symbols or other reflecting elements for painted symbols will be permitted only after approval by the Department.
- (R-3) 18. Lanterns and Torches - Lanterns, with red globes, shall be used only in low speed urban areas. Open-flame torches shall not be used under any circumstances.
- Barricades, Flashing Beacons and Flashers - Refer to appropriate "M" Standard (Timber Barricade for details).
- Flagman Sign - This sign shall have a black painted background on both sides to form a contrast for the octagonal Stop sign and the diamond Warning sign. The "STOP" sign shall be fabricated by reverse screen process using transparent red paint on smooth surface silver reflective sheeting. The "SLOW" side of the Flagman Sign shall be black process paint on smooth surface yellow reflective sheeting. Handle to be grooved on one side to indicate reading direction to Flagman.
- Sign "A": This is the first advance warning sign and shall be placed 1,500 feet ahead of Barricade or project terminal. Postings are required on both sides of the roadway on divided highways. Dual posting is required where warranted on two-lane, two-way highways.
Sign "B": This is the second advance warning sign and shall be placed 1,000 feet ahead of barricade or project terminal. Postings are required on both sides of the roadway on divided highways and singly on two-lane, two-way highways.
Sign "C": This is the third advance warning sign in cases where barricades are used. It shall be placed 500 to 750 feet ahead of barricade or potentially hazardous condition. Posting required on both sides of the roadway on divided highways and singly on two-lane, two-way highways.
Sign "D": SD 5-2 - This sign shall be placed to mark the beginning of a Project of more than 2 miles in extent, where traffic is maintained through the project. It shall be placed singly and near the beginning of construction.
Sign "E": SD 5-3 - This sign shall be placed to mark the end of the Project. It shall be placed singly and may be placed opposite barricade if desirable.
Sign "F": Construction identification signs shall be furnished and installed by the Department on all Federal-Aid and Forest Highway Projects where actual construction is in progress visible to highway users. These signs should be located so as not to obscure or detract the effectiveness of other official signs. Where two or more projects are contiguous the appropriate data may be included in one set of signs. Refer to appropriate "M" Standard (Identification Signs) for sign details.
Signs A through F shall be furnished, installed and maintained by the Department.
- When Flags are used in lieu of the Flagman Sign, they shall be a minimum of 18"x18", of a good grade of bright red material, and fastened securely to a staff of approximately 3 foot length. The free edge should be weighted to insure that the flag will hang vertically even in heavy winds.
- (R-1) (R-2) 23. Each 6"x6" timber sign post shall be provided with two 2" diameter holes through the neutral axis normal to the roadway, one hole at 6" and one hole at 18" above the ground level. The 4"x4" timber posts shall not be provided with any type of break-away device. The inside portion of each 2" diameter hole shall be painted white. The underground portion of each timber post shall be treated with creosote.

DEPARTMENT OF HIGHWAYS
STATE OF COLORADO
DIVISION OF HIGHWAYS
TRAFFIC SIGNS
FOR HIGHWAY
CONSTRUCTION

Designed By D.R.W. Traffic Engineer
Made By J.L.S.
Checked By J.B. Date: AUGUST 5