


FEDERAL ROAD DISTRICT NO.	DIVISION	PROJECT NO.	SHEET NO.	TOTAL SHEETS
XIII	COLORADO	HES 0004 (23)	15	

AS CONSTRUCTED	REVISED	VOID
☐	☐	☐

Note: For More Details of Box Culvert Extensions See C.B.C. Extension Detail Sheet.


REVISIONS

NOTES:
1 BENCHMARK SPIKE IN POWER POLE, EAST SIDE OF 63RD ST. AT NW COR. OF HUGH M. WOODS BLDG. ELEV. = 5150.77 C.O.B. DATUM
2 BASIS OF SURVEY: THE EAST LINE OF THE SEV4 OF SECTION 3 T1N, R70W OF THE 6TH P.M. AS BEARING N00°06'12"W COORDINATES OF THE SE CORNER OF SECTION 3, T1N, R70W ARE 10,000.0000 NORTH & 10,000.0000 EAST.

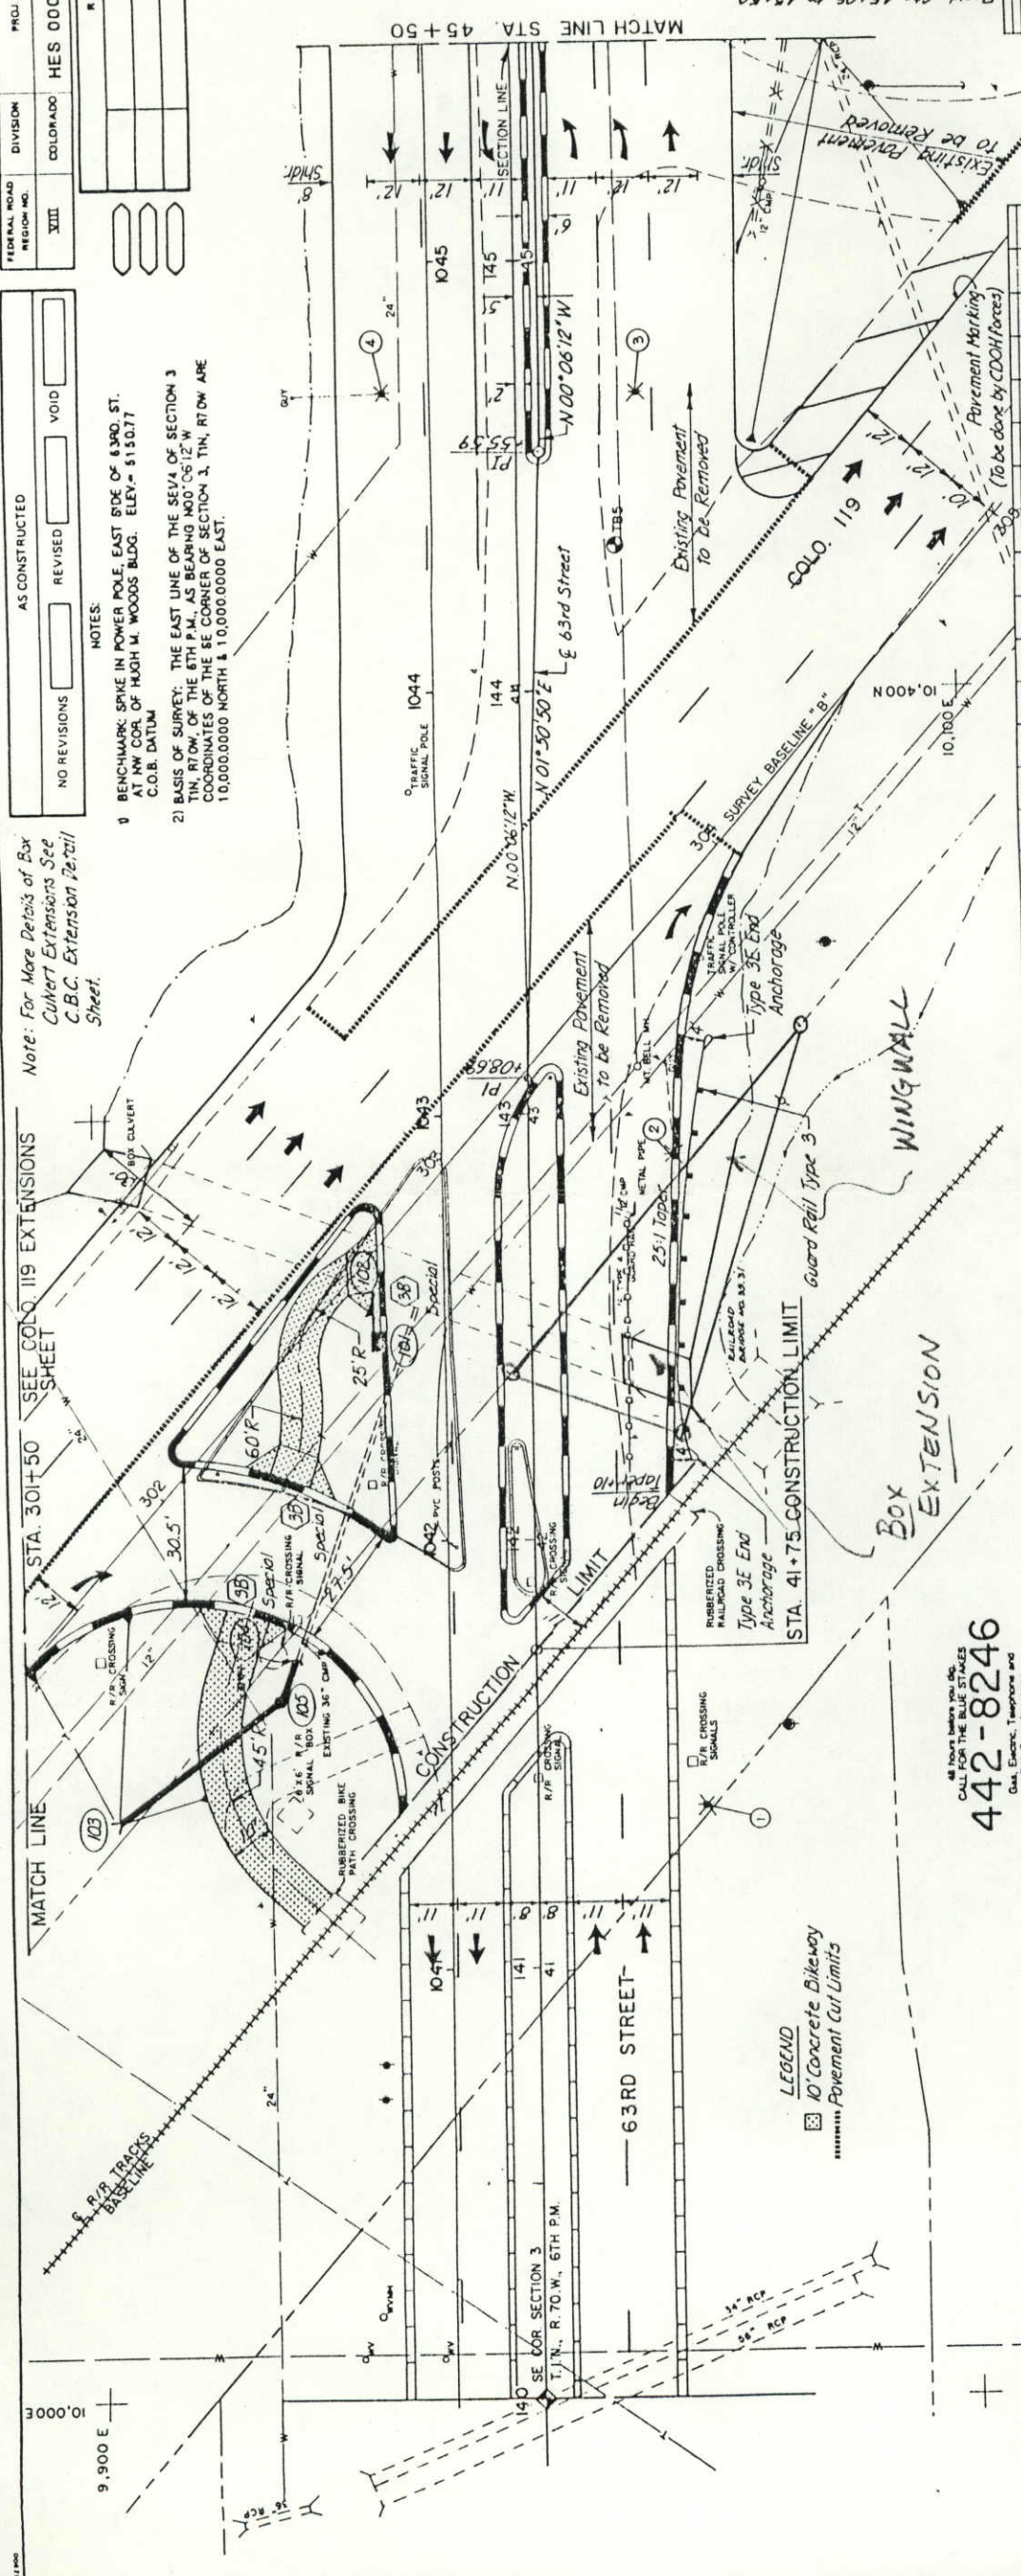

442-8246
ALL POINTS SHOWN ARE TO BE CALLED FOR THE BLUE STAKES
Gas, Electric, Telephone and T.V. Cables Located

LEGEND
10' Concrete Bikeway
Pavement Cul Limits

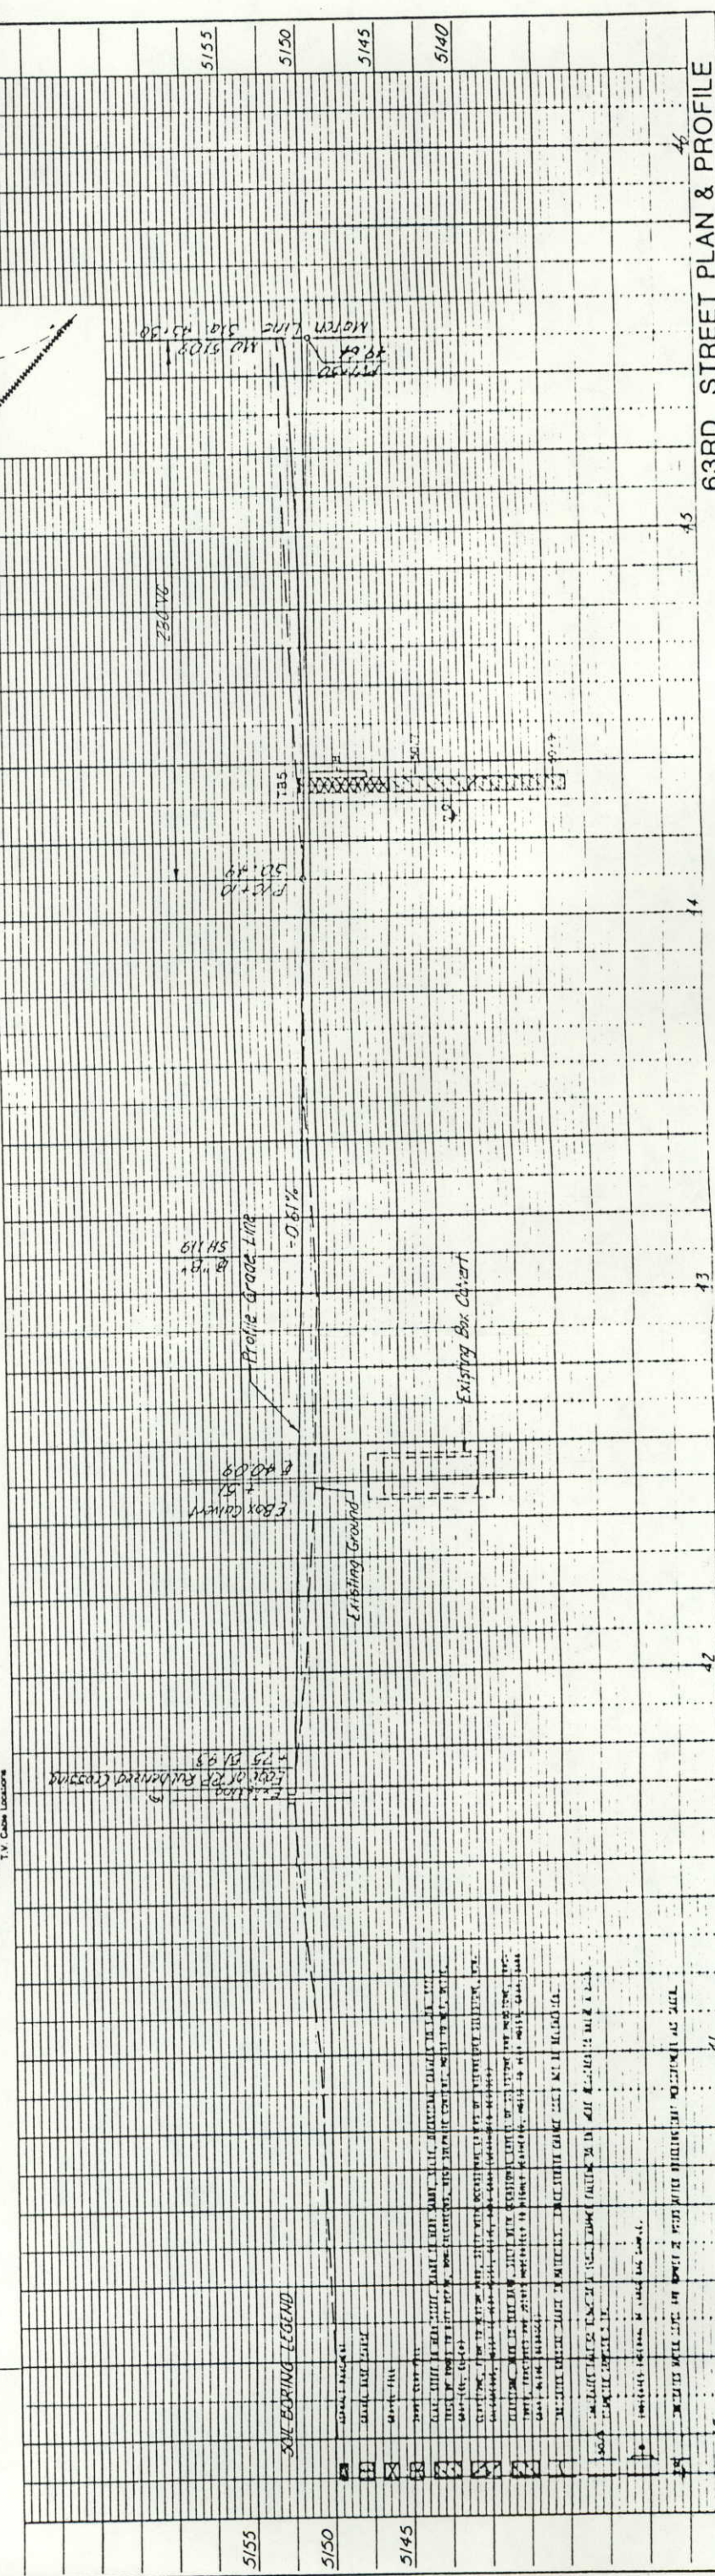

63RD STREET PLAN & PROFILE

120° = 120°

N 40° 03' 23" E 6.25'

SEE 1/4 SECTION 3
TIN, 270 W

COMPUTER PLOT:
BOX CULVERT BASEMENT LYING
IN R.O.W OF COLORADO;
SOUTHERN R/R
63RD STREET PROJECT

SOUTHERN R.R.
63RD STREET PROJECT

SW 1/4, SECTION 2
T1N, R70W

1 COLORADO
SOUTHERN R.R. E-O-W
(100' in width)

PROPOSED IMPROVEMENTS

EAST LINE SE 1/4 SECTION 3

10036'12" W

COLORADO Hwy # 119
DIAGONAL HIGHWAY

THE GREENS
INDUSTRIAL MA
REPT# 35239
P.B. F.3 #30

PREPARED BY:

C.O.B. R.O.W — 63rd St

$$\begin{array}{r} \text{NCC}^{\cdot} 2612\text{-M} \\ \hline 244.93 \end{array}$$

63RD STREET

WEST LINE SW 1/4 SECTION 2

① 1-SW COPPER, SECTION 2, TIN, R70 W