

STATE DEPARTMENT OF HIGHWAYS
DIVISION OF HIGHWAYS—STATE OF COLORADO

PLAN AND PROFILE OF ~~PROPOSED~~ AS CONSTRUCTED
FEDERAL AID PROJECT NO. HES 0004(36)


STATE HIGHWAY NO. 34
WELD COUNTY

THIS PROJECT IS COMBINED WITH HES 0004 (39) FOR CONSTRUCTION.

INDEX OF SHEETS

1	TITLE SHEET
2	STANDARD PLANS LIST
3	GENERAL NOTES, TYPICAL SECTIONS AND SCHEDULE OF TRAFFIC CONTROL DEVICES
4, 5	SUMMARY OF APPROXIMATE QUANTITIES
6	TABULATION OF CURB AND GUTTER, CONCRETE SIDEWALK & CONCRETE PAVEMENT, AND CONCRETE CURB RAMP, OILING QUANTITIES, SURFACING QUANTITIES, AND STABILIZATION DATA.
7	CONSTRUCTION PLAN AND PROFILE
8	TRAFFIC SIGNAL PLAN
9	STRIPING PLAN
10	TRAFFIC CONTROL PLAN
11-13	SIGNAL DETAIL SHEETS

R66W
PROJECT LOCATION
HES 0004 (36) M.P. 8.254

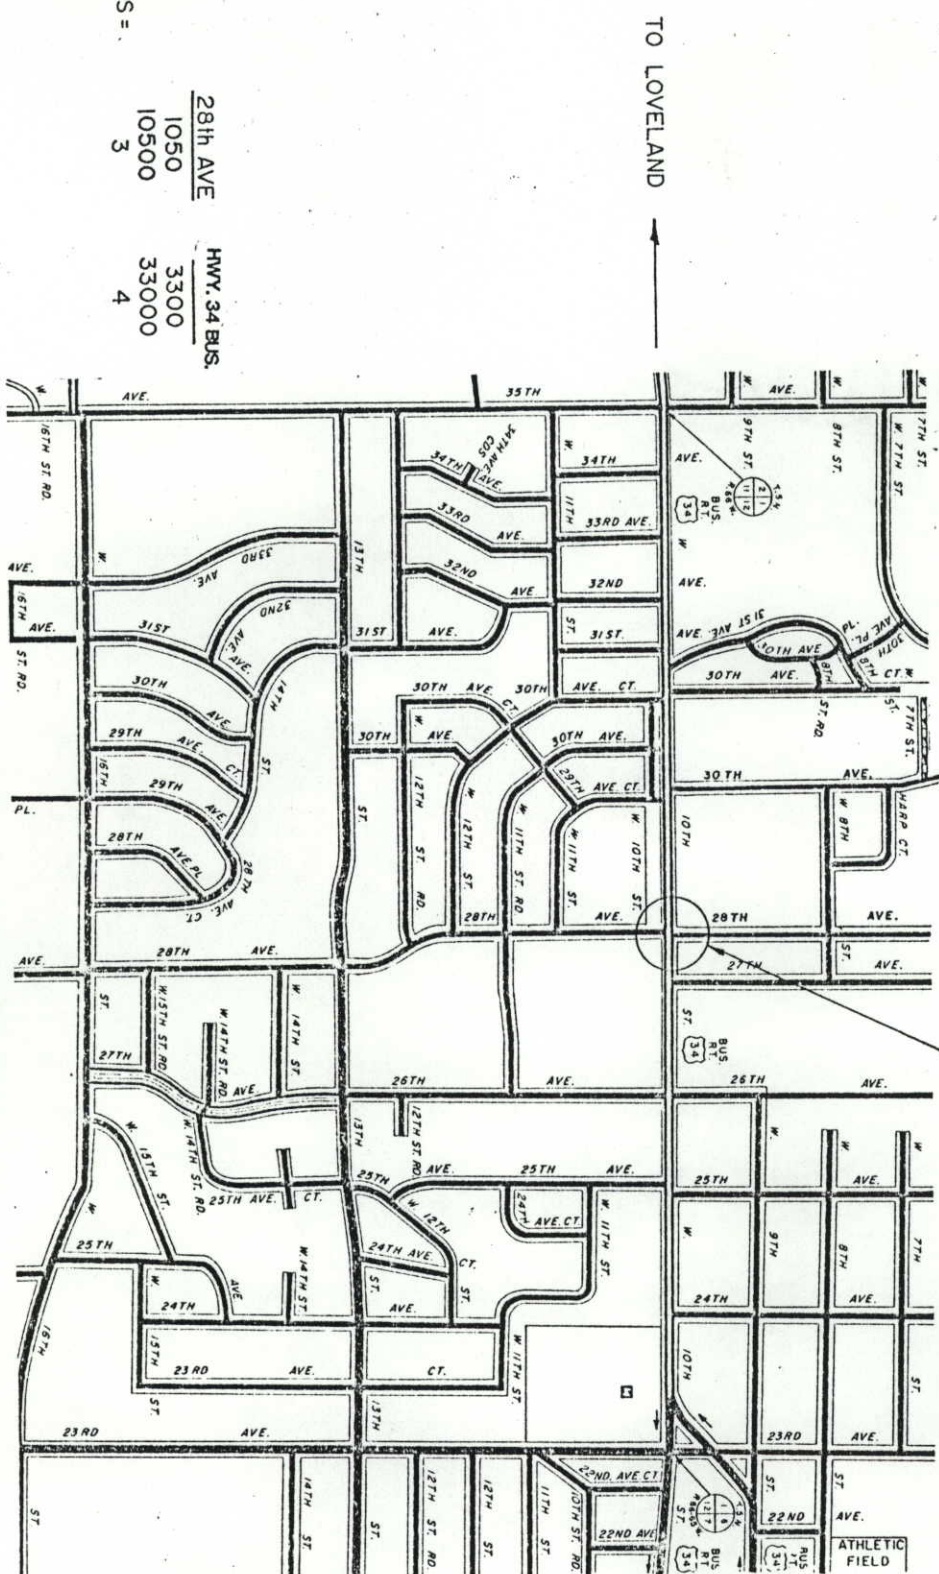

DESIGN DATA
2010 DESIGN TRAFFIC VOLUME DHV =
ADT = 1050
% TRUCKS = 3
28th AVE 3300
HWY. 34 BUS. 33000
4

CITY OF GREELEY

SCALE IN FEET
0 500 1000 1500
SCALE IN METRES
0 100 200 300 400

AS CONSTRUCTED PLANS
RETURN TO DIST. 4 DESIGN

PLANS PREPARED BY: CITY OF GREELEY
DEPARTMENT OF PUBLIC WORKS/TRAFFIC
CITY HALL
GREELEY, COLORADO 80631
BY: *John C. Bouda*
DATE: 1-17-90

AS CONSTRUCTED INFORMATION
CONTRACTOR *Stevens Electric Co.*
DESIGN ENGINEER *Kenneth L. Dwyer*
(Project or Resident)
PROJECT STARTED *August 6, 1990*
PROJECT COMPLETED *November 26, 1990*
AS CONSTRUCTED PLANS *Plotted*
APPROVED *R. L. Hite* DATE *2/2/91*
TITLE

88168

GRR/Dist. 4

AS CONSTRUCTED

NO. REVISIONS10-26-72

REVISED

VOID

FEDERAL ROAD REGION NO.	DIVISION	PROJECT NO.	SHEET NO.	TOTAL SHEETS
VIII	COLORADO	HES 0004 (36)	2	13

Plan No.	Title	Page
☒ M-100-1	STANDARD SYMBOLS.....	1
☐ M-107-1	TEMPORARY EROSION CONTROL.....	2
☐ M-203-1	APPROACH ROADS, FLARING, CUT SLOPE TREATMENT, BRIDGE & CREST WIDENING.....	3
☐ M-203-2	DITCH TYPES.....	4
☐ M-203-10	SUPERELEVATION OF CURVES - CROWNED HIGHWAYS.....	5
☐ M-203-11	SUPERELEVATION OF CURVES - DIVIDED HIGHWAYS - SHOULDER PIVOT.....	6
☐ M-203-12	SUPERELEVATION OF CURVES - STREETS.....	7
☐ M-203-13	SUPERELEVATION OF CURVES - DIVIDED HIGHWAYS - CENTER PIVOT.....	8
☐ M-206-1	EXCAVATION AND BACKFILL FOR STRUCTURES..... (2 SHEETS)	9
☐ M-206-2	EXCAVATION AND BACKFILL FOR BRIDGES.....	11
☐ M-214-1	PLANTING DETAILS.....	12
☐ M-412-1	CONCRETE PAVEMENT JOINTS.....	13
☐ M-504-1	STEEL CRIBBING.....	14
☐ M-506-1	GABIONS AND SLOPE MATTRESS.....	15
☐ M-510-1	STRUCTURAL PLATE CULVERT PIPE - H-20 LOADING..... (2 SHEETS)	16
☐ M-601-1	SINGLE CONCRETE BOX CULVERT.....	18
☐ M-601-2	DOUBLE CONCRETE BOX CULVERT.....	19
☐ M-601-3	TRIPLE CONCRETE BOX CULVERT.....	20
☐ M-601-10	HEADWALL FOR PIPE CULVERTS.....	21
☐ M-601-11	TYPE "S" SADDLE HEADWALL FOR PIPE CULVERTS.....	22
☐ M-601-12	HEADWALL, INTERCEPTING HEADWALL AND CULVERT OUTLET PAVING.....	23
☐ M-601-20	WINGWALLS FOR PIPE OR BOX CULVERTS.....	24
☐ M-603-1	METAL CULVERT PIPE - H-20 LOADING..... (2 SHEETS)	25
☐ M-603-2	REINFORCED CONCRETE PIPE.....	27
☐ M-603-3	PRECAST CONCRETE BOX CULVERT.....	28
☐ M-603-10	CONCRETE AND METAL END SECTIONS.....	29
☐ M-604-1	PIPE SEWER IN TRENCH.....	30
☐ M-604-10	INLET, TYPE C.....	31
☐ M-604-11	INLET, TYPE D.....	32
☐ M-604-12	CURB INLET, TYPE R..... (2 SHEETS)	33
☐ M-604-13	CONCRETE INLET, TYPE 13.....	35
☐ M-604-20	MANHOLES.....	36
☐ M-604-21	STEPS FOR MANHOLES & INLETS.....	37
☐ M-606-1	GUARD RAIL, TYPE 3, W-BEAM..... (8 SHEETS)	38
☐ M-606-2	GUARD RAIL, TYPE 3, W-BEAM FOR LOCAL ROADS & STREETS..... (4 SHEETS)	46
☐ M-606-10	GUARD RAIL, TYPE 4, CONCRETE BARRIER, CAST-IN-PLACE.....	50
☐ M-606-11	GUARD RAIL, TYPE 4, CONCRETE BARRIER, PRECAST-PORTABLE.....	51

Plan No.	Title	Page	Plan No.	Title	Page
☐ S-612-1	WIRE FENCES AND GATES.....	(2 SHEETS) 52	☐ S-614-1	TYPICAL DELINEATOR INSTALLATIONS..... (4 SHEETS)	75
☐ M-607-1	CHAIN LINK FENCE.....	(3 SHEETS) 54	☐ S-614-2	TYPICAL GROUND SIGN PLACEMENT.....	79
☐ M-607-2	BARRIER FENCE.....	57	☐ S-614-3	CLASS I GROUND SIGN INSTALLATIONS.....	80
☐ M-607-3	DEER FENCE AND GATE.....	(2 SHEETS) 58	☐ S-614-4	CLASS II GROUND SIGN INSTALLATIONS.....	81
☐ M-607-4	PICKET SNOW FENCE.....	60	☐ S-614-5	CLASS III SIGNS, LAMINATED ALUMINUM PANELS AND POST SPACING TABLE..... (2 SHEETS)	82
☐ M-607-10	CURB RAMPS.....	61	☐ S-614-6	BREAK-AWAY SIGN SUPPORT DETAILS FOR GROUND SIGNS..... (2 SHEETS)	84
☒ M-608-1	CURBS AND GUTTERS.....	62	☐ S-614-10	CONCRETE FOOTINGS AND SIGN ISLANDS FOR CLASS III SIGNS..... (2 SHEETS)	86
☒ M-609-1	CATTLE GUARD - WELDED GRILL UNITS - 10' THRU 42' ROADWAYS.....	(2 SHEETS) 63	☐ S-614-11	TYPICAL MARKER ASSEMBLY INSTALLATIONS.....	88
☐ M-611-1	HIGHWAY LIGHTING.....	(2 SHEETS) 65	☐ S-614-12	MILEPOST SIGN AND INSTALLATION.....	89
☐ M-613-1	EMBANKMENT PROTECTOR, TYPES 3 & 4.....	67	☐ S-614-13	STRUCTURE NUMBER INSTALLATION (BRIDGE INFORMATION SHEET).....	90
☐ M-615-1	EMBANKMENT PROTECTOR, TYPE 5.....	68	☐ S-614-20	STANDARD RAILROAD CROSSING SIGNS AND MARKINGS.....	91
☐ M-615-2	EMBANKMENT PROTECTOR, TYPE 5.....	69	☐ S-614-21	TYPICAL POLE MOUNT SIGN INSTALLATION.....	92
☐ M-616-1	INVERTED SIPHON..... (ALSO USE M-603 OR M-604 AS REQUIRED)	70	☐ S-614-22	CONCRETE BARRIER SIGN POST INSTALLATIONS.....	93
☐ M-620-1	FIELD LABORATORY - CLASS 1.....	71	☐ S-614-30	TYPICAL MULTI-SIGN INSTALLATIONS.....	94
☐ M-620-2	FIELD LABORATORY - CLASS 2.....	72	☐ S-614-31	INTERSTATE ROUTE MARKERS.....	95
☐ M-620-11	FIELD OFFICE - CLASS 1.....	73	☐ S-614-32	U. S. & COLORADO ROUTE MARKERS.....	96
☐ M-620-12	FIELD OFFICE - CLASS 2.....	73	☐ S-614-40	AUXILIARY MARKERS.....	97

THE STANDARD PLAN SHEETS INDICATED HEREON BY A
MARKED BOX ARE TO BE USED TO CONSTRUCT THIS
PROJECT.


DEPARTMENT OF HIGHWAYS
STATE OF COLORADO
DIVISION OF HIGHWAYS

STANDARD PLANS LIST

M & S STANDARDS ~ JANUARY, 1982


TYPICAL SECTIONS

(NO SCALE)

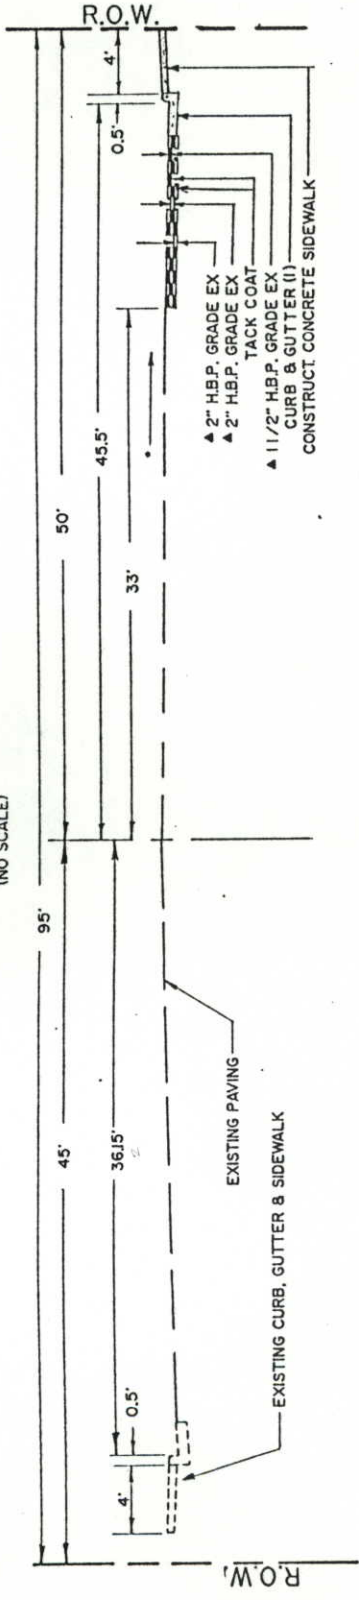


• MATCH EXISTING SLOPE

STA. 0+27 to STA. 3+28 28TH AVE.

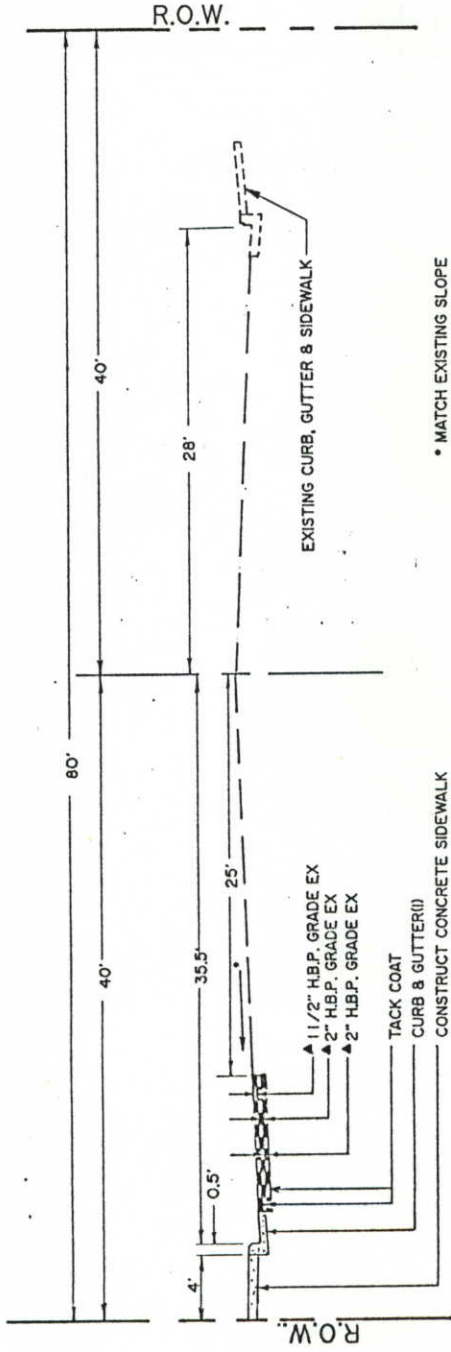


• MATCH EXISTING SLOPE

STA. 4+33 to STA. 7+41 28TH AVE.

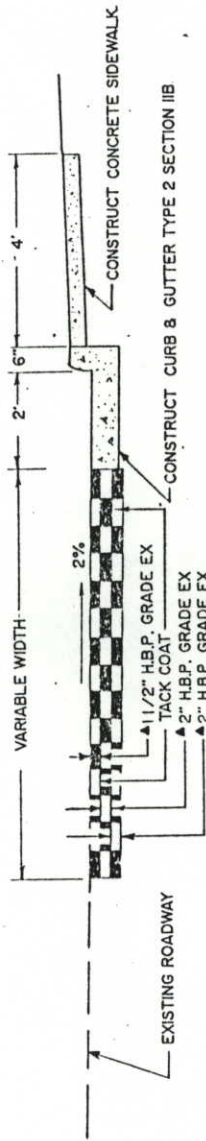

SECTION A-A
NO SCALE

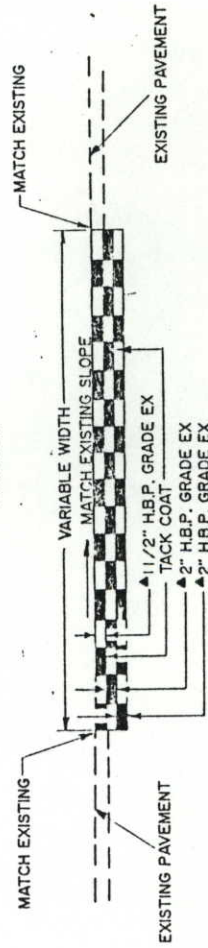

SECTION B-B
NO SCALE

▲ APPROXIMATE THICKNESS

TYPICAL SECTION NOTES

(1) NOTE: VERTICAL FACE CURB & GUTTER, TYPE 2(SECTION IIB)

- CONSTRUCTION SURVEYING TO BE DONE BY CITY FORCES.
- TACK COAT DILUTED EMULSIFIED ASPHALT (SLOW SETTING) @ 0.1 GAL/SQUARE YARD (DILUTED).
- BITUMINOUS PAVEMENT, GRADING EX, @ 110 LBS. PER SQUARE YARD/INCH.
- DILUTED EMULSIFIED ASPHALT FOR TACK COAT SHALL CONSIST OF ONE PART EMULSIFIED ASPHALT AND ONE PART WATER.
- ACTUAL RATES OF APPLICATION TO BE DETERMINED IN THE FIELD BY THE ENGINEER.
- THE FOLLOWING SHALL BE FURNISHED WITH EACH BITUMINOUS PAVEMENT:
 - A SKI TYPE DEVICE AT LEAST 30 FEET IN LENGTH
 - SHORT SKI OR SHOE.
- ANY LAYER OF BITUMINOUS PAVEMENT THAT IS TO HAVE A SUCCEEDING LAYER PLACED THEREON SHALL BE COMPLETED FULL WIDTH BEFORE SUCCEEDING LAYER IS PLACED.
- POWER POLES TO BE MOVED BY OTHERS AT NO COST TO THE PROJECT. CONTRACTOR SHALL COORDINATE THIS WITH THE UTILITY COMPANY.
- FULL DEPTH 3/4" CUT ALL ASPHALT AND CONCRETE PARKING LOTS, DRIVEWAYS, AND SIDEWALKS. REMOVE AND REPLACE AS REQUIRED. COST OF SAWCUTTING SHALL NOT BE PAID FOR SEPARATELY BUT INCLUDED IN OTHER WORK.
- REPLACEMENT OF CONCRETE AT DRIVEWAYS SHALL BE A MINIMUM OF 6 INCHES THICK AND SHALL BE PAID FOR AS CONCRETE PAVEMENT.
- REMOVAL OF CONCRETE DRIVEWAYS TO BE PAID FOR UNDER REMOVAL OF SIDEWALK.
- EXISTING STRIPING REMOVAL AND NEW STRIPING WILL BE DONE BY CITY FORCES. CONTRACTOR SHALL FURNISH TEMPORARY TRAFFIC CONTROL FORCES FOR TEMPORARY AND PERMANENT STRIPING INSTALLATION AT NO COST TO THE PROJECT.
- EXISTING TRAFFIC SIGNAL POLE BASES TO BE REMOVED TO 12 INCHES BELOW FINISHED GRADE AND PATCHED TO MATCH EXISTING MATERIALS (COST TO BE INCLUDED IN THE REMOVAL ITEM).
- CONTRACTOR TO MAINTAIN ACCESS TO ALL BUSINESSES DURING ALL PHASES OF CONSTRUCTION AT NO ADDITIONAL COST TO THE PROJECT.
- REMOVED TRAFFIC SIGNAL EQUIPMENT TO BE RETAINED BY THE CITY OF GREELEY. CONTRACTOR SHALL LOAD SALVAGED MATERIAL ONTO CITY OF GREELEY TRUCKS.
- RESETTING SPRINKLERS AND LANDSCAPING WILL BE PAID FOR BY FORCE ACCOUNT ITEM FOR RESET SPRINKLERS AND LANDSCAPING.
- ALL CONDUIT SHALL BE SCHEDULE 80 PVC UNLESS OTHERWISE SHOWN (TRENCHED).
- REMOVAL OF ASPHALT MAT TO BE INCLUDED IN THE UNCLASSIFIED EX BID ITEM, AND THE CONTRACTOR SHALL INCLUDE THIS WORK ON HIS METHOD STATEMENT.
- ~~REMOVED ASPHALT MAT TO BE INCLUDED IN THE UNCLASSIFIED EX BID ITEM, AND THE CONTRACTOR SHALL INCLUDE THIS WORK ON HIS METHOD STATEMENT.~~ 103 CUBIC YARDS OF UNCLASSIFIED EXCAVATION (COMPLETE IN PLACE) WILL BE REQUIRED FOR THIS PROJECT FOR REMOVAL AND WIDENING OPERATIONS. *11/20 ONLY SEE CMO #1*
(Uncl. Excavation (CIP) changed to LS payment by CMO #1)

FINAL SCHEDULE OF CONSTRUCTION TRAFFIC CONTROL DEVICES

SIGN CODE	LEGEND	DIMENSIONS	EACH PANEL SIZE		ITEM	QUANTITY	FINAL
			A	B			
48W20-1	ROAD /CONST/AHEAD	48"x48"	4	5	VERTICAL PANEL(W/LIGHT)8/8EACH	20	20
36W20-1	ROAD /CONST/AHEAD	36"x36"	2	1			
**48W20-5	() /LANE /CLOSED /AHEAD	48"x48"	4	3	TRAFFIC CONE	--EACH	70
**36W20-5	() /LANE /CLOSED /AHEAD	36"x36"	2	2			
**48W4-2	() /LANE TRANSITION	48"x48"	8	3			
**36W4-2	() /LANE TRANSITION	36"x36"	4	2			
24 R4-7a	KEEP RIGHT	24"x30"	—	1			
36R3-7R	RIGHT LANE MUST TURN RIGHT	36"x36"	2	—			
48W20-7a	FLAGGER SYMBOL	48"x48"	4	4			
36W20-7a	FLAGGER SYMBOL	36"x36"	2	2			
60G20-2	END/CONSTRUCTION	60"x24"	4	3			
SPECIAL	Sidewalk Closure/Crossover	36"x48"	—	2			
**TYPE 2 BARRICADE			8	8			
SIGN TOTALS			20	24			
FINAL TOTALS			16	20	ANY TRAFFIC CONTROL DEVICE USED ON ONE PROJECT AND SUBSEQUENTLY MOVED TO THE OTHER PROJECT WILL BE PAID FOR ONLY ONE TIME.		

NOTE: ALL CONSTRUCTION WARNING SIGNS PROVIDED ON THIS PROJECT SHALL BE PROVIDED WITH HIGH BRIGHTNESS ENCAPSULATED TYPE REFLECTIVE SHEETING. SEE SECTION 713.0 OF THE STANDARD SPECIFICATIONS.

** THESE SIGNS TO BE FURNISHED WITH INTERCHANGEABLE PLAQUE (LEFT) OR (RIGHT) AT NO ADDITIONAL EXPENSE

- EXISTING SIGN REMOVAL AND NEW SIGN INSTALLATIONS TO BE DONE BY CITY FORCES AT NO COST TO THE PROJECT.
- EXISTING CURB AND GUTTER SHALL REMAIN IN PLACE UNTIL WITHIN 48 HOURS OF PAVING OPERATION OR AS APPROVED BY PROJECT ENGINEER.
- DEPTH OF MOISTURE DENSITY CONTROL SHALL BE AS FOLLOWS:
FULL DEPTH OF ALL EMBANKMENTS.
BASES OF CUTS AND FILLS 0.5 FOOT.
EXCAVATION REQUIRED FOR COMPACTION OF CUTS AND FILLS WILL BE CONSIDERED AS SUBSIDIARY TO THAT OPERATION AND WILL NOT BE PAID FOR SEPARATELY.
TYPE OF COMPACTION SHALL BE AASHTO T-99.



FINAL

[illegible]

FINAL TABULATION OF CONCRETE SIDEWALK
& CONCRETE PAVEMENT

STATION TO STATION	SIDE	CONCRETE SIDEWALK (4 FOOT)		CONCRETE PAVEMENT (6 INCH)		REMOVAL OF CONCRETE SIDEWALK	
		SQ. YD.		SQ. YD.		SQ. YD.	
		PLAN	FINAL	PLAN	FINAL	PLAN	FINAL
0+27 to 3+40 3+46 0+47	RT						153
0+27 to 0+47	RT		9				
0+97 0+70 to 1+66 1+79	RT	43	38				
1+80	RT			12	23		
2+12 1+96 to 3+40 3+46 4+30 to 5+30 4+30 East	RT	60	68			62	237
4+78 4+30 to 4+68 4+90 4+83	LT	30	5	13			
5+30 4+98 to 5+27 5+75 4+08 West	LT		22				
5+62 West 5+80 5+30 5+95 5+94	LT		8	21	83		4
5+94 5+97 to 6+96 6+97	LT	44	46	12	14		9
7+05				8	12		
7+14 7+13 to 7+40 7+41		12					
TOTALS		202	215	87	168	215	414

NOTE: IT IS ESTIMATED THAT THERE WILL BE APPROXIMATELY 210 L.F. OF CONCRETE SAVING AND 210 L.F. OF ASPHALT SAVING TO BE INCLUDED IN THE COST OF SIDEWALK REMOVAL AND UNCLASSIFIED EXCAVATION RESPECTIVELY.

FINAL TABULATION OF CONCRETE CURB RAMP

STATION	SIDE	CONCRETE CURB RAMP	
		SQ. YD.	
		PLAN	FINAL
3+46 3+30 4+35 to 4+78	RT	10	17
	LT	10	27
TOTAL		20	44

FINAL TABULATION OF CURB & GUTTER

STATION TO STATION	SIDE	CURB & GUTTER TYPE 2 SECTION 11.B		REMOVE CURB TYPE 2 (6" BARRIER) SEC. B		REMOVAL OF CURB & GUTTER		REMOVAL OF ROLL-OVER CURB, GUTTER & S.W.	
		LINEAR FEET		LINEAR FEET		LINEAR FEET		LINEAR FEET	
		PLAN	FINAL	PLAN	FINAL	PLAN	FINAL	PLAN	FINAL
0+27 to 3+40 3+46 3+35 to 3+58 4+78 4+30 to 7+40 7+41 1+94	RT	331	255			337	360		
	LT	321	190			82	82		
4+30 to 5+30 5+30 to 7+40 4+50	LT			10	10				
	LT					111	120	209	209
5+70	LT			20	20				
	LT			7	12				
TOTAL		652	449	37	42	530	562	209	209

FINAL SURFACING QUANTITIES

STATION TO STATION	SOURCE	HOT BITUMINOUS PAVEMENT (GRADING EX)	
		PLAN TONS	
		PLAN	FINAL
0+27 to 3+42	CONTRACT	80	
3+35 to 3+60	CONTRACT	14	
4+30 to 7+40	CONTRACT	63	
IRREGULARITIES		15	
TOTALS		172	277.15

IT IS ESTIMATED THAT 6 TONS OF BITUMINOUS PAVEMENT WILL BE REQUIRED AT DRIVEWAYS AND PARKING LOTS AND IS INCLUDED IN THE QUANTITIES FOR SURFACING IRREGULARITIES.

VOILING QUANTITIES

CSS-1H ROADWAY (TACK COAT)	103	FINAL
TOTAL	103	31

FOR INFORMATION ONLY

INCLUDED IN COST OF H.B.P. (GR EX) (H & A)

STABILIZATION DATA

	28th AVE. WIDENING NORTHBOUND (E. SIDE)	28th AVE. WIDENING SOUTHBOUND (W. SIDE)
SERVICIBILITY INDEX	2.0	2.0
18 K ESAL	788,400	788,400
RELIABILITY	80	80
SOIL MR	17,788	14,271
WSN	2.2	2.4
DESIGN HBP THICKNESS	5"	5.5"
OVERALL DEVIATION	0.44	0.44
STRENGTH COEFFICIENT: HBP = 0.44		

NOTE: 5.5" THICKNESS (PAVING) USED THROUGHOUT PROJECT FOR EASE OF CONSTRUCTION

City of GREELEY, COLORADO



DIVISION OF ENGINEERING

10th STREET & 28th AVENUE



OWNERSHIP OF UTILITIES

WATER MAINS - CITY OF GREELEY 350-9811
SANITARY & STORM SEWER - CITY OF GREELEY 350- 9811
TELEPHONE - U.S. WEST 1-226-6310
ELECTRIC LINES - PUBLIC SERVICE 353-1144
GAS LINES - GREELEY GAS 352-1511
CABLE TV - CABLEVISION 350-6669

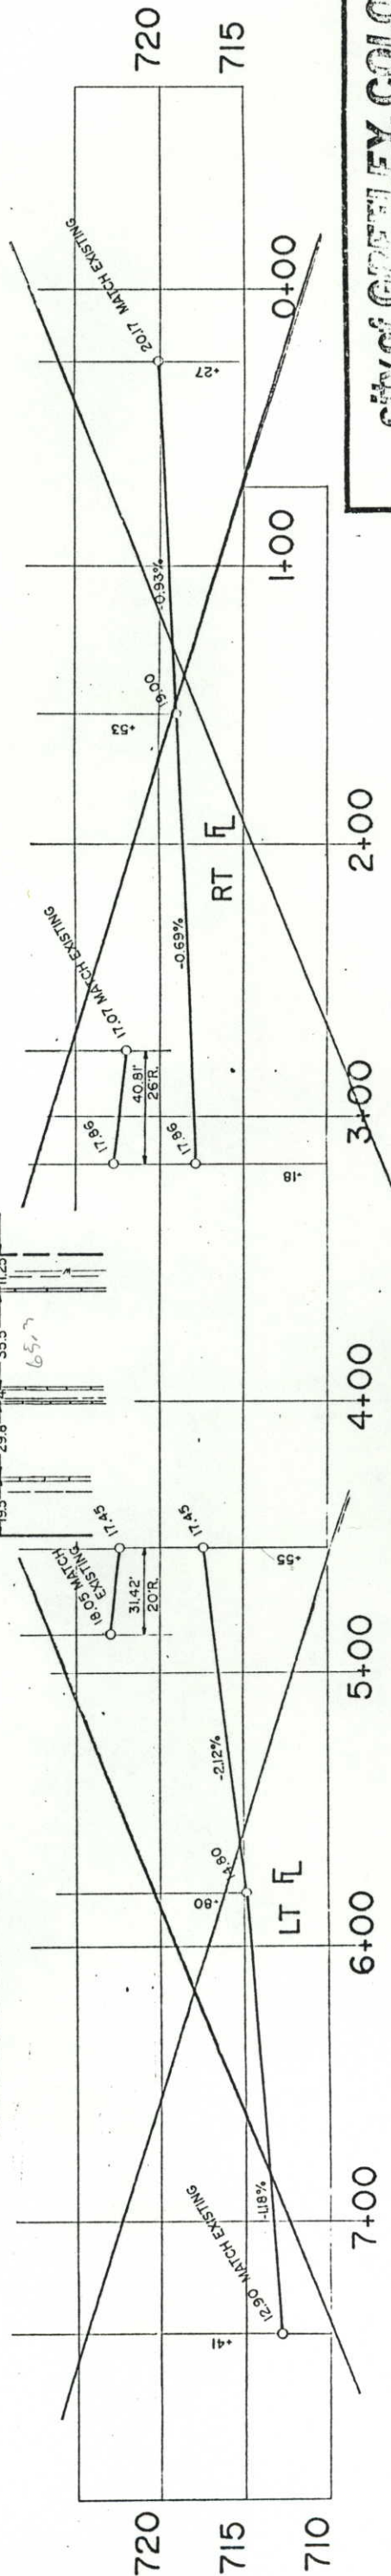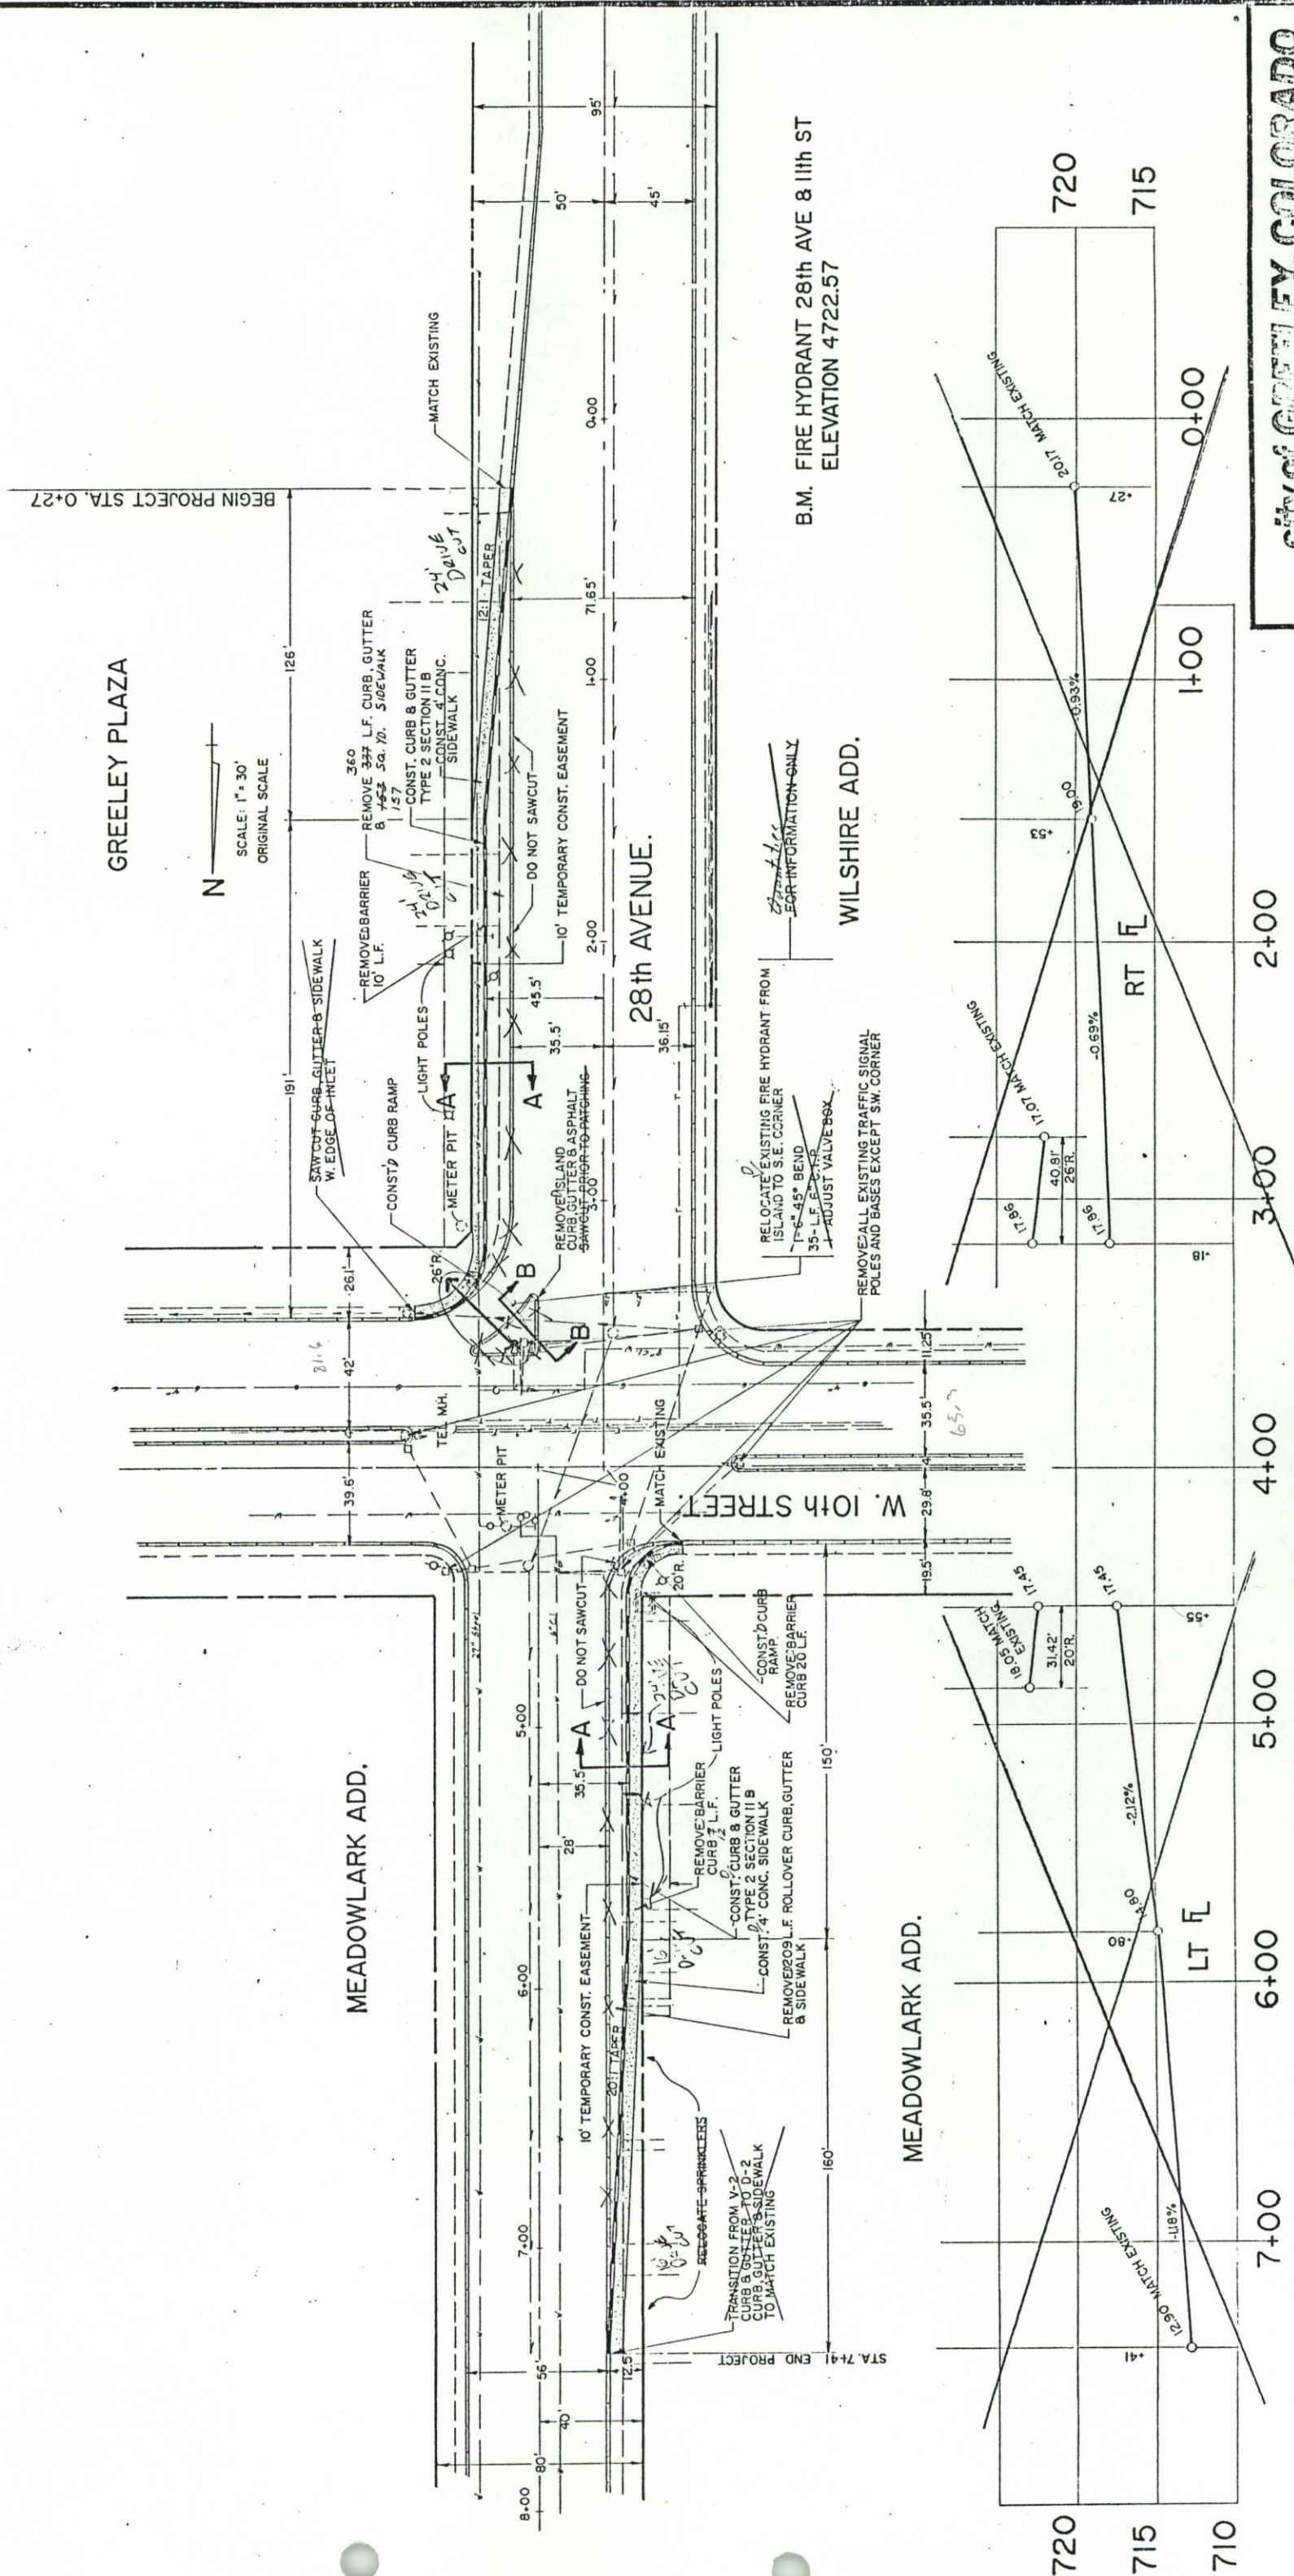

NOTE: ALL GRADES FIELD ADJUSTED TO FIT EXISTING CONDITIONS

CITY OF GREELEY, COLORADO
DIVISION OF ENGINEERING
10th STREET & 28th AVENUE
IMPROVEMENTS
Notebook Ref. [blank] Revised [blank]

TRAFFIC SIGNAL PLAN

AS CONSTRUCTED

NO REVISION

REVISID 13-25-92

VOID

PROJ NO

DIVISION

COLORADO

HES 0004 (36)


SHEET NO

8

TOTAL SHEETS

13


SIGNAL PHASING

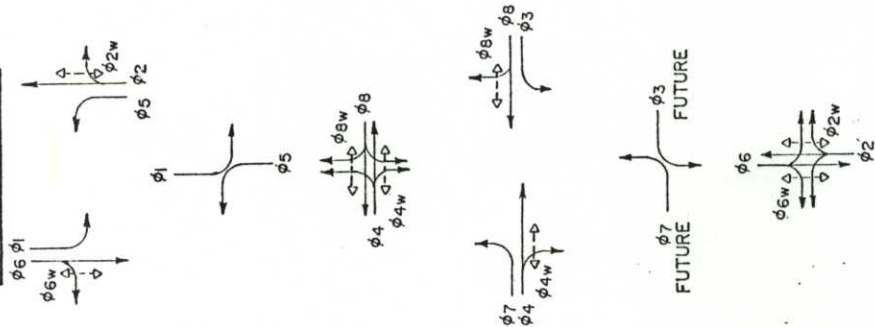

NOTES

- The controller shall include 8 pedestrian push buttons & pedestrian signs. Signs shall be decal type.
- Luminaires will be furnished and installed by others. Mounting height shall be 30 feet.
- The contractor shall install street light wiring furnished by others.
- Controller shall be a Type 170. Controller cabinet shall be a Model 332. Controller shall include a model 400 modem card. Fire preemption unit shall be Opticom type and include 4 detectors.
- Traffic signals mounted on mast arms shall be furnished with Astro type mounting brackets.
- Each signal pole shall include luminaire extensions and 15' arms.
- Loop wire will be duct type. Loops will be 6"x40' quads.
- All street markings to be installed by city forces at no cost to the project.
- The cost of connecting electrical service switch to the controller shall be included in the cost of the controller.
- Intersection shall be wired for 8 phase operation.

SIGNAL FACES

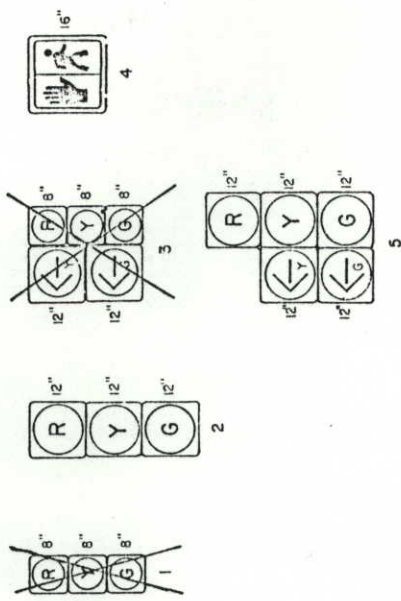


LEGEND

- Traffic Signal Pole with Mast Arm
- Traffic Signal Span Wire Pole
- Pedestrian Pole
- Traffic Signal Face
- Traffic Signal Face with Backplate
- Pedestrian Signal Face
- Controller and Cabinet
- Electrical Conduit and Pull Box
- Vehicle Loop Detector
- Pedestrian Push Button
- Luminaire
- Water Valve Style Pull Box
- Fire Preemption Unit Detector

FINAL
TABULATION OF TRAFFIC SIGNAL QUANTITIES

ITEM NO.	ITEM DESCRIPTION	UNIT	QUANTITY	FINAL
202	REMOVAL OF TRAFFIC SIGNAL FACE	EA.	9	9
202	REMOVAL OF TRAFFIC SIGNAL POLE	EA.	3	3
202	REMOVAL OF TRAFFIC CONTROLLER AND CABINET	EA.	1	1
202	REMOVAL OF PEDESTAL POLE	EA.	2	2
613	1 1/2 INCH ELECTRICAL CONDUIT (1/2 AC)	L.F.	80	57
613	1 1/2 INCH ELECTRICAL CONDUIT (PLASTIC)	L.F.	205	212
613	2 INCH ELECTRICAL CONDUIT (PLASTIC)	L.F.	40	78
613	3 INCH ELECTRICAL CONDUIT (PLASTIC)	L.F.	700	721
613	WIRING	L.S.	0.5	0.5
614	PEDESTRIAN SIGNAL FACE (16)	EA.	8	8
614	TRAFFIC SIGNAL FACE (12-12-12)	EA.	14	14
614	TRAFFIC SIGNAL FACE (12-12-12-12)	EA.	2	2
614	FIRE PREEMPTION UNIT & TIMER	EA.	2	2
614	LOOP DETECTOR WIRE	L.F.	3000	2551
614	TRAFFIC SIGNAL-LIGHT POLE STEEL (1 MASTARM)	EA.	3	3
614	MODEL 332 - TRAFFIC SIGNAL-CONTROL UNIT (1 MASTARM)	EA.	1	1
614	TRAFFIC SIGNAL CONTROLLER (TYPE 170)	EA.	1	1

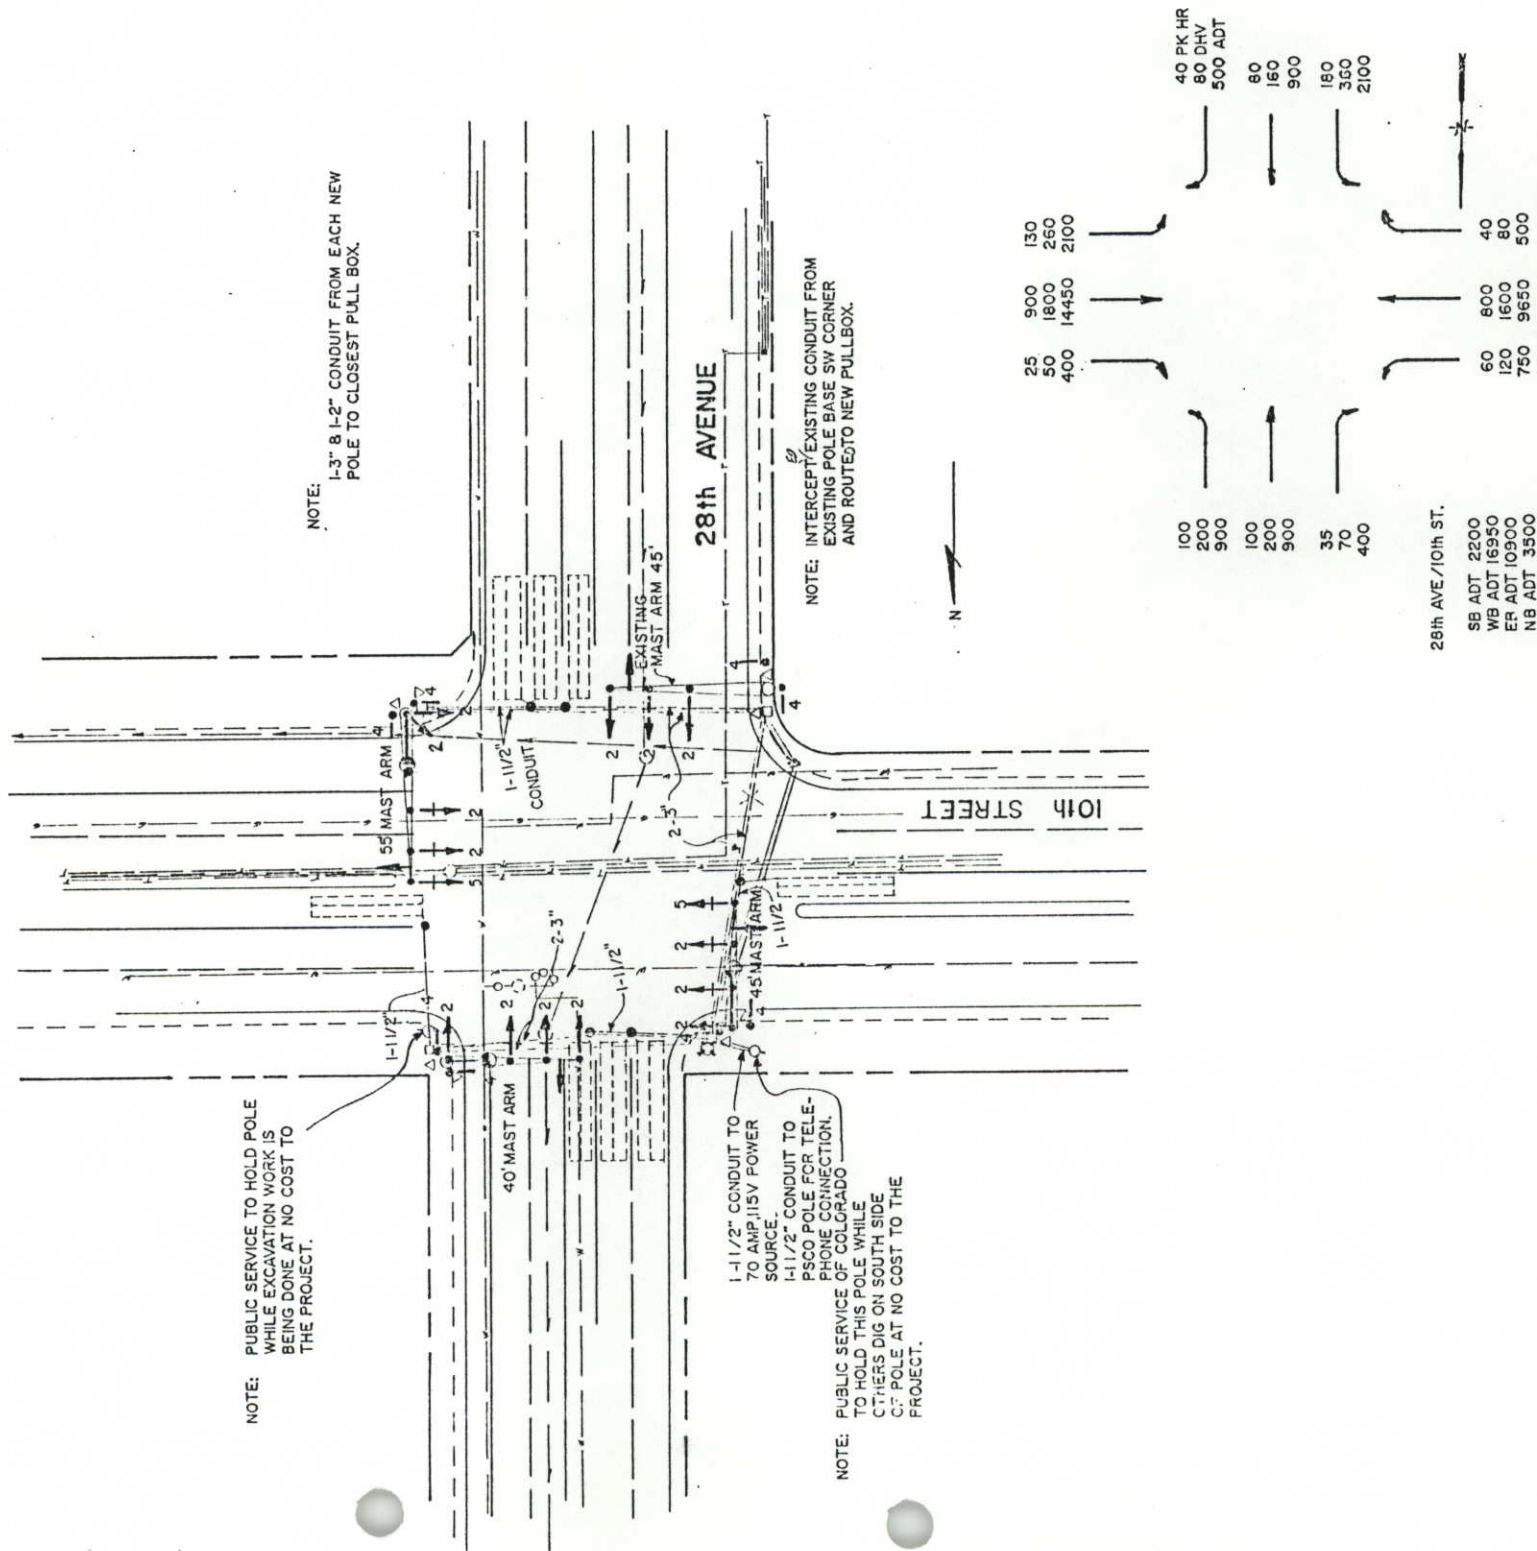

NOTE: PUBLIC SERVICE TO HOLD POLE WHILE EXCAVATION WORK IS BEING DONE AT NO COST TO THE PROJECT.

NOTE: PUBLIC SERVICE TO HOLD POLE WHILE OTHERS DIG ON SOUTH SIDE OF POLE AT NO COST TO THE PROJECT.

NOTE: INTERCEPT EXISTING CONDUIT FROM EXISTING POLE BASE SW CORNER AND ROUTE TO NEW PULLBOX.



NOTE: 1-3" 8 L2" CONDUIT FROM EACH NEW POLE TO CLOSEST PULL BOX.

28th AVE./10th ST.

SB ADT 2200
WB ADT 16950
EB ADT 10900
NB ADT 3500

1990 DATA

VIII	COLORADO	HES 0004(36)	9
AS CONSTRUCTED			
NO REVISIONS	REVISED	1/2-2-72	VOID

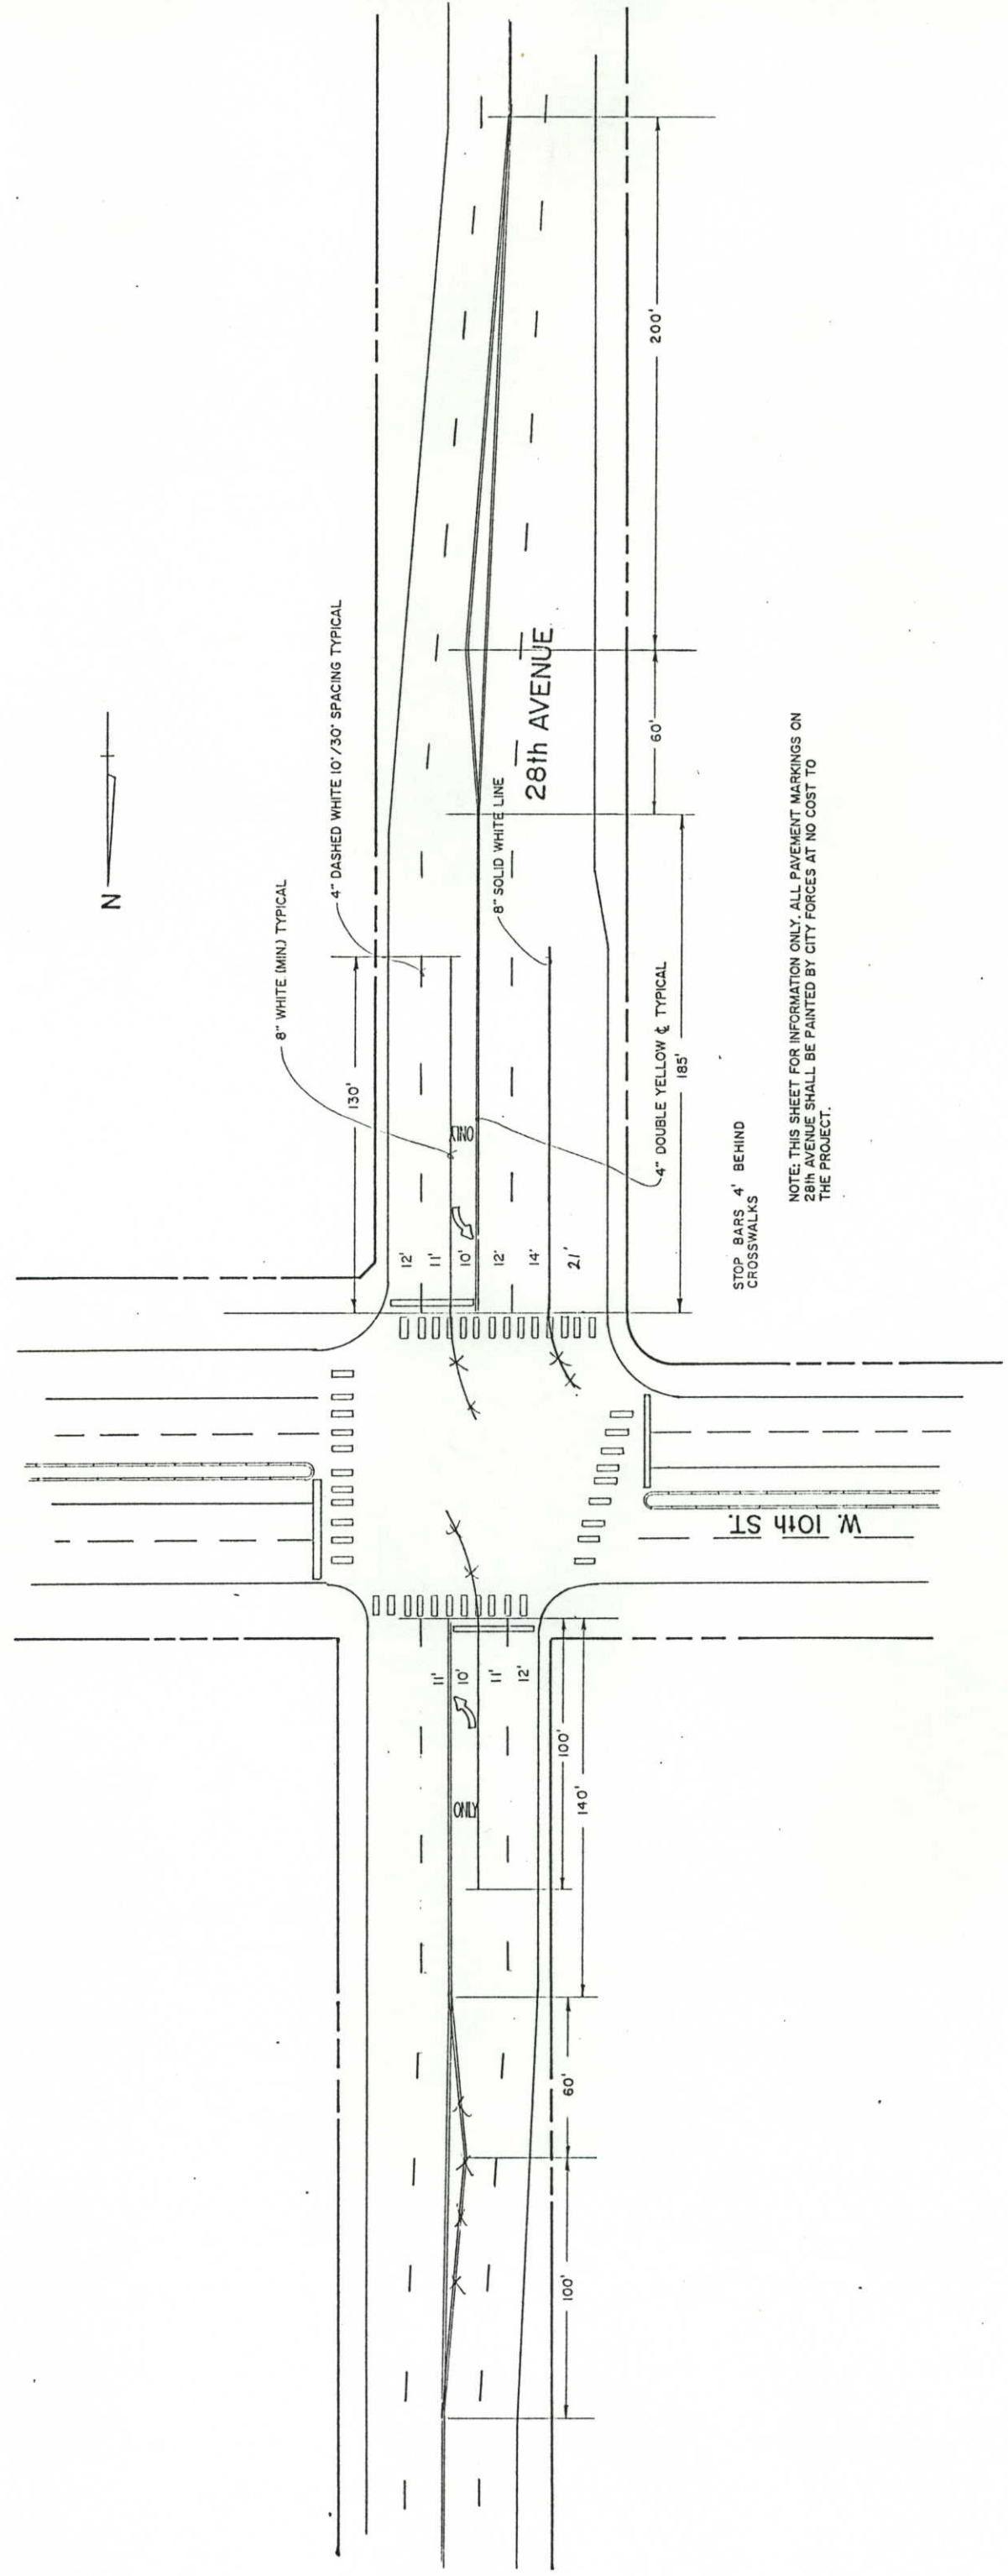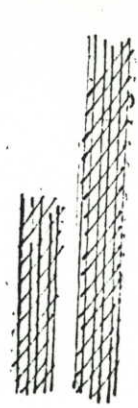

NOTE: THIS SHEET FOR INFORMATION ONLY. ALL PAVEMENT MARKINGS ON 28th AVENUE SHALL BE PAINTED BY CITY FORCES AT NO COST TO THE PROJECT.

City of GREELEY, COLORADO

DIVISION OF ENGINEERING

28th AVENUE STRIPING PLAN

Notes: See

VIII	COLORADO	H E S 000 41367	10
------	----------	-----------------	----

AS CONSTRUCTED

NO REVISIONS	REVISED	VOID
--------------	---------	------


1-26-62

VIII	COLORADO	H E S 000 41367	10
------	----------	-----------------	----

AS CONSTRUCTED

NO REVISIONS	REVISED	VOID
--------------	---------	------

1-26-62

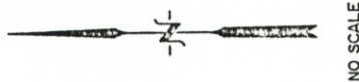

NOTE: FLAGGER SYMBOLS TO BE USED IN WORK AREA AS NEEDED.

TYPE TWO BARRICADES TO BE USED AS NEEDED FOR EXTENDED OPEN EXCAVATIONS.



TYPICAL CORNER CONSTRUCTION ZONES SHOWN.

ONE THRU LANE TO REMAIN OPEN EACH DIRECTION AT ALL TIMES UNLESS DIRECTED BY THE ENGINEER.



CONTRACTOR SHALL MAKE PROVISIONS FOR PEDESTRIAN TRAFFIC THROUGH THE WORK ZONE AT ALL TIMES. ALL EXCAVATIONS TO BE PROTECTED BY HIGH VISIBILITY FENCING OR AS DIRECTED BY THE ENGINEER. THIS WORK SHALL NOT BE PAID FOR SEPARATELY BUT SHALL BE INCLUDED IN THE COST OF THE PROJECT.

ASTRO — TYPE MOUNTING BRACKETS.

FEDERAL ROAD DISTRICT NO.	DIVISION	PROJ. NO.	SHEET NO.	TOTAL SHEETS
VIII	COLORADO	HES 0004 (36)	11	13
AS CONSTRUCTED				
NO REVISIONS				
REVISED 10-26-90 VOID				

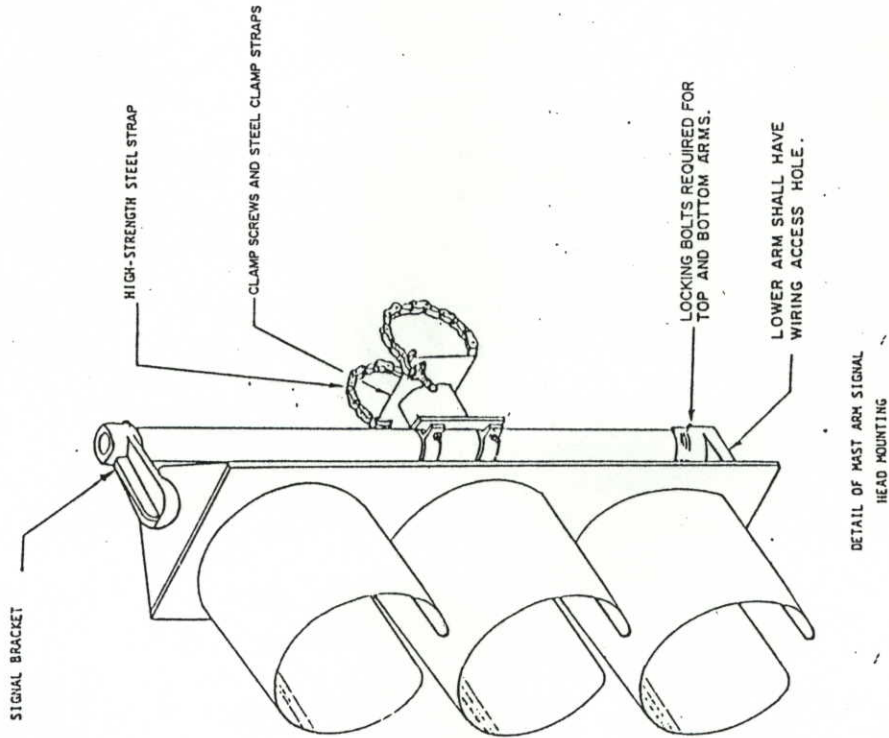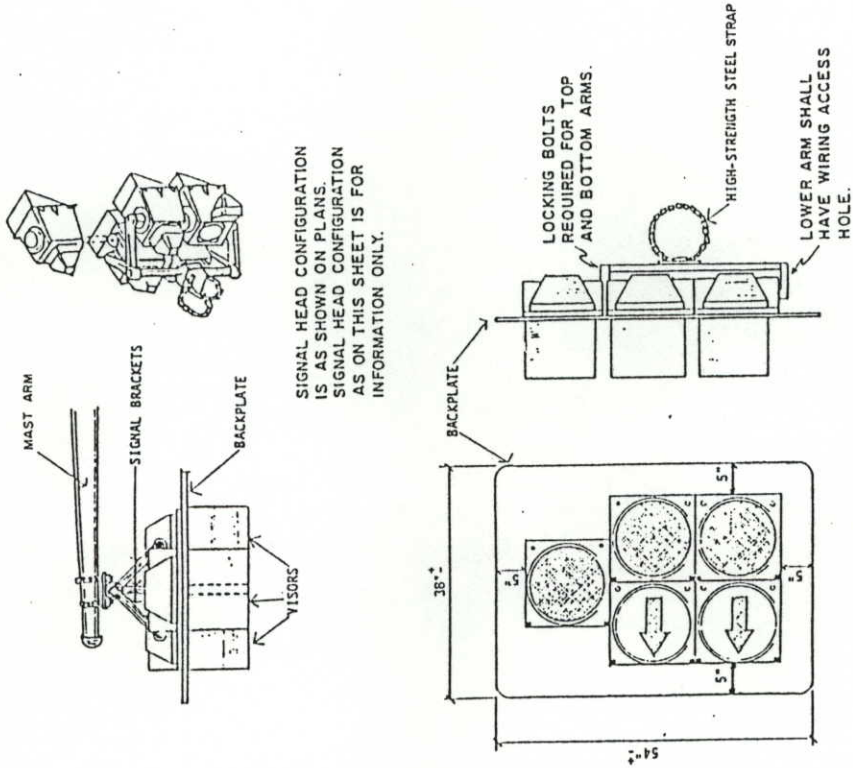

Approved by MCR #2,
Line Item #1.

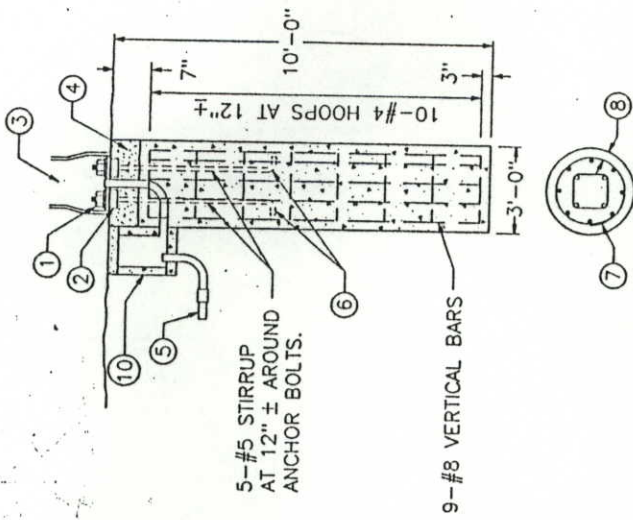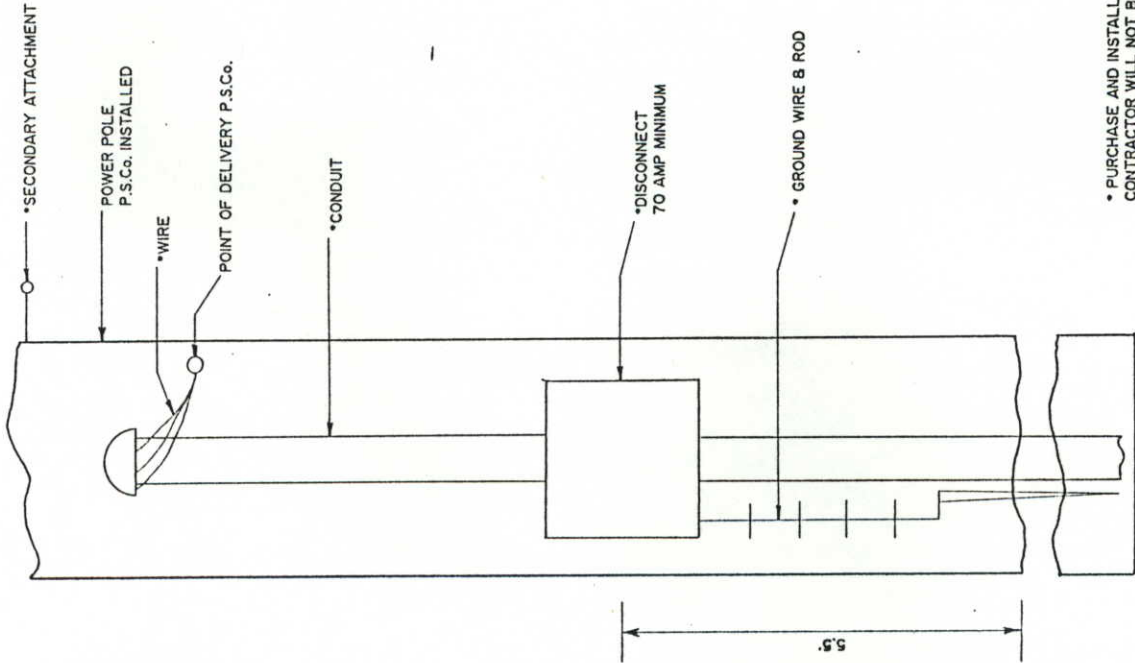

TYPICAL TRAFFIC SIGNAL
POLE FOOTING

FOOTING NOTES

- ① HEX NUTS
- ② SQUARE NUTS
- ③ HAND HOLE SHALL BE PROVIDED
- ④ 4" MIN. NON-SHRINKABLE GROUT OVER ROUGH FOUNDATION
- ⑤ RIGID CONDUIT (24" MIN. DEPTH, 30" MIN. DEPTH UNDER ROADWAY)
- ⑥ INSTALL ANCHOR BOLTS (FURNISHED WITH POLE) PER MANUFACTURER'S TEMPLATE PRINT (FURNISHED WITH ORDER)
- ⑦ MINIMUM OVERLAP OF 12"
- ⑧ 1-1/2" CLEARANCE FOR HOOPS
- ⑨ CAISSON DESIGNS REQUIRE THAT THE CAISSON BE FOUNDED IN COMPACT SAND, CLAY OR SANDY CLAY. IF BY VISUAL INSPECTION OF THE HOLE, OTHER MATERIAL IS PRESENT, THE CAISSON DESIGN SHALL BE MODIFIED AS DETERMINED BY THE ENGINEER.
- ⑩ PULL BOX


* PURCHASE AND INSTALLATION BY CONTRACTOR WILL NOT BE PAID FOR SEPARATELY, BUT IS INCLUDED IN THE COST OF THE PROJECT.

POWER SOURCE
CONNECTION DETAIL


PULL BOX - SPECIAL

FOR LOOP DETECTOR WIRE


FEDERAL ROAD DISTRICT NO.	DIVISION	PROJ. NO.	SHEET NO.	TOTAL SHEETS
VIII	COLORADO	HES 0004 (36)	12	13
NO REVISIONS 10-26-92 REVISED VOID				
AS CONSTRUCTED				

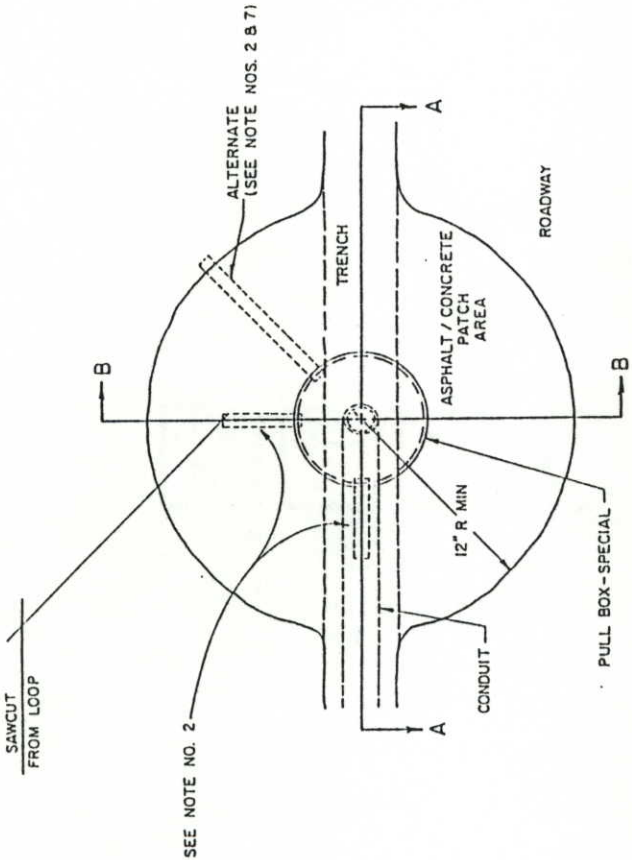

TOP VIEW

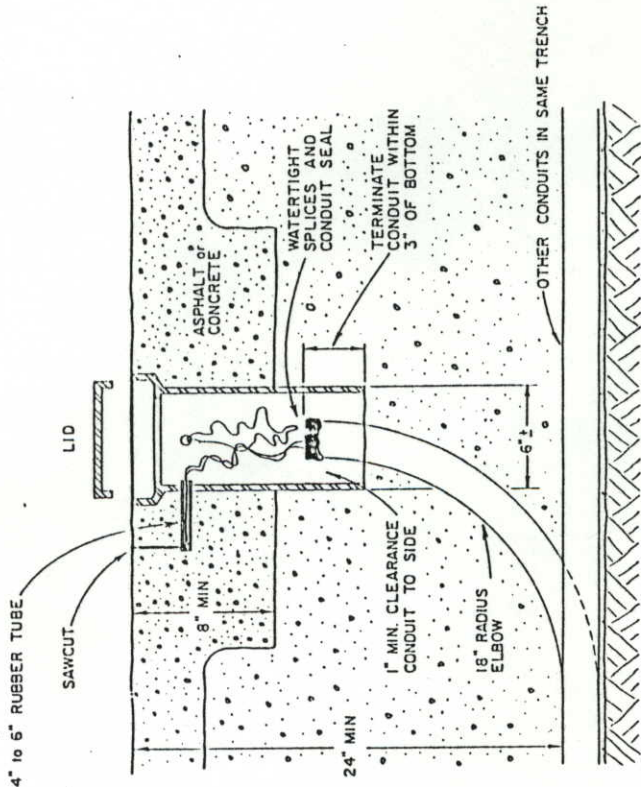

SECTION A-A

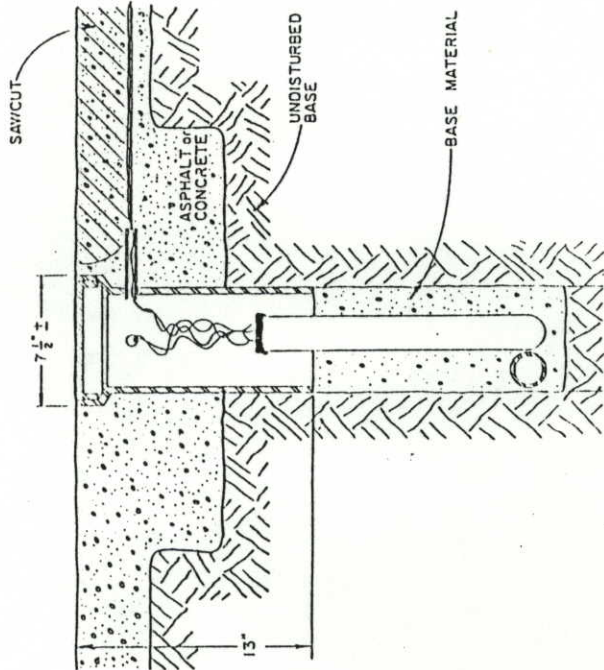

SECTION B-B

GENERAL NOTES:

1. Pull Box-Special shall be a Water Valve Stem Type pull box made of cast iron or steel. The pull box shall have capability of accepting riser rings for future overlays. The lid shall have the word "TRAFFIC" printed on it.
2. Pull boxes shall have $\frac{3}{4}$ " to 1" diameter holes drilled or torched $\frac{3}{8}$ " from top to accept a 4" to 6" rubber tube ($\frac{3}{4}$ " garden hose). The number of holes shall be as per plans or as directed by the engineer.
3. Care shall be taken during backfill compaction to prevent collapse of the tubes.
4. 2' minimum slack of both feed and loop wires is to be provided so that all testing and splicing can be done outside of the pull box.
5. Pull box lid is to be sealed water tight by caulking.
6. Pull box is to be located in an area of the street not heavily traveled if possible and centered a minimum of 12" from the concrete gutter pan.
7. If hot asphalt is not available a concrete ring (12" minimum radius and 8" minimum depth) may be allowed by the engineer. If concrete is allowed the rubber tube must be extended beyond the concrete to asphalt joint.
8. All work listed above for installation of pull boxes shall not be paid for separately, but shall be included in the price of the conduit.

