

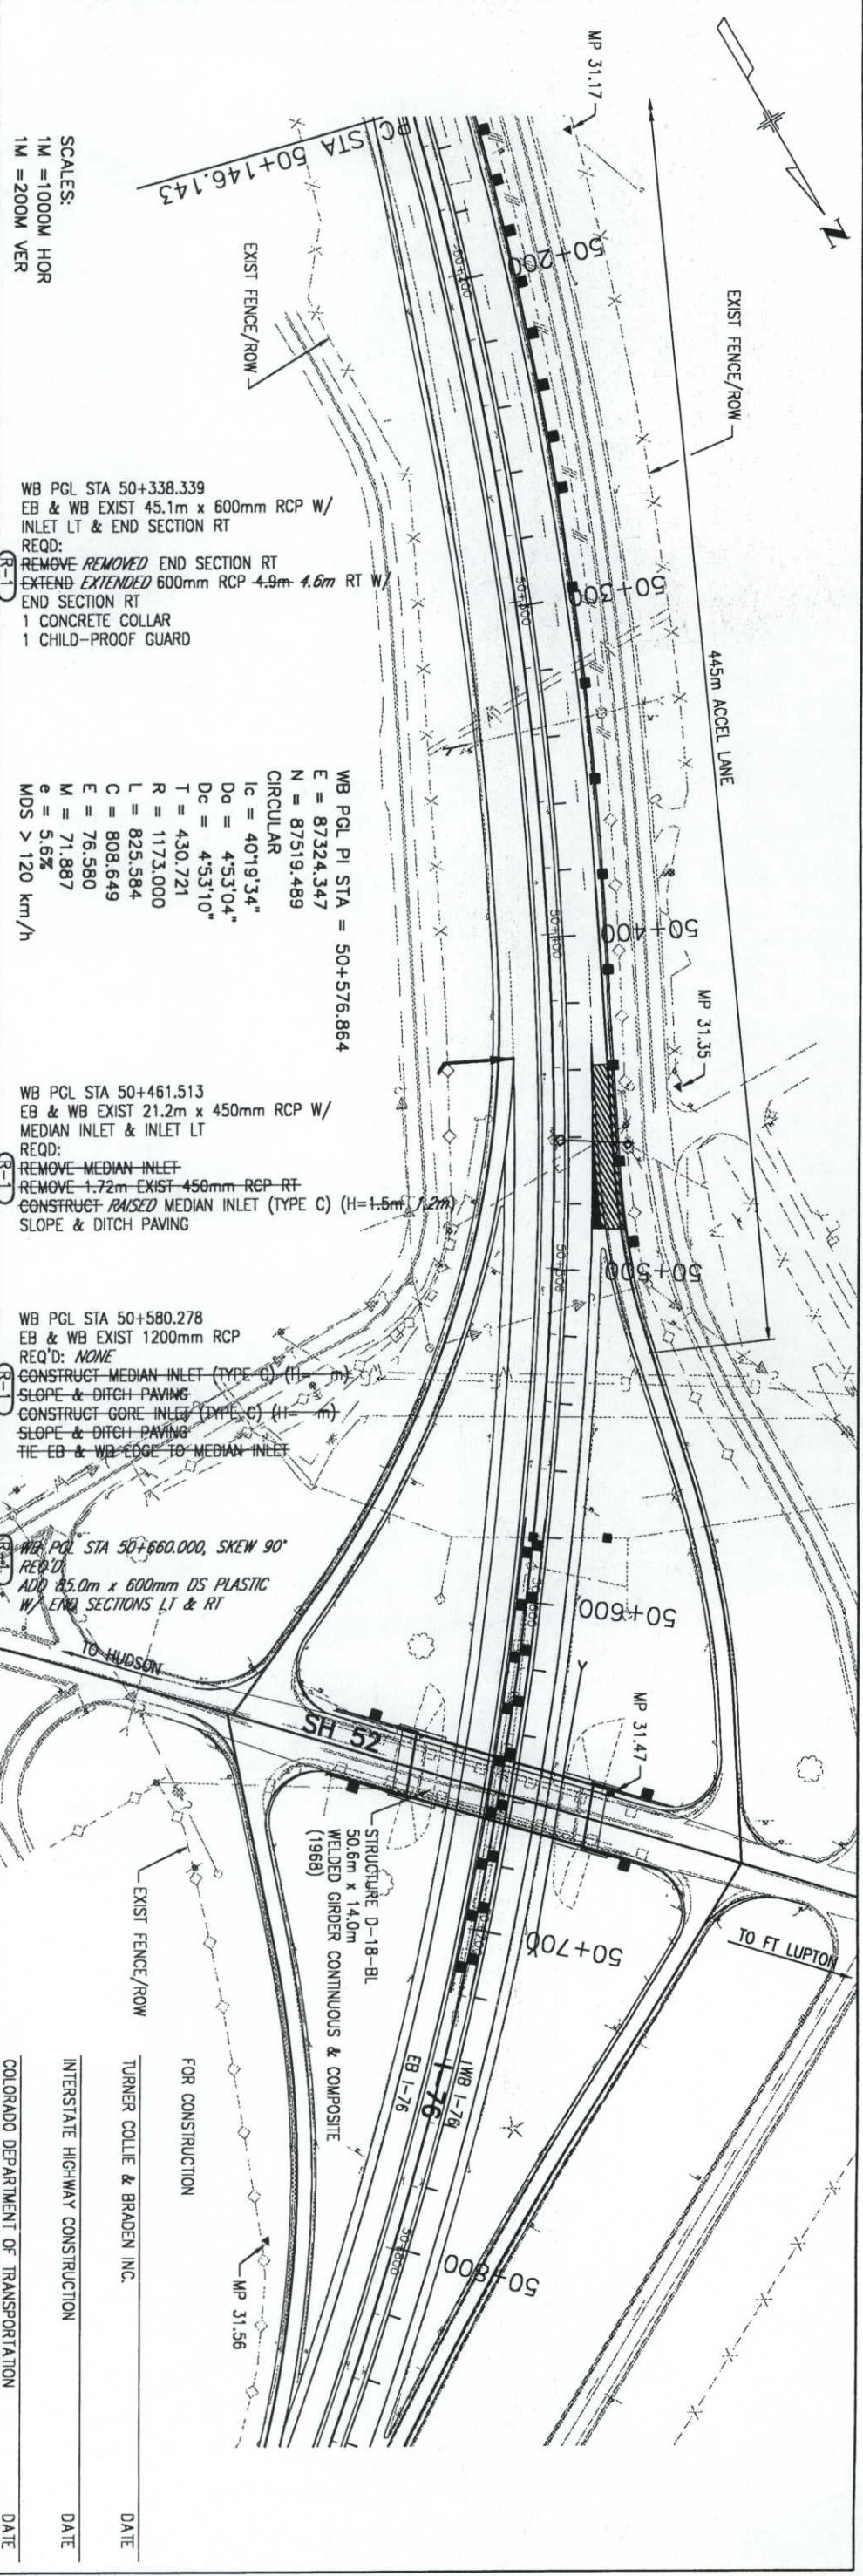
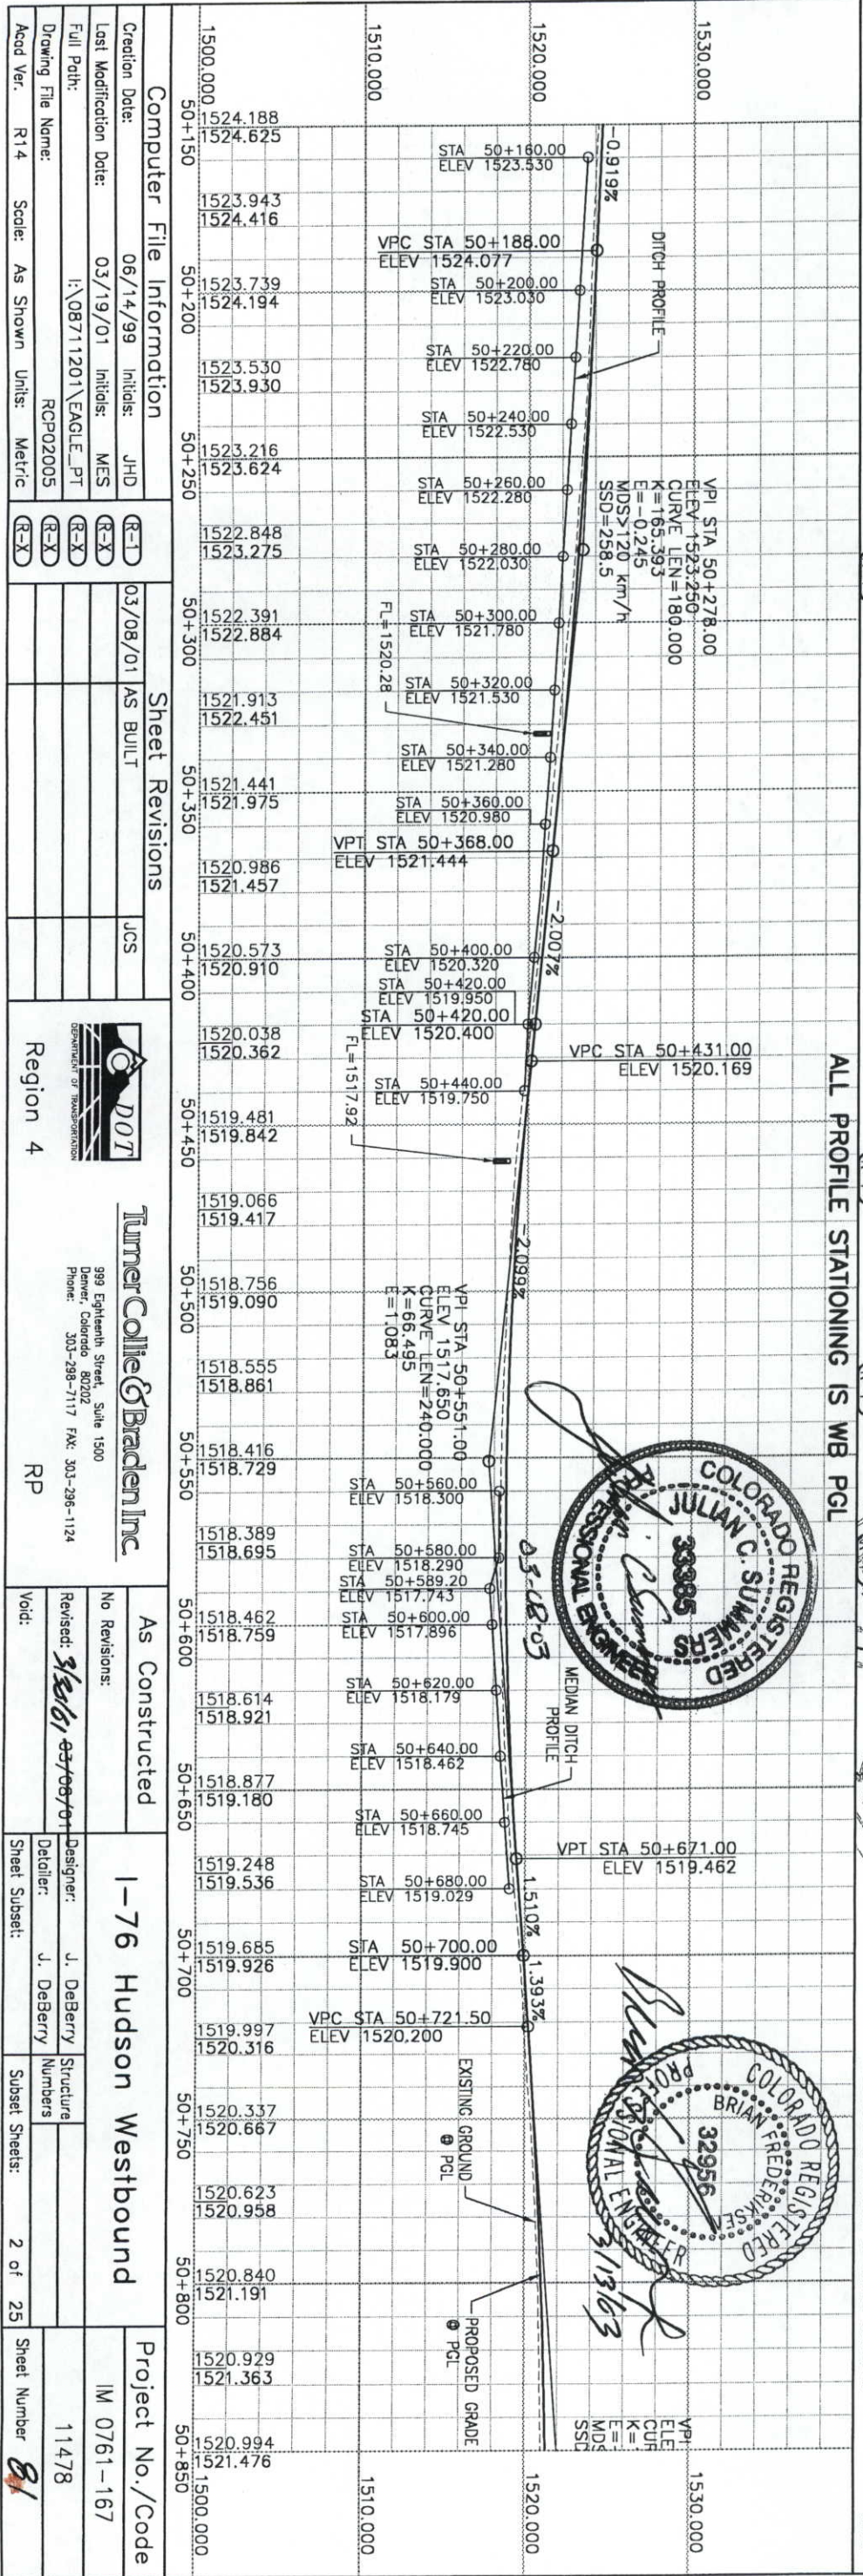


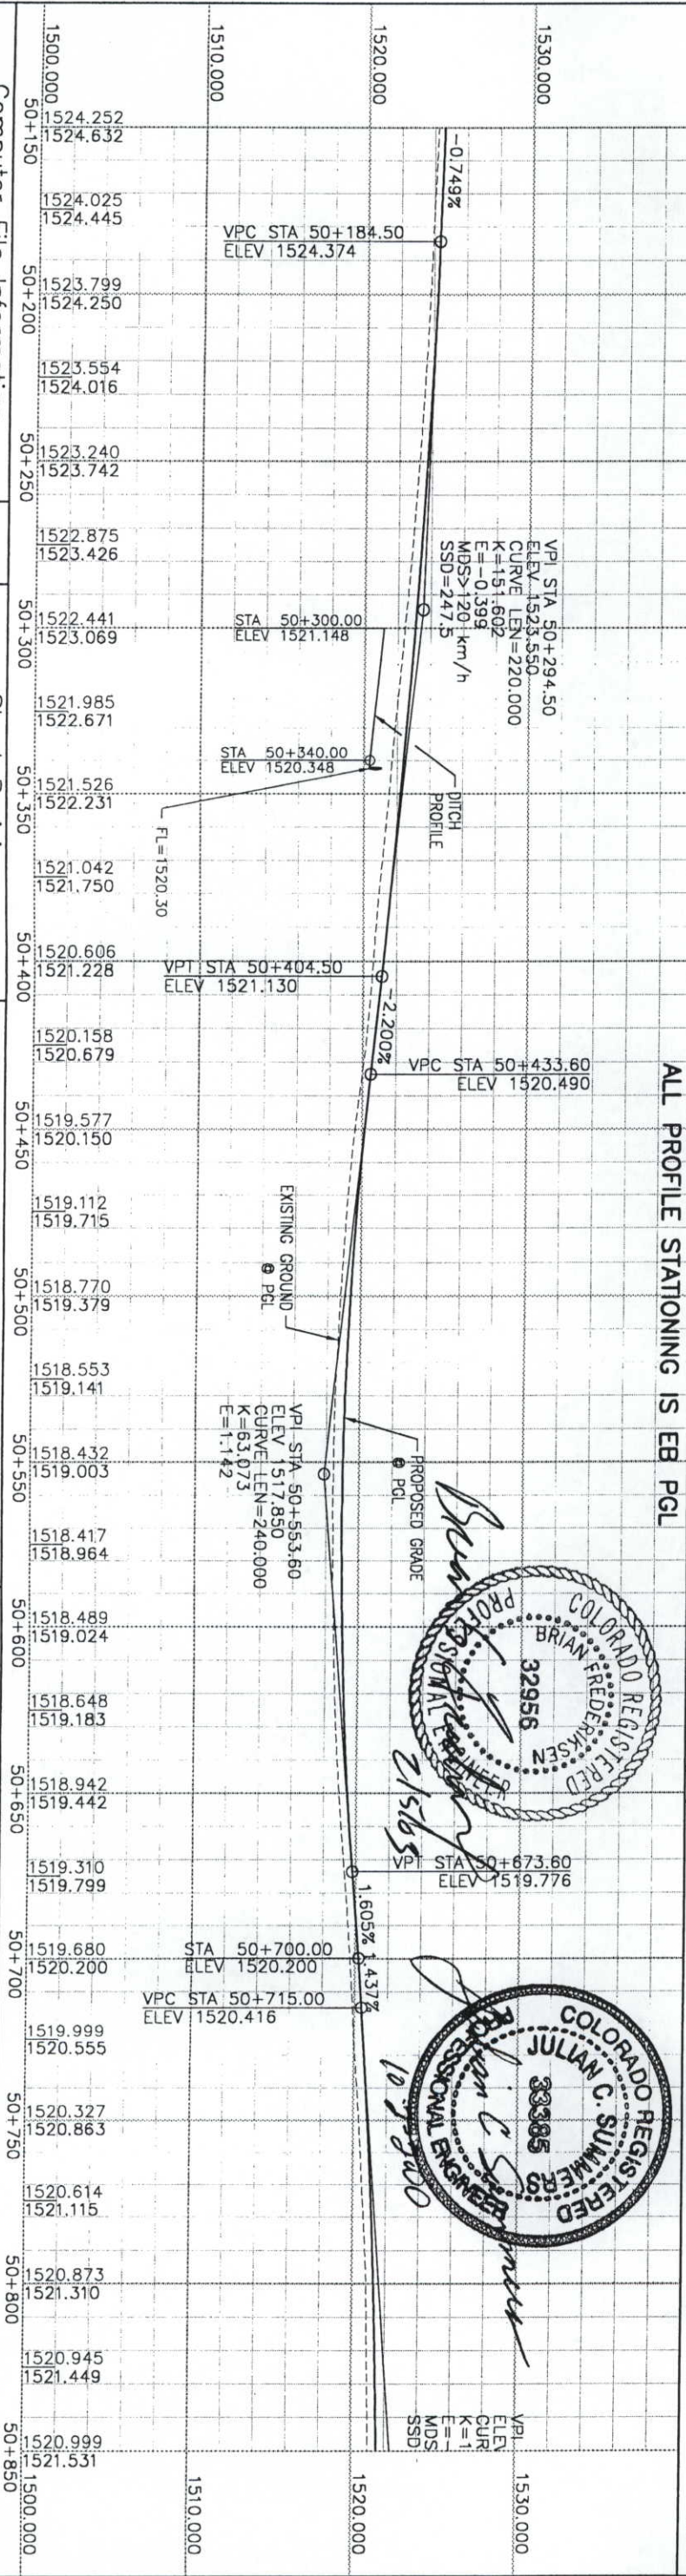

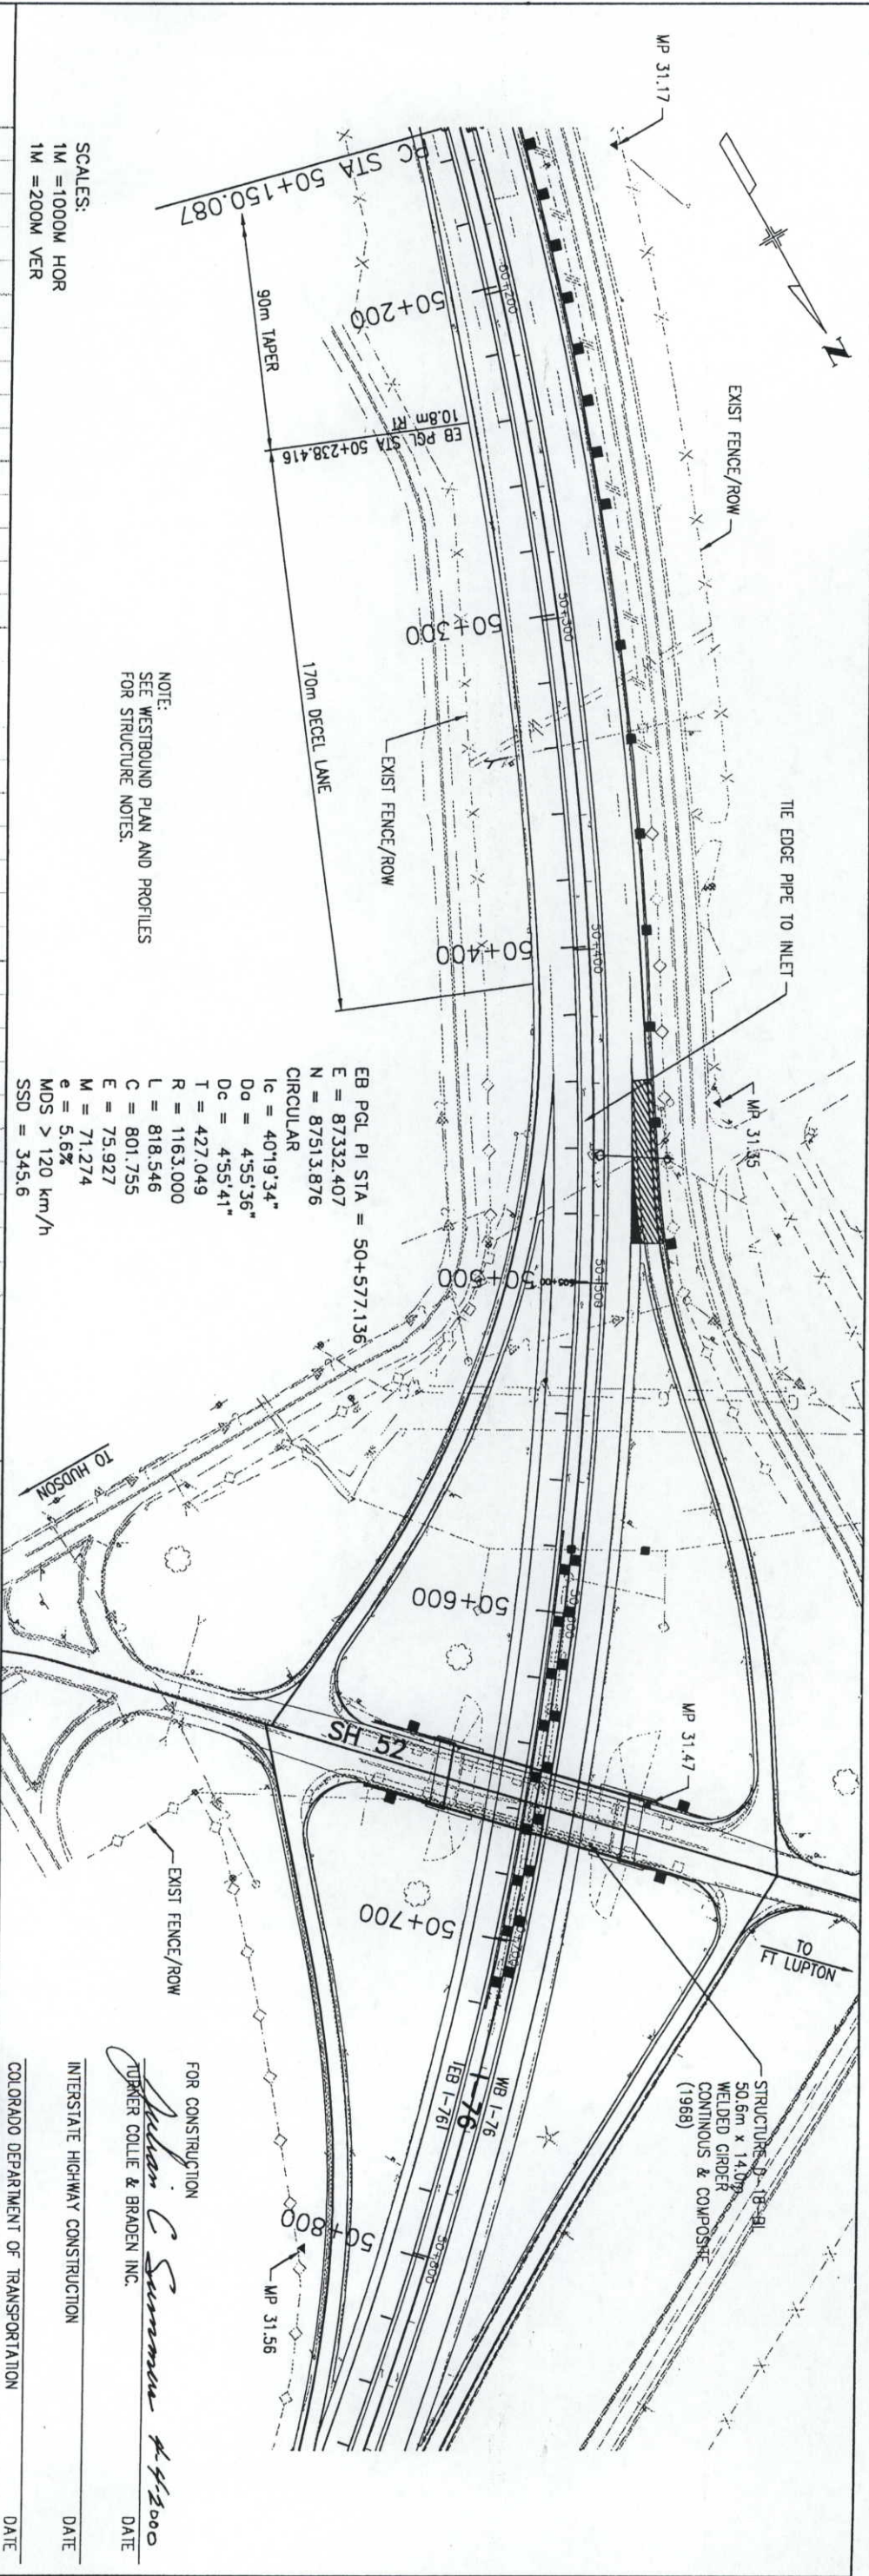


Computer File Information				Sheet Revisions			
Creation Date:	06/14/99	Initials:	JHD	(R-X)			
Last Modification Date:	04/04/00	Initials:	BSB	(R-X)			
Full Path:	I:\08711201\EAGLE.PT			(R-X)			
Drawing File Name:	RCP02006			(R-X)			
Acad Ver:	R14	Scale:	As Shown	Units:	Metric		


Region 4				RP			
----------	--	--	--	----	--	--	--

As Constructed				1-76 Hudson Eastbound			
No Revisions:	3/30/01			Designer:	J. DeBerry	Structure	
Revised:				Detailer:	J. DeBerry	Numbers	
Void:				Sheet Subst:			

Project No./Code				Sheet Number			
IM 0761-167				11478			
				2 of 25			
				106			

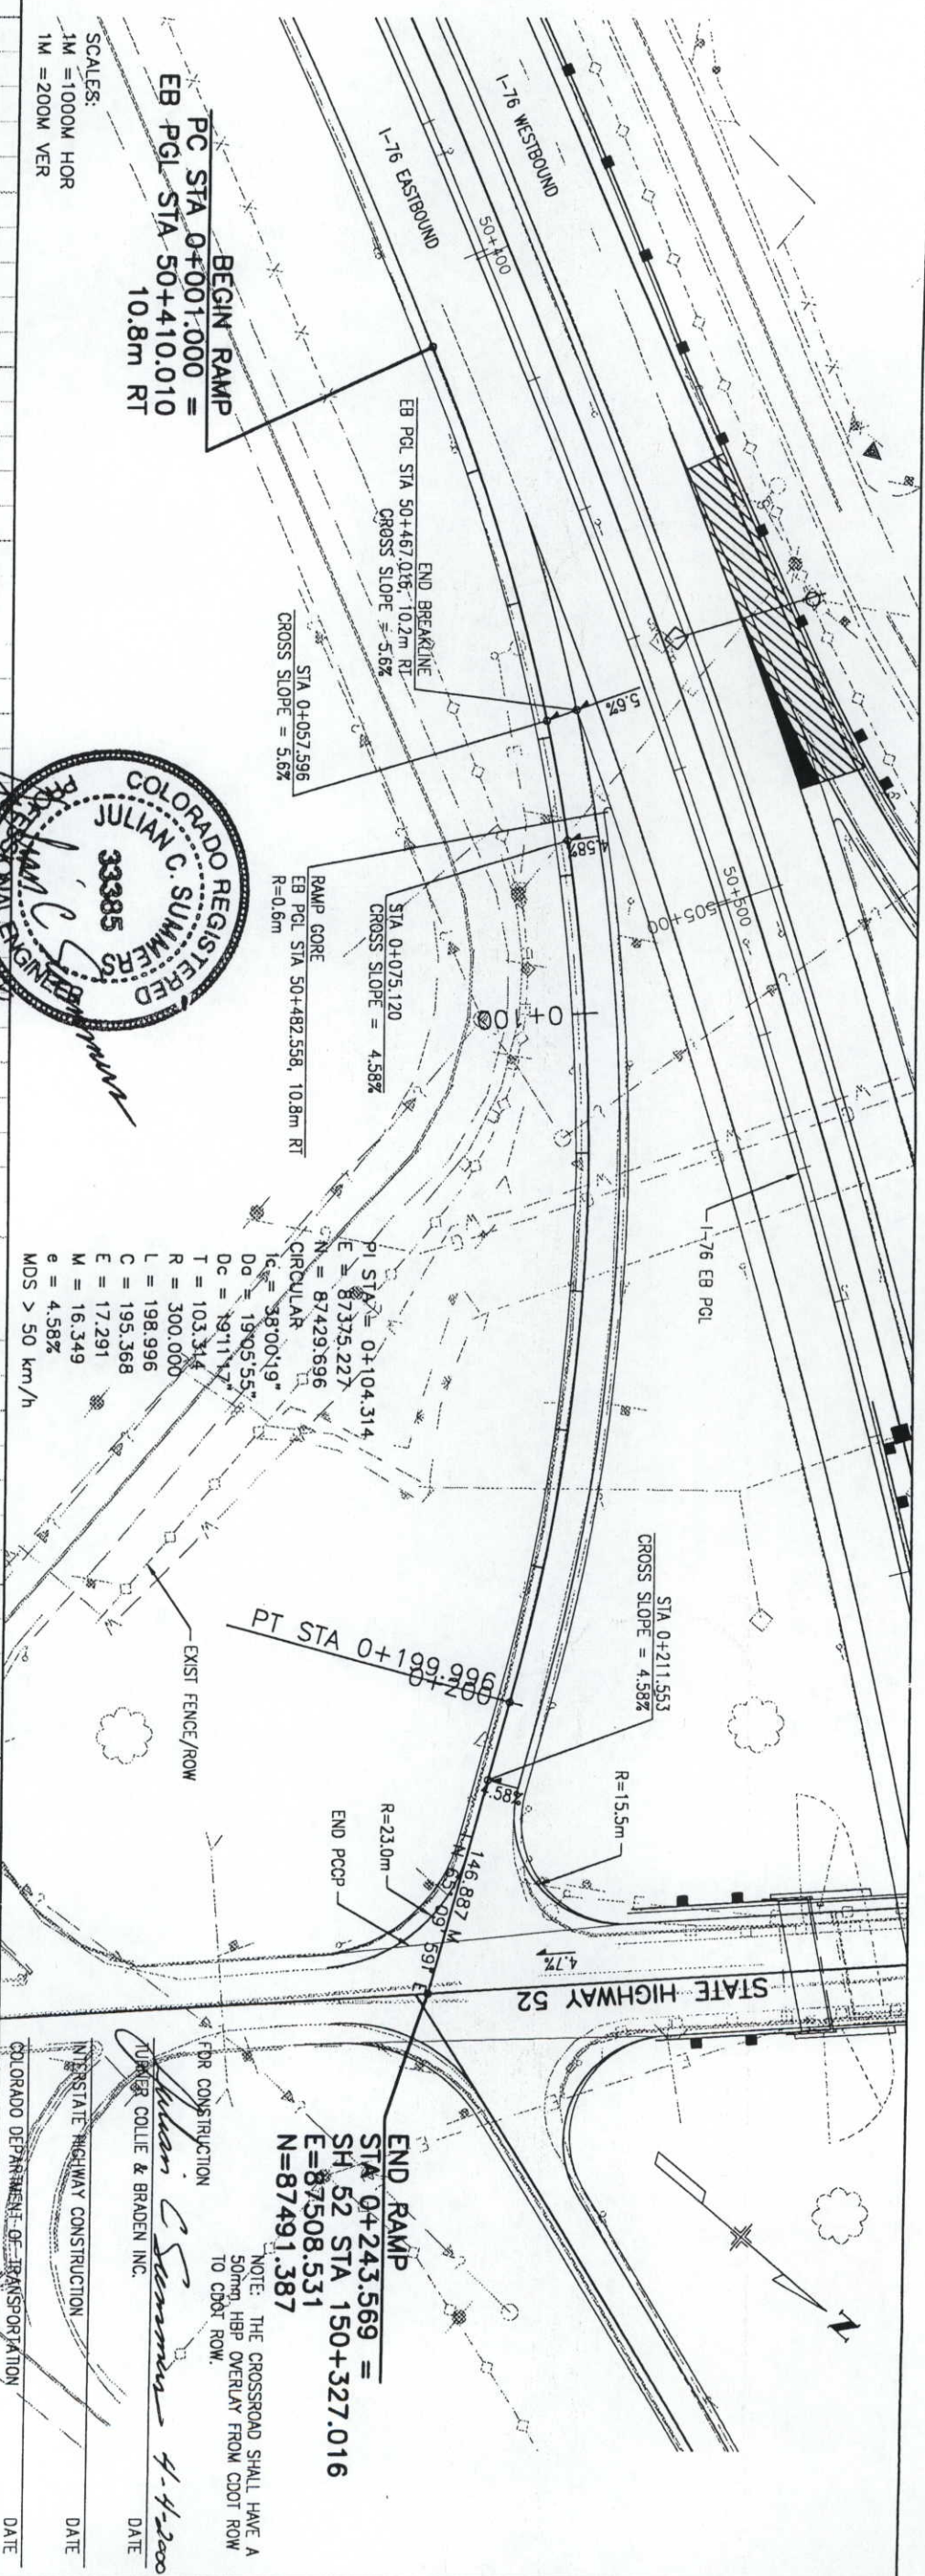

Computer File Information										Sheet Revisions										 Department of Transportation TurnerCollie&BradenInc. 999 Eighteenth Street, Suite 1500 Denver, Colorado 80202 Phone: 303-298-7117 FAX: 303-296-1124 Region 4 RP																																																																																																																																																																																																																																																																																																																																																																																																																																																																																																																																																																																																																																																																																																																																																																																																																																																																																																																																																																																																																																																																																																																																																																																																																																																																																																																																																										
Creation Date:	07/08/99			Initials:	BSB					(R-X)																																																																																																																																																																																																																																																																																																																																																																																																																																																																																																																																																																																																																																																																																																																																																																																																																																																																																																																																																																																																																																																																																																																																																																																																																																																																																																																																																																				

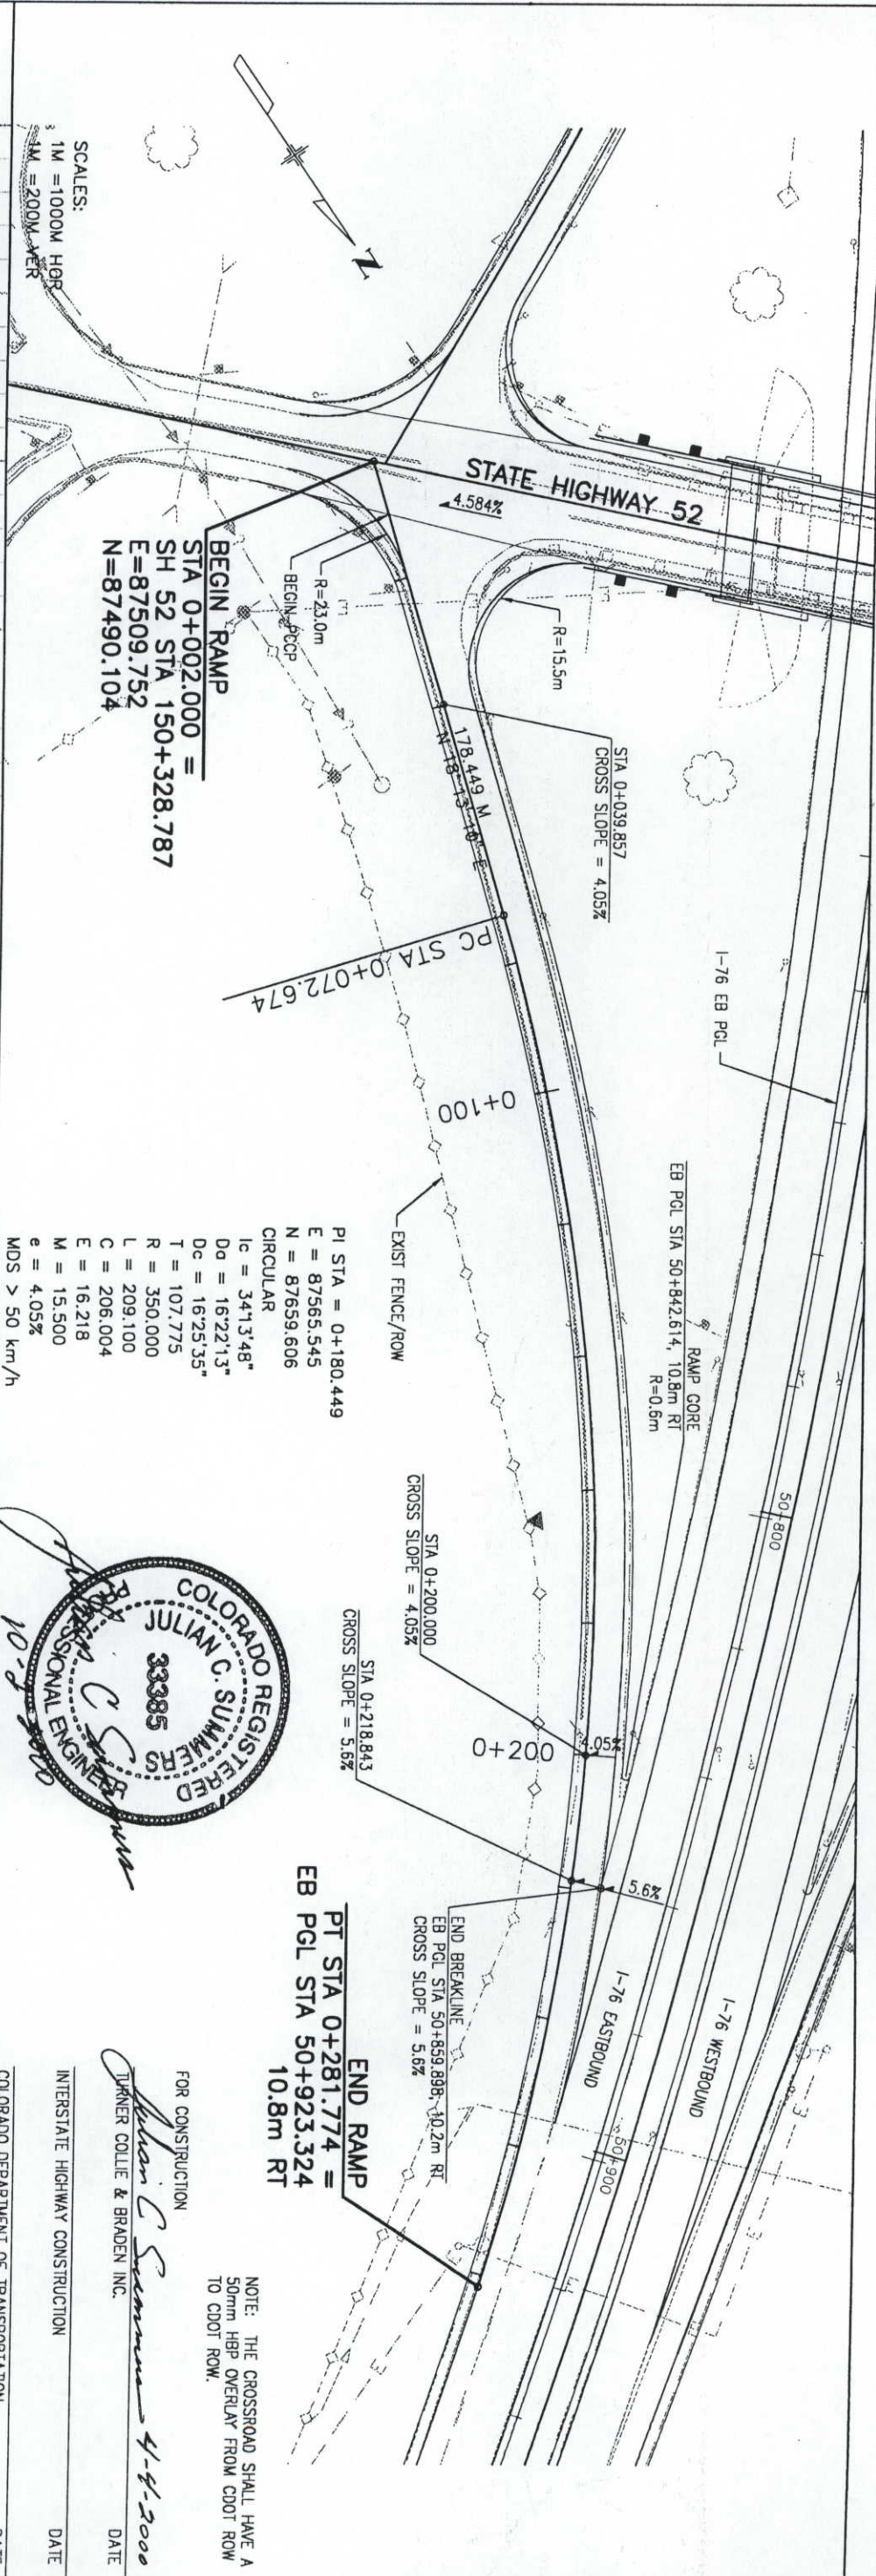

BEGIN RAMP
STA 0+002.000 =
MATCH SH 52
OVERLAY
CROSS SLOPE

Computer File Information				Sheet Revisions				As Constructed				Hudson EB On-Ramp				Project No./Code	
Creation Date:	07/08/99	Initials:	BSB	(R-X)				No Revisions:	3/24/01	Designer:	J. DeBerry	Structure		IM 0761-167			
Last Modification Date:	04/04/00	Initials:	BSB	(R-X)				Revised:		Detailer:	J. DeBerry	Numbers		11478			
Full Path:	I:\08711201\EAGLE_PT																
Drawing File Name:	RCP01011																
Acad Ver:	R14	Scale:	As Shown	Units:	Metric	(R-X)		Void:		Sheet Subsets:	1 of 1			Sheet Number	136		
												Region 4				RP	

Turner Collier & Braden Inc.

999 Eighteenth Street, Suite 1500
Denver, Colorado 80202
Phone: 303-298-7117 FAX: 303-296-1124

SCALES:
1M = 1000M HOR
1M = 200M VER

STA 0+055.691
BEGIN BREAKLINE AT EOT
CROSS SLOPE = 5.6%

STA 0+155.319
END BREAKLINE

INTERSTATE HIGHWAY CONSTRUCTION

DATE

DATE


DATE

TURNER COLLIE & BRADEN INC.

4-4-2000

COLORADO DEPARTMENT OF TRANSPORTATION

DATE

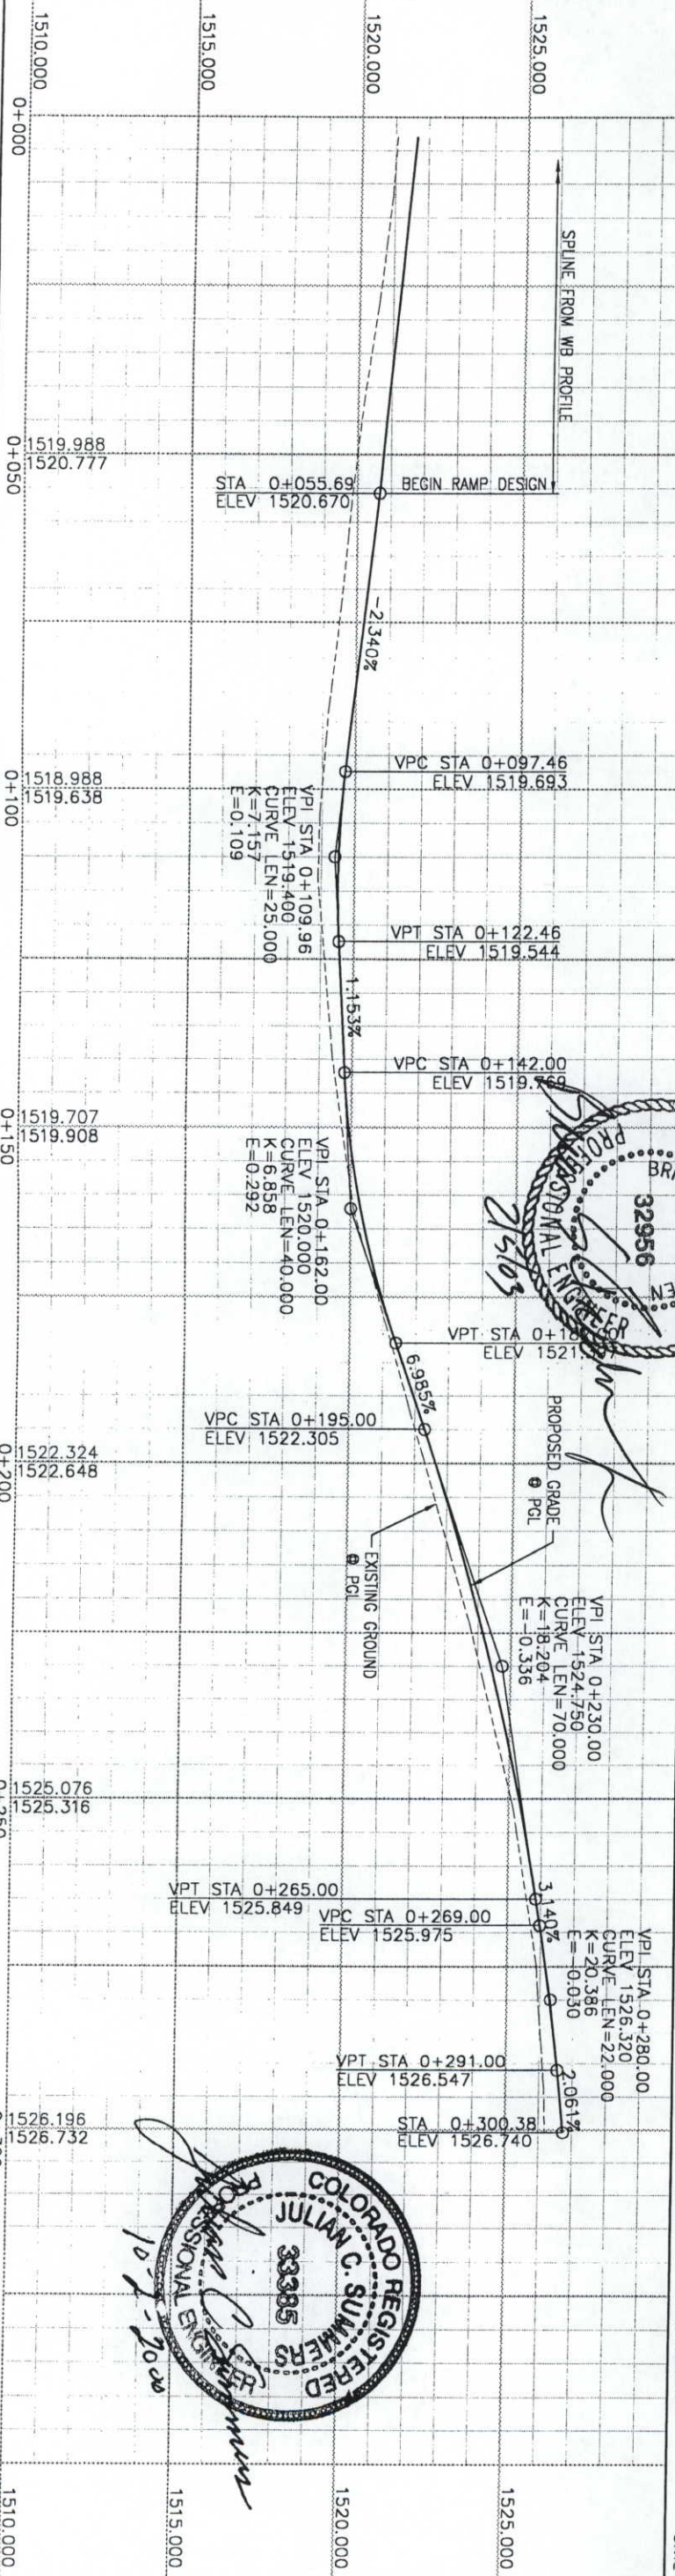

BEGIN RAMP
STA 0+003.000 =
WB PGL STA 50+386.342 10.8 m LT
E=87290.736
N=87331.966

PI STA = 0+113.457 CIRCULAR
E = 87339.310
N = 87431.169
Lc = 14.4056"
Dc = 28.3852"
Dc = 28.5718"
T = 25.766
R = 200.000
L = 51.251
C = 51.111
E = 1.653
M = 1.639

PI STA = 0+217.193 CIRCULAR
E = 87359.881
N = 87533.134
Lc = 15.4255"
Dc = 20.5005"
Dc = 20.5705"
T = 37.952
R = 275.000
L = 75.428
C = 75.192
E = 2.607
M = 2.582

END RAMP
STA 0+300.377 =
SH 52 STA 150+166.650
E=87397.928
N=87607.691

Computer File Information

Creation Date:	03/07/00	Initials:	JCS
Last Modification Date:	04/04/00	Initials:	JCS
Full Path:	I:\08711090\EAGLE_PT		
Drawing File Name:	RCP	(R-X)	(R-X)
Acad Ver:	R14	Scale:	As Shown Units: Metric

Sheet Revisions

 **Turner Collie & Braden Inc.**
999 Eighth Street, Suite 1500
Denver, Colorado 80202
Phone: 303-298-7117 FAX: 303-296-1124

Region 4

DP

As Constructed

No Revisions:	3/20/01
Revised:	
Void:	

Hudson WB On-Ramp

Designer:	J. Summers	Structure	
Detailer:	J. Summers	Numbers	
Sheet Subst:		Sheet Sheets:	1 of 1

Project No./Code

IM 0761-167
11478
Sheet Number 137

SCALES:
1M = 1000M HOR
1M = 200M VER

WB PGL STA 50+876.730, 10.2m LT
CROSS SLOPE = 5.6%

INTERSTATE HIGHWAY CONSTRUCTION



DATE

TURNER COLLE & BRADEN INC.

DATE

FOR CONSTRUCTION

NOTE: THE CROSSROAD SHALL HAVE A
50mm HBP OVERLAY FROM CDOT ROW
TO CDOT ROW.

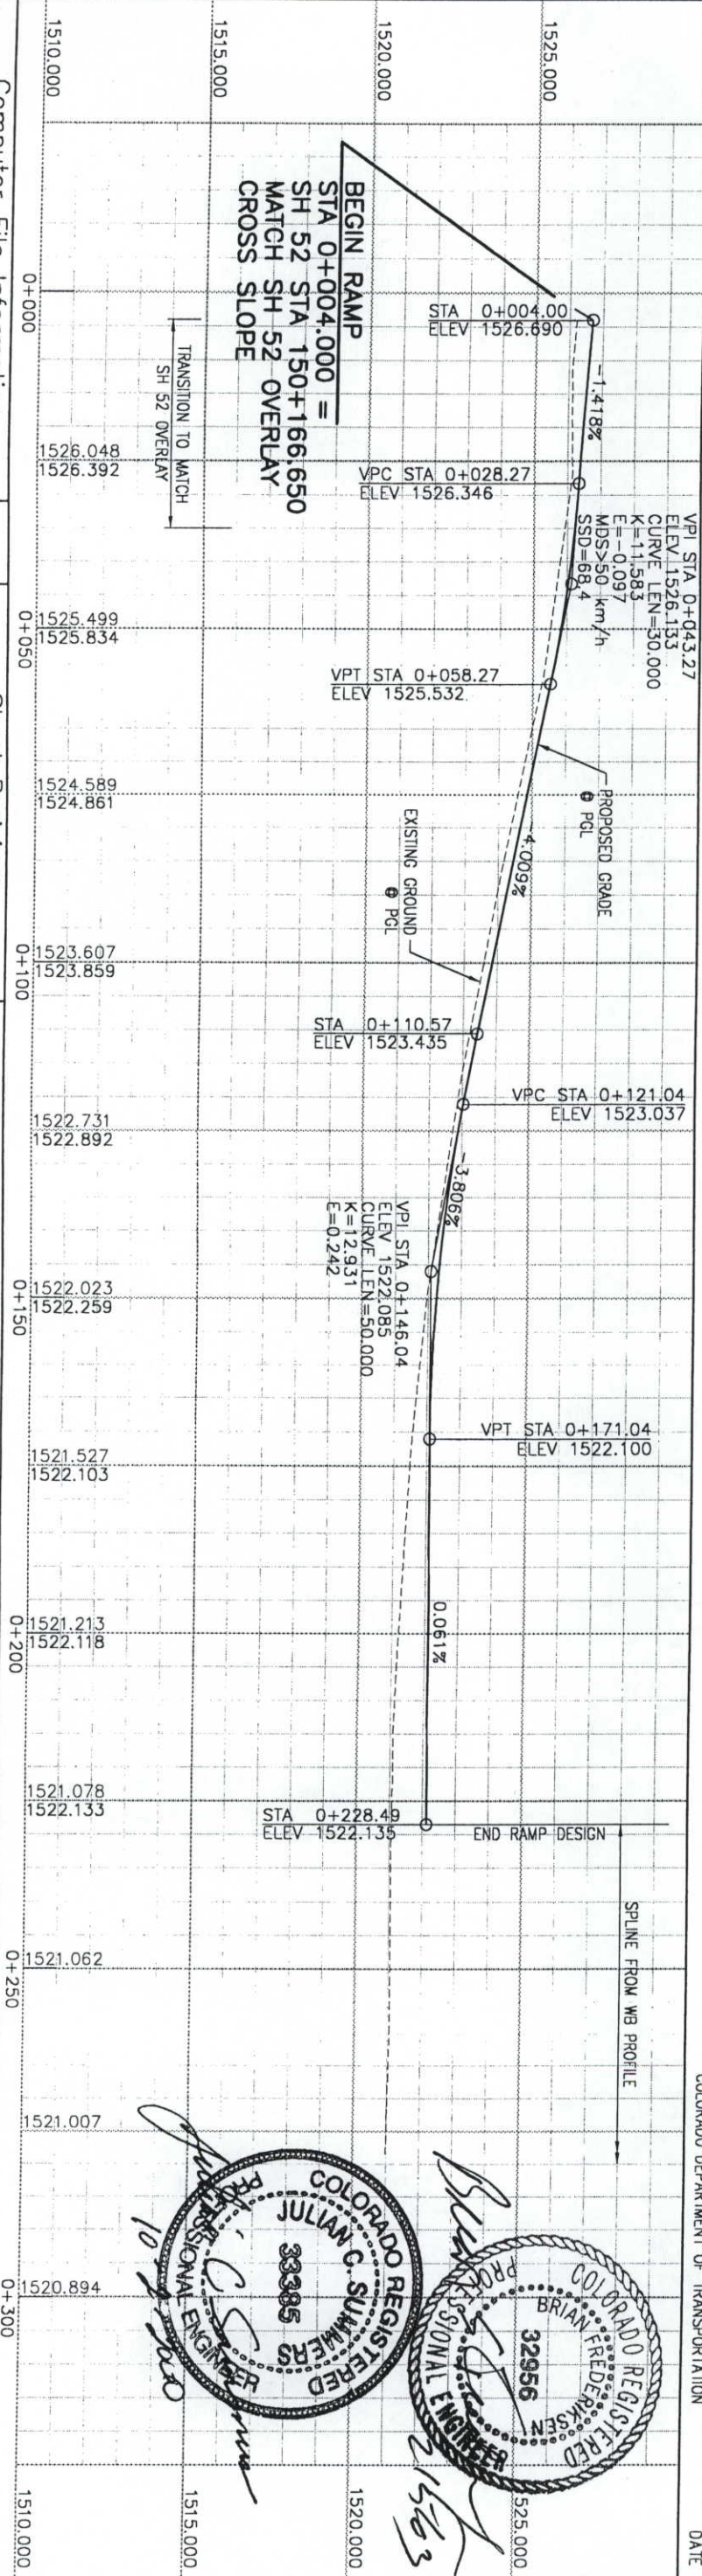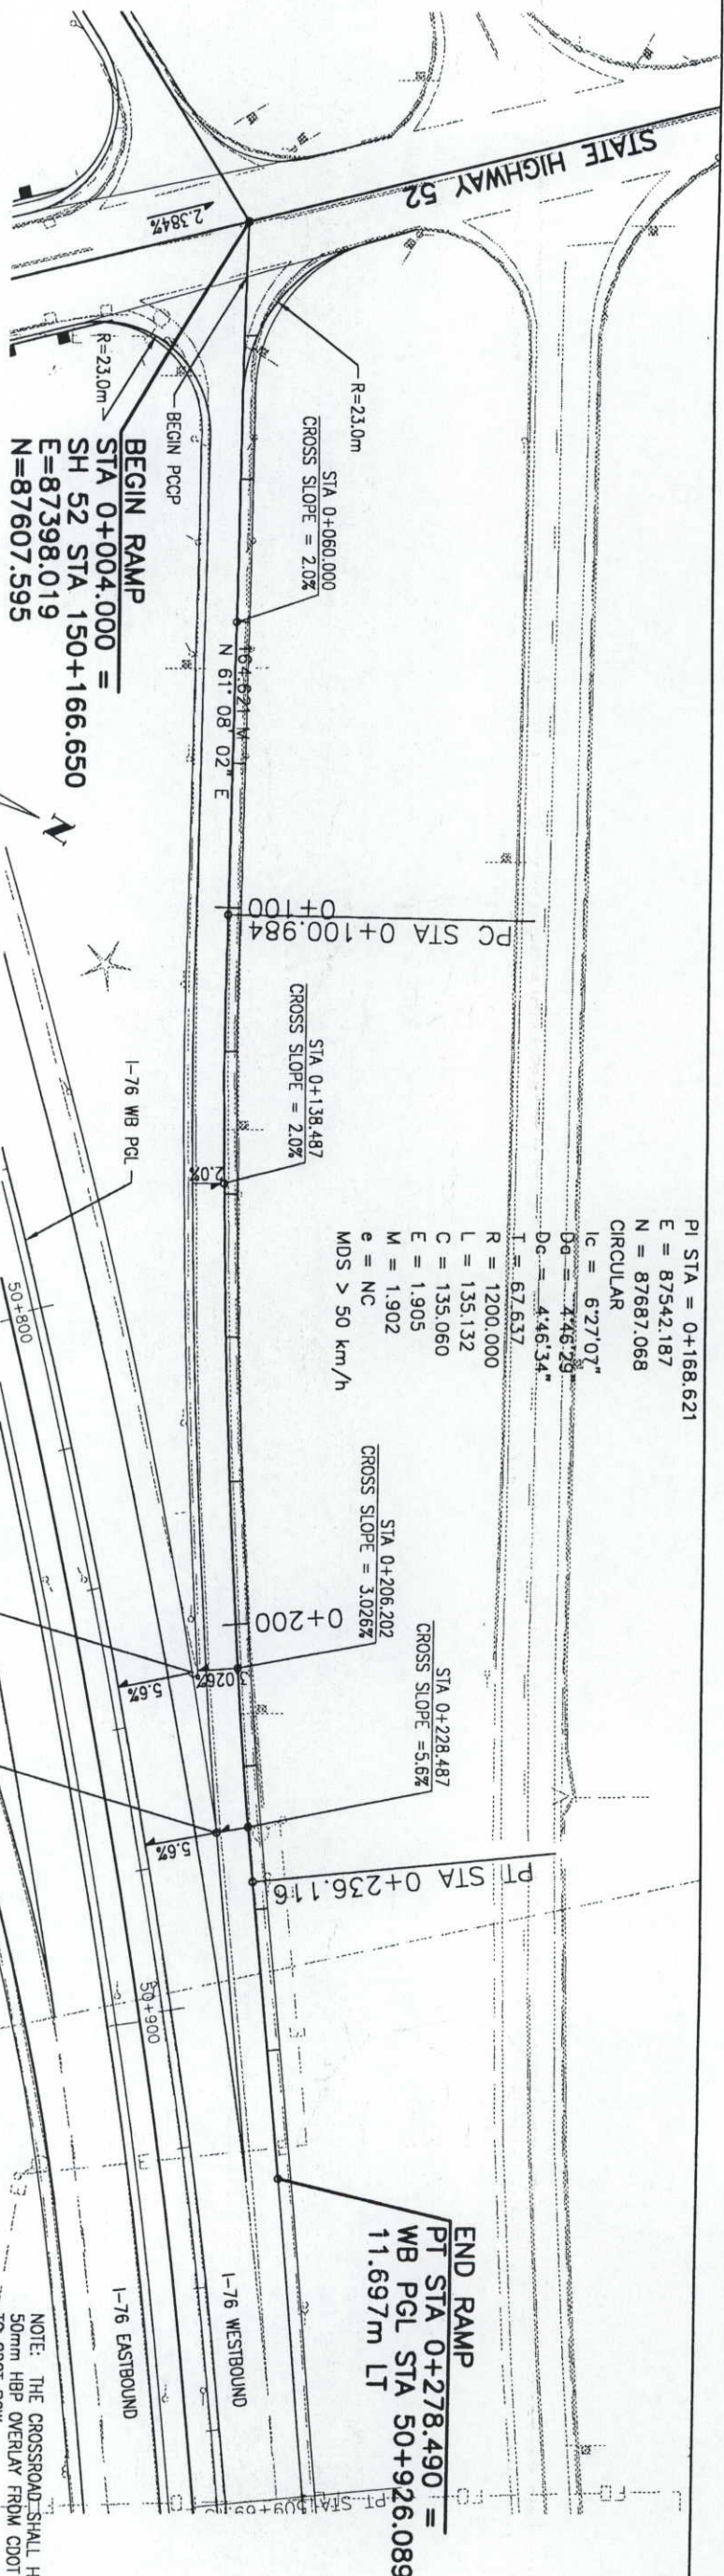

BEGIN RAMP
STA 0+004.000 =
SH 52 STA 150+166.650
MATCH SH 52 OVERLAY
CROSS SLOPE

END RAMP
PT STA 0+278.490 =
WB PGL STA 50+926.089
11.697m LT

Computer File Information

Creation Date:	07/08/99	Initials:	BSB
Last Modification Date:	04/04/00	Initials:	BSB
Full Path:	i:\08711201\EAGLE_PT		
Drawing File Name:	RCP01013		
Acad Ver:	R14	Scale:	As Shown
		Units:	Metric

Sheet Revisions

(R-X)	
(R-X)	
Turner College & Braden Inc.
999 Eighth Street, Suite 1500
Denver, Colorado 80202
Phone: 303-298-7117 FAX: 303-296-1124

Region 4

RP

As Constructed

No Revisions:	3/24/01
Revised:	
Void:	


Hudson WB Off-Ramp

Designer:	J. DeBerry
Detailer:	J. DeBerry
Sheet Subst:	

Project No./Code
IM 0761-167

11478

138

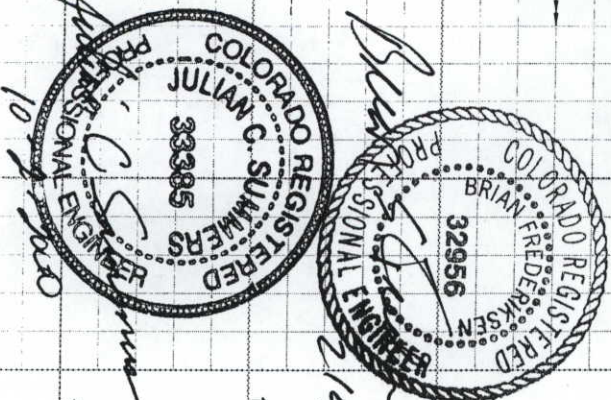

CALL UTILITY NOTIFICATION
CENTER OF COLORADO
1-800-922-1987


CALL 2-BUSINESS DAYS IN ADVANCE
BEFORE YOU DIG, GRADE OR EXCAVATE
FOR THE MARKING OF UNDERGROUND
MEMBER UTILITIES.

I-76 CL STA 49+775.02 =
WB PGL STA 49+773.11
BEGIN IM 0761-167

WB PGL PI STA = 50+576.864 CIRCULAR
E = 87324.347 $I_c = 40'19'34''$ L = 825.584
N = 87519.489 $D_a = 4'53'04''$ C = 808.649
 $D_c = 4'53'10''$ E = 76.580
T = 430.721 M = 71.887
e = 5.6%
MDS > 120 km/h

WB PGL PI STA = 49+544.253
E = 87067.397
N = 86315.512
CIRCULAR
 $I_c = 21'09'50''$
 $D_a = 6'32'53''$
 $D_c = 6'33'06''$
T = 163.466
R = 875.000
L = 323.206
C = 321.371
E = 15.138
M = 14.881

SCALES:
1M = 1000M HOR
1M = 200M VER

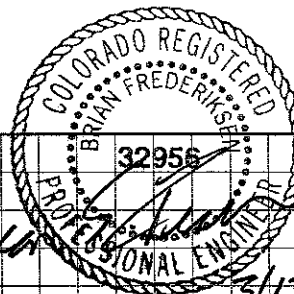

FOR CONSTRUCTION

TURNER COLLIE & BRADEN INC.


DATE

INTERSTATE HIGHWAY CONSTRUCTION

DATE

COLORADO DEPARTMENT OF TRANSPORTATION

DATE

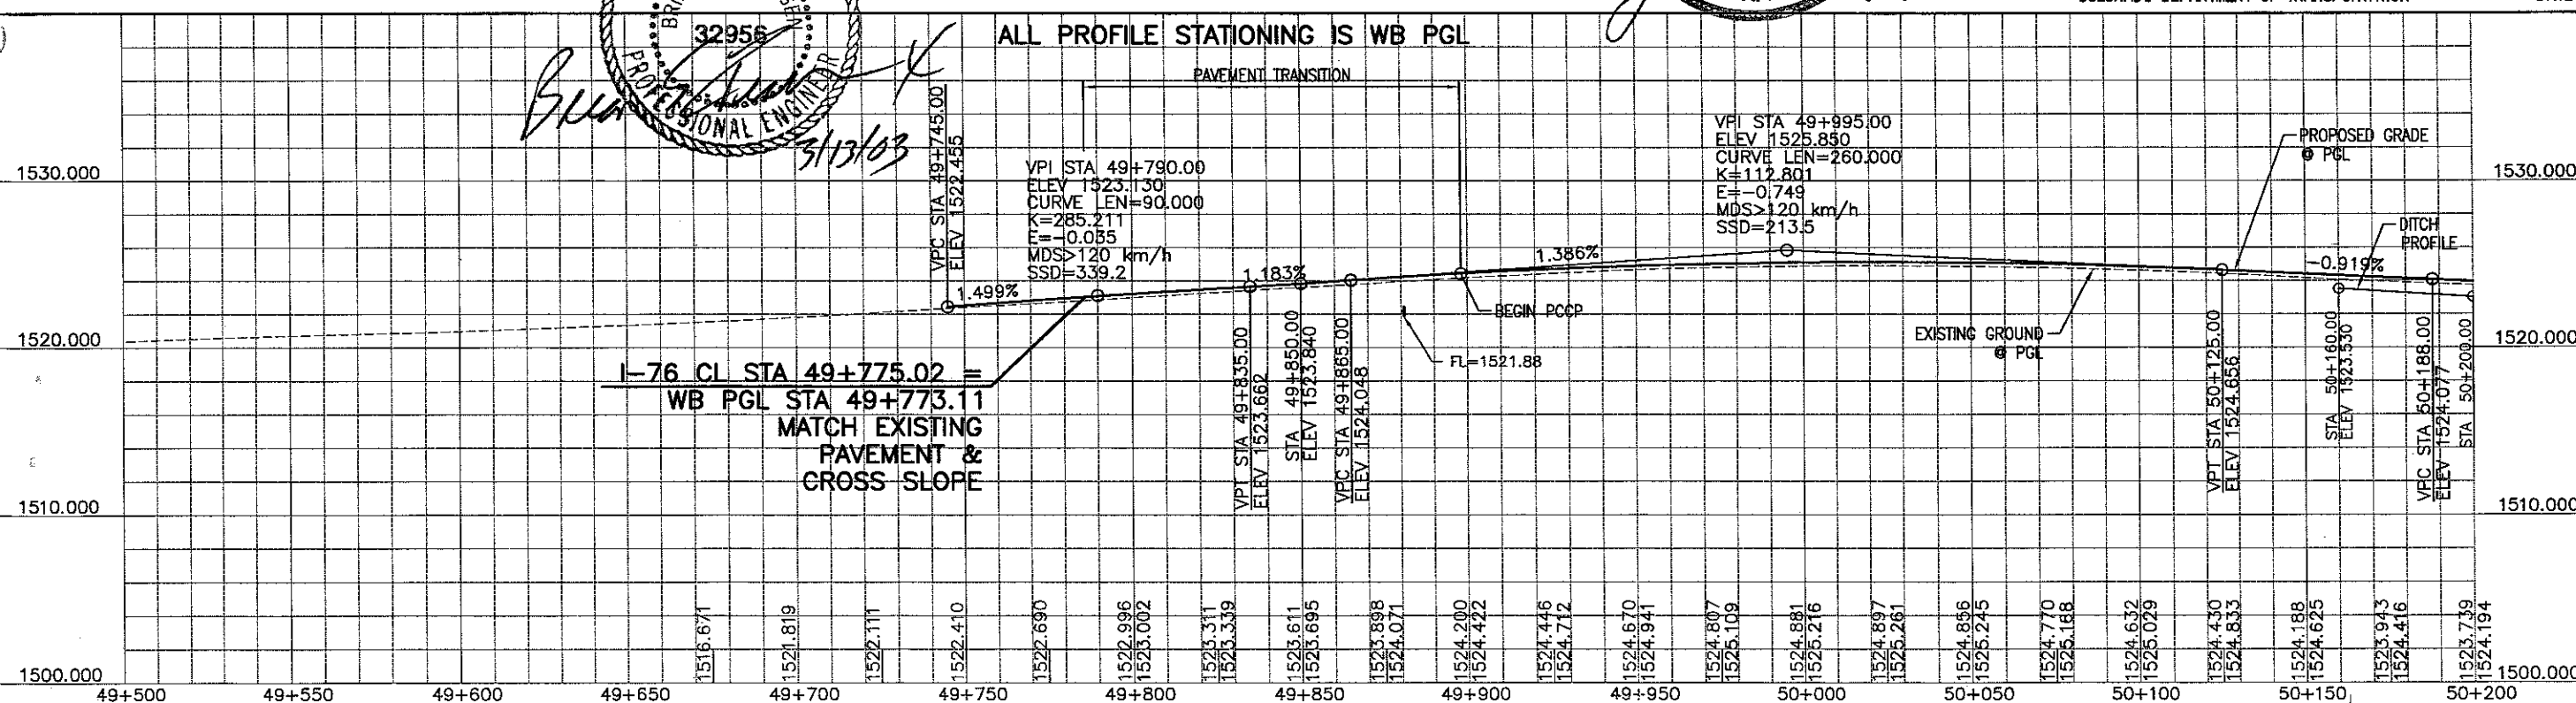

Computer File Information

Creation Date: 06/14/99 Initials: JHD
Last Modification Date: 03/13/01 Initials: MES
Full Path: I:\08711201\EAGLE_PT
Drawing File Name: RCP01005
Acad Ver. R14 Scale: As Shown Units: Metric

Sheet Revisions

(R-X)		
(R-X)		
(R-X)		
(R-X)		



Region 4

Turner Collie & Braden Inc.

999 Eighteenth Street, Suite 1500
Denver, Colorado 80202
Phone: 303-298-7117 FAX: 303-296-1124

RP

As Constructed

No Revisions: 03/08/01
Revised: 3/30/01
Void:

I-76 Hudson Westbound

Designer: J. DeBerry
Detailer: J. DeBerry
Sheet Subset:

Structure Numbers
Subset Sheets: 1 of 25

Project No./Code



IM 0761-167

11478

Sheet Number 80

jle_pt\rcp02005.dwg Mon Mar 19 15:24:09 2001

711204

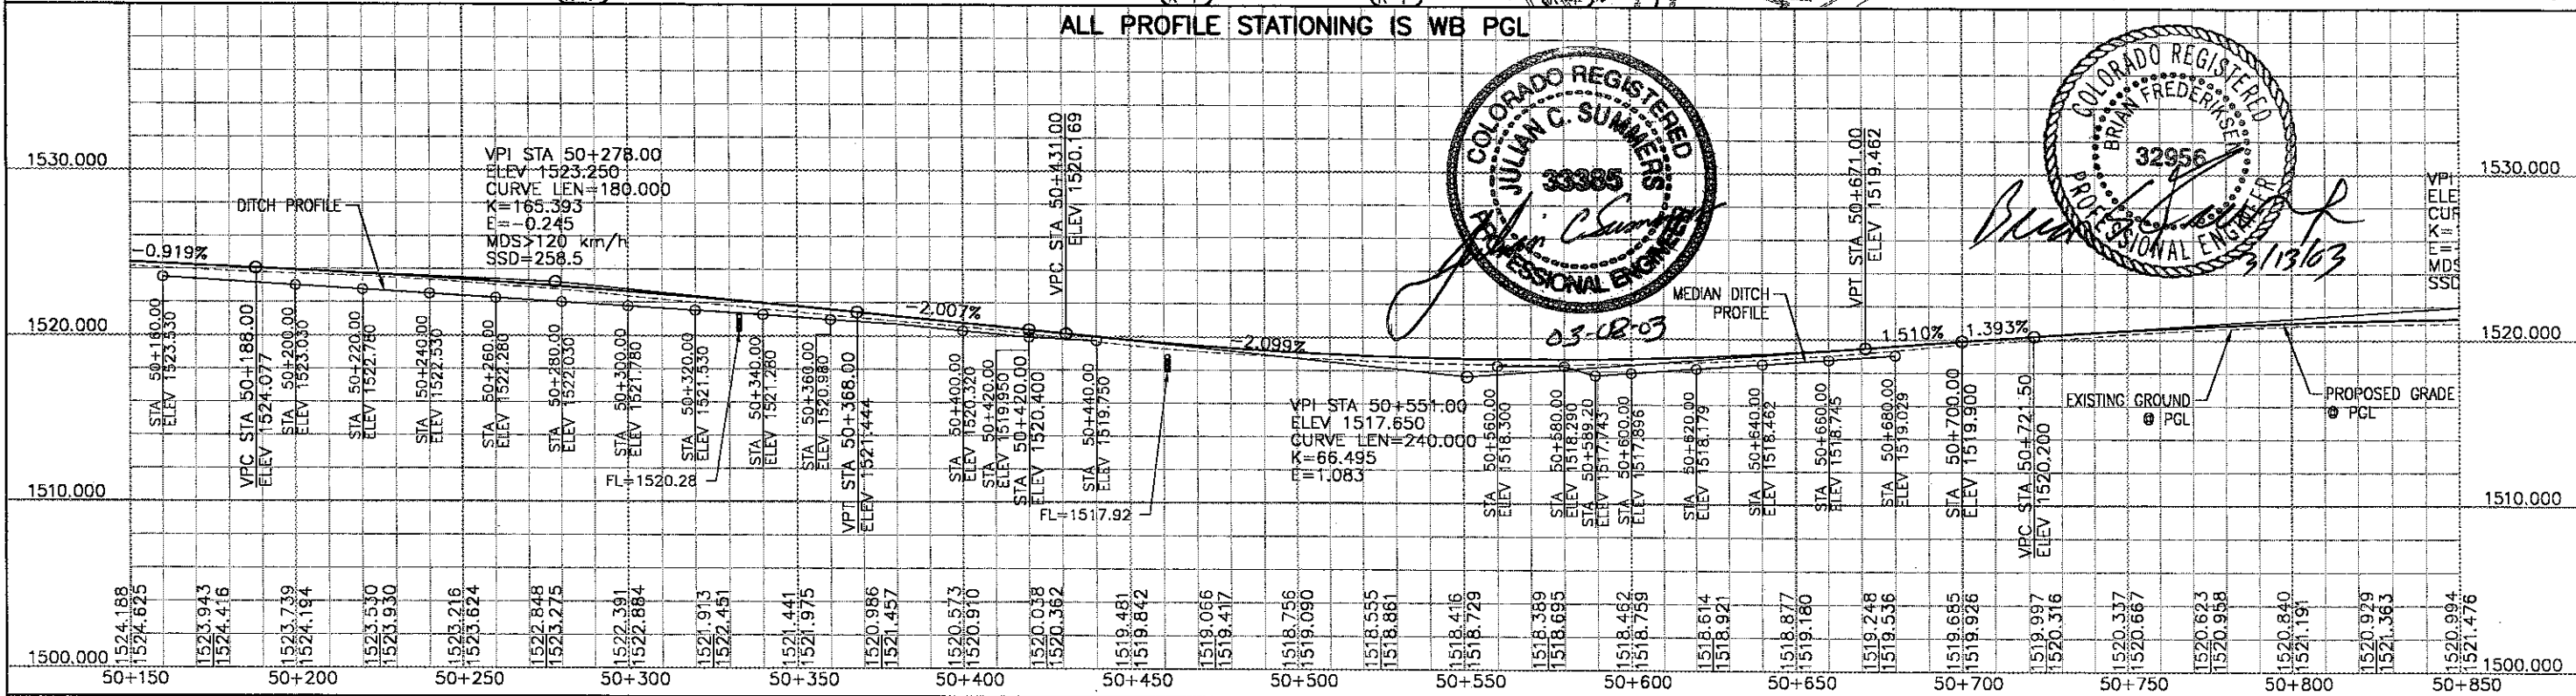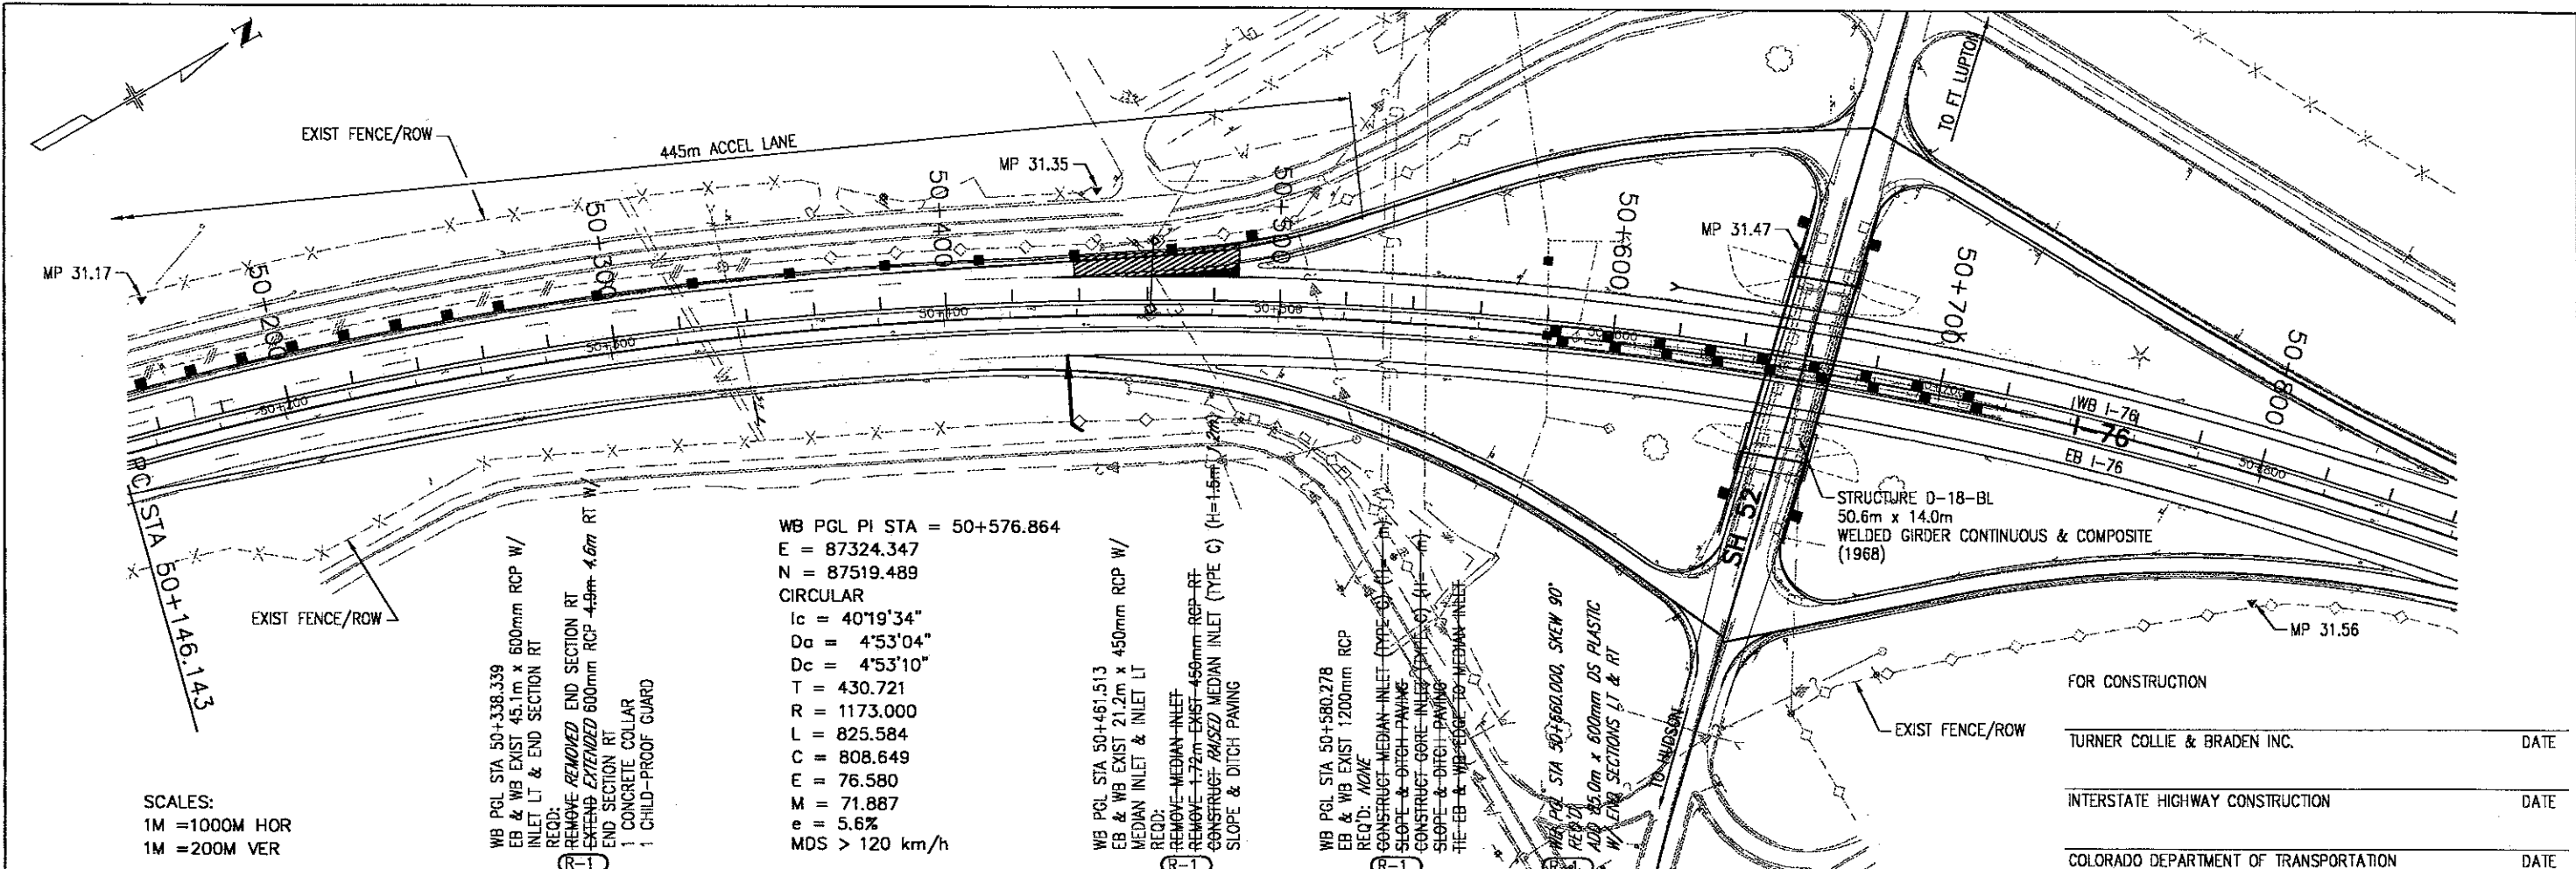

Computer File Information			Sheet Revisions			As Constructed			I-76 Hudson Westbound			Project No./Code	
Creation Date:	06/14/99	Initials: JHD	(R-1)	03/08/01	AS BUILT	JCS	No Revisions:					IM 0761-167	
Last Modification Date:	03/19/01	Initials: MES	(R-X)				Revised: 3/20/01	03/08/01	Designer: J. DeBerry	Structure Numbers		11478	
Full Path:	I:\08711201\EAGLE_PT						Void:		Detailer: J. DeBerry	Sheet Subset:	Subset Sheets: 2 of 25	Sheet Number 81	
Drawing File Name:	RCP02005												
Acad Ver.	R14	Scale: As Shown	Units: Metric										



Region 4

TurnerCollie&Braden Inc.

999 Eighteenth Street, Suite 1500
Denver, Colorado 80202
Phone: 303-298-7117 FAX: 303-296-1124

RP

I:\0871121\rcp01012.dwg Tue Apr 04 23:02:47 2000

