

OF HIGHWAYS
SHEET

INDEX OF SHEETS
SHEET NO.

- 1 SKETCH MAP & TITLE SHEET
- 2-3 TABULATION OF PROPERTIES SHEETS
- 4-16 PLAN & PROFILE SHEETS
- 17-19 OWNERSHIP MAP SHEETS

COLORADO DEPARTMENT OF HIGHWAYS

PLAN AND PROFILE OF PROPOSED
FEDERAL AID PROJECT NO. ~~I-092-3(2)~~
I 25-1(9)48
STATE HIGHWAY NO. ~~4~~ **25**
HUERFANO COUNTY

SCALES OF ORIGINAL DRAWINGS


ON PLAN, 1 IN. = 100 FT.
ON PROFILE, 1 IN. = 100 FT. HORIZONTAL
1 IN. = 10 FT. VERTICAL
GRADE LINE ON PROFILE IS SHOWN AS GRADE OF FINISHED ROAD
GROSS LENGTH OF PROJECT
NET LENGTH OF PROJECT

RIGHT OF WAY

FEDERAL ROAD DIVISION NO.	DISTRICT	PROJ. NO.	SHEET NO.
9	COLORADO	I-25-1(9)48	1
RIGHT OF WAY			
REVISIONS			
6-19-59	Begin B. Eng.	19. R	

CONVENTIONAL SIGNS

CENTER LINE
RIGHT OF WAY LINE
COUNTY LINE
TOWNSHIP OR RANGE LINE
LAND LINES
RAILROAD
BARBED WIRE FENCE
COMBINATION WIRE FENCE
SNOW FENCE
TELEPHONE & TELEGRAPH LINES
POWER LINE
DETOUR
PRESENT ROAD (Plan Sheets)
Access denied by Deed
Frontage Road (Present Const.)
Frontage Road (Future Const.)
Protected By (Virgin Location)
Freeway Law

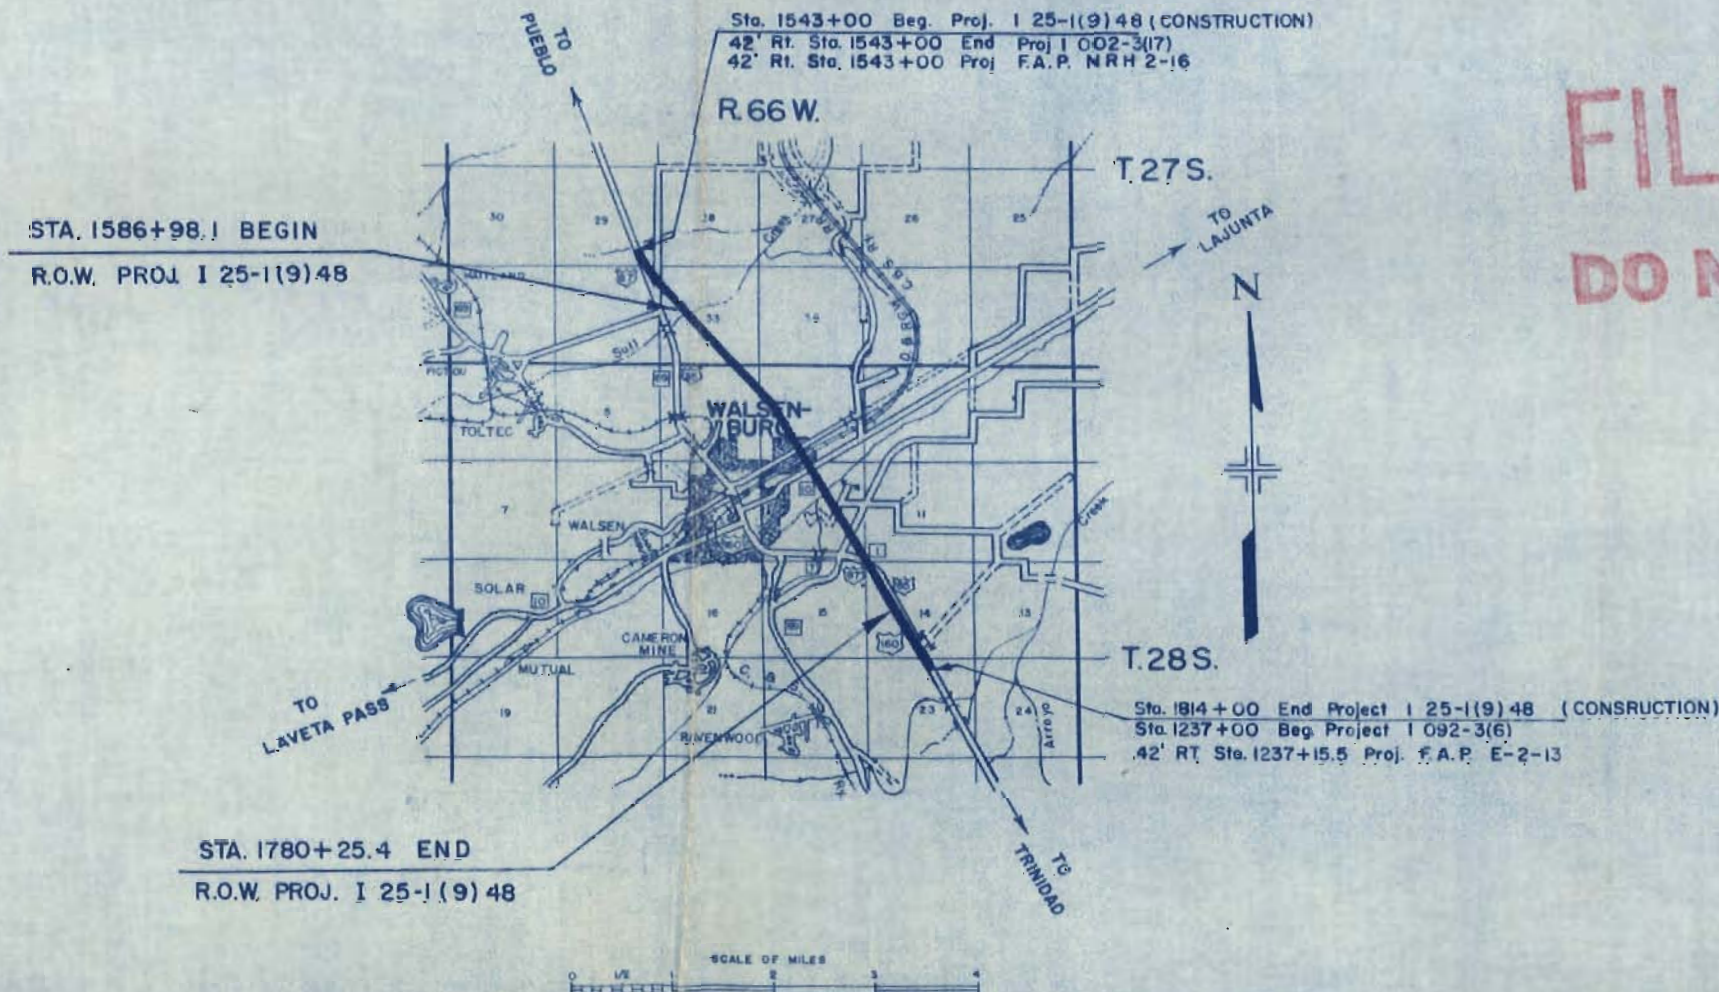

FILE COPY
DO NOT REMOVE

PARCEL NO.	OWNER	ADDRESS	LOCATION	AREA IN ACRES							REMARKS	NO
				TOTAL LAND IN TRACT	PARCEL	TO BE ACQUIRED						
			T.27S., R. 66 W. SECTION 33 SE 1/4 OF NW 1/4, E 1/2 OF SW 1/4, W 1/2 OF SE 1/4 E 1/2 OF SW 1/4, W 1/2 OF SE 1/4,									
1	JOHN W. ALBRIGHT & RAE B. ALBRIGHT				32.481	32.481						
E-1	JOHN W. ALBRIGHT & RAE B. ALBRIGHT				3.073	3.073						
E-1-A	JOHN W. ALBRIGHT & RAE B. ALBRIGHT		E 1/2 OF SW 1/4,		5.739	5.739					PERMANENT EASEMENT	
E-1-B	JOHN W. ALBRIGHT & RAE B. ALBRIGHT		E 1/2 OF NW 1/4, E 1/2 OF SW 1/4,		0.732	0.732					PERMANENT EASEMENT	
E-1-C	JOHN W. ALBRIGHT & RAE B. ALBRIGHT		NE 1/4 SW 1/4		0.117	0.117					PERMANENT EASEMENT	
E-1-D	DELETED											
E-1-E	ST. MARY CEMETARY ASSOCIATION INCORPORATED		W 1/2 OF NW 1/4 & 1/2 W 1/2 OF SW 1/4 SW 1/4 OF NW 1/4		1.442	1.442					PERMANENT EASEMENT	
E-1-F	ST. MARY CEMETARY ASSOCIATION INCORPORATED				0.653	0.653					PERMANENT EASEMENT	
			T.28S., R. 66 W. SECTION 4									
2	EVERETT L. KINTIGH & JESSIE I. KINTIGH		NW 1/4 OF NE 1/4 (LOT 2)		4.805	4.805						
3	BEN D. MARCHIORI & JOSEPHINE MARCHIORI		E 1/2 OF NE 1/4		23.884	23.884						
E-3	DELETED											
E-3-A	BEN D. MARCHIORI & JOSEPHINE MARCHIORI		E 1/2 OF NE 1/4		0.627	0.627					PERMANENT EASEMENT	
3A	BEN D. MARCHIORI & JOSEPHINE MARCHIORI		E 1/2 OF NE 1/4		21.155	21.155						
			SECTION 3									
4	JOHN W. ALBRIGHT & RAE B. ALBRIGHT		NW 1/4 OF NW 1/4		0.121	0.121						
5	BEN D. MARCHIORI & JOSEPHINE MARCHIORI		W 1/2 OF SW 1/4 OF NW 1/4 & NW 1/4 OF SW 1/4		14.969	14.969						
6	HANNAH UGOLINI, FLORENCE BERNADINE UGOLINI, WILLIAM EDWARD UGOLINI, CARLENE FRANCES UGOLINI, HEIRS AT LAW		E 1/2 OF SW 1/4 OF NW 1/4, NE 1/4 OF SW 1/4, NW 1/4 OF SW 1/4		23.359	23.359						
5A	BEN D. MARCHIORI & JOSEPHINE MARCHIORI		W 1/2, SW 1/4, NW 1/4		3.746	3.746						
			FARR'S ADDITION TO THE CITY OF WALSENBURG, COLO.									
7	ELIAS CRUZ & MODESTA CRUZ		ALL OF LOTS 13 TO 16 INCL. BLOCK 56		0.096	0.096						
8	TOWN OF WALSENBURG		ALL OF BLOCKS 32 & 37		4.070	4.070						
9 Rev.	THE TAYLOR ABSTRACT CO.		BLOCK 31 & 38									
ER-10	COLORADO & SOUTHERN RAILWAY COMPANY		BLOCK 13 & 14		1.894	1.894					ACCESS ONLY	
											PERMANENT EASEMENT	
			SECTION 3									
ER-11	D. & R. G. W. R.R.		S 1/2		1.670	1.670					PERMANENT EASEMENT	
12	UNKNOWN		SW 1/4		0.309	0.157						
13	SAM K. BAYLIS & LETHA BAYLIS		SW 1/4 OF SE 1/4		0.976	0.719						
13A Rev.	SAM K. BAYLIS & LETHA BAYLIS		SE 1/4		1.246	0.951						
			SECTION 10									
14A Rev.	HANNAH UGOLINI, FLORENCE BERNADINE UGOLINI, WILLIAM EDWARD UGOLINI, CAROLINE FRANCIS UGOLINI, HEIRS AT LAW		NE 1/4 OF NW 1/4		3.644	3.281						
14	HANNAH UGOLINI, FLORENCE BERNADINE UGOLINI, WILLIAM EDWARD UGOLINI, CARLENE FRANCES UGOLINI, HEIRS AT LAW		E 1/2 OF NW 1/4		0.823	0.809						
E-14-Rev2	HANNAH UGOLINI, FLORENCE BERNADINE UGOLINI, WILLIAM EDWARD UGOLINI, CARLENE FRANCES UGOLINI, HEIRS AT LAW		NE 1/4 OF NW 1/4		0.433	0.410					PERMANENT EASEMENT	
15	SAM K. BAYLIS & LETHA BAYLIS		NW 1/4 OF NE 1/4		13.052	13.052						
E-15	SAM K. BAYLIS & LETHA BAYLIS		NW 1/4 OF NE 1/4		5.248	5.248					PERMANENT EASEMENT	
15A Rev.	SAM K. BAYLIS & LETHA BAYLIS		NW 1/4 OF NE 1/4		2.529	2.529						
15B Rev.	SAM K. BAYLIS & LETHA BAYLIS		NW 1/4 OF NE 1/4		1.218	1.218						
E13A	SAM K. BAYLIS & LETHA BAYLIS		NE 1/4		0.216	0.216					PERMANENT EASEMENT	

REVISIONS			
6-19-59	9 DELETED, (9 Rev Access)	DWB	
4-24-62	Added 13A, 14A, 15A, & 15B		
	Rev E 14 & E 15B	AWP	
5-22-62	Rev 13A, 14A, E 14 Rev, 15A, 15B, & E 15B Rev.	LRJ	
6-15-62	Added E 13A	LRJ	

#5745 6/6/62 Incl. 8, 25, 27

#5235 6/5/62 Incl. 13-Access, 15-Access, 15-B Rev, E 13A

#3860 6/5/62 Incl. 14-Access, E-14 Rev.

R.O.W. TABULATION OF PROPERTIES IN HUERFANO COUNTY S.H.No. 1 PROJ. ~~I-092-3(2)~~ I 25-1(9)48

Rev. 4-1-59 (Over 16, E-16) JLS

FEDERAL ROAD DIVISION NO.	DISTRICT	PROJ. NO.	SHEET NO.	TOTAL SHEETS
9	COLORADO	I-092-3(2)	3	

RIGHT OF WAY I 25-1(9)48


PARCEL NO.	OWNER	ADDRESS	LOCATION T.28S., R.66W. SECTION 10	AREA IN ACRES							REMARKS	NO.
				TOTAL LAND IN TRACT	PARCEL	TO BE ACQUIRED						
15D	SAM K. BAYLIS & LETHA BAYLIS		NW 1/4 OF NE 1/4		0.308	0.308						E15D
TE15-B Rev. 2	SAM K. BAYLIS & LETHA BAYLIS		NW 1/4 OF NE 1/4		0.023	0.023				50.00	10/1/62 TEMPORARY EASEMENT	TE-15-B
E-15-C	SAM K. BAYLIS & LETHA BAYLIS		NW 1/4 OF NE 1/4		0.073	0.073					PERMANENT EASEMENT	E15-C
E-15-A	SAM K. BAYLIS & LETHA BAYLIS		NW 1/4 OF NE 1/4		0.037	0.037					PERMANENT EASEMENT	E15-A
16	GEORGE AMEDEI & LENA AMEDEI		W 1/2 OF SW 1/4 OF NE 1/4		0.782	0.782						
E-16	GEORGE AMEDEI & LENA AMEDEI		W 1/2 OF SW 1/4 OF NE 1/4		8.812	8.812					PERMANENT EASEMENT	E-16
17	GEORGE AMEDEI & LENA AMEDEI		E 1/2 OF SW 1/4 OF NE 1/4		11.719	11.719						
E-17	GEORGE AMEDEI & LENA AMEDEI		E 1/2 OF SW 1/4 OF NE 1/4		5.137	5.137					PERMANENT EASEMENT	E-17
17A	GEORGE AMEDEI & LENA AMEDEI		E 1/2 OF SW 1/4 OF NE 1/4		1.726	1.726				235	10/10/62	E17A
18	GEORGE HUDRAN & JEAN EFFIE HUDRAN		W 1/2 OF E 1/2 OF NE 1/4		1.743	1.743						
E-18	GEORGE HUDRAN & JEAN EFFIE HUDRAN		W 1/2 OF E 1/2 OF NE 1/4		0.288	0.288					PERMANENT EASEMENT	E-18
19	MIKE HUDRAN & MARY C. HUDRAN		E 1/2 OF SE 1/4		29.943	26.566						
20	JACOB BOBIAN		NE 1/4 OF SE 1/4		0.116	0.116						
E-20	JACOB BOBIAN		NE 1/4 OF SE 1/4		0.055	0.055					PERMANENT EASEMENT	E-20
21	DONALD VIGIL		NE 1/4 OF SE 1/4		0.069	0.069						
22	MARY LEGARDIA P. PADILLA		NE 1/4 OF SE 1/4		1.000	1.000						
23	OSCAR VALDEZ & ROSE VALDEZ		NE 1/4 OF SE 1/4		0.674	0.674						
24	LA FRATENIDAD PIADOSADE DE NUESTRO PADRE JESUS A LOS HERMANOS DEL CRICO		NE 1/4 OF SE 1/4		0.737	0.737						
25	CITY OF WALSENBURG		SECTION 11 W 1/2 OF SW 1/4 OF SW 1/4		2.803	2.803						
26	MIKE HUDRAN & MARY C. HUDRAN		SECTION 15 NE 1/4 OF NE 1/4		2.668	2.071						
27	CITY OF WALSENBURG		SECTION 14 W 1/2 OF NW 1/4 OF NW 1/4		2.235	2.235						
28	LILLIE NOVAK		W 1/2 OF NW 1/4 OF NW 1/4		22.955	20.820						
29	MIKE HUDRAN & MARY C. HUDRAN		SW 1/4 OF NW 1/4, NW 1/4 OF SW 1/4		4.162	2.355						
29 A	EDNA B. LEVY		E 1/2 OF NW 1/4 OF NW 1/4		5.951	5.951				3400	9/17/62 Incl. 30	
30	EDNA B. LEVY		SE 1/4 OF NW 1/4 & NE 1/4 OF SW 1/4		0.834	0.834						

SE 1/4 SEC. 29
T.27S., R.66W

RIGHT OF WAY

Rev. 5-26-59 (Access Control) (DWB.)

FED. ROAD DIV. NO.	DIST.	PROJ. NO.	SHEET NO.	TOTAL SHEETS
9	COLO.	I-092-3(12)	4	

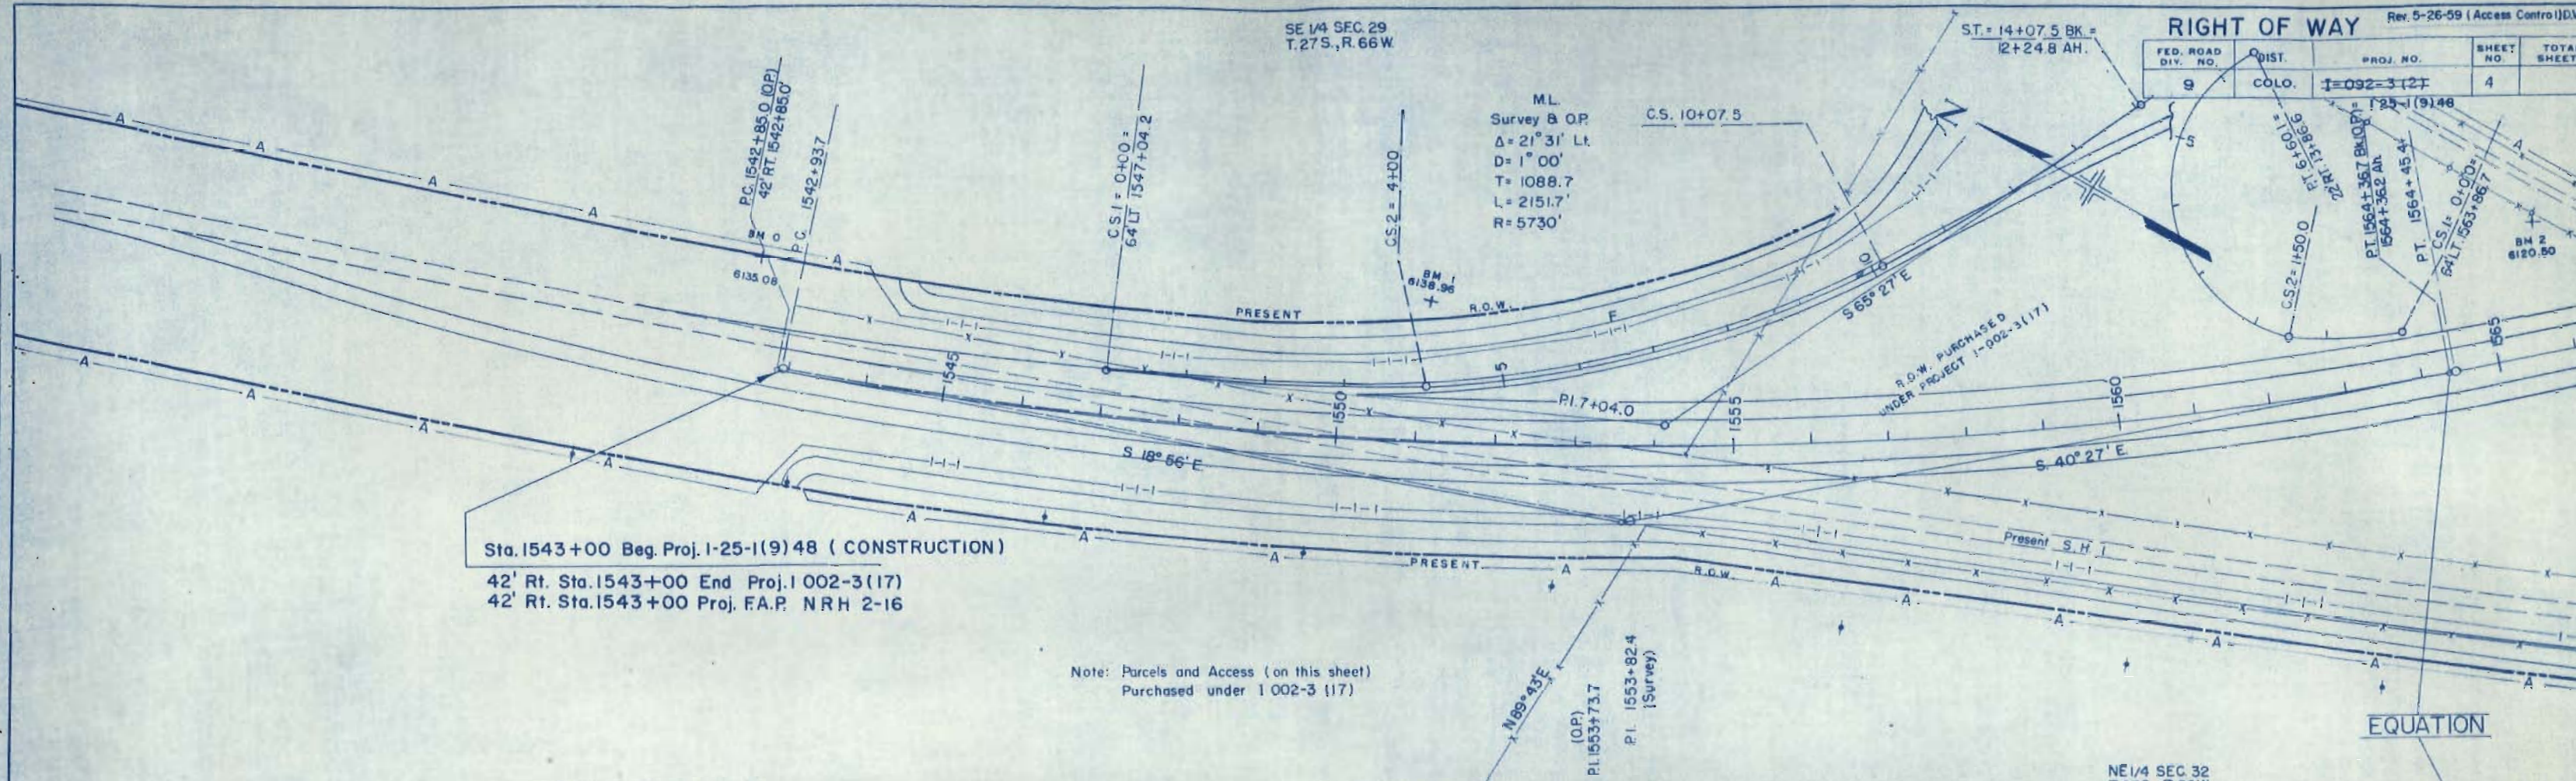

Sta. 1543+00 Beg. Proj. I-25-1(9) 48 (CONSTRUCTION)

42' Rt. Sta. 1543+00 End Proj. I 002-3(17)
42' Rt. Sta. 1543+00 Proj. F.A.P. NRH 2-16

Note: Parcels and Access (on this sheet)
Purchased under 1 002-3 (17)

NE 1/4 SEC. 32
T.27S., R.66W.

6140
6130
6120

NOTE: BOOK GRADINGS CHECKED
B.M. 1542.96
STRUCTURE NOTATION: CHYD

COLORADO DEPARTMENT OF HIGHWAYS
Form C.D.R. 134
April 1962

PLAN
CONVISED
PLOTTER
NOTE BOOK
ALIGNMENT CHECKED
RT. OF WAY CHECKED
NO.

CONVISED
PLOTTER
NOTE BOOK
GRADES CHECKED
S. & A. NOTES
STRUCTURE NOTATION CHECKED
NO.


NW 1/4 SEC 33
T.27S., R.66W.

JOHN W. ALBRIGHT
RAE B. ALBRIGHT


Rev. 4-1-59 (Owner on I, E-I, E-IA, B, C) JLS
Rev. 5-26-59 (To show access control) DWB.

FED. ROAD DIST. NO.	DIST.	PROJ. NO.	SHEET NO.	TOTAL SHEETS
9	COLO.	1-092-3(2)	5	

RIGHT OF WAY 125-1(9)48

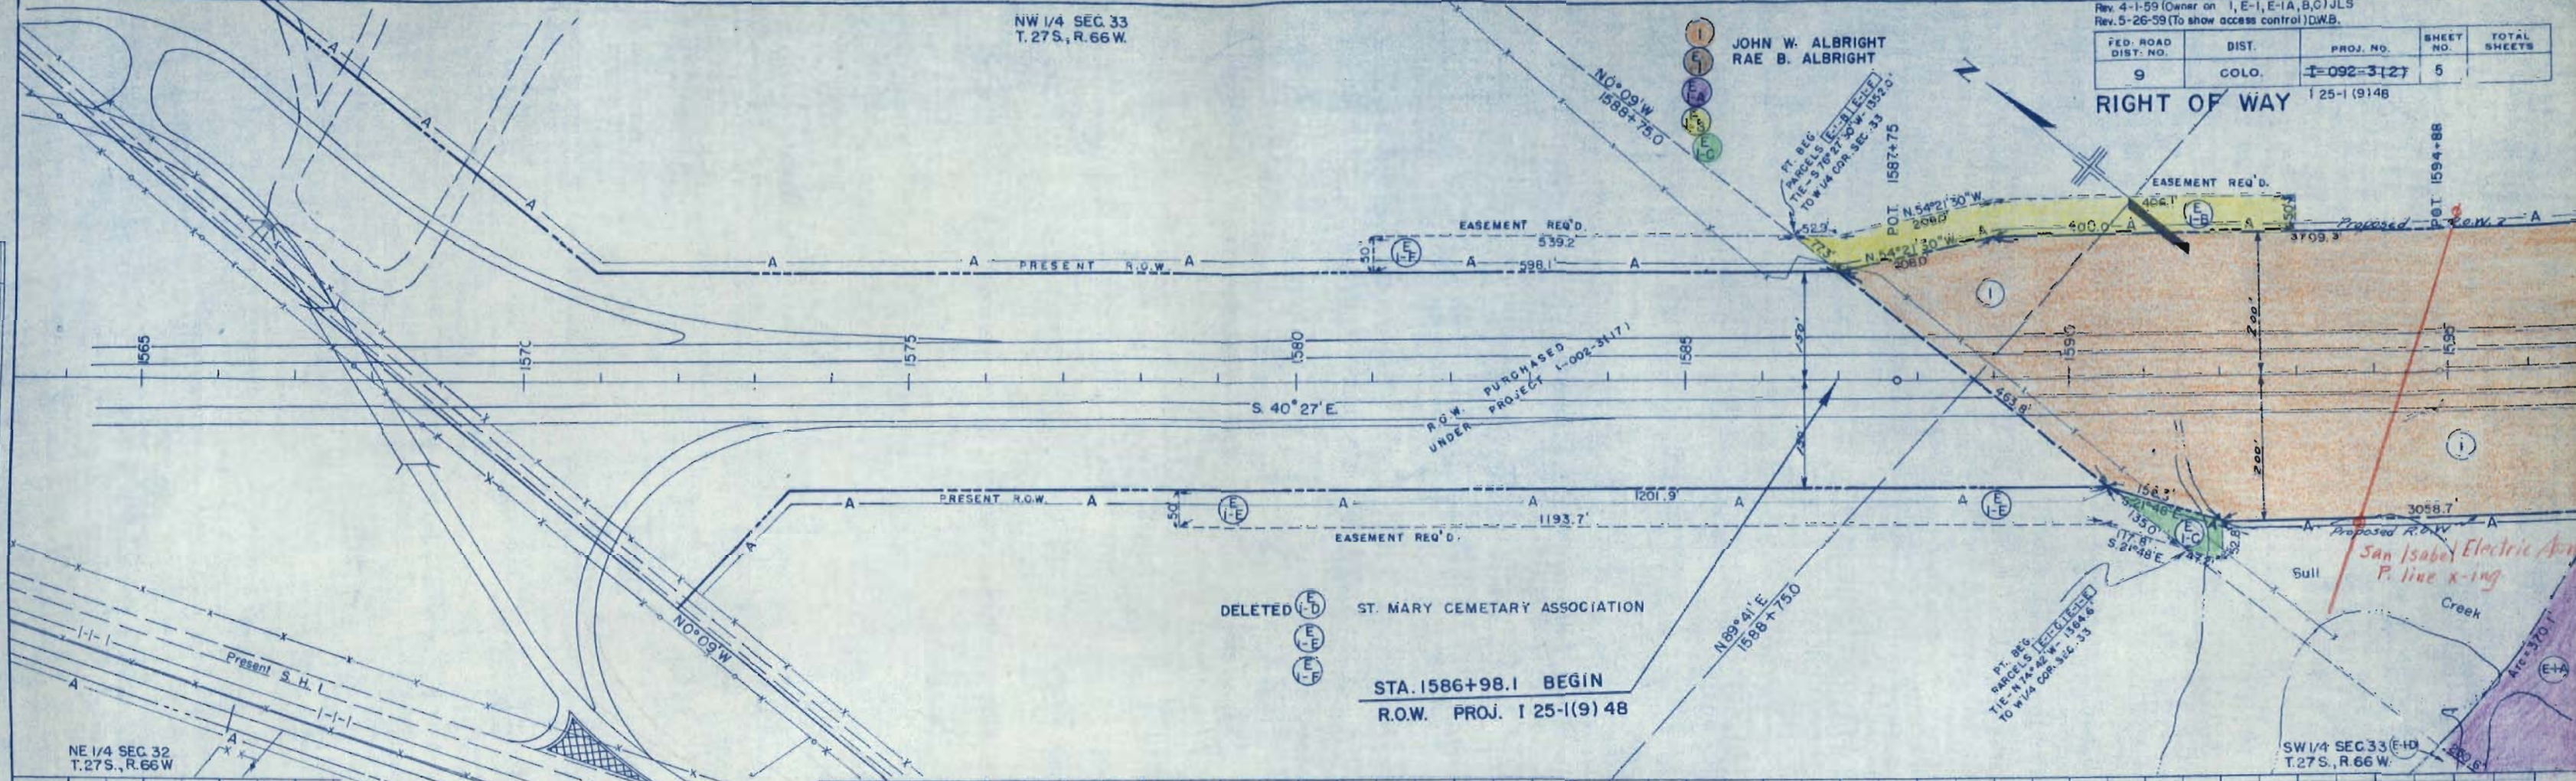


35' open
1571+50
Appr. by H.W. Harris
6/14/63

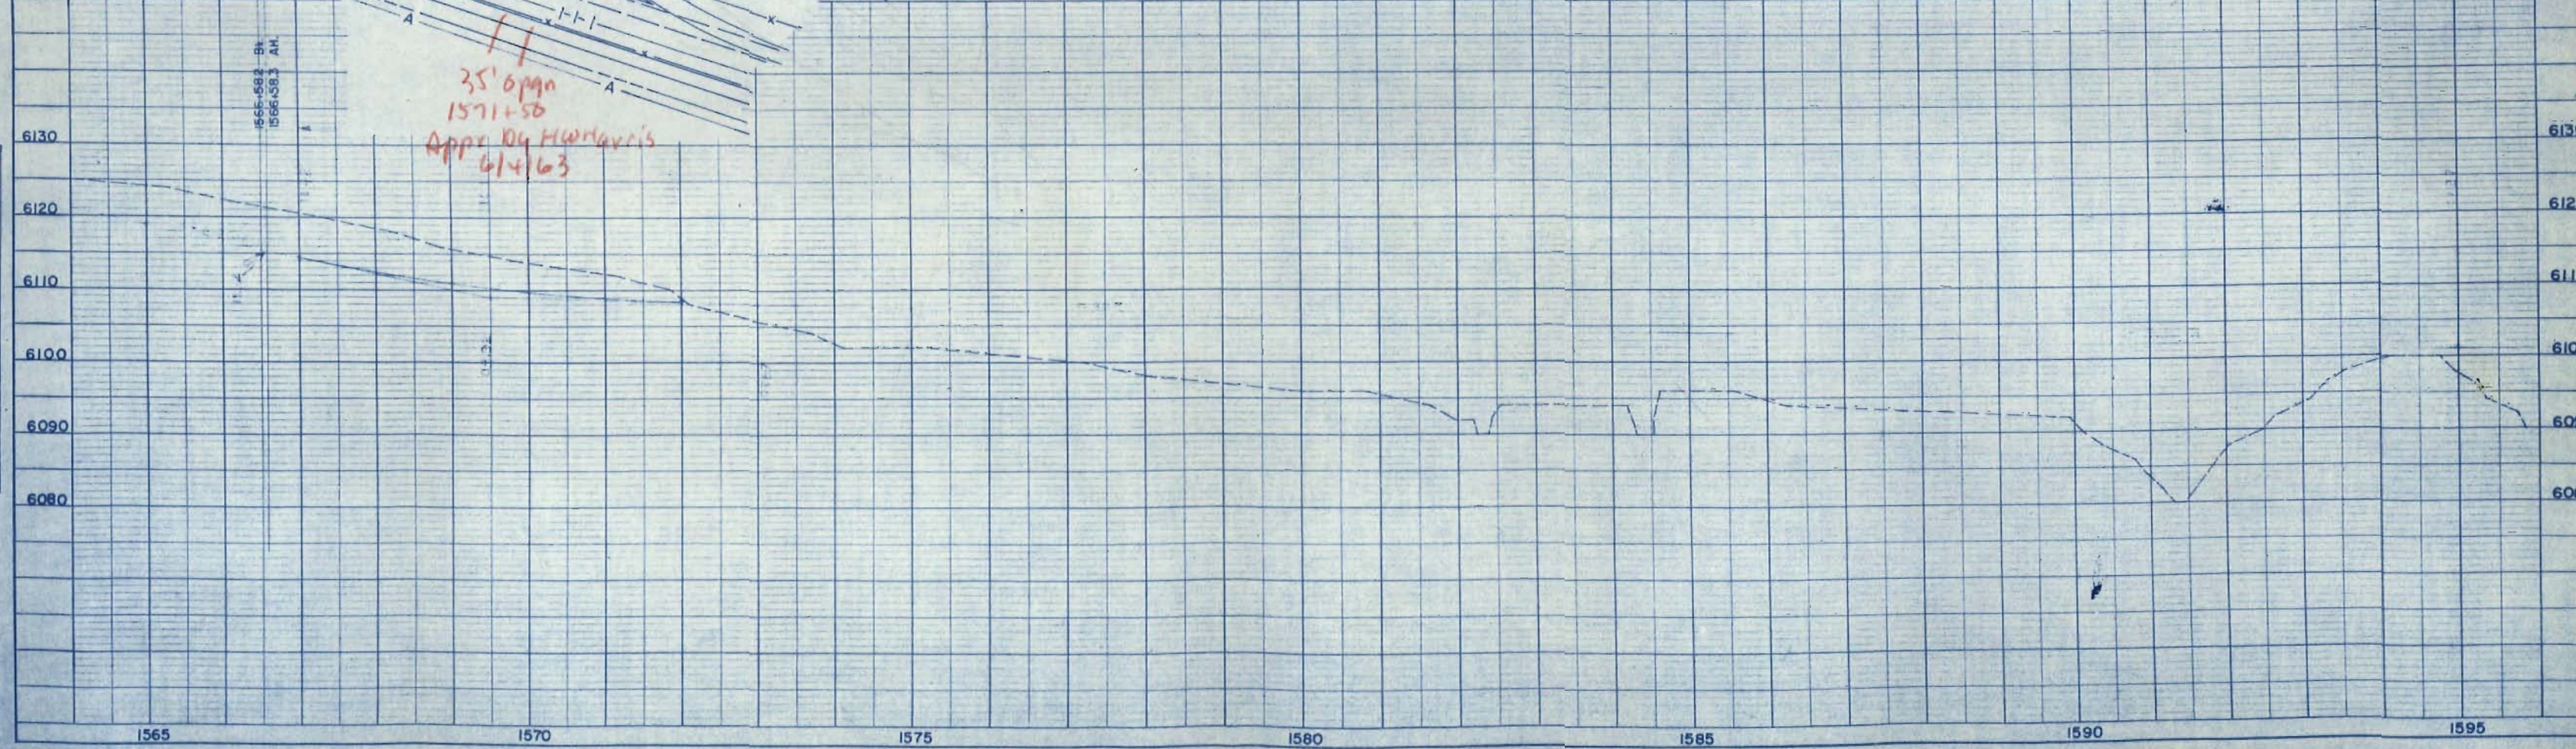

FEDERAL ROAD DIVISION NO.	DISTRICT	PROJ. NO.	SHEET NO.	TOTAL SHEETS
9	COLORADO	1-092-3(2)	6	
		I 25-1(9)48	Revisions	
		NE 1/4 SEC. 33 T. 27 S., R. 66 W.	4-1-59 Owner on I, E-1'S & 4	JLS
			5-26-59 Access Control	DWB

RIGHT OF WAY

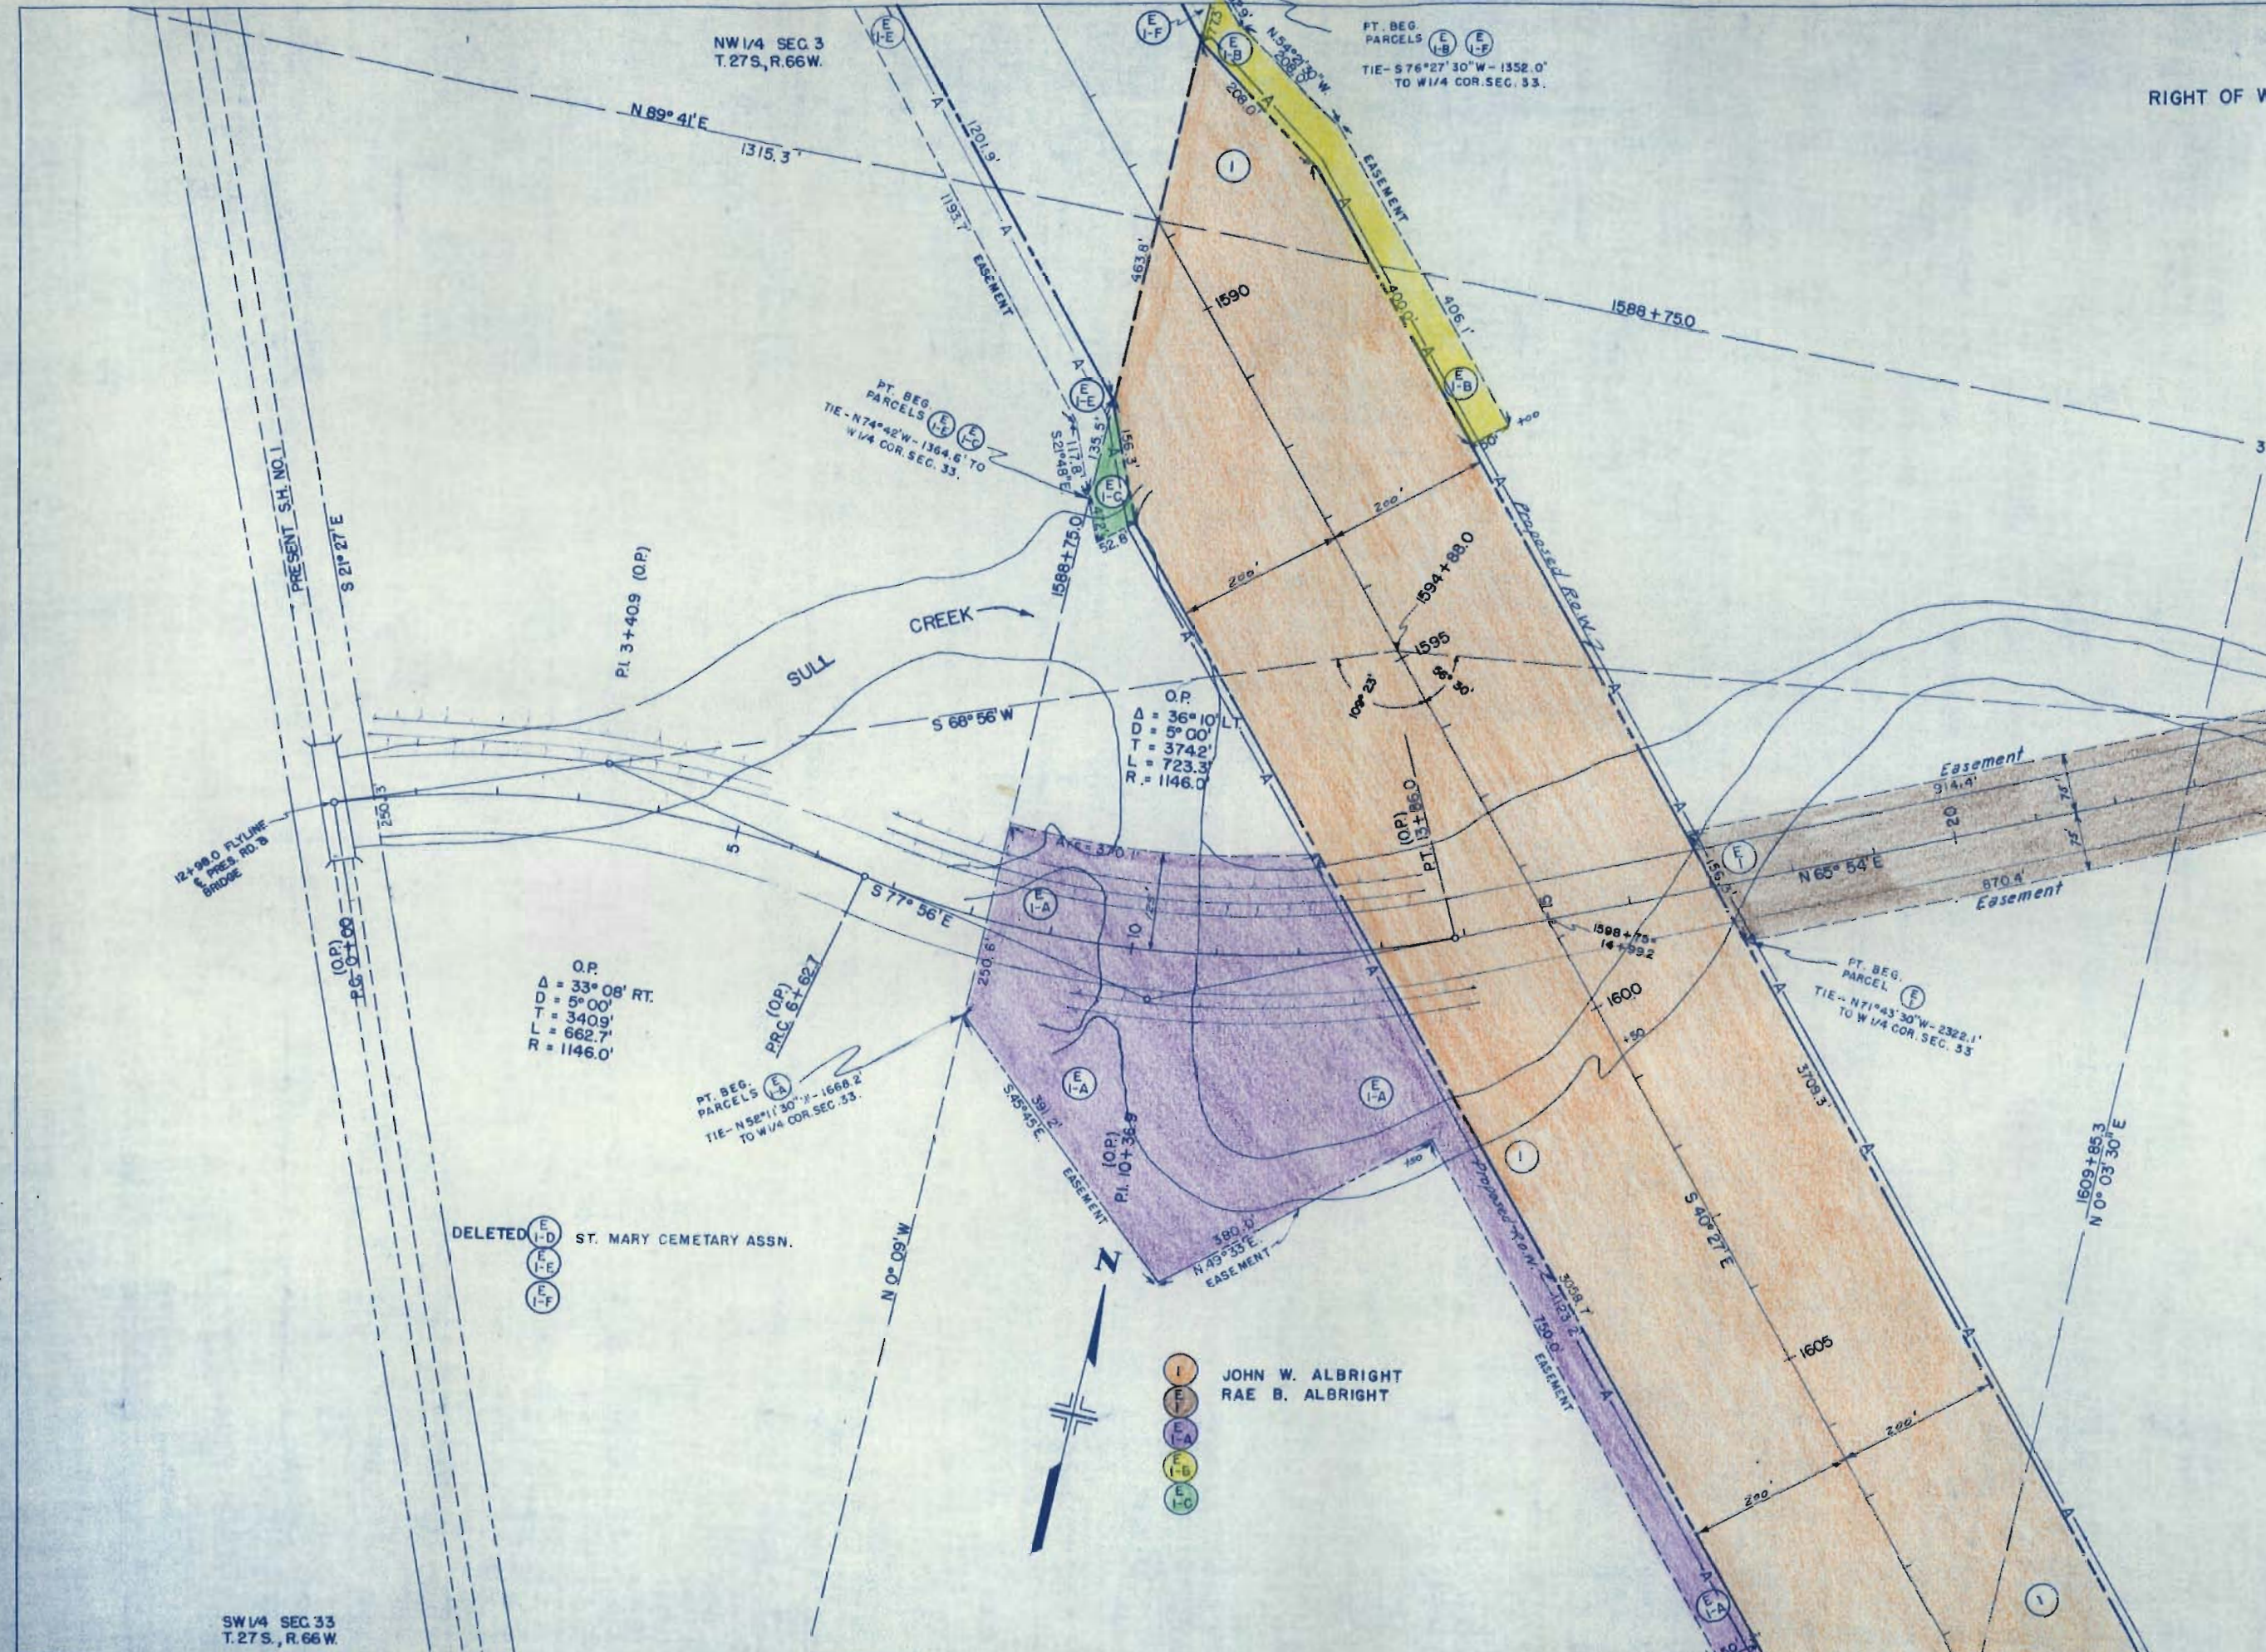


SW 1/4 SEC. 33
T. 27 S., R. 66 W.

SE 1/4 SEC. 33
T. 27 S., R. 66 W.

NOTE: BOOK GRADES CHECKED
NO. 1000
ST. 1000

NOTE: BOOK GRADES CHECKED
NO. 1000
ST. 1000

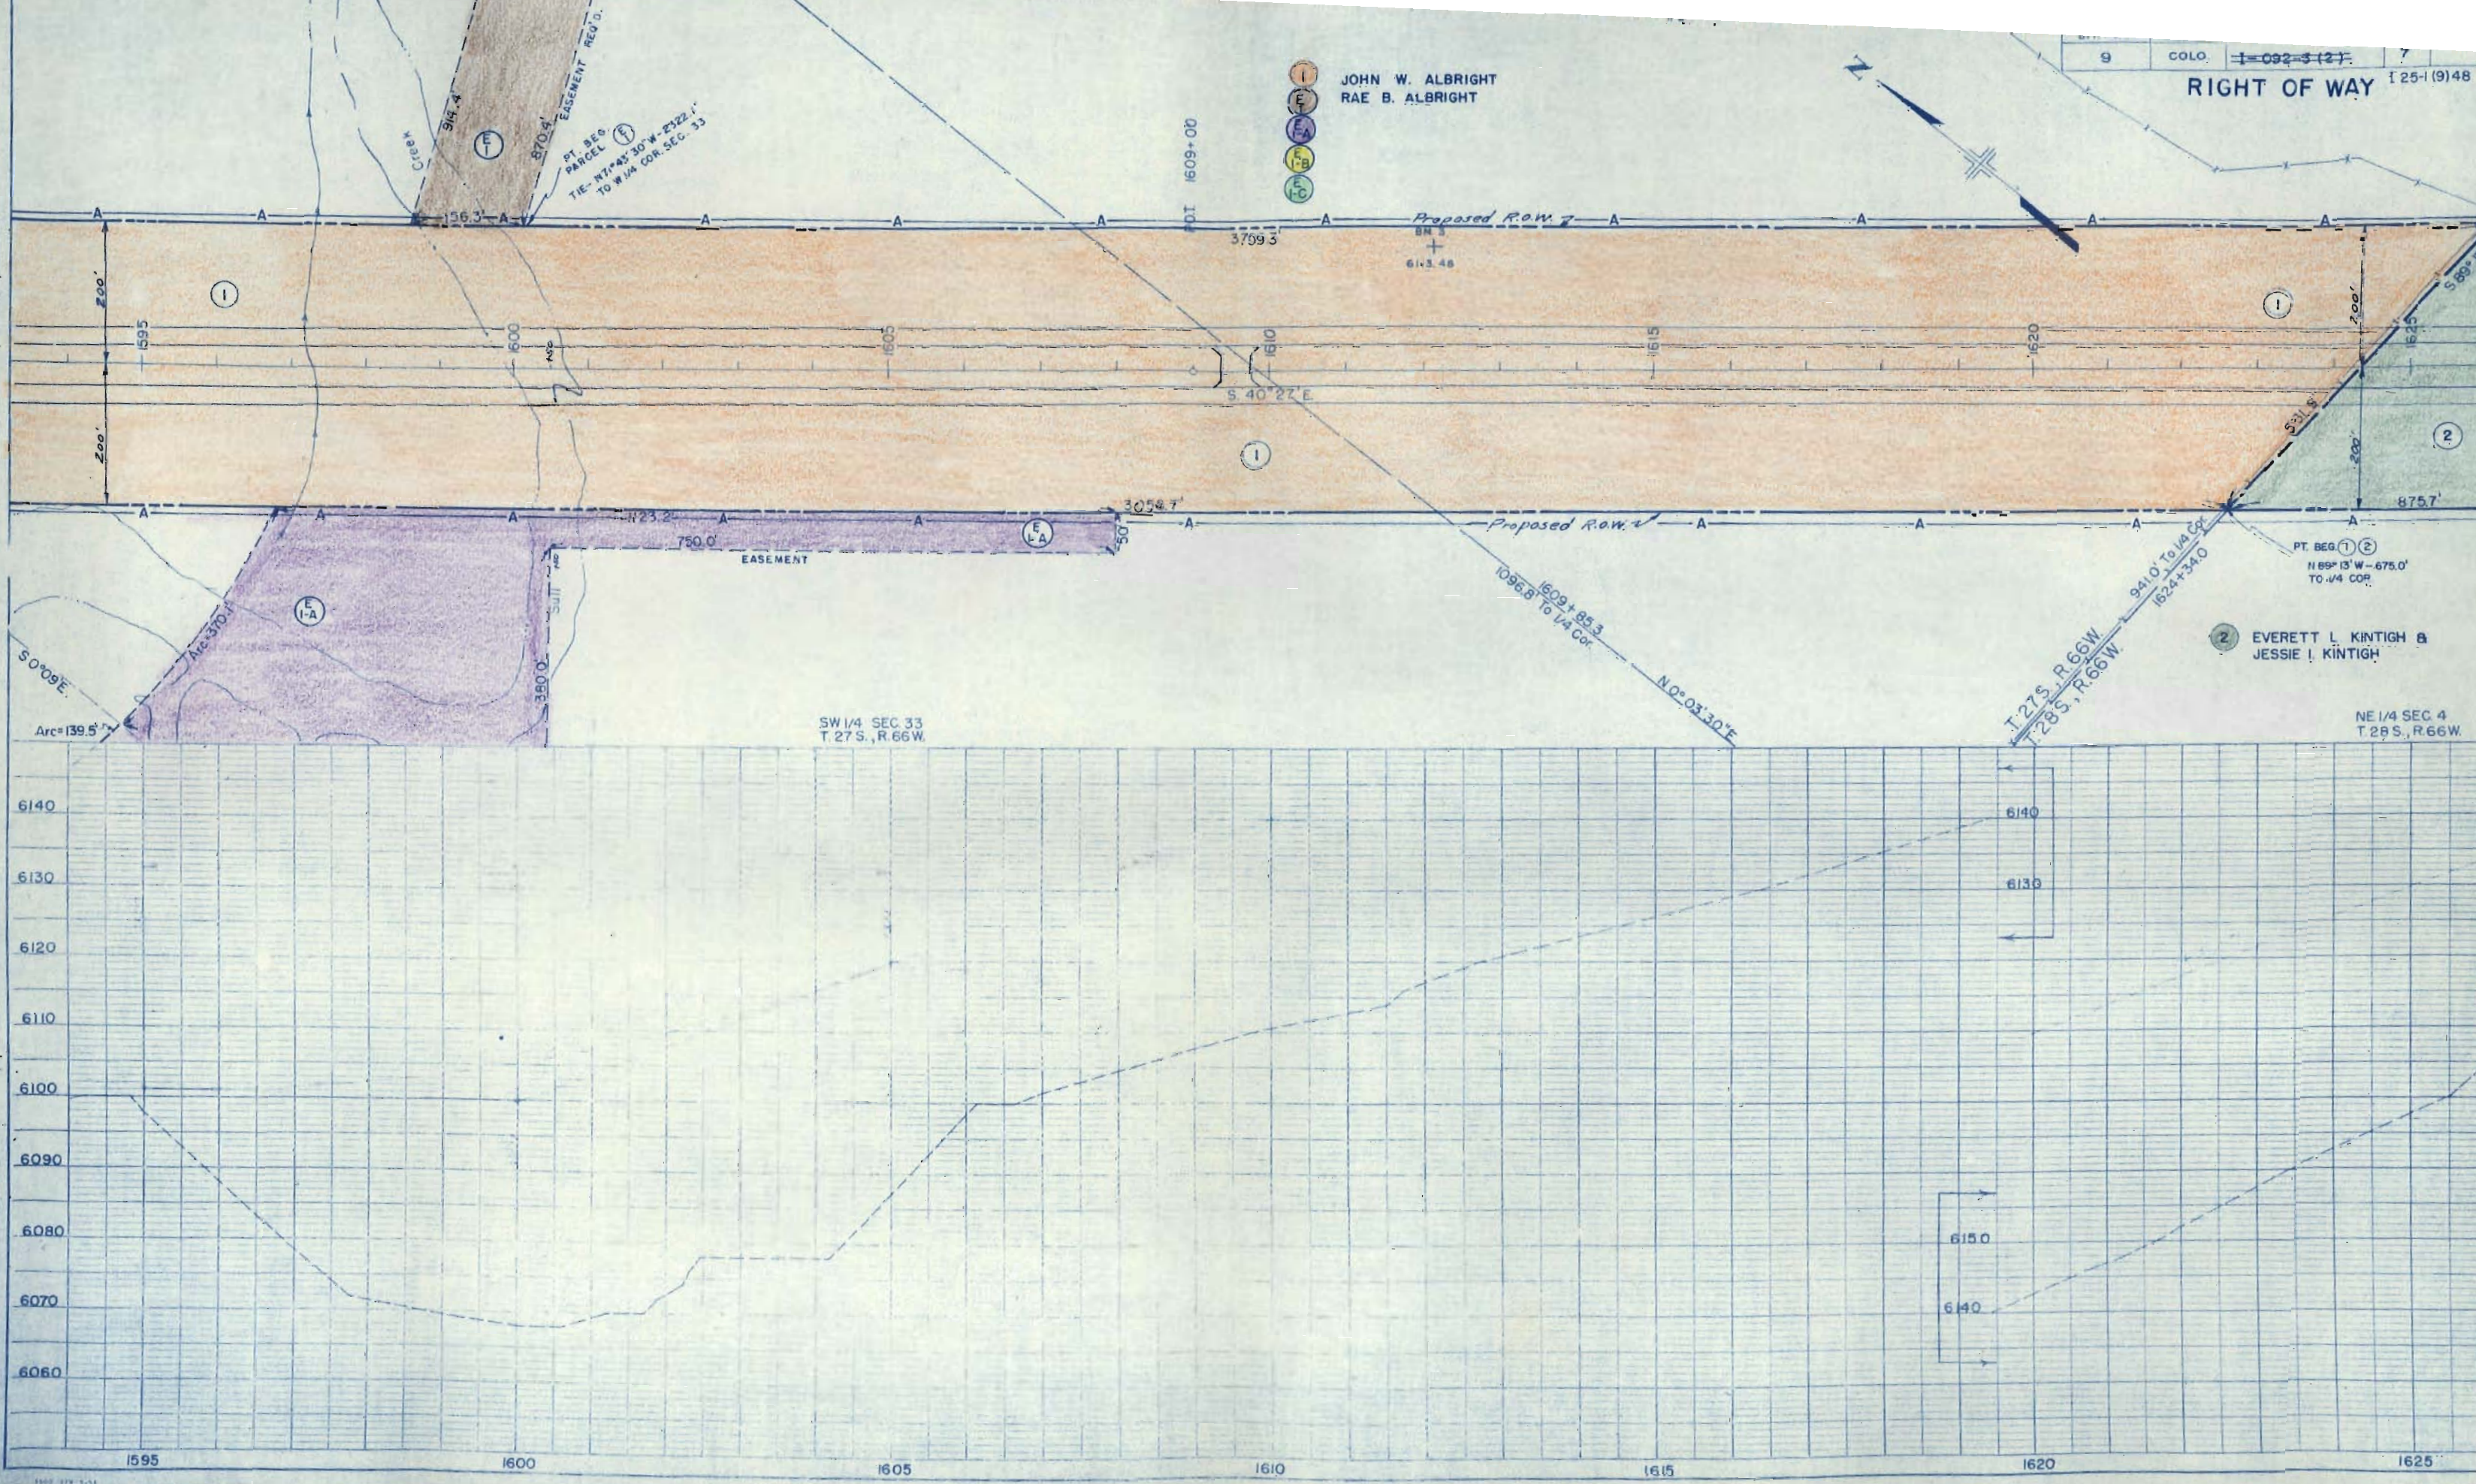

JOHN W. ALBRIGHT
RAE B. ALBRIGHT

Note: Parcel No. 3A Refer Sheet # 8A

BEN D. MARCHIORI &
JOSEPHINE MARCHIORI

Deleted
E 3
3A

E 3 Deleted


JOHN W. ALBRIGHT
RAE B. ALBRIGHT

NW 1/4 SEC 3
T.28S, R.66W.

Rev. 4-1-59 (Owner on 184) JLS
Rev. 5-26-59 (Access Control) DWB
Rev. 6-15-59 (Add 3A & 5A, Delet E 3) DWB
Rev. 6-23-59 (Access) JLS

RIGHT OF WAY


FED. ROAD DIV. NO.	DIST.	PROJ. NO.	SHEET NO.	TOTAL SHEETS
9	COLO.	1-092-3(2)	8	

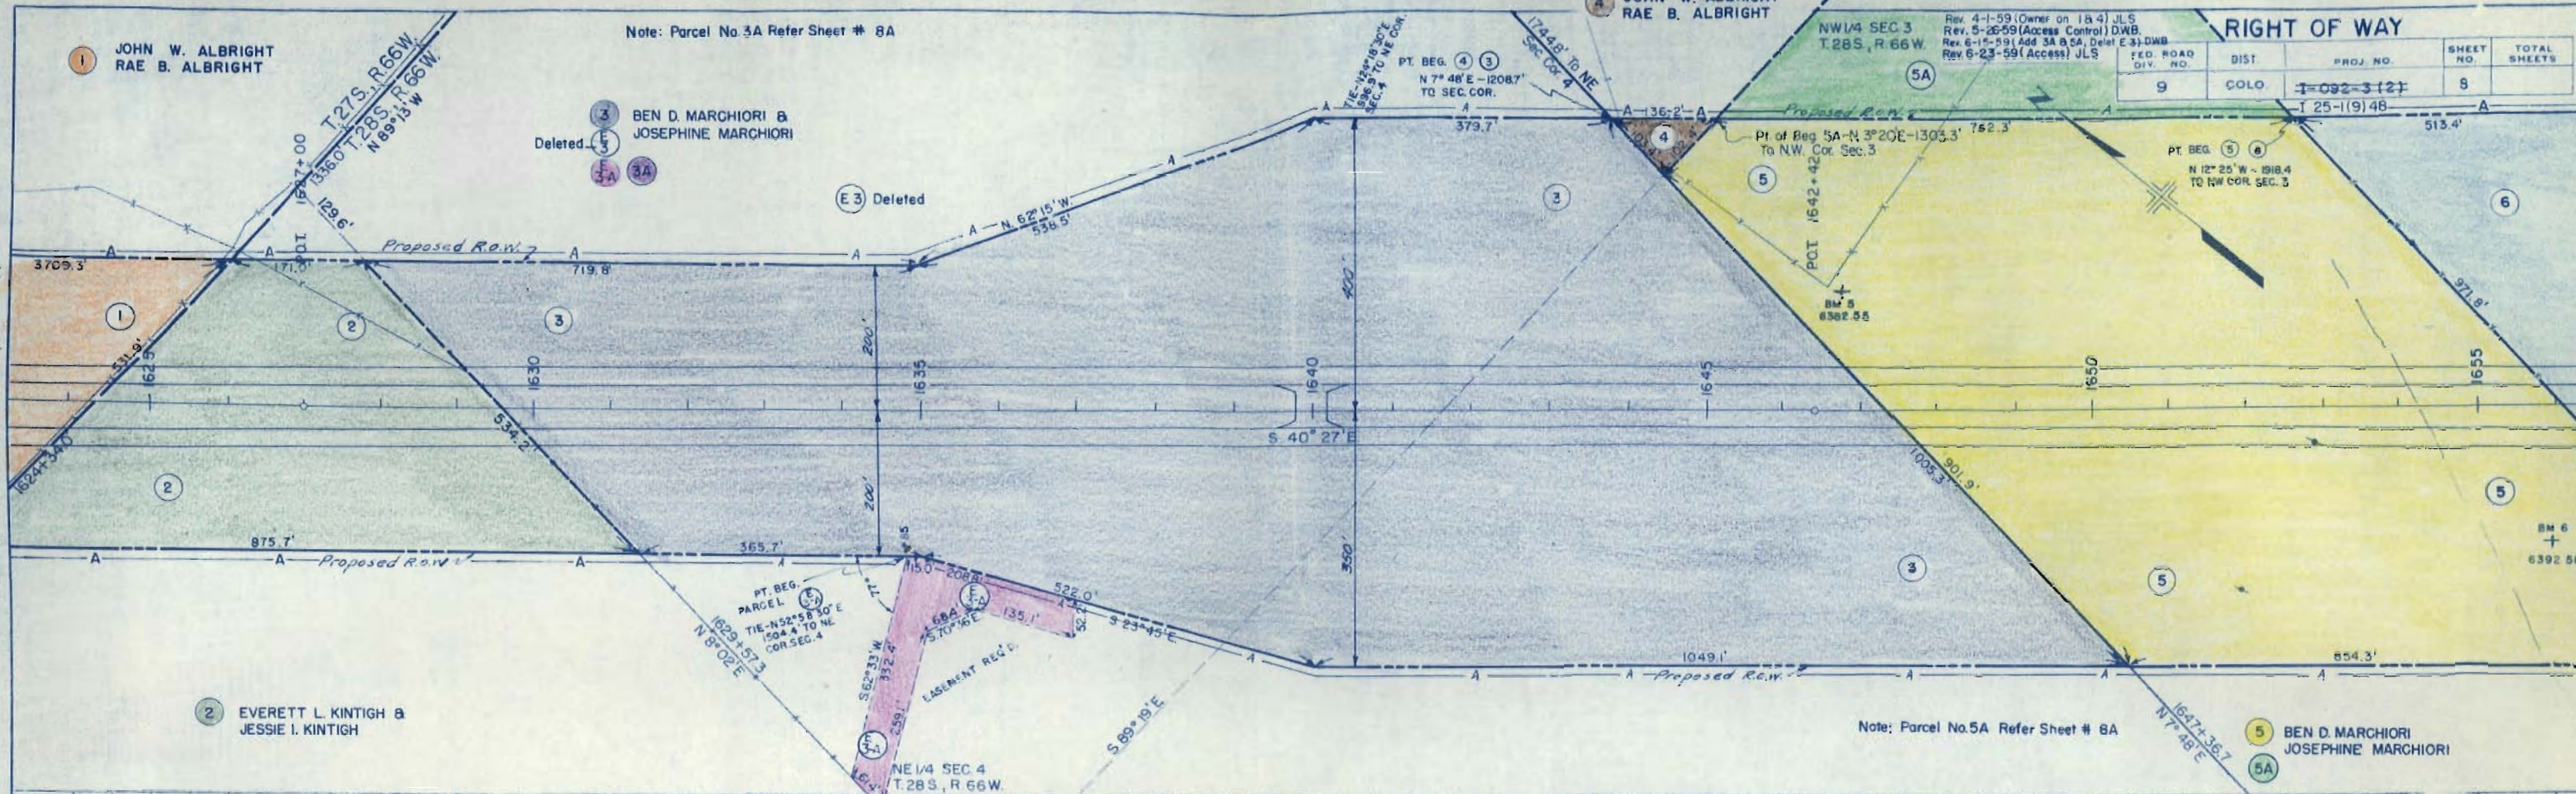

EVERETT L. KINTIGH &
JESSIE I. KINTIGH

Note: Parcel No. 5A Refer Sheet # 8A

BEN D. MARCHIORI
JOSEPHINE MARCHIORI

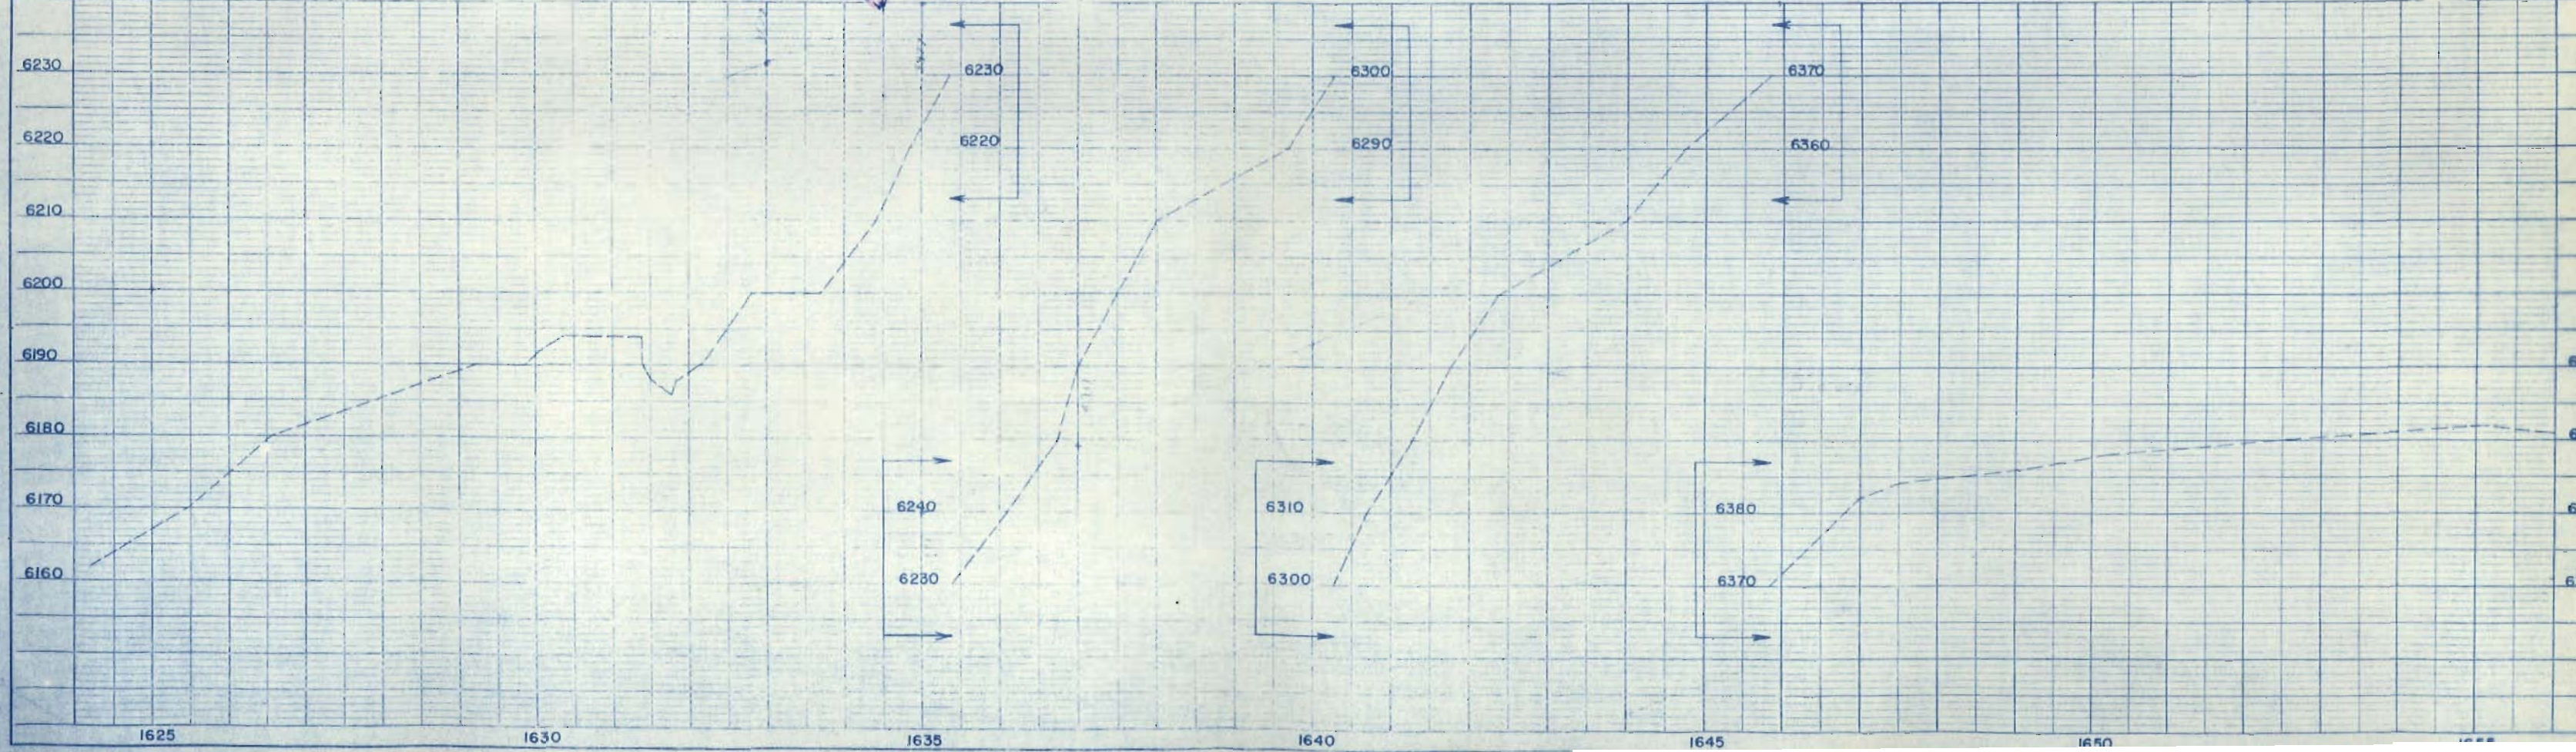

FEDERAL ROAD DISTRICT NO.	DISTRICT	PROJ. NO.	SHEET NO.	TOTAL SHEETS
9	COLORADO	1-090-3401	8A	
		125-119-48		

RIGHT OF WAY

① JOHN W. ALBRIGHT
RAE B. ALBRIGHT


③ BEN D. MARCHIORI
JOSEPHINE MARCHIORI
E-3A

④ JOHN W. ALBRIGHT
RAE B. ALBRIGHT

⑥ HANNAH UGOLINI, FLORENCE BERNADINI
UGOLINI, EDWARD UGOLINI & CARLENE
FRANCES UGOLINI, HEIRS AT LAW



② EVERETT L. KINTIGH
JESSIE I. KINTIGH

⑤ BEN D. MARCHIORI
JOSEPHINE MARCHIORI
5A Rev. 2

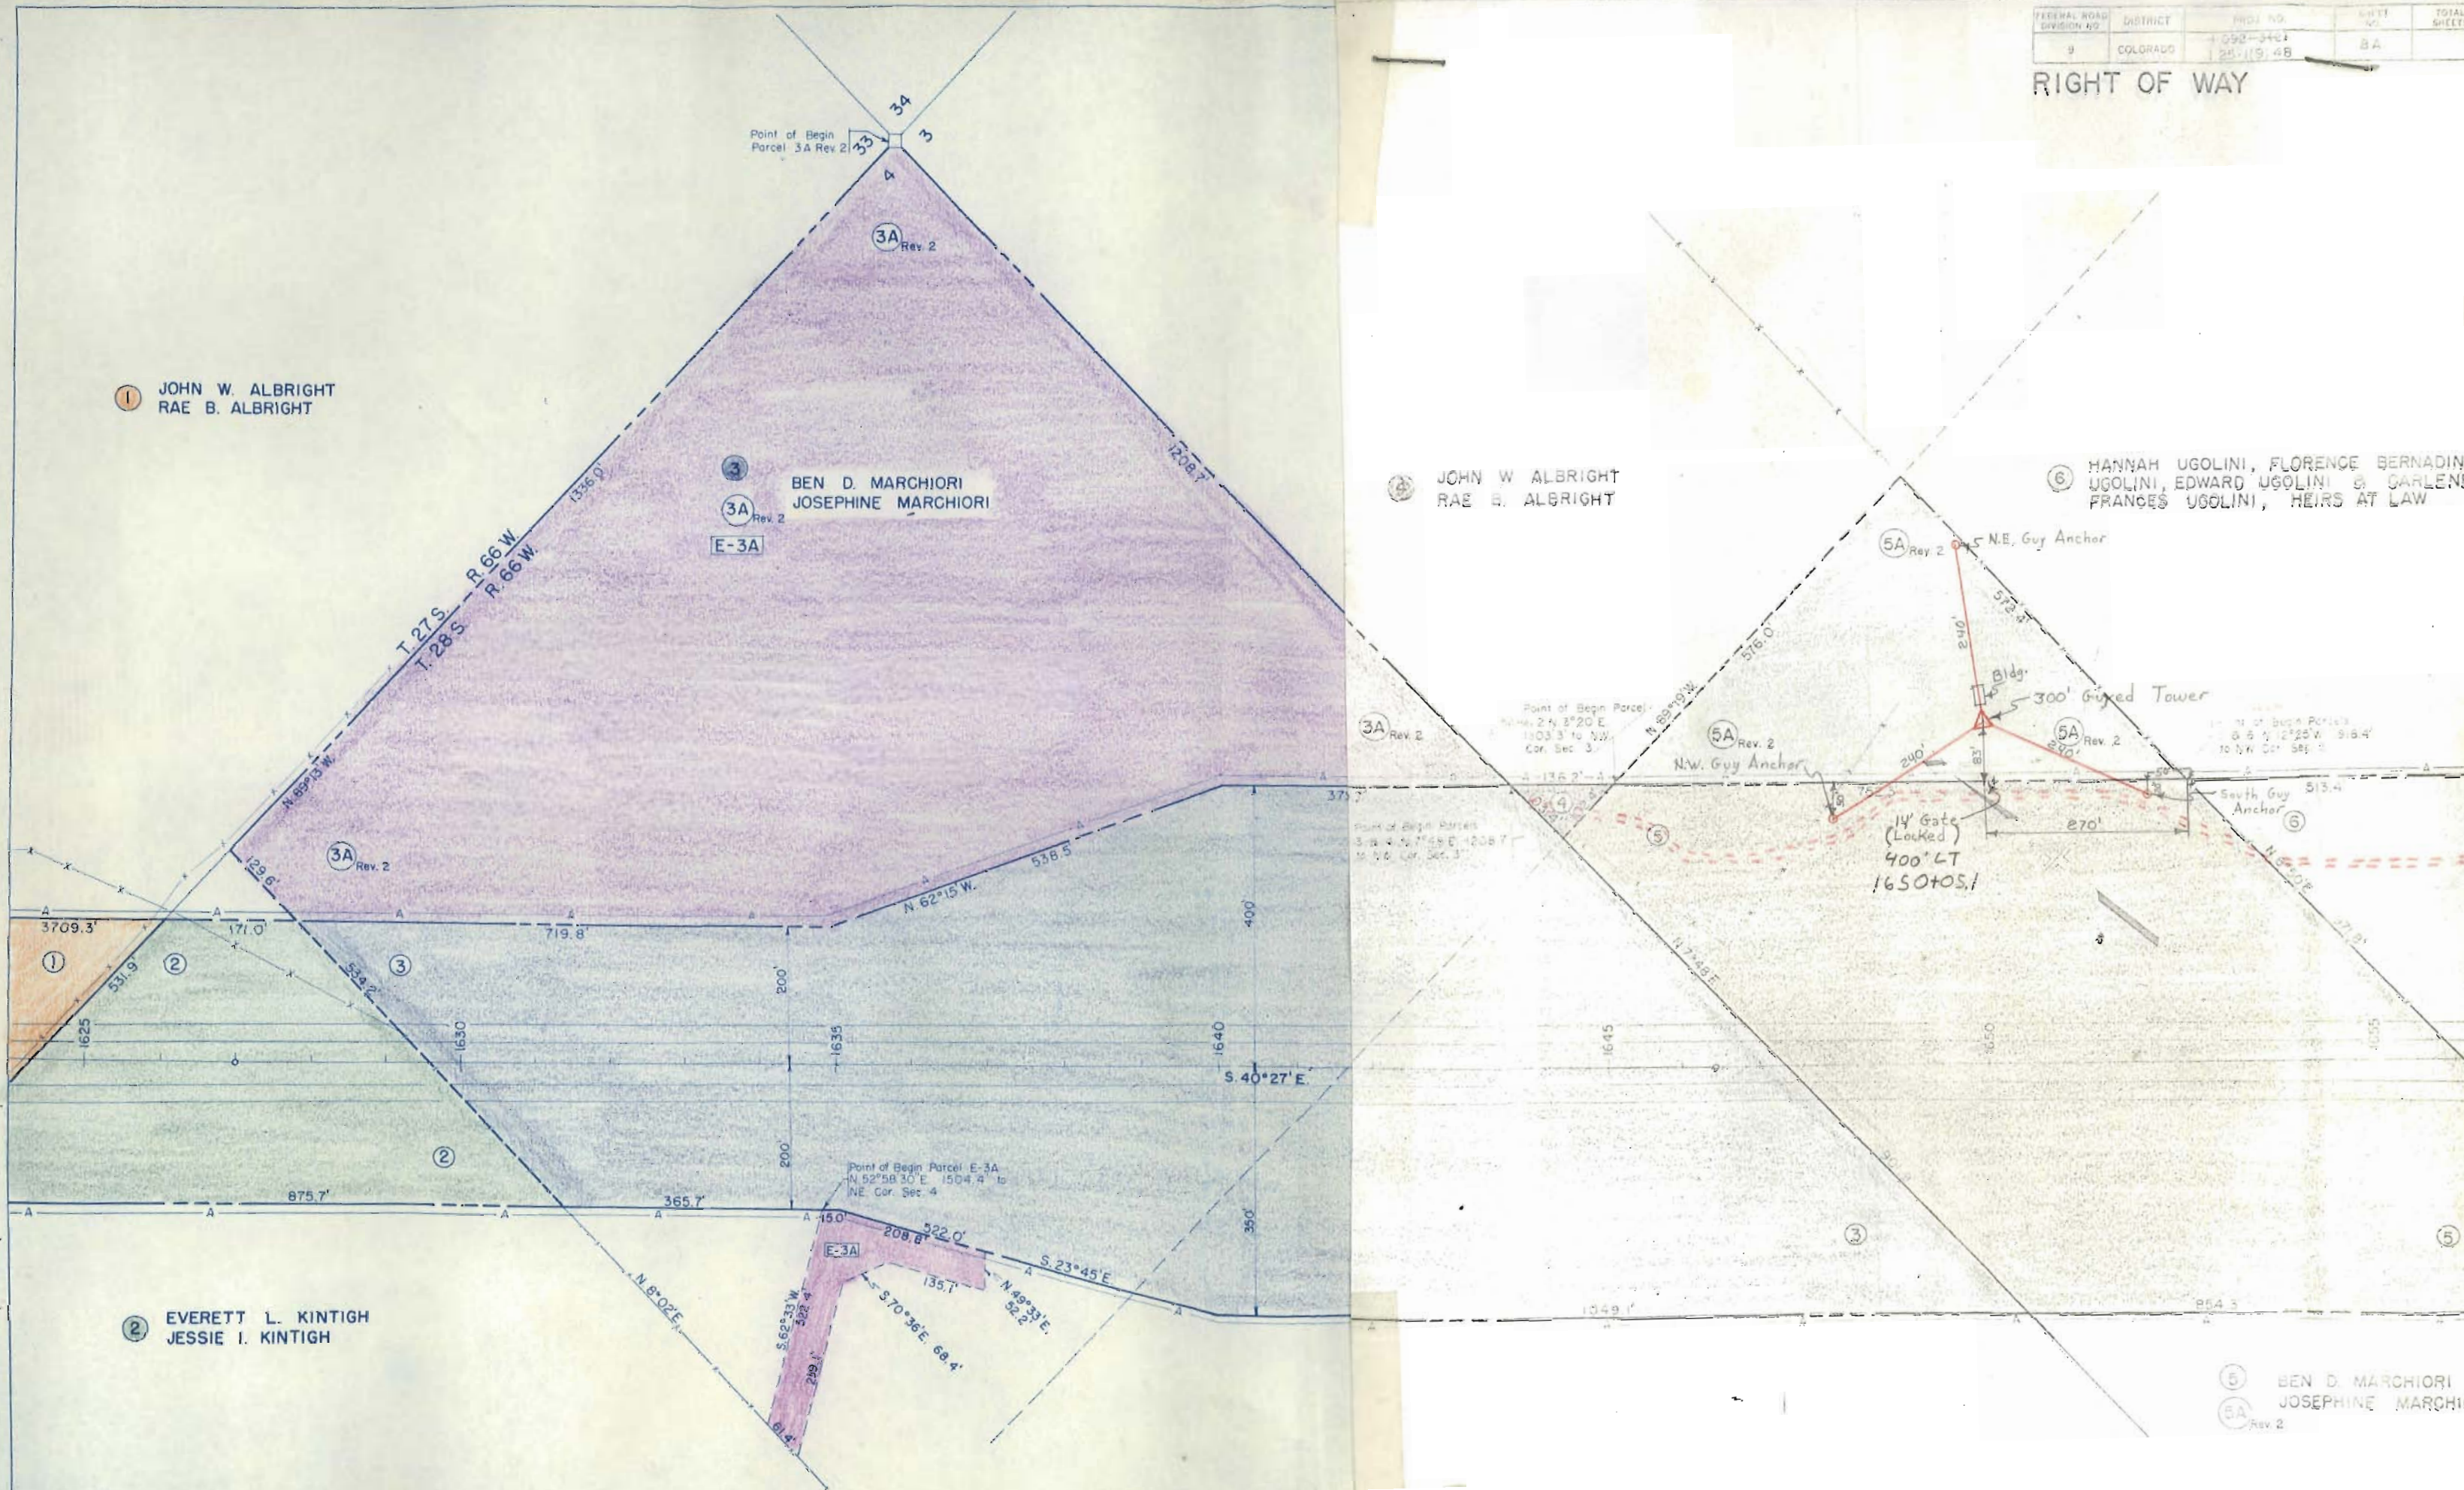


REVISIONS		
6-19-59	9 DELETED	DWB
6-23-59	ACCESS	JLS

ERII D. & R. G. W. R.R.

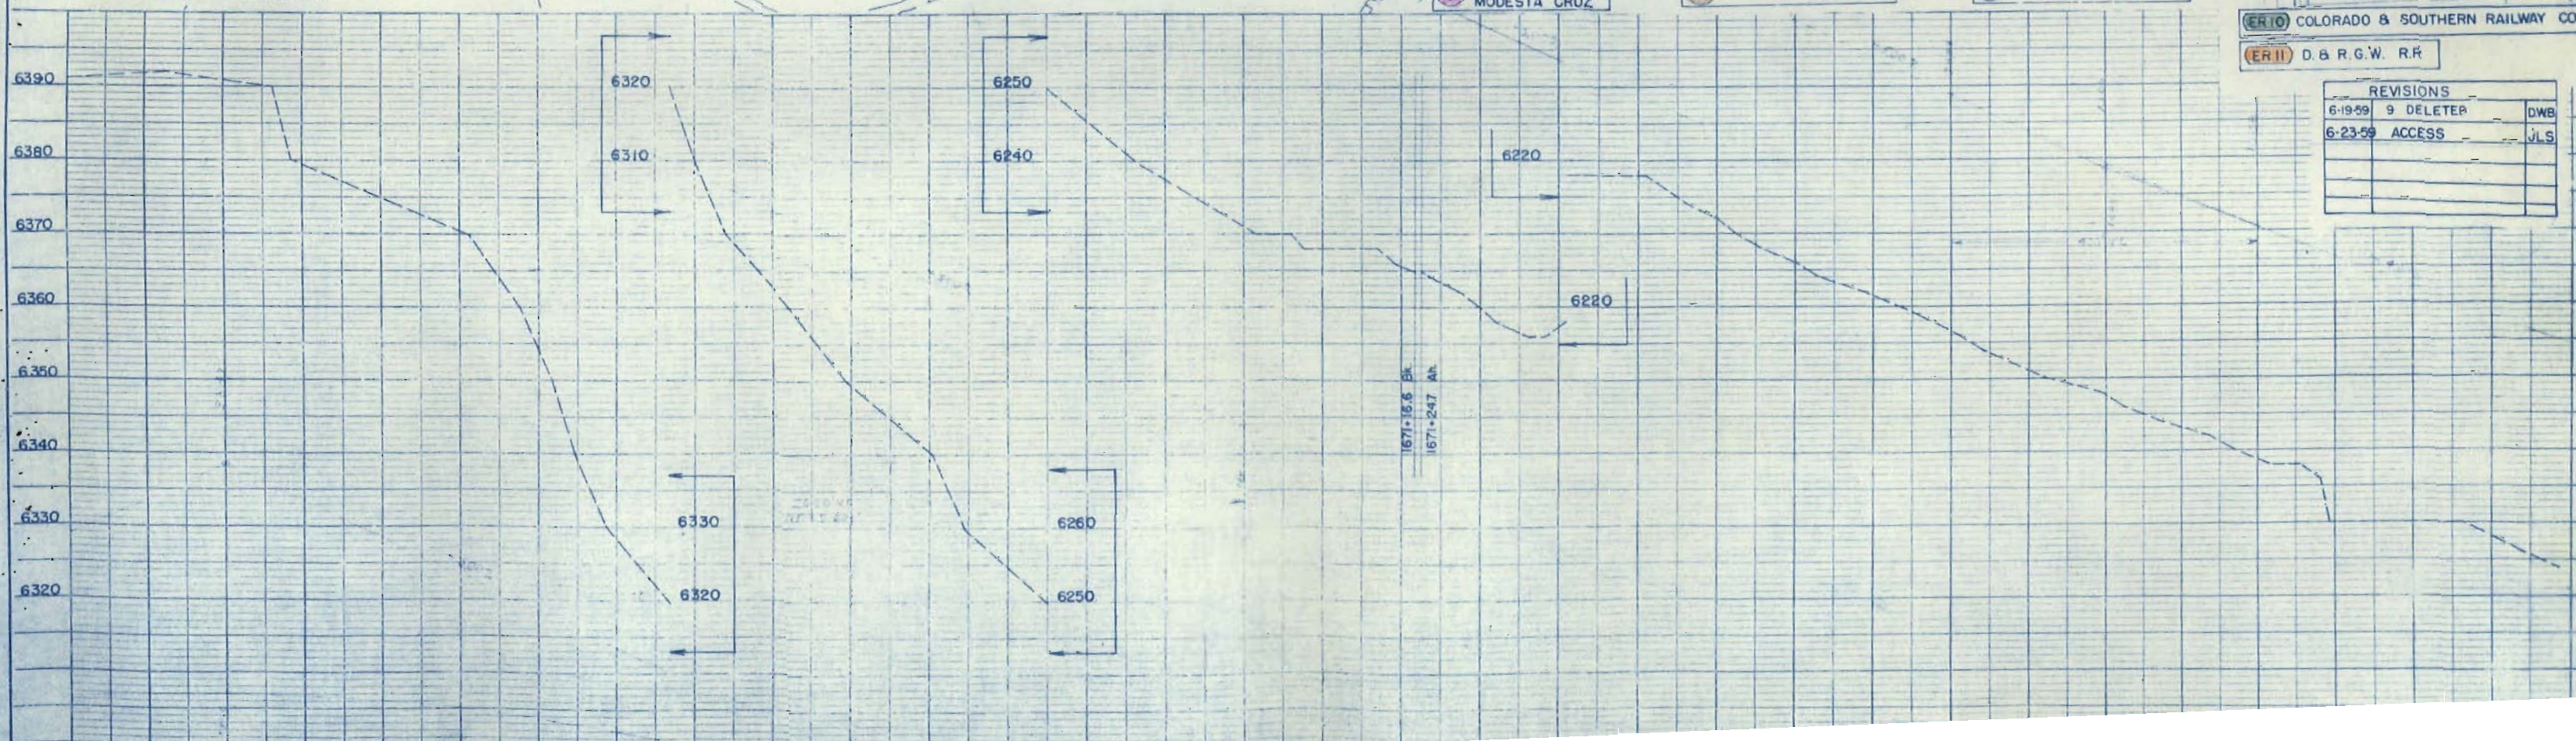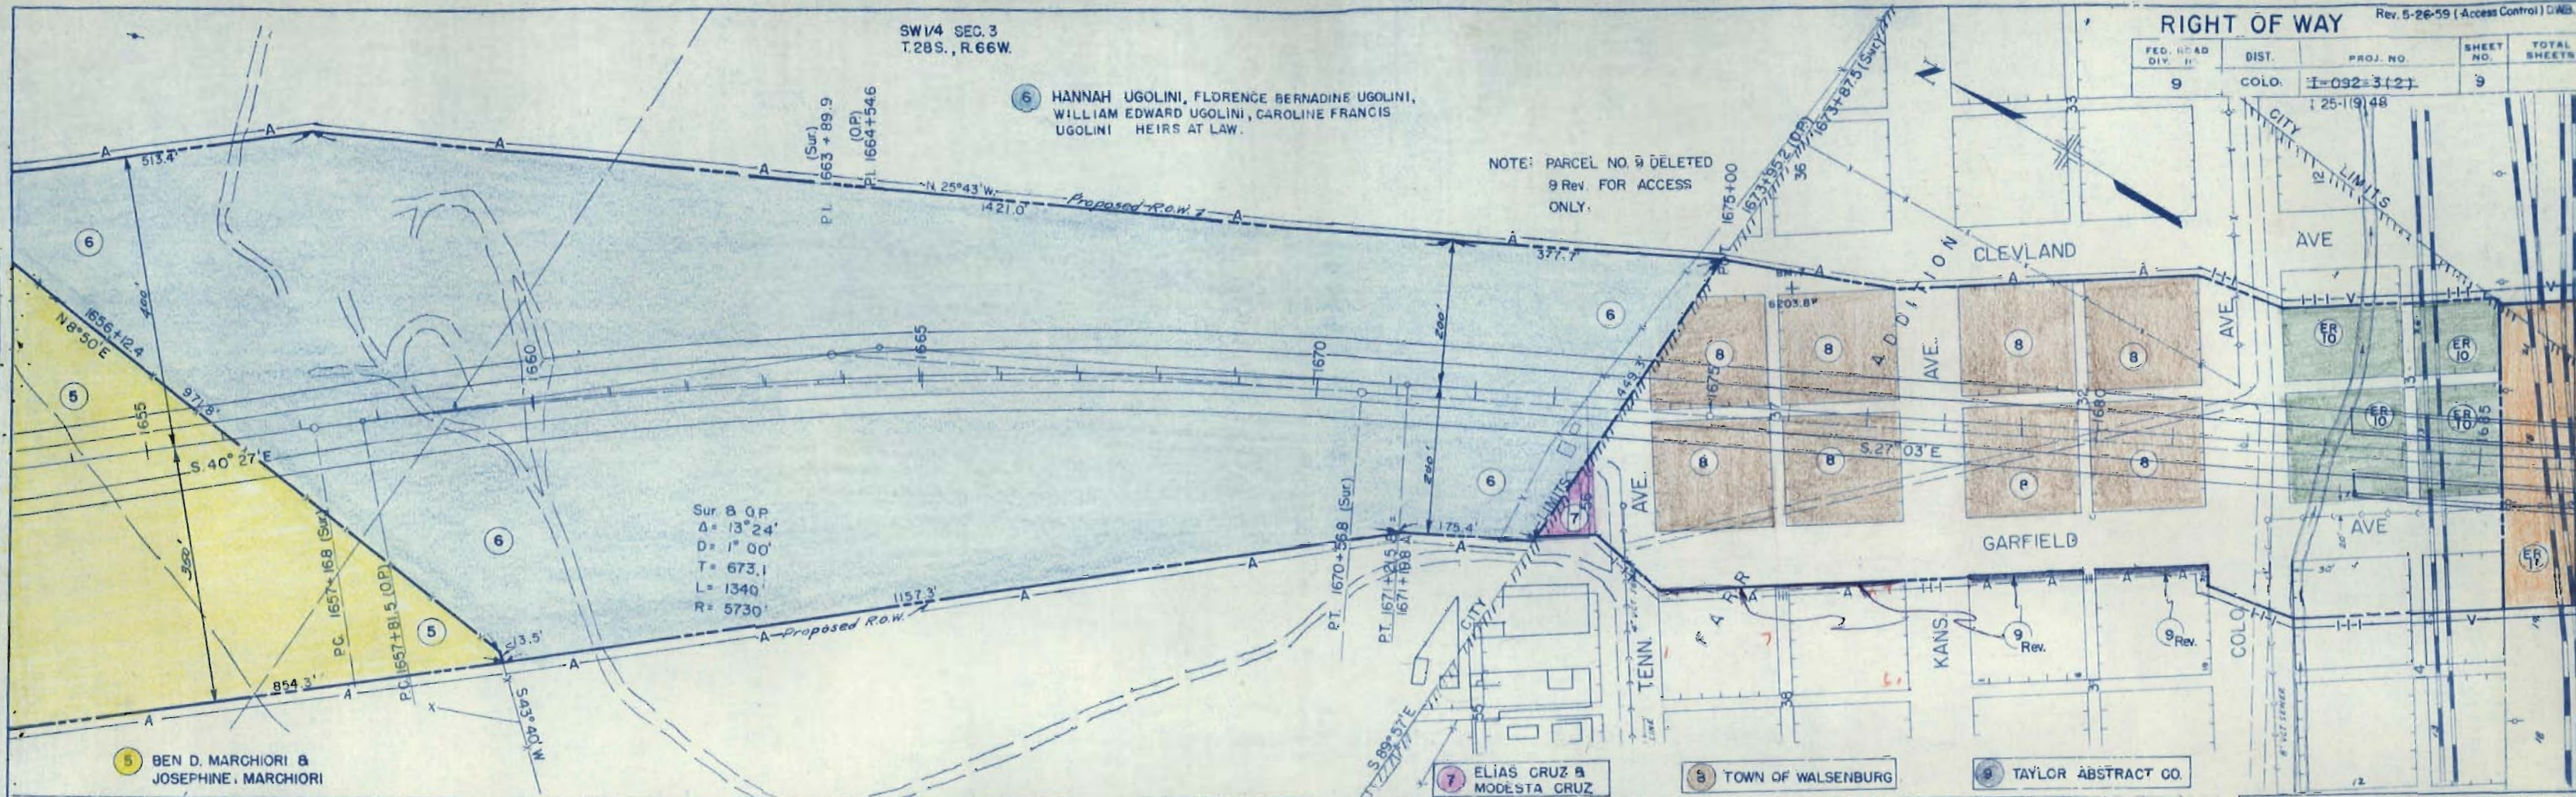

PLAN	DATE	BY
REVISED		
NOTED		
NO. OF WAY CHECKED		
NO.		

PROFILE	DATE	BY
REVISED		
NOTED		
NO. OF WAY CHECKED		
NO.		

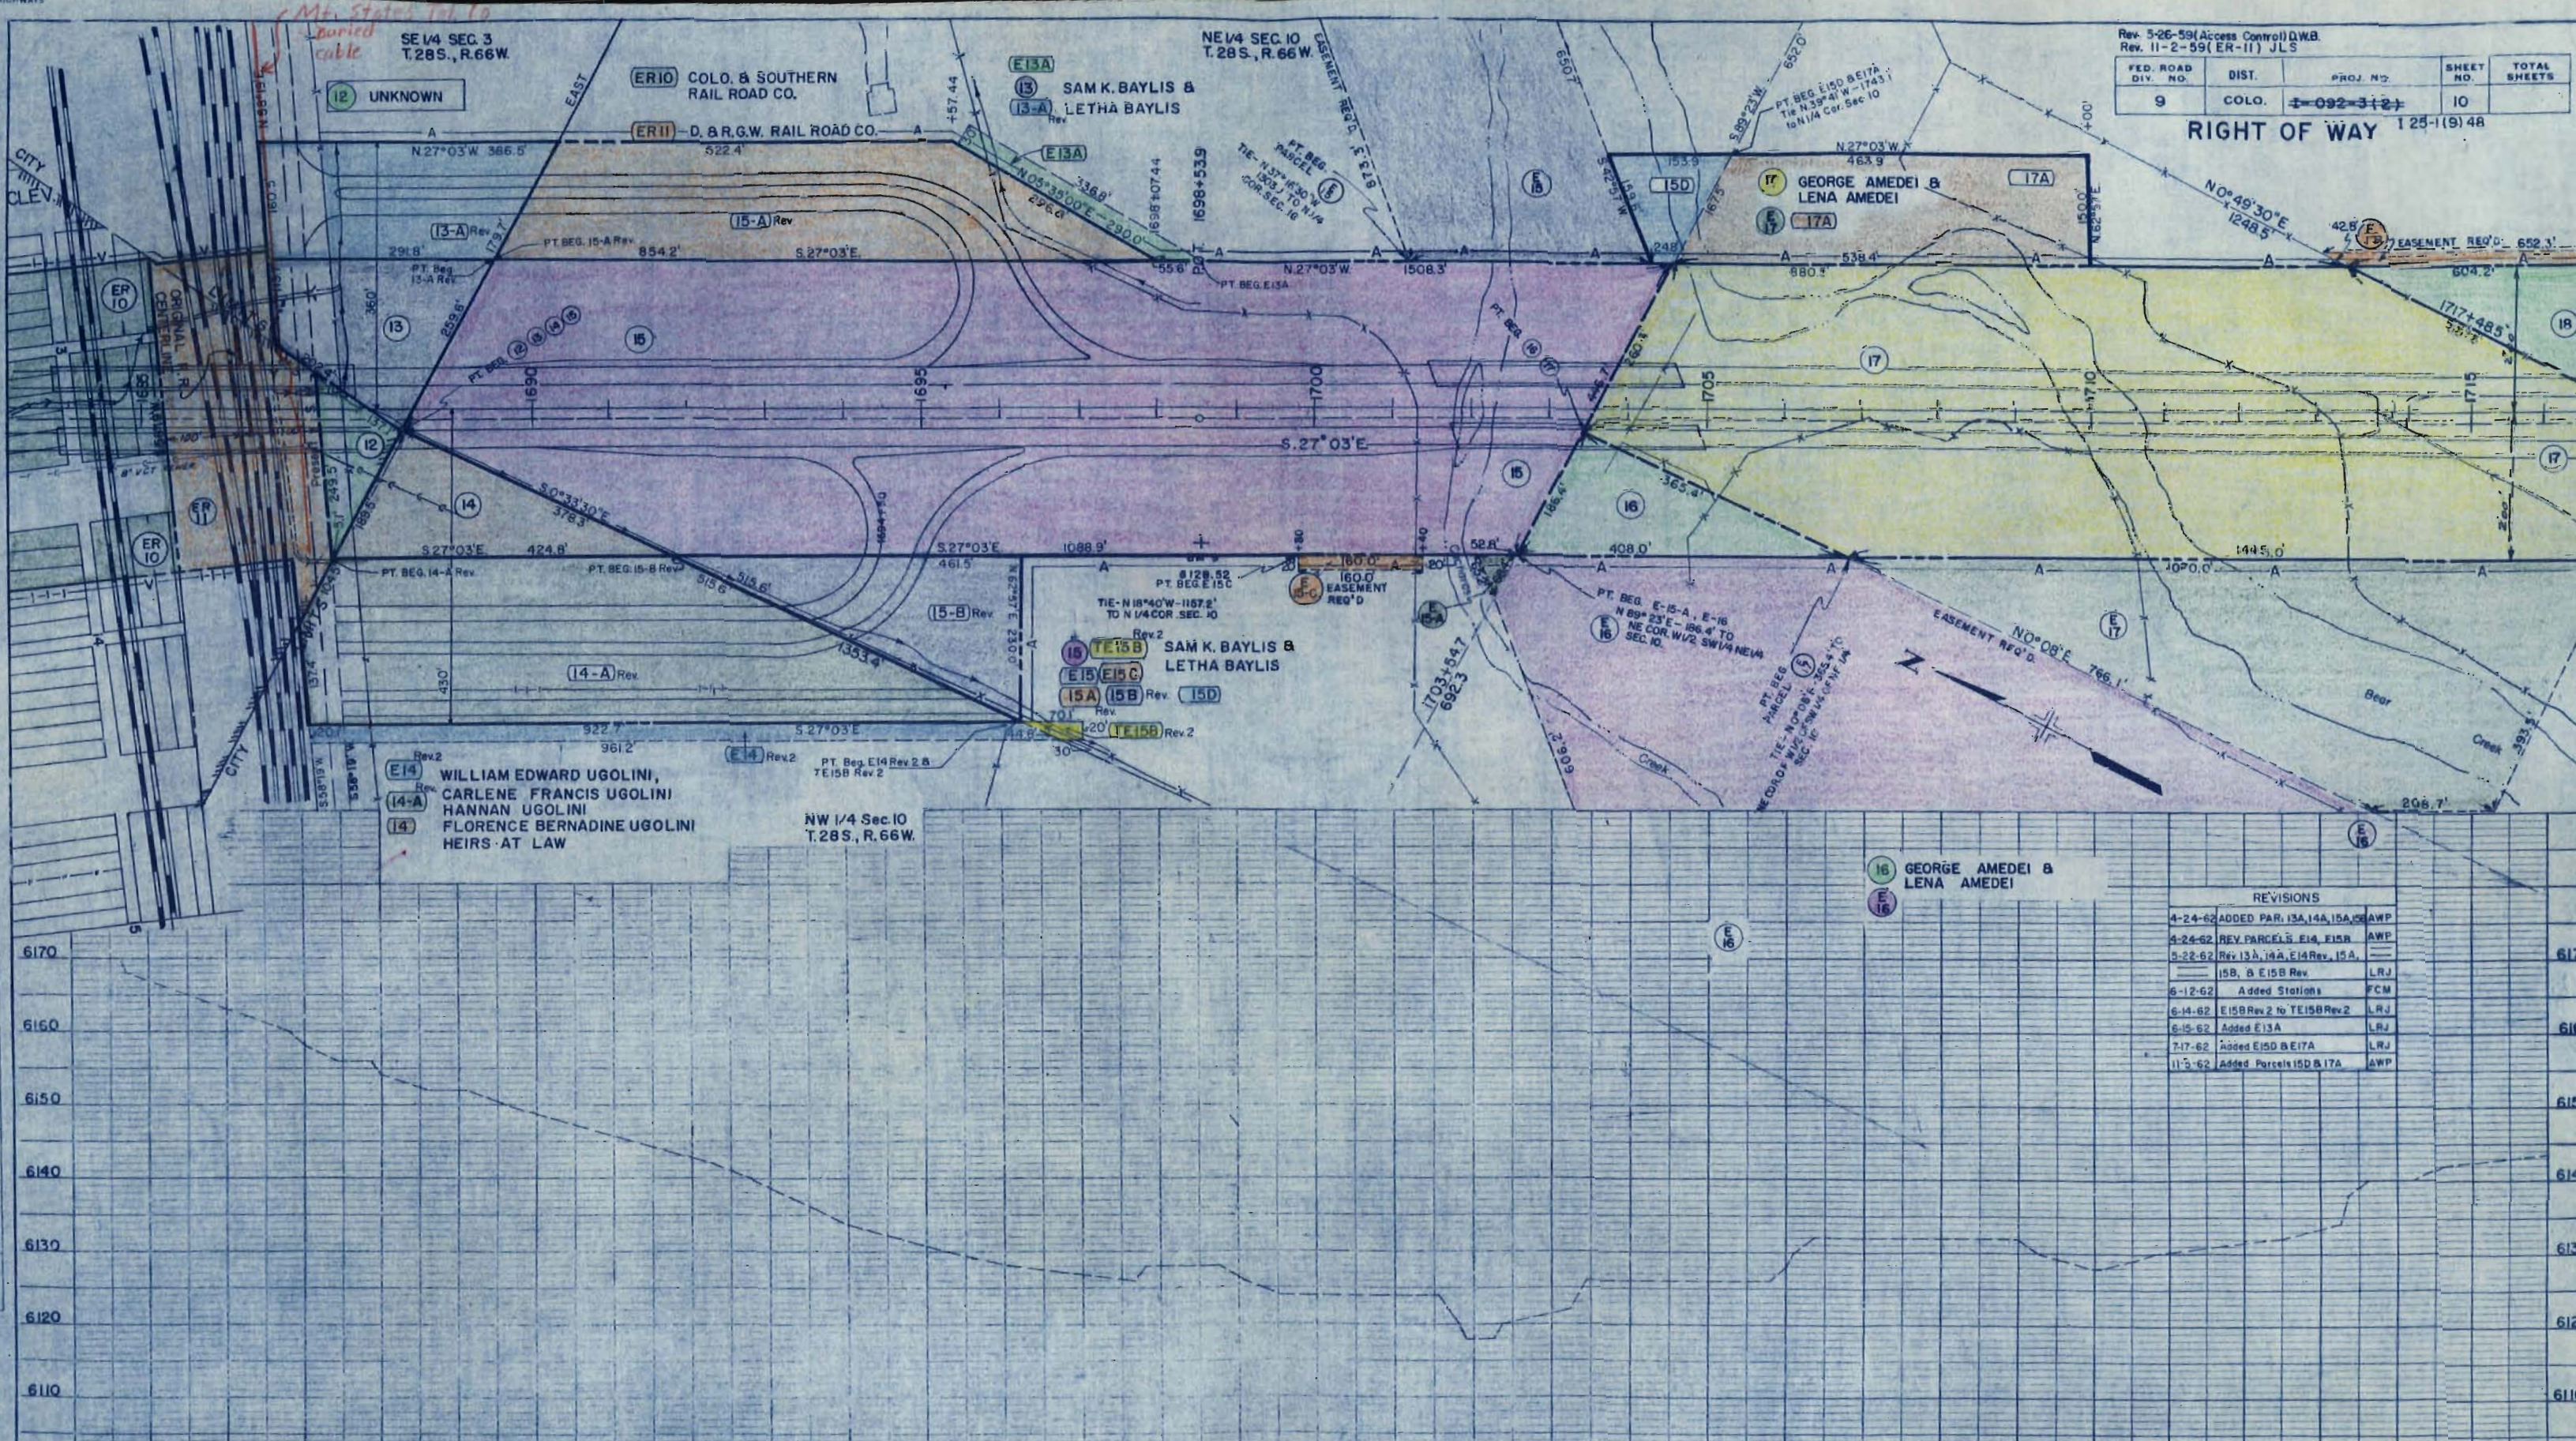


NW 1/4 SEC. 10
T.28S., R.66W.

NE 1/4 SEC. 10
T.28S., R.66W.

RIGHT OF WAY

125-119148

REVISIONS		
5-26-59	Access Control	DWB
7-17-62	Added E15D & E17A	LRJ
11-5-62	Added 15D & 17A	AWP

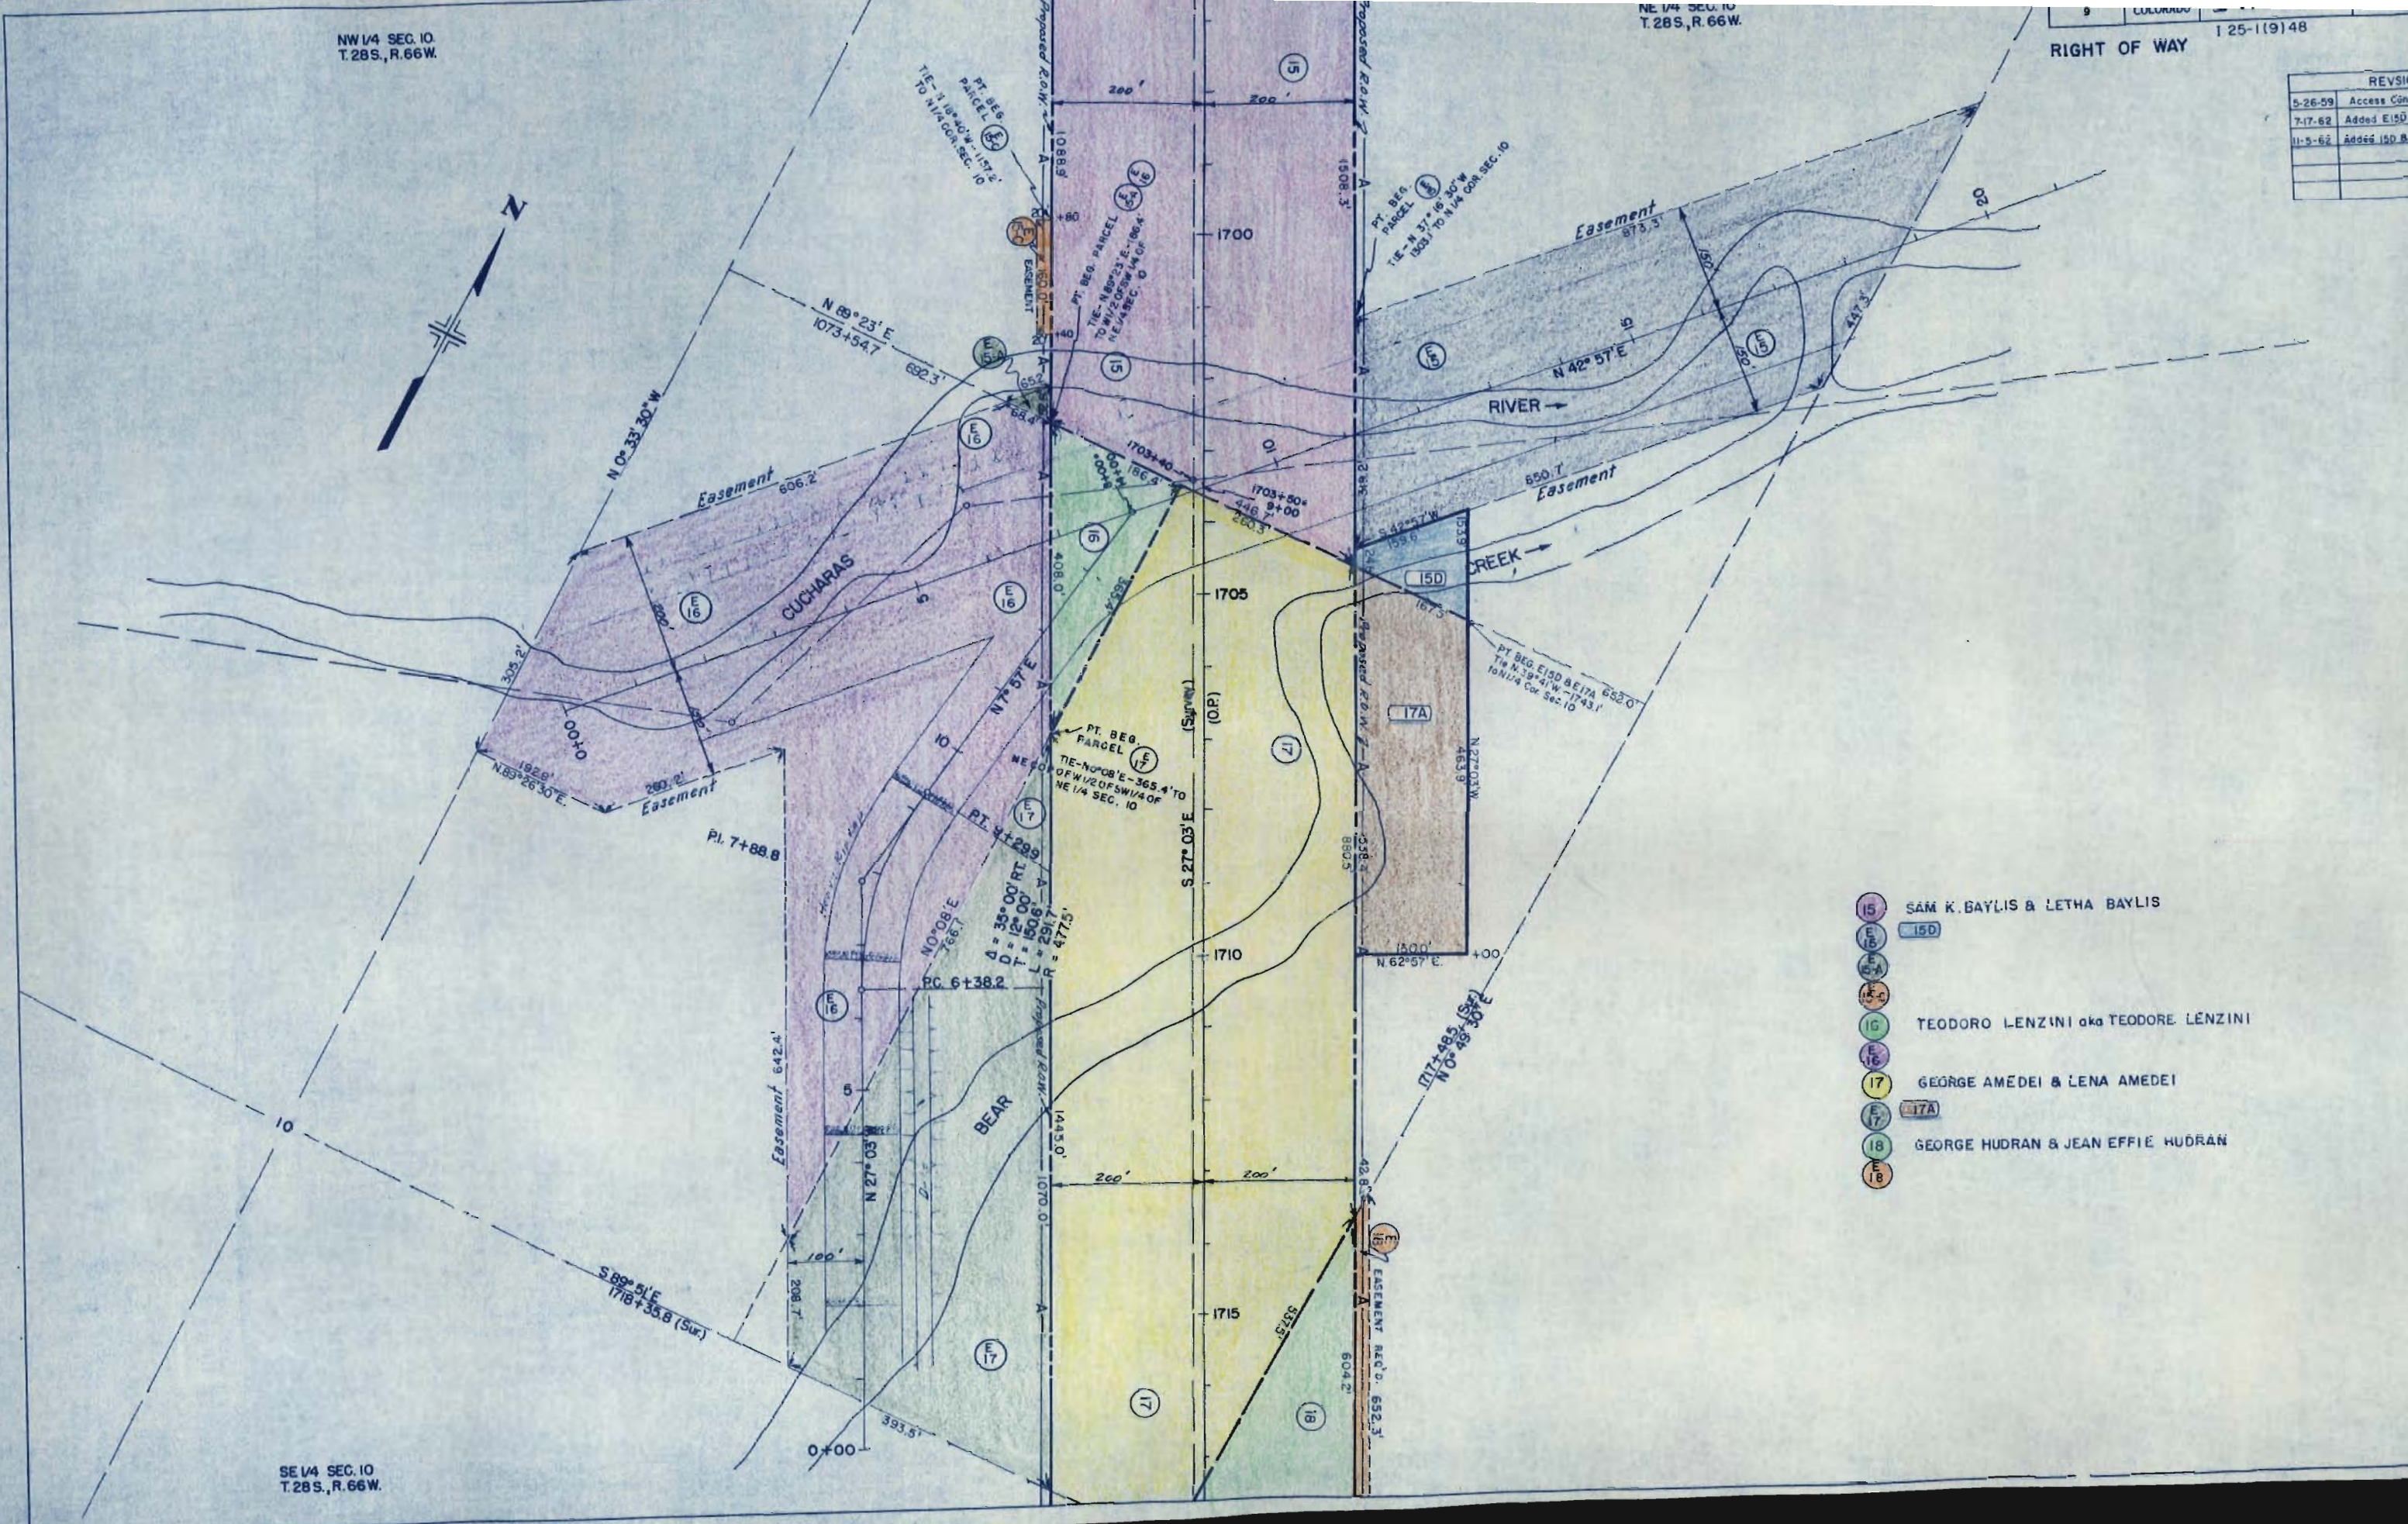

SE 1/4 SEC. 10
T.28S., R.66W.

- 15 SAM K. BAYLIS & LETHA BAYLIS
- 16 TEODORO LENZINI aka TEODORE LENZINI
- 17 GEORGE AMEDEI & LENA AMEDEI
- 18 GEORGE HUDRAN & JEAN EFFIE HUDRAN

NE 1/4 SEC. 10
T. 28S., R. 66W.

24 LA FRATERNIDAD PIADOSA DE
NUESTRO PADRE JESUS, A
LOS HERMANOS DEL CRICO.

SW 1/4 SEC. 11
T. 28S., R. 66W.

Rev. 5-26-59 (Access Control) D.W.B.

FED. ROAD DIV. NO.	DIST.	PROJ. NO.	SHEET NO.	TOTAL SHEETS
9	COLO.	1-092-3 (2)	12	125-19148



RIGHT OF WAY


1713+04.24

NOTE: BOOK ALIGNMENT CHECKED
BY: J. W. CHICK
DATE: 10/1/59

NOTE: BOOK ALIGNMENT CHECKED
BY: J. W. CHICK
DATE: 10/1/59

1713+04.24

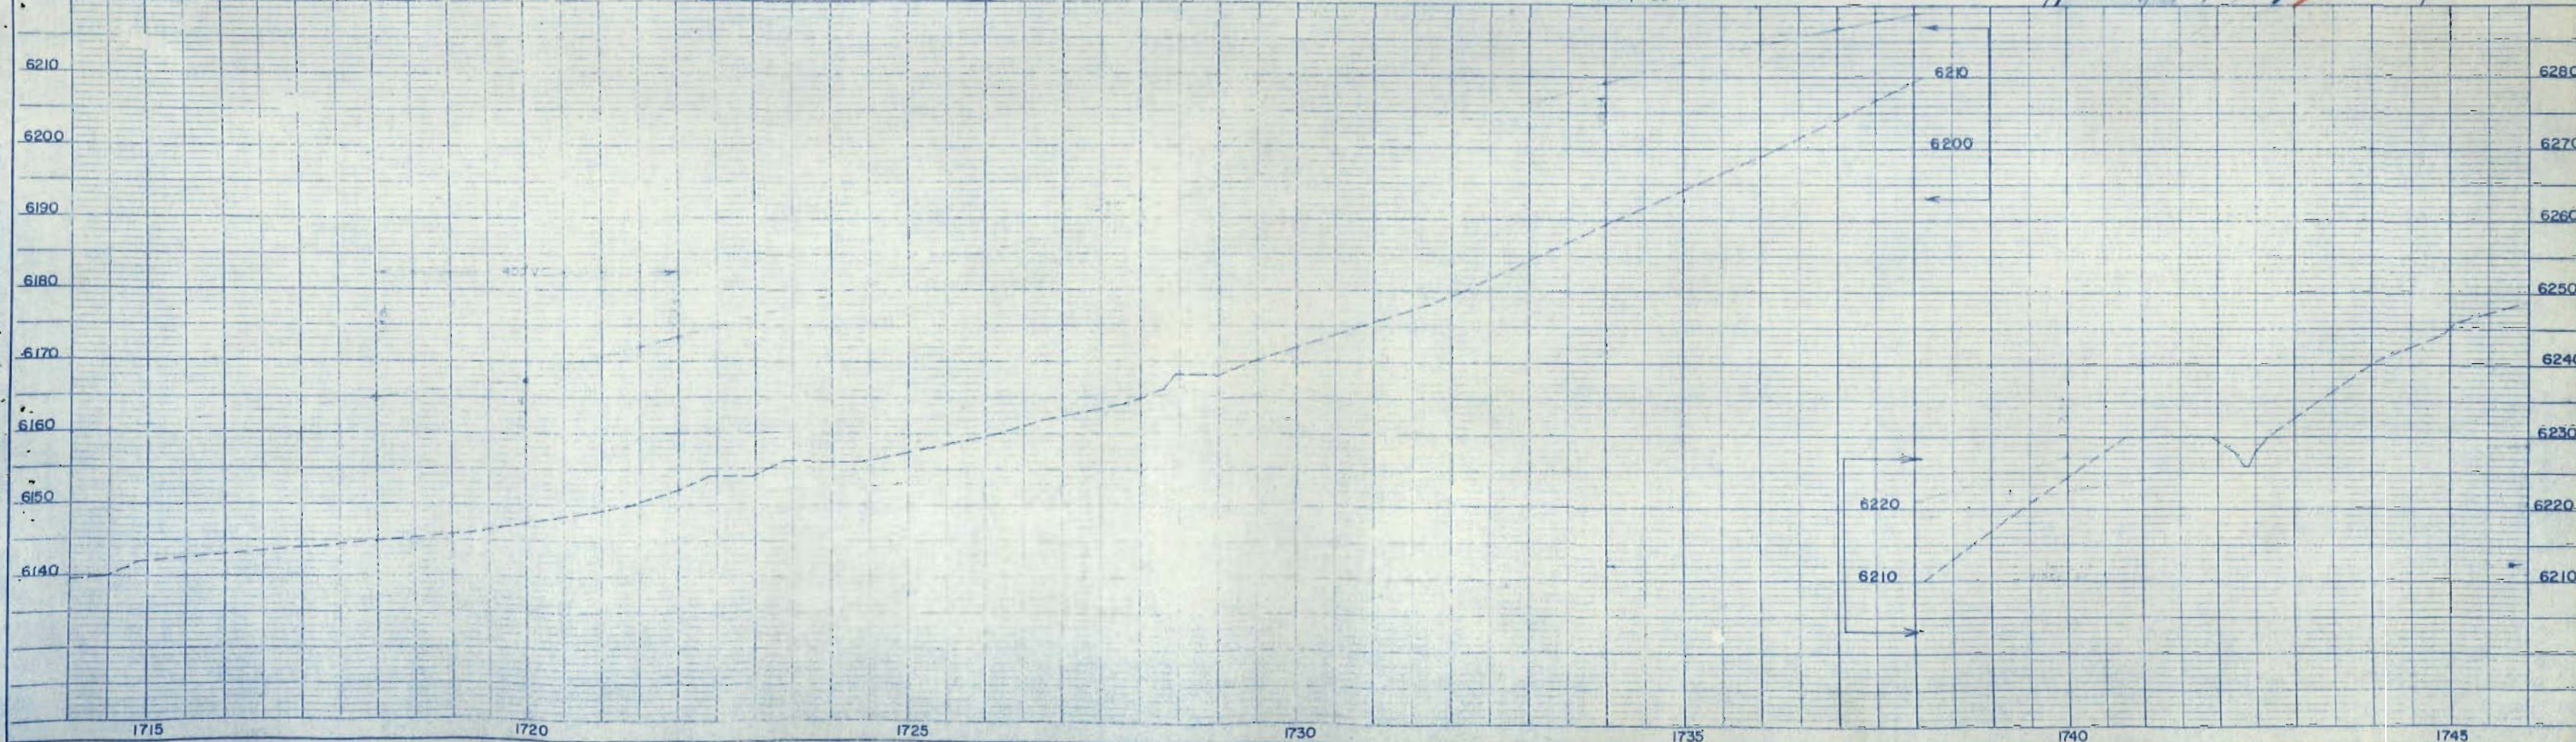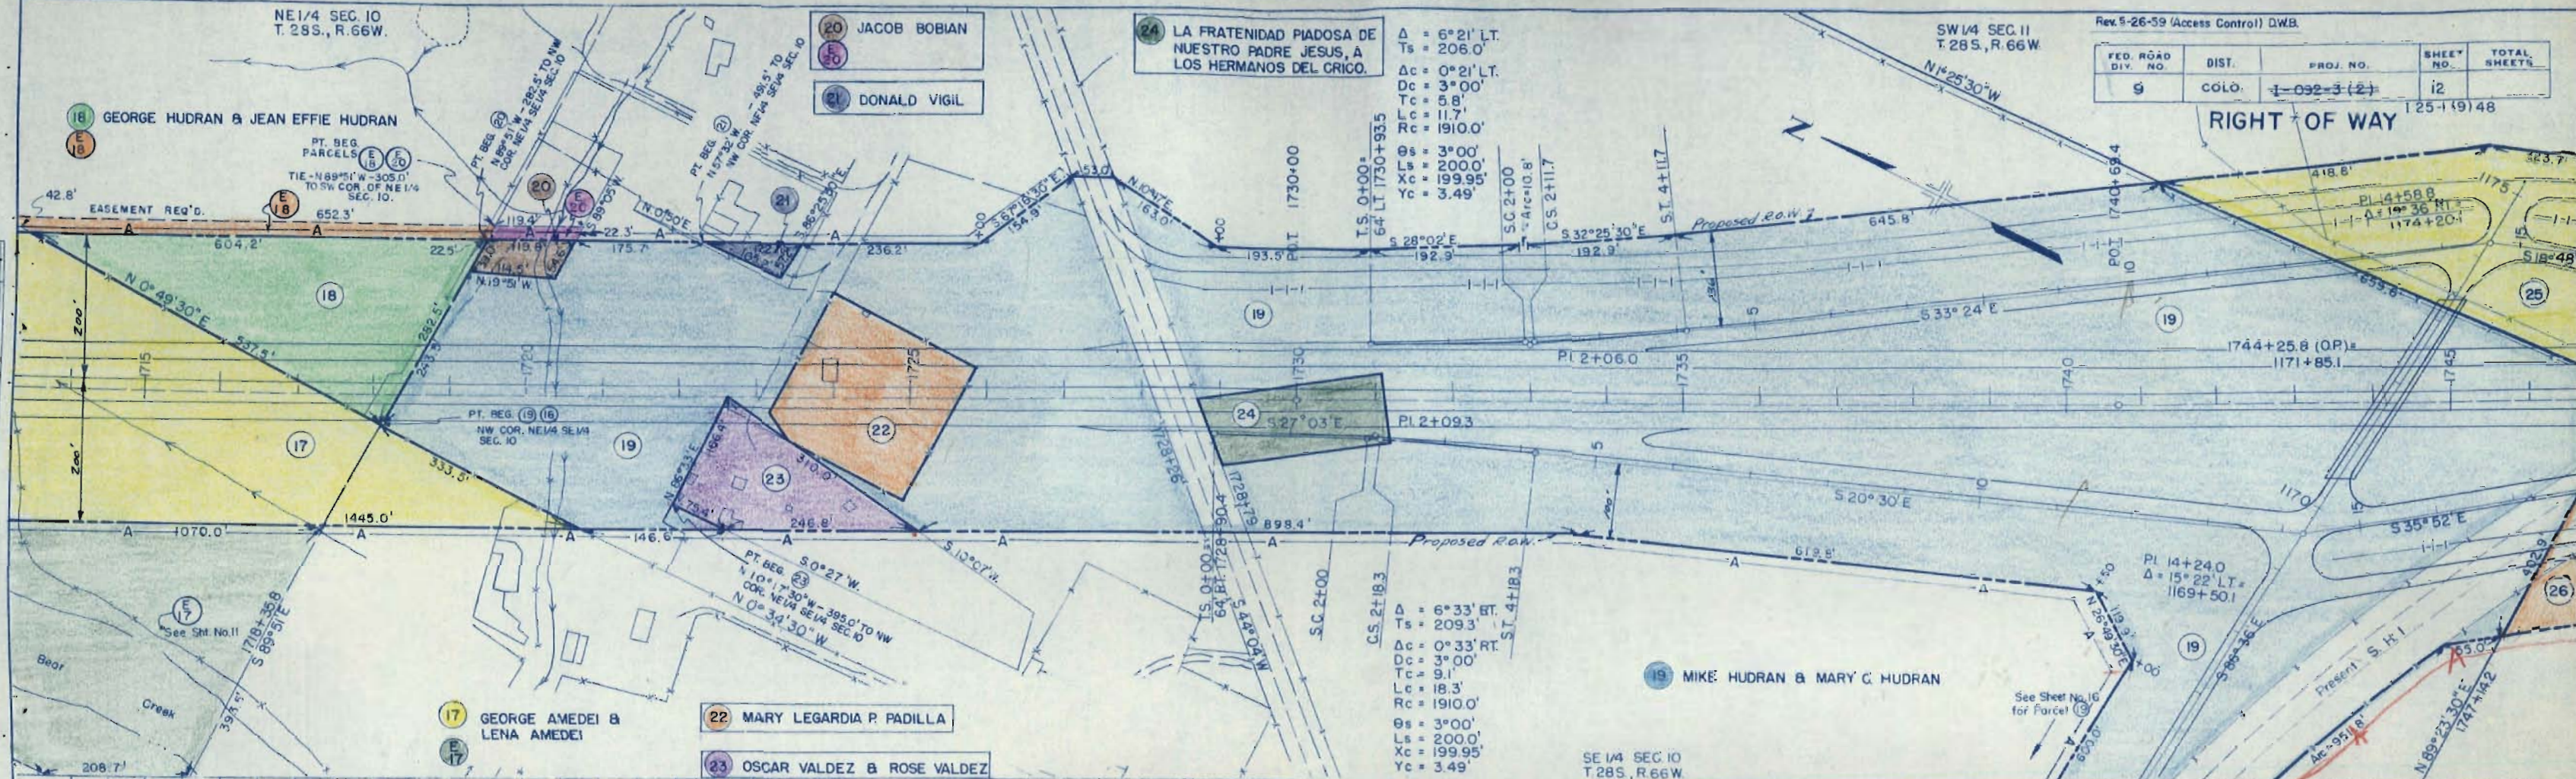


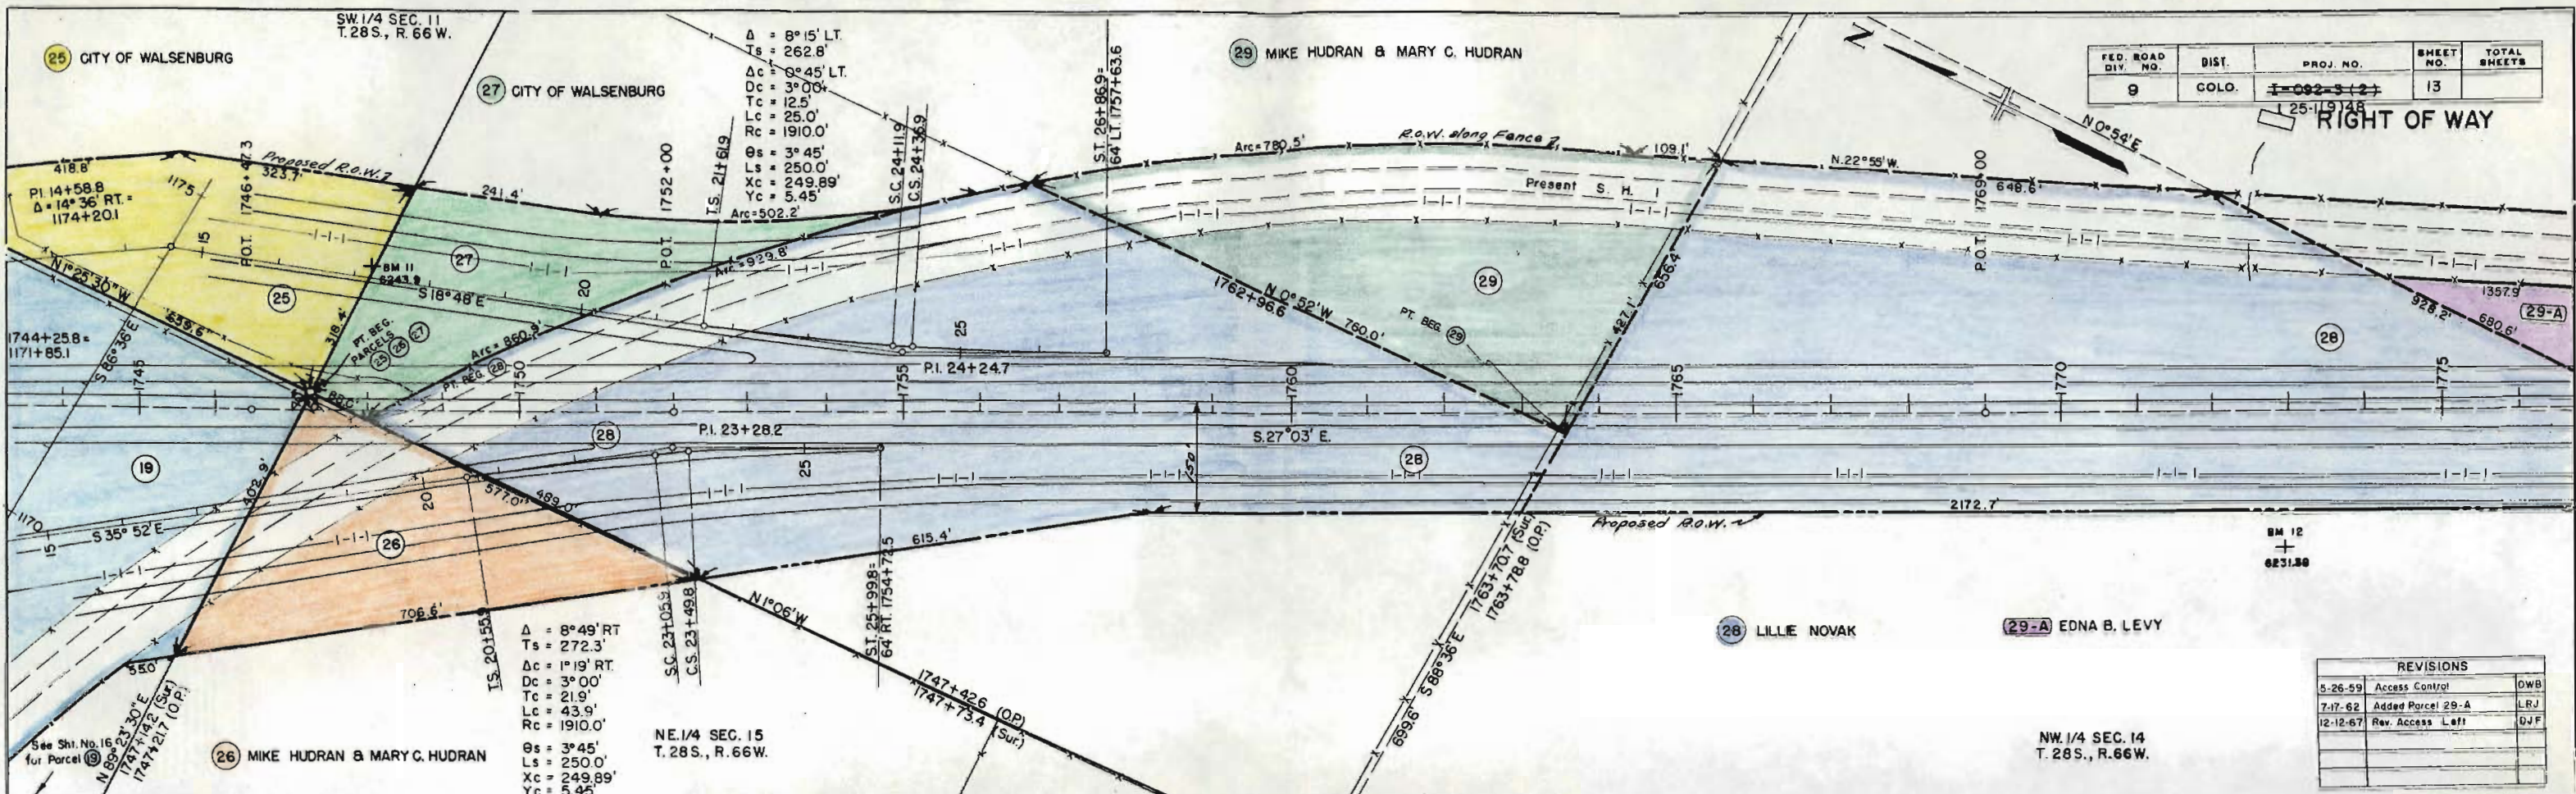

FED. ROAD DIV. NO.	DIST.	PROJ. NO.	SHEET NO.	TOTAL SHEETS
9	COLO.	1-082-3-12	13	

RIGHT OF WAY

REVISIONS		
5-26-59	Access Control	DWB
7-17-62	Added Parcel 29-A	LRJ
12-12-67	Rev. Access Left	DJF

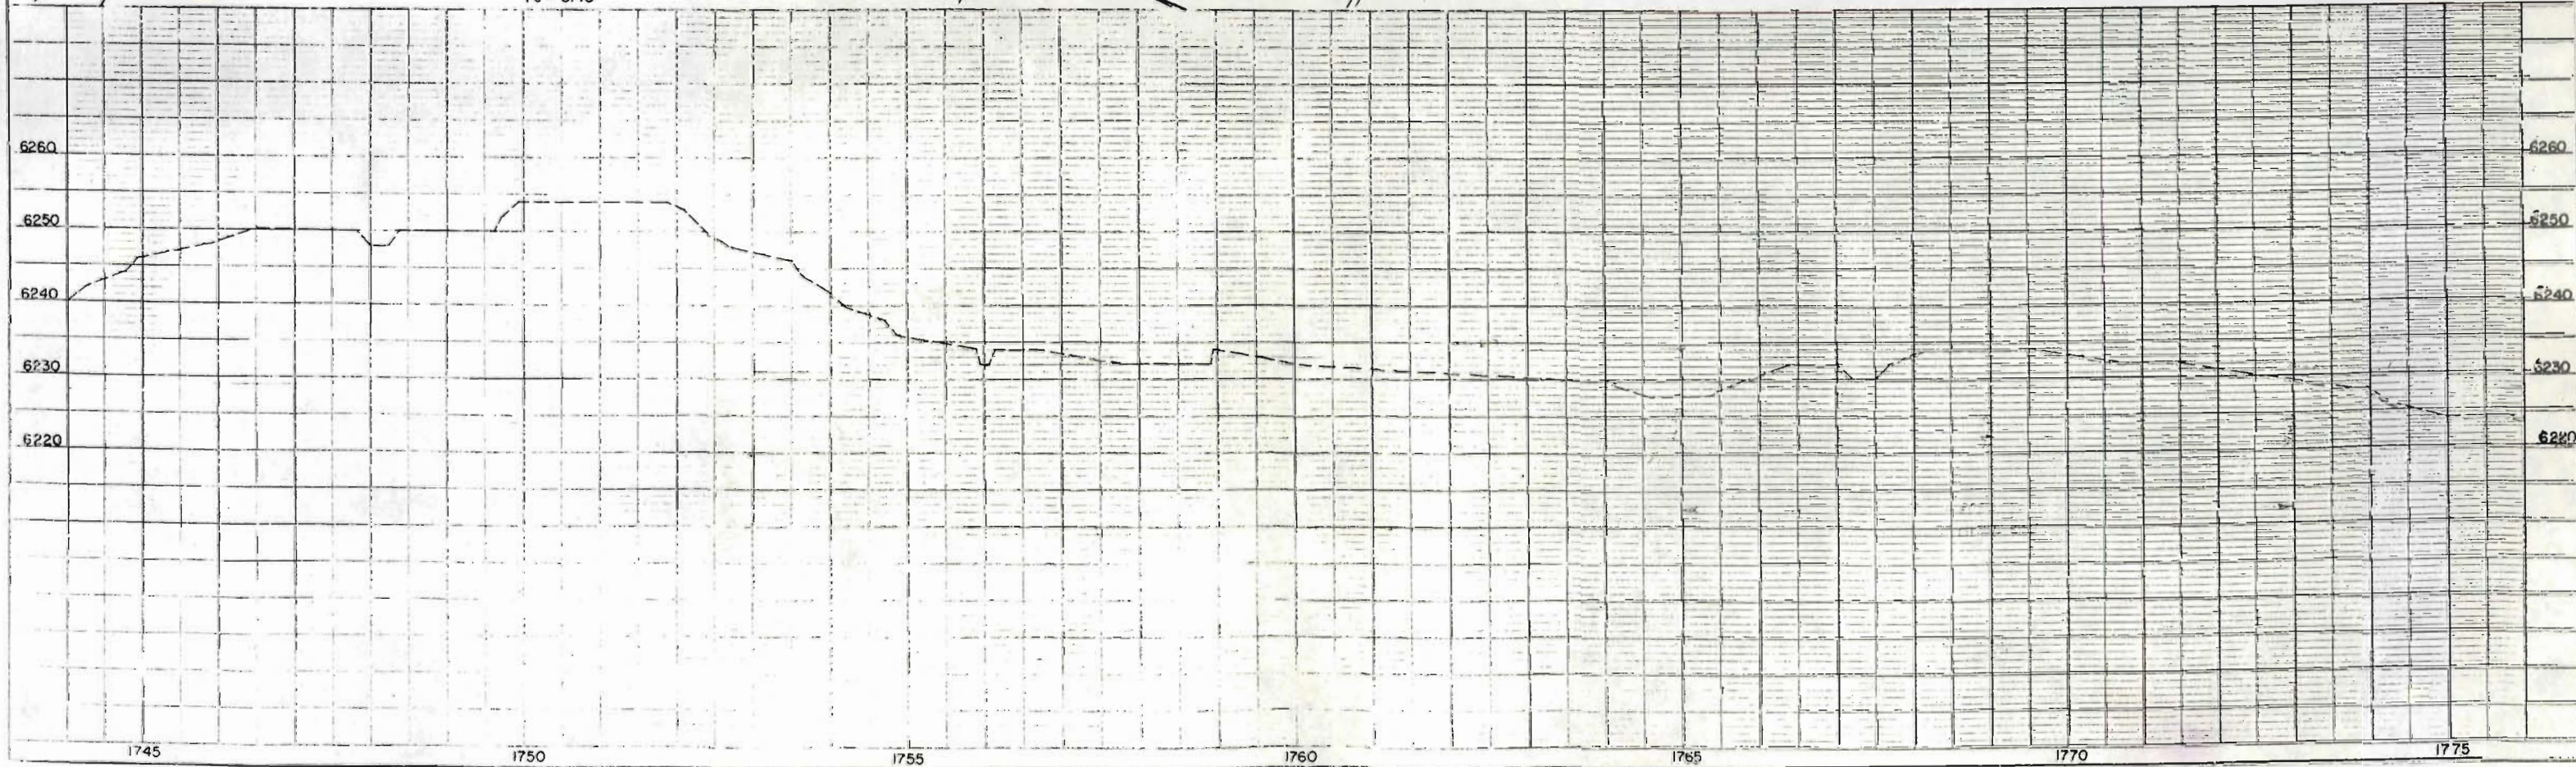

NW 1/4 SEC. 14
T.28S., R.66W.


SE 1/4 SEC. 14
T.28S., R.66W.

(29-A) EDNA B. LEVY


(30) EDNA B. LEVY


FED. ROAD DIST. NO.	DIST.	PROJ. NO.	SHEET NO.	TOTAL SHEETS
9	COLO.	1-092-3(12)	14	

RIGHT OF WAY 125-1(9)48

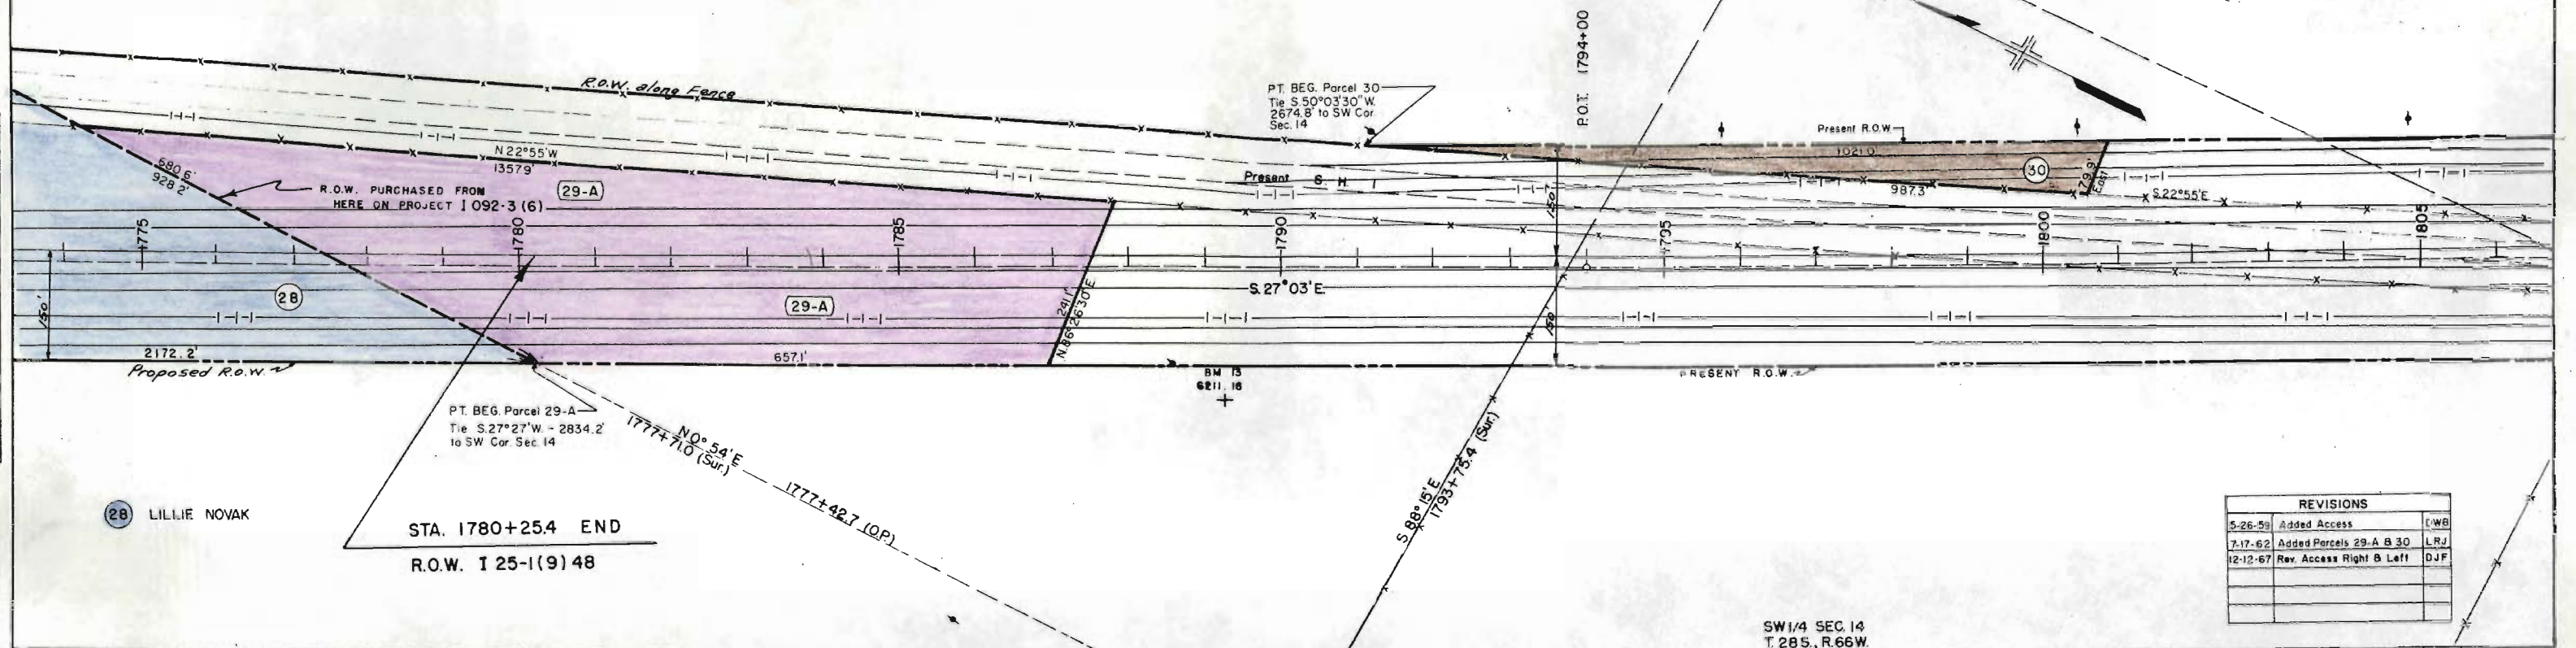

REVISIONS		
5-26-59	Added Access	CWB
7-17-62	Added Parcels 29-A & 30	LRJ
12-12-67	Rev. Access Right & Left	DJF

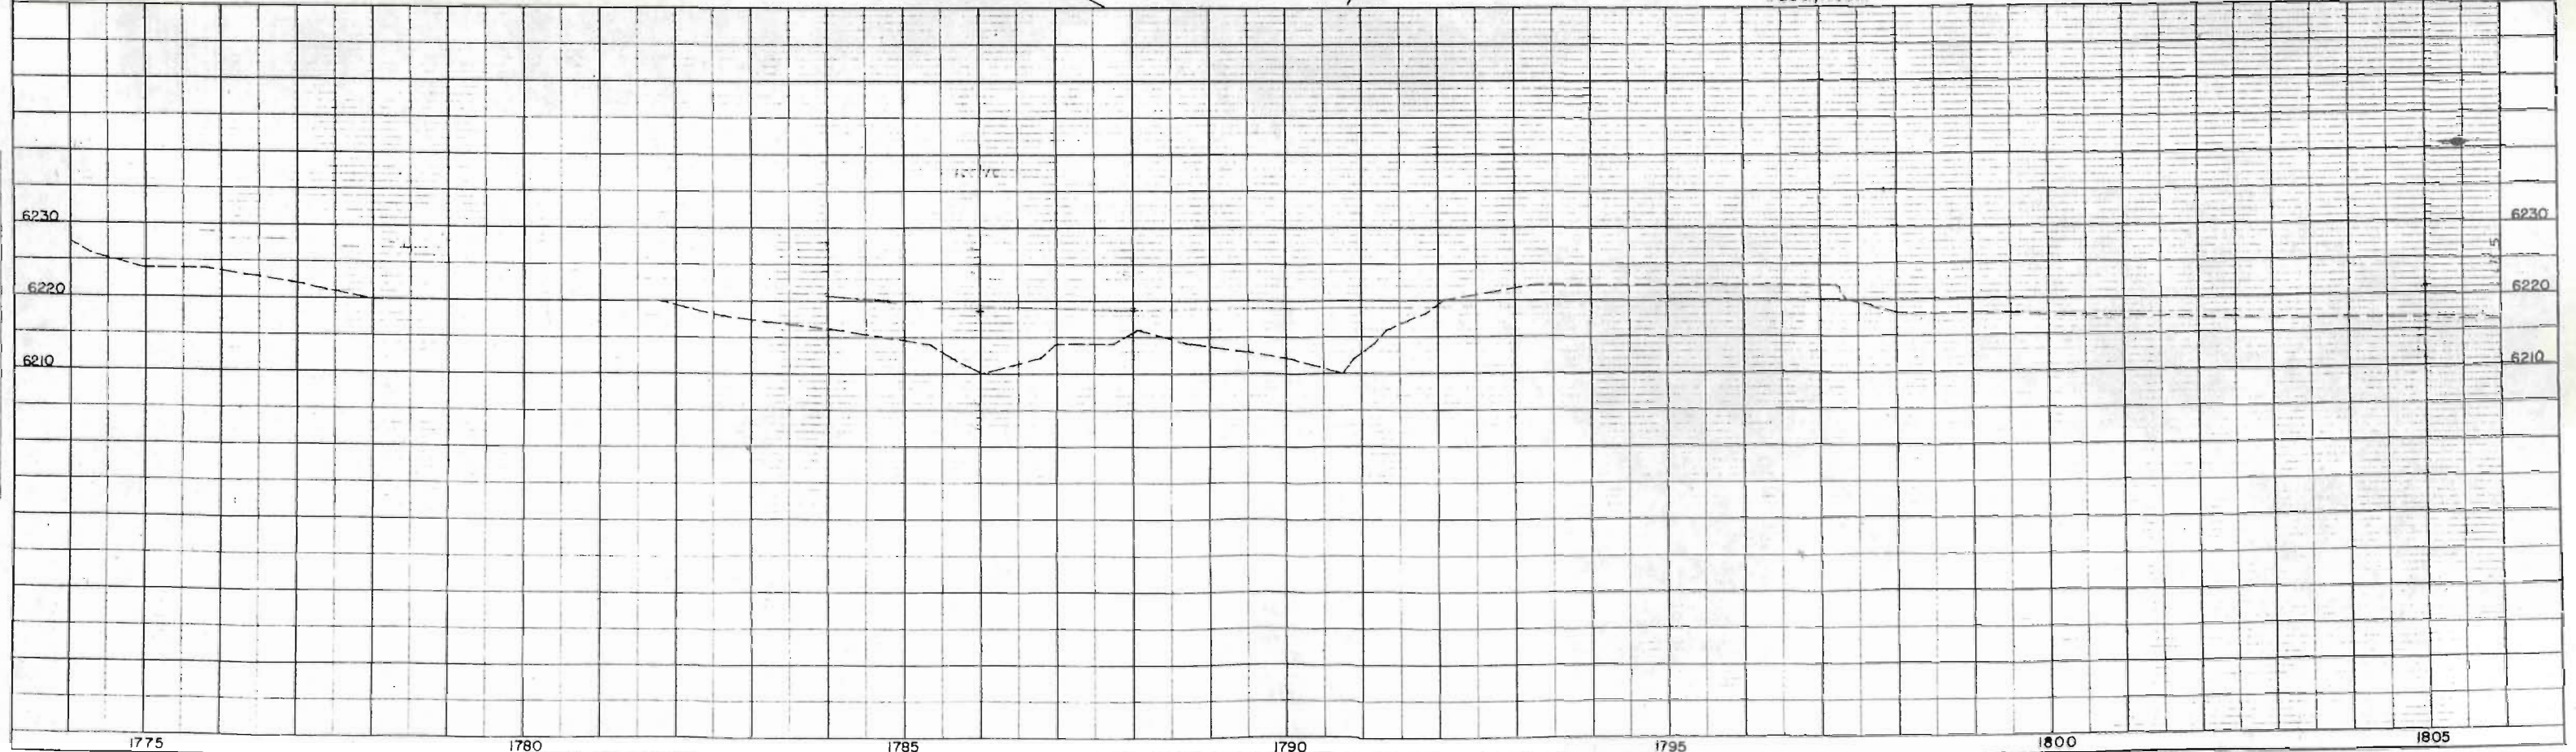

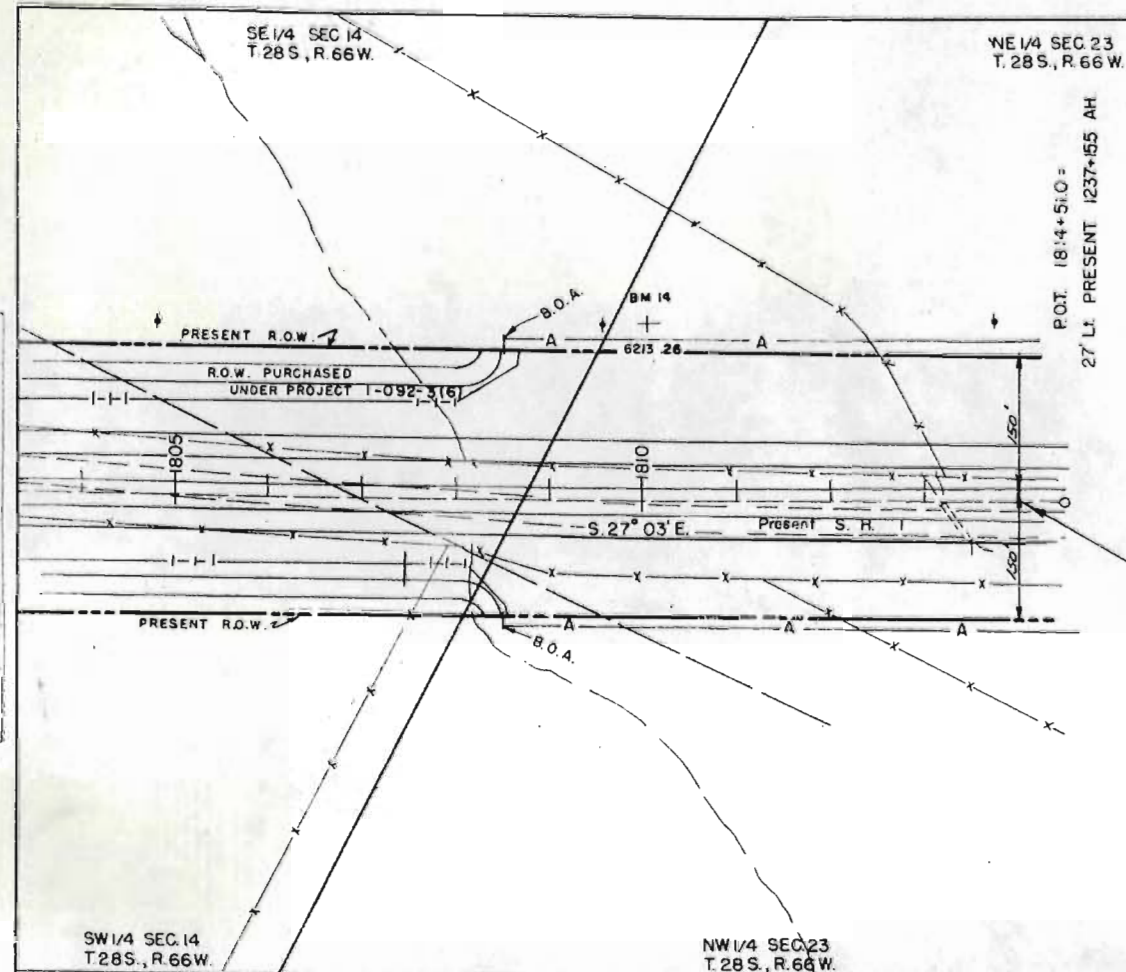


Sta. 1814+00 End Proj. 125-1(9)48 (CONSTRUCTION)
 Sta. 1237+00 Beg. Proj. 1092-3(6)
 42' Rt. Sta. 1237+15.5 Proj. F.A.P. E-2-13

Rev. 5-26-59 (Access Control) D.W.B.
 Rev. 12-12-67 (Access Rt. & Lt.) D.J.F.

FED. ROAD DIST. NO.	DIST.	PROJ. NO.	SHEET NO.	TOTAL SHEETS
9	COLO.	1-092-3(6)	15	

RIGHT OF WAY 125-1(9)48

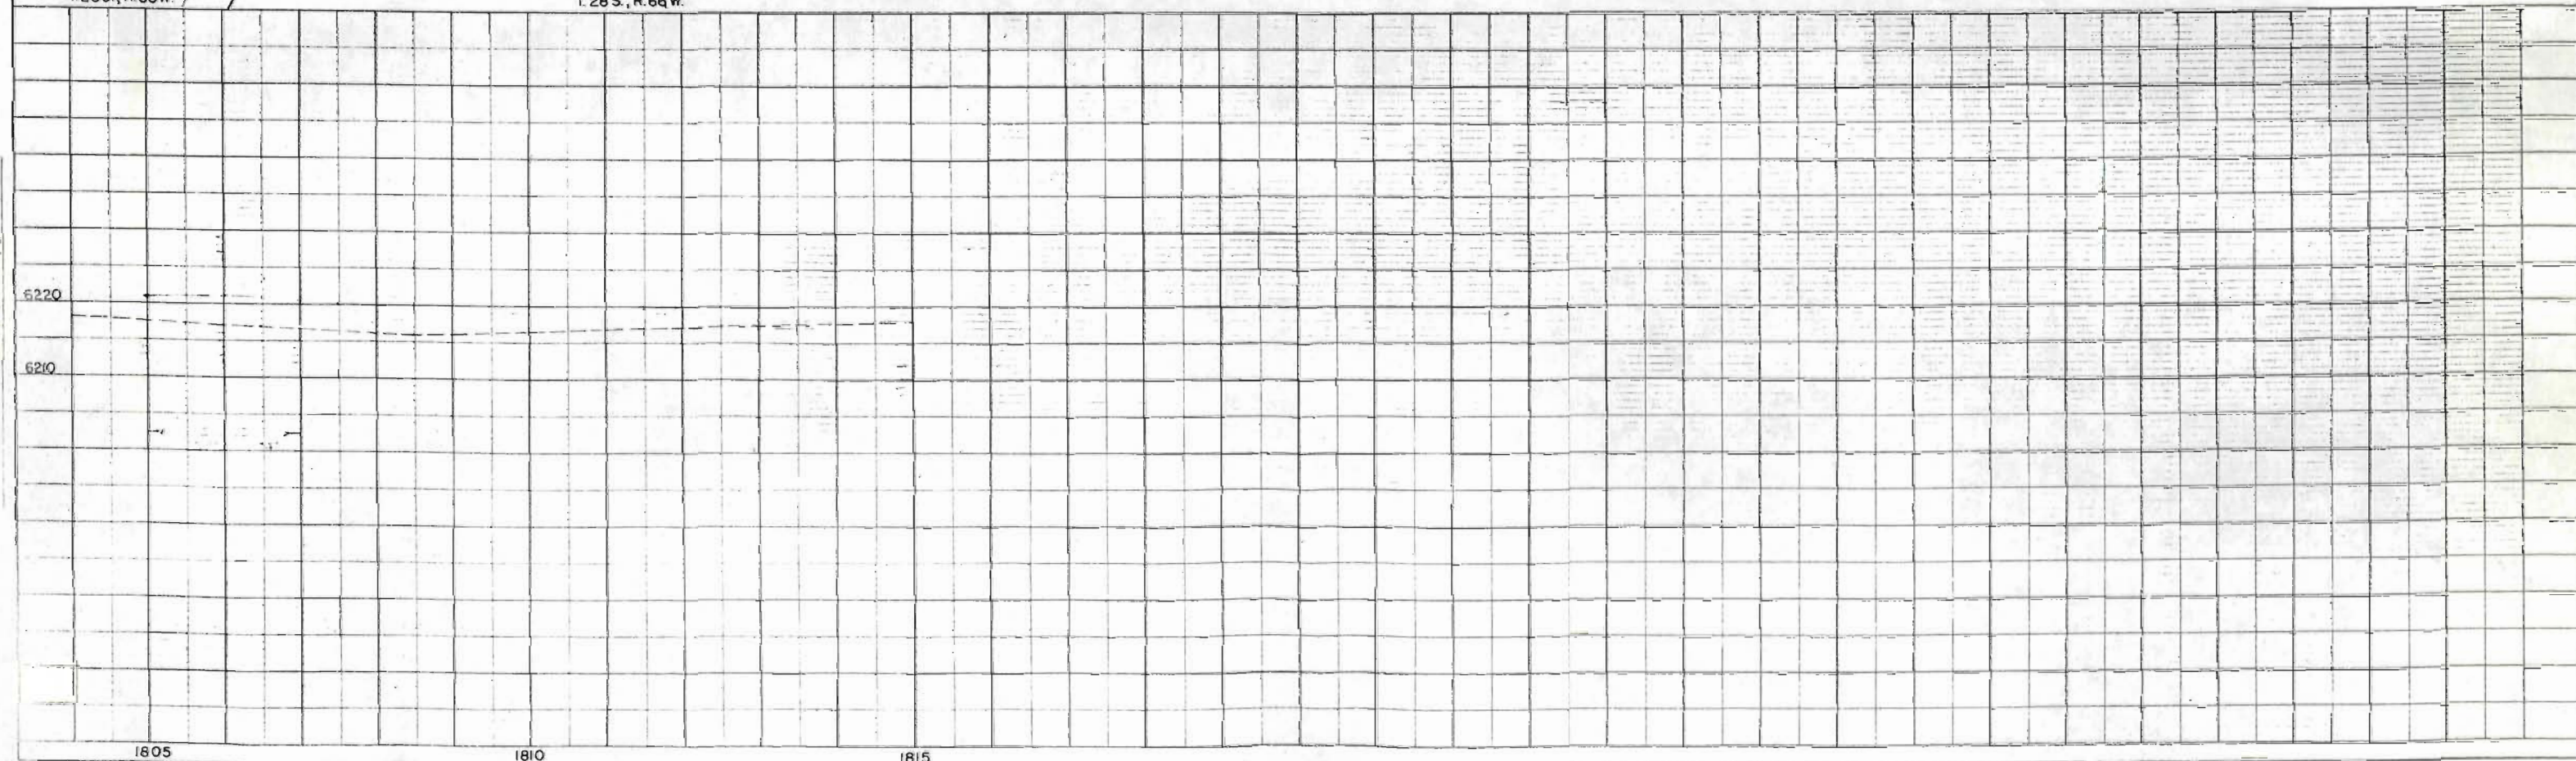



SE 1/4 SEC. 10
T. 28 S., R. 66 W.

MIKE HUDRAN &
MARY C. HUDRAN

SW 1/4 SEC. 11
T. 28 S., R. 66 W.

REV. 0-00-00 (Access Control) D.W.B.
REV. 12-12-67 (Access - Southerly) D.J.F.



TRIP ROAD DIV. NO.	DIST.	REQ. NO.	SHEET NO.	TOTAL SHEETS
9	GOLD	092-3 (2)	16	

RIGHT OF WAY
125-119148

CITY OF WALSINGHAM

NE 1/4 SEC. 15
T. 28 S., R. 66 W.

NW 1/4 SEC. 14
T. 28 S., R. 66 W.

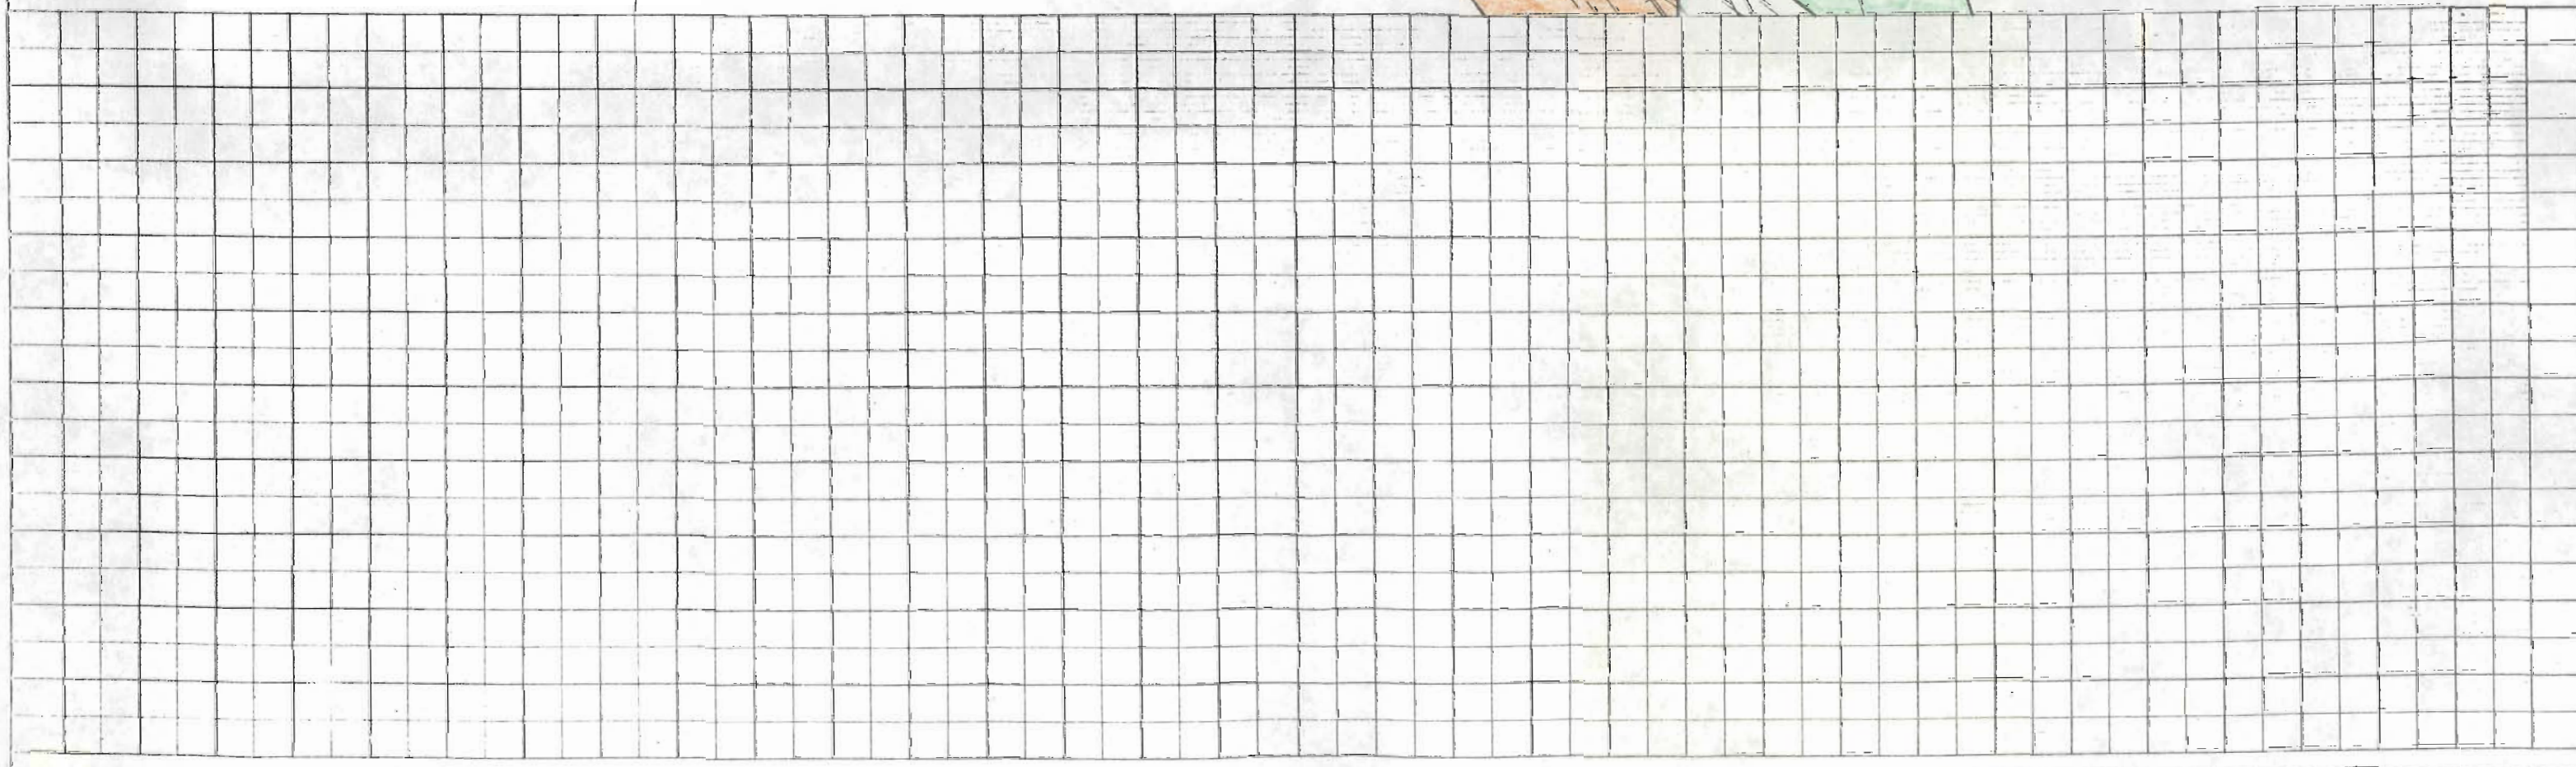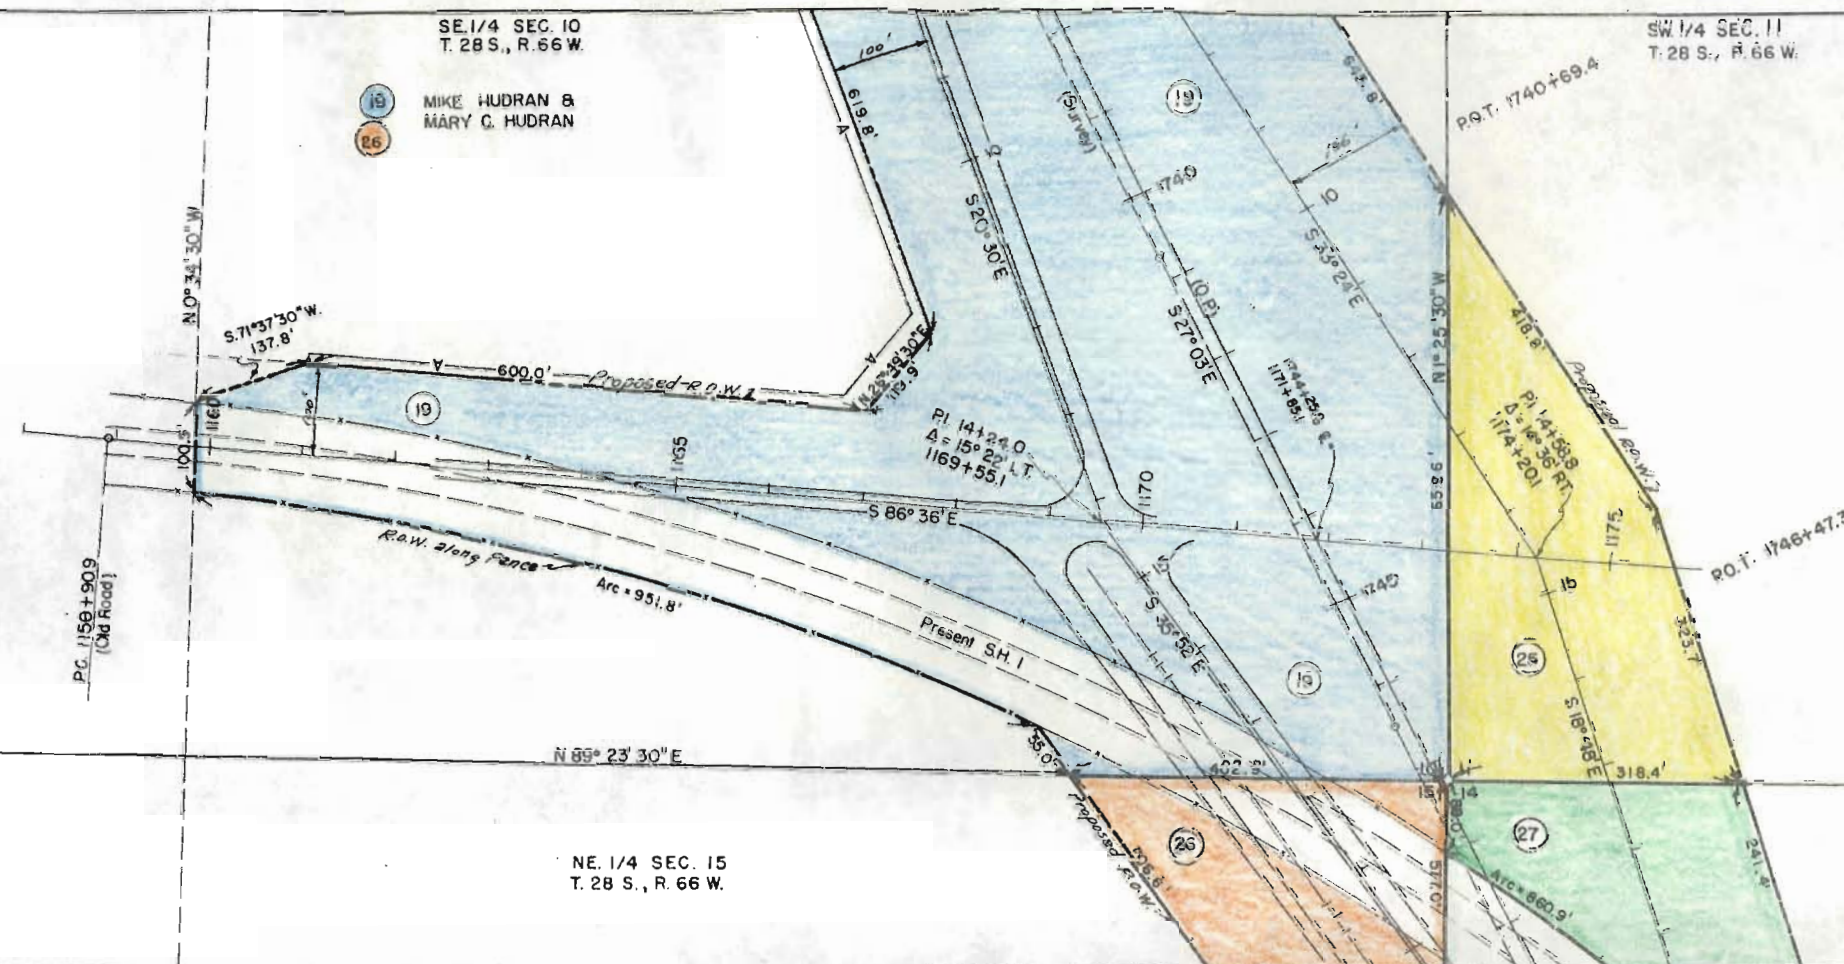



SE 1/4 SEC. 10
T.28 S., R.66 W

MIKE HUDRAN &
MARY C. HUDRAN

SW 1/4 SEC. 11


Rev: 5-26-59 (Access Control) D.W.B.

FED. ROAD DIV. NO.	DIST.	PROJ. NO.	SHEET NO.	TOTAL SHEETS
9	COLO	1-092-3 (2)	16	

RIGHT OF WAY
T 25-1(9) 48

CITY OF WALSENBURG

NW 1/4 SEC. 14
T.28 S., R.66 W.

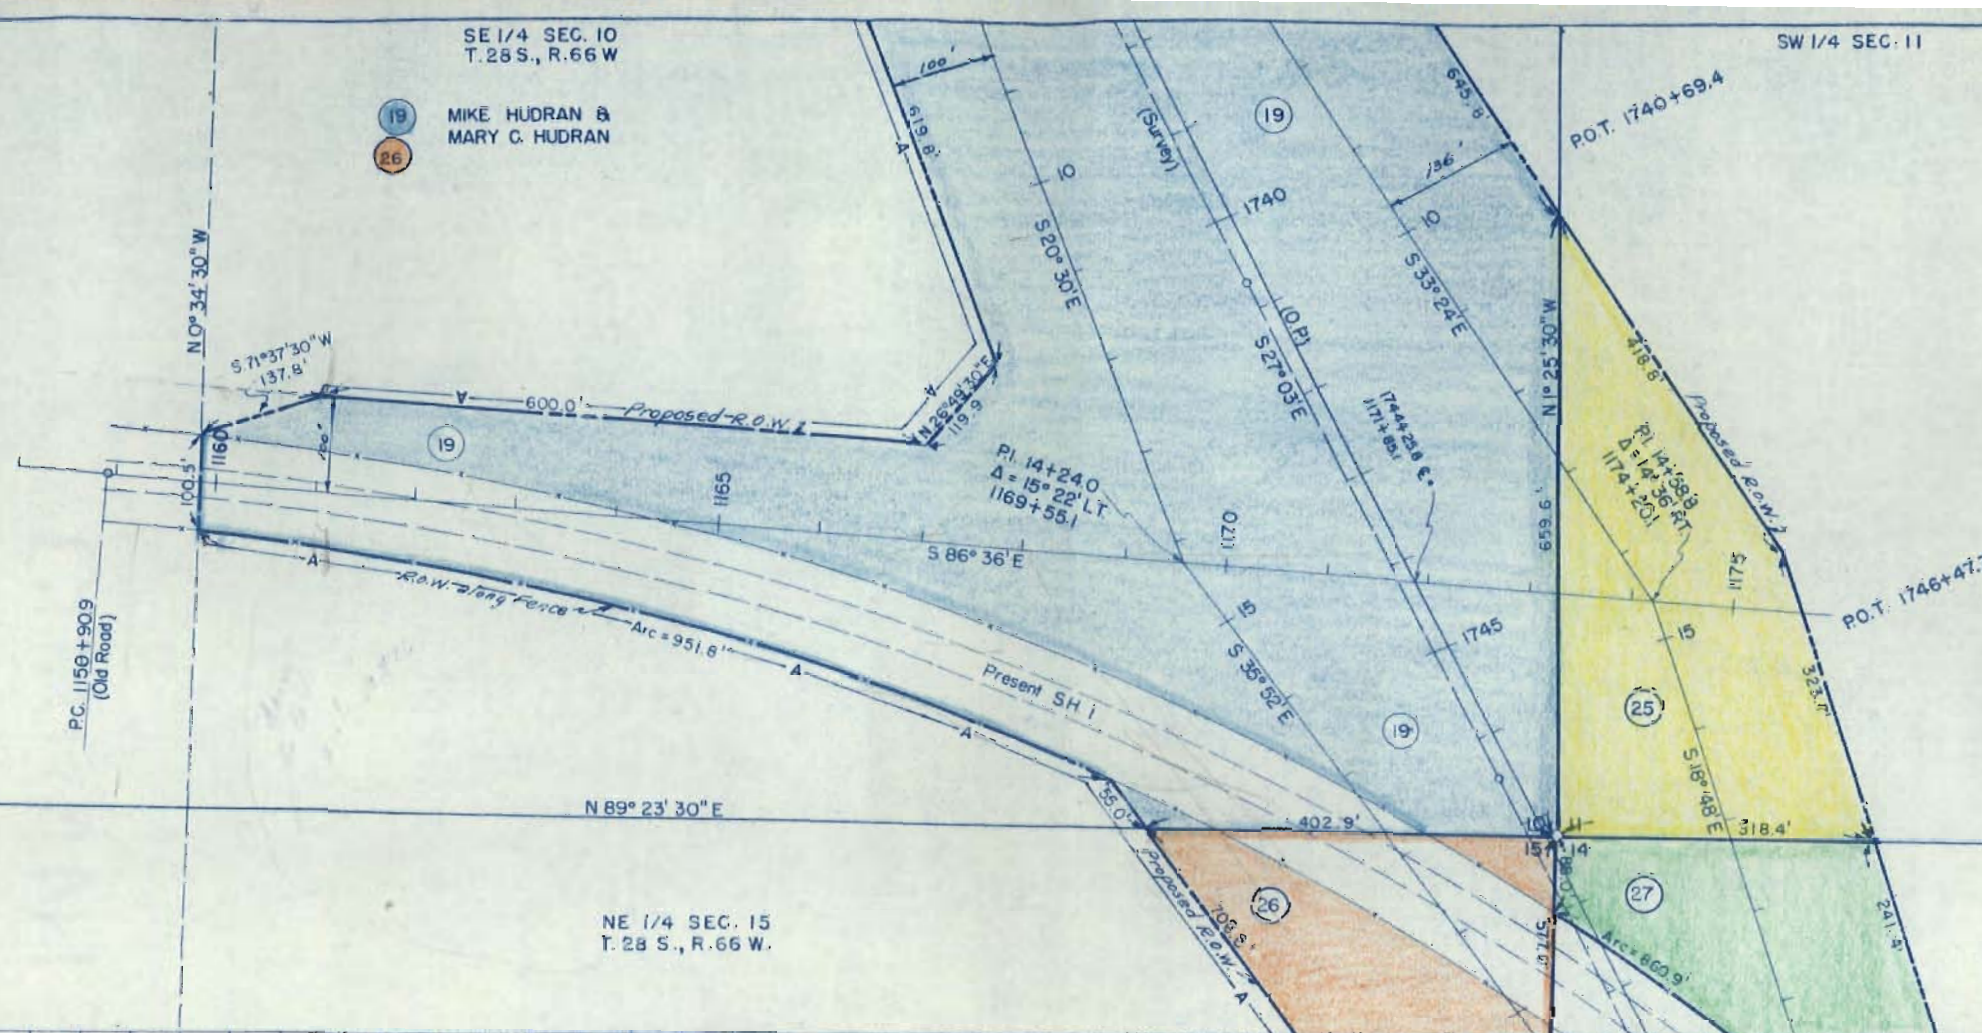


Rev. 4-1-59 (Owner on I, E-I, E-IA, E-IB, E-IC) J.L.S.

REVISIONS		
6-19-59	Begin Sta. R.O.W.	DWB

FEDERAL ROAD DIVISION NO.	DISTRICT	PROJ. NO.	SHEET NO.	TOTAL SHEETS
9	COLORADO	1-092-3(2)	17	

RIGHT OF WAY OWNERSHIP MAP PLAT


SHOWING CLAIMANTS WITH REGARD TO RIGHT OF WAY FOR PROJECT 1-092-3(2)
ORIGINAL SCALE: 1" = 400'

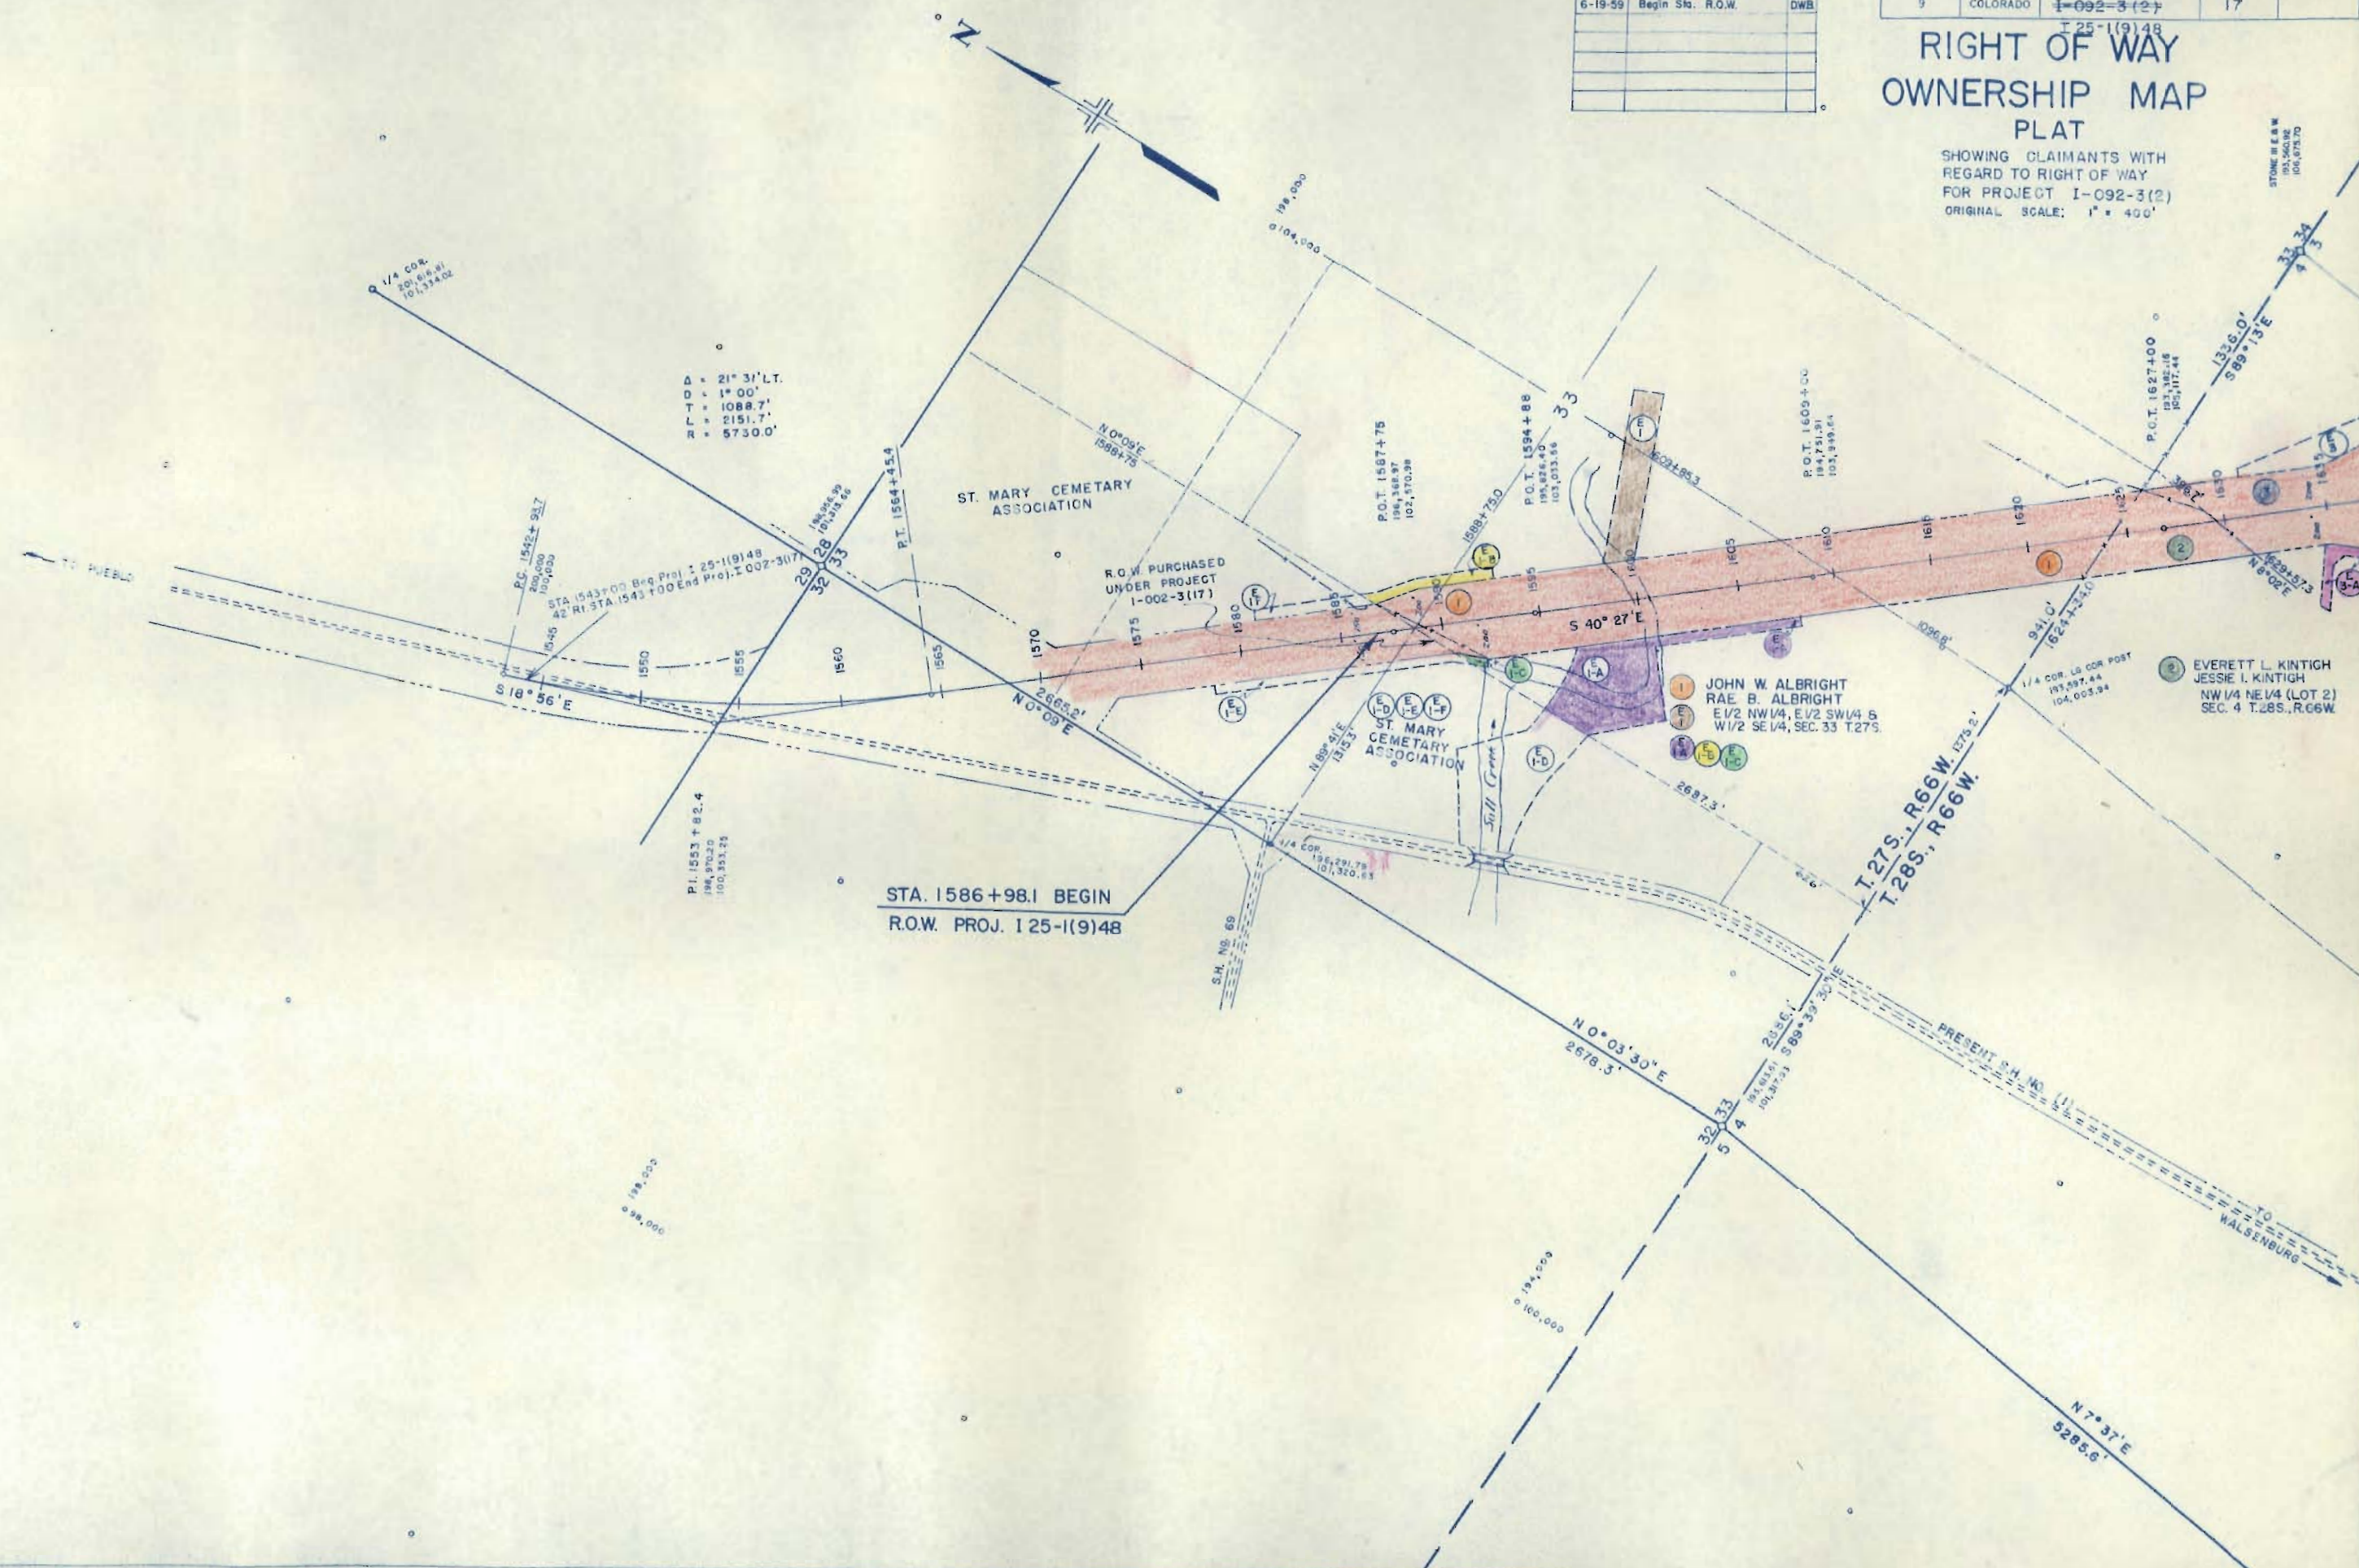

Revisions	FEDERAL ROAD DIVISION NO.	DISTRICT	PROJ. NO.	SHEET NO.	TOTAL SHEETS
4-1-59 16 B E-16 Owner Change JLS	9	COLORADO	T-092-3(2)	18	
6-15-59 add 3A & 5A, Delet E3 D.W.B.					
6-19-59 9 Deleted, 9 Rev. Access Only D.W.B.					
4-24-62 Added 13A, 14A, 15A, 15B AWP					
4-24-62 Revised E14, E15B AWP					
5-22-62 Rev 13A, 14A, E14 Rev, 15A, 15B, B E15B Rev. LRJ					
6-14-62 E15B Rev 2 to TE15B Rev 2 LRJ					
6-15-62 Added E13A LRJ					
7-17-62 Added E15D & E17A LRJ					
11-5-62 Added 15D, B, 17A AWP					

RIGHT OF WAY OWNERSHIP MAP PLAT

SHOWING CLAIMANTS WITH
REGARD TO RIGHT OF WAY
FOR PROJECT T-092-3(2)
ORIGINAL SCALE: 1"=400'

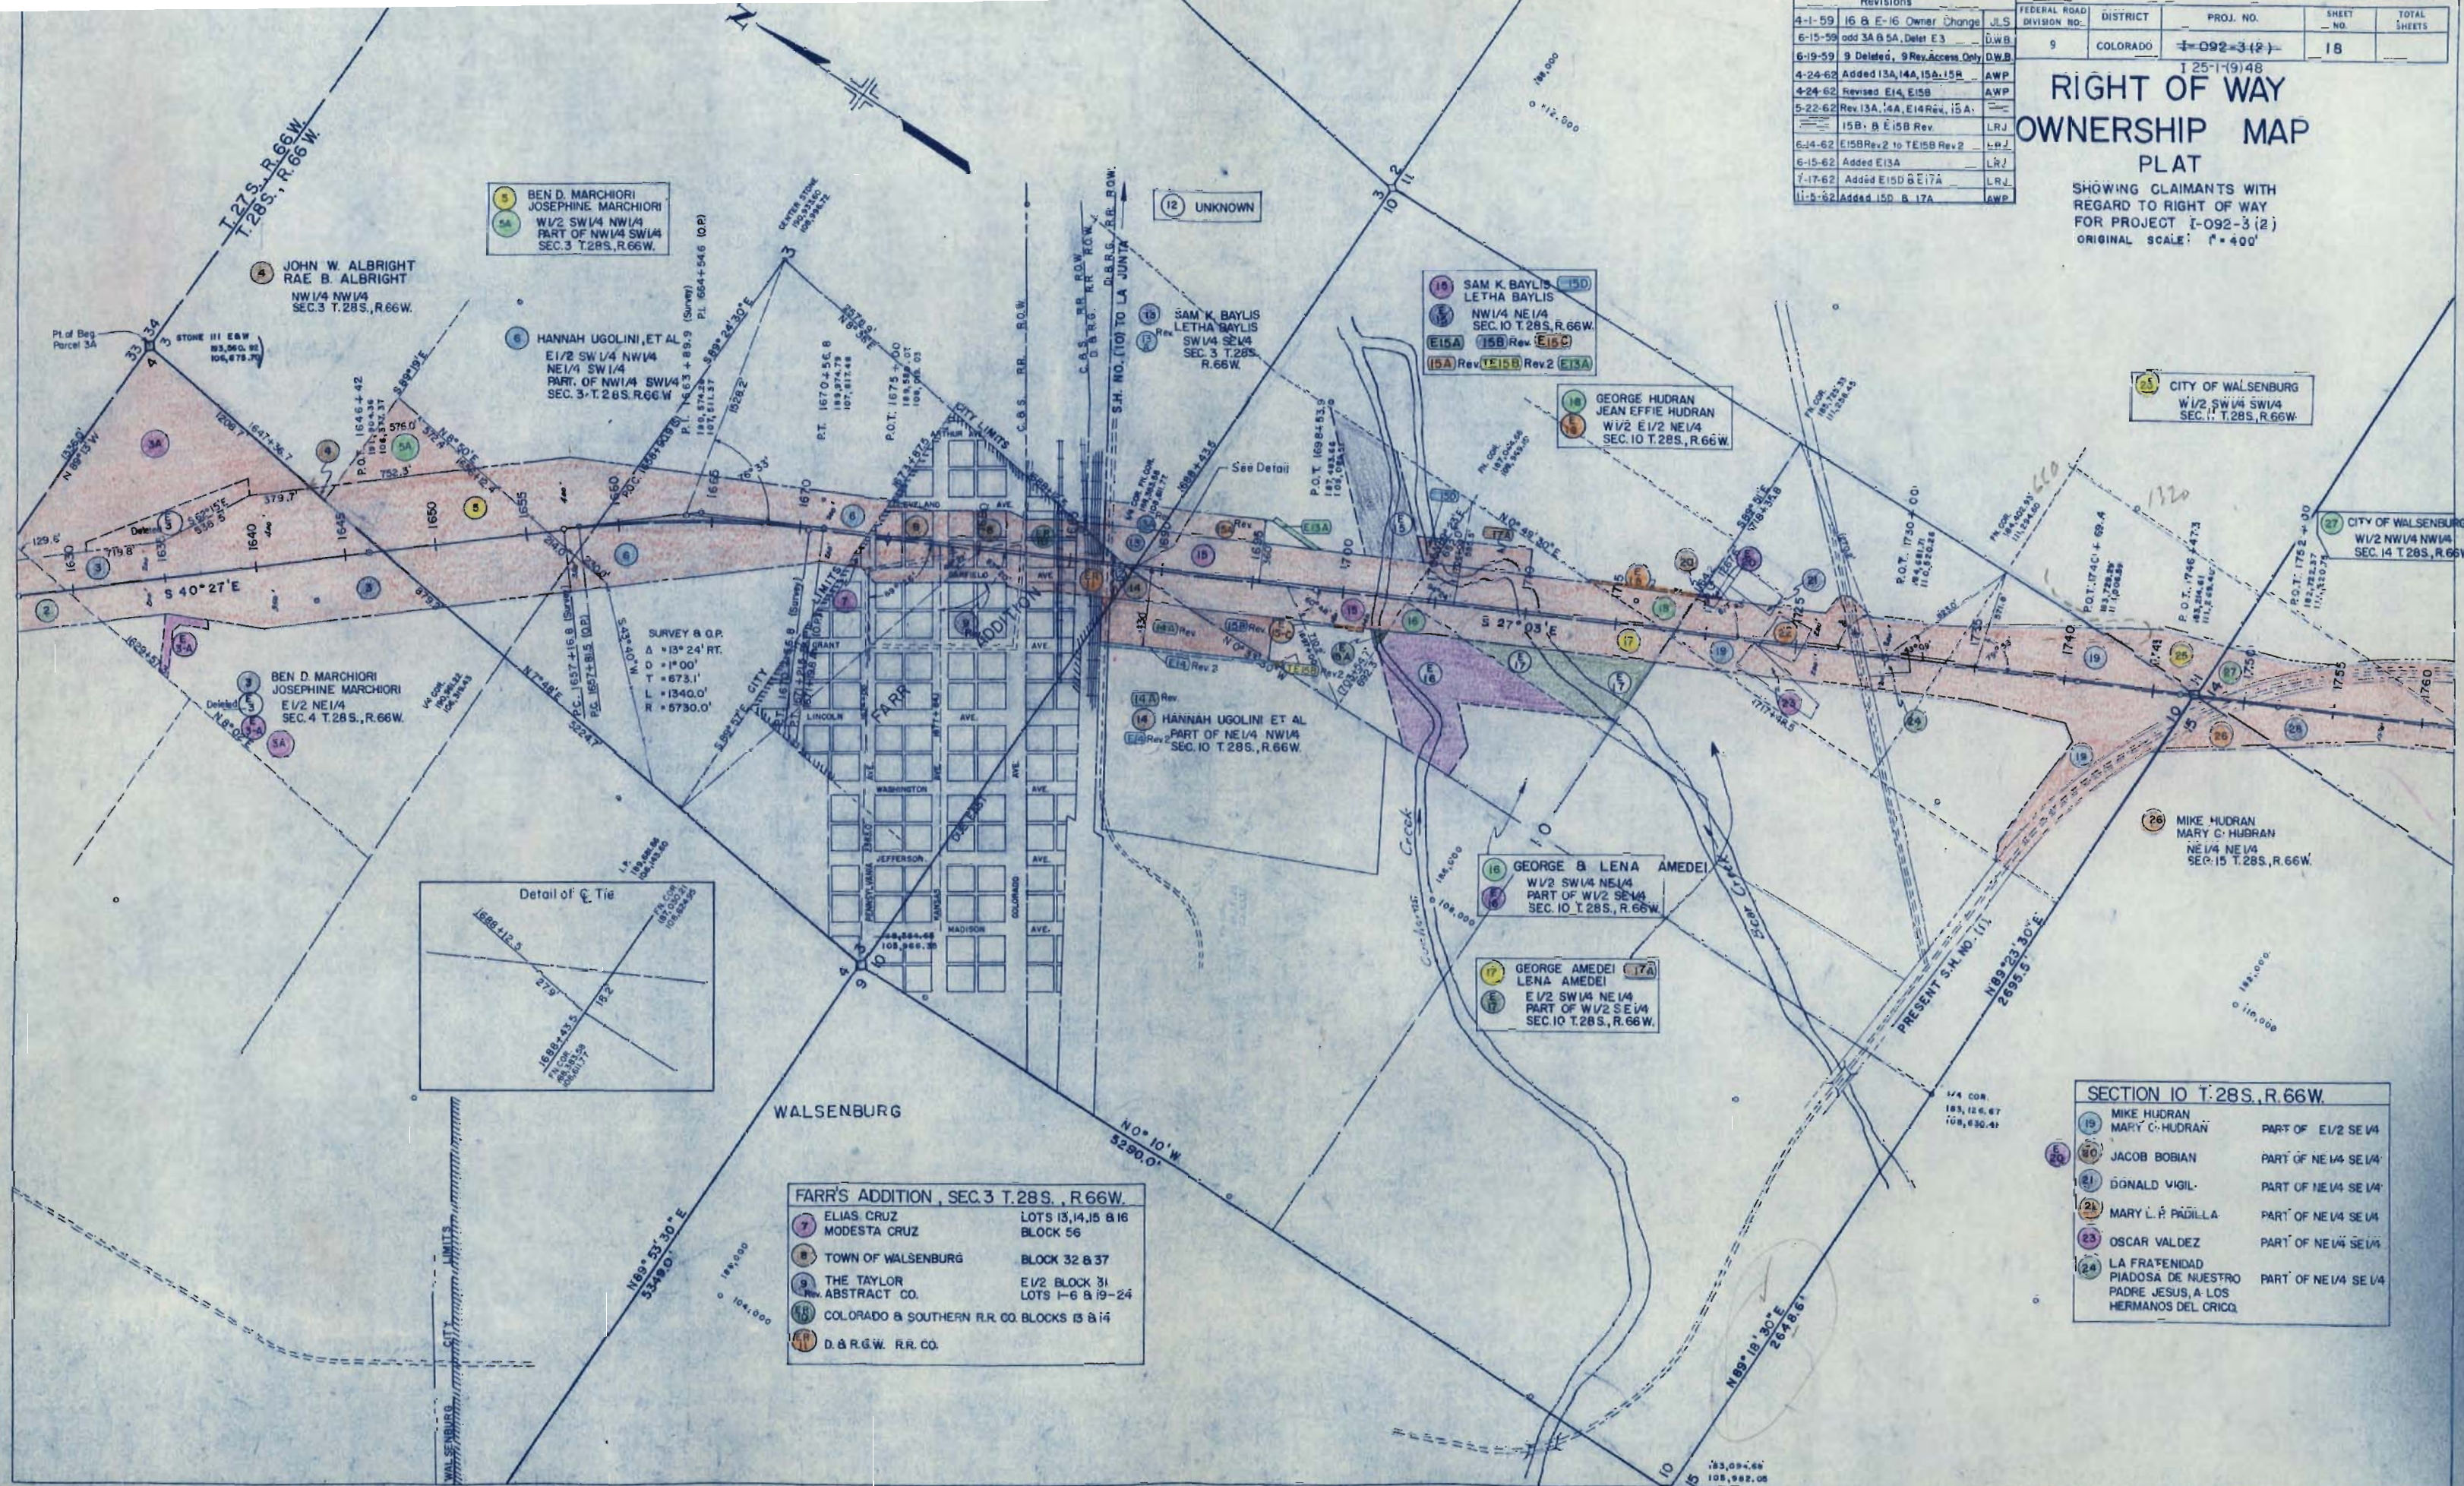

5 BEN D. MARCHIORI
JOSEPHINE MARCHIORI
W1/2 SW1/4 NW1/4
PART OF NW1/4 SW1/4
SEC. 3 T.28S., R.66W.

JOHN W. ALBRIGHT
RAE B. ALBRIGHT
NW1/4 NW1/4
SEC. 3 T.28S., R.66W.

6 HANNAH UGOLINI, ET AL
E1/2 SW1/4 NW1/4
NE1/4 SW1/4
PART OF NW1/4 SW1/4
SEC. 3 T.28S., R.66W.

12 UNKNOWN

15 SAM K. BAYLIS
LETHA BAYLIS
NW1/4 NE1/4
SEC. 10 T.28S., R.66W.
E15A E15B Rev E15C
E15A Rev TE15B Rev 2 E15A

16 GEORGE HUDRAN
JEAN EFFIE HUDRAN
W1/2 E1/2 NE1/4
SEC. 10 T.28S., R.66W.

25 CITY OF WALSENBURG
W1/2 SW1/4 SW1/4
SEC. 11 T.28S., R.66W.

27 CITY OF WALSENBURG
W1/2 NW1/4 NW1/4
SEC. 14 T.28S., R.66W.

26 MIKE HUDRAN
MARY C. HUDRAN
NE1/4 NE1/4
SEC. 15 T.28S., R.66W.

18 GEORGE & LENA AMEDEI
W1/2 SW1/4 NE1/4
PART OF W1/2 SE1/4
SEC. 10 T.28S., R.66W.

17 GEORGE AMEDEI
LENA AMEDEI
E1/2 SW1/4 NE1/4
PART OF W1/2 SE1/4
SEC. 10 T.28S., R.66W.

FARR'S ADDITION, SEC. 3 T.28S., R.66W.
7 ELIAS CRUZ
MODESTA CRUZ
LOTS 13, 14, 15 & 16
BLOCK 56
8 TOWN OF WALSENBURG
BLOCK 32 & 37
9 THE TAYLOR
REV. ABSTRACT CO.
E1/2 BLOCK 31
LOTS 1-6 & 19-24
10 COLORADO & SOUTHERN R.R. CO. BLOCKS 13 & 14
11 D. & R.G.W. R.R. CO.

SECTION 10 T.28S., R.66W.

19 MIKE HUDRAN
MARY C. HUDRAN PART OF E1/2 SE1/4
20 JACOB BOBIAN PART OF NE1/4 SE1/4
21 DONALD VIGIL PART OF NE1/4 SE1/4
22 MARY L. P. PADILLA PART OF NE1/4 SE1/4
23 OSCAR VALDEZ PART OF NE1/4 SE1/4
24 LA FRATERNIDAD
PIADOSA DE NUESTRO PART OF NE1/4 SE1/4
PADRE JESUS, A LOS
HERMANOS DEL CRICQ.

6-19-52	ROW	DWB
7-17-62	AB 30	LRJ

FEDERAL ROAD DIVISION NO.	DISTRICT	PROJ. NO.	SHEET NO.	TOTAL SHEETS
9	COLORADO	1-092-3(2) 1-25-1(9)48	19	

RIGHT OF WAY OWNERSHIP MAP

PLAT
SHOWING CLAIMANTS WITH
REGARD TO RIGHT OF WAY
FOR PROJECT 1-092-3 (2)
ORIGINAL SCALE: 1" = 400'

