

INDEX OF SHEETS

(For Index of Sheets see Sheet No. 1a)


COLORADO STATE HIGHWAY DEPARTMENT PLAN AND PROFILE OF PROPOSED FEDERAL AID INTERSTATE PROJECT NO. I-25-3(32) 283 STATE HIGHWAY NO. 185 LARIMER AND WELD COUNTIES.

SCALES OF ORIGINAL TRACINGS
ON PLAN, 1 IN. = 100 FT.
ON PROFILE 1 IN. = 100 FT. HORIZONTAL
1 IN. = 10 FT. VERTICAL
GRADE LINE ON PROFILE IS SHOWN AS GRADE OF FINISHED ROAD
GROSS LENGTH OF PROJECT } 89,047.5 Lin. Ft. = 16.865 Mi.
NET LENGTH OF PROJECT }

CONVENTIONAL SIG.
CENTER LINE OF SURVEY
RIGHT OF WAY LINES
COUNTY LINE
TOWNSHIP LINES
SECTION LINES
ONE QUARTER SECTION LINES
BARBED WIRE FENCE
COMBINATION WIRE FENCE
TELEPH. & TELEG. LINE
POWER LINE
C. of A. LINE (CONTROL OF ACCESS)
ACCESS DENIED BY DEED
RAILROAD
ACCESS POINTS (Freeways)

AS CONSTRUCTED PLANS
RETURN TO DIST. 4 DESIGN


NOTE:
See Special Provisions for Notice to Bidders

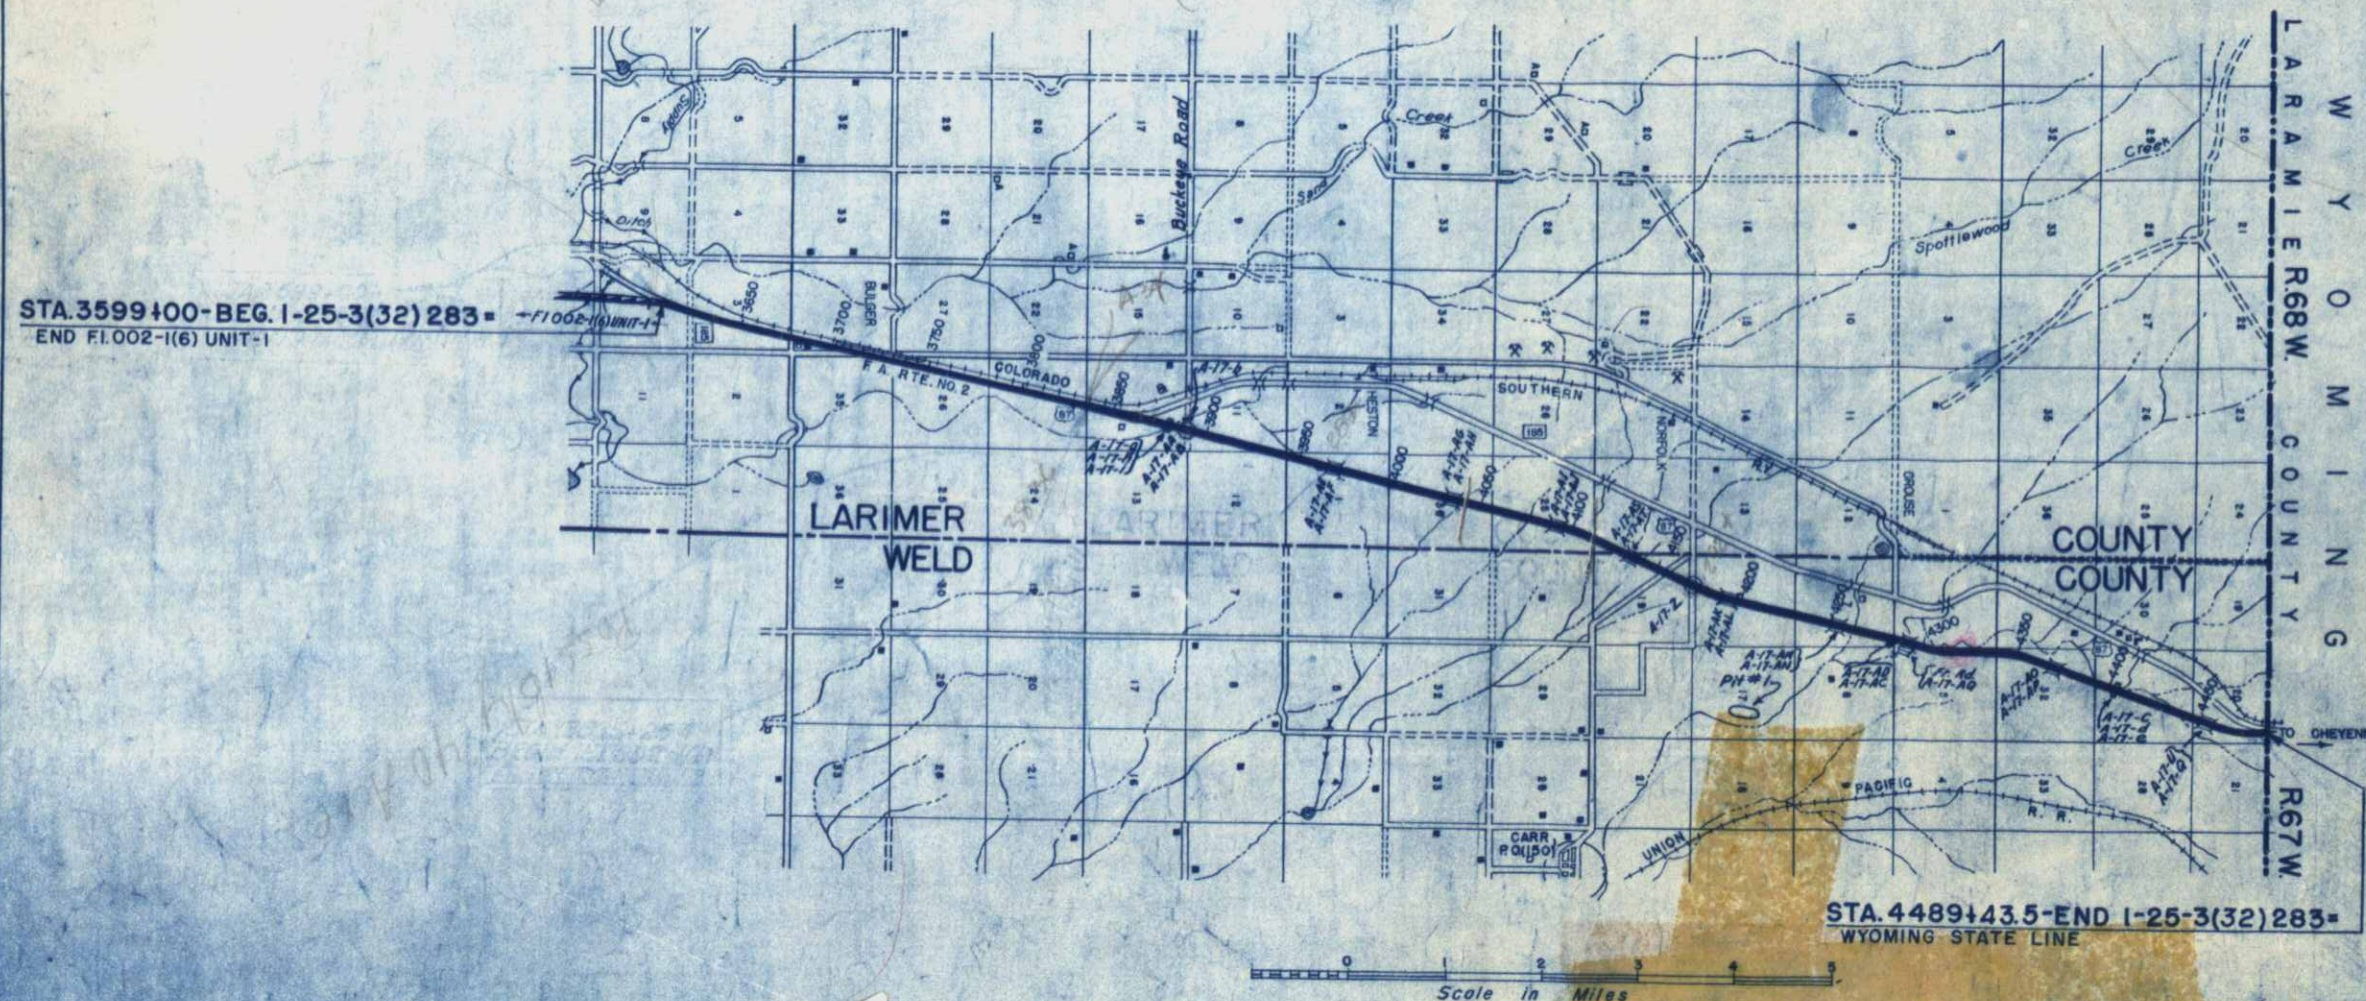


APPROVED:
CHIEF ENGINEER
DATE

APPROVED:
DIVISION ENGINEER
R.S.M.

PROFILE	SURVEYED	DATE
NOTE BOOK	PLOTTED	
	GRADES CHECKED	
NO 13607	S.I.E. - NOTED	
	STRUCTURE NOTATIONS ON XD	

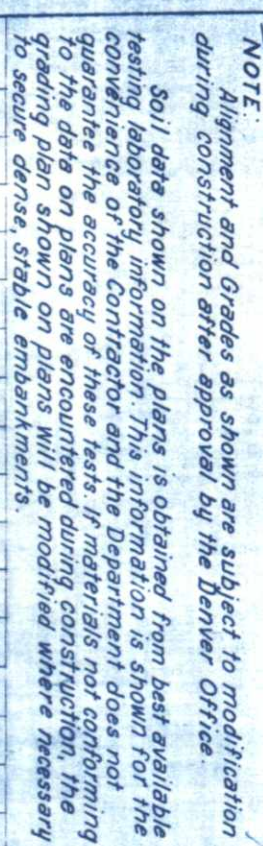


APPROACH TO PROJECT
Shall be a gradual transition from 2 lane to 4 lane over a distance of 1000 feet as stated by the Engineer

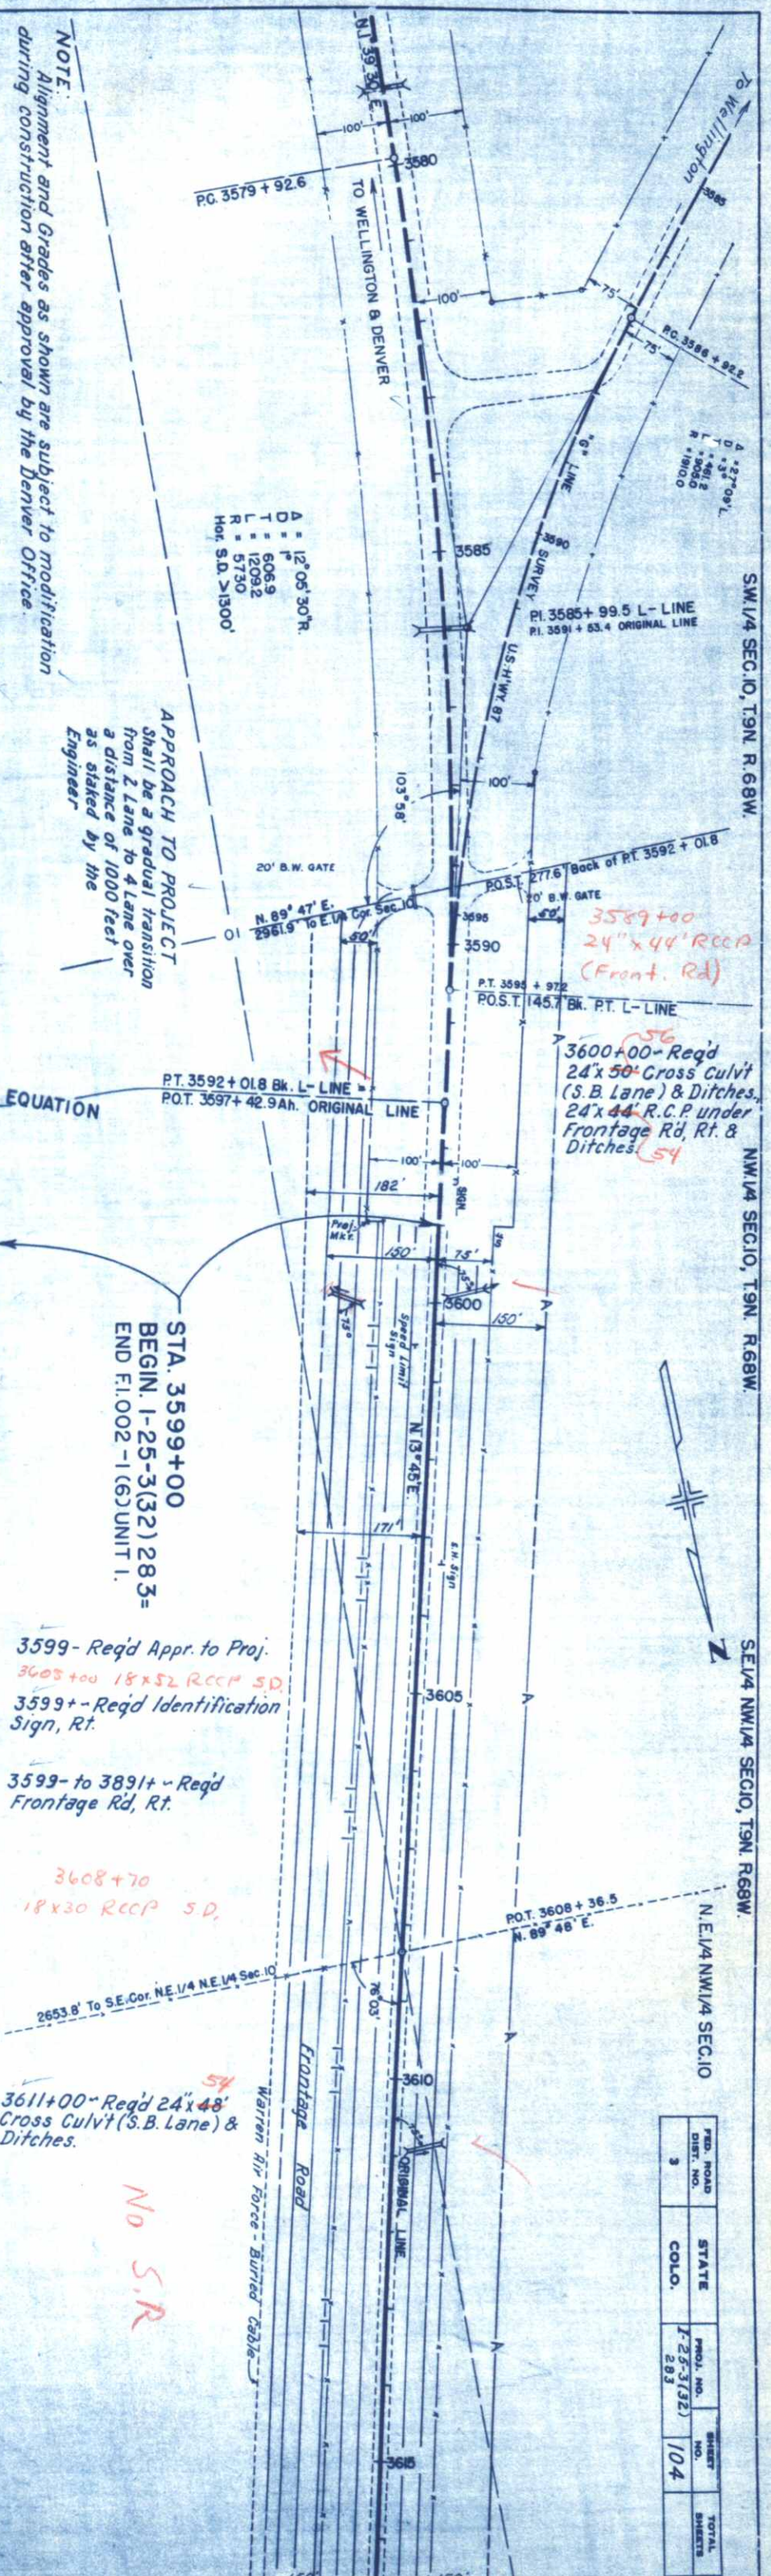


FED. ROAD DIST. NO.	STATE	PROJ. NO.	SHEET NO.	TOTAL SHEETS
3	COLO.	1-25-3(32) 283	104	

PLAN		BY	DATE
NOTE BOOK	SURVEYED		
	PLOTTED		
NO. 13271	ALIGNMENT CHECKED		
	WT. OF WAY CHECKED		

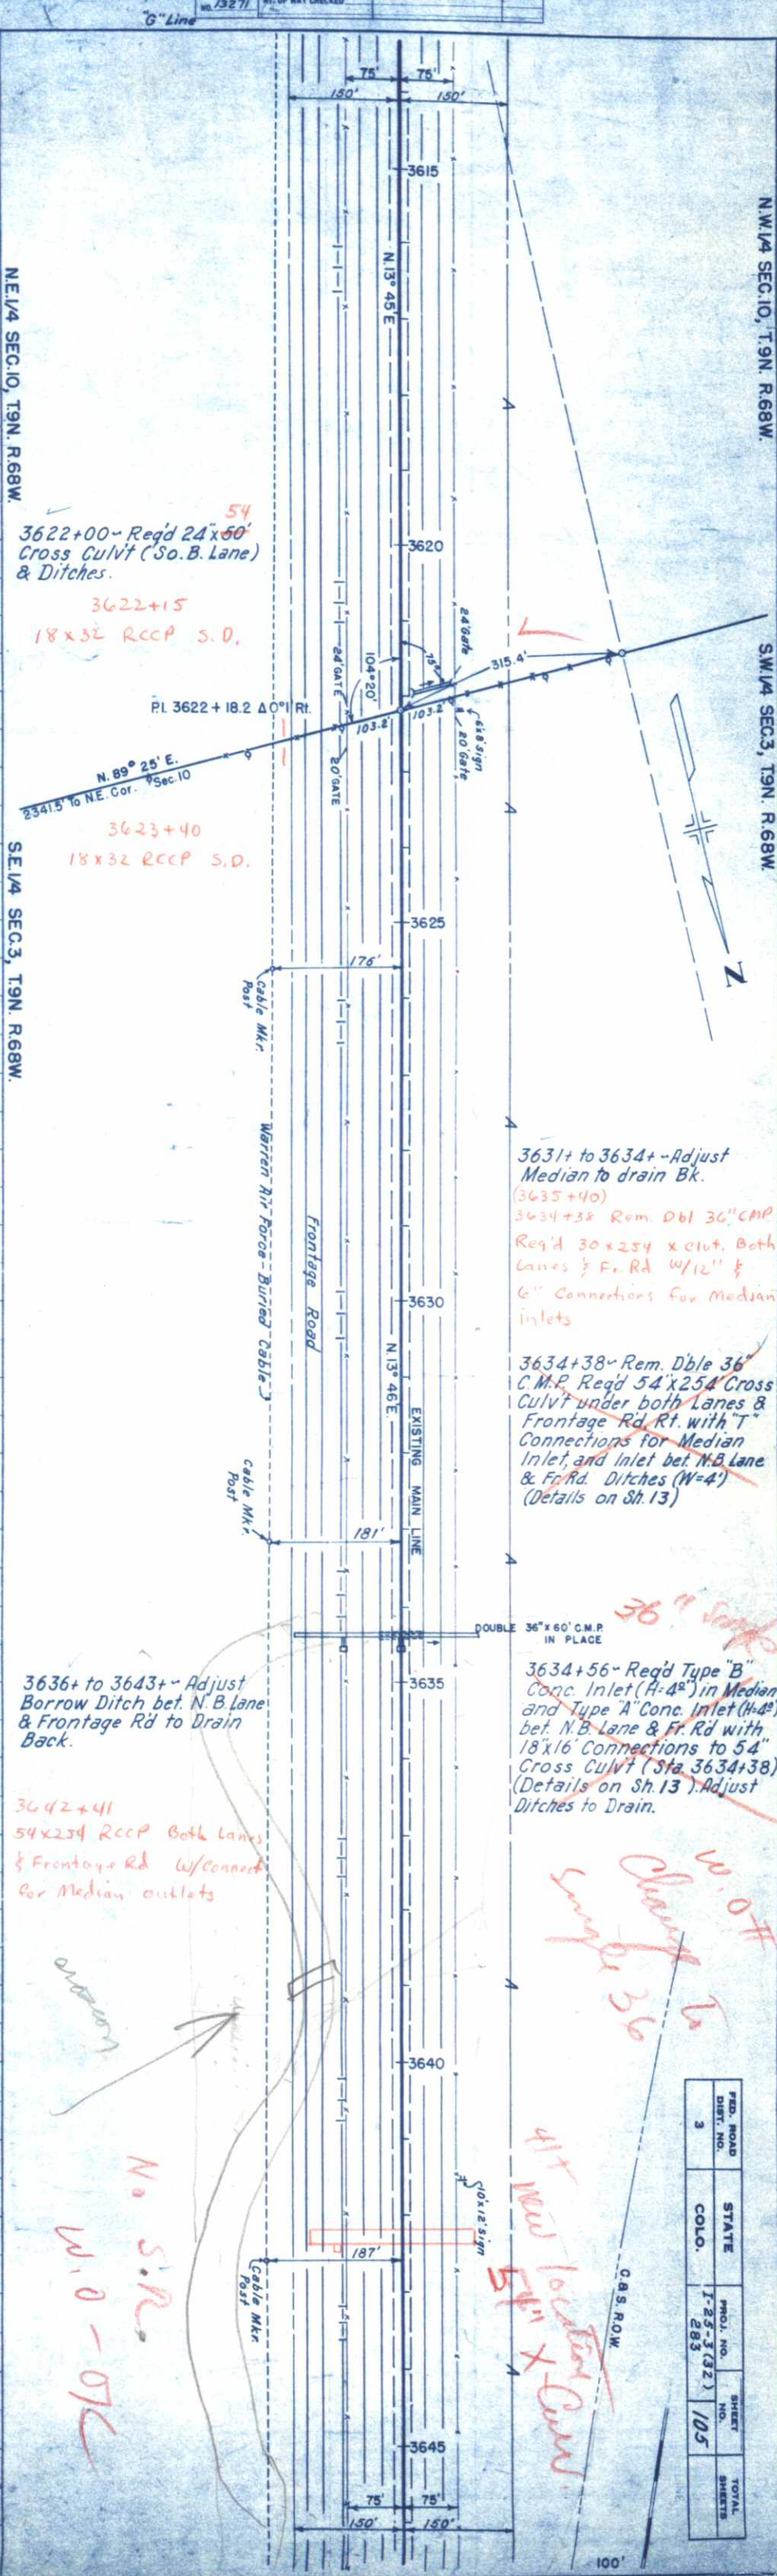

FED. ROAD DIST. NO.	STATE	PROJ. NO.	SHEET NO.	TOTAL SHEETS
3	COLO.	F-25-3(32) 283	105	



PLAN		BY	DATE
NOTE BOOK	SURVEYED		
NO. 13271	PLOTTED		
	ALIGNMENT CHECKED		
	RT. OF WAY CHECKED		

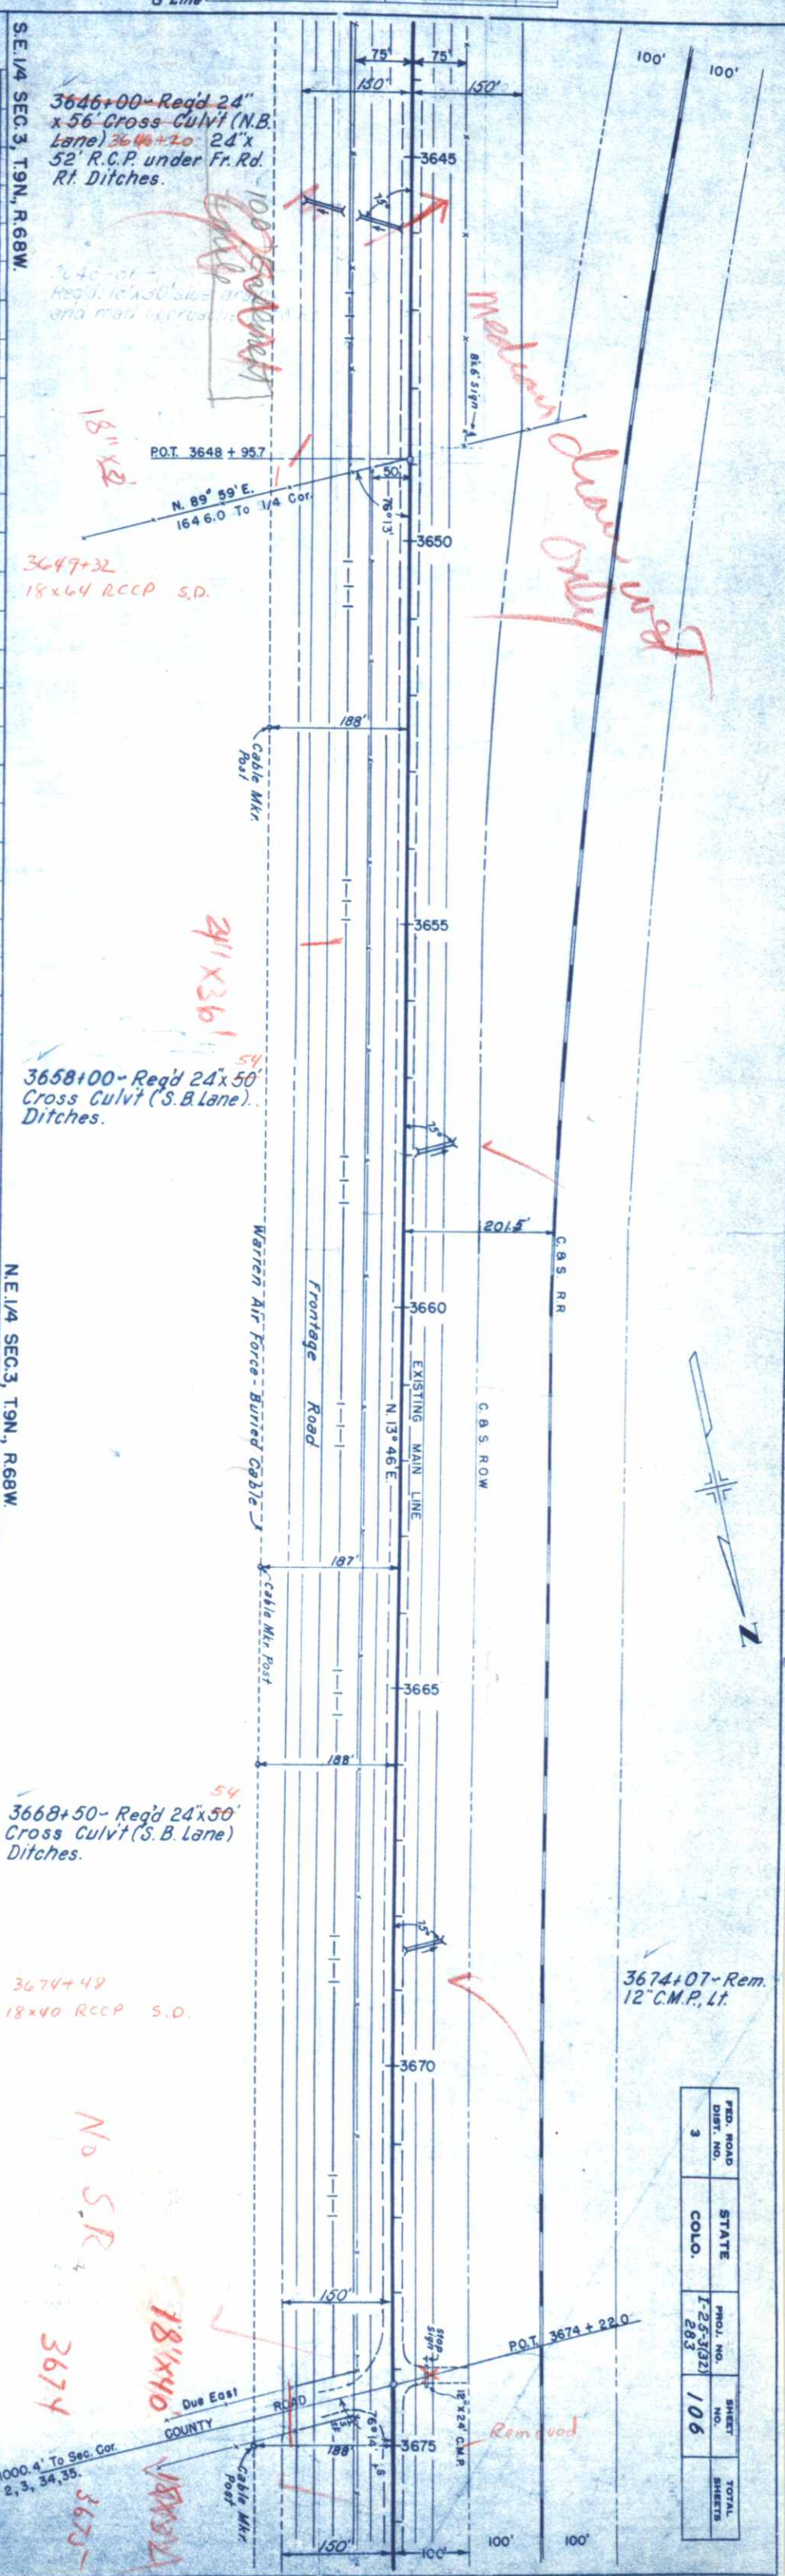

FED. ROAD DIST. NO.	STATE	PROJ. NO.	SHEET NO.	TOTAL SHEETS
3	COLO.	E-25-3(32) 283	106	

PROFILE	SURVEYED	BY	DATE
NOTE BOOK	PLOTTED		
NO. 13264	GRADES CHECKED		
	S.A. NOTED		
	STRUCTURE NOTATIONS ON VD		

PLAN	SURVEYED	BY	DATE
NOTE BOOK	PLOTTED		
NO. 13271	ALIGNMENT CHECKED		
	RT. OF WAY CHECKED		

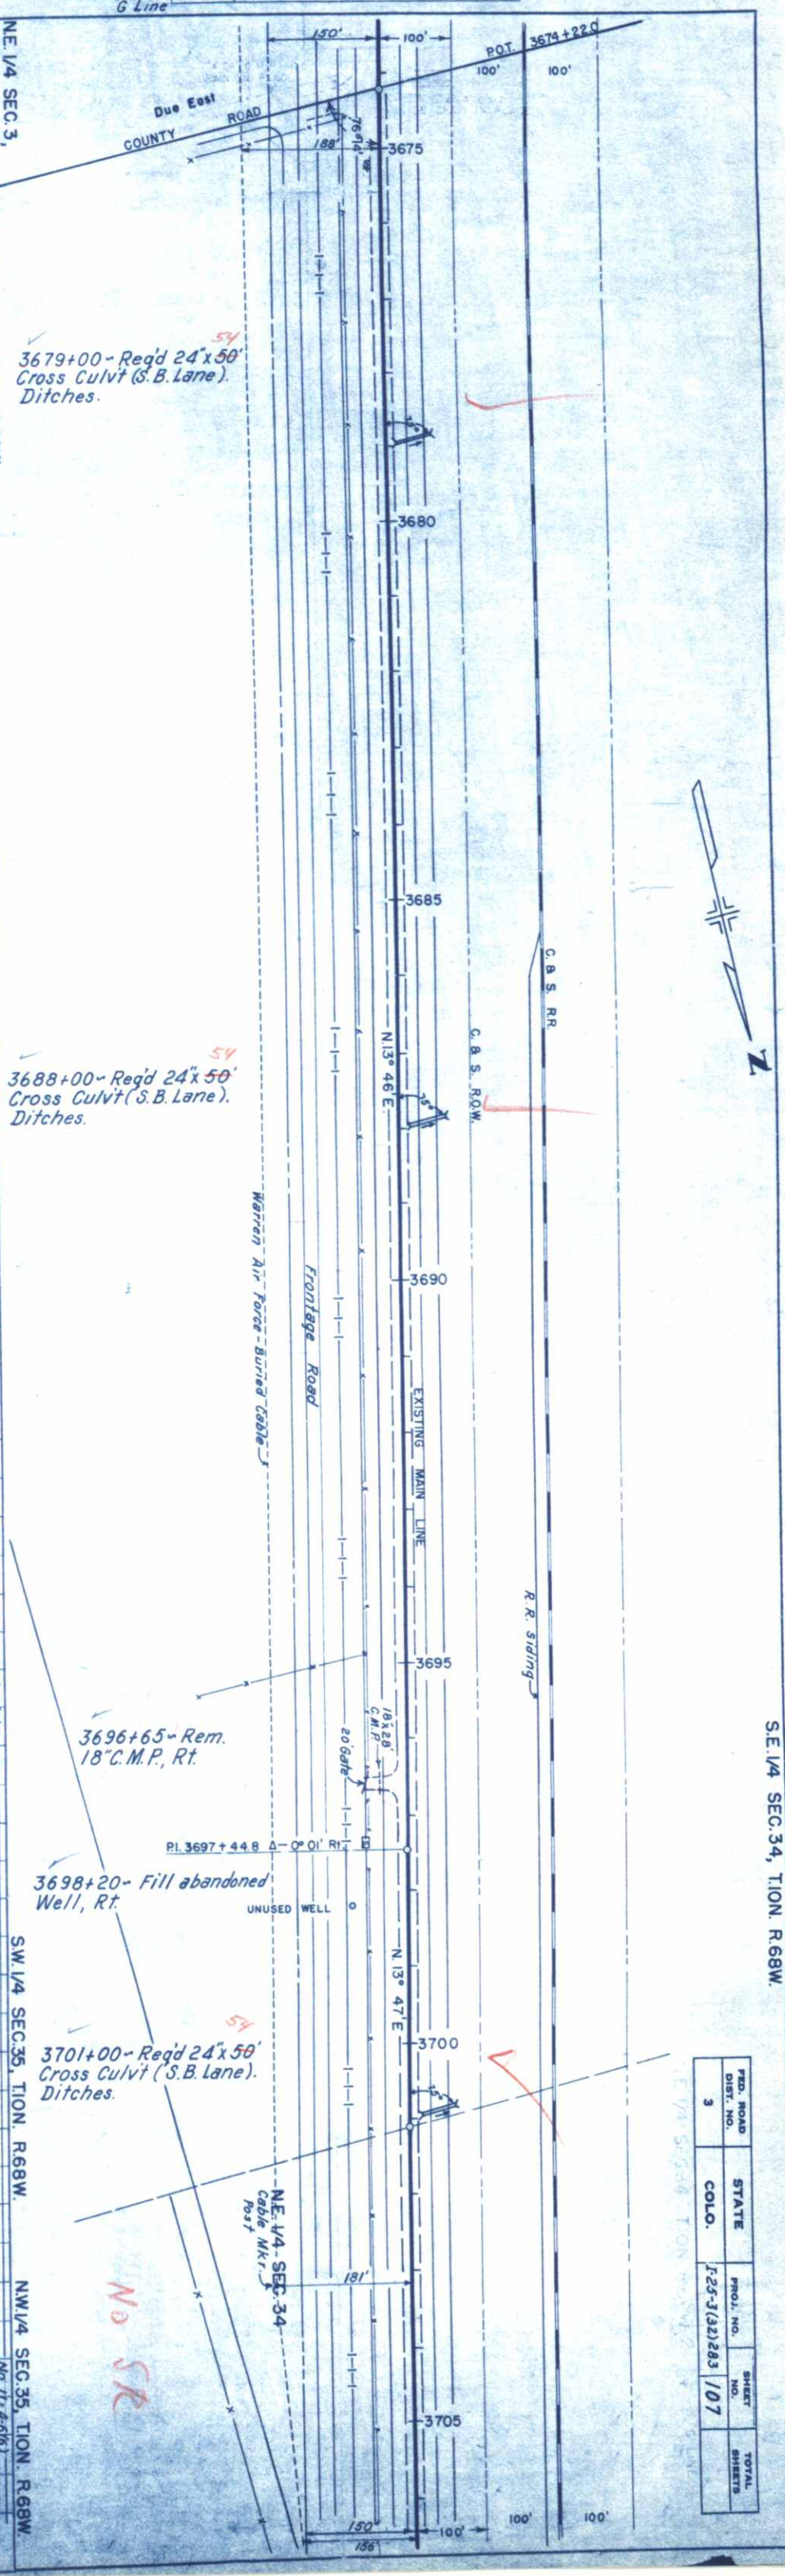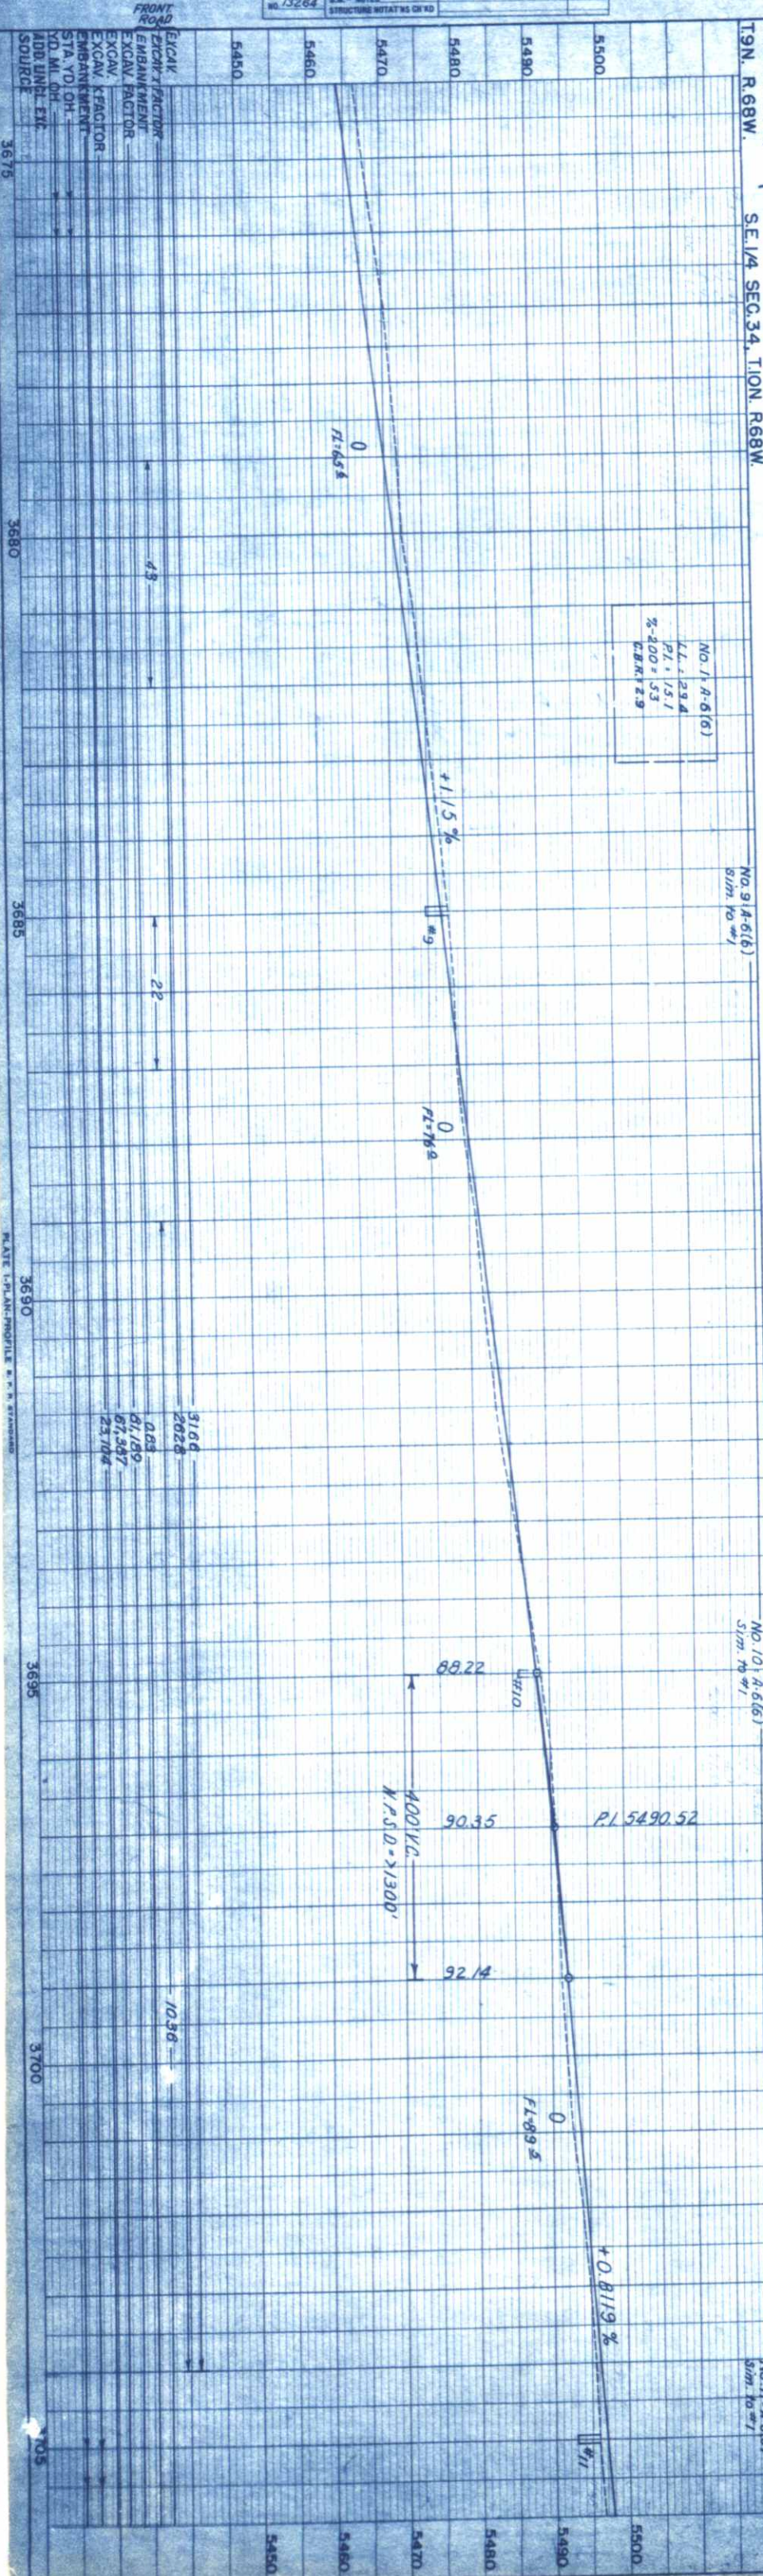

3679+00 ~ Reg'd 24"x50'
Cross Culvt (S.B. Lane).
Ditches.

3688+00 ~ Reg'd 24"x50'
Cross Culvt (S.B. Lane).
Ditches.

3696+65 ~ Rem.
18" C.M.P. Rt.

3698+20 ~ Fill abandoned
Well, Rt.


3701+00 ~ Reg'd 24"x50'
Cross Culvt (S.B. Lane).
Ditches.

FED. ROAD DIST. NO.	STATE	PROJ. NO.	SHEET NO.	TOTAL SHEETS
3	COLO.	F-25-J(32)283	107	

S.E. 1/4 SEC. 34, T.10N. R.68W.

PROFILE	SURVEYED	BY	DATE
NOTE BOOK	PLOTTED		
NO. 13264	GRADES CHECKED		
	N.B. - NOTED		
	STRUCTURE DETAILS OK'D		

PLAN	SURVEYED	BY	DATE
NOTE BOOK	PLOTTED		
NO. 13271	ALIGNMENT CHECKED		
	RT. OF WAY CHECKED		

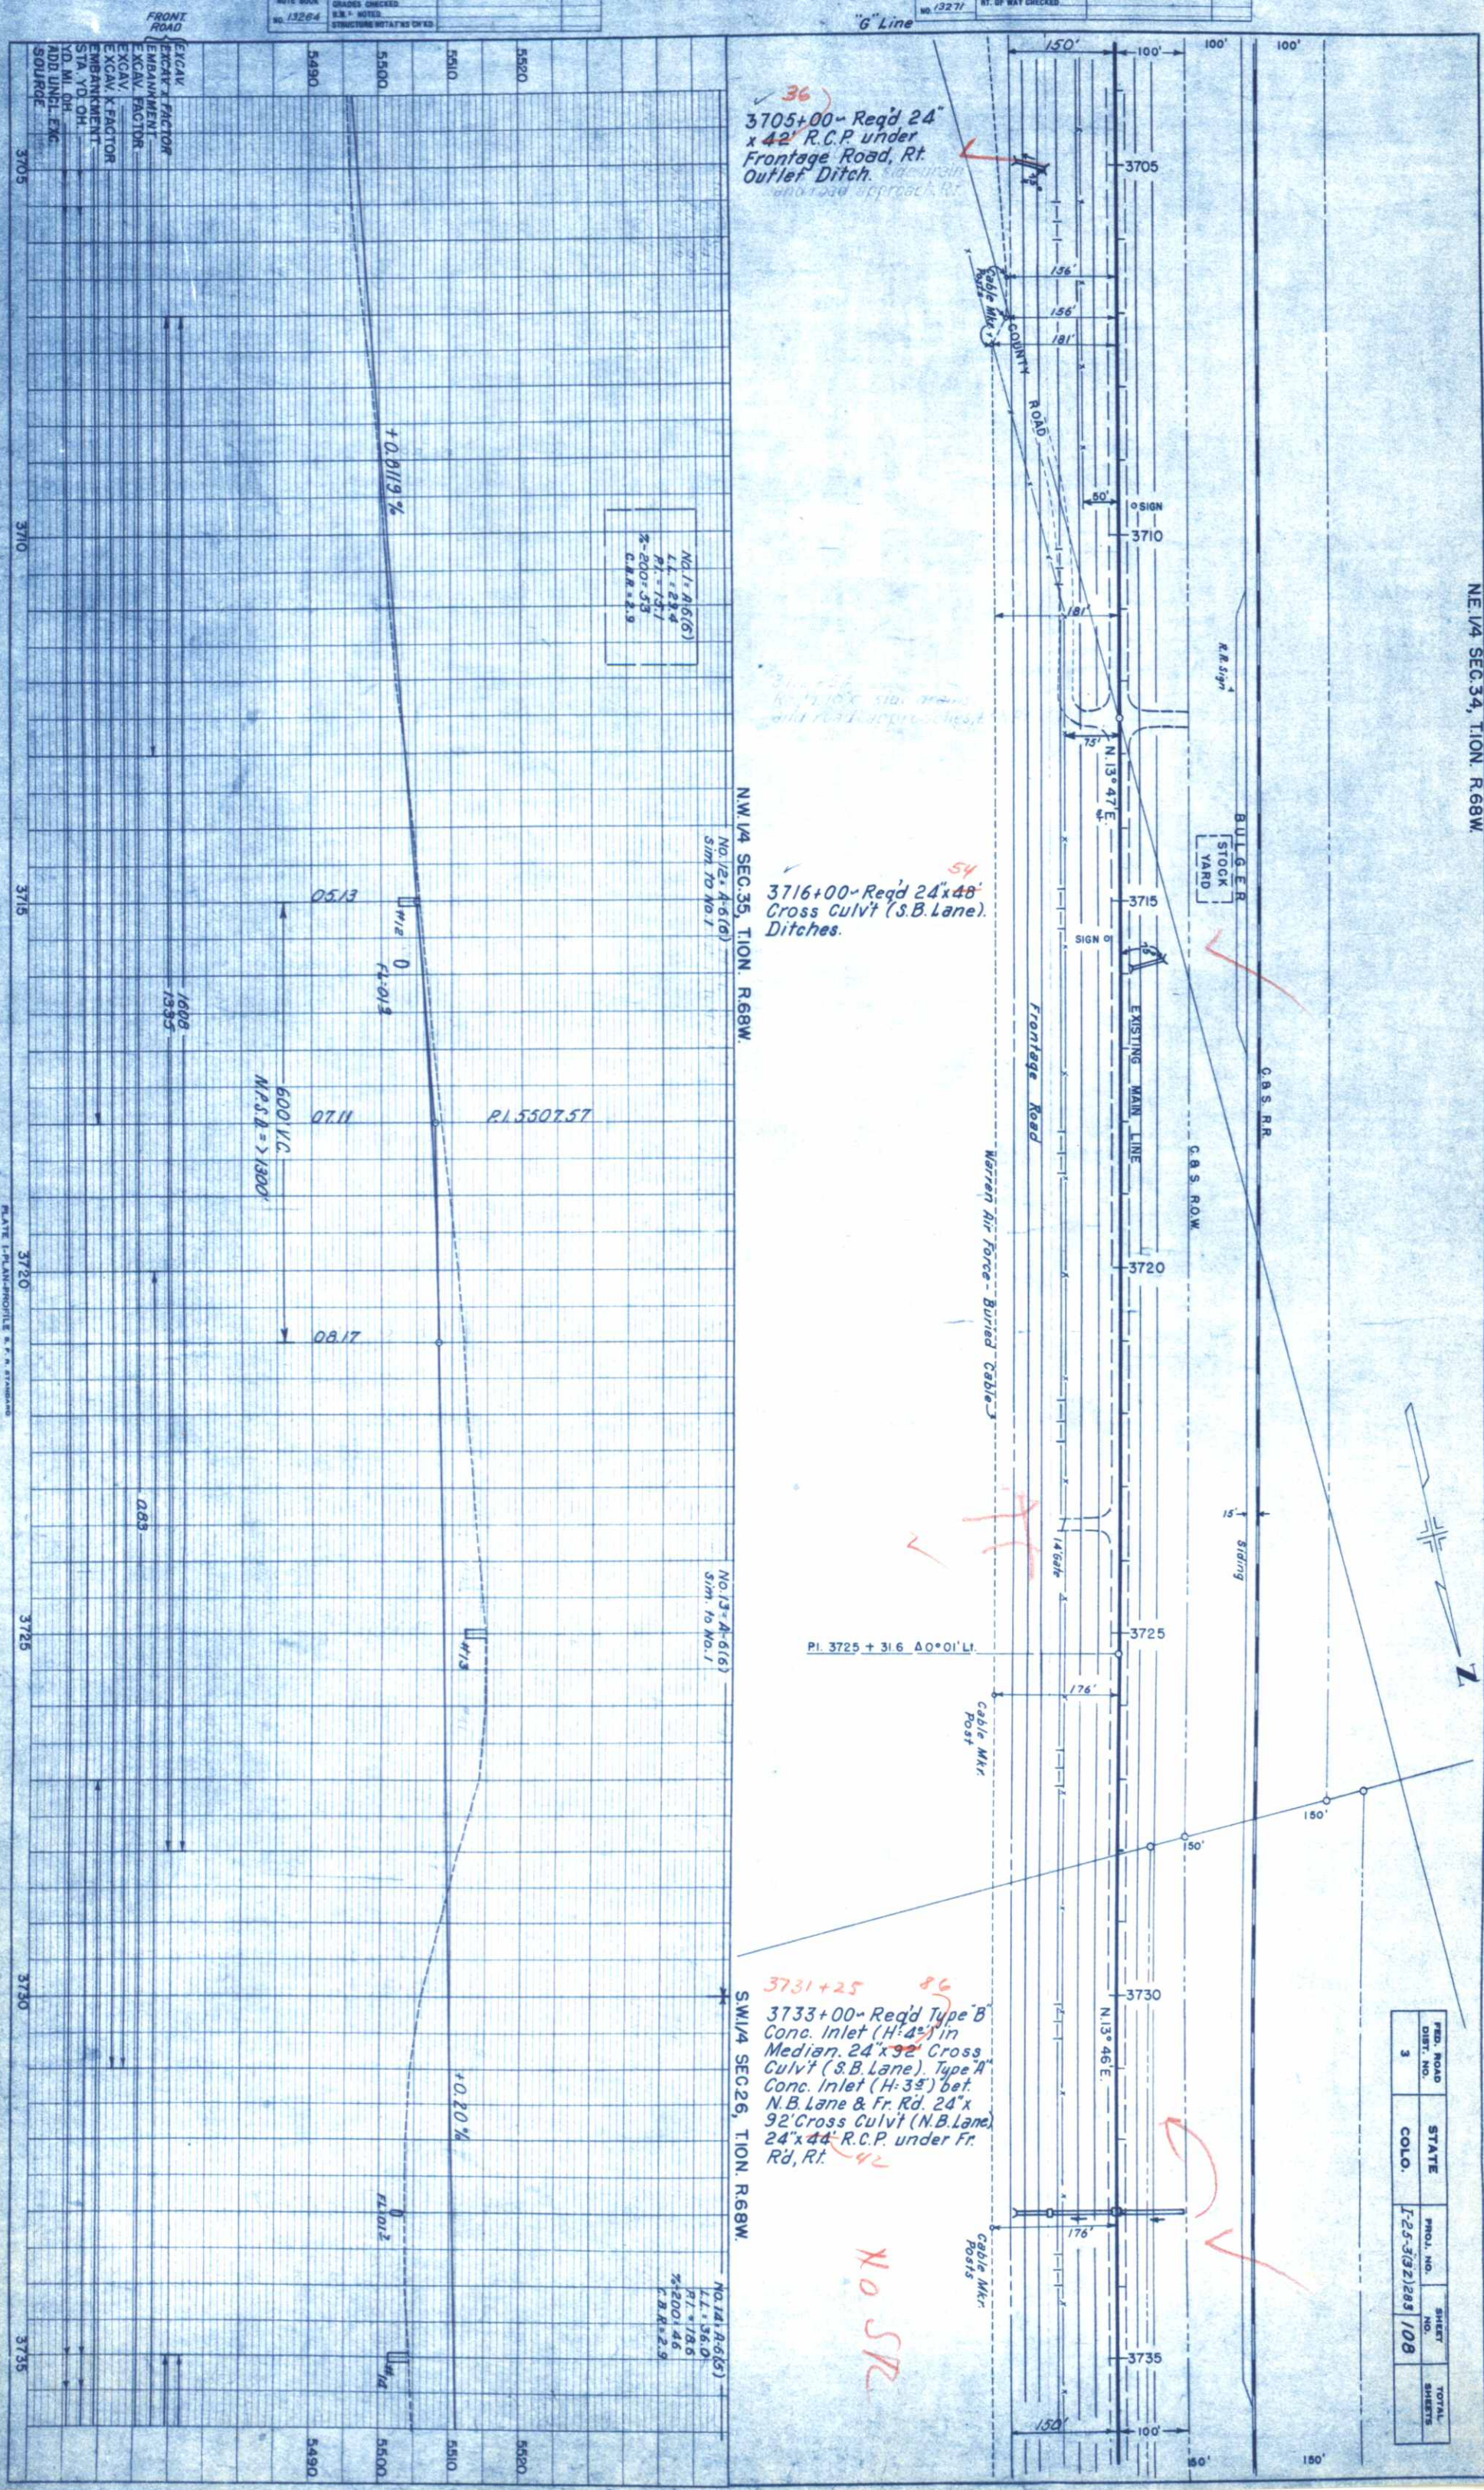


NE 1/4 SEC. 34, T10N R68W

FED. ROAD DIST. NO.	STATE	PROJ. NO.	SHEET NO.	TOTAL SHEETS
3	COLO.	1-25-3(32)283	106	

PROFILE	SURVEYED	BY	DATE
NOTE BOOK	PLOTTED		
NO. 13271	GRADES CHECKED		
	S.A. NOTES		
	STRUCTURE NOTATIONS CHECKED		

PLAN	SURVEYED	BY	DATE
NOTE BOOK	PLOTTED		
NO. 13271	ALIGNMENT CHECKED		
	RT. OF WAY CHECKED		

"G" Line

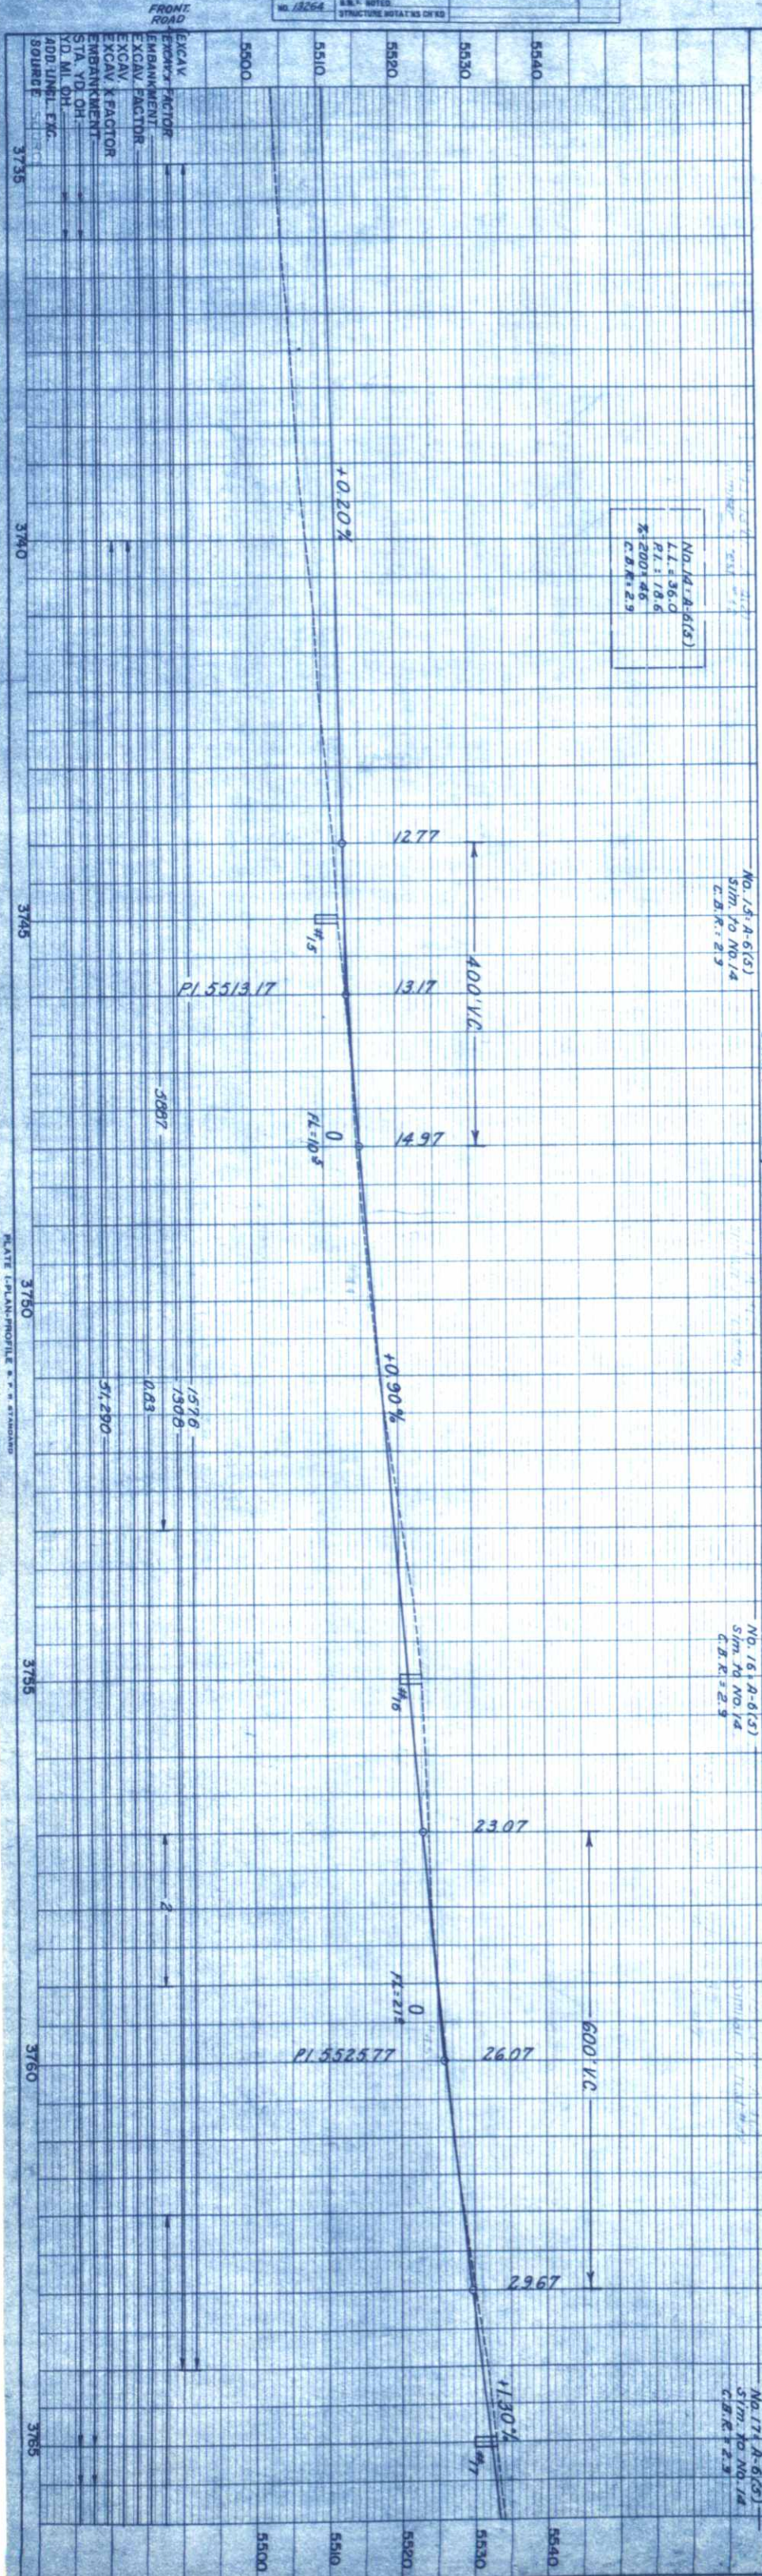

SW 1/4 SEC. 26, TION. R68W


NW 1/4 SEC. 26, TION. R68W

3748+00- Req'd 24'x52' Cross Culv't (N.B. Lane). 24'x42' R.C.P. under Fr. Rd. Rt. Ditches.

3753+25 18x34 RCCP S.D.

3759+50- Req'd 24'x52' Cross Culv't (N.B. Lane). 24'x42' R.C.P. under Fr. Rd. Rt. Ditches.


No. 572

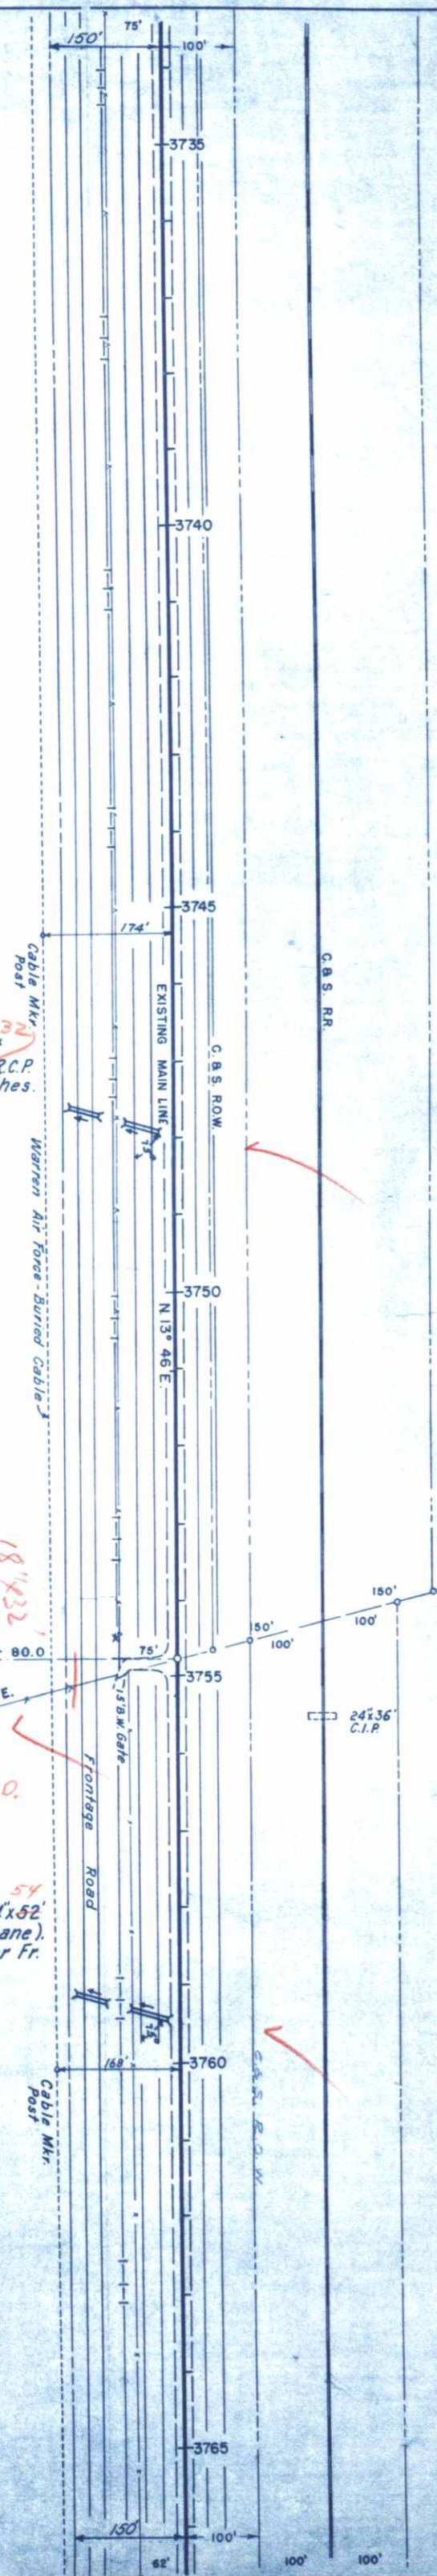

FED. ROAD DIST. NO.	STATE	PROJ. NO.	SHEET NO.	TOTAL SHEETS
3	COLO.	I-25-3(32)283	109	

PROFILE	SURVEYED	BY	DATE
NOTE BOOK	PLOTTED		
NO. 13264	GRADES CHECKED		
	S.M.N. NOTED		
	STRUCTURE NOTATIONS OK'D		

PLAN	SURVEYED	BY	DATE
NOTE BOOK	PLOTTED		
NO. 13271	ALIGNMENT CHECKED		
	RT. OF WAY CHECKED		

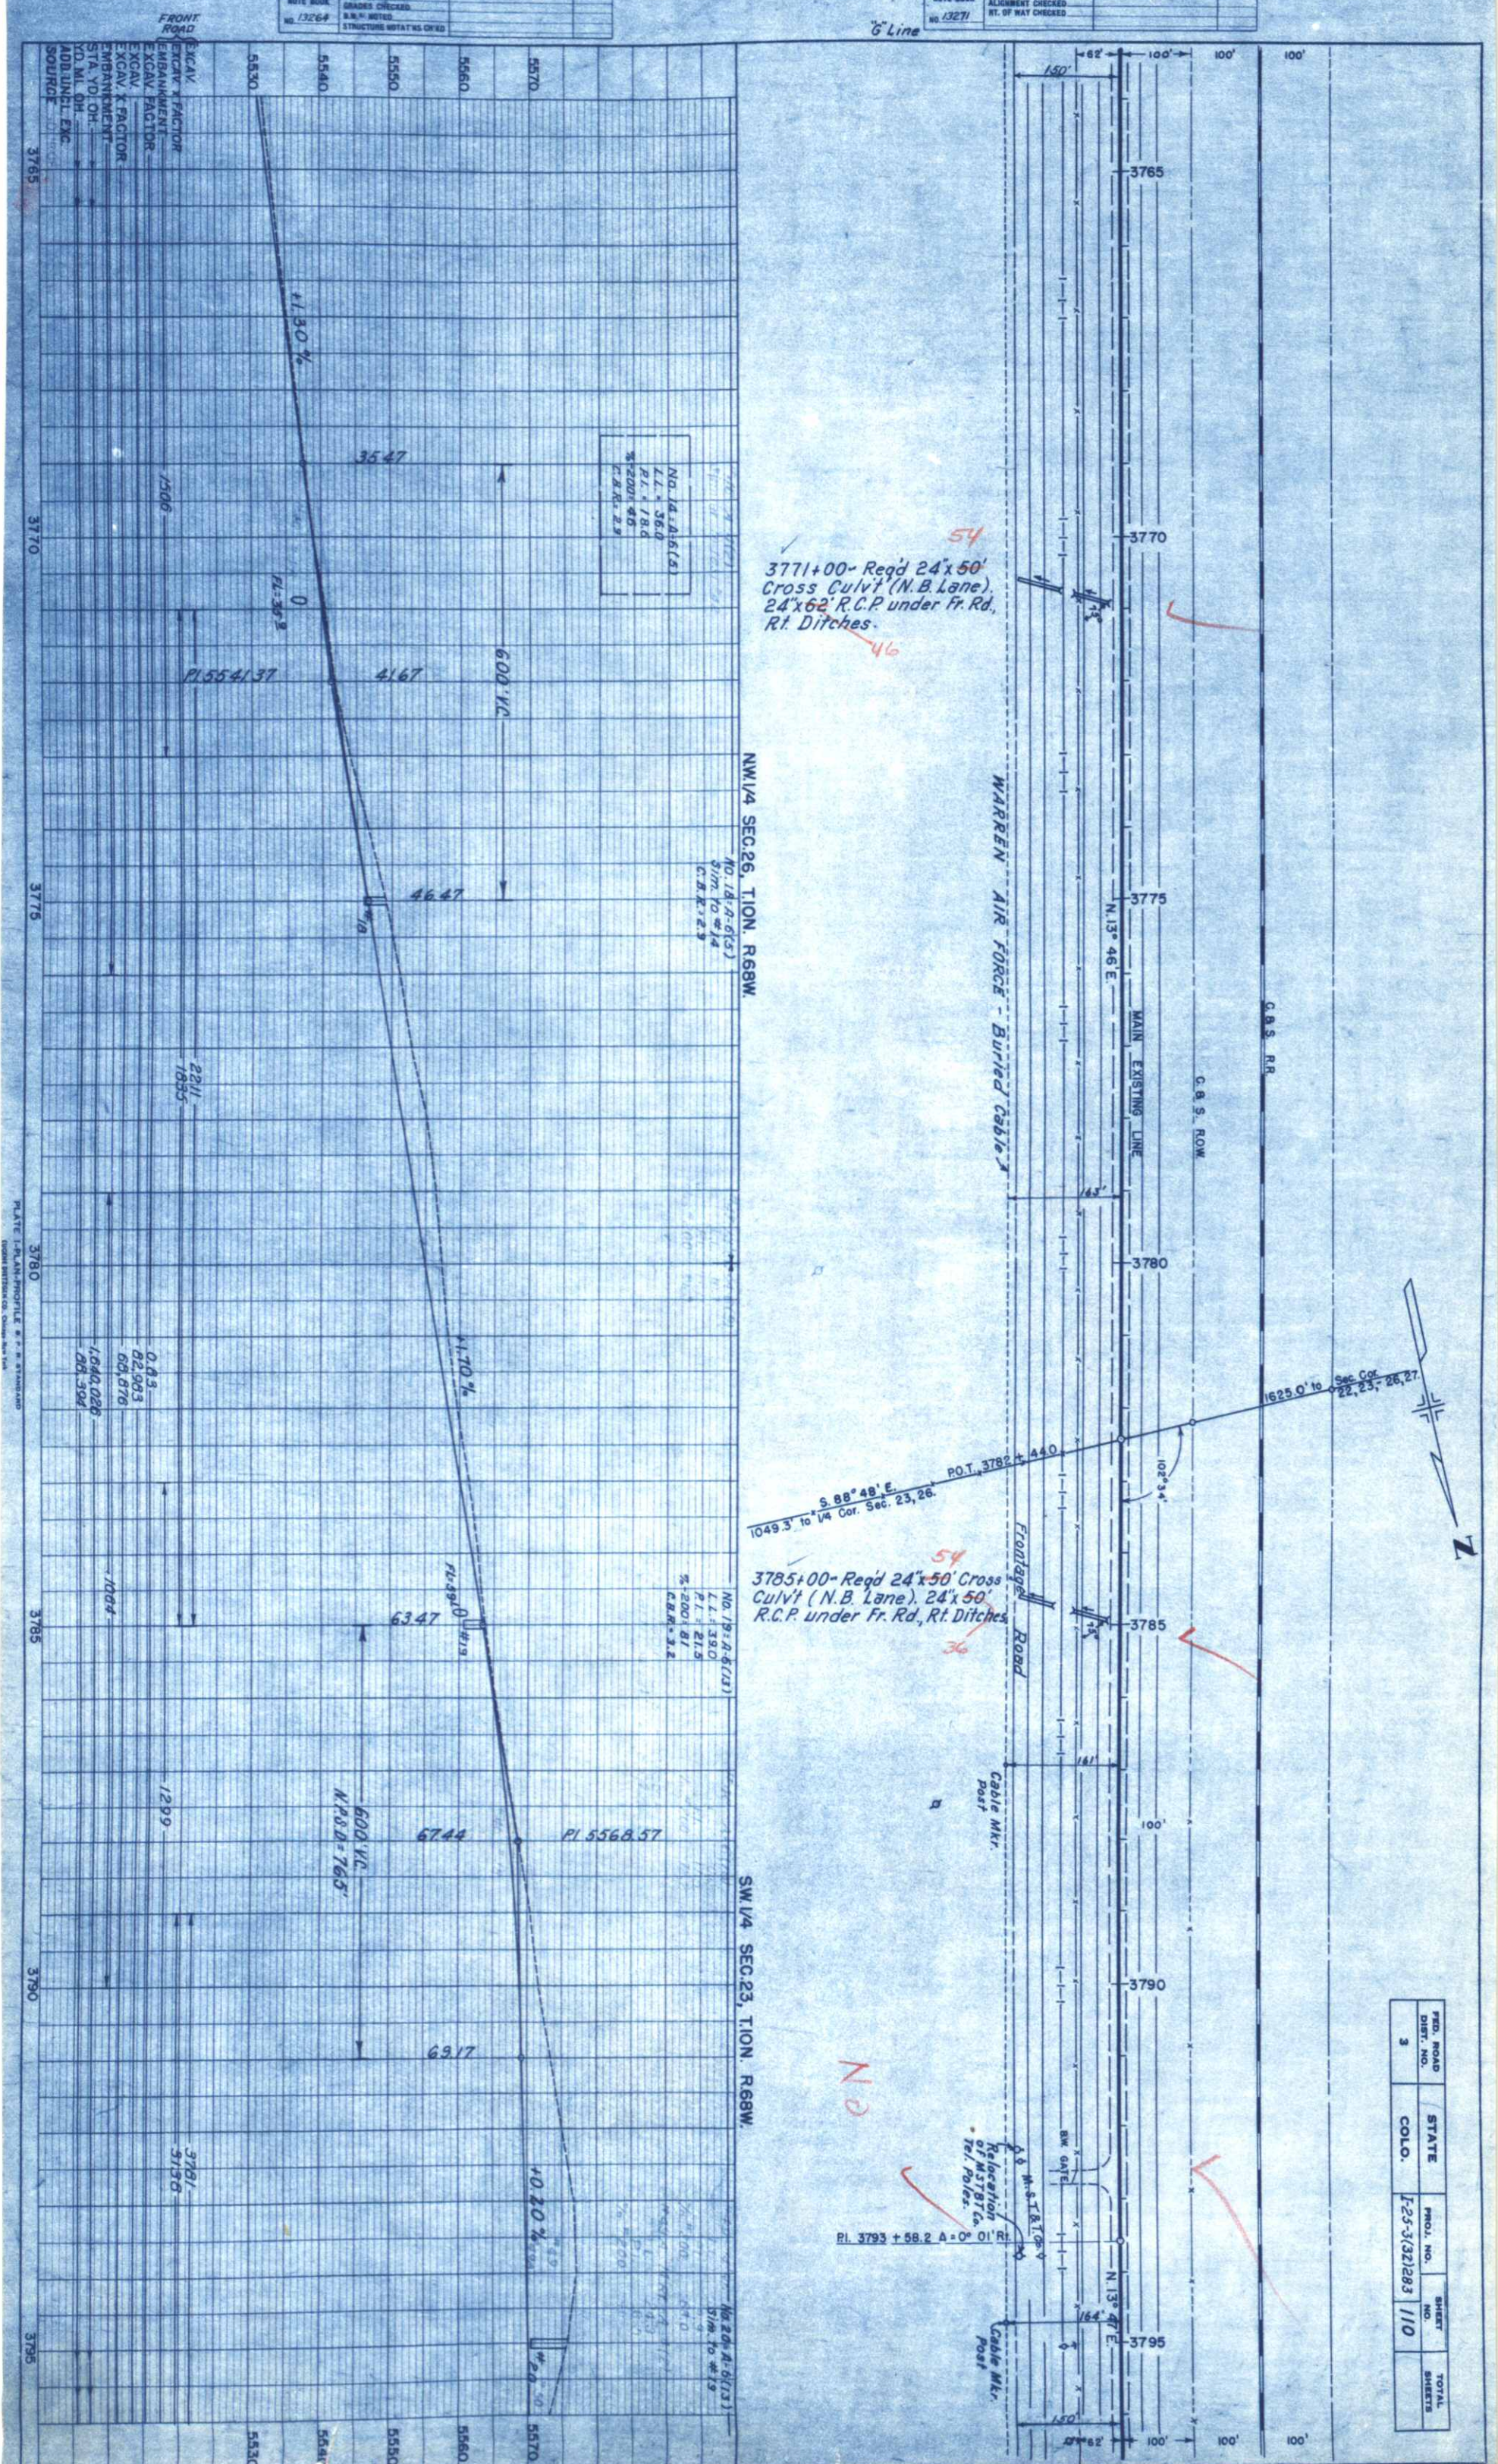

3771+00- Req'd 24"x50' Cross Culvert (N.B. Lane), 24"x62" R.C.P. under Fr. Rd, Rt. Ditches.

3785+00- Req'd 24"x50' Cross Culvert (N.B. Lane), 24"x50" R.C.P. under Fr. Rd, Rt. Ditches.


FEED. ROAD	STATE	PROJ. NO.	SHEET NO.	TOTAL SHEETS
3	COLO.	I-23-3(32)283	110	

PROFILE	SURVEYED	DATE
NOTE BOOK	PLOTTED	
13264	GRADES CHECKED	
13265	R.M. NOTED	
	STRUCTURE NOTATIONS CHECKED	

PLAN	SURVEYED	DATE
NOTE BOOK	PLOTTED	
13271	ALIGNMENT CHECKED	
13272	RT. OF WAY CHECKED	

FRONT ROAD

"G" Line

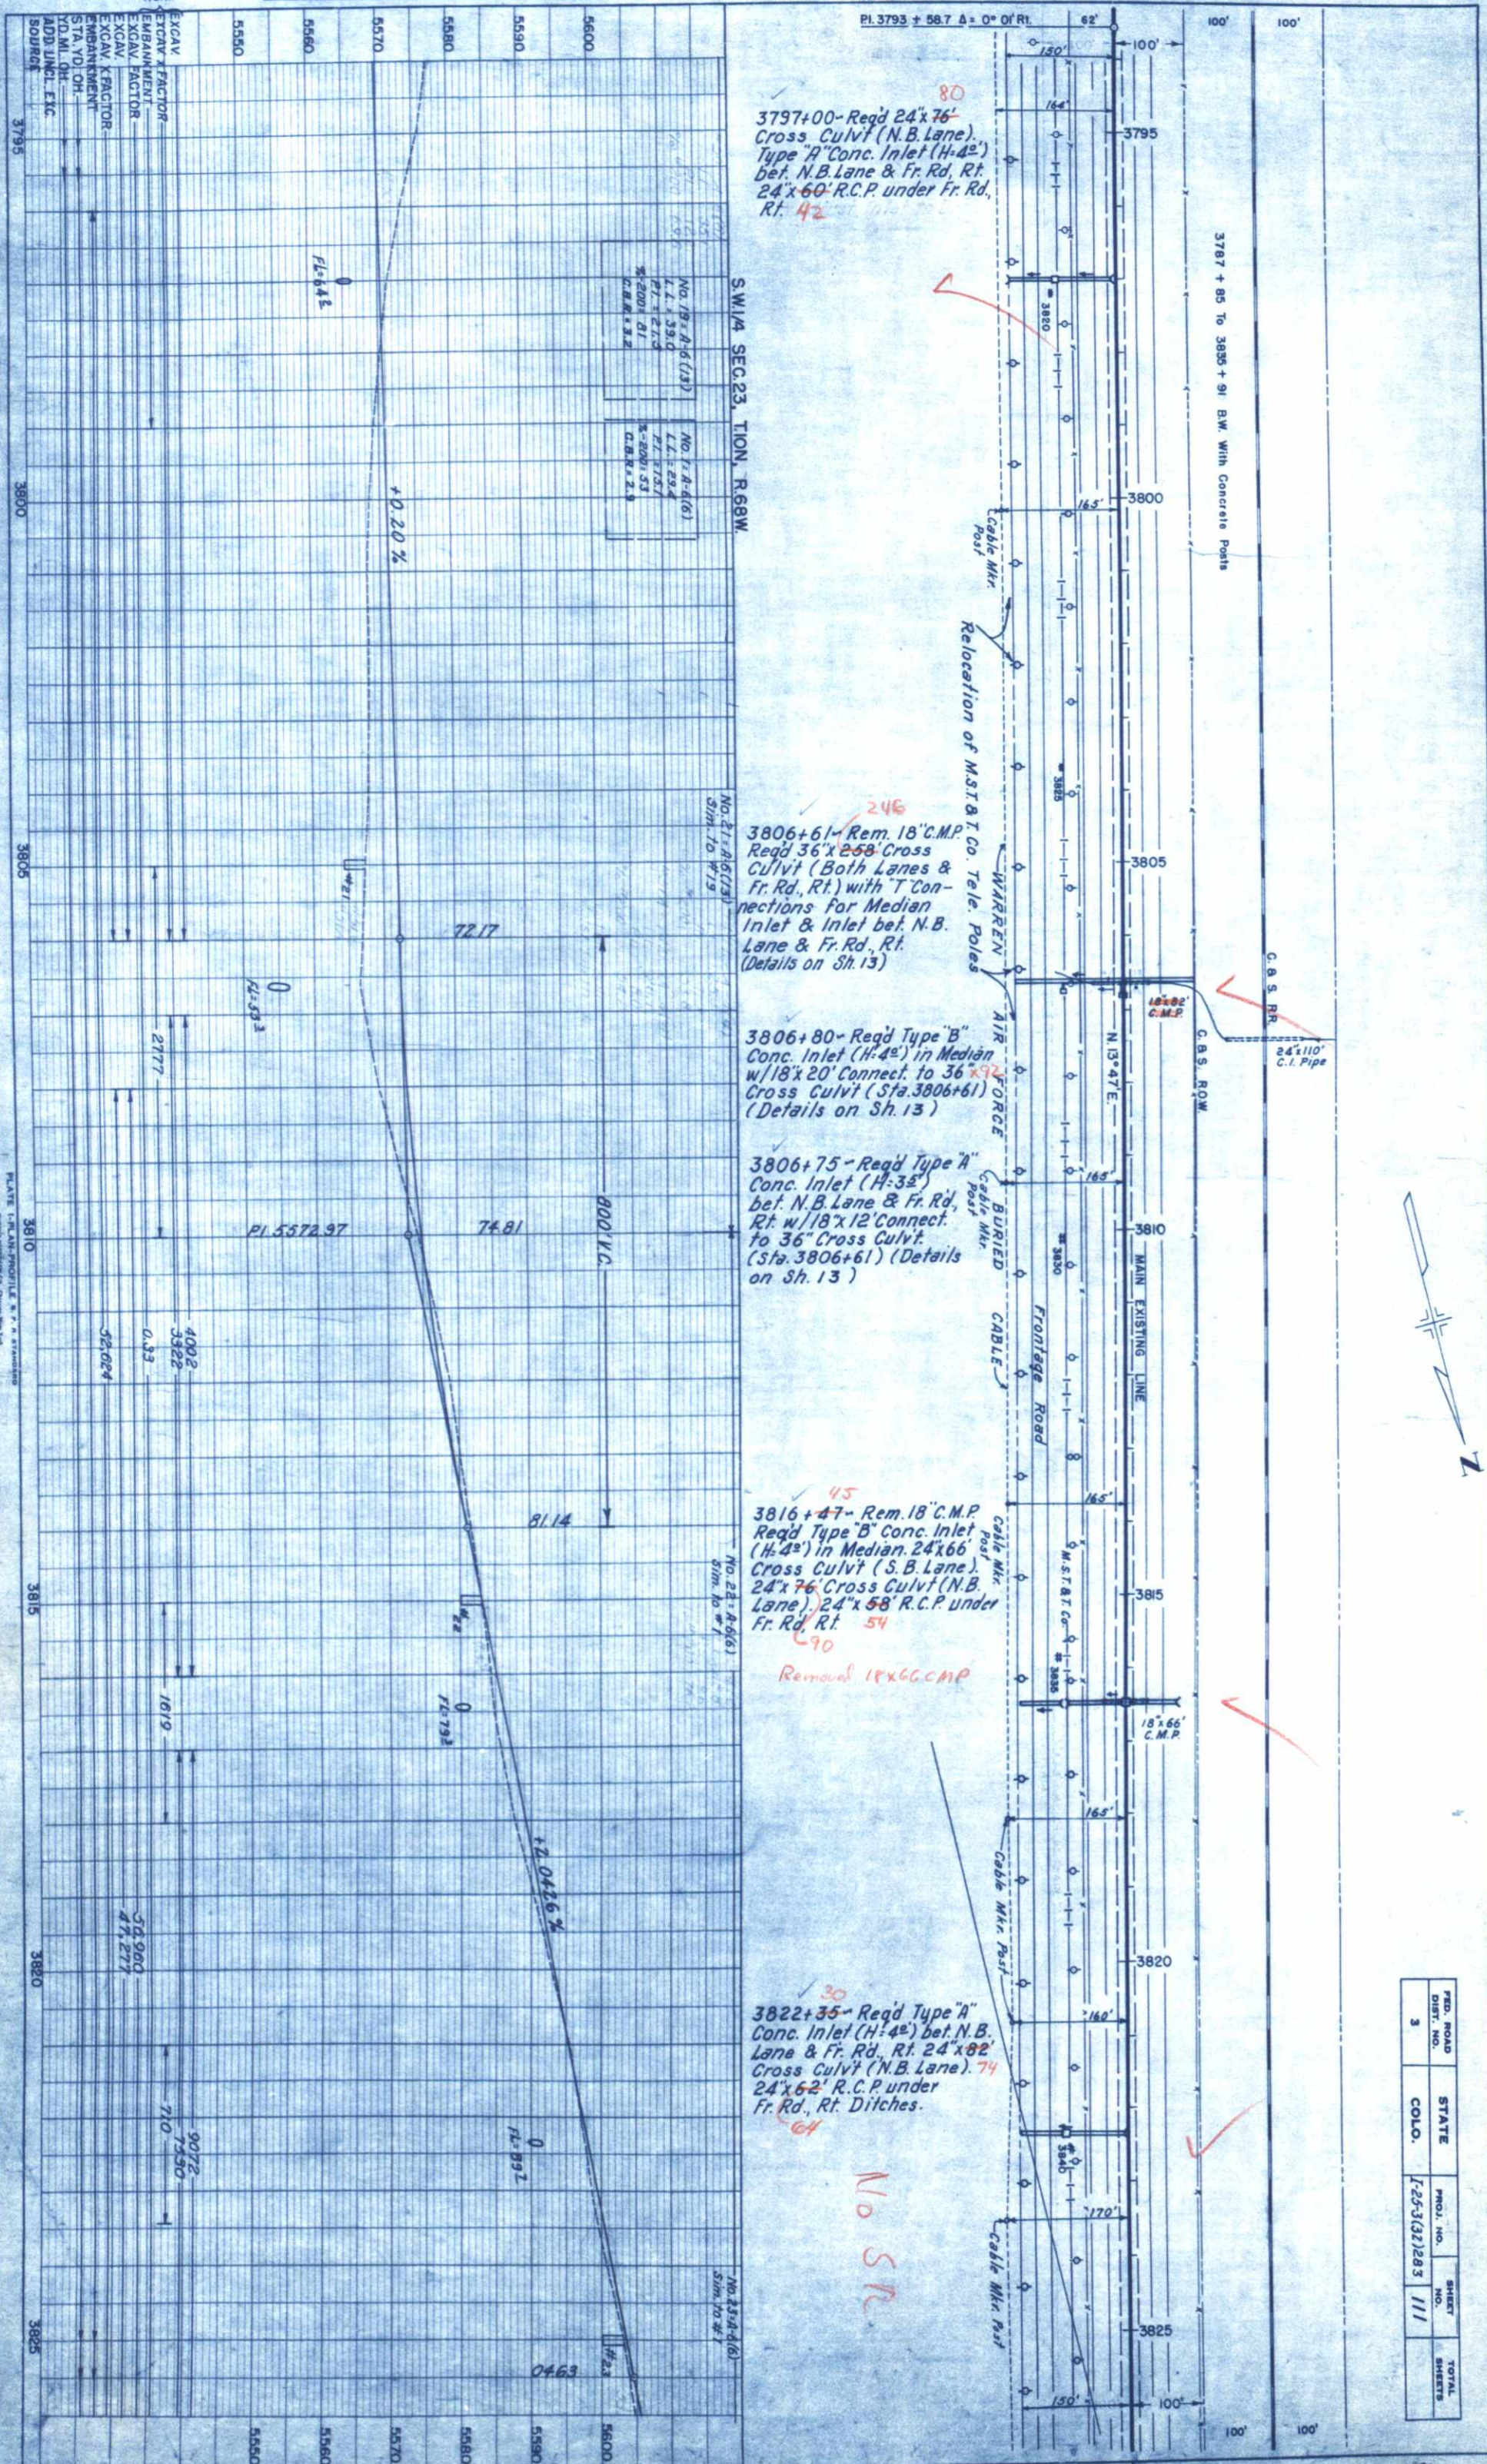


FED. ROAD DIST. NO.	STATE	PROJ. NO.	SHEET NO.	TOTAL SHEETS
3	COLO.	1-25-3(32)283	111	

PROFILE	DATE
SURVEYED	
NOTE BOOK	
NO. 13605	
STRUCTURE NOTATION ON RD	

PLAN	DATE
SURVEYED	
NOTE BOOK	
NO. 13605	
ALIGNMENT CHECKED	
RT. OF WAY CHECKED	

PLATE 1-PLAN, PROFILE & P. H. STANDARD

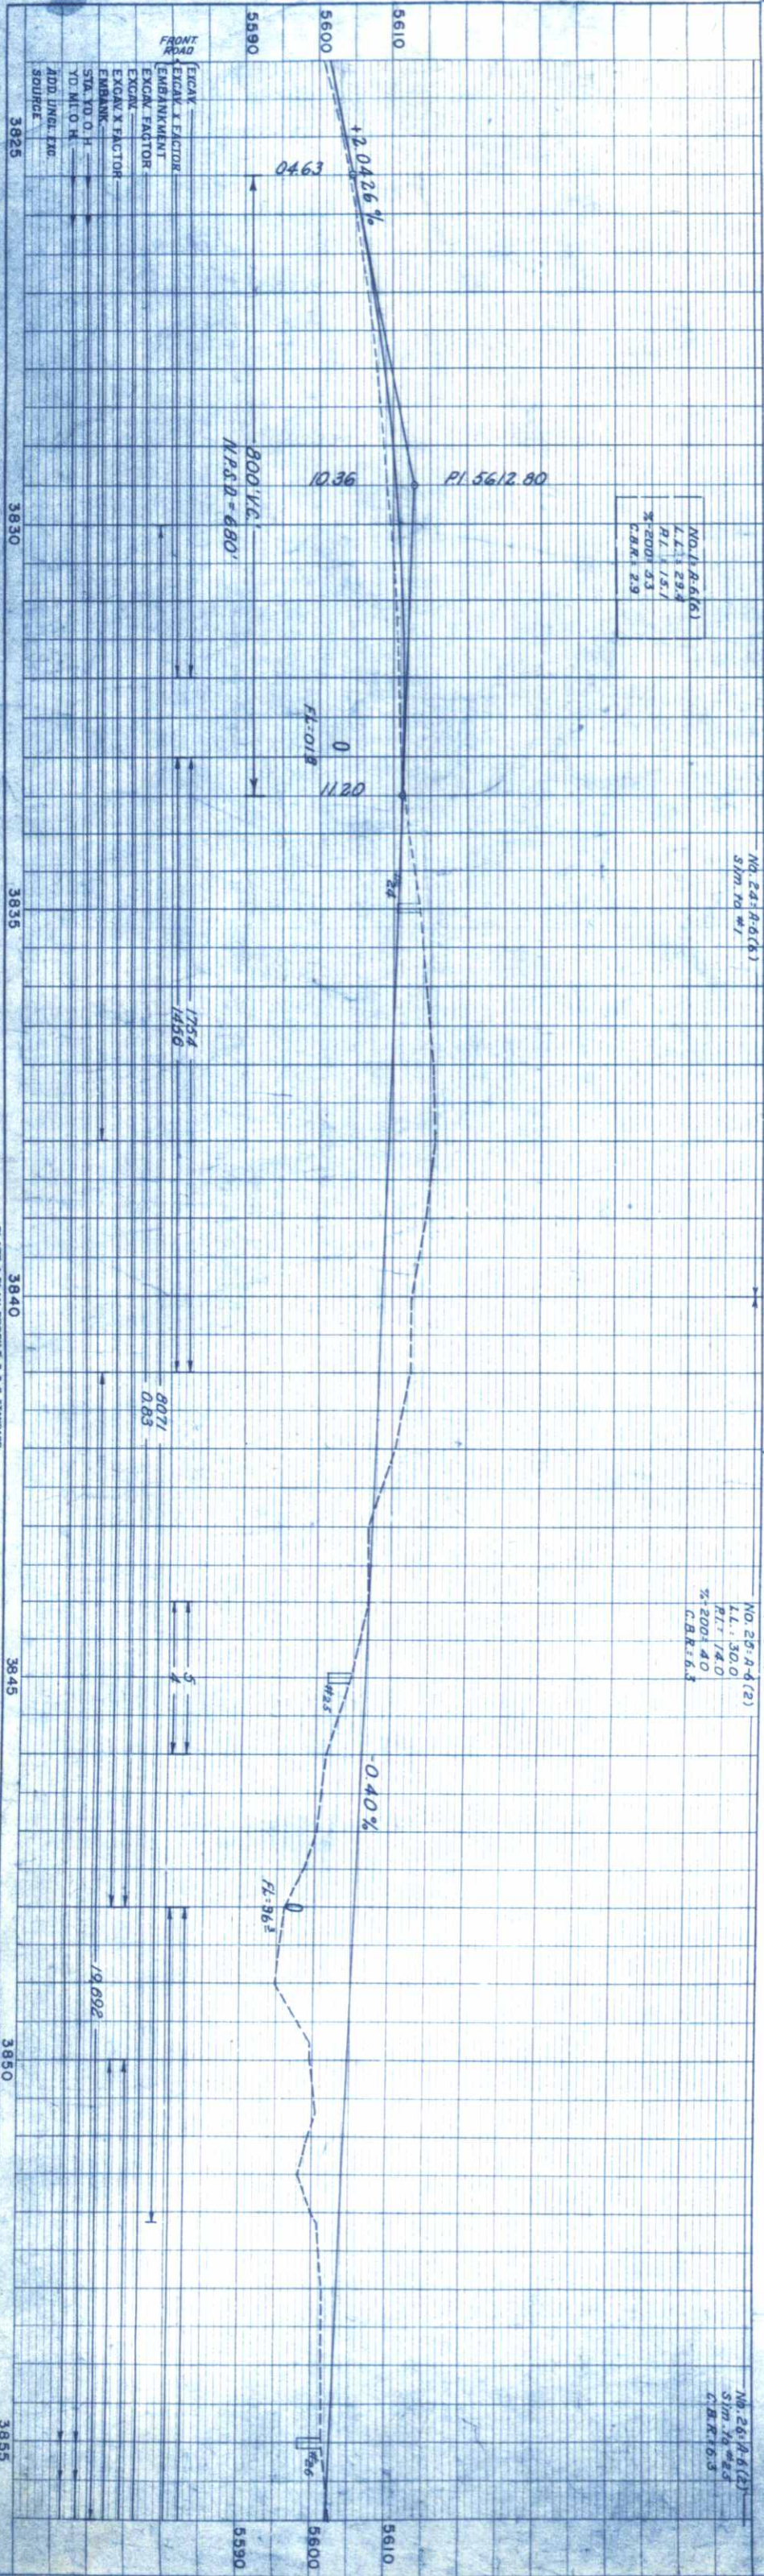


3832+82 - Rem. 18" C.M.P.
Reqd 24'x230' Cross
Culvt (Both Lanes &
Fr. Rd, Rt.). Inlet Ditch.

3832+3834 - Adjust
Ditch bet. N.B. Lane &
Fr. Rd, Rt. to Drain.

S.E. 1/4 SEC. 14 T. 10N. R. 68 W.

3848+00 - Req'd Type "B"
Conc. Inlet (4'-4") in Median.
24'x68' Cross Culvt (S. B.
Lane) & 24'x84' (N.B. Lane).
24'x50' R.C.P. under Fr Rd,
Rt. 5L

NO

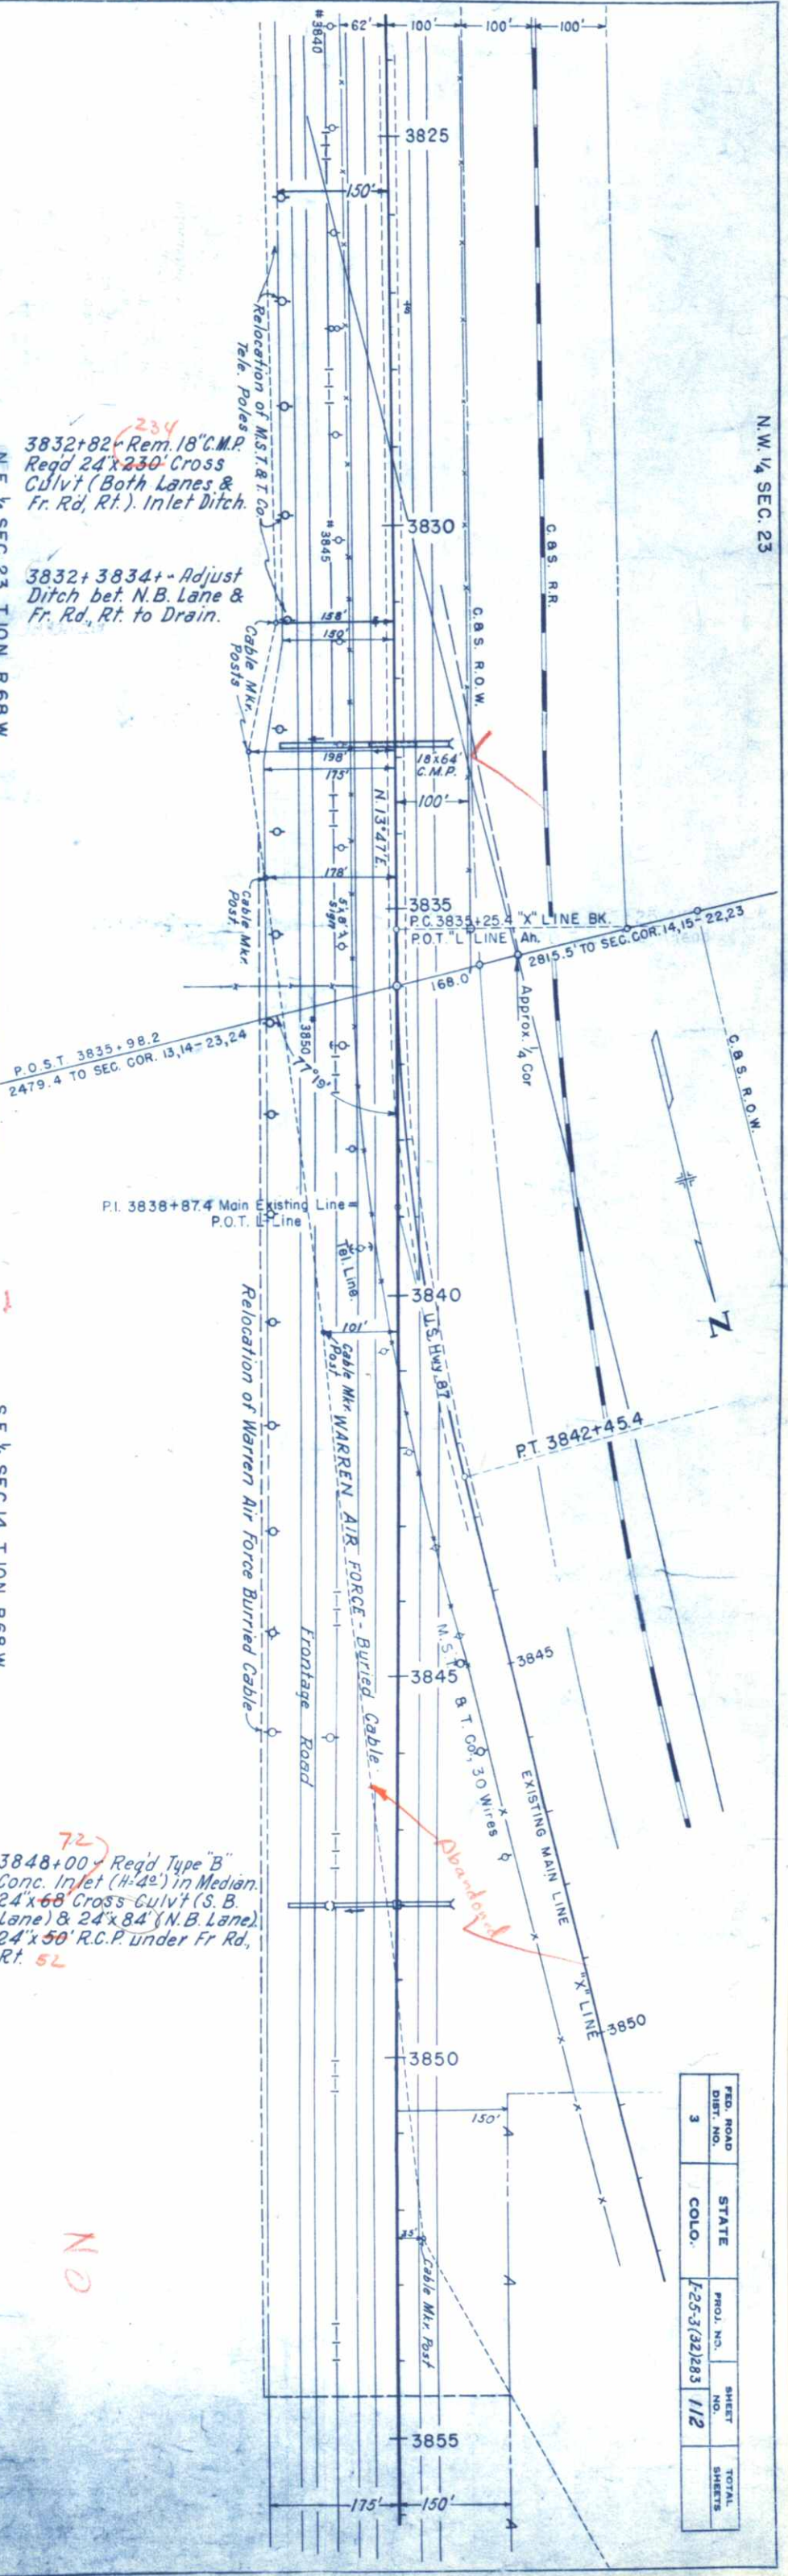


PROJ. ROAD	STATE	PROJ. NO.	SHEET	TOTAL
3	COLO.	125-3(32)283	112	SHEETS

PROFILE	SURVEYED	BY	DATE
NOTE BOOK	PLOTTED		
NO. 13605	GRADES CHECKED		
	STRUCTURE NOTATION CHECKED		

PLAN	SURVEYED	BY	DATE
NOTE BOOK	PLOTTED		
NO. 13605	ALIGNMENT CHECKED		
	RT. OF WAY CHECKED		

2" Line

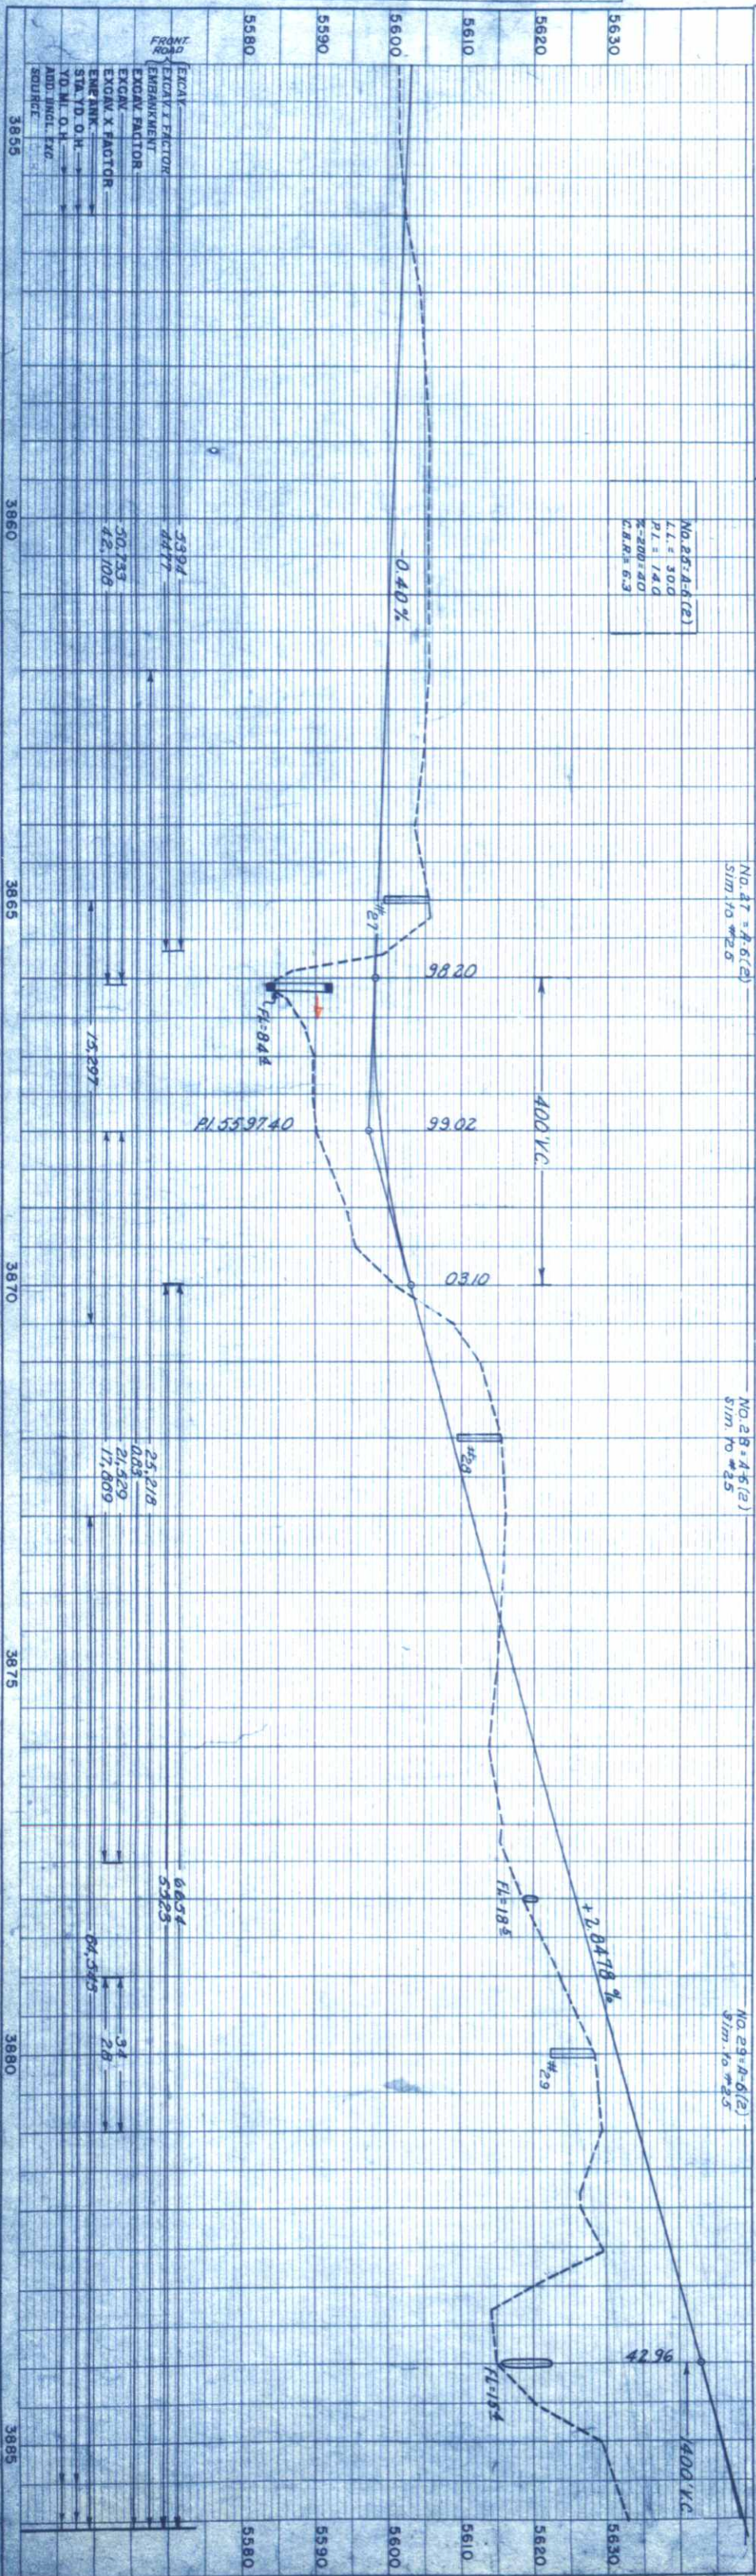

S.E. 1/4 SEC. 14

N.E. 1/4 SEC. 14 T. 10 N. R. 68 W.


3867+30

3885+00

3866+09- Req'd Special Dble 8'x7'x243' C.B.C. No. 13 Inlet Grating & Frame in top of C.B.C. in Median & No. 13 Inlet (H=24) with Grating & Frame on top of C.B.C. bet N.B. Lane & Fr. Rd., Rt. Ditches (W=20') Inlet only (Details on Sh. 13) (Str. No. A-17-g) (" " A-17-h) (" " A-17-i)

3878+00- Req'd 24"x92" Cross Culvt (S.B. Lane) & 24"x80" (N.B. Lane). 24"x44" R.C.P. under Fr. Rd. Rt. Ditches.



3884+00- Req'd 84"x52" x-548' Cross Culvt (Both Lanes, Ramps Lt. & Rt.). 84"x136" R.C.P. under Fr. Rd. Rt. Ditches (W=12')

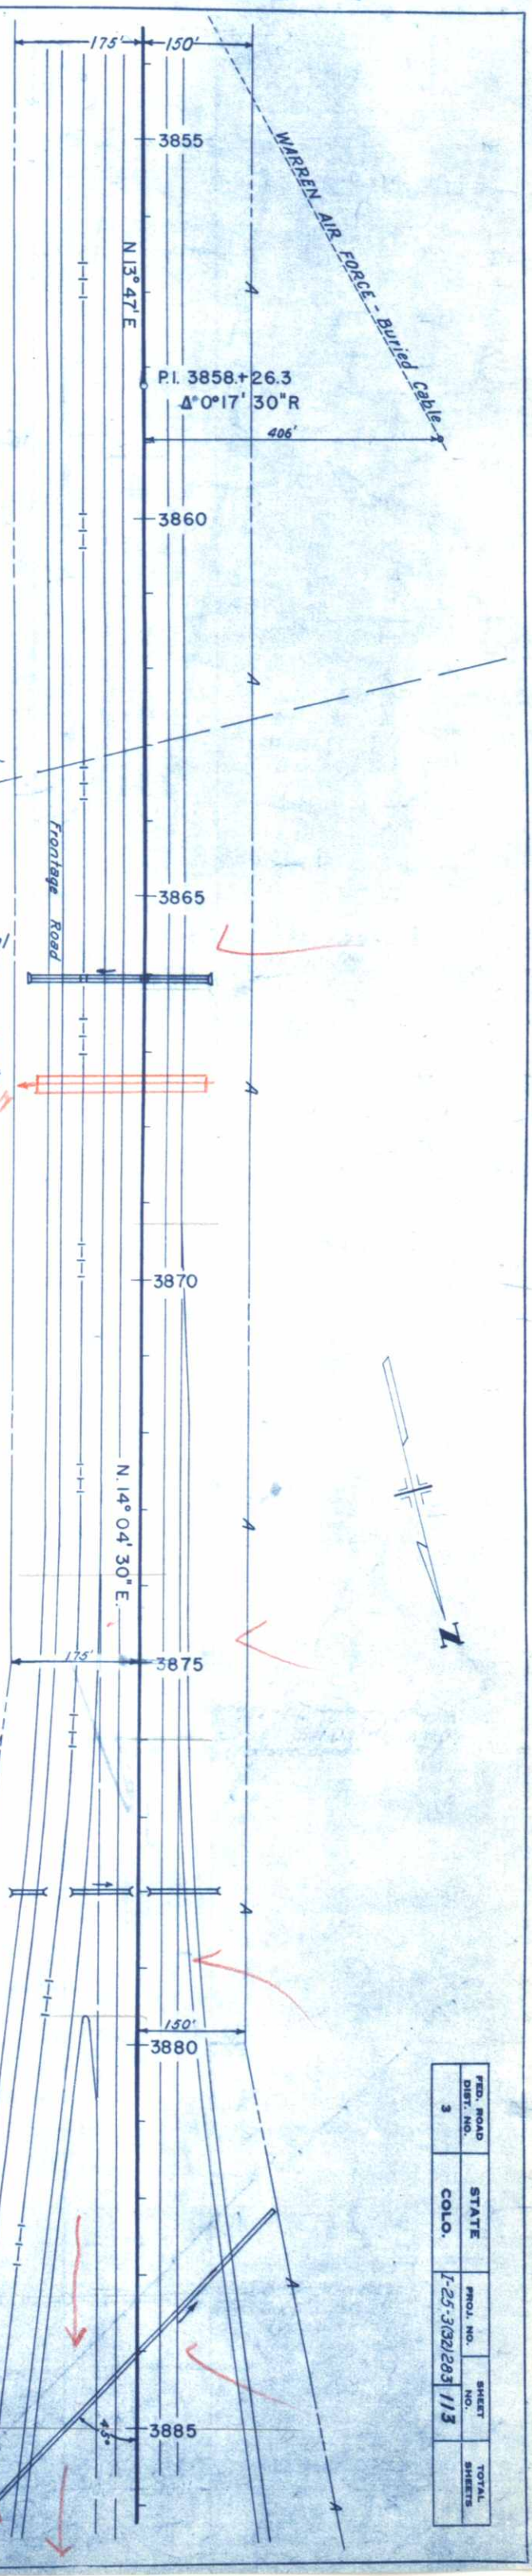

FED. ROAD DIST. NO.	STATE	PROJ. NO.	SHEET NO.	TOTAL SHEETS
3	COLO.	I-25-332203	113	

PROFILE	SURVEYED	BY	DATE
NOTE BOOK	PLOTTED		
NO. 13608	GRADES CHECKED		
	N.B. 1. NOTED		
	STRUCTURE NOTATIONS CH'KD		

PLAN	SURVEYED	BY	DATE
NOTE BOOK	PLOTTED		
NO. 13605	ALIGNMENT CHECKED		
	RT. OF WAY CHECKED		

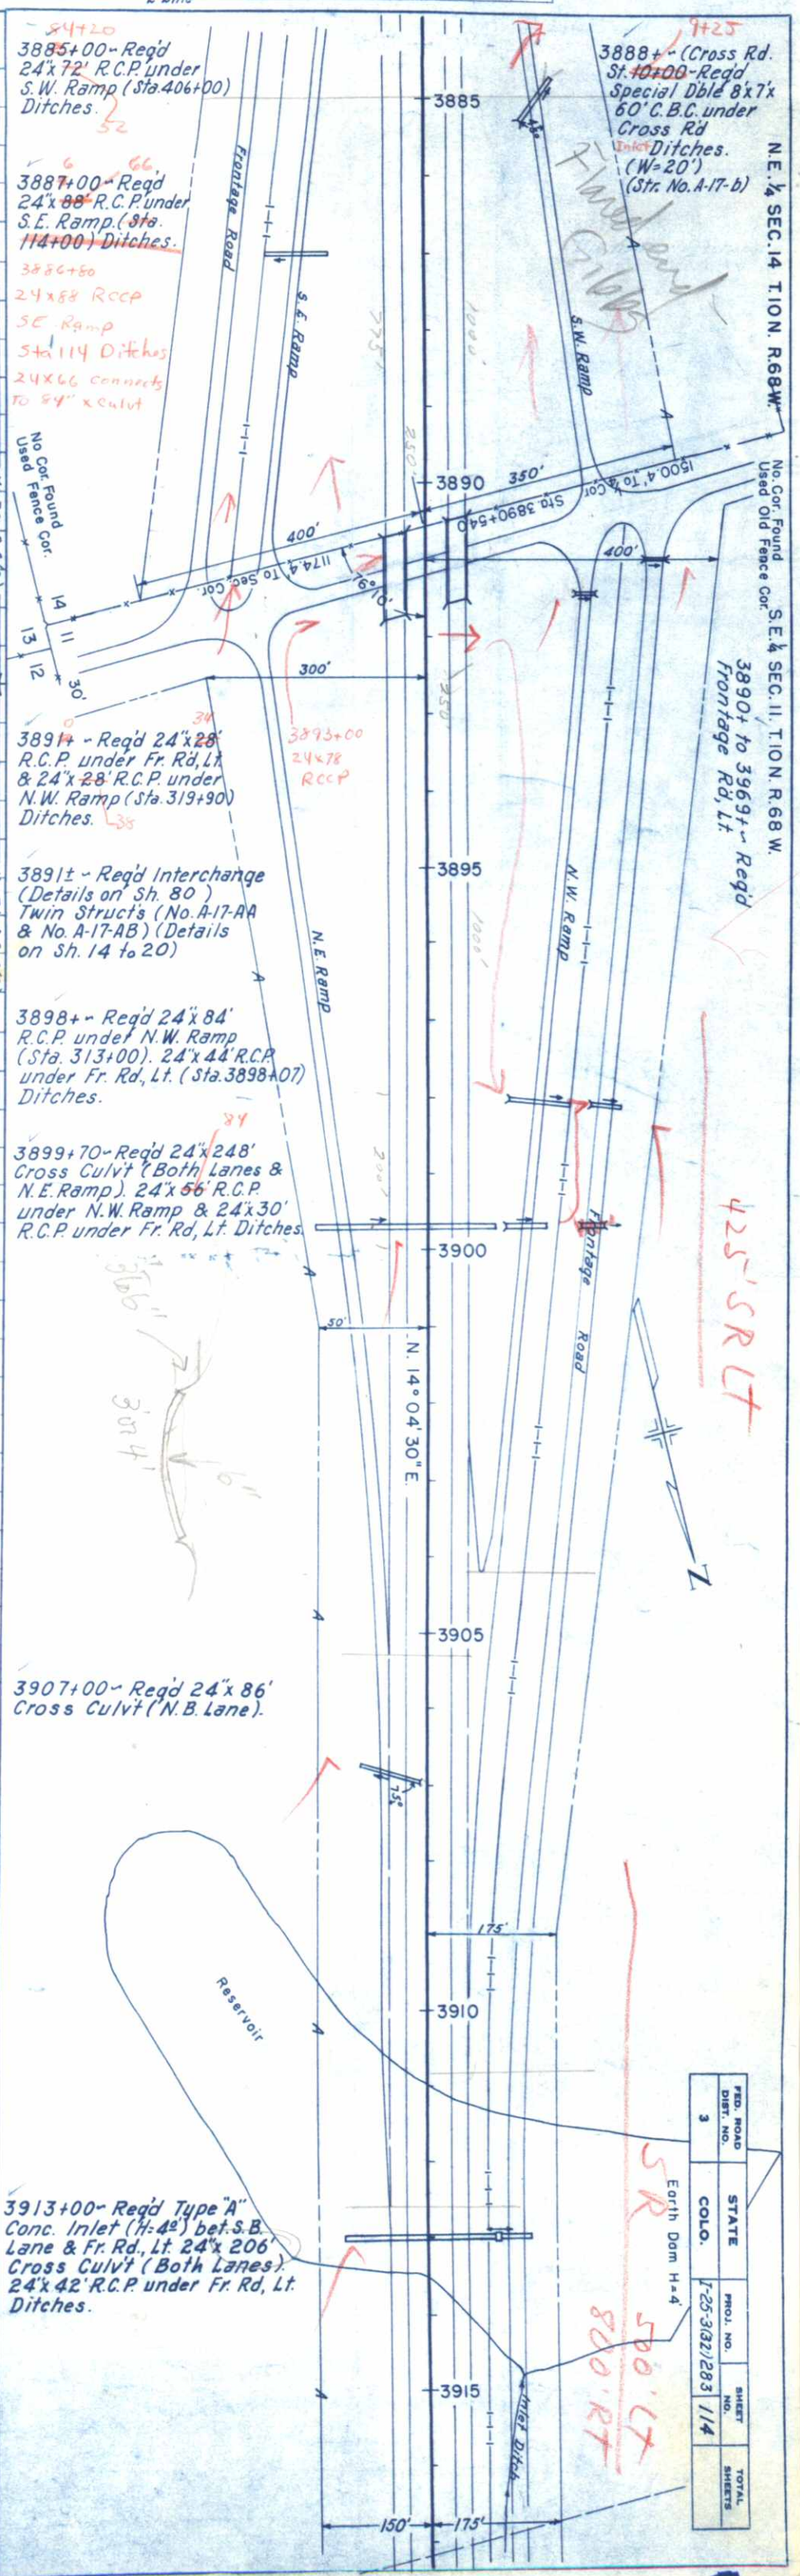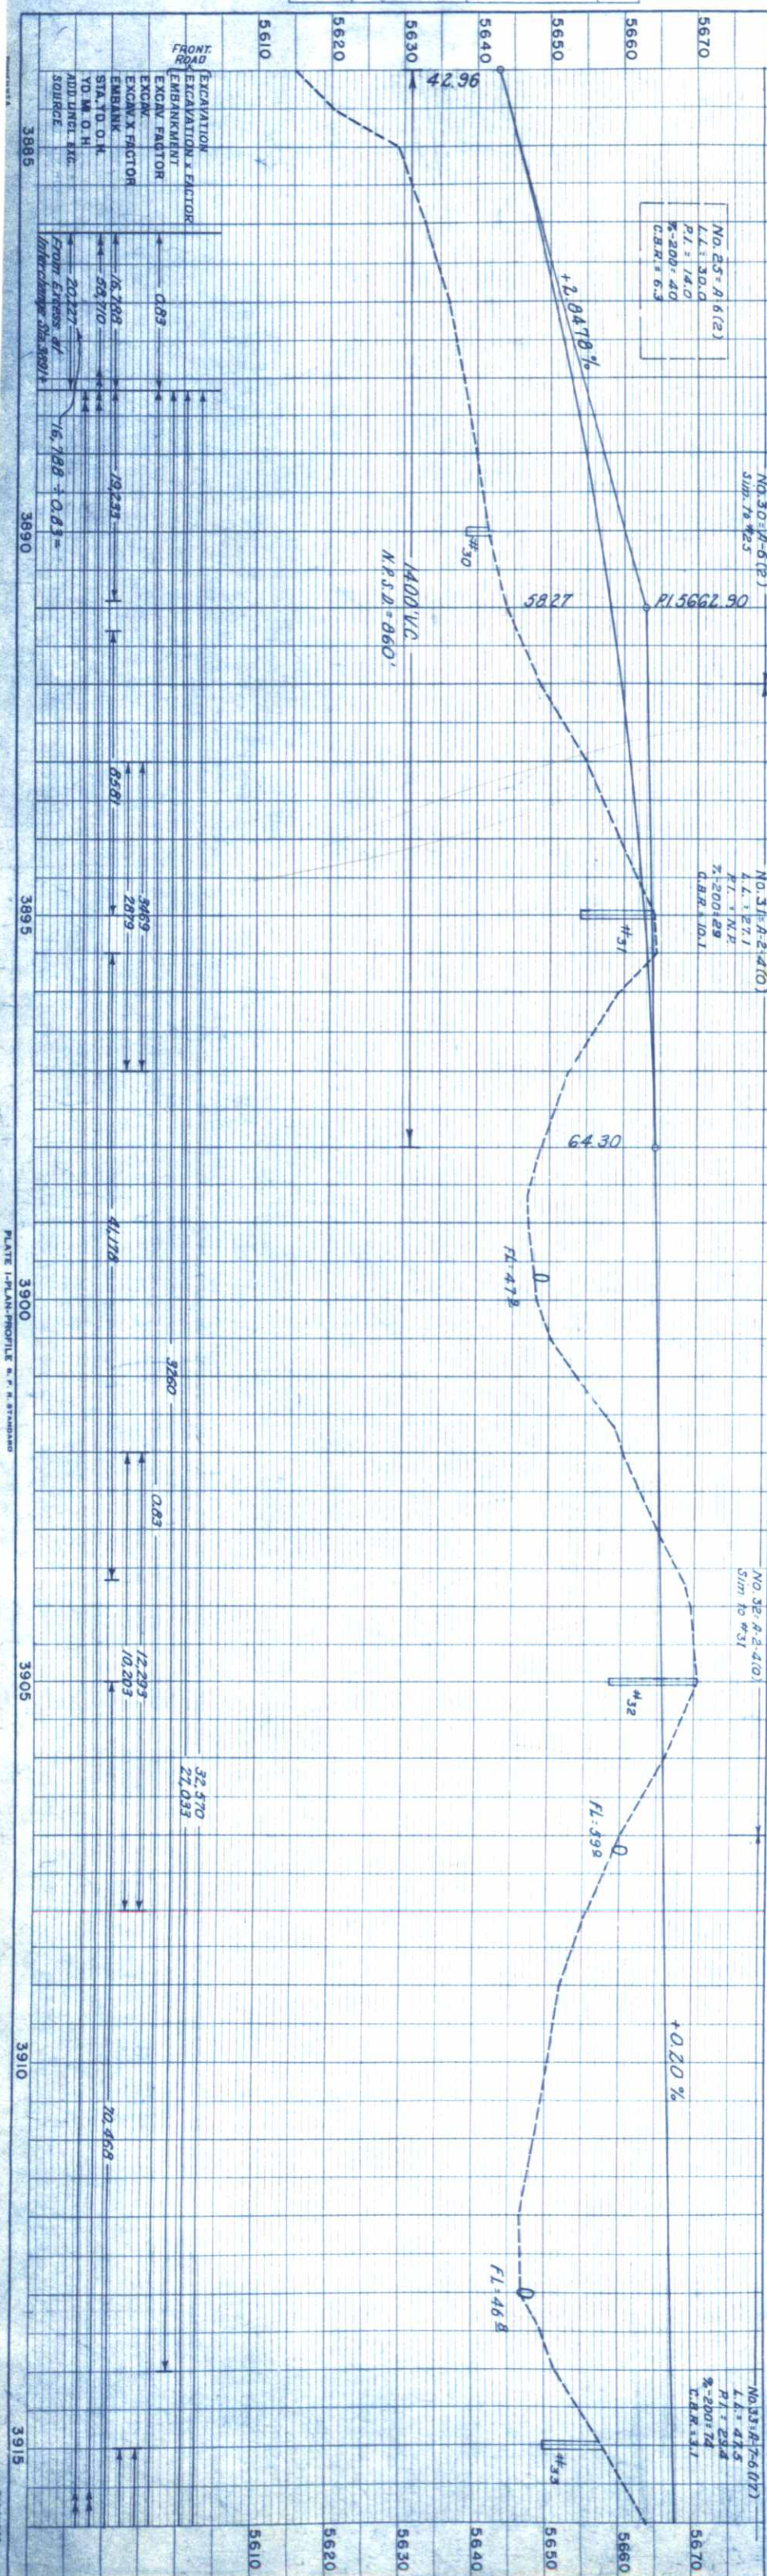



FED. ROAD DIST. NO.	STATE	COLO.	PROJ. NO.	SHEET NO.	TOTAL SHEETS
3			1-25-3(32)/283	1/4	

PLATE I-PLAN-PROFILE & R. R. STANDARD
BROWN BROTHERS CO. Chicago, Ill. 60601

PROFILE	SURVEYED	BY	DATE
NOTE BOOK	PLOTTED		
NO. 13605	GRADES CHECKED		
	S. & A. NOTED		
	STRUCTURE NOTATIONS CHECKED		

PLAN	SURVEYED	BY	DATE
NOTE BOOK	PLOTTED		
NO. 13605	ALIGNMENT CHECKED		
	RT. OF WAY CHECKED		

"L" Line

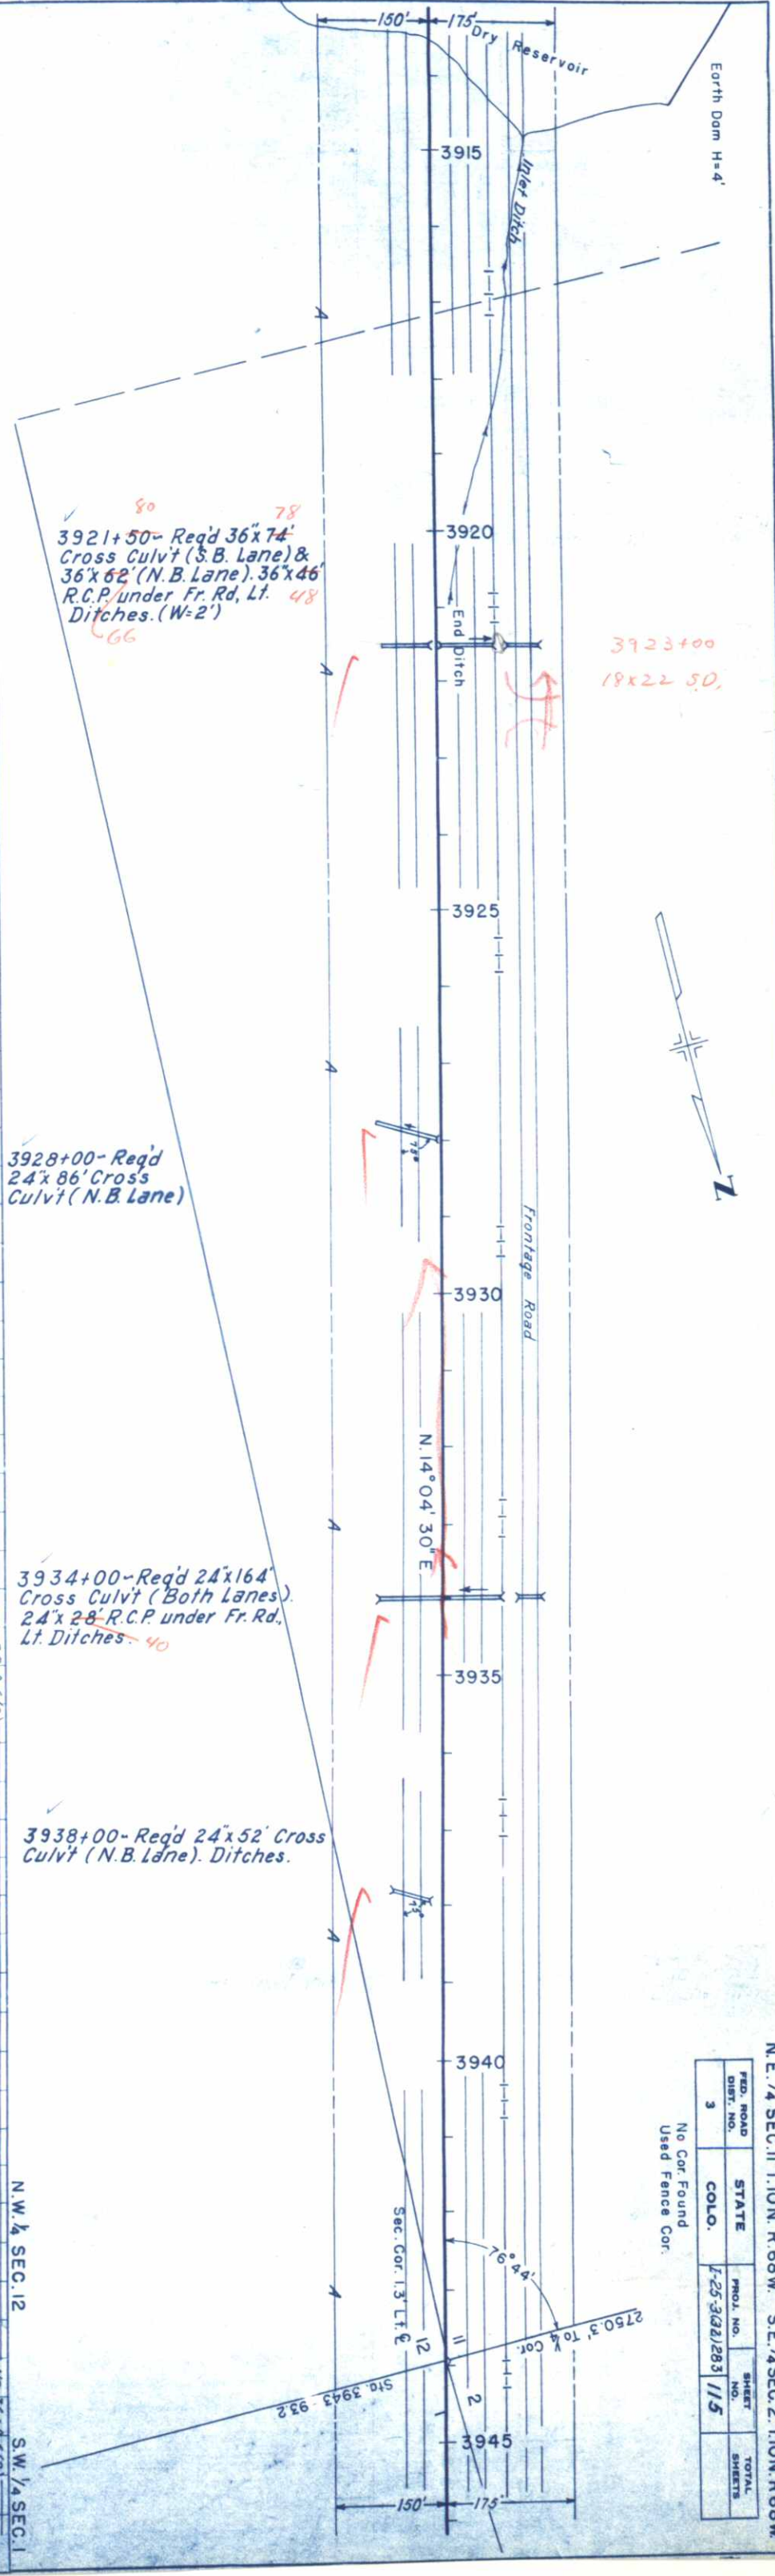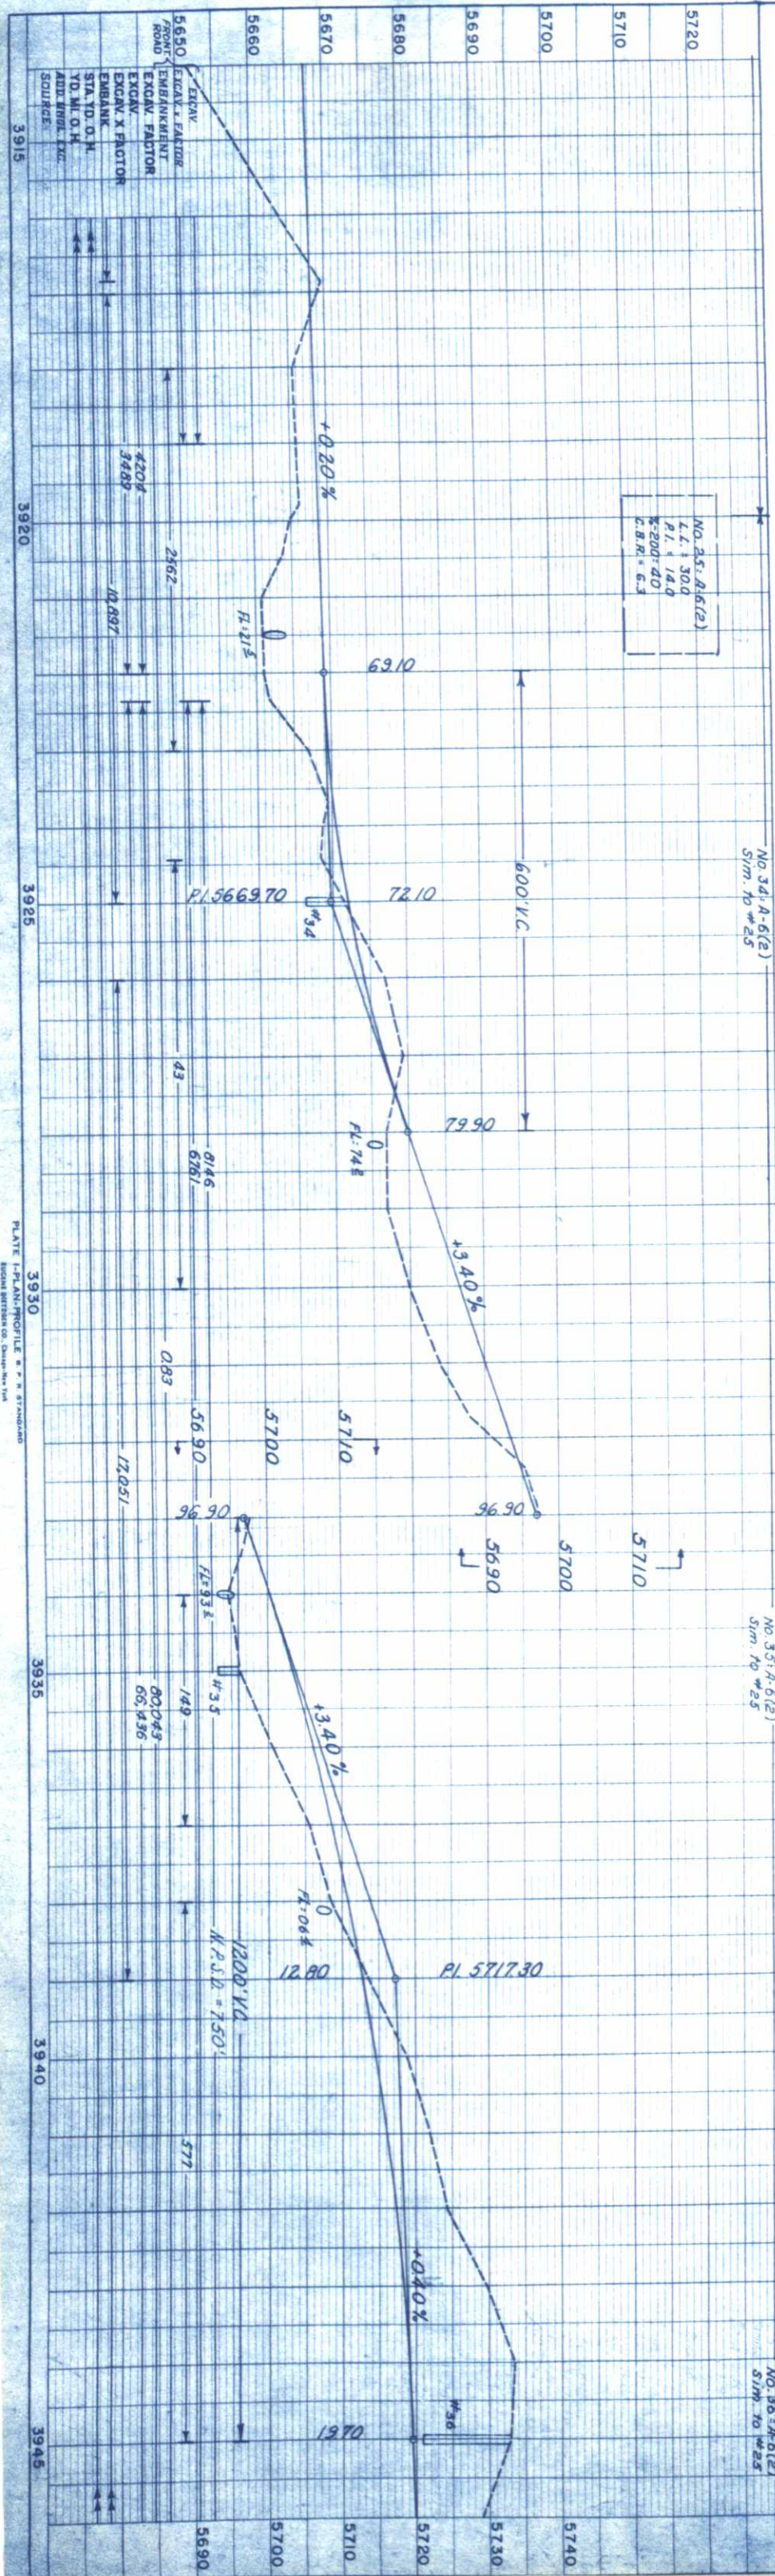

80 78
3921+50- Req'd 36"x74'
Cross Culvt (S.B. Lane) &
36"x62' (N.B. Lane). 36"x46'
R.C.P. under Fr. Rd, Lt. 48
Ditches. (W=2') 66

3928+00- Req'd
24'x 86' Cross
Culvt (N.B. Lane)

3934+00- Req'd 24'x164'
Cross Culvt (Both Lanes)
24'x 28' R.C.P. under Fr. Rd.
Lt. Ditches. 40

3938+00- Req'd 24'x52' Cross
Culvt (N.B. Lane). Ditches.

FED. ROAD DIST. NO.	STATE	PROJ. NO.	SHEET NO.	TOTAL SHEETS
3	COLO.	1-25-3(22)/283	115	


No Cor. Found
Used Fence Cor.

N.E. 1/4 SEC. 11 T. 10 N. R. 68 W. S.E. 1/4 SEC. 2 T. 10 N. R. 68 W.

PROFILE	SURVEYED	BY	DATE
NOTE BOOK	PLOTTED		
NO. 13608	GRADES CHECKED		
	R.R. - NOTED		
	STRUCTURE NOTATIONS OK		

PLAN	SURVEYED	BY	DATE
NOTE BOOK	PLOTTED		
NO. 13605	ALIGNMENT CHECKED		
	RT. OF WAY CHECKED		

"L" Line

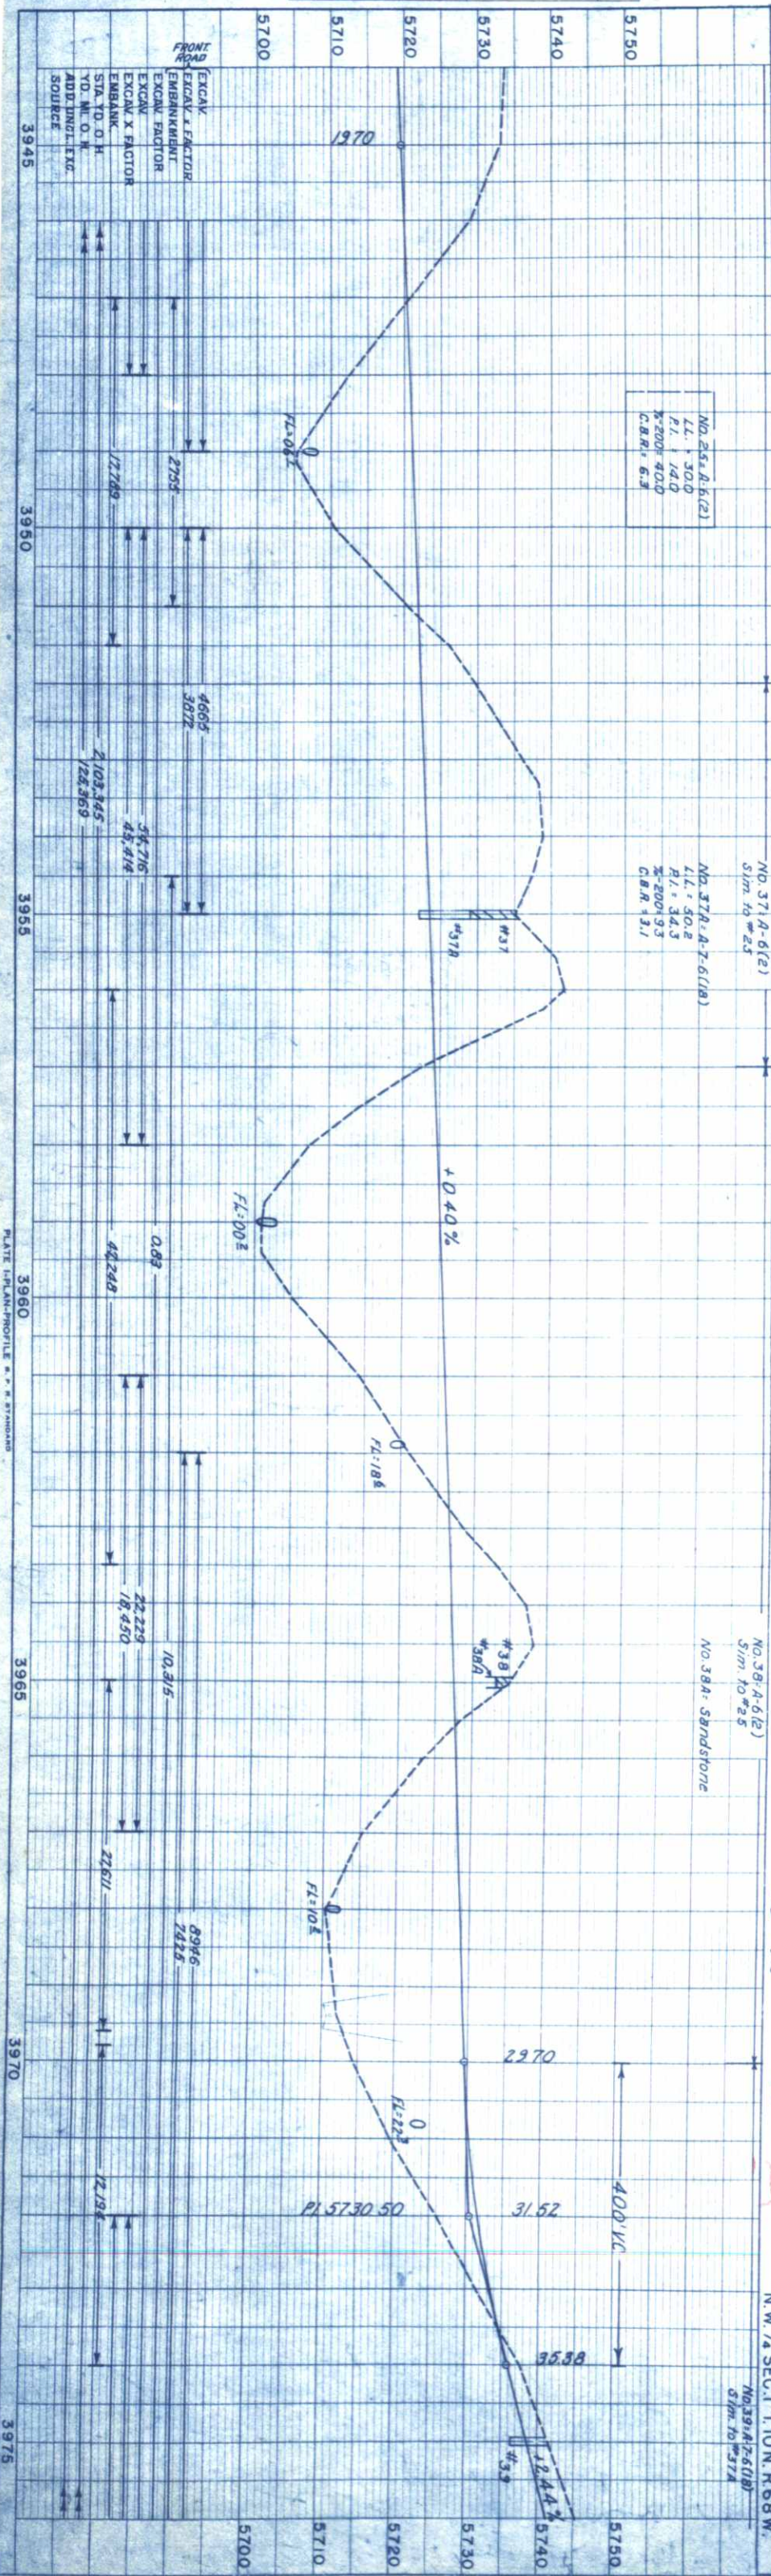

N.W. 1/4 SEC. 12 T. 10N. R. 68 W.

3949+00 - Req'd Type "A" Conc. Inlet (H-6') bet. S.B. Lane & Fr. Rd. Lt. 24'x200' Cross Culvt (Both Lanes) w/T Connection for Median Drain. 24'x64' R.C.P. under Fr. Rd. Lt. Ditches. (Details on Sh. 13)

3949+13 - Req'd Type "B" Conc. Inlet (H-4') in Median with 18'x12' R.C.P. Connection to 24' Cross Culvt (Sta. 3949+00)

3959+00 - Req'd 30'x270' Cross Culvt (Both Lanes & Fr. Rd. Lt.) w/T Connection for Inlet bet. S.B. Lane & Fr. Rd. Lt. Ditches. (Details on Sh. 13)

3959+13 - Req'd Type "A" Conc. Inlet (H-4') bet. S.B. Lane & Fr. Rd. Lt. w/18'x12' R.C.P. Connection to 30' Cross Culvt (Sta. 3959+00)

3962+00 - Req'd 24'x74' Cross Culvt (S.B. Lane). Ditches.

3968+00 - Req'd 24'x206' Cross Culvt (Both Lanes). 24'x30' R.C.P. under Fr. Rd. Lt. Ditches.

3969+ to 4034+ - Req'd Frontage Rd, Rt.

3969+ - Req'd Twin Struct's (No. A-17-AE & No. A-17-AF) (Details on Sh. 21 to 30)

3970+40 - Req'd 16ft. Cattle Guard, Rt.

3971+00 - Req'd 24'x94' Cross Culvt (S.B. Lane).


Some one Road way (overflow)

Some one Road way (overflow)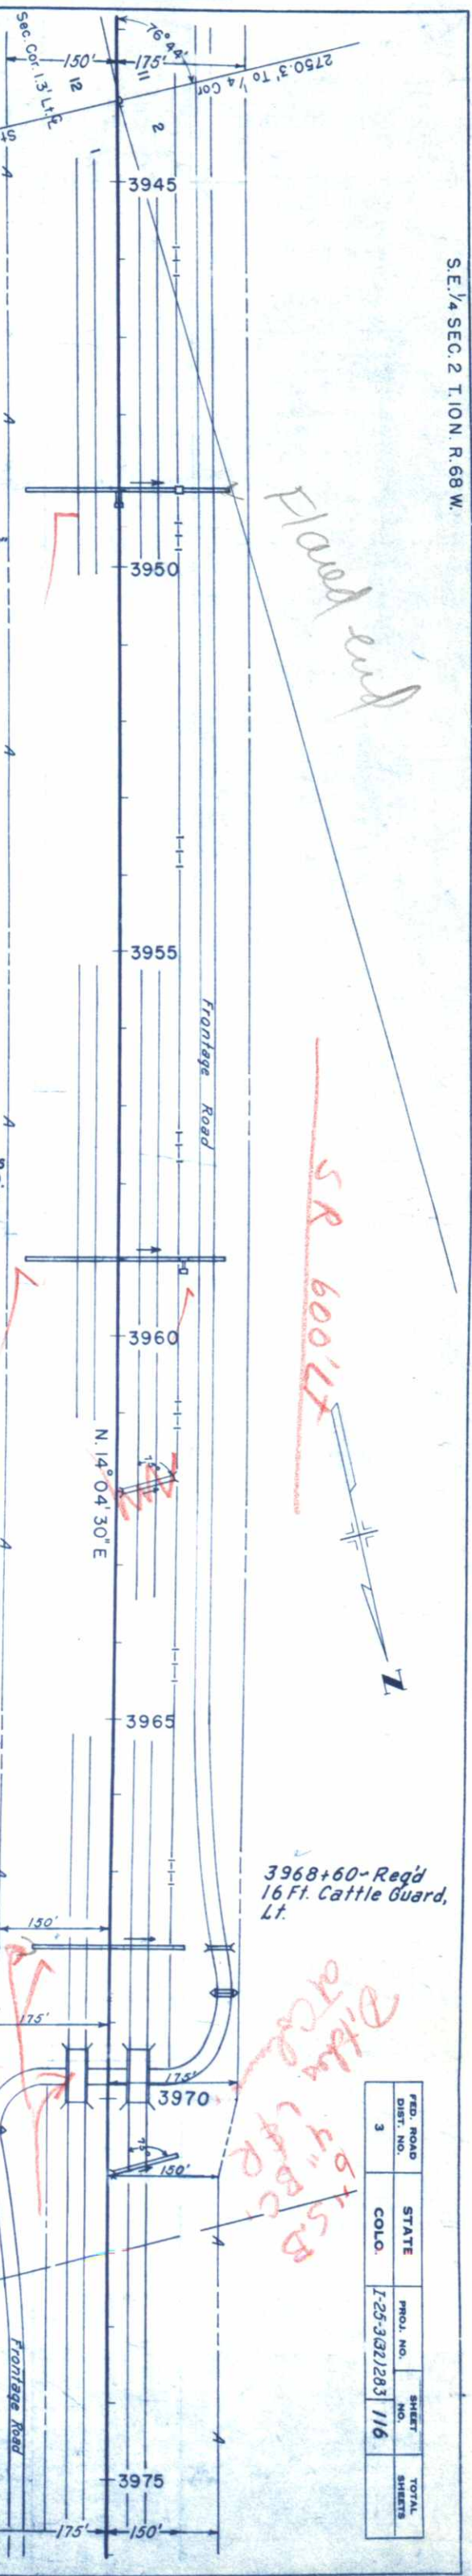

S.E. 1/4 SEC. 2 T. 10N. R. 68 W.

Flashed end


SR 600' LT

3968+60 - Req'd 16ft. Cattle Guard, Lt.

FED. ROAD DIST. NO.	STATE	PROJ. NO.	SHEET NO.	TOTAL SHEETS
3	COLO.	I-25-3(2)283	116	

PLAN		BY	DATE
NOTE BOOK	SURVEYED PLOTTED		
NO. 19005	ALIGNMENT CHECKED RT. OF WAY CHECKED		

"L" Line

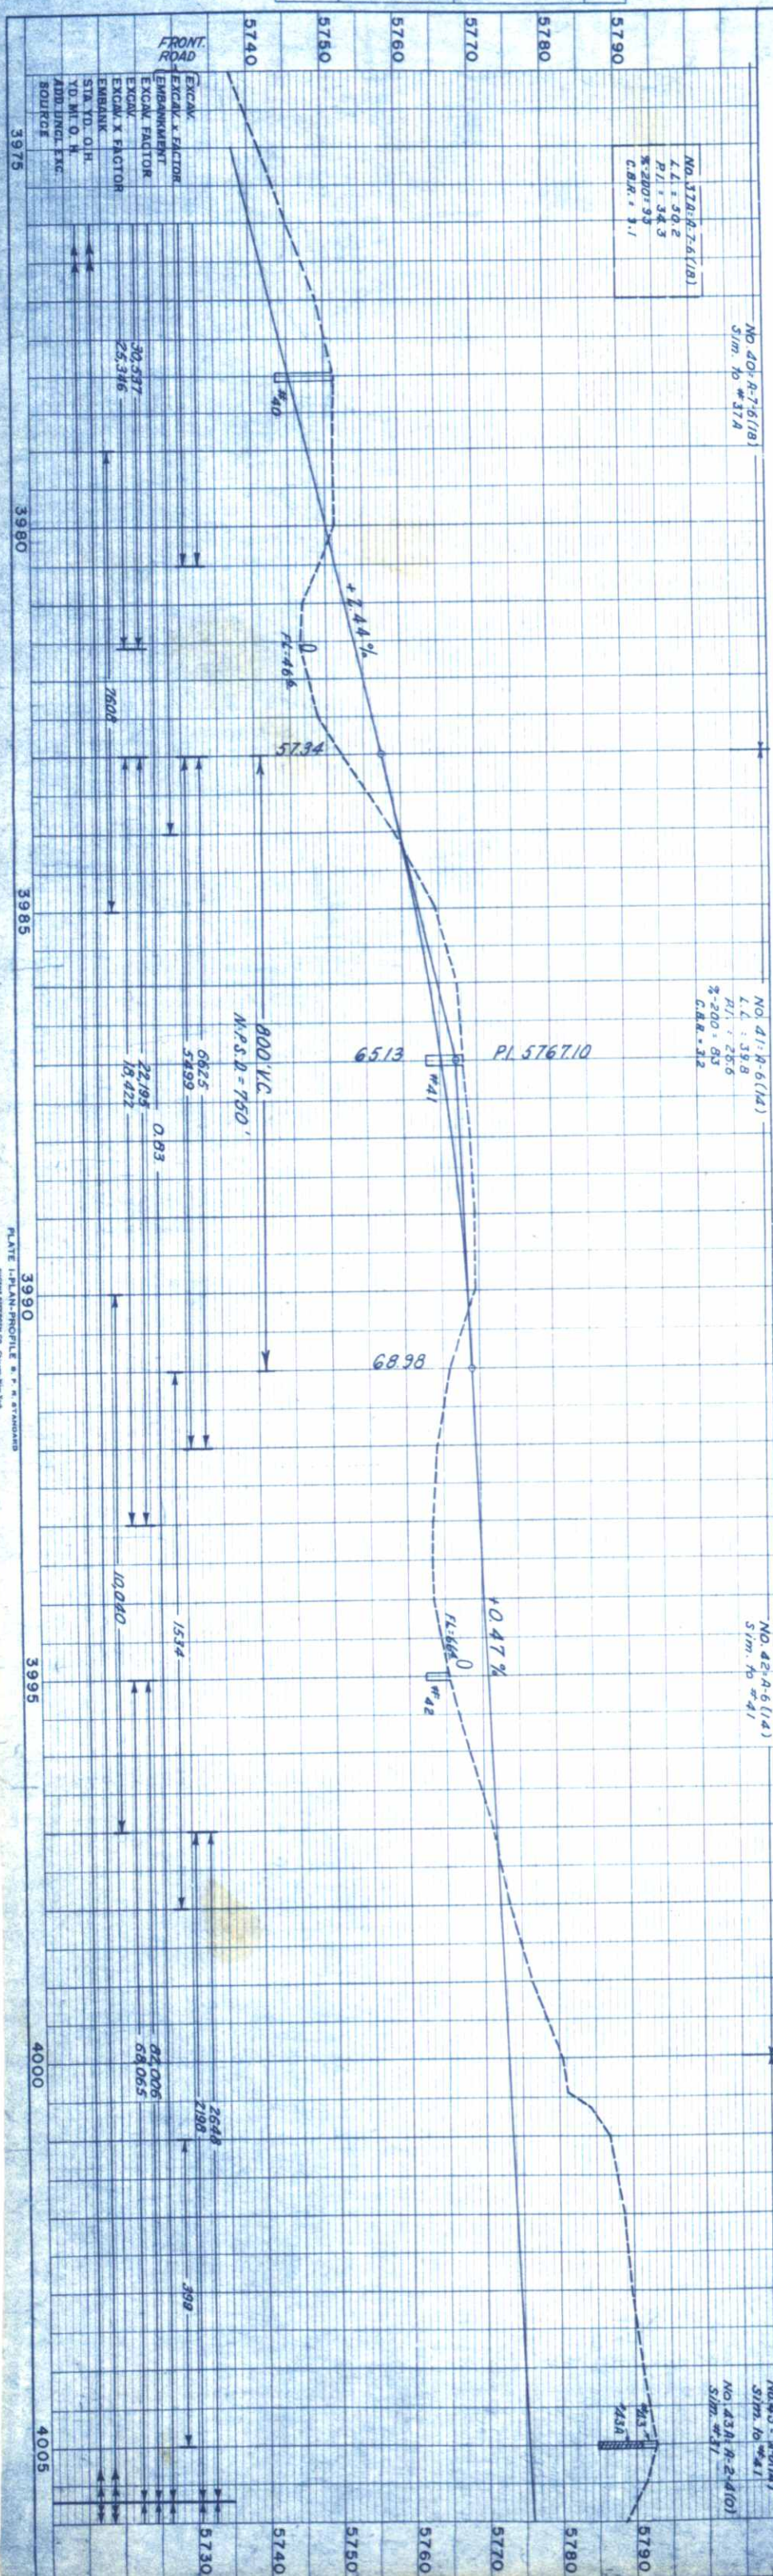

✓ 30
3981 + 57 - Req'd 24"x78'
Cross Culv't (S.B. Lane), &
24"x62' (N.B. Lane). 24"x40'
R.C.P. under Fr. Rd., Rt. Ditches.

✓ 93+10 76
3995+00 - Reg'd 24"x 52' Cross
Culvt (S.B. Lane).
Adjust Median to Drain.

3994t - Req'd Fill Low
Area, Lt.



NB ~~FR~~ FR
East

FED. ROAD DIST. NO.	STATE	PROJ. NO.	SHEET NO.	TOTAL SHEETS
3	COLO.	I-25-3(32)283	117	

PROFILE	SURVEYED	BY	DATE
NOTE BOOK	PLOTTED		
NO. 13608	GRADES CHECKED		
	B.M. NOTED		
	STRUCTURE NOTATIONS CHECKED		

PLAN	SURVEYED	BY	DATE
NOTE BOOK	PLOTTED		
NO. 13605	ALIGNMENT CHECKED		
	ST. OF WAY CHECKED		

"L" Line

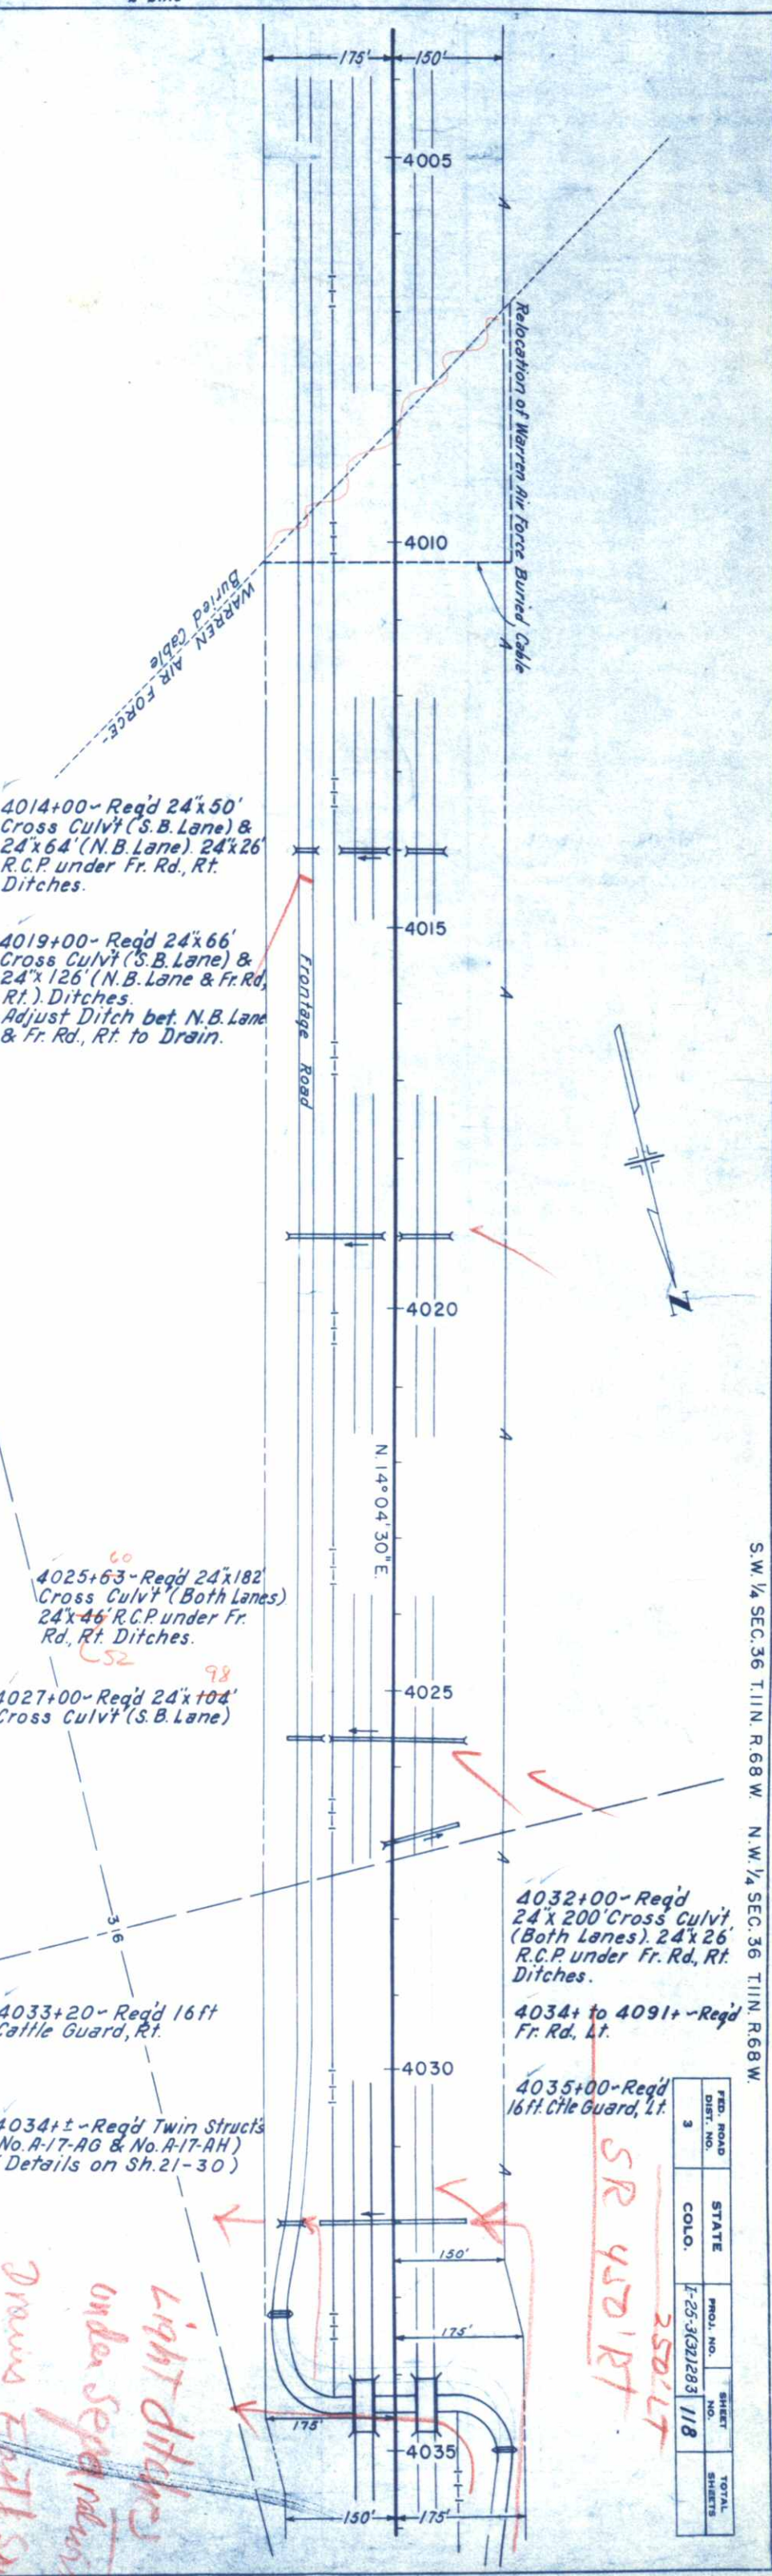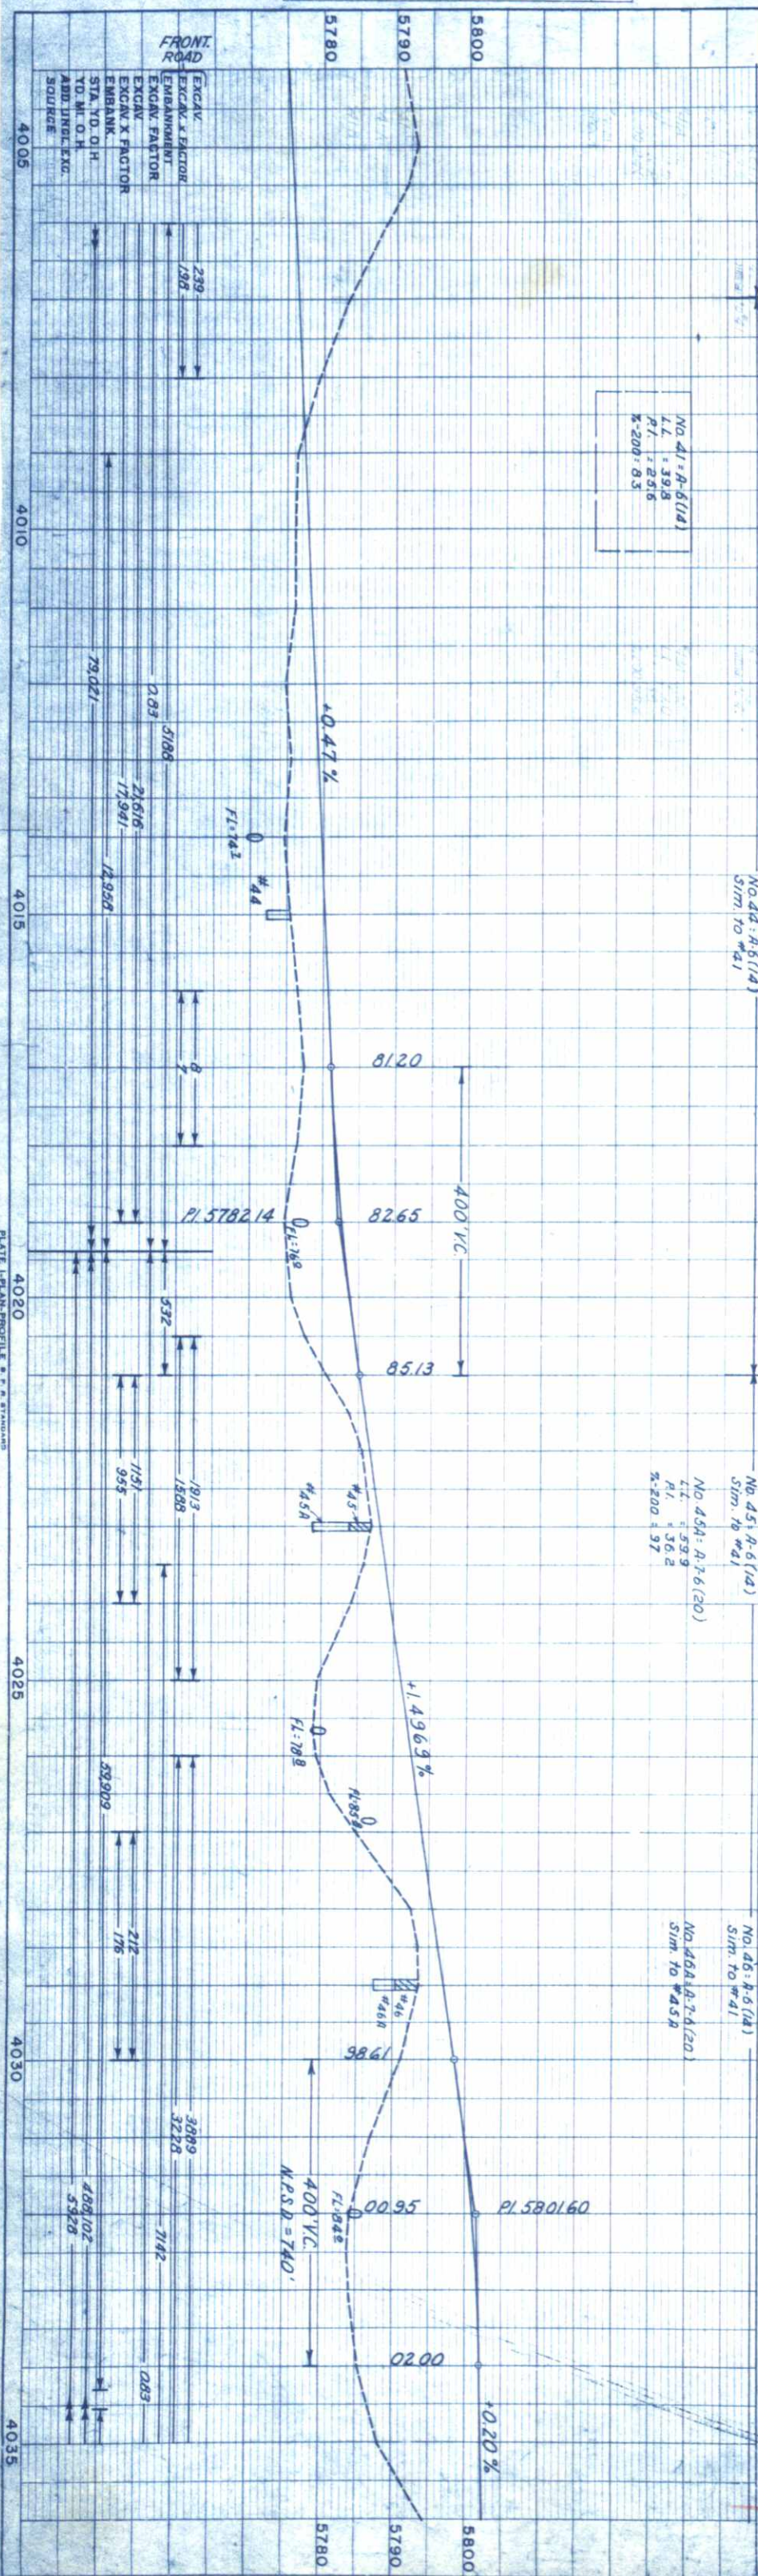



S.W. 1/4 SEC. 36 T.11N. R.68 W. N.W. 1/4 SEC. 36 T.11N. R.68 W.

FED. ROAD DIST. NO.	STATE	PROJ. NO.	SHEET NO.	TOTAL SHEETS
3	COLO.	I-25-3(32)283	118	

PLAN	SURVEYED	BY	DATE
NOTE BOOK	PLOTTED		
NO. 13605	ALIGNMENT CHECKED		
	RT. OF WAY CHECKED		

PROFILE	SURVEYED	BY	DATE
NOTE BOOK NO. 13605	PLOTTED GRADES CHECKED S.M. - NOTED STRUCTURE NOTATIONS OK'D		

PLAN	SURVEYED	BY	DATE
NOTE BOOK NO. 13605	PLOTTED ALIGNMENT CHECKED RT. OF WAY CHECKED		

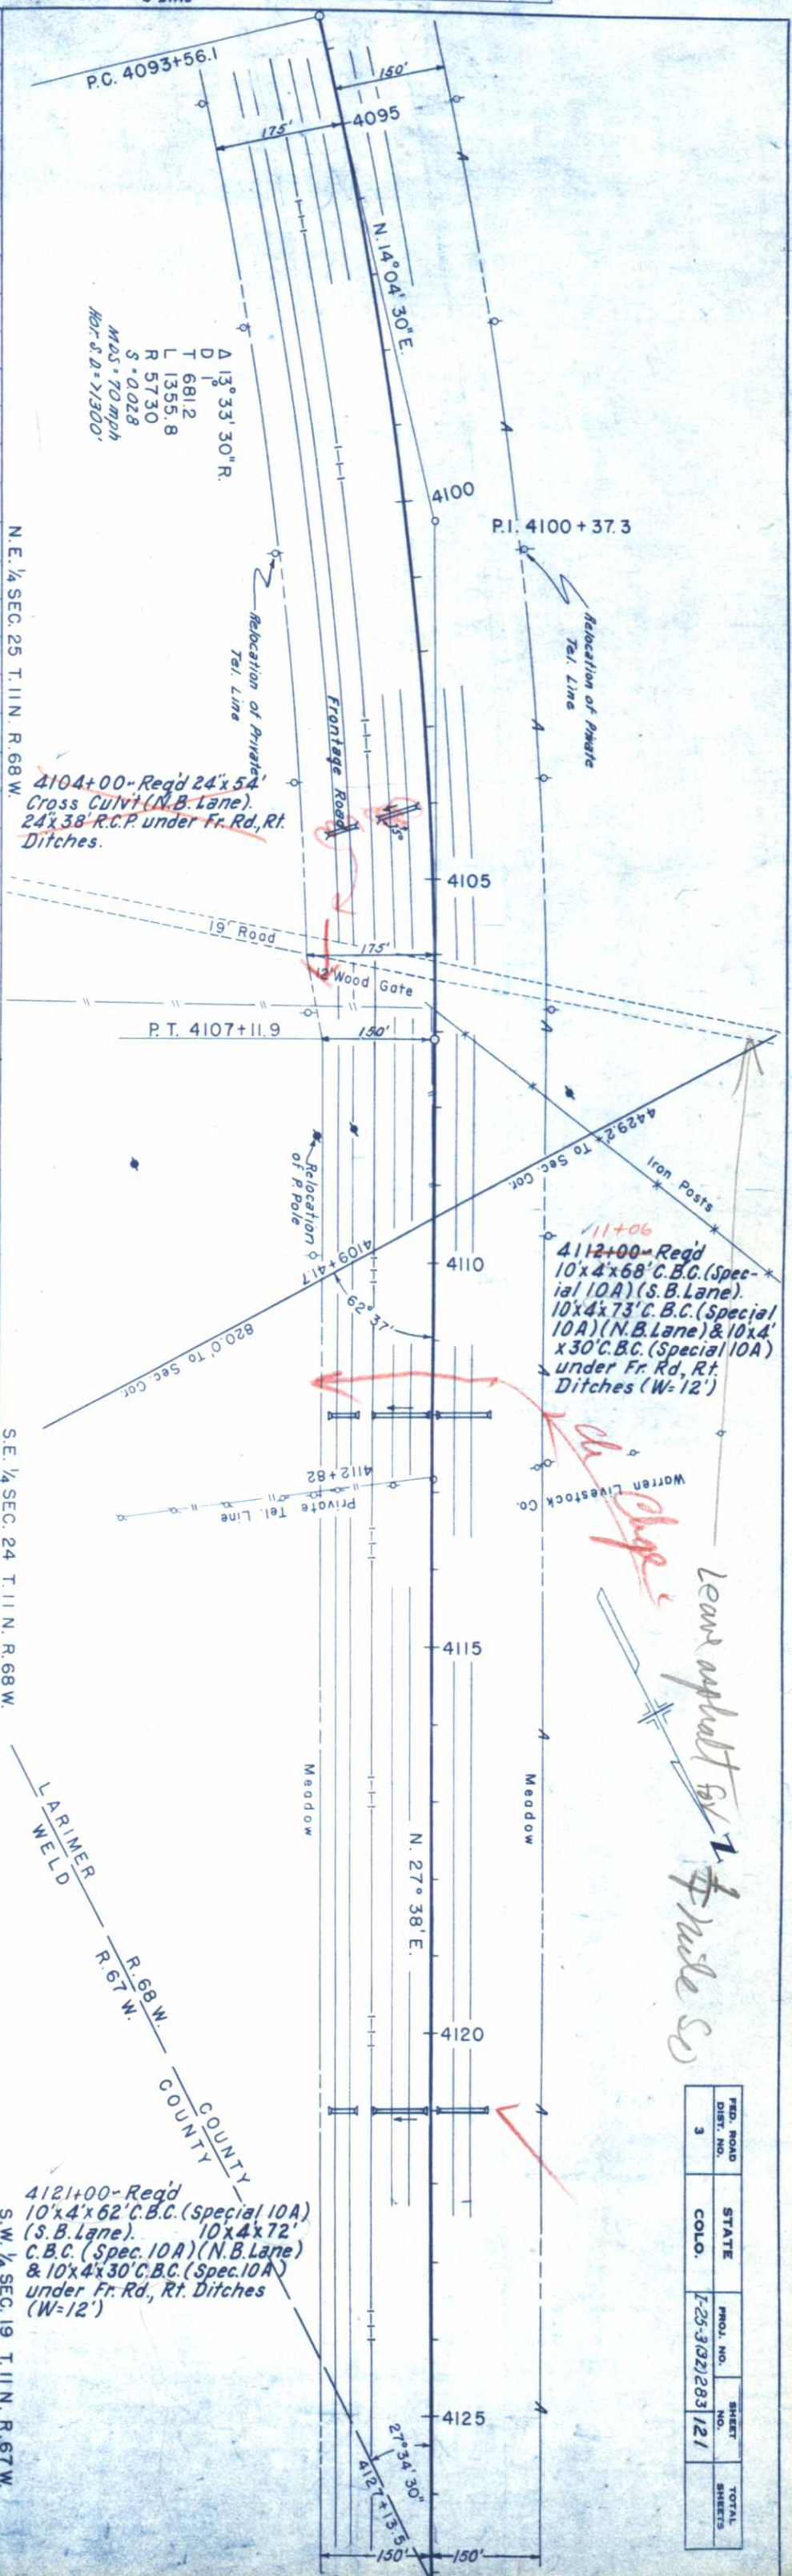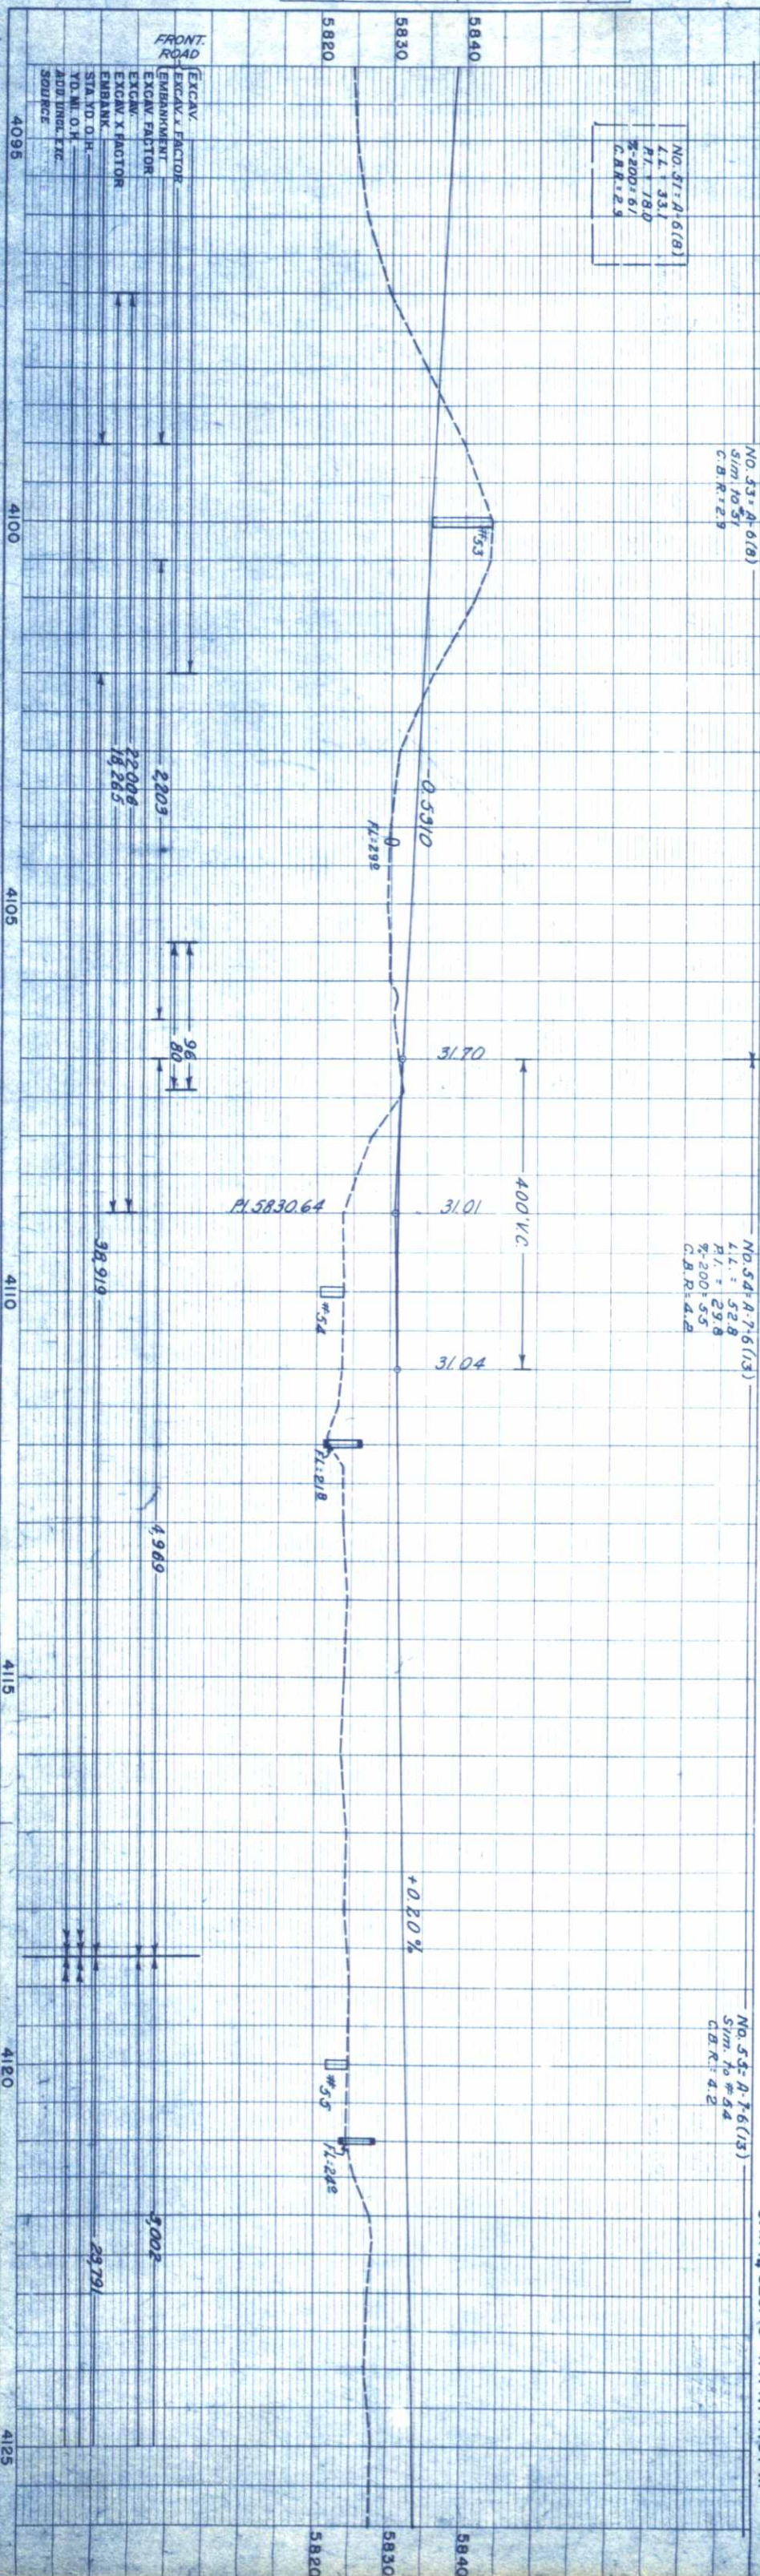


FED. ROAD DIST. NO.	STATE	PROJ. NO.	SHEET NO.	TOTAL SHEETS
3	COLO.	I-25-3(2)203	121	

Leave asphalt for 1/4 mile S

PLAN	SURVEYED	BY	DATE
NOTE BOOK	PLOTTED		
NO. 13605	ALIGNMENT CHECKED		
	RT. OF WAY CHECKED		



S.E. $\frac{1}{4}$ SEC. 24 T. 11 N. R. 68 W

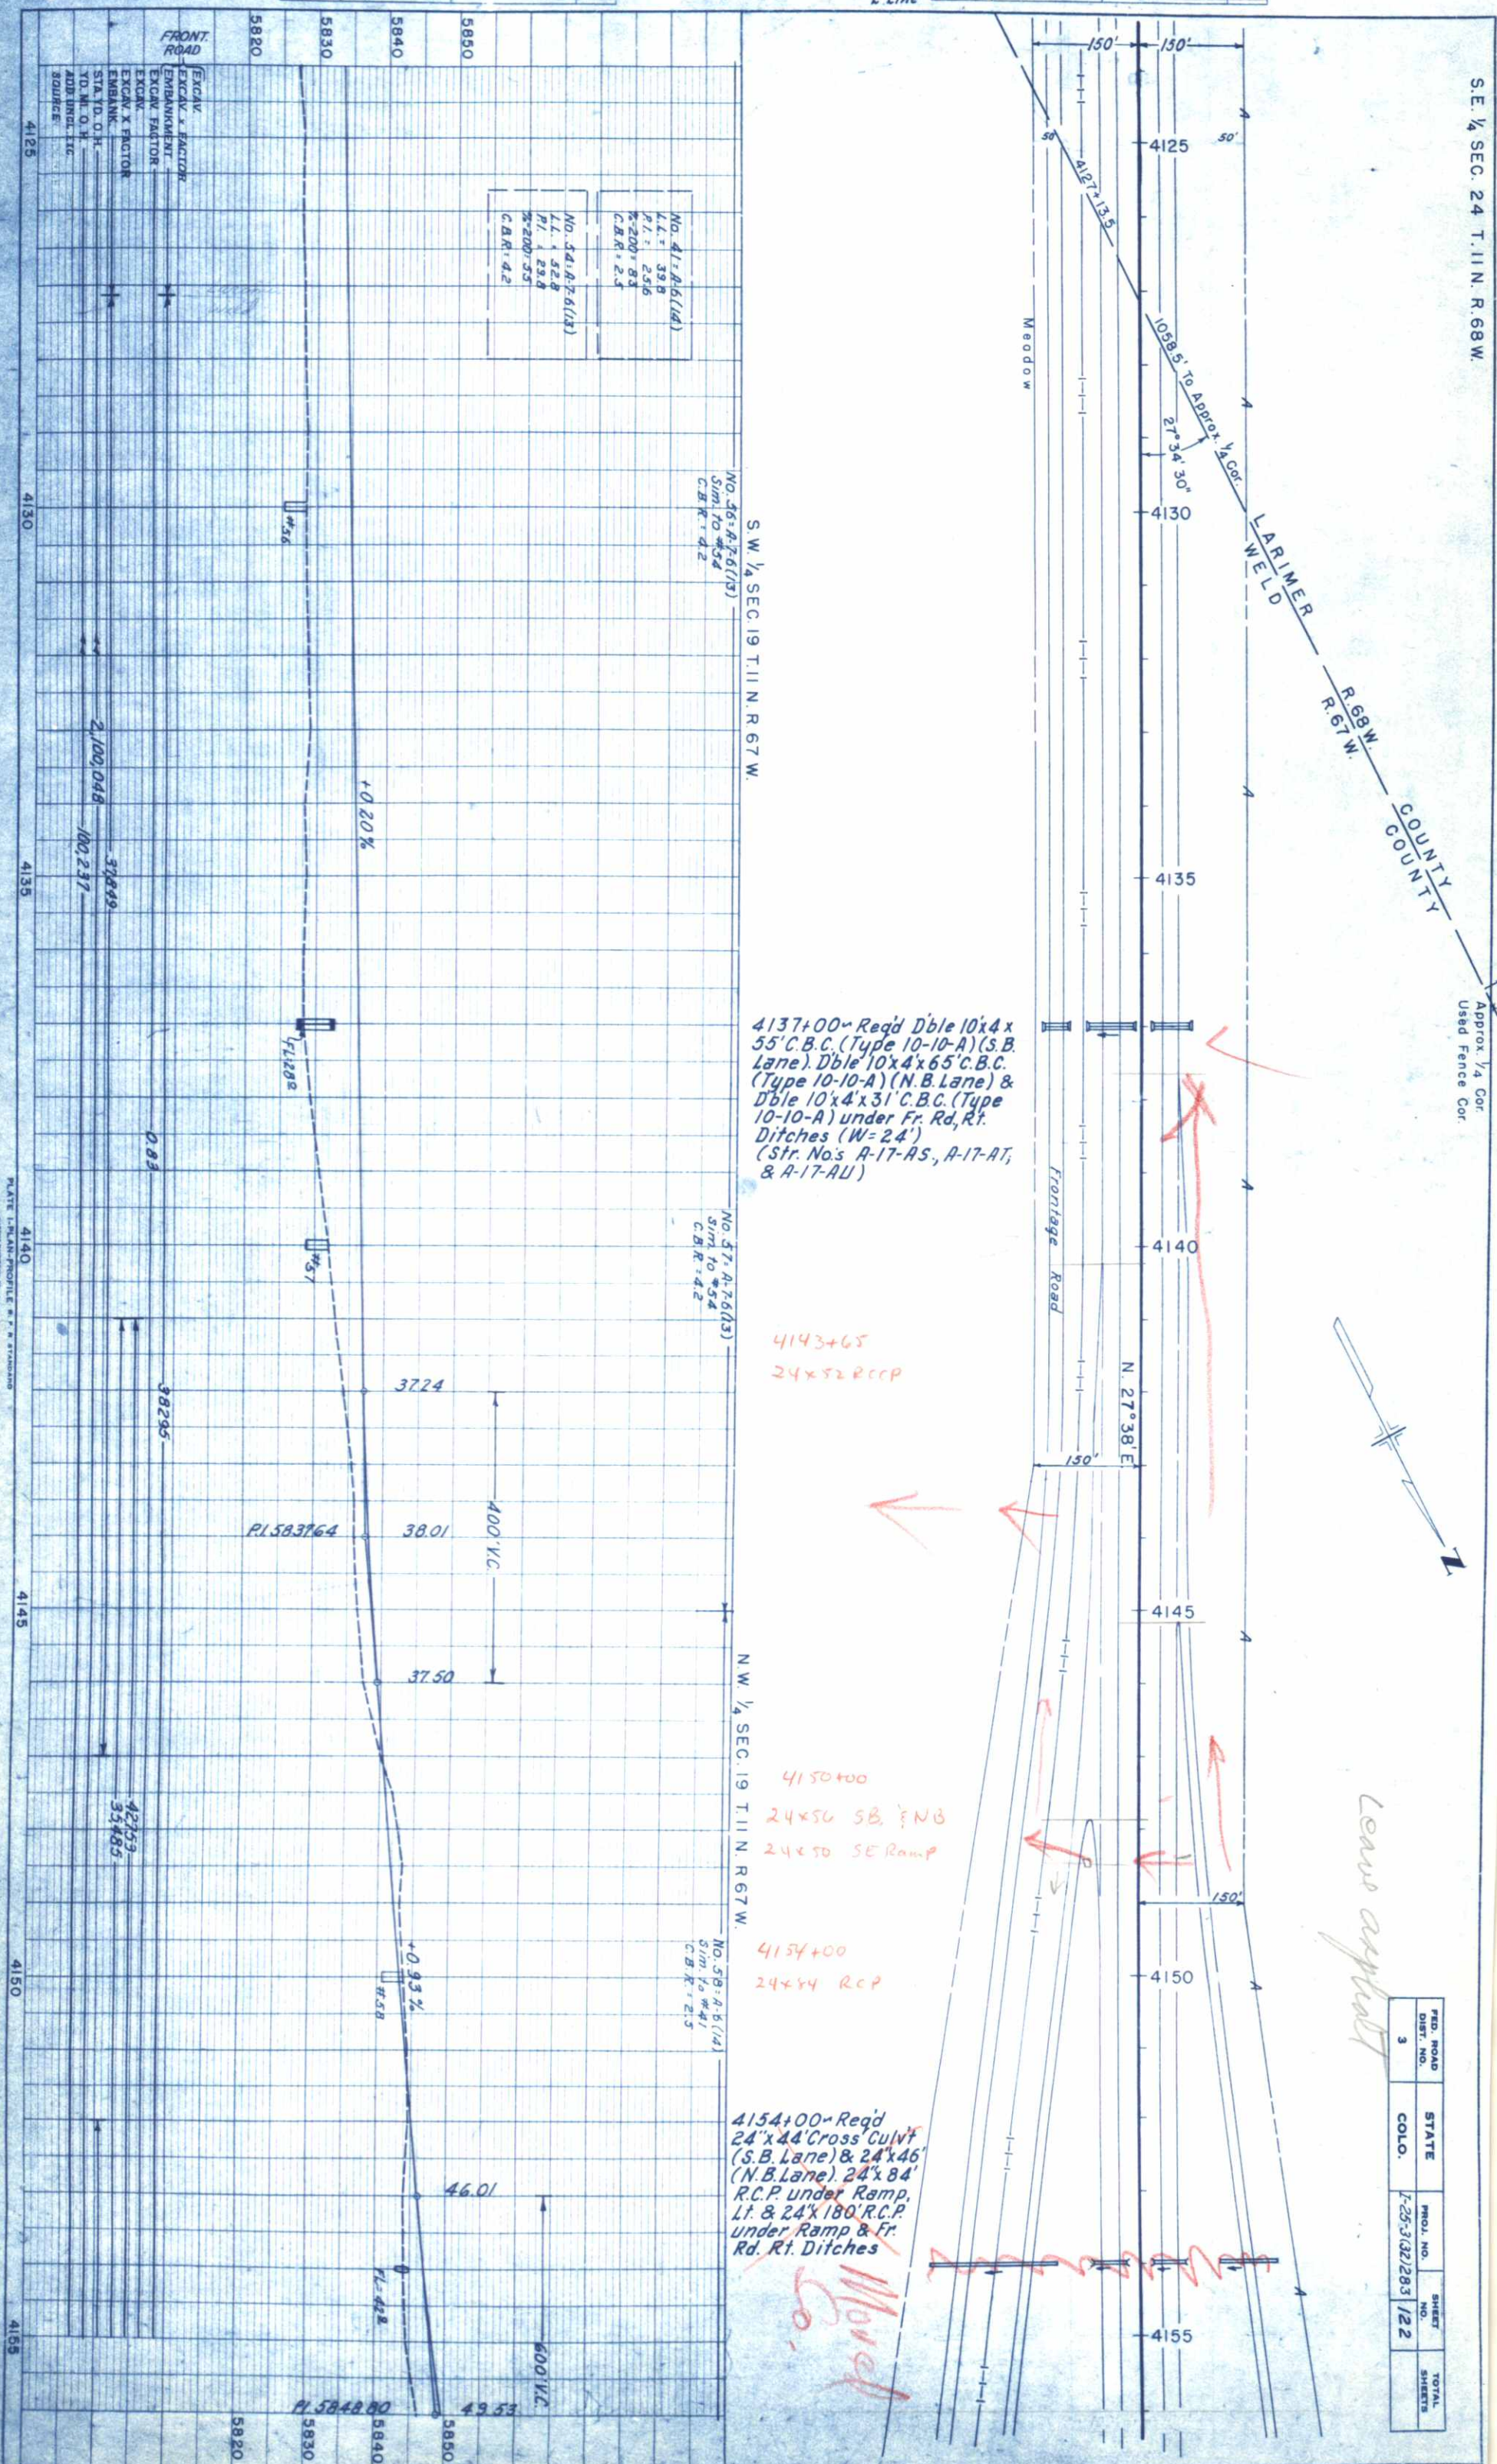

FED. ROAD DIST. NO.	STATE	PROJ. NO.	SHEET		TOTAL SHEETS
			NO.		
3	COLO.	I-25-3(32)283	122		

PROFILE	SURVEYED	BY	DATE
NOTE BOOK	PLOTTED		
NO. 13605	GRADES CHECKED		
	S.M. & NOTED		
	STRUCTURE NOTATIONS ON RD		

PLAN	SURVEYED	BY	DATE
NOTE BOOK	PLOTTED		
NO. 13605	ALIGNMENT CHECKED		
	HT. OF WAY CHECKED		

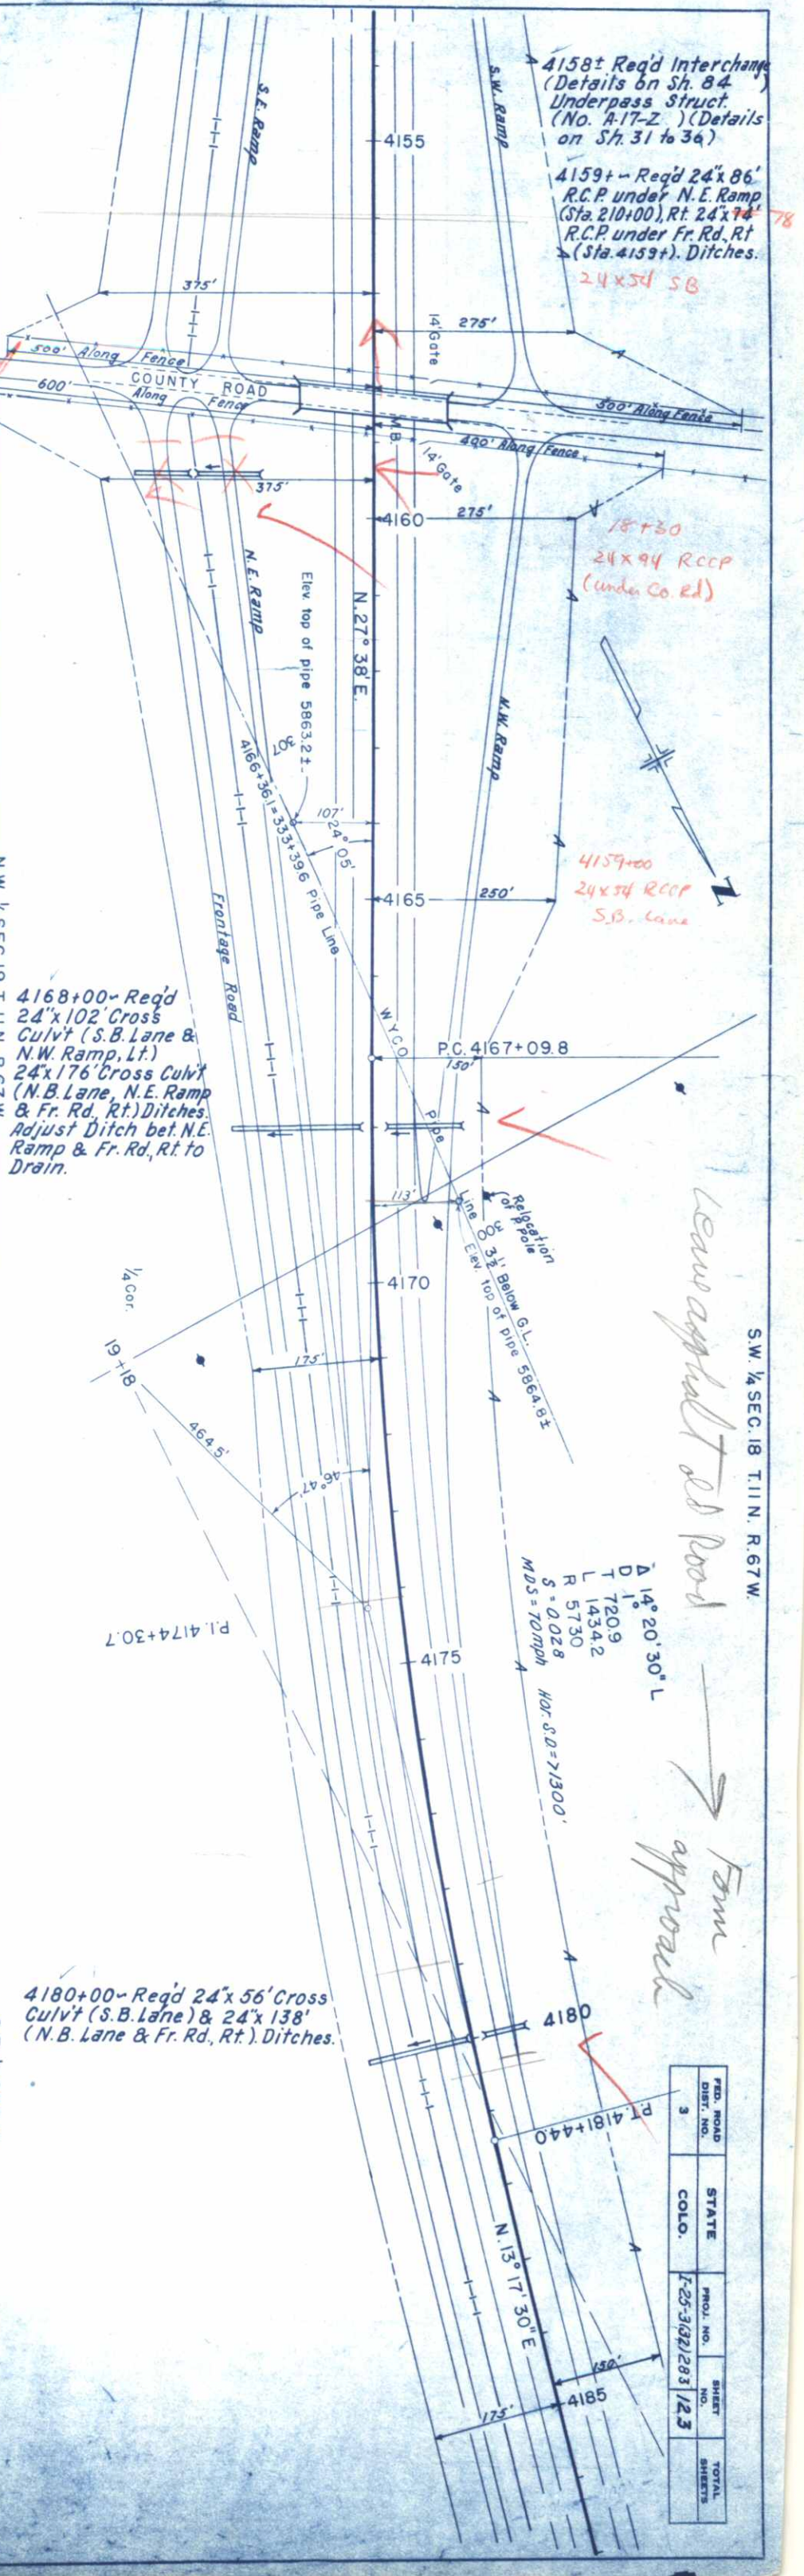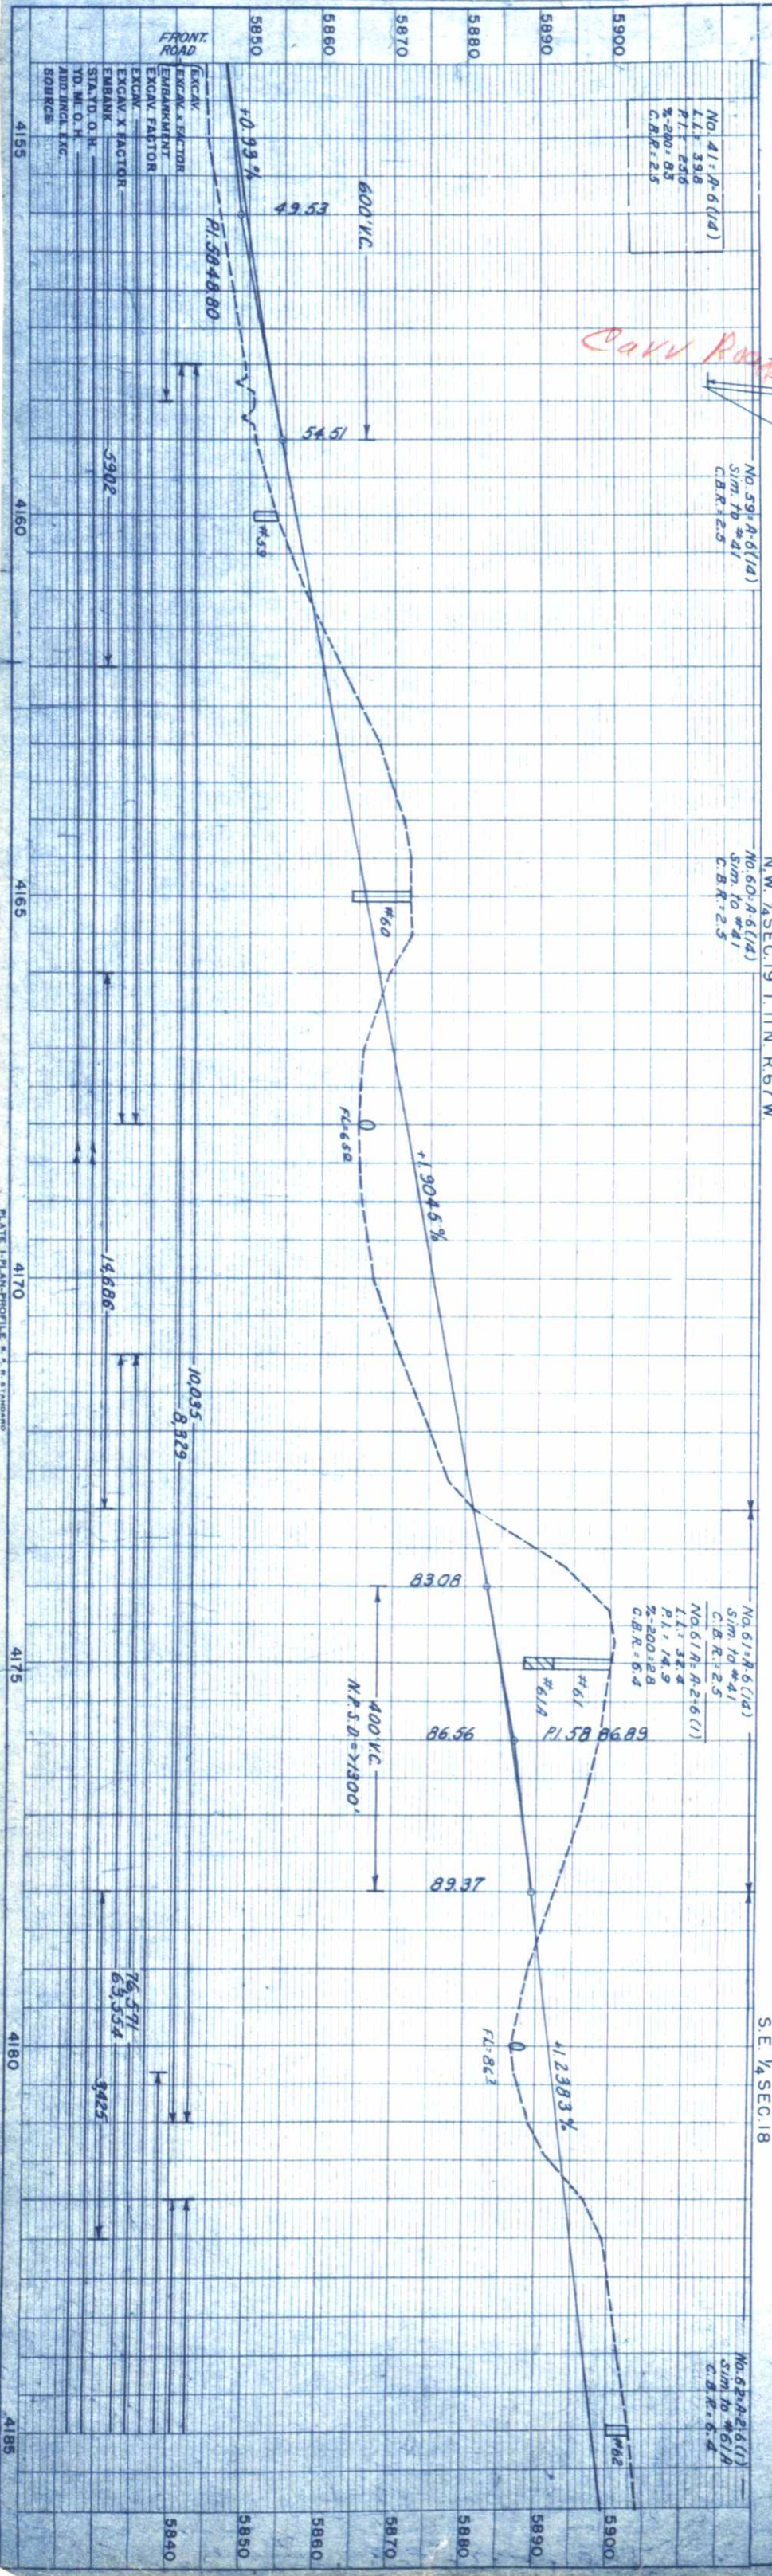

Leave as applied to old road

Form approval

FED. ROAD DIST. NO.	STATE	PROJ. NO.	SHEET NO.	TOTAL SHEETS
3	COLO.	I-25-3(92)283	123	

PROFILE	SURVEYED	DATE
NOTE BOOK	PLOTTED	
NO. 13605	GRADES CHECKED	
	R.M. - NOTED	
	STRUCTURE NOTATIONS OK'D	

PLAN	SURVEYED	BY	DATE
NOTE BOOK	PLOTTED		
NO. 13605	ALIGNMENT CHECKED		
	RT. OF WAY CHECKED		

"L" Line

S.W. 1/4 SEC. 18 T.11 N. R.67 W.

No Cor Found
Used Fence Cor.

FED. ROAD DIST. NO.	STATE	PROJ. NO.	SHEET NO.	TOTAL SHEETS
3	COLO.	1-25-3132/283	124	

S.E. 1/4 SEC. 18 T.11 N. R.67 W.

4192+40- Req'd 16 ft. Cattle Guard, Rt.

4193+ - Req'd Twin Struct's (No. A-17-AK & No. A-17-AL) (Details on Sh. 21 to 30)

4194+40- Req'd 16 ft. Cattle Guard, Rt.

4195+50- Req'd 24"x48" Cross Culvt. (S.B. Lane). Ditches.

4193+15
24x42 RCCP

4193+25
18x24 Rd Appr



N.E. 1/4 SEC. 18

4208+00- Req'd 24"x48" Cross Culvt (N.B. Lane). Ditches.

No. 61A-2-6(1)
Sim. to #61A
C.B.R. = 6.4

No. 61A-2-6(1)
Sim. to #61A
C.B.R. = 6.4

No. 61A-2-6(1)
L.L. = 32.4
P.L. = 14.9
% = 200.28
C.B.R. = 6.4

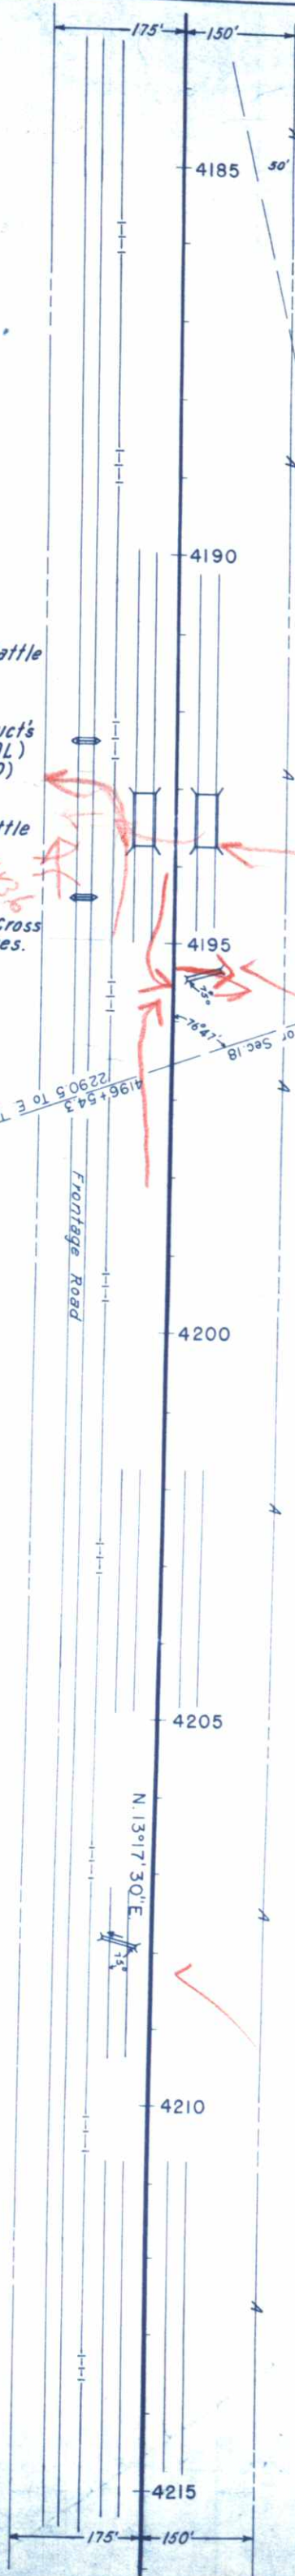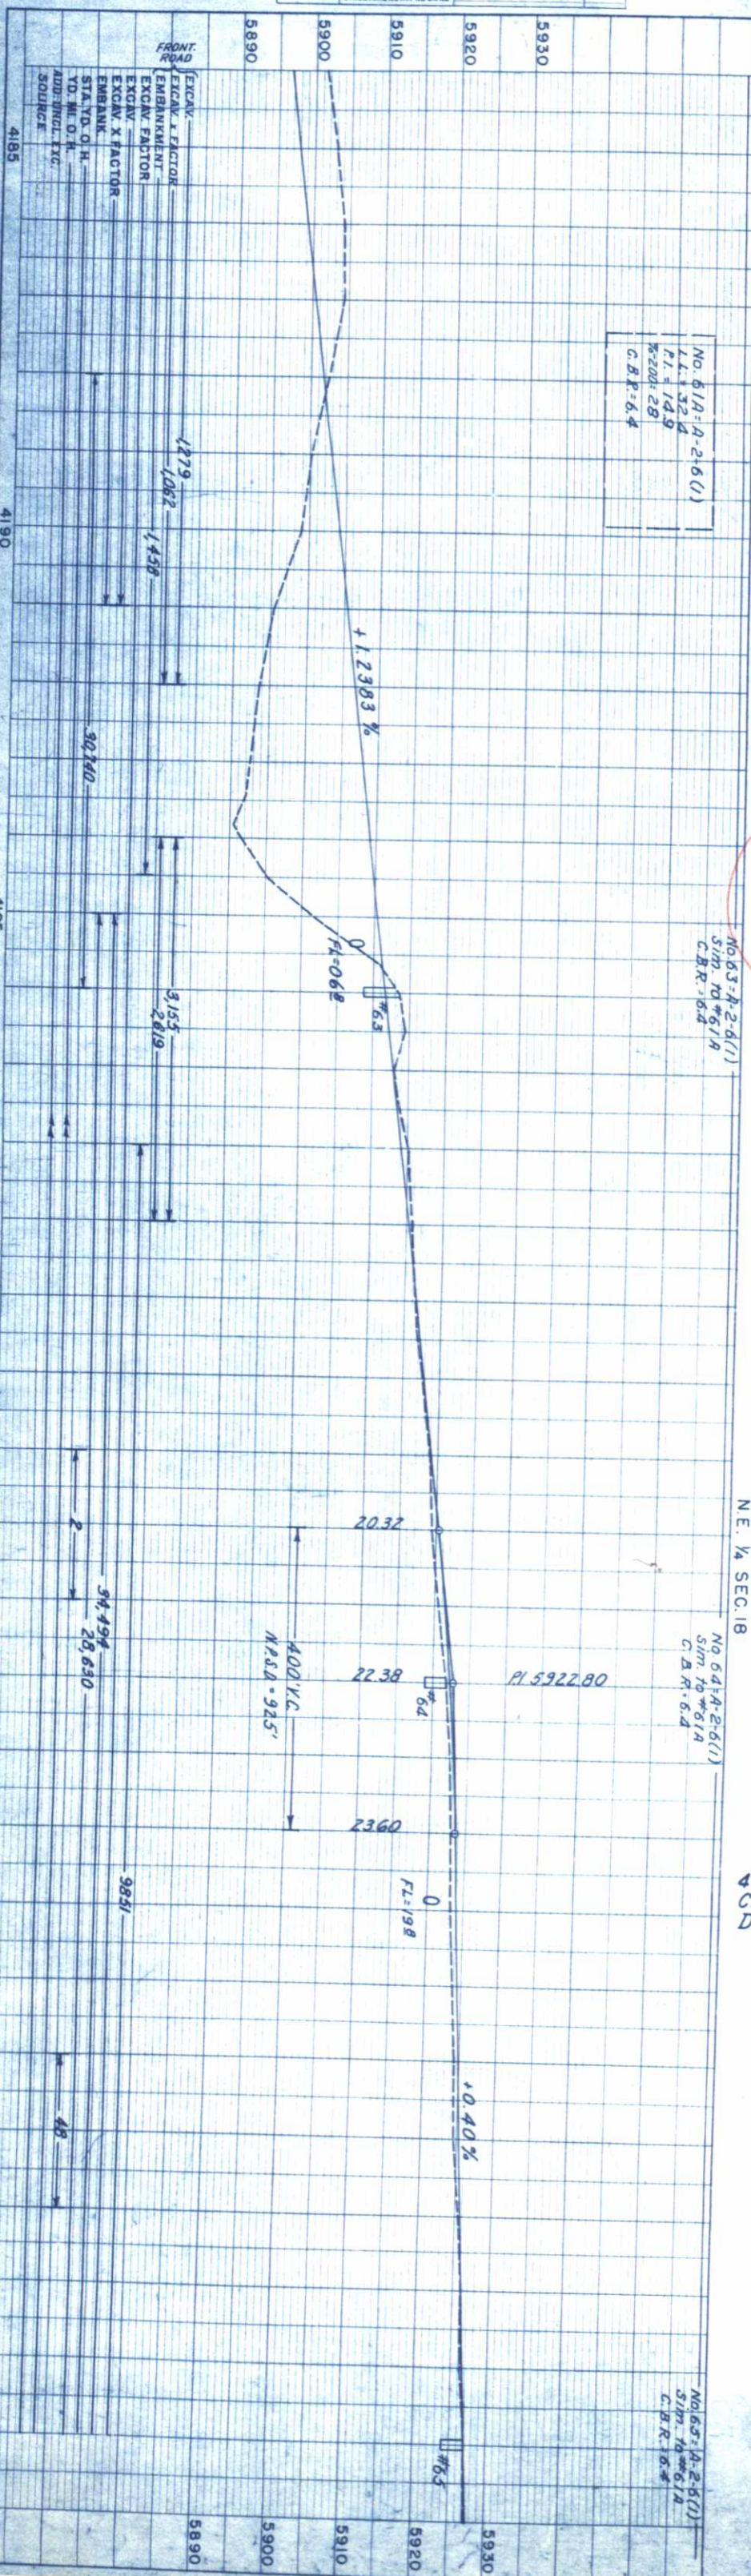

PLAN		BY	DATE
NOTE BOOK	SURVEYED		
	PLOTTED		
	ALIGNMENT CHECKED		
NO. 13605	RT. OF WAY CHECKED		

"L" Line



NO. 61A: A-2-6(1)
L.L. = 32.4
R.L. = 14.9
%-200: 2.8
C.B.R. = 6.4

NO. 66: A-2-6(1)
S.M. to 61A
C.B.R. = 6.4

NO. 67 = A-2-6(1) -
Sim. to # 61A
C.B.R. : 64

NO. 68: A-2-6(1)
Sim. to #61A

Nd. 69: A-2-5(1
Sinh. rd #61A

4226+ to 4227+ - Adjust
Ditch Bet. N.B. Lane & Fr.
Rd Rt to Drain Ah


4226+68 - Reg'd 24"x224'
Cross Culvt (Both Lanes
& Fr. Rd. Rt.) Ditches.

4230+00-Reg'd Type "A" Conc
Inlet (H=4') bet. N.B. Lane &
Fr. Rd, Rt. 24"x32' R.C.P.
under Fr. Rd. Rt.

4231+72 - Reg'd 36"x246'
Cross Culv't (Both Lanes &
Fr Rd Rt Ditches (W-2')

4234+00 ~ Req'd 24"x72'
Cross Culvt (S.B. Lane).

4242+81 ~ Reg'd 24"x48'
Cross Culvt (S.B. Lane) &
24"x56' (N.B. Lane). 24"x52'
R.C.P. under Fr. Rd., Rt.
Ditches.

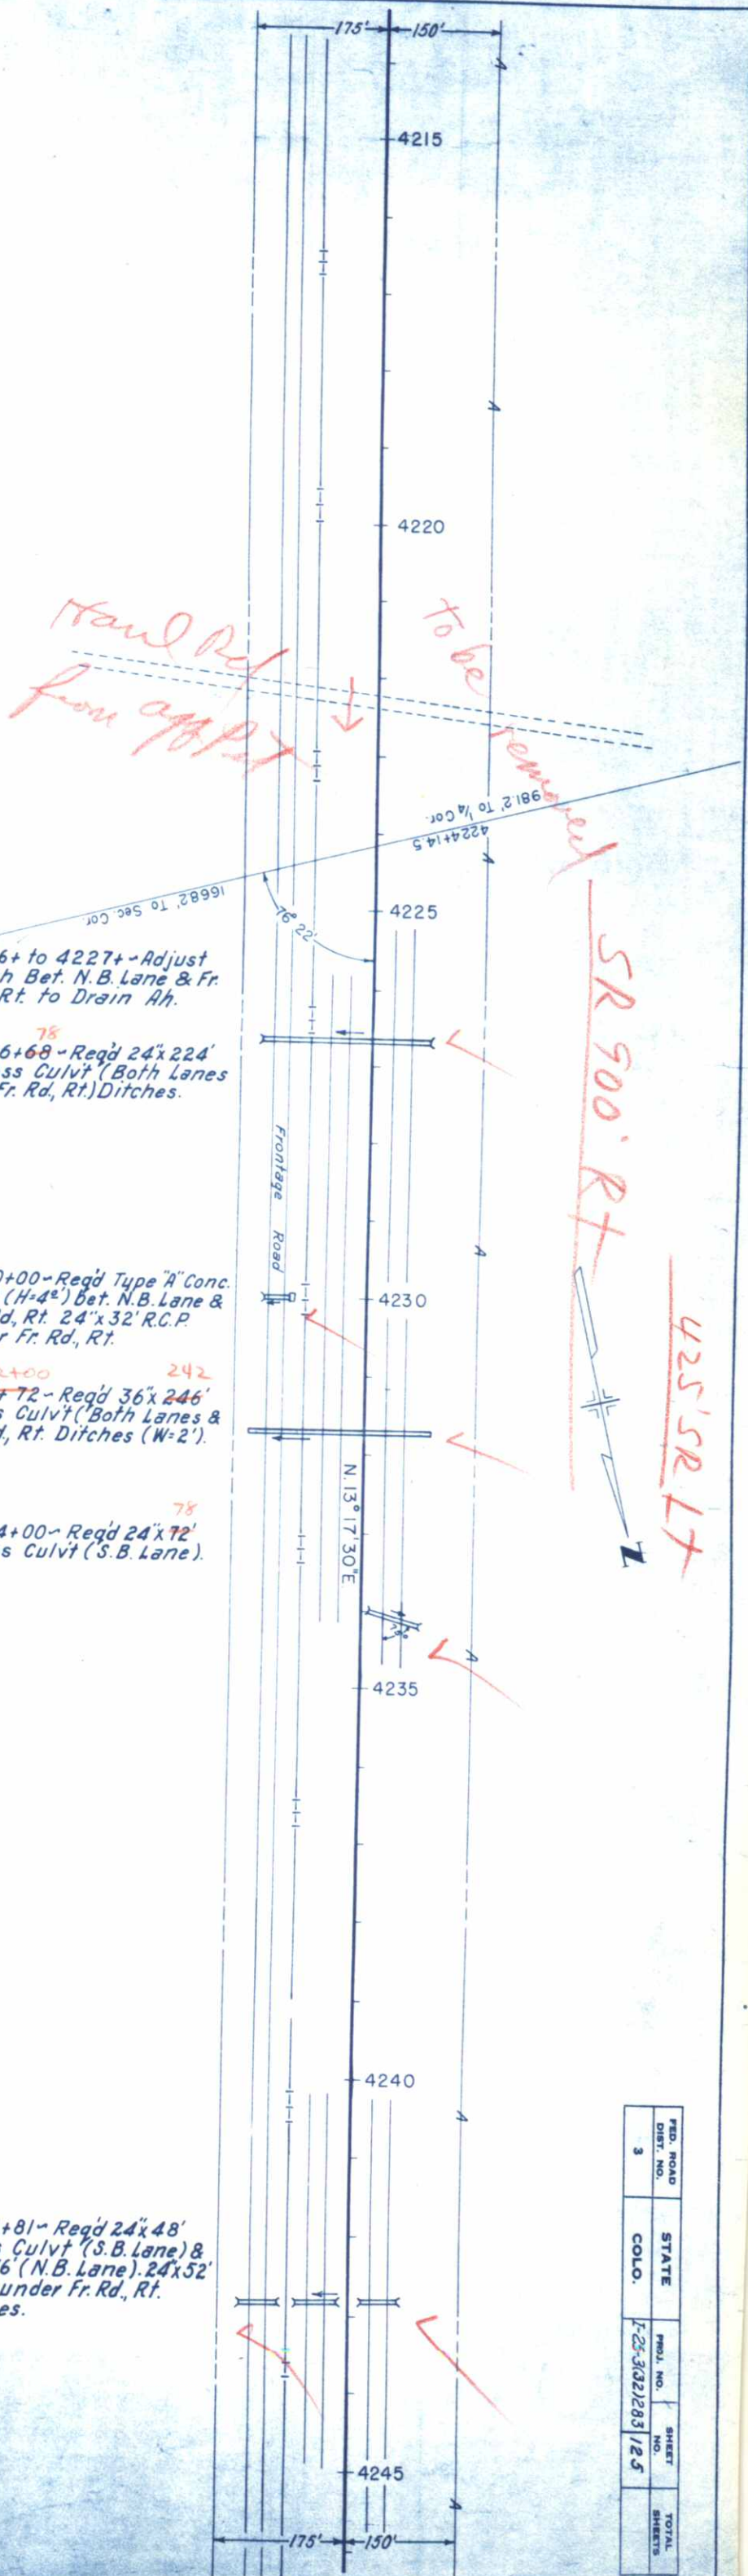

Hand Ref
from app


10

SR 900' R+

425 SR L7

FED. ROAD DIST. NO.	STATE	PROJ. NO.	SHEET NO.	TOTAL SHEETS
3	COLO.	I-25/302/283	125	

PLAN		BY	DATE
NOTE BOOK	SURVEYED		
	PLOTTED		
	ALIGNMENT CHECKED		
NO 13605	RT. OF WAY CHECKED		

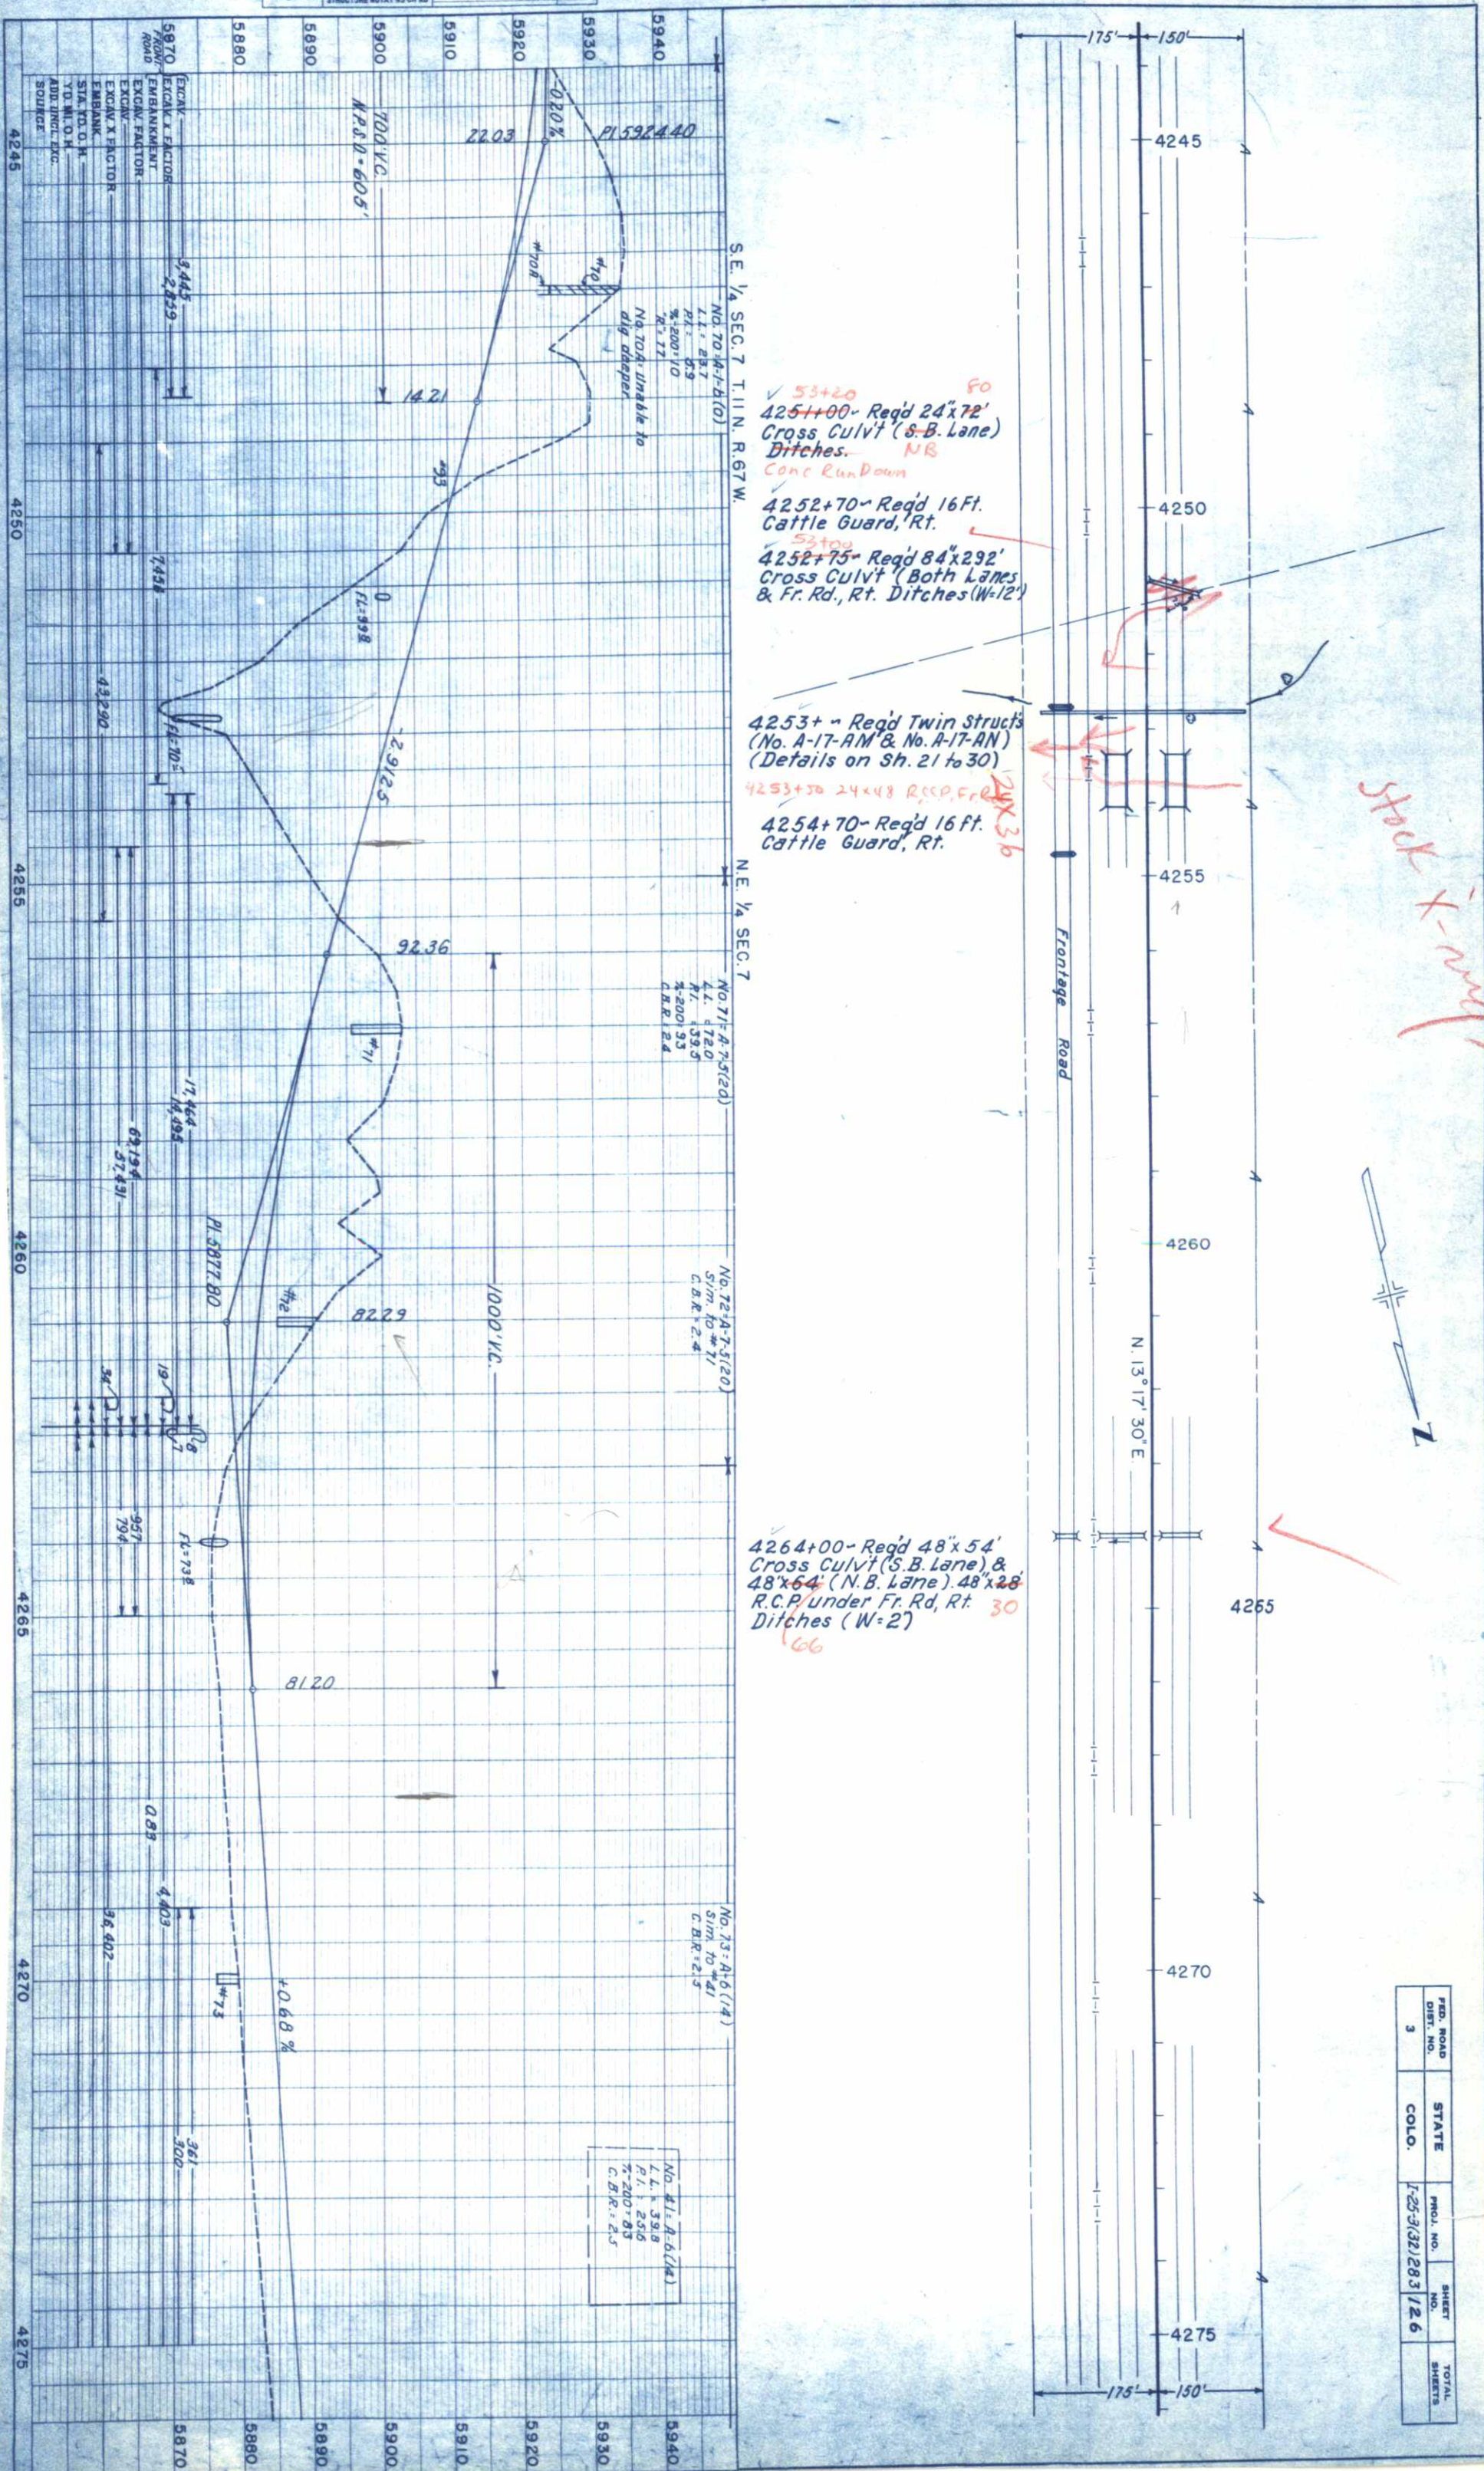

PROFILE	SURVEYED	BY	DATE
NOTE BOOK	PLOTTED		
	GRADES CHECKED		
NO. 13609	S.N. & NOTED		
	STRUCTURE NOTATIONS ON KD		

S.E. $\frac{1}{4}$ SEC. 6 T. 11 N. R. 67 W


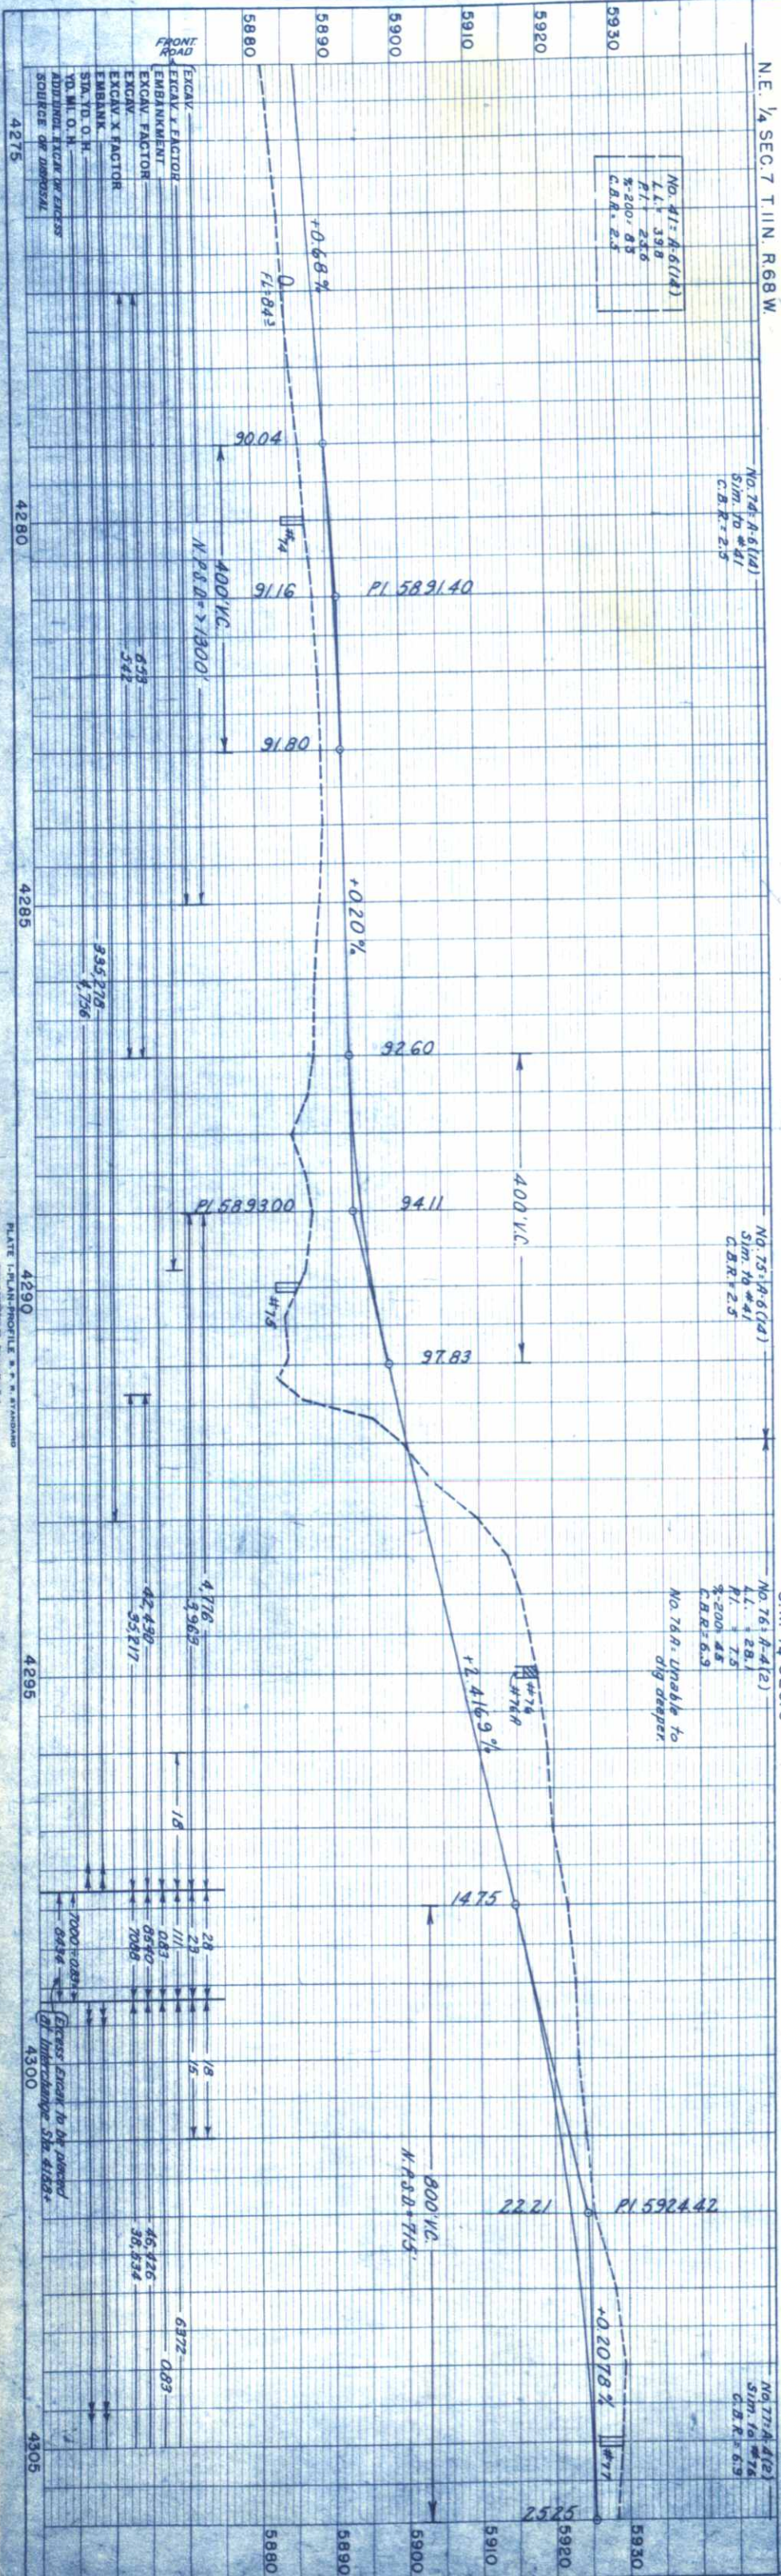


PLATE 1-PLAN-PROFILE B. P. M. STANDARD

FED. ROAD DIST. NO.	STATE	PROJ. NO.	SHEET NO.	TOTAL SHEETS
3	COLO.	I-25-3(32)283	127	

PROFILE	SURVEYED	BY	DATE
NOTE BOOK	PLOTTED	H.J. Winter	9-27
NO. 3683	GRADES CHECKED	R.L. Markley	10-27
	STRUCTURE NOTATION CHECKED		

PLAN	SURVEYED	BY	DATE
NOTE BOOK	PLOTTED	H.J. Winter	9-27
NO. 3683	ALIGNMENT CHECKED	R.L. Markley	10-27
	RT. OF WAY CHECKED		


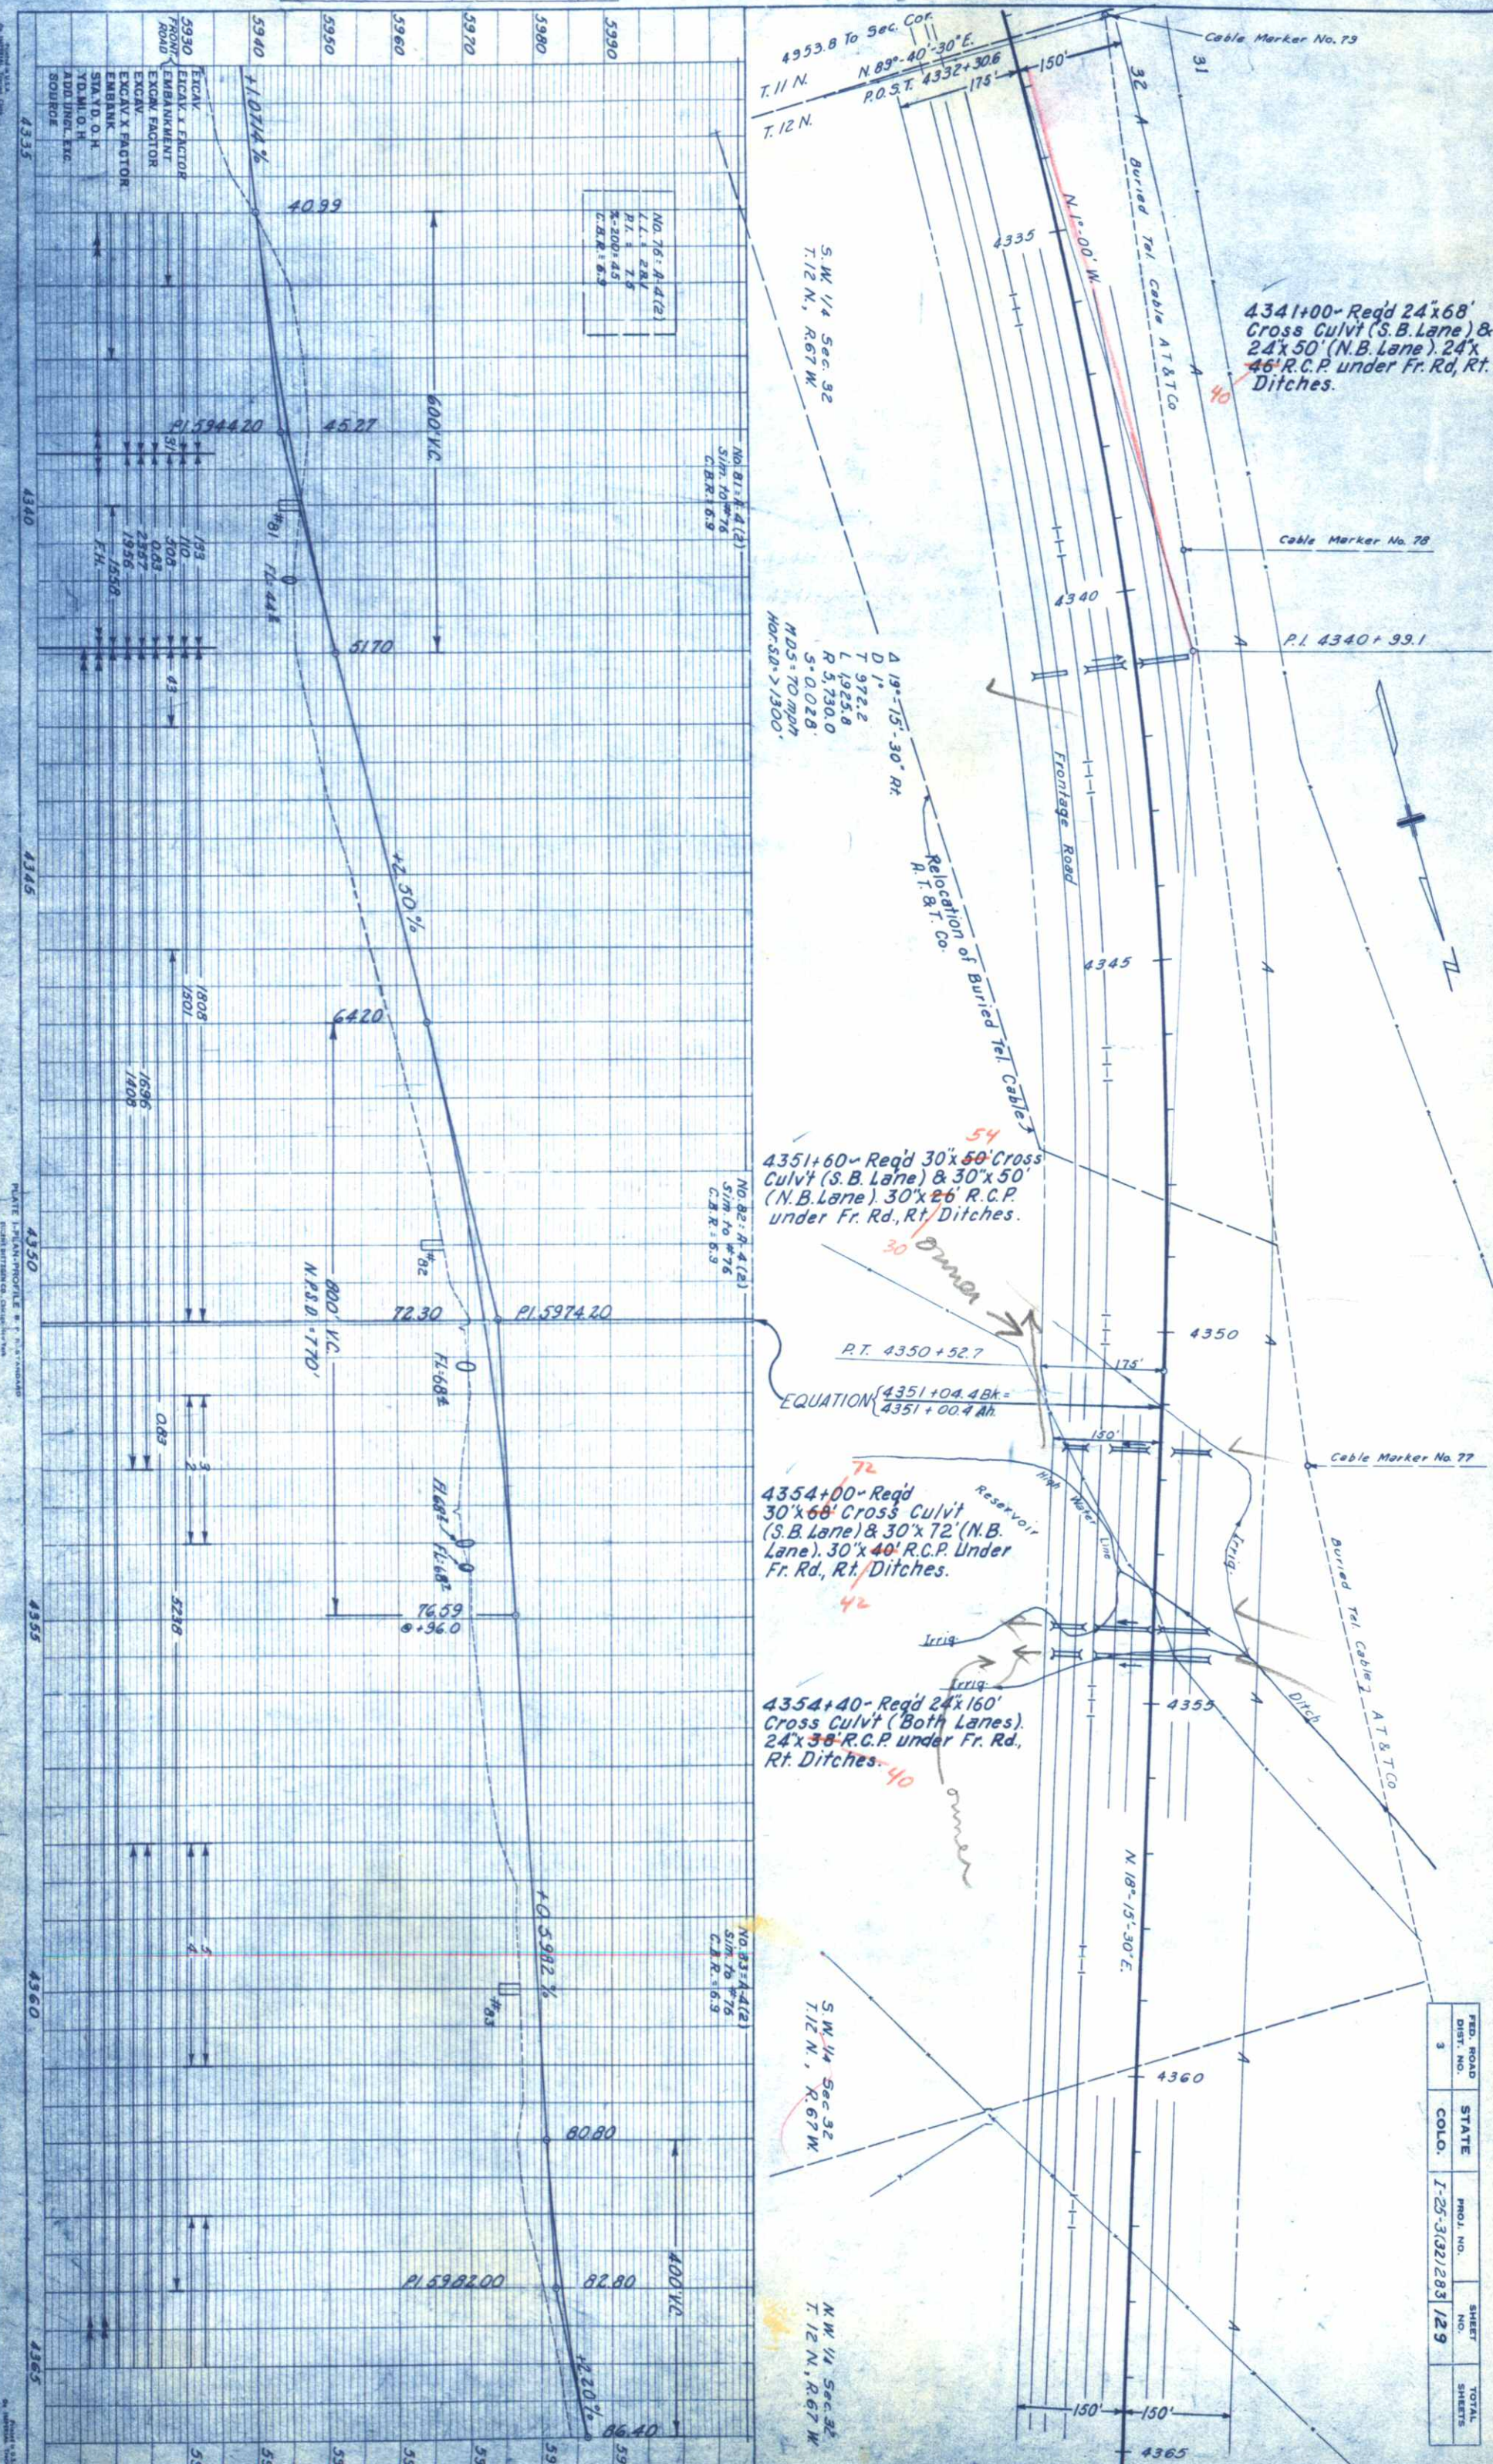


FED. ROAD DIST. NO.	STATE	PROJ. NO.	SHEET NO.	TOTAL SHEETS
3	COLO.	I-25-3(32)283	129	

PROFILE	DATE
NO. 13683	9-47
DATE	10-47
BY	H. J. Winter
BY	R. L. Marley
NOTE BOOK	
PLANNED	
GRADES CHECKED	
ALIGNMENT CHECKED	
HT. OF VAY CHECKED	


"W" Line

PLAN	DATE
NO. 13683	9-47
DATE	10-47
BY	H. J. Winter
BY	R. L. Marley
NOTE BOOK	
PLANNED	
GRADES CHECKED	
ALIGNMENT CHECKED	
HT. OF VAY CHECKED	

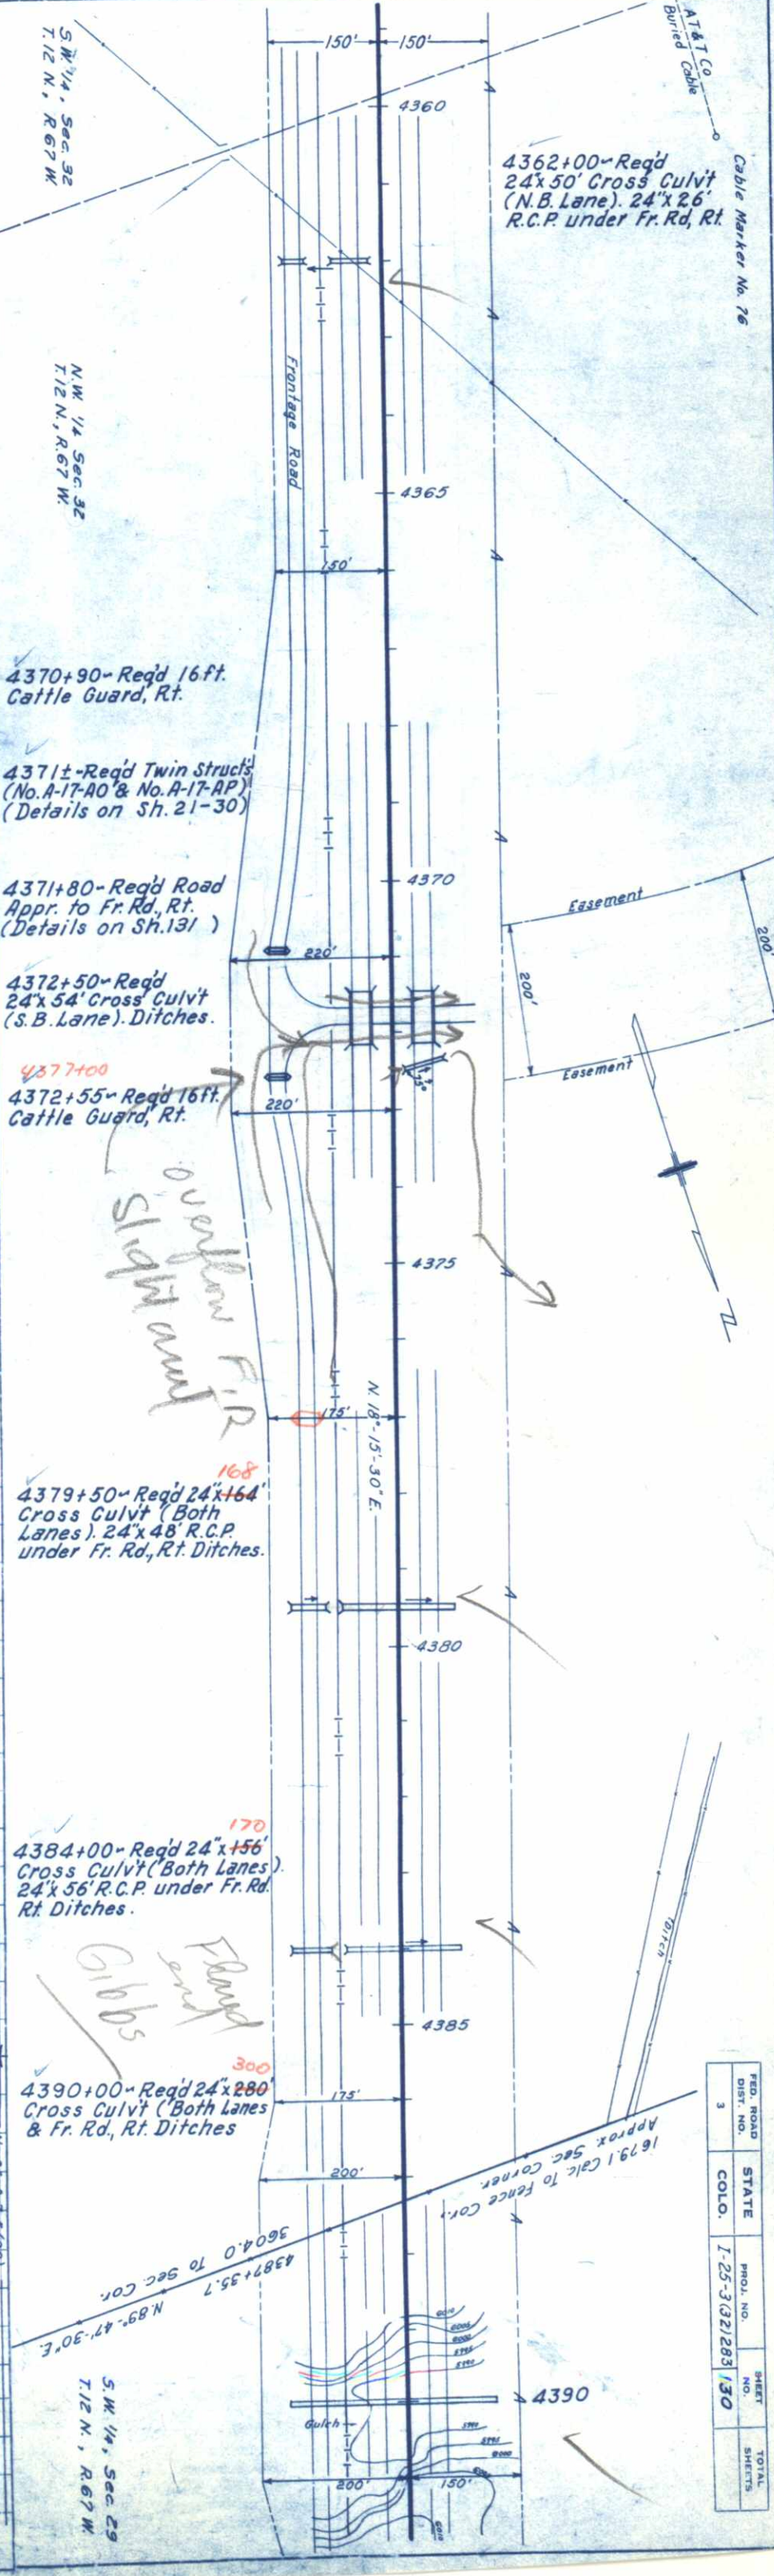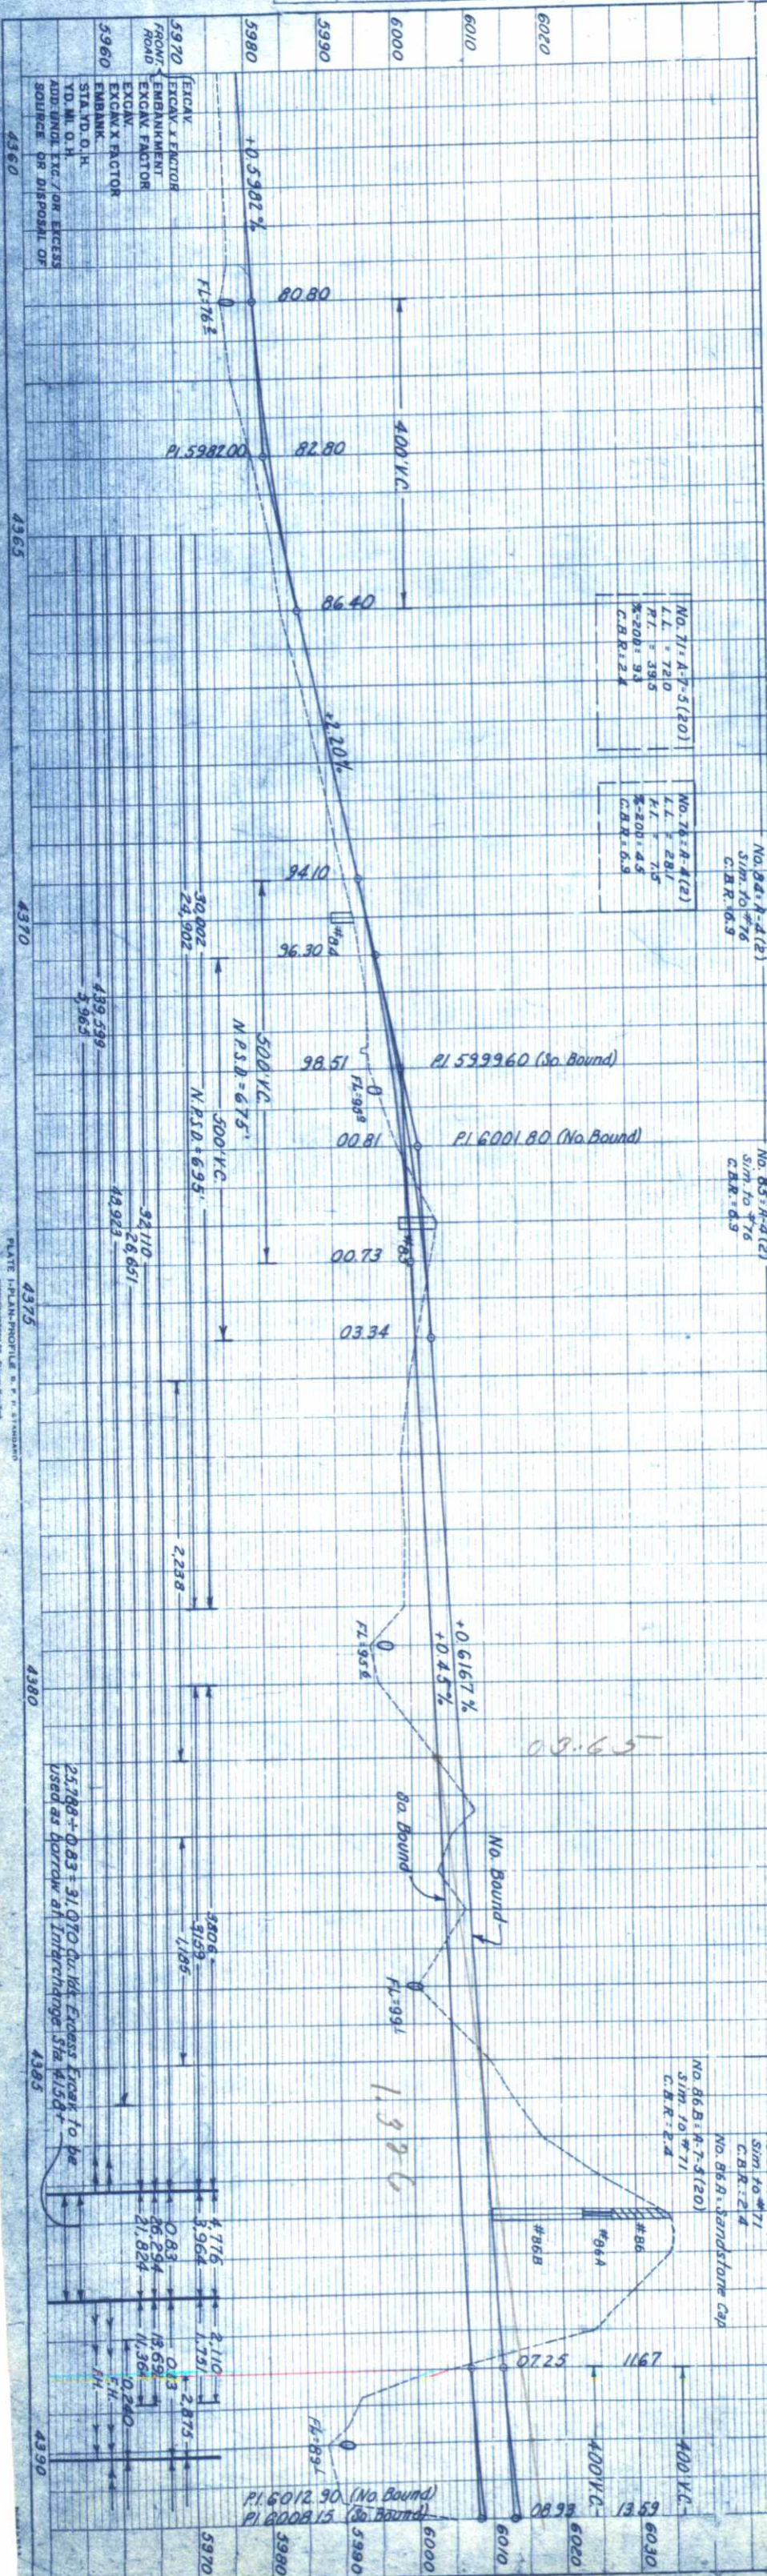

REQ. ROAD	STATE	PROJ. NO.	SHEET	TOTAL
DIST. NO.	COLO.	I-25-3(32)283	130	SHEETS
3				

PROFILE	SURVEYED	BY	DATE
NOTE BOOK	PLOTTED	R.C.P.	12-22
	GRADES CHECKED		
NO.	B.N. & NOTED		
	STRUCTURE NOTATIONS ON KD		

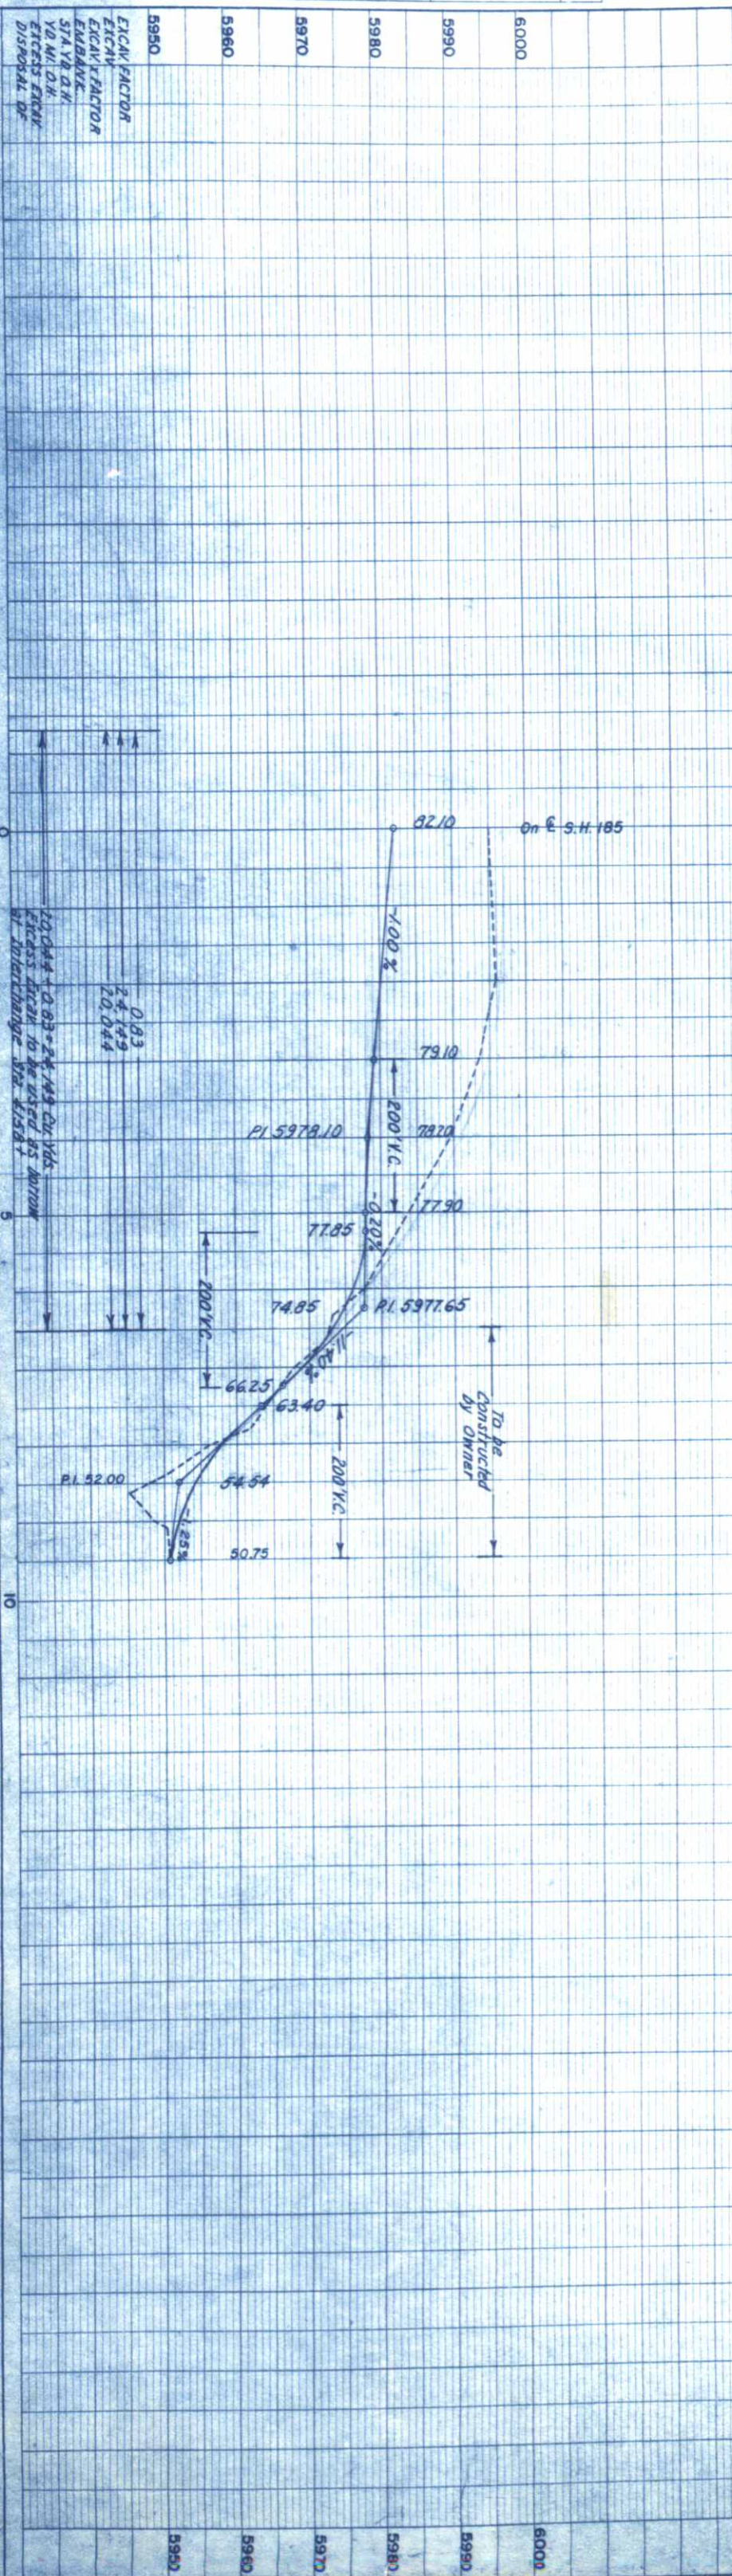

N.W. $\frac{1}{4}$ SEC. 32
T. 12 N., R. 67 W.

FED. ROAD DIST. NO.	STATE	PROJ. NO.	SHEET NO.	TOTAL SHEETS
3	COLO.	I-25-3(32)283	131	

Proposed Road Approach
Lt. Sta. 4371 + 90.9

73	RECEIVED
NOV 19 1964	NOTED
	STRUCTURE NOTATIONS CH'KD

