


STATE DEPARTMENT OF HIGHWAYS

DIVISION OF HIGHWAYS—STATE OF COLORADO

FEDERAL ROAD DISTRICT NO.	DIVISION	PROJECT NO.	SHEET NO.
VIII	COLORADO	170-1 (12) Sec. 4	1

RIGHT OF WAY		REVISIONS	
RIFLE—EAST & WEST		9-12-74	Rev. Beg. R.O.W. Sta. & Proj. Length D.J.F.
5-04	REV. SHT. 1, 2, 9, 19	JJ	

CONVENTIONAL SIGNS

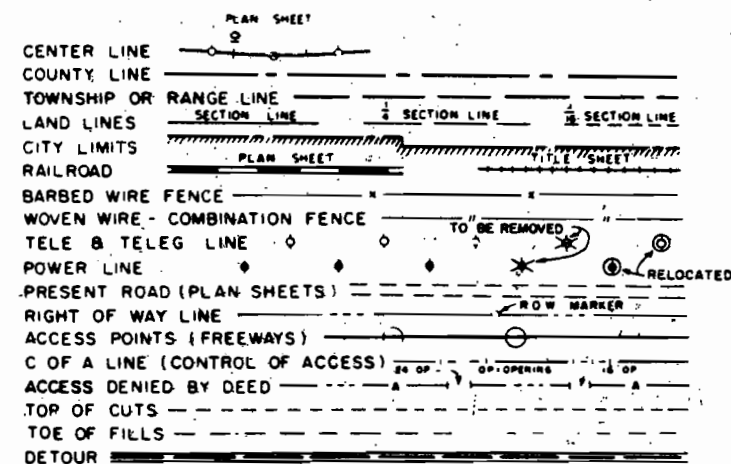

PLAN AND PROFILE OF PROPOSED FEDERAL AID PROJECT NO. 170-1 (12) SEC. 4 STATE HIGHWAY NO. 70 GARFIELD COUNTY

RIGHT OF WAY

SCALE OF ORIGINAL DRAWINGS
PLAN SHEETS 1" = 100'
DETAIL SHEETS 1" = 50'
OWNERSHIP MAPS 1" = 400' & 200'


R.O.W. LENGTH OF PROJECT = 30,757.2 = 5.825 MILES E.B.

INDEX OF SHEETS	
SHEET NO.	
1	TITLE SHEET
2-6	TABULATION OF OWNERSHIPS
7-18	ALIGNMENT SHEETS
19-24	OWNERSHIP MAPS
24	TOTAL OWNERSHIP MAP

BEGIN R.O.W. PROJECT 170-1 (12) Sec. 4 Sta. 669+18.1 E.B.
END R.O.W. PROJECT 170-1 (12) Sec. 3 Sta. 669+18.1 E.B.

RF 013-1 (23)
RIFLE - SPUR
CALC. RIVER NORTH

END R.O.W. PROJECT 170-1 (12) Sec. 4 Sta. 976+75.3 E.B.
BEGIN R.O.W. PROJECT 170-1 (12) Sec. 5 Sta. 976+75.3 E.B.

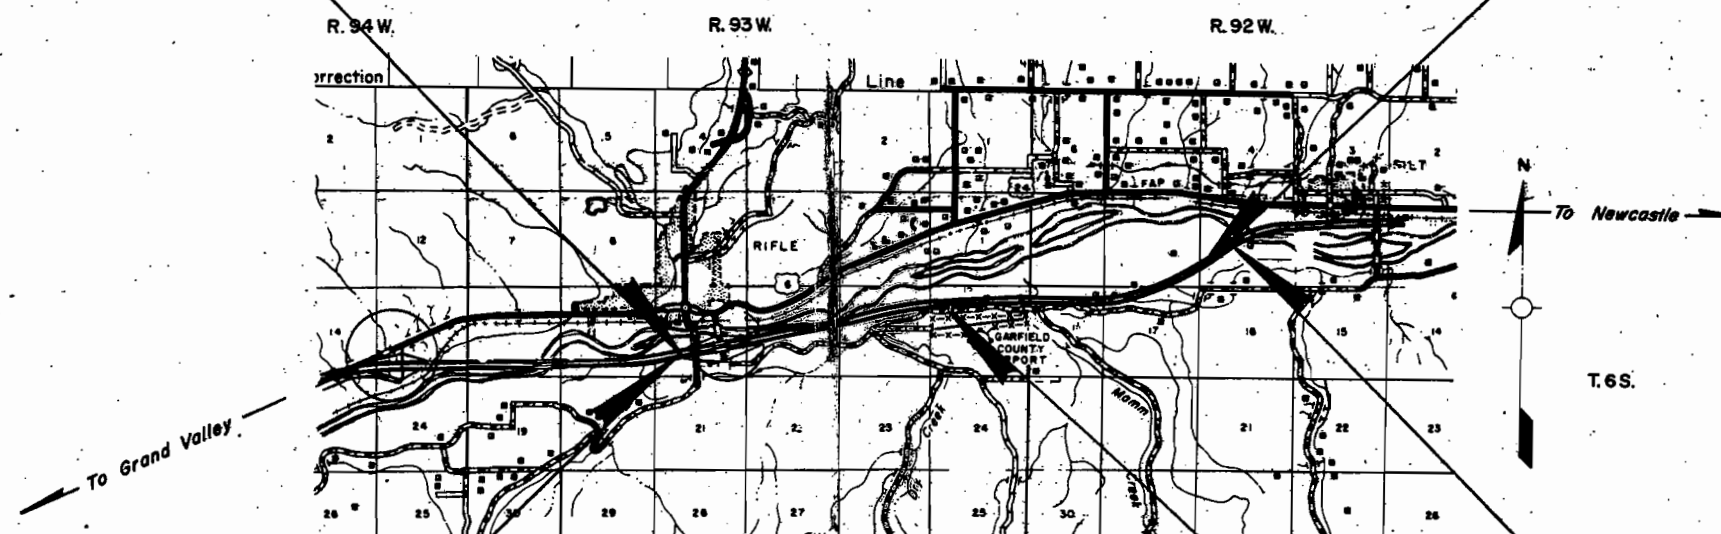

BEGIN CONST. 170-1 (43) Sta. 666+00 E.B.
END CONST. 170-1 (39) Sta. 666+00 E.B.

END CONST. 170-1 (43) Sta. 840+00 E.B.
BEGIN CONST. 170-1 (42) Sta. 840+00 E.B.

END CONST. 170-1 (42) Sta. 1001+00 E.B.
BEGIN CONST. 170-1 (41) Sta. 1001+00 E.B.

TYPICAL SECTIONS CONSTRUCT TO SUBGRADE THIS PROJECT EASTBOUND AND WESTBOUND ROADWAYS

FEDERAL ROAD REGION NO	DIVISION	PROJ. NO.	SHEET NO.	TOTAL SHEETS
VIII	COLORADO	I 70-1(42) 196	2	

(R-1) ~ Rev. Typical Section, Note-12-18-74-JLC


CUT AND FILL SLOPES
6:1 Slope when "H" is 10' or less
4:1 Slope when "H" is 10' to 25'
3:1 Slope when "H" is over 25'

In special cases slope may be steepened.

AS CONSTRUCTED
REVISED DATE
11-18-76

Median Slopes	
Slope	
Cut	Fill
84.3° to 85.4° Straight line connection between points of slope selection.	6:1

NOTE:
SEE STANDARDS FOR DETAILS OF CUT SLOPE TREATMENT, FLARING AND WIDENING.

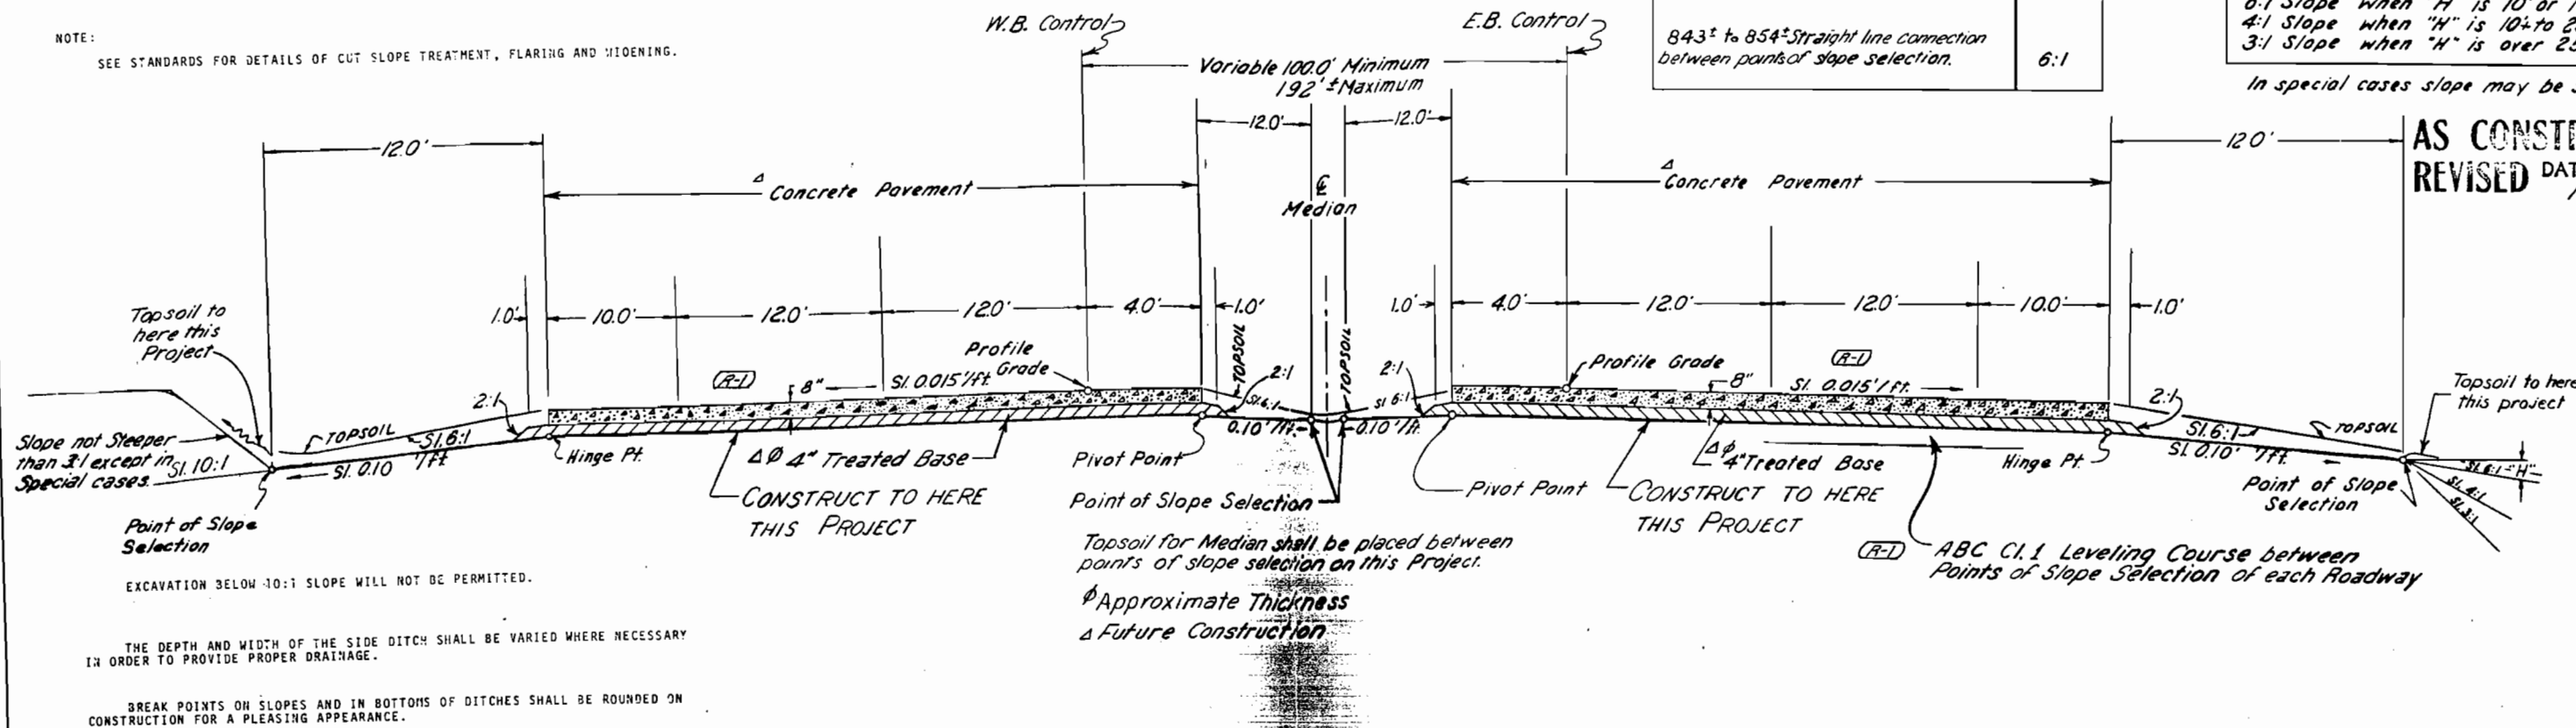


TABULATION OF R.O.W. MARKERS

STATION	LT.	RT.	STATION	LT.	RT.
840+00 E.B.		250'	900+99.9 E.B.		73.1'
844+00 E.B.		650'	903+00 E.B.	300'	
845+62.1 W.B.	200'		914+01.8 E.B.		62.5'
849+03.0 E.B.	300'		913+85.3 W.B.	200'	
850+56.3 E.B.		602.3'	916+85.3 W.B.	200'	
854+00 E.B.		550'	917+40.3 E.B.		59.8'
855+50 E.B.		300'	918+75.0 E.B.		100'
862+65.0 E.B.	300'		924+75.0 E.B.	358.9'	100'
865+24.0 W.B.	200'		933+00 E.B.	391.2'	100'
868+00 E.B.		300'	941+75.0 E.B.	358.9'	100'
871+00 W.B.	200'		947+75.0 E.B.		100'
872+00 E.B.		125'	948+35.3 W.B.	200'	
874+45 E.B.		665'	950+00 E.B.		100'
874+72 E.B.		164'	951+35.3 W.B.	225'	
879+00 W.B.	450'		960+00 E.B.		150'
881+48.9 E.B.		589.6'	961+40 E.B.	325'	
881+79.1 E.B.		657.5'	970+00 E.B.	325'	150'
882+00 W.B.	450'		980+00 E.B.	325'	150'
882+49.9 E.B.		450'	990+00 E.B.		150'
886+00.8 E.B.		369'	991+00 W.B.	225'	
890+00 E.B.		100'	993+14.2 W.B.	150'	
893+00 W.B.	200'		1001+00 E.B.	250'	150'
899+00 E.B.		100'			

ROW Markers are 3/8" Concrete Reinforcing Steel Bars with Aluminum Caps.
Concrete Nail in Concrete Footing of Steel Corner Post

TYPICAL DETOUR SECTION Sta. 885+00 E.B.

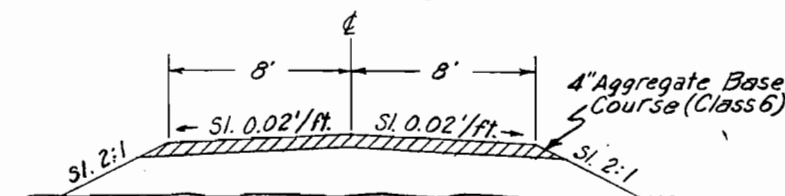

Detour Quantities (for Information only)

Item	Unit	Quantity
Aggregate Base Course (Class 6)	Ton	320
Unclassified Excav. (Embankment)	Cu.Yd.	600

AS CONSTRUCTED
REVISED DATE 11/23/76

FEDERAL ROAD REGION NO.	DIVISION	PROJ. NO.	SHEET NO.	TOTAL SHEETS
VIII	COLORADO	170-1(43)92	17	

FENCING TABULATION

ROW MARKERS IN PLACE E.B.L. Sta. Except as Noted	
Lt.	Rt.
670+00	678+00
683+91.0	682+92.5
684+50.6	683+61.6
684+92.5	689+14.4
687+54.8	694+25.4 (2 Caps)
687+66.0	697+63.5
689+13.4	705+00
690+59.9	706+50
46+36.18 S.H.13	712+50
E.O.A 580.8' West	726+83.3
706+50	732+83.3
709+24.6 WB	746+16.3
724+11.2 WB	752+16.3
732+83.3	769+83
746+16.3	775+83
752+16.3 WB	797+40
764+	803+40
765+	821+00
769+21.0 WB	832+03
775+21.0 WB	835+03
797+40	840+00
802+78.1 WB	
806+63.6 WB	
826+17.4	
832+03	
834+86.5 WB	

Private Survey Caps

BRACE POSTS		
	FINAL	Ref. Source
Corner & Line Br Post	49	Bk. 5, Pg. 10
End Post	25	Bk. 5, Pg. 10
Corner & Line Br Post (Special)	66	Bk. 5, Pg. 11
End Post (Special)	24	Bk. 5, Pg. 11

STATION	SIDE	REMOVAL OF FENCE	FENCE DEER		FENCE COMB. WIRE METAL POSTS	GATE DEER		16' GATE DRIVEWAY	
		LIN. FT.		LIN. FT.	LIN. FT.	EACH		EACH	
667+ EB	X	600							
671+ EB	X	1,130							
673+ EB	X	450							
676+ EB	X	690							
679+ EB	X	500							
681+ EB	X	1,900							
684+ EB	X	3,050							
689+ EB	X	1,780							
694+ EB	X	1,060							
695+ EB	LT	390							
698+ EB	X	1,525							
699+ EB	X	390							
708+ EB	X	1,375							
711+ EB	X	420							
725+ EB	X	570							
726+ EB	X	1,100							
736+ EB	X	400							
747+ EB	X	620							
755+ EB	X	850							
765+ EB	X	470							
772+ EB	X	1,030							
780+ EB	X	1,490							
794+ EB	X	470							
802+ EB	X	1,520							
812+ TO 828+ EB	LT	2,970							
832 TO 840 EB	LT	1,855							
666 TO 764 EB	LT				10,350				
764 TO 840 EB	LT		7,545		7,500				
666 TO 683 EB	RT		1,700						
683+ TO 705 EB	RT				2,200				
705+ TO 840 EB	RT		13,645						
797+ TO 840 EB	RT				4,395				
783+ (DRY CREEK)	LT & RT		680						
46+ SH 13 743+	LT. RT.					1		1	
75+ 830+ 830+ 832+	RT. LT. LT. & RT. LT. & RT.					1 2		1 2	
FINAL TOTALS		21,255	Bk. 5, Pg. 8	24,655	Bk. 5, Pg. 11	22,386	Bk. 5, Pg. 10	7	Bk. 5, Pg. 12
		20,995		23,570		24,445		6	Bk. 5, Pg. 12

IT IS ESTIMATED THE FOLLOWING WILL BE REQUIRED:

30 CORNER & LINE BRACE POSTS AND 27 END POSTS FOR COMB. WIRE FENCE

65 CORNER & LINE BRACE POSTS (SPECIAL) AND 32 END POSTS (SPECIAL) FOR DEER FENCE

DEER FENCE TO BE PLACED BETWEEN MAIN LINE AND FRONTAGE ROAD.

34" MESH

Design

R.O.W. TABULATION OF PROPERTIES IN GARFIELD COUNTY S.H.No. 70 PROJ. 170-1(12) SEC. 4

FEDERAL ROAD DIVISION NO.	DISTRICT	PROJECT NO.	SHEET NO.
8	COLORADO	170-1(12) SEC. 4	2
RIGHT OF WAY RIFLE EAST & WEST			

PARCEL NO.	OWNER	ADDRESS	LOCATION	AREA IN ACRES				PURCHASE DATA					REMARKS	NO.
				PARCEL	TO BE ACQUIRED	REMAINDER		LAND	IMPROV'M'TS	DAMAGE	MISC.	TOTAL		
			T. 6 S., R. 93 W., 6th P.M.			LT.	RT.							
401 Rev.	JAMES I. LAYNE & JUANITA M. LAYNE	RIFLE, COLORADO	LOTS 5, 6 & 7 SEC. 16	11.809	11.809	9.073	16.722							
402	MARJORIE B. SWEENEY & LAURENCE J. SWEENEY, J.T.	RIFLE, COLORADO	LOTS 6 & 7 SEC. 16	0.712	0.712	0	0						402-R IS REMAINDER RT.	
402-R	MARJORIE B. SWEENEY & LAURENCE J. SWEENEY, J.T.	RIFLE, COLORADO	LOT 6 SEC. 16	0.161	0.161									
403	ALBERT F. HAFNER & JOYCE L. HAFNER, J.T.	SOUTH OF RIFLE, COLORADO	LOT 7 SEC. 16	0.903	0.903	0	0							
404	S. C. BARNETT	RIFLE, COLORADO	LOT 7 SEC. 16	0.064	0.064	0.3	0							
405	COUNTY OF GARFIELD		LOT 7 SEC. 16	0.601	0.601									
406	LENA CLUGSTON & HUGH E. CLUGSTON, J.T.	SOUTH OF RIFLE, COLORADO	LOT 8 SEC. 16	3.220	3.220	0	0							
407	DANIEL T. LONG & EMMA P. B. LONG, J.T.	SOUTH OF RIFLE, COLORADO	LOT 8 SEC. 16	4.329	4.329	133 SQ. FT.								
408	CHARLES ERNEST PRATT & AGNES T. PRATT	SOUTH OF RIFLE, COLORADO	LOT 8 SEC. 16	0.263	0.263	0.7	0							
409	ECTYL J. DEGASE & MYRTLE DEGASE, J.T.		LOT 8 SEC. 16	0.080	0.080	1.9	0							
410 Rev.3	FRANK C. ANDERSON	321 E. 6th, RIFLE, COLORADO	PART OF LOTS 8 & 9 SEC. 16	20.502	20.502	0	0						410R Rev.2 IS REMAINDER LT. & 410-R-A IS REMAINDER RT.	
410-R Rev.2	FRANK C. ANDERSON	321 E. 6th, RIFLE, COLORADO	PART OF LOTS 8 & 9 SEC. 16	5.686	5.686									
410-R-A	FRANK C. ANDERSON (Note: has been sold)	321 E. 6th, RIFLE, COLORADO	PART OF LOTS 8 & 9 SEC. 16	0.161	0.161								sold to: Alpine Bank, a Colo. Corp. (B.1581 P.728) subject to: Transportation Comission approval	

R.O.W. TABULATION OF PROPERTIES IN GARFIELD COUNTY S.H.No. 70 PROJ. I 70-1(12) SEC. 4

FEDERAL ROAD DIVISION NO.	DISTRICT	PROJECT NO.	SHEET NO.
8	COLORADO	I 70-1(12) SEC. 4	3

RIGHT OF WAY RIFLE EAST & WEST

PARCEL NO.	OWNER	ADDRESS	LOCATION	AREA IN ACRES				PURCHASE DATA					REMARKS	NO.
				PARCEL	TO BE ACQUIRED	REMAINDER		LAND	IMPROV'M'TS	DAMAGE	MISC.	TOTAL		
			T. 6 S., R. 93 W., 6th P.M.			LT.	RT.							
411 Rev.	RONALD JAMES CRANDALL & BARBARA CRANDALL, J.T.		PART OF LOT 8 SEC. 16	0.301	0.301	0	0.406							
412 Rev.	MURIEL D. SWALLOW	0506 294 ROAD RIFLE, COLORADO	PART OF LOT 8 SEC. 16	0.435	0.435	0	0.692							
413 Rev.	JAKE SHAEFFER AKA JACOB SHAEFFER & FRIEDA SHAEFFER AKA FRIEDA C. SHAEFFER, J.T.	SOUTH OF RIFLE, COLORADO	PART OF LOTS 1&9 SEC. 16	25.635	25.635		49.4						413-R REV. IS REMAINDER LT.	
			LOTS 12-15 MCLEARN ORCHARD											
			LANDS, SW 1/4 NW 1/4 & NW 1/4											
			SW 1/4 SEC. 15											
413R, Rev. 2	JAKE SHAEFFER AKA JACOB SHAEFFER & FRIEDA SHAEFFER AKA FRIEDA C. SHAEFFER, J.T.	SOUTH OF RIFLE, COLORADO	LOTS 1&9 SEC. 16, LOTS 12-13	26.622	26.622								7 Add a portion of Meander Land located in the Colorado River which contains 7.49 ac., more or less	
			MCLEARN ORCHARD LANDS &											
			SW 1/4 NW 1/4 SEC. 15											
414 Rev.	JAKE BILLINGSLEY D.B.A. JAKE BILLINGSLEY & COMPANY AS TRUSTEE		LOTS 1-11 MCLEARN ORCHARD SEC. 15	37.212	37.212	120.3	666.3							
414-A	DELETED													
415 Rev.	AGNES HUNT		NW 1/4 SW 1/4, SE 1/4 NW 1/4	66.728	62.988	179.4	52.3							
			SW 1/4 NE 1/4 & LOTS 2 & 4											
			SEC. 14											
416	TOWN OF RIFLE		LOT 5 SEC. 14	14.800	14.800	0	94.9							
416-A	TOWN OF RIFLE		SE 1/4 NW 1/4, SW 1/4 NE 1/4	3.268	3.268	SEE PAR. 416								
			SEC. 13											
417 Rev.	RIFLE LAND ASSOCIATES, LTD.		SE 1/4 NW 1/4, SW 1/4 NE 1/4	17.758	17.758	0	1,620.3							
			& LOT 2 SEC. 13											
418 Rev.	GUY C. SNYDER & EVELYN E. SNYDER	SOUTH OF RIFLE, COLORADO	N 1/2 NE 1/4 & LOT 1 SEC. 13	57.048	50.492	203	7.6							

R.O.W. TABULATION OF PROPERTIES IN GARFIELD COUNTY S.H.No. 70 PROJ. I 70-1(12) SEC. 4

FEDERAL ROAD DIVISION NO.	DISTRICT	PROJECT NO.	SHEET NO.
8	COLORADO	I 70-1(12) SEC. 4	4


RIGHT OF WAY RIFLE EAST & WEST

PARCEL NO.	OWNER	ADDRESS	LOCATION	AREA IN ACRES				PURCHASE DATA					REMARKS	NO.
				PARCEL	TO BE ACQUIRED	REMAINDER		LAND	IMPROV'M'TS	DAMAGE	MISC.	TOTAL		
			T. 6 S., R. 93 W., 6th P.M.			LT.	RT.							
419-Rev.	JAMES G. SNYDER	SOUTH OF RIFLE, COLORADO	NE. 1/4 NE. 1/4 SEC. 13	0.566	0.566	0	2.3							
419-A	DELETED													
			T. 6 S., R. 92 W., 6th P.M.											
420-Rev.2	VALLEY FARMS, INC.		N. 1/2 NE. 1/4 & LOT 1 SEC. 18	54.615	53.202	203	15.9							
420R-Rev.	VALLEY FARMS, INC.		LOT 1 SEC. 18	1.600	1.600	SEE PAR. 420 Rev. 2								
421	KENNETH BALCOMB & WILLIS E. PARKINSON		PART OF NE. 1/4 NE. 1/4 SEC. 18	1.253	1.253	169	0							
422	AUDREY D. STOCKER & MABEL ROBINSON		NW. 1/4 NW. 1/4 SEC. 17	10.786	10.786	33.6	11.7							
423	J. COOKE WILSON, JR.		N. 1/2 NW. 1/4 SEC. 17 SE. 1/4 SW. 1/4 SEC. 8	18.302	18.302	57.9	1115.5							
424	CAROL JO SHIDELER 1/3 BARRY CRAIG SHIDELER 1/3 PAUL ROB SHIDELER 1/3		NW. 1/4 NE. 1/4 SEC. 17 S. 1/2 SE. 1/4 & NE. 1/4 SE. 1/4 SEC. 8	33.112	33.112	123.0	102.3							
426	CASCADE NATURAL GAS CO.		NW. 1/4 SW. 1/4 SEC. 14	0.503	0.503									
	PERMANENT EASEMENTS		T. 6 S., R. 93 W., 6th P.M.											
E-401	JAMES I. LAYNE & JUANITA M. LAYNE		LOT 6 SEC. 16	0.860	0.860								SEE NOTE ON SHEETS 7 & 8	
E-402	DIVISION OF HIGHWAYS TO: JAMES I. LAYNE & JUANITA M. LAYNE, J.T. & PUBLIC SERVICE COMPANY		LOT 6 SEC. 16	0.103	0.103									
E-413Rev	JAKE SHAEFFER AKA JACOB SHAEFFER & FRIEDA SHAEFFER AKA FRIEDA C. SHAEFFER, J.T.		LOT 12 MCLEARN ORCHARD LANDS SEC. 15	0.155	0.155									
E-414Rev	JAKE BILLINGSLEY D.B.A. JAKE BILLINGSLEY & COMPANY AS TRUSTEE		LOT 11 MCLEARN ORCHARD LANDS SEC. 15	0.021	0.021								IRRIGATION DITCH	
E-414-A	JAKE BILLINGSLEY D.B.A. JAKE BILLINGSLEY & COMPANY AS TRUSTEE		NE. 1/4 SW. 1/4 SEC. 14	0.131	0.131								UTILITY EASEMENT TO BE DEEDED DIRECTLY TO PUBLIC SERVICE COMPANY	

REVISIONS		
5-15-74	Rev. Remainder Par. 424	D.J.F.
9-12-74	Rev. 420-Name Chg. E-414-Added 426	D.J.F.
—	420R, E-401 & E-414-A	D.J.F.
12-30-74	Added Name to Par. E-402	D.J.F.
5-30-75	Rev. 419, 420 Rev., 420R.	—
—	Deleted 419A	K.C.
8-5-75	Added Parcel 426	J.B.
9-17-75	Revised E-413, E-414	J.B.

PARCEL 426 REPRESENTS ANY & ALL INTEREST IN A UTILITY EASEMENT GRANTED TO CASCADE NATURAL GAS CO. & QUIT CLAIMED BY THEM TO C.D.Q.H. IN EXCHANGE FOR A USE PERMIT.

→ B. 470 P. 263 Rec. 266664
ROAD APPROACH TO BE DEEDED TO LAYNE
UTILITY EASEMENT TO PUBLIC SERVICE COMPANY
→ B. 470 P. 262 Rec. 266663
IRRIGATION DITCH

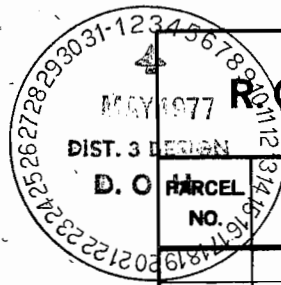

R.O.W. TABULATION OF PROPERTIES IN GARFIELD COUNTY S.H.No. 70 PROJ. I 70-1(12) SEC. 4

FEDERAL ROAD DISTRICT NO.	DISTRICT	PROJECT NO.	SHEET NO.
8	COLORADO	I 70-1(12) SEC. 4	5

RIGHT OF WAY RIFLE EAST & WEST

PARCEL NO.	OWNER	ADDRESS	LOCATION	AREA IN ACRES			PURCHASE DATA					REMARKS	NO.
				PARCEL	TO BE ACQUIRED	REMAINDER	LAND	IMPROV'M'TS	DAMAGE	MISC.	TOTAL		
			T. 6 S., R. 93 W., 6th P.M.			LT. RT.							
E-415	AGNES HUNT		SE. 1/4 NW. 1/4, SW. 1/4 NE. 1/4 & LOT 4 SEC. 14	2.459	2.459							UTILITY EASEMENT TO BE DEEDED DIRECTLY FROM AGNES HUNT TO PUB. SER. CO.	
E-415-A	AGNES HUNT		SE. 1/4 NW. 1/4, NE. 1/4 SW. 1/4 SEC. 14	0.299	0.299							UTILITY EASEMENT TO BE DEEDED DIRECTLY FROM AGNES HUNT TO PUBLIC SERVICE COMPANY	
E-418	GUY C. SNYDER & EVELYN E. SNYDER		NW. 1/4 NE. 1/4 & LOT 1 SEC. 13	2.271	2.271							UTILITY EASEMENT TO BE DEEDED DIRECTLY FROM GUY C. & EVELYN E. SNYDER TO PUBLIC SER. CO.	
E-418A-Rev	GUY C. SNYDER & EVELYN E. SNYDER		NW. 1/4 NE. 1/4 SEC. 13	0.032	0.032							UTILITY EASEMENT TO BE DEEDED DIRECTLY FROM GUY C. & EVELYN E. SNYDER TO PUBLIC SER. CO.	
			T. 6 S., R. 92 W., 6th P.M.										
E-420	VALLEY FARMS, INC.		NE. 1/4 NE. 1/4 SEC. 18	0.686	0.686							IRRIGATION DITCH	
E-421	KENNETH BALCOMB & WILLIS E. PARKINSON		NE. 1/4 NE. 1/4 SEC. 18	0.078	0.078							IRRIGATION DITCH	
E-424	CAROL JO SHIDELER 1/3 BARRY CRAIG SHIDELER 1/3 PAUL ROB SHIDELER 1/3		NE. 1/4 SE. 1/4 SEC. 8	0.114	0.114							IRRIGATION DITCH	
E-425	DELETED												
	TEMPORARY EASEMENTS		T. 6 S., R. 93 W., 6th P.M.										
TE-401	DELETED												
TE-409	ECTYL J. DEGASE & MYRTLE DEGASE, J.T.		LOT 8 SEC. 16	0.132	0.132							IRRIGATION DITCH	
TE-413	JAKE SHAEFFER AKA JACOB SHAEFFER & FRIEDA SHAEFFER AKA FRIEDA C. SHAEFFER		LOT 9 SEC. 16 LOTS 12-15 MCLEARN ORCHARD LANDS SEC. 15	1.246	1.246							IRRIGATION DITCH	
TE-414	JAKE BILLINGSLEY D.B.A. JAKE BILLINGSLEY & COMPANY AS TRUSTEE		LOT 4 SEC. 15	0.796	0.796							IRRIGATION DITCH	
TE-414A-Rev	JAKE BILLINGSLEY D.B.A. JAKE BILLINGSLEY & COMPANY AS TRUSTEE		LOTS 1-11 MCLEARN ORCHARD LANDS SEC. 15	1.841	1.841							IRRIGATION DITCH	

REVISIONS		
5-15-74	Correct County	D.A.P.
5-12-74	Added E-415, E-418A, E-418 & E-418A	D.A.P.
	Deleted TE-401-Home Ch. TE-404, TE-405 & TE-406	D.A.P.
2-30-76	Home Ch. E-418 & E-418A	D.A.P.
5-30-75	Revised E-418A	D.A.P.
5-17-75	Revised TE-414-A	D.A.P.
4-25-77	Deleted E-425	D.A.P.

R. O. W. TABULATION OF PROPERTIES IN GARFIELD COUNTY S.H. No. 70 PROJ. I 70-1(12) SEC. 4

FEDERAL ROAD DIVISION NO.	DISTRICT	PROJECT NO.	SHEET NO.
8	COLORADO	I 70-1(12) SEC. 4	6

RIGHT OF WAY RIFLE EAST & WEST

PARCEL NO.	OWNER	ADDRESS	LOCATION	AREA IN ACRES			PURCHASE DATA					REMARKS	NO.
				PARCEL	TO BE ACQUIRED	REMAINDER	LAND	IMPROV'M'TS	DAMAGE	MISC.	TOTAL		
			T. 6 S., R. 93 W., 6th P.M.										
TE-414 B	DELETED												
TE-414 C	DELETED												
TE-414 D	JAKE BILLINGSLEY D.B.A. JAKE BILLINGSLEY & COMPANY AS TRUSTEE		LOTS 1-4 MCLEARN ORCHARD LANDS SEC. 15	1.355	1.355							IRRIGATION DITCH	
TE-415	AGNES HUNT		NW. 1/4 SW. 1/4 SEC. 14	0.239	0.239							IRRIGATION DITCH	
TE-418	GUY C. SNYDER & EVELYN E. SNYDER		LOT 1 SEC. 13	0.430	0.430							IRRIGATION DITCH	
TE-418 A	GUY C. SNYDER & EVELYN E. SNYDER		N. 1/2 NE. 1/4 SEC. 13	1.429	1.429							IRRIGATION DITCH	
TE-418 B	GUY C. SNYDER & EVELYN E. SNYDER		N. 1/2 NE. 1/4 SEC. 13	0.291	0.291							CHANNEL CHANGE	
			T. 6 S., R. 92 W., 6th P.M.										
TE-420	VALLEY FARMS, INC.		N. 1/2 NE. 1/4 & LOT 1 SEC. 18	1.304	1.304							IRRIGATION DITCH	
TE-420 A	VALLEY FARMS, INC.		N. 1/2 NE. 1/4 & LOT 1 SEC. 18	0.367	0.367							IRRIGATION DITCH	
TE-420 B	VALLEY FARMS, INC.		LOT 1 SEC. 18	0.596	0.596							CHANNEL CHANGE	
TE-423	J. COOKE WILSON, JR.		SE. 1/4 SW. 1/4 SEC. 8	0.305	0.305							IRRIGATION DITCH	
TE-424	CAROL JO SHIDELER 1/3 BARRY CRAIG SHIDELER 1/3 PAUL ROB SHIDELER 1/3		NE. 1/4 SE. 1/4 SEC. 8	0.530	0.530							IRRIGATION DITCH	


REVISIONS		
5-15-74	Correct County	D.J.F.
9-12-74	Revised Sheet	D.J.F.
12-30-74	Name Chg. TE-418 & TE-419A	D.J.F.
2-13-75	Correct Acreage TE-414-D	J.B.
5-30-75	Added TE-418B & TE-420B	K.C.
9-17-75	Deleted TE-414-B & TE-414-C	J.B.

T. 6 S., R. 93 W., 6th P.M.

FEDERAL ROAD REGION NO.	DIVISION	PROJ. NO.	SHEET NO.	TOTAL SHEETS
XIII	COLORADO	I 70-1 (12) Sec. 4	7	24

RIGHT OF WAY
RIFLE EAST & WEST

REVISIONS		
5-15-74	Added Parcel lines 402 - 404	D.J.F.
9-12-74	Rev. 401 - Added E-401 - Deleted TE-401	D.J.F.
10-31-74	Rev. Notes E-401 & E-402	D.J.F.
12-30-74	Corrected Southerly Meander Line	J.G.

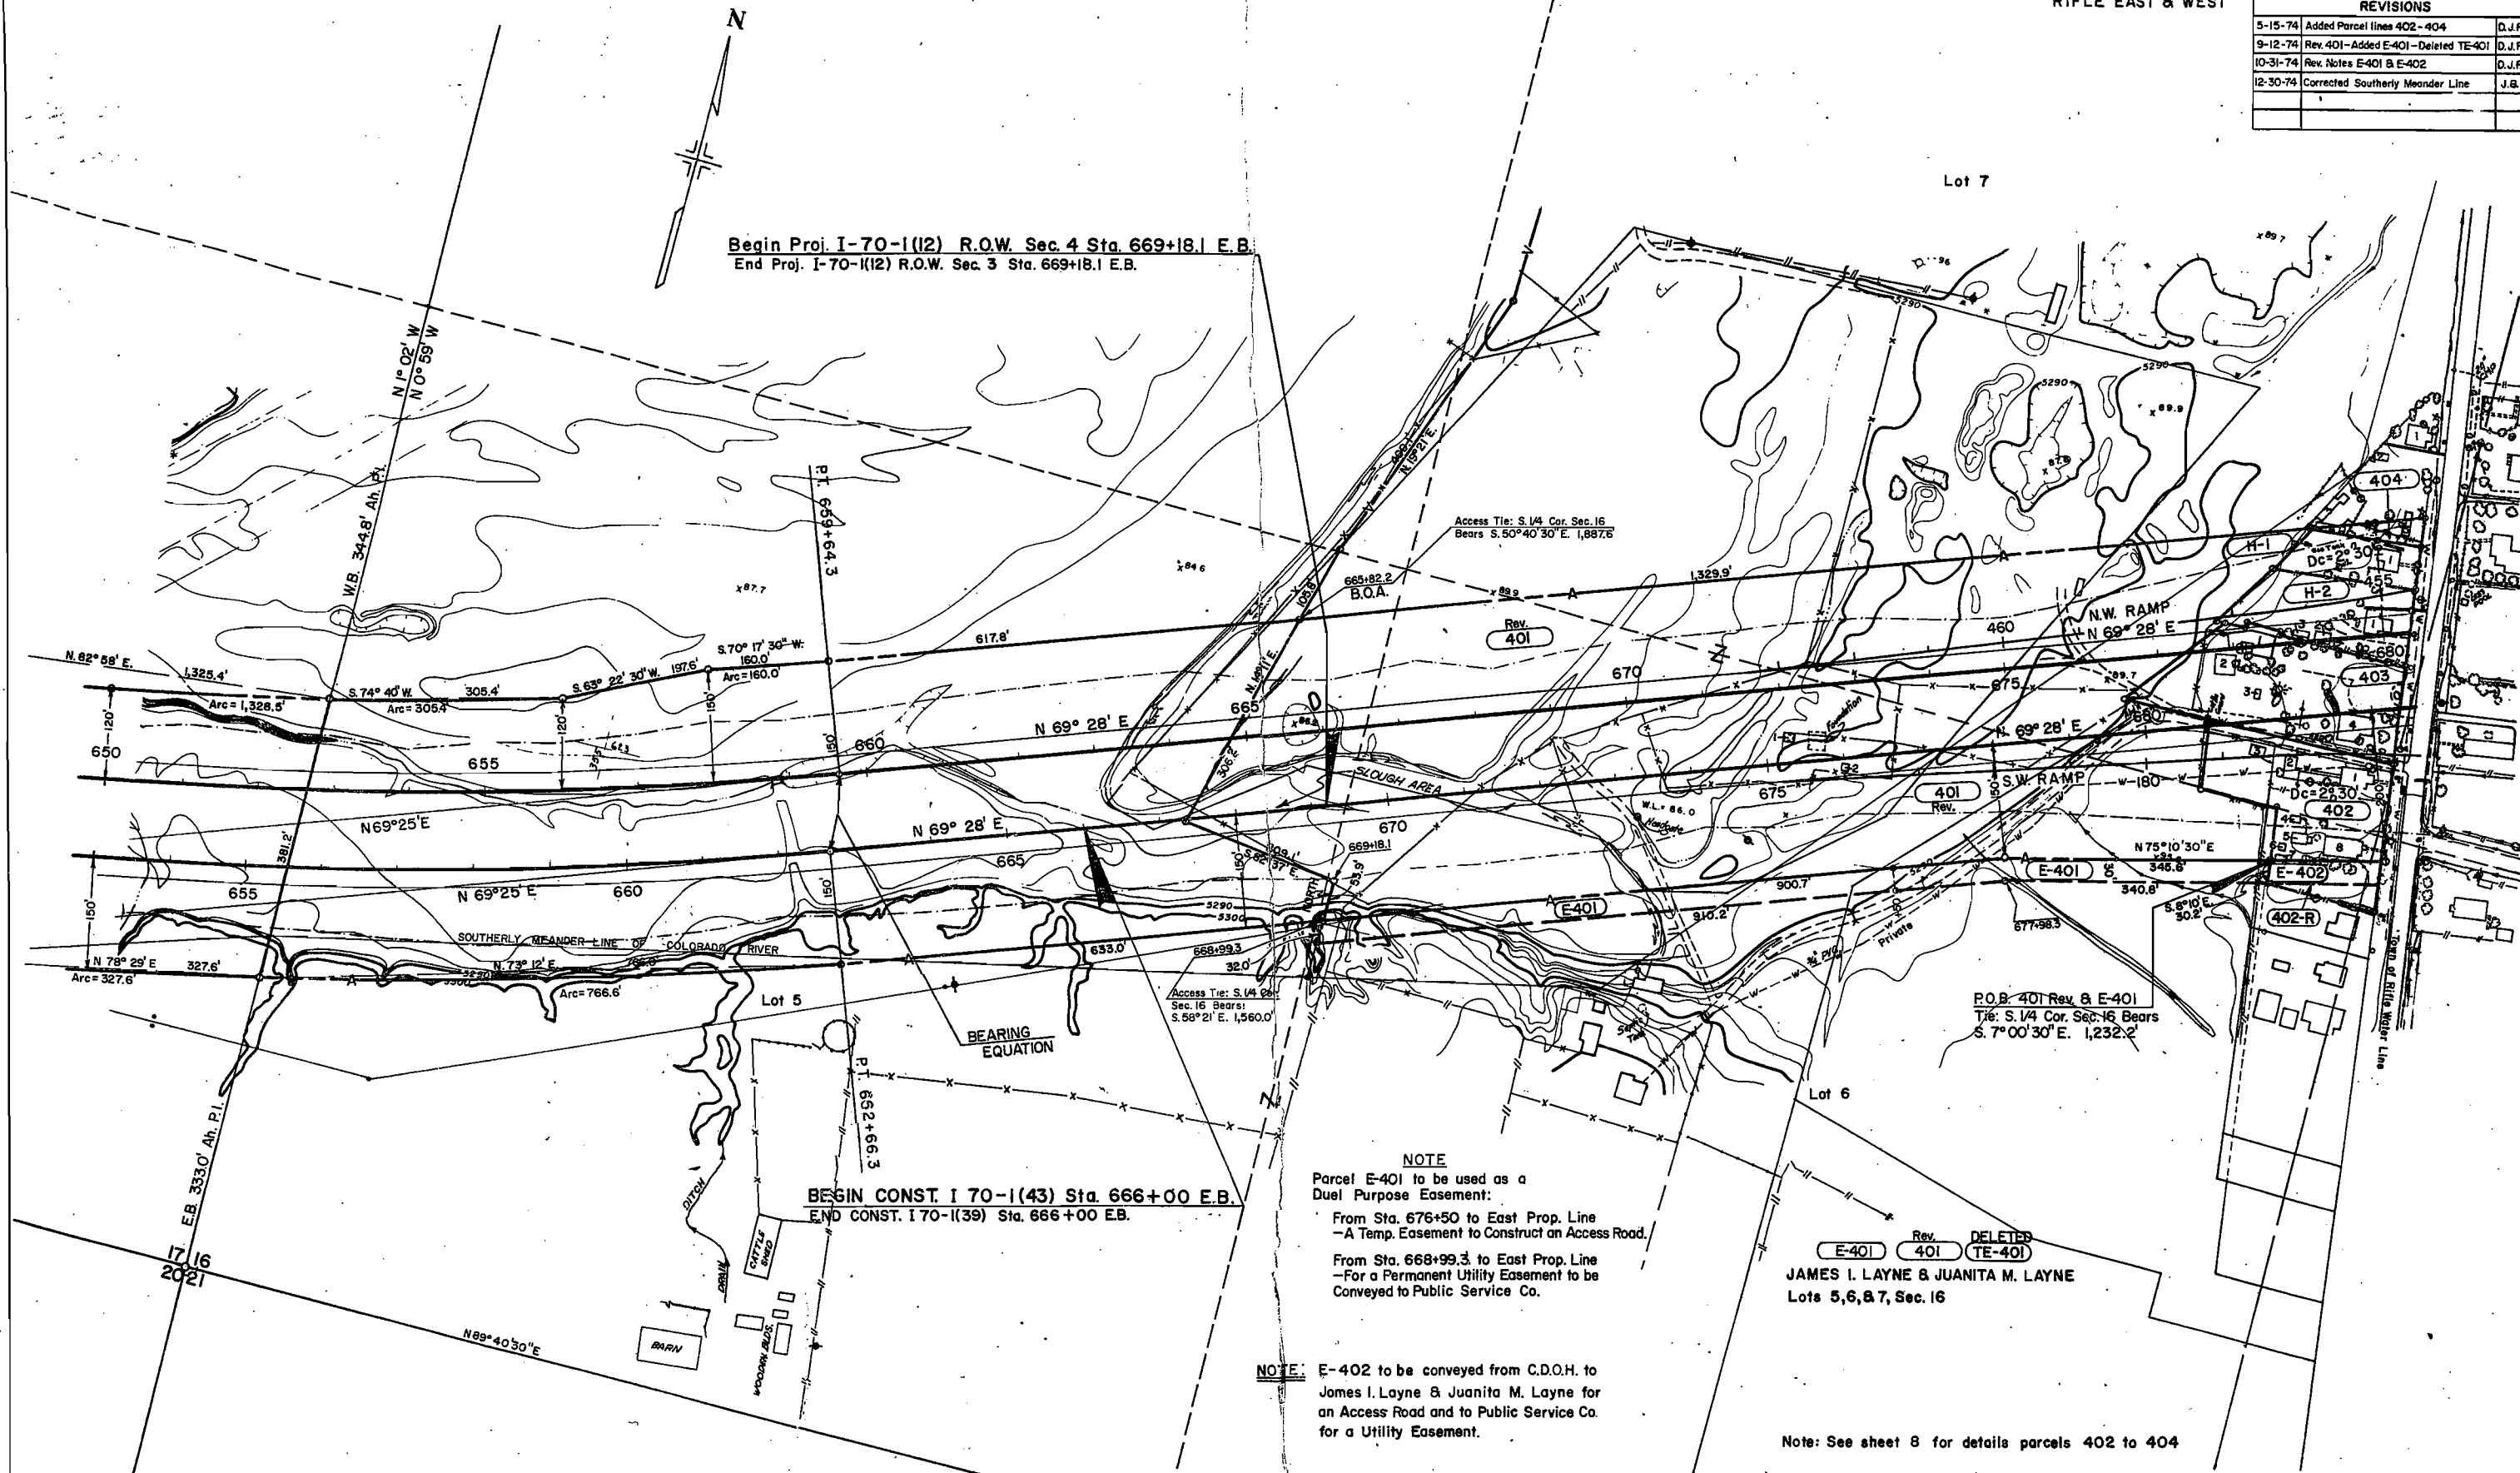

Begin Proj. I-70-1(12) R.O.W. Sec. 4 Sta. 669+18.1 E.B.
End Proj. I-70-1(12) R.O.W. Sec. 3 Sta. 669+18.1 E.B.

BEGIN CONST. I 70-1(43) Sta. 666+00 E.B.
END CONST. I 70-1(39) Sta. 666+00 E.B.

NOTE
Parcel E-401 to be used as a
Dual Purpose Easement:
From Sta. 676+50 to East Prop. Line
-A Temp. Easement to Construct an Access Road.
From Sta. 668+99.3 to East Prop. Line
-For a Permanent Utility Easement to be
Conveyed to Public Service Co.

NOTE E-402 to be conveyed from C.D.O.H. to
James I. Layne & Juanita M. Layne for
an Access Road and to Public Service Co.
for a Utility Easement.

DELETED
E-401 Rev. 401 TE-401
JAMES I. LAYNE & JUANITA M. LAYNE
Lots 5, 6, & 7, Sec. 16

Note: See sheet 8 for details parcels 402 to 404

FEDERAL ROAD REGION NO.	DIVISION	PROJ. NO.	SHEET NO.	TOTAL SHEETS
8	COLORADO	170-1(12) Sec. 4	8	24


RIGHT OF WAY

RIFLE - EAST & WEST

Scale 1" = 50'

REVISIONS

DATE	DESCRIPTION	BY
5-15-74	Corr. R.O.W. line Rt. Sta. 682+	D.J.F.
9-12-74	Rev. 401 - Added E-401 - Deleted TE-401	D.J.F.
10-31-74	Rev. Notes on E-401 & E-402	D.J.F.
12-30-74	Correct Bearing 403 - Name Cha. 406	D.J.F.

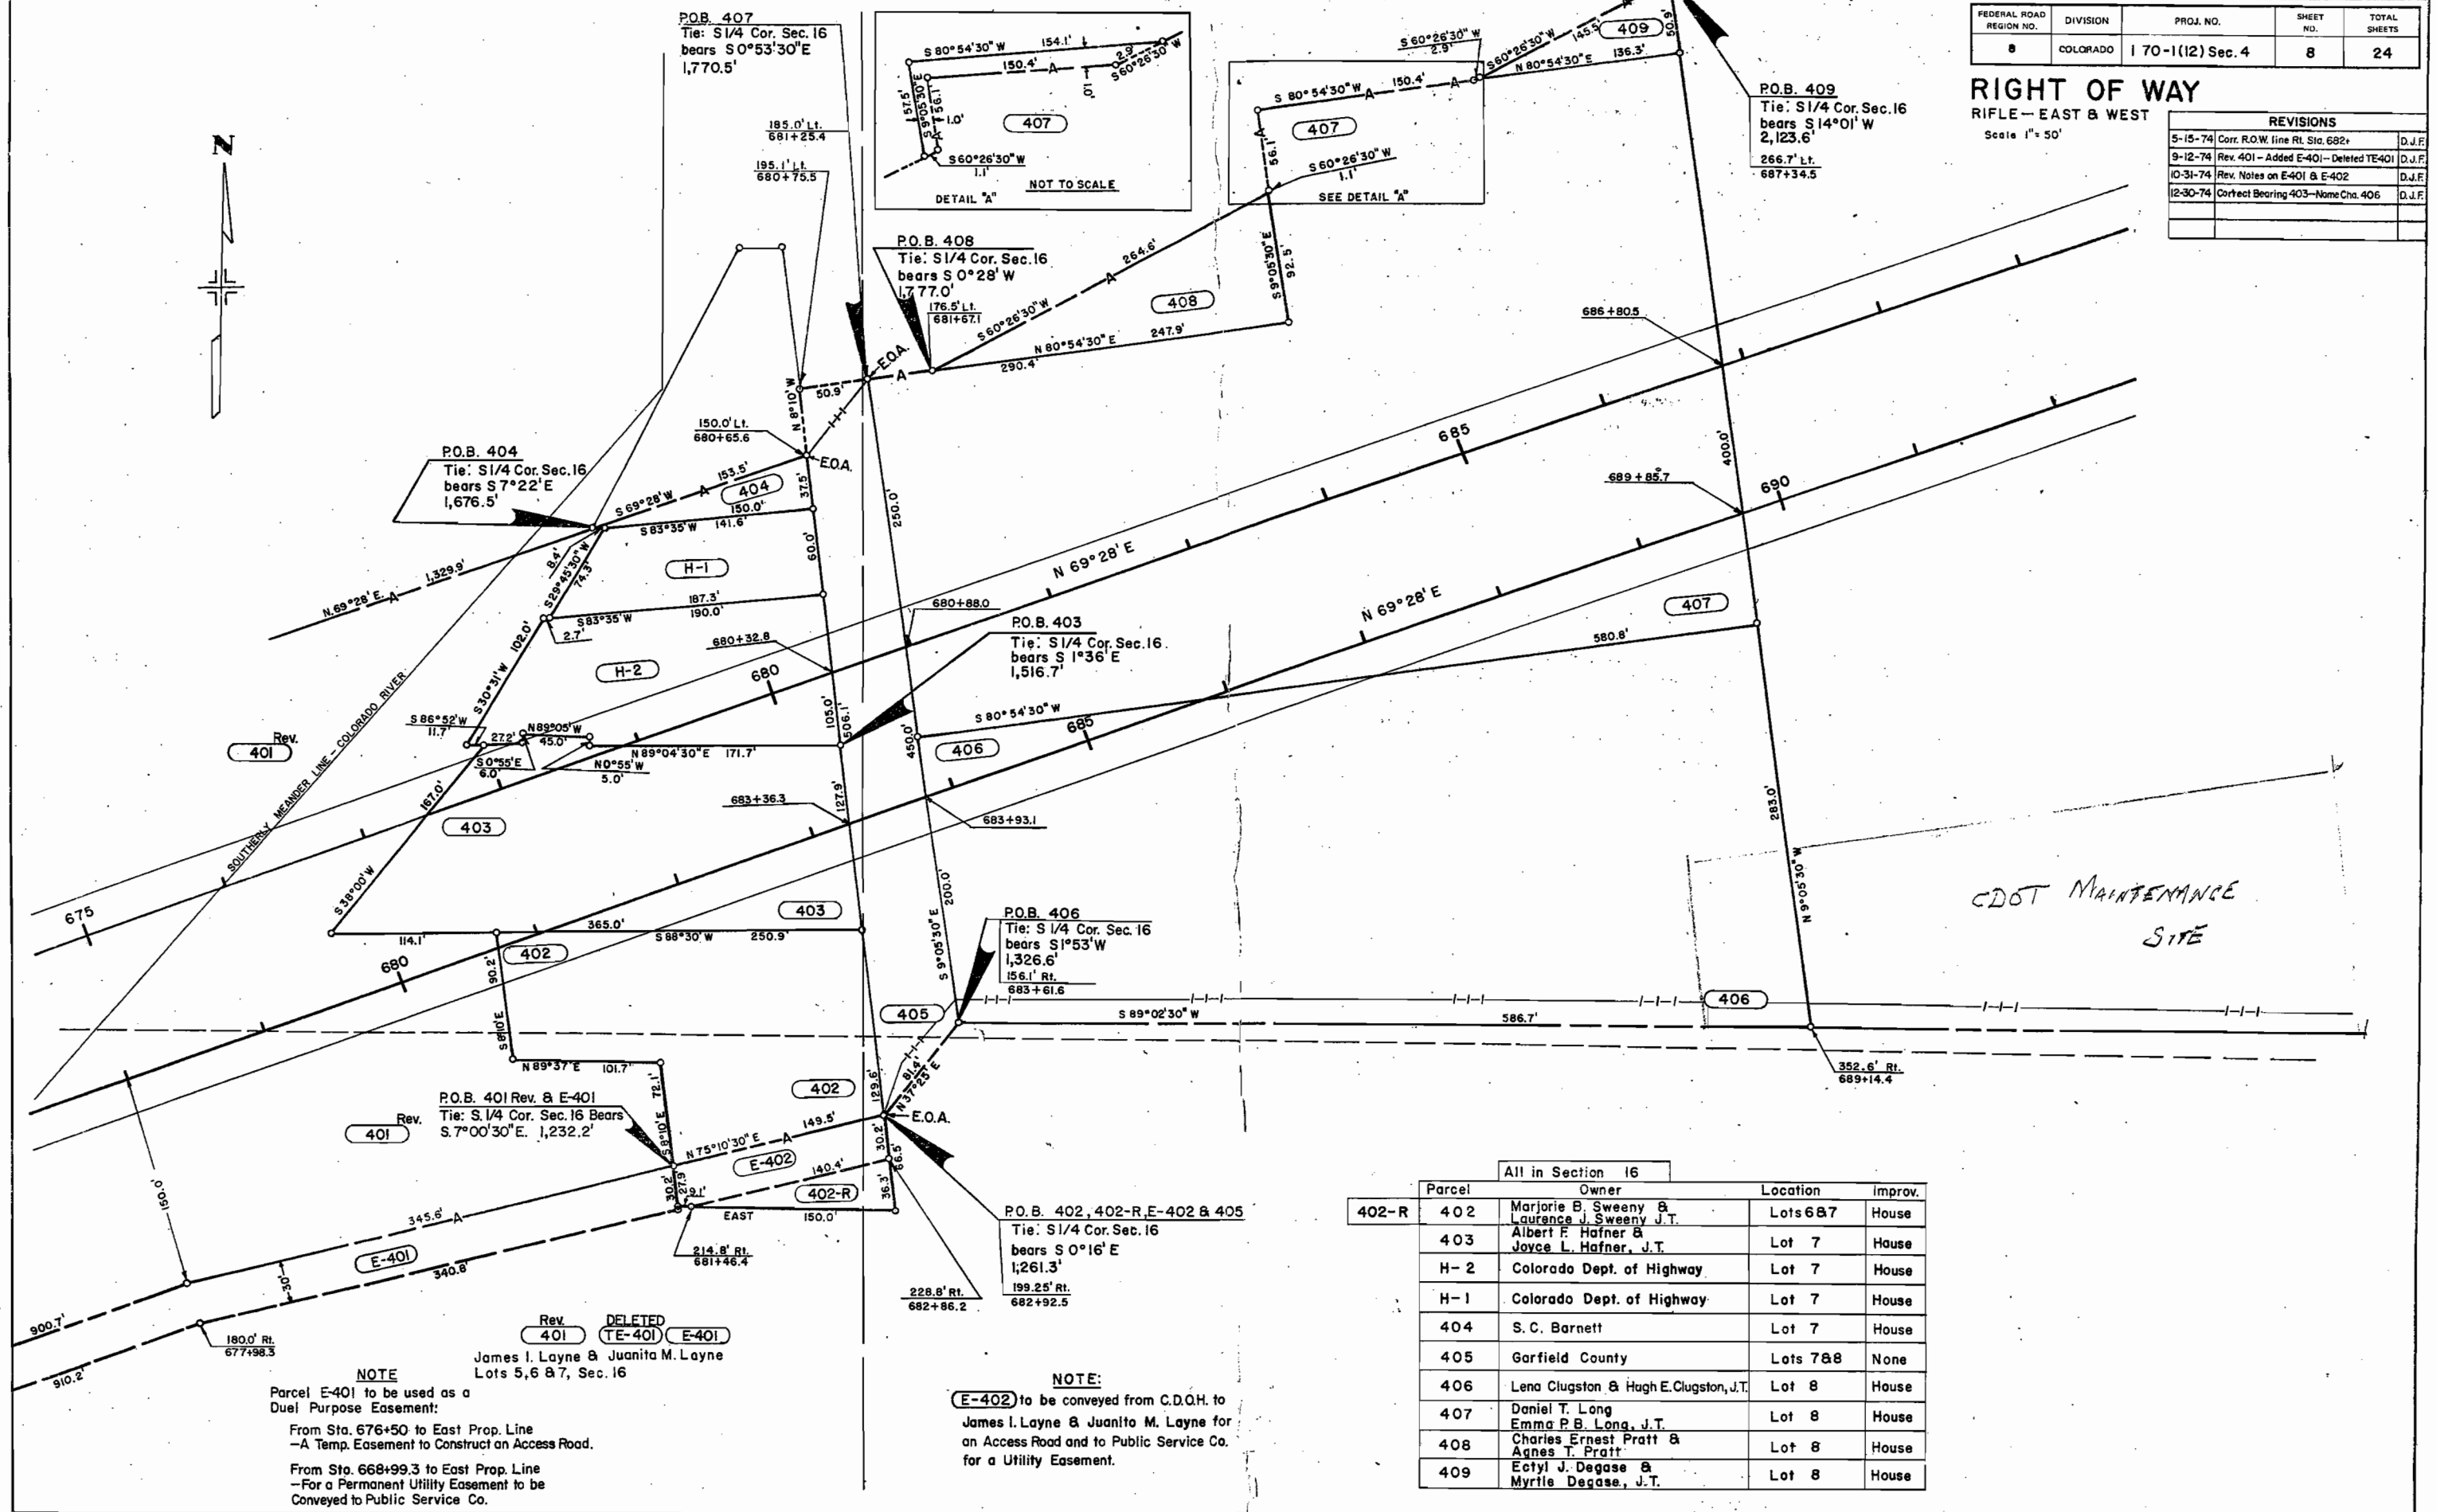

T. 6 S., R. 93 W., 6th P.M.

FEDERAL ROAD REGION NO.	DIVISION	PROJ. NO.	SHEET NO.	TOTAL SHEETS
8	COLORADO	I 70-1 (12) Sec. 4	9	24

RIGHT OF WAY

RIFLE EAST & WEST

REVISIONS		
5-15-74	Rev. 410, 411 & 412 - Added 410-R-A	D.J.F.
10-31-74	Rev. 410 Rev. B 410-R	D.J.F.
12-30-74	Added Rest Area Road - Name Chg. 406	D.J.F.
7-29-75	Name Chg. Par. 412 Rev.; Rev. Par. 410 Rev. 2	J.B.
10-31-75	B 410-R Rev.	J.B.
9-17-75	Revised Pars. 413 & 413-R	J.B.
4-8-76	Added Note	D.J.F.
8-21-86	Revised Par. 413R, Rev. 2	D.P.T.
5-04	PAR. 410-A-R SOLD	JJ


NOTE

- Access 410 Rev. 3 To be reserved by the Department upon the sale of 410-R Rev. 2 and 410-R-A.
- Par. 413R, Rev. 2, Add a portion of Meander Land located in the Colorado River which contains 7.49 ac. more or less.

410-R-A

CDOT
conveyed to: Alpine Bank
a Colo. Corp.
subject to: Transportation Commission approval
(B.1581 P.728)

LOT 1

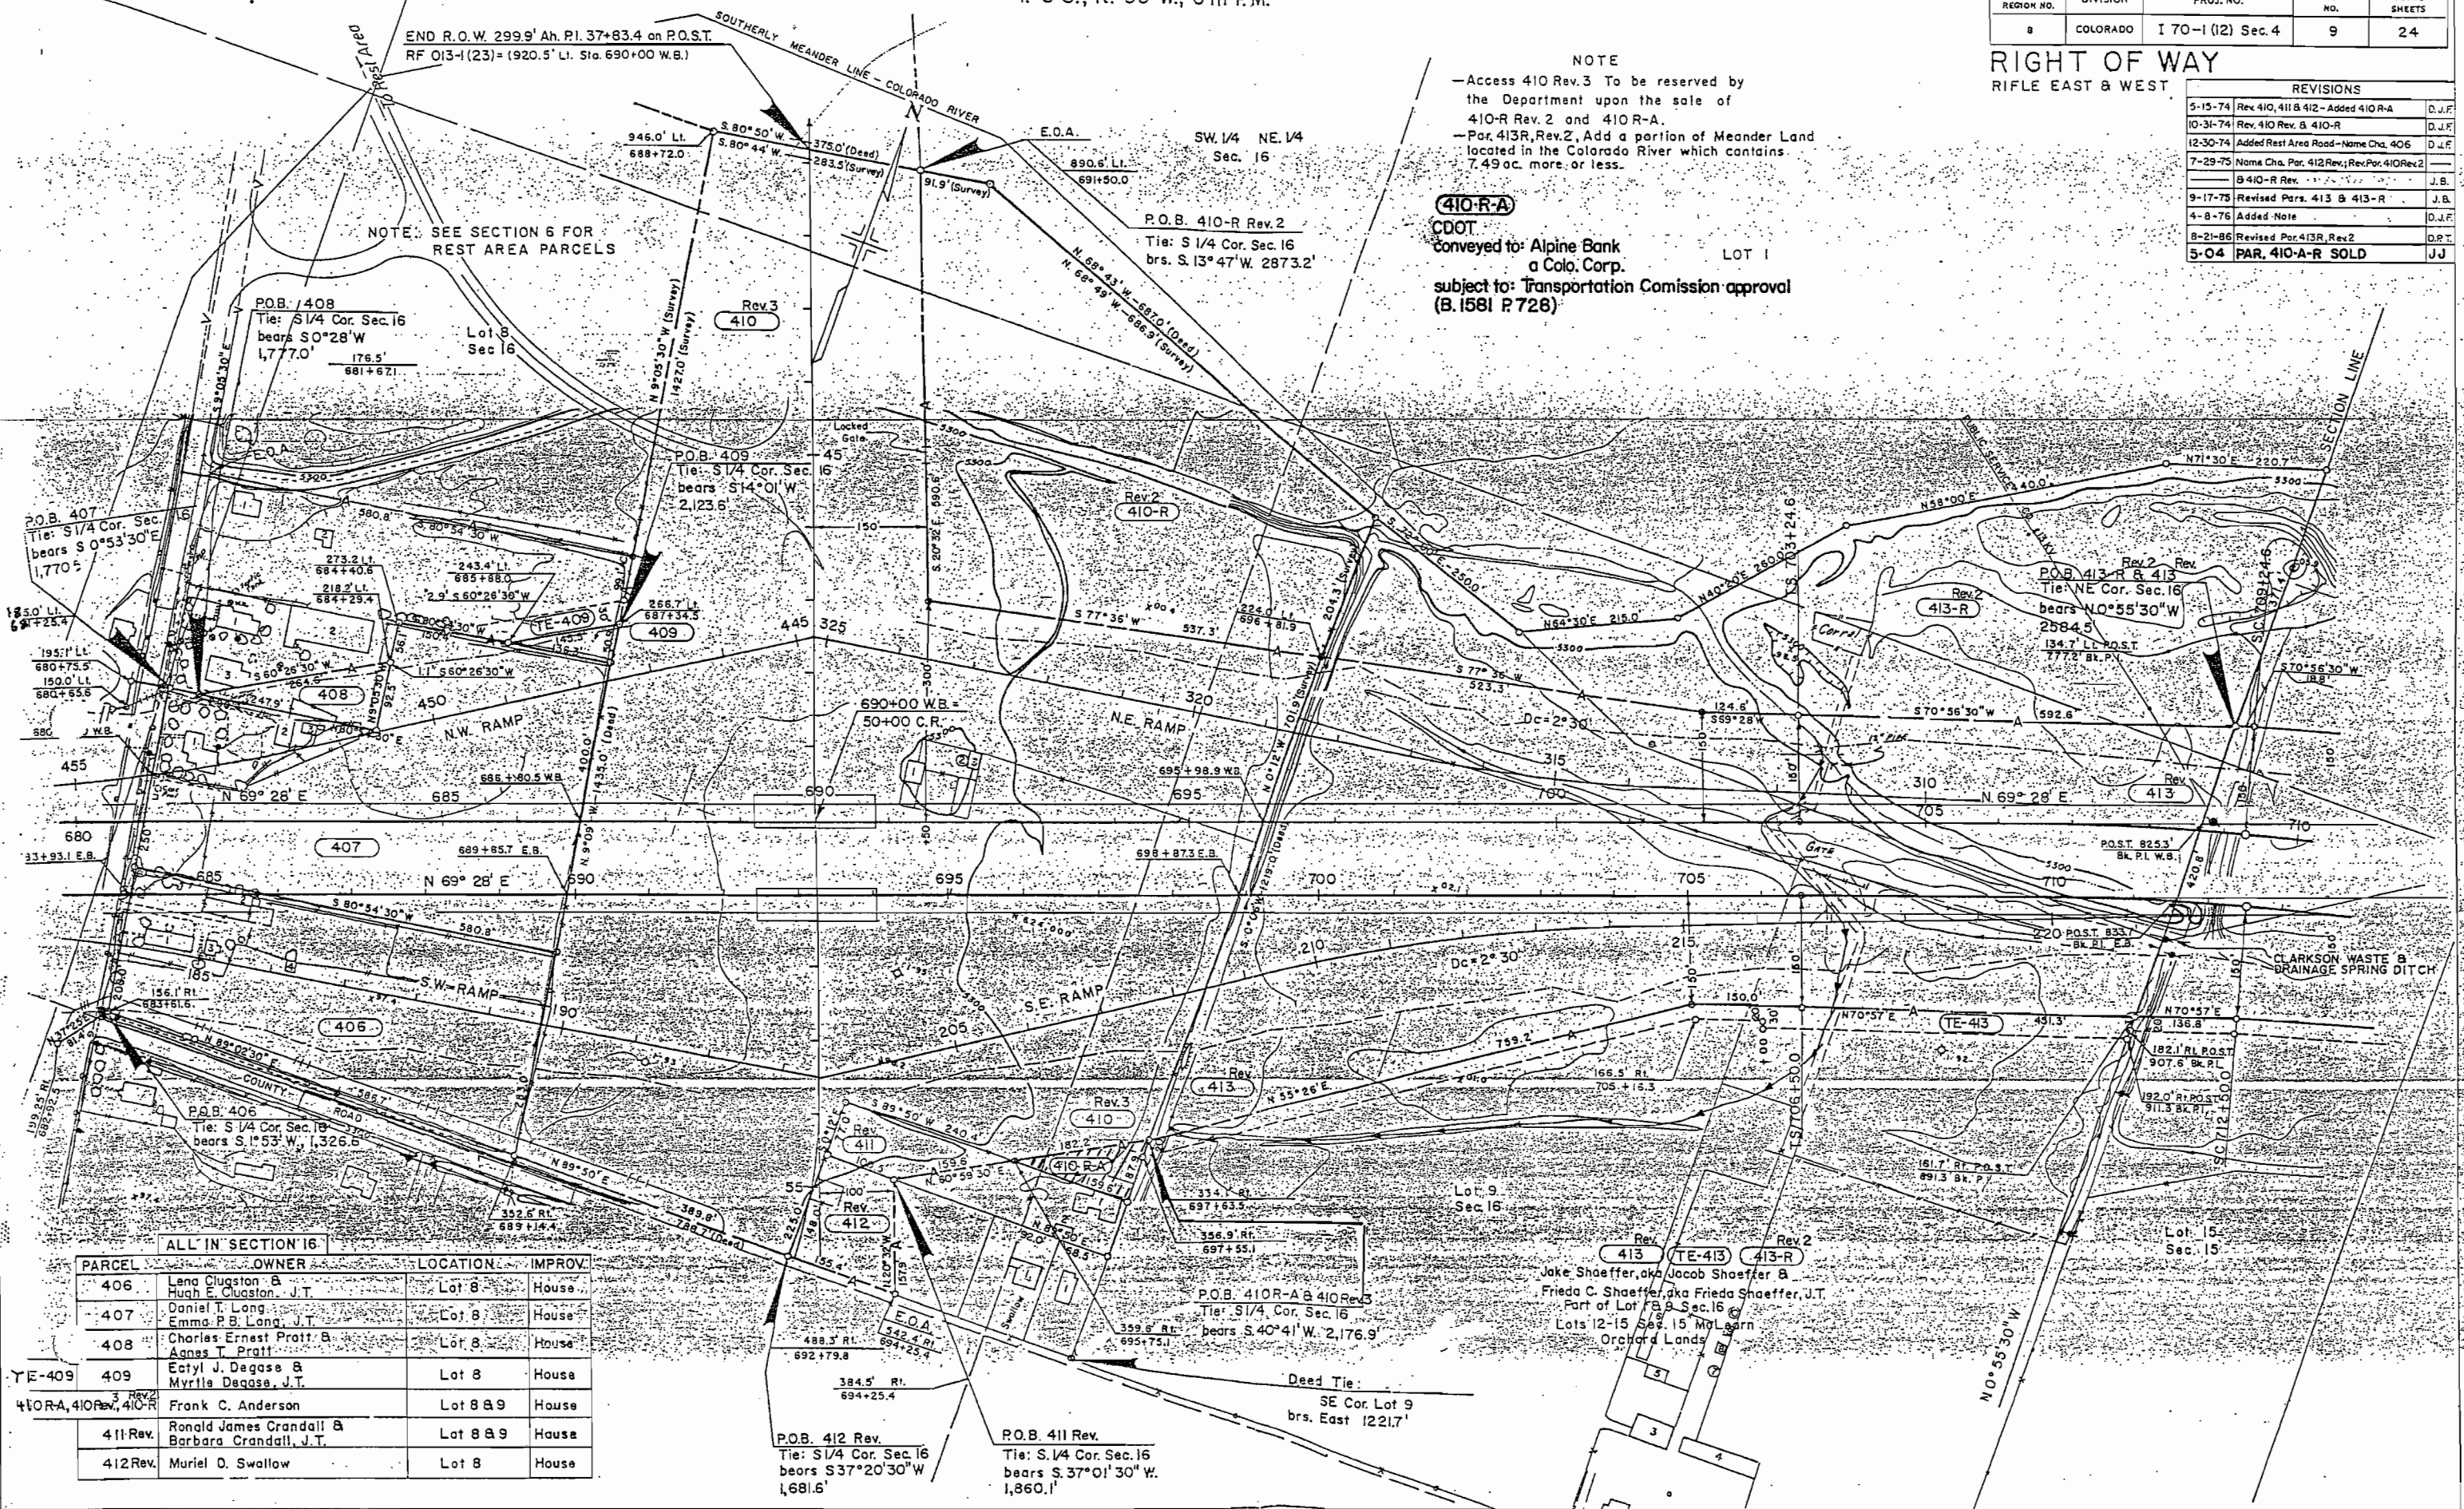

ALL IN SECTION 16

PARCEL	OWNER	LOCATION	IMPROV.
406	Lena Clugston & Hugh E. Clugston, J.T.	Lot 8	House
407	Daniel T. Long & Emma P.B. Long, J.T.	Lot 8	House
408	Charles Ernest Pratt & Agnes T. Pratt	Lot 8	House
409	Ectyl J. Degase & Myrtle Degase, J.T.	Lot 8	House
410R, 410R-A, 410R-B	Frank C. Anderson	Lot 8 & 9	House
411 Rev.	Ronald James Crandall & Barbara Crandall, J.T.	Lot 8 & 9	House
412 Rev.	Muriel D. Swallow	Lot 8	House

P.O.B. 412 Rev.
Tie: S 1/4 Cor. Sec. 16
bears S 37° 20' 30" W
1,681.5'

P.O.B. 411 Rev.
Tie: S 1/4 Cor. Sec. 16
bears S 37° 01' 30" W
1,860.1'

Rev. 413 (TE-413) 413-R
Jake Shaeffer, aka Jacob Shaeffer &
Frieda C. Shaeffer, aka Frieda Shaeffer, J.T.
Part of Lot 15 Sec. 16
Lots 12-15 Sec. 15 McLean
Orchard Lands

T. 6 S., R. 93 W., 6th P.M.

FEDERAL ROAD REGION NO.	DIVISION	PROJ. NO.	SHEET NO.	TOTAL SHEETS
VI	COLORADO	170-1 (12) Sec. 4	10	24

RIGHT OF WAY


RIFLE EAST & WEST

NOTE

— Par. 413R, Rev. 2, Add a portion of Meander Land located in the Colorado River which contains 7.49 ac. more or less.

REVISIONS

DATE	DESCRIPTION	BY
9-12-74	Name Chg. 414, E-414, TE-414 & TE-414-A	D.J.F.
12-30-74	Corrected Southerly Meander Line	J.B.
2-13-75	Correct West Line TE-414	J.B.
9-17-75	Rev. Par. 413, 413-R, E-413, 414, E-414,	
	TE-414-A	J.B.
4-8-76	Added Prop. Line	D.J.F.
8-21-86	Revised Par. 413R, Rev. 2	D.P.T.

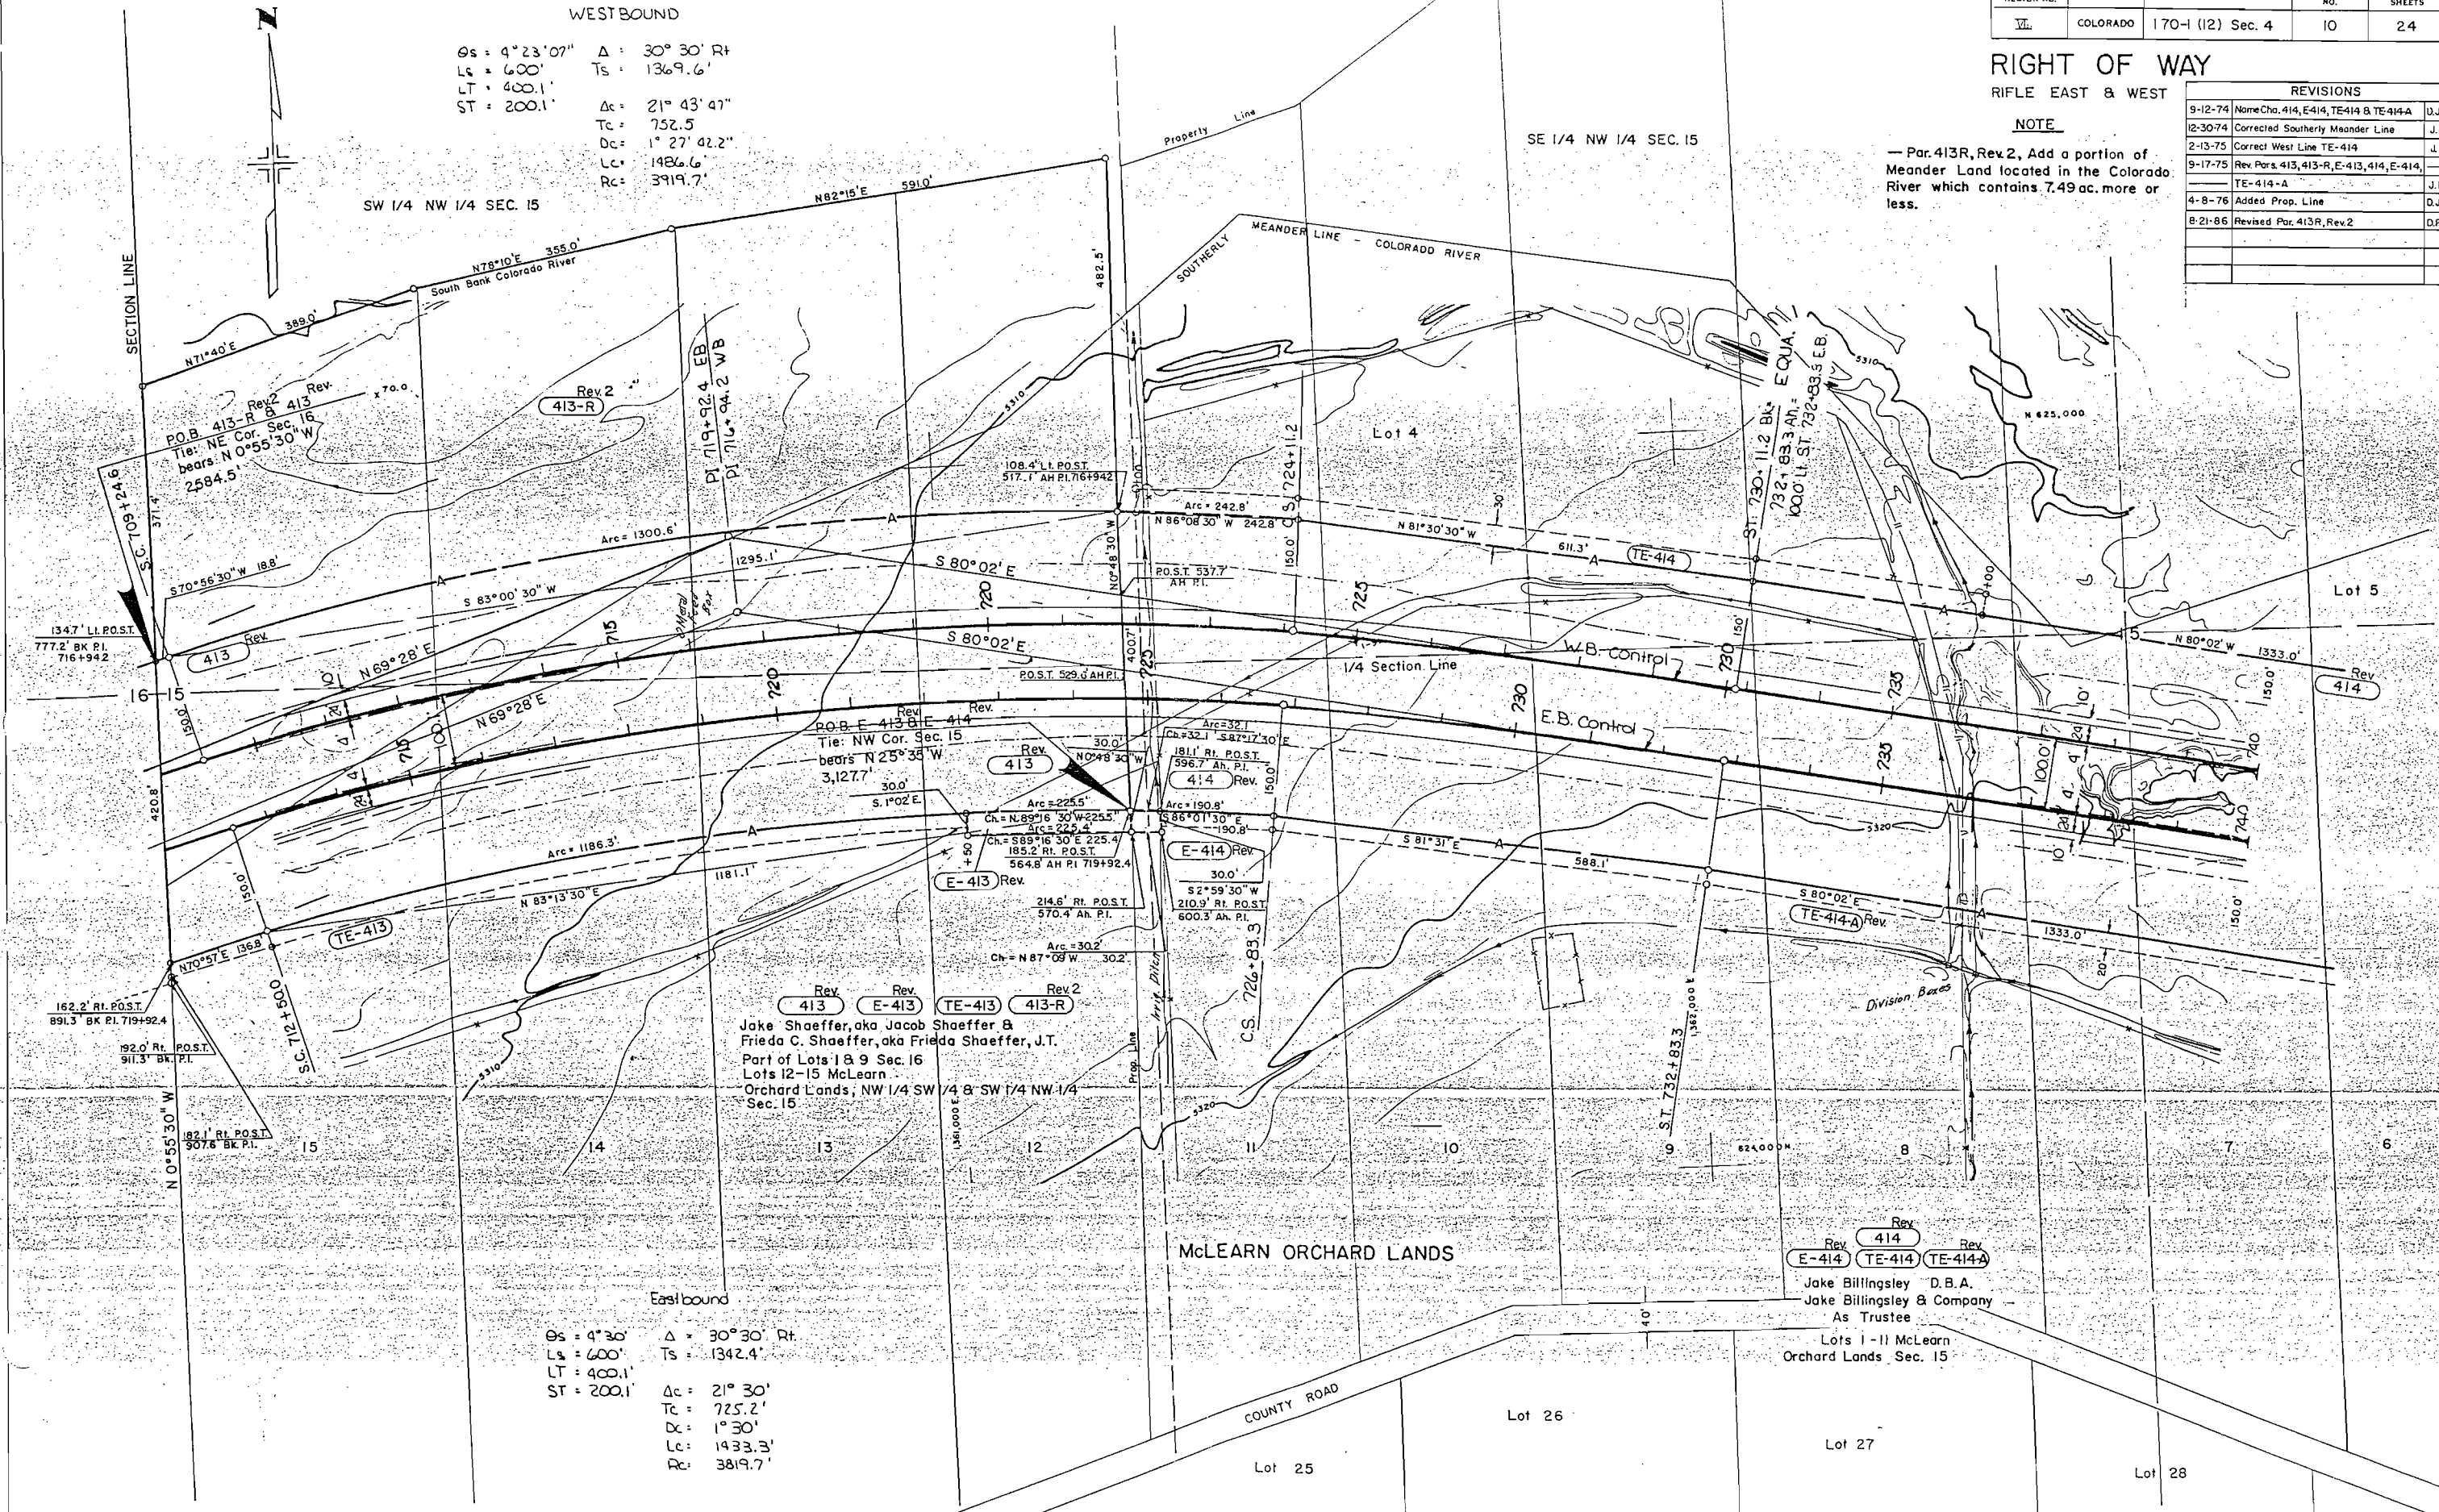

T.6 S., R.93 W., 6th P.M.

Westbound

$\theta_s = 4^\circ 37' 16''$ $\Delta = 35^\circ 30' \text{ Lt.}$
 $L_s = 600.0'$ $T_s = 1491.9'$
 $LT = 400.1'$
 $ST = 200.1'$
 $\Delta_c = 26^\circ 15' 27''$
 $D_c = 1^\circ 32' 25''$
 $T_c = 867.6'$
 $L_c = 1702.7'$
 $R_c = 3719.7'$


NOTE

PARCEL 426 REPRESENTS ANY AND ALL INTEREST IN A UTILITY EASEMENT GRANTED TO CASCADE NATURAL GAS CO. AND QUIT CLAIMED BY THEM TO C.D.O.H. IN EXCHANGE FOR A USE PERMIT.

FEDERAL ROAD REGION NO.	DIVISION	PROJ. NO.	SHEET NO.	TOTAL SHEETS
VIII	COLORADO	170-1 (12) Sec. 4	11	24

RIGHT OF WAY
RIFLE EAST & WEST

REVISIONS		
9-12-74	Name Chg. 414, TE-414, TE-414-A, B & D	D.J.F.
12-30-74	Corrected Southerly Meander Line	J.B.
8-5-75	Added Par. 426	J.B.
9-17-75	Rev. Pars. 414, TE-414-A; Deleted Pars.	
	414-A, TE-414-B, TE-414-C	J.B.
4-8-76	Rev. Par. 415	D.J.F.
8-7-87	Add 2nd. Revision To Par. 415 Rev.	D.P.T.

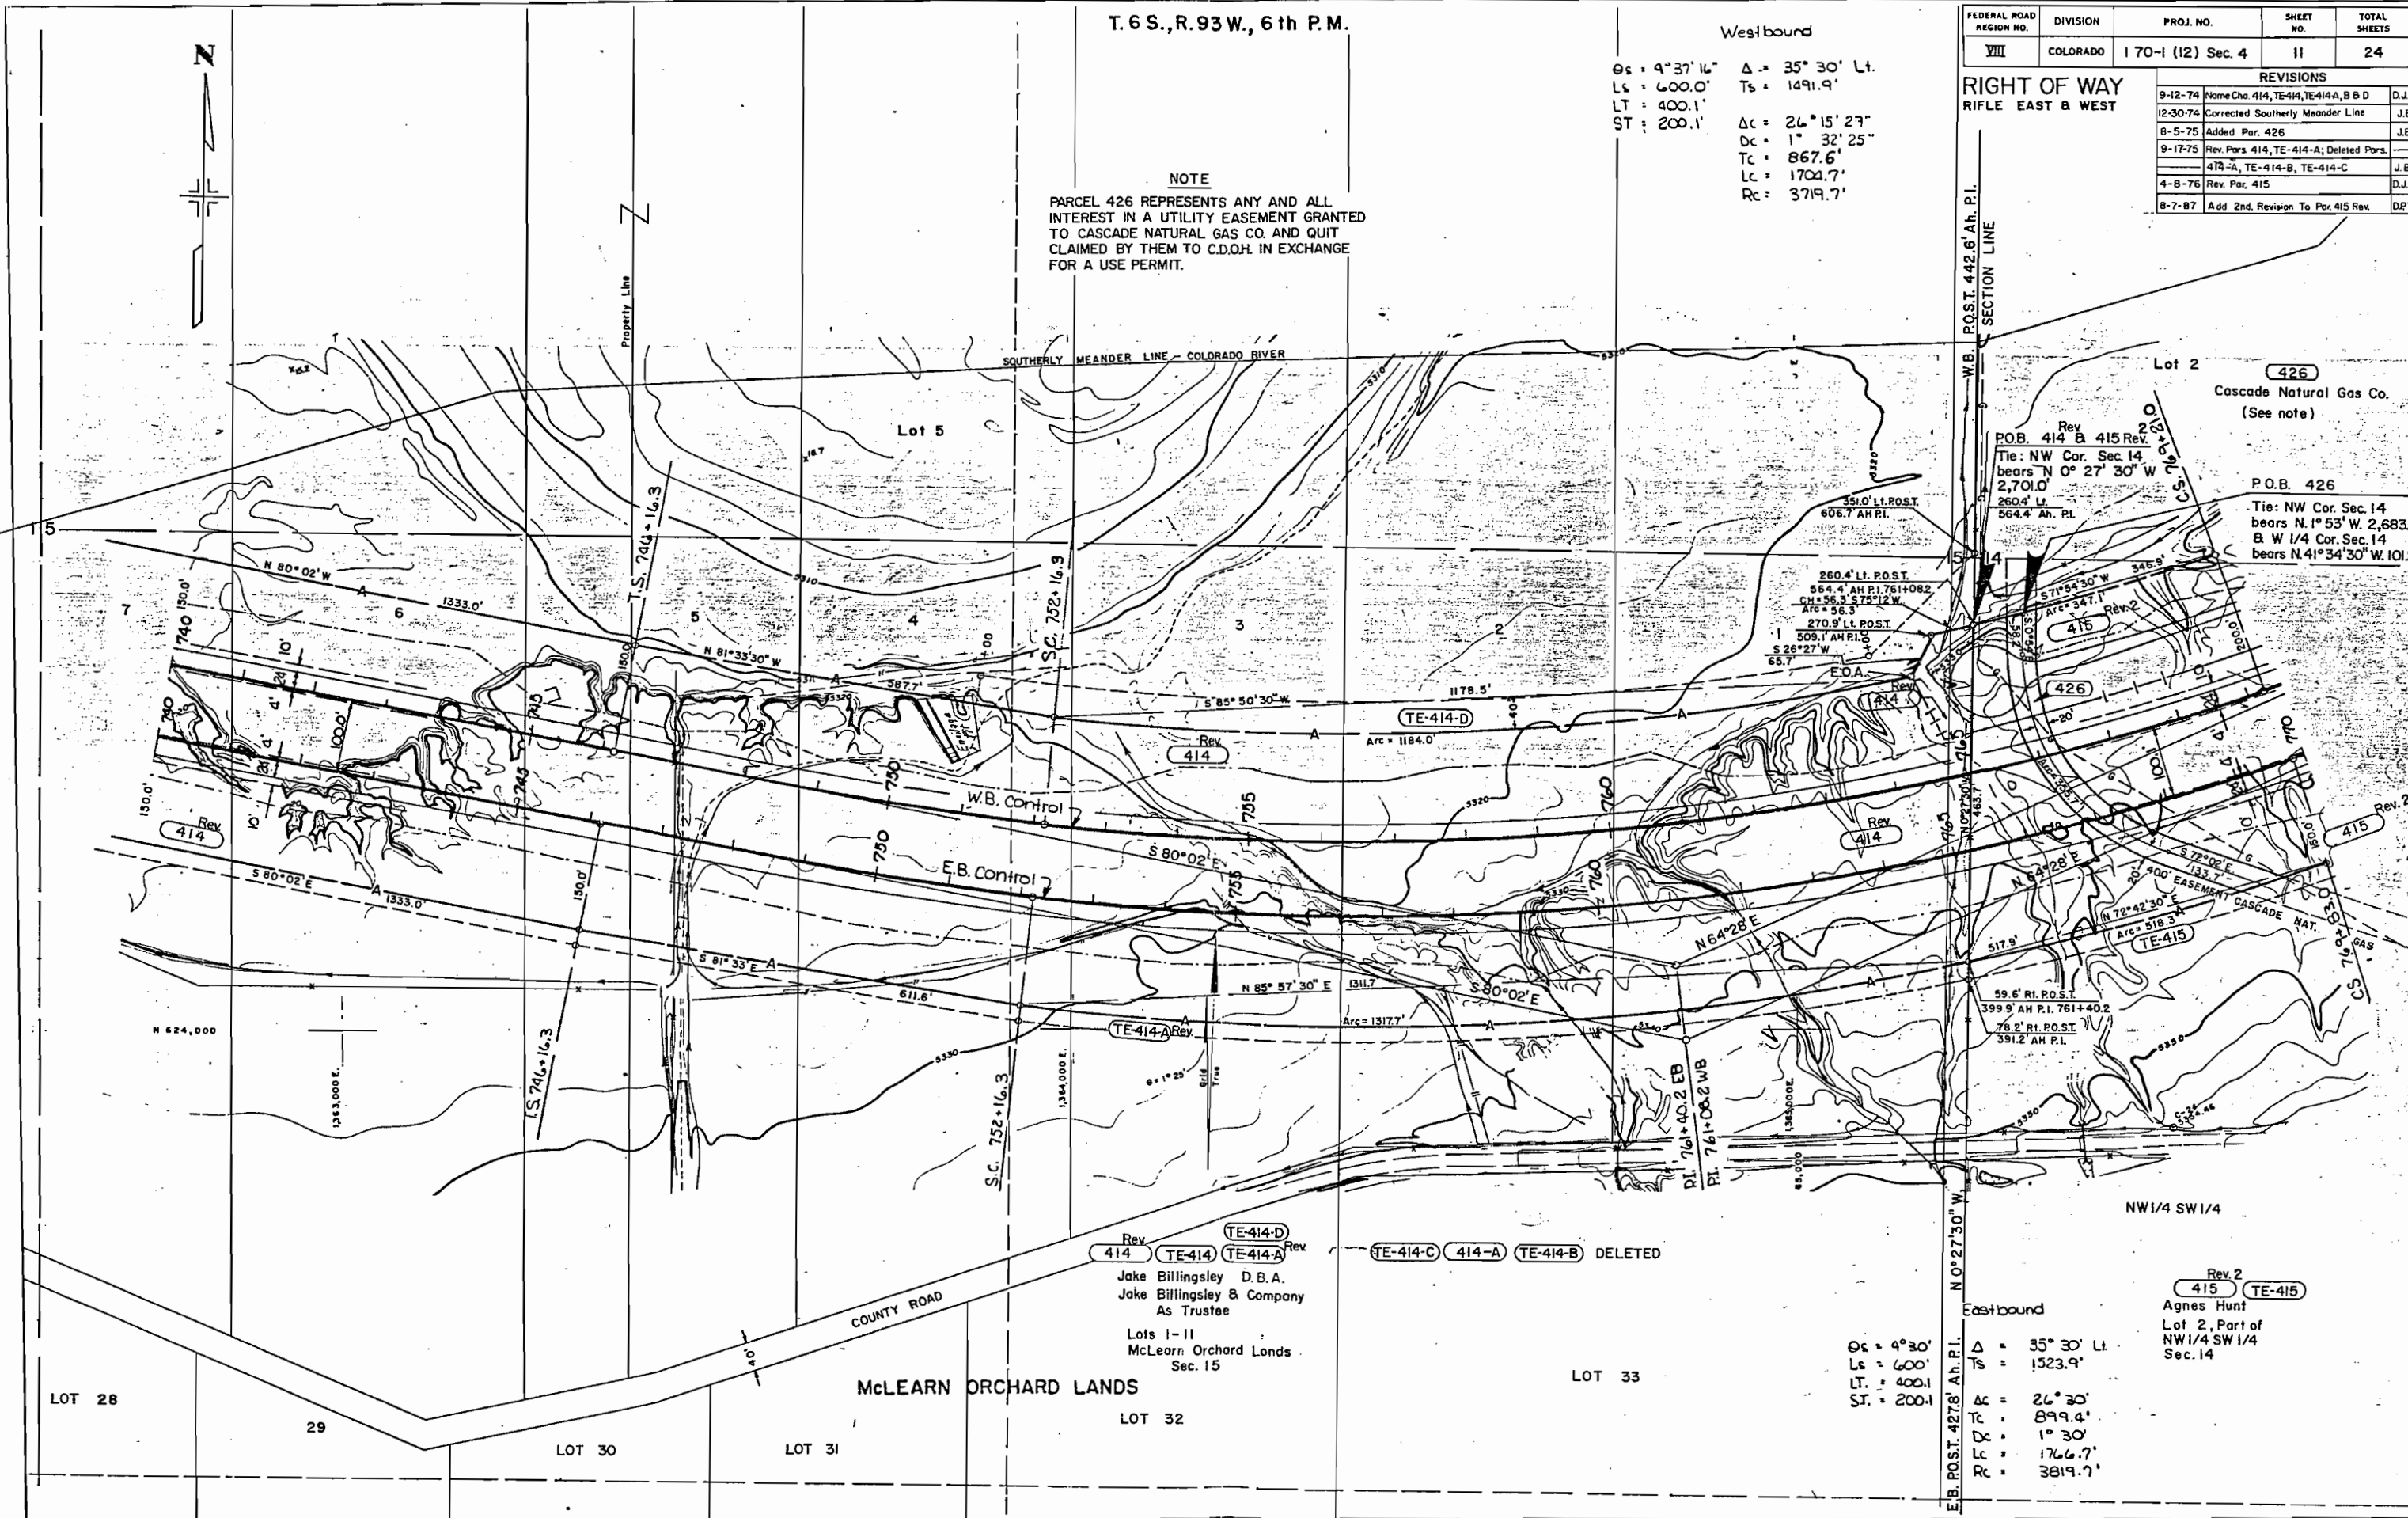

T. 6 S., R. 93 W., 6th P.M.

FEDERAL ROAD REGION NO.	DIVISION	PROJ. NO.	SHEET NO.	TOTAL SHEETS
VIII	COLORADO	170-1 (12) Sec. 4	12	24

RIGHT OF WAY


RIFLE EAST & WEST

REVISIONS

DATE	DESCRIPTION	BY
9-12-74	Added E-414-A, E-415 & E-415-A	D.J.F.
12-30-74	Added Note E-414-A	D.J.F.
6-20-75	Added 415-R	D.J.F.
9-17-75	Added Easement Widths on E-414-A & E-415-A	J.B.
4-8-76	Rev. Par. 415	D.J.F.
8-7-87	Add 2nd Revision To Par. 415 Rev.	D.J.F.
	Delete Par. 415-R	D.P.T.

NOTE
E-414-A to be Deeded directly
from Jake Billingsley & Company
to Public Service Company.

NOTE
E-415 & E-415-A to be Deeded
directly from Agnes Hunt to
Public Service Company.

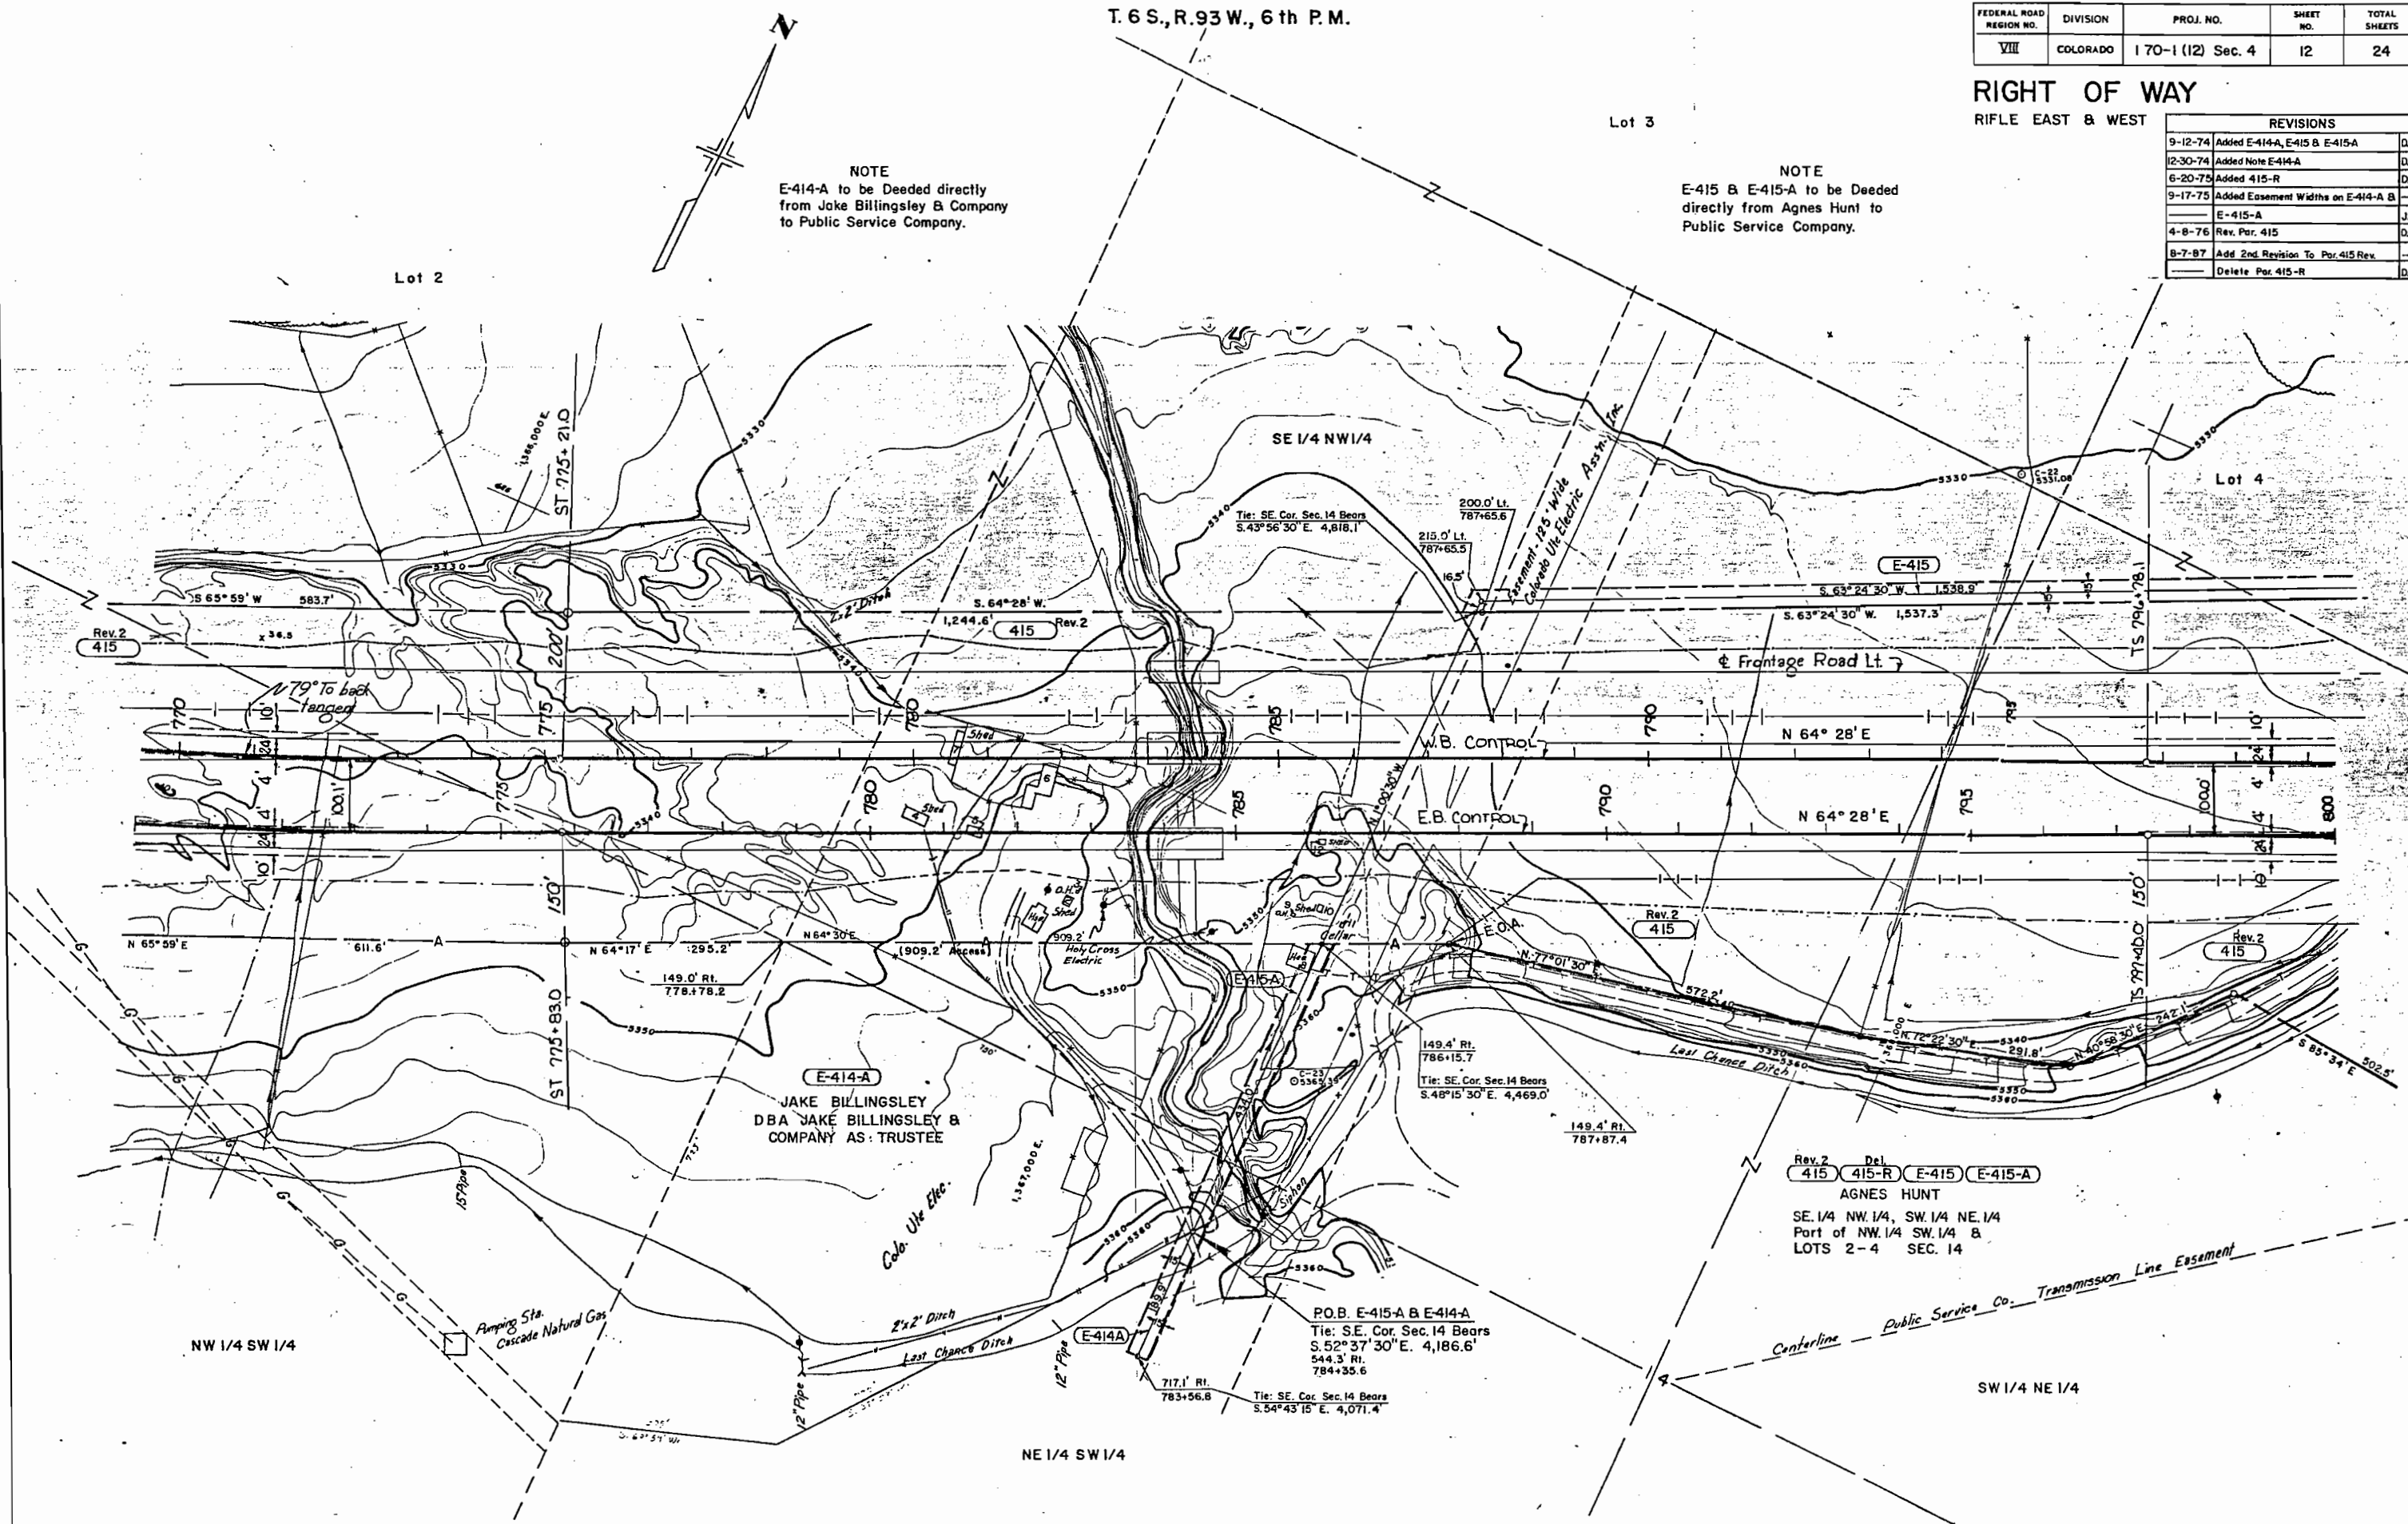

RIGHT OF WAY
RIFLE EAST & WEST ☐

REVISIONS		
9-12-74	Added E-415 & E-418 -- Name Cha. 417	D.J.F.
12-30-74	Name Cha. 418 & E-418	D.J.F.
2-13-75	Relocate Last Chance Ditch	J.B.
5-30-75	Revised Pars. 417 & 418	K.C.
4-8-76	Revised Par. 415	D.J.F.
8-11-87	Add 2nd Revision To Par. 415 Rev.	D.R.T.

Rev. 418 E-418
Guy C. Snyder &
Evelyn E. Snyder
Lot 1, Sec. 13

$\Delta = 26^{\circ} 00' \text{ Rt.}$
 $T_s = 985.5$

$\phi_s = 5^{\circ} 47' 51''$ $\Delta c = 14^{\circ} 24' 17''$
 $LS = 600.0'$ $Tc = 374.7'$
 $LT = 400.2'$ $Dc = 1^{\circ} 55' 57''$
 $ST = 200.2'$ $Lc = 745.4'$
 $Rc = 2964.8$

Rev. 415 E-415
Agnes Hunt
Lot 4, SW1/4
NE 1/4 Sec. 14

NOTE
E-415 to be Deeded directly
from Agnes Hunt to Public
Service Company.

NOTE
E-418 to be Deeded directly from
Guy C. & Evelyn E. Snyder to
Public Service Company.

East bound

$$\Delta = 26^{\circ} 00' \text{ Rt.}$$
$$T_s = 962.5'$$

$\theta_s = 6^{\circ}00'$	$\Delta c = 14^{\circ}00'$
$L_s = 600.0'$	$T_c = 351.8'$
$LT = 400.2'$	$b_c = 2^{\circ}00'$
$ST = 200.2'$	$L_c = 700.0'$
	$R_c = 284.8'$

416
Town of Rifle
Part of Lot 5
Sec. 14

Rev.
417
Rifle Land Associates, Ltd.
Part of Lot 2 Sec.13

FEDERAL ROAD REGION NO.	DIVISION	PROJ. NO.	SHEET NO.	TOTAL SHEETS
12	COLORADO	170-1 (12) Sec. 4	14	24

RIGHT OF WAY
RIFLE EAST & WEST

REVISIONS			
9-12-74	Added E-418 & E-418-A - Name Chg. 417	D.J.F.	
12-30-74	Name Chg. 418, E-418, E-418-A, TE-418, TE-418-A	D.J.F.	
2-13-75	Relocate Last Chance Ditch	J.B.	
5-30-75	Rev. 417, 418, & E-418A	K.C.	

NOTE
E-418 & E-418-A-Rev. to be deduced directly from Guy C. & Evelyn E. Snyder to Public Service Company.

West bound

$\Delta = 14^{\circ}00' Lt.$
 $T_c = 841.3$
 $ST = 100.0'$
 $LS = 200.0'$
 $LC = 1073.6'$
 $RC = 5629.6'$

T. 6 S., R. 93 W., 6th P.M.

East bound

$\Delta = 14^{\circ}00' Lt.$
 $T_c = 853.6'$
 $ST = 100.0'$
 $LS = 200.0'$
 $LC = 1100.0'$
 $RC = 5729.6'$


SE1/4NW1/4, Sec. 13

P.O.B. 416-A

Tie: SW Cor. Sec. 13
bears S 39° 23' 30" W
4,700.1
602.3' Rl.
850+156.3

416-A

Town of Rifle,
a municipal corp.
S1/2N1/2, N1/2SW1/4,
Sec. 13

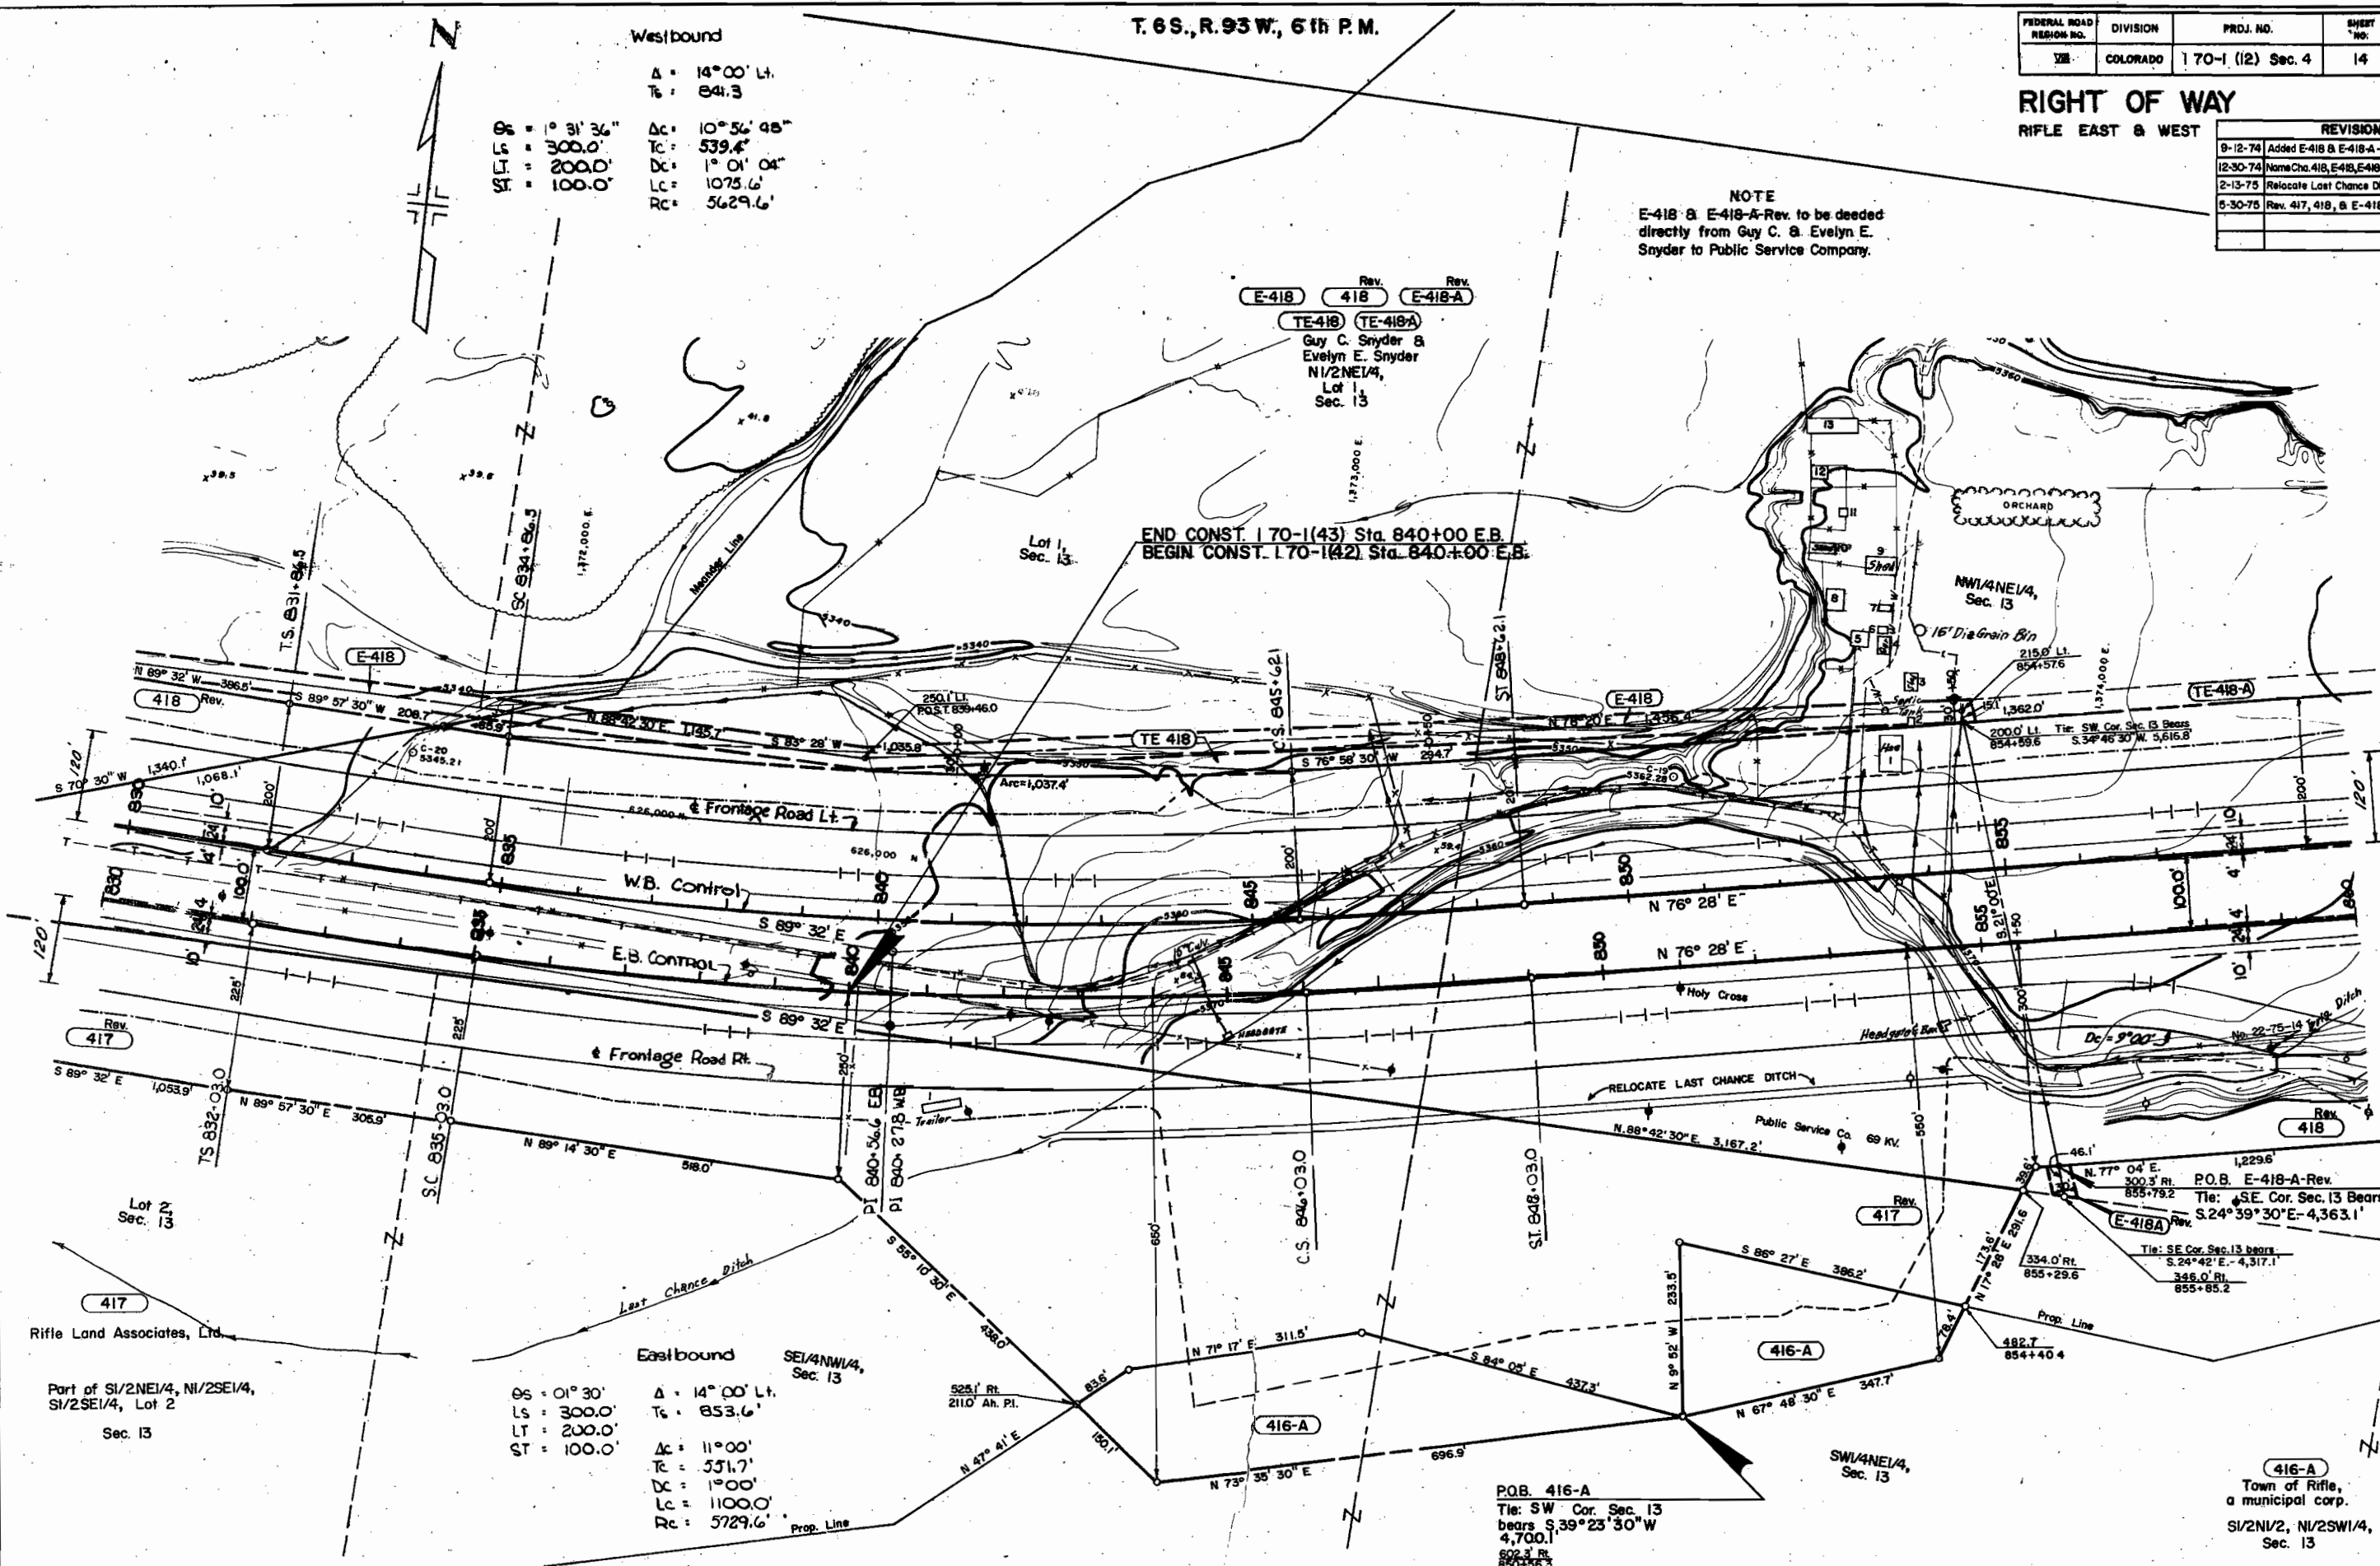

T. 6 S., R. 93 W., 6th P.M.

T. 6 S., R. 92 W., 6th P.M.

FEDERAL ROAD DISTRICT NO.	DIVISION	PROJ. NO.	SHEET NO.	TOTAL SHEETS
VII	COLORADO	170-1 (12) Sec. 4	15	24

RIGHT OF WAY
RIFLE EAST & WEST

REVISIONS		
9-12-74	Rev. 420-Added 419-A & 420-R	D.J.F.
10-24-74	Deleted Access 419-B & 420-R	D.J.F.
12-30-74	Added 419-B & TE-419-A	D.J.F.
5-30-75	Revised 419, 419-A, 420-R, & 420-R	---
---	Deleted 419-A, Added TE-419-B, TE-420-B, K.C.	---

Westbound

$\Delta = 14^{\circ} 00' \text{ Rl.}$
 $T_s = 865.8'$
 $\theta_s = 1^{\circ} 28' 27''$
 $L_s = 300.0'$
 $L_T = 200.0'$
 $ST = 100.0'$
 $\Delta_c = 11^{\circ} 03' 05''$
 $T_c = 564.0'$
 $\Delta_c = 0^{\circ} 58' 58''$
 $L_c = 1124.4'$
 $R_c = 5829.6'$


SE1/4SE1/4,
Sec. 12

Eastbound

$\Delta = 14^{\circ} 00' \text{ Rl.}$
 $T_s = 853.6'$
 $\theta_s = 1^{\circ} 30'$
 $L_s = 300.0'$
 $L_T = 200.0'$
 $ST = 100.0'$
 $\Delta_c = 11^{\circ} 00'$
 $T_c = 551.7'$
 $\Delta_c = 1^{\circ} 00'$
 $L_c = 1100.0'$
 $R_c = 5729.6'$

Rev.
419
James G. Snyder
NE1/4NE1/4,
Sec. 13

(419A) DELETED

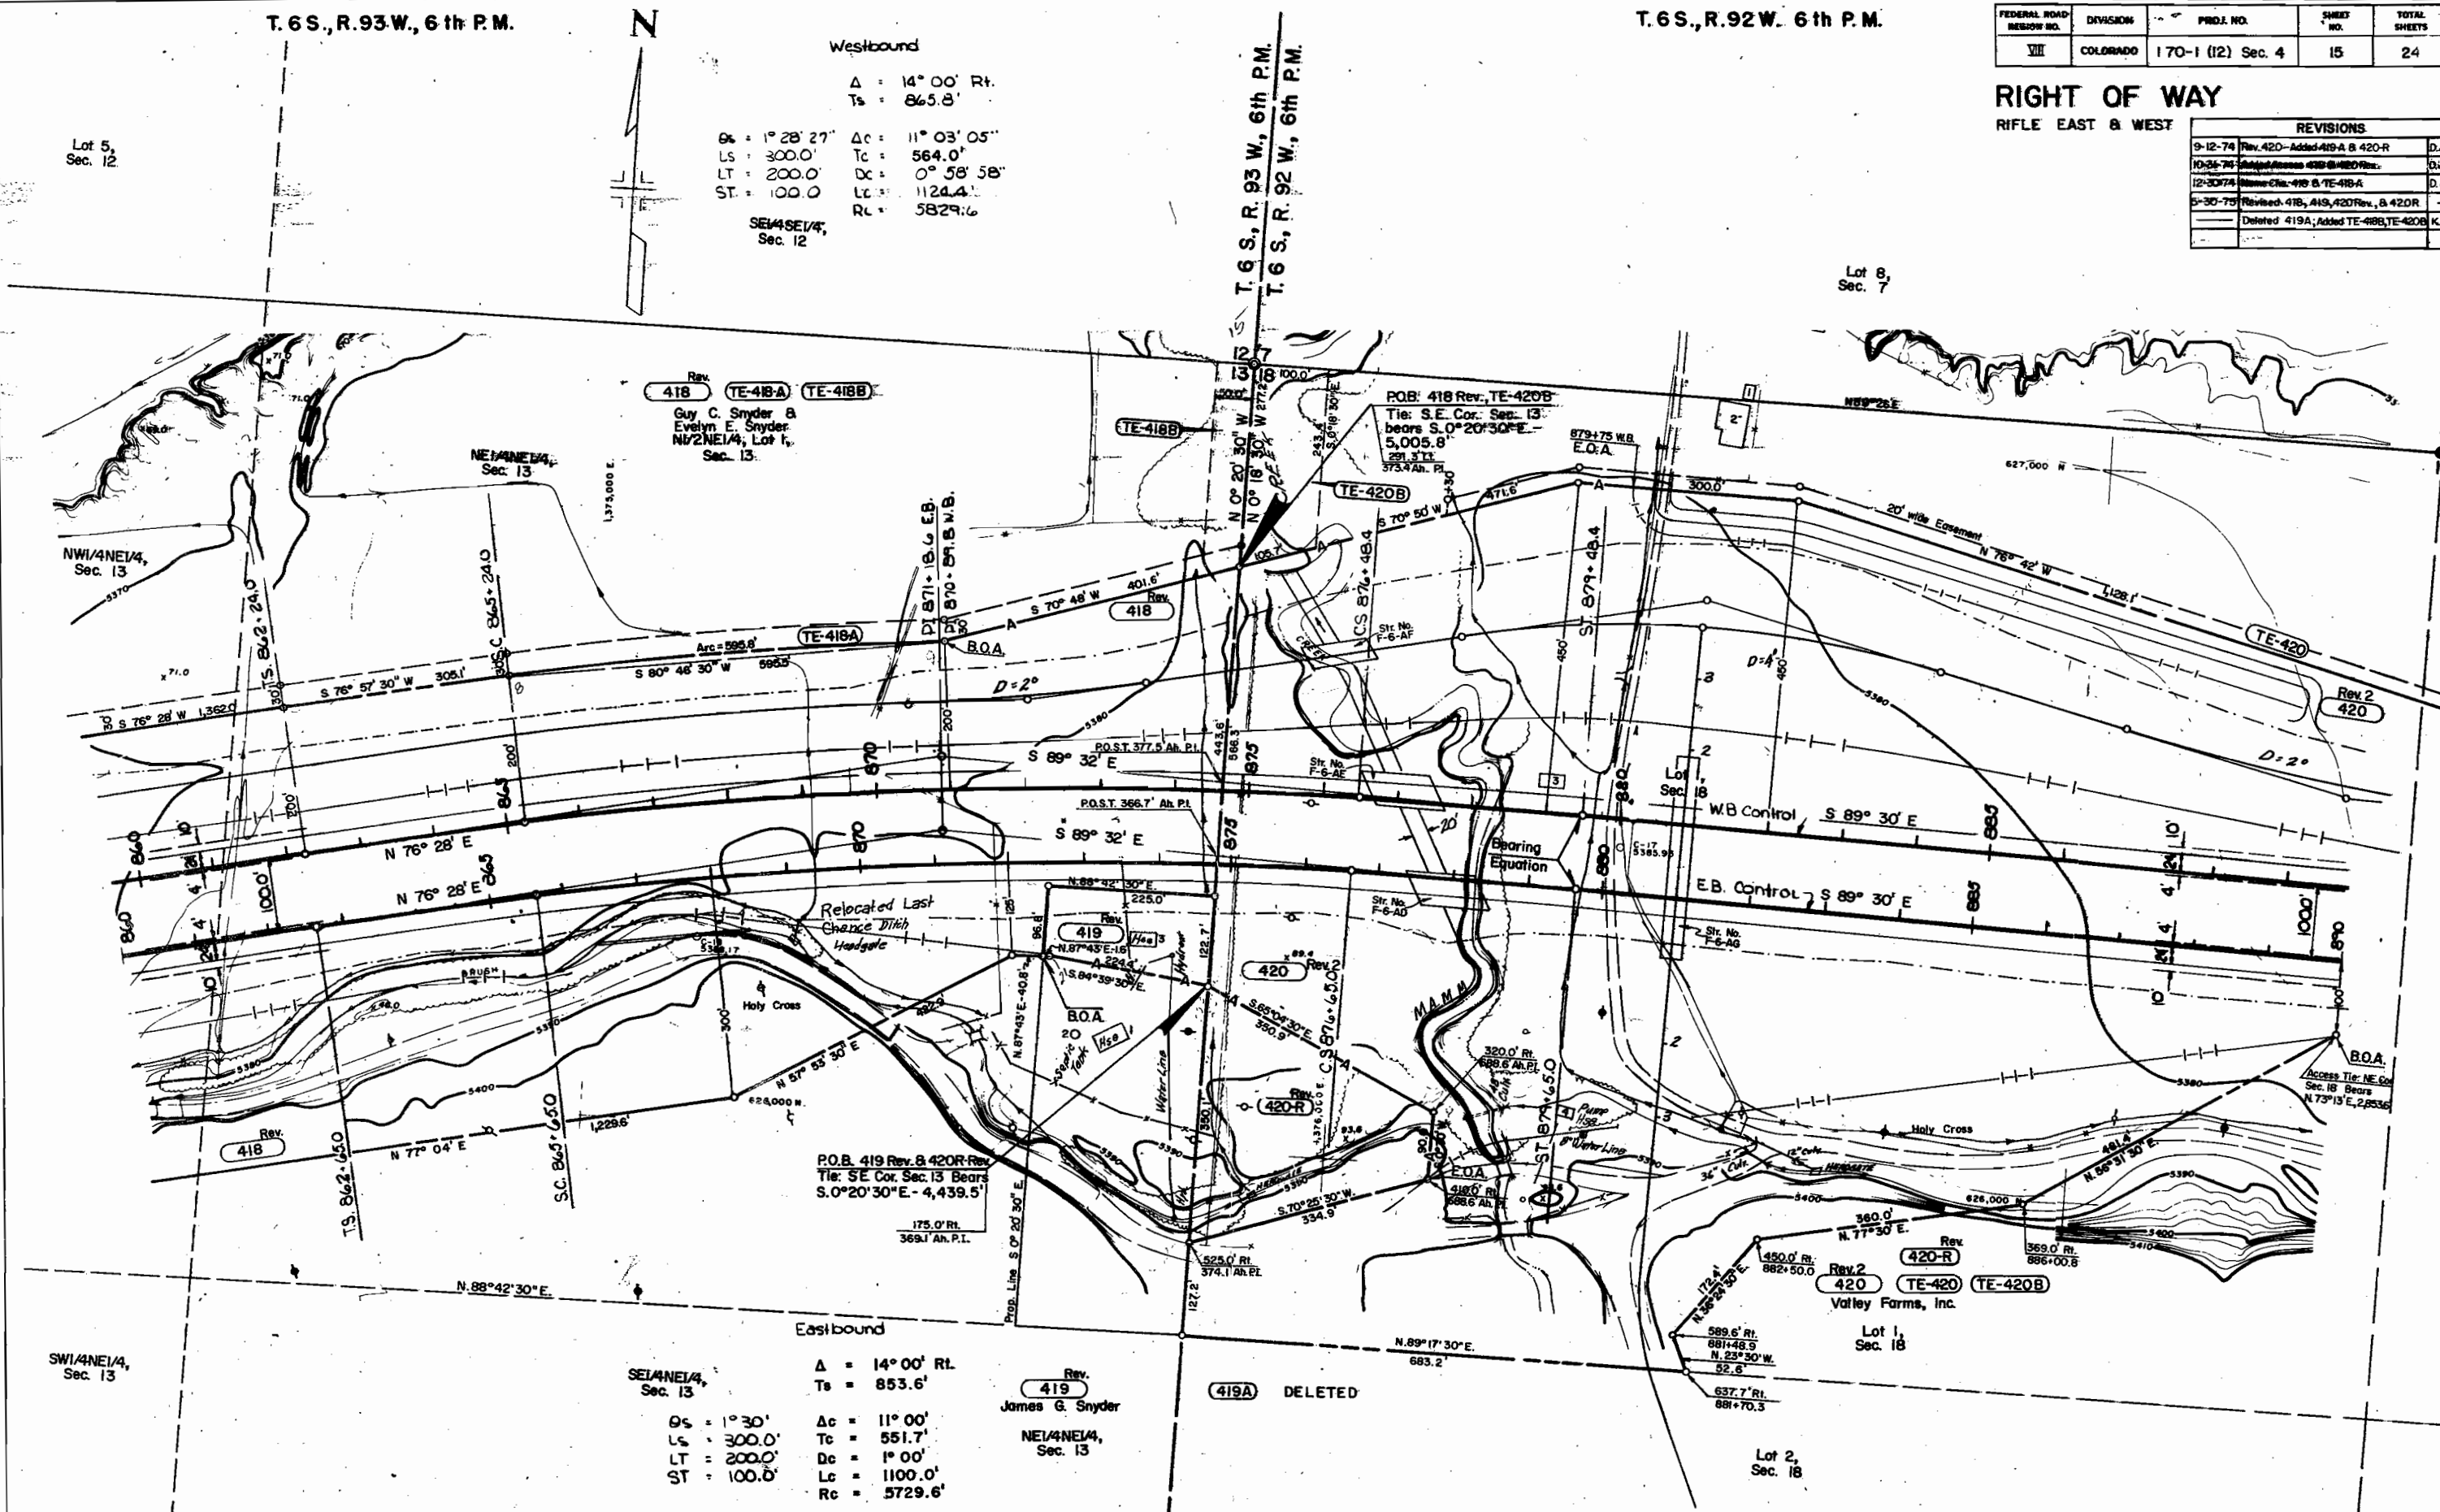

421 E-421
Kenneth Balcomb &
Willis E. Parkinson
A strip of land 150' wide,
Sec. 7 & 18



T.6S., R.92W., 6th P.M.


REVISIONS:

FEDERAL ROAD REGION NO.	DIVISION	PROJ. NO.	SHEET NO.
VIII	COLORADO	I 70-I (12) Sec. 4	18

RIGHT OF WAY
RIFLE EAST & WEST

424
E-424 TE-424
Carol Ja. Shideler 1/3
Barry Craig Shideler 1/3
Paul Rob. Shideler 1/3
S1/2SE1/4, NE1/4SE1/4,
Sec. 8

END R.O.W. PROJECT I-70-I(12) Sec. 4 Sta. 976+75.3EB.
BEGIN R.O.W. PROJECT I-70-I(12) Sec. 5 Sta. 976+75.3EB.

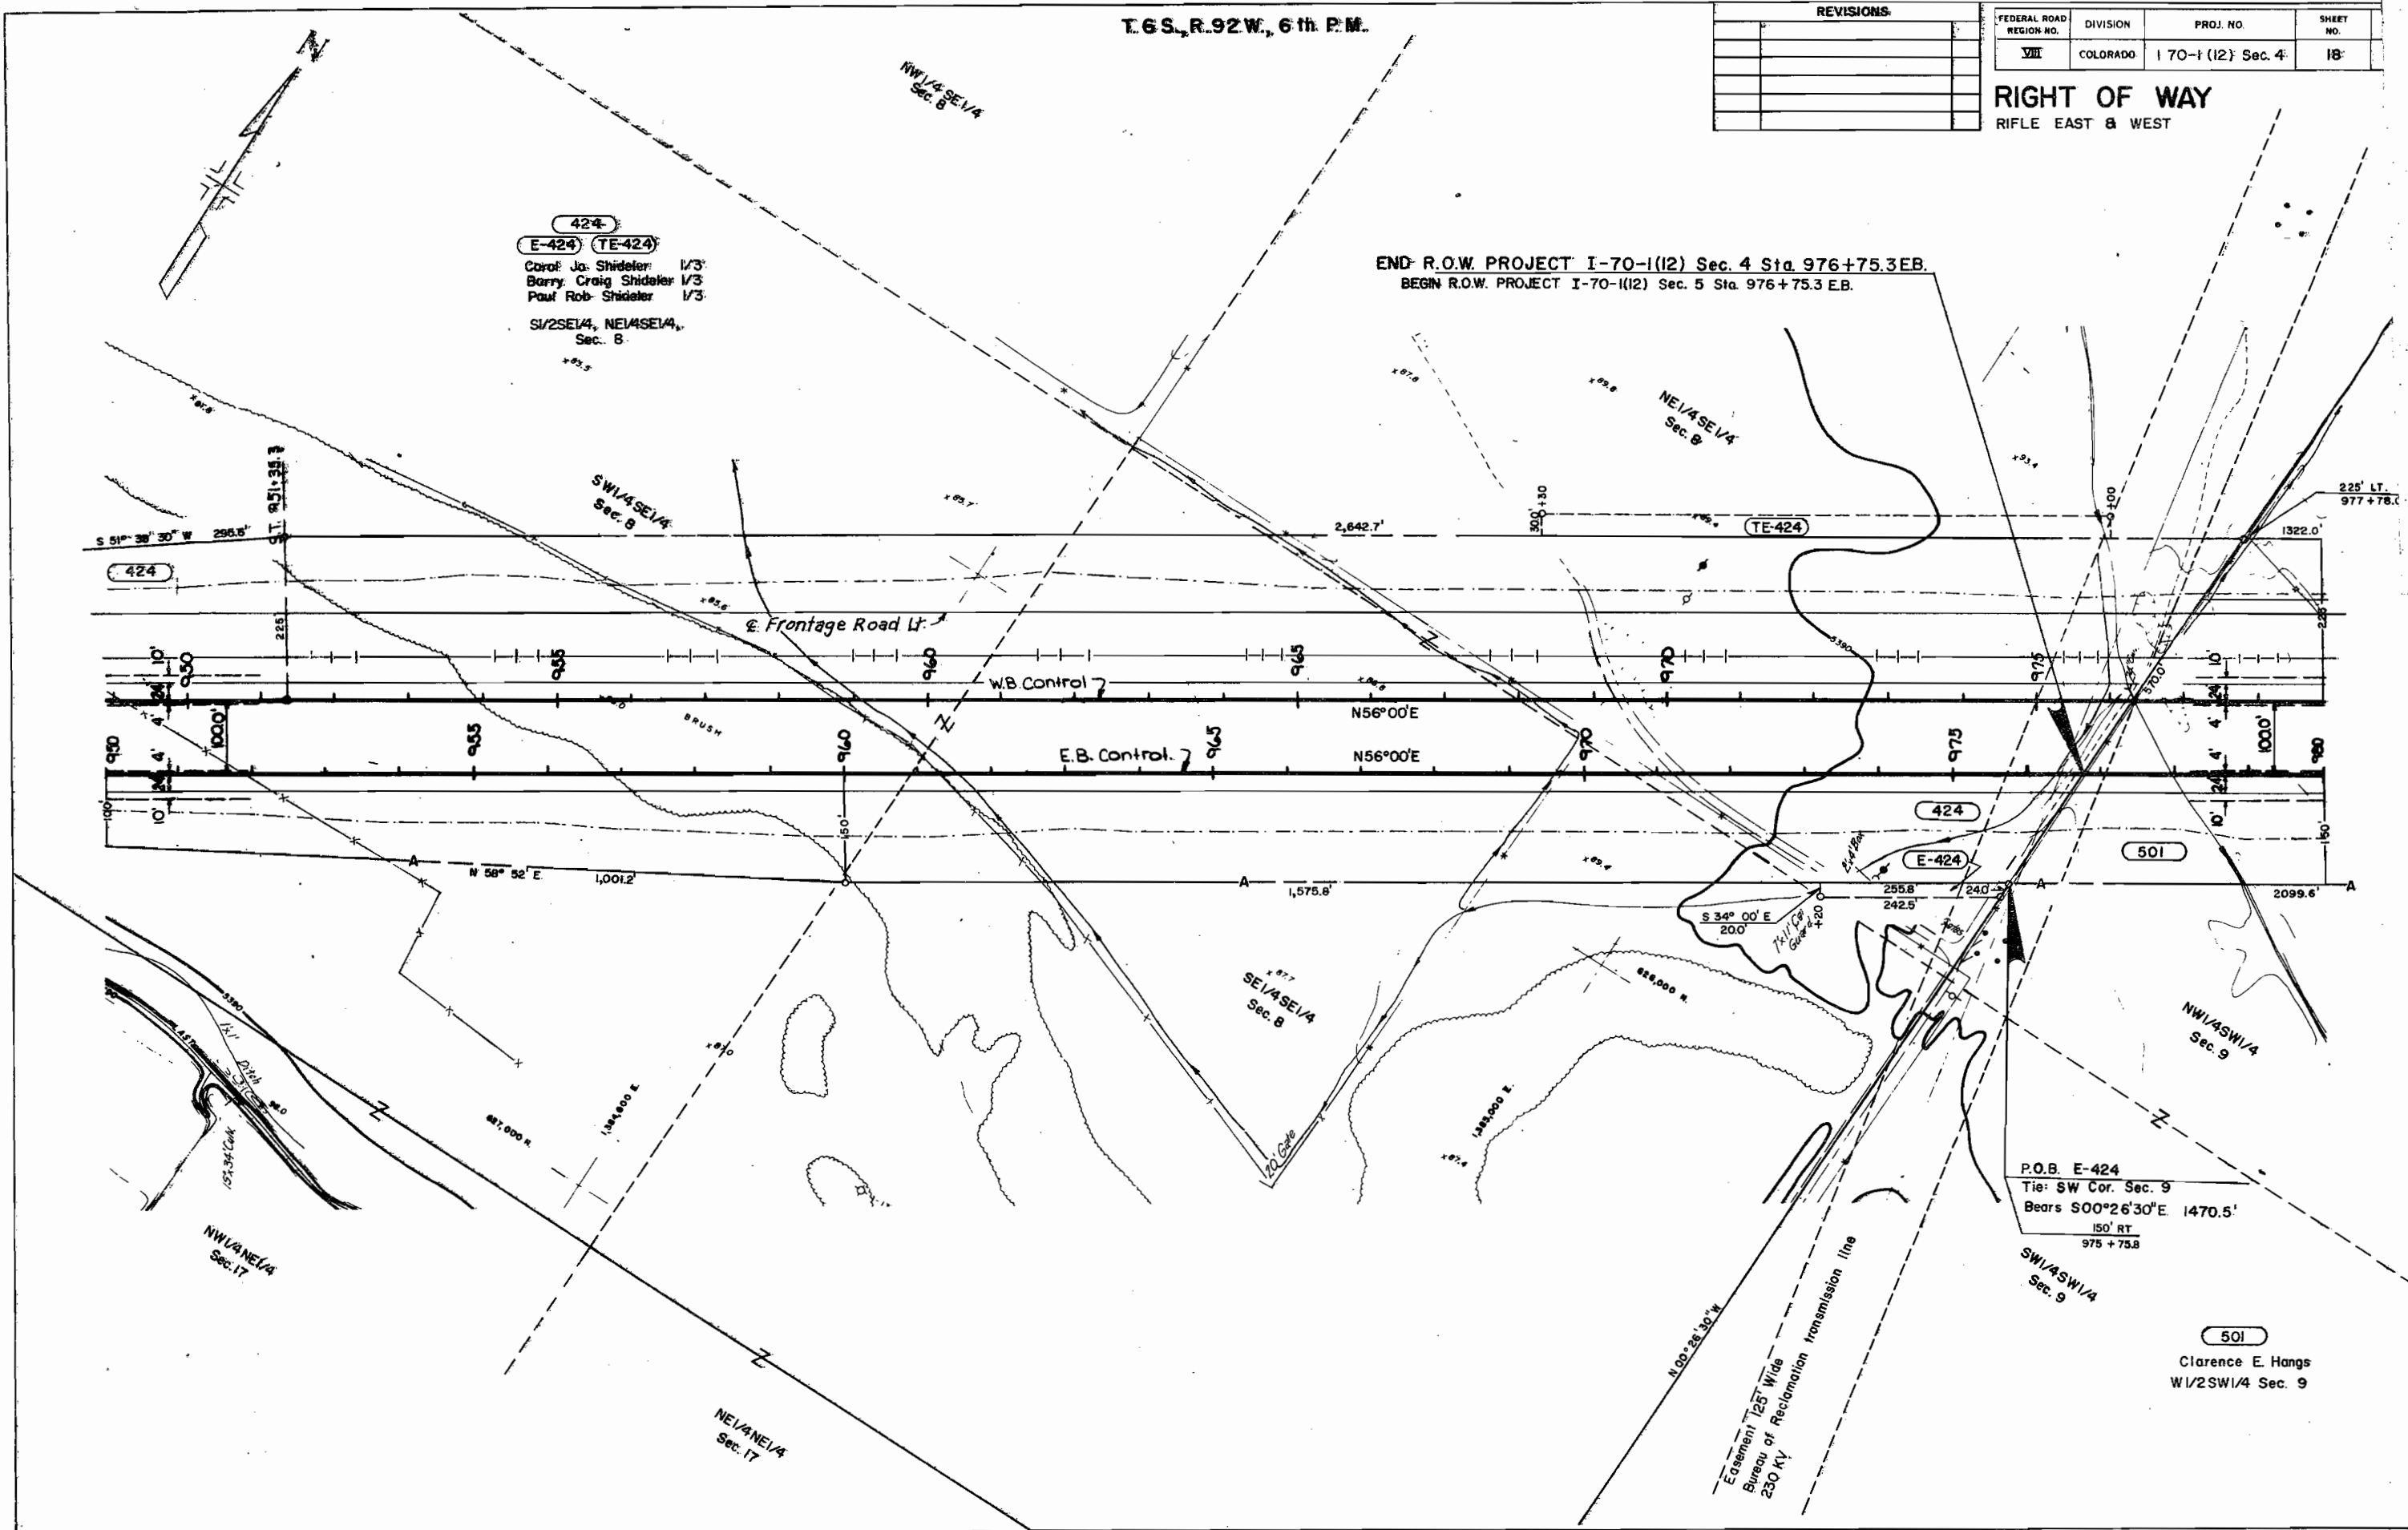

THE STATE DEPARTMENT OF HIGHWAYS
DIVISION OF HIGHWAYS—STATE OF COLORADO
PROJECT 170-1(12) Sec. 4
R.O.W. OWNERSHIP MAP

FEDERAL ROAD DIVISION NO.	DISTRICT	PROJ. NO.	SHEET NO.	TOTAL SHEETS
VIII	COLORADO	I 70-1 (12) Sec. 4	19	24

RIGHT OF WAY
RIFLE EAST & WEST

NOTE

—Par. 413R, Rev. 2, Add a portion of Meander Land located in the Colorado River which contains 7.49 ac. more or less.


REVISIONS				
5-15-74	Rev. 410, 411 & 412—Added 410RA	D.J.F.		
9-12-74	Rev. 401—Added E-401—Deleted TE-401	D.J.F.		
10-31-74	Rev. 410 Rev. 8 410-R	D.J.F.		
12-30-74	Name Cha. Par. 406	D.J.F.		
7-29-75	Name Cha. Par. 412 Rev. 2	D.J.F.		
	8 410R Rev.	J.B.		
9-17-75	Revised Pars. 413 & 413-R	J.B.		
4-8-76	Added Prop. Line	D.J.F.		
8-21-86	Revised Par. 413R, Rev. 2	D.J.F.		
5-04	PAR 410-R-A SOLD	JJ		

410RA

CDOT
conveyed to: Alpine Bank
a Colo. Corp.
subject to Transportation Commission approval
(B.1581 P 728)

GARFIELD COUNTY
T. 6 S., R. 93 W., 6th P.M.
Scale 1" = 400'

ALL IN SECTION 16				
PARCEL	OWNER	LOCATION	IMPROV.	
402R	MARJORIE B. SWEENEY & LAURENCE J. SWEENEY, J.T.	LOTS 6 & 7	HOUSE	
403	ALBERT F. HAFNER & JOYCE L. HAFNER, J.T.	LOT 7	HOUSE	
H-2	COLORADO DEPT. OF HIGHWAY	LOT 7	NONE	
H-1	COLORADO DEPT. OF HIGHWAY	LOT 7	NONE	
404	S.C. BARNETT	LOT 7	HOUSE	
405	GARFIELD COUNTY	LOT 7 & 8	NONE	
406	LENA CLUGSTON & HUGH E. CLUGSTON, J.T.	LOT 8	HOUSE	
407	DANIEL T. LONG & EMMA P.B. LONG, J.T.	LOT 7 & 8	HOUSE	
408	CHARLES ERNEST PRATT & AGNES T. PRATT	LOT 7 & 8	HOUSE	
TE-409	ECTYL J. DEGASE & MYRTLE DEGASE, J.T.	LOT 7 & 8	HOUSE	
410-R Rev. 2	410RA 410 Rev. 3	FRANK C. ANDERSON	LOT 8 & 9	HOUSE
	411 Rev.	RONALD JAMES CRANDALL & BARBARA CRANDALL, J.T.	LOT 8 & 9	HOUSE
	412 Rev.	MURIEL D. SWALLOW	LOT 8 & 9	HOUSE

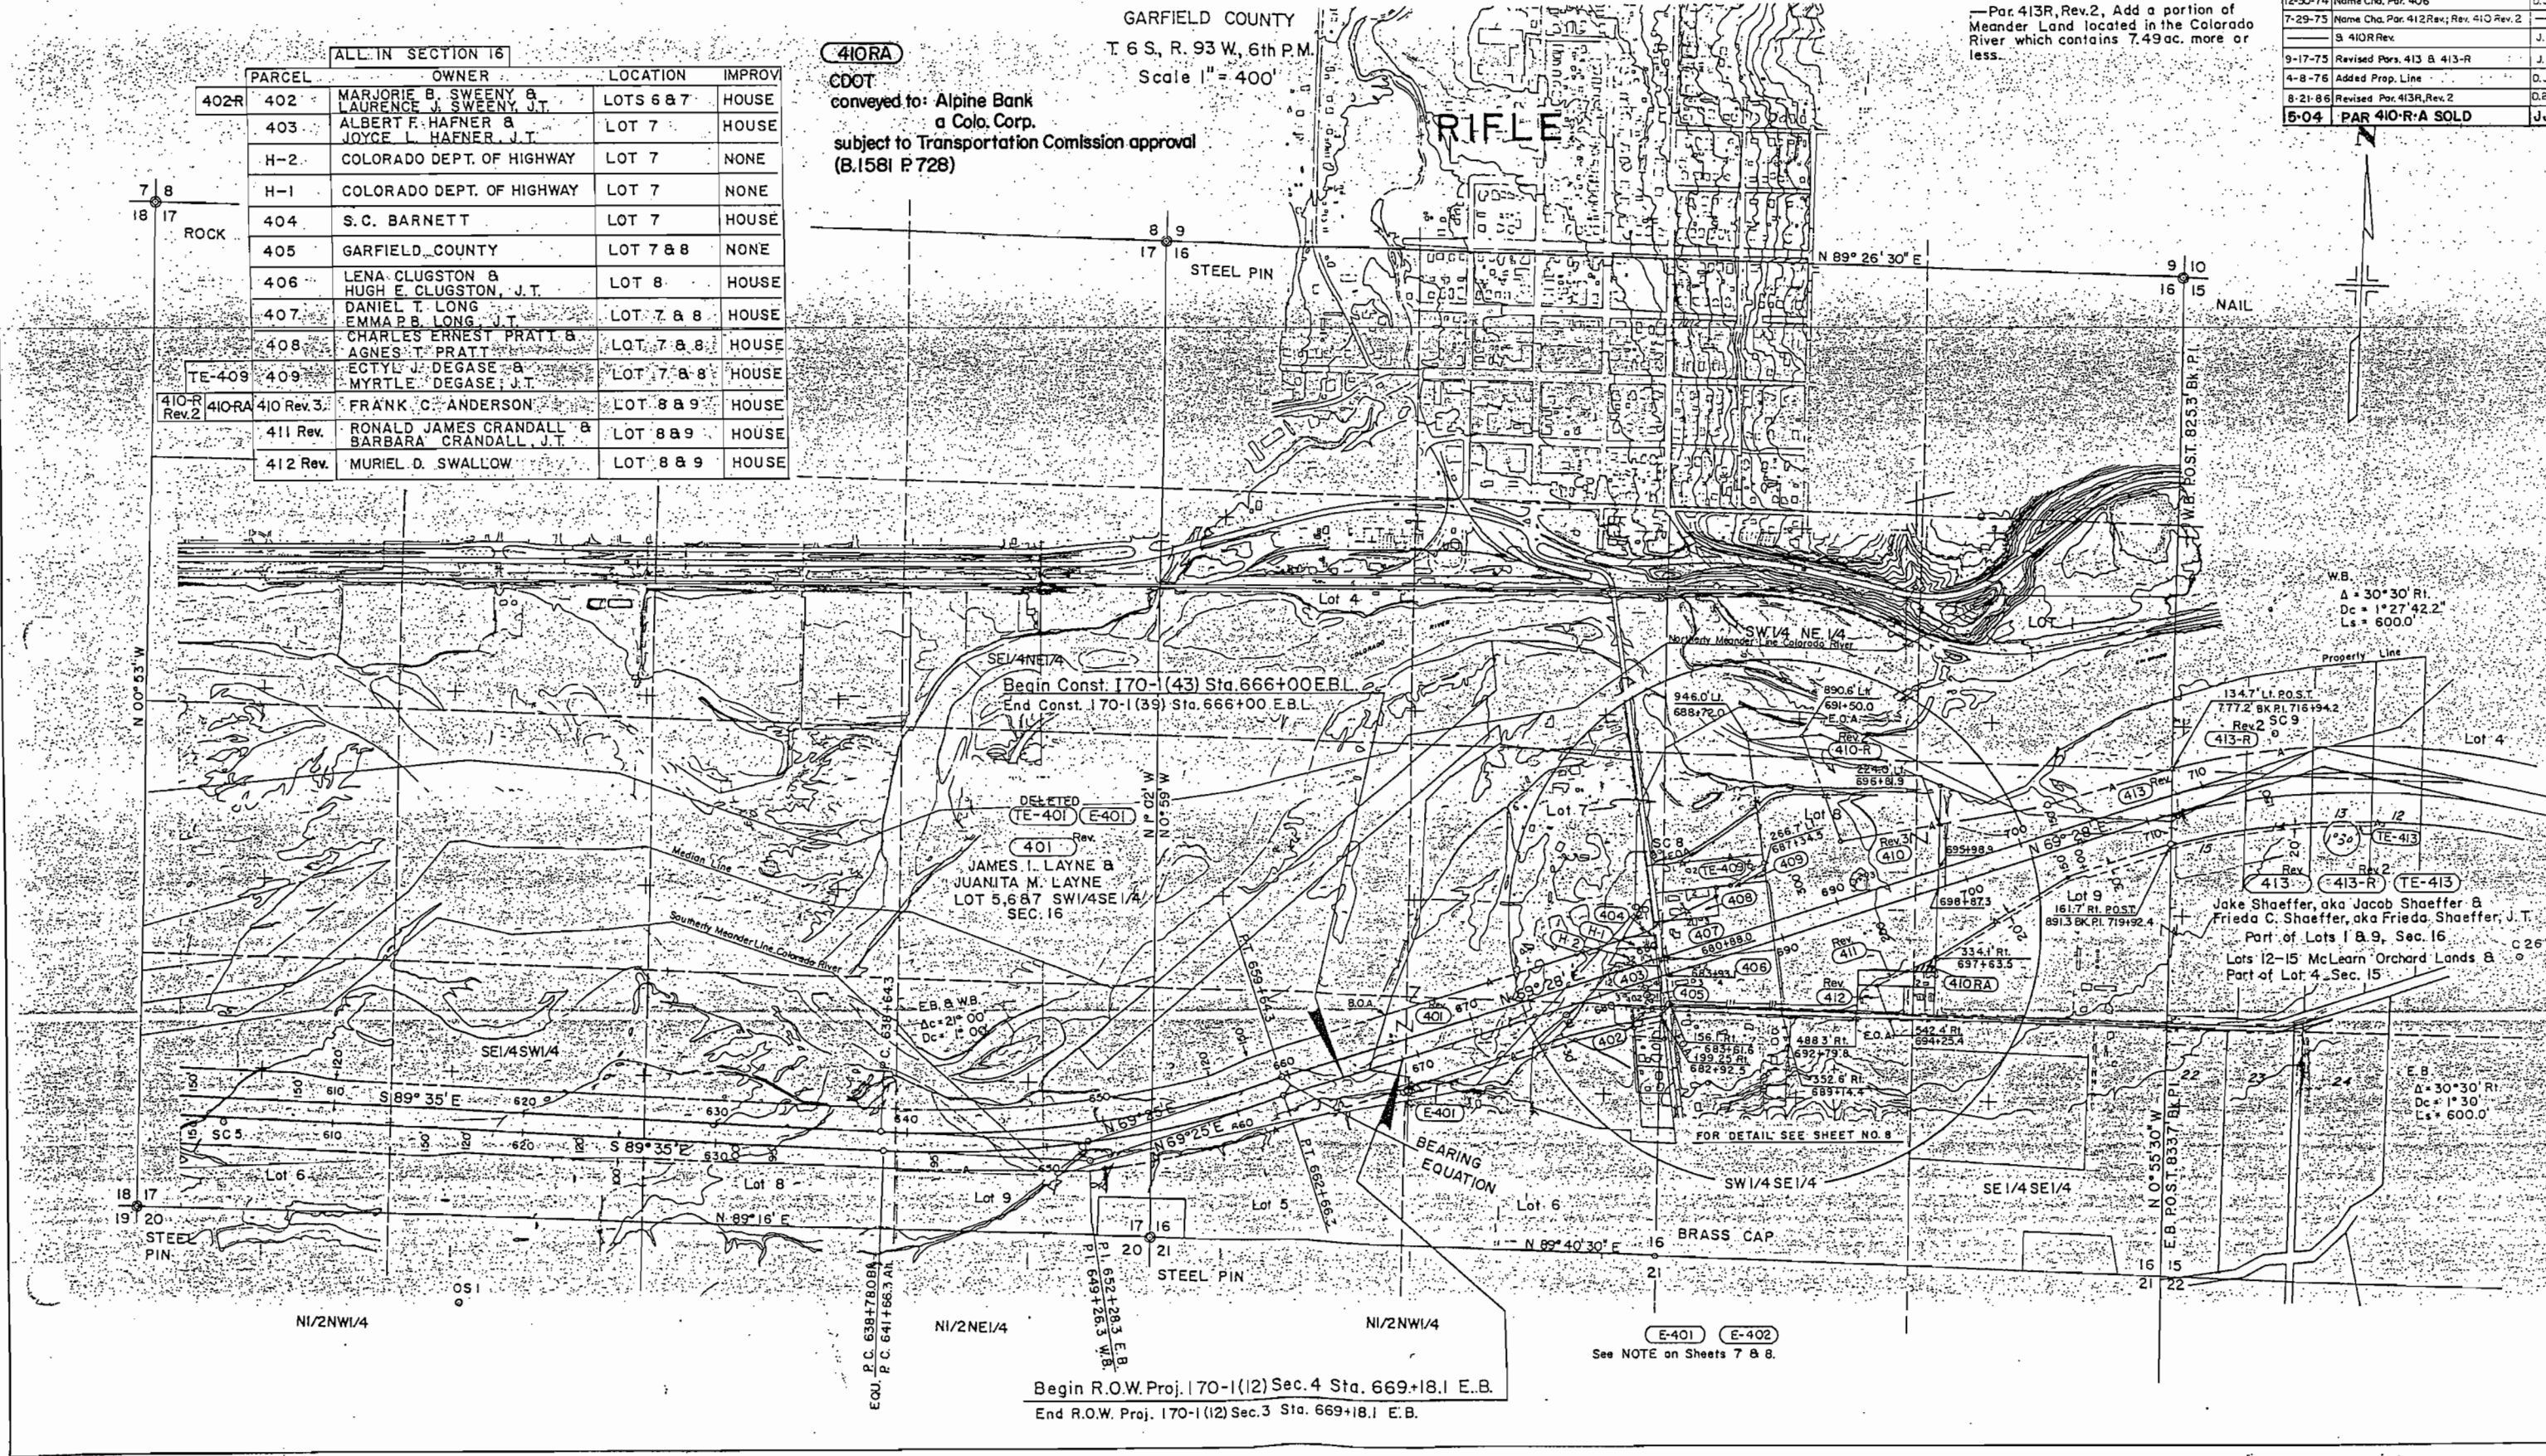

9/10
16/15

THE STATE DEPARTMENT OF HIGHWAYS
DIVISION OF HIGHWAYS—STATE OF COLORADO
PROJECT 170-1(12) Sec. 4
R.O.W. OWNERSHIP MAP

GARFIELD COUNTY
T. 6 S., R. 93 W., 6th P.M.
Scale 1" = 200'

REVISIONS				
9-12-74	Name Chg. 414, E-414, TE-414A, B & D	D.J.F.		
2-13-75	Correct Lot Lines	J.B.		
8-5-75	Added Par. 426	J.B.		
9-17-75	Rev. Pars. 413, 413-R, E-413, 414, E-414			
	TE-414-A; Del. Par. 414-A, TE-414-B, TE-414C	J.B.		
4-8-76	Rev. Par. 415	D.J.F.		
8-21-86	Revised Par. 413R, Rev. 2	D.P.T.		
8-11-87	Add 2nd Revision To Par. 415 Rev.	D.P.T.		

FEDERAL ROAD REGION NO.	DIVISION	PROJ. NO.	SHEET NO.	TOTAL SHEETS
VIII	COLORADO	170-1(12) Sec. 4	20	24

RIGHT OF WAY
RIFLE EAST & WEST

NOTE

PARCEL 426 REPRESENTS ANY AND ALL INTEREST IN A UTILITY EASEMENT GRANTED TO CASCADE NATURAL GAS CO. AND QUIT CLAIMED BY THEM TO C.D.O.H. IN EXCHANGE FOR A USE PERMIT.

TE-414-B 414A TE-414C DELETED

Rev. 2
415 TE-415
AGNES HUNT
SE 1/4 NW 1/4, SW 1/4 NE 1/4
Part of NW 1/4 SW 1/4 &
Lots 2, 3 & 4 Sec. 14

426
CASCADE NATURAL GAS CO.
(See Note)

W.B.
Δ = 35°30' Lt.
Dc = 1°32'25"
Ls = 600.0'

260.4' Lt. POST.
564.4' AH PL. 761+08.2
LOT 2

270.9' Lt. POST.
509.1' AH PL. 761+08.2

59.6' Rl. POST.
399.9' AH PL. 761+40.2

NW 1/4 SW 1/4

E.B.
Δ = 35°30'
Dc = 1°30'
Ls = 600.0'

E.B.
Δ = 30°30' Rt.
Dc = 1°30'
Ls = 600.0'

Rev. 413 E-413 TE-413 413-R
JAKE SHAEFFER, aka JACOB SHAEFFER &
FRIEDA C. SHAEFFER, aka FRIEDA SHAEFFER, J.T.
Lots 12-15 McLearn Orchard Lands
and Part of Lot 4, Sec. 15

Also, add a portion of Meander Land
in the Colorado River which contains
7.49 ac. more or less.

TE-414
TE-414-A Rev.
414 E-414 Rev.
JAKE BILLINGSLEY D.B.A. JAKE
BILLINGSLEY & COMPANY AS TRUSTEE
Lots 1-11, 25-33
McLearn Orchard Lands and
Part of Lots 4 & 5 Sec. 15

Rev. 414 TE-414-D
JAKE BILLINGSLEY D.B.A. JAKE
BILLINGSLEY & COMPANY AS TRUSTEE
Lots 1-11, 25-33 McLearn Orchard
Lands and Part of Lots 4 & 5
Sec. 15

McLearn Orchard Lands


THE STATE DEPARTMENT OF HIGHWAYS
DIVISION OF HIGHWAYS—STATE OF COLORADO
PROJECT 170-1(12) Sec. 4
R.O.W. OWNERSHIP MAP
GARFIELD COUNTY
T. 6 S., R. 93 W., 6th P.M.
Scale 1" = 200'

FEDERAL ROAD REGION NO.	DIVISION	PROJ. NO.	SHEET NO.	TOTAL SHEETS
VIII	COLORADO	170-1(12) SEC. 4	21	24

REVISIONS	
9-12-74	Add E-414A, E-415, E-415A & E-418 Name Chg. 417 D.J.F.
12-30-74	Name Chg. 418 B E-418 D.J.F.
5-30-75	Revised Pars. 417 & 418 K.C.
6-20-75	Added 415-R D.J.F.
9-17-75	Added Width on E-414-A & E-415-A J.B.
4-8-76	Revised Par. 415 D.J.F.
8-11-87	Add 2nd Revision To Par. 415 Rev. —
	Delete Par. 415 R D.P.T.

RIGHT OF WAY
RIFLE EAST & WEST

NOTE
E-414A, E-415, E-415A & E-418 to be
Deeded directly from owners to
Public Service Company.

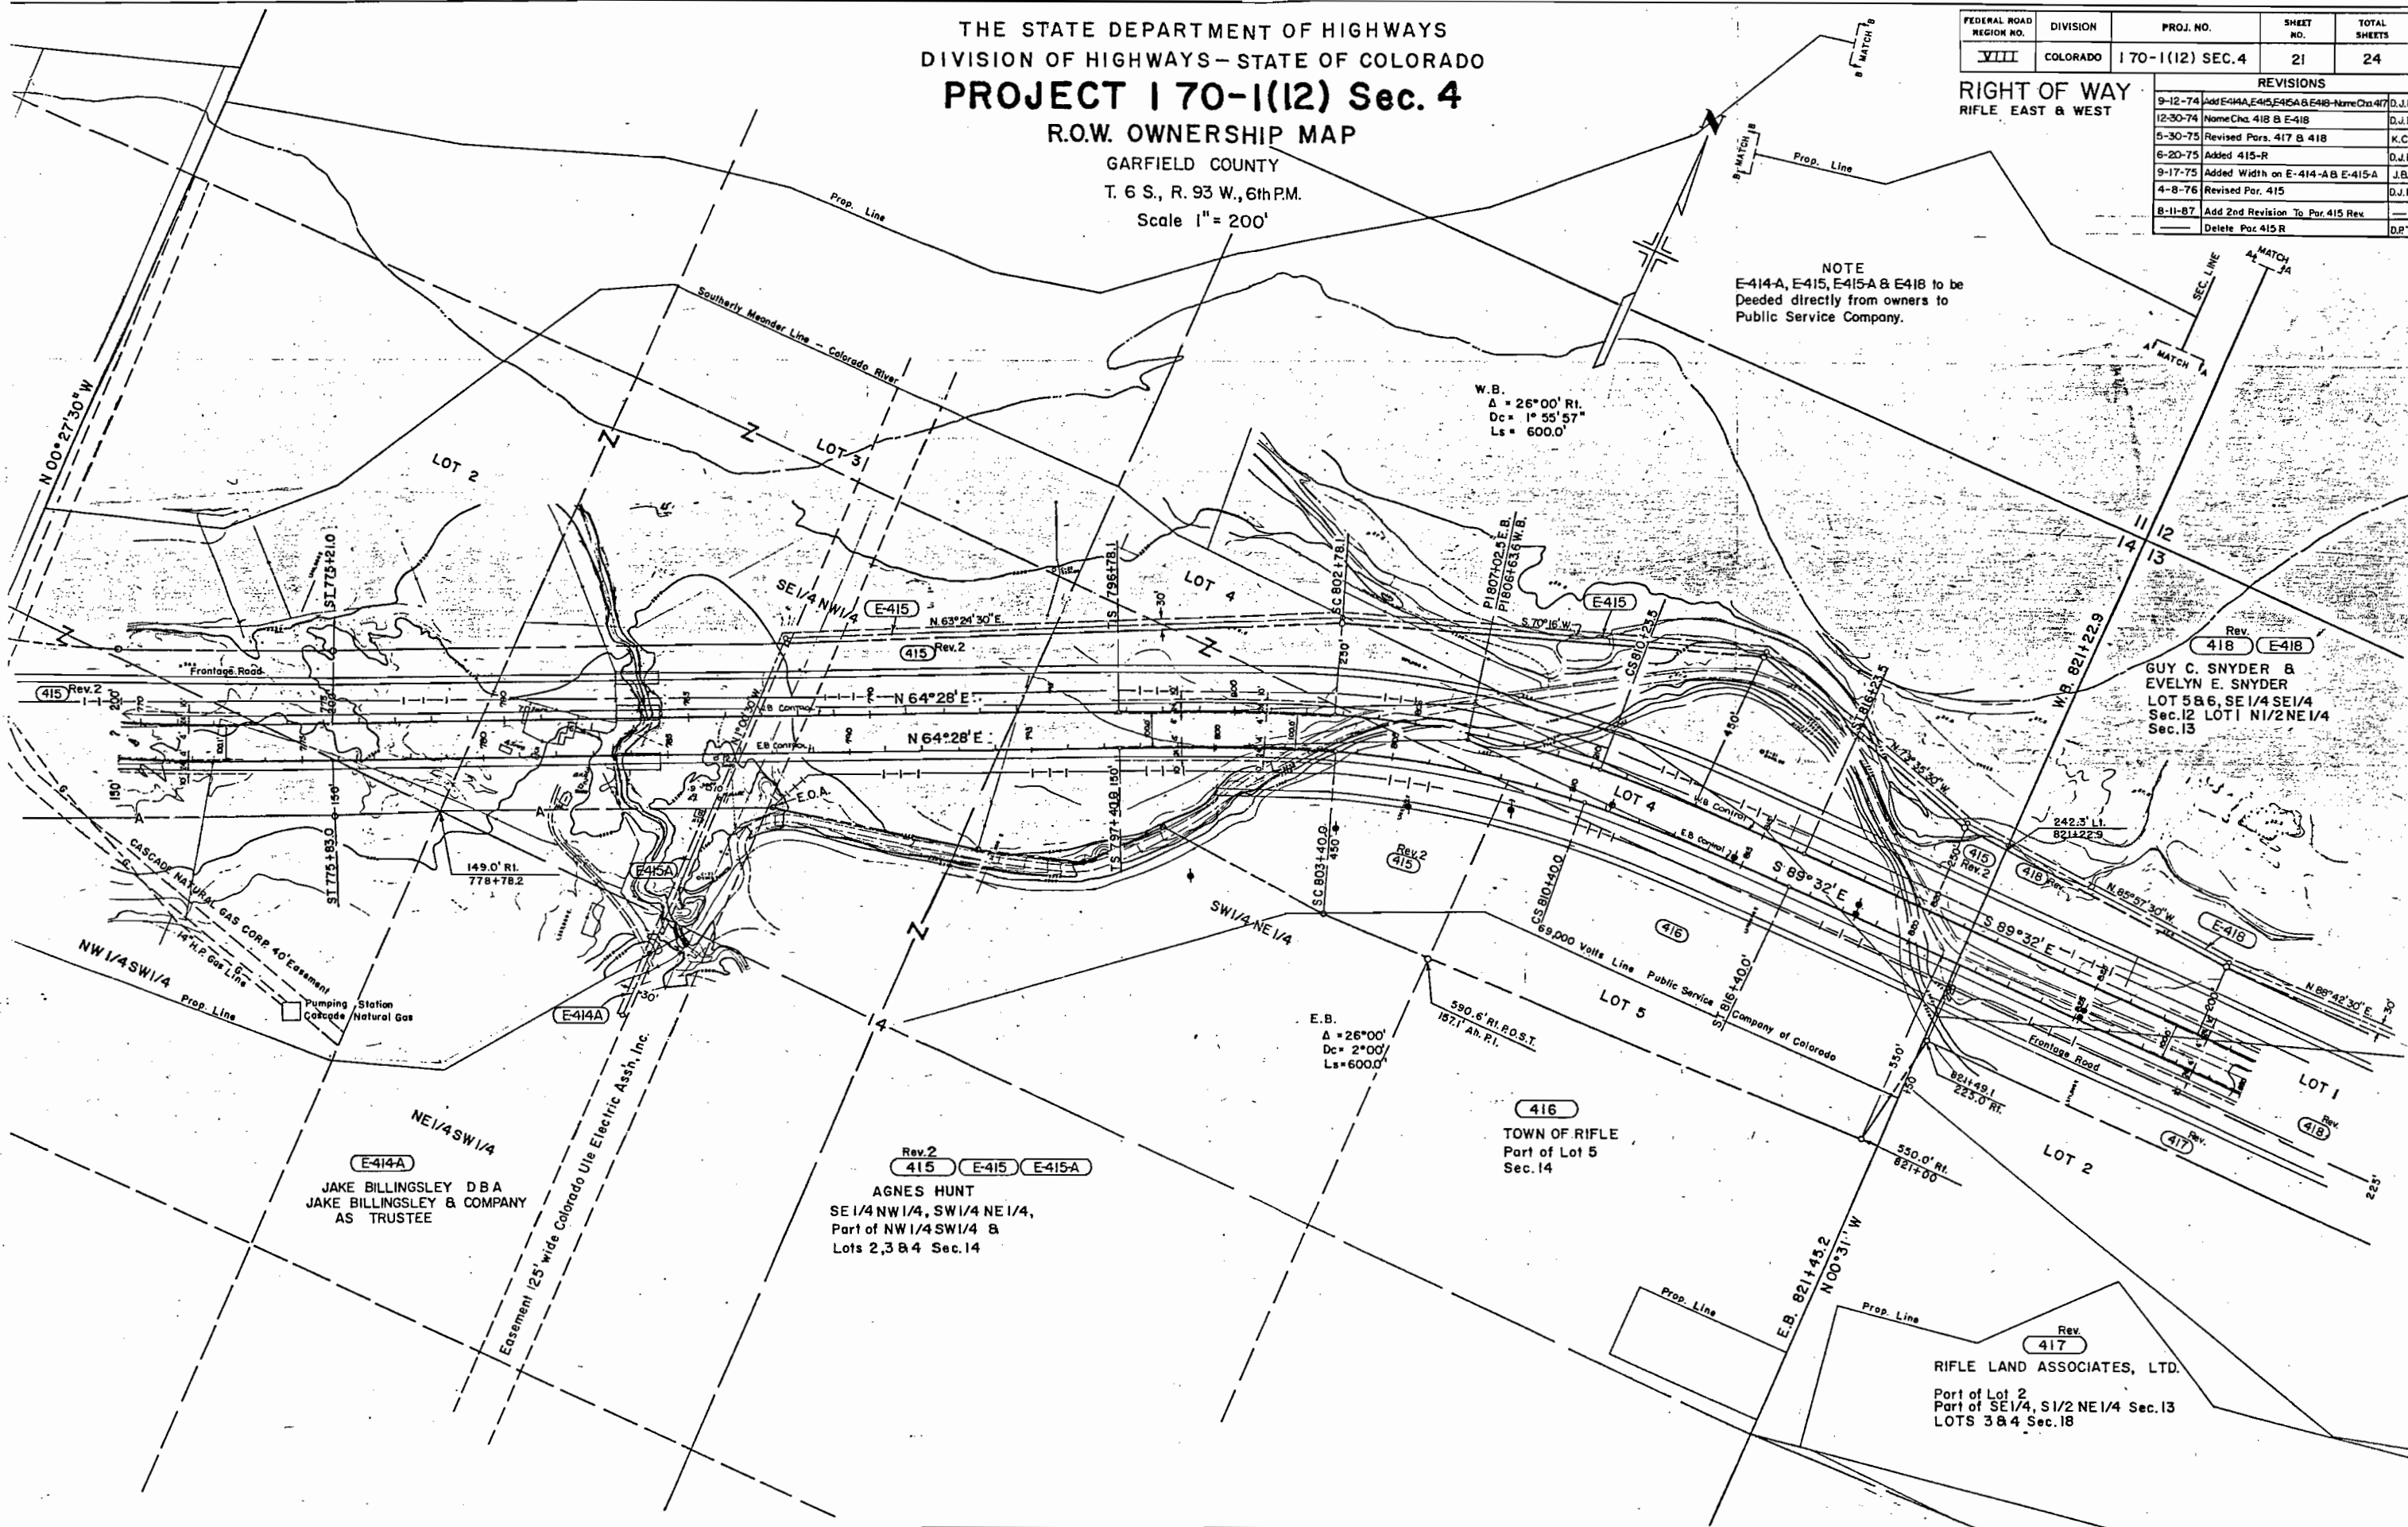

THE STATE DEPARTMENT OF HIGHWAYS
DIVISION OF HIGHWAYS - STATE OF COLORADO
PROJECT 170-1(12) Sec. 4
R.O.W. OWNERSHIP MAP

GARFIELD COUNTY
T.6S., R.93 W., 6th PM.
T.6S., R.92 W., 6th PM.
Scale 1" = 200'

FEDERAL ROAD REGION NO.	DIVISION	PROJ. NO.	SHEET NO.	TOTAL SHEETS
VIII	COLORADO	170-1(12) Sec. 4	22	24

REVISIONS	
9-12-74	Rev. 420-Added E-418, E-418A, 419A, B
10-31-74	420-R-Name Chg. 417
12-30-74	Added Access 418 B, 420 Rev.
5-30-75	Name Chg. 418, E-418, E-418A, TE-418, TE-418A
	Rev. 417, 418, E-418A, 419, 420 Rev., B
	420R, Add TE-418B, TE-420B
	Delete 419A
	K.C.

NOTE
E-418 B E-418-A-Rev. to be deeded directly from owners to Public Service Company.

TE-418B Rev.
418
E-418
E-418-A
TE-418
TE-418A
GUY C. SNYDER &
EVELYN E. SNYDER
LOT 5 & 6 SE 1/4 SE 1/4
Sec. 12, LOT 1 N 1/2 NE 1/4
Sec. 13

Rev. 2
420
Rev. 2
420-R
TE-420
TE-420B
VALLEY FARMS, INC.
LOTS 5-8 S 1/2 SE 1/4 Sec. 7
Part of LOT 1, N 1/2 NE 1/4 Sec. 18
SEE SHEET 24 INSET "A"

W.B.
Δ = 14°00' Rt.
Dc = 0°58'58"
Ls = 300.0'


End Const. 170-1(43) Sta. 840+00 E.B.L.
Begin Const. 170-1(42) Sta. 840+00 E.B.L.

Rev. 419
JAMES G. SNYDER
Part of NE 1/4 NE 1/4
Sec. 13

Rev. 417
RIFLE LAND ASSOCIATES, LTD.
Part of SE 1/4, S 1/2 NE 1/4 Sec. 13
LOTS 3 & 4 Sec. 18
SEE SHEET 24 INSET "A"

416A
TOWN OF RIFLE
Part of LOT 5 Sec. 14
Parts of S 1/2 N 1/2, N 1/2 SW 1/4
Sec. 13

419A DELETED

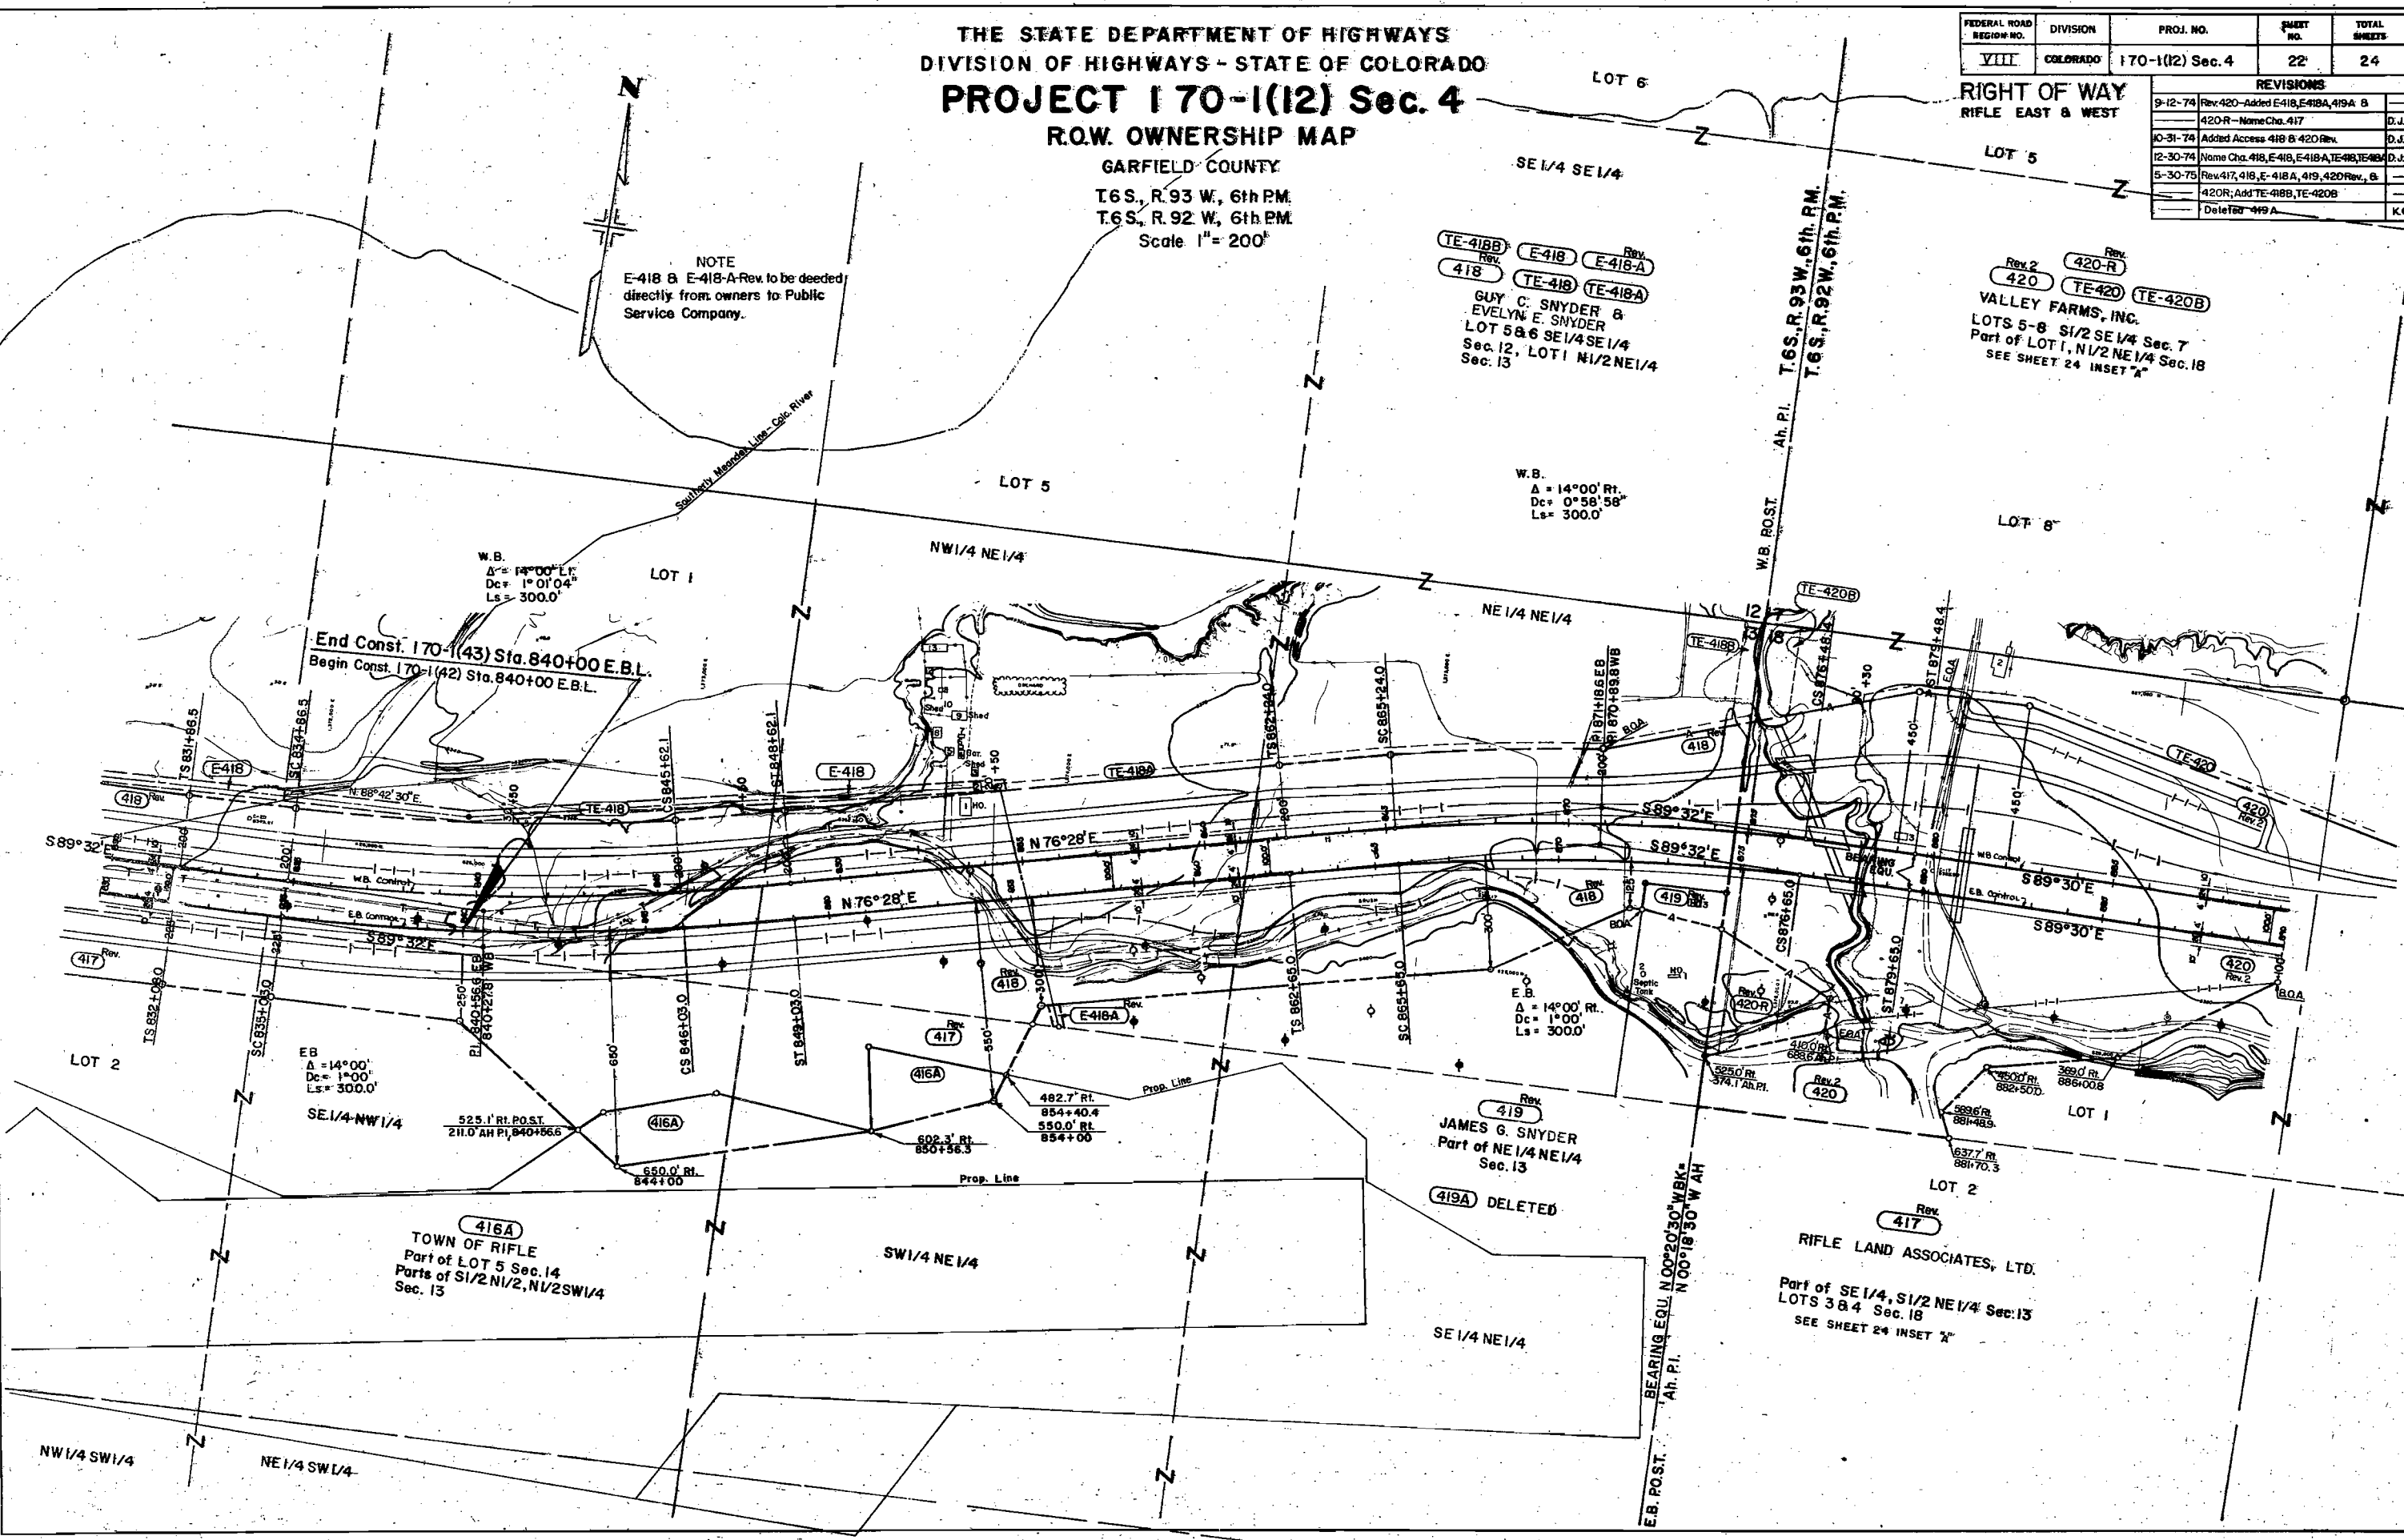

THE STATE DEPARTMENT OF HIGHWAYS
DIVISION OF HIGHWAYS - STATE OF COLORADO
PROJECT 170-1(12) Sec. 4


R.O.W. OWNERSHIP MAP

GARFIELD COUNTY
T.6 S., R.92 W., 6th PM.
Scale 1" = 200'

REVISIONS		
9-12-74	Rev. 420	D.J.F.
5-30-75	Revised Per. 420 Rev.	K.C.
4-25-77	Deleted E-425	D.J.F.

FEDERAL ROAD DISTRICT NO.	DIVISION	PROJ. NO.	SHEET NO.	TOTAL SHEETS
VIII	COLORADO	170-1(12) Sec. 4	23	24

RIGHT OF WAY
RIFLE EAST & WEST

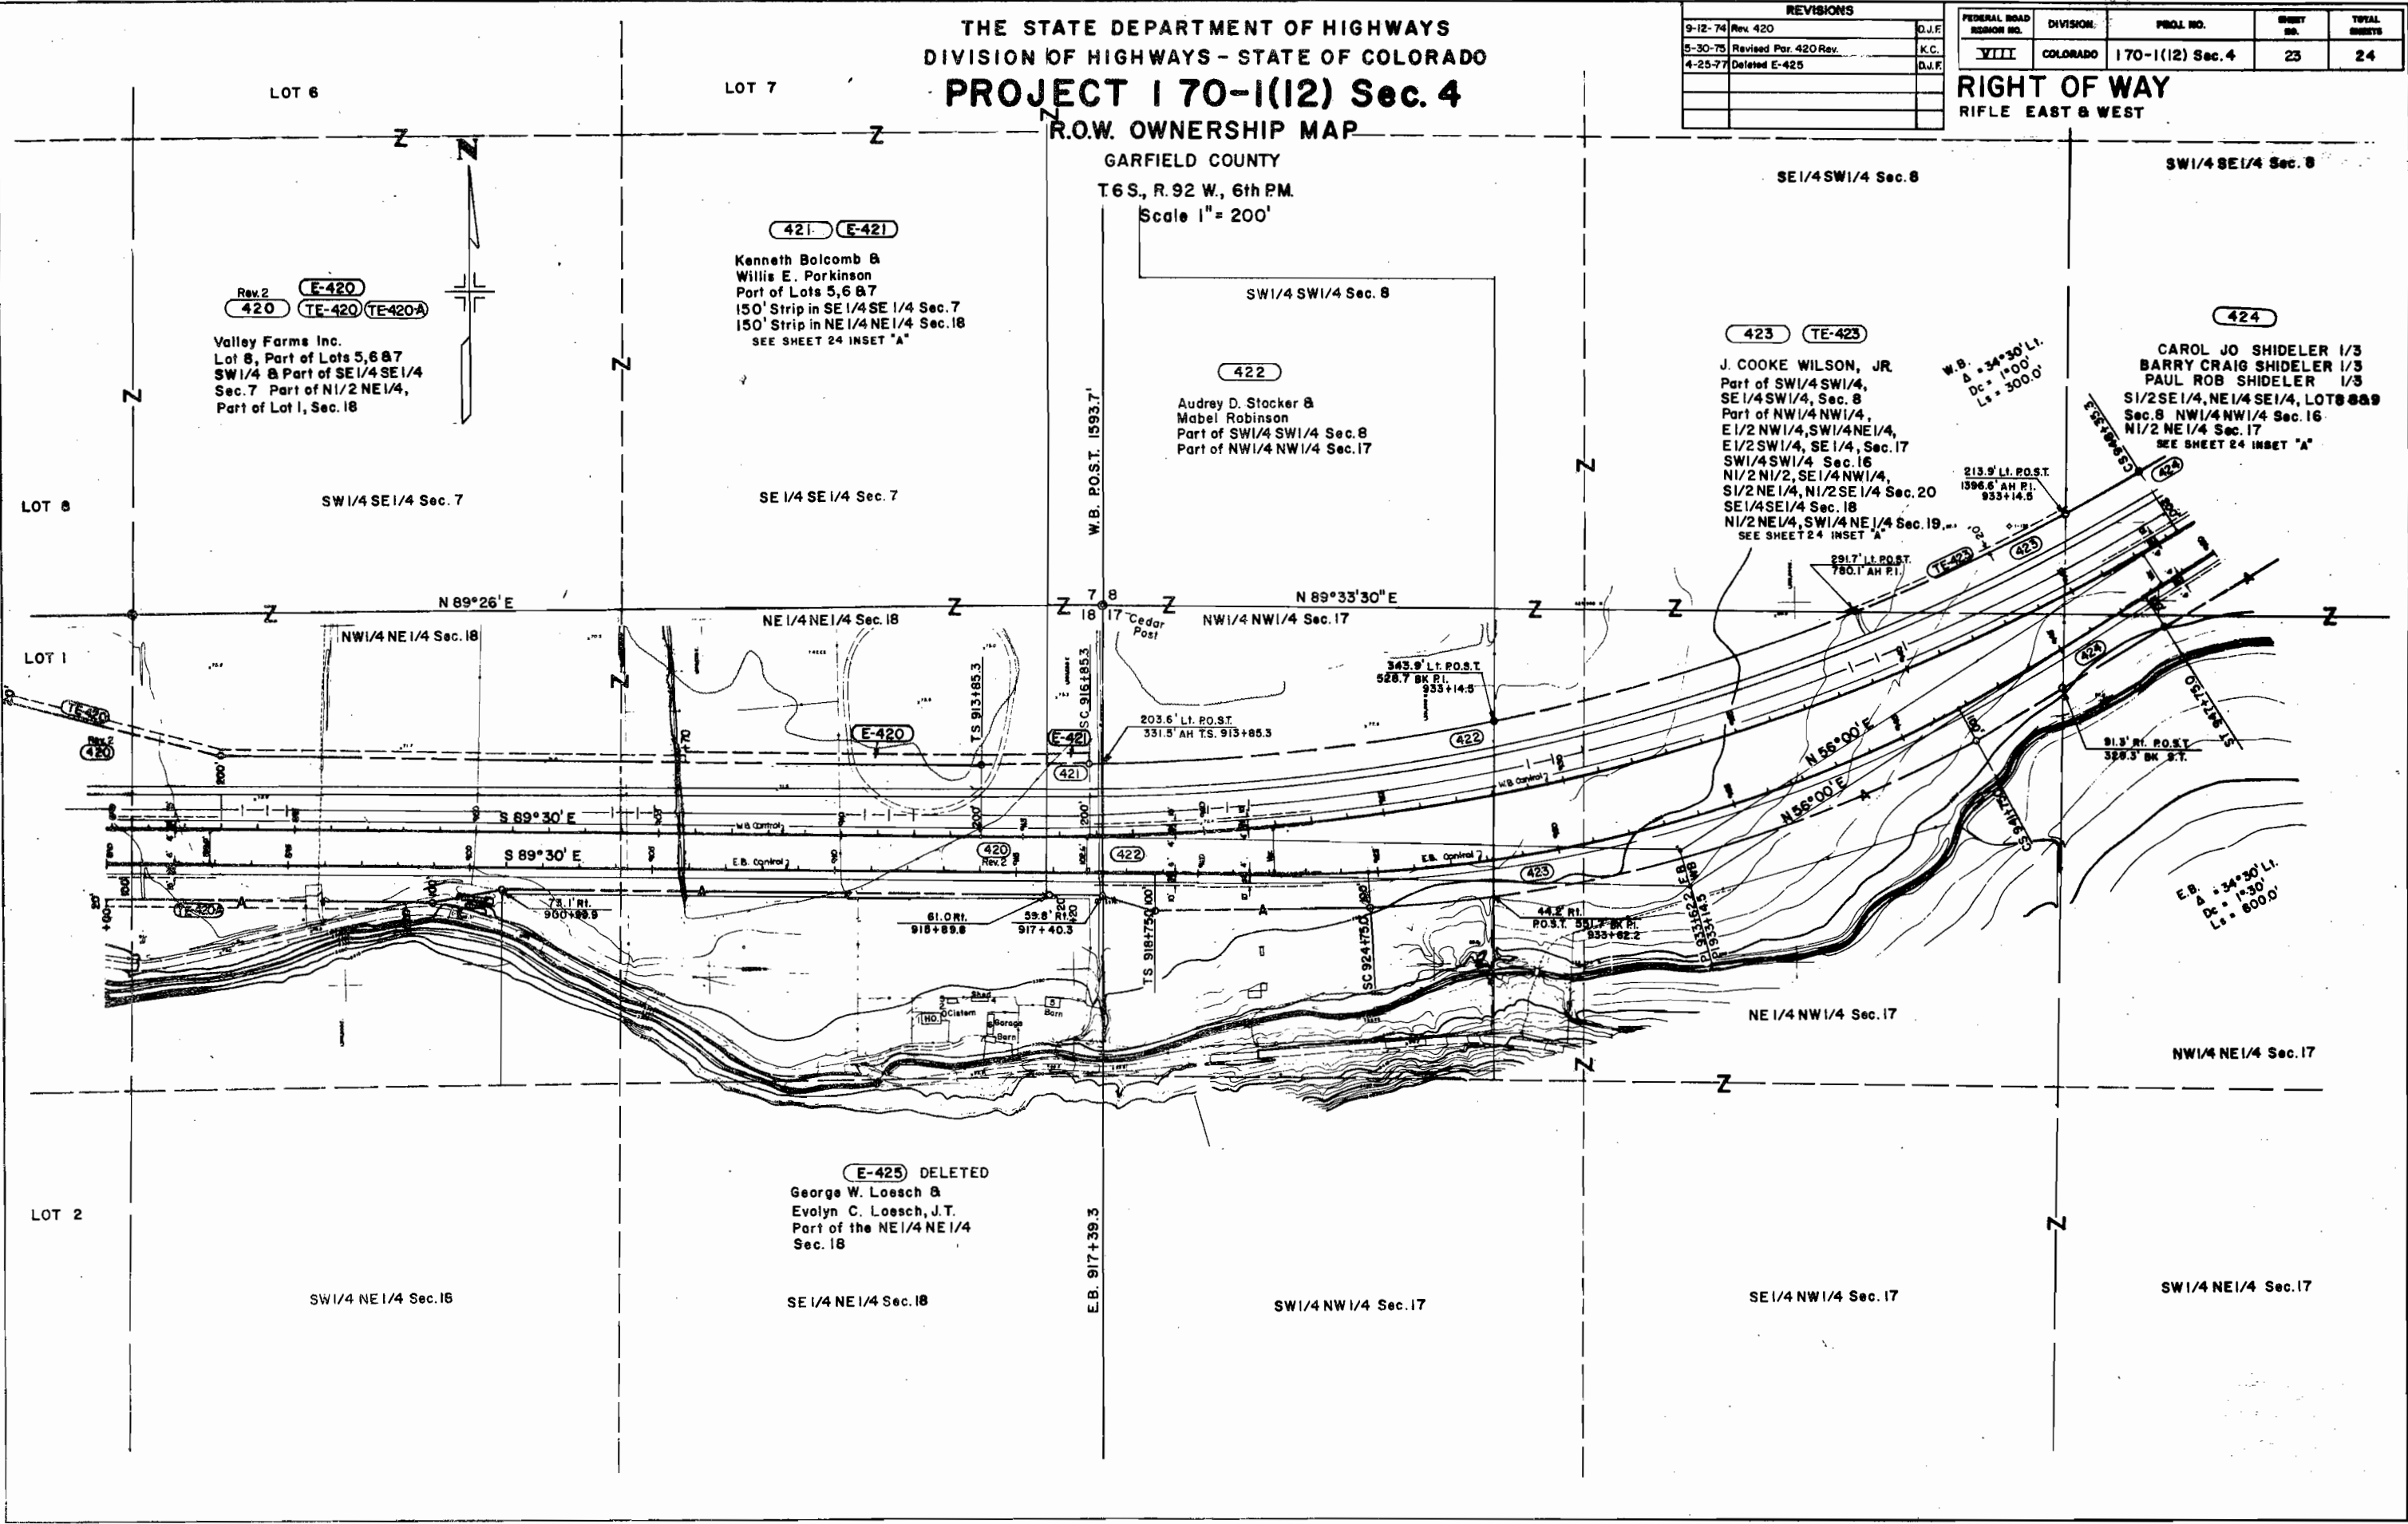


THE STATE DEPARTMENT OF HIGHWAYS
DIVISION OF HIGHWAYS - STATE OF COLORADO
PROJECT 170-1(12) Sec. 4
R.O.W. OWNERSHIP MAP

GARFIELD COUNTY
T6S., R. 92 W., 6th P.M.
Scale 1" = 200'

FEDERAL ROAD REGION NO.	DIVISION	PROJ. NO.	SHEET NO.	TOTAL SHEETS
VIII	COLORADO	170-1(12) Sec. 4	24	24

RIGHT OF WAY
RIFLE EAST & WEST


REVISIONS		
5-15-74	Corrected Ownership Inset 'A'	D.J.F.
9-12-74	Rev. Inset 'A'	D.J.F.
2-13-75	Revise Sheet	J.B.

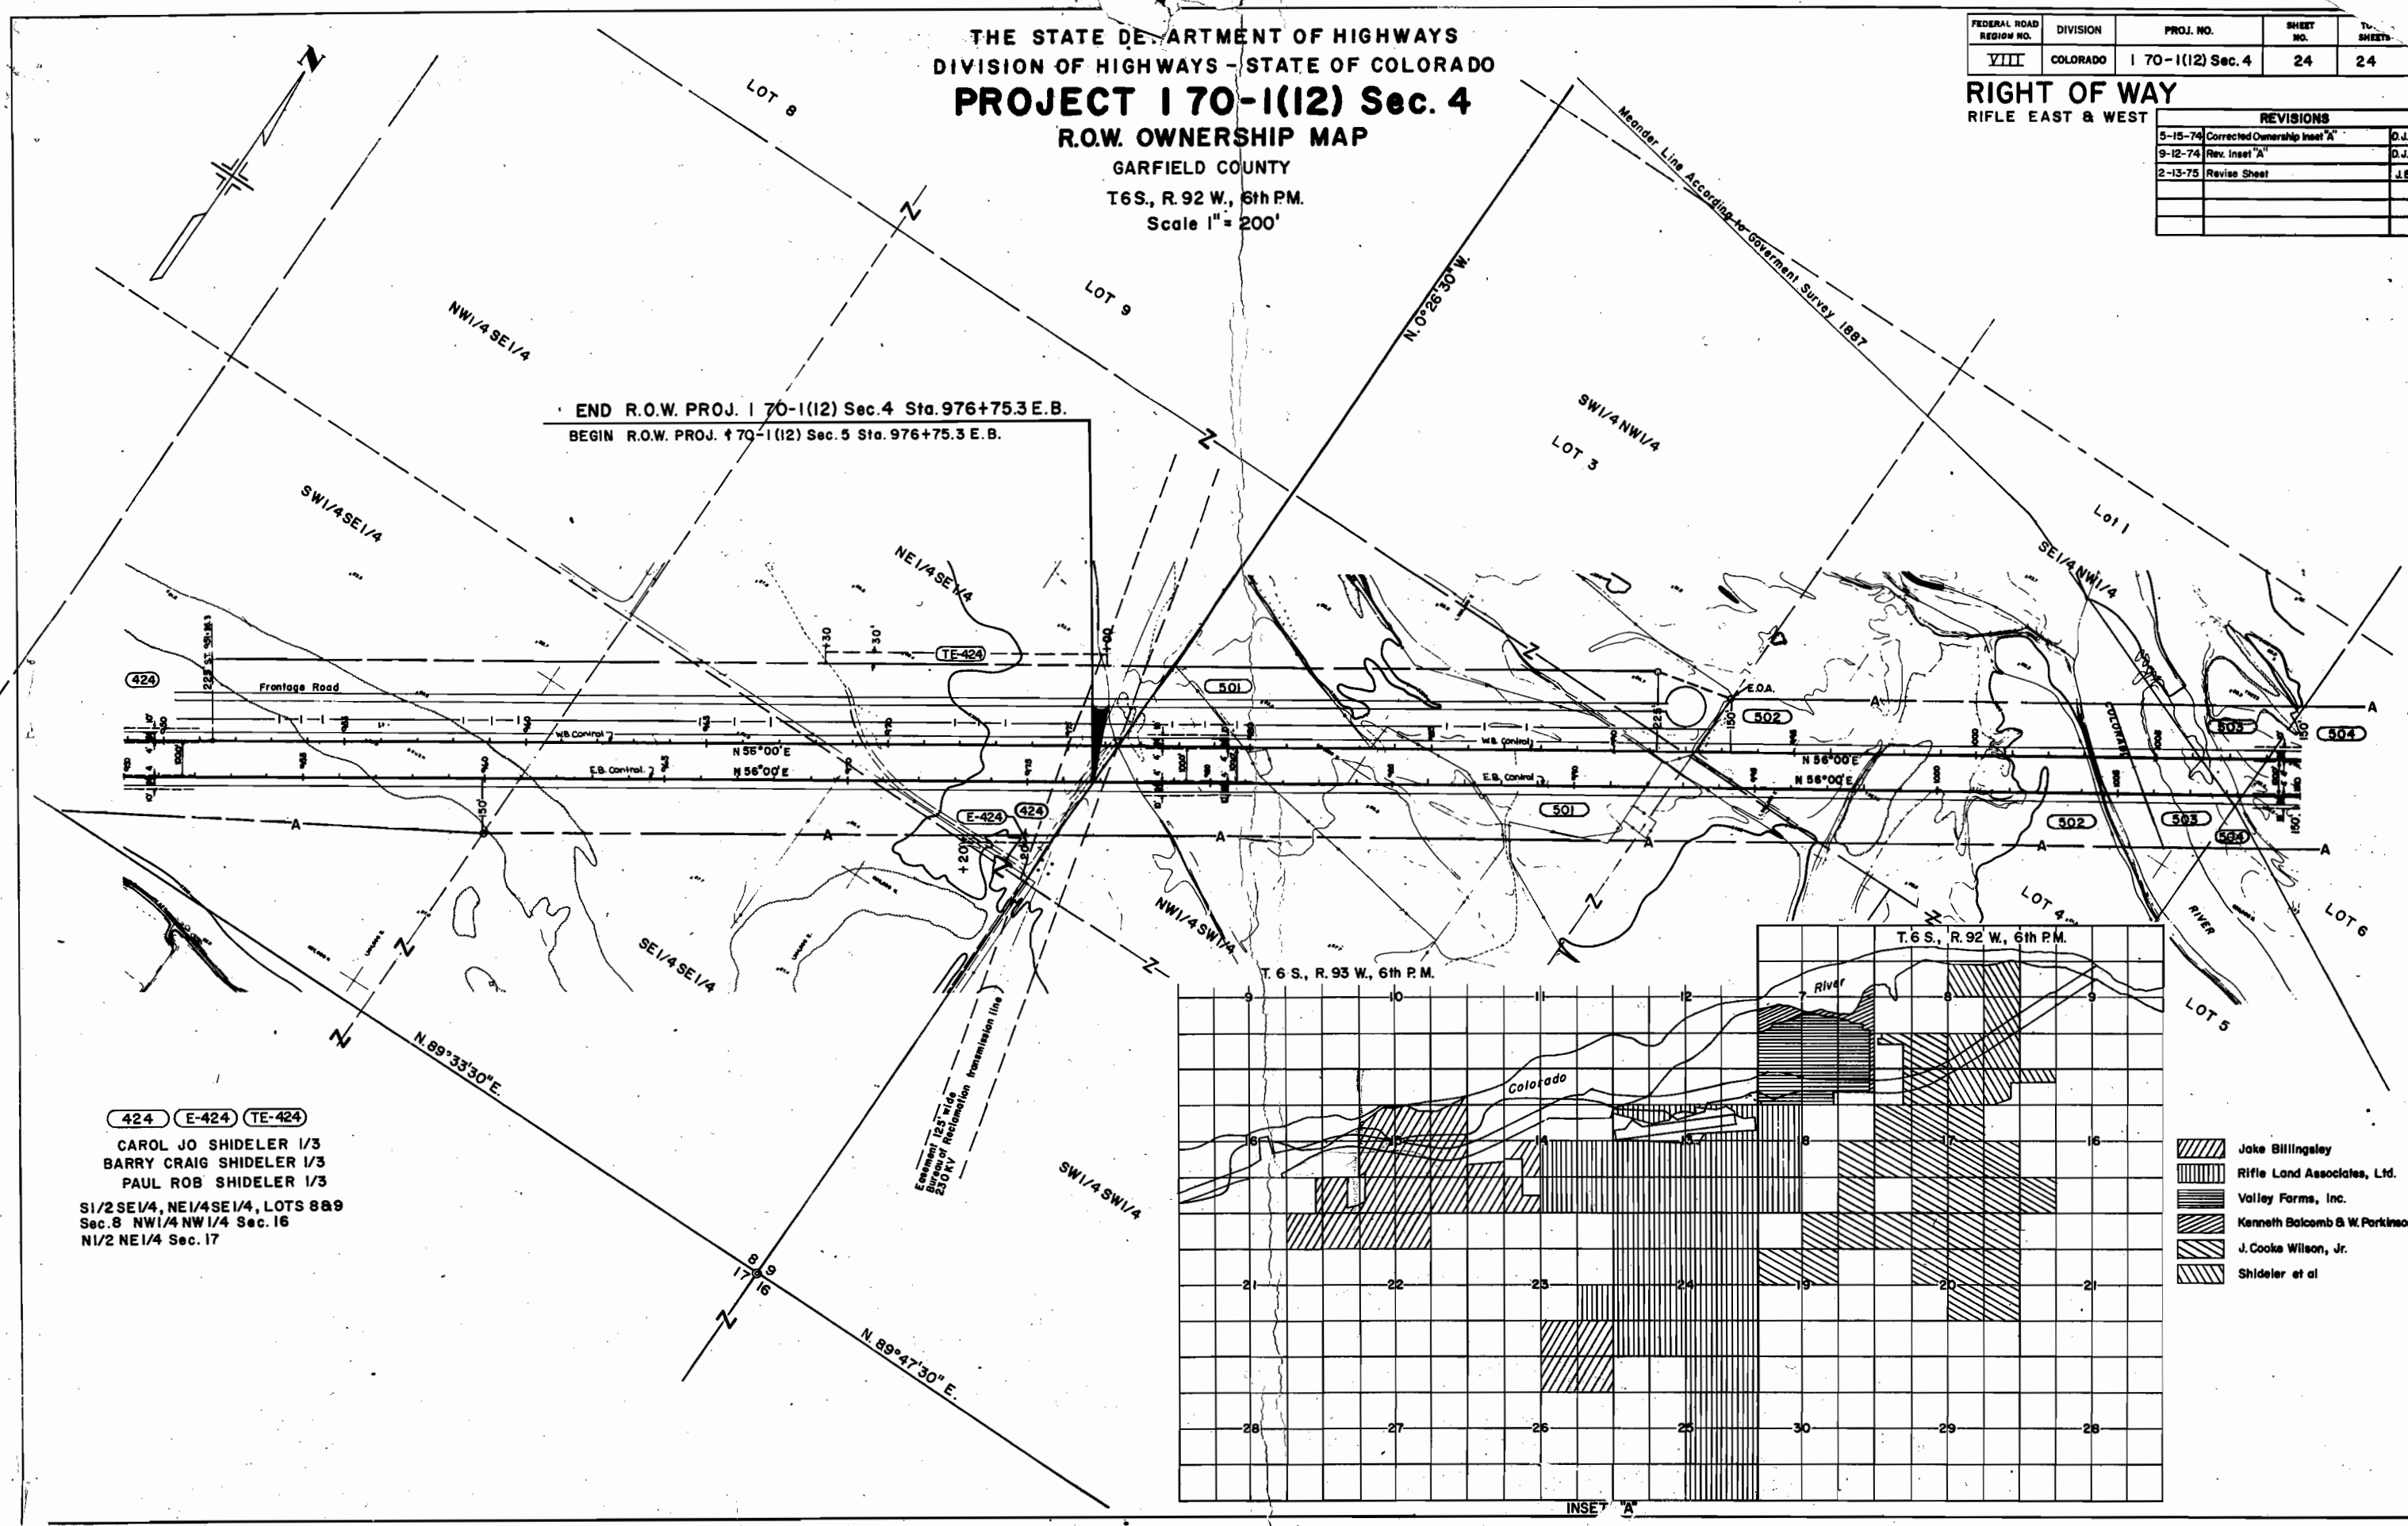

END R.O.W. PROJ. 170-1(12) Sec. 4 Sta. 976+75.3 E.B.
BEGIN R.O.W. PROJ. 170-1(12) Sec. 5 Sta. 976+75.3 E.B.

424 E-424 TE-424
CAROL JO SHIDELER 1/3
BARRY CRAIG SHIDELER 1/3
PAUL ROB SHIDELER 1/3
S1/2 SE1/4, NE1/4 SE1/4, LOTS 8 & 9
Sec. 8 NW1/4 NW1/4 Sec. 16
N1/2 NE1/4 Sec. 17

Exhibit 125 with
Bureau of Reclamation transmission line

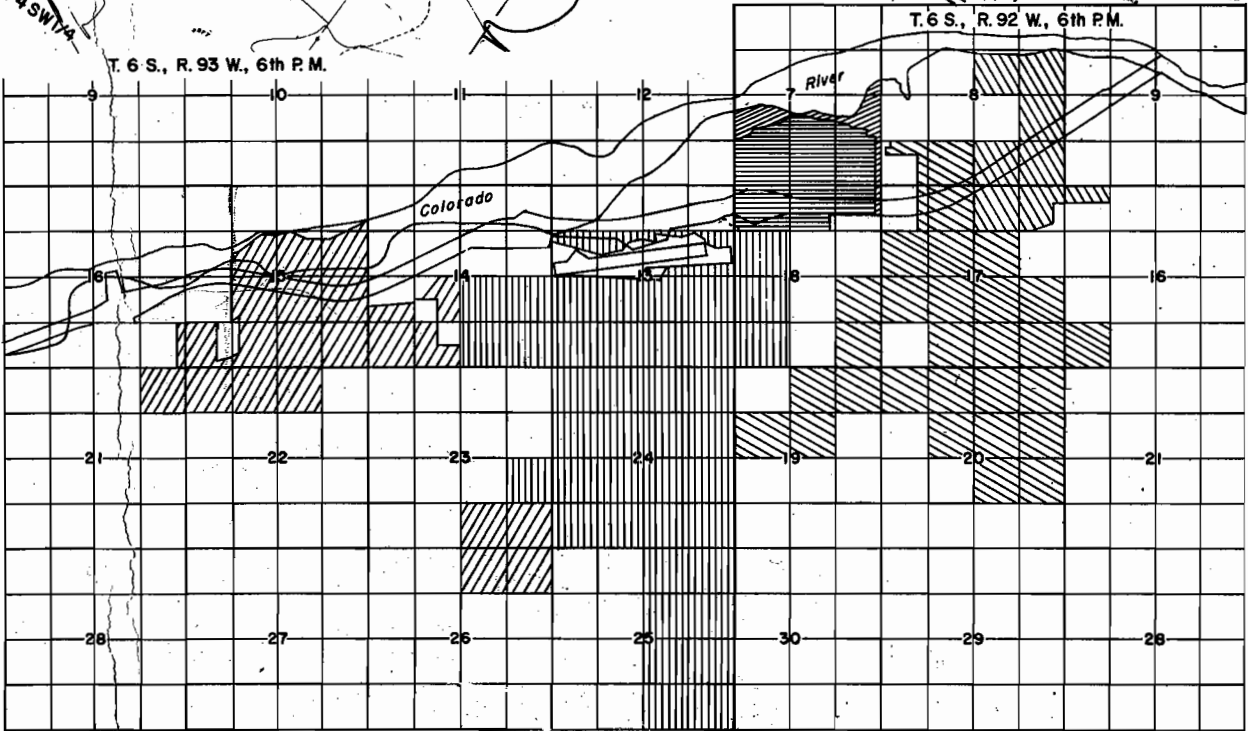

- Jake Billingsley
- Rifle Land Associates, Ltd.
- Valley Farms, Inc.
- Kenneth Balcomb & W. Parkinson
- J. Cooke Wilson, Jr.
- Shideler et al