

STATE DEPARTMENT OF HIGHWAYS

DIVISION OF HIGHWAYS—STATE OF COLORADO

CONVENTIONAL SIGNS

County Line
Township or Range Line
Land Lines
Property or Tract Line
City Limits
Railroad
Existing Road
New Road

Control of Access
Access denied by Dead
Right of Way Line
Protected by Freeway (Virgin Location)
Top of Cuts
Toe of Fills
Barbed Wire Fence
Chain Link Fence
Woven Wire-Combination Fence
Snow Fence
Wood Fence
Deer Fence

Trees
Deciduous
Coniferous

Tel. & Teleg. Lines
Electric Lines
Elec. Trans. Tower
Buried Tel. Cable
Buried Electric Cable
Gas Main
Oil Main
Water Main
Sanitary Sewers
Storm Sewers

Road Approaches
Section Corner
Center of Section


Culverts & Drains
Proposed
Existing
Proposed
Existing (To be dashed)

Bridges
Existing (To be dashed)

PLAN AND PROFILE OF PROPOSED FEDERAL AID PROJECT NO. 170-1(45) Sec.6 STATE HIGHWAY NO. 70 MESA COUNTY RIGHT OF WAY

SCALES OF ORIGINAL DRAWINGS
ON PLAN, 1 IN. = 100 FT.

LENGTH OF R.O.W. PROJECT = 33,033.9' (6.256 MI.)

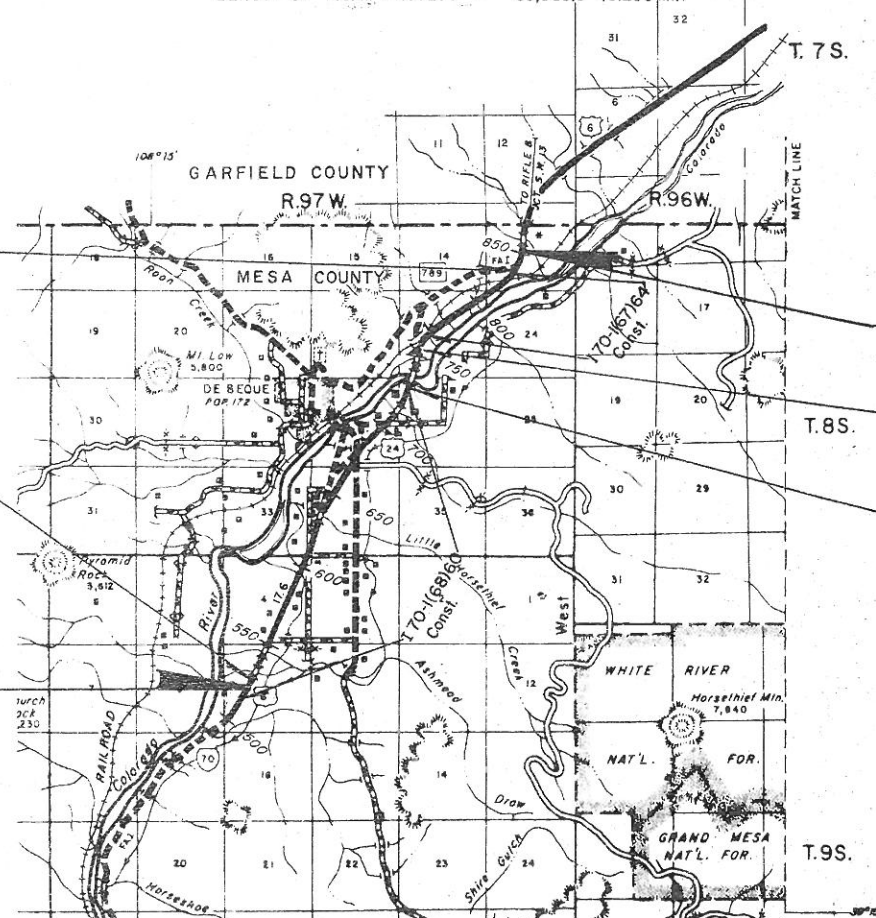

STA. 842+00 END CONST. PROJ. 170-1(54)60=
842+00 END CONST. PROJ. 170-1(67)64

STA. 532+00 BEGIN CONST. PROJ. 170-1(54)60=
532+00 BEGIN CONST. PROJ. 170-1(68)60

BEGIN R.O.W. PROJ. 170-1(45)SEC.6 P.O.S.T. 518+86.3=
118.9' LT. STA. 206+24.2 on R.O.W. PROJ. F.A.P. 297C

END R.O.W. PROJ. 170-1(45)SEC.6 STA. 849+20.2 (Proj. Line)

END CONST. I 70-1(64)63 STA. 752+20

BEGIN CONST. I 70-1(64)63 STA. 735+00

FEDERAL ROAD REGION NO.	DIVISION	PROJECT NO	SHEET NO
VIII	COLORADO	170-1(45) Sec. 6	1

REVISIONS		
5-22-80	Add Const. Proj. No.	KMS
12-77-81	Add Const. Proj. No.	DA 7
3-9-12	sht. 1, 2B, & 8 add sht. 8A	JWJ

RIGHT OF WAY
DeBeque Canyon to
West of Rifle

INDEX OF SHEETS

SHEET NO.
1 TITLE SHEET
2-2K TABULATION OF OWNERSHIP
3-15 ALIGNMENT SHEETS
16-19 TOTAL OWNERSHIP

DIST III

E.M.T. 3/79

SCALE OF MILES
0 1/2 1 2 3 4

DIVISION OF HIGHWAYS	
APPROVED:	DATE
<i>R. C. [Signature]</i>	5-11-79
CHIEF ENGINEER	

DEPARTMENT OF TRANSPORTATION FEDERAL HIGHWAY ADMINISTRATION	
APPROVED:	DATE
DIVISION ADMINISTRATOR	

FEDERAL ROAD REGION NO.	DIVISION	PROJ. NO.	SHEET NO.	TOTAL SHEETS
VIII	COLORADO	I70-164163	6	
AS CONSTRUCTED				
NO REVISIONS		REVISED	11-26-80	VOID

SEEDING PLAN

SEEDING, SOIL PREPARATION, FERTILIZING WITH COMMERCIAL FERTILIZER, AND MULCHING
were ~~will be~~ REQUIRED FOR APPROXIMATELY ~~22~~ ACRES FOR ROADWAY WITHIN RIGHT OF WAY LIMITS
ON ALL DISTURBED AREAS NOT SURFACED AND ~~2~~ ACRES FOR PIT(S) ON ALL DISTURBED AREAS.
3.035

* 5.023

THE FOLLOWING TYPES AND RATES ~~shall be~~ ^{were} USED FOR ROADWAY SIDESLOPES AND ADJACENT RIGHT OF WAY.

COMMON NAME	BOTANICAL NAME	PERCENT PURITY	PERCENT GERMINATION	RATE PLS/ACRE
ALKALI SACATON	SPOROBOLUS AIROIDES	95	80	0.8 OZ.
FAIRWAY WHEATGRASS	AGROPYRON CRISTATUM	80	75	1.0
INDIAN	ORYZOPSIS HYMENOIDES	90	70	1.0
"VINALL" RUSSIAN WILD RYE	ELYMUS JUNCEUS "VINALL"	90	80	1.0
"P-27" SIBERIAN WHEATGRASS	AGROPYRON SIBIRICUM "P-27"	90	90	1.0
WESTERN WHEATGRASS	AGROPYRON SMITHII	80	80	3.0
"MADRID" YELLOW SWEETCLOVER	MELITOTUS OFFICINALIS	95	85	1.0
GOOSEBERRY LEAF GLOBE MALLOW	SPHAERALCEA GROSSULARI AEFOLIA	50	*	0.2 OZ.
RUBBER RABBIT BRUSH	CHRYSOTHAMNUS NAUSEOSUS	50	*	1.0
SHAOSCALE SALTBUSH	ATRIPLEX CONFERTIFOLTA	50	*	1.0

TOTAL PLS/ACRE SEEDING (NATIVE) 10 LBS. 10 OZ.

MULCHING MATERIAL

STRAW 2 TONS PER ACRE

FERTILIZING REQUIREMENT:

COMMERCIAL FERTILIZER	LBS/ACRE	LBS/ACRE ACTUAL N	LBS/ACRE ACTUAL P	LBS/ACRE ACTUAL K
DIAMMONIUM PHOSPHATE (18-46-0)	250	45	115	0
TOTAL	250	45	115	0

PROJECT SUBTOTAL (Roadway)

Seeding (Native)	127 Lbs.	Final Subtotal 53.37 lbs.
Mulching	24 Tons	10.05 Tons
Fertilizer	3000 Lbs.	1255.75 lbs
Soil Preparation (Native)	12 Acres	5.023 Acres
Water (Landscaping)	300 M.Gal.	

THE FOLLOWING TYPES AND RATES ~~shall be~~ ^{were} USED FOR CHANNEL CHANGE, PIT AND OTHER DISTURBED AREAS OUTSIDE OF ROADWAY LIMITS.

COMMON NAME	BOTANICAL NAME	PERCENT PURITY	PERCENT GERMINATION	RATE PLS/ACRE
SMOOTH BROME	BROMUS INERMIS	85	80	4.0
WESTERN WHEATGRASS	AGROPYRON SMITHII	80	80	5.0
BASIN WILD RYE	ELYMUS CINEREUS	75	80	2.0
ALKALI SACATON	SPOROBOLUS AIROIDES	95	80	0.4 OZ.
INTERMEDIATE WHEATGRASS	AGROPYRON INTERMEDIUM	90	85	3.0
REDTOP	AGROSTIS ALBA	90	85	0.1 OZ.
SKUNKBRUSH SUMAC	RHUS TRILOBATA	50	*	1.0
RUBBER RABBIT BRUSH	CHRYSOTHAMNUS NAUSEOSUS	50	*	1.0

TOTAL PLS/ACRE SEEDING (NATIVE) 16 LBS. 5 OZ.

MULCHING MATERIAL

STRAW 2 TONS PER ACRE

FERTILIZING REQUIREMENT:

COMMERCIAL FERTILIZER	LBS/ACRE	LBS/ACRE ACTUAL N	LBS/ACRE ACTUAL P	LBS/ACRE ACTUAL K
DIAMMONIUM PHOSPHATE (18-46-0)	250	45	115	0
TOTAL	250	45	115	0

* List State, County, and Elevation where seed is collected

PROJECT SUBTOTAL (Pit & Channel Change)

Seeding (Native)	147 Lbs.	Final Subtotal 49.51 lbs.
Mulching	18 Tons	2.71 Tons
Fertilizer	2250 Lbs.	758.75 lbs
Soil Preparation (Native)	4 Acres	3.035 Acres
Water (Landscaping)	225 M.Gal.	

Final Tabulation of ROW Markers

735+00	270' RT
741+20	270' RT
742+00	160' RT
749+00	160' RT
749+41.3	236.2' RT

Common Name state County Elevation

- * SKUNKBRUSH montana custer 4600
- * SUMAC
- * RUBBER RABBIT BRUSH Colo. Delta 4980
- * BRUSH
- * SHAOSCALE SALTBUSH utah
- * GOOSEBERRY LEAF GLOBE MALLOW Colo. globe mallow

PROJECT TOTALS

Seeding (Native)	274 Lbs.	Final Project Totals 103 lbs
Mulching	42 Tons	12.76 Tons
Fertilizer	5250 Lbs.	2015 lbs.
Soil Preparation (Native)	21 Acres	8.1 ACRES
Water (Landscaping)	525 M.Gal.	

FEDERAL ROAD REGION NO.	DIVISION	PROJ. NO.	SHEET NO.	TOTAL SHEETS
VIII	COLORADO	170-1(67)64	8	76
AS CONSTRUCTED				
NO REVISIONS ☐ REVISED 6-2-81 VOID ☐				

FINAL CONSTRUCTION TRAFFIC CONTROL DEVICES

SIGN CODE	LEGEND	DIMENSIONS	PANEL SIZE - QUANTITY			
			A	B	C	OTHER
M-20-1	ROAD/CONSTRUCTION/ AHEAD	48" x 48"		2		
G-20-2	END/CONSTRUCTION	48" x 48"	2			
XW 20-7A	FLAGMAN SYMBOL	48" x 48"		2		
	TRUCKS/TURNING/ ON HIGHWAY	48" x 48"		2		
	BE/PREPARED/ TO/STOP	36" x 36"	2			
	TRAFFIC CONES					20
TOTALS			4	6		
FINAL TOTAL			3	4		0


FINAL TABULATION OF ROW. MARKERS

775+15.6	86.4'	LT.
776+03.3	85.3'	LT.
776+74.5	93.0'	LT.
779+73.0	150.0'	LT.
TS. 790+28.95	150.0'	LT.
POST 791+11.5	159.3'	RT.
SC. 794+28.95	150.0'	LT. & RT.
CS. 798+28.95	150.0'	LT. & RT.
ST. 802+28.95	150.0'	LT. & RT.
806+39.75	150.0'	RT.
807+65.95	150.0'	LT.
TS. 811+20.37	150.0'	LT. & RT.
SC. 817+20.37	200.0'	RT.
SC. 817+20.37	162.4'	LT.
POST 820+41.1	101.5'	RT.
POST 822+73.2	42.9'	RT.
POST 823+02.5	431.5'	LT.
POST 825+75.9	554.8'	LT.
POST 828+47.1	256.5'	LT.
POST 422.6' A.H. PI. 829+	44.3'	LT.
ST. 843+49.37	226.5'	LT.
POST. 1387.2' A.H. PI. 829+	542.5'	RT.
620+00 P.E. BL.	74.3'	RT.
626+00 P.E. BL.	175.0'	RT.
629+12.8 P.E. BL.	175.0'	RT.


FINAL FENCING

STATION	SIDE	REMOVAL OF FENCE		FENCE BARBED WIRE WITH METAL POSTS		CORNER AND LINE BRACE POSTS		END POSTS			
		LIN. FT.	FINAL	LIN. FT.	FINAL	EACH	FINAL	EACH	FINAL		
752+ to 763+	LT.	1,000									
828+ to 830+	Both	500									
778+ to 786+	LT.			800		1		2			
780+	LT. & RT.	800									
786+ to 793+	LT.			800		2		2			
794+ to 826+	LT.			3,030		5		2			
827+ to 835+	LT.	1,400		2,250		3		2			
843+ to 849+	LT.	500		565				2			
786+ to 793+	RT.			800		4		2			
791+	RT.			750		1		2			
794+ to 827+	RT.			3,130		6		2			
828+ to 837+	RT.			775		4		2			
835+ to 849+	RT.			1,250		2		2			
TOTALS		4,200	4,273	14,150	10,947	28	31	20	15		

DETAIL OF WINGWALLS

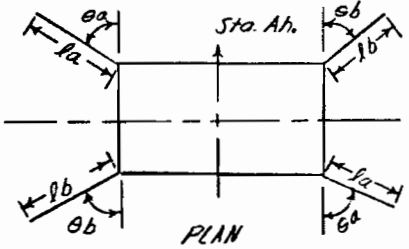

STATION	la	theta_a	lb	theta_b	K	m
*785+80	24'	80°	32'	45°	4.0'	11.33'
*793+00	26'	60°	26'	60°	4.0'	11.33'

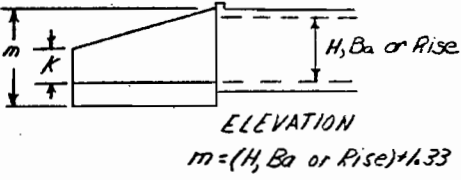

*All headwalls perpendicular to structure
See Standard M-601-WW for further details

AS CONSTRUCTED

NO REVISIONS

REVISED 3/23/81

VOID

(R-1) 1-16-80, Note & M Standards, WCB

GENERAL NOTES

Right - of - Way Markers

FOR PRELIMINARY PLAN QUANTITIES OF BITUMINOUS MATERIALS, THE FOLLOWING RATES OF APPLICATION WERE USED:

PRIME COAT	0.3 GALS./SQ.YD.
TACK COAT DILUTED EMUL. ASPH.	0.1 GALS. SQ.YD. (DILUTED)
BITUMINOUS PAVEMENT (GRADING E)	104 LBS. PER SQ.YD./INCH

DILUTED EMULSIFIED ASPHALT FOR TACK COAT SHALL CONSIST OF 1 PART EMULSIFIED ASPHALT AND 1 PART WATER.

RATES OF APPLICATION SHALL BE AS DETERMINED BY THE ENGINEER AT THE TIME OF APPLICATION.

WATER SHALL BE USED AS A DUST PALLIATIVE WHERE REQUIRED. LOCATIONS SHALL BE AS ORDERED.

THE FOLLOWING SHALL BE FURNISHED WITH EACH BITUMINOUS PAYER:

1. A SKI TYPE DEVICE AT LEAST 30 FEET IN LENGTH.
2. SHORT SKI OR SHOE.

ANY LAYER OF BITUMINOUS PAVEMENT THAT IS TO HAVE A SUCCEEDING LAYER PLACED THEREON SHALL BE COMPLETED FULL WIDTH BEFORE SUCCEEDING LAYER IS PLACED.

FLEXIBLE CONDUITS ON THIS PROJECT WITH HELICAL CORRUGATIONS, JOINED BY DIMPLED CONNECTING BANDS, SHALL USE A SEALING COMPOUND OR GASKET WITH THE CONNECTING BAND.

ROAD APPROACHES WHICH REQUIRE BITUMINOUS PAVEMENT SHALL BE PRIMED AND A 2" THICKNESS OF PAVEMENT PLACED AS FOLLOWS:

PUBLIC APPROACHES AND ENTRANCES TO BUILDINGS OR RESIDENCES SHALL BE PAVED 50 FEET OUT FROM EDGE OF SHOULDER OR TO THE RIGHT OF WAY LINE, WHICHEVER IS LESS. FIELD ENTRANCES SHALL BE PAVED 4 FEET OUT FROM EDGE OF SHOULDER.

DEPTH OF MOISTURE-DENSITY CONTROL FOR THIS PROJECT SHALL BE AS FOLLOWS:

FULL DEPTH OF ALL EMBANKMENTS
BASES OF CUTS AND FILLS 0.5 FOOT.
FULL DEPTH OF EMBANKMENT SECTIONS USED FOR DITCHES AND CHANNEL CHANGES

EXCAVATION REQUIRED FOR COMPACTION OF BASES OF CUTS AND FILLS ~~WERE~~ ^{WERE} CONSIDERED AS SUBSIDIARY TO THAT OPERATION AND ~~WERE~~ ^{WERE} NOT ~~BE~~ PAID FOR SEPARATELY.

~~IT IS ESTIMATED THAT 4446~~ ⁴⁴⁴⁶ HOURS OF FLAGGING FOR CONTROLLING TRAFFIC ~~WERE~~ ^{WERE} REQUIRED FOR THIS PROJECT.
THE MINIMUM THICKNESS OF TOPSOIL ~~WAS~~ ^{WAS} 6 INCHES. ~~IT IS ESTIMATED THAT 72,787~~ ^{72,787} CU. YDS. ~~WERE~~ ^{WERE} REQUIRED AND ~~WERE~~ ^{WERE} OBTAINED FROM ROADWAY EXCAVATION.
~~IT IS ESTIMATED THAT 90,000 CU. YDS. OF TOPSOIL~~ ^{WAS} ~~WERE~~ ^{WAS} STOCKPILED. 19,000 CU. YDS. SHALL BE LEFT IN STOCKPILE FOR FUTURE SURFACING PROJECT.

THE FOLLOWING TYPES OF EQUIPMENT SHALL BE USED FOR "BLADING" AND "DOZING" ON THIS PROJECT:

BLADING - A MOTOR GRADER IN THE 200 TO 250 FLY WHEEL HORSEPOWER RANGE.
DOZING - A CRAWLER-TYPE TRACTOR IN THE 270 TO 400 FLYWHEEL HORSEPOWER RANGE. TRACTOR SHALL HAVE DOZER BLADE AND RIPPER ATTACHMENTS.

THE FORCE ACCOUNT ITEM, "CLEARING OF BUILDING SITES, ETC.," SHALL INCLUDE REMOVAL OF ALL FOUNDATIONS, WELLS, BUILDINGS AND OTHER APPURTENANCES NOT REMOVED BY THE OWNER, AND ANY NECESSARY BACKFILLING OF CELLARS, CESSPOOLS, WELL, ETC., TO PROVIDE NEAT ROADSIDE CONDITIONS. IT IS ESTIMATED THAT THIS ITEM APPLIES AT THE FOLLOWING LOCATIONS:

STA. 557+
STA. 568+
STA. 680+

SEEDING, SOIL PREPARATION, FERTILIZING WITH COMMERCIAL FERTILIZER, AND MULCHING WILL BE REQUIRED FOR APPROXIMATELY 88 ACRES FOR ROADWAY WITHIN RIGHT OF WAY LIMITS ON ALL DISTURBED AREAS NOT SURFACED.

THE FOLLOWING TYPES AND RATES SHALL BE USED:

COMMON NAME	BOTANICAL NAME	PURITY	GERMINA- TION	PURE LIVE SEED LBS/AC	OZ/AC
ALKALI SACATON	SPOROBOLUS AIROIDES	95	80	-	8
FAIRWAY WHEATGRASS	AGROPYRON CRISTATUM	80	75	1	-
INDIAN RICEGRASS	ORZOPSIS HYMNIOIDES	90	70	1	-
"VINALL" RUSSIAN WILDRYE	ELYMUS JUNCCEUS "VINALL"	90	80	1	-
"P-27" SIBERIAN WHEATGRASS	AGROPYRON SIBIRICUM "P-27"	90	90	1	-
"ARRIBA" WESTERN WHEATGRASS	AGROPYRON SMITHII "ARRIBA"	80	80	3	-
"MADRID" YELLOW SWEET CLOVER	MELITOTUS OFFICINALIS "MADRID"	95	85	1	-
GOOSEBERRY LEAF GLOBEMALLOW	SPHAERALCEA GROSSULARIAEFOLIA	50	SOURCE IDENTIFIED	-	2
RUBBER RABBITBRUSH	CHRYSOTHAMNUS NAUSEOSUS	50	SOURCE IDENTIFIED	1	-
SHADSCALE SALTBRUSH	ATRIPLEX CONFERTIFOLIA	50	SOURCE IDENTIFIED	1	-
TOTAL PLS/ACRE SEEDING (NATIVE)				10 LBS. 10 OZ.	

* SOURCE IDENTIFIED SEED SHALL HAVE THE ELEVATION, COUNTY, AND STATE OF COLLECTION NOTED AND SHALL BE APPROVED BY THE ENGINEER PRIOR TO USE.

MULCHING MATERIAL

NATIVE HAY OR STRAW	2 TONS PER ACRE
	2 TONS PER ACRE

COMMERCIAL FERTILIZER	PERCENT AVAILABLE	LBS/ACRE AVAILABLE	RATE LBS/ACRE
AVAILABLE SUPERPHOSPHATE (D-45-0)	45		100
TOTAL LBS/ACRE FERTILIZER			100

PROJECT TOTALS		FINAL TOTALS	
SEEDING (NATIVE)	935 LBS.	939.68 LBS.	
MULCHING	176 TONS	175.5 TONS	
FERTILIZER	8,800 LBS.	8844 LBS.	
SOIL PREPARATION	88 ACRES	88.44 ACRES	
WATER	2,200 M GAL.	DELETED	

ADDITIONAL FERTILIZING AND LANDSCAPING WILL BE DONE ON FUTURE PROJECT

(R-1) A CLASS 2 FIELD LABORATORY AS DETAILED ON STANDARD M-620-A IS REQUIRED ON THIS PROJECT.

Right - of - Way Markers

P.O.T. 525+00.0 220' Lt.
P.O.T. 540+00.0 150' Lt.
P.O.T. 548+00.0 200' Lt.
P.O.T. 554+94.0 175' Lt.
P.O.T. 578+00.0 175' Lt.
P.O.T. 591+00.0 175' Lt.
P.O.T. 600+00.0 200' Lt.
P.O.T. 608+00.0 200' Lt.
P.O.T. 625+48.6 140.8' Rt.
P.O.T. 630+00.0 200' Rt.
T.S. 645+39.19 200' Rt.
P.O.L. 1464+69.8384
1464+86.1244 90' Rt. So. Frontage Road
P.O.T. 3248+50.0 90' Lt. Cross Road
P.O.T. 3249+80.0 80' Rt. Cross Road

"M" STANDARDS		
M-100-A	STANDARD SYMBOLS	5-11-73
M-203-B	APPROACH ROADS, FLARING, CUT SLOPE TREATMENT, BRIDGE AND CREST WIDENING	12-11-72
M-203-C	DITCH TYPES	7-23-68
M-203-SC	SUPERELEVATION OF CURVES - CROWNED HIGHWAYS	1-6-77
M-203-SD	SUPERELEVATION OF CURVES - DIVIDED HIGHWAYS	1-6-77
M-206-AB	EXCAVATION AND BACKFILL FOR STRUCTURES (3 SHEETS)	4-30-79
M-601-BC2	DOUBLE CONCRETE BOX CULVERT	9-14-79
M-601-BC3	TRIPLE CONCRETE BOX CULVERT	9-14-79
M-601-CH	HEADWALL FOR PIPE CULVERT	5-6-76
M-601-WW	WINGWALLS FOR PIPE OR BOX CULVERTS	9-14-79
M-603-CA	CONCRETE AND METAL END SECTIONS	8-29-77
M-603-MA	METAL CULVERT PIPE - H-20 LOADING	11-3-78
M-603-RC	REINFORCED CONCRETE PIPE	7-13-76
M-604-BA	INLET, TYPE C	9-18-78
(R-1) M-604-OA	STEPS FOR MANHOLES AND INLETS	9-20-76
M-604-E	MANHOLES	3-19-74 ADDED
M-606-AC	GUARD RAIL, TYPE 3, W-3EAM (8 SHEETS)	9-14-79
M-607-A	WIRE FENCE AND GATES (2 SHEETS)	9-14-79
M-612-A	MARKER POST AND BENCH MARKS	6-30-71
(R-1) M-620-A	FIELD LABORATORY - CLASS 2	9-26-79, ADDED
M-707-CB	TYPICAL ALTERNATE COUPLING BANDS FOR CORRUGATED CULVERT PIPE	11-3-78

"S" STANDARDS		
S-612-1A	TYPICAL DELINEATOR INSTALLATIONS (4 SHEETS)	10-28-77
S-614-39A	TRAFFIC SIGNING FOR HIGHWAY CONSTRUCTION (4 SHEETS)	5-8-78
S-614-52B	BARRICADES, DRUMS, CONCRETE BARRIER (TEMP) AND VERTICAL PANELS	1-10-79

Design

FEDERAL ROAD REGION NO.	DIVISION	PROJECT NO.	SHEET NO.
VIII	COLORADO	I 70-1(45) Sec. 6	2

RIGHT OF WAY DEBEQUE CANYON TO
WEST OF RIFLE

R. O. W. TABULATION OF PROPERTIES IN

MESA

COUNTY

S. H. NO. 70

PARCEL NO.	OWNER	ADDRESS	LOCATION	AREA IN ACRES				PARCEL NO.	REMARKS	REVISIONS		
				PARCEL	TO BE ACQUIRED	REMAINDER				7/9/79	Name Change 604	BG
						LEFT	RIGHT					
			T.8&9S., R.97W., 6th P.M.									
600	DOUGLAS E. DEAN & PATRICIA A. DEAN		E½ W½, SEC. 9, T.9S.	3.171	3.171	-	285.6	600				
601	KENNETH L. ETTER & JIMMIE L. ETTER, J.T.		SE¼NW¼ & NE¼SW¼, SEC.9, T.9S.	12.380	12.380	73.5	-	601				
602	ALBERT W. HAMMER, DECEASED AMANDA E. HAMMER, DECEASED & GWENDOLYN HAMMER		NE¼NW¼, NW¼NE¼ SEC. 9, T.9S.	8.777	8.777	34.0	33.8	602				
603	SOHIO PETROLEUM CO., a Delaware Corp. 60% THE CLEVELAND-CLIFFS IRON CO., an Ohio Corp. 40%		W½SE¼ SEC. 4, T.9S.	8.467	8.467	53.6	44.4	603				
604	LUTHER COLBY FRALIX & MARJORIE C. FRALIX, J.T.		NW¼SE¼ SEC.4, T.9S.	2.987	2.987	24.2	1.8	604				
605	MARVIN A. TILLMAN		NW¼SE¼ SEC.4, T.9S.	3.703	3.703	15.7	0.1	605				
606	SOHIO PETROLEUM CO., a Delaware Corp. 60% THE CLEVELAND-CLIFFS IRON CO., an Ohio Corp. 40%		NE¼SE¼, S½NE¼, Lot 1, SEC.4, T.9S. & SE¼SE¼ SEC. 33, T.8S.	20.515	20.330	245.1	53.9	606				
607	ROY H. INSKEEP, DECEASED		SE¼SE¼ SEC. 33, T.8S.	1.882	1.244	14.8	-	607	OTHER AREAS: SEC.3 - 40 ACRES SEC. 33 - 18.0 ACRES			
608	CLYDE F. SHELDON		SW¼SW¼ SEC.34, T.8S.	2.486	2.057	-	-	608				
609	ROBERT L. LATHAM & JOHN H. LATHAM JOHN HARVEY LATHAM		NW¼SW¼ SEC. 34 T.8S.	6.446	6.436	183.4	61.6	609				

FEDERAL ROAD REGION NO.	DIVISION	PROJECT NO.	SHEET NO.
XIII	COLORADO	I 70-1(45) Sec. 6	2-A

RIGHT OF WAY DEBEQUE CANYON TO
WEST OF RIFLE

R. O. W. TABULATION OF PROPERTIES IN

MESA

COUNTY

S. H. NO. 70

PARCEL NO.	OWNER	ADDRESS	LOCATION	AREA IN ACRES				PARCEL NO.	REMARKS	REVISIONS		
				PARCEL	TO BE ACQUIRED	REMAINDER				8/21/79	ADD PAR. 615AR	MR
						LEFT	RIGHT					
			T.8S.,R.97W.,6th P.M.							10/10/79	NAME CHNG-610-612	KMS
610	ROBERT L. LATHAM & JOHN H. LATHAM aka JOHN HARVEY LATHAM		NW¼SW¼ & NW¼ SEC. 34	10.875	10.875	See 609		610				
611	CARTER W. ELLIOTT, JR.	685 Crestridge Dr. Grand Junction, Colorado	SW¼NW¼, SEC. 34	1.989	1.989	4.7	-	611				
612	ROBERT L. LATHAM & JOHN H. LATHAM aka JOHN HARVEY LATHAM		SW¼NW¼ SEC. 34	1.104	1.097	See 609		612				
613	BETTY M. SISSON ½ MARGIE E. MORIN ½ THE SOCIETY FOR THE PRO- PAGATION OF THE FAITH FOR SHIRLEY M. ELLIOTT ½ CARTER W. ELLIOTT, JR. ½		NE¼NW¼ SEC. 34	24.003	23.317	0.6	11.2	613				
613A	BETTY M. SISSON ½ MARGIE E. MORIN ½ THE SOCIETY FOR THE PRO- PAGATION OF THE FAITH FOR SHIRLEY M. ELLIOTT ½ CARTER W. ELLIOTT, JR. ½		NE¼NW¼ SEC. 34	0.019	0.019	See 613		613A				
614 Rev.	J. D. SEVERSON ½ BERT ST. JOHN (DECEASED) & EDNA MAE ST. JOHN ½	699 Crestridge Grand Junction, Colorado	S½SE¼SW¼ SEC. 27	7.963	7.405	See 615-AR	-	614 Rev.				
615 Rev.	J. D. SEVERSON ½ BERT ST. JOHN (DECEASED) & EDNA MAE ST. JOHN ½	699 Crestridge Grand Junction, Colorado	S½SE¼SW¼ SEC. 27	3.679	3.679	See 614	Rev.	615 Rev.				
615 AR	J. D. SEVERSON ½ BERT ST. JOHN (DECEASED) & EDNA MAE ST. JOHN ½	699 Crestridge Grand Junction, Colorado	S½SE¼SW¼, SEC. 27	3.677	3.677	-	-	615 AR				



COLORADO DEPARTMENT OF TRANSPORTATION

Region 3
222 South Sixth Street, Room 318
Grand Junction CO, 81501
Phone: (970) 683-6230 Fax: (970) 683-6249

RIGHT OF WAY : LED

Sheet Revisions			Sheet Revisions			Sheet Revisions		
7/9/79	name change par. 616 Rev.	BG	MM/YR		XXX	MM / YR		XXX
10/12/79	name chg-620-623	KMS						
12/4/80	rev. par. 616 Rev	RM						
3/9/12	add par. 616Rev2X	JWJ						

RIGHT OF WAY PLANS				
TABULATION OF PROPERTIES				
PROJECT NUMBER: I 70-1(45) Sec. 6				
PROJECT LOCATION: DeBeque Canyon to West of Rifle				
PROJECT LOCATION:				
Project Code	Last Mod. Date	Subset Sheets	Sheet No.	Total No. of Sheets
75039	3/9/2012	2 to 2K	2-B	19

R.O.W. TABULATION OF PROPERTIES IN

MESA

COUNTY

S.H. NO. 70

PARCEL NO.	OWNER	ADDRESS	LOCATION	AREA IN ACRES					REMARKS
				AREA OF PARCEL	EXISTING ROW	NET AREA	REMAINDER		
							LEFT	RIGHT	
			T.8S., R.97W., 6th P.M.						
615A	J. D. SEVERSON 1/2	699 Crestridge	S1/2SE1/4SW1/4, Sec. 27	0.292		0.292	SEE PAR	614 Rev	
	BERT ST. JOHN (DECEASED)	Grand Jct., CO.							
	& EDNA MAE ST. JOHN 1/2								
616 Rev2	CHARLES D. REICKS, 1/6		SPECK SUDIVISION	3.176		3.176	6.7		
	JOE R. MARSH 1/6		SE1/4SW1/4, SEC. 27						
	NATALIE B. STETTNER, 1/6								
	TOM WILKINSON, 1/6								
	MARSH E. ANDERSON, 1/6								
	LEONARD S. SMITH 1/6								
616Rev2X	DEPT. OF TRANSPORTATION		SE1/4SW1/4, SEC. 27	0.041		0.041			conveyed to Kum & Go LLC., an Iowa Limited Liability Co.
	STATE OF COLORADO			1,791 SQ FT		1,791 SQ FT			rec. #2586815 (Mesa County Clerk and Recorder)
617 rev	ELMER RICE aka		LOT 3, BLOCK 3,	0.269		0.134			
	ELMER L. RICE &		SPECK SUBDIVISION						
	RUTH E. RICE., J.T.		SE1/4SW1/4, SEC. 27						
618	MARION E. NOVINGER (DECEASED)		SW1/4NW1/4 NE1/4, SEC. 27	0.295		0.125		29.5	
	FRANCES E. NOVINGER								
619	JAMES T. MODRELL &		S1/2NW1/4NW1/4NE1/4, SEC. 34	0.773		0.594		4.3	
	NETTIE F. MODRELL, J.T.								
620	MAXINE A. PITTMAN aka		N1/2 NW1/4NW1/4NE1/4,	2.383		2.176		2.4	
	MAXINE PITTMAN ALLEN		SEC. 34						
621Rev	BETTY SISSON 1/4		SW1/4SE1/4, SEC. 27	14.149		13.708		22.3	
	MARGIE E. MORIN 1/4								
	SHIRLEY M. ELLIOTT 1/4								
	CARTER W. ELLIOTT, JR. 1/4								
622 Rev	CARTER W. ELLIOTT, JR	685 Crestridge Dr.	NW1/4SE1/4, SEC. 27	4.762		4.762	43.1	0.6	
		Grand Junction, CO.							
623 Rev	ROBERT L. LATHAM &		S1/2NE1/4SE1/4, SEC. 27	2.528		2.528		18	
	JOHN H. LATHAM aka								
	JOHN HARVEY LATHAM								
624	CARTER W. ELLIOTT, JR	685 Crestridge Dr.	N1/2 NE1/4SE1/4, S1/2 NE1/4,	30.373		29.751	24.5	130.1	
		Grand Junction, CO.	SEC. 27, NW1/4, SEC. 26						

RIGHT OF WAY DEBEQUE CANYON TO
WEST OF RIFLE

PARCEL NO.	OWNER	ADDRESS	LOCATION	AREA IN ACRES				PARCEL NO.	REMARKS	REVISIONS		
				PARCEL	TO BE ACQUIRED	REMAINDER				7/9/79	Rev. E609 Rev.	
						LEFT	RIGHT					
			T.8S.,R.97W.,6th P.M.									
ER-600	THE DENVER & RIO GRANDE		SE½SW½, SEC. 13	2.426	2.426	-	-	ER-600		10/12/79	NAME CHNG-E-609	
REV.	WESTERN R.R., a Delaware									2/14/80	Rev. 2, E-610 Rev.	KMS
	Corp.							REV.		5/22/80	Add PE-615AR	RBM
											Add PE-629B	KMS
	PERMANENT EASEMENTS											
E-600	DOUGLAS E. DEAN &		SE½NW½, SEC.9,T.9S.	0.149	0.149	-	-	E-600	CONSTRUCTION OF WING WALL			
	PATRICIA A. DEAN											
E-602	ALBERT W. HAMMER (DECEASED)		NW½NE½, SEC.9,T.9S.	0.121	0.121	-	-	E-602	CONSTRUCTION OF WING WALL			
	AYANDA E. HAMMER (DECEASED)											
	GWENDOLYN HAMMER											
E-609	ROBERT L. LATHAM &		NW½SW½, SEC. 34,	0.459	0.459	-	-	E-609	CHANNEL IMPROVEMENT			
REV. 2	JOHN H. LATHAM aka							REV. 2				
	JOHN HARVEY LATHAM											
E-610	ROBERT L. LATHAM &		NW½SW½, SEC. 34	0.230	0.230	-	-	E-610	CHANNEL IMPROVEMENT			
REV.	JOHN H. LATHAM aka							REV.				
	JOHN HARVEY LATHAM											
E-636	DELETED											
REV.												
PE-615	COLORADO DEPARTMENT OF		SE½ SW½ SEC. 27	0.476	--			PE-615	GRANTED TO P.S. CO. FOR TRANSMISSION LINES			
AR	HIGHWAYS							AR				
PE-629B	JERRY HAFNER		SW½ SW½, SEC. 13	0.75	0.75			PE-629B	UTILITY EASEMENT			

S. H. NO. 70

RIGHT OF WAY DEBEQUE CANYON TO
WEST OF RIFLE

[illegible]

R. O. W. TABULATION OF PROPERTIES IN

MESA

COUNTY

S. H. NO. 70

FEDERAL ROAD REGION NO.	DIVISION	PROJECT NO.	SHEET NO.
XIII	COLORADO	I 70-1(45) Sec. 6	2-F

RIGHT OF WAY DEBEQUE CANYON TO
WEST OF RIFLE

WEST OF RIFLE											
PARCEL NO.	OWNER	ADDRESS	LOCATION	AREA IN ACRES				PARCEL NO.	REMARKS	REVISIONS	
				PARCEL	TO BE ACQUIRED	REMAINDER				7/9/79	
						LEFT	RIGHT				
			T.9S.,R.97W.,6th P.M.								REV. TE-603A,B
											ADD TE-603E REV.
											DEL. TE-604,A.
											REV. TE-604B,C
TE-603	SOHIO PETROLEUM CO.		SW¼SE¼, SEC. 4	1.088	1.088	-	-	TE-603	CONSTRUCTION		
A REV.	a Delaware Corp. 60%							A REV.	IRRIGATION		
	THE CLEVELAND-CLIFFS IRON								DITCH		
	CO., an Ohio Corp. 40%										
TE-603	SOHIO PETROLEUM CO.		SW¼SE¼, SEC. 4	0.092	0.092	-	-	TE-603	CONSTRUCTION OF IRRIGATION DITCH		
B REV.	a Delaware Corp. 60%							B REV.			
	THE CLEVELAND-CLIFFS IRON										
	CO., an Ohio Corp. 40%										
TE-603	SOHIO PETROLEUM CO.		SW¼SE¼, SEC. 4	0.092	0.092	-	-	TE-603	CONSTRUCTION OF PIPE		
C	a Delaware Corp. 60%							C			
	THE CLEVELAND-CLIFFS IRON										
	CO., an Ohio Corp. 40%										
TE-603	SOHIO PETROLEUM CO.		SW¼SE¼, SEC. 4	0.073	0.073	-	-	TE-603	CONSTRUCTION OF PIPE		
D	a Delaware Corp. 60%							D			
	THE CLEVELAND CLIFFS IRON										
	CO., an Ohio Corp. 40%										
TE-603	SOHIO PETROLEUM CO., a Delaware Corp. 60%		NW¼SE¼, SEC. 4	0.020	0.020	-	-	TE-603	CONSTRUCTION OF IRRIGATION DITCH		
E REV.	THE CLEVELAND CLIFFS IRON CO., an Ohio Corp. 40%							E REV.			
TE-604	DELETED										
TE-604A	DELETED										
TE-604	L. COLBY FRALIX &		NW¼SE¼, SEC. 4	0.025	0.025	-	-	TE-604	CONSTRUCTION OF IRRIGATION DITCH		
B REV.	MARJORIE C. FRALIX, J.T.							B REV.			
TE-604	L. COLBY FRALIX &		NW¼SE¼, SEC. 4	0.029	0.029	-	-	TE-604	CONSTRUCTION OF IRRIGATION DITCH		
C REV.	MARJORIE C. FRALIX, J.T.							C REV.			
TE-605	MARVIN A TILLMAN		NW¼SE¼, SEC. 4	0.026	0.026			TE-605	CONSTRUCTION OF PIPE		

S. H. NO. 70

RIGHT OF WAY DEBEQUE CANYON TO
WEST OF RIFLE

[illegible]

S. H. NO. 70

RIGHT OF WAY DEBEQUE CANYON TO
WEST OF RIFLE

WEST OF RIFLE

PARCEL NO.	OWNER	ADDRESS	LOCATION	AREA IN				PARCEL NO.	REMARKS	REVISIONS		
				PARCEL	TO BE ACQUIRED	REMAINDER				7/9/79	ADD TE-610C ;	
						LEFT	RIGHT					
			T.8S.,R.97W.,6th P.M.									
TE-610	ROBERT L. LATHAM & .		NW½SW½, SEC. 34	0.661	0.661	-	-	TE-610	CONSTRUCTION	8/21/79	DEL. TE-620	BG
C	JOHN H. LATHAM aka							C	OF IRRIGATION	10/12/79	NAME CHNG-TE-610	MR
	JOHN HARVEY LATHAM								DITCH		C. 612A	KMS
TE-611	CARTER W. ELLIOTT, JR.		SW½NW½, SEC. 34	0.035	0.035	-	-	TE-611	CONSTRUCTION OF IRRIGATION DITCH			
TE-611	CARTER W. ELLIOTT, JR.		SW½NW½, SEC. 34	0.276	0.276	-	-	TE-611	CONSTRUCTION OF IRRIGATION DITCH			
A								A				
TE-612	DELETED											
TE-612	ROBERT L. LATHAM &		SW½NW½, SEC. 34	0.030	0.030	-	-	TE-612	CONSTRUCTION OF IRRIGATION DITCH			
A	JOHN H. LATHAM aka							A				
	JOHN HARVEY LATHAM											
TE-613	BETTY M. SISSON ½		NE½NW½, SEC. 34	1.084	1.084	-	-	TE-613	CONSTRUCTION OF IRRIGATION DITCH			
	MARGIE M. MORIN ½											
	THE SOCIETY FOR THE PRO-											
	PAGATION OF THE FAITH ½											
	CARTER W. ELLIOTT, JR. ½											
TE-618	MARION E. NOVINGER (DECEASED)		NW½NE½, SEC. 34	0.104	0.104	-	-	TE-618	CONSTRUCTION OF DITCH			
	FRANCES E. NOVINGER											
TE-619	JAMES T. MODRELL &		NW½NE½, SEC. 34	0.265	0.265	-	-	TE-619	CONSTRUCTION OF DITCH			
	NETTIE F. MODRELL, J.T.											
TE-620	DELETED											
TE-621	BETTY M. SISSON ½		SW½SE½, SEC. 27	1.085	1.085	-	-	TE-621	CONSTRUCTION OF DITCH			
REV.	MARGIE E. MORIN ½							REV.				
	SHIRLEY M. ELLIOTT ½											
	CARTER W. ELLIOTT, JR. ½											

T.9S. R.97W. 6th PM.

FEDERAL ROAD REGION NO.	DISTRICT	PROJ. NO.	SHEET NO.	TOTAL SHEETS
XIII	COLORADO	170-1(45) Sec.6	3	19

RIGHT OF WAY DeBeque Canyon to West of Rifle		
REVISIONS		
8-21-79	Add Structure Sta. 531+00	M.R.
8-21-79	Add Stationing at Beg. Proj.	CDB

(TE-601) (601)
KENNETH L. ETTER &
JIMMIE L. ETTER, J.T.
N1/2 SW1/4 NW1/4, SE1/4 NW1/4,
Part of NE1/4 SW1/4, SEC. 9

(602)
ALBERT W. HAMMER, DEC.
AMANDA E. HAMMER, DEC.
GWENDOLYN HAMMER
NE1/4 NW1/4, NW1/4 NE1/4,
SEC. 9

NE1/4 NW1/4
Sec. 9

P.O.B. 601 & 602
Tie: NW Cor. Sec. 9
bears N 58° 26' 30" W
2584.4'

239.0' Lt.
P.O.S.T. 225.6' Ah. P.I.

Frontage Rd.
Δ = 8° 19' Lt.
D = 0° 30'
T = 833.03'
L = 1,663.13'
R = 11,459.16'

Frontage Rd. x 935
Δ = 9° 37' 04"
Ts = 316.04'
Dc = 2° 00' x 930
Lc = 330.89'
Rc = 2,864.79'

P.O.B. E-600
Tie: SW COR. SEC. 9
bears S 32° 27' W
3,989.0'

P.O.B. 600
Tie: SW Cor. Sec. 9
bears S 32° 51' W
3,376.7'

(600) (E-600) (TE-600)
DOUGLAS E. DEAN &
PATRICIA A. DEAN
E1/2 SW1/4
Part of SE1/4 NW1/4, SEC. 9

BEGIN R.O.W. PROJ. 170-1(45) Sec. 6 P.O.S.T. 518+86.3
118.9' Lt. Sta. 206+24.2 on R.O.W. PROJ. FAP 297C

R.O.W. PREVIOUSLY PURCHASED ON PROJ. FAP 297-C

T. 9S., R. 97W., 6th. PM.

FEDERAL ROAD REGION NO.	DISTRICT	PROJ. NO.	SHEET NO.	TOTAL SHEETS
VIII	COLORADO	170-1(45) Sec. 6	4	19

REVISIONS	
7-9-79	Del. TE 602, 602A, 602C, 602D, 603, Rev. TE 603A, 603B, Add TE 603E
8-21-79	Rev. Name chg. TE 604B to LUTHER COLBY FRALIX & MARJORIE C. FRALIX, J.T.
8-21-79	Add Structure, Sta. 548+20
8-21-79	Add Structure, Sta. 548+20

DELETED
TE-602A
E-602
DELETED
TE-602B
602
DELETED
TE-602C
TE-602
DELETED
TE-602D
ALBERT W. HAMMER, DEC.
AMANDA E. HAMMER, DEC.
GWENDOLYN HAMMER
NE 1/4 NW 1/4, NW 1/4 NE 1/4
SEC. 9

REV. REV.
TE-604B TE-604C
LUTHER COLBY FRALIX &
MARJORIE C. FRALIX, J.T.

DELETED
TE-603
TE-603C
REV. REV.
TE-603A TE-603B
603
TE-603D
REV.
TE-603E
SOHIO 60%
CLIFFS 40%
SE 1/4 SW 1/4, SW 1/4 SE 1/4
SEC. 4

P.O.B. 603
Tie: SW Cor. Sec. 4
bears N 89° 39' 30" W
2752.1'
184.8' Lt.
P.O.S.T. 1,669.7' Ah. P.I.

P.O.B. 601 & 602
Tie: NW Cor. Sec. 9
bears N 58° 26' 30" W
2,584.4'

Frontage Rd.
Δ = 8° 19' Lt.
D = 0° 30'
T = 833.03'
L = 1,663.13'
R = 11,459.16'

Δ = 12° 14'
D = 0° 20'
T = 1842.00'
L = 3670.00'
R = 17,188.73'

213.9' Lt.
P.O.S.T. 1,056.3' Ah. P.I.

TE-602B

603

602

TE-603A

603

TE-604B

602

603

TE-604C

E-602

TE-603B

TE-603C

TE-603D

TE-604D

P.O.B. E-602
Tie: NW COR. SEC. 9
bears N 80° 15' 30" W
2,981.6'

Frontage Rd.
Δ = 9° 37' 04" Lt.
Ts = 316.04'
Δc = 6° 37' 04"
Dc = 2° 00'
Lc = 330.89'
Rc = 2,864.79'

Frontage Rd.
Δ = 1° 30'
Ts = 150.0'
Δc = 6° 37' 04"
Dc = 2° 00'
Lc = 330.89'
Rc = 2,864.79'

NW 1/4 NE 1/4
SEC. 9

548+20
10-10x8x326 CBC


R.O.W. PREVIOUSLY PURCHASED ON PROJ. FAP 297-C

FEDERAL ROAD REGION NO.	DISTRICT	PROJ. NO.	SHEET NO.	TOTAL SHEETS
<u>VIII</u>	COLORADO	170-1(45)Sec. 6	5	19

RIGHT OF WAY

DeBeque Canyon to West of R

REVISIONS		
7-9-79	Name chg. 604; Del. TE's 604A, 606C, D, G; Rex TE's 604B, C, 606A	B 60

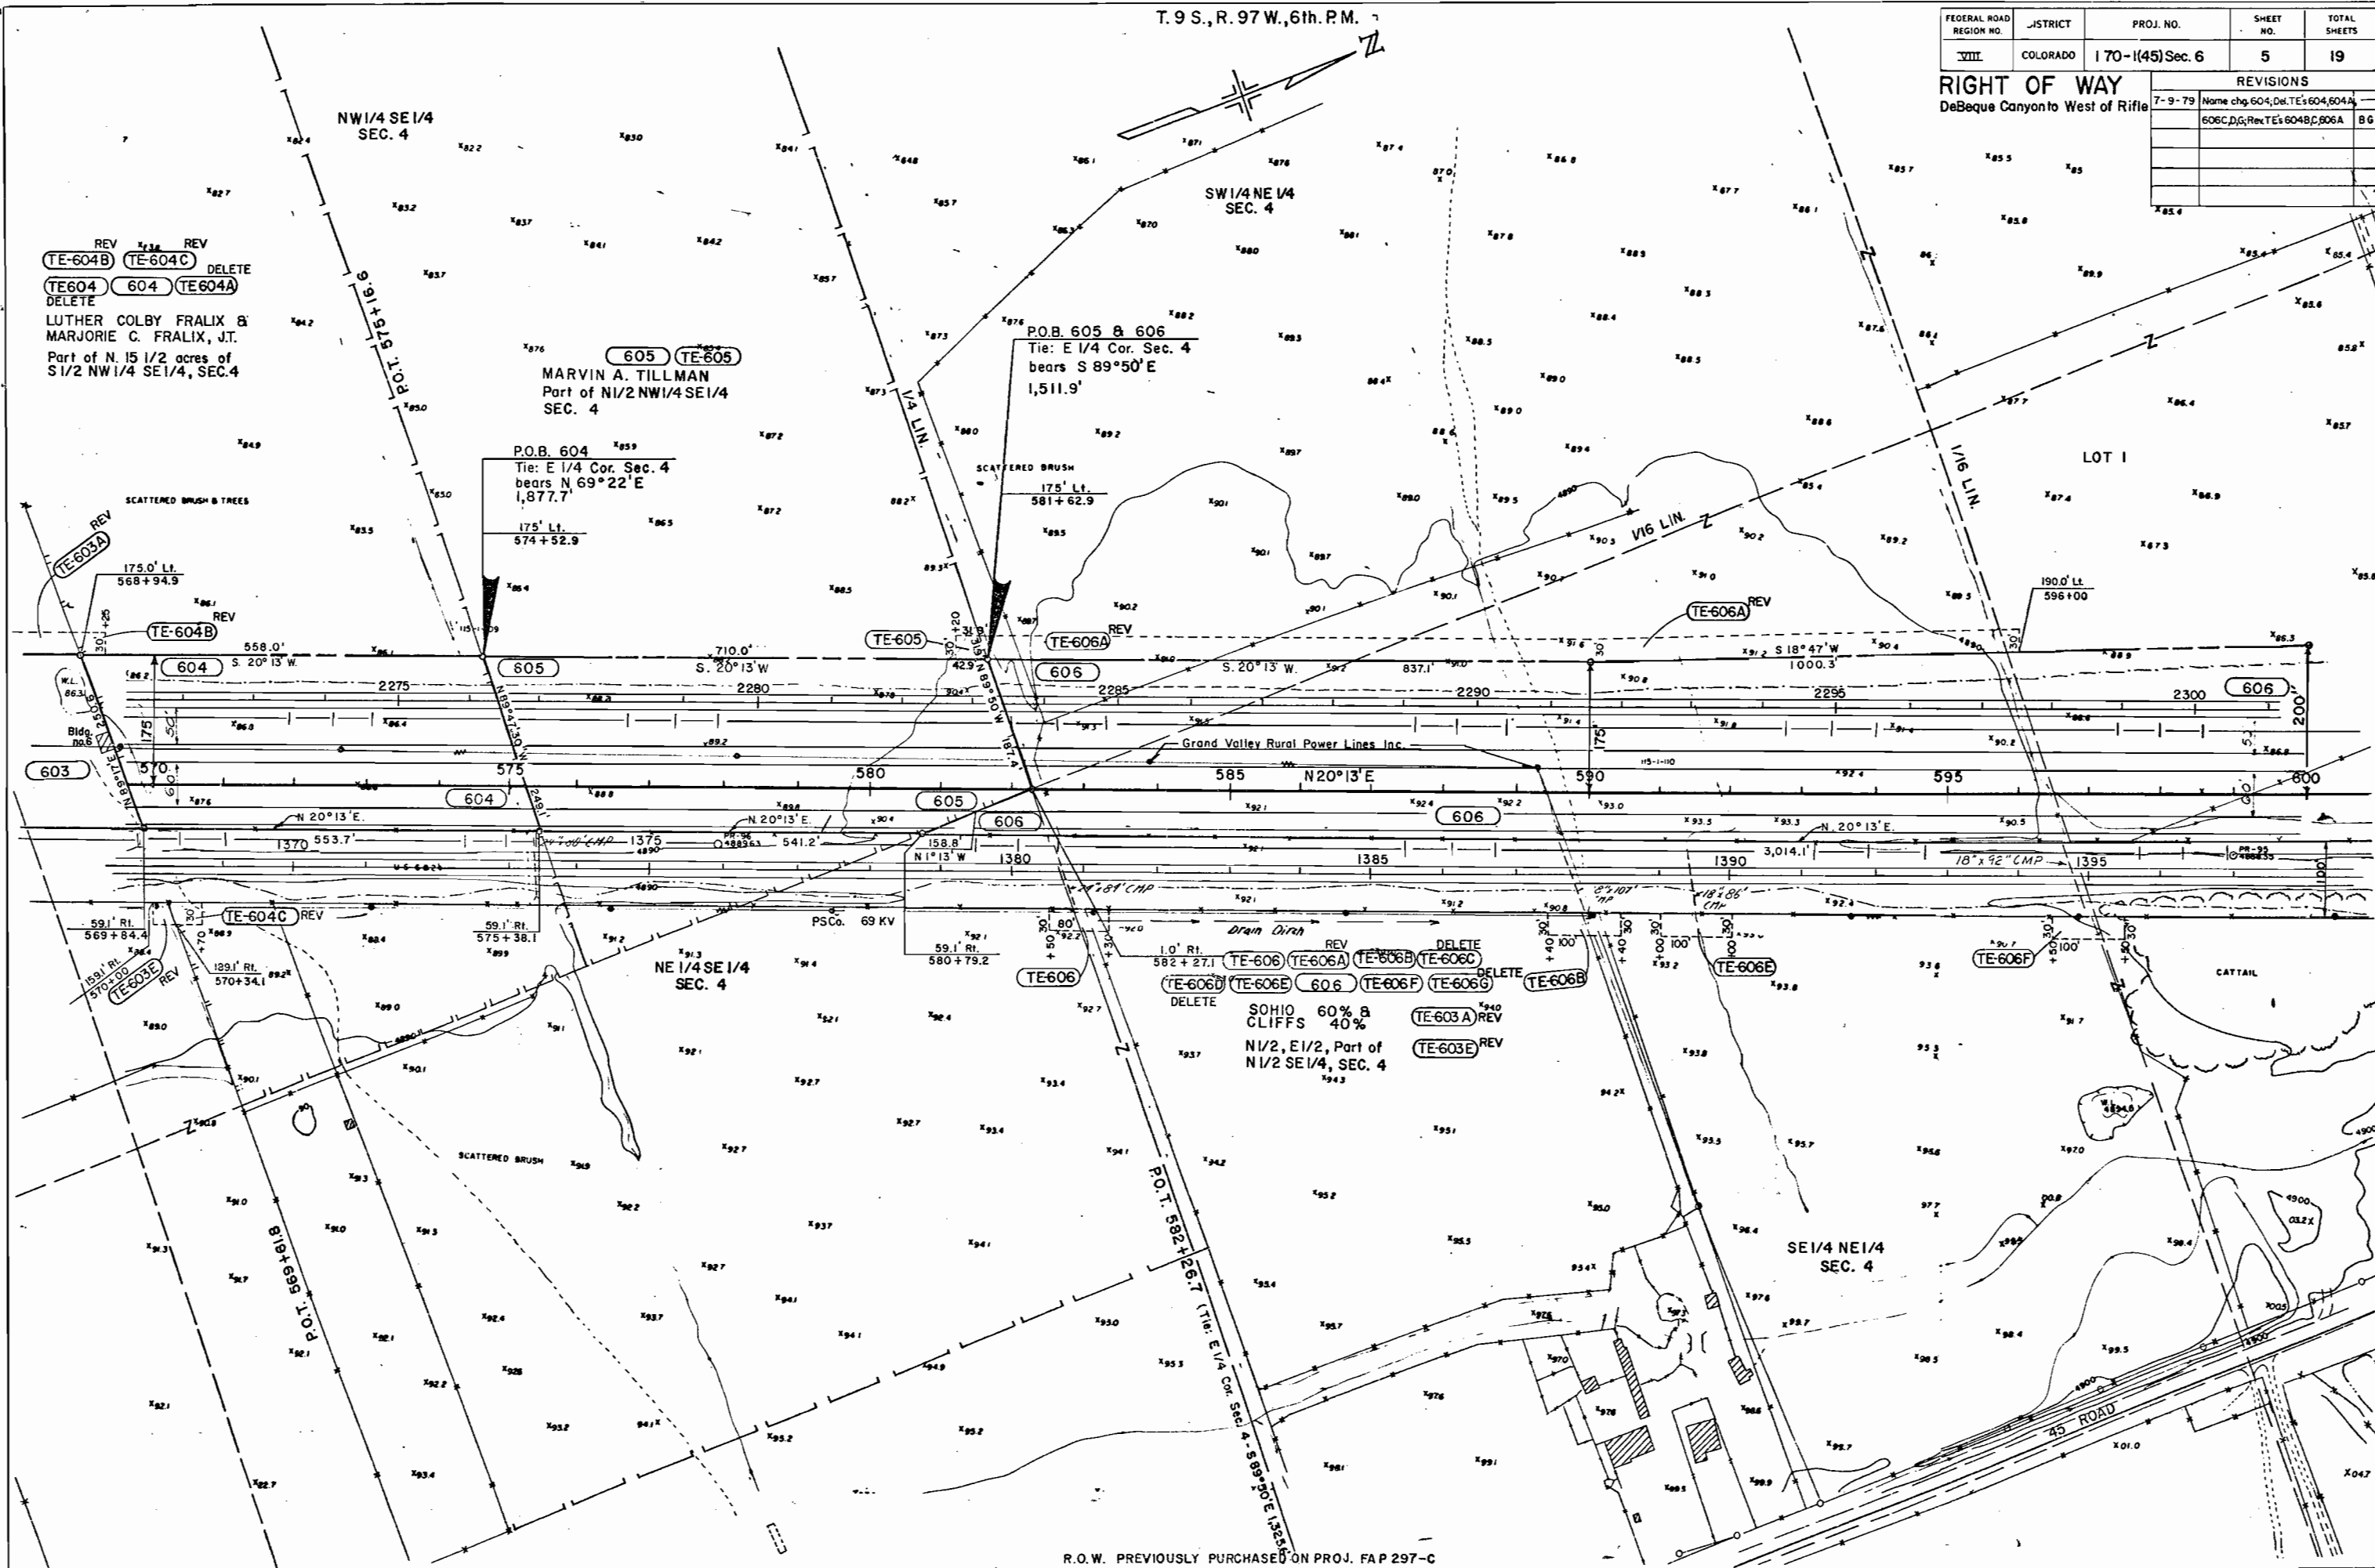

R.O.W. PREVIOUSLY PURCHASED ON PROJ. FAP 297-C

T. 8 S., 8 T. 9 S., R. 97 W., 6th. P.M.

FEDERAL ROAD REGION NO.	DISTRICT	PROJ. NO.	SHEET NO.	TOTAL SHEETS
VIII	COLORADO	170-1(45)Sec.6	6	19

RIGHT OF WAY

DeBeque Canyon to West of Rifle

REVISIONS

NO.	DATE	DESCRIPTION	BY
7-9-79		Del. TE's 606G, H, J, Add TE's 606K	
609, 610C, 621A Rev			B.S.
10-12-79		Name change, 609	K.M.S.

NE 1/4 SE 1/4
SEC. 33

609 610 TE-609 TE-610C

ROBERT L. LATHAM & JOHN H. LATHAM aka
JOHN HARVEY LATHAM
Part of NW 1/4 SW 1/4
SEC. 34

P.O.B. 607 & 608

Tie: SE Cor. Sec. 33
bears S 0°42'30"E
1,334.5'


SE 1/4 SE 1/4
SEC. 33

607 TE-607
ROY H. INSKEEP (DEC.)
Part of SE 1/4 SE 1/4
SEC. 33

P.O.B. 606
Tie: SE Cor. Sec. 33
bears N 90°00'E
494.6'

DELETE
TE-606G
DELETE
TE-606H
DELETE
TE-606J
SOHIO 60%
CLIFFS 40%
LOT 1, SEC. 4, T. 9 S.
Part of SE 1/4 SE 1/4
SEC. 33, T. 8 S.

LOT 1
SEC. 4

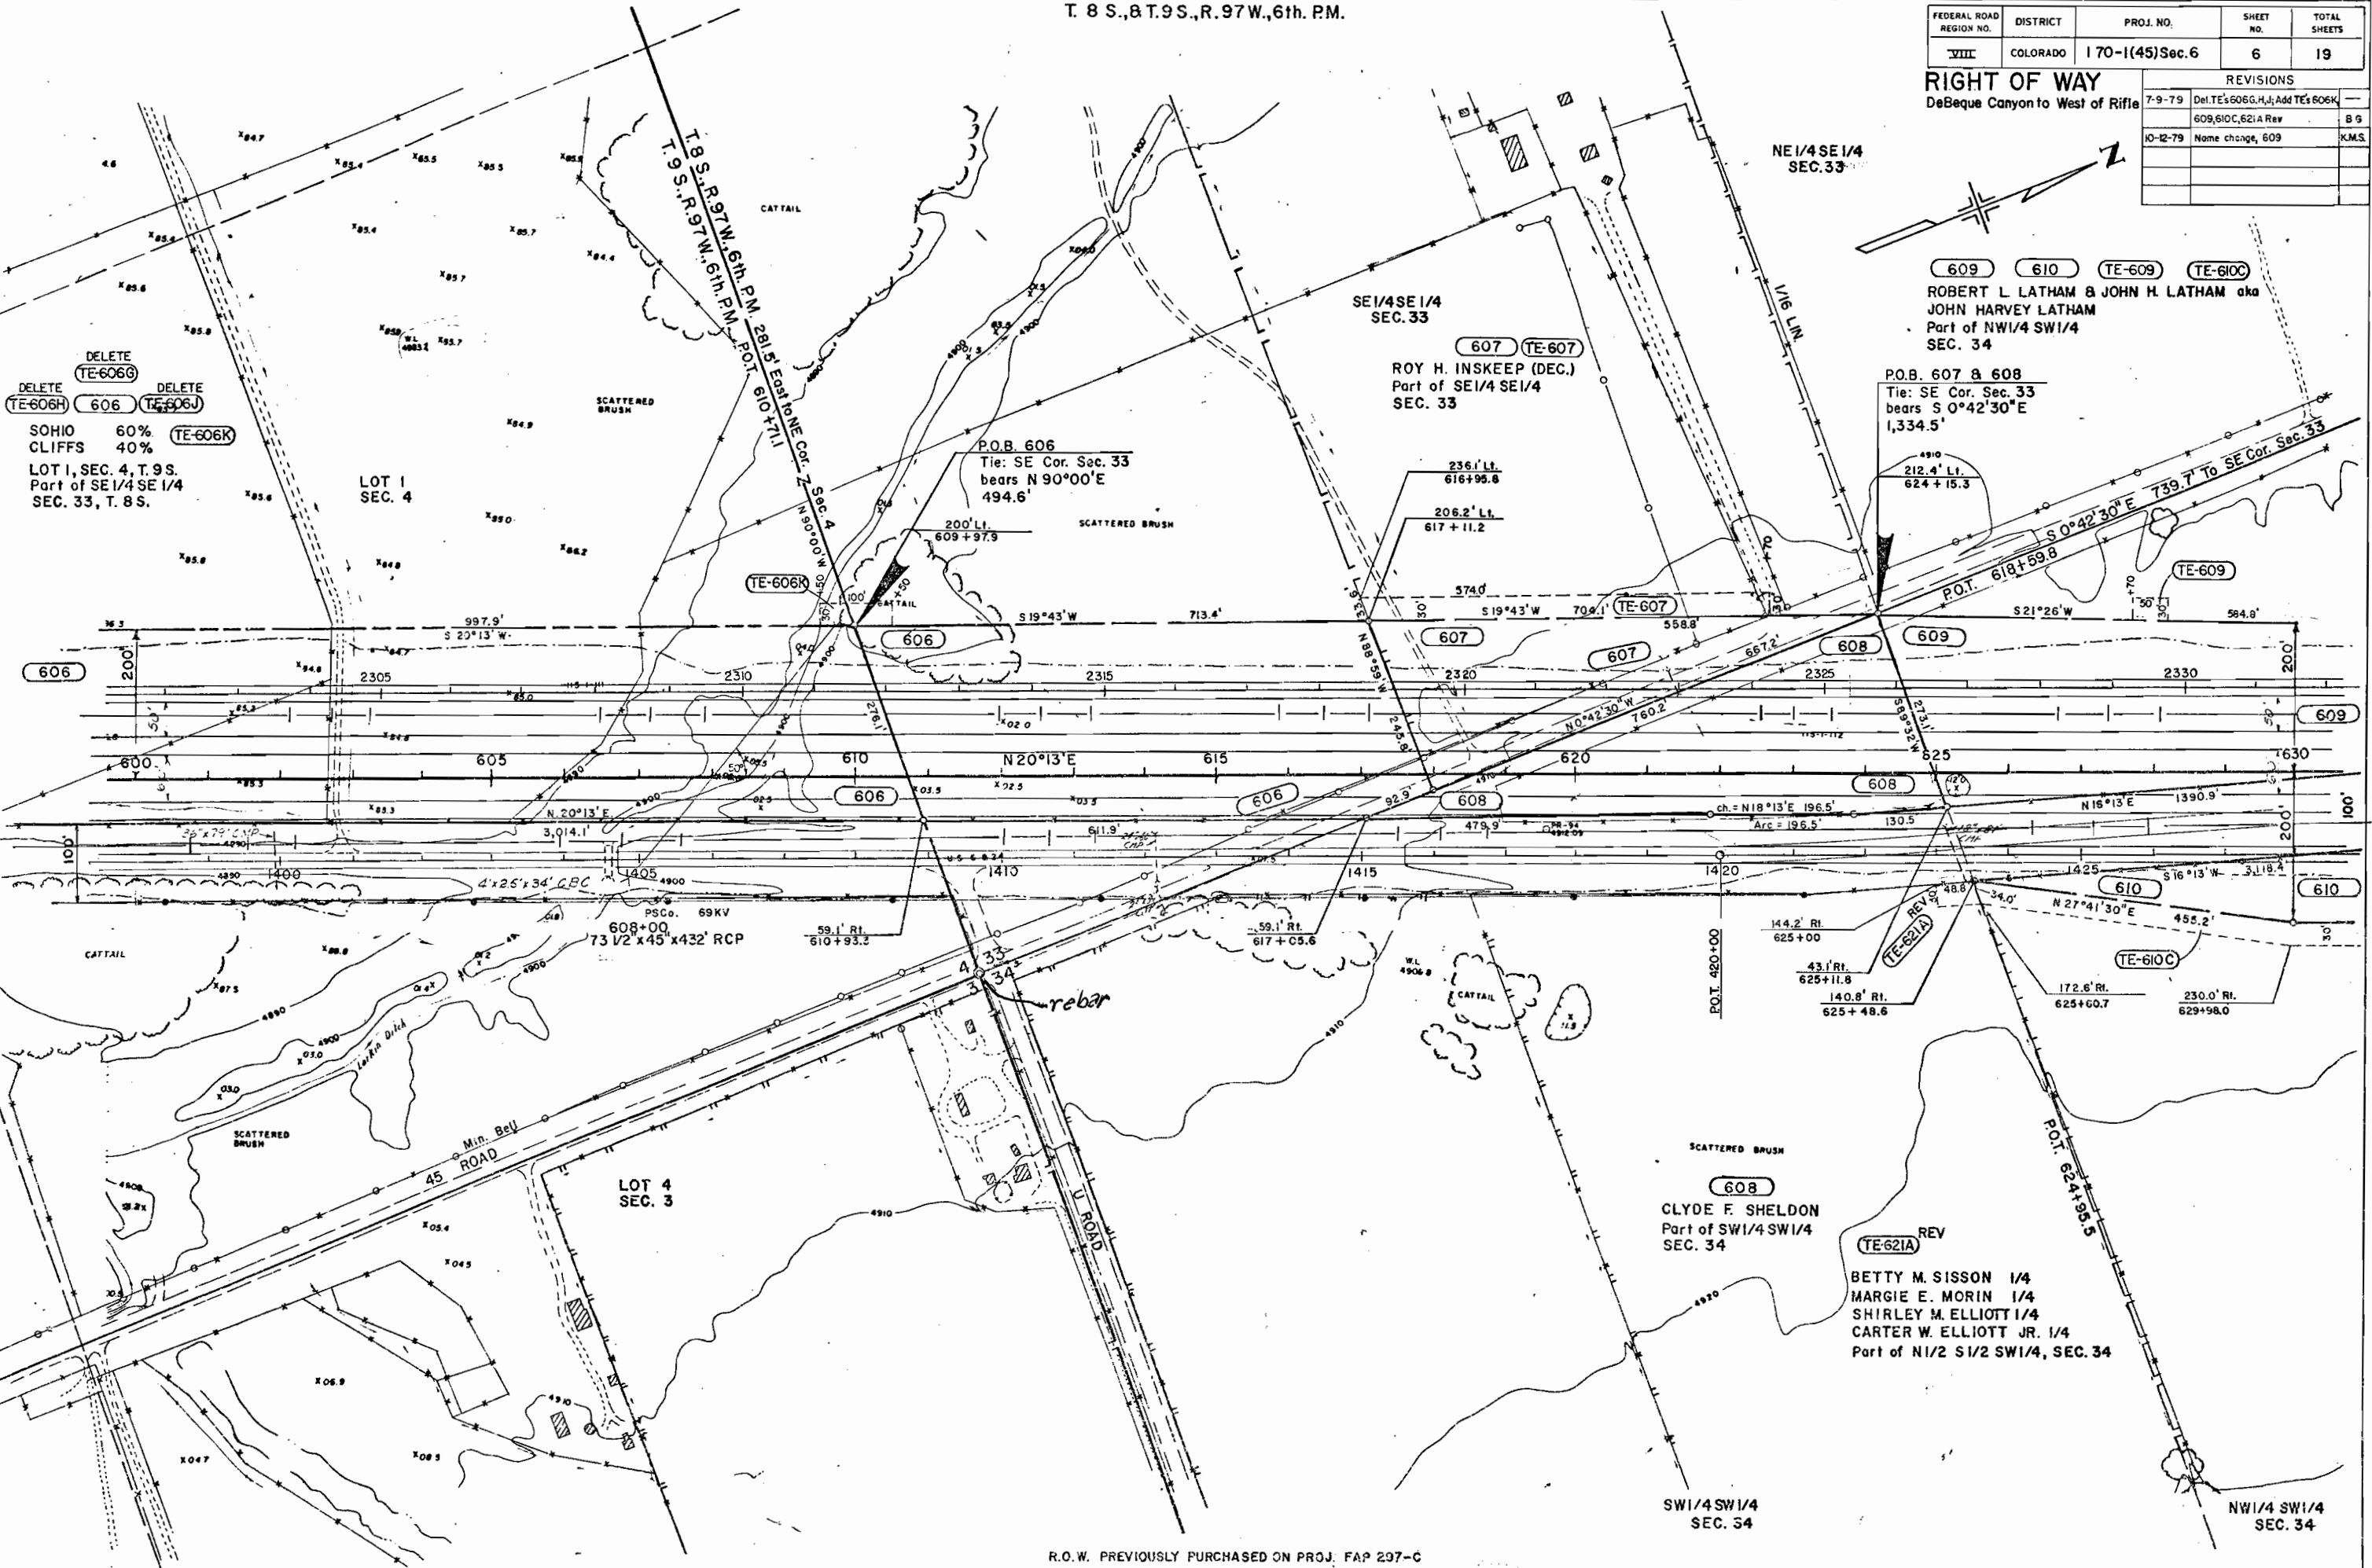

T. 8 S., R. 97 W., 6th. P.M.


FEDERAL ROAD REGION NO.	DIVISION	PROJ. NO.	SHEET NO.	TOTAL SHEETS
VIII.	COLORADO	170-1(45) Sec. 6	8	19

REVISIONS			
7-9-79	Name chg. Par. 616 Rev. Del. TE-634;		B.G.
8-21-79	Add TE's 620, 621 Rev.		MR
8-21-79	Name change, par. 613 & 613A		MR
10-12-79	Name change, par. 620		KMS
2-14-80	Add PE-615AR		R.B.M.
12-4-80	Rev. Par. 616 Rev.		R.M.
3-9-12	Add note about sh. 8A		J.W.J.

RIGHT OF WAY
DeBeque Canyon to West of Rifle

NW 1/4 SE 1/4
SEC. 27

62 Rev. TE-621 Rev.
BETTY M. SISSON 1/4
MARGIE E. MORIN 1/4
SHIRLEY M. ELLIOTT 1/4
CARTER W. ELLIOTT, JR. 1/4
SW 1/4 SE 1/4, SEC. 27

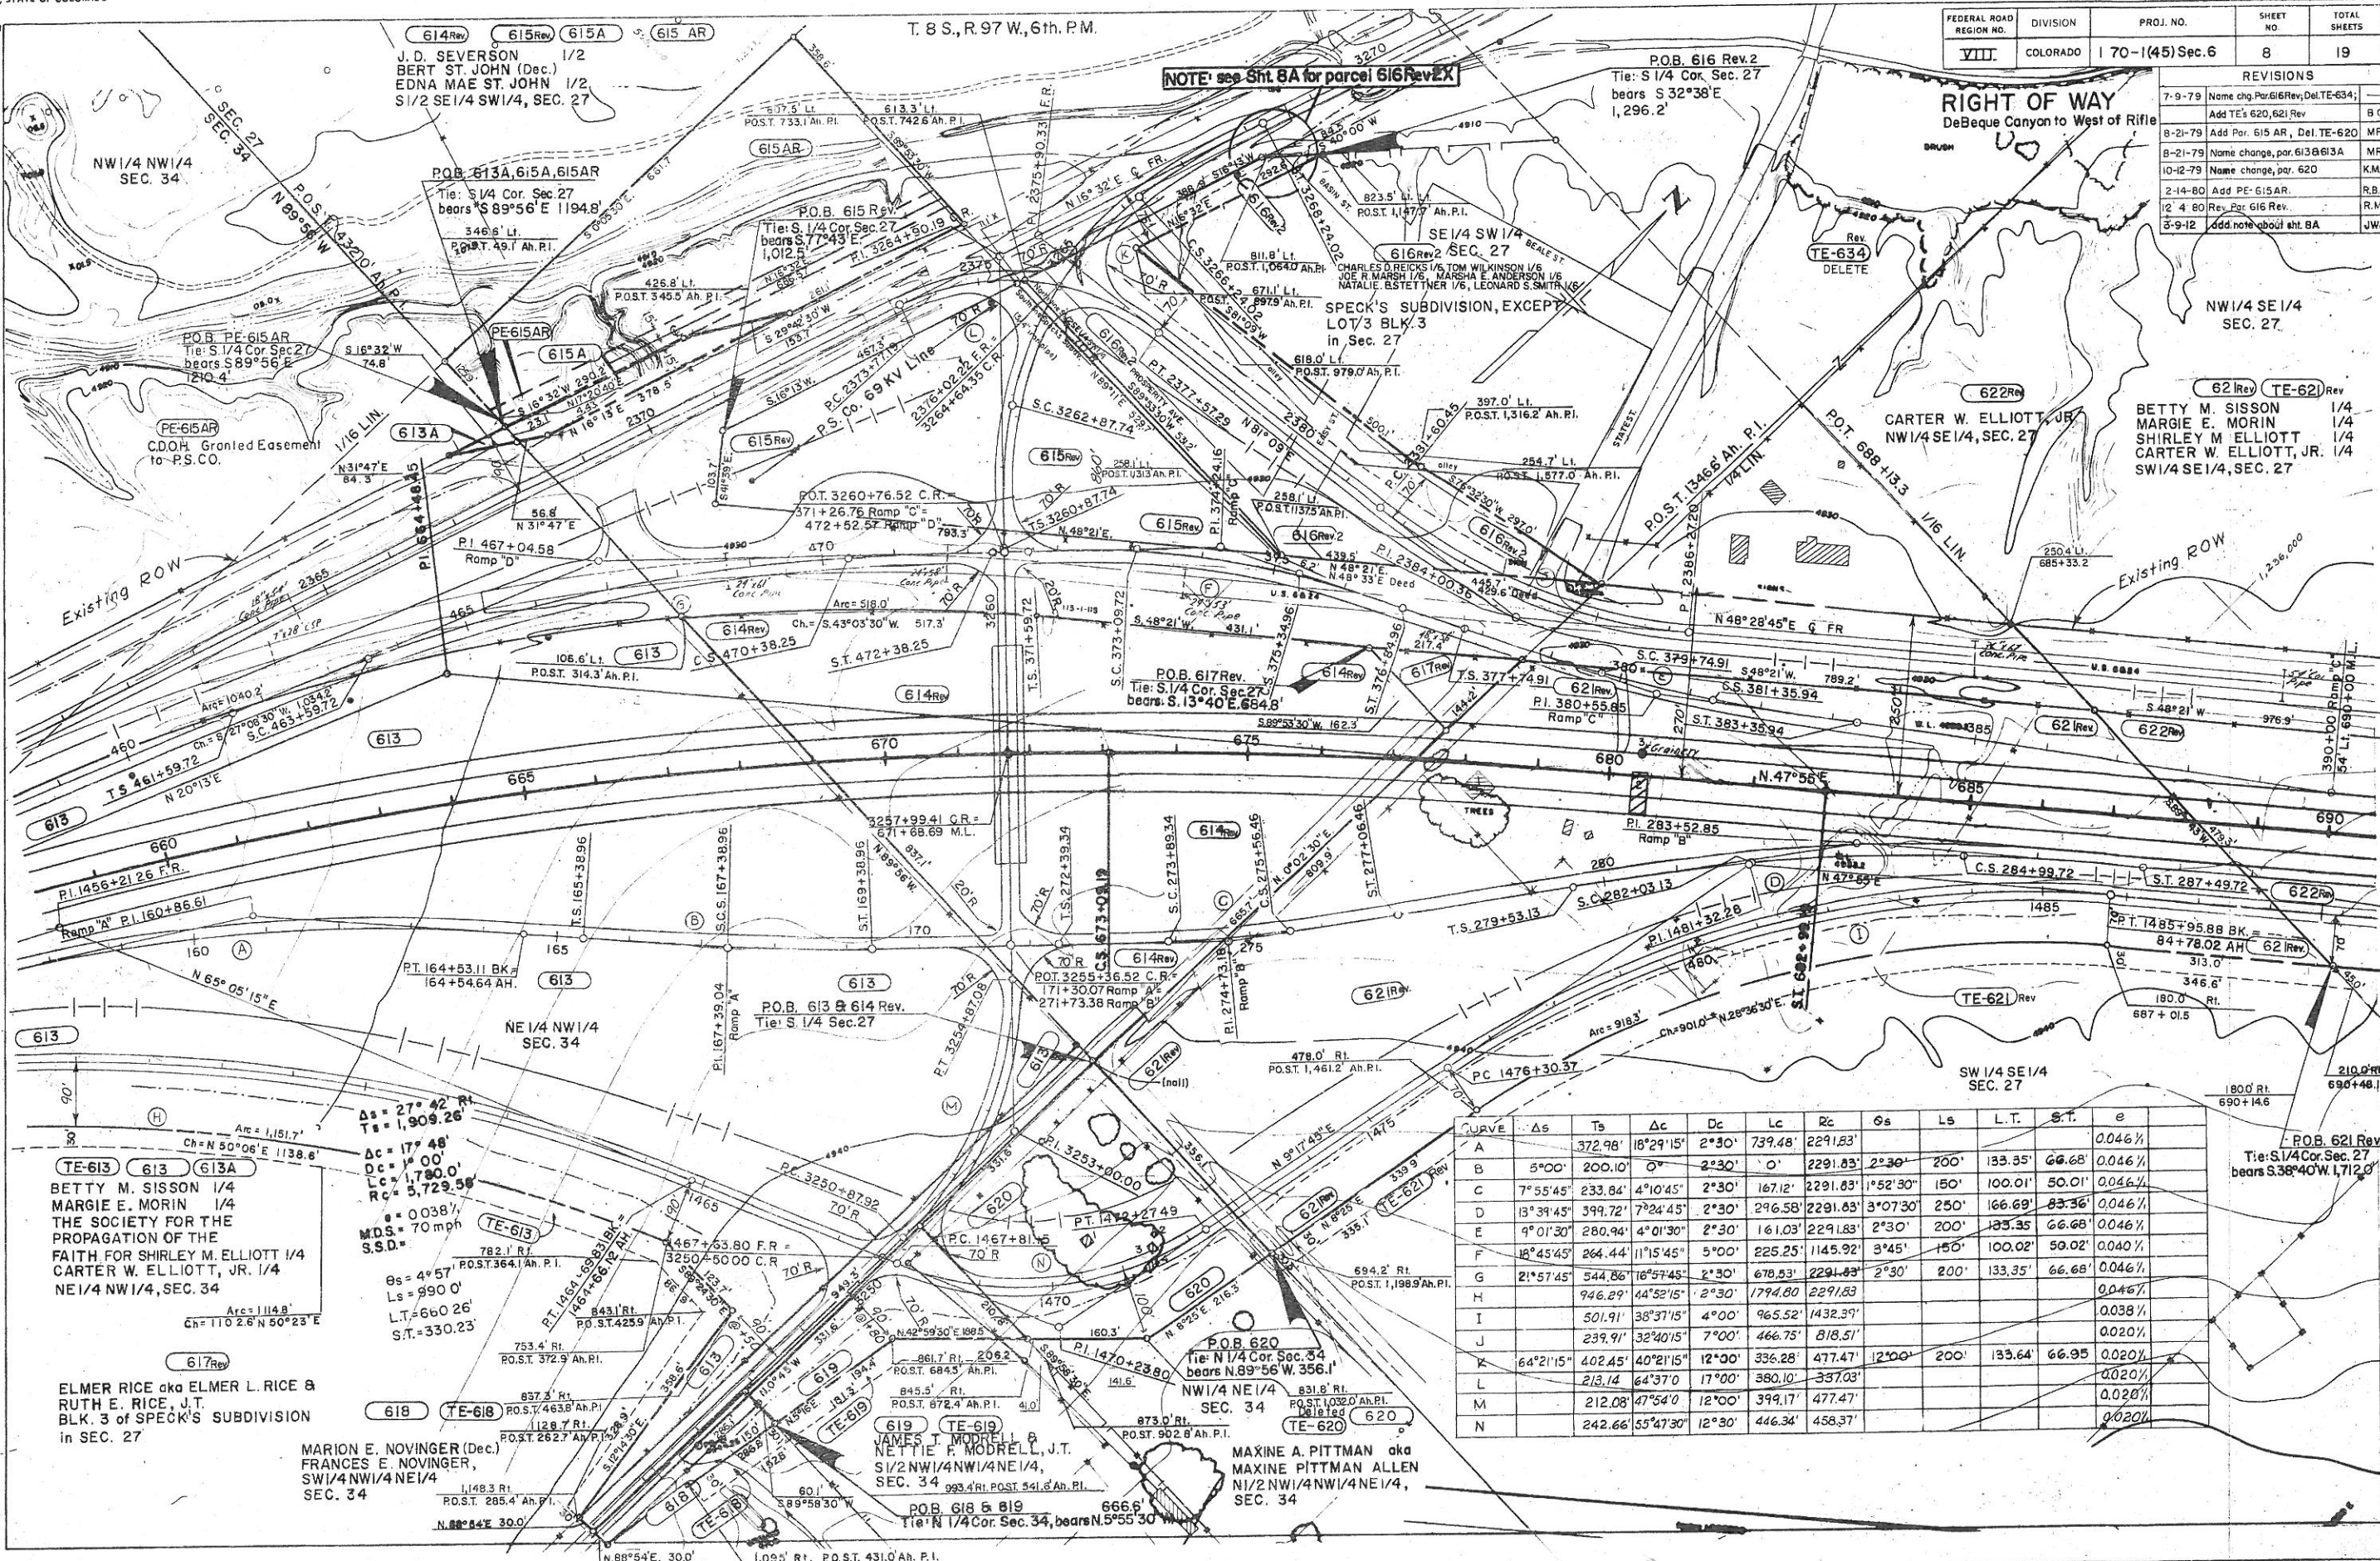

CURVE	Δs	Ts	Δc	Dc	Lc	Rc	Δs	Ls	L.T.	S.T.	e
A	372.98'	18° 29' 15"	2° 30'	739.48'	2291.83'		2° 30'	200'	133.35'	66.68'	0.046%
B	5° 00'	200.10'	0°	2° 30'	0'	2291.83'	2° 30'	200'	133.35'	66.68'	0.046%
C	7° 55' 45"	233.84'	4° 10' 45"	2° 30'	167.12'	2291.83'	1° 52' 30"	150'	100.01'	50.01'	0.046%
D	13° 39' 45"	399.72'	7° 24' 45"	2° 30'	296.58'	2291.83'	3° 07' 30"	250'	166.69'	83.36'	0.046%
E	9° 01' 30"	280.94'	4° 01' 30"	2° 30'	161.03'	2291.83'	2° 30'	200'	133.35'	66.68'	0.046%
F	18° 45' 45"	264.44'	11° 15' 45"	5° 00'	225.25'	1145.92'	3° 45'	150'	100.02'	50.02'	0.040%
G	21° 57' 45"	544.86'	16° 57' 45"	2° 30'	678.83'	2291.83'	2° 30'	200'	133.35'	66.68'	0.046%
H	946.29'	44° 52' 15"	2° 30'	1794.80'	2291.83'						0.046%
I	501.91'	38° 31' 15"	4° 00'	965.52'	1432.39'						0.038%
J	239.91'	32° 40' 15"	7° 00'	466.75'	818.51'						0.020%
K	64° 21' 15"	402.45'	40° 21' 15"	12° 00'	336.28'	477.47'	12° 00'	200'	133.64'	66.95'	0.020%
L	213.14'	64° 37' 0"	17° 00'	380.10'	337.03'						0.020%
M	212.08'	47° 54' 0"	12° 00'	399.17'	477.47'						0.020%
N	242.66'	55° 47' 30"	12° 30'	446.34'	458.37'						0.020%



Sheet Revisions

Date	Description	Initials
3-9-12	add sht 8A	JWJ

Sheet Revisions

Date	Description	Initials
mm/dd/yy	XXXXXXXX	XXX

Sheet Revisions


Date	Description	Initials
mm/dd/yy	XXXXXXXX	XXX

RIGHT OF WAY PLANS

Project Number:	I 70-1(45) Sec. 6			
Project Location:	DeBeque Canyon to W. of Rifle			
Project Code:	Last Mod. Date	Subset	Sheet No.	Total Sheets
75039	3-9-12		8A	19

T. 8 S., R. 97 W., 6th P.M.


Basis of bearings for parcel 616Rev2X are as follows:
S.00°09'13"E. on the east line of said SE¹/₄SW¹/₄, of
Sec. 27. This line is between the NE cor. of said
SE¹/₄SW¹/₄, a fnd. AL. cap (LS #16413) and the S¹/₄
cor. of said Sec. 27 (a fnd Mesa Co. Survey Maker #1409).

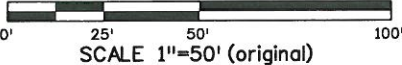

P.O.B. 616Rev2X

Tie: NE Cor. SE¹/₄SW¹/₄ Sec. 27 to P.O.B.
(a fnd. AL. cap - LS #16413)
Bears: 1) S.89°05'00"W, 662.10'
2)thence Arc =219.07' (rad =11,109.16)
CHD =S.16°31'34"W, 219.07'
3)Thence Arc =74.12' (Rad=5823.04')
CHD =S.15°35'47"W, 74.12'
(to the true point of begining)

ARC =26.70' - (deed)
CRD =N.15°21'47"E., 26.70'
(RAD = 5823.04')
S.16°13'W. (plans I 70-1(45) Sec. 6)
N.73°41'06"W. - (deed)
29.08'

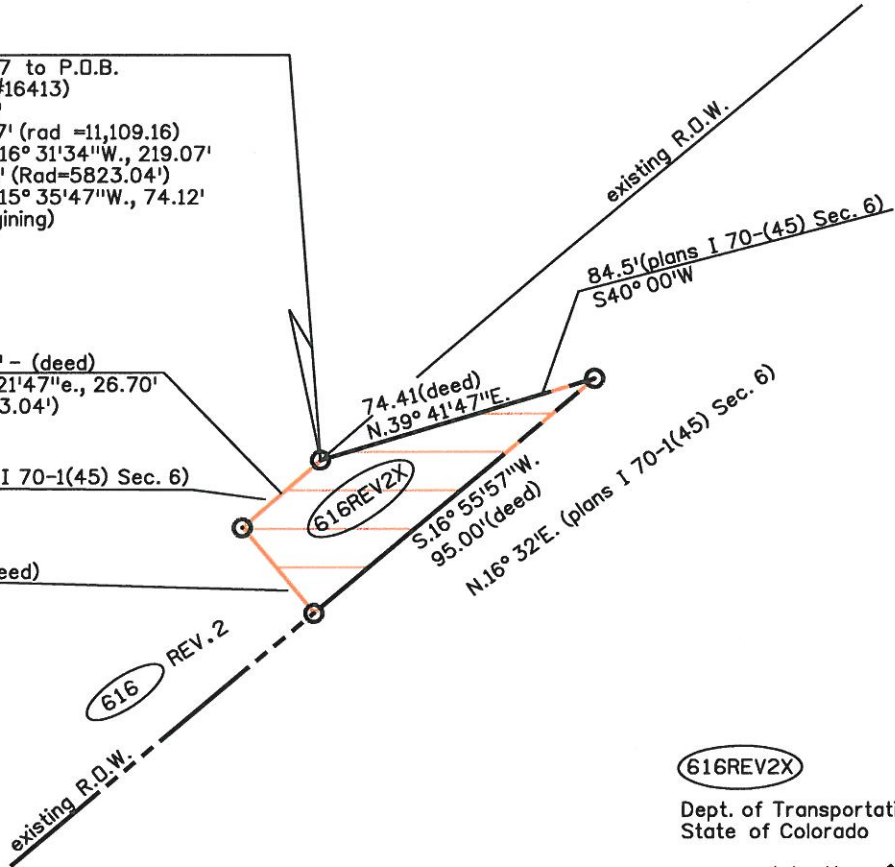

616REV2X

Dept. of Transportation
State of Colorado

conveyed to: Kum & Go, LLC
an Iowa Limited Liability Company
rec. #2586815 (Mesa County Clerk & Recorder)


(DETAIL A)

NOTE: The existing ROW lines shown on this sheet were from project I 70-1(45) Sec. 6

RIGHT OF WAY

DeBeque Canyon to West of Rifle

REVISIONS		
7-9-79	Del. TE's 622A, 624R Rev, 624A, 624D, 635; Add TE's 623 Rev 2, 624B Rev 624C Rev	—
8-21-79	Del. TE-624C, Str. 711 + 60 Add. TE-622A	—

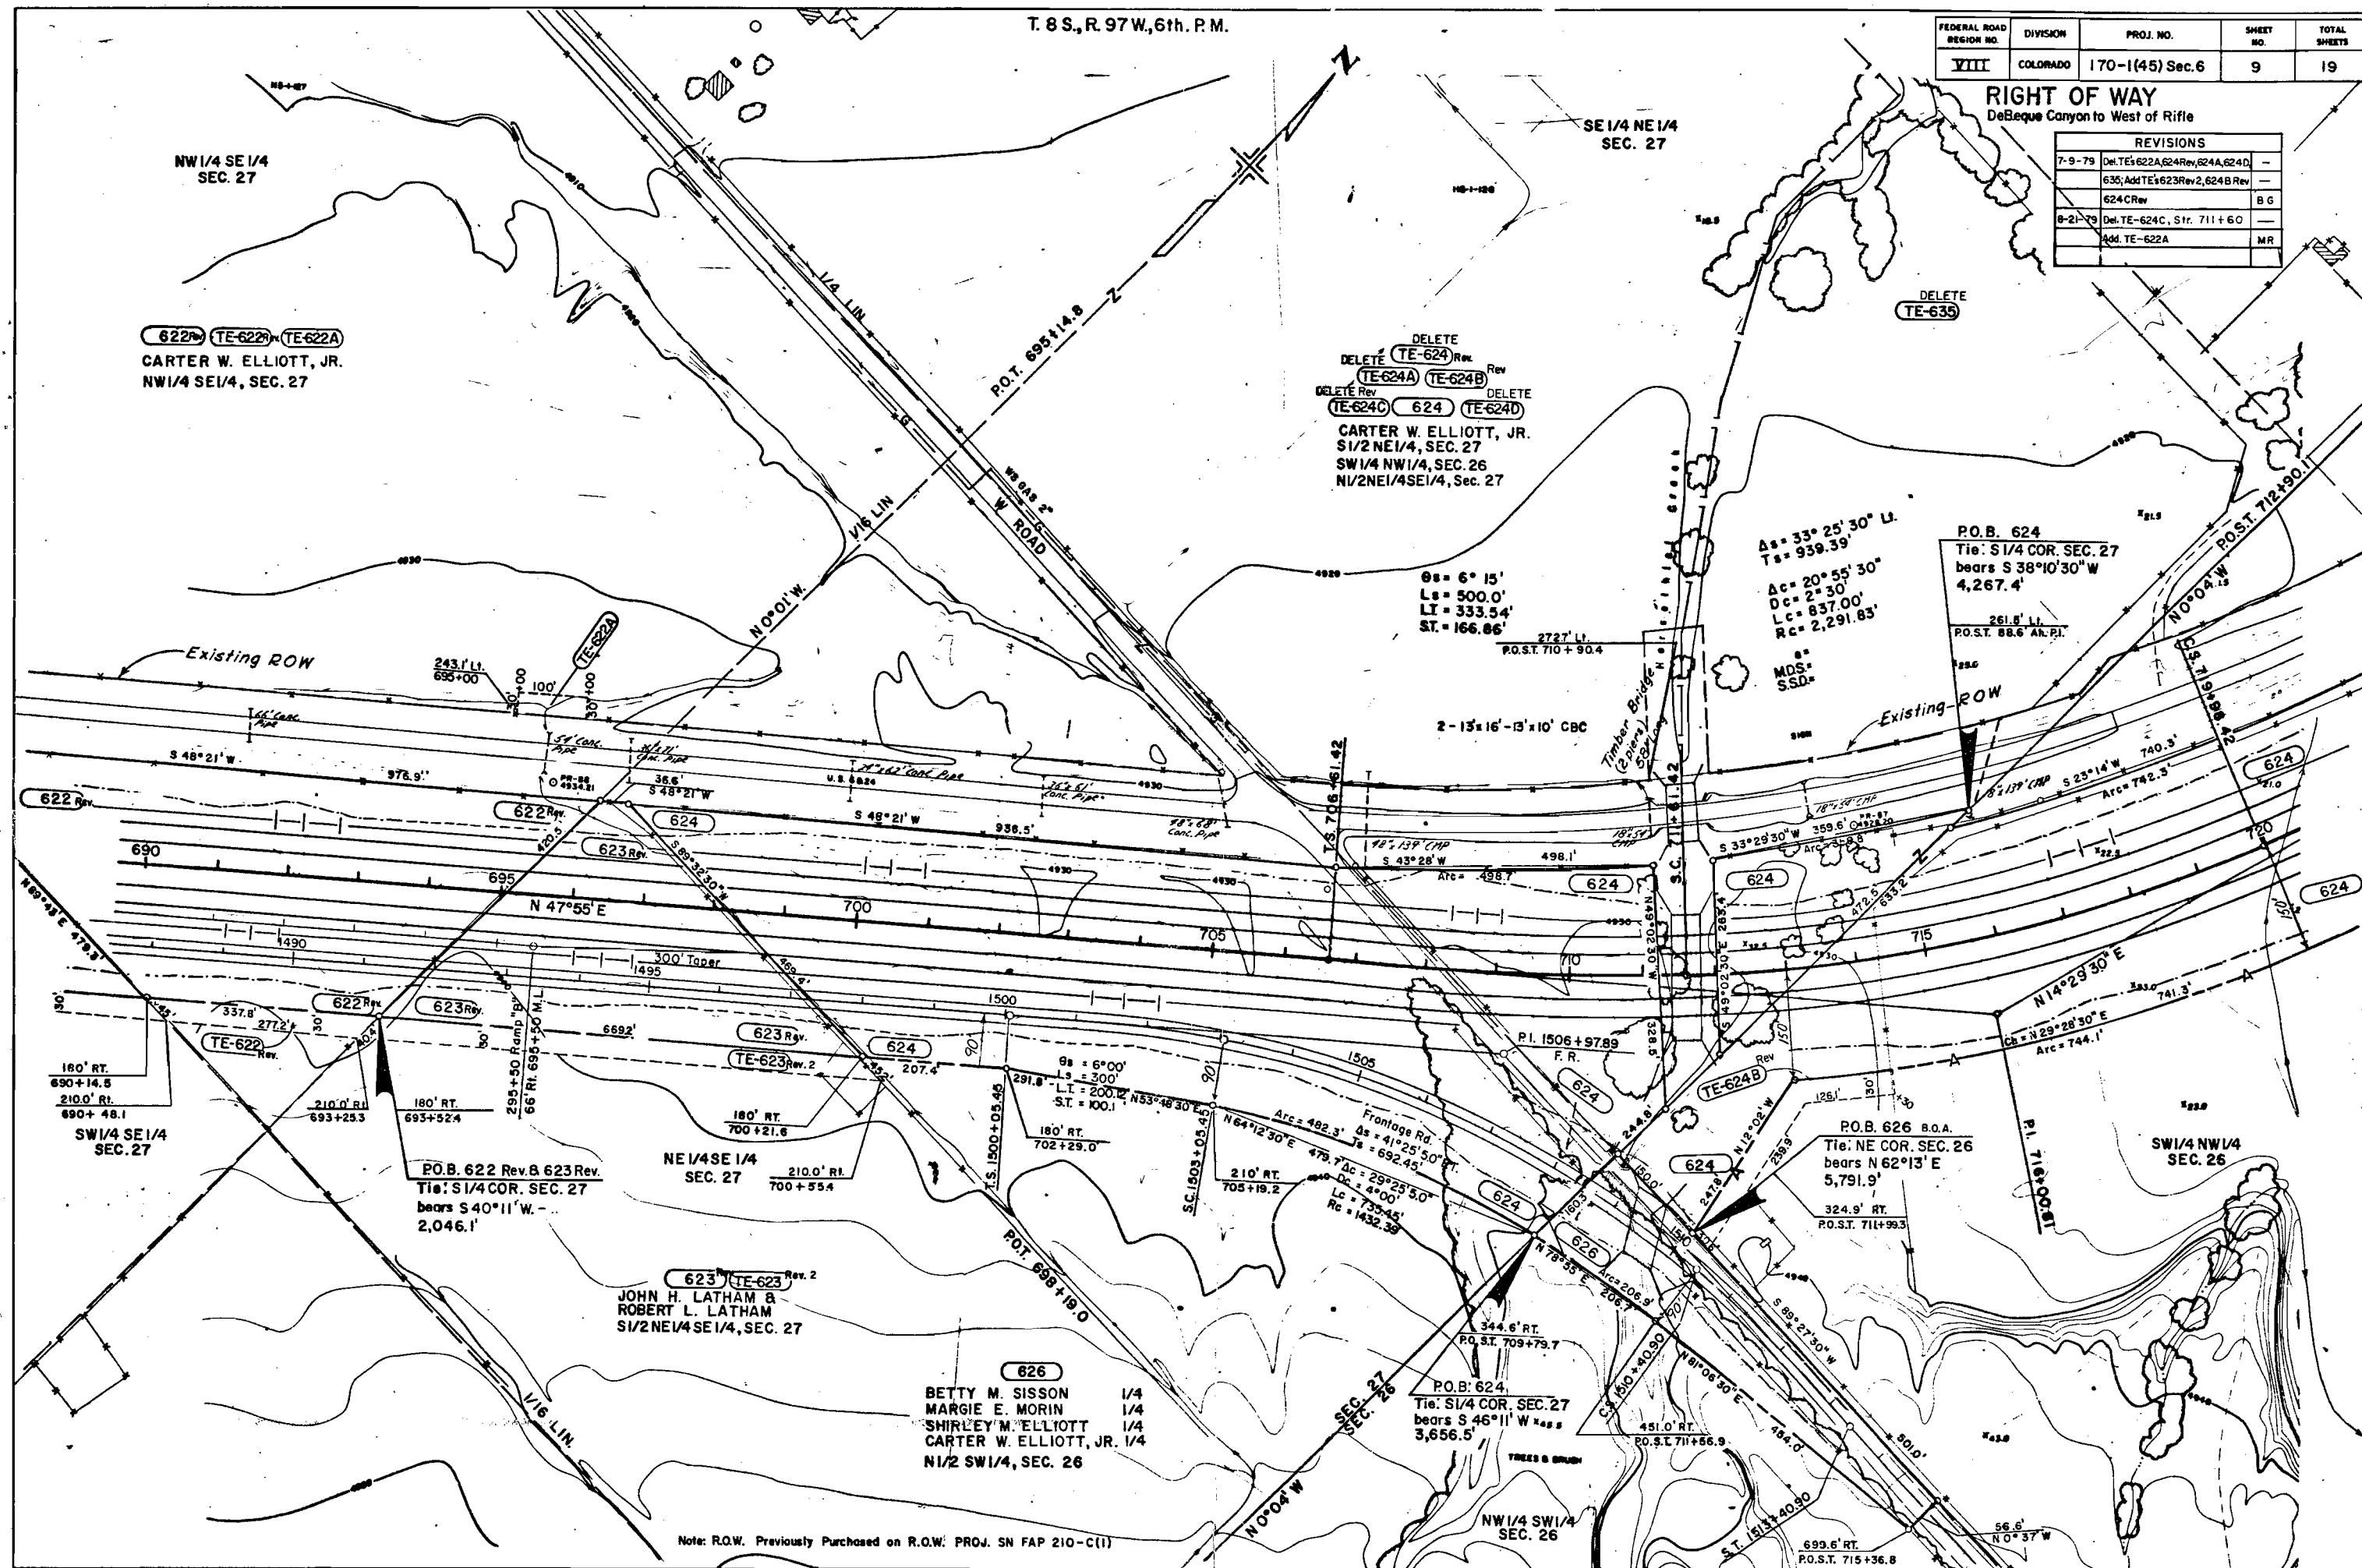

Note: R.O.W. Previously Purchased on R.O.W. PROJ. SN FAP 210-C(1)

FEDERAL ROAD SECTION NO.	DIVISION	PROJ. NO.	SHEET NO.	TOTAL SHEETS
VIII	COLORADO	1-70-1(45) SEC. 6	11	19

RIGHT OF WAY
DeBeque Canyon to West of Rifle


SE 1/4 NW 1/4
SEC. 23

628 REV. 4

628-R

FIRST NATIONAL BANK in GRAND JCT. TRUSTEE
E 1/2 W 1/2, SW 1/4 NE 1/4
SEC. 23


REVISIONS	
6-13-79 Add Par. 628 A, Rev. 628 Rev.	M.R.
7-9-79 Adj. lines	B.G.
8-21-79 Add Structure, Sta 759+25	M.R.
5-22-80 Rev Par. 628 Rev 2	K.M.S.
7-25-80 Add Par. 628 B	G.C.F.
11-28-80 Deleted Par. 628 B	G.C.F.
12/7/81 Revise 628 Rev 3, Access, Add 628-R	E.A. 7

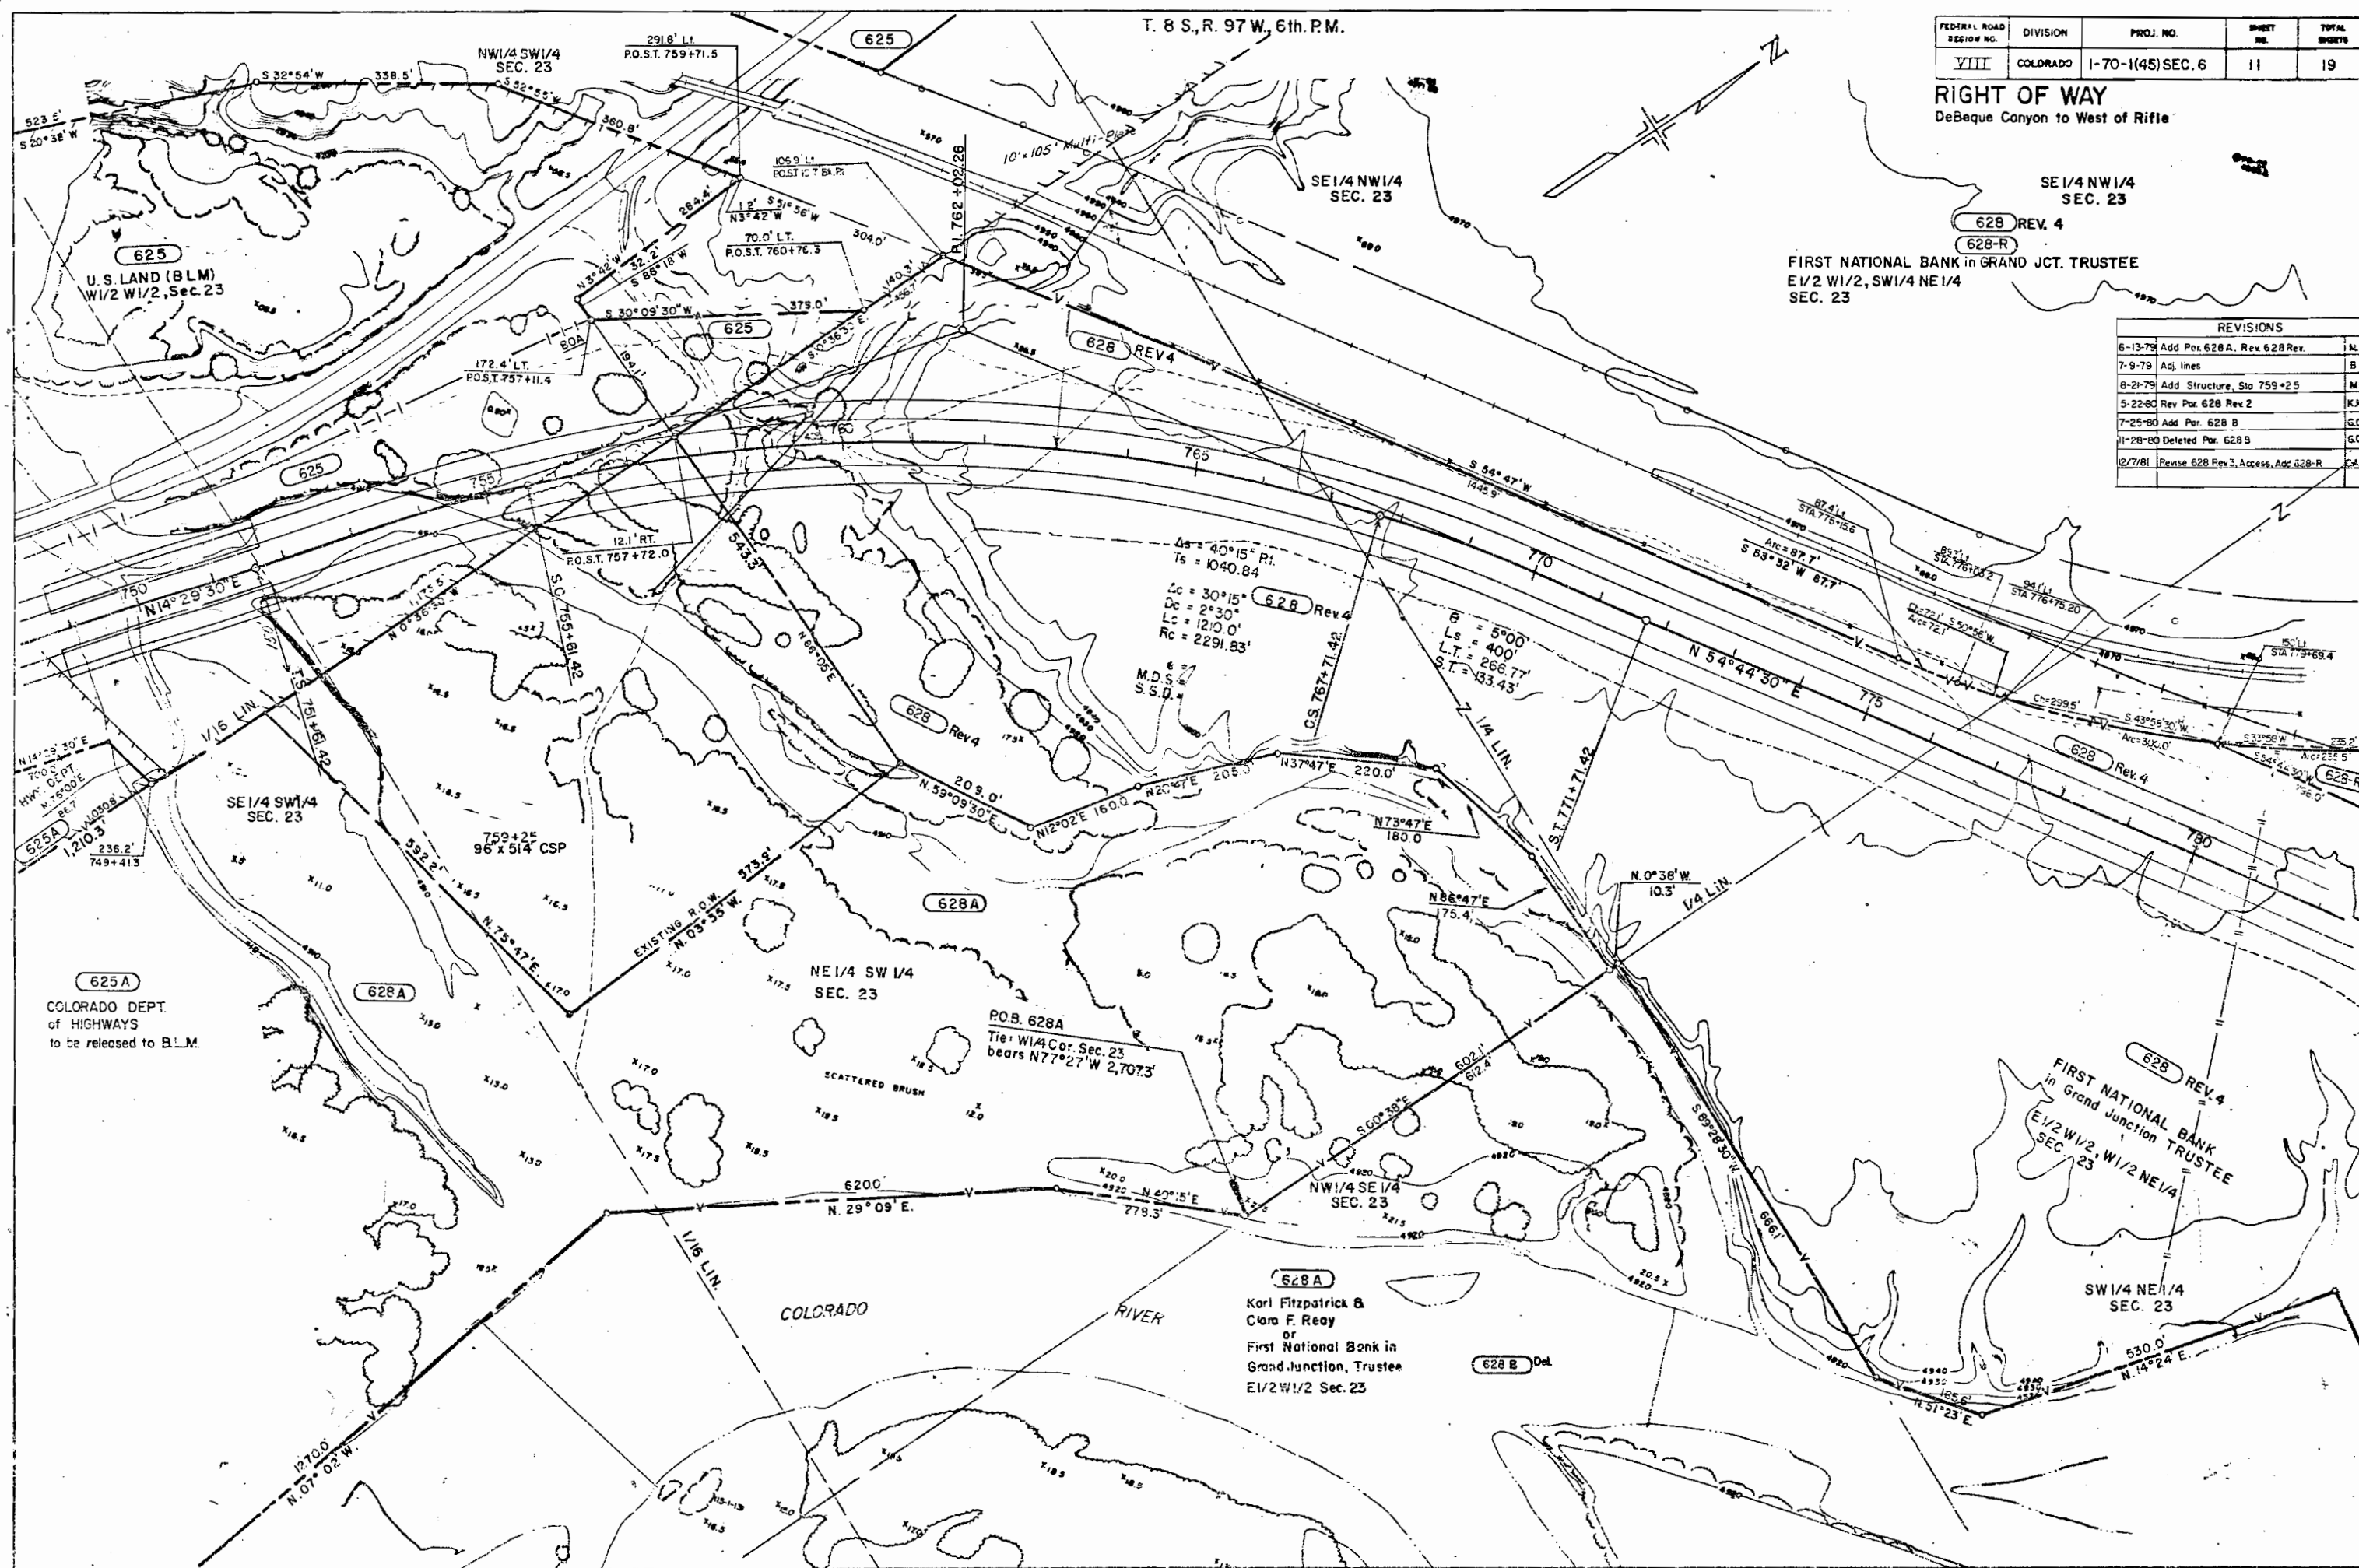

T.8 S. R.97 W. 6 P.M.

FEDERAL ROAD REG. NO.	DIVISION	PROJ. NO.	SHEET NO.	TOTAL SHEETS
VIII	COLORADO	170-1(45) Sec. 6	10	19

RIGHT OF WAY
De Beque Canyon to West of Rifle

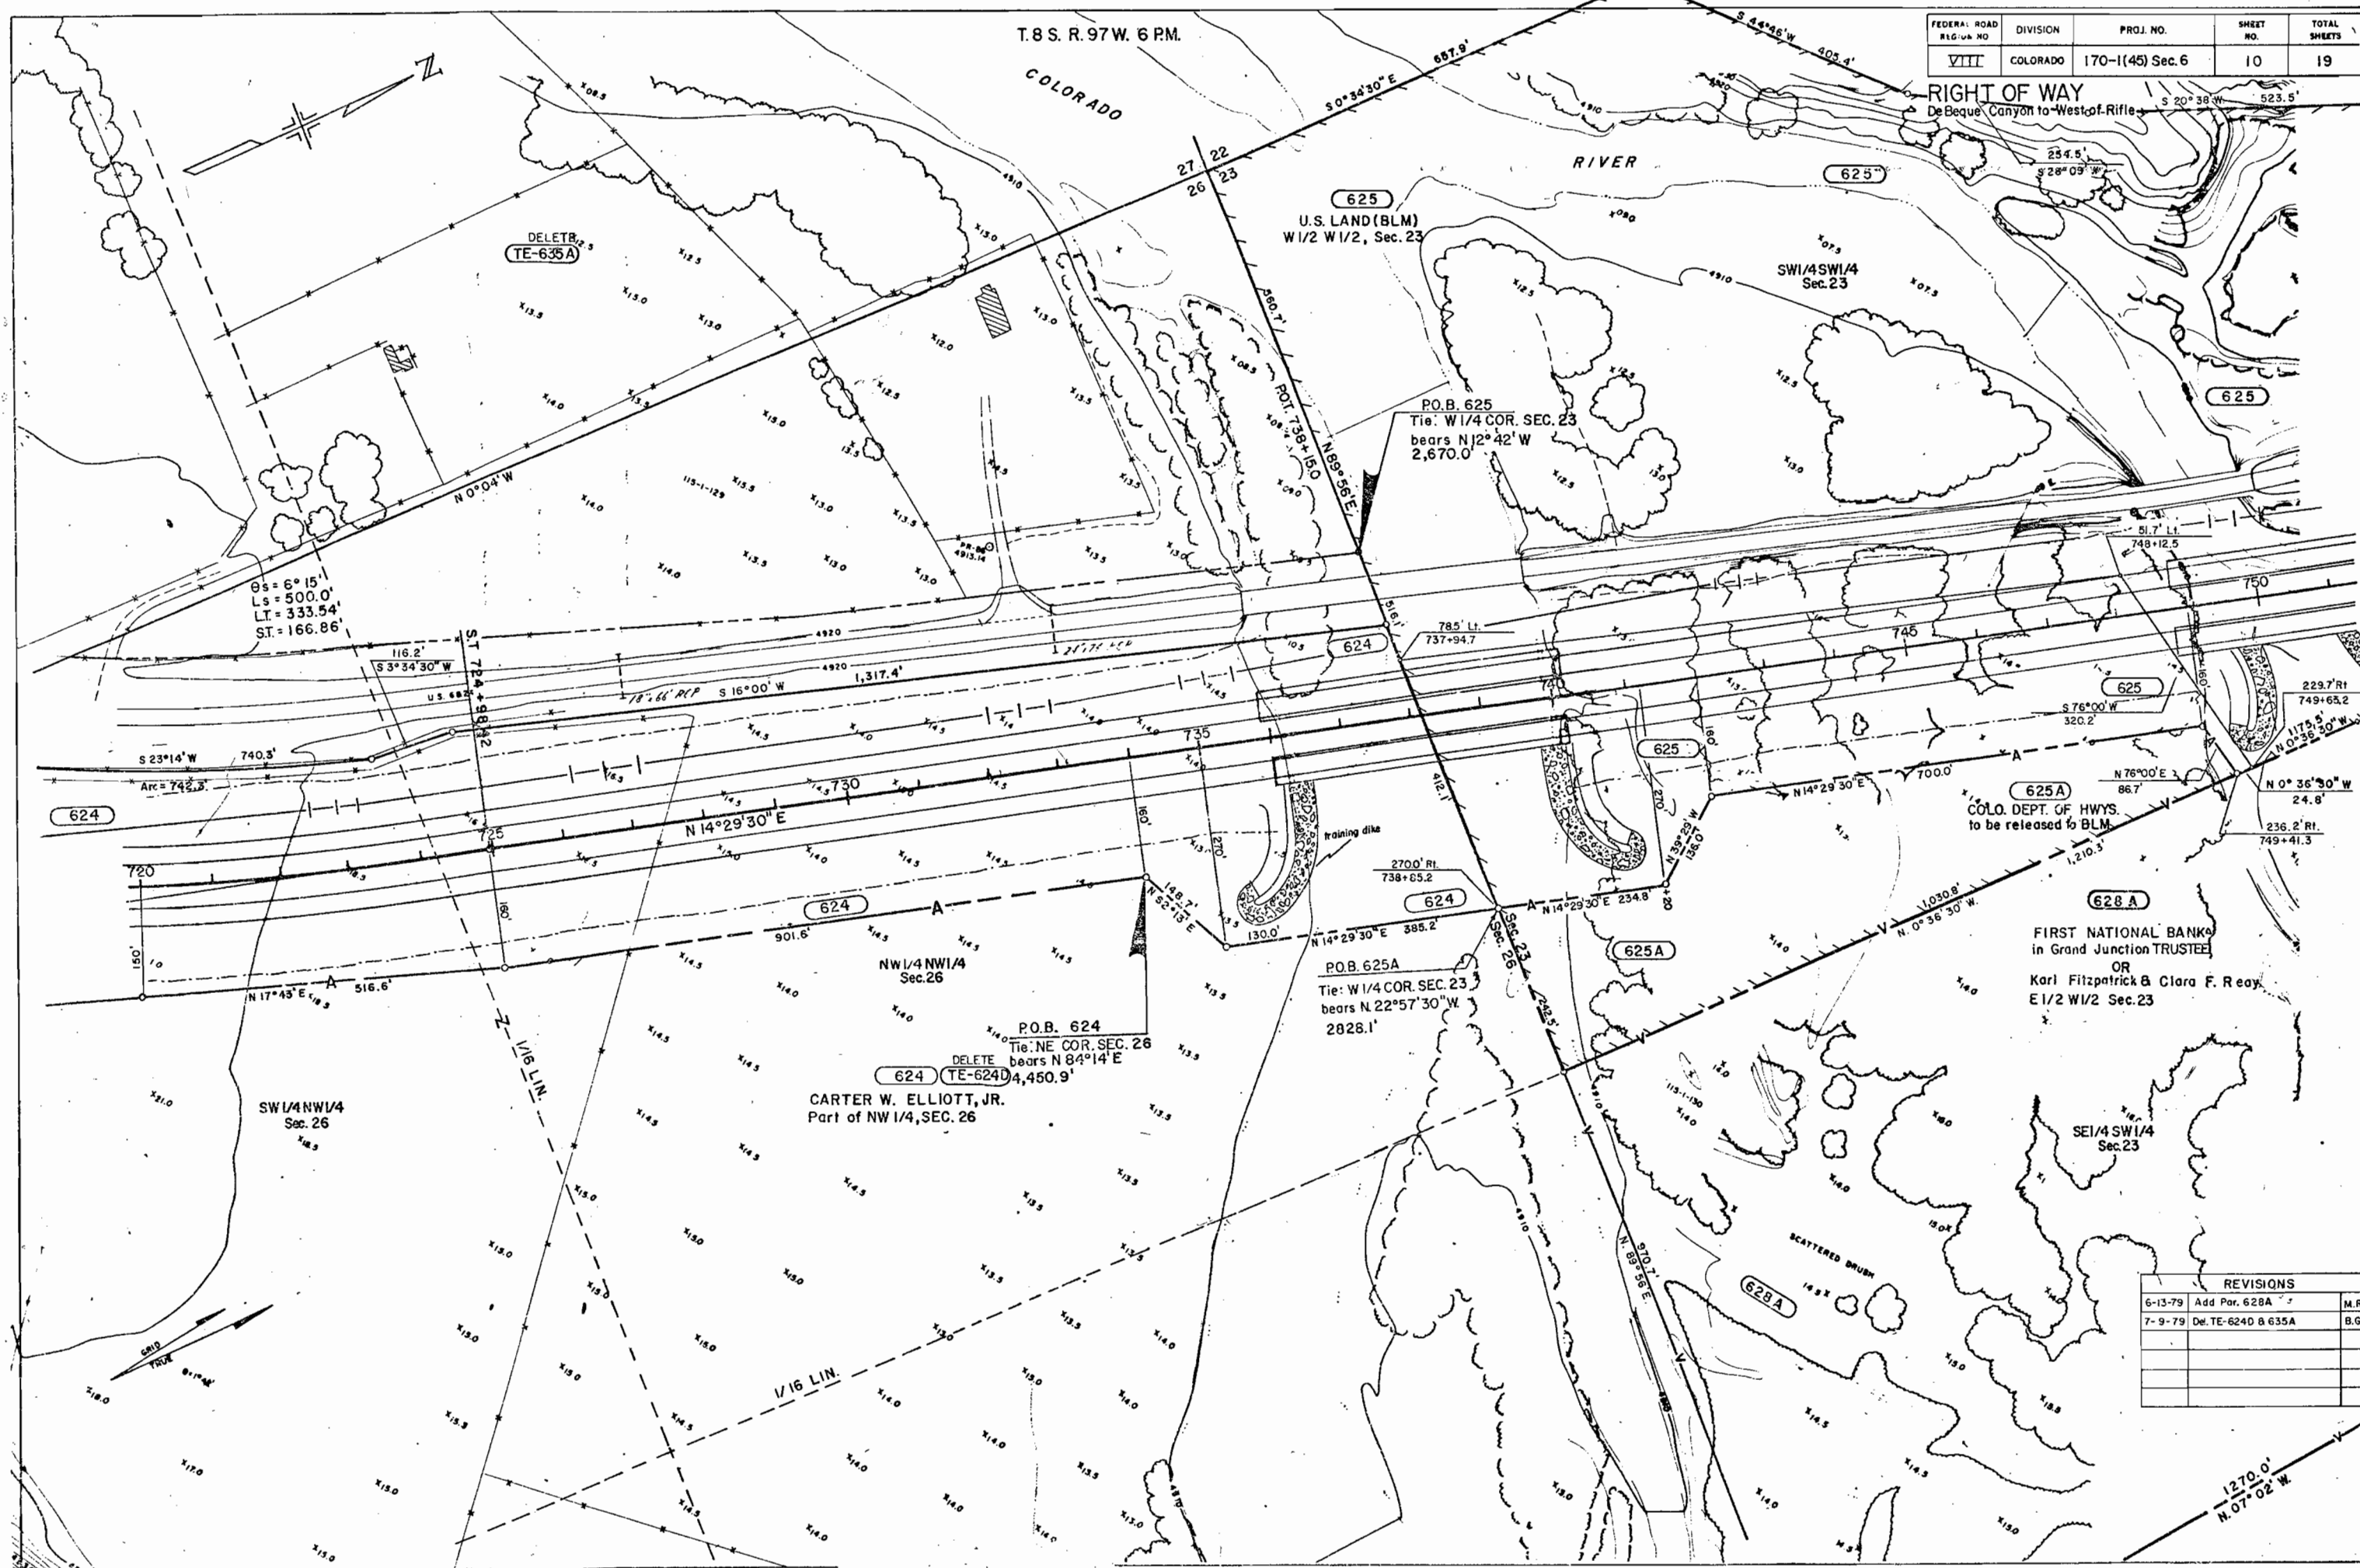

625A
COLO. DEPT. OF HWYS.
to be released to BLM

628A
FIRST NATIONAL BANK
in Grand Junction TRUSTEE
OR
Karl Fitzpatrick & Clara F. Reay
E 1/2 W 1/2 Sec. 23

REVISIONS		
6-13-79	Add Par. 628A	M.R.
7-9-79	Del. TE-624D & 635A	B.G.

1270.0'
N.07°02'W

W. 1/2, N.W. 1/4, Section 23

T. 8 S. R. 97 W.
6th P.M.

FED. ROAD DIST. NO.	STATE	PROJ. NO.	SHEET NO.	TOTAL SHEETS
VIII	COLO.	170-1(45)Sec 6	12	19

REVISIONS	


W. 1/2, S.W. 1/4, Section 23

P.O.B. 625
Tie: W 1/4 COR. SEC. 23
bears N 68° 15' 15" W
941.8'

625 U.S. LAND (BLM)
W 1/2 W 1/2 SEC. 23

E. 1/2, N.W. 1/4, Section 23

Δ: 59° 27' R
D: 3° 00'
T: 1090.5'
L: 19817'
R: 19100'

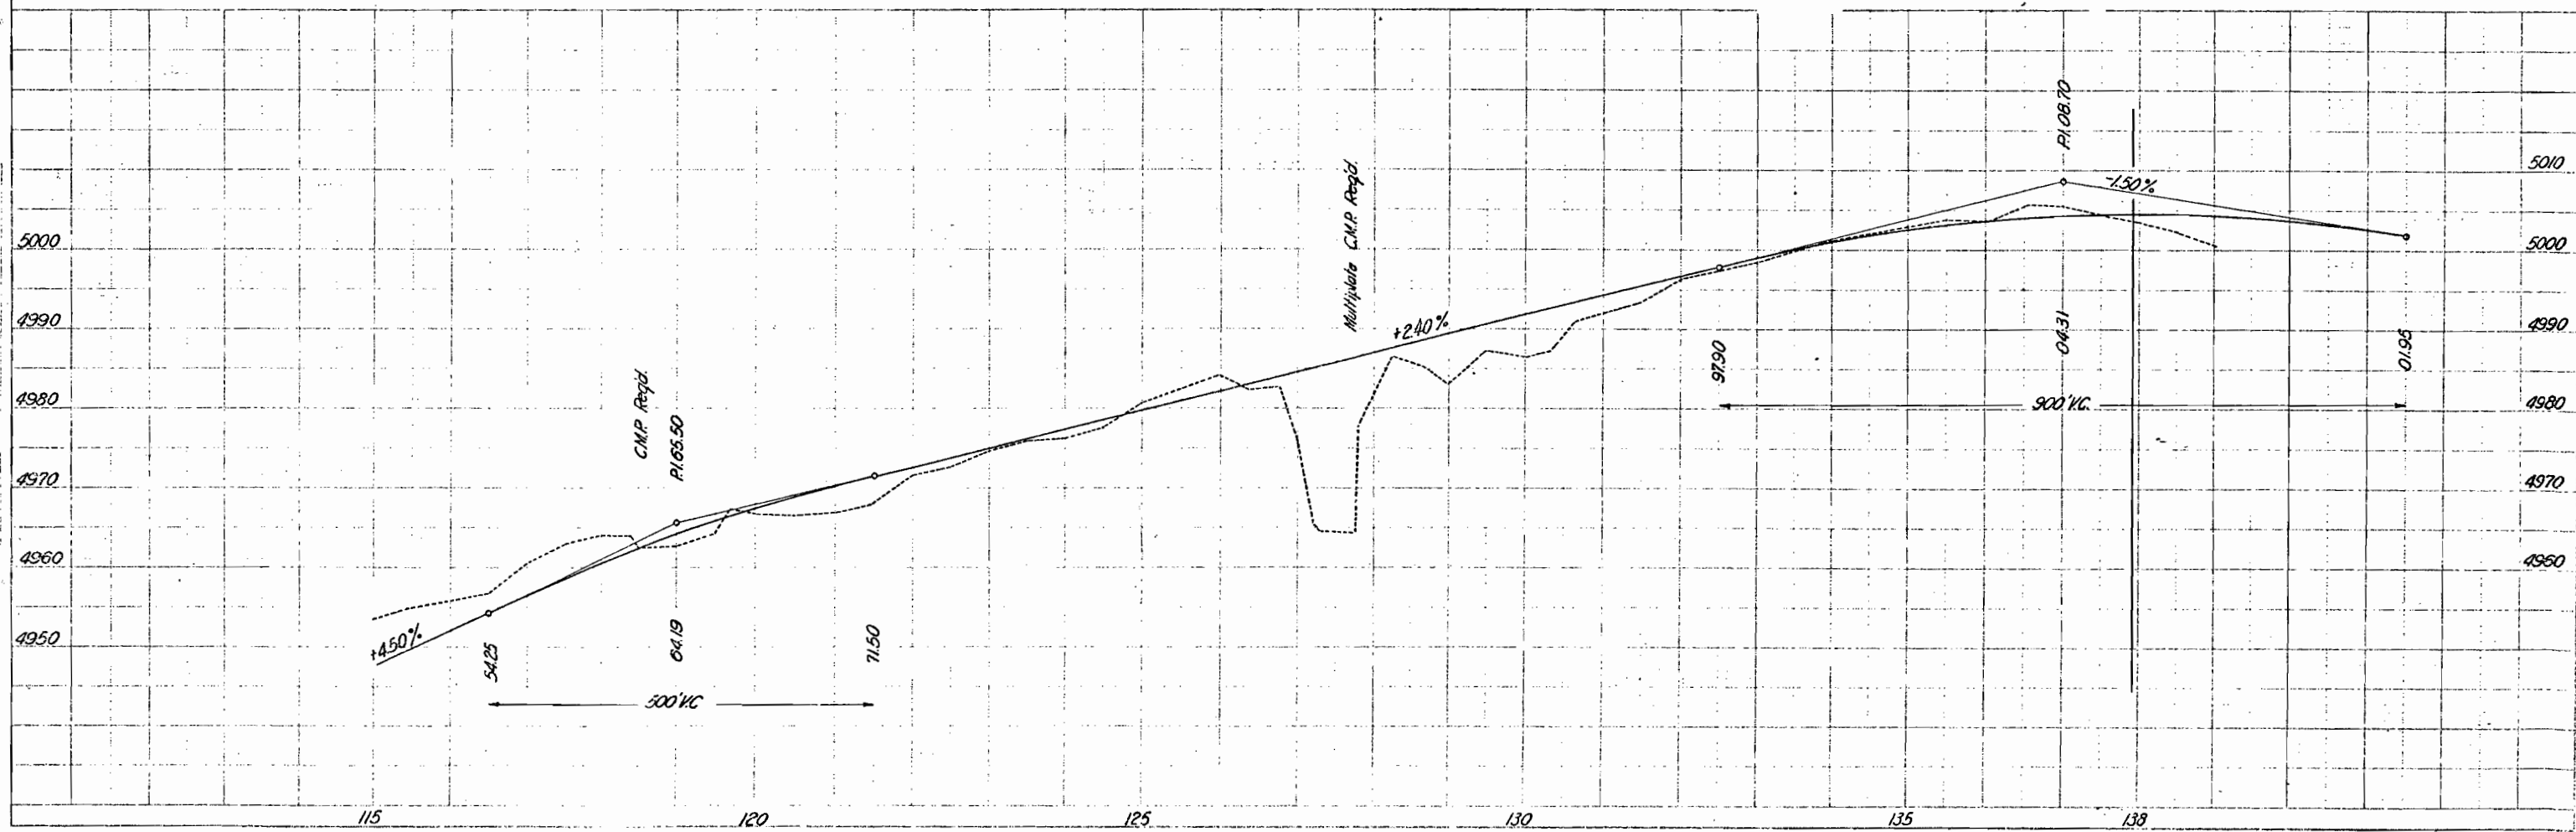


Art. Borden R.E.
C. Anderson

Art. Borden R.E.
C. Anderson

FEDERAL ROAD REGION NO.	DIVISION	PROJ. NO.	SHEET NO.	TOTAL SHEETS
VIII	COLORADO	1 70-1(45) SEC. 6	13	19

DeBeque Canyon to West of Rifle

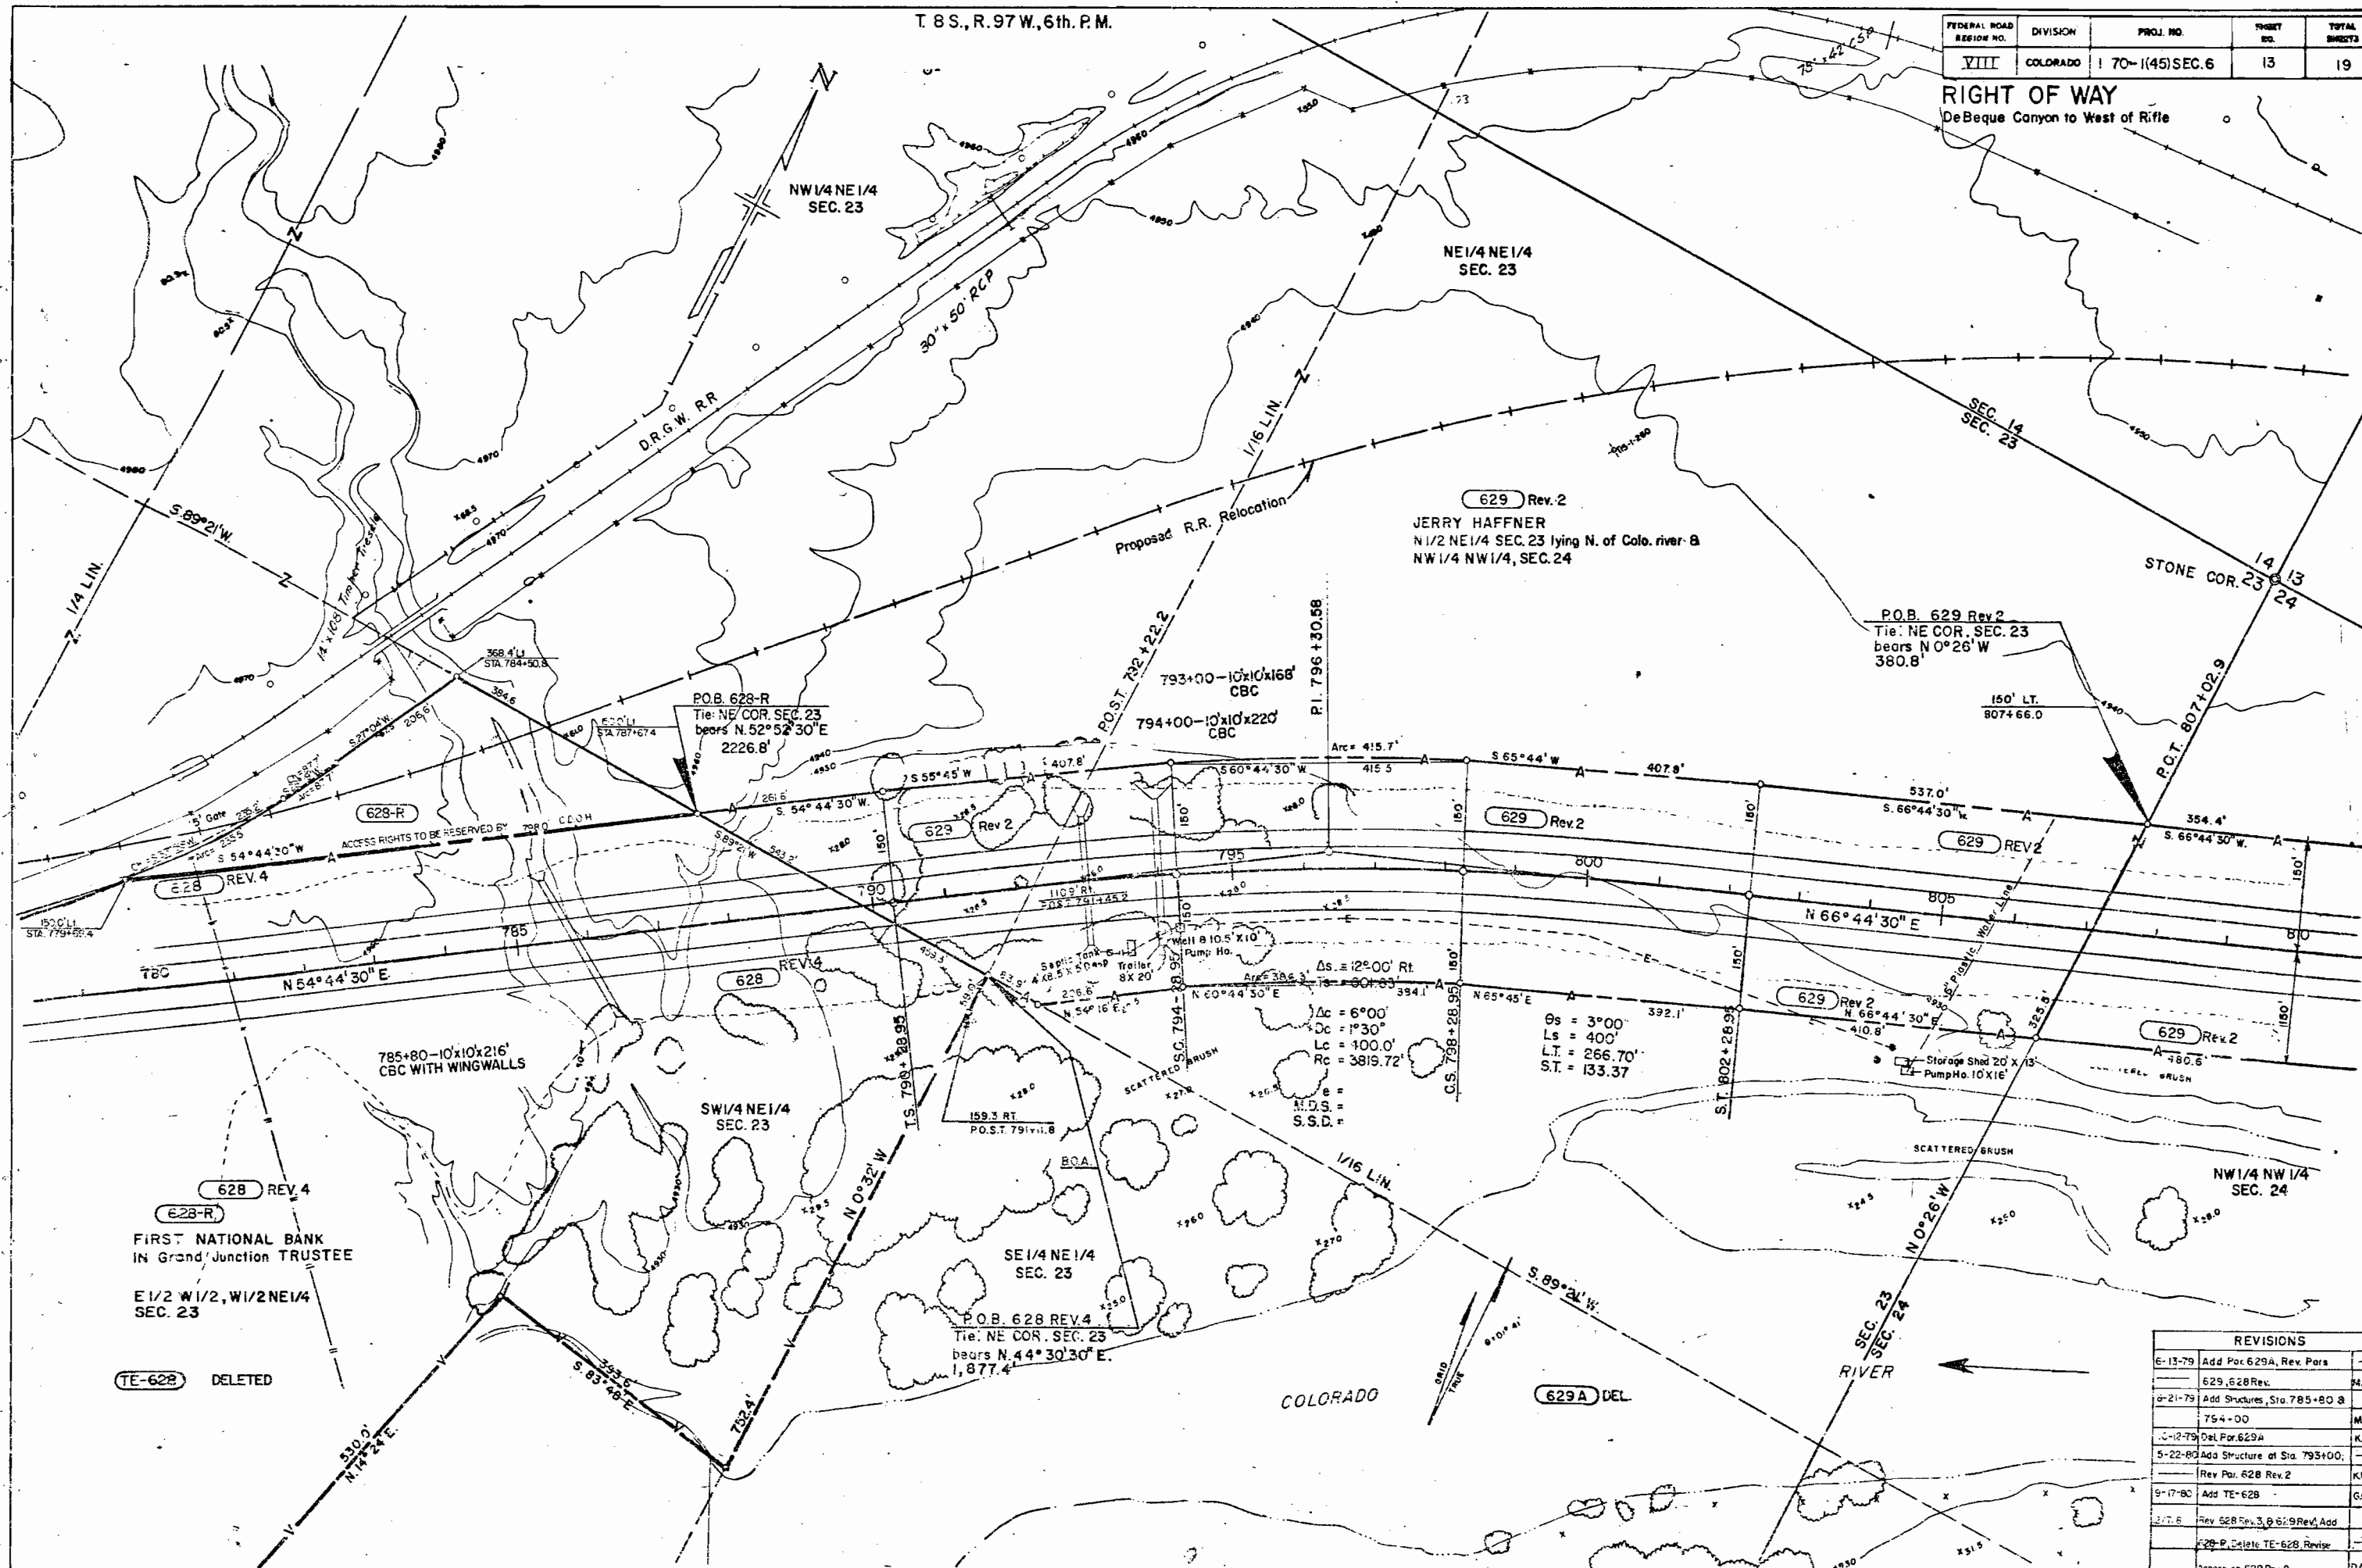

REVISIONS		
6-13-79	Add Par. 629A, Rev. Pars	
-----	529, 628 Rev.	84
6-21-79	Add Structures, Sta. 785+80 &	
	754 - 00	M
5-12-79	Del. Par. 629A	K
5-22-80	Add Structure of Sta. 793+00;	
	Rev. Par. 628 Rev. 2	K
9-17-80	Add TE-628	G
3-7-8	Rev. 528 Rev. 3, 629 Rev. Add	
	629 P, Delete TE-628 Revise	

[illegible]

REVISIONS		
6-13-79	Rev Pars 629,630,631,ER 600	M
7-9-79	Add TE-631A, S RAMP	B
1-5-80	Rev Par 631 Rev B TE-631 Rev Add Par 629B, Add Structures at Site 635 B 642	
	Add Barrier Line, Change Channel, Add	
	Pat. 631R	KM
5-22-82	Add PE-629B	KM
2-7-81	Add C30-RAH31 RA, Detek TE-631 Rev 2	K
	Revise 629 Rev B Access of 532	DA

FEDERAL ROAD REGION NO.	DISTRICT	PROJ. NO.	SHEET NO.	TOTAL SHEETS
VIII	COLORADO	170-1(45) SEC. 6	15	19


TE-631 Rev. 2 DELETED

631 632

FIRST NATIONAL BANK GRAND JCT. TRUSTEE
NE 1/4 SW 1/4, NW 1/4 SE 1/4
SEC. 13

RIGHT OF WAY
DeBeque Canyon to West of Rifle

REVISIONS	
6-13-75	Rev. Par. 631
1-9-80	Rev. TE-631 Rev. 8 631 Rev.
2-7-81	Delete TE-631 Rev. 2 Add 631-
	RA, Revise Access 632
	DAZ

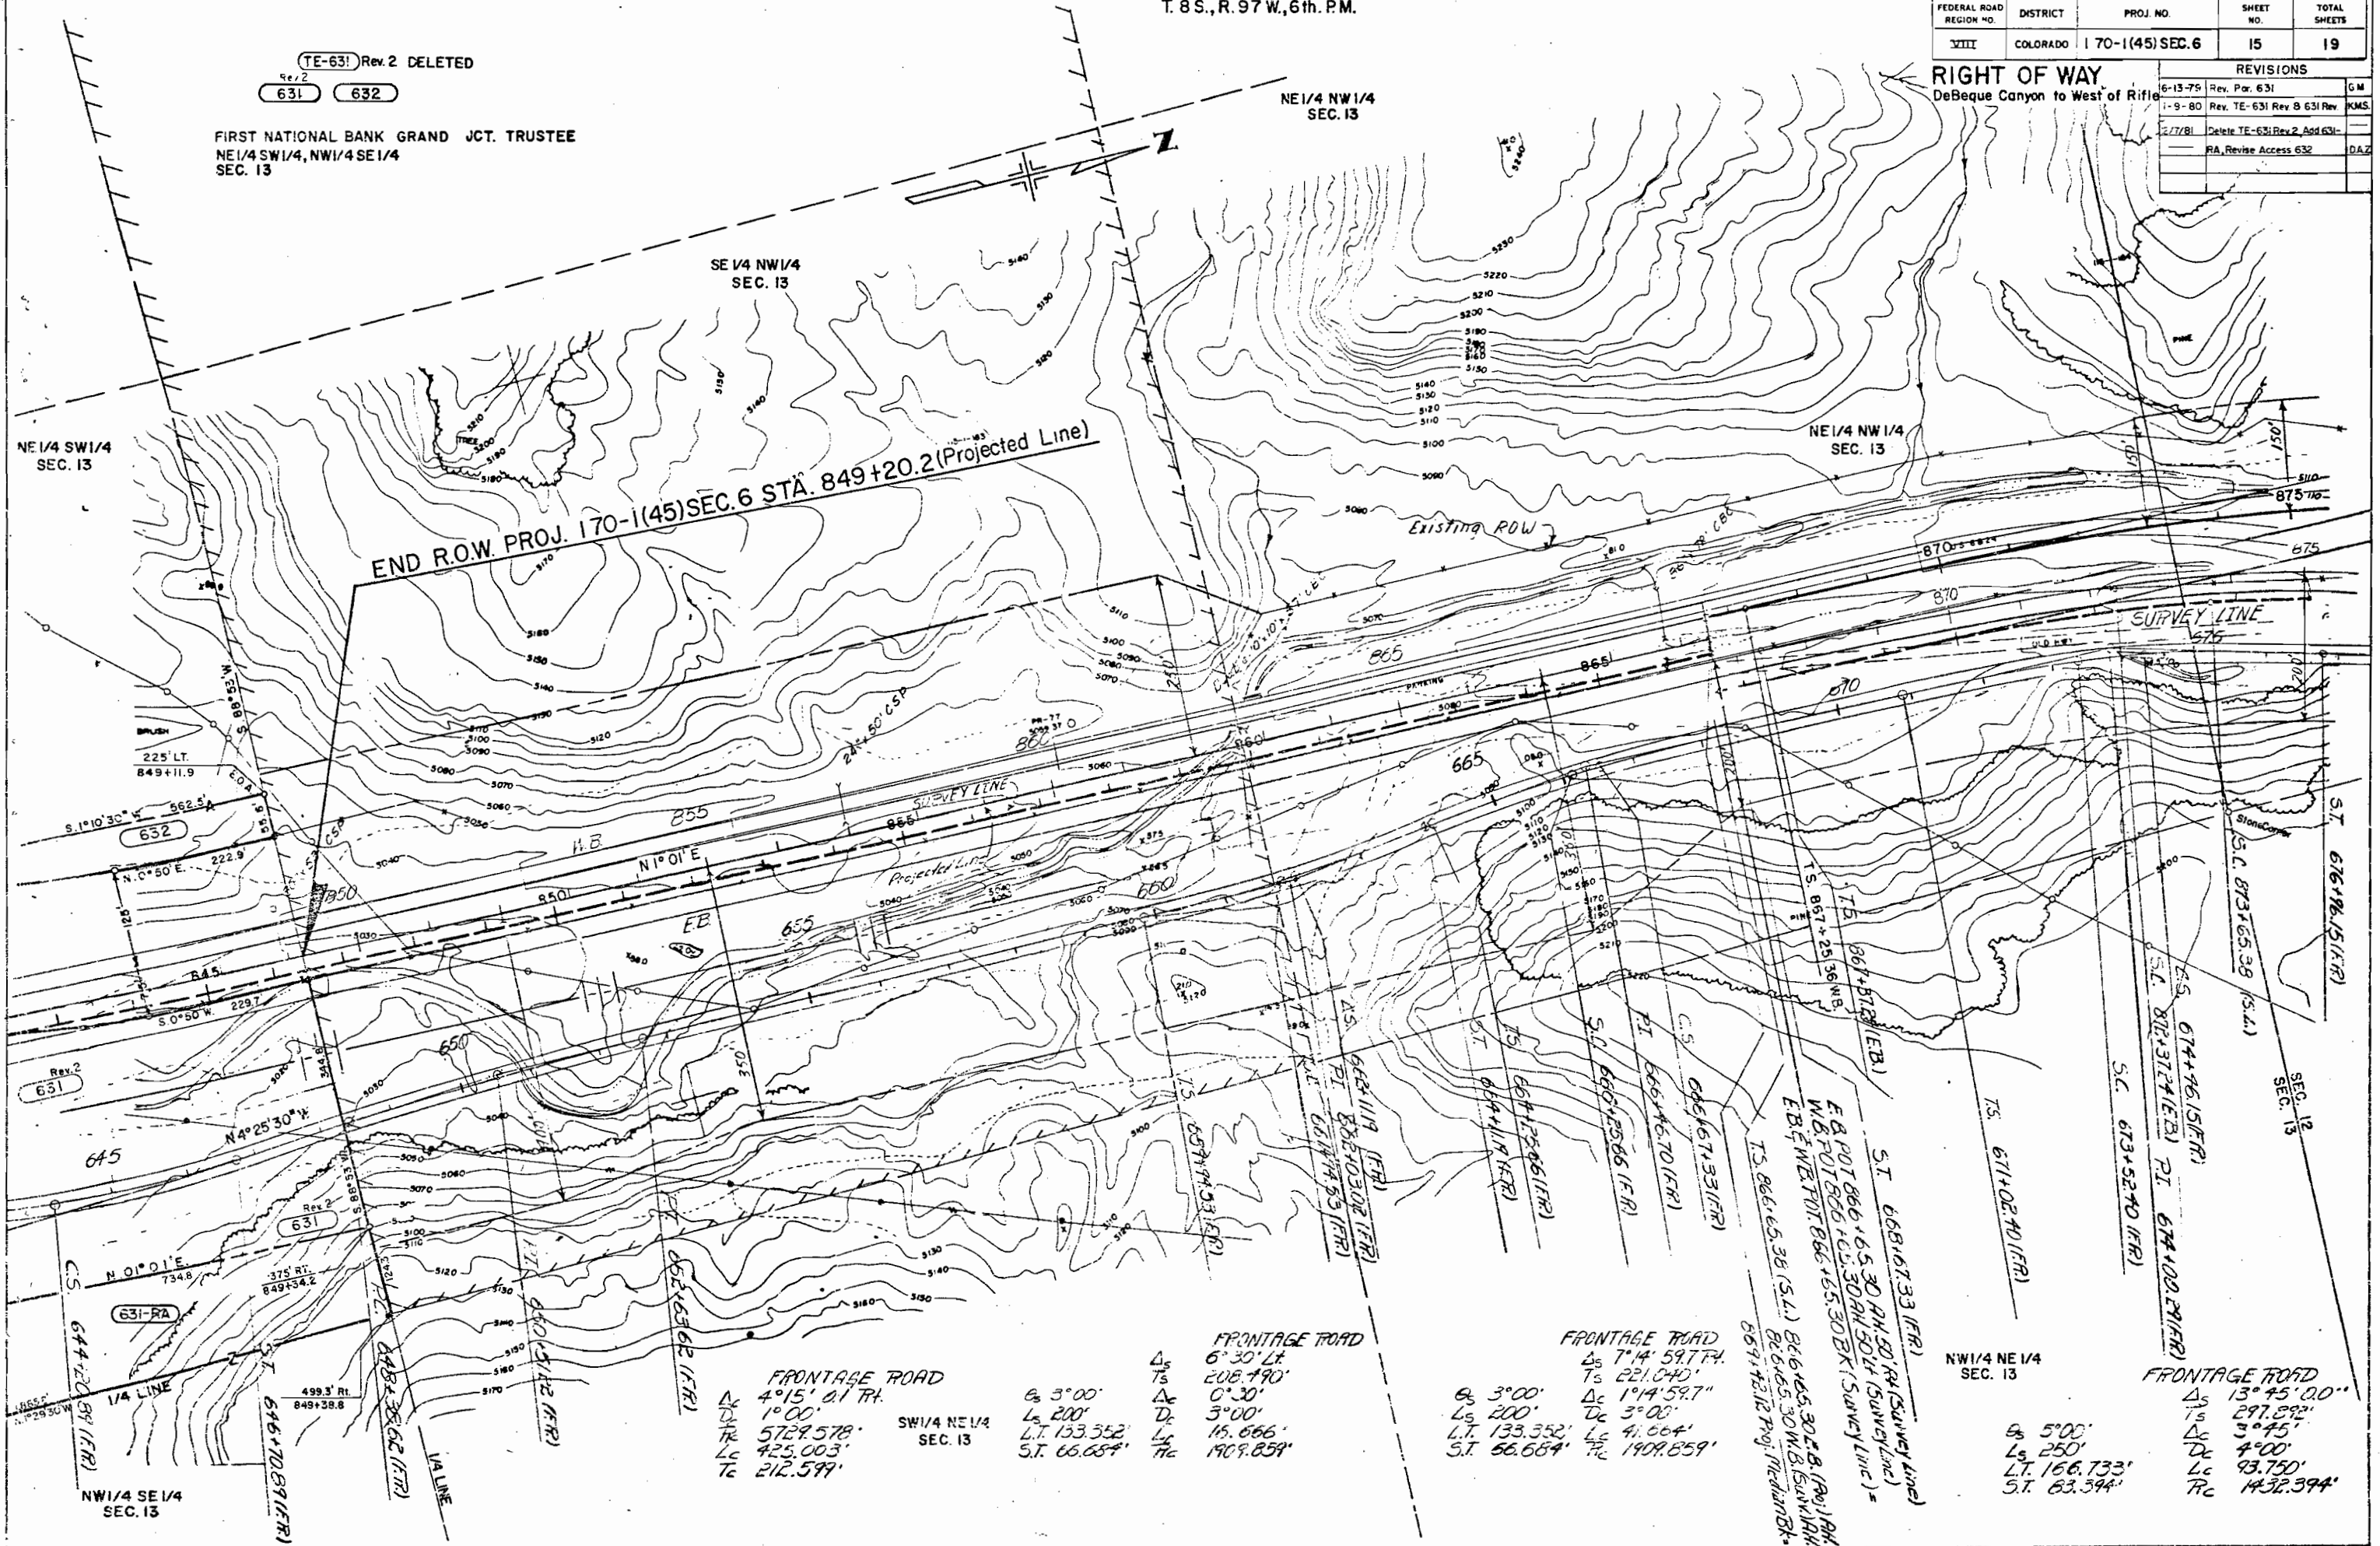

FRONTAGE ROAD
4°15' 01" RT.
1°00'
5729.578'
425.003'
212.599'

SW 1/4 NE 1/4
SEC. 13

6°3'00"
Ls 200'
L.T. 133.352'
S.T. 66.684'

FRONTAGE ROAD
6°30' LT.
208.490'
0°30'
3°00'
15.666'
190.859'

FRONTAGE ROAD
6°14' 59.77"
Ts 221.040'
6°14' 59.7"
Ts 3°00'
Ls 200'
L.T. 133.352'
S.T. 66.684'

NW 1/4 NE 1/4
SEC. 13

6°5'00"
Ls 250'
L.T. 166.733'
S.T. 83.394'

FRONTAGE ROAD
13°45' 00"
Ts 297.882'
13°45'
Ts 4°00'
Ls 250'
L.T. 166.733'
S.T. 83.394'

THE STATE DEPARTMENT OF HIGHWAYS
DIVISION OF HIGHWAYS—STATE OF COLORADO
PROJECT 170-1(45) Sec. 6
R.O.W. OWNERSHIP MAP

MESA COUNTY
T8S, T9S, R97 W. 6th PM.
Scale 1" = 400'


FEDERAL ROAD REGION NO.	DISTRICT	PROJ. NO.	SHEET NO.	TOTAL SHEETS
9	COLORADO	170-1(45)Sec. 6	17	19

RIGHT OF WAY

DEBEQUE CANYON TO WEST OF RIFLE

REVISIONS		
7-9-79	Rev. sheet	B.G.
8-21-79	Del. TE-620, Add TE-615AR	C.D.S.
10-12-79	Name change, per 609 Rev.	K.M.S.
	E610, 620	K.M.S.
12-4-80	Rev. For 616 Rev.	R.M.

ELMER RICE aka ELMER R. RICE
& RUTH E. RICE, J.T.
BLOCK 3, SPECK'S SUBDIVISION
in Sec. 27

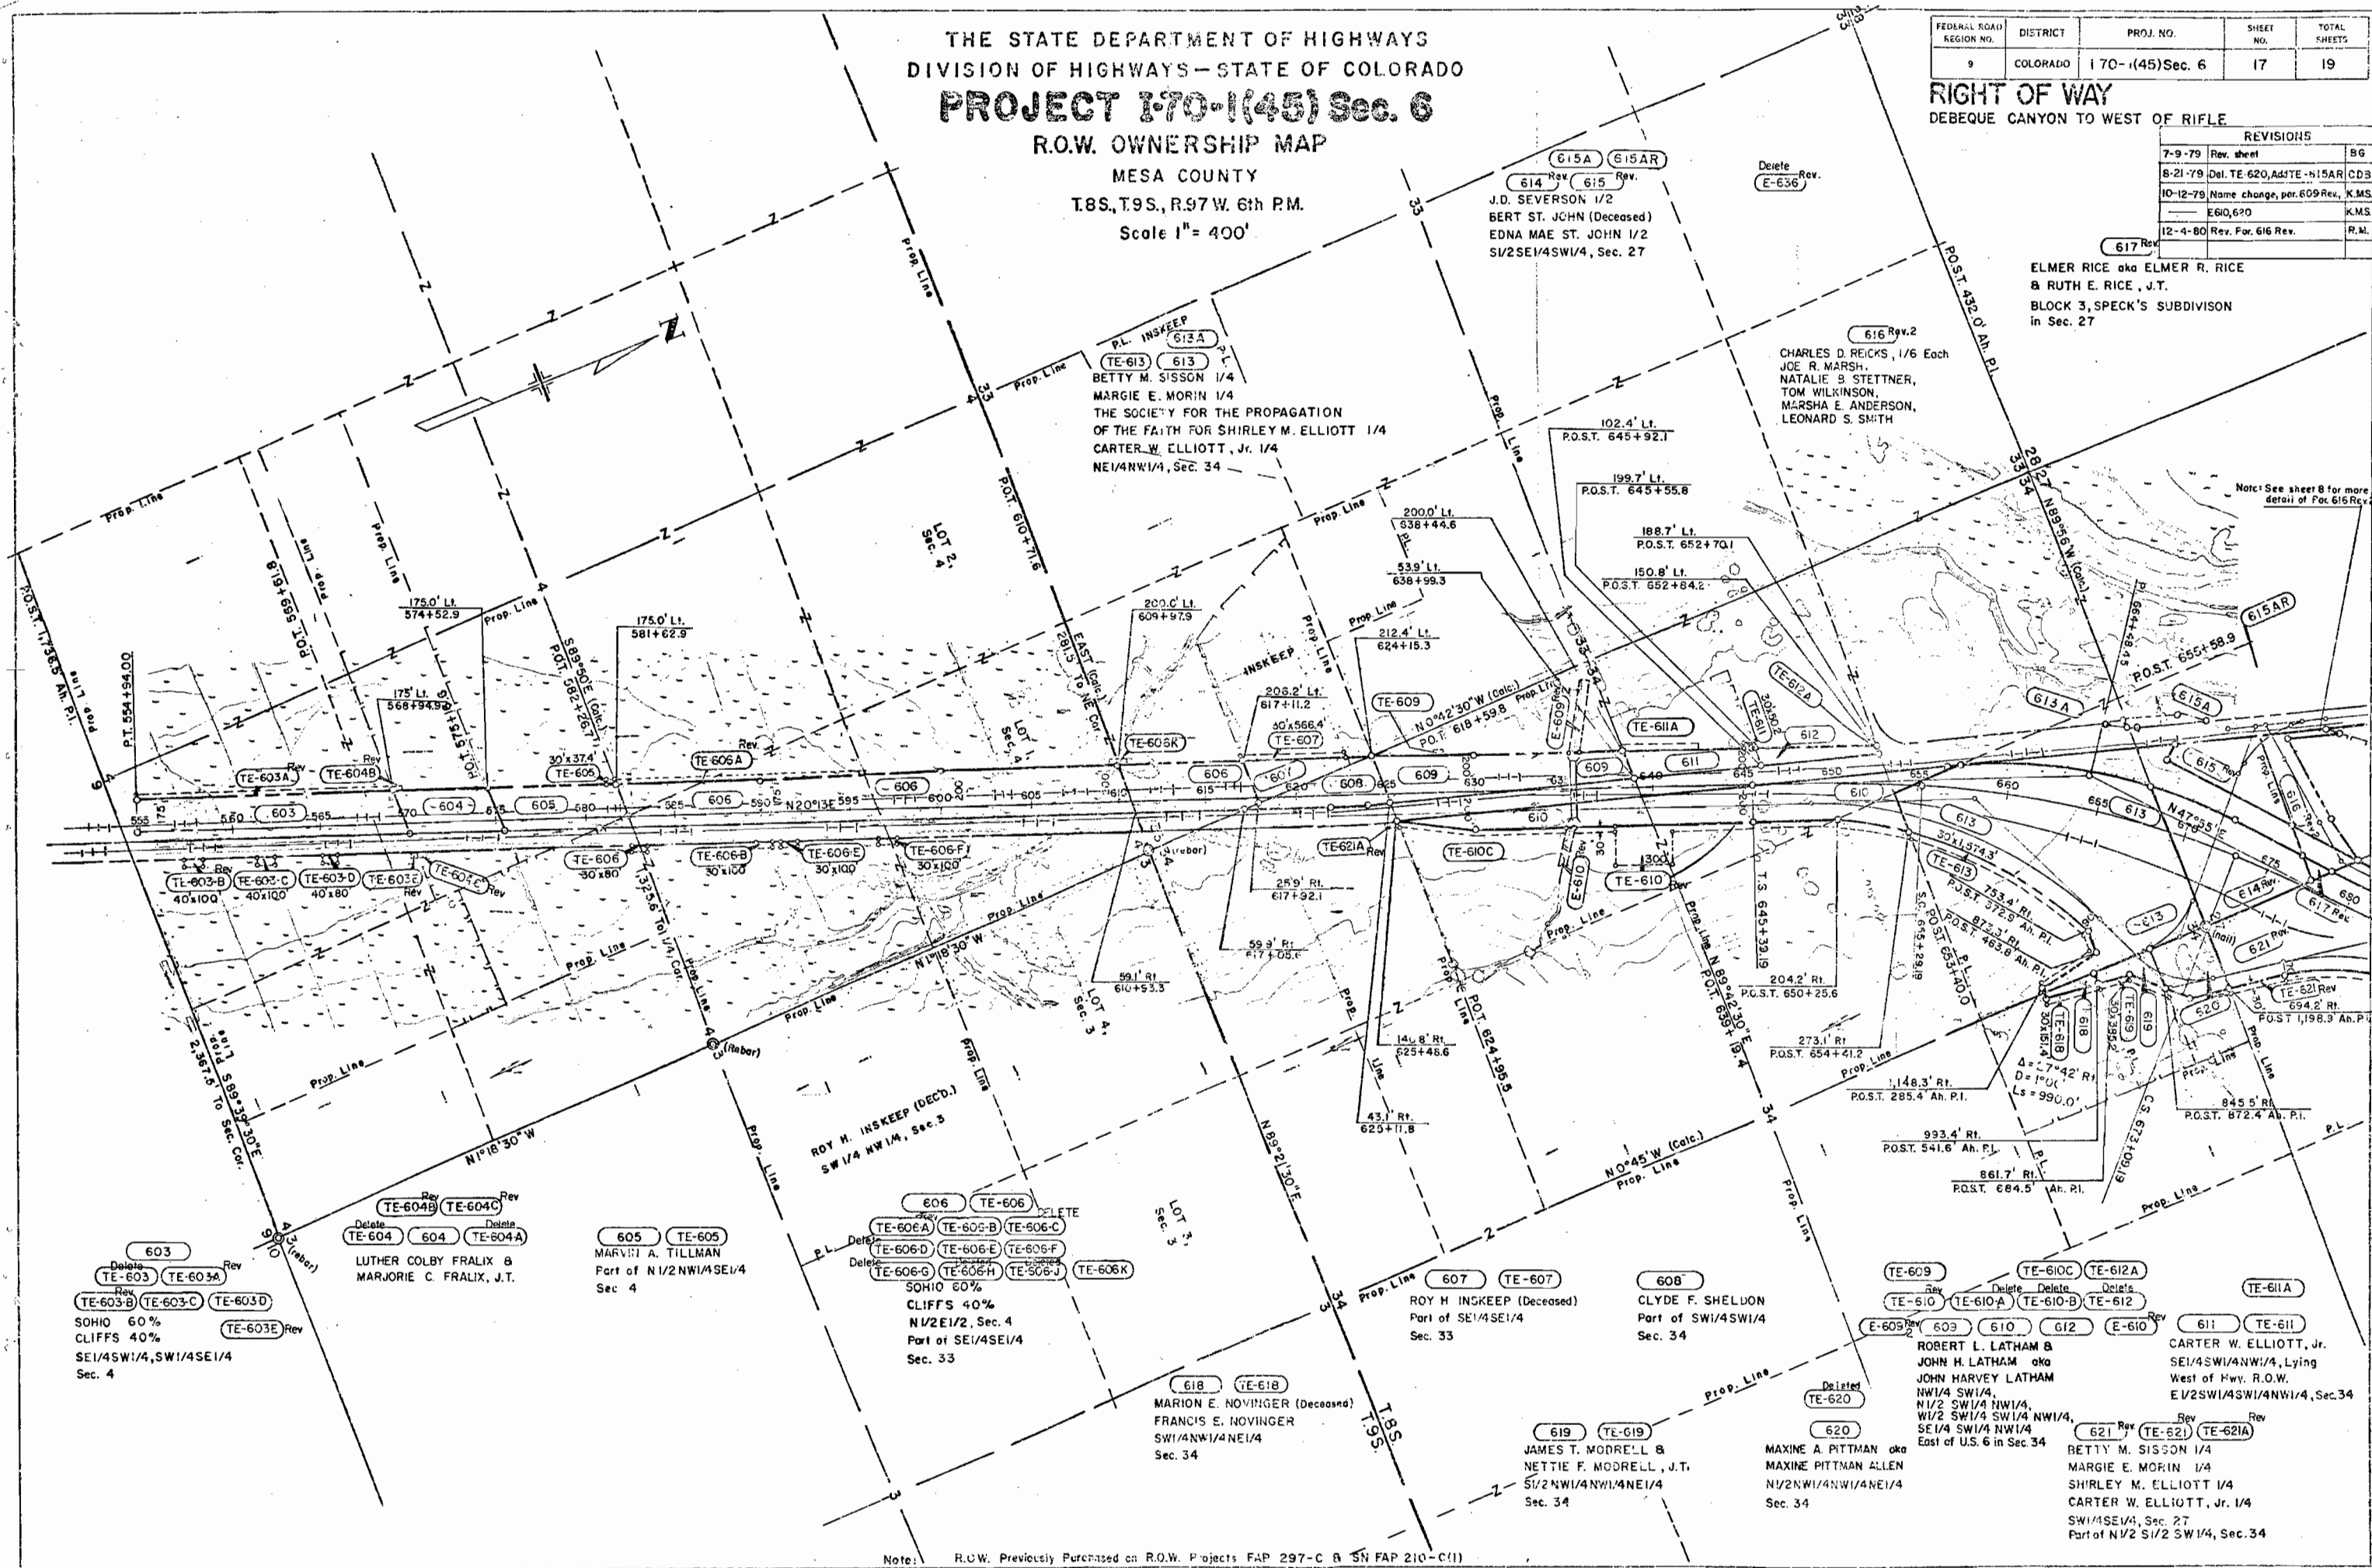

Note: R.O.W. Previously Purchased on R.O.W. Projects FAP 297-C & SW FAP 210-C(1)

THE STATE DEPARTMENT OF HIGHWAYS
DIVISION OF HIGHWAYS—STATE OF COLORADO
PROJECT 170-1(45) Sec. 6
R.O.W. OWNERSHIP MAP
MESA COUNTY
T.8S., R.97W., 6th P.M.
Scale 1" = 400'

FEDERAL ROAD REGION NO.	DISTRICT	PROJ. NO.	SHEET NO.	TOTAL SHEETS
9	COLORADO	170-1(45) SEC. 6	18	19

RIGHT OF WAY
DEBEQUE CANYON TO
WEST OF RIFLE

613 TE-613 613A
BETTY M. SISON 1/4
MARGIE E. MORIN 1/4
THE SOCIETY FOR THE
PROPAGATION OF THE
FAITH FOR SHIRLEY M. ELLIOTT 1/4
CARTER W. ELLIOTT, JR. 1/4
NE 1/4 NW 1/4, SEC. 34

614 Rev. 615 Rev. 615A 615AR

J.D. SEVERSON 1/2
BERT ST. JOHN (Deceased)
EDNA MAE ST. JOHN 1/2
S 1/2 SE 1/4 SW 1/4, Sec. 27

616 Rev. 2

Charles D. Reicks (1/6), Tom Wilkinson (1/6),
Joe R. Marsh (1/6), Marsha E. Anderson (1/6)
Natalie B. Stettner (1/6), Leonard S. Smith (1/6)

617 Rev.

ELMER RICE and ELMER L. RICE &
RUTH E. RICE, L.T.
BLK 3 of SPECK'S SUBDIVISION in
SEC. 27

618 TE-618

MARION E. NOVINGER (Deceased)
FRANCES E. NOVINGER,
SW 1/4 NW 1/4 NE 1/4,
E 1/2 NW 1/4 NE 1/4, Sec. 34

PE-615AR

CDOH GRANTED EASEMENT
TO P.S.CO.

Note: See sheet 8 for more
detail of Par. 615 Rev. 2

REVISIONS		
6-13-79	Adc Par. 628A, Rev. 628 Rev.	GM
7-9-79	Rev. sheet	B.G.
8-2-79	Del. TE-624C, Add TE-622A, 615AR	CDB
—	Del. TE-620	—
10-12-79	Name change, par. 620, 623	R.M.S.
2-14-80	Add Par. PE-615AR	R.M.
12-4-80	Rev. Par. 616 Rev.	R.M.
6-5-80	Rev. Par. 628 Rev. 2	G.C.F.
12-7-81	Revise 628 Rev. 3	D.A.Z.

Note: R.O.W. Previously Purchased on R.O.W. PROJ. SN FAP 210-C(1)


THE STATE DEPARTMENT OF HIGHWAYS
DIVISION OF HIGHWAYS—STATE OF COLORADO
PROJECT I-70-1(45) SEC. 6
R.O.W. OWNERSHIP MAP

MESA COUNTY
T8S,R.97W, 6th PM.
Scale 1" = 400'

FEDERAL ROAD REGION NO.	DISTRICT	PROJ. NO.	SHEET NO.	TOTAL SHEETS
9	COLORADO	I 70-1(45) SEC. 6	19	19

RIGHT OF WAY
DE BEQUE CANYON WEST OF RIFLE

REVISIONS			
6-13-79	Add Par. 628A, 629A, Rev.		
	Paras 628 Rev., 629, 630, 631		
	ER-600, TE-631		GM
10-12-79	Del. 629 A		KMS.
1-9-80	Rev Par. 631 Rev. 8 TE-631 Rev.		
	Add Par. 629B & 631R		KMS.
6-5-80	Add PE 629B, Rev. 628 Rev. 2		G.C.F.
7-25-80	Add Par. 628B		GM
9-17-80	Add TE-628		G.C.F.
11-28-80	Deleted Par. 628 B		G.C.F.
12-7-81	Rev. 629 Rev. Access 632, 628 Rev. 3		
	Add 631-RA, 630-R, 628-R		
	Delete TE-631 Rev. 2, TE-628		DAZ

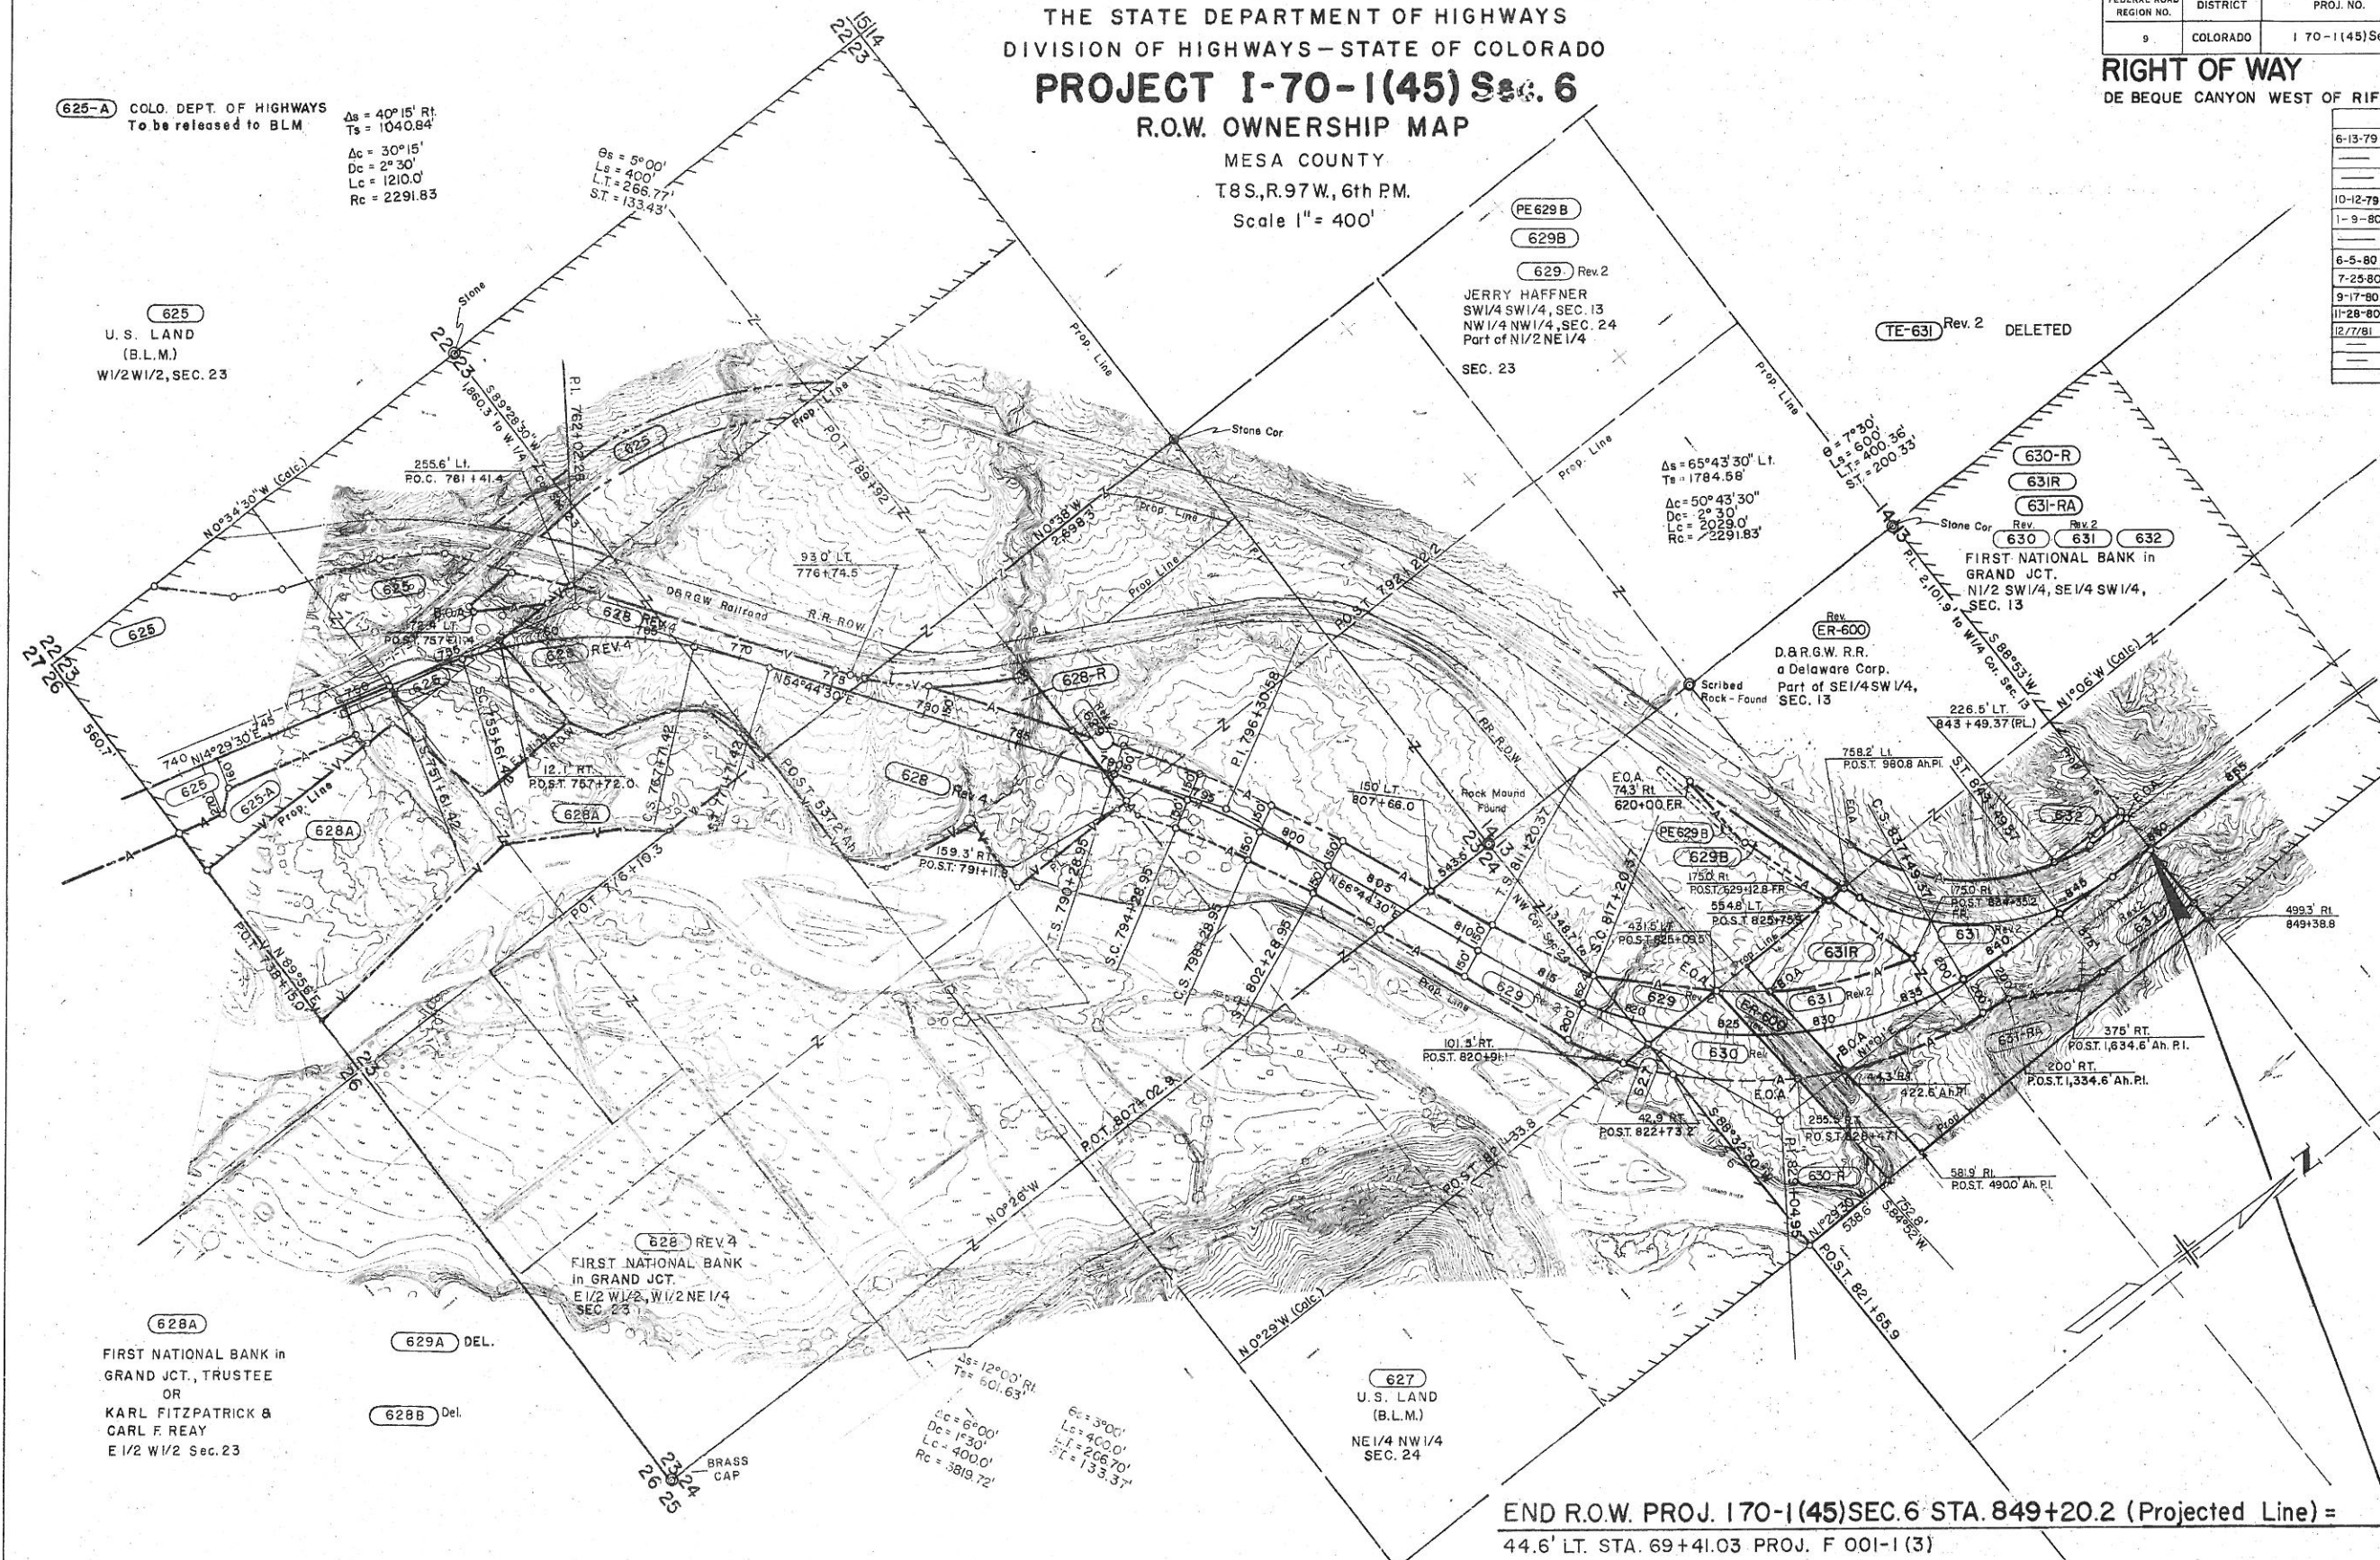

END R.O.W. PROJ. I 70-1(45) SEC. 6 STA. 849+20.2 (Projected Line) =
44.6' LT. STA. 69+41.03 PROJ. F 001-1 (3)

NOTE: OLD R.O.W. PREVIOUSLY PURCHASED ON PROJ. F 001-1 (3)