

STATE DEPARTMENT OF HIGHWAYS DIVISION OF HIGHWAYS - STATE OF COLORADO

P.E., R.O.W. and Utilities
under Project I 70-3(125)

FED. ROAD REGION	DIVISION	PROJECT NUMBER	SHEET NUMBER
XXX	COLO.	I 70 - 3(140)	1

AS CONSTRUCTED		
NO REVISIONS	REVISED	VOID
	12-12-88	

REVISIONS		

PLAN AND PROFILE OF PROPOSED ~~AS CONSTRUCTED~~ FEDERAL AID PROJECT NO. I 70-3(140) STATE HIGHWAY NO. 470 JEFFERSON COUNTY

TABULATION OF LENGTH


STATION TO STATION	LINEAR FEET	
	ROADWAY	MAJOR STRUCTURE
STA 335+96.60 Begin I 70-3(140)= STA 231+97.08 Ramp A, 102' RL on I-IR 70-3(137) M.P. = 259.45	3352.07	
STA. 369+48.67 End I 70-3(140)= STA. 1207+17.30 Ramp D, 90' Lt. on I-IR 70-3(143) M.P. = 260.08		
SH 470 - NORTH BOUND 28+00	438.71	
32+38.71 STRUCTURE NO. F-16-KW		311.36
35+50.07	584.05	
41+34.12		
SH 470 - NORTH BOUND and SOUTH BOUND 41+34.12	3065.88	
72+00.00		
RAMP A 231+97.08	935.42	
241+32.50 STRUCTURE NO. F-16-KY		202.67
243+35.17	1015.38	
253+51.05		
RAMP B 1412+32.10	1713.96	
1429+47.06		
RAMP C 423+32.46	2717.54	
450+50.00		
RAMP D 1207+17.30	1480.33	
1221+97.63 STRUCTURE NO. F-16-KZ		187.08
1223+84.71	923.57	
1233+08.28 STRUCTURE NO. F-16-XX		281.08
1235+89.36	544.76	
1241+34.12		
RAMP F 28+00	378.05	
31+78.05		
TOTALS	13,798.15	982.19
SUMMARY	LINEAR FEET	MILES
ROADWAY - NET LENGTH	13,798.15	2.613
MAJOR STRUCTURES	982.19	0.186
PROJECT GROSS LENGTH	14,780.34	2.799

SCALES OF ORIGINAL DRAWINGS

ON PLAN, 1 IN. = 100 FT.
ON PROFILE { 1 IN. = 100 FT. HORIZONTAL
1 IN. = 10 FT. VERTICAL

SHEET NO.	INDEX OF SHEETS
1	TITLE SHEET
2	STANDARD PLANS LIST
3-4	TYPICAL SECTIONS
5	GENERAL NOTES AND TABULATION OF DRAINAGE ITEMS
6-8	SUMMARY OF APPROXIMATE QUANTITIES
9	TABULATION OF SURFACING AND TREATED SUBGRADE
10	TABULATIONS OF GUARD RAIL AND DELINEATORS
11	GUARD RAIL DETAILS FOR OBSTRUCTION IN MEDIAN
12	GUARD RAIL DETAILS - S.W. 470 AND RAMP D GORE AREA AND DETAIL OF MODIFY INLET
13	DETAIL FOR CONNECTION OF GUARD RAIL TYPE 4 TO BRIDGE RAIL TYPE 4 SPECIAL
14-23	LIGHTING PLANS
24-26	I 70/S.H. 470 INTERCHANGE PLAN SHEETS
27-31	S.H. 470 AND RAMP PROFILES
32-55	SIGNING PLANS
56	STANDARD M-203-11 SUPERELEVATIONS OF CURVES - DIVIDED HIGHWAYS - SHOULDER PIVOT (SPECIAL FOR THIS PROJECT)
57	STANDARD M-203-13 SUPERELEVATIONS OF CURVES - DIVIDED HIGHWAYS - CENTER PIVOT (SPECIAL FOR THIS PROJECT)

NEW AND REVISED STANDARDS
M-606-12 GUARD RAIL TYPE 4 CONCRETE BARRIER (9 SHEETS) 2-18-83

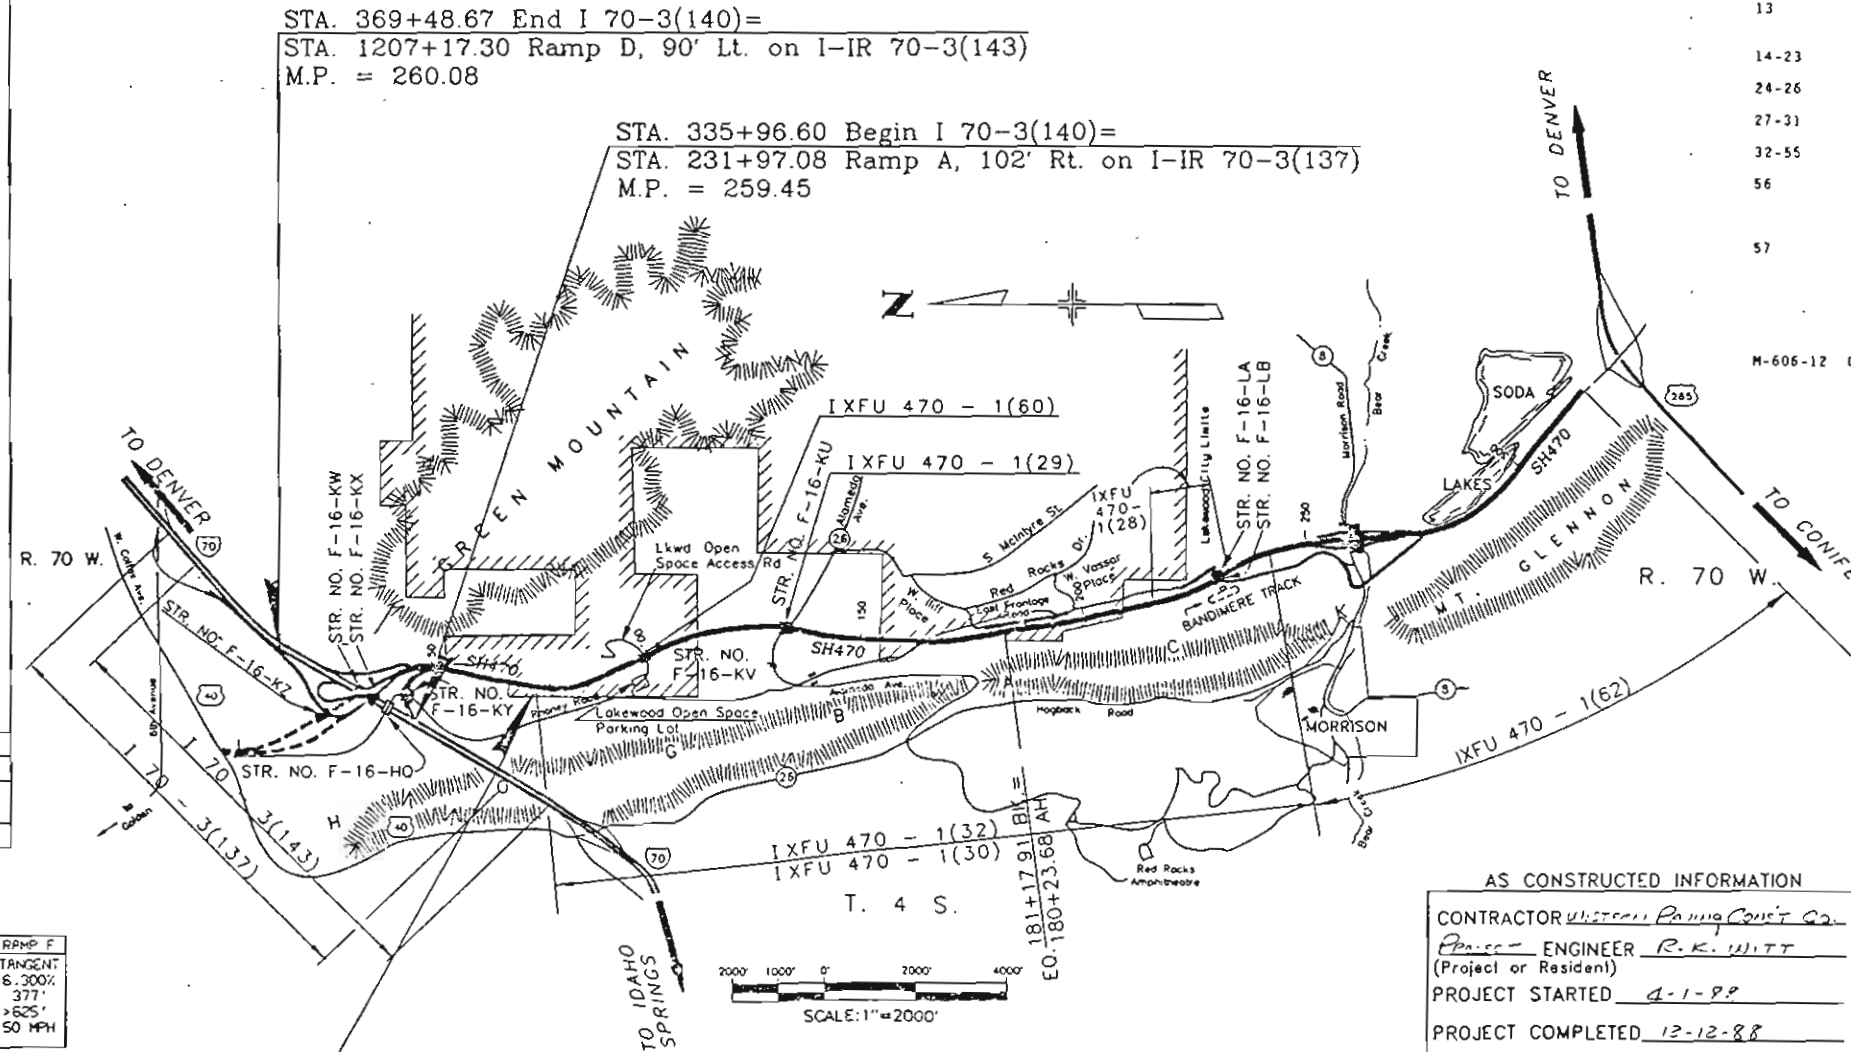

STA. 72+00.00 End Work
on SH 470 Mainline

DESIGN DATA

	SH 470	RAMP A	RAMP B	RAMP C	RAMP D	RAMP F	TANGENT
Max. Degree of Curve	5' 00' 00"	12' 00' 00"	20' 00' 00"	3' 30' 00"	12' 00' 00"	12' 00' 00"	6.300%
Minimum Grade	6.000%	5.728%	5.244%	5.1403%	2.7187%	6.300%	377'
Minimum SSD (Vertical)	565'	290'	> 625'	300'	> 625'	250'	> 625'
Minimum SSD (Horizontal)	584'	302'	279'	> 625'	250'	> 625'	
Maximum Design Speed	60 MPH	40 MPH	40 MPH	40 MPH	40 MPH	50 MPH	

AS CONSTRUCTED INFORMATION

CONTRACTOR Western Paving Const Co.
 PROJECT ENGINEER R. K. WITT
 (Project or Resident)
 PROJECT STARTED 4-1-88
 PROJECT COMPLETED 12-12-88
 AS CONSTRUCTED PLANS APPROVED is [Signature]
 Const Eng. 7-19-89
 TITLE DATE

C.D.L.

DIVISION OF HIGHWAYS
 APPROVED:
Robert L. Chumley 9/18/87
 CHIEF ENGINEER DATE

DEPARTMENT OF TRANSPORTATION
 FEDERAL HIGHWAY ADMINISTRATION
 APPROVED _____ DATE _____
 DIVISION ADMINISTRATOR

Plan No.	Title	Page
<input checked="" type="checkbox"/> M-100-1	STANDARD SYMBOLS	1
<input type="checkbox"/> M-107-1	TEMPORARY EROSION CONTROL	2
<input type="checkbox"/> M-203-1	APPROACH ROADS, FLARING, CUT SLOPE TREATMENT, BRIDGE & CREST WIDENING	3
<input type="checkbox"/> M-203-2	DITCH TYPES	4
<input type="checkbox"/> M-203-10	SUPERELEVATION OF CURVES - CROWNED HIGHWAYS	5
<input type="checkbox"/> M-203-11	SUPERELEVATION OF CURVES - DIVIDED HIGHWAYS - SHOULDER PIVOT	6
<input type="checkbox"/> M-203-12	SUPERELEVATION OF CURVES - STREETS	7
<input type="checkbox"/> M-203-13	SUPERELEVATION OF CURVES - DIVIDED HIGHWAYS - CENTER PIVOT	8
<input type="checkbox"/> M-206-1	EXCAVATION AND BACKFILL FOR STRUCTURES (2 SHEETS)	9
<input type="checkbox"/> M-206-2	EXCAVATION AND BACKFILL FOR BRIDGES	11
<input type="checkbox"/> M-214-1	PLANTING DETAILS	12
<input type="checkbox"/> M-412-1	CONCRETE PAVEMENT JOINTS	13
<input type="checkbox"/> M-504-1	STEEL CRIBBING	14
<input type="checkbox"/> M-506-1	GABIONS AND SLOPE MATTRESS	15
<input type="checkbox"/> M-510-1	STRUCTURAL PLATE CULVERT PIPE - H-20 LOADING (2 SHEETS)	16
<input type="checkbox"/> M-601-1	SINGLE CONCRETE BOX CULVERT	18
<input type="checkbox"/> M-601-2	DOUBLE CONCRETE BOX CULVERT	19
<input type="checkbox"/> M-601-3	TRIPLE CONCRETE BOX CULVERT	20
<input type="checkbox"/> M-601-10	HEADWALL FOR PIPE CULVERTS	21
<input type="checkbox"/> M-601-11	TYPE "S" SADDLE HEADWALL FOR PIPE CULVERTS	22
<input checked="" type="checkbox"/> M-601-12	HEADWALL, INTERCEPTING HEADWALL AND CULVERT OUTLET PAVING	23
<input type="checkbox"/> M-601-20	WINGWALLS FOR PIPE OR BOX CULVERTS	24
<input type="checkbox"/> M-603-1	METAL CULVERT PIPE - H-20 LOADING (2 SHEETS)	25
<input checked="" type="checkbox"/> M-603-2	REINFORCED CONCRETE PIPE	27
<input type="checkbox"/> M-603-3	PRECAST CONCRETE BOX CULVERT	28
<input type="checkbox"/> M-603-10	CONCRETE AND METAL END SECTIONS	29
<input type="checkbox"/> M-604-1	PIPE SEWER IN TRENCH	30
<input checked="" type="checkbox"/> M-604-10	INLET, TYPE C	31
<input type="checkbox"/> M-604-11	INLET, TYPE D	32
<input type="checkbox"/> M-604-12	CURB INLET, TYPE R (2 SHEETS)	33
<input type="checkbox"/> M-604-13	CONCRETE INLET, TYPE 13	35
<input type="checkbox"/> M-604-20	MANHOLES	36
<input type="checkbox"/> M-604-21	STEPS FOR MANHOLES & INLETS	37
<input checked="" type="checkbox"/> M-606-1	GUARD RAIL, TYPE 3, W-BEAM (8 SHEETS)	38
<input type="checkbox"/> M-606-2	GUARD RAIL, TYPE 3, W-BEAM FOR LOCAL ROADS & STREETS (4 SHEETS)	46
<input type="checkbox"/> M-606-10	GUARD RAIL, TYPE 4, CONCRETE BARRIER, CAST-IN-PLACE	50
<input type="checkbox"/> M-606-11	GUARD RAIL, TYPE 4, CONCRETE BARRIER, PRECAST-PORTABLE	51

Plan No.	Title	Page
<input type="checkbox"/> M-607-1	WIRE FENCES AND GATES (2 SHEETS)	52
<input type="checkbox"/> M-607-2	CHAIN LINK FENCE (3 SHEETS)	54
<input type="checkbox"/> M-607-3	BARRIER FENCE	57
<input type="checkbox"/> M-607-4	DEER FENCE AND GATE (2 SHEETS)	58
<input type="checkbox"/> M-607-10	PICKET SNOW FENCE	60
<input type="checkbox"/> M-608-1	CURB RAMPS	61
<input type="checkbox"/> M-609-1	CURBS AND GUTTERS	62
<input type="checkbox"/> M-611-1	CATTLE GUARD - WELDED GRILL UNITS - 10' THRU 42' ROADWAYS (2 SHEETS)	63
<input checked="" type="checkbox"/> M-613-1	HIGHWAY LIGHTING (2 SHEETS)	65
<input type="checkbox"/> M-615-1	EMBANKMENT PROTECTOR, TYPES 3 & 4	67
<input checked="" type="checkbox"/> M-615-2	EMBANKMENT PROTECTOR, TYPE 5	68
<input type="checkbox"/> M-616-1	INVERTED SIPHON (ALSO USE M-603 OR M-604 AS REQUIRED)	69
<input type="checkbox"/> M-620-1	FIELD LABORATORY - CLASS 1	70
<input checked="" type="checkbox"/> M-620-2	FIELD LABORATORY - CLASS 2	71
<input type="checkbox"/> M-620-11	FIELD OFFICE - CLASS 1	72
<input type="checkbox"/> M-620-12	FIELD OFFICE - CLASS 2	73

Plan No.	Title	Page
<input checked="" type="checkbox"/> S-612-1	TYPICAL DELINEATOR INSTALLATIONS (4 SHEETS)	75
<input checked="" type="checkbox"/> S-614-1	TYPICAL GROUND SIGN PLACEMENT	79
<input checked="" type="checkbox"/> S-614-2	CLASS I GROUND SIGN INSTALLATIONS	80
<input checked="" type="checkbox"/> S-614-3	CLASS II GROUND SIGN INSTALLATIONS	81
<input checked="" type="checkbox"/> S-614-4	CLASS III SIGNS, LAMINATED ALUMINUM PANELS AND POST SPACING TABLE (2 SHEETS)	82
<input type="checkbox"/> S-614-5	BREAK-AWAY SIGN SUPPORT DETAILS FOR GROUND SIGNS (2 SHEETS)	84
<input checked="" type="checkbox"/> S-614-6	CONCRETE FOOTINGS AND SIGN ISLANDS FOR CLASS III SIGNS (2 SHEETS)	86
<input checked="" type="checkbox"/> S-614-10	TYPICAL MARKER ASSEMBLY INSTALLATIONS	88
<input type="checkbox"/> S-614-11	MILEPOST SIGN AND INSTALLATION	89
<input checked="" type="checkbox"/> S-614-12	STRUCTURE NUMBER INSTALLATION (BRIDGE INFORMATION SHEET)	90
<input type="checkbox"/> S-614-13	STANDARD RAILROAD CROSSING SIGNS AND MARKINGS	91
<input checked="" type="checkbox"/> S-614-20	TYPICAL POLE MOUNT SIGN INSTALLATION	92
<input type="checkbox"/> S-614-21	CONCRETE BARRIER SIGN POST INSTALLATIONS	93
<input type="checkbox"/> S-614-22	TYPICAL MULTI-SIGN INSTALLATIONS	94
<input checked="" type="checkbox"/> S-614-30	INTERSTATE ROUTE MARKERS	95
<input checked="" type="checkbox"/> S-614-31	U. S. & COLORADO ROUTE MARKERS	96
<input checked="" type="checkbox"/> S-614-32	AUXILIARY MARKERS	97
<input type="checkbox"/> S-614-40	TRAFFIC SIGNAL INSTALLATION DETAILS (3 SHEETS)	98
<input checked="" type="checkbox"/> S-614-50	TRAFFIC CONTROLS FOR HIGHWAY CONSTRUCTION (4 SHEETS)	101
<input checked="" type="checkbox"/> S-614-51	BARRICADES, DRUMS, CONCRETE BARRIER (TEMP) & VERTICAL PANELS	105
<input checked="" type="checkbox"/> S-627-1	TYPICAL PAVEMENT MARKINGS (3 SHEETS)	106

THE STANDARD PLAN SHEETS INDICATED HEREON BY A MARKED BOX ARE TO BE USED TO CONSTRUCT THIS PROJECT.

DEPARTMENT OF HIGHWAYS
 STATE OF COLORADO
 DIVISION OF HIGHWAYS



STANDARD PLANS LIST

M & S STANDARDS JANUARY, 1982


AS CONSTRUCTED		FED. ROAD REGION	DIVISION	PROJ. NO.	SHEET NO.
NO REVISIONS	12-12-88	REVISD	VDID	VIII	COLO.
				I 70-3(140)	3

TYPICAL SECTIONS SH 470

STA. 28+00.00 TO STA. 72+00.00

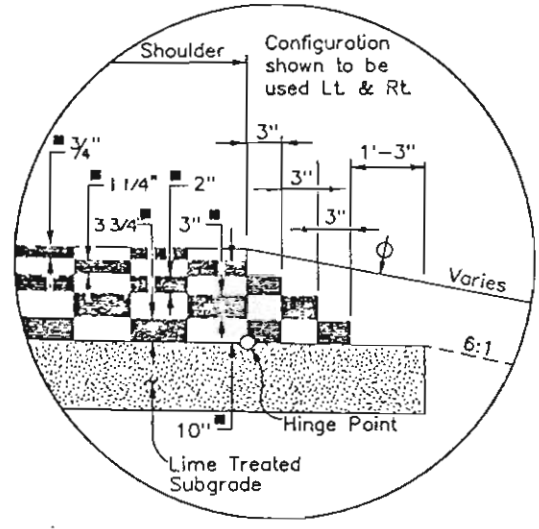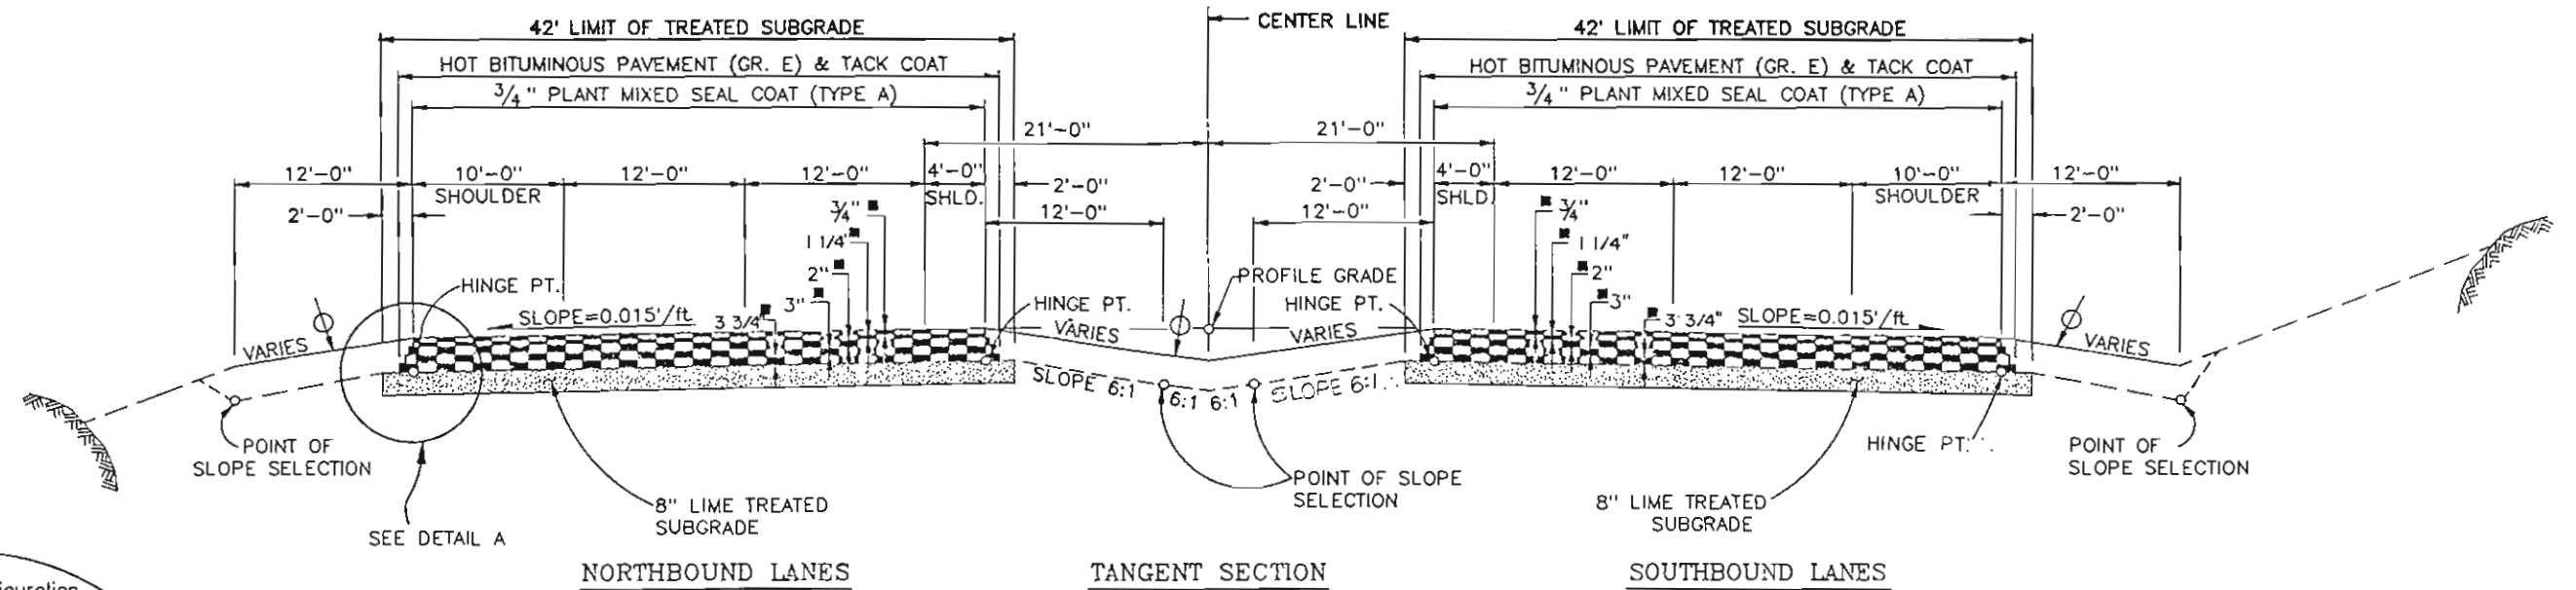

DETAIL A

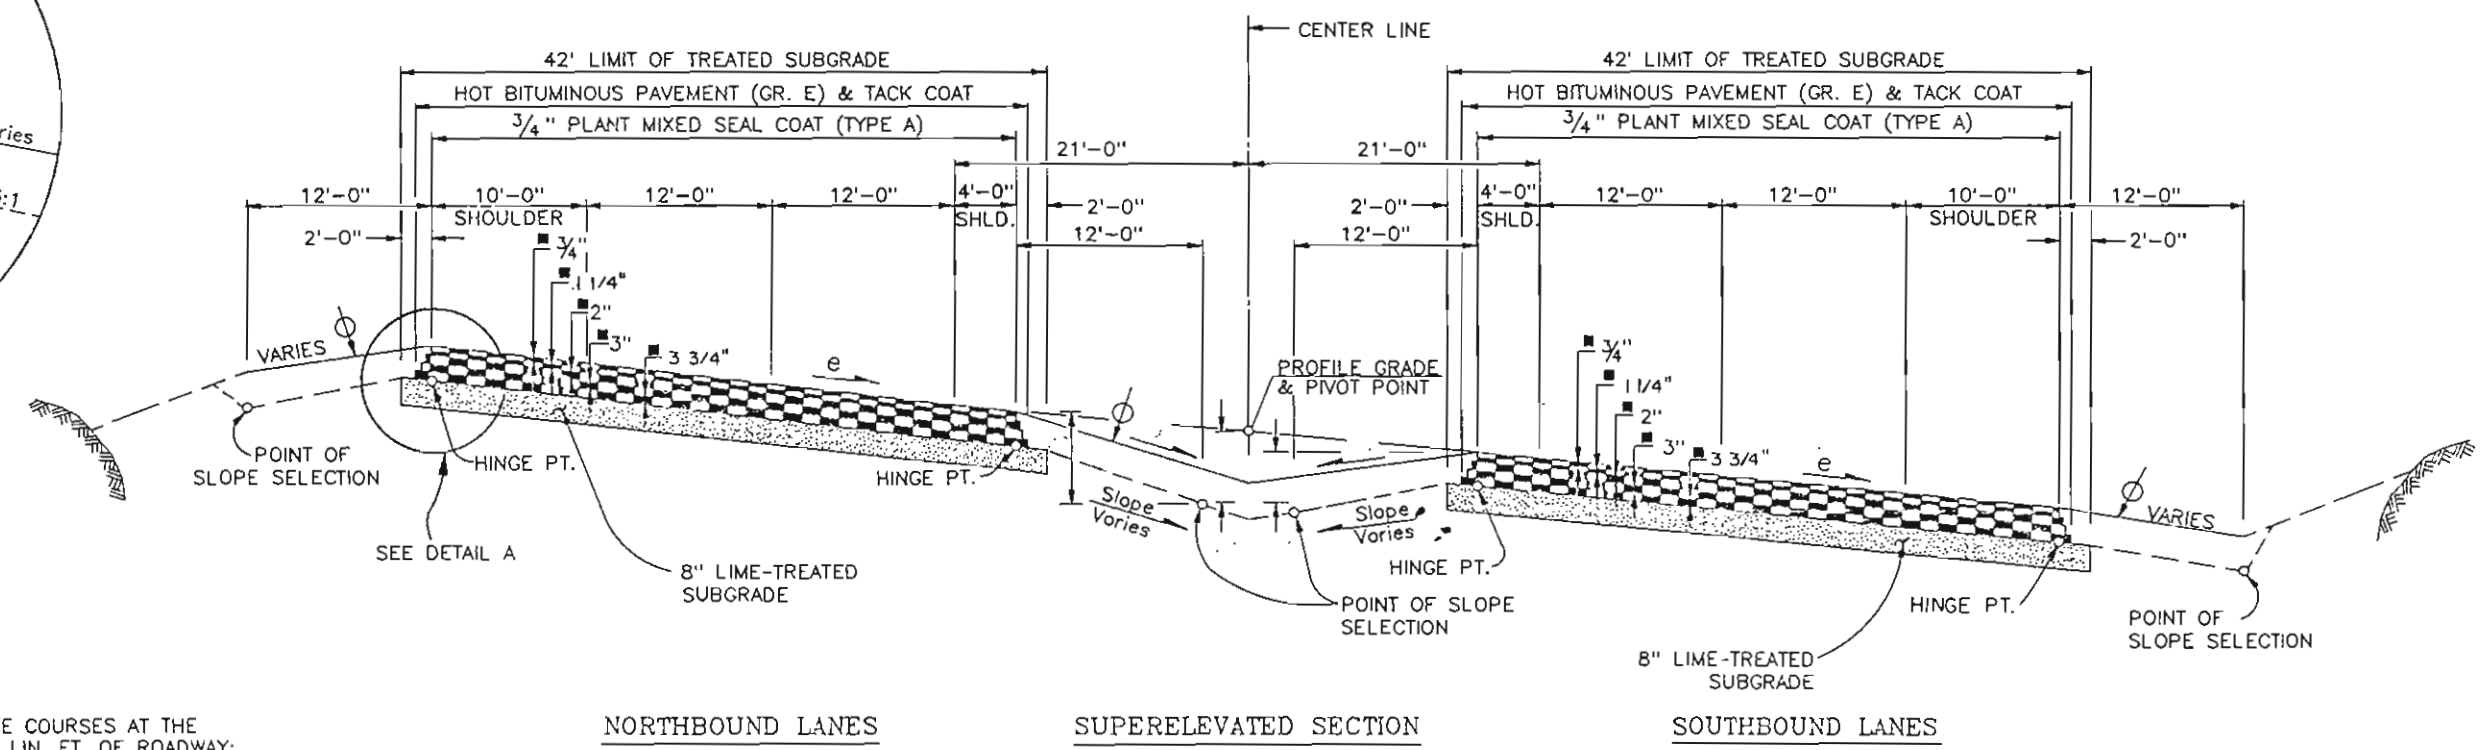

TYPICAL SECTION NOTES

- ⊕ TOPSOIL (4" MINIMUM)
- APPROXIMATE THICKNESS

MATERIALS SHALL BE PLACED IN SEPARATE COURSES AT THE FOLLOWING APPROXIMATE RATES PER 100 LIN. FT. OF ROADWAY:

		MAINLINE S.H. 470
PLANT MIXED SEAL COAT	TOP LAYER	35 TONS
HOT BITUMINOUS PAVEMENT	FOURTH LAYER	58 TONS
	THIRD LAYER	94 TONS
	SECOND LAYER	143 TONS
	BOTTOM LAYER	181 TONS

THE RATES SHOWN HAVE BEEN DETERMINED FROM INFORMATION AVAILABLE AT THE TIME OF DESIGN. RATES SHOULD BE ADJUSTED DURING CONSTRUCTION TO OBTAIN THE REQUIRED APPROXIMATE THICKNESS.


TABLE FOR MEDIAN SLOPES AND DIMENSIONS

DEGREE OF CURVE	ROADWAY SLOPE	DISTANCE "a"	DISTANCE "b"	DISTANCE "c"	SLOPE Δ	SLOPE θ
2° 30'	0.073'/ft	2.00'	3.24'	4.48'	8.5:1	3.79:1
5° 00'	0.080'/ft	2.00'	3.36'	4.72'	8.5:1	3.60:1

NO number 07/27/87 07:05:32 ...C:\MID\0904\UP\B2014\ROMY\1401.TYP\DFU470CC


TYPICAL SECTIONS

AS CONSTRUCTED		FED. ROAD REGION	DIVISION	PROJ. NO.	SHEET NO.
NO REVISIONS	12-12-88	REVISED	VOID	VIII	COLO.
				I 70-3(140)	4

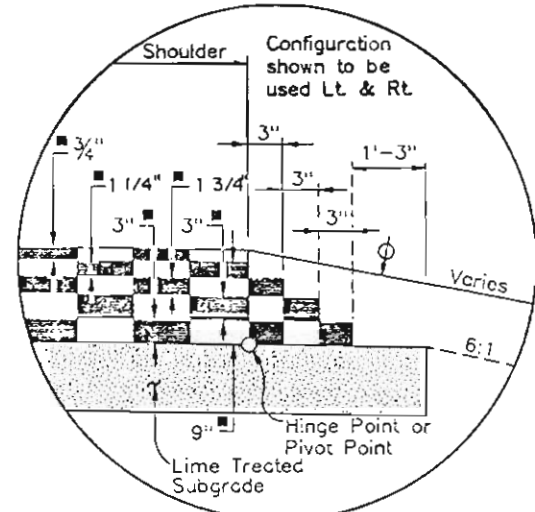


DETAIL B

RAMP C & RAMP D (Note: Ramp D is opposite hand of Ramp C) (TWO LANES, ONE WAY)

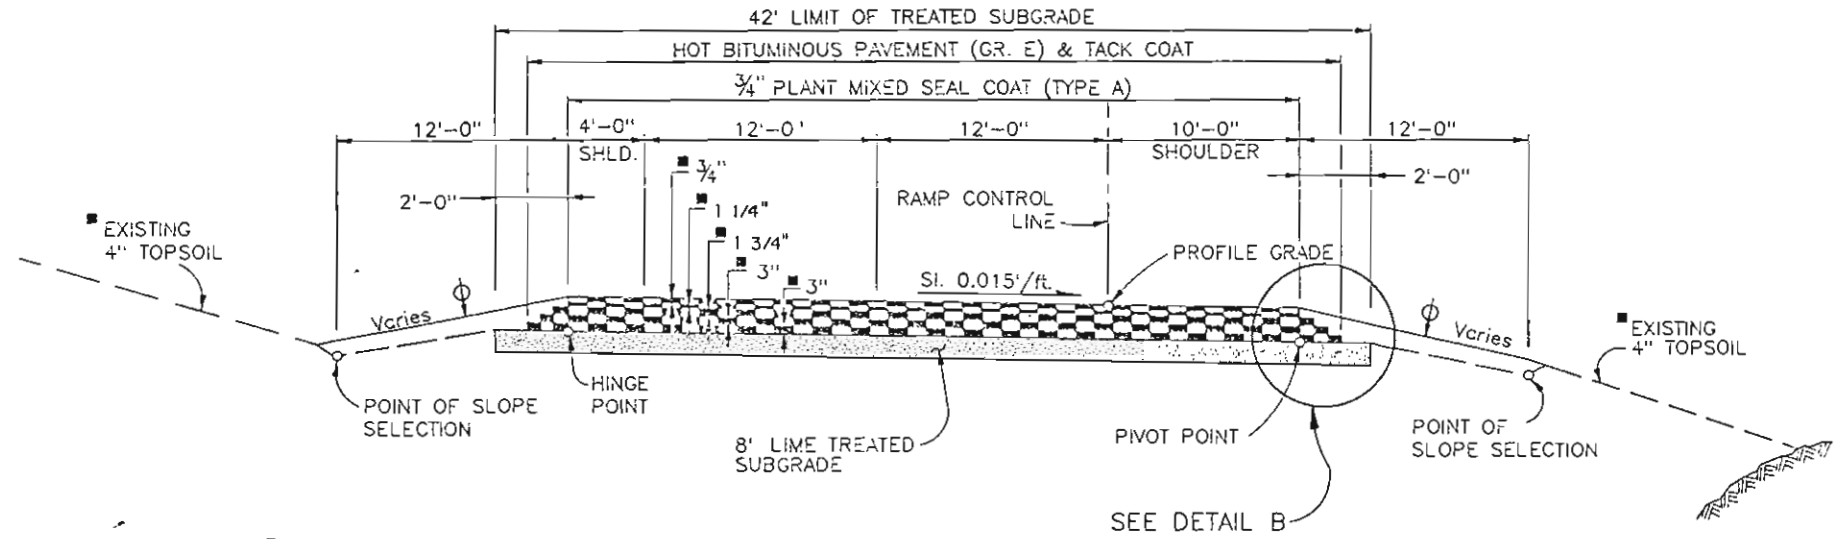

RAMP A, RAMP B & RAMP F (Note: Ramp B is opposite hand of Ramp A) (ONE LANE RAMP)

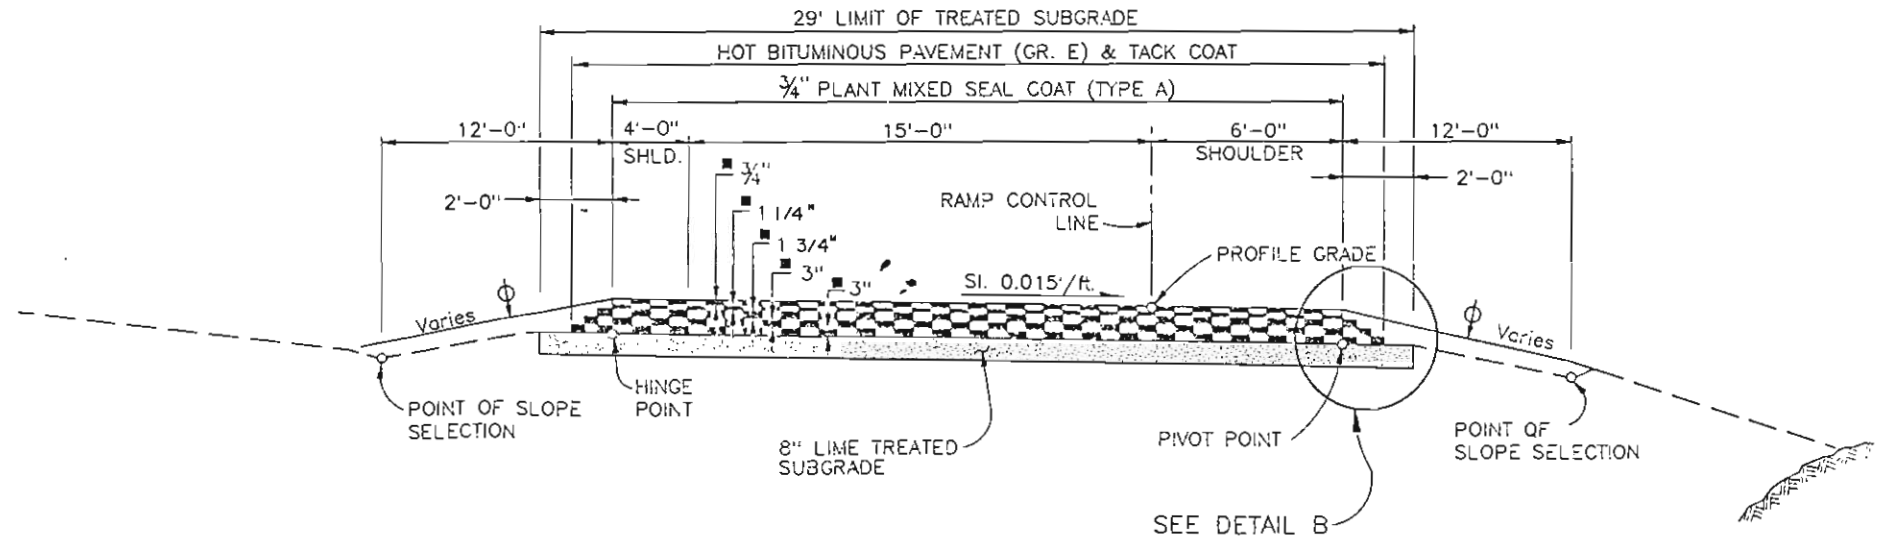

TYPICAL SECTION NOTES

⊕ TOPSOIL (4" MINIMUM)

■ APPROXIMATE THICKNESS

MATERIALS SHALL BE PLACED IN SEPARATE COURSES AT THE FOLLOWING APPROXIMATE RATES PER 100 LIN. FT. OF ROADWAY:

		RAMPS A & B	RAMPS C & D
PLANT MIXED SEAL COAT	TOP LAYER	11 TONS	17 TONS
HOT BITUMINOUS PAVEMENT	FOURTH LAYER	19 TONS	29 TONS
	THIRD LAYER	27 TONS	41 TONS
	SECOND LAYER	48 TONS	72 TONS
	BOTTOM LAYER	49 TONS	72 TONS

THE RATES SHOWN HAVE BEEN DETERMINED FROM INFORMATION AVAILABLE AT THE TIME OF DESIGN. RATES SHOULD BE ADJUSTED DURING CONSTRUCTION TO OBTAIN THE REQUIRED APPROXIMATE THICKNESS.

FINAL SUMMARY OF APPROXIMATE QUANTITIES

AS CONSTRUCTED
NO REVISIONS REVISED 12-12-88 VOID

FED. ROAD REGION	DIVISION	PROJ. NO.	SHEET NO.
VIII	COLO.	170-3(140)	6

INDEX			CONTRACT ITEM NO.	CONTRACT ITEM	UNIT	ROADWAY		STRUCTURE NO. F-16-KW		STRUCTURE NO. F-16-KX		STRUCTURE NO. F-16-KY		STRUCTURE NO. F-16-KZ		PROJECT TOTALS		DIFF. +/-	% PLAN.
						PLAN	AS CONST.	PLAN	AS CONST.	PLAN	AS CONST.	PLAN	AS CONST.	PLAN	AS CONST.				
3	1	32	202	REMOVAL OF BARRICADE	EACH	2	2									2	2	0	100
	2	32	202	REMOVAL OF PAVEMENT MARKING	SQ FT	1,170	1,138									1,170	1,138	-32	97
	3	32	202	REMOVAL OF SIGN PANEL	EACH	4	4									4	4	0	100
	4	32	202	REMOVAL OF GUARD RAIL TYPE 4	LIN FT	1,442	890									1,442	890	-552	62
	5	5	203	EMBANKMENT MATERIAL (COMPLETE IN PLACE)	CU YD	1,434	1,434									1,434	1,434	0	100
	6	5	207	TOPSOIL (HAUL)	CU YD	11,511	11,507									11,511	11,507	-4	99
	7	5	210	MODIFY INLET	EACH	1	2									1	2	+1	200
	8	5	212	SEEDING (NATIVE)	ACRE	9	15.28									9	15.28	+6.28	170
	9	5	213	MULCHING	ACRE	9	15.28									9	15.28	+6.28	170
	10	5	213	MULCH TACKIFIER	LB	900	1,528									900	1,528	+628	170
	11	9	307	HYDRATED LIME	TON	1,153	975.70									1,153	975.70	-177.3	85
	12	9	307	PROCESSING LIME TREATED SUBGRADE (8 INCH)	SQ YD	77,703	80,671									77,703	80,671	+2,968	104
	13	9	403	HOT BITUMINOUS PAVEMENT (GRADING E) (HAUL AND ASPHALT)	TON	39,770	39,152.47	141	141	144	144	47	47	69	69	40,171	39,552.47	-618.53	98
	14	9	410	PLANT MIXED SEAL COAT (TYPE A) (HAUL AND ASPHALT)	TON	2,926	2,440.17	85	85	86	86	29	29	42	42	3,168	2,682.17	-54.17	116
	15	5	411	EMULSIFIED ASPHALT (SLOW-SETTING)	GAL	13,911	7,310									13,911	7,310	-6,601	53
	16	5	506	RIPRAP	CU YD	23	89									23	89	+66	387
	17	5	507	CONCRETE SLOPE AND DITCH PAVING (REINFORCED)	CU YD	1.1	6.60									1.1	6.6	+5.5	600
	18	5	507	BITUMINOUS SLOPE AND DITCH PAVING (HAUL AND ASPHALT)	TON	20	255.24									20	255.24	+255.24	1276
	19	5	515	WATERPROOFING (MEMBRANE)	SQ YD			2058	2,058	2090	2,090	692	692	1012	1,012	5,852	5,852	0	100
	20	5	603	18 INCH REINFORCED CONCRETE PIPE	LIN FT	200	332.50									200	332.50	+132.5	166
	21	5	603	24 INCH REINFORCED CONCRETE PIPE DELETE MCR 40-17	LIN FT	80	0									80	0	-80	0
	22	5	603	24 INCH REINFORCED CONCRETE END SECTION DELETE MCR 40-18	EACH	2	0									2	0	-2	0
	23	5	604	INLET TYPE C (5 FOOT)	EACH	1	2									1	2	+1	200
	24	10	606	GUARD RAIL TYPE 3 (6-3 POST SPACING)	LIN FT	1,175	1,775									1,175	1,775	+600	151
	25	10	606	GUARD RAIL TYPE 4	LIN FT	1,891	1,921									1,891	1,921	+30	102
	26	10	606	END ANCHORAGE TYPE 3E	EACH	9	9									9	9	0	100
	27	10	606	END ANCHORAGE TYPE 3F	EACH	5	5									5	5	0	100
	28	10	612	DELINEATOR (TYPE I)	EACH	204	320									204	320	+116	157
	29	10	612	DELINEATOR (TYPE II)	EACH	73	73									73	73	0	100
	30	10	612	DELINEATOR (TYPE III) DELETE MCR 40-19	EACH	8	0									8	0	-8	0
	31	16	613	2 INCH ELECTRICAL CONDUIT	LIN FT	305	130									305	130	-175	43
	32	16	613	3 INCH ELECTRICAL CONDUIT	LIN FT	280	280									280	280	0	100
	33	16	613	3 INCH ELECTRICAL CONDUIT (JACKED) DELETE MCR 40-20	LIN FT	40	0									40	0	-40	0
	34	16	613	DIRECT-BURIAL CABLE	LIN FT	14,180	10,357									14,180	10,357	-3,823	73
	35	16	613	WIRING	L S	0.5	0.5									0.5	0.5	0	100

FINAL SUMMARY OF APPROXIMATE QUANTITIES

AS CONSTRUCTED		FED. ROAD REGION	DIVISION	PROJ. NO.	SHEET NO.
NO REVISIONS	REVISED 12-12-88	VIII	COLO.	170-3(140)	7

INDEX	CONTRACT ITEM NO.	CONTRACT ITEM	UNIT	ROADWAY		STRUCTURE NO. F-16-KW		STRUCTURE NO. F-16-KX		STRUCTURE NO. F-16-KY		STRUCTURE NO. F-16-KZ		PROJECT TOTALS		DIFF. +/-	% PLAN.
				PLAN	AS CONST.	PLAN	AS CONST.	PLAN	AS CONST.	PLAN	AS CONST.	PLAN	AS CONST.				
4	36	613	LUMINAIRE HIGH PRESSURE SODIUM (50,000 LUMEN)	EACH	7	7								7	7	0	100
	37	613	LUMINAIRE HIGH PRESSURE SODIUM (140,000 LUMEN)	EACH	80	80								80	80	0	100
	38	613	LUMINAIRE HIGH PRESSURE SODIUM (WALL TYPE)(12,000 LUMEN)	EACH	6	6								6	6	0	100
	39	613	LIGHT STANDARD METAL (40 FOOT)	EACH	7	7								7	7	0	100
	40	613	LIGHT STANDARD STEEL HIGH MAST (100 FOOT)	EACH	9	9								9	9	0	100
	41	613	LIGHT STANDARD STEEL HIGH MAST (120 FOOT)	EACH	1	1								1	1	0	100
	42	613	CONCRETE FOUNDATION PAD	EACH	7	7								7	7	0	100
	43	613	HIGH MAST FOUNDATION (DRILLED CAISSON) (48 INCH)	LIN FT	159	153								159	153	-6	96
	44	613	LOWERING DEVICE	EACH	10	10								10	10	0	100
	45	613	PORTABLE POWER UNIT	EACH	1	1								1	1	0	100
	46	613	LIGHTING CONTROL CENTER	EACH	2	10								2	10	+8	500
	47	614	FLAGGING	HOUR	3000	524.5								3000	524.5	-2475.5	17
	48	614	TRAFFIC CONTROL SUPERVISOR	DAY	160	47								160	47	-113	29
	49	614	SIGN PANEL (CLASS I)	SQ FT	228	313.50								228	313.50	+85.5	138
	50	614	SIGN PANEL (CLASS II)	SQ FT	520	852								520	852	+332	164
	51	614	SIGN PANEL (CLASS III)	SQ FT	1,959	2,135								1,959	2,135	+176	109
	52	614	TIMBER SIGN POST 6X6 INCH	LIN FT	580	1,037								580	1,037	+457	179
	53	614	STEEL SIGN POST (W 10X26)	LIN FT	49	94.50								49	94.50	+45.5	193
	54	614	CONCRETE FOOTING (TYPE 6)	EACH	2	4								2	4	+2	200
	55	614	CONCRETE FOOTING VI (SPREAD)	EACH	1	1								1	1	0	100
	56	614	CONCRETE FOOTING II-S (SPREAD)	EACH	4	4								4	4	0	100
	57	614	MASK SIGN LEGEND	EACH	7	6								7	6	-1	86
	58	614	MODIFICATION OF SIGN LEGEND	L S	1	1								1	1	0	100
	59	614	SIGN BRIDGE STRUCTURE (70 TO LESS THAN 75 FOOT FRAME)	EACH	1	1								1	1	0	100
	60	614	SIGN BRIDGE STRUCTURE (80 TO LESS THAN 85 FOOT FRAME)	EACH	1	1								1	1	0	100
	61	614	CANTILEVER STRUCTURE (25 TO LESS THAN 30 FOOT FRAME)	EACH	4	4								4	4	0	100
	62	614	BARRICADE (TYPE 3 M-A)	EACH	30	34								30	34	+4	113
	63	614	CONSTRUCTION TRAFFIC SIGN (PANEL SIZE A)	EACH	8	2								8	2	-6	25
	64	614	CONSTRUCTION TRAFFIC SIGN (PANEL SIZE B)	EACH	34	37								34	37	+3	109
	65	614	VERTICAL PANEL	EACH	70	79								70	79	+9	113
	66	614	VERTICAL PANEL (WITH LIGHT) (FLASHING)	EACH	24	34								24	34	+10	142
	67	614	ADVANCE WARNING FLASHING OR SEQUENCING ARROW PANEL (C TYPE)	EACH	2	2								2	2	0	100

FINAL SUMMARY OF APPROXIMATE QUANTITIES

AS CONSTRUCTED			FED. ROAD REGION	DIVISION	PROJ. NO.	SHEET NO.
NO REVISIONS	REVISED	VOID	VIII	COLD.	170-3(140)	8

INDEX	CONTRACT ITEM NO.	CONTRACT ITEM	UNIT	ROADWAY		STRUCTURE NO. F-16-KW		STRUCTURE NO. F-16-KX		STRUCTURE NO. F-16-KY		STRUCTURE NO. F-16-KZ		PROJECT TOTALS		DIFF. +/-	* PLAN.
				PLAN	AS CONST.	PLAN	AS CONST.	PLAN	AS CONST.	PLAN	AS CONST.	PLAN	AS CONST.				
68	32	614	TRAFFIC CONE	EACH	50	180								50	180	+130	360
67		620	FIELD LABORATORY (CLASS 2)	EACH	1	1								1	1	0	100
70		620	SANITARY FACILITY	EACH	1	1								1	1	0	100
71		625	CONSTRUCTION SURVEYING	LS	0.5	0.5								0.5	0.5	0	100
		626	MOBILIZATION	LS	0.5	0.5								0.5	0.5	0	100
72	36	627	THERMOPLASTIC PAVEMENT MARKING	SQ FT	16,159	14,241								16159	14,241	-1,918	88
73	36	627	PREFORMED PLASTIC PAVEMENT MARKING (60 MILS)	SQ FT	1,300	1,330								1300	1,330	+30	102
			FORCE ACCOUNT =====														
		F/A01	MINOR CONTRACT REVISIONS	FA	1 \$10,000.00	0 \$0								1 (\$10,000.00)	0 \$0	-1 -\$10,000	0
		F/A02	ON-THE-JOB TRAINEE	FA	2 \$1,600.00	1								2 (\$1,600.00)	1	-1	50
		F/A03	OBTAIN POWER FROM PUBLIC SERVICE COMPANY FOR SIGNING AND LIGHTING (BY CONTRACTOR)	FA	1 \$15,000.00	2,301.00								1 (\$15,000.00)	1 (\$2,301.00)	0 -\$12,699	100
74	5	603	18 IN. RCES MCR 40-3	EACH	0	3									3		
75		203	BLADING MCR 40-1	HOUR	0	79									79		
76		104	RESTOCK ELECT. CABLE MCR 40-2	LS	0	1									1		
77		507	BIT. 5 & D PAVING (SPEC.) MCR 40-4	TON	0	158.97									158.97		
78		613	UPGRADE DIR. BUR. CABLE MCR 40-5	LS	0	1									1		
79		613	POWER PEDESTALS MCR 40-6	EACH	0	10									10		
80		627	PAVE. MARK. PAINT MCR 40-7	GAL	0	91									91		
81		614	DRUM CHANNEL. DEVICE MCR 40-9	EACH	0	30									30		
82		609	CURE TY 6 M MCR 40-8	LINE FT	0	705									705		
83	10	606	END ANCHOR TY 3D MCR 40-13	EACH	0	2									2		
84		614	FLEX. SIGN POST MCR 40-15	LINE FT	0	144									144		
85		203	DOZING (LANDSCAPING) MCR 40-14	HOUR	0	25									25		
86		210	RESET GROUND SIGN MCR 40-16	EACH	0	3									3		
87		612	REFLECTOR (MED. BARR) MCR 40-10	EACH	0	93									93		
88		601	STRUC. CONC. COATING MCR 40-11	SQ YD	0	828									828		
89		610	IMPACT ATTEN. (TEMP) MCR 40-12	EACH	0	4									4		
90		612	OVERHEAD SIGN LUM. MCR 40-21	EACH	0	2									2		
91		108.07	LIQUIDATED DAMAGES	DAY	0	18									18		

TABULATION OF SURFACING AND TREATED SUBGRADE

LOCATION	SOURCE	QUANTITY - TON					HYDRATED LIME	PROCESSING LIME TREATED SUBGRADE SQ. YD.	
		PLANT MIXED SEAL COAT (TYPE A)(H&A)	HOT BITUMINOUS PAVEMENT (H&A)						
			TOP GRADING E	THIRD GRADING E	SECOND GRADING E	BOTTOM GRADING E			
NB S.H. 470									
28+00.00 TO 29+48.00	C O N T R I B U T I O N	26	43	93	106	134	10	691	
29+48.00 TO 32+25.76		89	149	239	361	455	34	2284	
32+25.76 TO 35+62.51 (STR. NO. F-16-KW)		85	141						
35+62.51 TO 38+18.00		49	82	133	201	255	19	1306	
38+18.00 TO 47+50.00		162	271	439	666	844	65	4349	
47+50.00 TO 50+50.00		78	129	209	318	401	30	2034	
50+50.00 TO 54+36.00		127	212	342	517	650	48	3260	
54+36.00 TO 63+00.00		206	343	554	840	1059	80	5376	
63+00.00 TO 69+00.00		127	211	341	517	654	50	3333	
69+00.00 TO 72+00.00		58	96	156	237	299	23	1533	
SB S.H. 470									
41+34.12 TO 47+28.00		116	193	312	473	599	46	3067	
47+28.00 TO 53+50.05		108	181	293	445	563	43	2903	
53+50.05 TO 62+69.45		234	535	629	952	1201	91	6129	
62+69.45 TO 68+50.12		112	186	302	458	579	44	2964	
68+50.12 TO 72+00.00	61	101	165	250	316	24	1633		
RAMP A									
232+13.04 TO 241+18.86	103	173	247	432	440	43	2919		
241+18.86 TO 243+48.91 (STR. NO. F-16-KY)	29	47							
243+48.91 TO 253+51.05	115	192	273	477	487	48	3229		
RAMP B									
1414+80.00 TO 1428+80.00	160	268	382	667	680	67	4511		
1428+80.00 TO 1429+47.06	9	15	21	37	37	3	234		
RAMP C									
425+50.00 TO 449+40.00	416	694	984	1709	1730	166	11153		
RAMP D									
1209+20.00 TO 1221+83.95	220	367	520	904	915	88	5894		
1221+83.95 TO 1224+23.76 (STR. NO. F-16-KZ)	42	69							
1224+23.76 TO 1231+78.00	131	219	310	539	546	52	3520		
1231+78.00 TO 1232+94.64	35	58	82	141	142	13	894		
1232+94.64 TO 1236+02.93 (STR. NO. F-16-KX)	86	144							
1236+02.93 TO 1241+34.12	123	273	385	501	505	48	3269		
RAMP F									
28+00.00 TO 31+78.00	43	73	103	180	184	18	1218		
WIDENING FOR GUARD RAIL									
		18	33	47	78	78			
ESTIMATED FOR IRREGULARITIES		TOTAL GRADING E = 39,553.47 TONS							
TOTALS		3,168 3,221.17	5,499	7,538	12,006	15,128	1,153 975.10	77,793 80,611	

STABILIZATION IS BASED ON:

	S.H. 470	RAMPS
18k ESAL	4,964,000	2,737,500
SERVICEABILITY INDEX	2.5	2.5
REGIONAL FACTOR	1.75	1.75
SUBGRADE "R" VALUE	5	5
WSN	5.38	4.98

STRENGTH COEFFICIENTS

	S.H. 470	RAMPS
HOT BITUMINOUS PAVEMENT	0.44	0.44
LIME TREATED SUBGRADE	0.10	0.10
PLANT MIXED SEAL COAT	0.25	0.25

RATE OF APPLICATION OF QUICKLIME = 23.1 LBS./SQ.YD./8" LAYER
 RATE OF APPLICATION OF HYDRATED LIME = 29.7 LBS./SQ.YD./8" LAYER
 PLAN QUANTITIES BASED ON 29.7 LBS./SQ.YD./8" LAYER

TABULATION OF GUARD RAIL

LOCATION	SIDE	GUARD RAIL TYPE 3 (6-3 POST SPACING)	GUARD RAIL TYPE 4	END ANCHORAGE		TYPE 3 D EACH
		LIN. FT.	LIN. FT.	TYPE 3E EACH	TYPE 3F EACH	
RAMP A						
239+39.67 TO 240+90.67	RT.	75	80	1		1
239+69.17 TO 241+20.17	LT.	75	80	1		
243+50.00 TO 244+22.00	RT.	75	72			
243+51.50 TO 244+23.50	LT.		72			
RAMP D						
1220+17.95 TO 1221+68.95	RT.	75	80	1		
1220+63.33 TO 1222+14.33	LT.	75	80	1		
1223+93.07 TO 1224+65.07	LT.	100	72			1
1224+34.76 TO 1225+06.76	RT.		72			
1231+47.36 TO 1232+98.36	RT.	75	80	1		
1231+31.68 TO 1232+82.68	LT.	75	80	1		
1236+16.53 TO 1236+88.53	RT.		72			
1236+00.00 TO 1237+80.79	LT.	50 150	105		1	
NB S.H. 470						
31+11.84 TO 31+83.84	LT.		72			
35+42.23 TO 36+93.23	LT.	75	80	1		
35+63.89 TO 37+68.89	RT.	50	130			
53+05.00 TO 55+67.00	MEDIAN	200	240		2	
54+24.00 TO 55+77.00	LT.	75	92	1		
67+69.00 TO 70+31.00	MEDIAN	200	240		2	
68+88.00 TO 70+41.00	LT.	75	92	1		
TOTALS		1175 1,715	1891 1,921	9	5	2

- TYPE 3 GUARD RAIL IS TO BE MADE OF CORROSION RESISTANT STEEL.
- CONNECTS TO BRIDGE RAIL.
- SEE GUARD RAIL DETAILS FOR OBSTRUCTION IN MEDIAN.
- SEE GUARD RAIL DETAILS - SH 470 AND RAMP D GORE AREA.
- TYPE 4 GUARD RAIL TO BE PAINTED AS PER PROJECT SPECIAL PROVISION, REVISION OF SECTION 601 - STRUCTURAL CONCRETE COATING

TABULATION OF DELINEATORS


LOCATION	SIDE	DELINEATORS					
		TYPE I		TYPE II		TYPE III	
		EACH		EACH		EACH	
RAMP A							
231+97.08 TO 233+83.87	LT & RT	3		1			
233+83.87 TO 239+69.17	LT	9					
239+69.17 TO 241+20.17	LT					1	
239+39.67 TO 240+90.67	RT					1	
243+51.50 TO 251+70.00	LT	14					
RAMP B							
1415+50.00 TO 1422+32.66	RT	15					
1422+32.66 TO 1429+41.49	RT	13					
RAMP C							
423+32.46 TO 450+50.50	RT	28					
423+32.46 TO 450+50.50	LT	27		1			
RAMP D							
1207+17.30 TO 1211+58.98	RT	5		2			
1208+75.00 TO 1211+58.98	LT	5					
1211+58.98 TO 1216+66.21	LT & RT	10					
1216+66.21 TO 1229+61.05	LT & RT	34				2	
1229+61.05 TO 1231+68.00	LT			2			
1231+68.00 TO 1232+82.68	LT			4		1	
1231+47.36 TO 1232+98.36	RT			4		1	
1236+16.53 TO 1241+28.00	LT & RT	10					
NB S.H. 470							
28+00.00 TO 29+48.00	RT	1					
29+48.00 TO 31+83.84	LT			3			
35+42.23 TO 36+93.23	LT					1	
35+63.89 TO 37+14.89	RT					1	
36+93.23 TO 38+18.00	LT			1			
38+18.00 TO 47+50.00	LT	9					
47+50.00 TO 50+50.00	LT			3			
50+50.00 TO 54+36.00	LT			4			
54+36.00 TO 63+00.00	LT			11			
63+00.00 TO 69+00.00	LT			6			
69+00.00 TO 72+00.00	LT			3			
SB S.H. 470							
41+28.00 TO 47+28.00	LT & RT			12			
47+28.00 TO 51+75.00	LT & RT	2					
51+75.00 TO 62+69.45	LT & RT	11		11			
62+69.00 TO 68+50.12	LT & RT	5		5			
68+50.12 TO 72+00.00	LT & RT	2					
RAMP F							
1228+00.00 TO 1229+61.05	RT	1					
TOTALS		204 320		73		8 0	

REFLECTORS:
CRYSTAL - 192
YELLOW - 182

AS CONSTRUCTED		
NO REVISIONS	REVISED 12-12-88	VOID

FED. ROAD REGION	DIVISION	PROJ. NO.	SHEET NO.
VIII	COLO.	170-3(140)	11

ORIGINAL SCALE: 1" = 20'

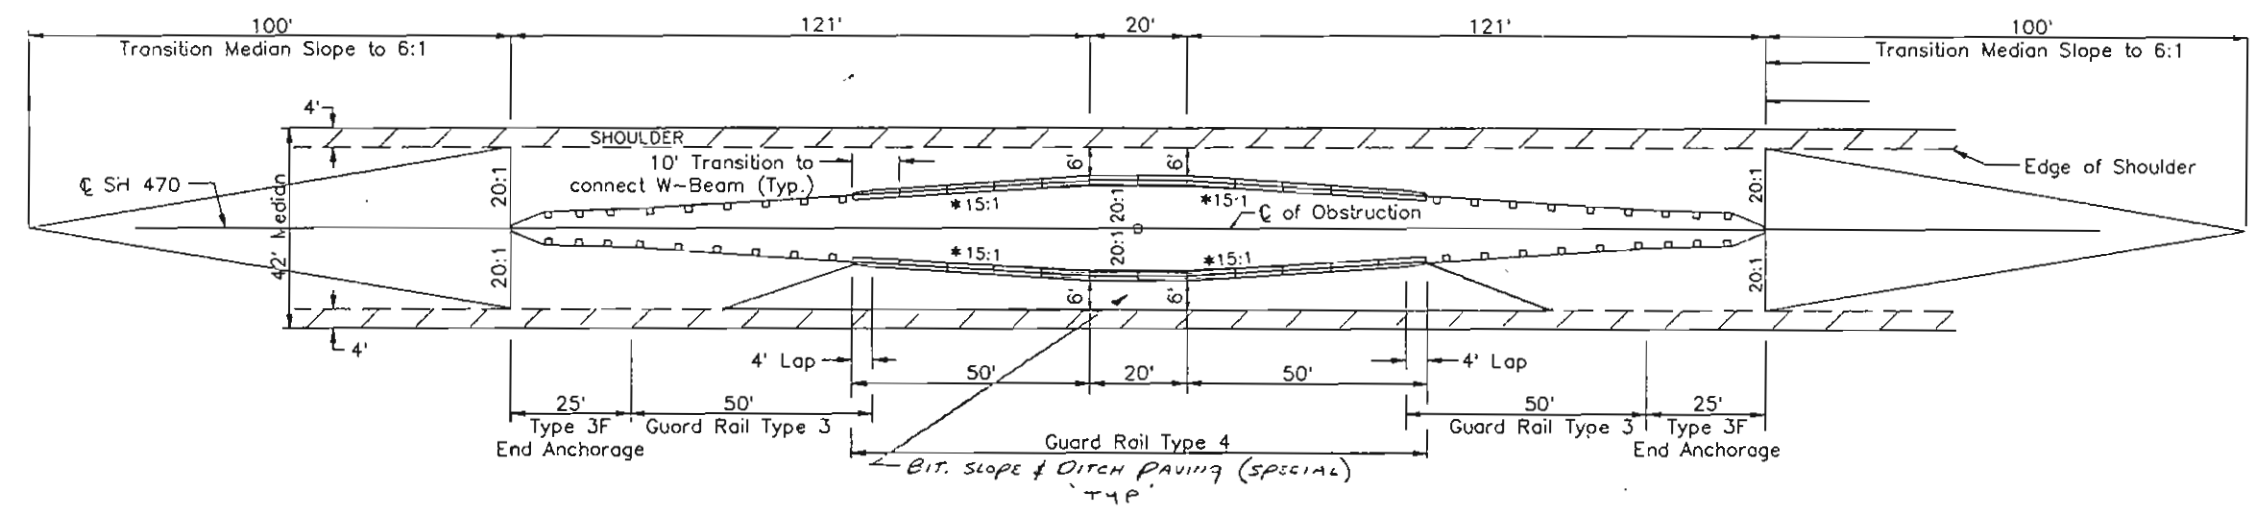

GENERAL NOTES


* 15:1 Flare Rate Based on a 55 MPH Operating Speed.
 Refer to Standards M-606-1 and M-606-12 for additional details.

GUARD RAIL DETAILS FOR OBSTRUCTION IN MEDIAN

NO number: .24/87 21:36:25 _DUAL: (DRM).PJ .86052.RD.WY.H101.(DETAIL) CRJOB

AS CONSTRUCTED			FED. ROAD REGION	DIVISION	PROJ. NO.	SHEET NO.
NO REVISIONS	12-12-88	REVISED	VIII	COLO.	I 70-3(140)	12

DETAIL OF MODIFY INLET

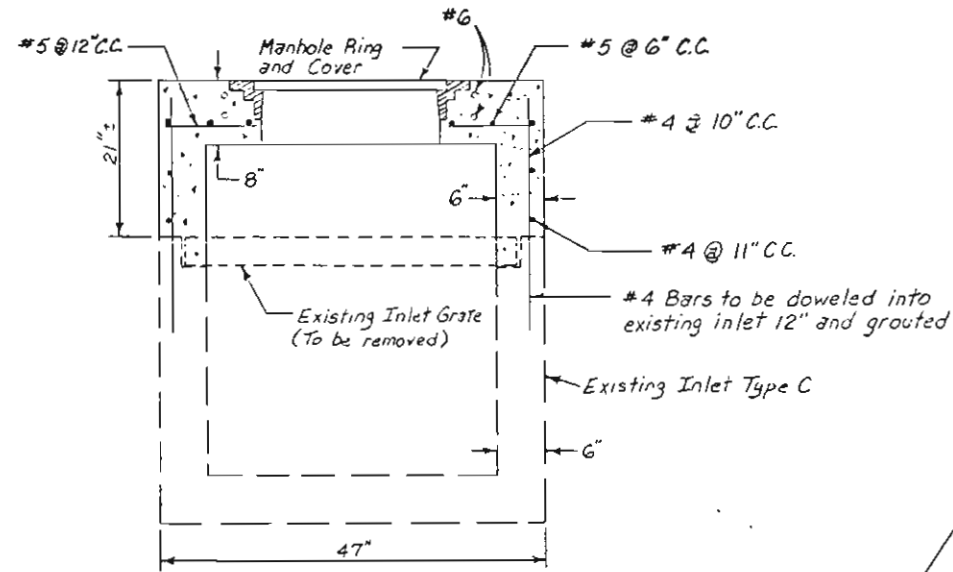

GENERAL NOTES

ALL WORK SHALL BE DONE IN ACCORDANCE WITH THE STANDARD SPECIFICATIONS APPLICABLE TO THE PROJECT.

ALL CONCRETE SHALL BE CLASS A OR B.

REINFORCING BARS SHALL BE DEFORMED AND SHALL BE OF INTERMEDIATE GRADE STEEL.


DIMENSIONS AND WEIGHTS OF TYPICAL MANHOLE RING AND COVER ARE NOMINAL. (SEE STANDARD M-604-12 FOR DETAILS).

CUT OR BEND BARS TO CLEAR MANHOLE.

CONCRETE, REINFORCING STEEL, REMOVAL OF INLET GRATE, MANHOLE RING AND COVER, AND ANY OTHER WORK NECESSARY TO COMPLETE THE INLET MODIFICATION SHALL BE INCLUDED IN THE COST OF ITEM 210 - MODIFY INLET.

FOR INFORMATION ONLY

CONCRETE 0.6 CU. YD.
 REINFORCING STEEL 165 LBS.

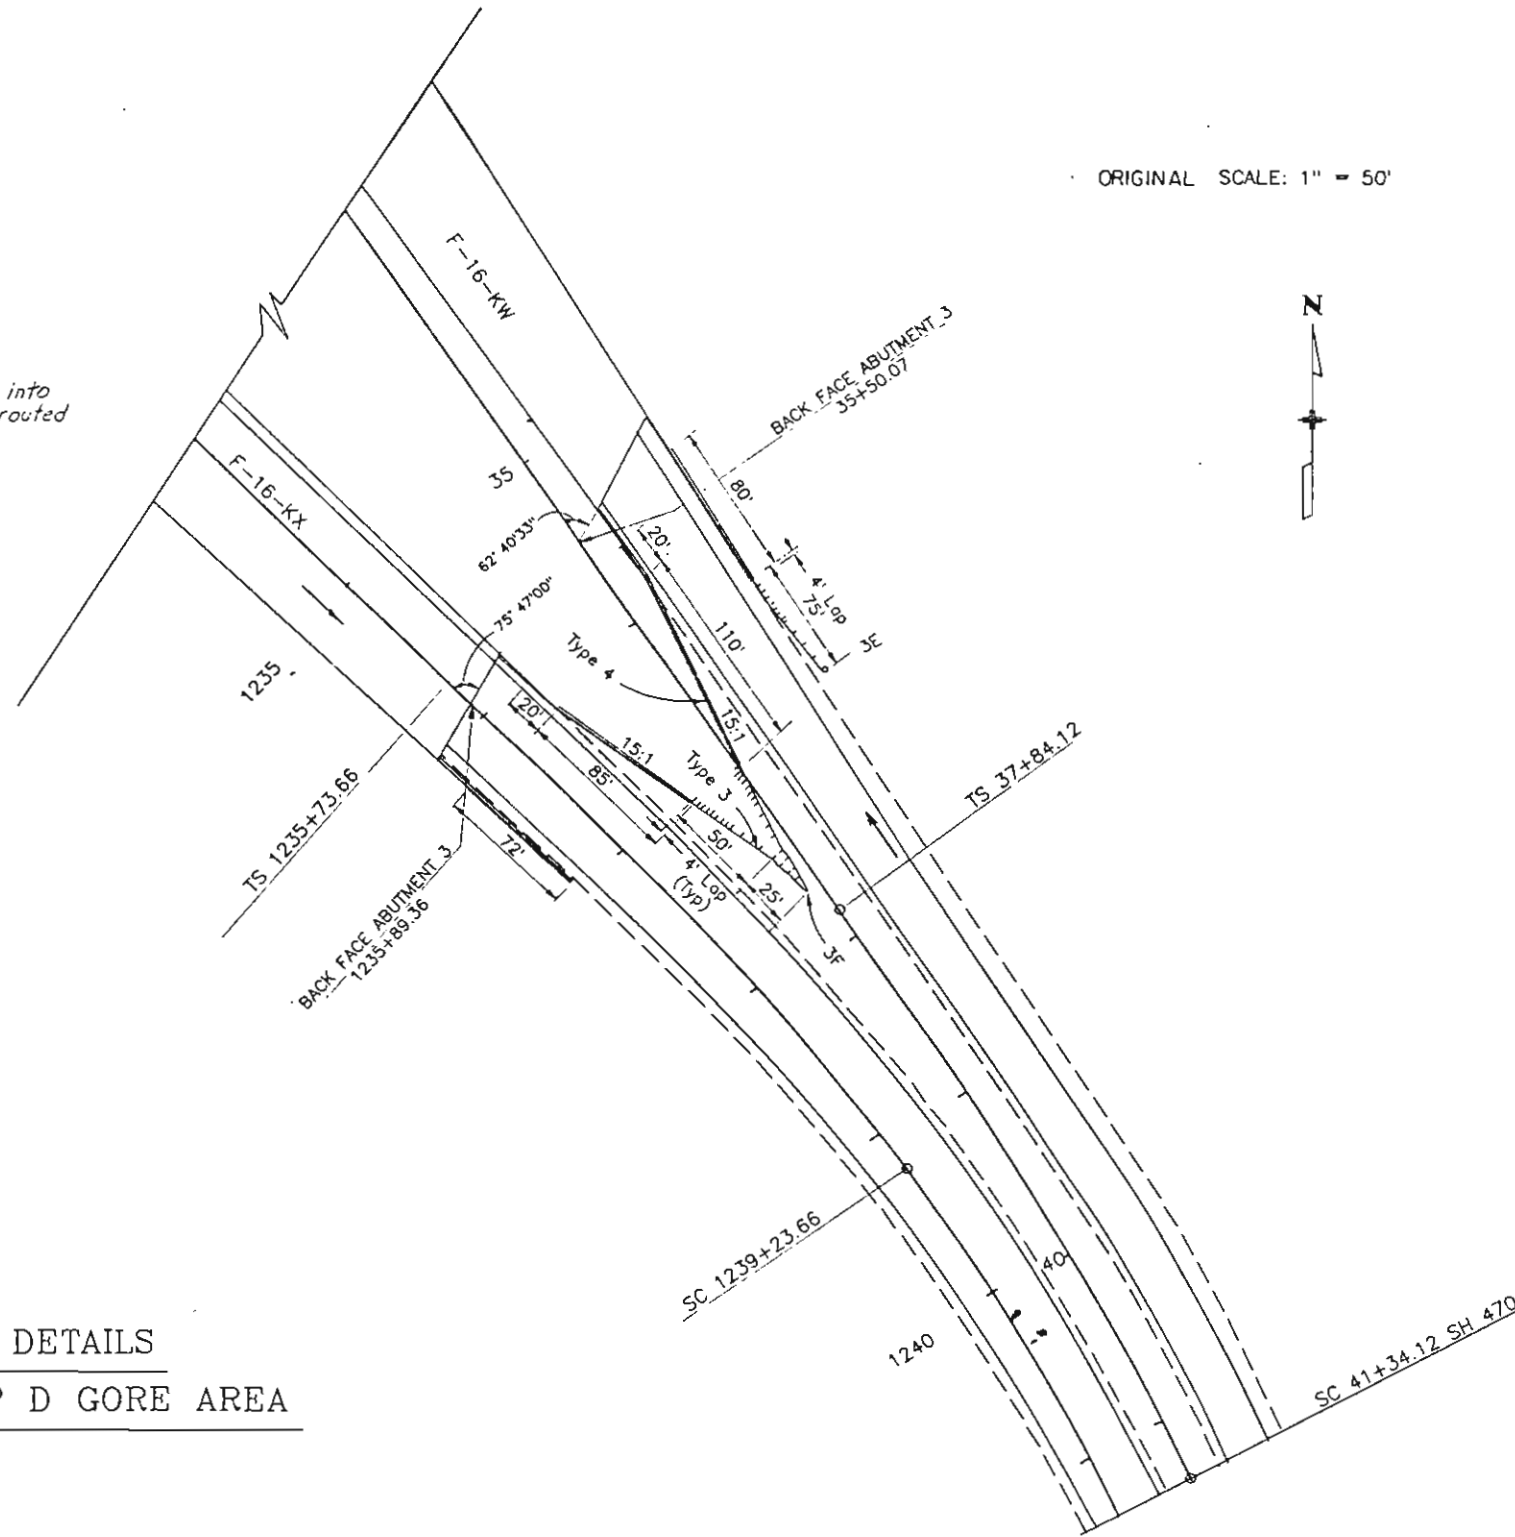


GUARD RAIL DETAILS
S.H. 470 AND RAMP D GORE AREA


AS CONSTRUCTED			
NO REVISIONS	12-12-87	REVISED	VOID

FEDERAL ROAD REGION NO.	DIVISION	PROJ. NO.	SHEET NO.	TOTAL SHEETS
XIII	COLORADO	170-3(140)	13	57

REVISIONS	

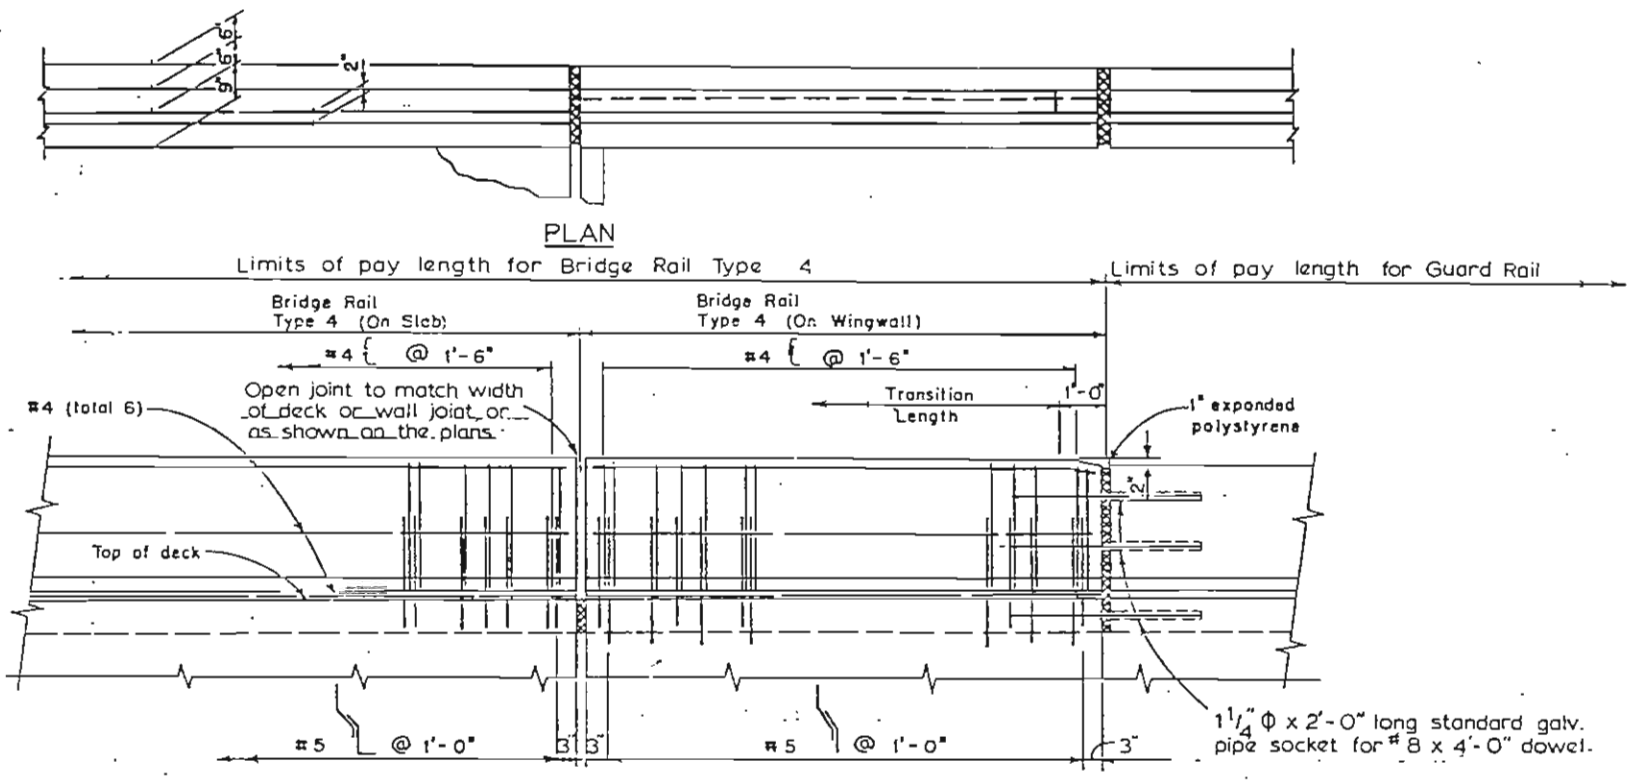

For additional details, see STD. M-606-12.

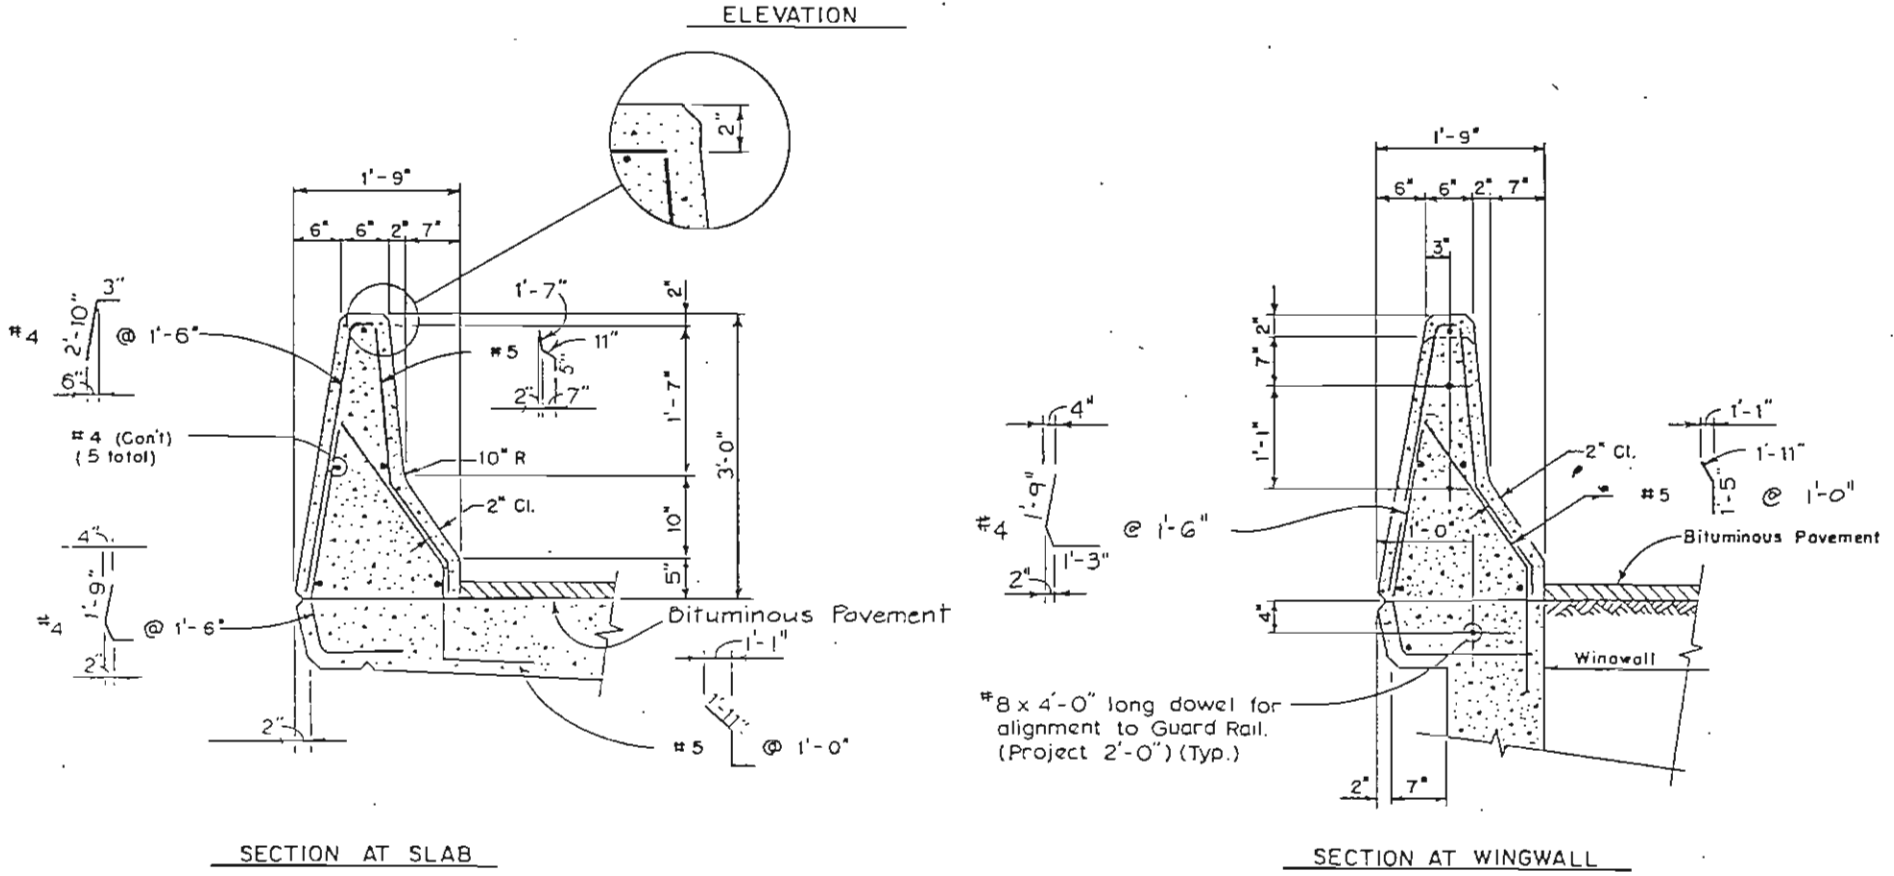

INFORMATION ONLY		
Description	Unit	Per Lin. Ft.
Concrete Class D	Cu. Yd.	0.11
Reinforcing Steel	Lb.	13.8

DIVISION OF HIGHWAYS

DETAIL FOR CONNECTION OF
GUARD RAIL TYPE 4 TO
BRIDGE RAIL TYPE 4
— SPECIAL

Designer CDOH	Structure
Detailer K. Lower	Numbers
Drawing Number B	of Drawings


CHECKED BY: M.D.A. 6:03
 QUANTITIES BY: S.L.W. 7:07
 DRAWN BY: J.D. 7:19
 DATE: 12-12-87

I 70 & S.H. 470 INTERCHANGE LIGHTING PLAN

FEDERAL ROAD DISTRICT NO.	DIVISION	PROJ. NO.	SHEET NO.	TOTAL SHEETS
VIII	COLORADO	170-3(140)	14	57
AS CONSTRUCTED				
NO REVISIONS	REVISED	12-12-81	VOID	

--- ORIGINAL CONTOUR
 — FINISHED CONTOUR
 4' CONTOUR INTERVAL

NOTE: ALL CONTOURS ARE EXISTING

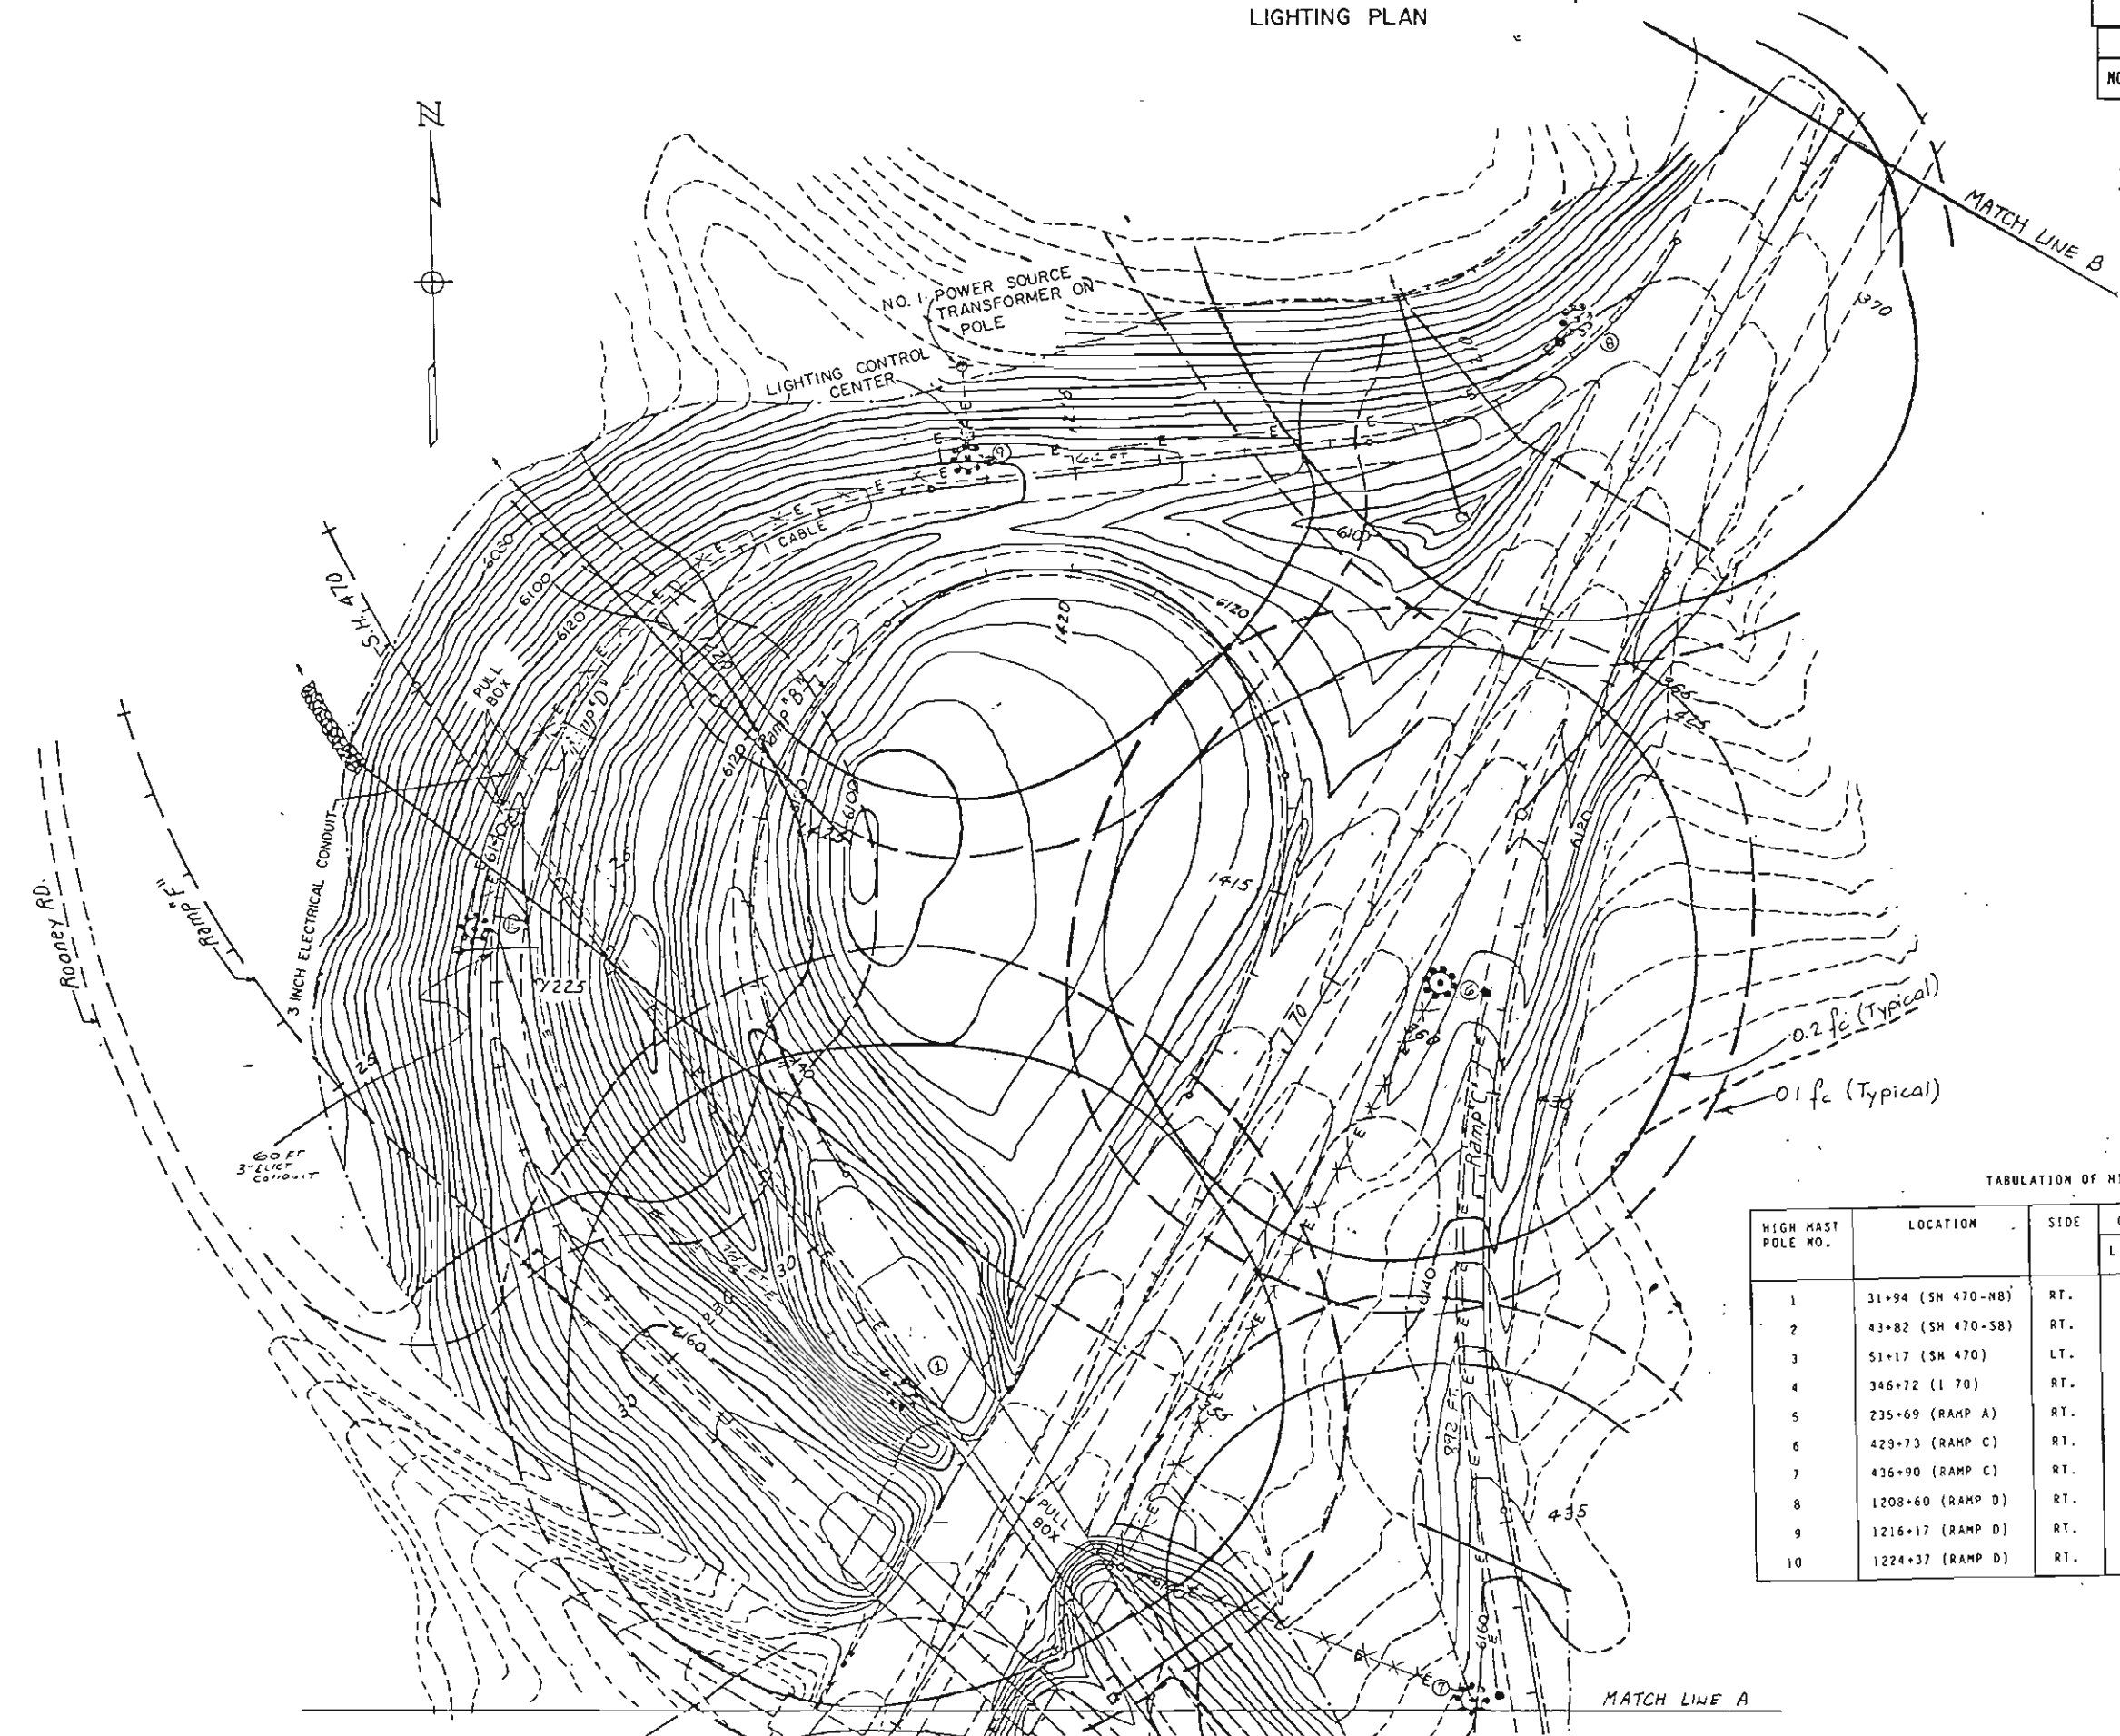

TABULATION OF HIGH MAST POLE LOCATIONS

HIGH MAST POLE NO.	LOCATION	SIDE	OFFSET LIN. FT.	BASE ELEVATION (TOP OF CAISSON)	HIGH MAST POLE COORDINATES	
					NORTH	EAST
1	31+94 (SH 470-NB)	RT.	6	6134.0	684848.462	2066710.930
2	43+82 (SH 470-SB)	RT.	85	6198.0	683818.665	2087240.693
3	51+17 (SH 470)	LT.	130	6212.0	683090.750	2087434.271
4	346+72 (I 70)	RT.	185	6186.0	684082.758	2086686.297
5	235+69 (RAMP A)	RT.	35	6176.0	683488.698	2086300.941
6	423+73 (RAMP C)	RT.	75	6122.0	685330.988	2087333.699
7	436+90 (RAMP C)	RT.	70	6160.0	684493.634	2087362.524
8	1208+60 (RAMP D)	RT.	35	6100.0	686098.403	2087494.266
9	1216+17 (RAMP D)	RT.	35	6120.0	685934.724	2086790.834
10	1224+37 (RAMP D)	RT.	36	6140.0	685393.982	2086204.907

FEDERAL ROAD DISTRICT NO.	DIVISION	PROJ. NO.	SHEET NO.	TOTAL SHEETS
VIII	COLORADO	I 70-3(140)	15	57
AS CONSTRUCTED				
NO REVISIONS		REVISED 12-12-82	VOID	

I 70 & SH 470 INTERCHANGE LIGHTING PLAN

--- ORIGINAL CONTOUR
 ——— FINISHED CONTOUR
 4' CONTOUR INTERVAL

NOTE: ALL CONTOURS ARE EXISTING



MATCH LINE A



I 70


SH 470
 54+47
 70 FT. 2" ELECT. CONDUIT

a.1 fc

0.2 fc

AS CONSTRUCTED		FED. ROAD REGION	DIVISION	PROJ. NO.	SHEET NO.	SHEET TOTALS
NO REVISIONS	REVISED 12-12-88	VOID	VIII	COLO.	170-3(140)	16
					57	57

I 70 & S.H. 470 INTERCHANGE LIGHTING PLAN

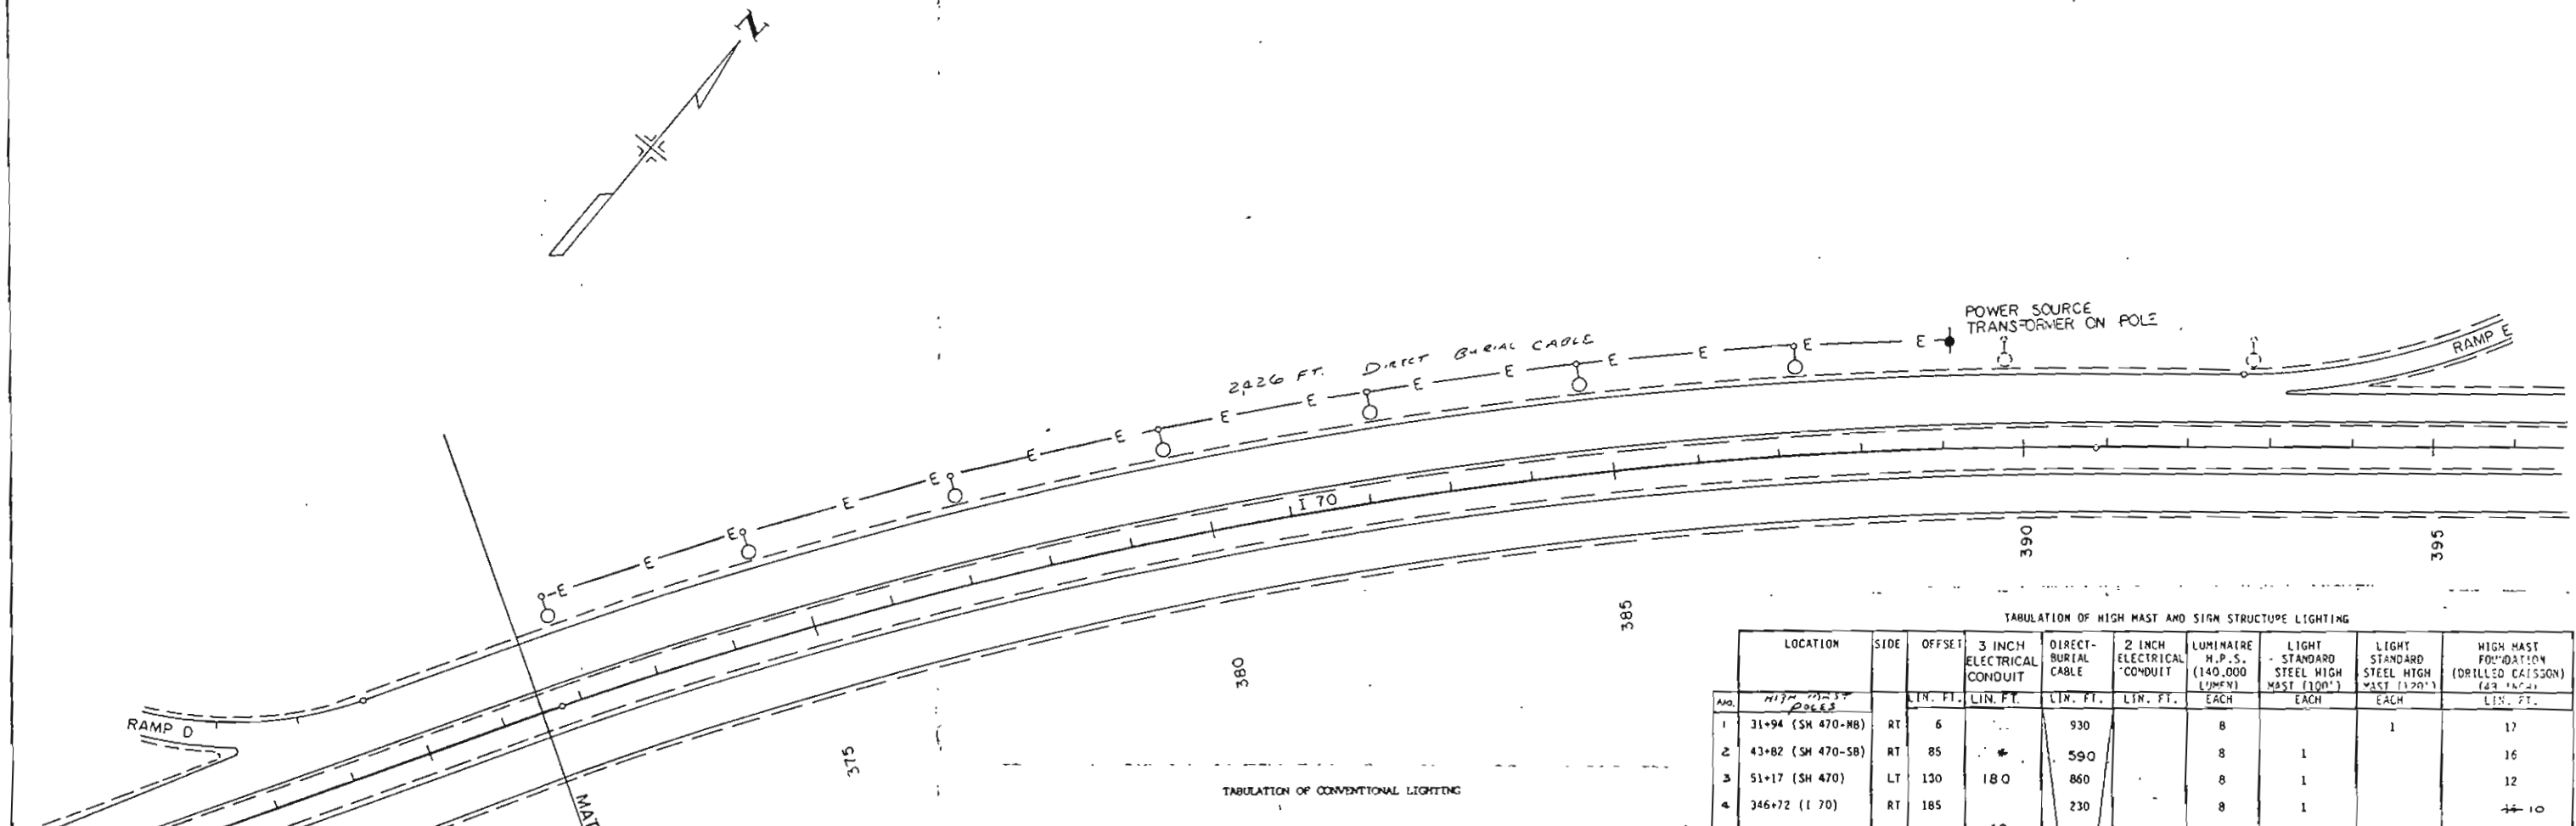

DIRECT BURIAL CABLE	LIN. FT.
HIGH MAST POLES	
R 1-10	860
R 11-13	767
R 14-15	827
R 16-17	892
R 18-19	764
I 70	
314+ - 330+	1,461
372+ - 389+ LT	2,426
I 70 - ROONEY RD.	325
354+ (E10) - SIGN # 31	103
C 470	
54+ - 69+	1,471
SIGN # 69	213
69+ 50	
HIGH MAST POLE # 8 -	
SIGN # 12	248
TOTAL	10,357

LOCATION	SIDE	DIRECT-BURIAL CABLE (LIN. FT.)	LUMINAIRE H.P.S. (50,000 LUMEN) EACH	LIGHT STANDARD METAL (40') EACH	CONCRETE FOUNDATION PAD EACH	LUMINAIRE H.P.S. (WALL TYPE) (12,000 LUMEN) EACH
I 70						
371+05	LT.	255	1	1	1	
374+50	LT.	255	1	1	1	
377+05	LT.	255	1	1	1	
379+60	LT.	255	1	1	1	
382+15	LT.	255	1	1	1	
384+70	LT.	255	1	1	1	
387+25	LT.	200	1	1	1	
SH 470						
70+00 (C2C)	LT. & RT.					6
TOTALS		1,730	7	7	7	6

NO.	LOCATION	SIDE	OFFSET (LIN. FT.)	3 INCH ELECTRICAL CONDUIT (LIN. FT.)	DIRECT-BURIAL CABLE (LIN. FT.)	2 INCH ELECTRICAL CONDUIT (LIN. FT.)	LUMINAIRE H.P.S. (140,000 LUMEN) EACH	LIGHT STANDARD STEEL HIGH MAST (100') EACH	LIGHT STANDARD STEEL HIGH MAST (120') EACH	HIGH MAST FOUNDATION (DRILLED CAISSON) (48" DIA) (LIN. FT.)
1	31+94 (SH 470-NB)	RT	6		930		8		1	17
2	43+82 (SH 470-SB)	RT	85	*	590		8	1		16
3	51+17 (SH 470)	LT	130	180	860		8	1		12
4	346+72 (I 70)	RT	185		230		8	1		10
5	235+69 (RAMP A)	RT	35	40	700		8	1		16
6	428+73 (RAMP C)	RT	75		750		8	1		15
7	436+90 (RAMP C)	RT	70		900		8	1		16
8	1208+60 (RAMP D)	RT	35		730		8	1		17
9	1216+17 (RAMP D)	RT	35		700		8	1		17
10	1224+37 (RAMP D)	RT	36	60	810		8	1		17
SIGN STRUCTURES										
SH 470										
	54+00 TO 70+00	LT&RT			1800		70			
	54+47	MID					155			
	60+18	LT&RT								
	69+00	RT					50			
I 70										
	314+00 TO 348+63	RT			3510		40			
	337+50	RT					50			
	354+45	LT			90					
	420+50 TO 425+00	LT			450					
TOTALS				280	12,450	305	80	9	1	153


WIRING FOR LIGHTING WILL BE PAID FOR AS LUMP SUM

IT IS ESTIMATED THAT 1 PORTABLE POWER UNIT, 10 LOWERING DEVICES (1 PER HIGH MAST POLE), AND 2 LIGHTING CONTROL CENTERS (LOCATIONS AS SHOWN IN PLANS) WILL BE REQUIRED FOR THIS PROJECT.
* IT IS ESTIMATED THAT 40 LIN. FT OF 3 INCH ELECTRICAL CONDUIT (JACKED) WILL BE REQUIRED FOR THIS PROJECT DELETED MCR 40-20


AS CONSTRUCTED			
NO REVISIONS	12-12-88	REVISED	VOID

ROADWAY LIGHTING HIGH MAST

FED. RD. REG. NO.	DIVISION	PROJECT NO.	SHEET NO.
170	COLORADO	170-3(140)	17

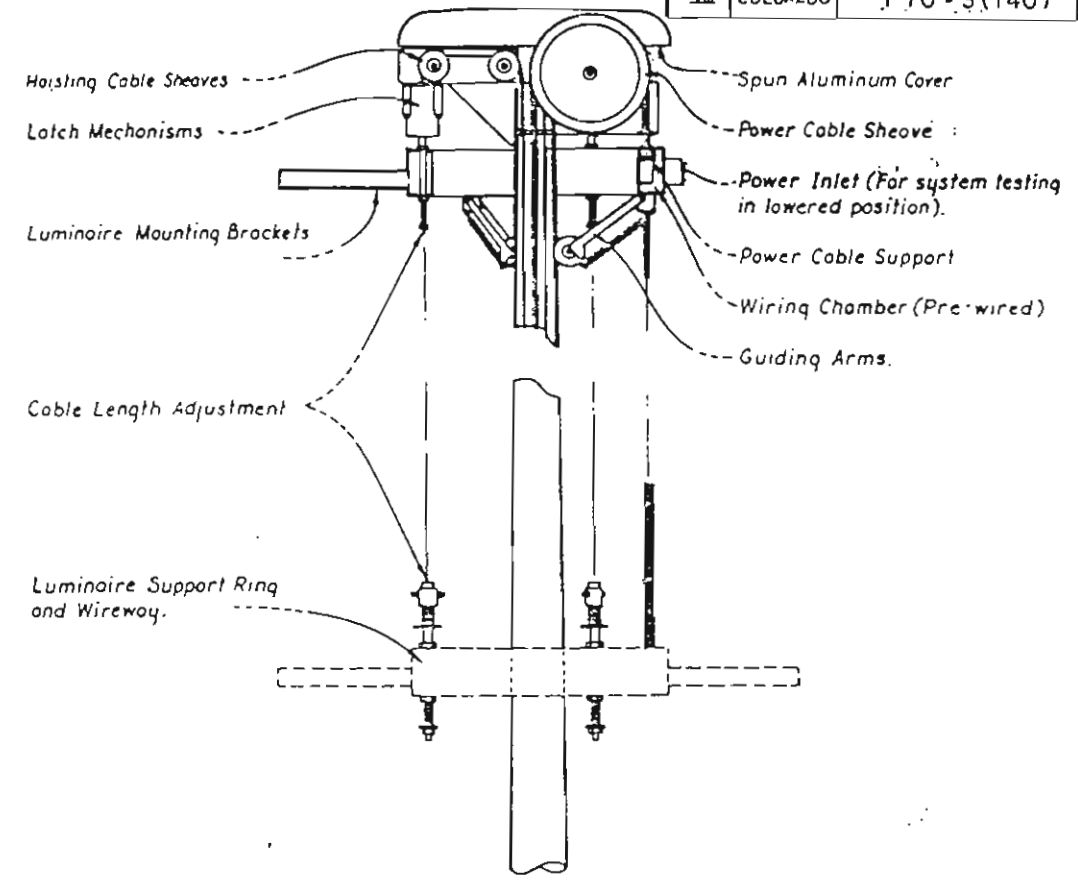


RAISING AND LOWERING DEVICE DETAIL "E"

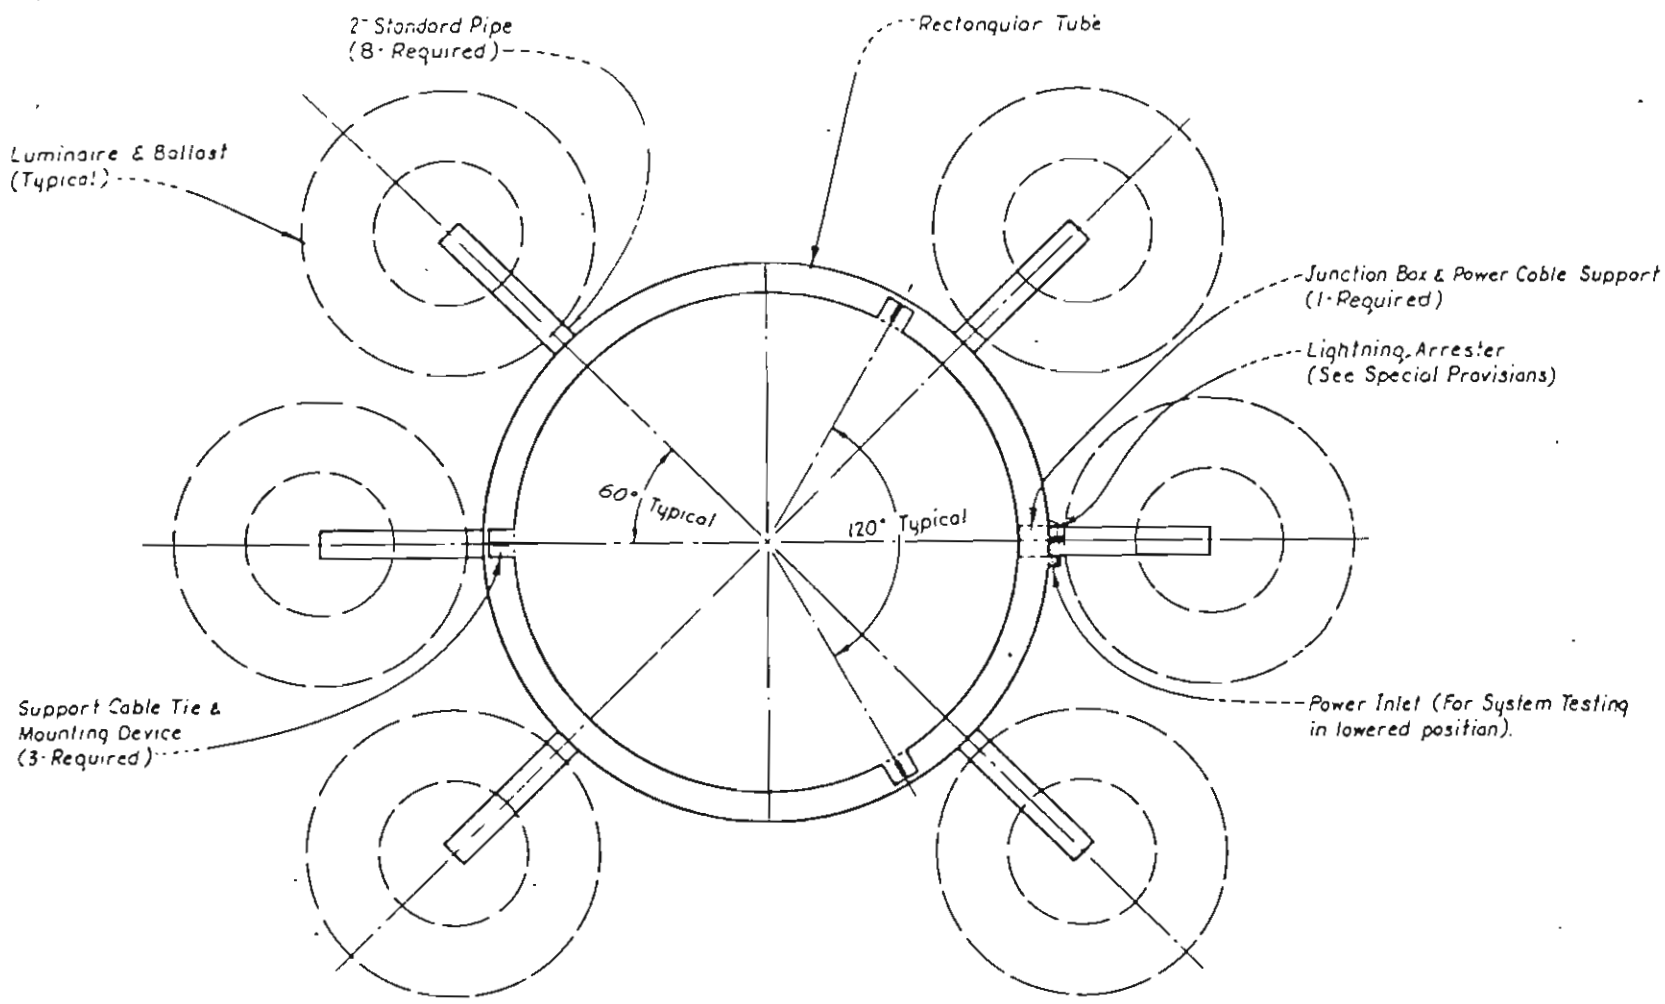

**LUMINAIRE SUPPORT ASSEMBLY
DETAIL "C"**

NOTE: 8 LUMINAIRES THIS PROJECT.

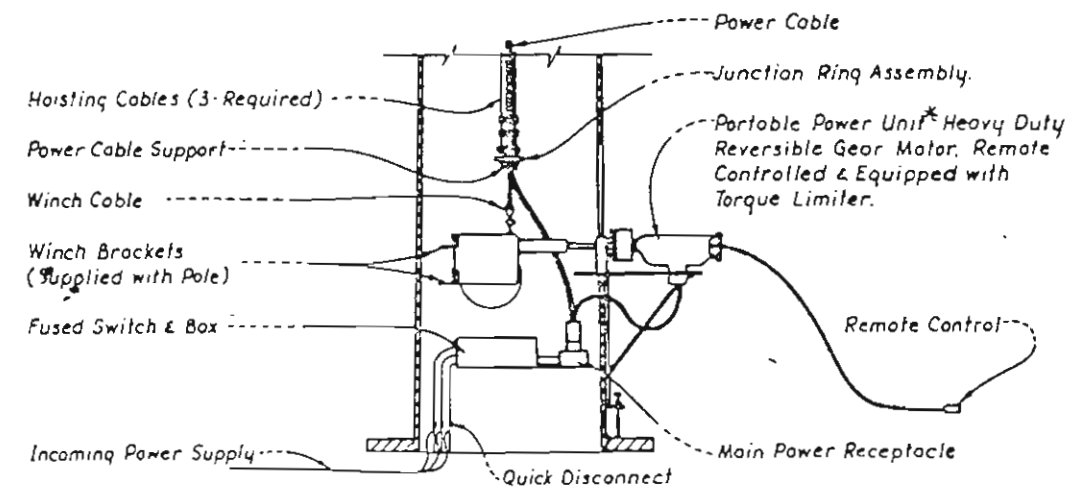


**POLE BASE
DETAIL "G"**

* Plug must fit into main power receptacle.


ROADWAY LIGHTING PLAN HIGH MAST

AS CONSTRUCTED		FED ROAD REG NO	DIVISION	PROJECT NO.	SHEET NO.
NO REVISIONS	12-12-88	REVISED	VOID	VIII	COLO.
				170-3(140)	18


Entrance head should be located just below transformer and lead made long enough for direct connection to transformer

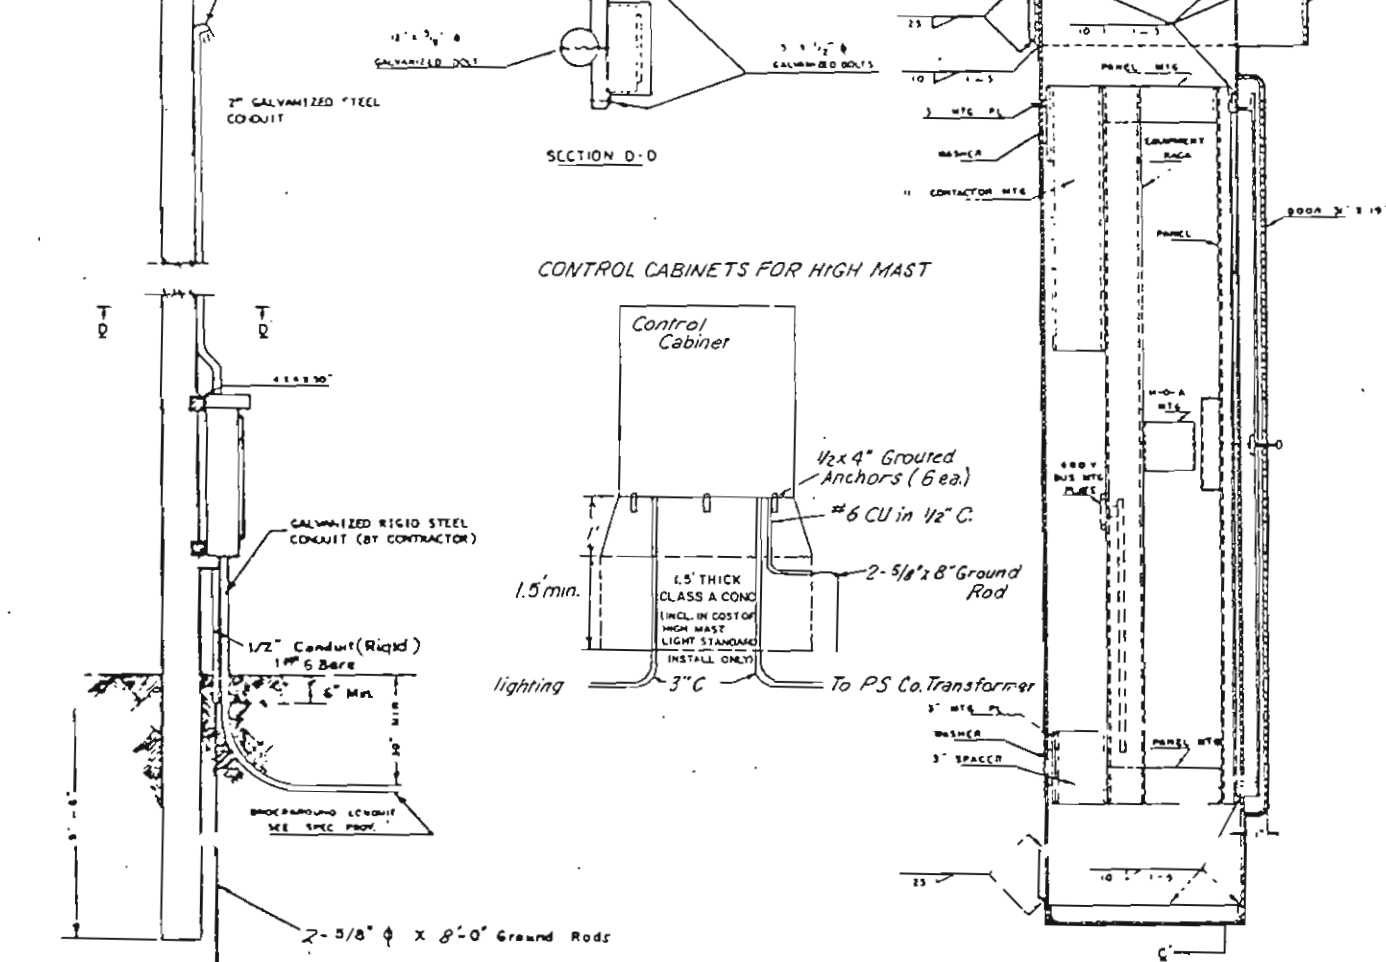


CONTROL CABINETS FOR HIGH MAST

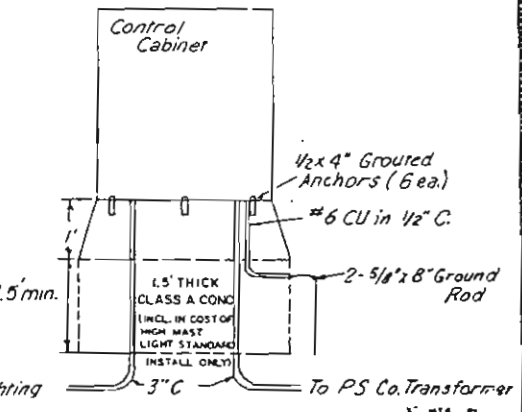

CABINET WIRING SCHEMATIC

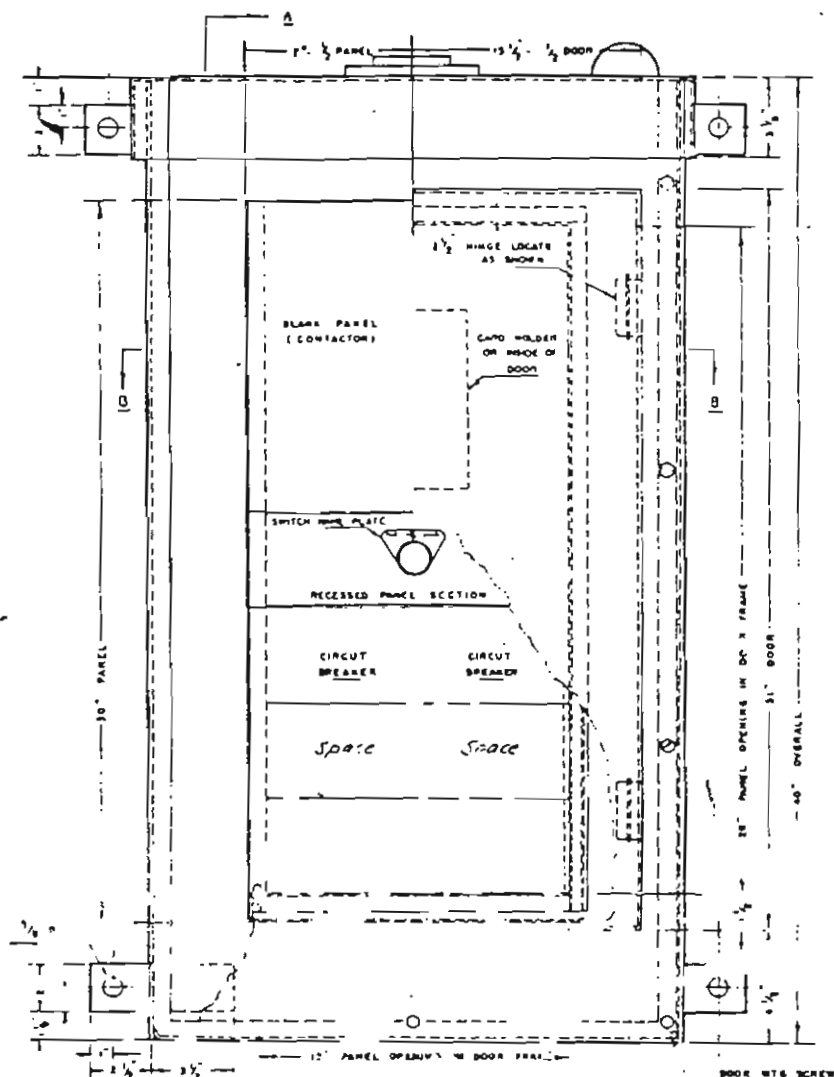

ELEVATION
SCALE 3/4\"/>


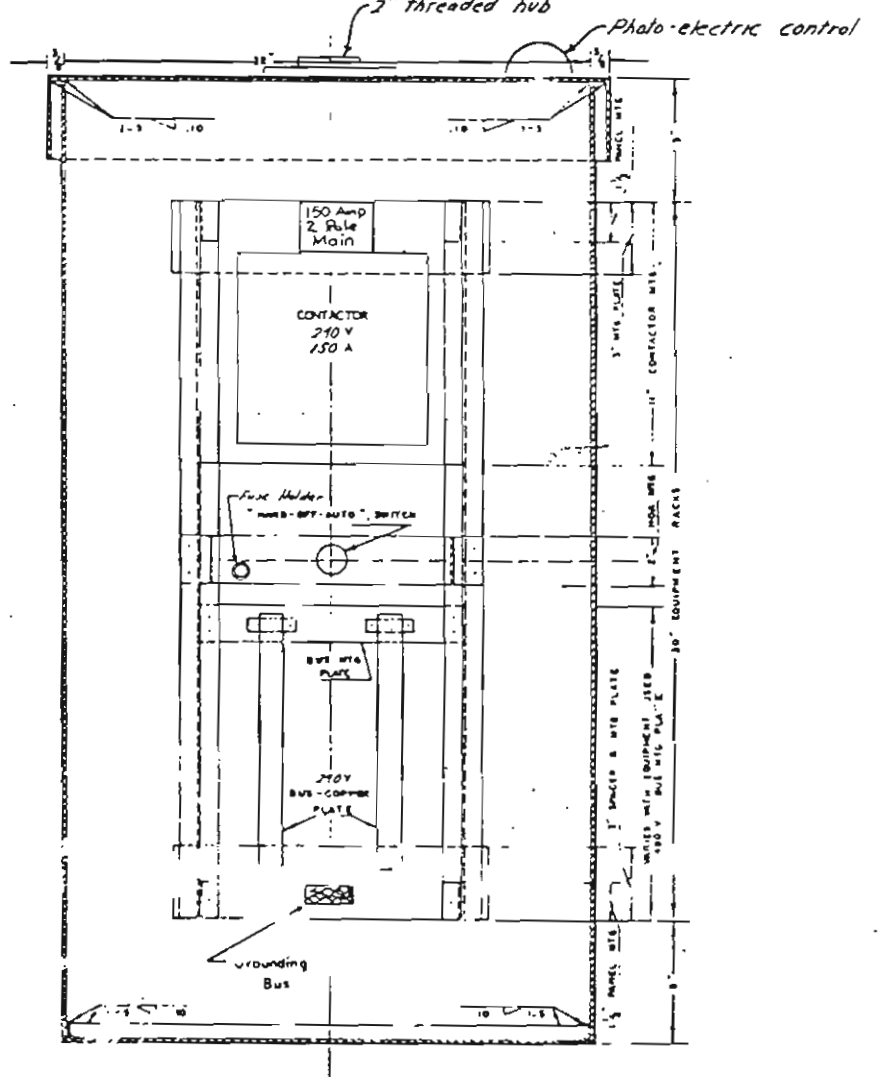


SECTION C-C

NOTES

DOOR & FRAME	12 GA
CABINET & MOOD	18 GA
PANEL	14 GA
EQUIPMENT RACK & INTERIOR MOUNTING PLATES	18 GA
DOOR, PANEL OPENING & PANEL TO BE CENTERED ON FRONT OF CABINET	
ALL FERROUS SHEET METAL & PLATES TO BE GALVANIZED	
CABINET, MOOD, PANEL, DOOR & FRAME TO BE PAINTED ONE PRIME COAT IN SHOP	
EXTERIOR SURFACE OF CABINET, MOOD, DOOR & FRAME TO BE FIELD PAINTED WITH ALUMINUM PAINT OR AS SPECIFIED	
OFF-AUTOMATIC SWITCH SHALL BE KEY OPERATED. KEY SHALL NOT BE REMOVABLE IN OFF POSITION	

DIMENSIONS SHOWN ARE TYPICAL AND MAY BE CHANGED TO ALLOW FOR CLEARANCE BY EQUIPMENT AND FABRICATING TOLERANCES

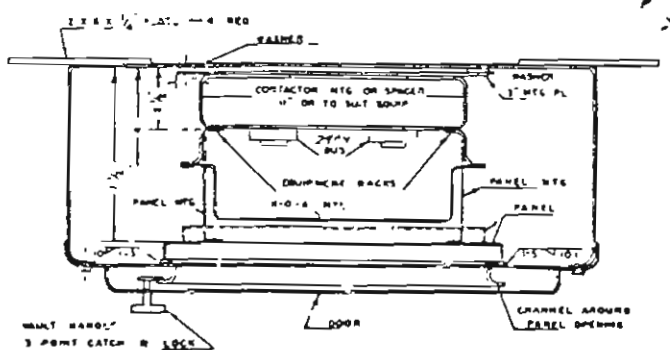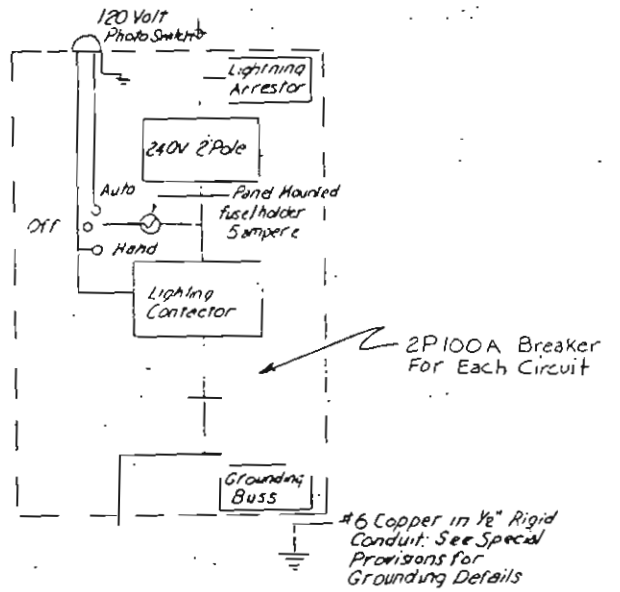

SECTION B-B

LIGHTING CONTROL CENTER

NOTES: (ELECTRICAL SERVICE)

THE CONTRACTOR SHALL COORDINATE HIS WORK WITH THE LOCAL UTILITY SERVICING THIS PROJECT. ELECTRICAL POWER SHALL BE FURNISHED AT THE APPROXIMATE LOCATION SHOWN IN THE PLANS TO THE SECONDARY SIDE OF THE TRANSFORMER. THE CONTRACTOR SHALL FURNISH AND INSTALL ALL NECESSARY CABLE, CONDUIT, PLANTS, CONTROL CABINET AND ALL RELATED PARTS FOR THE "LIGHTING CONTROL CENTER" SHOWN IN THE PLANS AND AS FURTHER DESCRIBED IN THE PLANS.

THE MINIMUM SIZE OF ELECTRICAL CABLE FOR THE PHOTOCELL CIRCUIT SHALL BE NO. 12 AWG. THE MINIMUM SIZE OF CONDUCTOR FURNISHED FOR ELECTRICAL SERVICE SHALL BE NO. 300 MCM COPPER OR NO. 500 MCM ALUMINUM.

NOTE: CABINET WILL BE CONSTRUCTED TO TAKE 500 MCM WIRING.


THE LIGHTING CONTROL CENTERS SHALL EACH CONTAIN THE FOLLOWING:

- ONE GROUNDING BUSS LOCATED NEAR THE BOTTOM OF THE CABINET. IN ADDITION TO THE TERMINALS NECESSARY FOR CONNECTING THE SERVICE DROP AND CONTROL WIRING THE BUSS SHALL HAVE AT LEAST 4 LUGS FOR TERMINATING UP TO 4/0 ALUMINUM (AL) OR 2/0 COPPER (CU) AND 4 LUGS FOR TERMINATING UP TO NO. 6 AL OR CU.
- ONE 120 VOLT PHOTO ELECTRIC CONTROL MOUNTED ON TOP OF CONTROL CABINET. IT SHALL BE VANDAL RESISTANT, WEATHERPROOF AND CAPABLE OF OPERATING THE INDUCTIVE LOAD OF THE CONTACTOR.
- ONE 240 VOLT LIGHTING CONTACTOR WITH A 120 VOLT COIL.
- ONE SINGLE POLE 3 POSITION SWITCH WITH PLATE MARKED HAND-OFF-AUTO.
- ONE LIGHTNING ARRESTOR
- ONE PANEL MOUNTED MINIATURE FUSE AND HOLDER.
- CIRCUIT BREAKERS AS REQUIRED SHALL HAVE LUGS APPROVED FOR AL OR CU WIRE AND BE CAPABLE OF INTERRUPTING AVAILABLE FAULT CURRENT.
- ONE THREE-CATCH CABINET LOCK KEYED IF POSSIBLE TO MATCH ONE OF UTILITY COMPANY'S STANDARD KEYS.

ROADWAY LIGHTING HIGH MAST

AS CONSTRUCTED			
NO REVISIONS	12 12 28	REVISED	VOID


FEDERAL ROAD REGION NO.	DIVISION	PROJECT NO.	SHEET NO.
XXX	COLORADO	1 70 - 3 (140)	19

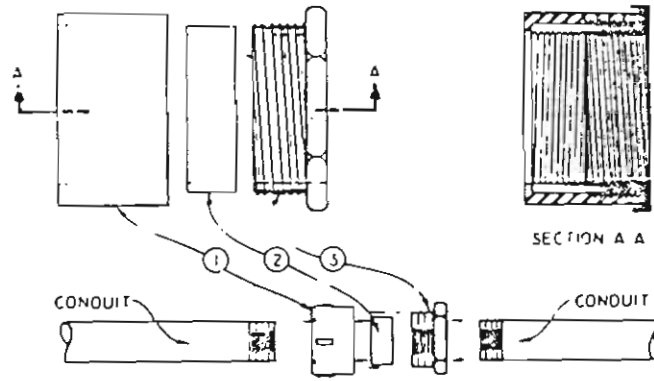


SLEEVE DETAIL

LEGEND

- LUMINAIRE AND BALLAST ASSEMBLIES
- FUSES
- DISCONNECT

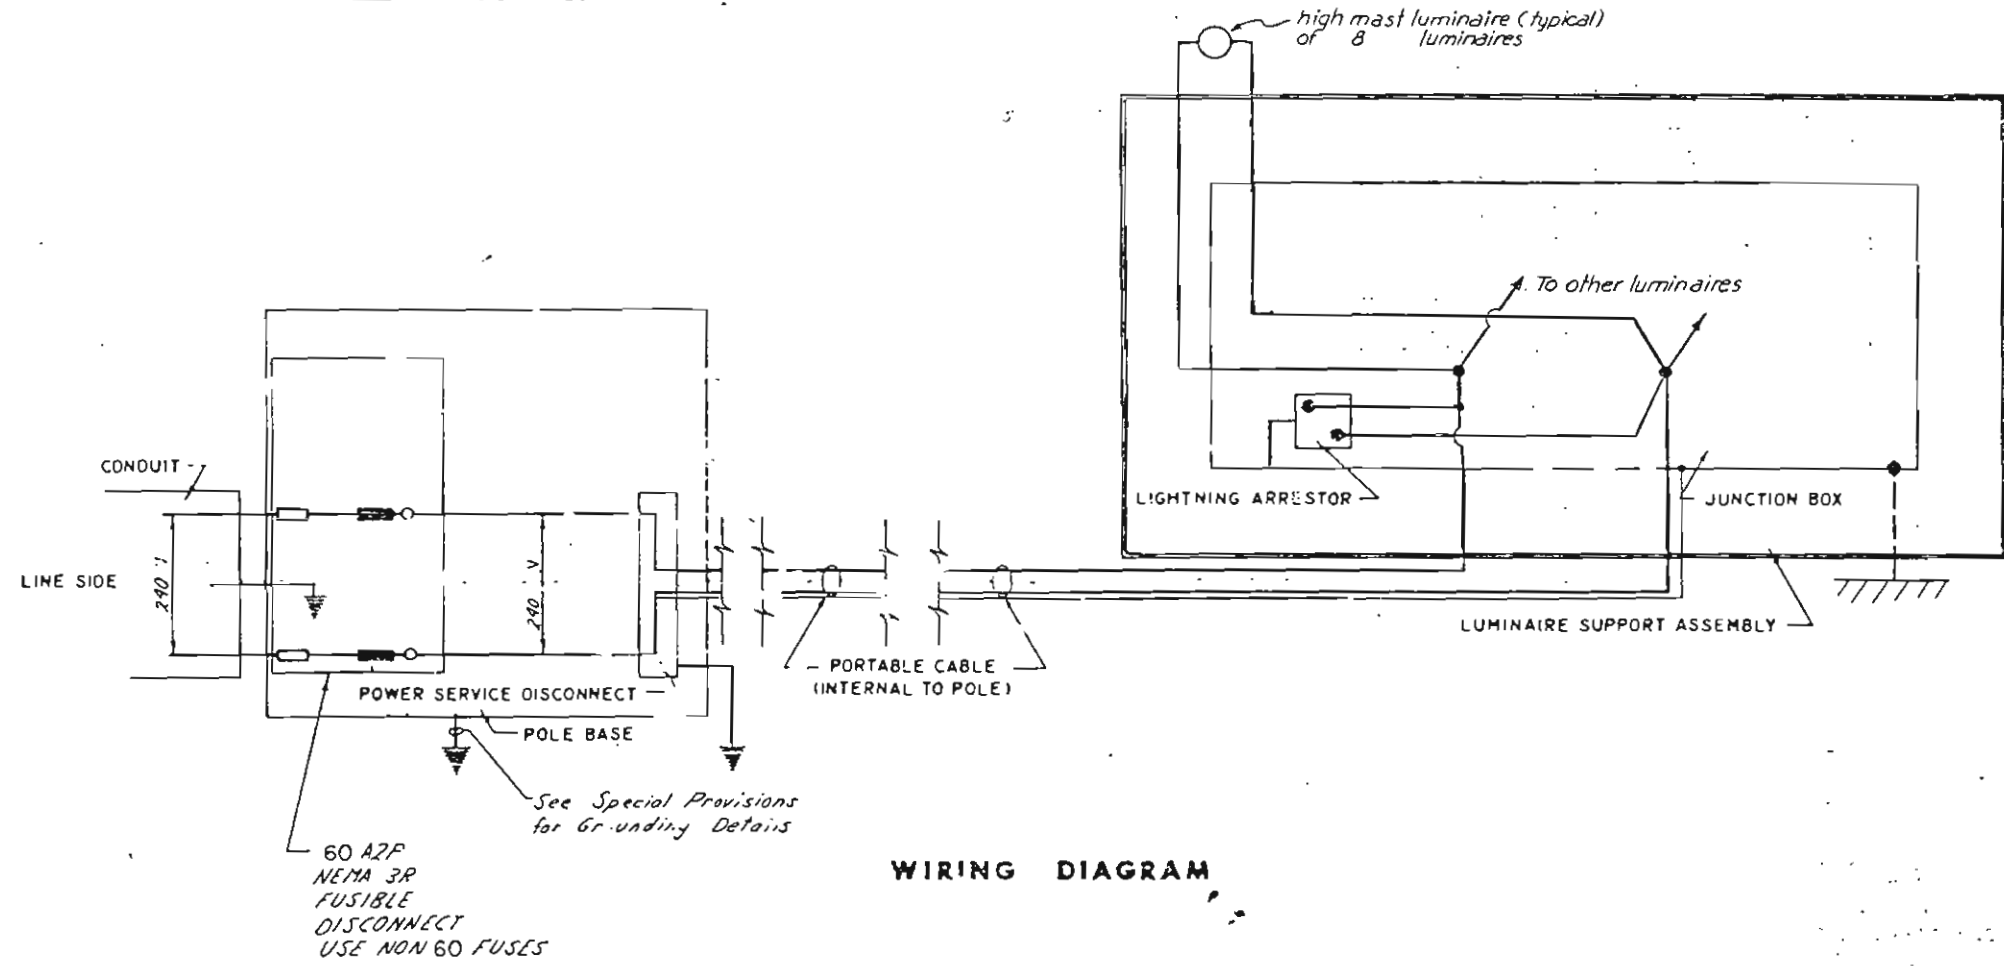

WIRING DIAGRAM

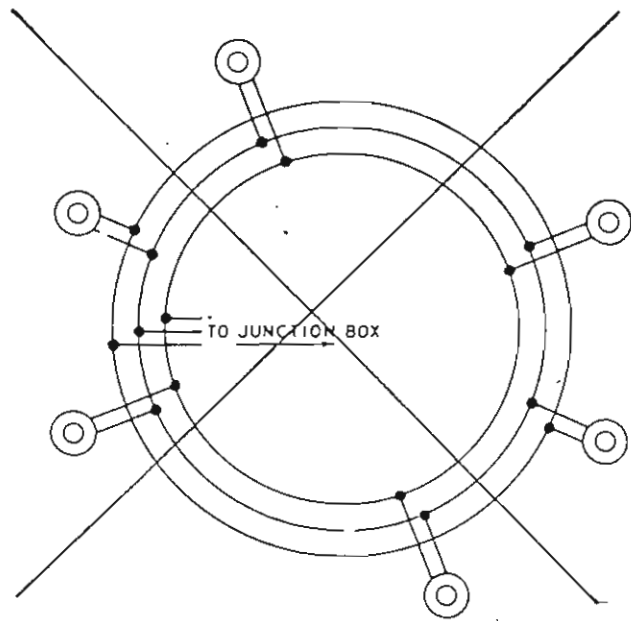

high mast luminaire (typical)
of 8 luminaires

To other luminaires

LIGHTNING ARRESTOR

JUNCTION BOX

LUMINAIRE SUPPORT ASSEMBLY

CONDUIT

LINE SIDE

240 V





POLE BASE

POWER SERVICE DISCONNECT


PORTABLE CABLE
(INTERNAL TO POLE)

ROADWAY LIGHTING HIGH MAST


AS CONSTRUCTED			REV. ROAD NO.	DIVISION	PROJECT NO.	SHEET NO.
NO REVISIONS	12-12-88	REVISED		VOID		
			VIII	COLO.	170-3(140)	20

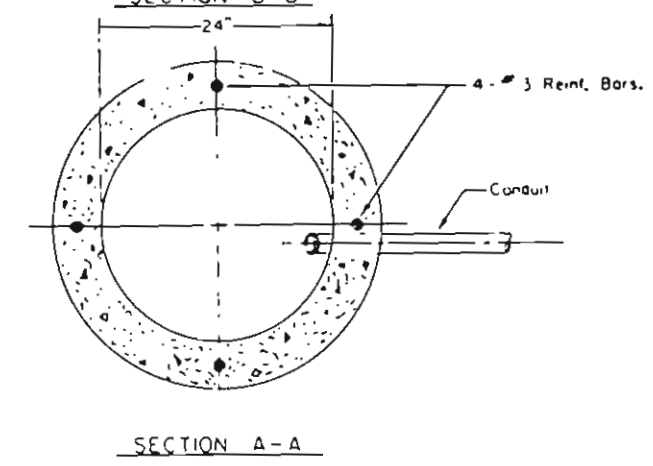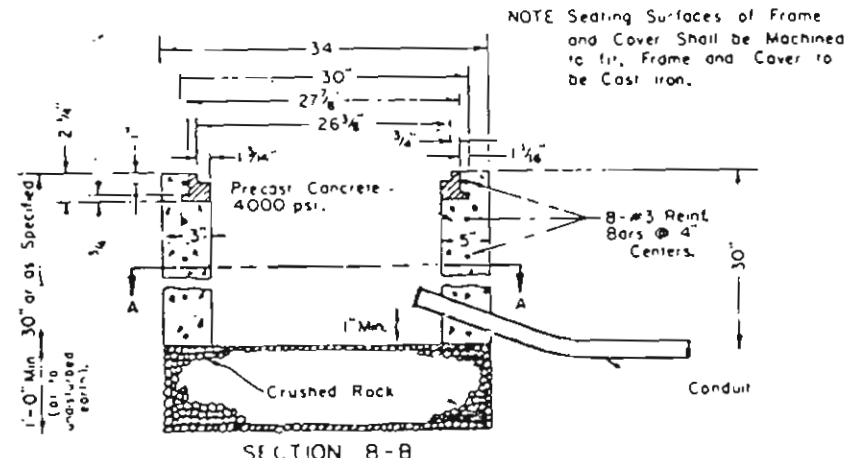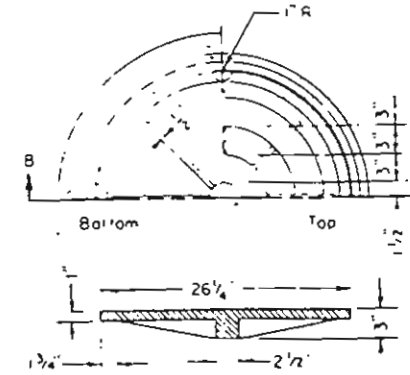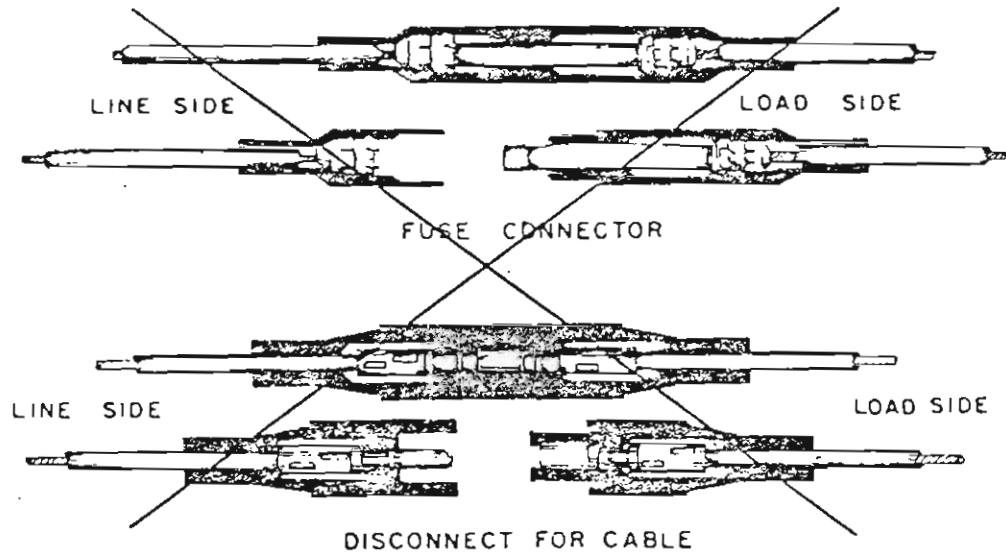

PULL BOX

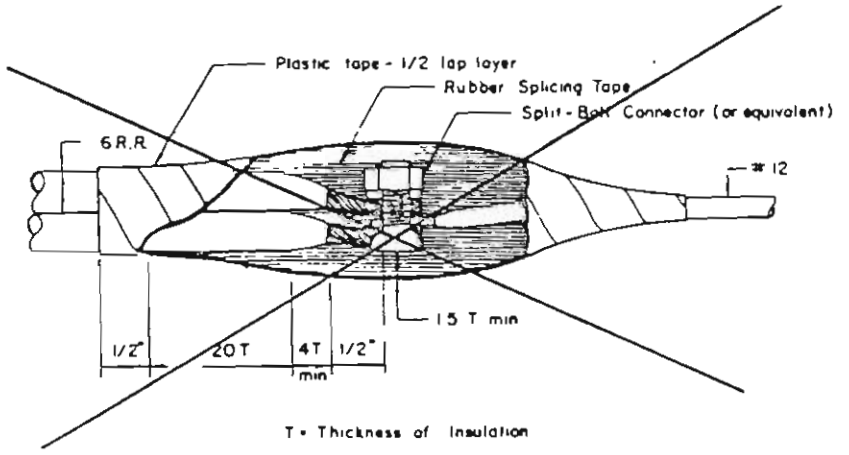

CABLE SPLICE

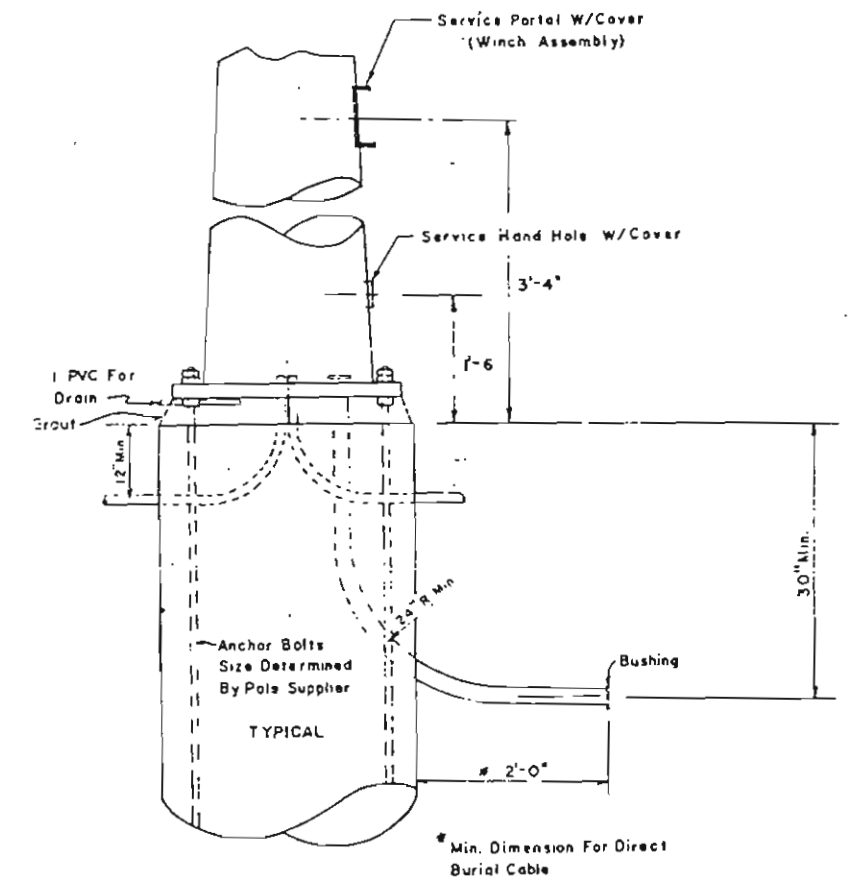

FOUNDATION NOTES

The Working Stress For Class "A" Concrete Shall Be 1200 p.s.i.


The Working Stress For Reinforcing Steel Shall Be 24,000 p.s.i.

Conduit, Ground Rods and Cable Not Shown.


ROADWAY LIGHTING HIGH MAST

AS CONSTRUCTED		
NO REVISIONS	12-12-8X	REVISED
		VOID


FEDERAL ROAD REGION NO.	DIVISION	PROJECT NO.	SHEET NO.
XIII	COLORADO	170-3(140)	21

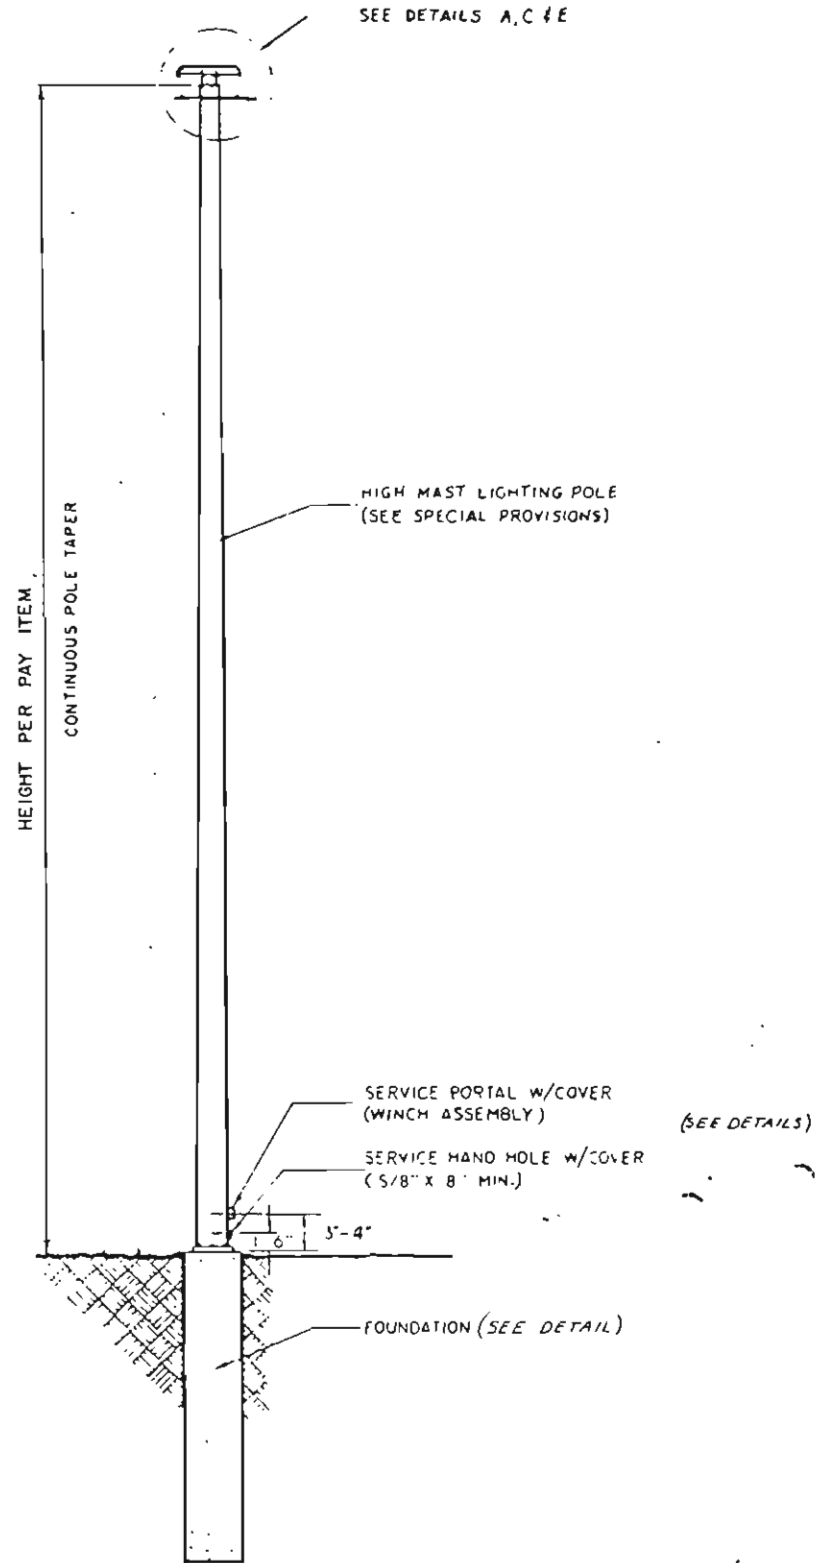

HIGH MAST LIGHTING UNIT

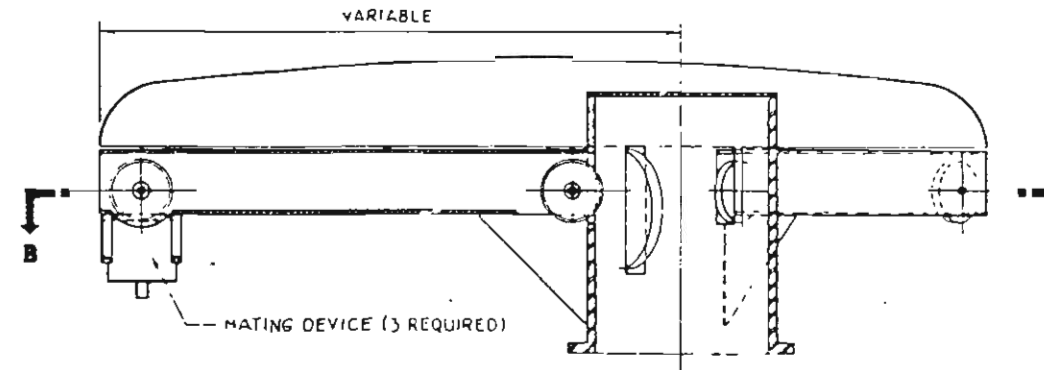

SECTION A-A
DETAIL A ELEVATION POLE TOP ASSEMBLY

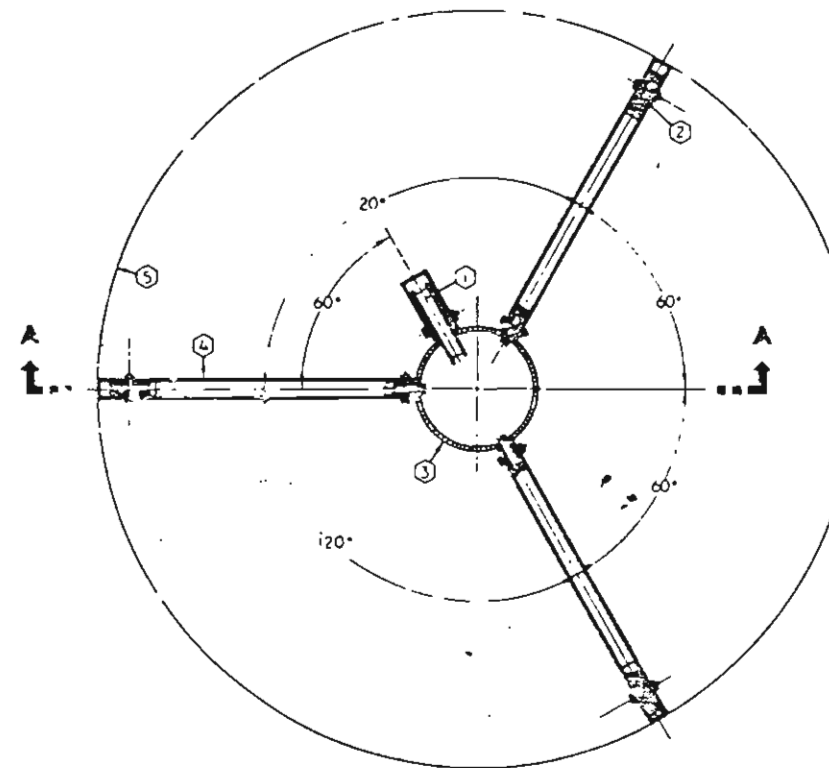

SECTION B-B

NOTES

- ① MINIMUM 8" DIA CABLE PULLEY (FOR PORTABLE ELECTRICAL CABLE)
- ② 4" DIA. SUPPORT CABLE PULLEY (6 REQUIRED)
- ③ POLE TOP (SCHEDULE 80 PIPE)
- ④ RECTANGULAR TUBE
- ⑤ HOOD

DETAILS FOR THE LOWERING SYSTEM ARE ONLY "FUNCTIONAL DRAWINGS" AND REPRESENT A TYPICAL LAYOUT
REQ'D. 1- POWER CABLE DISCONNECT AT BASE OF POLE


THE CONTRACTOR MAY SUBMIT FOR APPROVAL A LOWERING SYSTEM OF HIS OWN DESIGN PROVIDING IT MEETS THE REQUIREMENTS OF THE SPECIAL PROVISIONS AND AS APPROVED BY PUBLIC SERVICE COMPANY.

High Mast Lighting pole shall be an angular shape and weathering steel


AS CONSTRUCTED		
NO REVISIONS	12-12-88	REVISED
		VOID

FEDERAL ROAD REGION NO.	DIVISION	PROJ. NO.	SHEET NO.	TOTAL SHEETS
VIII	COLORADO	I 70-3(140)	22	57

REVISIONS	

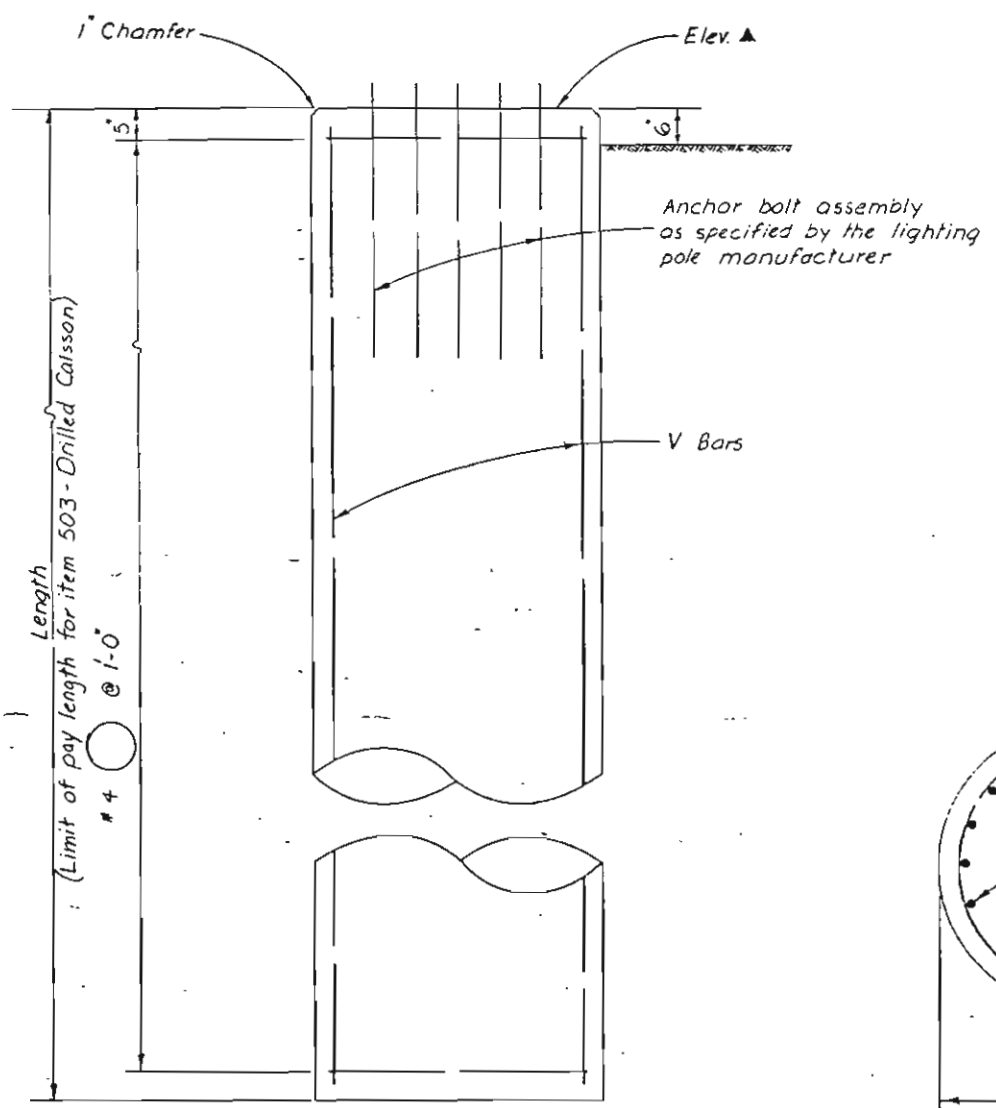

ELEVATION

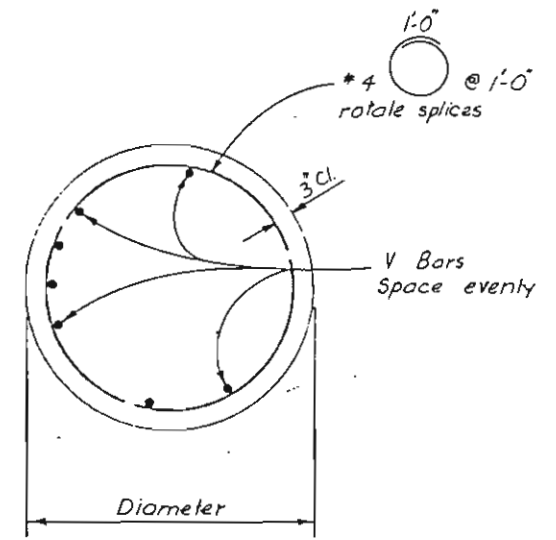

TYPICAL SECTION

Tower Station	Elev. ▲	Length	Diameter	Total V Bars	Size V Bars
*	*	17'-0"	4'-0"	23	#8
●	●	16'-0"	4'-0"	23	#8
51+17, 125' Lt. (470)	6212.0	12'-0"	4'-0"	23	#8
428+73, 75' Rt. (Ramp C)	6122.0	15'-0"	4'-0"	23	#8

Elevations shown shall be verified at time of construction by the Engineer. Concrete shall be Concrete Class A (Bridge).

QUANTITIES (ONE CAISSON)		
Tower Station	Concrete Class A (Cu. Yd.)	Reinforcing Steel (lb)
*	8	1186
●	8	1115
51+17, 125' Lt. (470)	6	858
428+73, 75' Rt. (Ramp C)	7	1044

For information only

- * Station 31+94, 6' Rt. (470-NB); Elev. 6134.0
- Station 1208+60, 30' Rt. (Ramp D); Elev. 6100.0
- Station 1216+17, 30' Rt. (Ramp D); Elev. 6120.0
- Station 1224+37, 36' Rt. (Ramp D); Elev. 6140.0
- Station 43+82, 75' Rt. (470-SB); Elev. 6198.0
- Station 346+72, 185' Rt. (70); Elev. 6186.0
- Station 235+69, 30' Rt. (Ramp A); Elev. 6176.0
- Station 436+90, 70' Rt. (Ramp C); Elev. 6160.0

DIVISION OF HIGHWAYS




CAISSON DETAIL

Designer <i>B. Pinkerton</i>	Structure
Dataller <i>B. Pinkerton</i>	Numbers
Drawing Number B 1 of 1 Drawings	


Revision Dates (Preliminary Stage Only)

AS CONSTRUCTED		FED ROAD REGION	DMSION	PROJ. NO.	SHEET NO.	SHEET TOTALS
NO REVISIONS	12-12-88	REMOVED	VOID	VIII	COLO.	170-3(140) 23 57

LIGHTING WIRING DESIGN

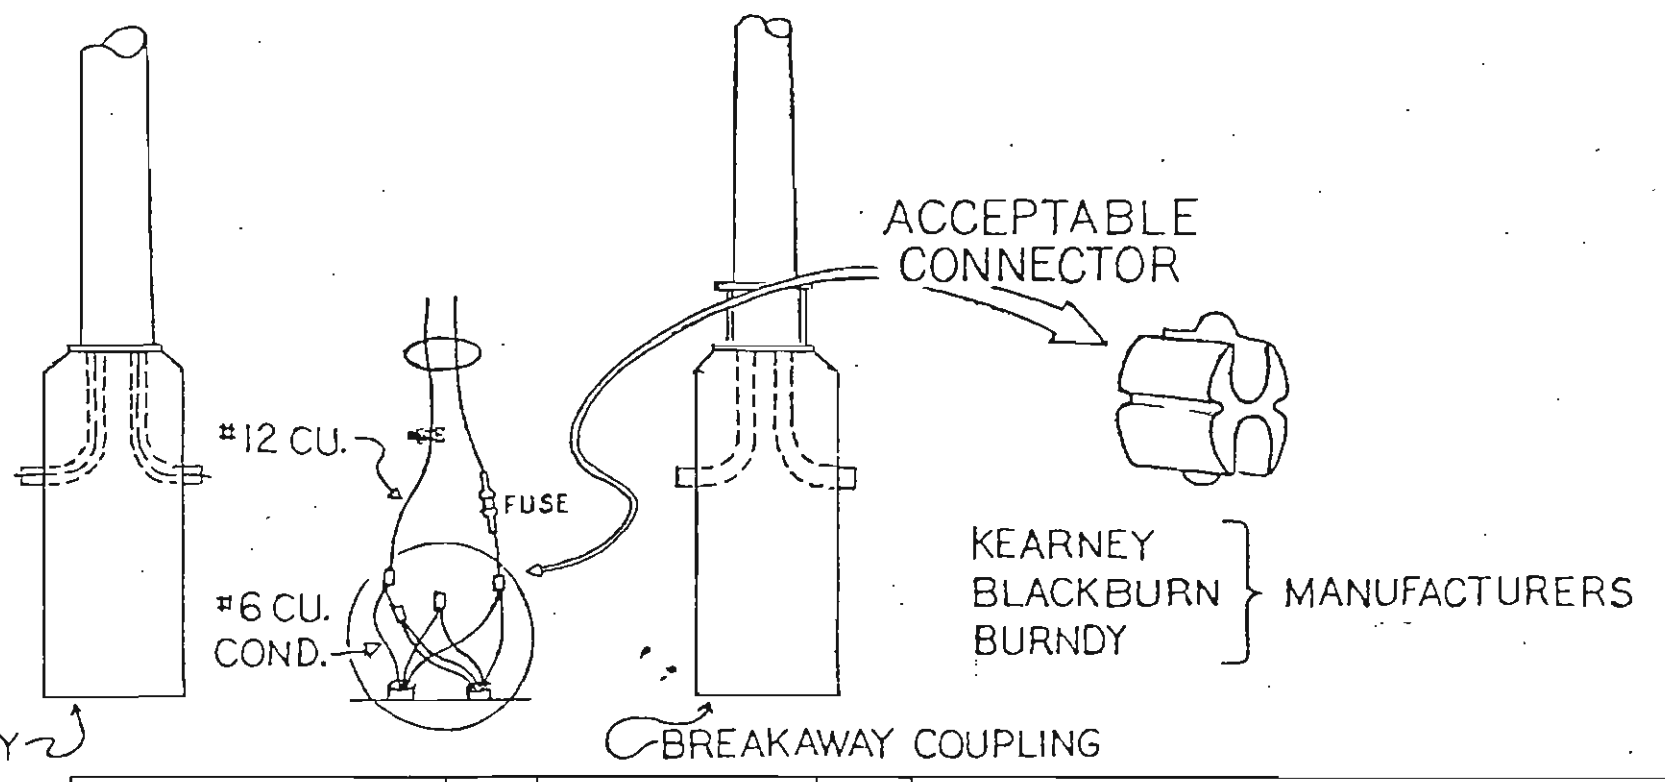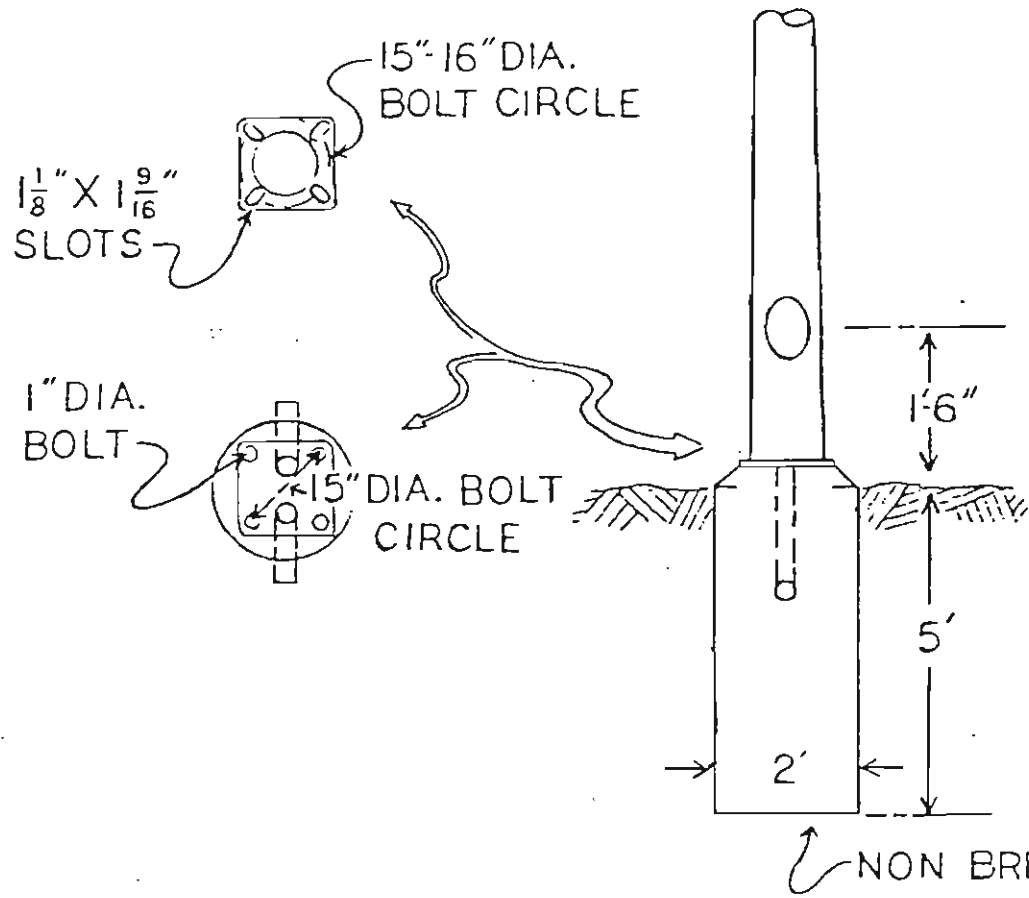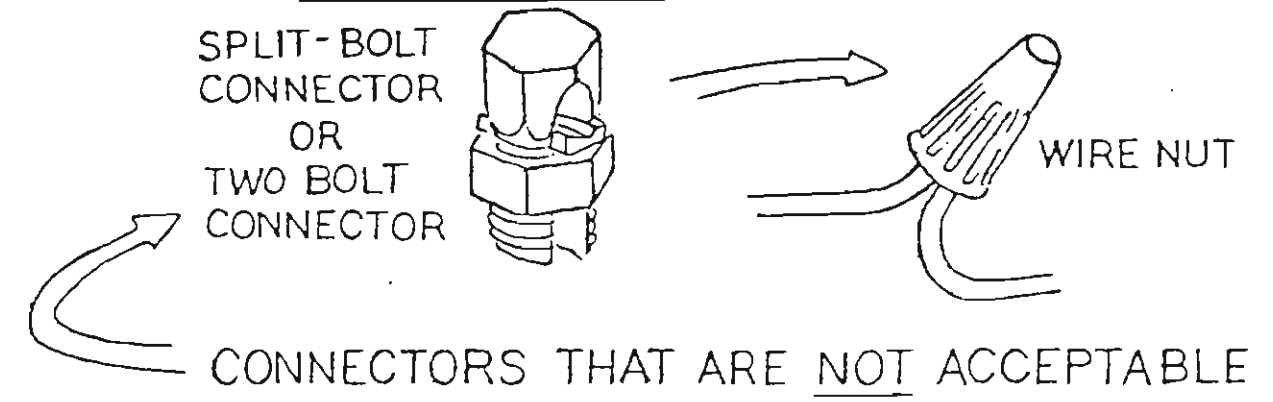

All wiring shall meet the requirements of the National Electrical Safety Code.

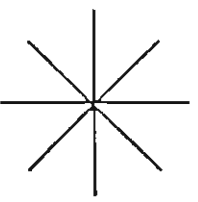

C.P.E.G.S. NO.		DATE	EXPLANATION	DATE	PUBLIC SERVICE CO. OF COLORADO ELEC. DISTRIBUTION ENG. DEPT.
W.O. J.O. NO.			ENGR. LUCERO		
M.S.T. & T. NO.			EST.		
SCALE			APP'D		DESCRIPTION
O N.T.S.			SEC. TWP. RNG.	QUARTER SEC.	
GRID NO.		EXCAVATION PERMIT REQUIRED NO <input type="checkbox"/> YES <input type="checkbox"/>		FEEDER NO.	
VER.	HOR.	VER.	HOR.	SHEET OF	
				PRIOR TO SCHEDULING JOB. CALL ENGR. FOR STAKES-	

FEDERAL ROAD DISTRICT NO.	DIVISION	PROJ. NO.	SHEET NO.	TOTAL SHEETS
VIII	COLORADO	I-70-3(140)	24	57

AS CONSTRUCTED

NO REVISIONS	REVISED	VOID
	12-12-83	

DETAILS OF I70/SH 470 INTERCHANGE



350+00 (I 70) REQ'D EMBANKMENT PROTECTOR TYPE 5 WITH 4 REPRAP DITCH CHECKS, RT.

CURVE DATA RAMP "A"

$\Delta = 154^{\circ} 23' 21.5''$ RT.
 $\Delta c = 94^{\circ} 23' 21.5''$
 $Dc = 12^{\circ} 00' 00''$
 $Tc = 515.519'$
 $Lc = 786.578'$
 $Rc = 477.465'$

BACK SPIRAL

$Ts = 2493.48'$
 $\theta_s = 36^{\circ} 00' 00''$
 $Ls = 600.00'$
 $LI = 408.597'$
 $ST = 207.838'$

AHEAD SPIRAL

$Ts = 2400.107'$
 $\theta_s = 24^{\circ} 00' 00''$
 $Ls = 400.00'$
 $LI = 269.159'$
 $ST = 135.602'$
 $e = 0.080'/ft.$
 $S.S.D. = 302'$
 $M.D.S. = 40 MPH.$

STA. 335 + 96.60 BEGIN I70-3(140) +
 STA. 231 + 97.08 RAMP A, 102' RT.
 ON I-IR 70-3(137)

CURVE DATA SH 470

$\Delta = 43^{\circ} 18' 36.2''$ RT.
 $Ts = 631.605'$
 $ES = 91.807'$
 $\Delta c = 25^{\circ} 48' 36.2''$
 $Dc = 5^{\circ} 00' 00''$
 $Tc = 262.556'$
 $Lc = 516.201'$
 $Rc = 1145.916'$
 $\theta_s = 8^{\circ} 45' 00''$
 $Ls = 350.00'$
 $LI = 233.619'$
 $ST = 116.926'$
 $e = 0.080'/ft.$
 $S.S.D. = 584'$
 $M.D.S. = 60 MPH.$

CURVE DATA RAMP "D"


$\Delta = 19^{\circ} 44' 59.8''$ RT.
 $Ts = 353.597'$ (Back)
 $\Delta c = 10^{\circ} 38' 32.3''$
 $Dc = 5^{\circ} 12' 15.7''$
 $Tc = 102.539'$
 $Lc = 204.488'$
 $Rc = 1100.919'$
 $\theta_s = 9^{\circ} 6' 27.5''$ (Back)
 $Ls = 350.00'$ (Back)
 $LI = 233.643'$ (Back)
 $ST = 116.948'$ (Back)
 $e = 0.080'/ft.$
 $S.S.D. = 584'$
 $M.D.S. = 60 MPH.$

CURVE DATA RAMP "C"

$\Delta = 21^{\circ} 37' 27.2''$ RT.
 $D = 3^{\circ} 30' 00''$
 $T = 312.637'$
 $L = 617.835'$
 $R = 1637.022'$
 $E = 29.586'$
 $e = 0.058'/ft.$
 $S.S.D. > 600'$
 $M.D.S. = 50 MPH.$

CURVE DATA ROONEY ROAD

$\Delta = 90^{\circ} 0' 00''$ RT.
 $D = 28^{\circ} 0' 13.7''$
 $T = 204.600'$
 $L = 321.385'$
 $R = 204.600'$
 $E = 84.748'$
 $e = 0.080'/ft.$
 $S.S.D. = 350'$
 $M.D.S. = 25 MPH.$

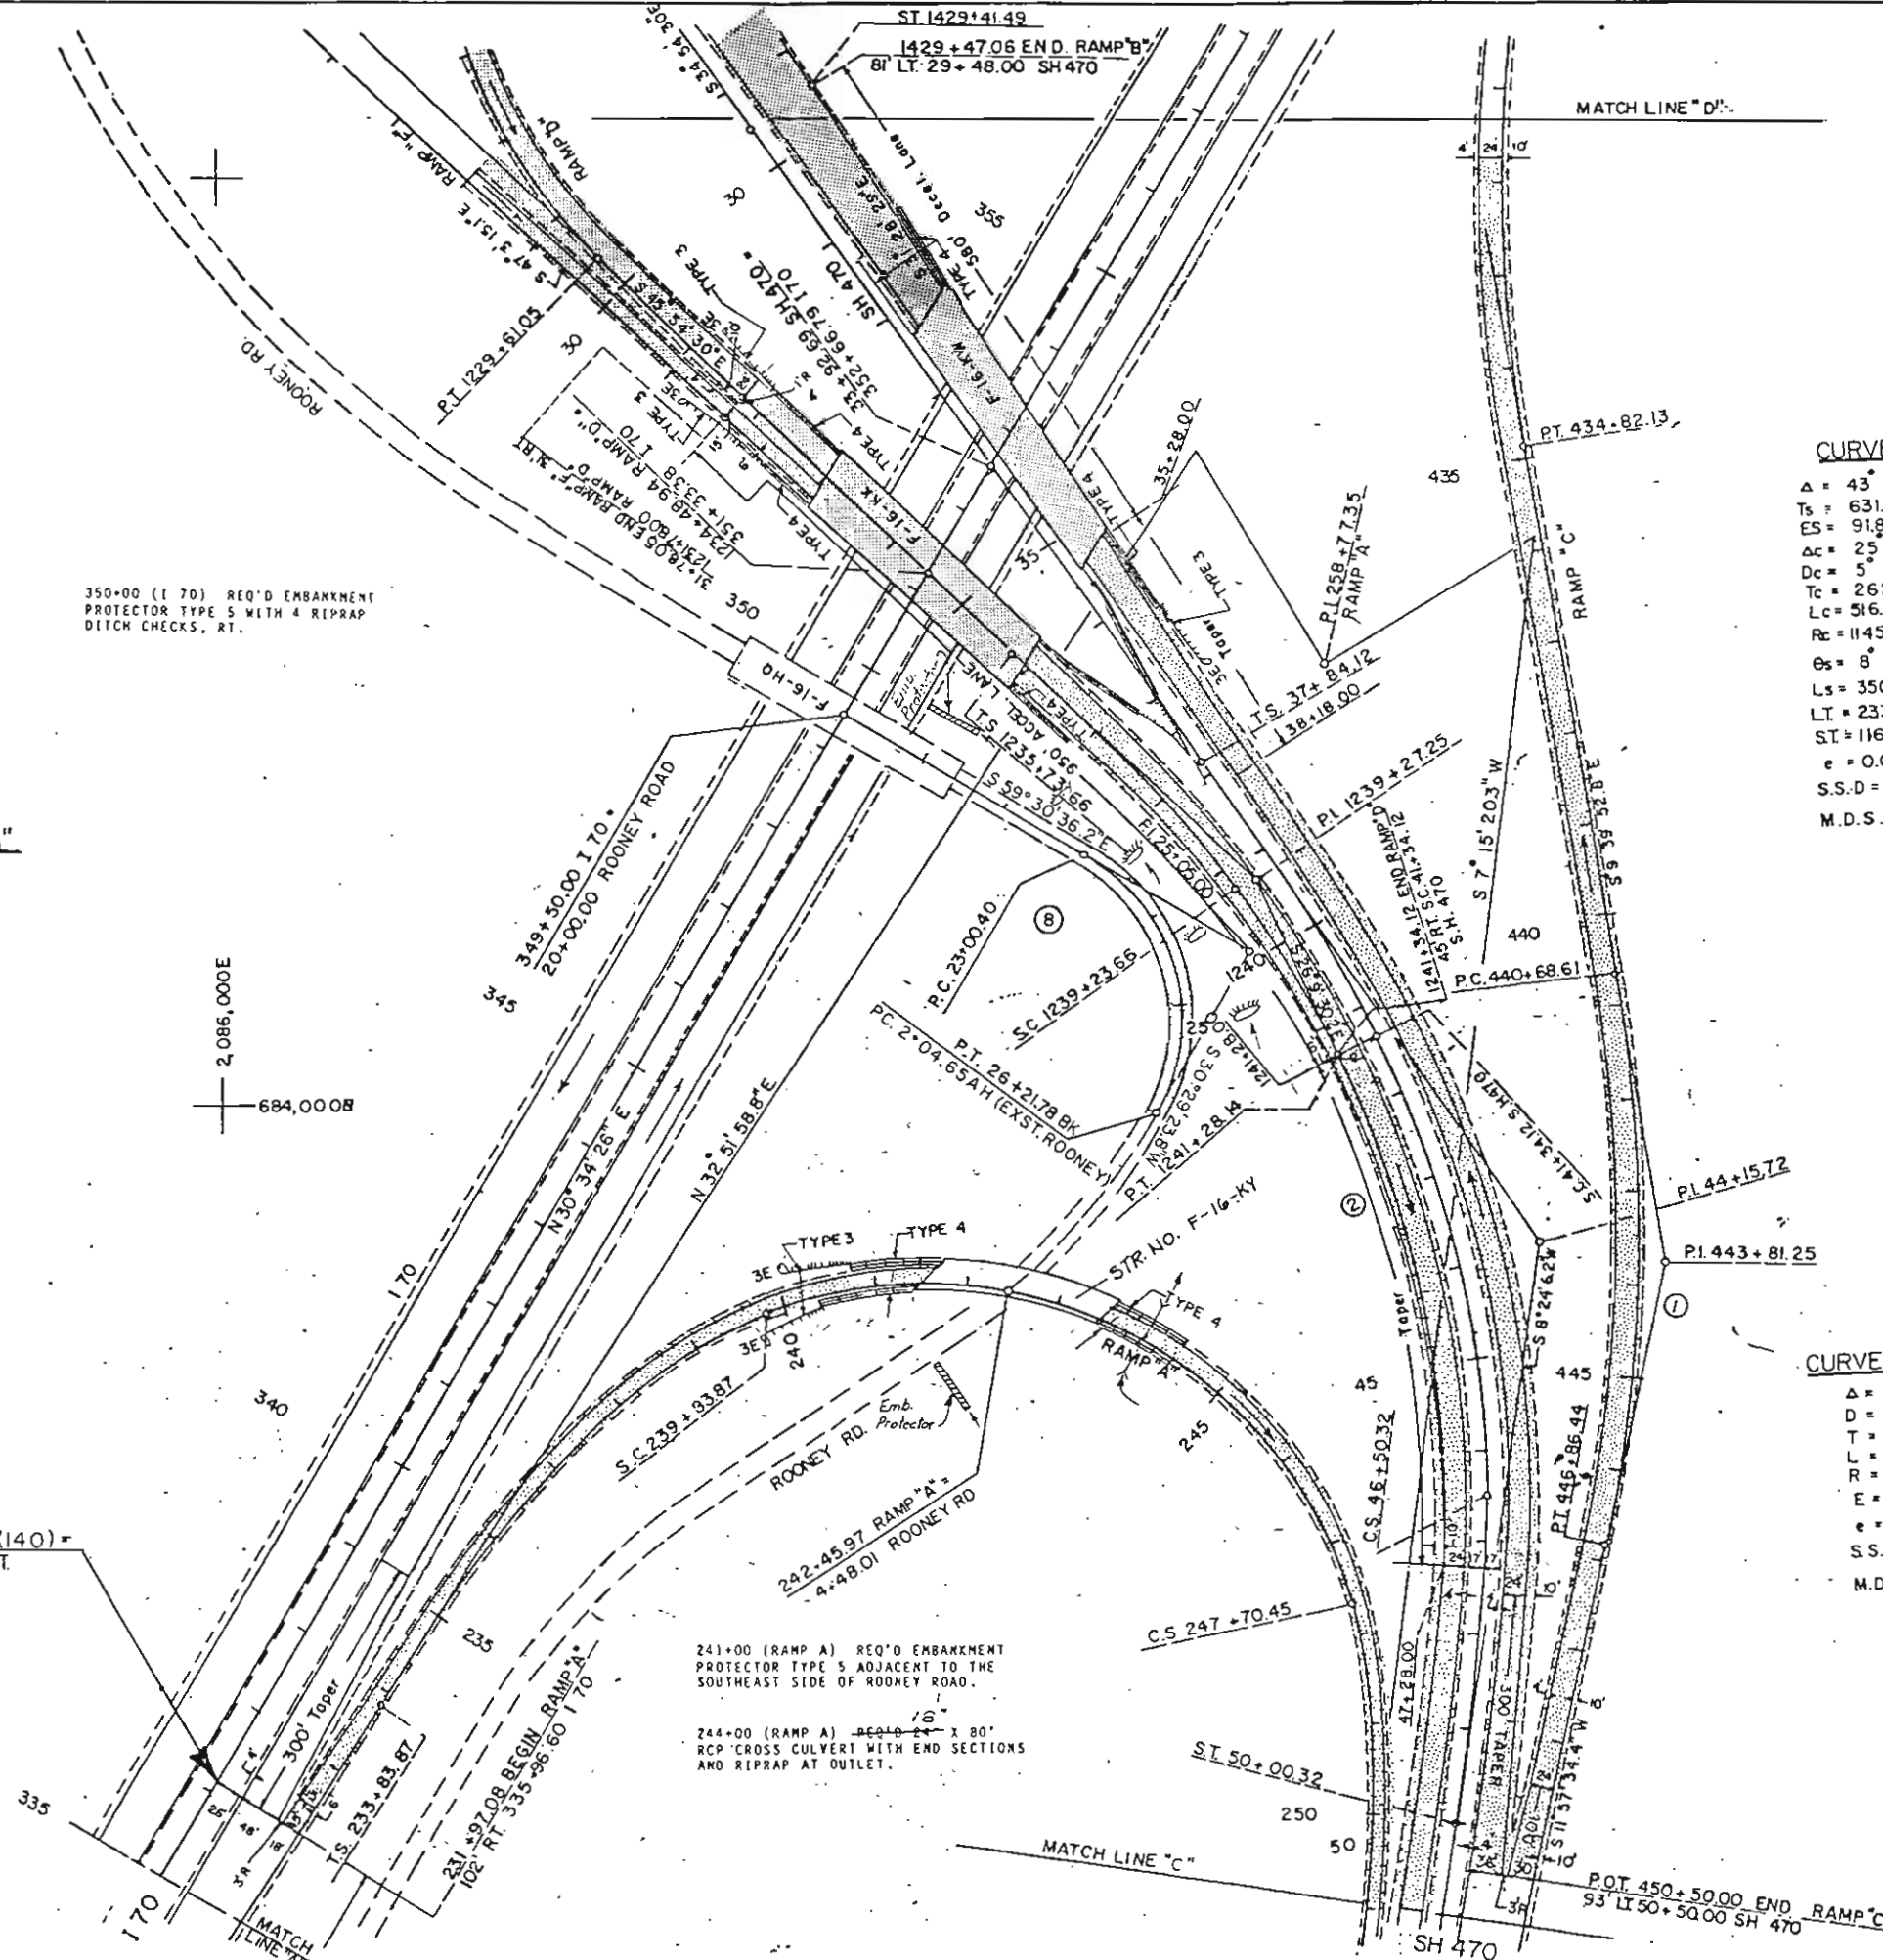

2,086,000E
 684,000N

684,000N

241+00 (RAMP A) REQ'D EMBANKMENT PROTECTOR TYPE 5 ADJACENT TO THE SOUTHEAST SIDE OF ROONEY ROAD.

244+00 (RAMP A) REQ'D 24' x 80' RCP CROSS CULVERT WITH END SECTIONS AND REPRAP AT OUTLET.

PAVING THIS PROJECT

P.O.T. 450+50.00 END RAMP "C"
 93' LI 50+50.00 SH 470

FEDERAL ROAD DISTRICT NO.	DIVISION	PROJ. NO.	SHEET NO.	TOTAL SHEETS
VIII	COLORADO	I, 70-3(140)	25	
AS CONSTRUCTED				
NO REVISIONS		REVISED	VOID	

DETAILS OF I70/SH470 INTERCHANGE

2,086,000E
 687,000N

2,087,000E
 687,000N

⑦ CURVE DATA RAMP "B" ⑥

$\Delta = 82^{\circ} 59' 24.6''$ LT.	$\Delta = 159^{\circ} 03' 30.4''$ LT.
$\Delta_c = 69^{\circ} 21' 32.2''$	$\Delta_c = 119^{\circ} 16' 20''$
$D_c = 13^{\circ} 37' 52.4''$	$D_c = 19^{\circ} 53' 35.2''$
$T_c = 290.826'$	$T_c = 491.624'$
$L_c = 508.824'$	$L_c = 599.565'$
$R_c = 420.328'$	$R_c = 288.018'$

AHEAD SPIRAL
 $T_s = 471.135'$

BACK SPIRAL
 $T_s = 1800.078'$

$\theta_s = 13^{\circ} 37' 52.4''$	$\theta_s = 40^{\circ} 00' 00''$
$L_s = 200.00'$	$L_s = 400.00'$
$L.T. = 133.731'$	$L.T. = 273.809'$
$S.T. = 67.028'$	$S.T. = 139.849'$
$e = 0.069'/ft$	$e = 0.079'/ft$
S.S.D. > 600'	S.S.D. = 279'
M.D.S. = 30 M.P.H.	M.D.S. = 30 M.P.H.


⑤ CURVE DATA RAMP "D" ④


$\Delta = 129^{\circ} 29' 3.7''$ LT.	$\Delta = 53^{\circ} 0' 7.7''$ RT.
$D = 10^{\circ} 00' 00''$	$D = 12^{\circ} 00' 00''$
$T = 124.415'$	$T = 238.066'$
$L = 1294.844'$	$L = 441.684'$
$R = 572.958'$	$R = 477.465'$
$E = 769.832'$	$E = 56.255'$
$e = 0.077'/ft$	$e = 0.080'/ft$
S.S.D. > 600'	S.S.D. > 600'
M.D.S. = 40 M.P.H.	M.D.S. = 40 M.P.H.

③ CURVE DATA RAMP "C"

$\Delta = 40^{\circ} 9' 16.6''$ LT
$D = 3^{\circ} 30' 00''$
$T = 598.330'$
$L = 1147.275'$
$R = 1637.022'$
$E = 105.918'$
$e = 0.058'/ft$
S.S.D. > 600'
M.D.S. = 50 M.P.H.


STA. 369 + 48.67 END I70-3(140) =
 STA. 1207 + 17.30 RAMP D, 90' LT.
 ON I-IR 70-3(143)

 PAVING THIS PROJECT

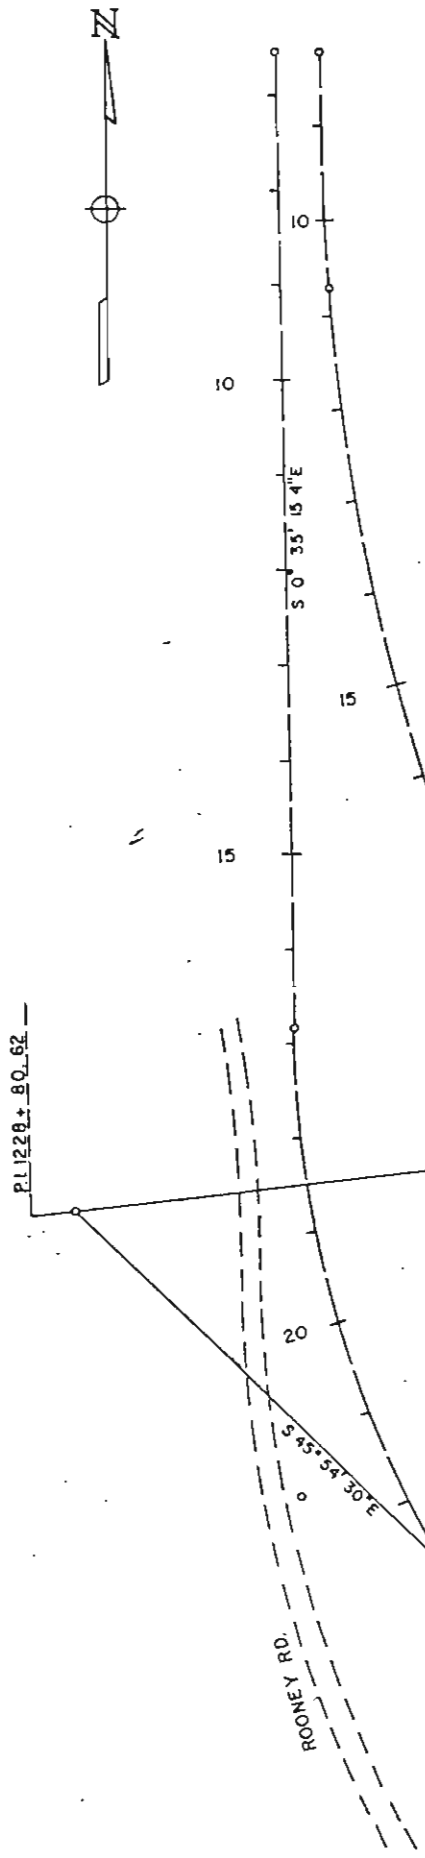

PL 1228 + 80.62


686,000N

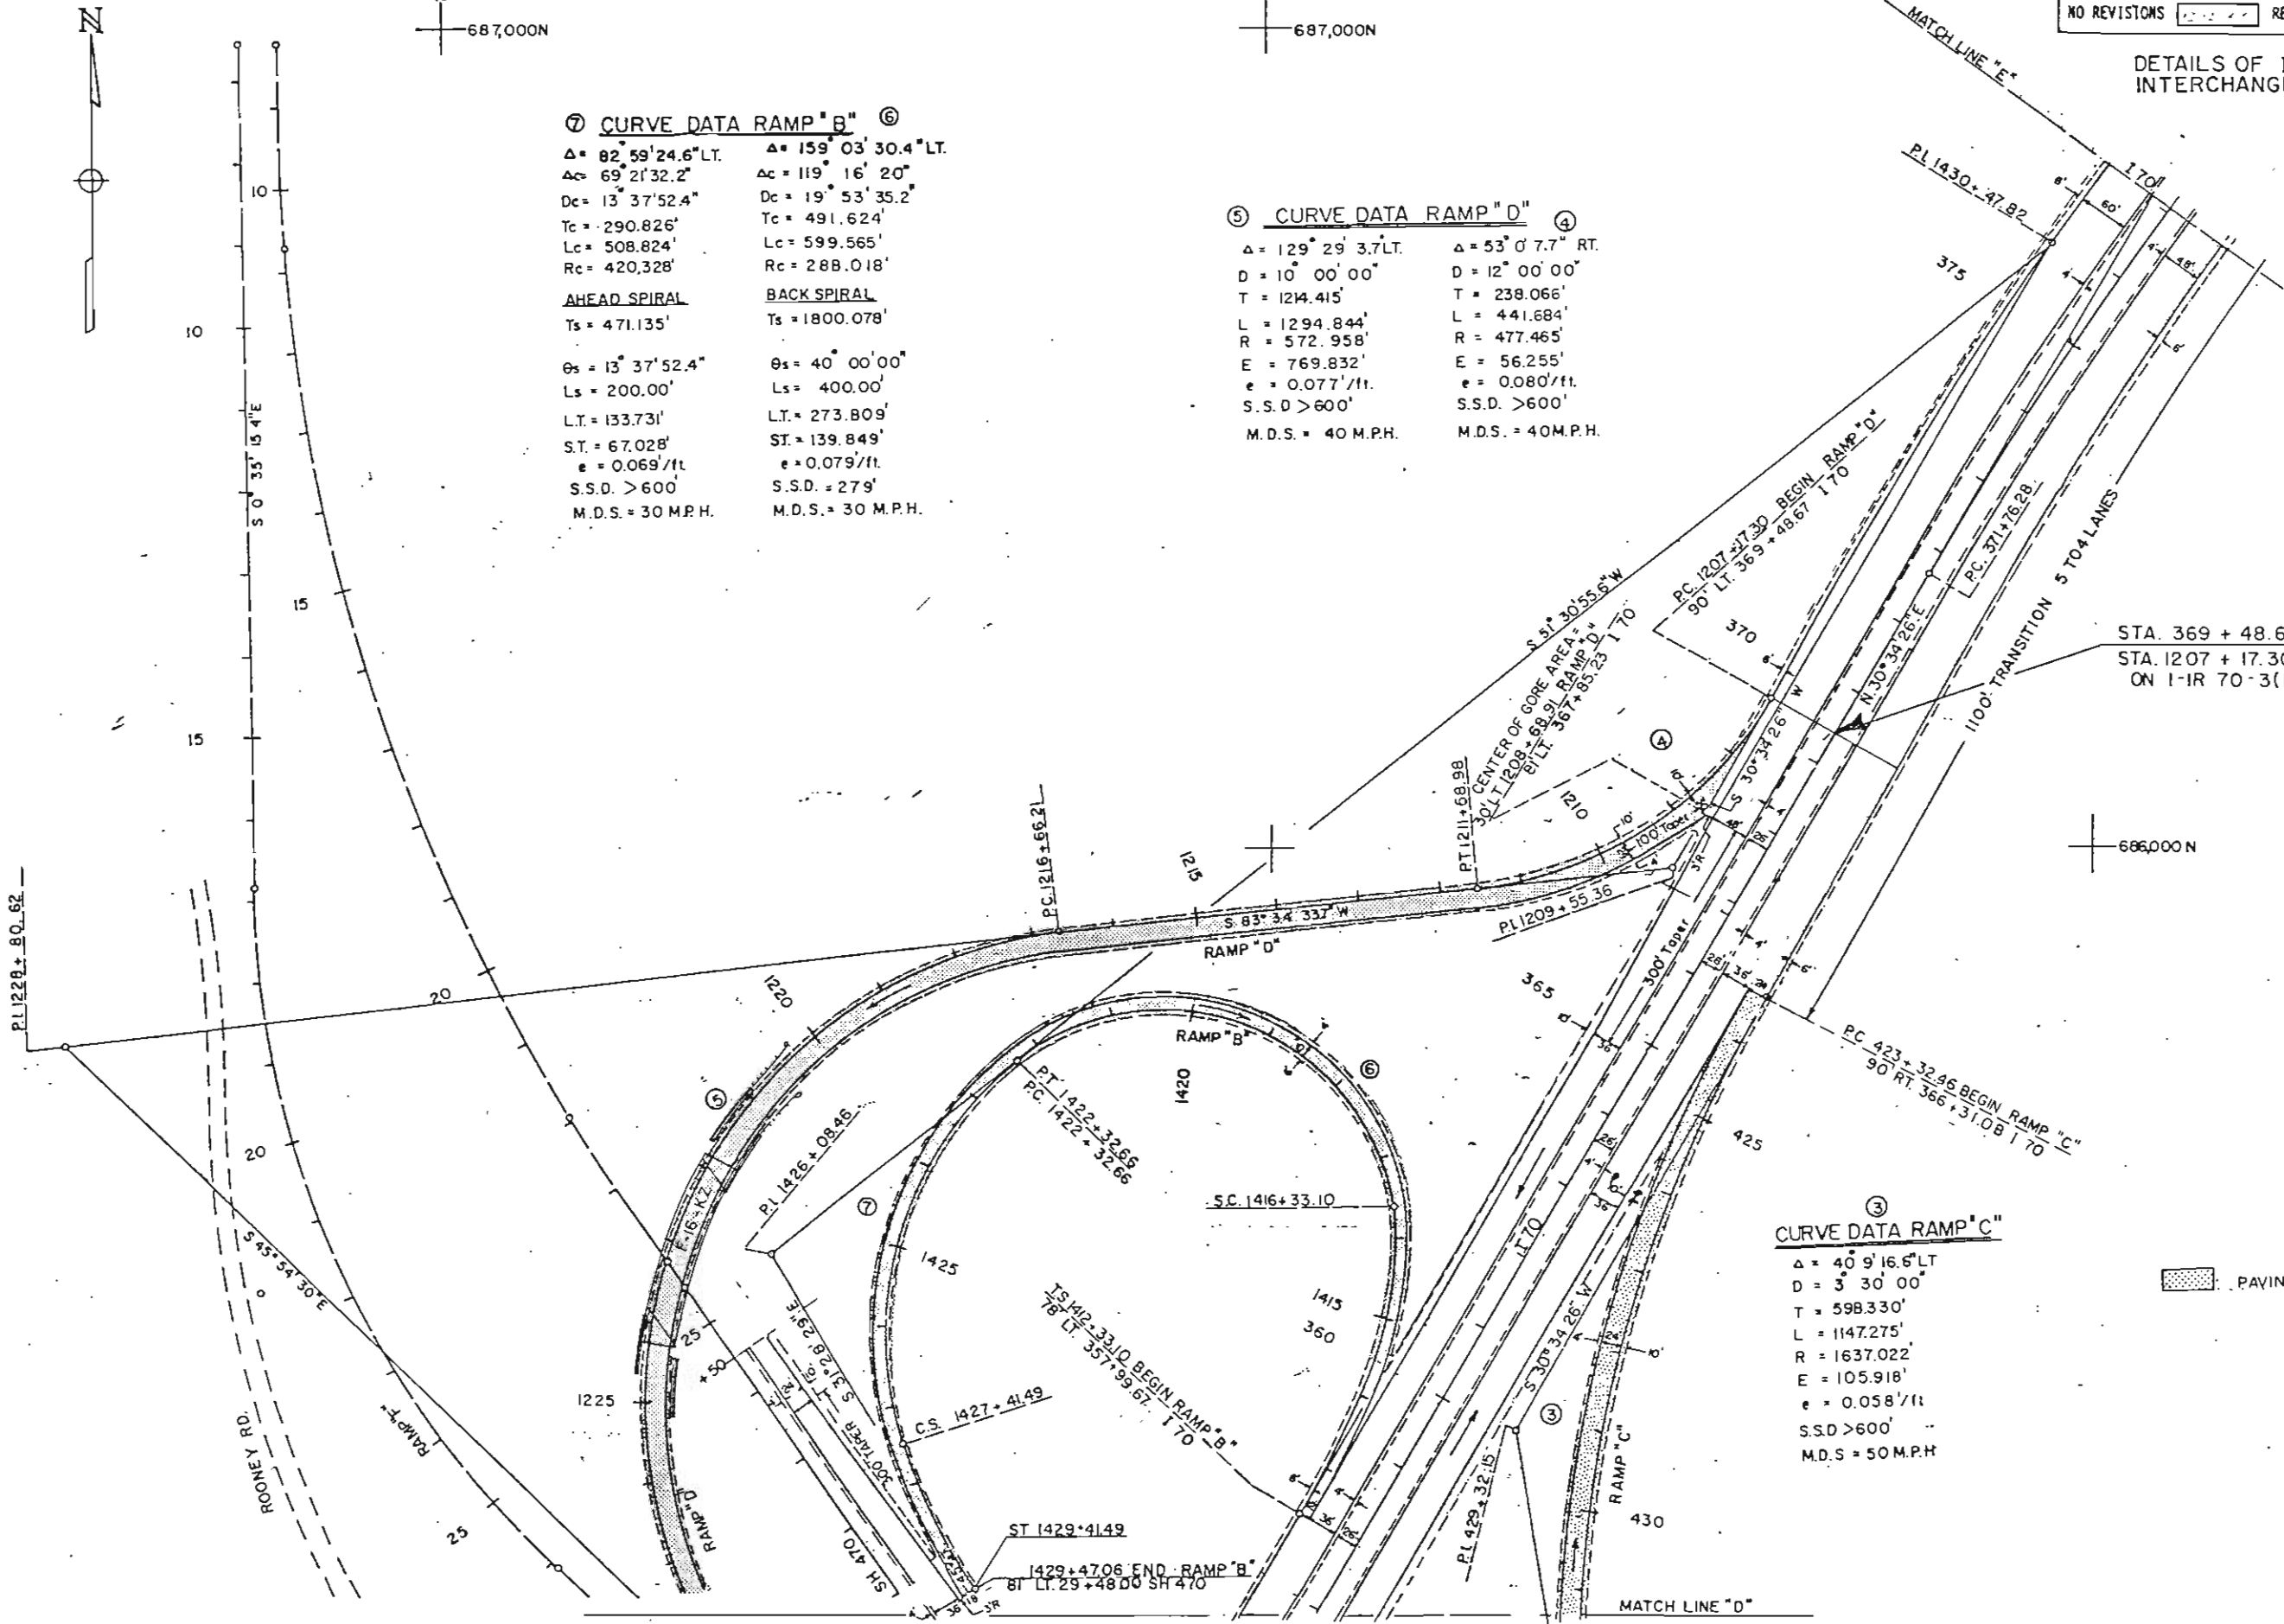

FEDERAL ROAD DISTRICT NO.	DIVISION	PROJ. NO.	SHEET NO.	TOTAL SHEETS
VIII	COLORADO	J 70-3(140)	26	57
AS CONSTRUCTED				
NO REVISIONS		REVISED 12-86	VOID	

DETAILS OF I70/SH470

PAVING THIS PROJECT

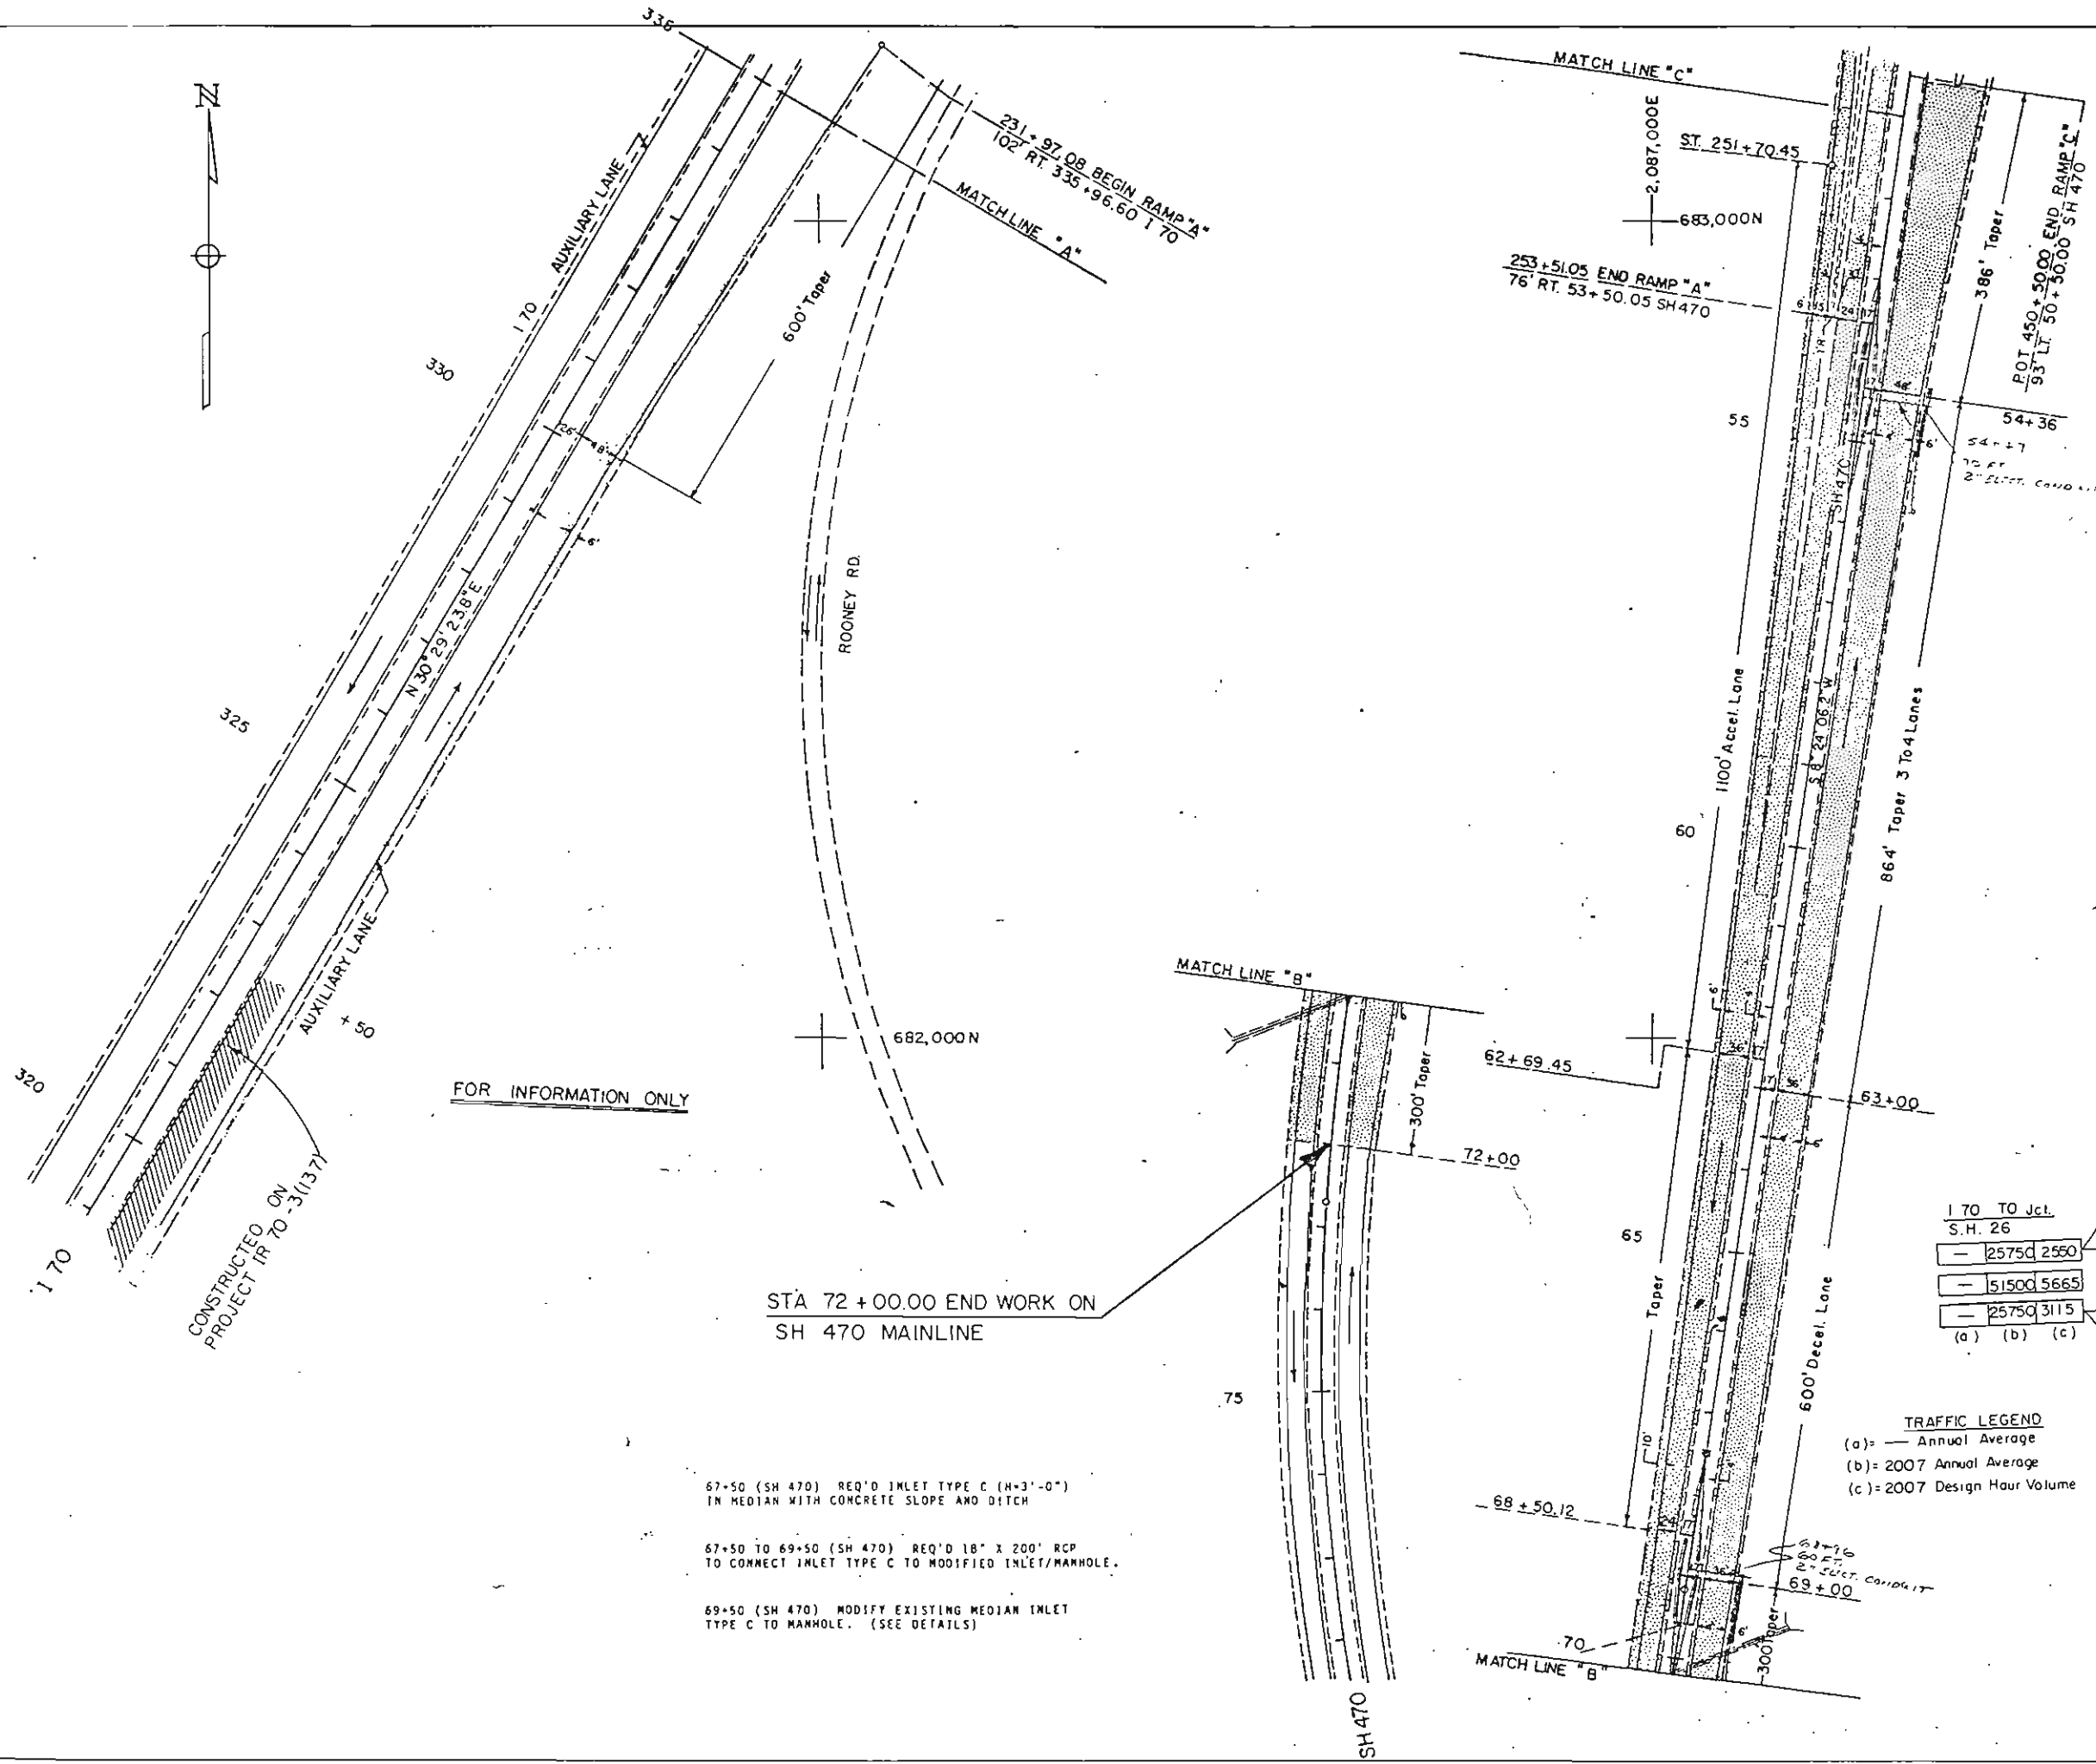

STA 72+00.00 END WORK ON SH 470 MAINLINE

- 67+50 (SH 470) REQ'D INLET TYPE C (H+3'-0") IN MEDIAN WITH CONCRETE SLOPE AND DITCH
- 67+50 TO 69+50 (SH 470) REQ'D 18" X 200' RCP TO CONNECT INLET TYPE C TO MODIFIED INLET/MANHOLE.
- 69+50 (SH 470) MODIFY EXISTING MEDIAN INLET TYPE C TO MANHOLE. (SEE DETAILS)


TRAFFIC LEGEND
 (a) = Annual Average
 (b) = 2007 Annual Average
 (c) = 2007 Design Hour Volume

SH 470 TO Jct. S.H. 40	8300	1005	16600	1825	8300	820
	(a)	(b)	(c)	(a)	(b)	(c)
I 70 TO Jct. S.H. 26	2575	2550	5150	5665	2575	3115
	(a)	(b)	(c)	(a)	(b)	(c)
I 70 TO Jct. S.H. 6	3815	4120	7630	8395	3815	4275
	(a)	(b)	(c)	(a)	(b)	(c)
SH 470 TO Jct. Morrison Rd.	2735	3305	5470	6015	2735	2710
	(a)	(b)	(c)	(a)	(b)	(c)

AS CONSTRUCTED
 NO. REVISIONS 12-1-17 REVISION NO. 100

F.L.D. ROAD REGION	DIVISION	PROJ. NO.	SHEET NO.
7000	300	1 70 3(140)	27


PROFILE GRADE - SH 470

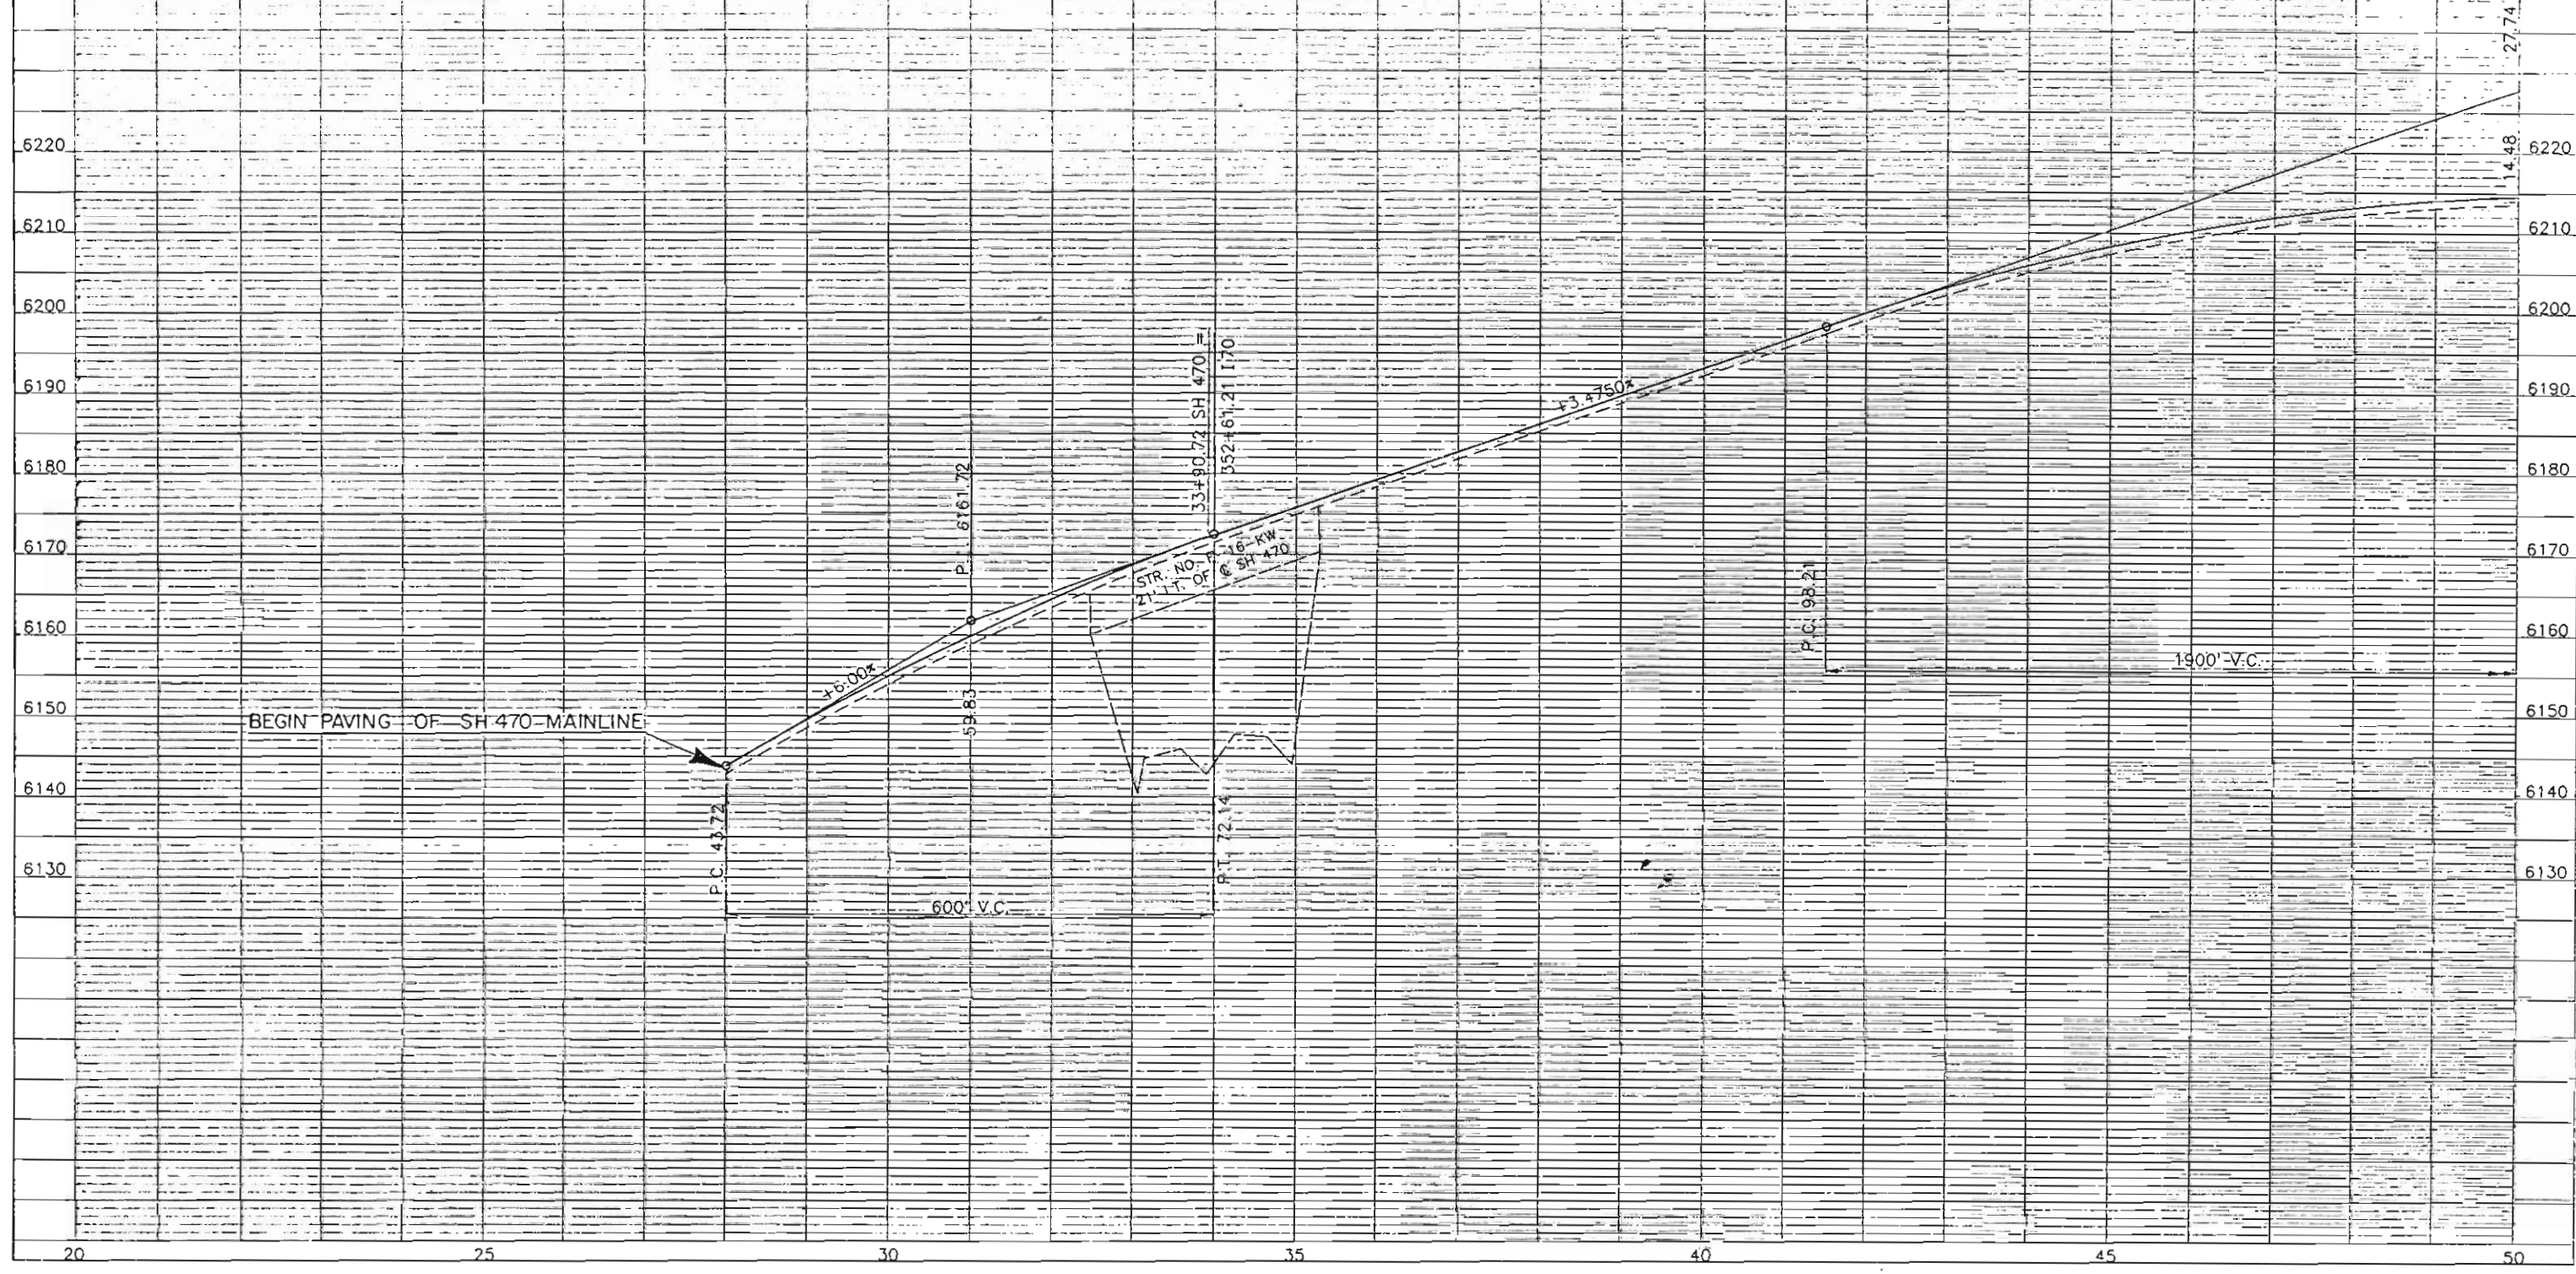

AS CONSTRUCTED
 NO REVISIONS 12-12-77 REVISED VOID


FED. ROAD REGION	DIVISION	PROJ. NO.	SHEET NO.
VIII	COLO.	I 70-3(140)	28

PROFILE GRADE SH 470

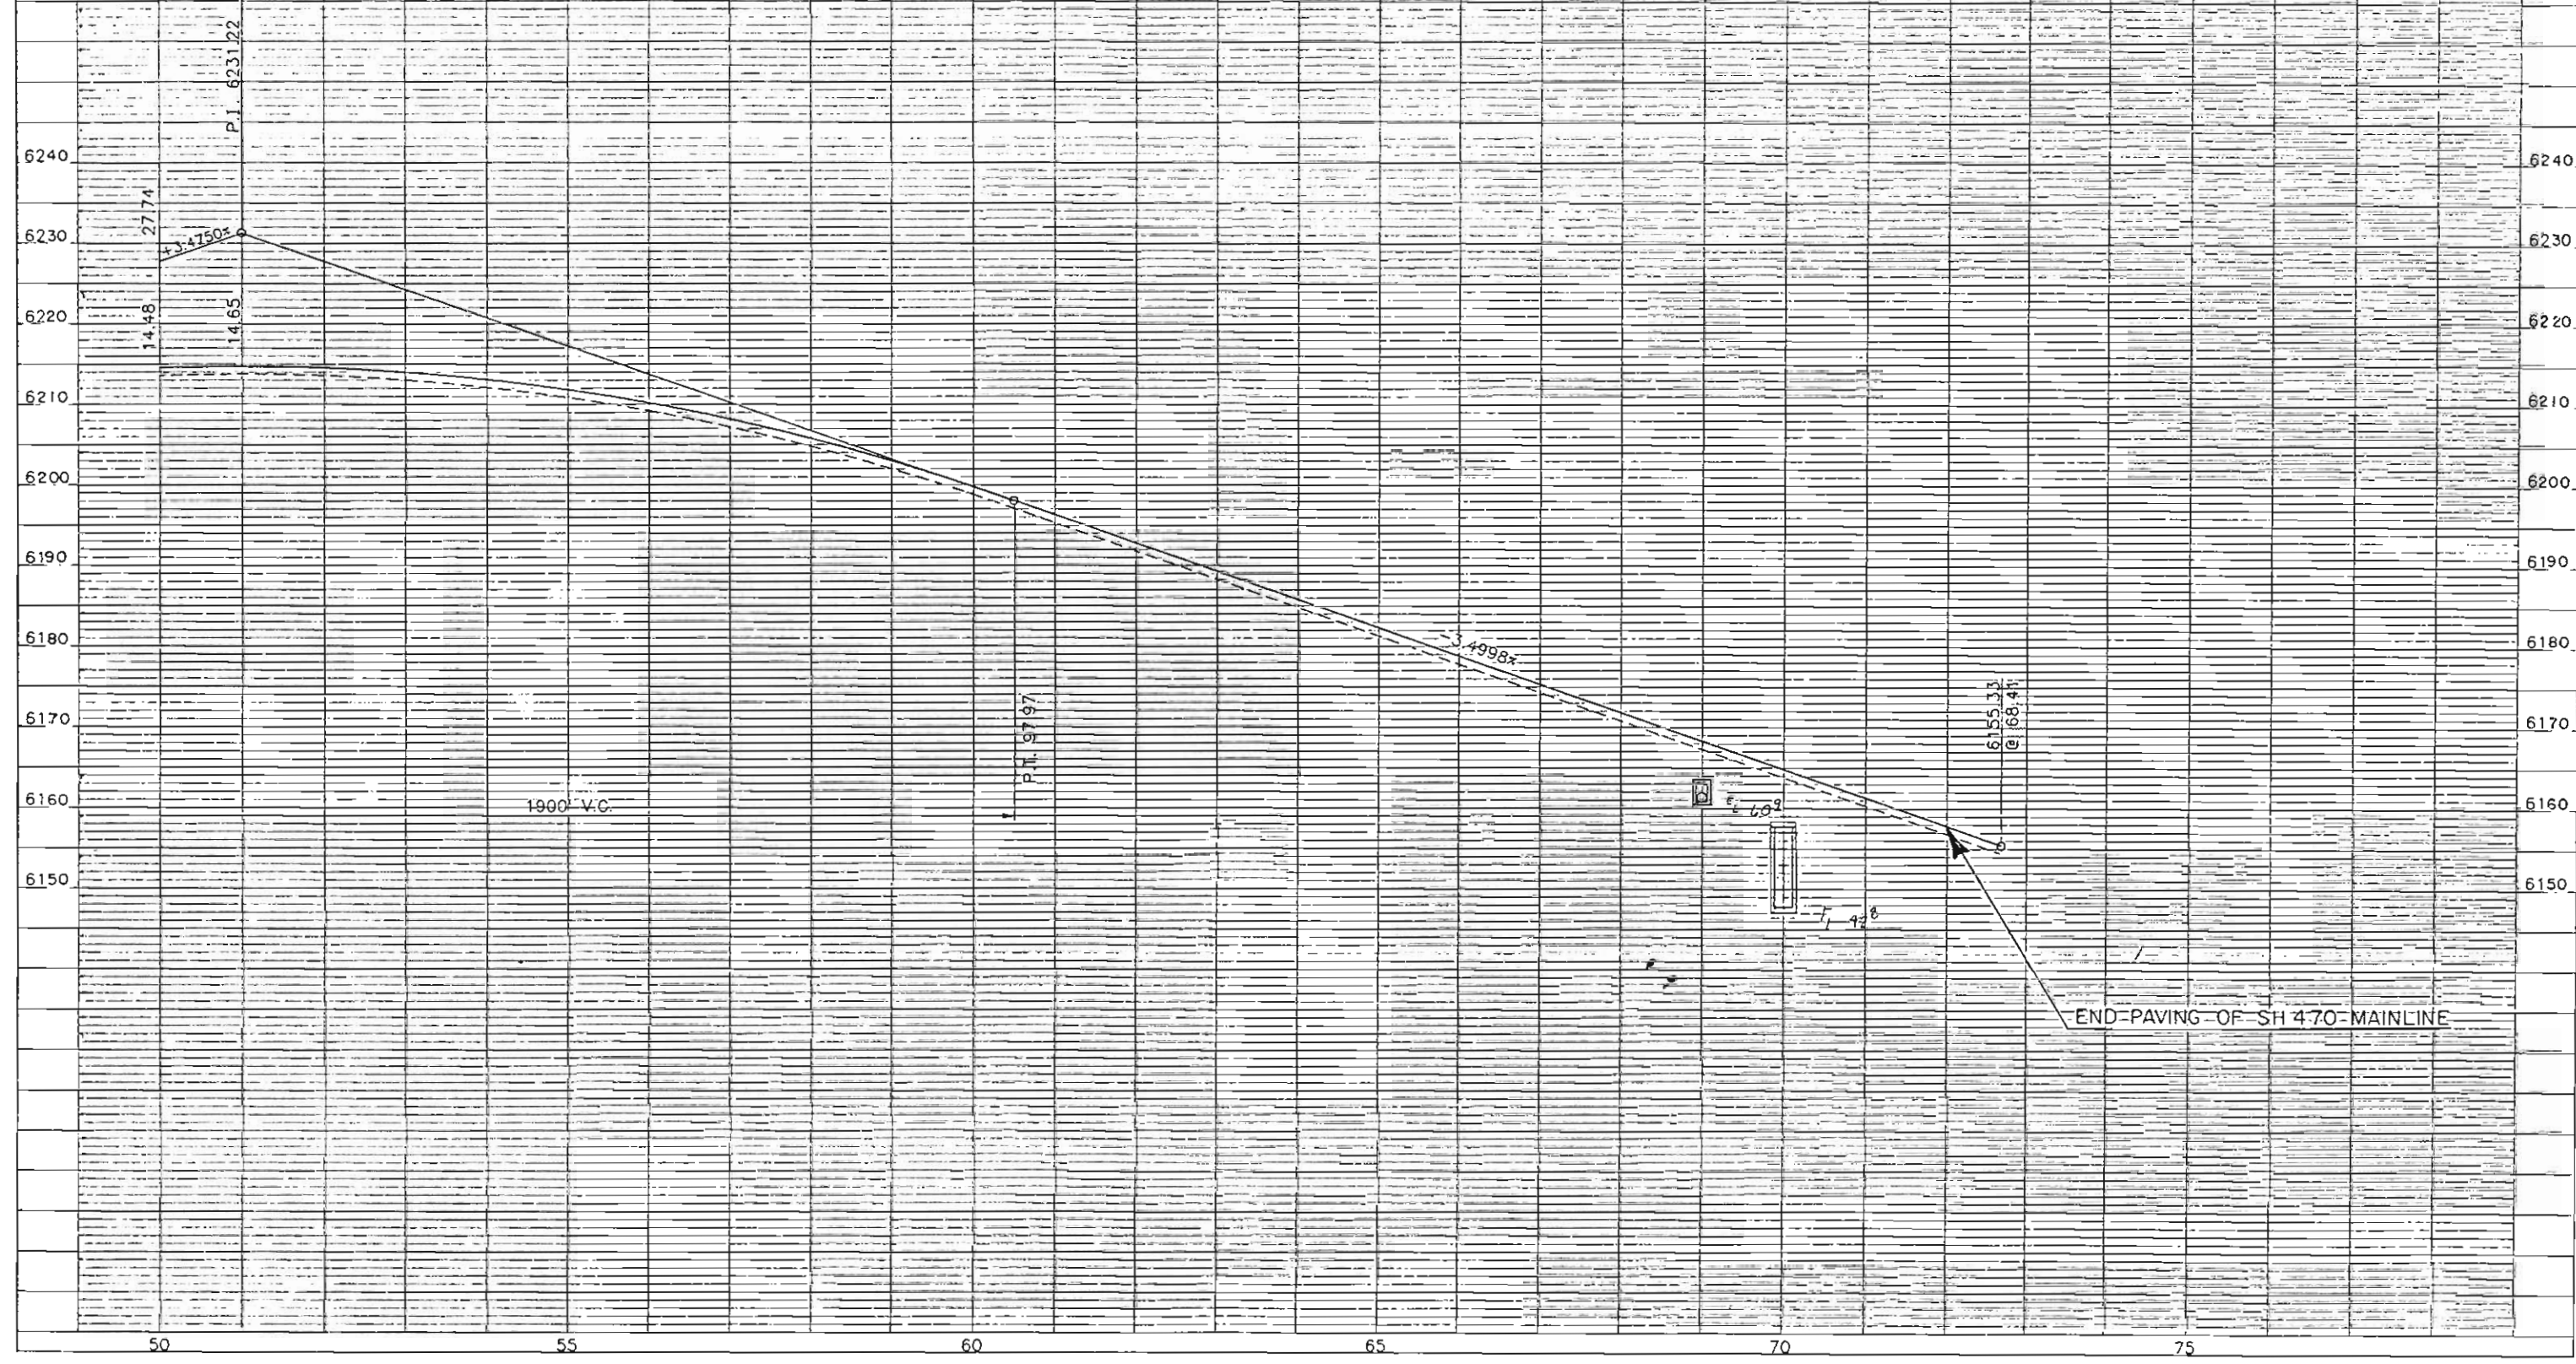


X-D number 06/29/87 17:55:55 ...NUM:HDRAWP.US2014.R01-Y:4101.PPS1 ROW:PRO.2

PROFILE GRADE - RAMP A

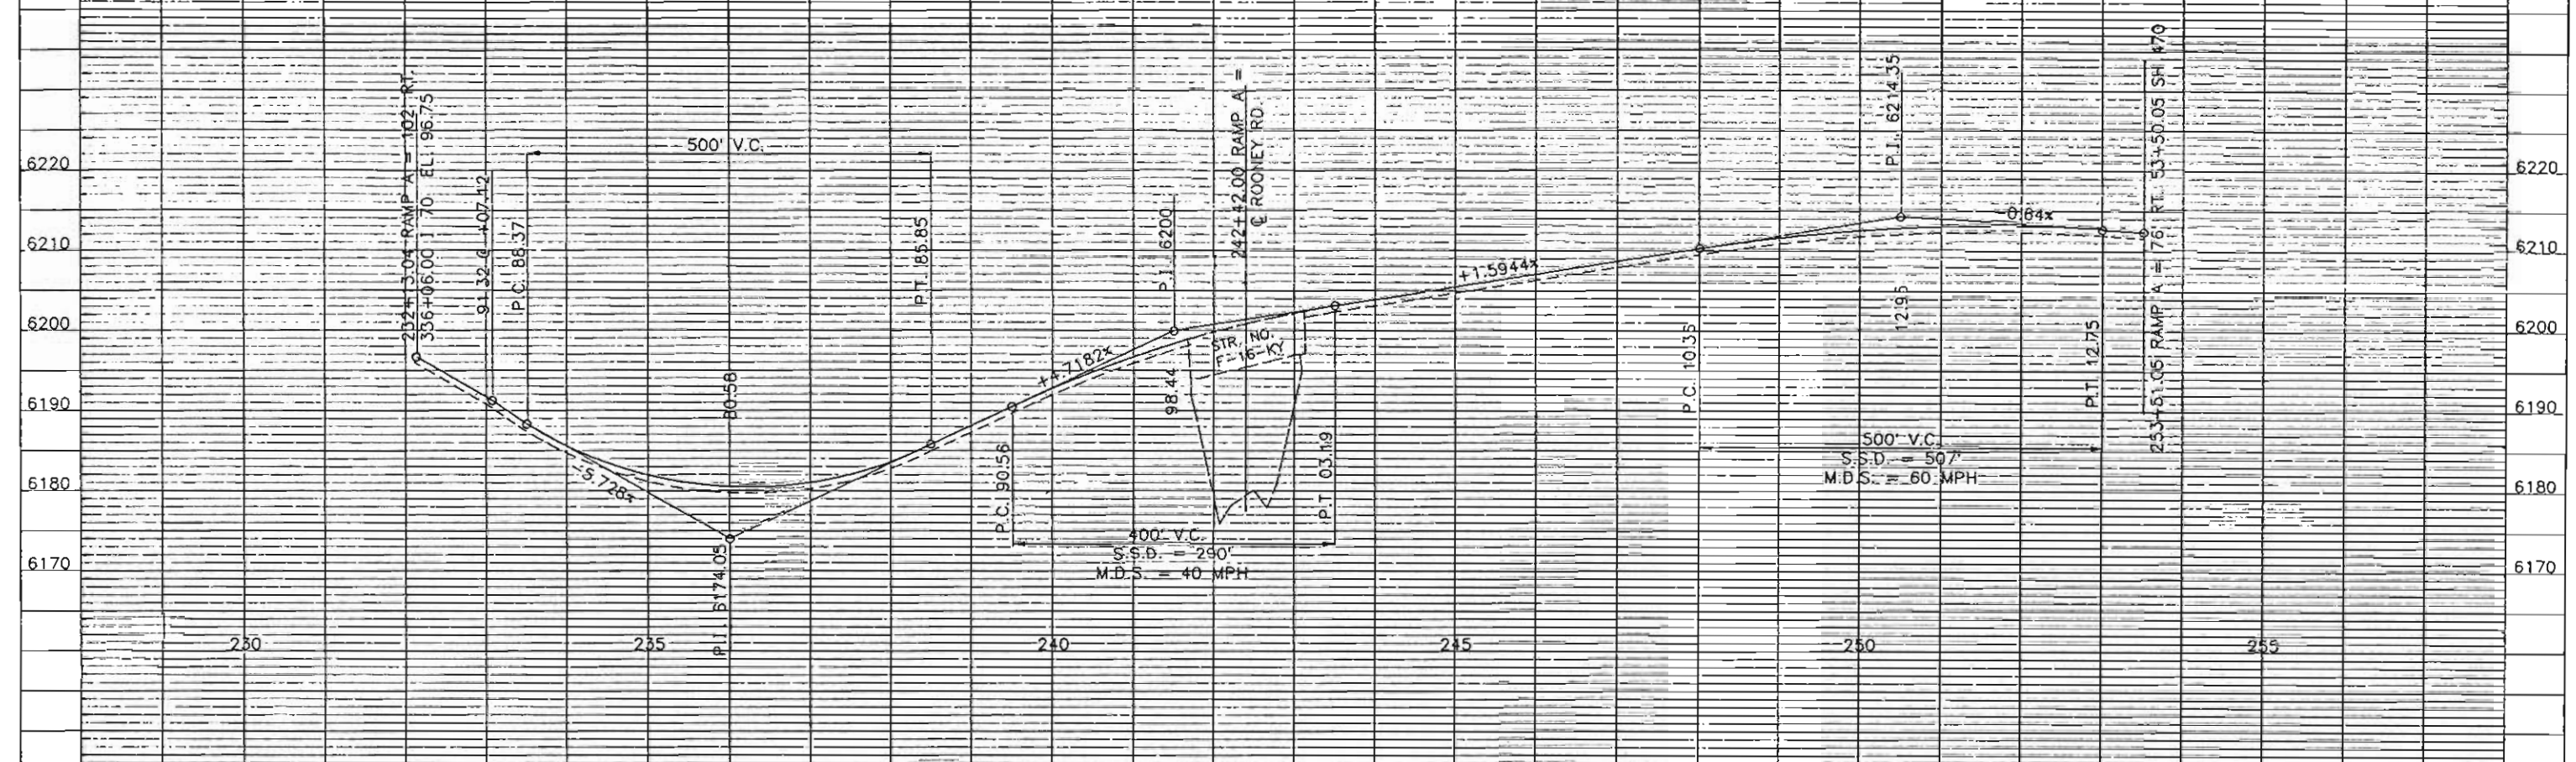

PROFILE GRADE RAMP B

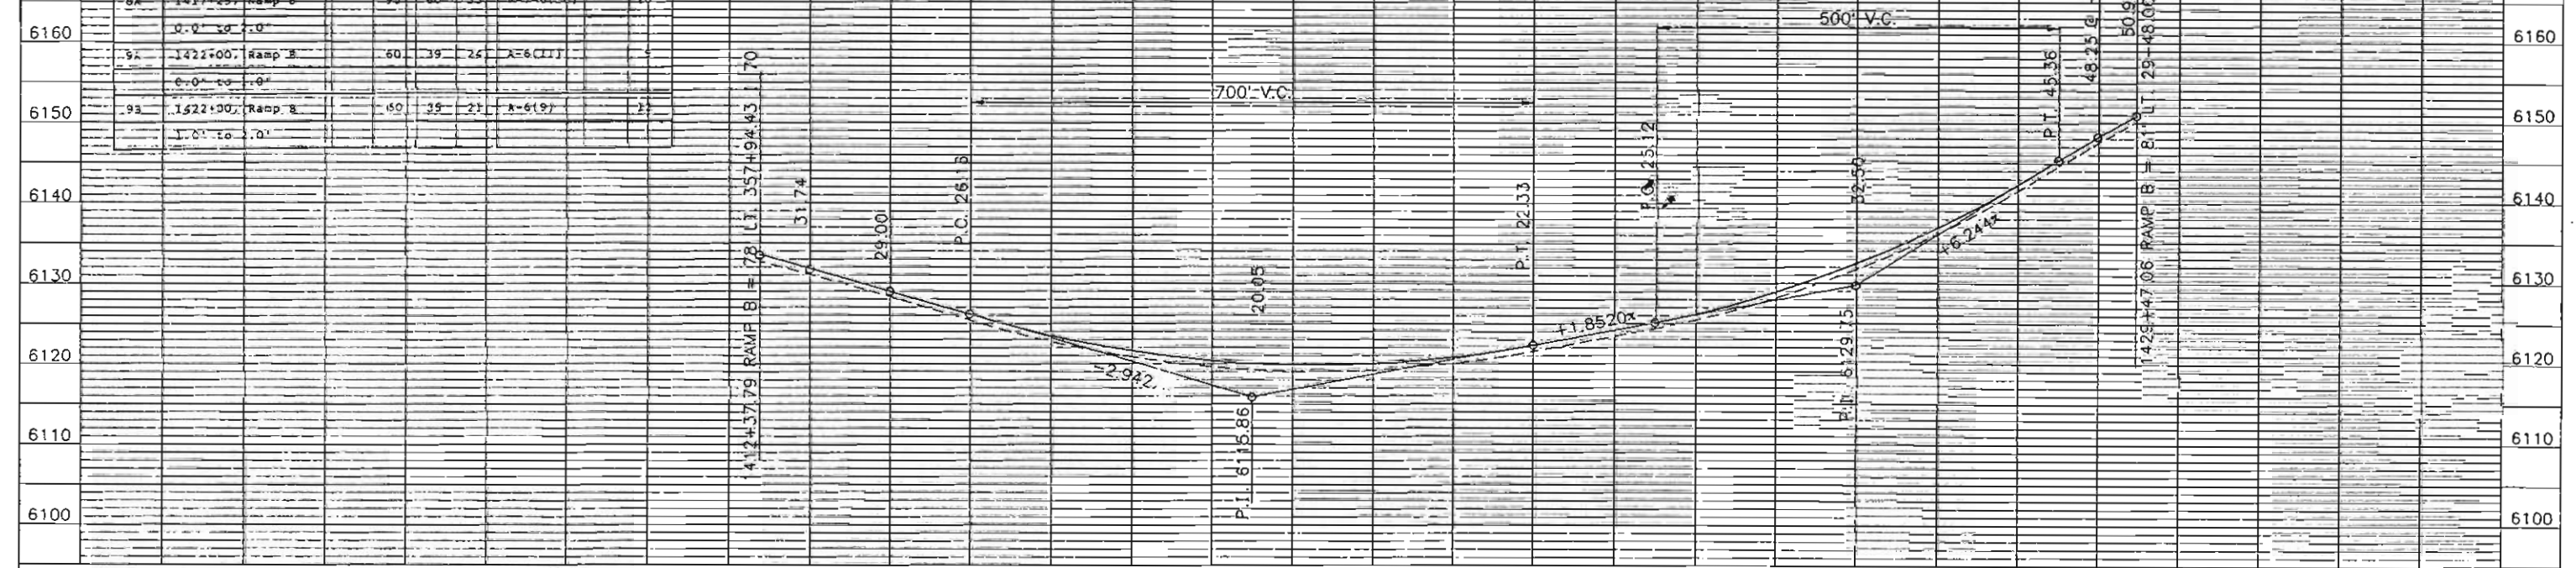


Post No.	Station and Log	Parent Designation	L.L.	P.L.	Curve and Group Index	Notes
8A	1417+25, Ramp B 0.0' to 1.0'	1200	60	33	A-6(34)	20
9A	1422+00, Ramp B 0.0' to 1.0'	60	39	26	A-6(11)	
9B	1522+00, Ramp B 1.0' to 2.0'	60	35	21	A-6(9)	21

NO Number 1 /87 12:24:52 - DURHAM RAMP 182014.DWG (101) PPS RAMP AB

AS CONSTRUCTED
 NO REVISIONS 12-16-82 REVISED _____ VOID _____

FED. ROAD REGION	DIVISION	PROJ. NO.	SHEET NO.
VIII	COLD.	I 70-3(140)	30

PROFILE GRADE - RAMP C

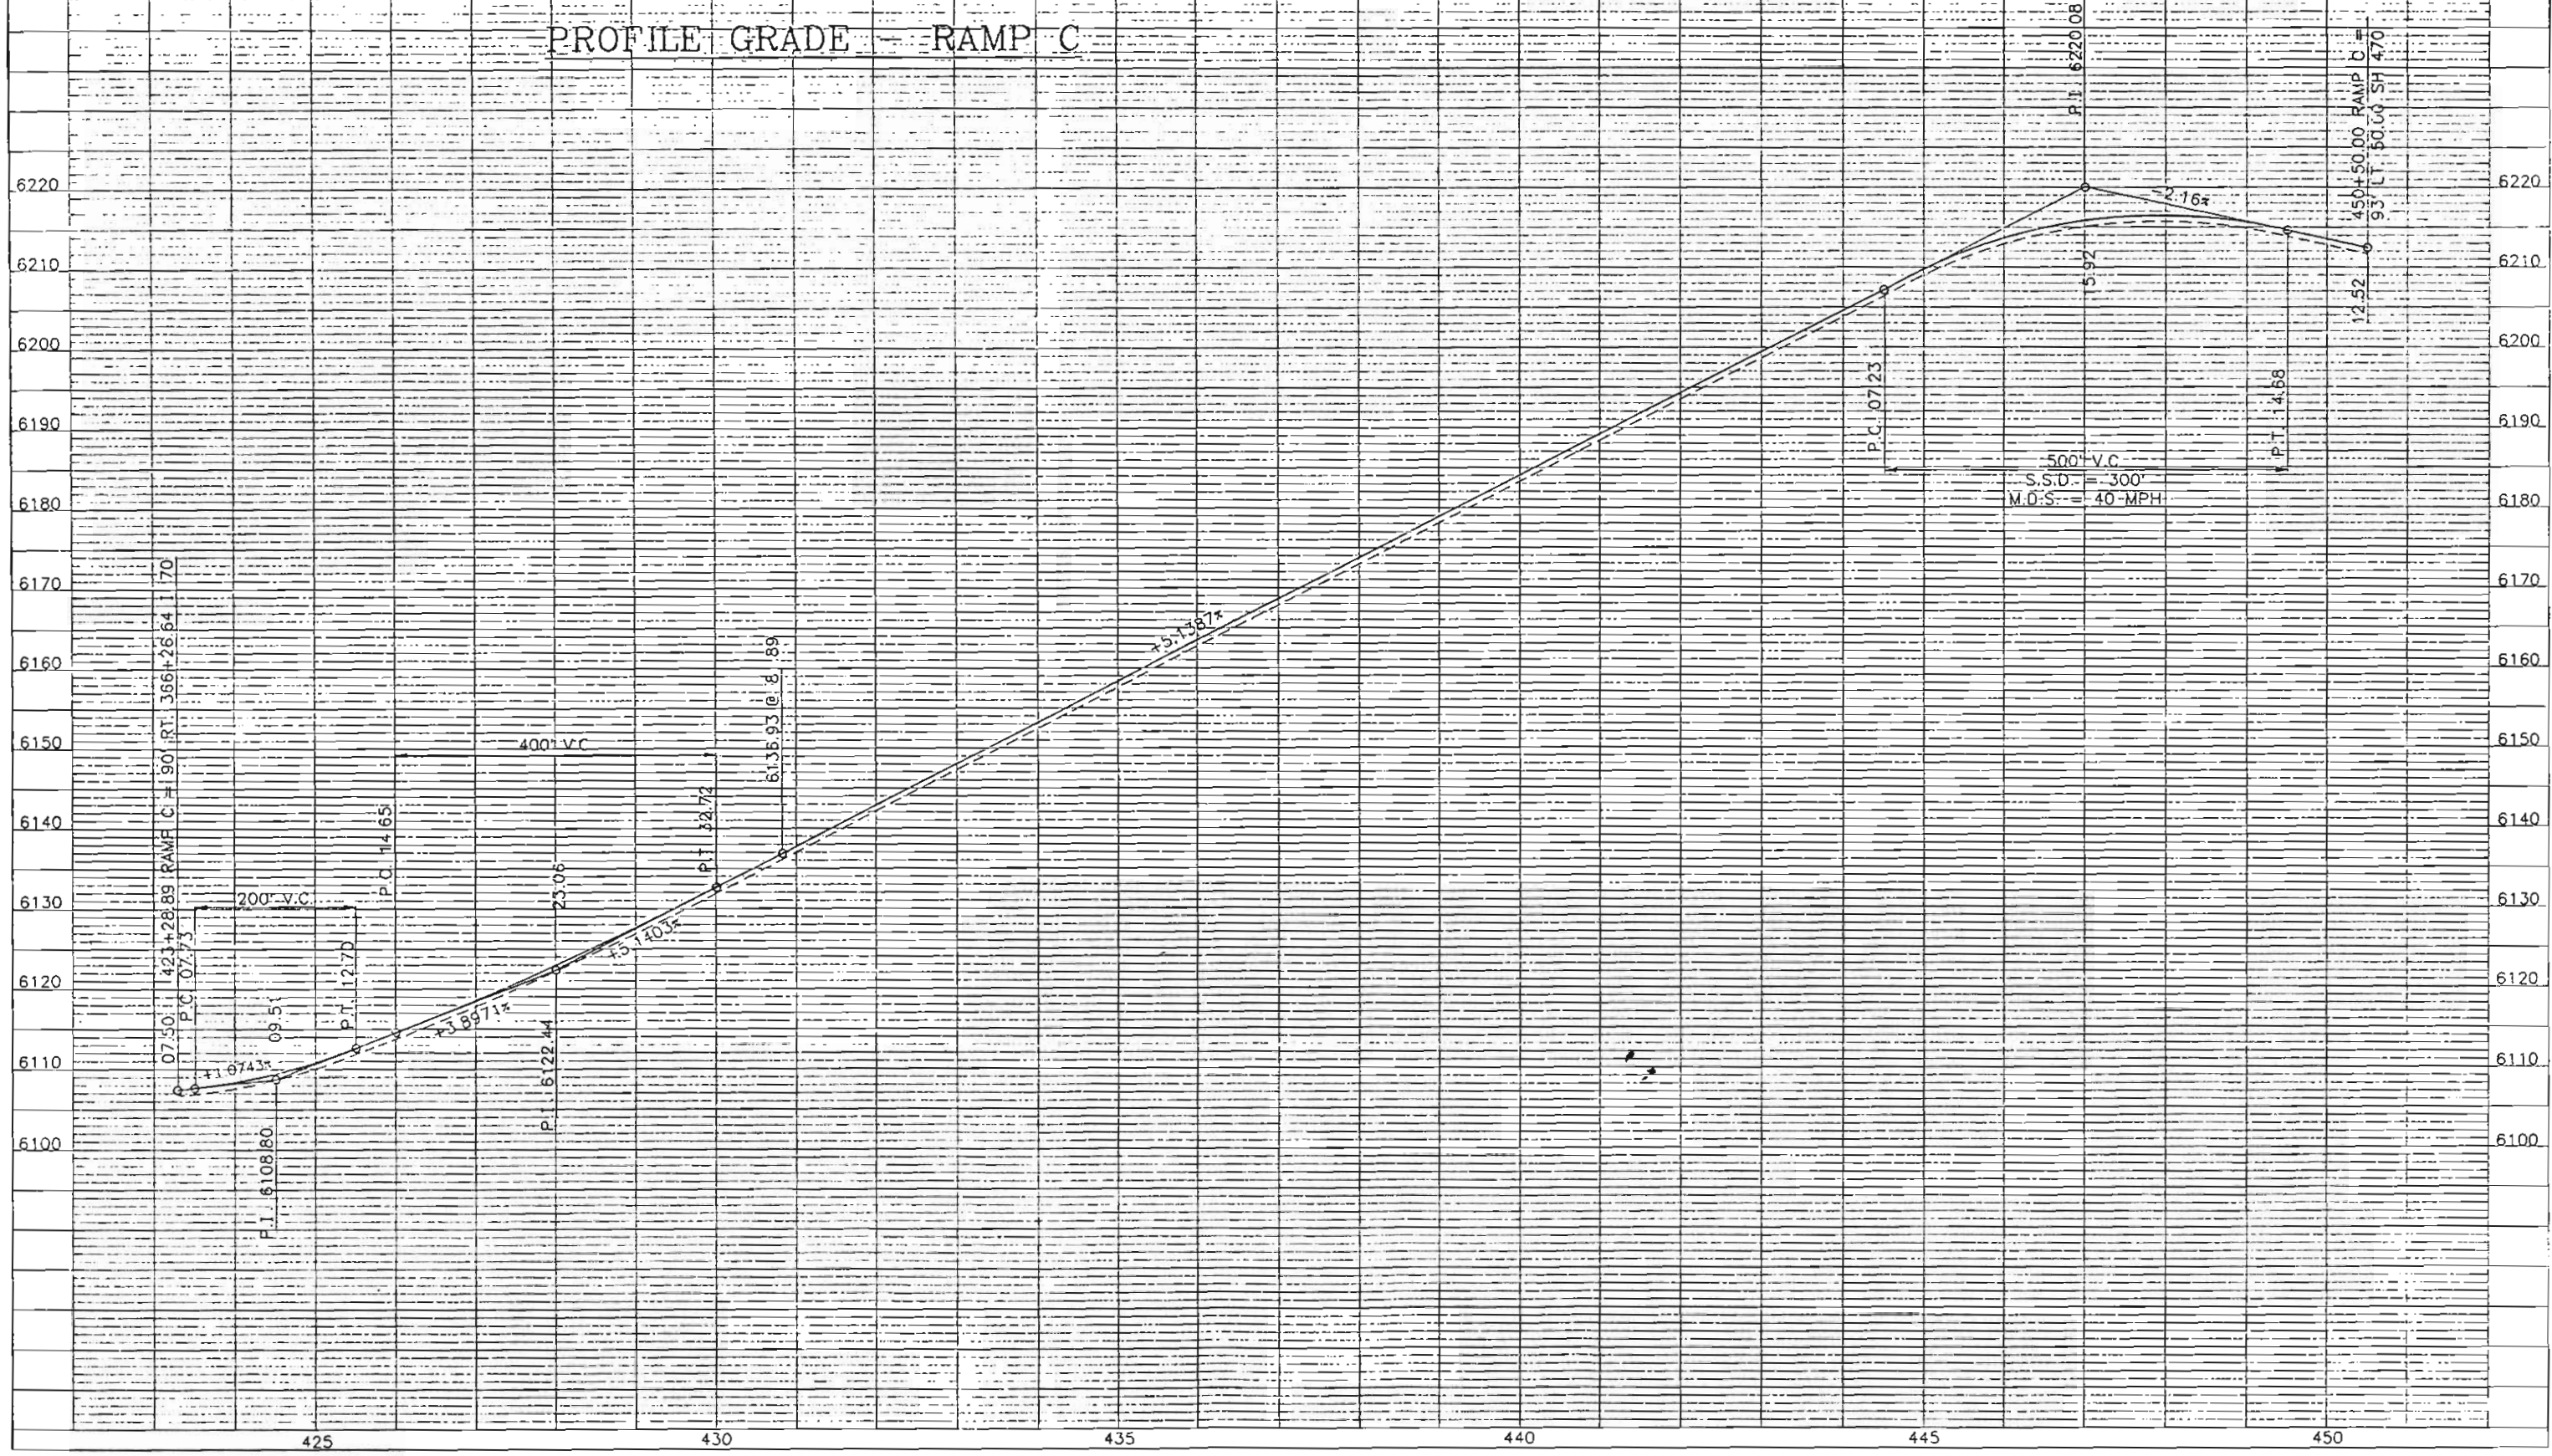


NO number 0... 2/87 10:38:26 ... D:\JIS\RAMPS\18201\JIMMY-HOLLIPS RAMPS_C


AS CONSTRUCTED
 NO REVISIONS 12-12-77 REVISED VOID

FED. ROAD REGION	DIVISION	PROJ. NO.	SHEET NO.
XIII	COLG.	I 70-3(140)	31


PROFILE GRADE RAMP D

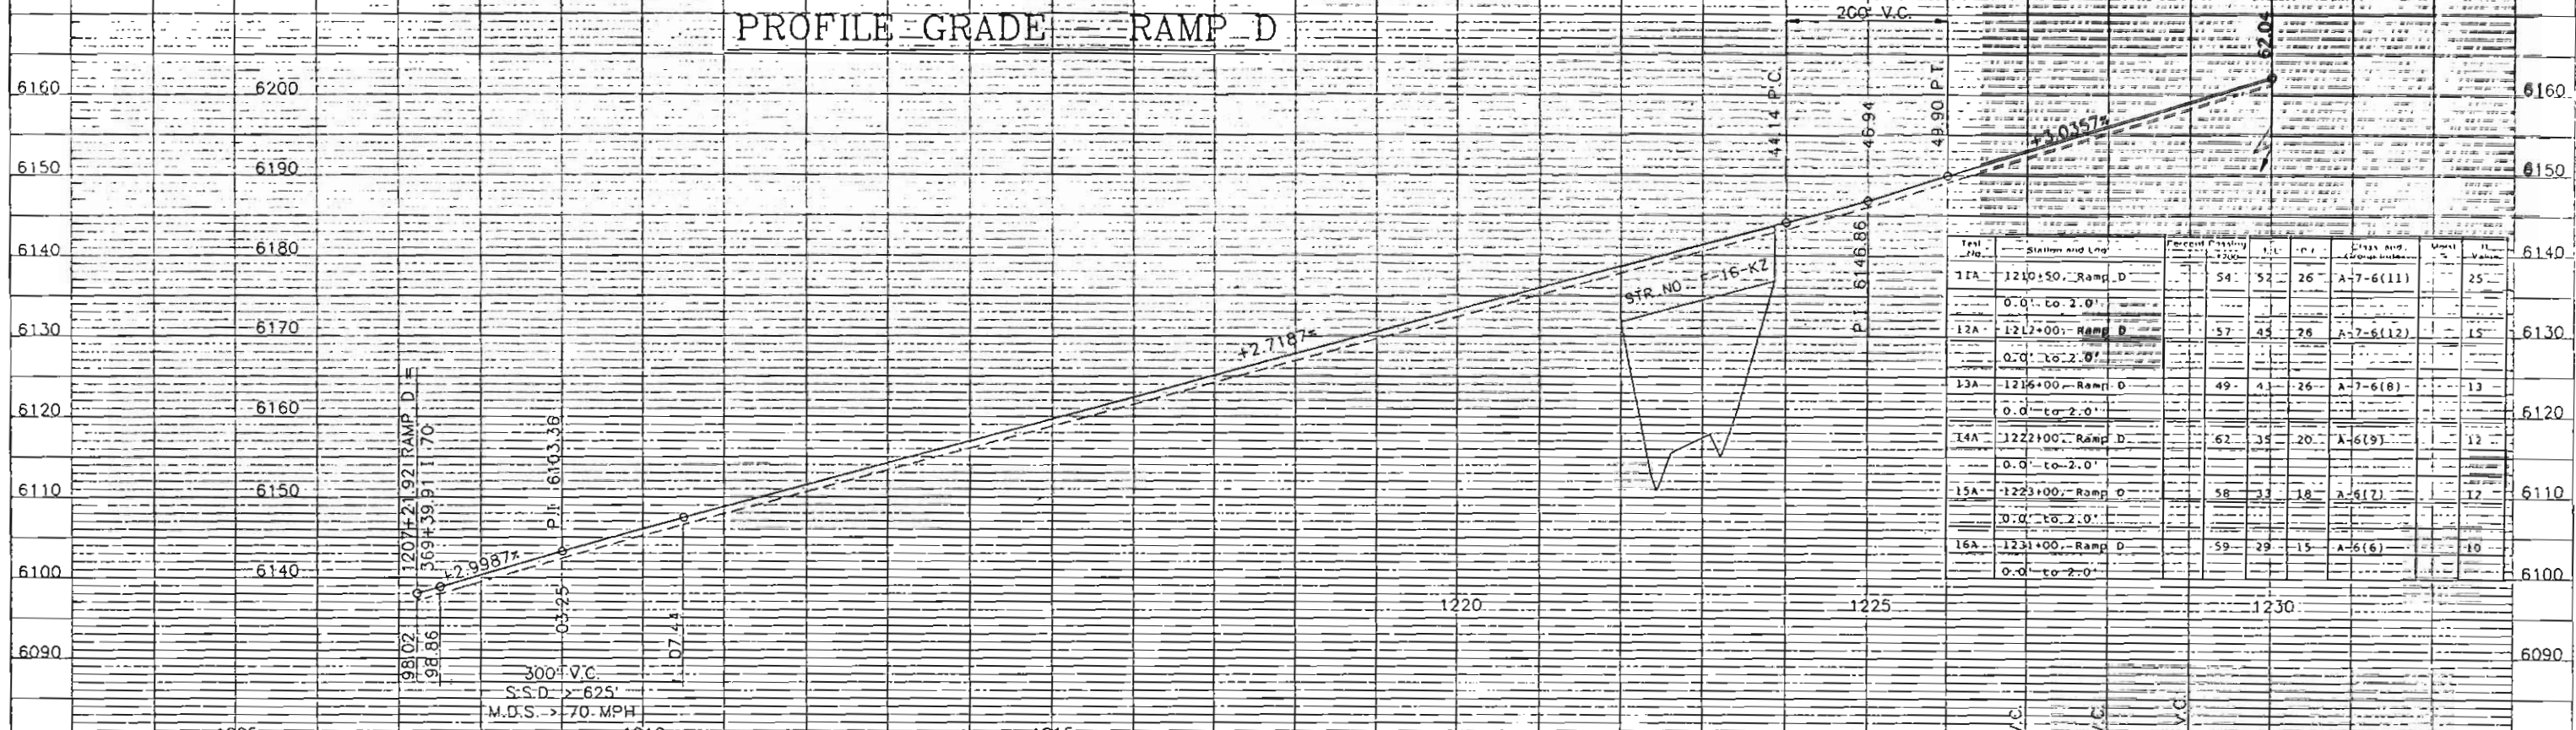

PROFILE GRADE RAMP F

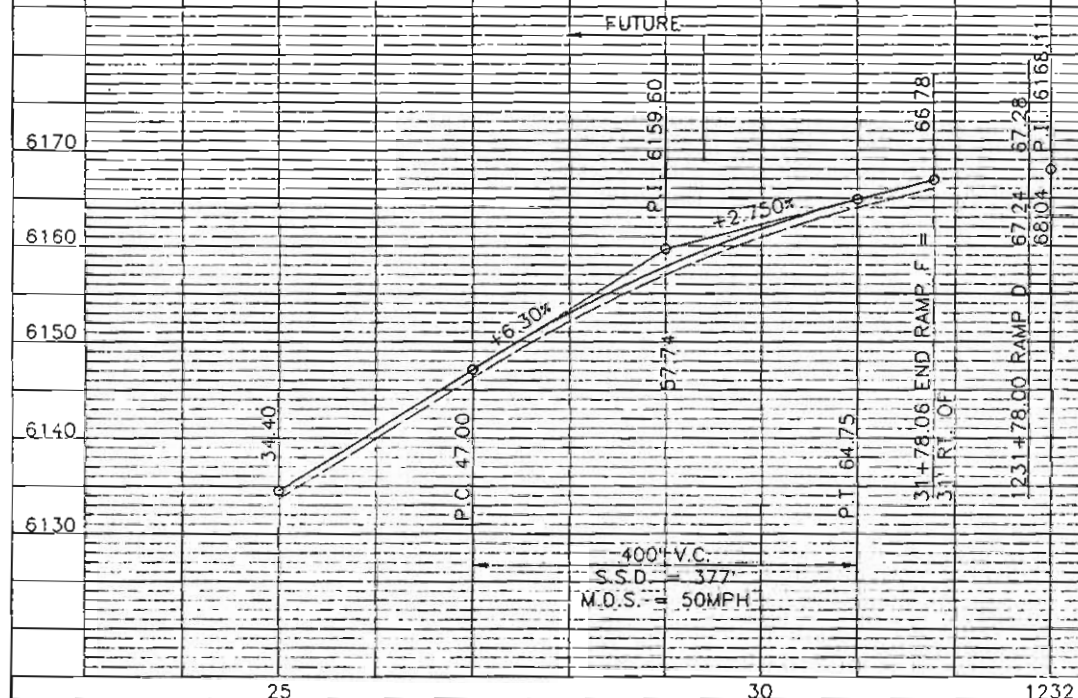

PROFILE GRADE RAMP D

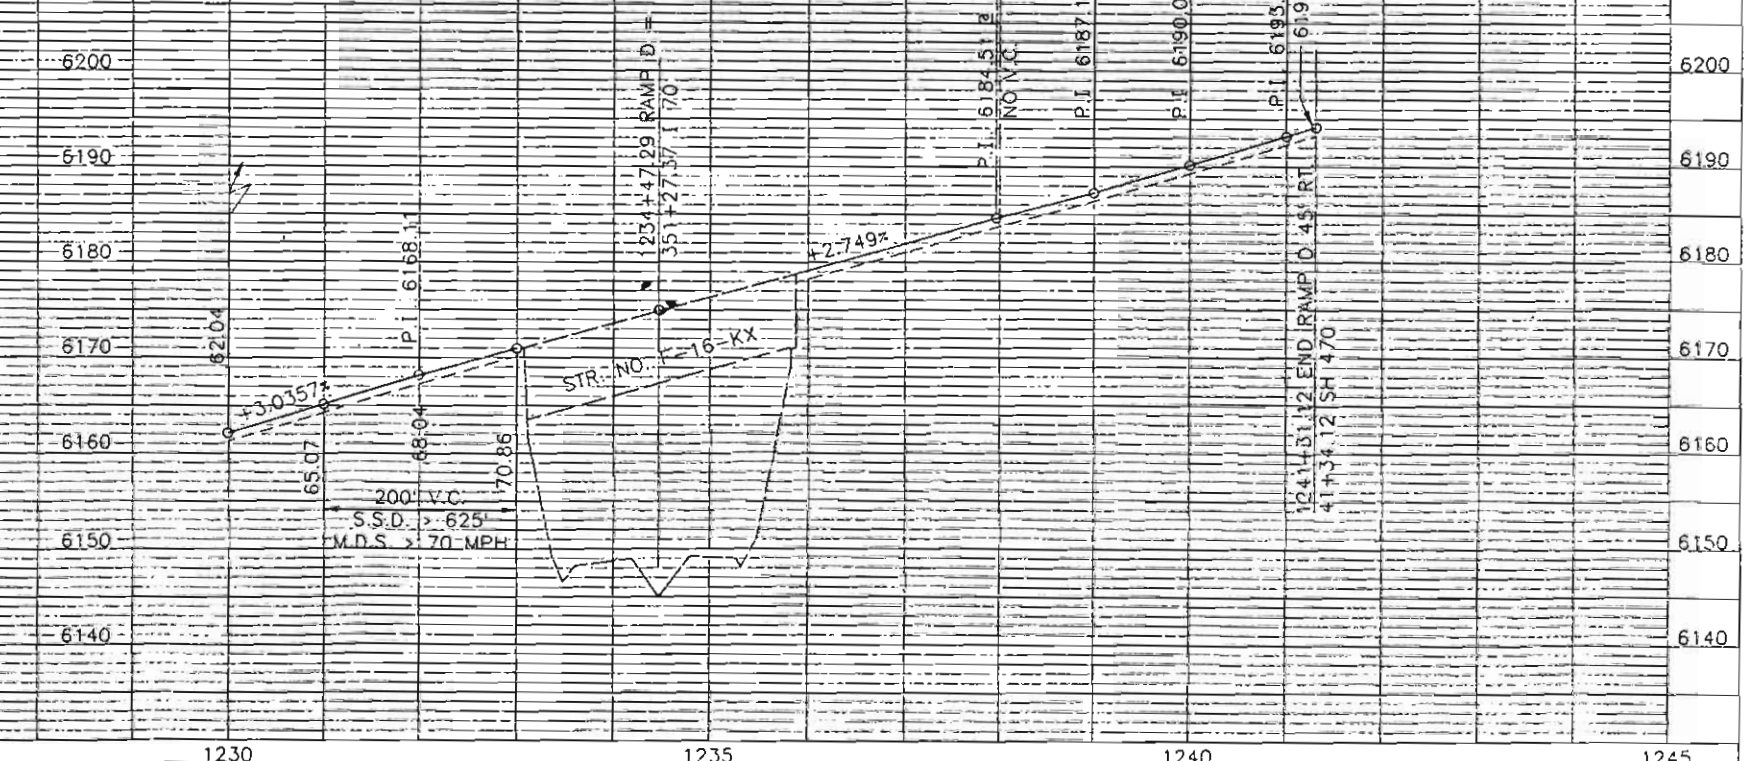

NO number 6-27-87 17:51:47 _DURI: (DRAW.PJ.82011.RDMY.H101.PPS) RAMP_DF

TABULATION OF SIGNING QUANTITIES

SCHEDULE OF CONSTRUCTION TRAFFIC SIGNS

ITEM NO.	ITEM	UNIT	PROJECT TOTALS
202	REM. BARRICADE	EACH	2
202	REM. PAVEMENT MARKING	SQ. FT.	+1,170
202	REM. SIGN PANEL	EACH	4
202	REM. G.D. RAIL TY 4	LIN. FT.	1,442
614	SIGN PANEL (CL. I)	SQ. FT.	228
614	SIGN PANEL (CL. II)	SQ. FT.	520
614	SIGN PANEL (CL. III)	SQ. FT.	1,159
614	TIMBER SIGN POST (6x6)	LIN. FT.	530
614	STEEL SIGN POST (W10x26)	LIN. FT.	47
614	CONC. FOOTING (TY C)	EACH	2
614	CONC. FOOTING II (SPREAD)	EACH	1
614	CONC. FOOTING II-S (SPREAD)	EACH	4
614	MASK SIGN LEGEND	EACH	7
614	MODIFICATION SIGN LEGEND	LS	1
614	SIGN BR STR (70 < 75)	EACH	1
614	SIGN BR STR (80 < 85)	EACH	1
614	CANT STR. (25 < 30)	EACH	4
614	BARRICADE (3M-A)	EACH	30
614	CONST TRAF. SIGN (A)	EACH	8
614	CONST TRAF. SIGN (B)	EACH	34
614	VERTICAL PANEL	EACH	70
614	VERTICAL PANEL (LIGHT) (F)	EACH	24
614	FLASH ARROW PANEL (C TY)	EACH	2
614	TRAFFIC CONE	EACH	50
627	THERMOPLASTIC PYMT MKG	SQ. FT.	16,159
627	PLASTIC PYMT MKG (60 MILS)	SQ. FT.	1,330

SIGNS (2) (4)					OTHER DEVICES		
SIGN CODE	LEGEND	DIMENSIONS	PANEL SIZE			ITEM	QUANTITY
			A	B	C		
⑤ 48W20-1	ROAD/CONSTRUCTION (DIST)	48"x48"	12			ADVANCE WARNING FLASHING OR SEQUENCING ARROW PANEL (TYPE)	2
60G20-2	END/CONSTRUCTION	60"x24"	2			VERTICAL PANEL	70
48W4-2(L)	LEFT LANE TRANSITION	48"x48"	4			VERTICAL PANEL (LIGHT) (F)	24
48W4-2(R)	RIGHT LANE TRANSITION	48"x48"	4			TRAFFIC CONE (28")	50
③ 48W20-5()	() LANE/CLOSED (DIST)	48"x48"	4				
48W20-7a	FLAGGER SYMBOL	48"x48"	4				
48W20-50	BE/PREPARED/TO/STOP	48"x48"	2				
60G20-1	ROAD/CONST/ NEXT 3 MILES	60"x36"	2				
BARRICADE (TY 2)				8			
SIGN TOTALS							8-34

- ① ALL SPECIAL REQUIREMENTS FOR CONSTRUCTION TRAFFIC CONTROL DEVICES WILL NOT BE PAID FOR SEPARATELY, BUT SHALL BE INCLUDED IN THE ITEM.
- ② CONSTRUCTION WARNING SIGNS SHALL BE FURNISHED WITH "HIGH BRIGHTNESS ENCAPSULATED TYPE REFLECTIVE SHEETING". SEE SECTION 713 OF THE STANDARD SPECIFICATIONS.
- ③ W20-5() ADVANCE WARNING SIGNS SHALL BE FURNISHED WITH EXCHANGEABLE PLAQUES READING "RIGHT", "LEFT", AND "CENTER", AT NO ADDITIONAL COST.
- ④ SIGNS MUST BE PERMANENTLY MOUNTED UNLESS OTHERWISE APPROVED BY THE ENGINEER. (SEE STANDARD S-G14-1)
- ⑤ INCLUDES 2-"1 MILES", 2-"2 MILES", 2-"3 MILES" FOR EASTBOUND AND 2-"AHEAD", 2-"1/2 MILE", 2-"1 MILE" FOR WESTBOUND.
- ⑥ THE CONTRACTOR WILL BE REQUIRED TO COVER ALL SIGNS WHICH CONFLICT WITH CONSTRUCTION SIGNING AS INCIDENTAL TO TRAFFIC CONTROL.

TABULATION OF OVERHEAD SIGNS

NOTES FOR OVERHEAD SIGNS

SIGN NO.	STATION	SIGN PANEL SIZE	BACK-GROUND COLOR	NO. OF POSTS	TYPE OF POST	STRUCTURE TYPE	FRAME SIZE	STRUCTURE NUMBER	SIGN PANEL CLASS I (SQ. FT.)	SIGN PANEL CLASS II (SQ. FT.)	SIGN PANEL CLASS III (SQ. FT.)	TYPE OF FOOTING	COMMENTS
1	751+00	13'x12'	GREEN			ON EXISTING SIGN BRIDGE	82'	F-16-GU		156.00	152.00	EXISTING	REPLACE THIS SIGN PANEL 10'x10'x12'x12' MASK SIGN LEGEND
2A	314+00	14'x11'	GREEN	1	VI	CANTILEVER	28'	F-16-ML		154.00	148.00	EXISTING	
2B		15'-8"x2'-6"	YELLOW						34.17				
4	322+00					ON EXISTING BUTTERFLY		F-16-MN					MODIFY LEGEND
5A	330+00	15'x11'	GREEN	1	VI	CANTILEVER	29'	F-16-MA		165.00	157.00	EXISTING	MASK SIGN LEGEND
5B		14'-8"x2'-6"	YELLOW						36.67				
12A		10'x2'	GREEN								20.00		
12B	369+50	16'x11'	GREEN			ON EXISTING SIGN BRIDGE	103'	F-16-MQ			176.00	EXISTING	MASK SIGN LEGEND
12C		15'-8"x2'-6"	YELLOW						39.17				
22A		10'x2'	GREEN								20.00		
22B	383+00	16'x11'	GREEN			ON EXISTING SIGN BRIDGE	116'	F-16-MR			176.00	EXISTING	MASK SIGN LEGEND
22C		15'-8"x2'-6"	YELLOW						39.17				
26	408+00					ON EXISTING SIGN BRIDGE CANT.	103'	F-16-MT					REMOVE SIGN PANEL (UNMASK SIGN LEGEND)
27	420+50	13'x11'	GREEN	1	VI	CANTILEVER	30'	F-16-MU	143.00	137.00		EXISTING	MASK SIGN LEGEND
28	125+50	23'x7'	GREEN			ON EXISTING BUTTERFLY	23'	F-16-NR			161.00	EXISTING	
29	199+00					ON EXISTING BUTTERFLY	23'	F-16-NU					REMOVE SIGN PANEL (UNMASK SIGN LEGEND)
31	31+50	15'x9'	YELLOW	1	VI	CANTILEVER	30'	F-16-PX			135.00	VI (SPREAD)	DARK TAN PAINTING
46A		13'x10'	GREEN								130.00		
46B	54+36	16'x10'	GREEN	2	II-S	SIGN BRIDGE	84'	F-16-PY			160.00	II-S (SPREAD)	DARK TAN PAINTING
46C		15'-8"x2'-6"	YELLOW						39.17				
51A	69+00	16'x10'	GREEN	2	II-S	SIGN BRIDGE	72'	F-16-PZ			160.00	II-S (SPREAD)	DARK TAN PAINTING
51B		15'-8"x2'-6"	YELLOW						39.17				
SPEED LIMIT	RAMP A	1'-6" x 3'	1 EA.		EXIST.				4.5				
SPEED LIMIT	RAMP E	1'-6" x 3'	2 EA.		EXIST.				9.0				
HAZ. PANEL	RAMP B	1' x 3'	12 EA.		FLEX.				36.0				
HAZ. PANEL	RAMP D	1' x 3'	12 EA.		FLEX.				36.0				
TOTAL PANEL FOR OVERHEAD SIGNS									227.52		1732.00		
									312.5		1759.00		


- PANELS FOR OVERHEAD SIGNS SHALL BE SHEET ALUMINUM. SEE "CLASS III SIGNS, SHEETS 1 AND 2" INCLUDED IN THE PLANS FOR PANEL AND BACKING ZEE REQUIREMENTS. ~~SEE DEPARTMENT STANDARD "CLASS II GROUND SIGN INSTALLATIONS" FOR CLASS II PANELS. PANELS SHALL HAVE 3 ALUMINUM BACKING ZEES SPACED AT 2" C. SEE DEPARTMENT STANDARD "CLASS I GROUND SIGN INSTALLATIONS" FOR CLASS I PANEL REQUIREMENTS. MINIMUM THICKNESS IS REDUCED TO 0.080"~~
- CLASS III AND CLASS I PANELS SHALL HAVE A SMOOTH SURFACE TYPE REFLECTIVE SHEETING BACKGROUND. ~~CLASS II PANELS SHALL HAVE HIGH BRIGHTNESS ENCAPSULATED TYPE REFLECTIVE SHEETING.~~
- LEGEND AND BORDER FOR GREEN BACKGROUND SIGNS SHALL BE SYSTEM 1 OR SYSTEM 2 AND FOR YELLOW BACKGROUND SIGNS SHALL BE SYSTEM 4. SEE SECTION 713 OF THE STANDARD SPECIFICATIONS.
- SEE THE PROJECT SPECIAL PROVISION FOR MASK SIGN LEGEND (PERMANENT).
- SEE THE PROJECT SPECIAL PROVISIONS FOR DARK TAN PAINTING.

CLASS III SIGNS - SHEET 2

AS CONSTRUCTED		
NO REVISIONS	REVISED	VOID

FEDERAL ROAD REGION NO	DISTRICT	PROJ NO	SHEET NO	TOTAL SHEETS
XIII	COLORADO	I 70-3 (140)	38	57

REVISIONS	

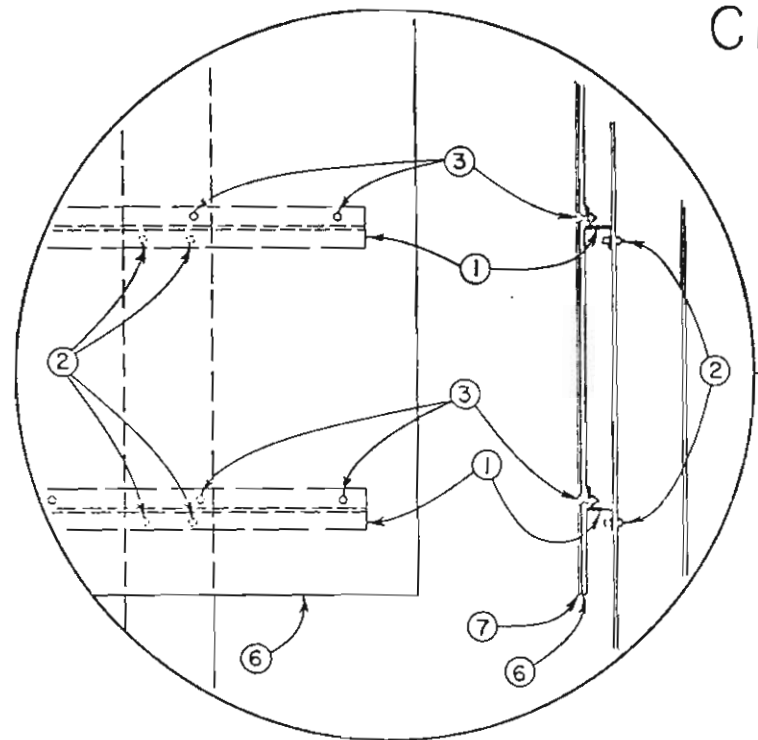


TYPICAL ELEVATION-DETAIL

FABRICATION NOTES




- ① BACKING ZEE. See "SPACING TABLE." Aluminum Alloy 6061-T6. Each zee to be provided with a 3/16" x 2" horizontal slot for each post mounting bolt. The length of each zee to be 1' less than the sign panel width.
- ② 3/8" HEX-HEAD BOLT. With nut and washers; 2 per backing zee per post are required.
- ③ 3/8" (No. 6) 90° COUNTERSUNK ALUMINUM LOCKBOLT FASTENER.
- ④ 2" x 0.080" ALUMINUM CLOSURE STRIP.
- ⑤ 1/8" x 3/8" UNIVERSAL-HEAD, HOLLOW SHANK ALUMINUM RIVET.
- ⑥ SHEET ALUMINUM. 0.125" minimum thickness.
- ⑦ NON-EXPOSED LENS REFLECTIVE SHEETING. To have a dry (heat activated) adhesive backing.

TYPICAL DETAIL SEAM CLOSURE ZEE

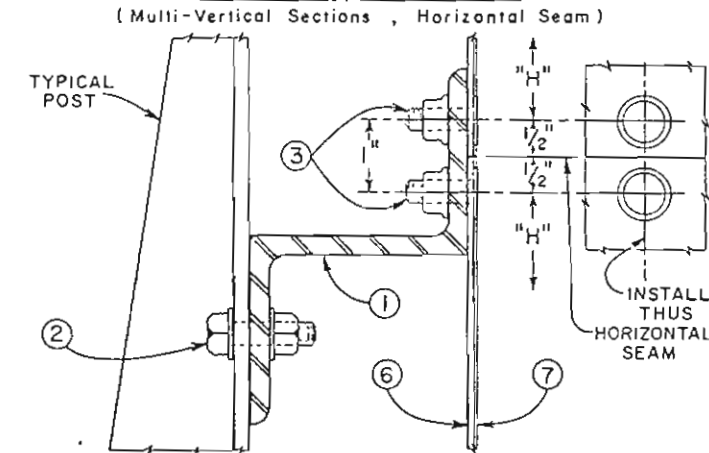




TYPICAL TIMBER POST INSTALLATION

PANEL FABRICATION AND MOUNTING DETAILS

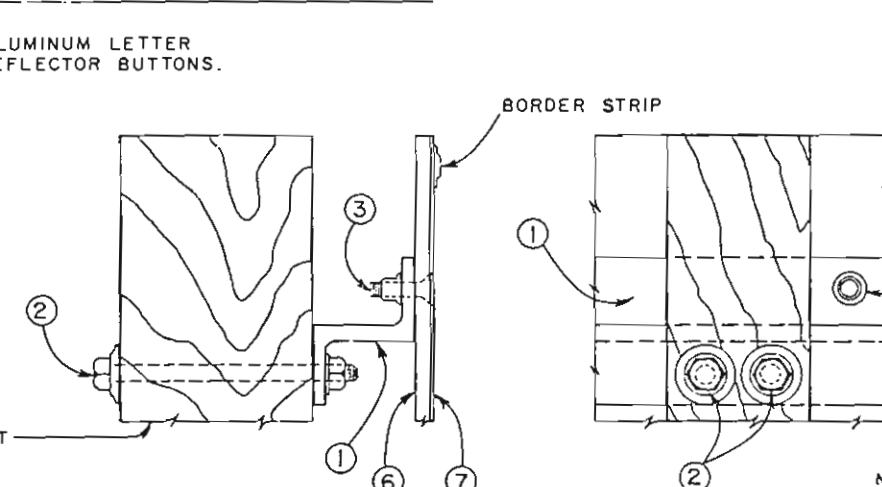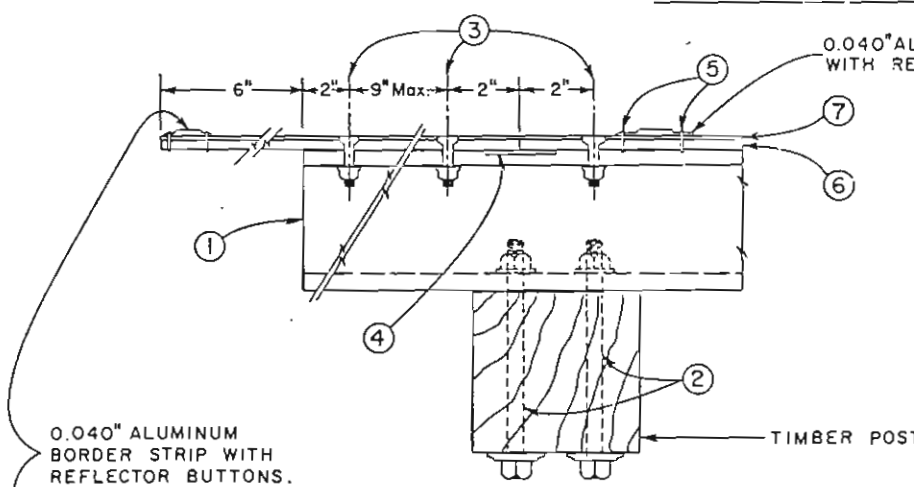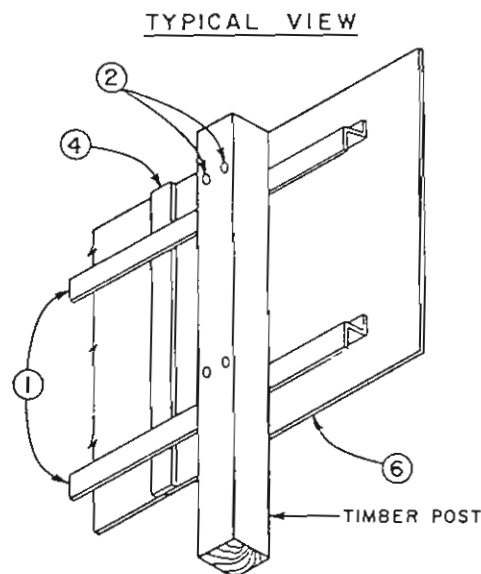


TYPICAL STEEL POST INSTALLATION

PANEL FABRICATION AND MOUNTING DETAILS

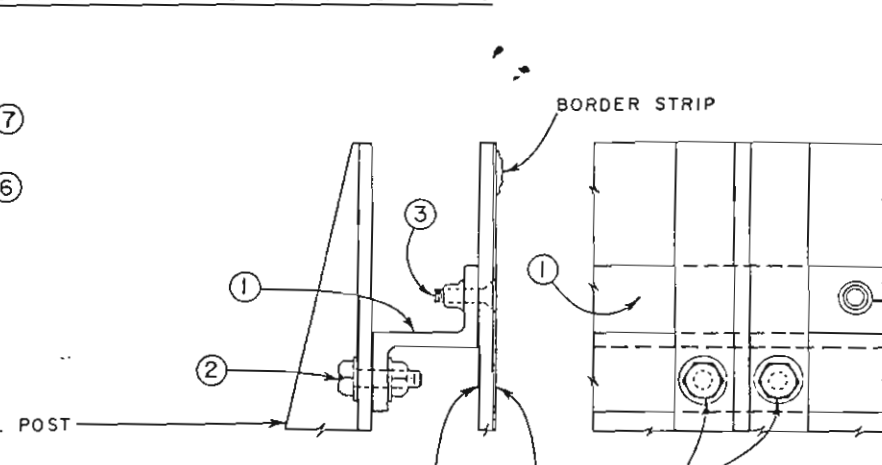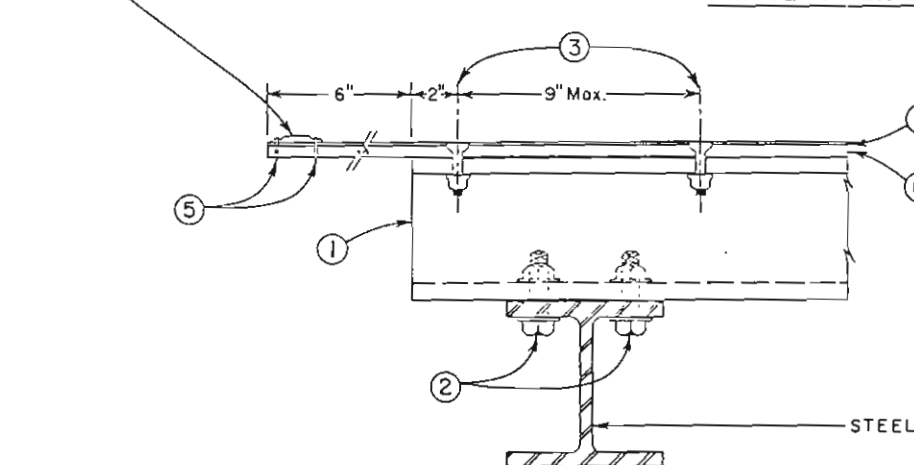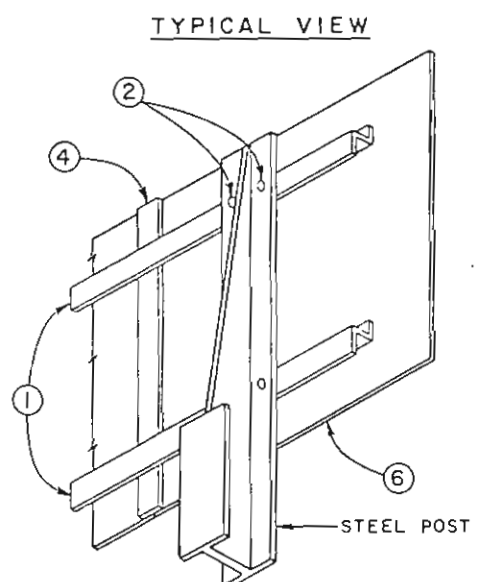

TYPICAL BORDER DETAILS EXIT NUMBER PANELS

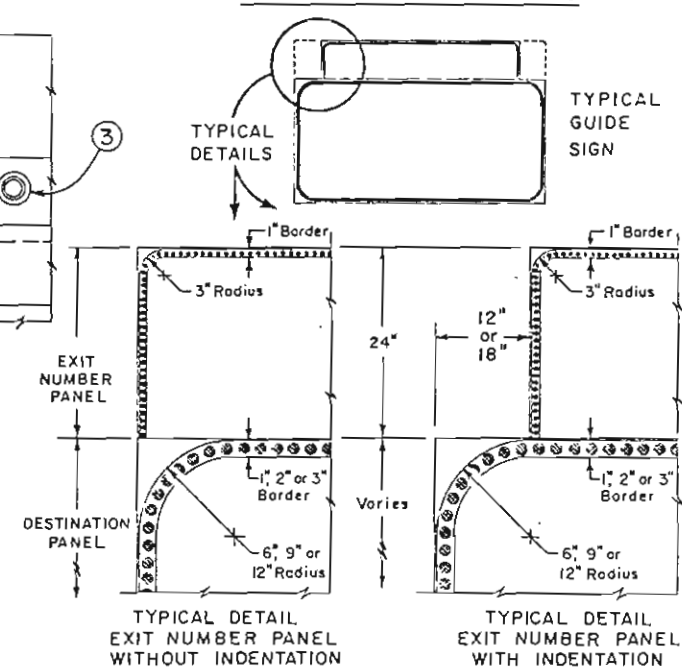

DEPARTMENT OF HIGHWAYS
STATE OF COLORADO
DIVISION OF HIGHWAYS

CLASS III SIGNS
SHEET ALUMINUM
PANELS

TYPICAL ELEVATION
STEEL POST ASSEMBLY

AS CONSTRUCTED
NO REVISIONS 12-12-88 REVISED VOID

STANDARD S-614-5

(SHEET 1 OF 2 SHEETS)
JANUARY 1982

SPECIAL FOR THIS
PROJECT


FEDERAL ROAD REGION NO.	DIVISION	PROJ. NO.	SHEET NO.	TOTAL SHEETS
VIII	COLORADO	I 70-3(140)	39	7

REVISIONS	


TYPICAL BREAK-AWAY SIGN SUPPORT INSTALLATIONS

STEEL POSTS

TIMBER POSTS

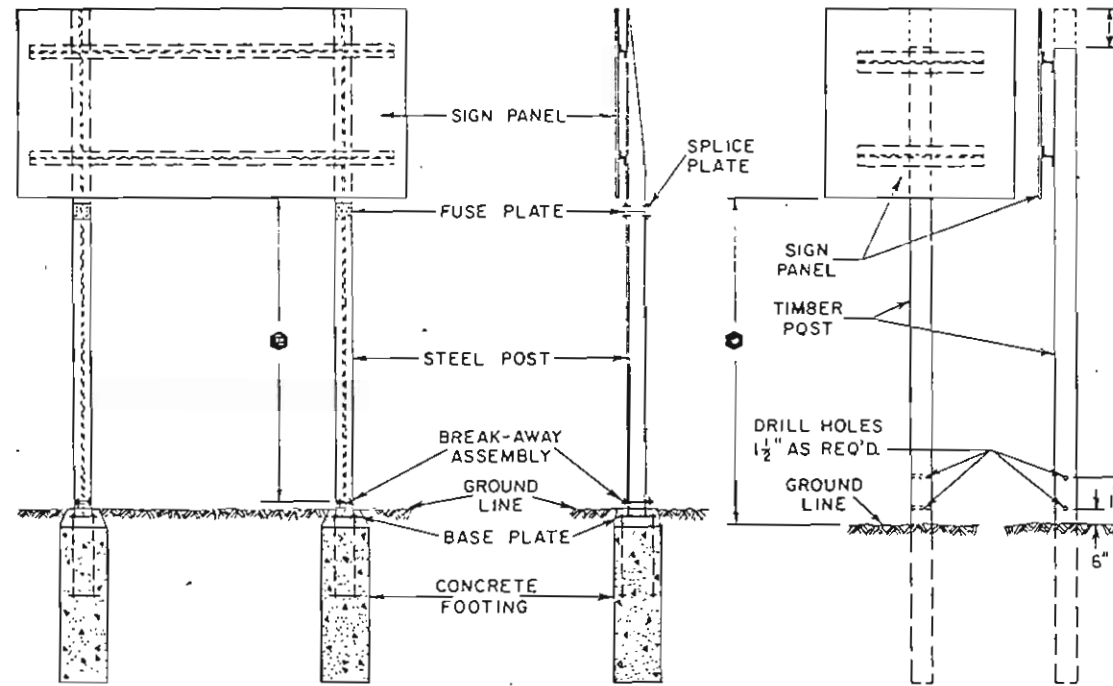

TYPICAL PROJECTED VIEW
STEEL POST ASSEMBLY

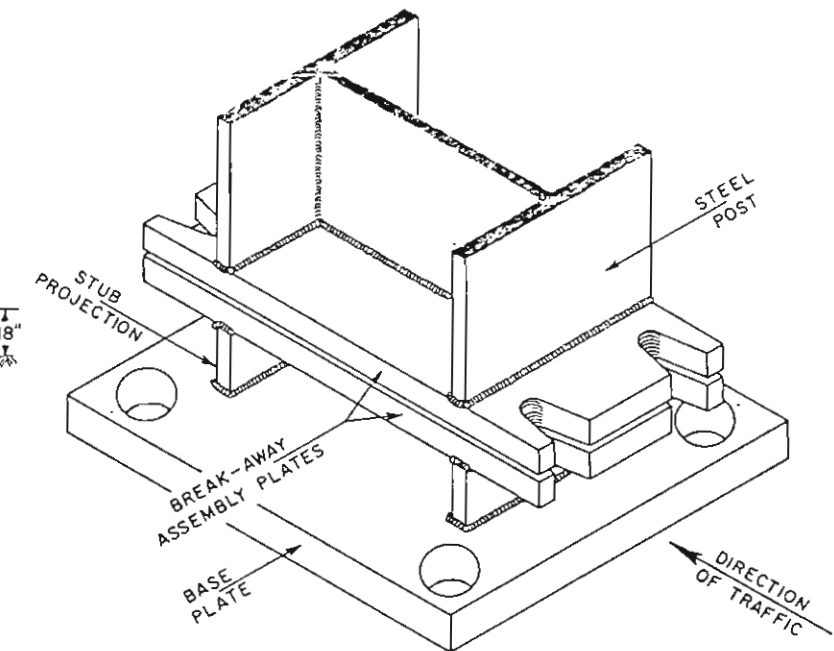

GENERAL NOTES

- All work shall be done in accordance with the Standard Specifications applicable to the Project.
- Design conforms with AASHTO "Specifications for the Design and Construction of Structural Supports for Highway Signs".
- All structural steel shall conform to ASTM-A36 and Section 509 of the Standard Specifications.
- Steel fuse plates and splice plates shall conform to ASTM-A36.
- All high strength bolts, nuts and washers shall conform to ASTM-A325. Washers used in the Break-Away Plate and Fuse Plate assemblies shall be of sufficient strength to prevent any deflection or "cupping" into the slotted grooves under bolt torquing.
- All bolts other than high strength bolts shall conform to ASTM-A307.
- All bolts, nuts, and washers shall be galvanized as per ASTM-A153 or ASTM-A164.
- All holes except of fuse plate may be drilled or sub-punched and reamed.
- All steel cuts shall preferably be saw cuts; however, flame cutting will be permitted provided all edges are ground. Remove all burrs. Metal shall not project beyond the plane of the plate face.
- A "Keeper Plate" of thin (28-gage) galvanized sheet metal, fabricated to match break-away plate dimensions but with holes rather than slots, shall be used to restrain bolt loosening due to wind vibration.
- High strength bolts in the break-away assembly shall be tightened only to the torque shown in the table. DO NOT OVERTIGHTEN.
- The "STUB POST" and one "BREAK-AWAY PLATE" are considered part of the footing. The other "BREAK-AWAY PLATE" and all nuts, bolts, washers and keeper plate for fastening the break-away plates are considered to be a part of the post.
- Timber posts shall be in accordance with Section 614 of the Standard Specifications as to Size, Alternate Size, Grade, Species, Treatment, and Break-Away Holes.
- For all base plate and footing work see the applicable Standard included in the plans.
- For additional information, refer to "Tabulation of Signs" and "Cross Sections for Class III Signs" included in the plans.
- Timber post flush with top of sign panel for direct mount and 3 3/16" minimum above bolt for backing zee mount.
- Minimum post length from bottom of sign panel to break-away assembly or ground line shall be 7' (in no case shall a backing zee be placed below the fuse plates).

BREAK-AWAY PLATE DATA TABLE


POST SIZE	DIMENSION	BOLT SIZE AND TORQUE	A	B	C	D	E	t1	WELD Z	R	STUB POST LENGTH
W 12 x 40		7/8" x 3 3/4" 1,135 In. Lb.	8"	19 1/4"	1 5/8"	4"	2"	1 1/4"	3/8"	1 5/32"	0'-4"
W 12 x 35			6 1/2"	17"	7/8"	3 1/2"	1 1/2"	1"	3/16"	1 3/32"	0'-4"
W 10 x 26		3/4" x 3 1/2" 750 In. Lb.	5 3/4"	14 7/8"	7/8"	3 1/4"	1 1/4"	1"	3/16"	1 3/32"	0'-4"
W 10 x 22			5 3/4"	14 3/8"	7/8"	3 1/4"	1 1/4"	1"	3/16"	1 3/32"	0'-4"
W 8 x 21			5 1/4"	12 3/8"	7/8"	2 3/4"	1 1/4"	1"	3/16"	1 3/32"	0'-4"
W 8 x 18			5 1/4"	12"	3/4"	3"	1 1/8"	3/4"	1/4"	1 1/32"	0'-4"
W 6 x 15		5/8" x 2 3/4" 450 In. Lb.	6"	10"	3/4"	3 3/4"	1 1/8"	3/4"	1/4"	1 1/32"	0'-4"
W 6 x 12			5"	10"	3/4"	2 3/4"	1 1/8"	3/4"	1/4"	1 1/32"	0'-4"

BOLTING PROCEDURE FOR
BREAK-AWAY PLATE ASSEMBLY


- Assemble post to stub with bolts - one flat washer on each bolt top and bottom, and one flat washer and the keeper plate between the break-away plates.
- Tighten all bolts to a "snug tight" condition with a 12" to 15" wrench to bed washers and to clean bolt threads, then loosen each bolt in turn and retighten in a systematic order to the prescribed torque. (See Break-Away Plate Data Table)
- Burr threads at junction with nut to prevent nut loosening.

DEPARTMENT OF HIGHWAYS
STATE OF COLORADO
DIVISION OF HIGHWAYS
BREAK-AWAY SIGN
SUPPORT DETAILS
FOR GROUND SIGNS

Designed By: J.J.B. Safety Traffic Engineer
Made By: F.J.B. Safety Projects Engineer
Checked By: J.E.M. Date: January, 19 80
Approved By: [Signature] Safety Traffic Engineer

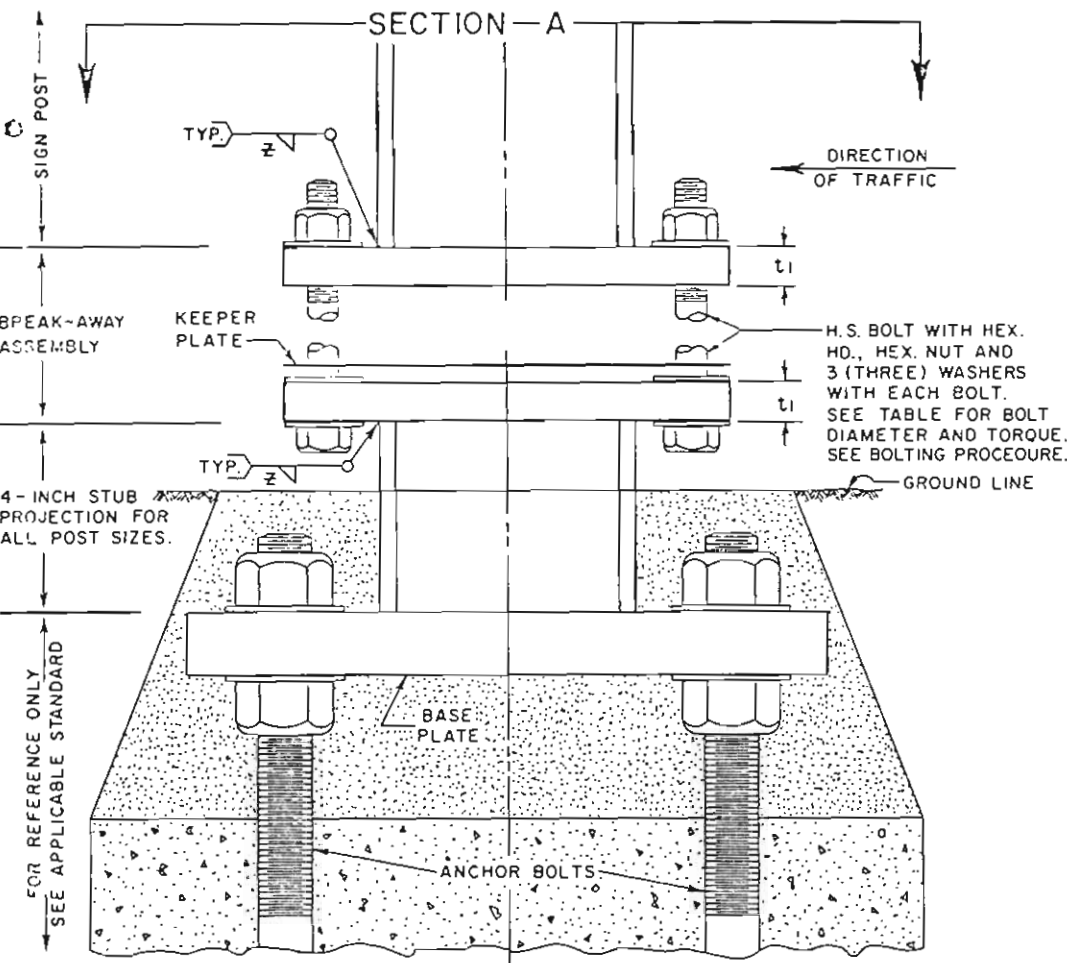

TYPICAL SECTION -A-

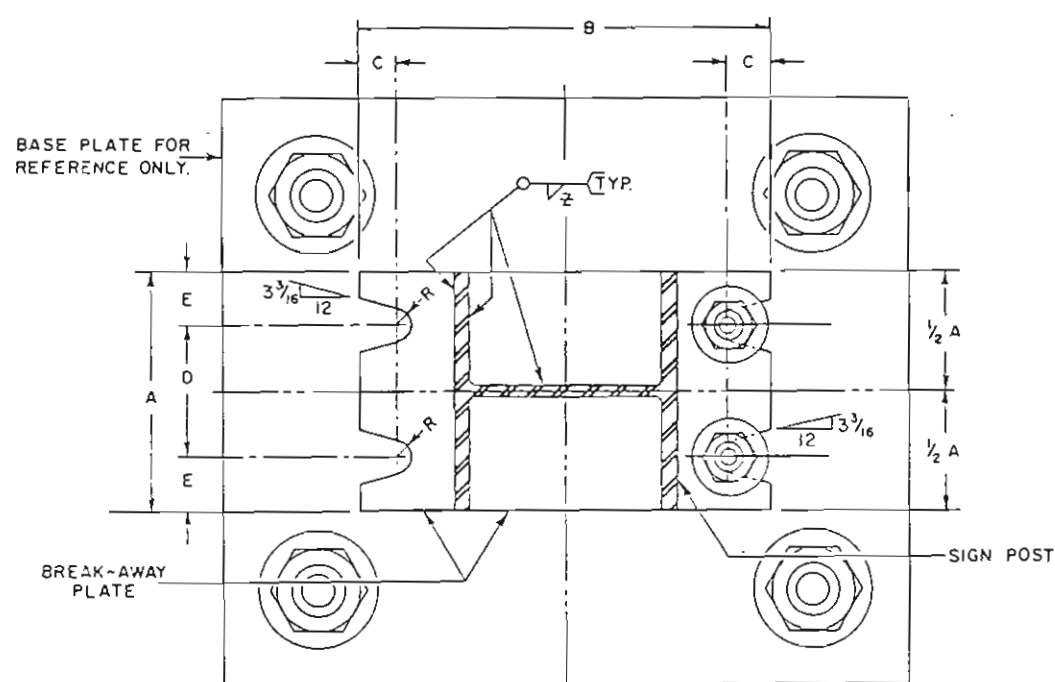


AS CONSTRUCTED
 12-12-22 REVISED
 VOID

STANDARD S-614-5


(SHEET 2 OF 2 SHEETS)
 SPECIAL FOR THIS PROJECT
 JANUARY 1982

REGION NO.	DIVISION	PROJ. NO.	SHEET NO.	TOTAL SHEETS
VIII	COLORADO	I 70-3(140)	40	57
REVISIONS				


TYPICAL SIDE VIEW
 FUSE PLATE AND POST COPE

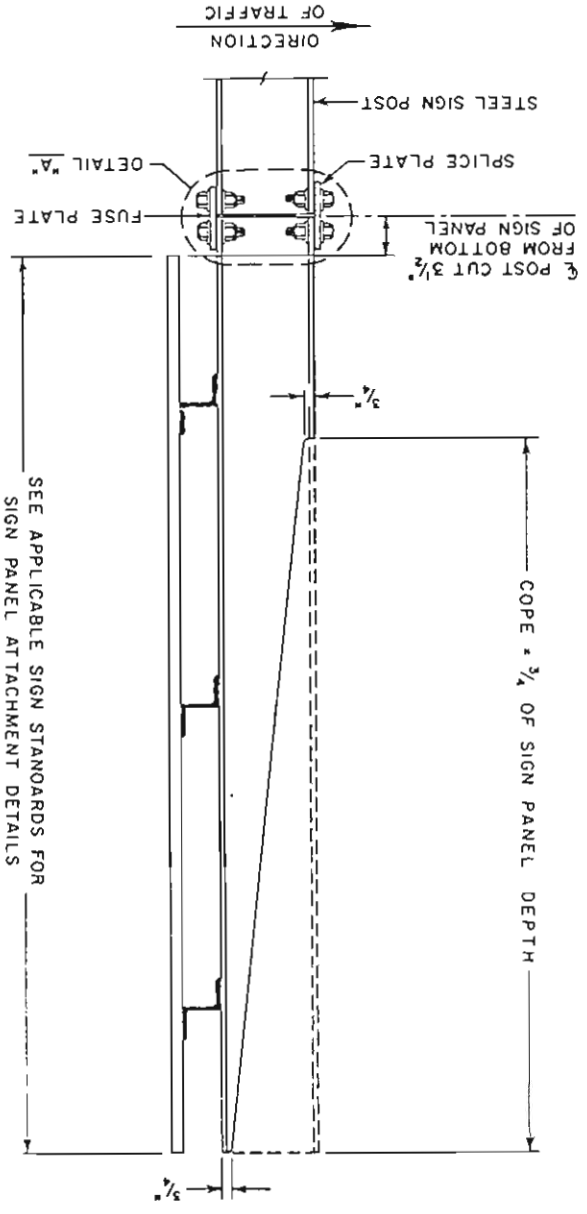

TYPICAL PROJECTED VIEW
 FUSE PLATE AND POST COPE

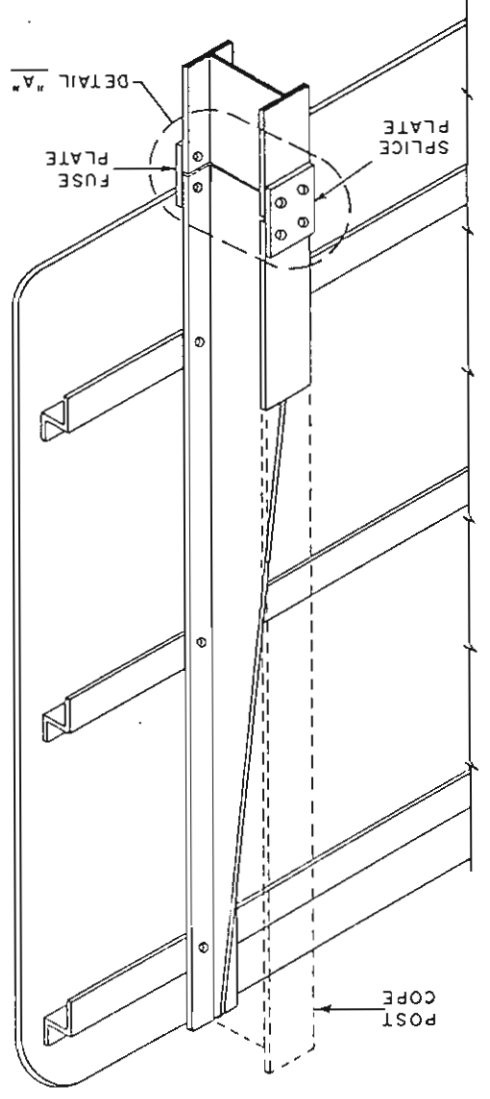

TYPICAL FUSE AND SPLICE PLATE HINGE DETAILS

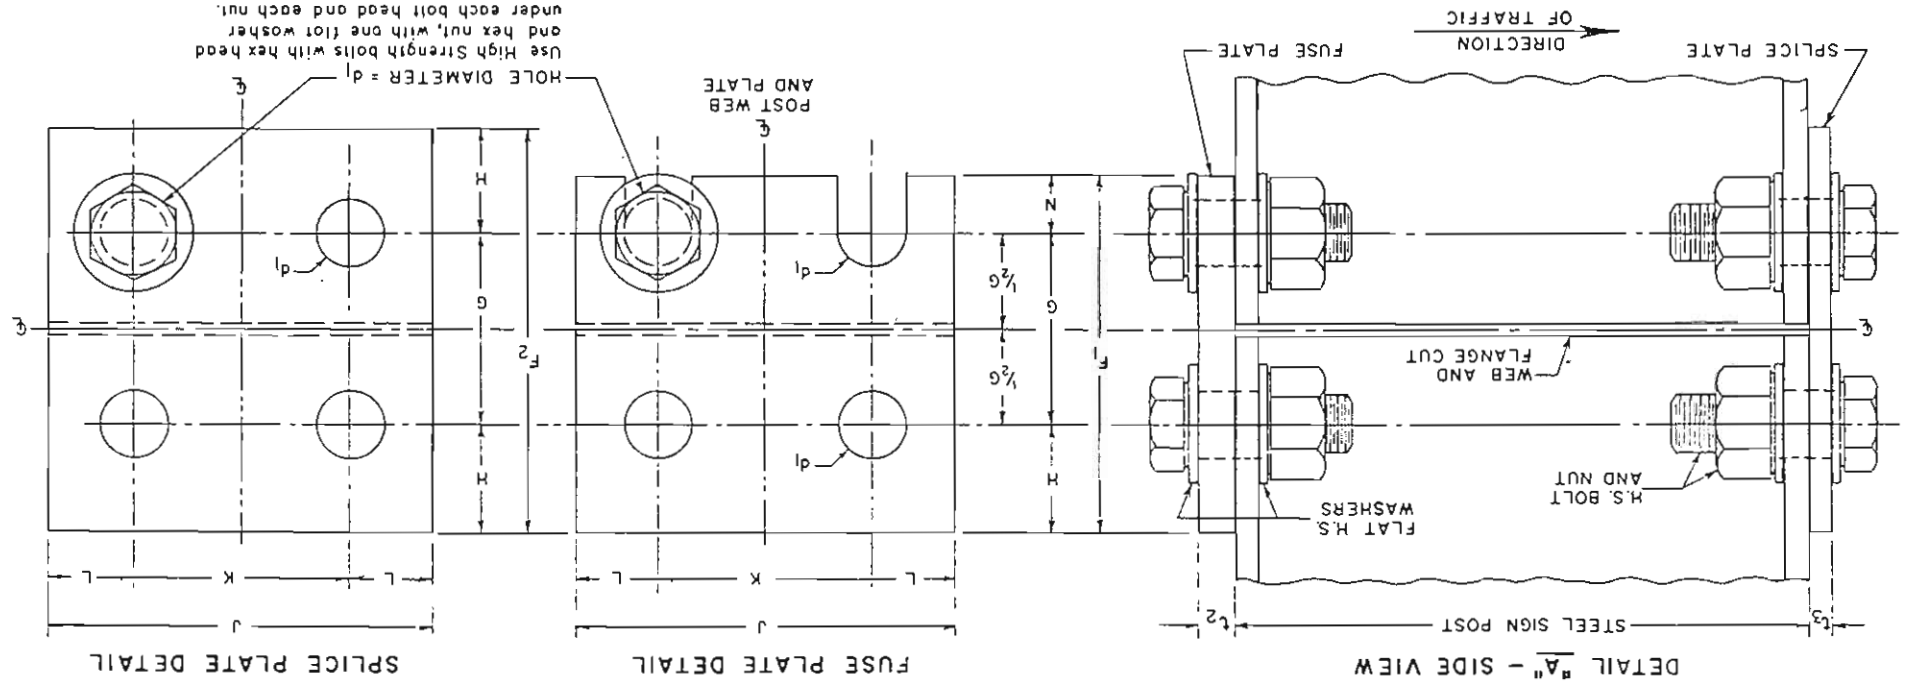

FUSE AND SPLICE PLATE HINGE DATA TABLE

POST SIZE	F ₁	F ₂	G	H	I	J	K	L	N	d ₁	d ₂	d ₃	BOLT RESIDUAL	BOLT TENSION
W 12 x 40	6"	6 3/4"	3 1/4"	1 3/4"	8"	4"	2"	1"	15 1/8"	9 5/8"	7 1/8"	7 1/8"	36,050 LBS.	36,050 LBS.
W 12 x 35	6"	6"	3"	1 1/2"	6 1/2"	3 1/2"	1 1/2"	7 8"	13 1/8"	9 1/8"	7 1/8"	7 1/8"	36,050 LBS.	36,050 LBS.
W 10 x 26	6"	6"	3"	1 1/2"	5 3/4"	2 3/4"	1 1/2"	7 8"	10 1/8"	9 1/8"	7 1/8"	7 1/8"	36,050 LBS.	36,050 LBS.
W 10 x 22	6"	6"	3"	1 1/2"	5 3/4"	2 3/4"	1 1/2"	7 8"	10 1/8"	9 1/8"	7 1/8"	7 1/8"	36,050 LBS.	36,050 LBS.
W 8 x 21	4 1/2"	5 1/2"	2 1/2"	1 1/2"	5 1/4"	2 3/4"	1 1/2"	7 8"	13 1/8"	9 1/8"	7 1/8"	7 1/8"	28,400 LBS.	36,050 LBS.
W 8 x 18	4 1/2"	5"	2 1/2"	1 1/2"	5 1/4"	2 3/4"	1 1/2"	7 8"	13 1/8"	9 1/8"	7 1/8"	7 1/8"	28,400 LBS.	28,400 LBS.
W 6 x 15	4 1/2"	5"	2 1/2"	1 1/2"	4 1/2"	3 1/2"	1 1/2"	7 8"	13 1/8"	9 1/8"	7 1/8"	7 1/8"	28,400 LBS.	28,400 LBS.
W 6 x 12	3 3/4"	4 1/2"	2"	1 1/2"	4 1/2"	3 1/2"	1 1/2"	7 8"	11 1/8"	9 1/8"	7 1/8"	7 1/8"	19,200 LBS.	19,200 LBS.

FUSE PLATE AND ITS POST HINGE HOLES SHALL BE DRILLED, OR CUT, TO FIT THE POST. INSTALL FUSE PLATE WITH THE NOTCHES TOWARD THE BASE OF THE POST.
 IMPORTANT—All fuse plate hinge bolts shall be tightened in the shop following a method approved by the Engineer. Tightening shall be to such a degree as to obtain the minimum residual tension in each of the bolts. Burr threads at junction with nut to prevent nut loosening.

DEPARTMENT OF HIGHWAYS
 STATE OF COLORADO
 DIVISION OF HIGHWAYS
 BREAK-AWAY SIGN
 SUPPORT DETAILS
 FOR GROUND SIGNS

Approved By: J. J. B. Staff Traffic Engineer
 Made By: F. J. B. Staff Projects Engineer
 Checked By: J. E. M. Staff Traffic Engineer
 19 80

OVERHEAD SIGNS - SHEET 1

FEDERAL ROAD DIVISION	COLORADO	I 70-3(140)	41	57
PROJ. NO.	DIVISION	SECTION NO.	SHEET NO.	TOTAL SHEETS


AS CONSTRUCTED	NO REVISIONS
VOID	REVISED

REVISIONS	DATE


GENERAL NOTES

1. All work shall be done in accordance with Standard Specifications applicable to the project and "Standard Specifications For Structural Supports For Highway Signs, Luminaires And Traffic Signals", A.S.H.T.O. current issue.
2. Wind loading 35 P.S.F. normal to panel area.
3. UNIT STRESSES:
 - a. Structural steel: $F_s = 18,000$ P.S.I.
 - b. Reinforced concrete: $F_c = 20,000$ P.S.I.
 - c. Footing soil pressure: $1\frac{1}{2}$ TONS/SQ. FT.
 - d. Allowable unit stresses due to wind load or wind load in combination with other forces are increased $33\frac{1}{3}\%$.
4. For reinforcement, embedment is clear to outside of bar and is 2" to main reinforcement, except as shown.
5. Base plates, pedestals, and footings, longer sides shall be normal to the axis of sign.
6. Backfill shall be in place prior to erection of post.
7. On single post sign structures, the post shall be roked out of plumb, with the use of the leveling nuts to make the bottom of the sign frame level.
8. Ground one post of each structure.
9. Tapered tube of equivalent size and thickness may be substituted for pipe post.
10. For SIGN BRIDGES only, a constant diameter pipe post of the base section size may be used in lieu of the two diameter sections shown.

ANCHORAGE DETAILS

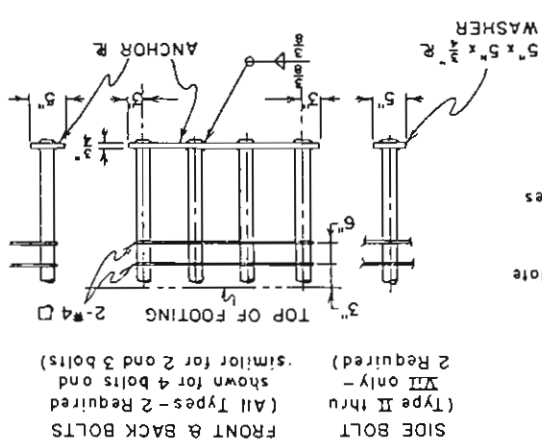


HANDHOLE DETAILS

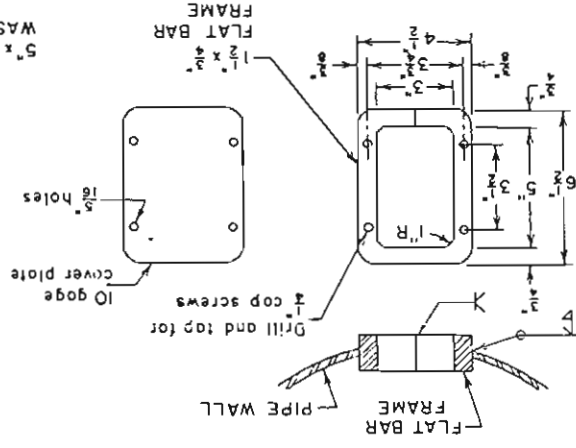


NOTE:
ANGLE IRON TRUSS BOX STRUCTURES ARE NOT PERMITTED. SEE THE PROJECT SPECIAL PROVISION REQUIRING TUBULAR DESIGN.


TYPICAL VIEWS

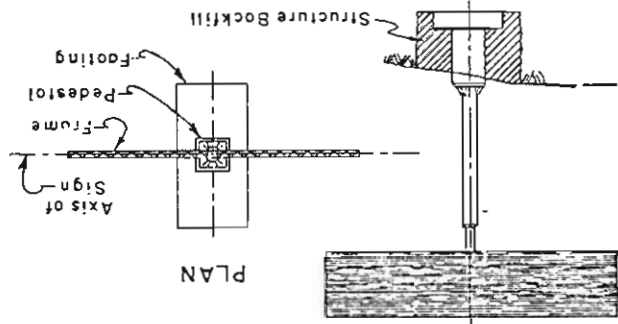

SECTION A-A

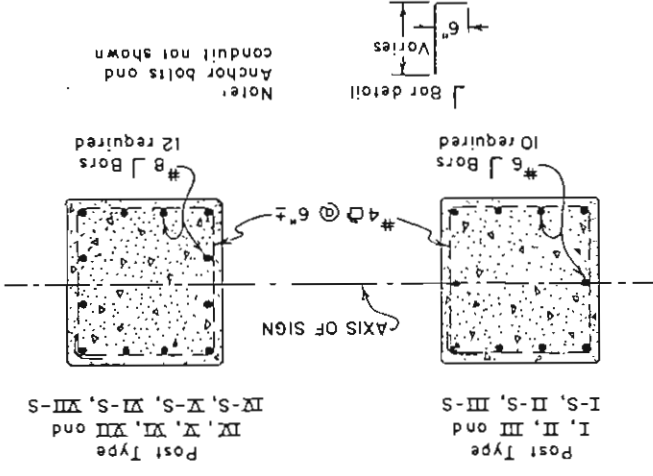

ELEVATION

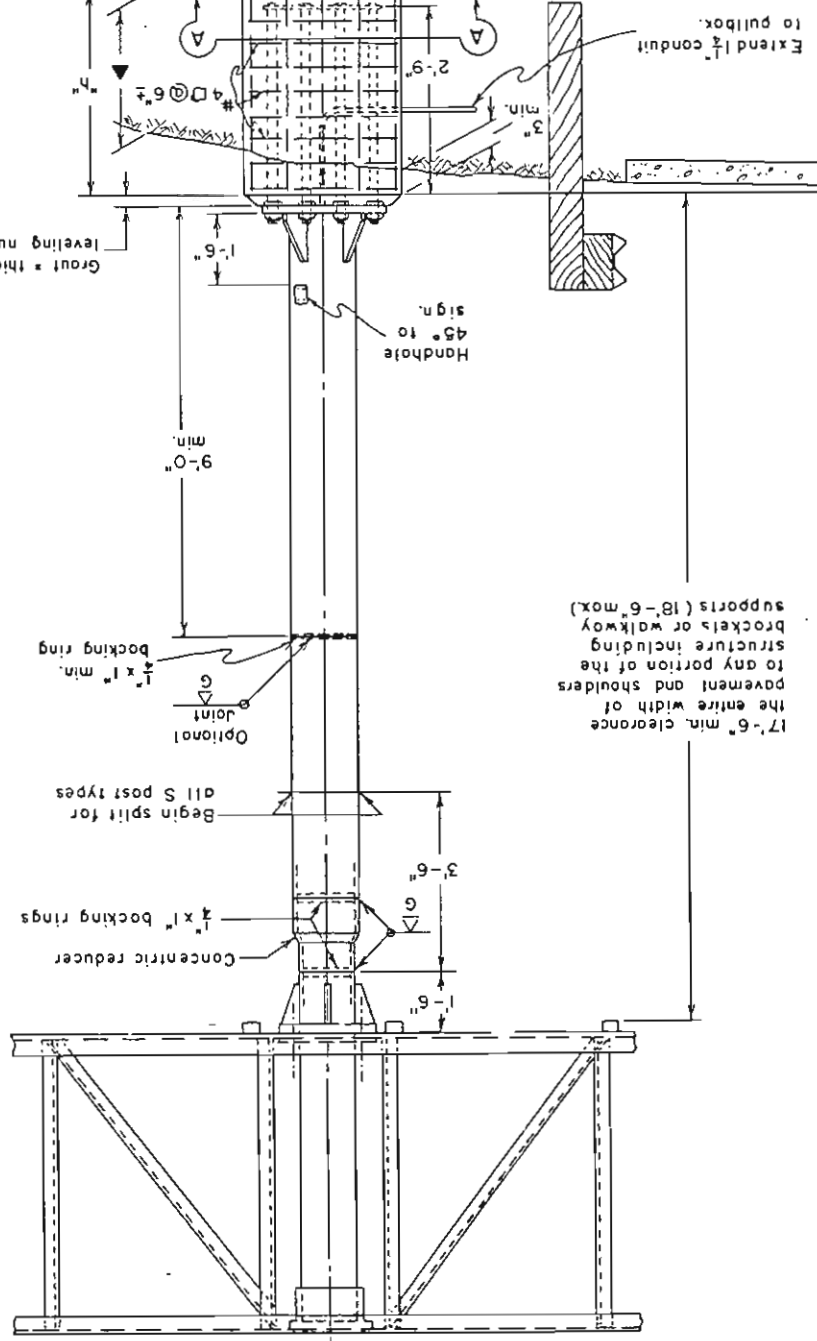

SIGN NO.	STRUCTURE TYPE	POST TYPE	PEDESTAL HEIGHT "h"	
			ONE POST	TWO POSTS
2	CANTILEVER	VI	5'-6" EXISTING	RI.
5	CANTILEVER	VI	12'-0" EXISTING	RI.
27	CANTILEVER	VI	4'-6" EXISTING	RI.
31	CANTILEVER	VI	6'-6"	RI.
46	SIGN BRIDGE	II-S	7'-0" A 7'-0"	RI.
51	SIGN BRIDGE	II-S	6'-6" A 7'-0"	RI.

* ONLY POSTS, FRAME AND SIGN PANEL ARE REQUIRED, FOOTINGS ARE FROM PREVIOUS PROJECT.

▲ POST LENGTH TO BE REDUCED 2'-8" (THE NORMAL CONCRETE MEDIAN BARRIER HEIGHT TO WHICH THE PEDESTAL IS TO BE BUILT).

DEPARTMENT OF HIGHWAYS
STATE OF COLORADO
DIVISION OF HIGHWAYS
OVERHEAD SIGNS
POSTS &
FOOTINGS (SPREAD)

OVERHEAD SIGNS - SHEET 2

FEDERAL ROAD DISTRICT	XIII	COLOMADO	I 70-3 (140)	PROJ. NO.	42	SHEET NO.	57	TOTAL SHEETS
-----------------------	------	----------	--------------	-----------	----	-----------	----	--------------


AS CONSTRUCTED	NO REVISIONS	12/12/11	REVISIED	VOID
----------------	--------------	----------	----------	------

REVISIONS				

POSTS TYPES I - VII & BASE PLATES

SECTION A-A
COMMON TO ALL TYPES

POSTS TYPES I-S - VII-S & BASE PLATES


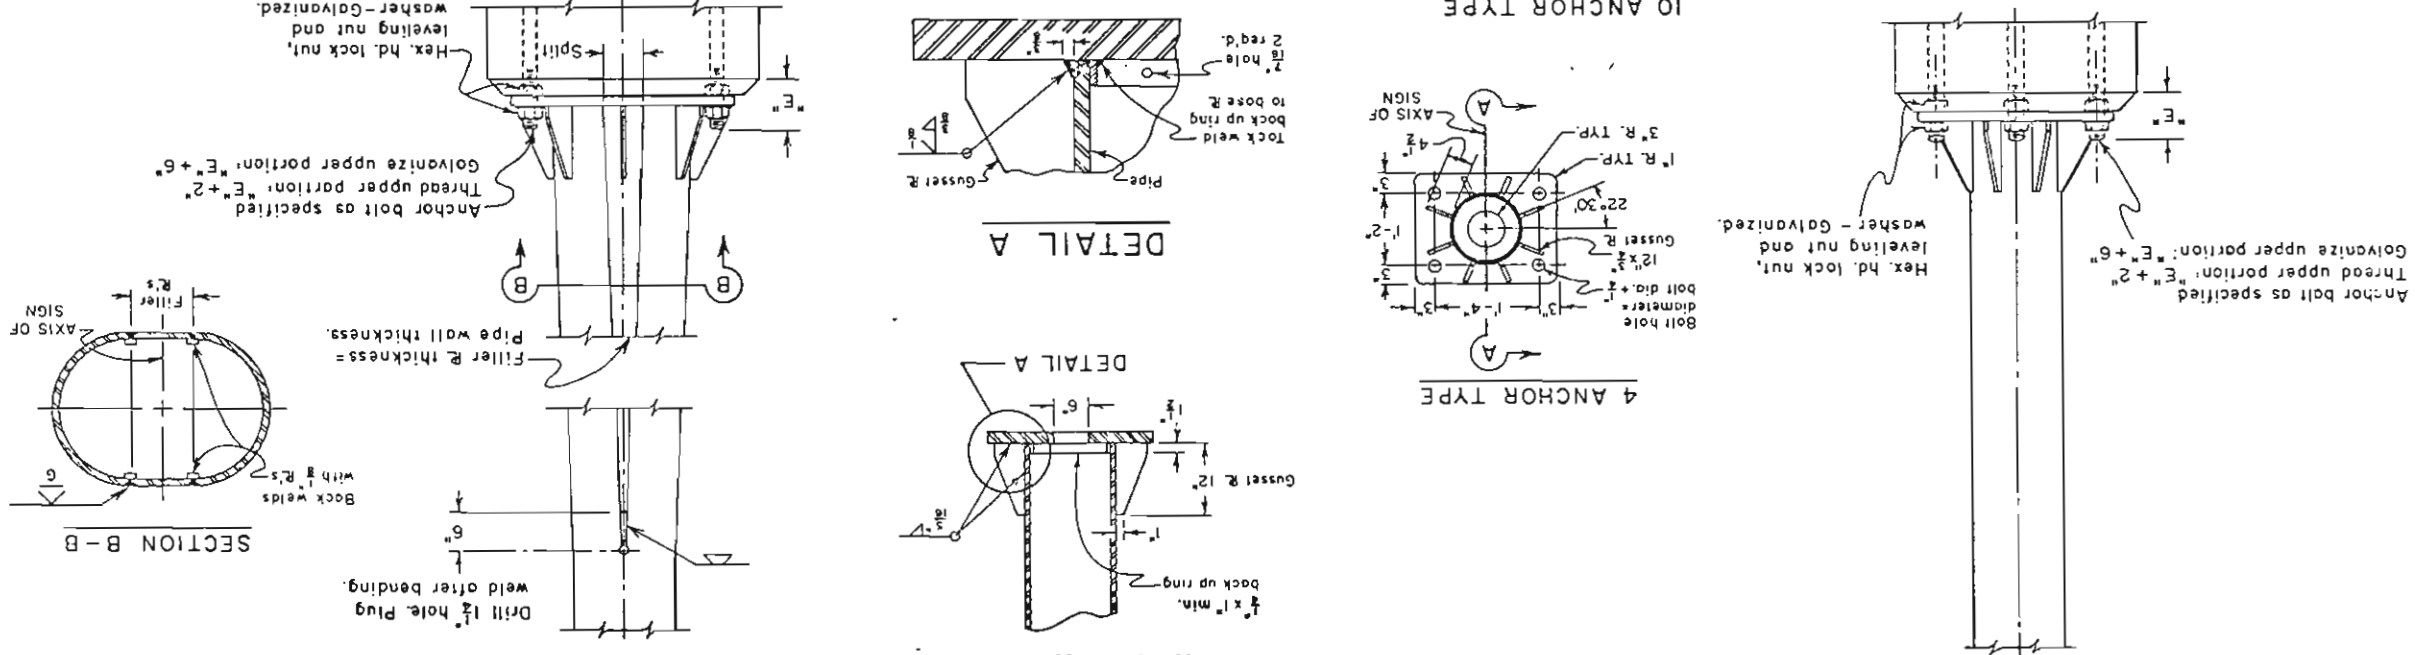


TYPES I THRU VII DATA TABLE

POST TYPE	PIPE SIZES			REDUCER "E"	BASE PLATE SIZE	ANCHOR BOLTS	FOOTING SIZE	LONGITUDINAL REINFORCEMENT
	BASE SECTION	UPPER SECTION	PIPE SIZES					
I	10" Sid @ 8 Sid @	8" Sid @	2'-5" x 2'-3"	7"	8"	7"	5'-0" x 9'-0"	6 # 4 bars
II	12" Sid @ 9.56	10" Sid @ 34.24	2'-4" x 2'-1" x 1 1/2"	7 1/2"	8"	7 1/2"	6'-0" x 10'-0"	6 # 4 bars
III	14" O.D. @ 72.09	12" Sid @ 43.77	2'-7" x 2'-3" x 1 1/2"	8 1/2"	1'-1"	1'-1"	7'-0" x 12'-0"	6 # 5 bars
IV	16" O.D. @ 82.77	14" O.D. @ 54.57	3'-1" x 2'-9" x 2"	8 1/2"	1'-2"	1'-2"	7'-0" x 13'-0"	6 # 5 bars
V	18" O.D. @ 93.45	16" O.D. @ 62.58	3'-3" x 3'-0" x 2 1/2"	8 1/2"	1'-3"	1'-3"	8'-0" x 14'-0"	7 # 5 bars
VI	20" O.D. @ 104.13	18" O.D. @ 70.59	3'-3" x 3'-0" x 2"	8 1/2"	1'-8"	1'-8"	9'-0" x 15'-0"	6 # 7 bars
VII	24" O.D. @ 125.49	20" O.D. @ 78.60	3'-7" x 3'-3" x 2 1/2"	10"	1'-8"	1'-8"	10'-0" x 17'-0"	7 # 8 bars

TYPES I-S THRU VII-S DATA TABLE

POST TYPE	PIPE SIZES			REDUCER LENGTH	SPLIT "E"	BASE PLATE SIZE	ANCHOR BOLTS	PEDESTAL SIZE	FOOTING SIZE	LONGITUDINAL REINFORCEMENT
	BASE SECTION	UPPER SECTION	PIPE SIZES							
I-S	10" Sid @ 40.48	8" Sid @ 28.55	2'-1" x 1'-9" x 1 1/2"	6 1/2"	4"	7"	6 1/2"	2'-7" x 2'-3"	5'-0" x 10'-0"	5 # 4 bars
II-S	12" Sid @ 49.56	10" Sid @ 34.24	2'-5" x 1'-11" x 1 1/2"	6 - 1 1/2"	5"	7 1/2"	7 1/2"	3'-0" x 2'-6"	6'-0" x 11'-0"	6 # 4 bars
III-S	14" O.D. @ 72.09	12" Sid @ 43.77	2'-9" x 2'-0" x 2"	6 - 2"	5"	8 1/2"	8 1/2"	3'-4" x 2'-7"	7'-0" x 13'-0"	7 # 8 bars
IV-S	16" O.D. @ 82.77	14" O.D. @ 54.57	2'-11" x 2'-7" x 2"	6 - 2"	6"	8 1/2"	8 1/2"	3'-6" x 3'-2"	8'-0" x 14'-0"	8 # 9 bars
V-S	18" O.D. @ 93.45	16" O.D. @ 62.58	3'-1" x 2'-9" x 2"	6 - 2"	7"	8 1/2"	8 1/2"	3'-8" x 3'-4"	8'-0" x 16'-0"	8 # 9 bars
VI-S	20" O.D. @ 104.13	18" O.D. @ 70.59	3'-5" x 2'-9" x 2"	6 - 2"	8"	8 1/2"	8 1/2"	4'-0" x 3'-4"	9'-0" x 17'-0"	9 # 10 bars
VII-S	24" O.D. @ 125.49	20" O.D. @ 78.60	3'-9" x 3'-3" x 2"	8 - 2 1/2"	8"	9 1/2"	9 1/2"	4'-5" x 3'-11"	10'-0" x 18'-0"	10 # 11 bars

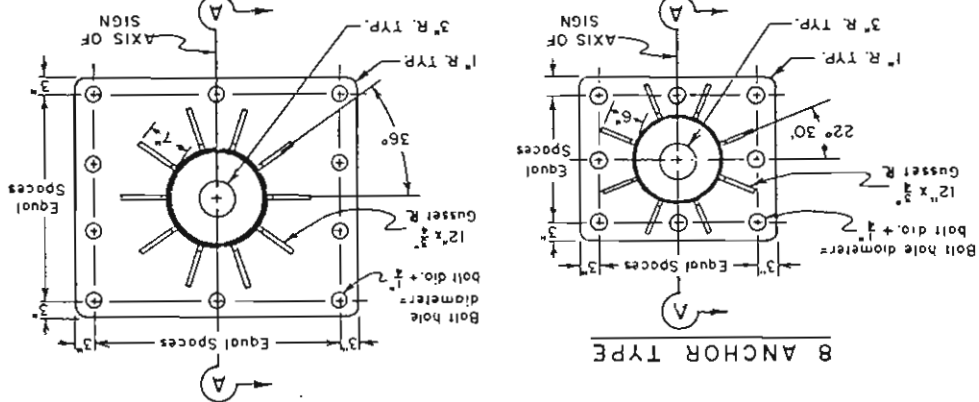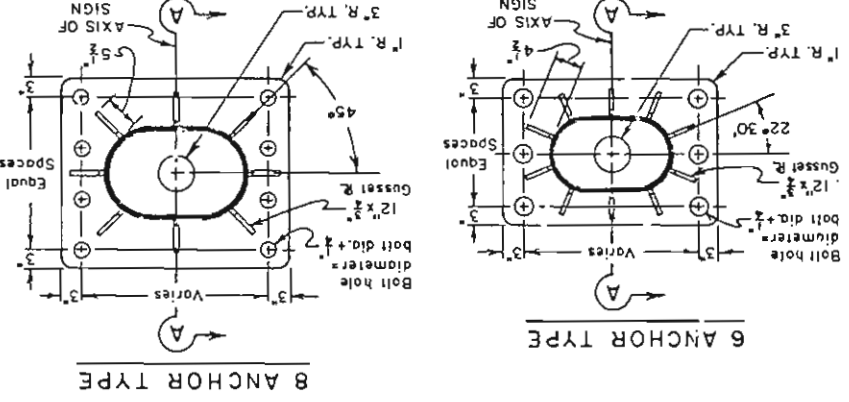

DEPARTMENT OF HIGHWAYS
STATE OF COLORADO
DIVISION OF HIGHWAYS
OVERHEAD SIGNS
POSTS &
FOOTINGS (SPREAD)


OVERHEAD SIGNS - SHEET 3

FEDERAL ROAD DISTRICT NO.	DIVISION	PROJ. NO.	SHEET NO.	TOTAL SHEETS
XIII	COLORADO	I 70-3(140)	43	57

REVISIONS	

NO REVISION	REVISED	VOID
AS CONSTRUCTED		

NOTE:
ANGLE IRON TRUSS BOX STRUCTURES ARE NOT PERMITTED. SEE THE PROJECT SPECIAL PROVISION REQUIRING TUBULAR DESIGN.

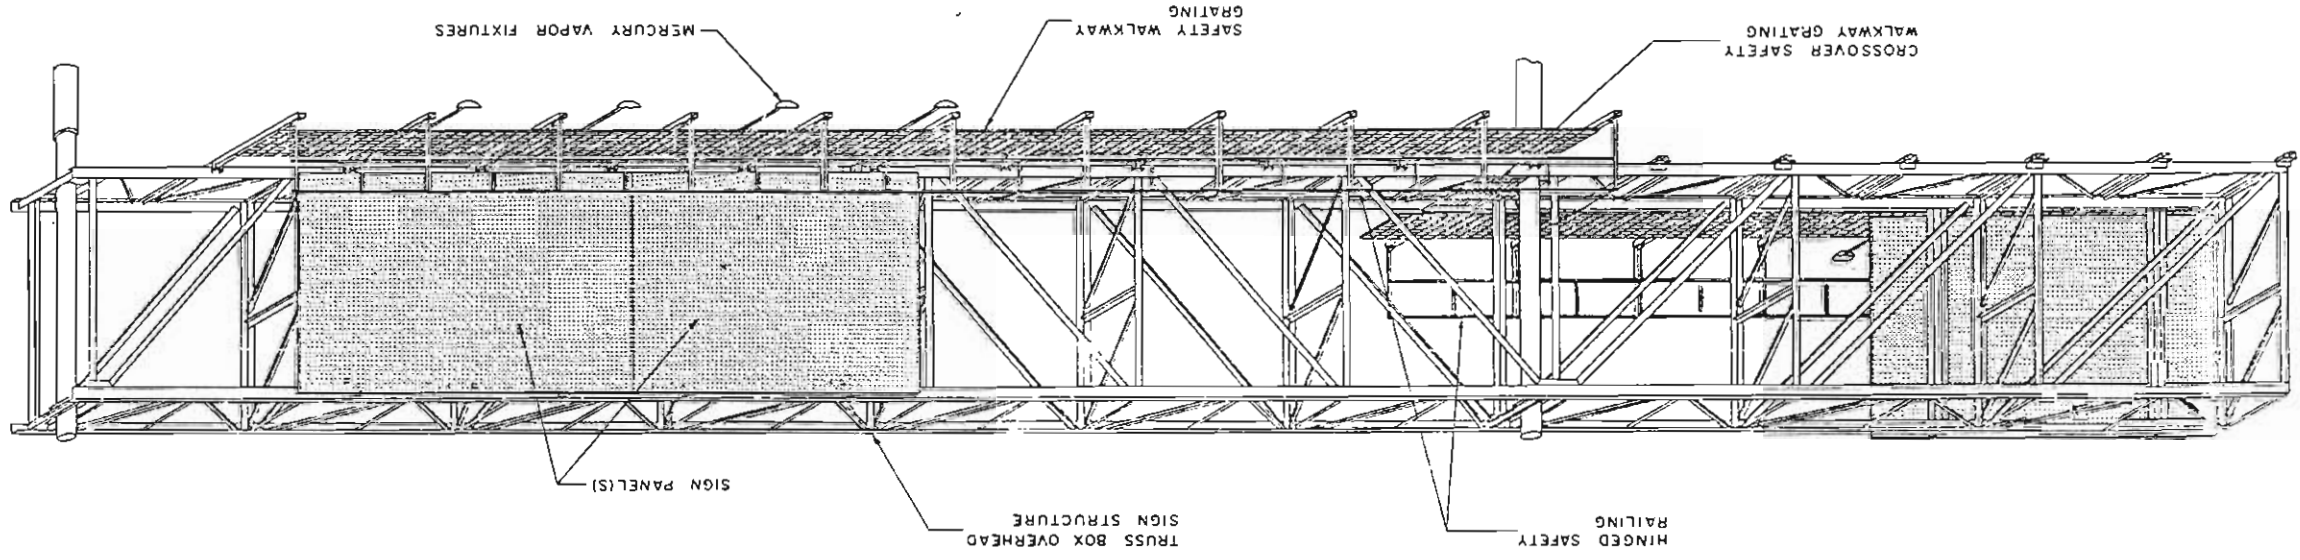








TYPICAL VIEW OF ASSEMBLED MEMBERS
TYPICAL CANTILEVER SIGN STRUCTURE SHOWN

1. All work shall be done in accordance with:
 - (a) the Standard Specifications applicable to the project.
 - (b) the "Manual on Uniform Traffic Control Devices for Streets and Highways" published by the Federal Highway Administration, and the latest revision of the Colorado Supplement thereto.
 - (c) AASHTO specifications for the design and construction of Structural Supports for Highway Signs.
2. Safety walkway grating shall be welded-type with 1/4" x 1/2" bearing bars at 1 3/16" centers and 3/16" dia. (or equal) crossbars at 4" centers.
3. Brackets to be evenly spaced with a maximum center to center spacing of 5'-6".
4. Bolts, nuts, washers, etc. shall be galvanized or cadmium plated.
5. Walkway grating, brackets and railing shall be painted in accordance with Section 509, wiring shall be in accordance with Section 613.
6. Crossover safety walkway to be used when sign bridges have sign panels facing two directions.

- LIGHTING NOTES
1. Fixtures shall be watertight, dustproof and designed for ease of lamp replacement.
 2. Lamp shall be of the Mercury Vapor type (400 Watt). Lamps and ballasts shall be designed to operate over an ambient temperature range of -25° F. to +120° F.
 3. Ballasts shall operate from a 120 volt, 60 hz, single phase source with a regulated output of ±12%. Ballasts shall be housed in a watertight dustproof enclosure.
 4. The type, number and spacing of fixtures shall be per manufacturers specifications to maintain a maximum initial illumination of the sign face of 30 foot candles to 60 foot candles with a maximum uniformity ratio (maximum illumination/minimum illumination) of 5:1.
 5. Fixture and mounting details will be subject to approval by the Engineer.

DEPARTMENT OF HIGHWAYS
STATE OF COLORADO
DIVISION OF HIGHWAYS
LIGHT FIXTURE
AND
SAFETY WALKWAY
DETAILS

DEPARTMENT OF HIGHWAYS
 STATE OF COLORADO
 DIVISION OF HIGHWAYS
 LIGHT FIXTURE
 AND
 SAFETY WALKWAY
 DETAILS

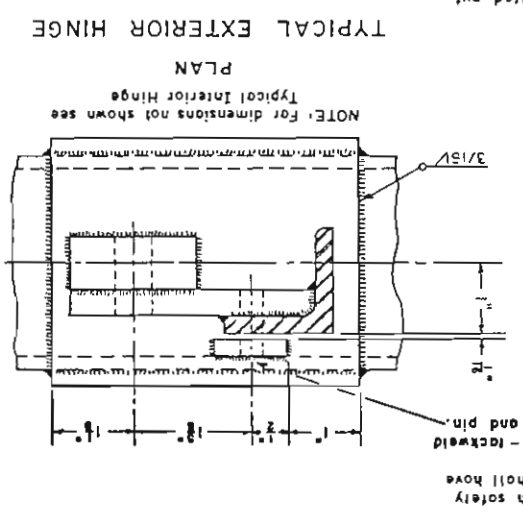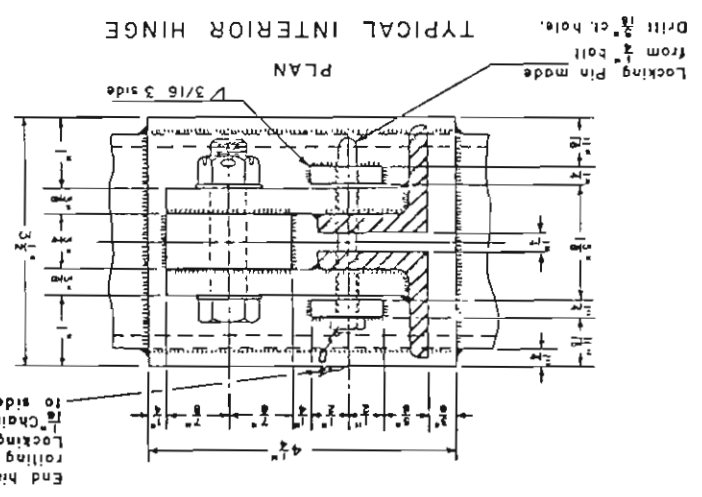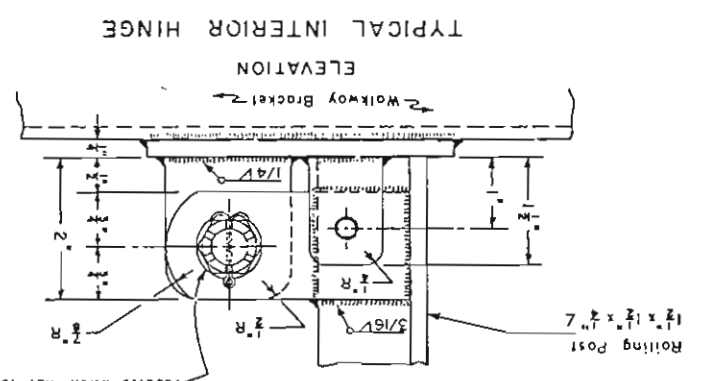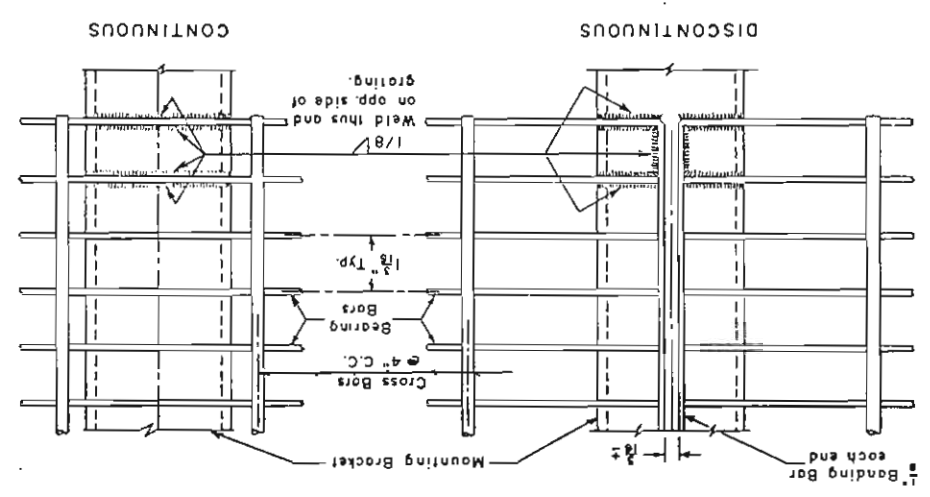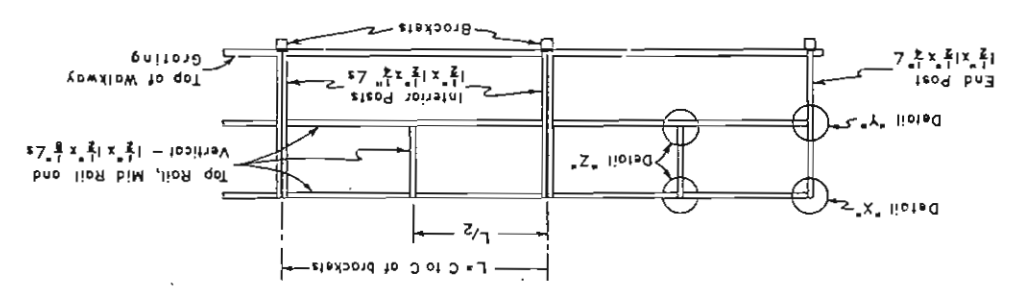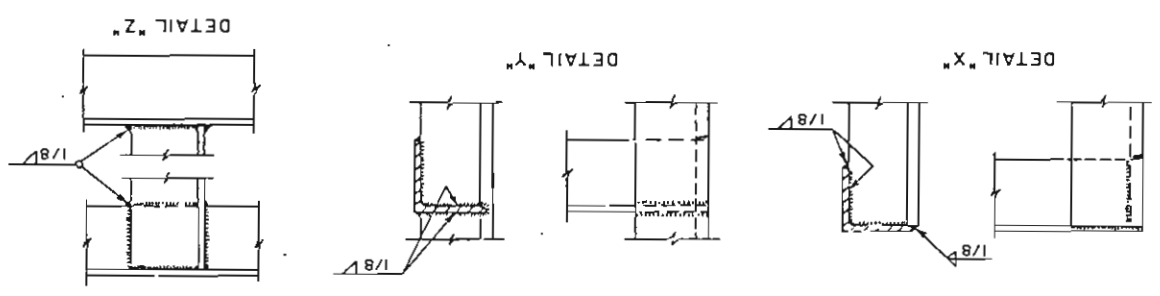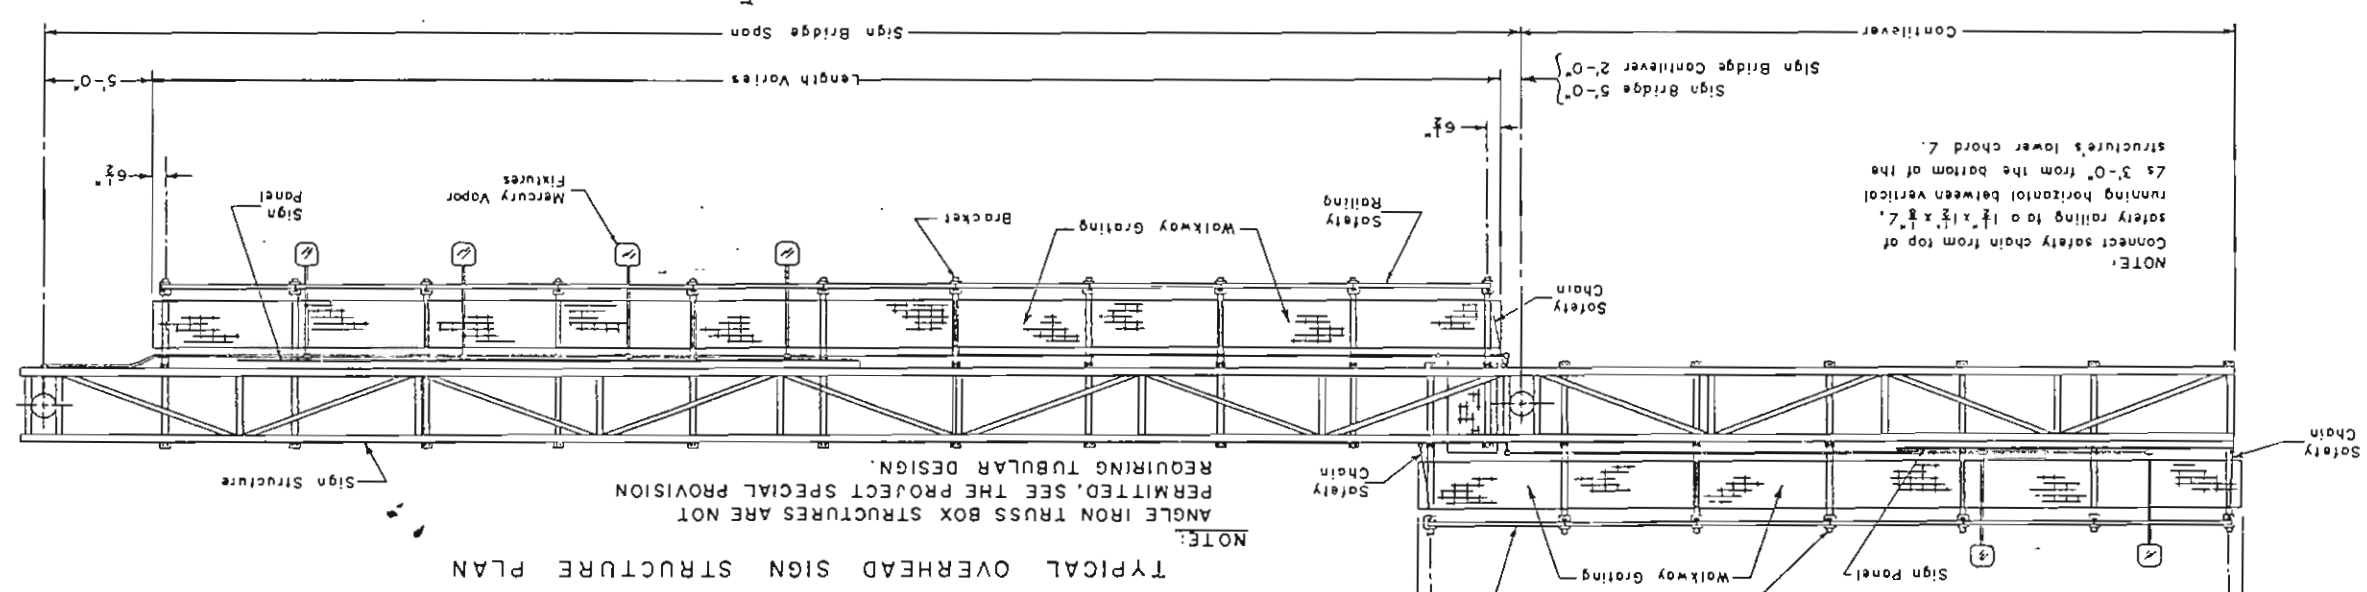

OVERHEAD SIGNS - SHEET 5

PLURAL ROAD	DIVISION	PROJ. NO.	SHEET	TOTAL
XIII	COLORADO	I 70-3(140)	45	57
NO REVISION 12-2-22 REVISED VOID				
AS CONSTRUCTED				
REVISIONS				




CROSS SECTIONS AT CLASS III & OVERHEAD SIGN LOCATIONS

AS CONSTRUCTED	REVISIONS	NO REVISIONS
	REVISID 2-12-83	VOID

170-3(140)

46

57

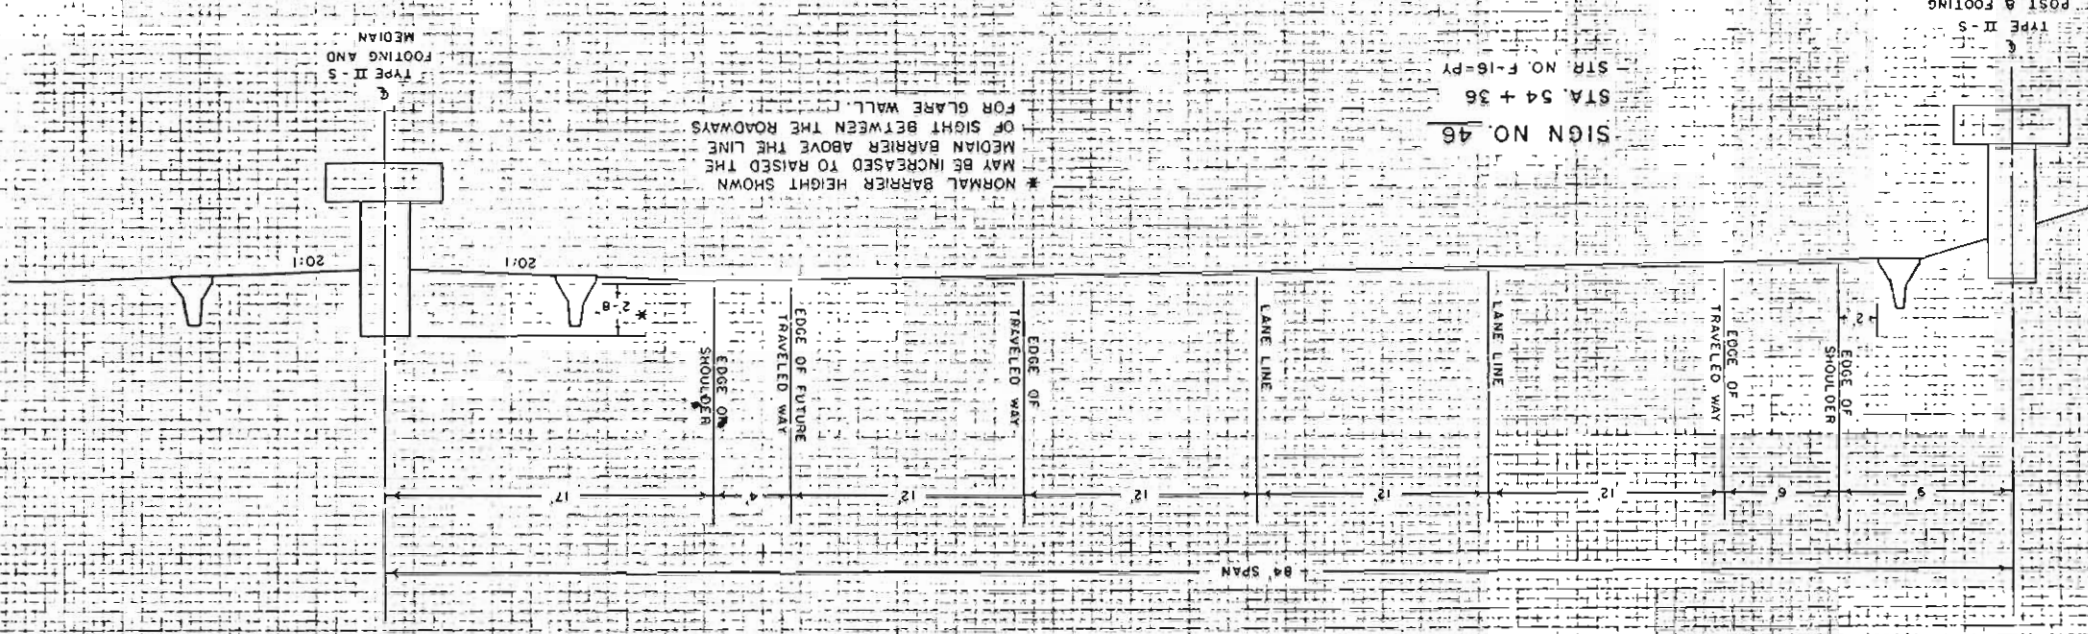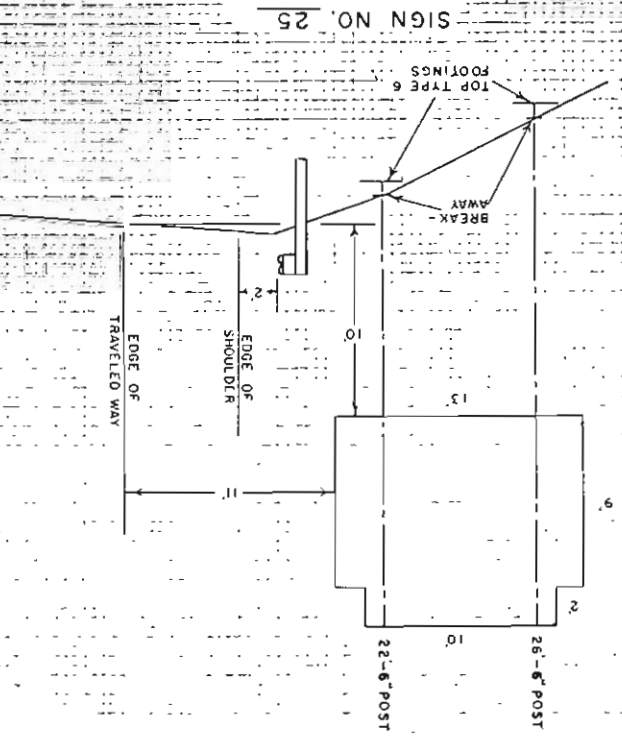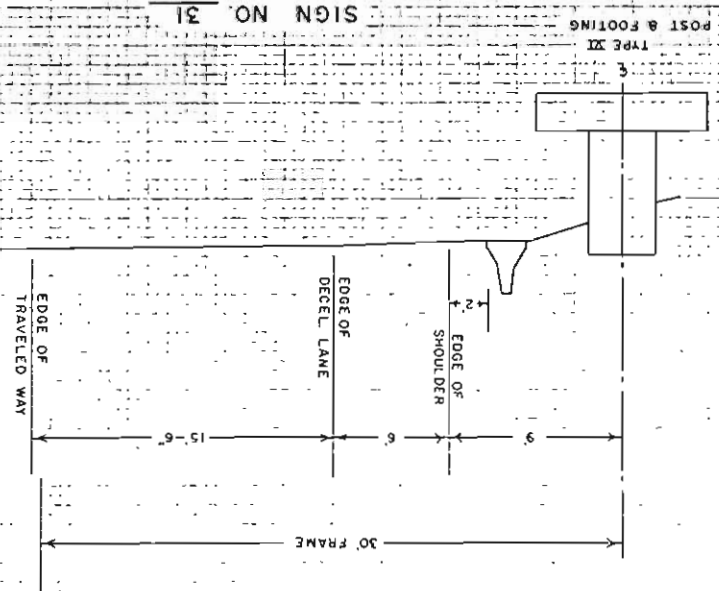

AS CONSTRUCTED


CROSS SECTIONS AT OVERHEAD SIGN LOCATIONS

AS CONSTRUCTED	REVISIED	12-12-88	NO REVISIONS

170-3(140)

47

57

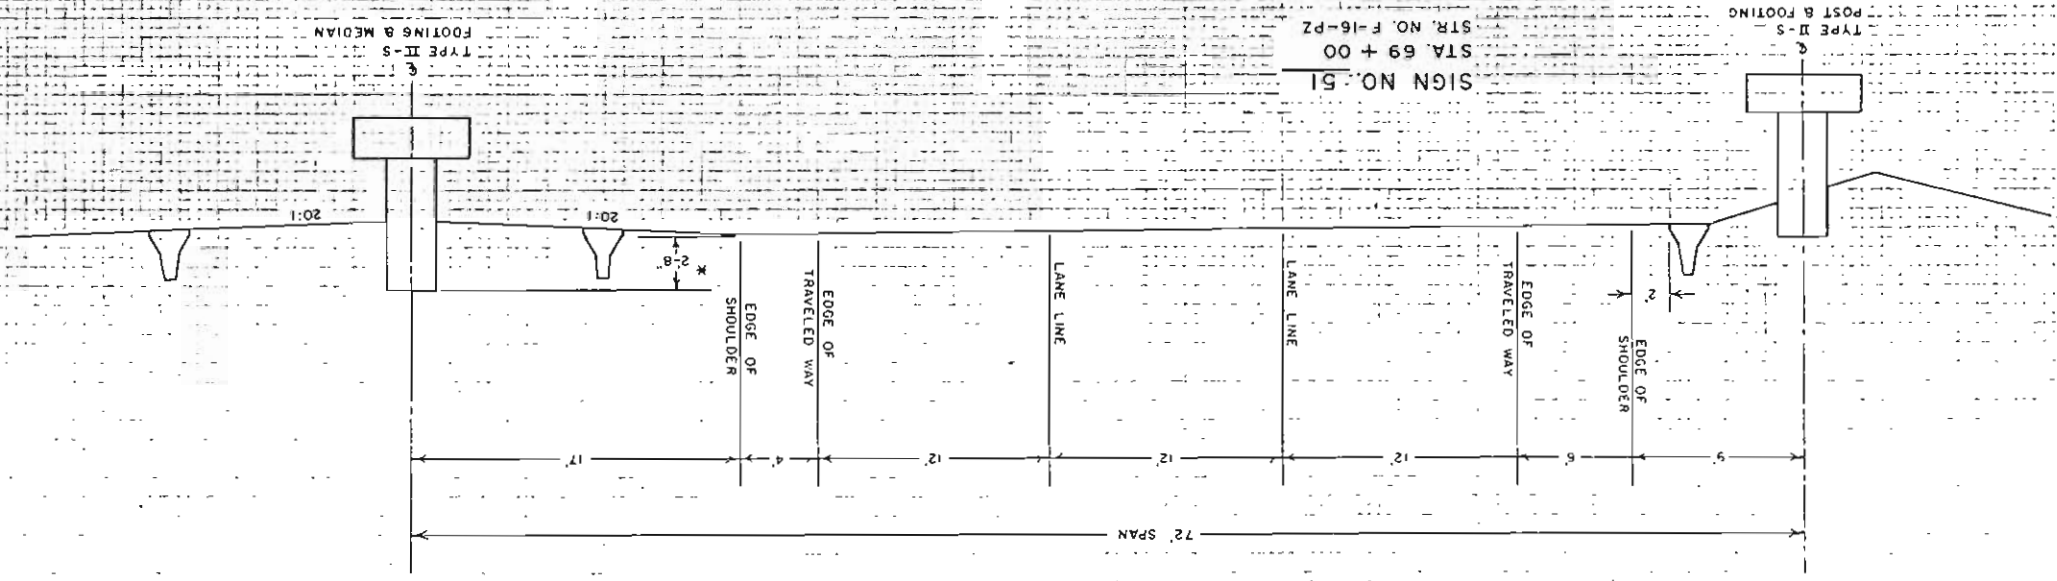


SIGN NO. 51

STA. 69 + 00

STR. NO. F-16-P2

TYPE II-S
FOOTING

POST B

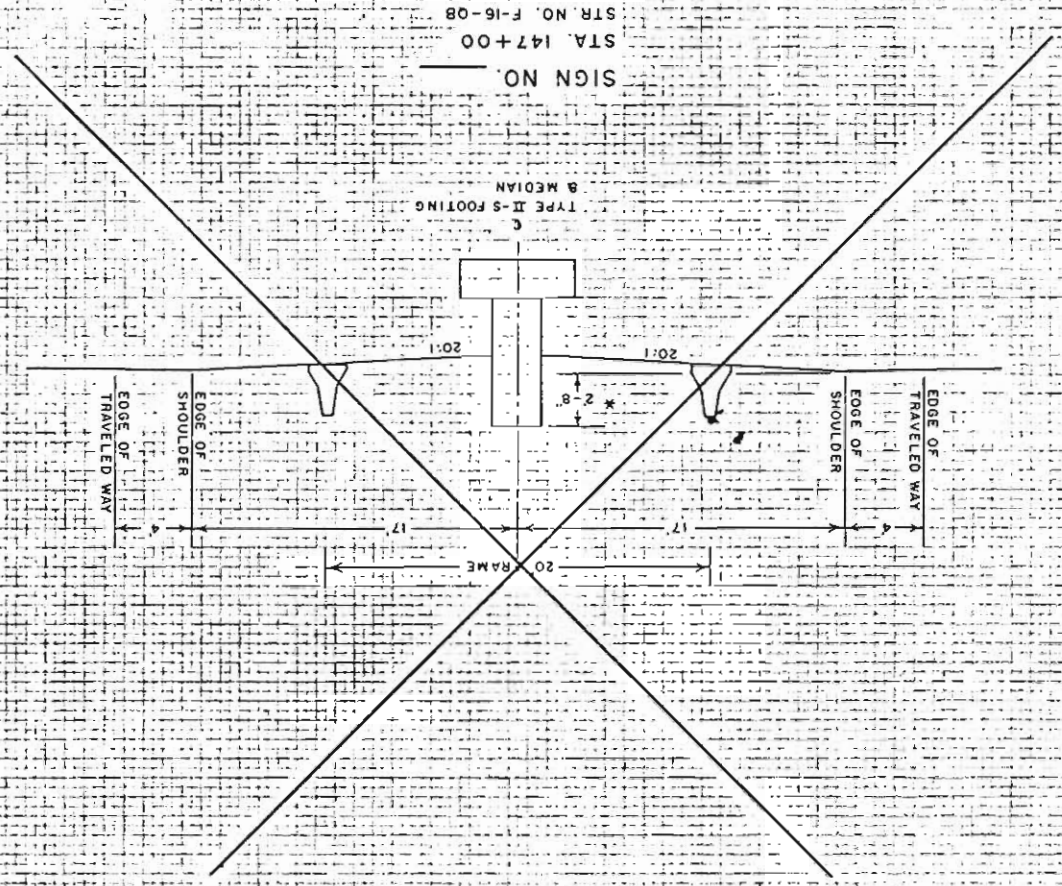


SIGN NO. 147+00

STA. 147+00

STR. NO. F-16-08

TYPE II-S FOOTING
& MEDIAN

* NORMAL BARRIER HEIGHT SHOWN
MAY BE INCREASED TO RAISED THE
MEDIAN BARRIER ABOVE THE LINE
OF SIGHT BETWEEN THE ROADWAYS
FOR GLARE WALL.

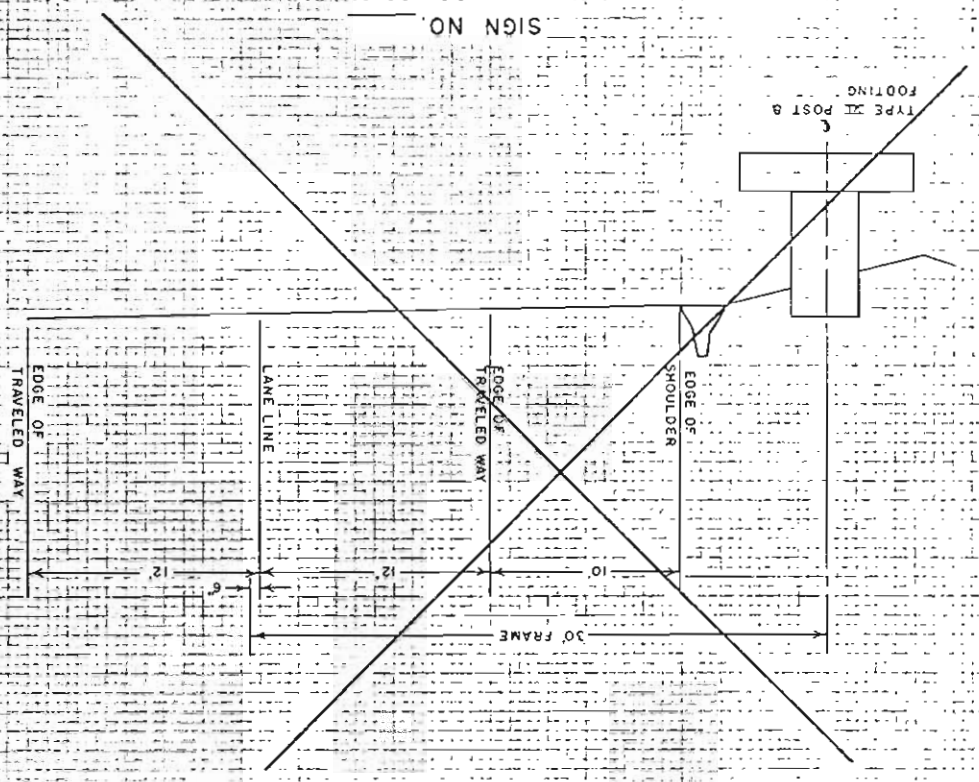

SIGN NO. 100+50

STA. 100+50





STR. F-16-0A

TYPE II-S
FOOTING


POST B

TOTAL SHEETS		57	
SHEET NO.		48	
PROJ. NO.		I 70-3(140)	
DIVISION		COLORADO	
REGION NO.		VIII	
AS CONSTRUCTED			
NO REVISIONS 12-2-23 REVISED			
VOID			


I-70 AT US. 40, S.H. 26 INTERCHANGE (EXIT 259)

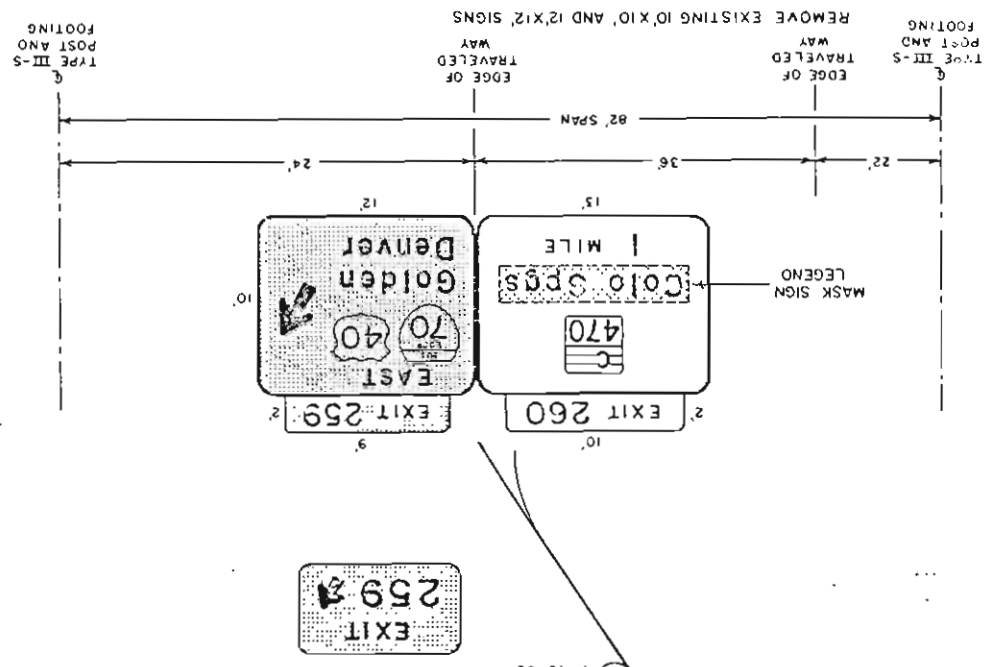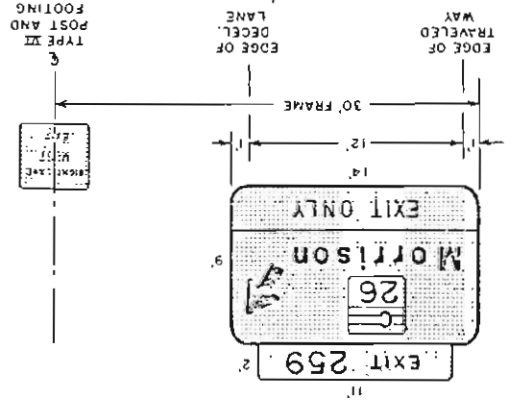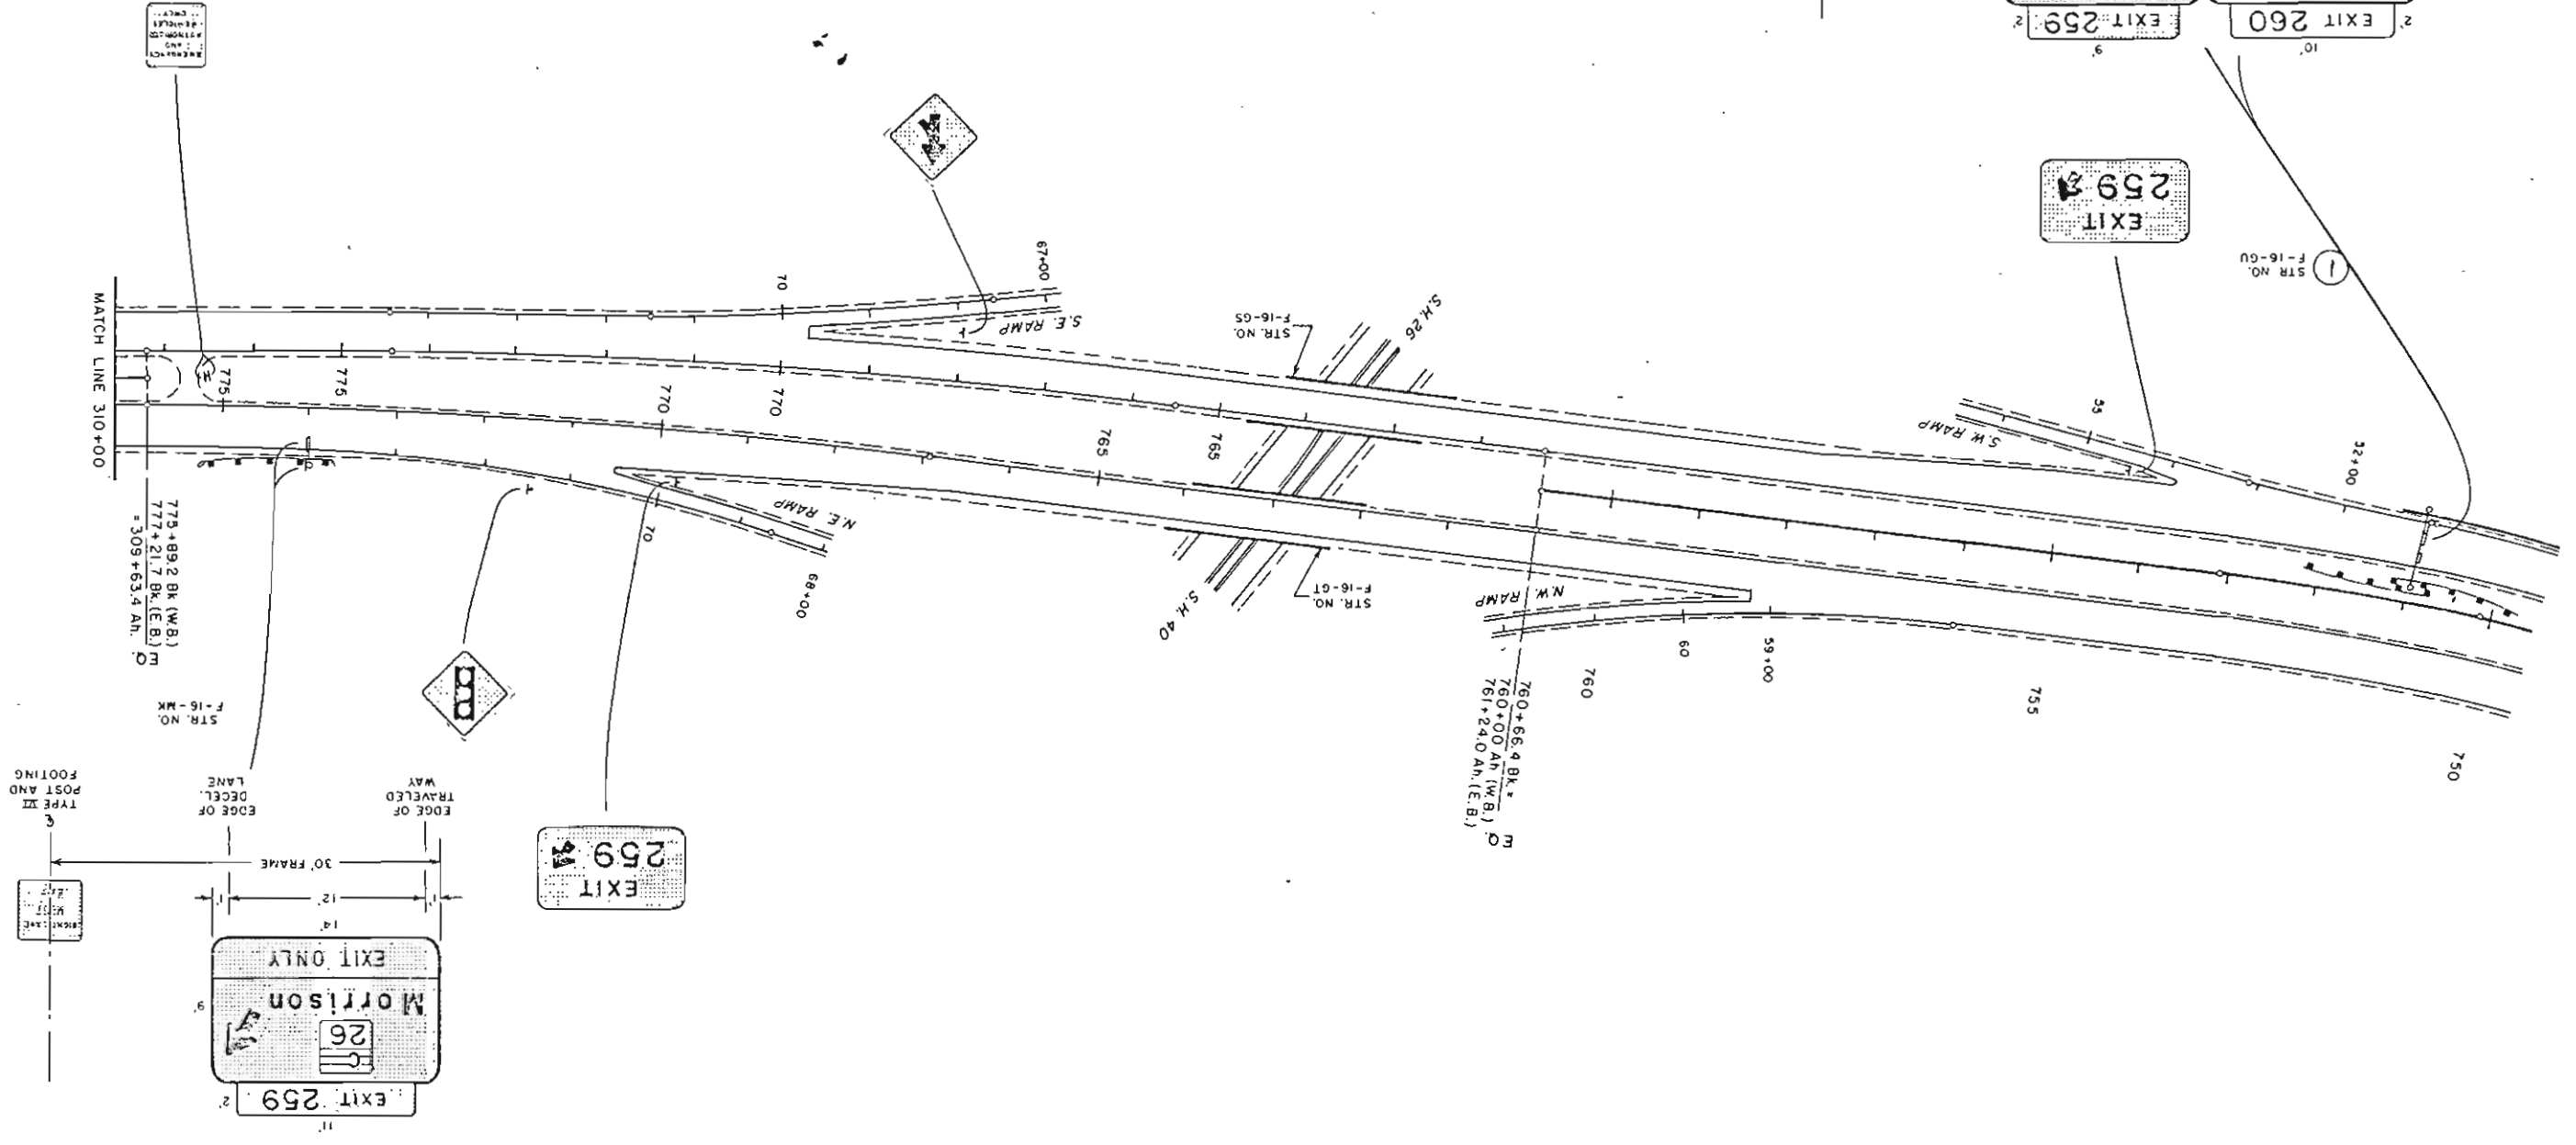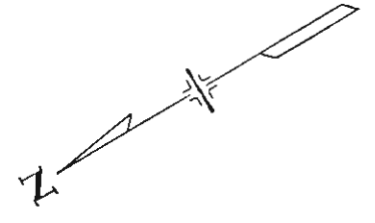


SIGNS MARKED [stippled box] ARE TO REMAIN IN PLACE.

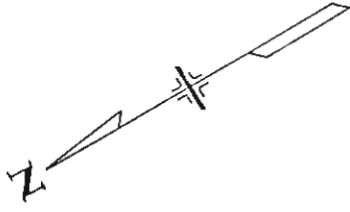


NO REVISIONS		AS CONSTRUCTED		FEDERAL ROAD DIVISION	
57	49	I 70-3(140)	COLORADO	VIII	PROJ. NO.
TOTAL SHEETS		SHEET NO.		SHEET NO.	
57		49		I 70-3(140)	

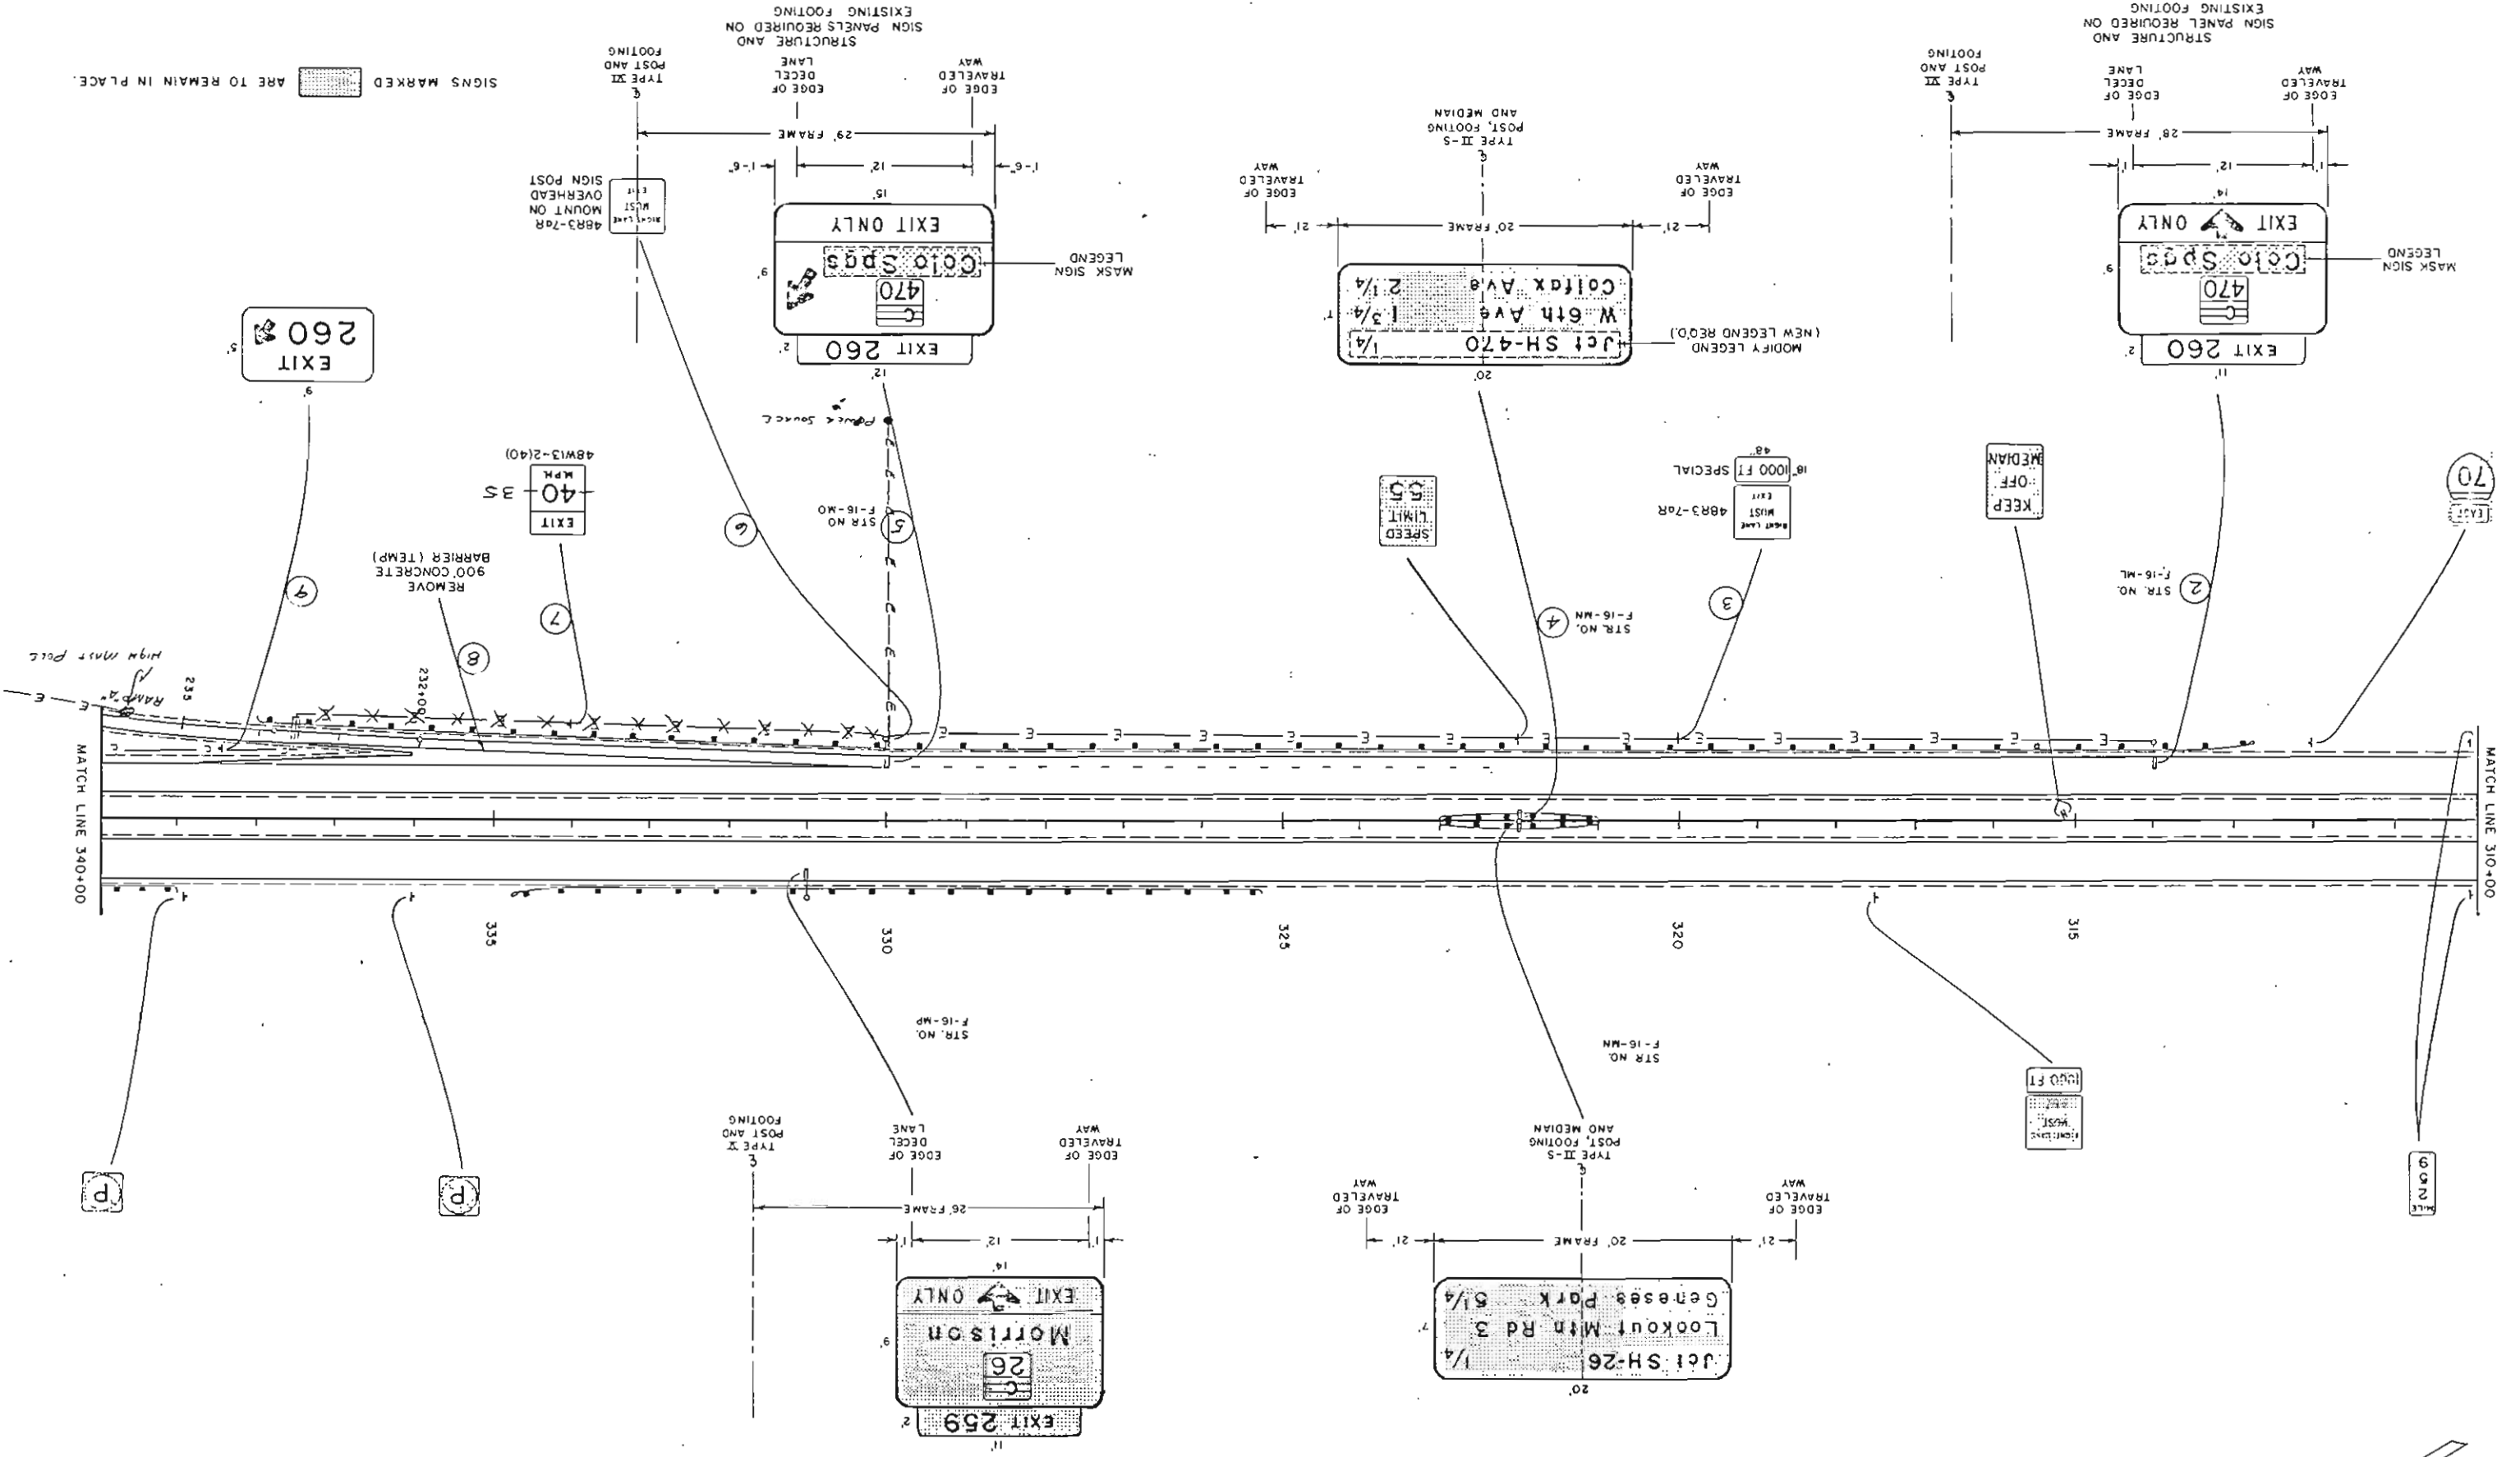








SIGNS MARKED ARE TO REMAIN IN PLACE.

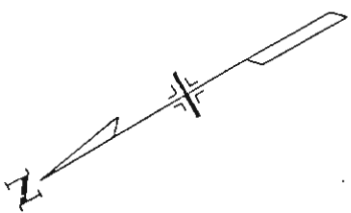


SIGNS MARKED ARE TO REMAIN IN PLACE.


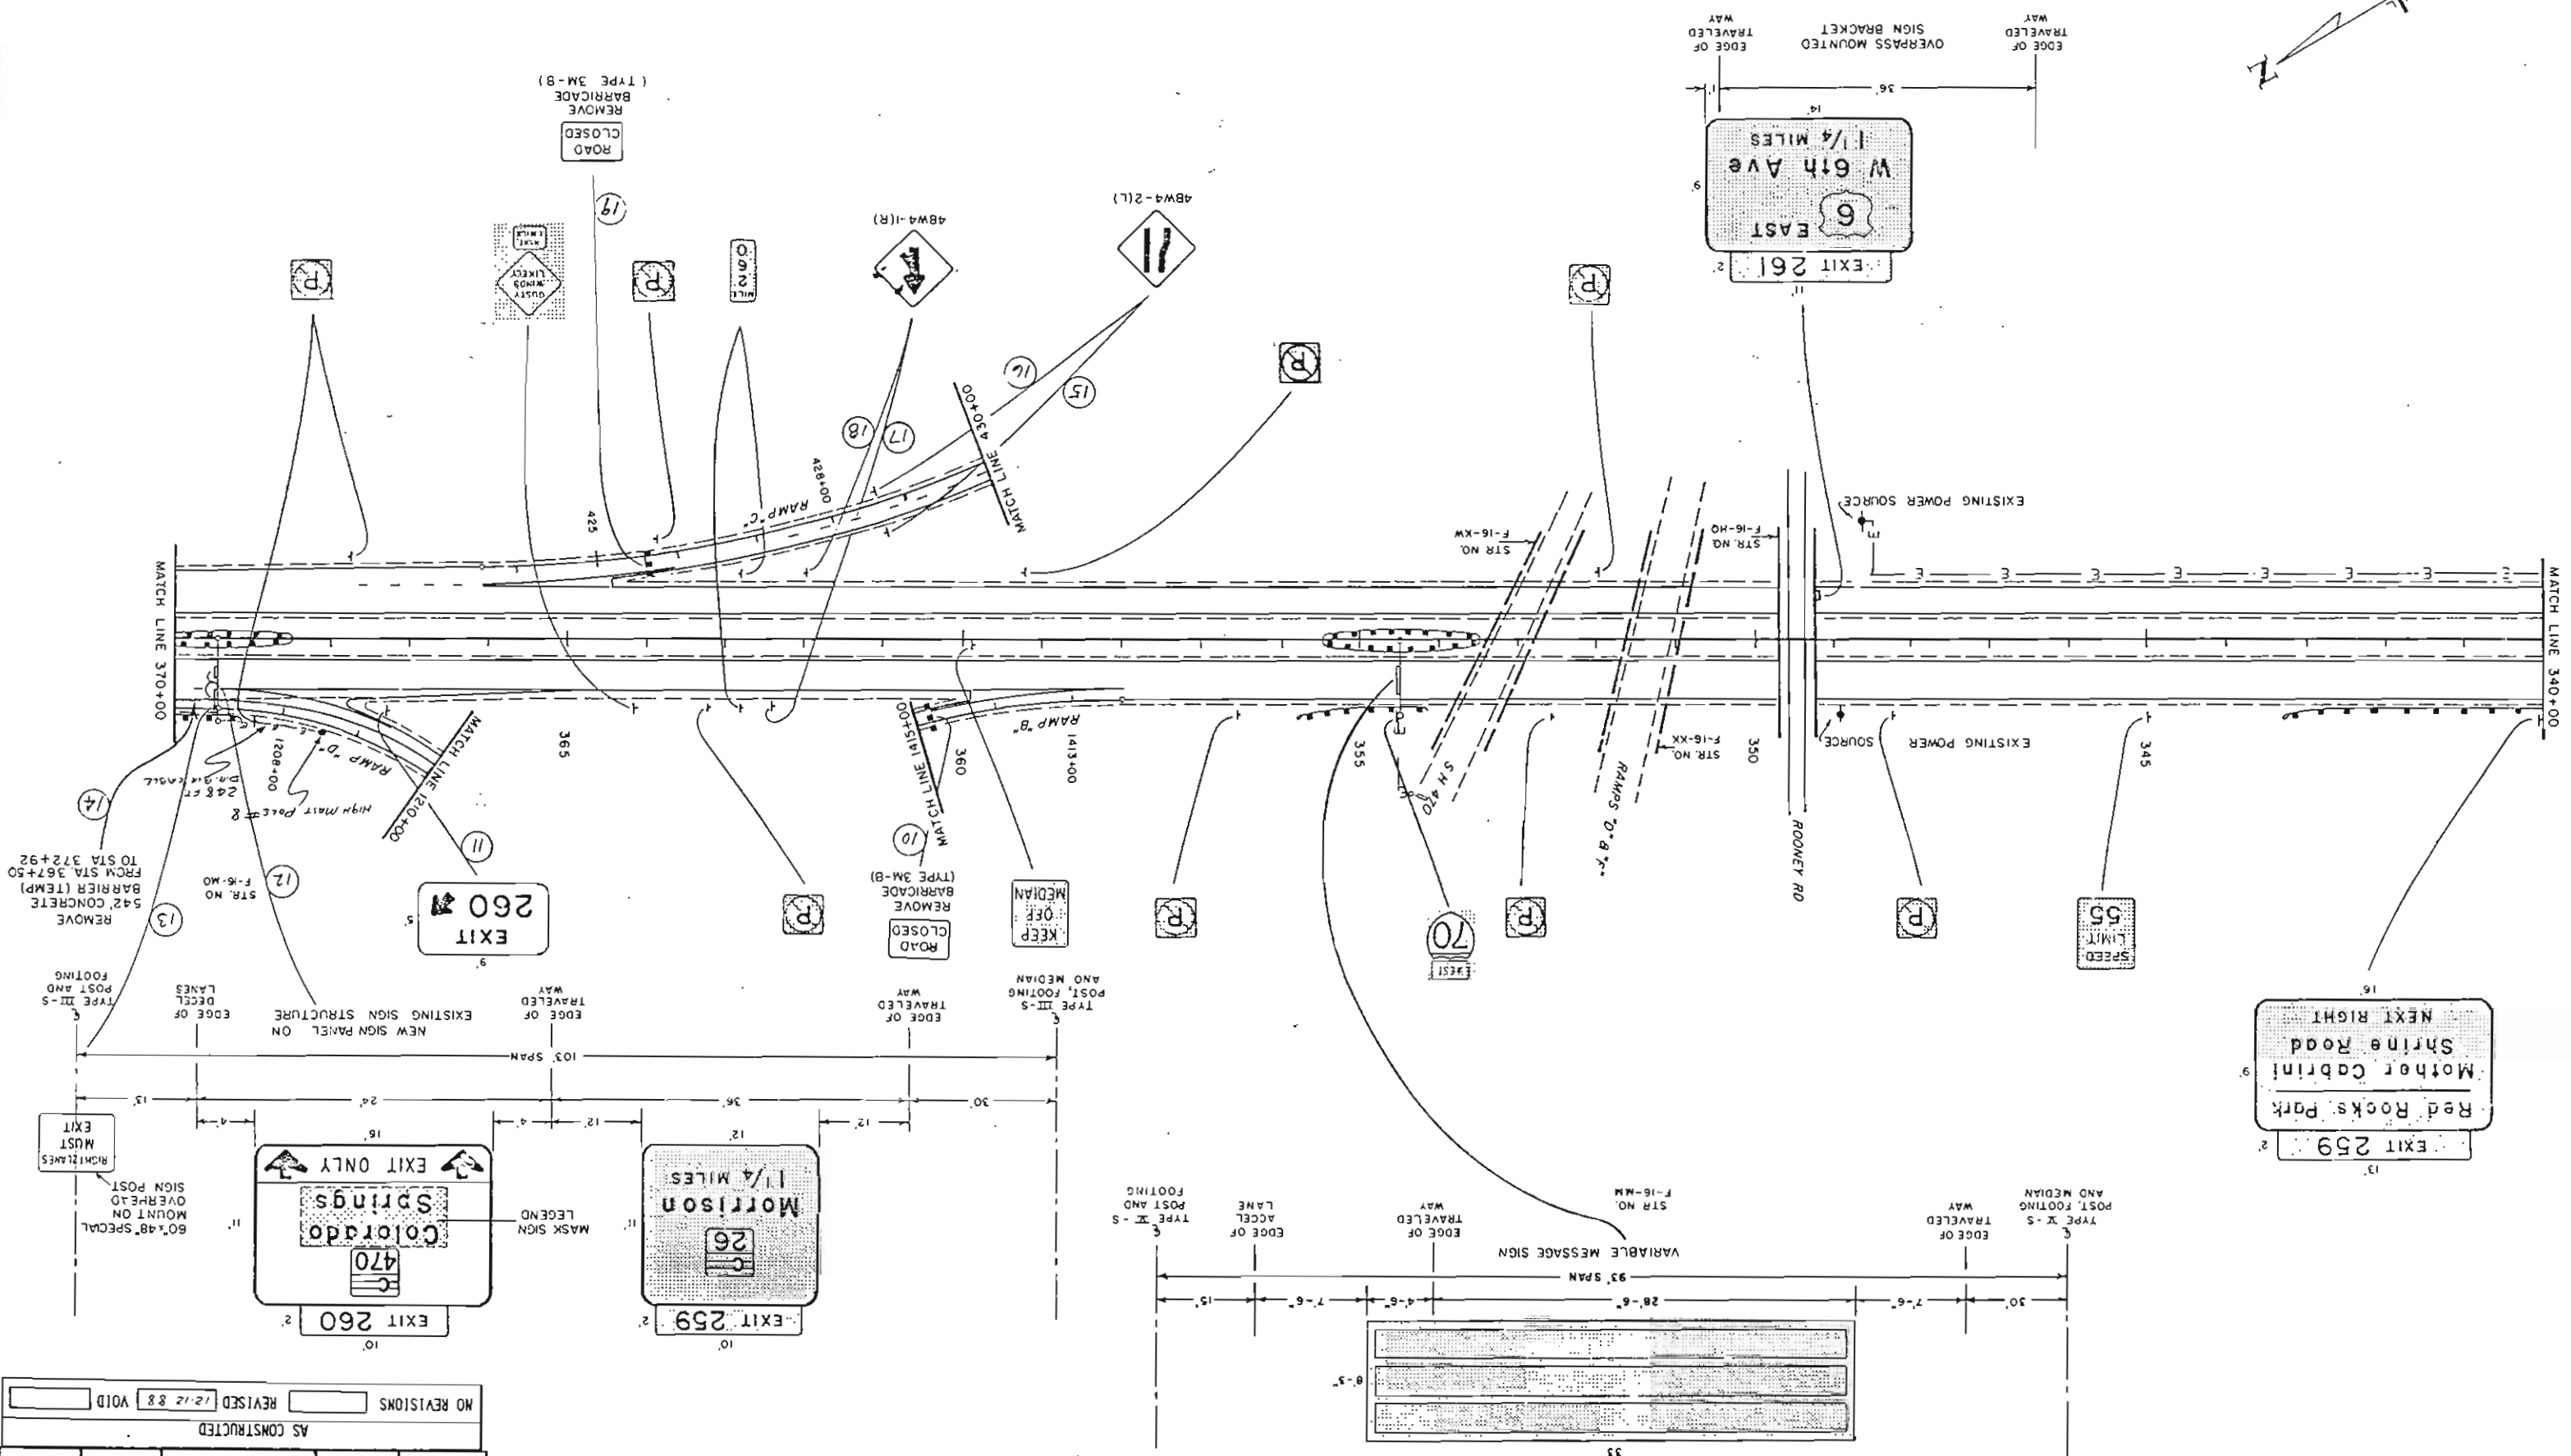


NO REVISIONS				REVISIED 12-12 88		VOID	
AS CONSTRUCTED							
VIII	COLORADO	I 70-3(140)	50	57			
FEDERAL ROAD DISTRICT NO.	DIVISION	PROJ. NO.	SHEET NO.	TOTAL SHEETS			

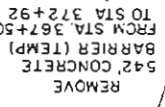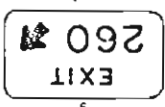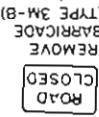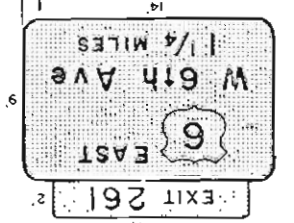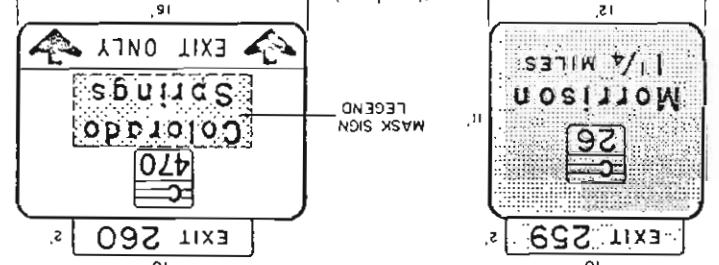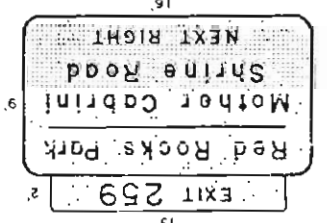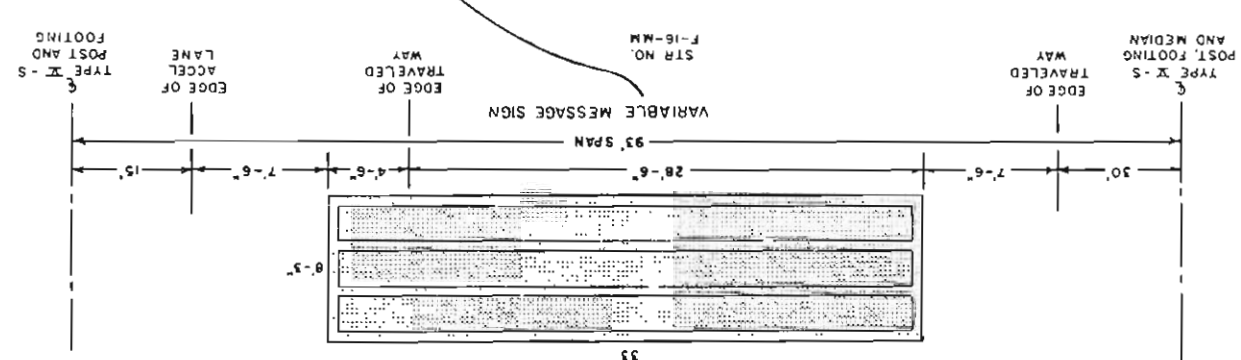

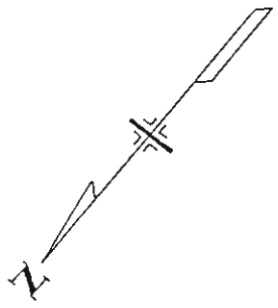


SIGNS MARKED [] ARE TO REMAIN IN PLACE.

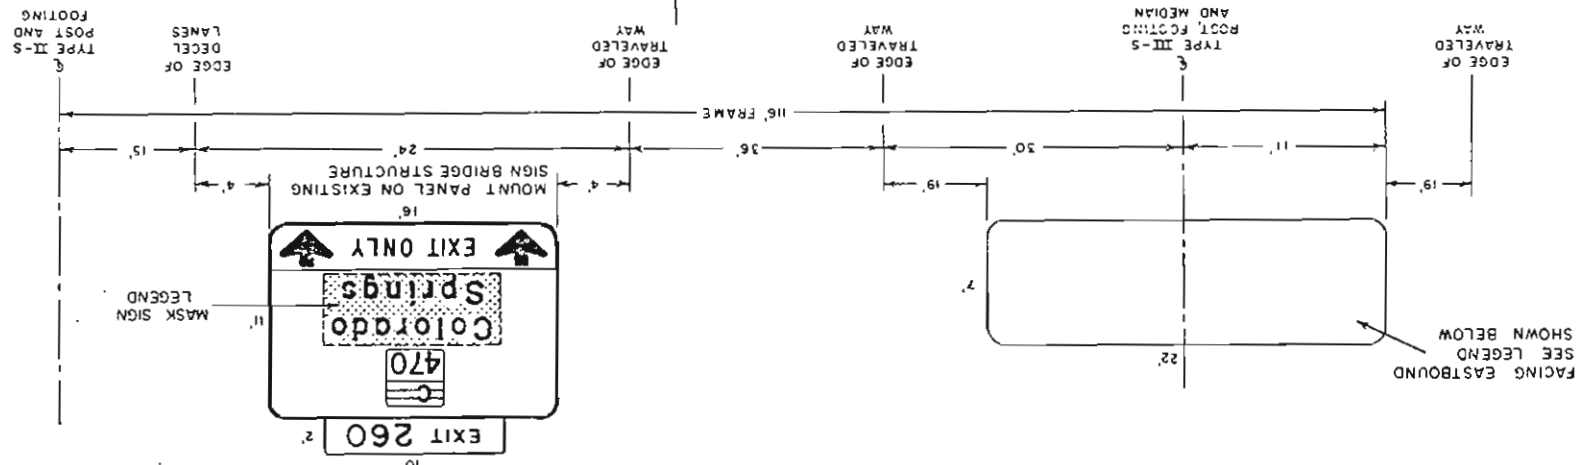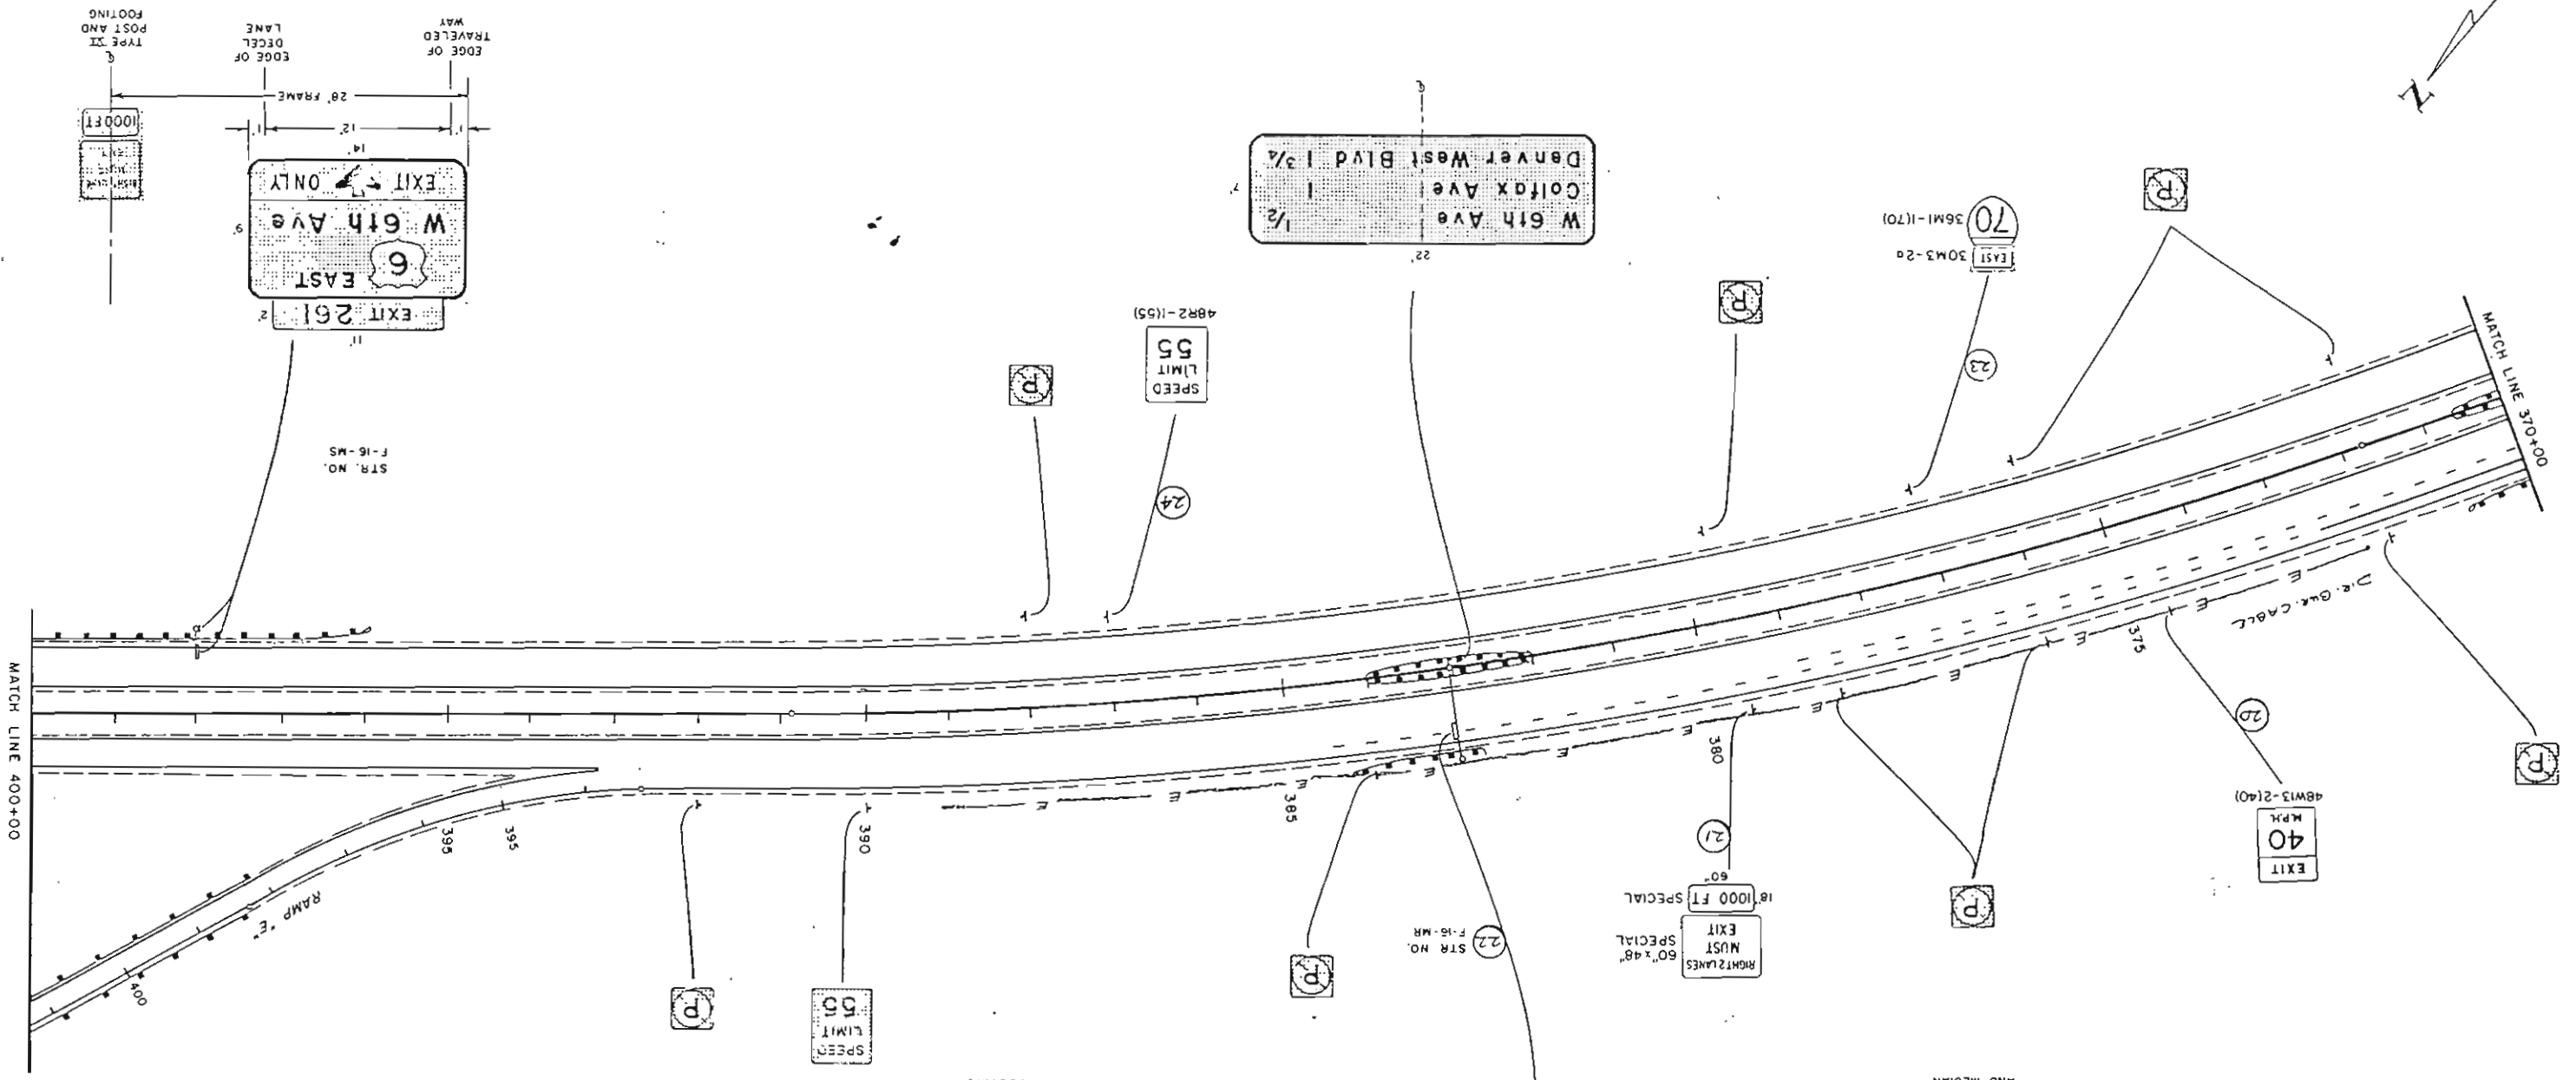

NO REVISIONS [] REVISED 12-23 VOID []				
AS CONSTRUCTED				
VIII	COLORADO	I 70-3(140)	51	57
FEDERAL ROAD REGION NO.	DIVISION	PROJ. NO.	SHEET NO.	TOTAL SHEETS

I-70 & US-6 (W 6th Ave.) INTERCHANGE (EXIT 261)

TOTAL SHEETS		57
PROJ. NO.		170-3 (140)
DIVISION		COLORADO
SHEET NO.		52
AS CONSTRUCTED		
NO REVISIONS		REVISSED 2-12-82
VOID		

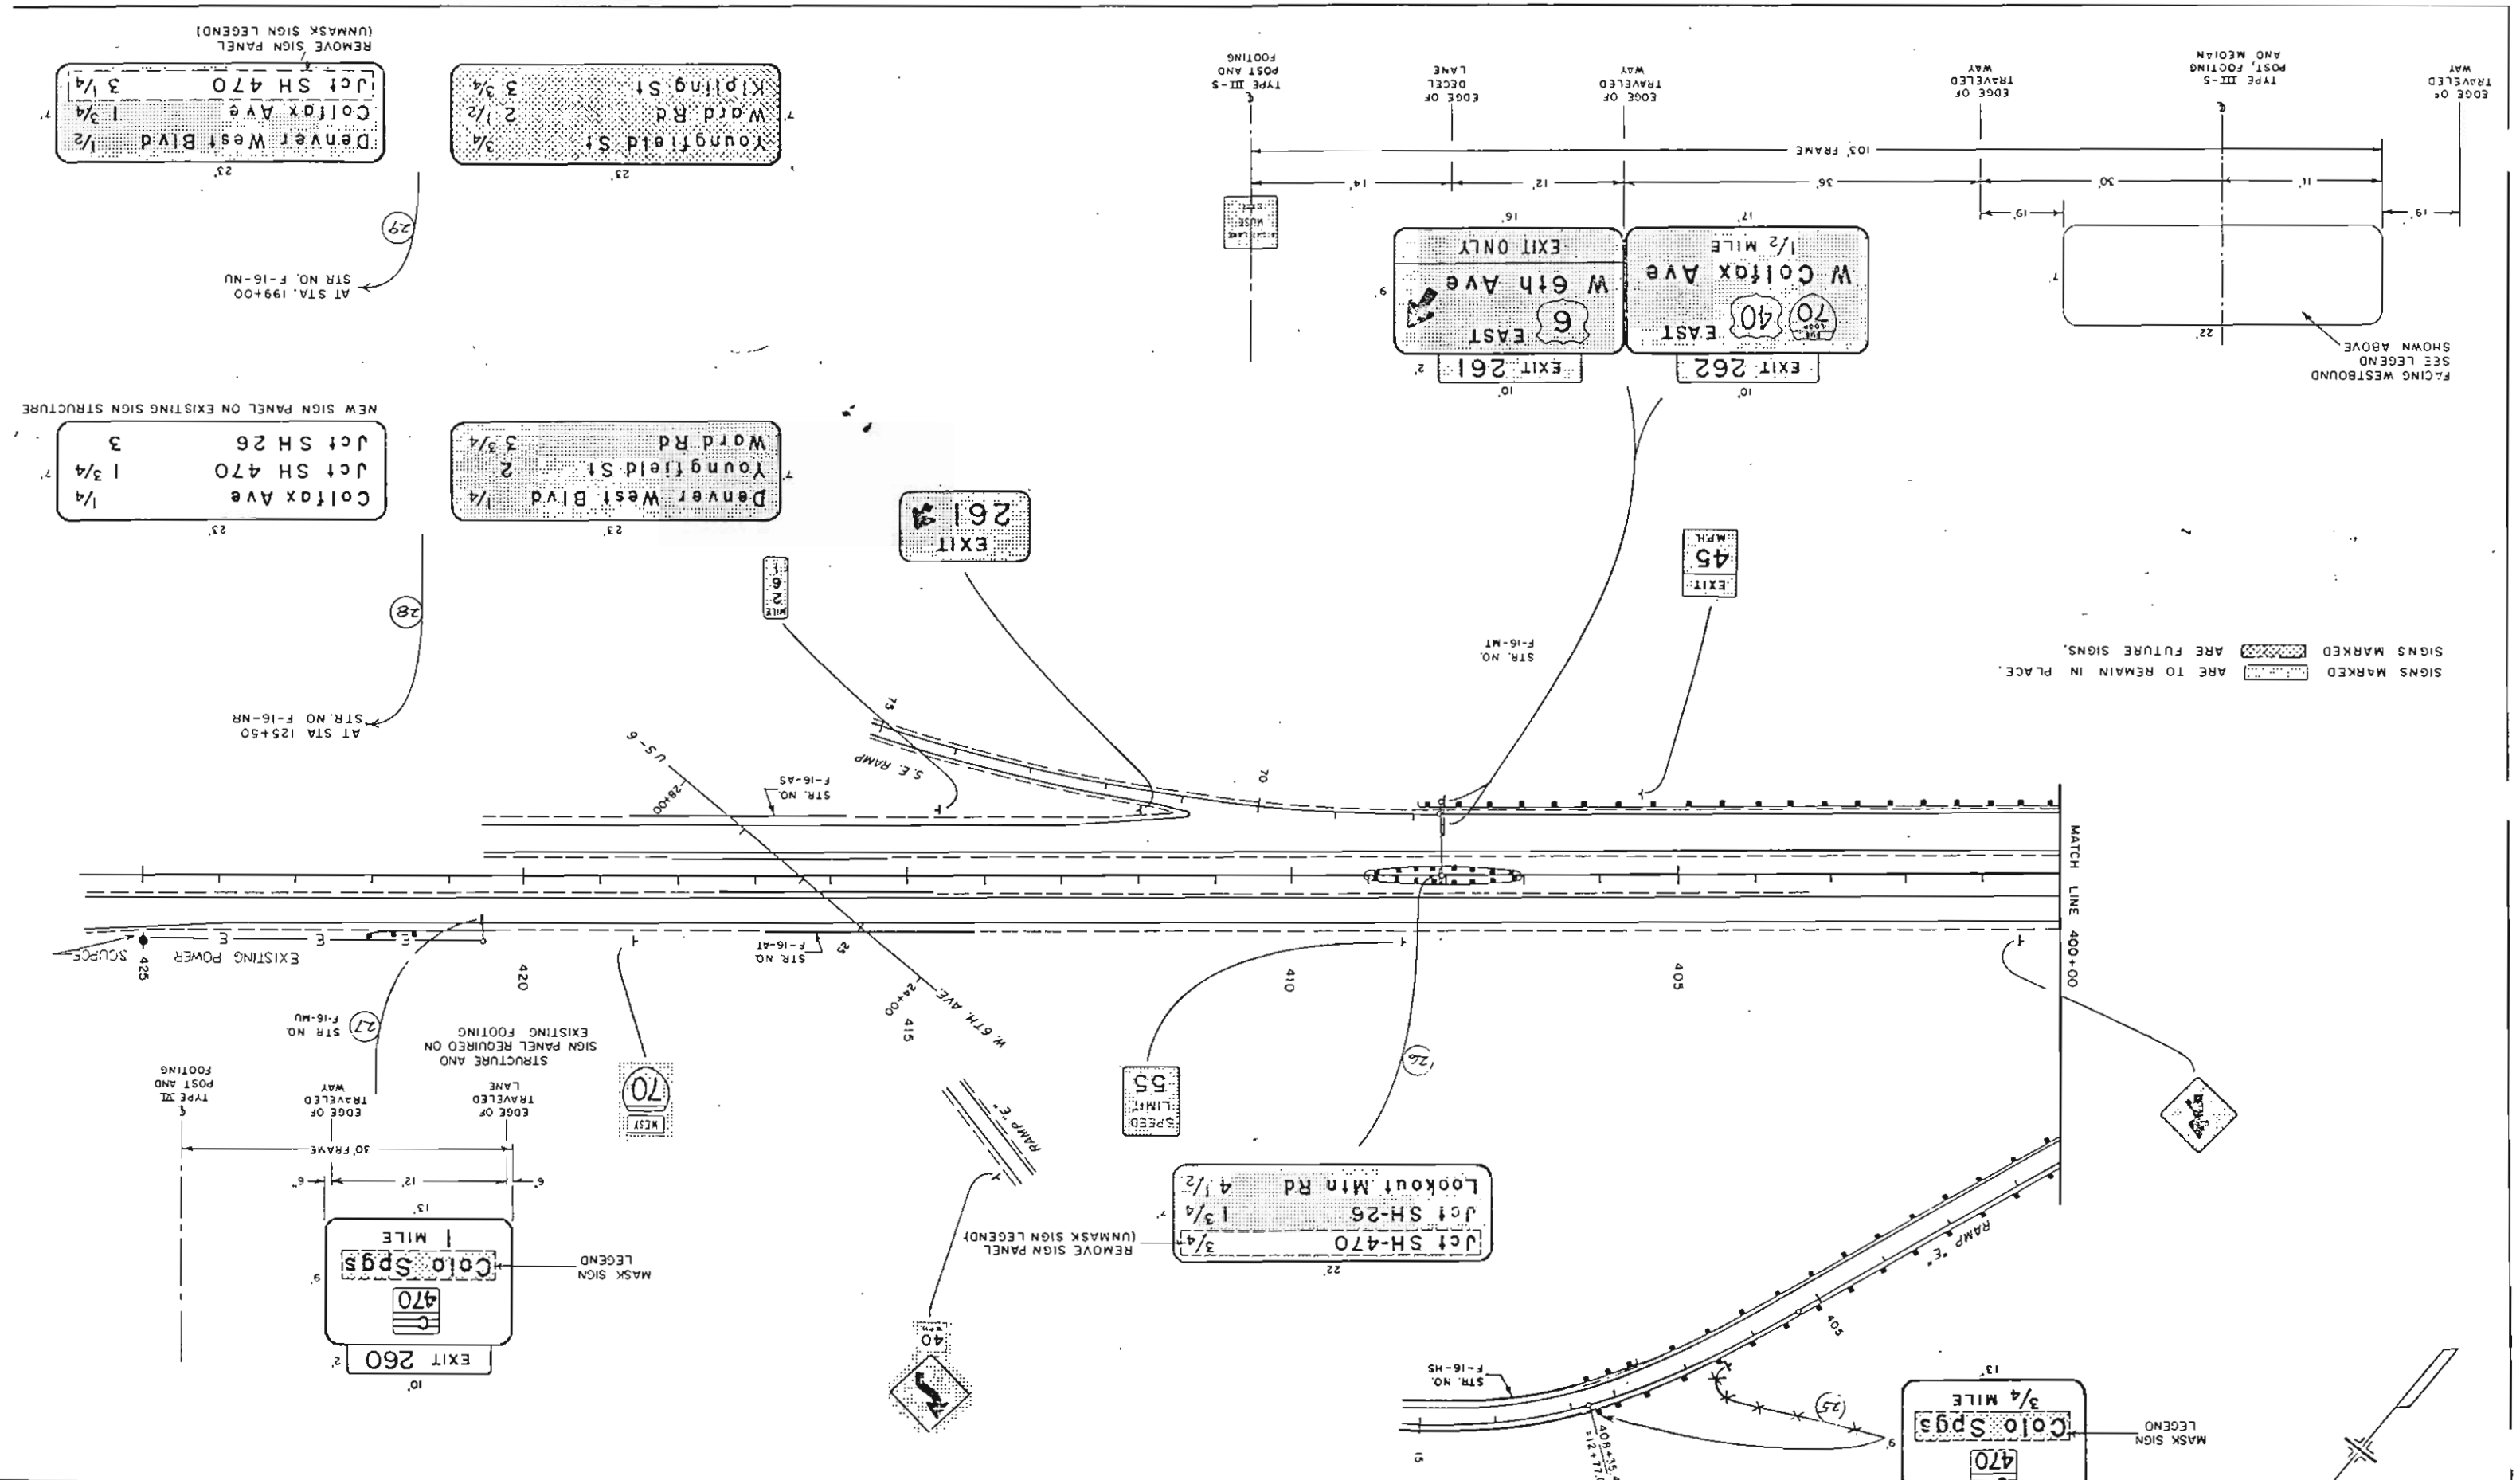

NEW SIGN PANEL ON EXISTING SIGN STRUCTURE
 Jct SH 26
 Jct SH 470
 Colfax Ave
 1/4 3/4 3

REMOVE SIGN PANEL (UNMASK SIGN LEGEND)
 Jct SH 470
 Colfax Ave
 Denver West Blvd
 1/2 1 3/4 3 1/4

Denver West Blvd 1/4
 Youngfield St 2
 World Rd 3 3/4

Youngfield St 3/4
 World Rd 2 1/2
 Kipling St 3 3/4

Jct SH-470
 Jct SH-26
 Lookout Min Rd
 3/4 1 3/4 4 1/2


EXIT 262
 W Colfax Ave
 1/2 MILE EAST
 EXIT 261
 W 6th Ave
 EAST
 EXIT ONLY





EXIT 260
 Colo Spgs
 470
 3/4 MILE

MASK SIGN LEGEND

SIGNALS MARKED ARE TO REMAIN IN PLACE.
 SIGNALS MARKED ARE FUTURE SIGNALS.

FACING WESTBOUND
 SEE LEGEND
 SHOWN ABOVE

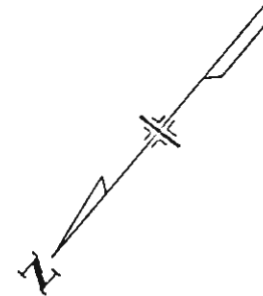


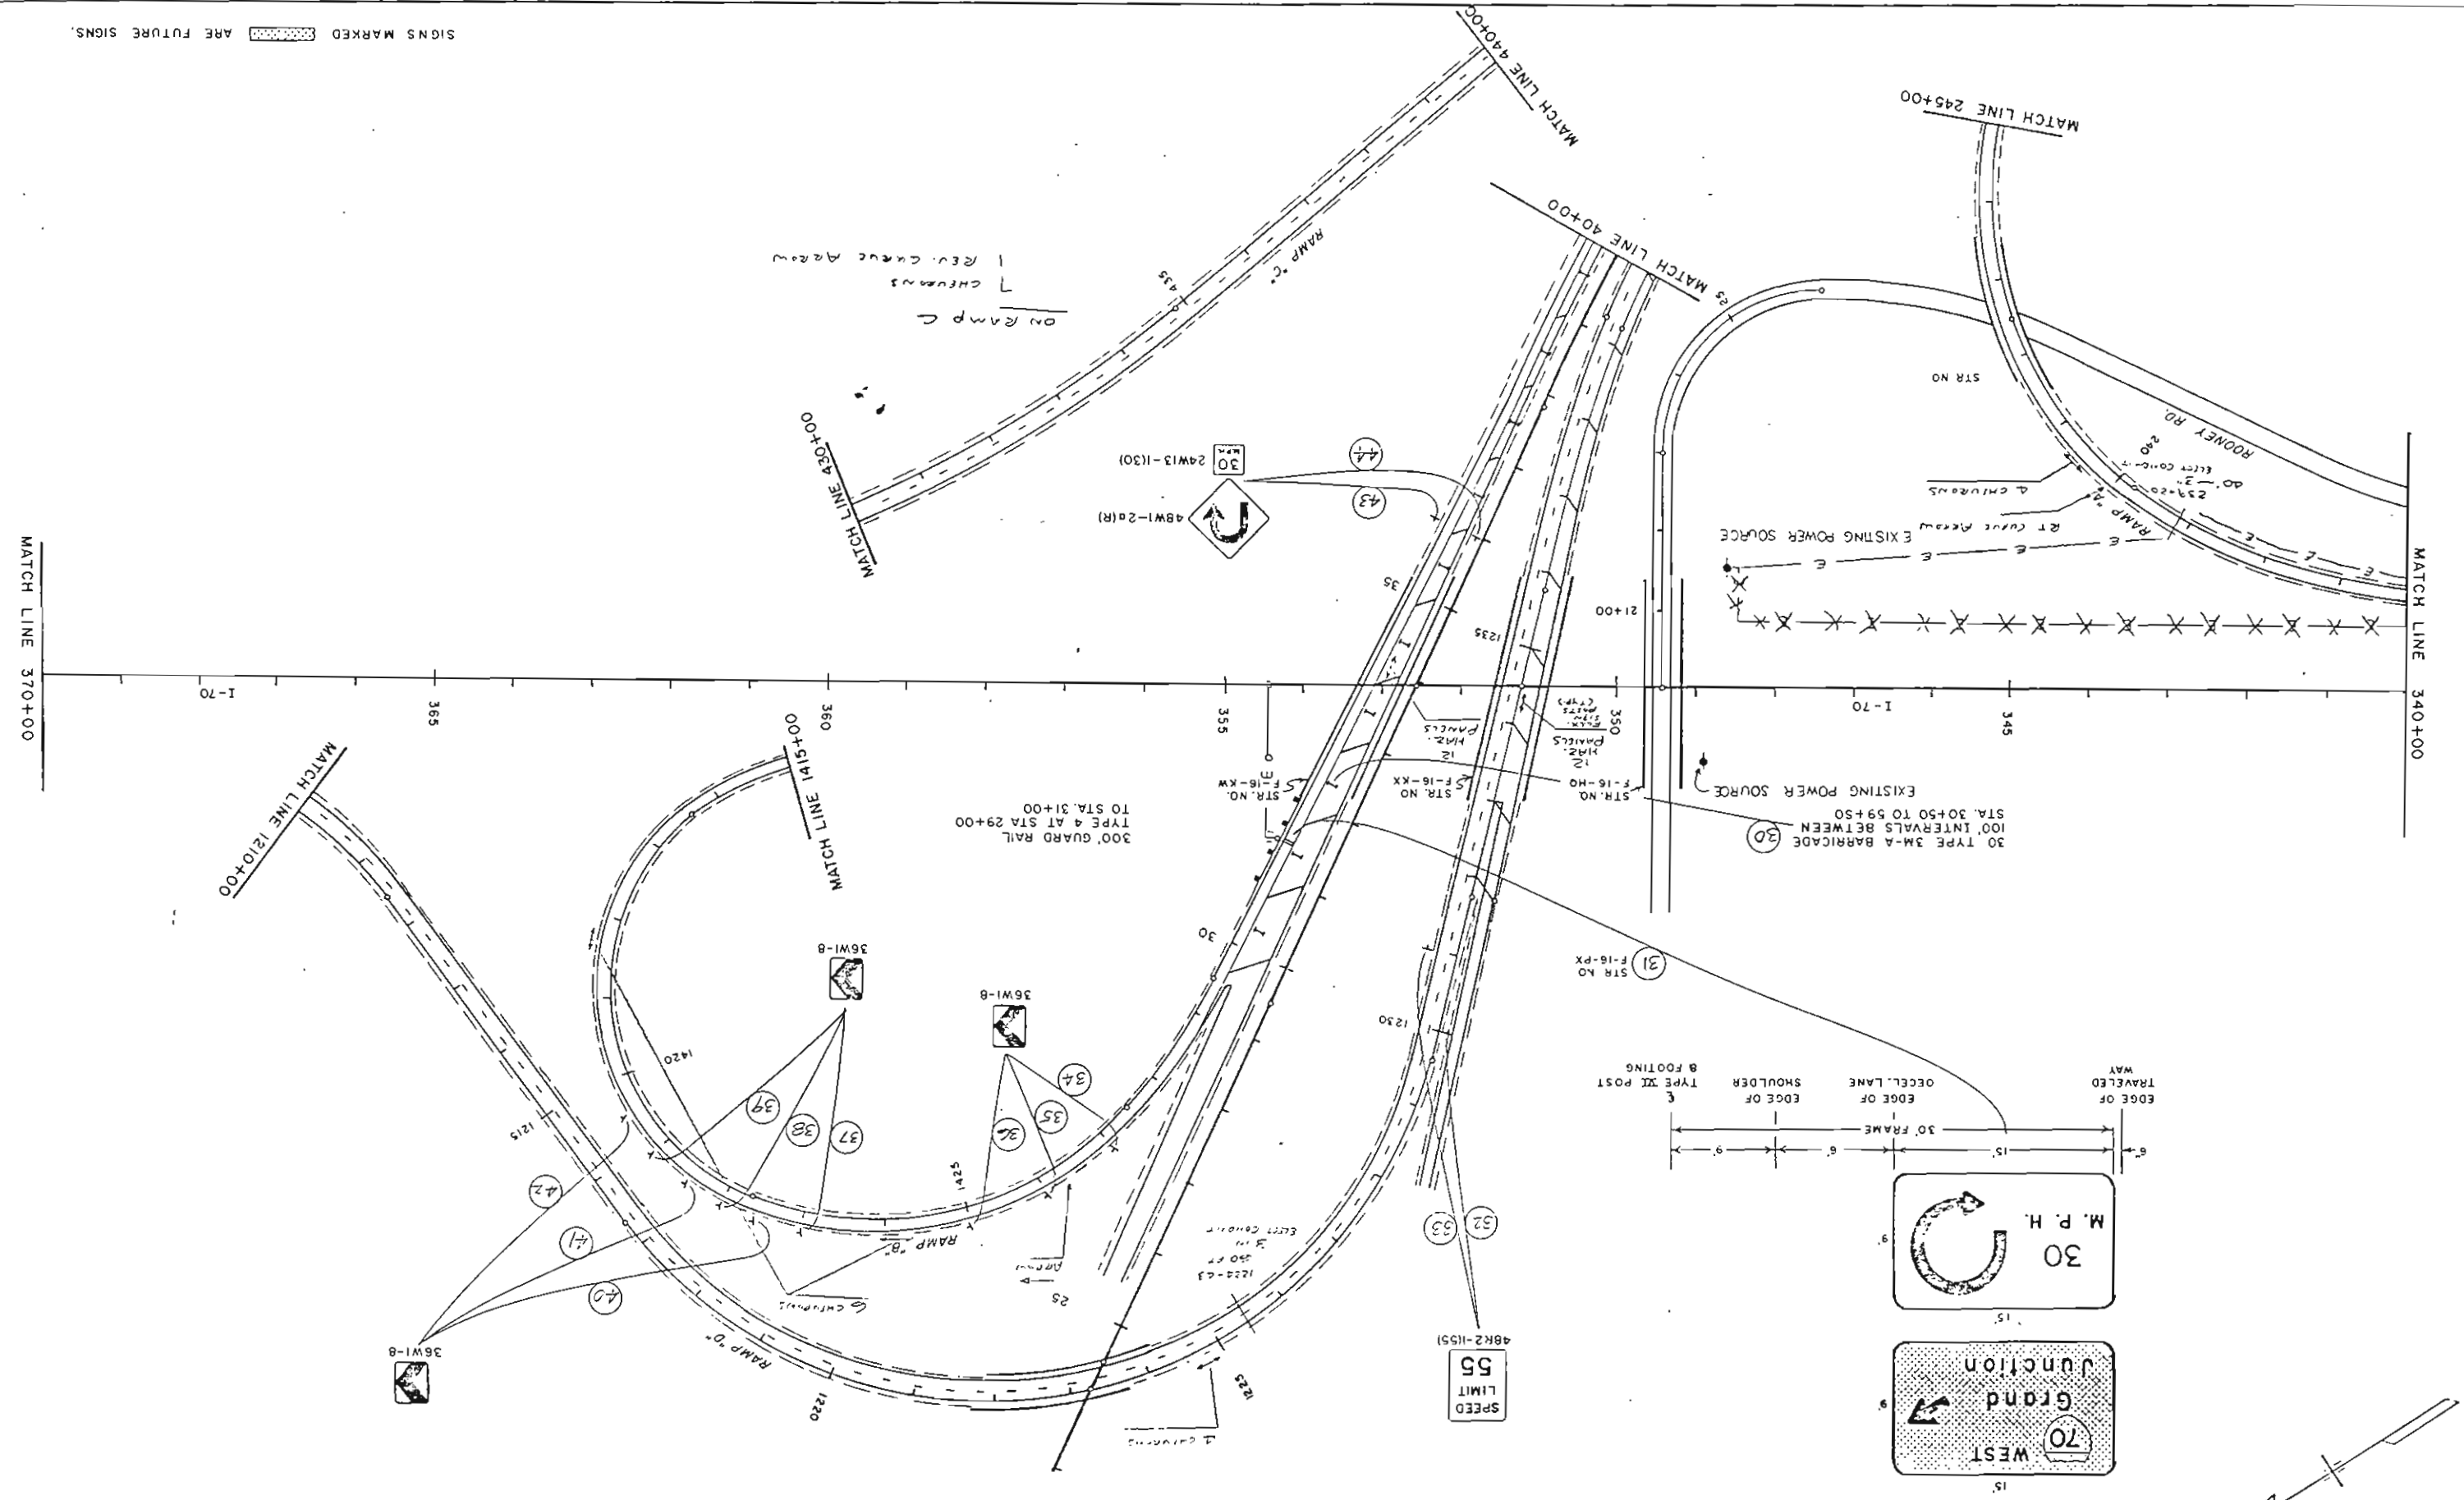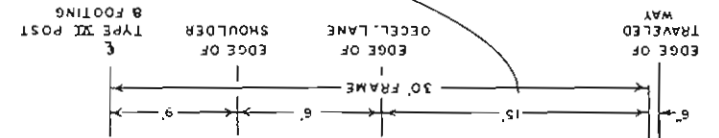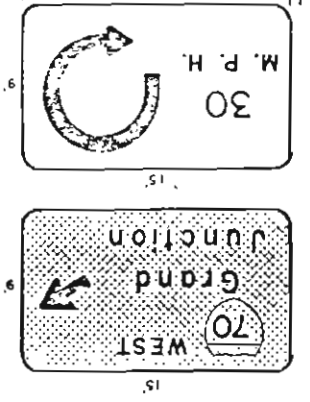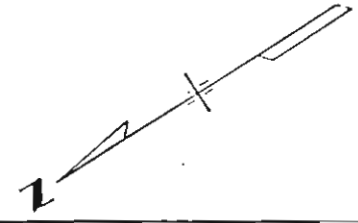


AS CONSTRUCTED		NO REVISIONS	
12.12.84 VOID		REVISION 12.12.84 VOID	
FED. ROAD REGION	DMS. NO.	COLD.	PROJ. NO.
VIII	I 70-3(140)	53	57
SHEET NO.		SHEET TOTALS	

SIGNS MARKED ARE FUTURE SIGNS.

FED. ROAD REGION	DMSION	PROJ. NO.	SHEET NO.	SHEET TOTALS
VIII	COLO.	I 70-3(140)	54	57
AS CONSTRUCTED				
NO REVISION		REVISED 12 12 82	VOID	

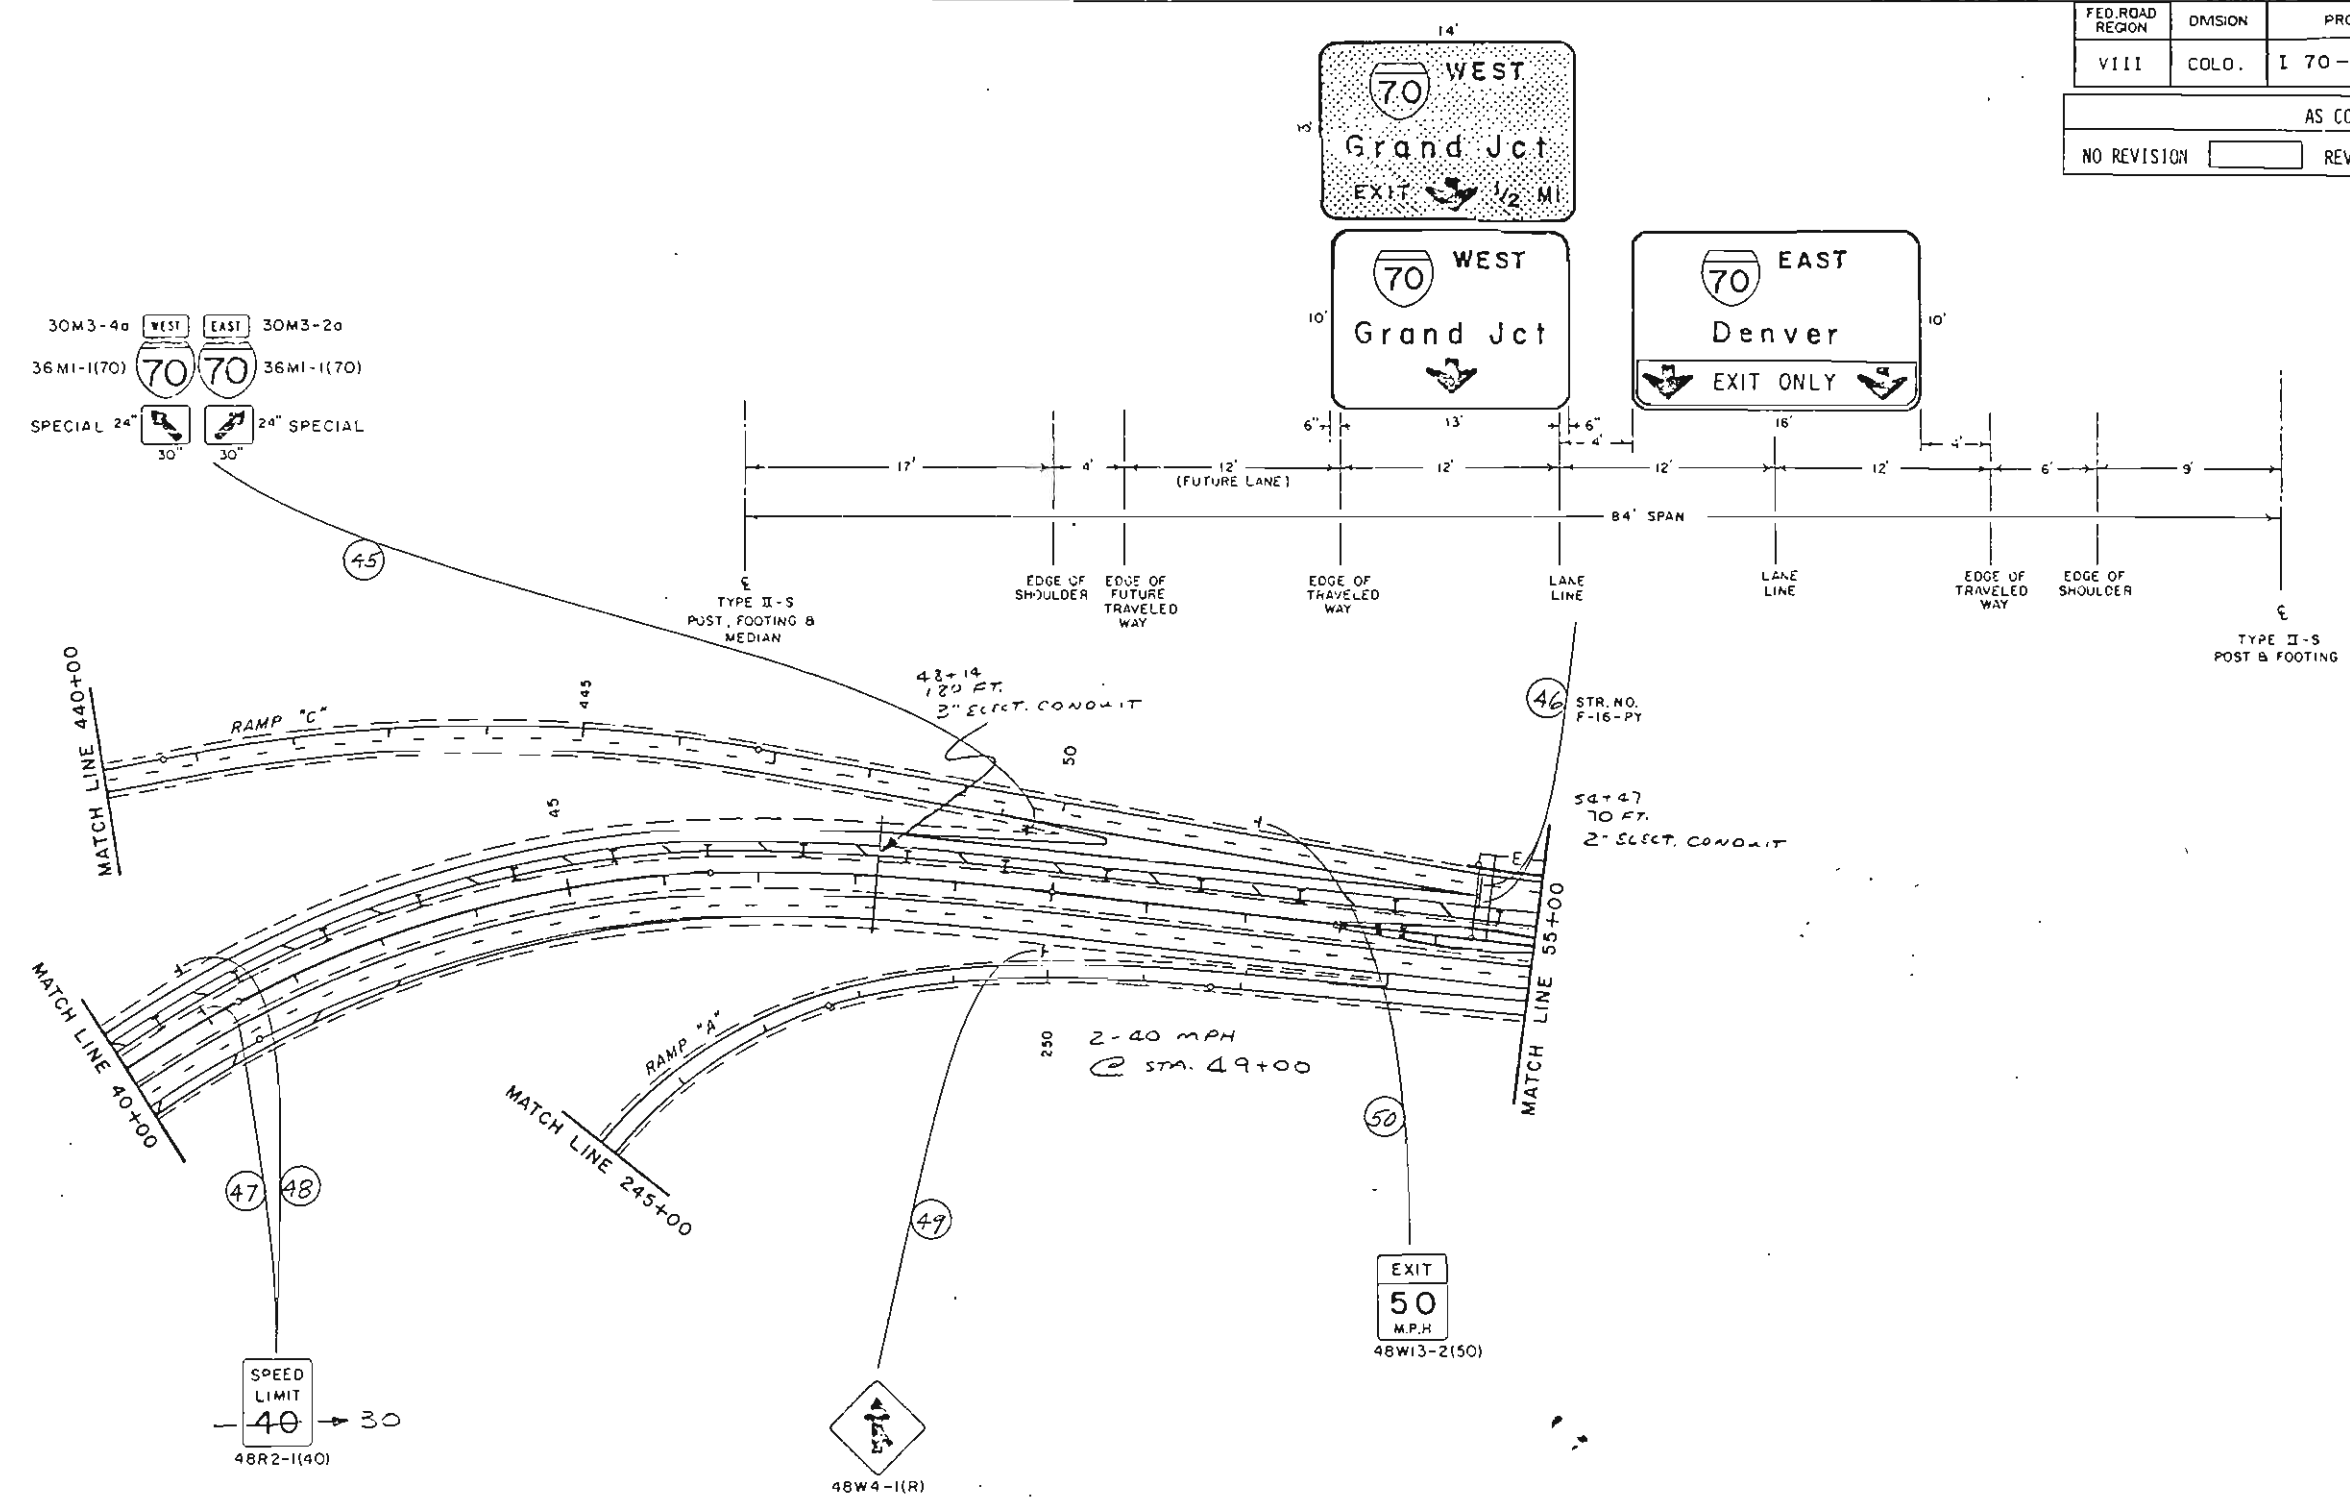


SIGNS MARKED ARE FUTURE SIGNS.

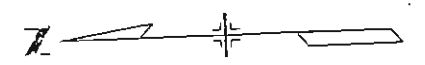


AS CONSTRUCTED
 NO REVISIONS 12-12-66 REVISED VOID





FED. ROAD REGION	DMSION	PROJ. NO.	SHEET NO.	SHEET TOTALS
VIII	COLO.	I 70-3(140)	55	57

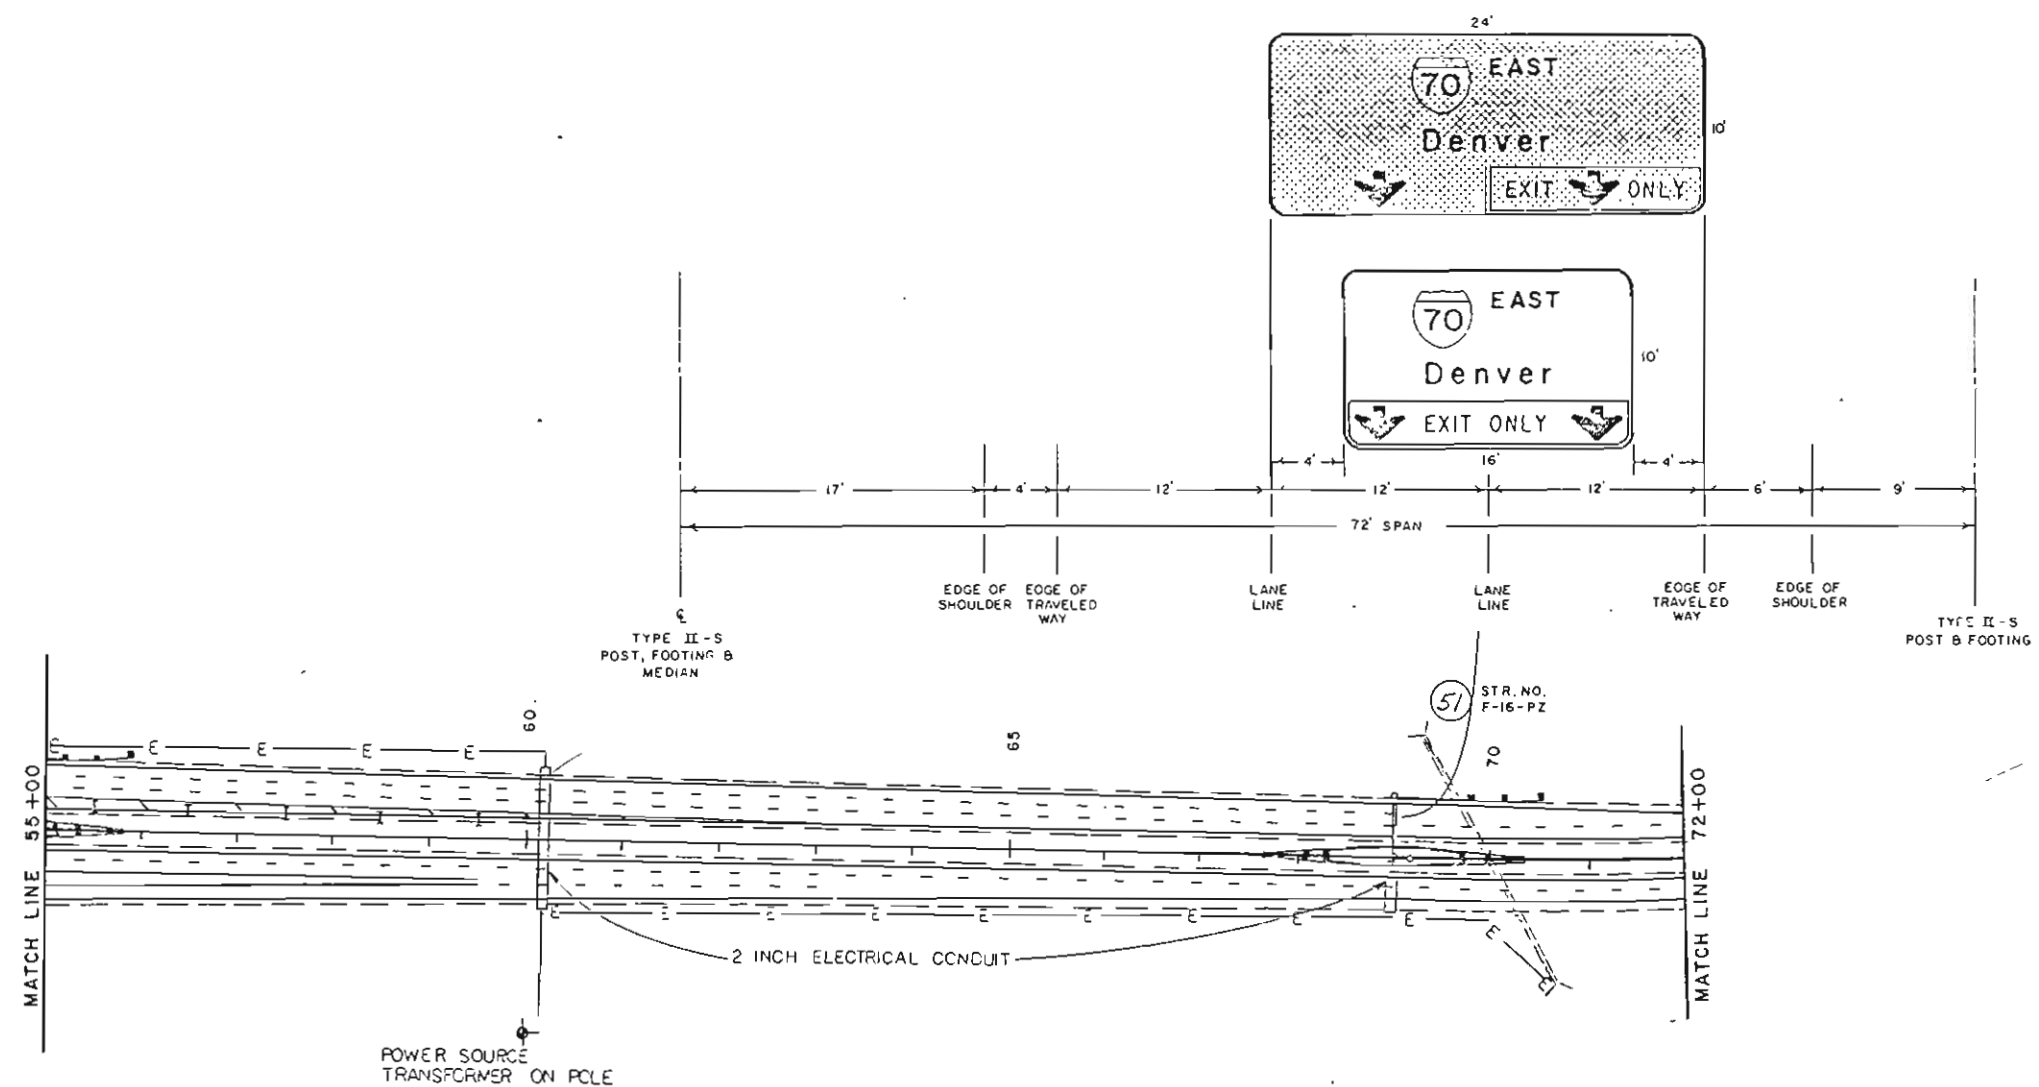

SIGNS MARKED ARE FUTURE SIGNS.

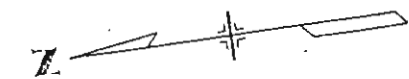

REVISIONS	

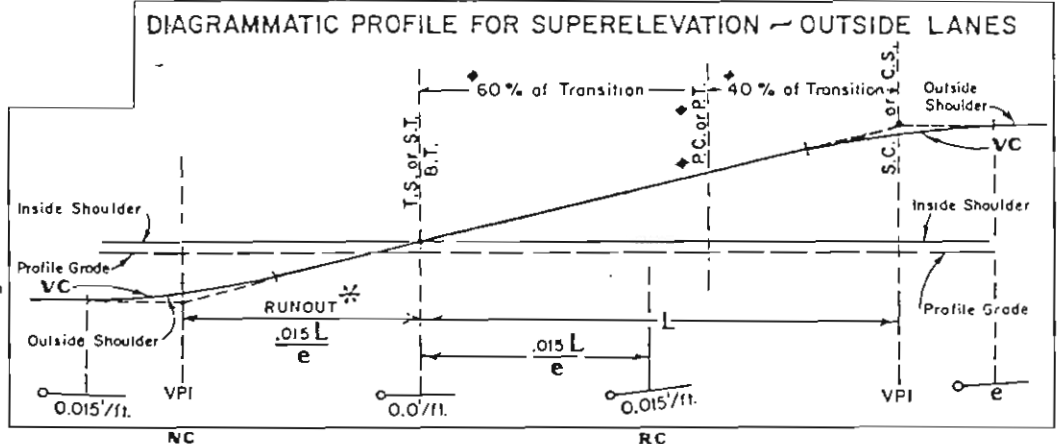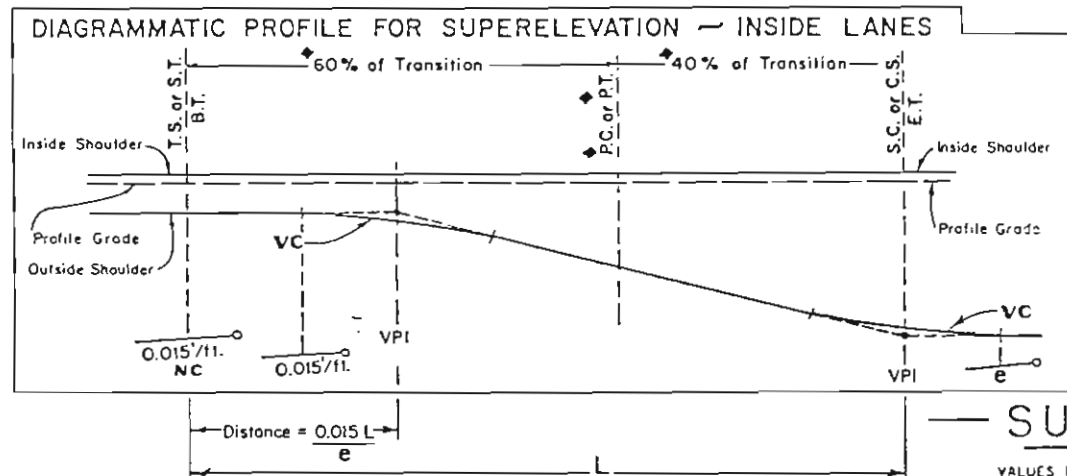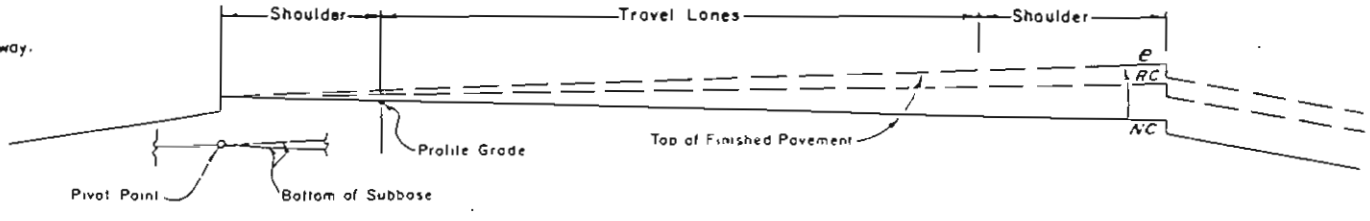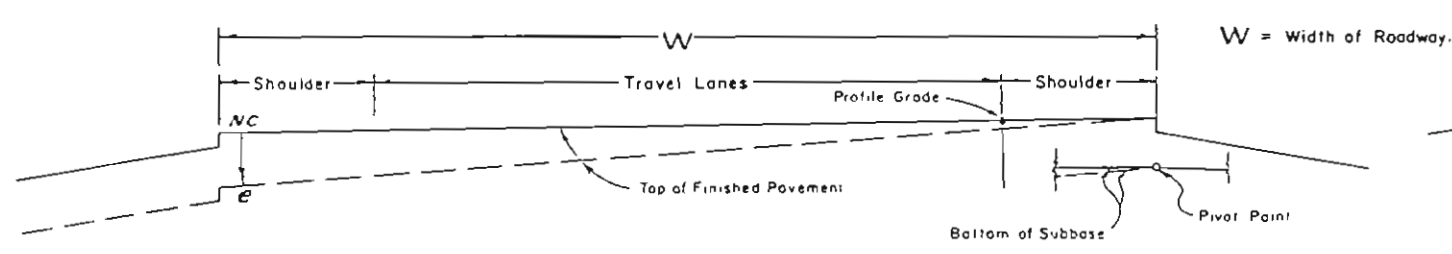

VC — TO OBTAIN SMOOTH PROFILES ON PAVEMENT EDGES, VERTICAL CURVES MAY BE INSERTED AT THE ANGULAR BREAK POINTS AT THE LOCATIONS SHOWN HERE. UNLESS RESTRAINING CONDITIONS EXIST, THE LENGTH OF VERTICAL CURVE SELECTED, IN FEET, SHOULD BE NO LESS THAN NUMERICALLY EQUAL TO THE DESIGN SPEED, AND NO MORE THAN $\frac{0.3L}{e}$.

* — RUNOUT LENGTH SHOULD USUALLY BE $\frac{0.15L}{e}$. WHEN CONDITIONS ARE SUCH THAT THIS LENGTH IS NOT SUITABLE, THE DESIGNER SHALL CHOOSE ANOTHER LENGTH TO SUIT CONDITIONS.

When Curve is Not Spiralled
 E = Maximum rate of superlevation in feet (per foot of width) for the given degree of curve and design speed.
 O = Pivot

SUPERELEVATION RATES

VALUES FOR DESIGN ELEMENTS RELATED TO DESIGN SPEED AND HORIZONTAL CURVATURE FOR A FOUR LANE DIVIDED HIGHWAY

Use in Mountainous Areas and Areas where Icing Conditions Frequently Exist

D	R	V=30 MPH		V=40 MPH		V=50 MPH		V=60 MPH		V=65 MPH		V=70 MPH		V=75 MPH		V=80 MPH	
		e	L- FEET	e	L- FEET	e	L- FEET	e	L- FEET	e	L- FEET	e	L- FEET	e	L- FEET	e	L- FEET
0° 15'	22914'	NC	0	NC	0	NC	0	NC	0	NC	0	NC	0	NC	0	NC	240
0° 30'	11457'	NC	0	NC	0	NC	0	NC	175	RC	190	RC	200	.022	220	.021	210
0° 45'	7639'	NC	0	NC	0	RC	150	.022	175	.025	190	.029	200	.032	220	.036	240
1° 00'	5773'	NC	0	RC	125	.021	150	.029	175	.033	190	.038	200	.043	220	.047	240
1° 15'	4894'	RC	100	.021	125	.030	150	.040	175	.046	200	.053	240	.060	290	.065	320
2° 00'	2865'	RC	100	.022	125	.038	150	.051	210	.057	250	.065	290	.072	340	.078	380
2° 30'	2292'	.021	100	.033	125	.048	170	.060	210	.066	250	.073	330	.078	370	.080	400
3° 00'	1910'	.025	100	.038	125	.053	190	.067	270	.073	320	.078	340	.080	340	.080	400
3° 30'	1637'	.028	100	.043	140	.058	210	.073	300	.077	320	.080	360	.080	380	D MAX=1.5*	
4° 00'	1442'	.032	100	.047	150	.063	230	.077	310	.079	340	.080	360	D MAX=1.5*			
5° 00'	1144'	.038	100	.055	170	.071	260	.090	320	.090	350	D MAX=1.5*					
6° 00'	954'	.043	120	.061	190	.077	280	.090	320	D MAX=1.5*							
7° 00'	814'	.048	130	.067	210	.079	280	D MAX=1.5*									
8° 00'	716'	.052	140	.071	220	.080	290										
9° 00'	651'	.056	150	.075	240	D MAX=1.5*											
10° 00'	573'	.059	160	.077	240												
11° 00'	523'	.063	170	.079	250												
12° 00'	477'	.066	180	.080	250												
13° 00'	441'	.068	180	.080	250												
14° 00'	409'	.070	190	D MAX=1.5*													
16° 00'	358'	.074	200														
18° 00'	325'	.077	210														
20° 00'	286'	.079	210														
22° 00'	250'	.080	220														
D MAX=1.5*																	

$e_{max} = 0.08$

Use in Rolling Areas and Areas where Icing Conditions Occasionally Exist

D	R	V=30 MPH		V=40 MPH		V=50 MPH		V=60 MPH		V=65 MPH		V=70 MPH		V=75 MPH		V=80 MPH	
		e	L- FEET	e	L- FEET	e	L- FEET	e	L- FEET	e	L- FEET	e	L- FEET	e	L- FEET	e	L- FEET
0° 15'	22914'	NC	0	NC	0	NC	0	NC	0	NC	0	NC	0	NC	0	NC	240
0° 30'	11457'	NC	0	NC	0	NC	0	RC	175	RC	190	RC	200	.022	220	.021	210
0° 45'	7639'	NC	0	RC	150	.022	175	.024	175	.025	190	.029	200	.033	220	.036	240
1° 00'	5773'	NC	0	RC	125	.023	150	.022	175	.025	190	.029	200	.034	220	.038	240
1° 15'	4894'	RC	100	.021	125	.033	150	.046	190	.052	220	.058	260	.065	310	.071	350
2° 00'	2865'	RC	100	.028	125	.042	150	.058	230	.066	290	.074	330	.082	390	.089	440
2° 30'	2292'	.021	100	.034	125	.051	180	.069	280	.077	320	.086	390	.094	450	.099	490
3° 00'	1910'	.025	100	.040	125	.059	210	.079	320	.087	340	.094	420	.100	480	.100	500
3° 30'	1617'	.029	100	.046	140	.067	240	.087	350	.093	400	.099	450	.100	480	.100	500
4° 00'	1432'	.033	100	.051	160	.073	260	.093	380	.098	420	.100	450	D MAX=1.5*			
5° 00'	1146'	.040	110	.061	190	.084	300	.099	400	.100	430	.100	450	D MAX=1.5*			
6° 00'	955'	.046	120	.070	220	.092	320	.100	410	D MAX=1.5*							
7° 00'	819'	.053	140	.077	240	.098	350	D MAX=1.5*									
8° 00'	716'	.059	160	.084	260	.100	360										
9° 00'	637'	.064	170	.089	280	.100	360										
10° 00'	573'	.068	180	.093	290	D MAX=1.5*											
11° 00'	523'	.073	200	.097	310												
12° 00'	477'	.077	210	.099	310												
13° 00'	441'	.080	220	.100	320												
14° 00'	409'	.083	220	.100	320												
16° 00'	358'	.089	240	D MAX=1.5*													
17° 00'	318'	.093	250														
20° 00'	286'	.097	260														
22° 00'	250'	.099	270														
24° 00'	229'	.100	270														
D MAX=1.5*																	

$e_{max} = 0.10$

Use in Plains Areas and Areas where Icing Conditions Seldom Exist or Where Roadways are Well Sanded during Icing Conditions

D	R	V=30 MPH		V=40 MPH		V=50 MPH		V=60 MPH		V=65 MPH		V=70 MPH		V=75 MPH		V=80 MPH	
		e	L- FEET	e	L- FEET	e	L- FEET	e	L- FEET	e	L- FEET	e	L- FEET	e	L- FEET	e	L- FEET
0° 15'	22914'	NC	0	NC	0	NC	0	NC	0	NC	0	NC	0	NC	0	NC	240
0° 30'	11457'	NC	0	NC	0	NC	0	RC	175	RC	190	RC	200	.022	220	.021	210
0° 45'	7639'	NC	0	NC	0	RC	150	.024	175	.026	190	.029	200	.033	220	.036	240
1° 00'	5773'	NC	0	RC	125	.023	150	.024	175	.025	190	.029	200	.034	220	.038	240
1° 15'	4894'	RC	100	.021	125	.033	150	.046	190	.052	220	.058	260	.065	310	.071	350
2° 00'	2865'	RC	100	.028	125	.042	150	.058	230	.066	290	.074	330	.082	390	.089	440
2° 30'	2292'	.021	100	.034	125	.051	180	.069	280	.077	320	.086	390	.094	450	.099	490
3° 00'	1910'	.025	100	.040	125	.059	210	.079	320	.087	340	.094	420	.100	480	.100	500
3° 30'	1617'	.029	100	.046	140	.067	240	.087	350	.093	400	.099	450	.100	480	.100	500
4° 00'	1432'	.033	100	.051	160	.073	260	.093	380	.098	420	.100	450	D MAX=1.5*			
5° 00'	1146'	.040	110	.061	190	.084	300	.099	400	.100	430	.100	450	D MAX=1.5*			
6° 00'	955'	.046	120	.070	220	.092	320	.100	410	D MAX=1.5*							
7° 00'	819'	.053	140	.077	240	.098	350	D MAX=1.5*									
8° 00'	716'	.059	160	.084	260	.100	360										
9° 00'	637'	.064	170	.089	280	.100	360										
10° 00'	573'	.068	180	.093	290	D MAX=1.5*											
11° 00'	523'	.073	200	.097	310												
12° 00'	477'	.077	210	.099	310												
13° 00'	441'	.080	220	.100	320												
14° 00'	409'	.083	220	.100	320												
16° 00'	358'	.089	240	D MAX=1.5*													
17° 00'	318'	.093	250														
20° 00'	286'	.097	260														
22° 00'	250'	.099	270														
24° 00'	229'	.100	270														
D MAX=1.5*																	

$e_{max} = 0.12$





D — DEGREE OF CURVE
 R — RADIUS OF CURVATURE
 V — ASSUMED DESIGN SPEED
 L — LENGTH OF SUPERELEVATION RUNOFF
 NC — NORMAL SECTION
 RC — REVERSE SLOPE (APPLICABLE TO OUTSIDE LANES ONLY)

SPIRALS DESIRABLE BUT NOT ESSENTIAL ABOVE THE UPPERMOST HEAVY LINE. LENGTHS ROUNDED IN MULTIPLES OF 25 OR 50 FEET PERMIT SIMPLER CALCULATIONS.

DEPARTMENT OF HIGHWAYS
 STATE OF COLORADO
 DIVISION OF HIGHWAYS
SUPERELEVATION OF CURVES
 DIVIDED HIGHWAYS
 SHOULDER PIVOT

Designed by JHK Approved by [Signature]
 Made by ALW Staff Design Engr
 Checked by DLV Date: October 22, 1971

REVISIONS	

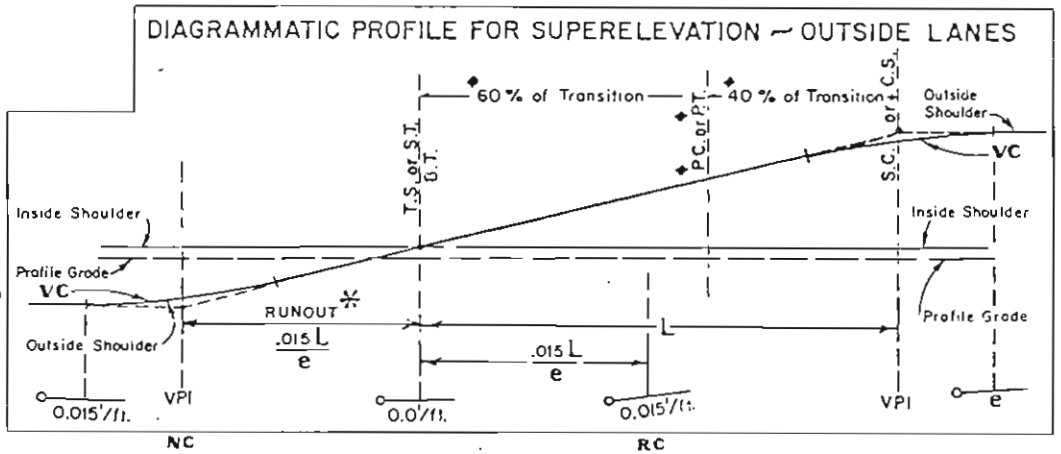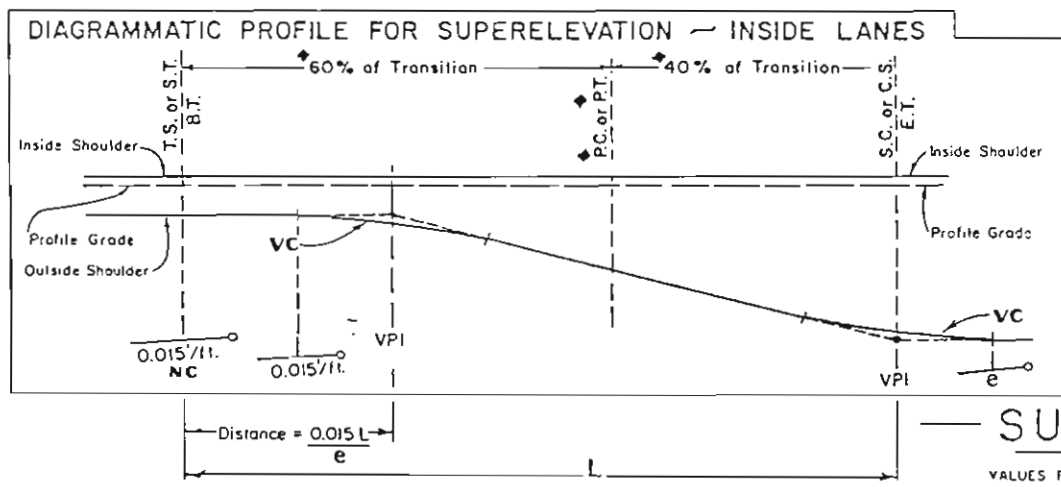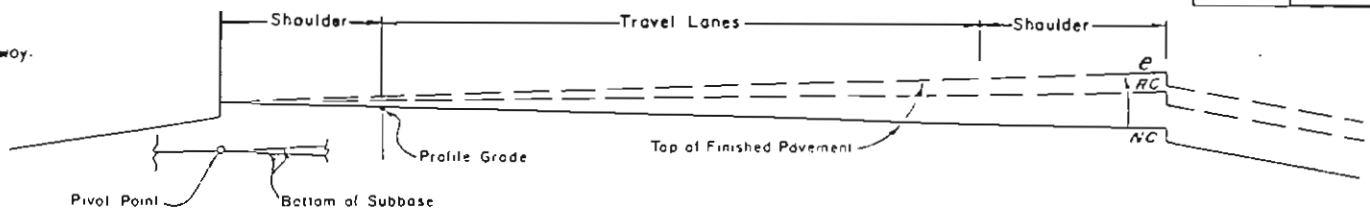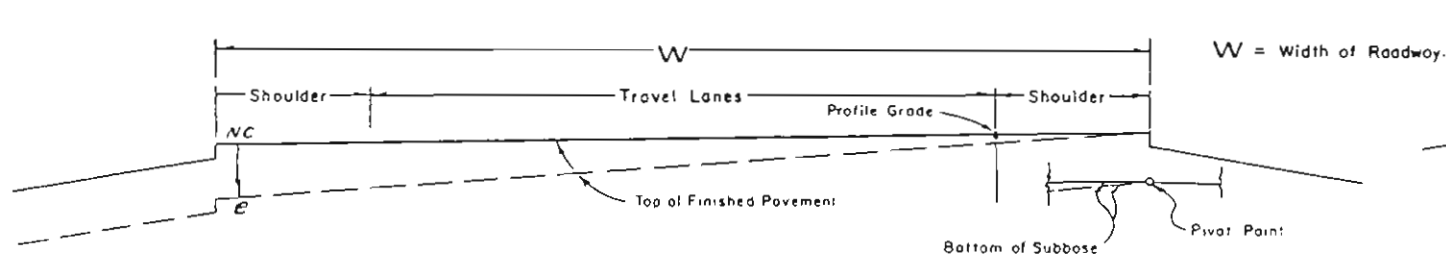

VC — TO OBTAIN SMOOTH PROFILES ON PAVEMENT EDGES, VERTICAL CURVES MAY BE INSERTED AT THE ANGULAR BREAK POINTS AT THE LOCATIONS SHOWN HERE. UNLESS RESTRAINING CONDITIONS EXIST, THE LENGTH OF VERTICAL CURVE SELECTED, IN FEET, SHOULD BE NO LESS THAN NUMERICALLY EQUAL TO THE DESIGN SPEED, AND NO MORE THAN $\frac{0.3L}{e}$.

* — RUNOUT LENGTH SHOULD USUALLY BE $\frac{0.15L}{e}$. WHEN CONDITIONS ARE SUCH THAT THIS LENGTH IS NOT SUITABLE, THE DESIGNER SHALL CHOOSE ANOTHER LENGTH TO SUIT CONDITIONS.

When Curve is Not Spiralled
 e = Maximum rate of superlevation in feet (per foot of width) for the given degree of curve and design speed.
 o = Pivot

SUPERELEVATION RATES
 VALUES FOR DESIGN ELEMENTS RELATED TO DESIGN SPEED AND HORIZONTAL CURVATURE FOR A FOUR LANE DIVIDED HIGHWAY

Use in Mountainous Areas and Areas where Icing Conditions Frequently Exist

D	R	V = 30 MPH		V = 40 MPH		V = 50 MPH		V = 60 MPH		V = 65 MPH		V = 70 MPH		V = 75 MPH		V = 80 MPH	
		e	L- FEET	e	L- FEET	e	L- FEET	e	L- FEET	e	L- FEET	e	L- FEET	e	L- FEET	e	L- FEET
0° 15'	22914'	NC	0	NC	0	NC	0	NC	175	RC	190	RC	200	0.22	220	0.21	210
0° 30'	11457'	NC	0	NC	0	NC	0	NC	175	RC	190	RC	200	0.22	220	0.21	210
0° 45'	7639'	NC	0	NC	0	RC	130	0.22	175	0.23	190	0.23	200	0.23	220	0.23	240
1° 00'	5730'	NC	0	RC	125	0.21	150	0.21	175	0.22	190	0.22	200	0.22	220	0.22	240
1° 30'	3820'	RC	100	0.21	125	0.20	150	0.20	175	0.21	200	0.21	220	0.21	240	0.21	260
2° 00'	2865'	RC	100	0.21	125	0.20	150	0.20	175	0.21	200	0.21	220	0.21	240	0.21	260
2° 30'	2292'	0.21	100	0.21	125	0.20	150	0.20	175	0.21	200	0.21	220	0.21	240	0.21	260
3° 00'	1910'	0.25	100	0.24	125	0.23	150	0.23	175	0.24	200	0.24	220	0.24	240	0.24	260
3° 30'	1627'	0.28	100	0.27	125	0.26	150	0.26	175	0.27	200	0.27	220	0.27	240	0.27	260
4° 00'	1422'	0.32	100	0.31	125	0.30	150	0.30	175	0.31	200	0.31	220	0.31	240	0.31	260
5° 00'	1145'	0.38	100	0.37	125	0.36	150	0.36	175	0.37	200	0.37	220	0.37	240	0.37	260
6° 00'	955'	0.43	120	0.41	150	0.40	175	0.40	200	0.41	220	0.41	240	0.41	260	0.41	280
7° 00'	811'	0.48	130	0.47	160	0.46	190	0.46	220	0.47	250	0.47	280	0.47	310	0.47	340
8° 00'	718'	0.52	140	0.51	170	0.50	200	0.50	230	0.51	260	0.51	290	0.51	320	0.51	350
9° 00'	637'	0.56	150	0.55	180	0.54	210	0.54	240	0.55	270	0.55	300	0.55	330	0.55	360
10° 00'	573'	0.59	160	0.58	190	0.57	220	0.57	250	0.58	280	0.58	310	0.58	340	0.58	370
11° 00'	521'	0.63	170	0.62	200	0.61	230	0.61	260	0.62	290	0.62	320	0.62	350	0.62	380
12° 00'	477'	0.66	180	0.65	210	0.64	240	0.64	270	0.65	300	0.65	330	0.65	360	0.65	390
13° 00'	441'	0.68	180	0.68	210	0.67	240	0.67	270	0.68	300	0.68	330	0.68	360	0.68	390
14° 00'	409'	0.70	190	0.70	220	0.69	250	0.69	280	0.70	310	0.70	340	0.70	370	0.70	400
16° 00'	328'	0.74	200	0.74	230	0.73	260	0.73	290	0.74	320	0.74	350	0.74	380	0.74	410
18° 00'	288'	0.77	210	0.77	240	0.76	270	0.76	300	0.77	330	0.77	360	0.77	390	0.77	420
20° 00'	266'	0.79	210	0.79	240	0.78	270	0.78	300	0.79	330	0.79	360	0.79	390	0.79	420
22° 00'	250'	0.80	220	0.80	250	0.79	280	0.79	310	0.80	340	0.80	370	0.80	400	0.80	430
D MAX = 23.0°																	

$e_{max} = 0.08$

Use in Rolling Areas and Areas where Icing Conditions Occasionally Exist

D	R	V = 30 MPH		V = 40 MPH		V = 50 MPH		V = 60 MPH		V = 65 MPH		V = 70 MPH		V = 75 MPH		V = 80 MPH	
		e	L- FEET	e	L- FEET	e	L- FEET	e	L- FEET	e	L- FEET	e	L- FEET	e	L- FEET	e	L- FEET
0° 15'	22914'	NC	0	NC	0	NC	0	NC	175	RC	190	RC	200	0.22	220	0.21	210
0° 30'	11457'	NC	0	NC	0	NC	0	NC	175	RC	190	RC	200	0.22	220	0.21	210
0° 45'	7639'	NC	0	NC	0	RC	130	0.21	175	0.22	190	0.22	200	0.22	220	0.22	240
1° 00'	5730'	NC	0	RC	125	0.21	150	0.21	175	0.22	190	0.22	200	0.22	220	0.22	240
1° 30'	3820'	RC	100	0.21	125	0.21	150	0.21	175	0.22	200	0.22	220	0.22	240	0.22	260
2° 00'	2865'	RC	100	0.21	125	0.21	150	0.21	175	0.22	200	0.22	220	0.22	240	0.22	260
2° 30'	2292'	0.21	100	0.21	125	0.21	150	0.21	175	0.22	200	0.22	220	0.22	240	0.22	260
3° 00'	1910'	0.25	100	0.24	125	0.23	150	0.23	175	0.24	200	0.24	220	0.24	240	0.24	260
3° 30'	1627'	0.28	100	0.27	125	0.26	150	0.26	175	0.27	200	0.27	220	0.27	240	0.27	260
4° 00'	1422'	0.32	100	0.31	125	0.30	150	0.30	175	0.31	200	0.31	220	0.31	240	0.31	260
5° 00'	1145'	0.38	110	0.37	140	0.36	170	0.36	200	0.37	230	0.37	260	0.37	290	0.37	320
6° 00'	955'	0.43	120	0.41	150	0.40	180	0.40	210	0.41	240	0.41	270	0.41	300	0.41	330
7° 00'	811'	0.48	130	0.47	160	0.46	190	0.46	220	0.47	250	0.47	280	0.47	310	0.47	340
8° 00'	718'	0.52	140	0.51	170	0.50	200	0.50	230	0.51	260	0.51	290	0.51	320	0.51	350
9° 00'	637'	0.56	150	0.55	180	0.54	210	0.54	240	0.55	270	0.55	300	0.55	330	0.55	360
10° 00'	573'	0.59	160	0.58	190	0.57	220	0.57	250	0.58	280	0.58	310	0.58	340	0.58	370
11° 00'	521'	0.63	170	0.62	200	0.61	230	0.61	260	0.62	290	0.62	320	0.62	350	0.62	380
12° 00'	477'	0.66	180	0.65	210	0.64	240	0.64	270	0.65	300	0.65	330	0.65	360	0.65	390
13° 00'	441'	0.68	180	0.68	210	0.67	240	0.67	270	0.68	300	0.68	330	0.68	360	0.68	390
14° 00'	409'	0.70	190	0.70	220	0.69	250	0.69	280	0.70	310	0.70	340	0.70	370	0.70	400
16° 00'	328'	0.74	200	0.74	230	0.73	260	0.73	290	0.74	320	0.74	350	0.74	380	0.74	410
18° 00'	288'	0.77	210	0.77	240	0.76	270	0.76	300	0.77	330	0.77	360	0.77	390	0.77	420
20° 00'	266'	0.79	210	0.79	240	0.78	270	0.78	300	0.79	330	0.79	360	0.79	390	0.79	420
22° 00'	250'	0.80	220	0.80	250	0.79	280	0.79	310	0.80	340	0.80	370	0.80	400	0.80	430
D MAX = 25.0°																	

$e_{max} = 0.10$


Use in Plains Areas and Areas where Icing Conditions Seldom Exist or Where Roadways are Well Sanded during Icing Conditions

D	R	V = 30 MPH		V = 40 MPH		V = 50 MPH		V = 60 MPH		V = 65 MPH		V = 70 MPH		V = 75 MPH		V = 80 MPH	
		e	L- FEET	e	L- FEET	e	L- FEET	e	L- FEET	e	L- FEET	e	L- FEET	e	L- FEET	e	L- FEET
0° 15'	22914'	NC	0	NC	0	NC	0	NC	175	RC	190	RC	200	0.22	220	0.21	210
0° 30'	11457'	NC	0	NC	0	NC	0	NC	175	RC	190	RC	200	0.22	220	0.21	210
0° 45'	7639'	NC	0	NC	0	RC	130	0.21	175	0.22	190	0.22	200	0.22	220	0.22	240
1° 00'	5730'	NC	0	RC	125	0.21	150	0.21	175	0.22	190	0.22	200	0.22	220	0.22	240
1° 30'	3820'	RC	100	0.21	125	0.21	150	0.21	175	0.22	200	0.22	220	0.22	240	0.22	260
2° 00'	2865'	RC	100	0.21	125	0.21	150	0.21	175	0.22	200	0.22	220	0.22	240	0.22	260
2° 30'	2292'	0.21	100	0.21	125	0.21	150	0.21	175	0.22	200	0.22	220	0.22	240	0.22	260
3° 00'	1910'	0.25	100	0.24	125	0.23	150	0.23	175	0.24	200	0.24	220	0.24	240	0.24	260
3° 30'	1627'	0.28	100	0.27	125	0.26	150	0.26	175	0.27	200	0.27	220	0.27	240	0.27	260
4° 00'	1422'	0.32	100	0.31	125	0.30	150	0.30	175	0.31	200	0.31	220	0.31	240	0.31	260
5° 00'	1145'	0.38	110	0.37	140	0.36	170	0.36	200	0.37	230	0.37	260	0.37	290	0.37	320
6° 00'	955'	0.43	120	0.41	150	0.40	180	0.40	210	0.41	240	0.41	270	0.41	300	0.41	330
7° 00'	811'	0.48	130	0.47	160	0.46	190	0.46	220	0.47	250	0.47	280	0.47	310	0.47	340
8° 00'	718'	0.52	140	0.51	170	0.50	200	0.50	230	0.51	260	0.51	290	0.51	320	0.51	350
9° 00'	637'	0.56	150	0.55	180	0.54	210	0.54	240	0.							

(JANUARY, 1982)
(SPECIAL FOR THIS PROJECT)


FEDERAL ROAD REGION NO	DIVISION	PROJ NO	SHEET NO	TOTAL SHEETS
VIII	COLORADO	170-3(140)	57	57

REVISIONS	

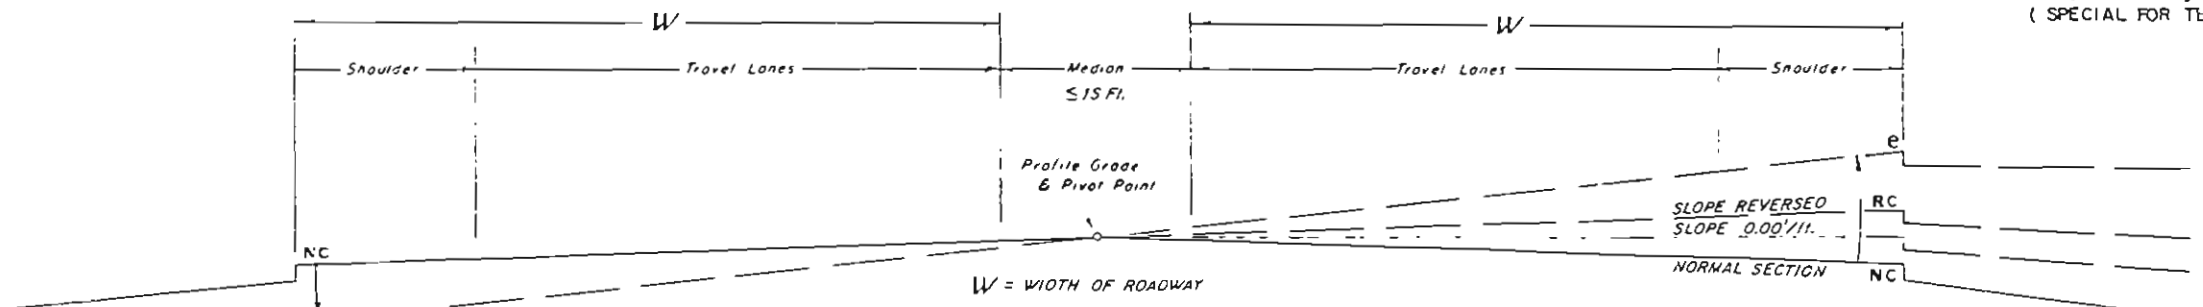


NOTE: THE SUPERELEVATION PIVOT POINT WILL BE LOCATED AS SHOWN ON THE TYPICAL SECTIONS ON THE PLANS.


* RUNOUT LENGTH SHOULD USUALLY BE $.015L/e$. WHEN CONDITIONS ARE SUCH THAT THIS LENGTH IS NOT SUITABLE, THE DESIGNER SHALL CHOOSE ANOTHER LENGTH TO SUIT CONDITIONS.

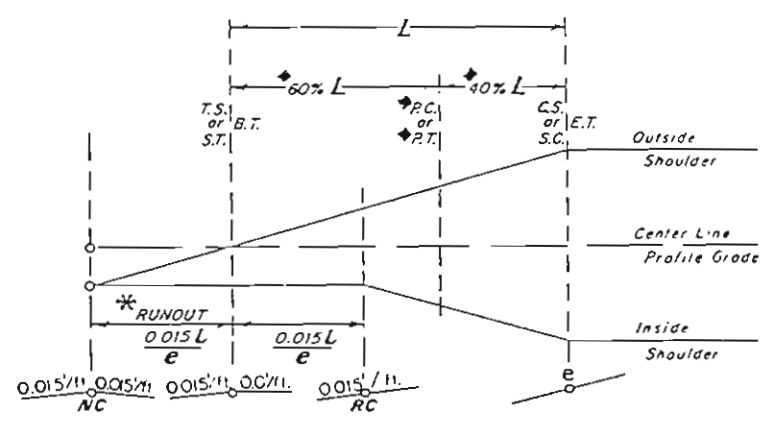

o = PIVOT
 ◆ - WHEN CURVE IS NOT SPIRALLED.
 e = Maximum rate of superlevation in feet (per foot of width) for the given degree of curve and design speed.

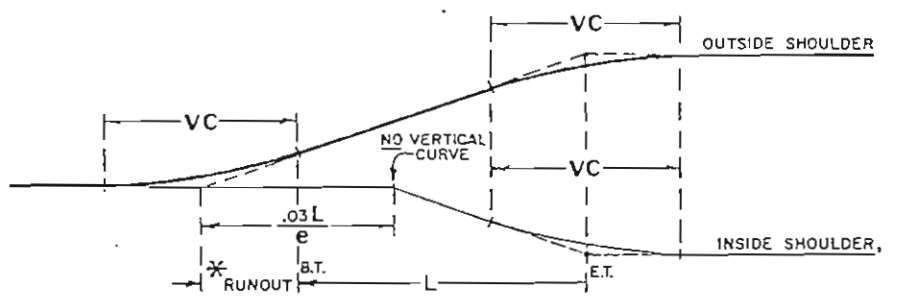

VC - TO OBTAIN SMOOTH PROFILES ON PAVEMENT EDGES, VERTICAL CURVES MAY BE INSERTED AT THE ANGULAR BREAK POINTS AT THE ENDS OF RUNOUT AND RUNOFF. UNLESS RESTRAINING CONDITIONS EXIST, THE LENGTH OF VERTICAL CURVE SELECTED, IN FEET, SHOULD BE NO LESS THAN NUMERICALLY EQUAL TO THE DESIGN SPEED, AND NO MORE THAN $.03L/e$.

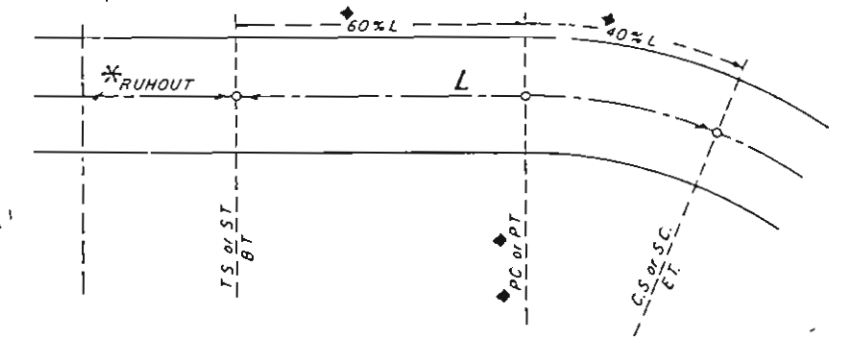

SUPERELEVATION RATES

VALUES FOR DESIGN ELEMENTS RELATED TO DESIGN SPEED AND HORIZONTAL CURVATURE FOR A FOUR LANE DIVIDED HIGHWAY WITH CENTER PIVOT POINT AND NARROW MEDIAN.

Use in Mountainous Areas and Areas where Icing Conditions Frequently Exist

Use in Rolling Areas and Areas where Icing Conditions Occasionally Exist

Use in Plains Areas and Areas where Icing Conditions Seldom Exist or Where Roadways are Well Sanded during Icing Conditions

D	R	V=30 MPH		V=40 MPH		V=50 MPH		V=60 MPH		V=70 MPH		V=75 MPH		V=80 MPH		
		e	L-Feet	e	L-Feet	e	L-Feet	e	L-Feet	e	L-Feet	e	L-Feet	e	L-Feet	
0° 15'	22918'	NC	0	NC	0	NC	0	NC	0	NC	0	NC	0	NC	240	
0° 30'	11459'	NC	0	NC	0	NC	0	NC	0	NC	0	NC	0	NC	240	
0° 45'	7639'	NC	0	NC	0	NC	0.22	175	0.21	190	0.20	200	0.18	220	0.16	240
1° 00'	5730'	NC	0	NC	0.21	150	0.20	175	0.18	190	0.17	200	0.15	220	0.14	240
1° 30'	3820'	RC	100	0.21	125	0.20	150	0.18	175	0.16	200	0.15	210	0.13	230	
2° 00'	2865'	RC	100	0.22	125	0.18	150	0.15	210	0.13	250	0.12	290	0.10	340	
2° 30'	2292'	0.21	100	0.23	125	0.18	170	0.16	210	0.14	250	0.13	270	0.11	300	
3° 00'	1910'	0.25	100	0.28	125	0.23	150	0.17	170	0.14	210	0.13	230	0.10	260	
3° 30'	1637'	0.25	100	0.42	140	0.23	210	0.17	310	0.14	440	0.13	480	0.10	540	
4° 00'	1432'	0.32	100	0.47	150	0.23	230	0.17	310	0.14	440	0.13	480	0.10	540	
5° 00'	1146'	0.35	100	0.55	170	0.21	260	0.16	370	0.13	500	0.12	540	0.09	600	
6° 00'	955'	0.43	120	0.63	190	0.17	280	0.14	420	0.11	540	0.10	580	0.08	640	
7° 00'	819'	0.48	130	0.67	210	0.17	280	0.14	420	0.11	540	0.10	580	0.08	640	
8° 00'	716'	0.52	140	0.71	220	0.16	290	0.13	430	0.11	540	0.10	580	0.08	640	
9° 00'	637'	0.56	150	0.75	240	0.15	300	0.12	440	0.10	540	0.09	580	0.07	640	
10° 00'	573'	0.59	160	0.77	240	0.14	310	0.11	450	0.09	540	0.08	580	0.07	640	
11° 00'	521'	0.63	170	0.79	250	0.13	320	0.10	460	0.09	540	0.08	580	0.07	640	
12° 00'	477'	0.65	180	0.80	250	0.12	330	0.09	470	0.08	540	0.07	580	0.06	640	
13° 00'	441'	0.68	190	0.80	250	0.11	340	0.08	480	0.07	540	0.06	580	0.05	640	
14° 00'	404'	0.70	190	0.81	250	0.10	350	0.08	490	0.07	540	0.06	580	0.05	640	
16° 00'	358'	0.74	200	0.82	250	0.09	360	0.07	500	0.06	540	0.05	580	0.04	640	
18° 00'	318'	0.77	210	0.83	250	0.08	370	0.06	510	0.05	540	0.04	580	0.03	640	
20° 00'	286'	0.79	210	0.84	250	0.07	380	0.05	520	0.04	540	0.03	580	0.02	640	
22° 00'	260'	0.80	210	0.85	250	0.06	390	0.04	530	0.03	540	0.02	580	0.01	640	
24° 00'	239'	0.80	210	0.86	250	0.05	400	0.03	540	0.02	540	0.01	580	0.01	640	

$e_{max} = 0.08$

D	R	V=30 MPH		V=40 MPH		V=50 MPH		V=60 MPH		V=70 MPH		V=75 MPH		V=80 MPH		
		e	L-Feet	e	L-Feet	e	L-Feet	e	L-Feet	e	L-Feet	e	L-Feet	e	L-Feet	
0° 15'	22918'	NC	0	NC	0	NC	0	NC	0	NC	0	NC	0	NC	240	
0° 30'	11459'	NC	0	NC	0	NC	0	NC	0	NC	0	NC	0	NC	240	
0° 45'	7639'	NC	0	NC	0	NC	0.14	175	0.13	190	0.12	200	0.10	220	0.08	240
1° 00'	5730'	NC	0	NC	0.13	150	0.12	175	0.11	190	0.10	200	0.08	220	0.07	240
1° 30'	3820'	RC	100	0.21	125	0.16	150	0.14	190	0.12	220	0.10	240	0.08	260	
2° 00'	2865'	RC	100	0.28	125	0.16	150	0.14	190	0.12	220	0.10	240	0.08	260	
2° 30'	2292'	0.21	100	0.34	125	0.16	180	0.14	200	0.12	230	0.10	250	0.08	270	
3° 00'	1910'	0.25	100	0.40	125	0.16	190	0.14	210	0.12	240	0.10	260	0.08	280	
3° 30'	1637'	0.25	100	0.46	140	0.16	210	0.14	230	0.12	260	0.10	280	0.08	300	
4° 00'	1432'	0.33	100	0.51	160	0.16	230	0.14	250	0.12	280	0.10	300	0.08	320	
5° 00'	1146'	0.36	110	0.57	180	0.15	260	0.13	300	0.11	330	0.09	350	0.07	370	
6° 00'	955'	0.44	120	0.70	200	0.14	290	0.11	340	0.09	370	0.07	390	0.05	410	
7° 00'	819'	0.49	130	0.77	210	0.14	290	0.11	340	0.09	370	0.07	390	0.05	410	
8° 00'	716'	0.53	140	0.81	220	0.13	300	0.10	350	0.08	380	0.06	400	0.04	420	
9° 00'	637'	0.57	150	0.85	230	0.12	310	0.09	360	0.07	390	0.05	410	0.04	420	
10° 00'	573'	0.60	160	0.86	230	0.11	320	0.08	370	0.06	400	0.04	420	0.03	430	
11° 00'	521'	0.64	170	0.87	230	0.10	330	0.07	380	0.05	410	0.04	420	0.03	430	
12° 00'	477'	0.67	180	0.88	230	0.09	340	0.06	390	0.04	420	0.03	430	0.02	430	
13° 00'	441'	0.70	190	0.89	230	0.08	350	0.05	400	0.03	430	0.02	430	0.01	430	
14° 00'	404'	0.73	200	0.90	230	0.07	360	0.04	410	0.02	430	0.01	430	0.01	430	
16° 00'	358'	0.77	210	0.91	230	0.06	370	0.03	420	0.01	430	0.01	430	0.01	430	
18° 00'	318'	0.80	220	0.92	230	0.05	380	0.02	430	0.01	430	0.01	430	0.01	430	
20° 00'	286'	0.82	220	0.93	230	0.04	390	0.01	430	0.01	430	0.01	430	0.01	430	
22° 00'	260'	0.83	220	0.94	230	0.03	400	0.01	430	0.01	430	0.01	430	0.01	430	
24° 00'	239'	0.84	220	0.95	230	0.02	410	0.01	430	0.01	430	0.01	430	0.01	430	

$e_{max} = 0.10$





D	R	V=30 MPH		V=40 MPH		V=50 MPH		V=60 MPH		V=70 MPH		V=75 MPH		V=80 MPH		
		e	L-Feet	e	L-Feet	e	L-Feet	e	L-Feet	e	L-Feet	e	L-Feet	e	L-Feet	
0° 15'	22918'	NC	0	NC	0	NC	0	NC	0	NC	0	NC	0	NC	240	
0° 30'	11459'	NC	0	NC	0	NC	0	NC	0	NC	0	NC	0	NC	240	
0° 45'	7639'	NC	0	NC	0	NC	0.08	175	0.07	190	0.06	200	0.05	220	0.04	240
1° 00'	5730'	NC	0	NC	0.07	150	0.06	175	0.05	190	0.04	200	0.03	220	0.02	240
1° 30'	3820'	RC	100	0.22	125	0.08	150	0.07	175	0.06	190	0.05	200	0.04	220	
2° 00'	2865'	RC	100	0.30	125	0.08	160	0.07	180	0.06	200	0.05	210	0.04	230	
2° 30'	2292'	0.22	100	0.37	125	0.08	170	0.07	190	0.06	210	0.05	220	0.04	240	
3° 00'	1910'	0.26	100	0.44	125	0.08	180	0.07	200	0.06	220	0.05	230	0.04	250	
3° 30'	1637'	0.26	100	0.50	140	0.08	200	0.07	220	0.06	240	0.05	260	0.04	280	
4° 00'	1432'	0.34	100	0.57	160	0.08	220	0.07	240	0.06	260	0.05	280	0.04	300	
5° 00'	1146'	0.38	110	0.64	180	0.07	250	0.06	270	0.05	290	0.04	310	0.03	330	
6° 00'	955'	0.46	120	0.78	200	0.06	280	0.05	300	0.04	320	0.03	340	0.02	360	
7° 00'	819'	0.51	130	0.85	210	0.06	280	0.04	310	0.03	330	0.02	350	0.01	370	
8° 00'	716'	0.55	140	0.89	220	0.05	290	0.04	320	0.03	340	0.02	360	0.01	380	
9° 00'	637'	0.59	150	0.93	230	0.04	300	0.03	330	0.02	350	0.01	370	0.01	390	
10° 00'	573'	0.62	160	0.94	230	0.03	310	0.02	340	0.01	360	0.01	380	0.01	400	
11° 00'	521'	0.66	170	0.95	230	0.02	320	0.01	350	0.01	370	0.01	390	0.01	410	
12° 00'	477'	0.69	180	0.96	230	0.01	330	0.01	360	0.01	380	0.01	400	0.01	420	
13° 00'	441'	0.72	190	0.97	230	0.01	340	0.01	370	0.01	390	0.01	410	0.01	430	
14° 00'	404'	0.75	200	0.98	230	0.01	350	0.01	380	0.01	400	0.01	420	0.01	440	
16° 00'	358'	0.79	210	0.99	230	0.01	360	0.01								

DETAILS FOR CAST IN PLACE CONCRETE BARRIER STANDARD M-606-12

(SHEET 1 OF 9)

FEDERAL ROAD REGION NO	DIVISION	PROJ. NO.	SHEET NO	TOTAL SHEETS
VIII	COLORADO			

REVISIONS	

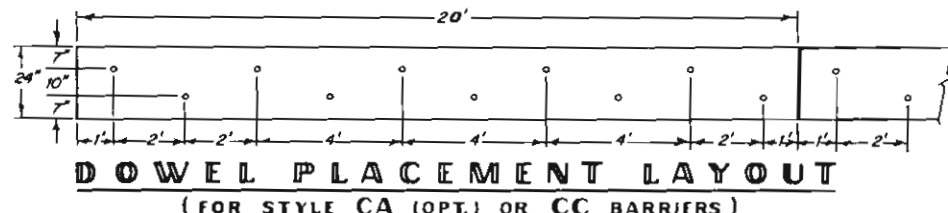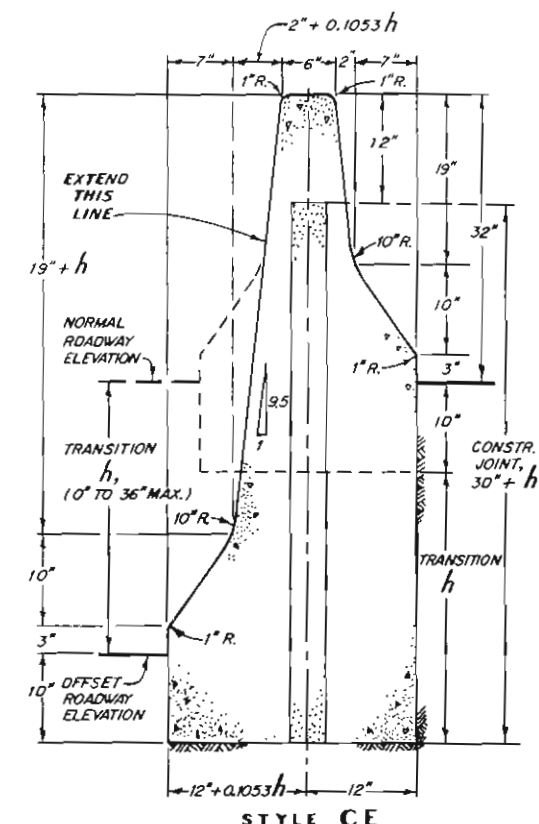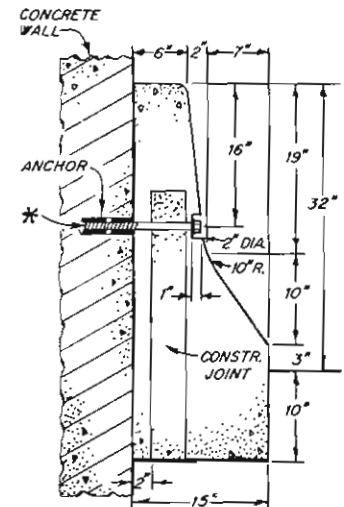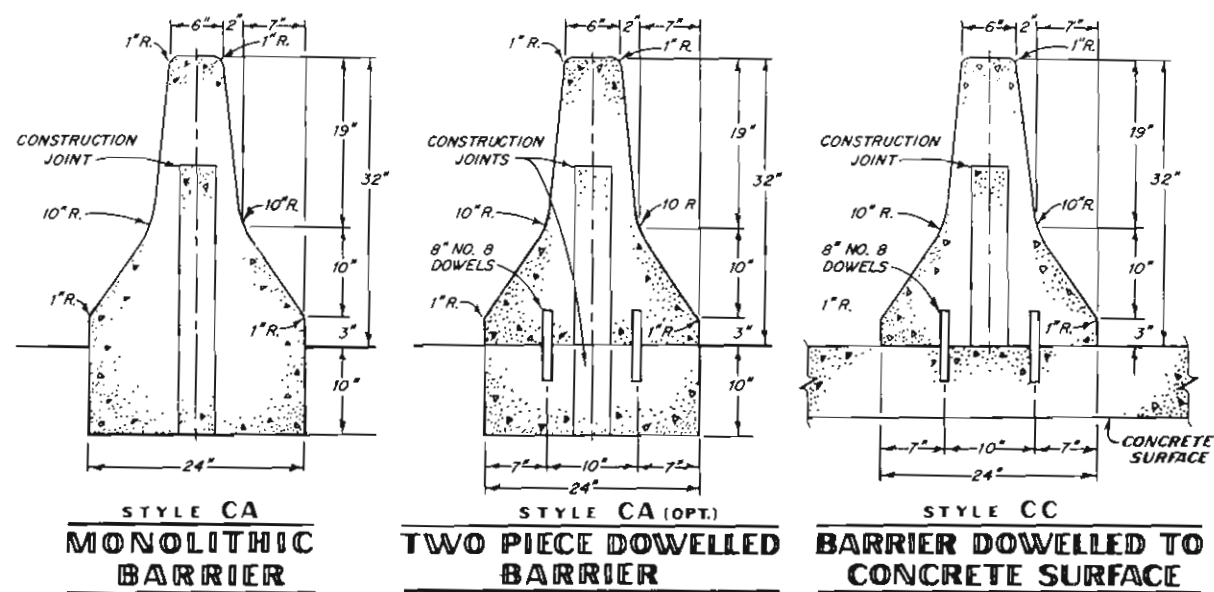

STYLE CD BARRIER AGAINST WALL

* 3/4" DIA. x 12" LONG GALVANIZED ANCHOR BOLT AND WASHER, MECHANICALLY FASTENED AT 2'-6" CTRS.; USE ONLY WHEN CALLED FOR ON PLANS.

GENERAL NOTES

ALL WORK SHALL BE DONE IN ACCORDANCE WITH THE STANDARD SPECIFICATIONS APPLICABLE TO THE PROJECT.

CONCRETE SHALL BE CLASS A, B OR D.

PAVEMENT SHALL BE PATCHED ALONG THE BARRIER FOUNDATION TO MATCH EXISTING ASPHALT SURFACE.

TYPE 4 BARRIER MAY BE CAST IN PLACE OR PRECAST UNLESS A SPECIFIC STYLE OF BARRIER IS SPECIFIED ON THE PLAN.

DOWEL BARS MAY BE PLACED IN WET CONCRETE OR GROUTED IN HOLES DRILLED IN EXISTING CONCRETE.

ALL INCIDENTAL WORK AND MATERIALS SUCH AS DOWELS, GROUT, ANCHORS, BOLTS, PINS, JOINT MATERIAL, EXCAVATION FOR BASE, ETC. SHALL BE INCLUDED IN THE COST OF BARRIER.

PRECAST BARRIER:
 ALL EXPOSED LOOPS SHALL BE THOROUGHLY CLEANED AND PAINTED IN ACCORDANCE WITH SECTION 509.

NUTS, WASHERS, LIFTING HARDWARE, CONNECTING PINS, DRIFT PINS AND ANCHOR BOLTS SHALL BE GALVANIZED.

TRIANGULAR SPACE IN BASE OF BARRIER IS TYPICAL. CIRCULAR ARC OR RECTANGULAR SHAPE WILL BE PERMITTED.

DRAINAGE SLOTS MAY BE OMITTED ON:

1. MEDIAN INSTALLATION WITH INLET DRAINAGE.
2. SHOULDER BARRIER ON HIGH EDGE OF SUPERELEVATED SHOULDER.
3. MEDIAN BARRIER ON CREST VERTICAL CURVE.
4. PERMANENT BARRIER.

STYLE CE BARRIER SHALL BE CAST IN PLACE UNLESS OTHERWISE PERMITTED.


THE JOINT BETWEEN CAST IN PLACE AND PERMANENT PRECAST BARRIER SHALL INCLUDE ALL RECESSES, LOOP REBARS AND PINS TO MAKE A PROPER MATCHING JOINT.

MIXING GUARD RAIL TYPES:
 THIS STANDARD SHOWS THE DETAILS FOR VARIOUS USAGES OF GUARD RAIL, TYPE 4, CONCRETE BARRIER.

THE PLANS WILL INDICATE THE LOCATIONS ON THE PROJECT WHERE GUARD RAIL TYPES 3 OR 4 ARE REQUIRED.

WHEN GUARD RAIL, TYPE 3, W-BEAM IS TO BE USED AS AN END TREATMENT TO CONCRETE BARRIER OR AT A LOCATION SHOWN ON THE PLAN; REFER TO THE W-BEAM GUARD RAIL STANDARD FOR DETAILS.

WHEN BRIDGE RAIL IS DIFFERENT FROM ROADWAY RAIL, THE BRIDGE PLANS WILL SHOW THE CONNECTION DETAILS.

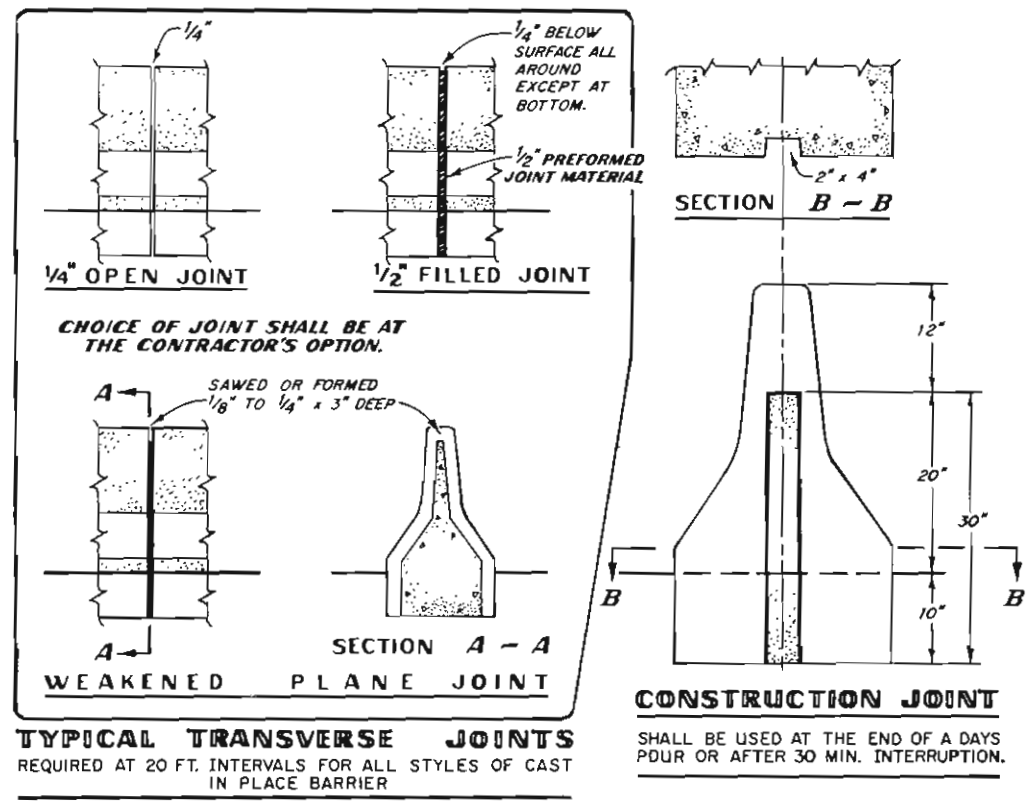

STATE DEPARTMENT OF HIGHWAYS
 DIVISION OF HIGHWAYS
 STATE OF COLORADO

GUARD RAIL~TYPE 4 CONCRETE BARRIER


APPROVED BY: *K. J. M...*
 STAFF DESIGN ENGINEER
 DATE: FEBRUARY 18, 1983

STANDARD PLAN NO.
M-606-12
 SHEET 1 OF 9

DETAILS FOR CAST IN PLACE CONCRETE BARRIER (CONT'D.)



STANDARD M-606-12
 (SHEET 2)

FEDERAL ROAD REGION NO.	DIVISION	PROJ. NO.	SHEET NO.	TOTAL SHEETS
VIII	COLORADO			
REVISIONS				

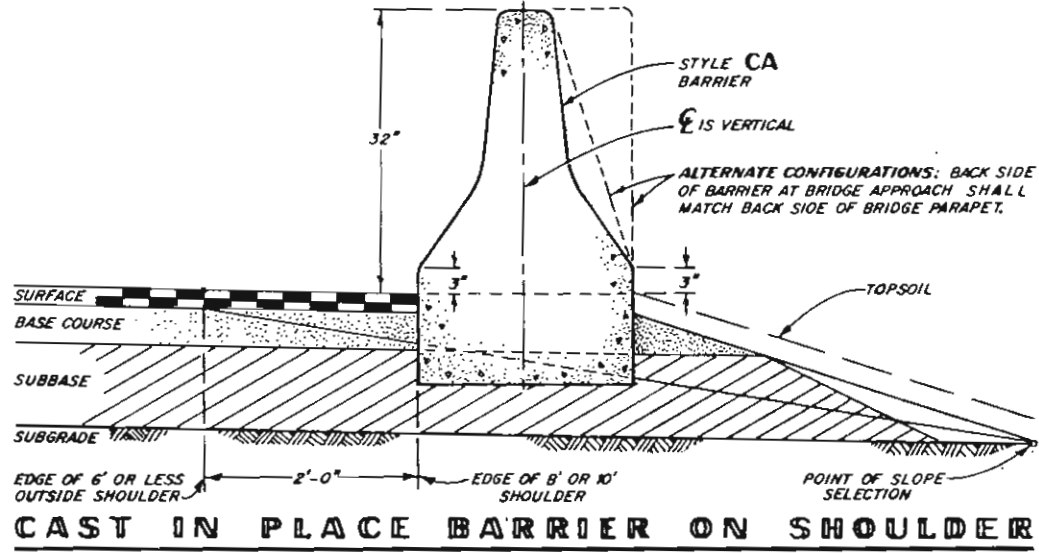


NOTE: USE 12' TRANSITION SECTION AT THE FOLLOWING LOCATIONS ONLY:

1. AT DOWNSTREAM END OF THE INSTALLATION, I.E. POINTED AWAY FROM APPROACHING TRAFFIC. (NOT TO BE USED ON 2 LANE-2 WAY ROADWAYS.)
2. AT INTERRUPTED MEDIAN CROSSOVERS. (SEE DETAIL ON SHEET B.)
3. AT LOCATIONS OUTSIDE THE "CLEAR ZONE", (GENERALLY 30' OR MORE FROM TRAVEL LANES).

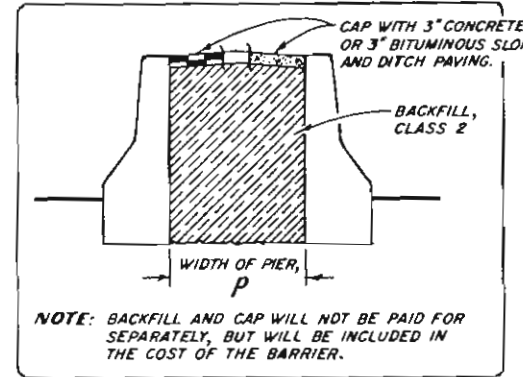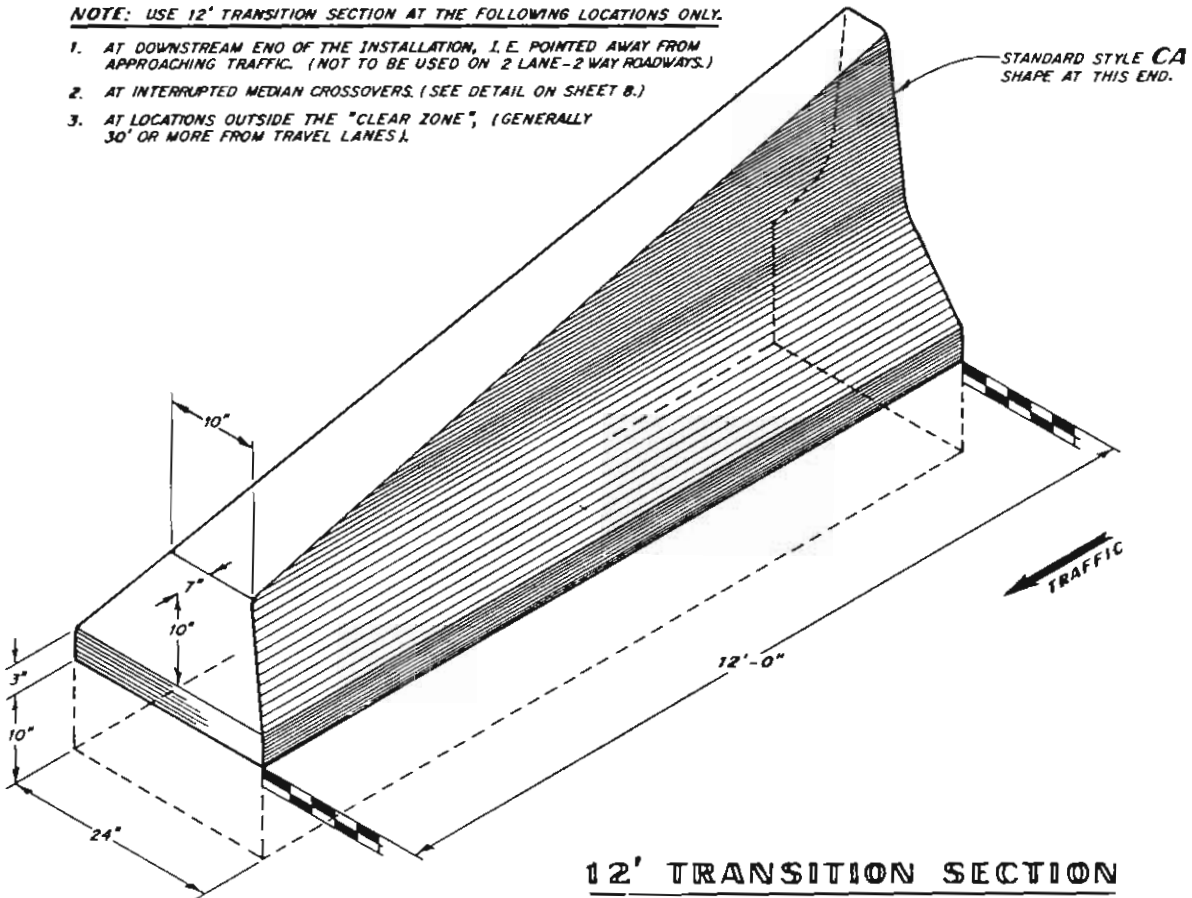

TREATMENT BETWEEN PIERS
 TYPICAL FOR BOTH DETAILS BELOW

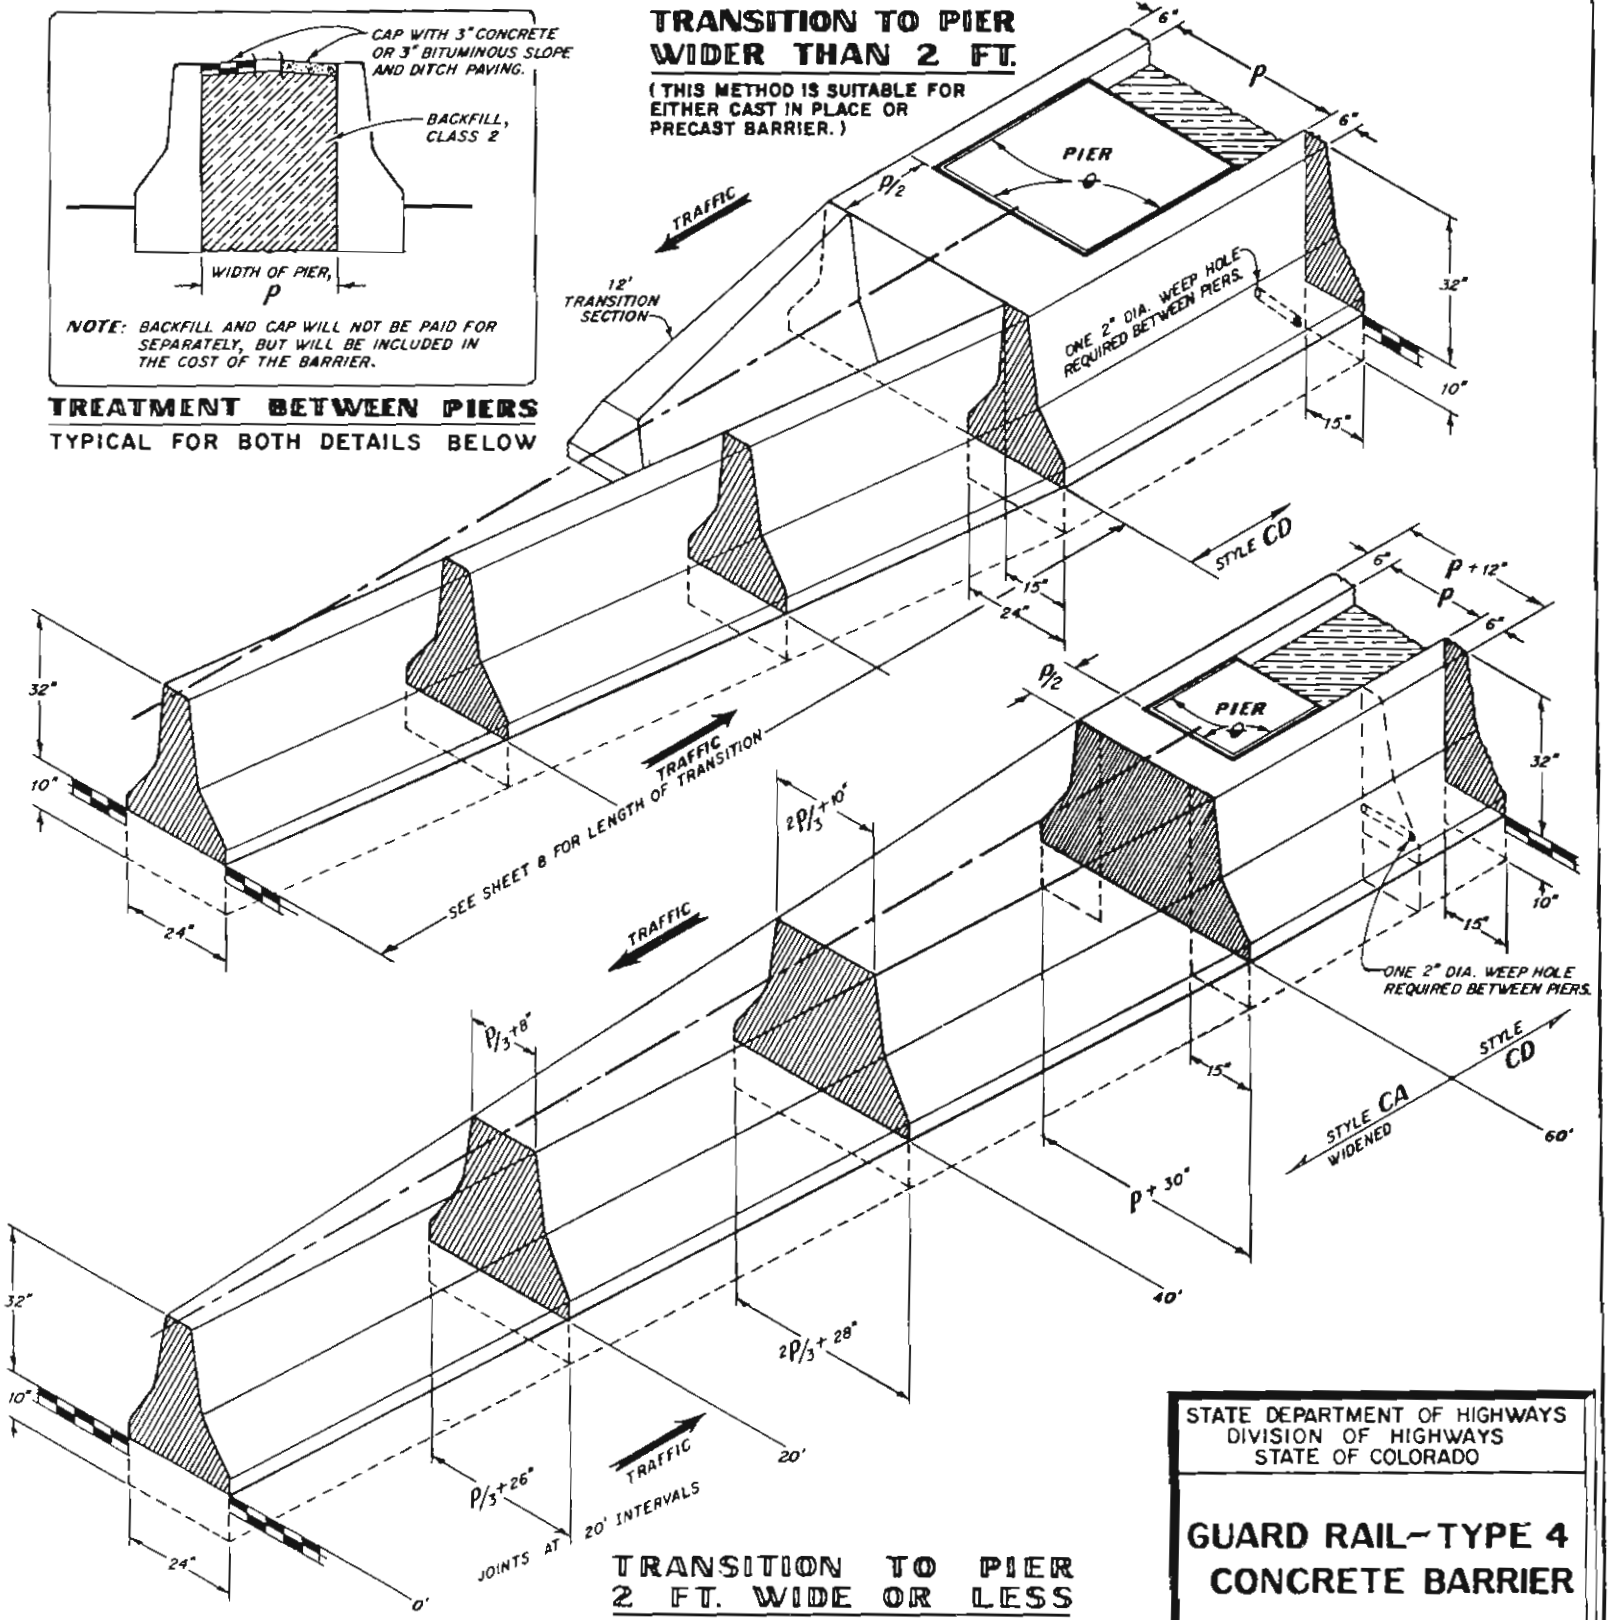

TRANSITION TO PIER
 2 FT. WIDE OR LESS

1/2" PREFORMED JOINT MATERIAL.

STATE DEPARTMENT OF HIGHWAYS
 DIVISION OF HIGHWAYS
 STATE OF COLORADO

**GUARD RAIL - TYPE 4
 CONCRETE BARRIER**

APPROVED BY:
 K. J. MAUTO
 STAFF DESIGN ENGINEER
 DATE: FEBRUARY 18, 1983

STANDARD PLAN NO.
M-606-12
 SHEET 2 OF 9


DETAILS FOR PRECAST CONCRETE BARRIER

STANDARD M - 606 - 12


(SHEET 3)

FEDERAL ROAD REGION NO.	DIVISION	PROJ. NO.	SHEET NO.	TOTAL SHEETS
VIII	COLORADO			



REVISIONS	

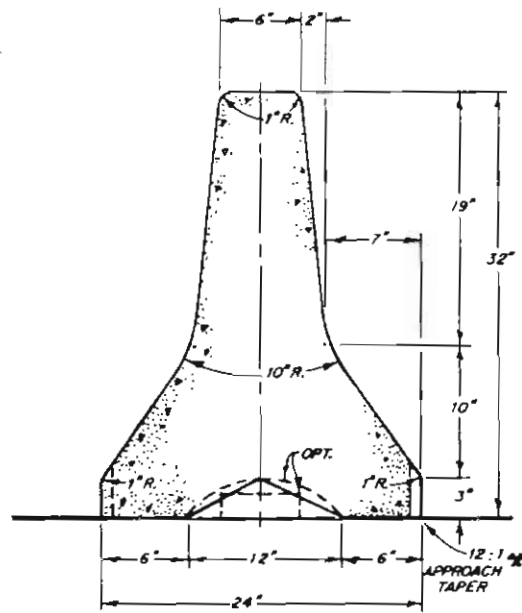


STYLE PA
PRECAST BARRIER

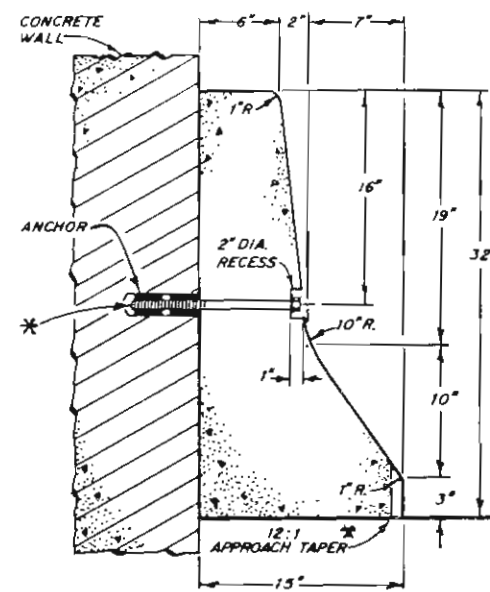


* 3/4" DIA. X 12" LONG GALVANIZED ANCHOR BOLT AND WASHER, MECHANICALLY FASTENED AT 2'-6" CTRS.; USE ONLY WHEN CALLED FOR ON PLANS.
 STYLE PD
PRECAST BARRIER AGAINST WALL

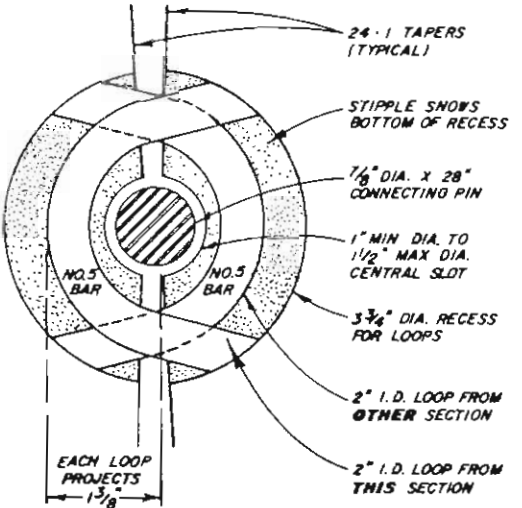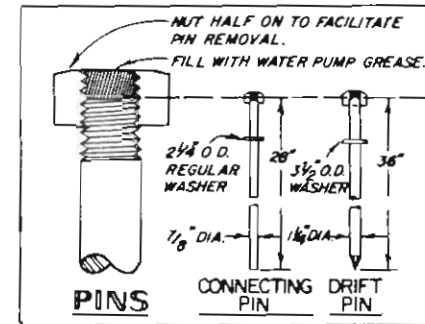


VIEW A-A
BARRIER CONNECTION
 (FOR STYLE PA OR PD)

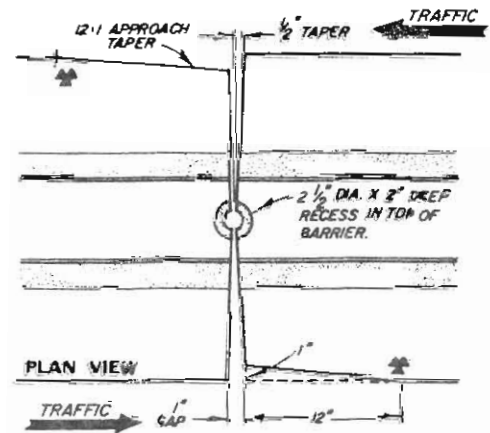


PLAN VIEW
 * A 1" IN 12" TAPER WILL BE REQUIRED AT ALL TRAFFIC APPROACH CORNERS OF PRECAST BARRIER SECTIONS TO ELIMINATE SNAGGING OF SNOW PLOW BLADE (BOTH STYLE PA AND PD BARRIERS).
JOINT IN PRECAST BARRIER.

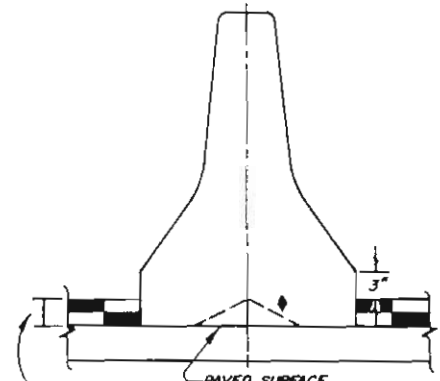


ADJACENT OVERLAY

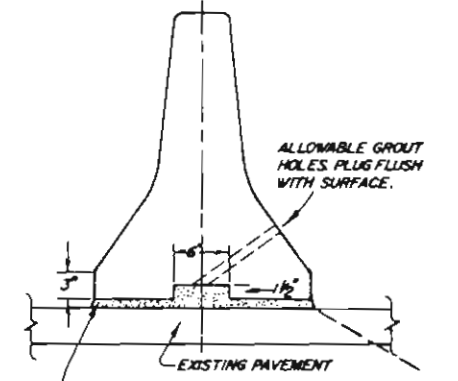


GROUT BED

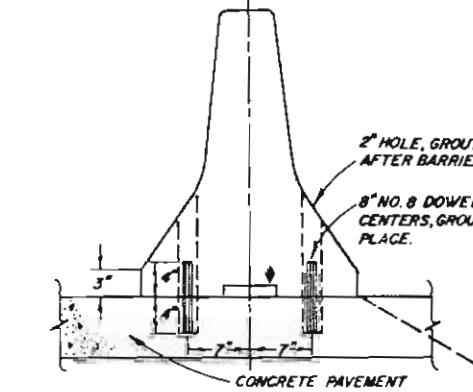

DOWELLED TO PAVEMENT

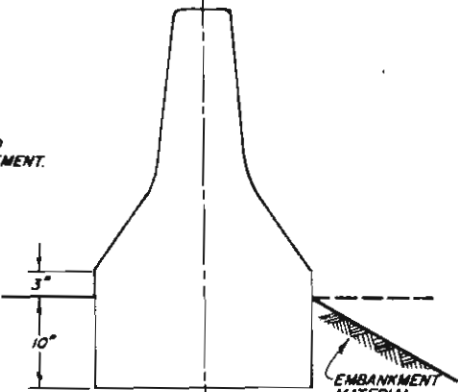

BARRIER WITH BASE

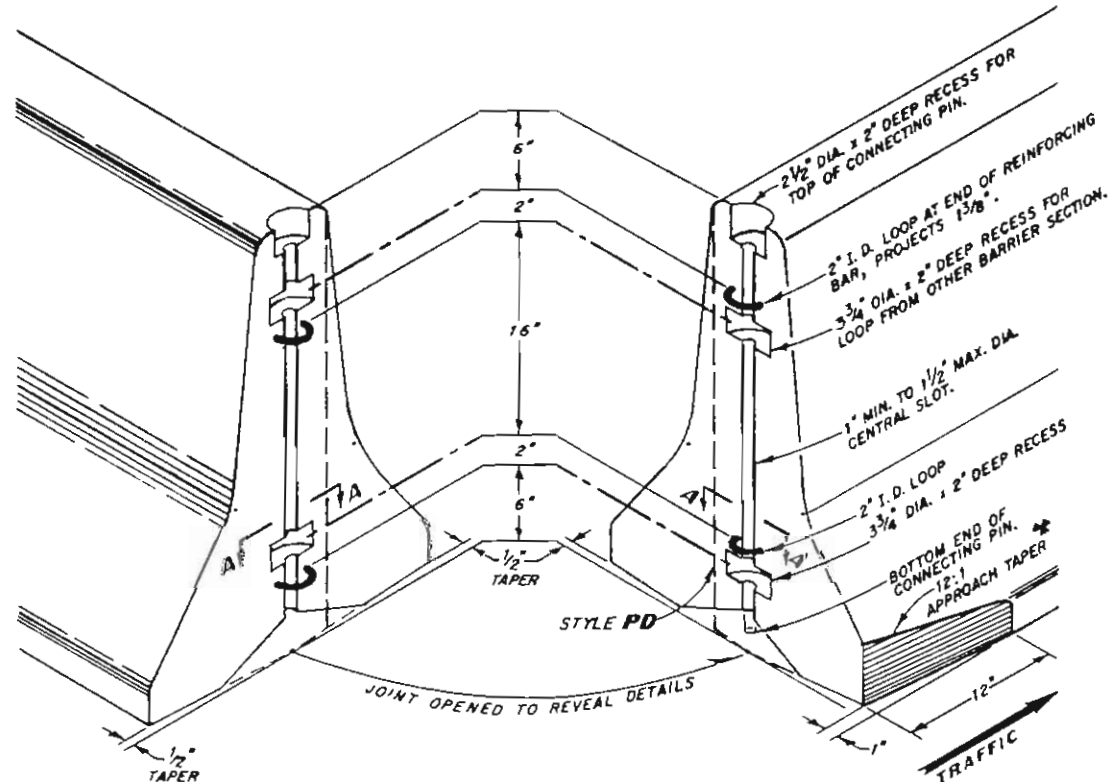

JOINT IN STYLES PA AND PD

ANCHOR DETAILS FOR PERMANENT BARRIERS

- NOTES:**
- ONE OF THE FOUR ALTERNATE ANCHOR DETAILS SHALL BE USED WHEN PRECAST BARRIER IS INSTALLED AS A PERMANENT BARRIER. STYLE PA DIMENSIONS APPLY AND THE BARRIER SHALL BE CAST WITH EXTRA FEATURES OF DOWEL HOLES, EXTRA BASE DEPTH, MODIFIED OR NO LONGITUDINAL SPACE IN BASE, ETC. AS NEEDED TO PROVIDE THE ANCHOR DETAIL TO BE CONSTRUCTED.
 - THESE ANCHOR DETAILS MAY BE USED FOR SHOULDER OR MEDIAN LOCATIONS EXCEPT THE ADJACENT OVERLAY ALTERNATE WHICH IS FOR MEDIANS ONLY.
 - THE 12:1 APPROACH TAPER ON BARRIER BOTTOM IS NOT REQUIRED ON PERMANENT BARRIERS.

STATE DEPARTMENT OF HIGHWAYS
 DIVISION OF HIGHWAYS
 STATE OF COLORADO

**GUARD RAIL - TYPE 4
 CONCRETE BARRIER**

APPROVED BY:
 K. P. M...
 STAFF DESIGN ENGINEER
 DATE: FEBRUARY 18, 1963


STANDARD PLAN NO.
M-606-12
 SHEET 3 OF 12

DETAILS FOR PRECAST CONCRETE BARRIER (CONT'D.)


STANDARD M-606-12
 (SHEET 4)

FEDERAL ROAD REGION NO.	DIVISION	PROJ. NO.	SHEET NO.	TOTAL SHEETS
VIII	COLORADO			


REVISIONS	

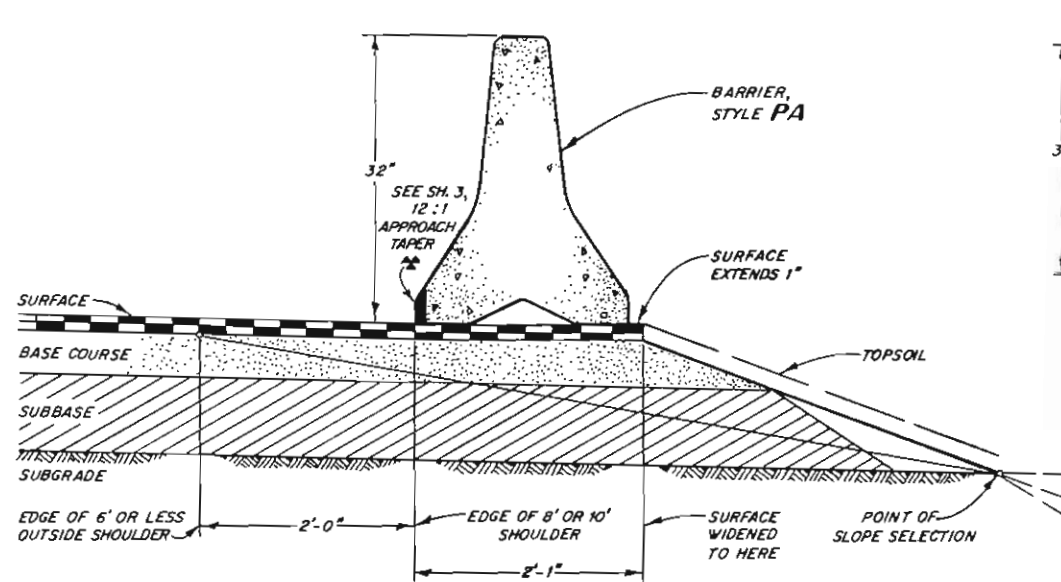


PRECAST CONCRETE BARRIER ON WIDENED SHOULDER

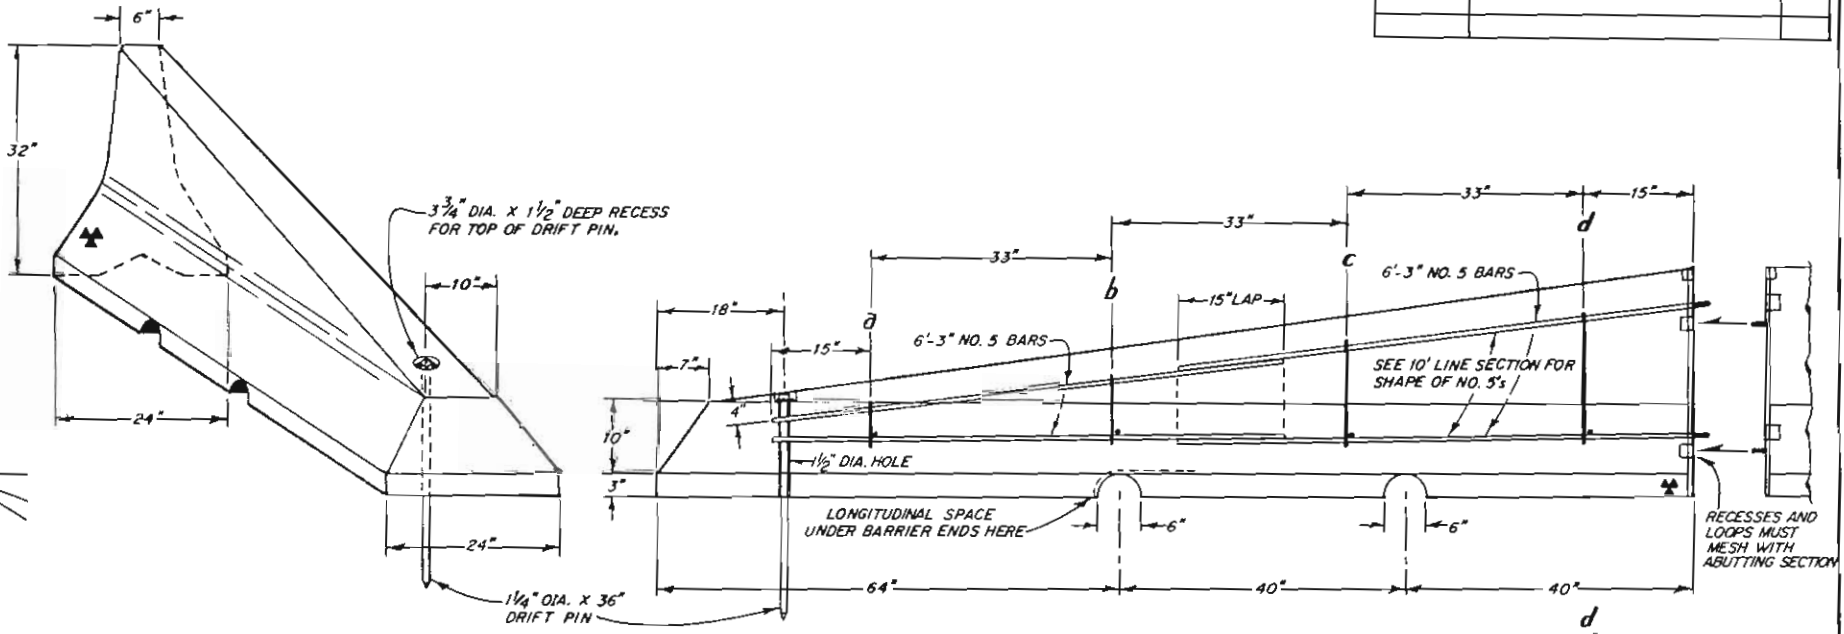


NOTES ON SHEET 2 DESCRIBING THE USES OF CAST IN PLACE 12' TRANSITION SECTION APPLY FOR PRECAST ALSO.

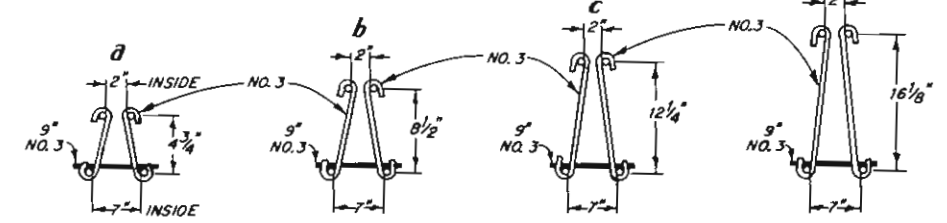

12' TRANSITION SECTION FOR STYLE PA BARRIER

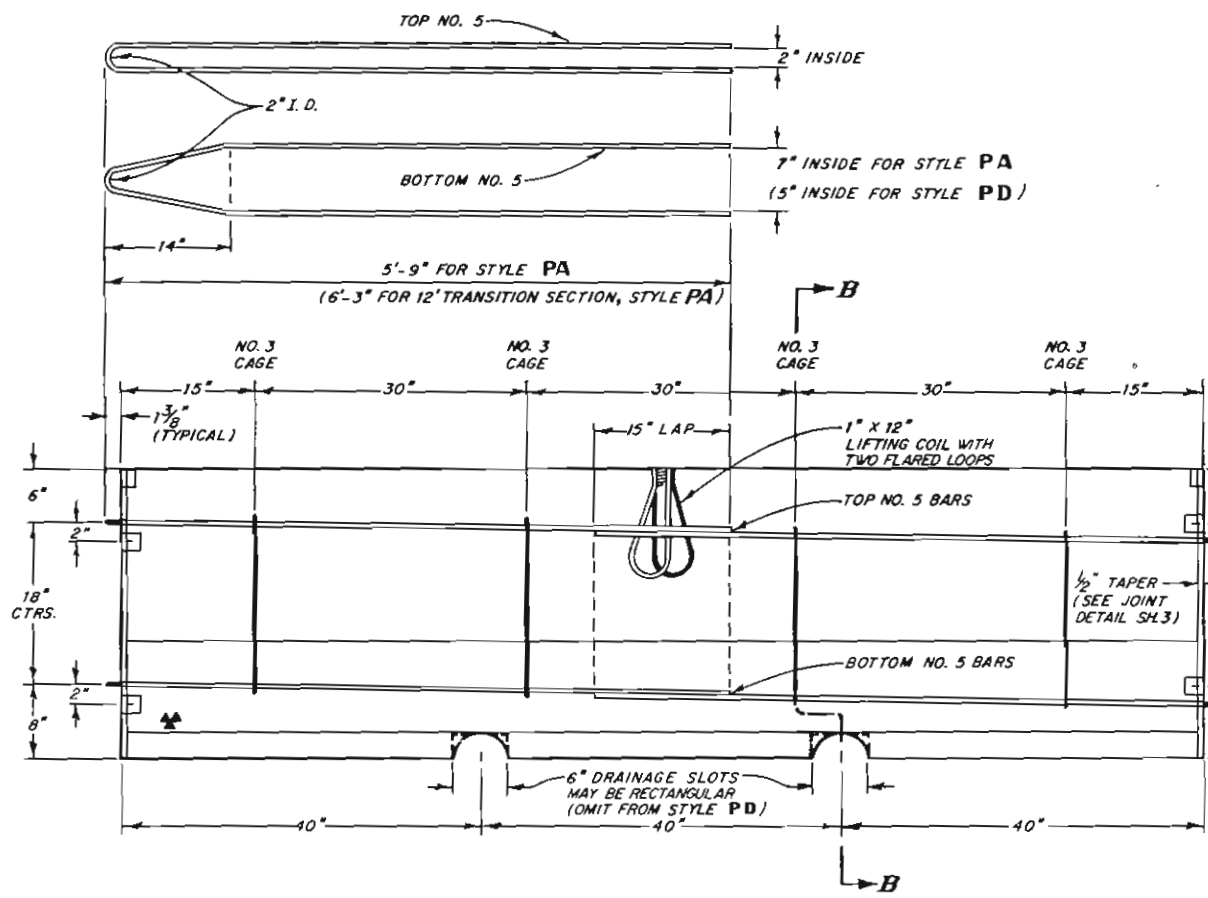

10' LINE SECTION — FOR STYLE PA OR PD

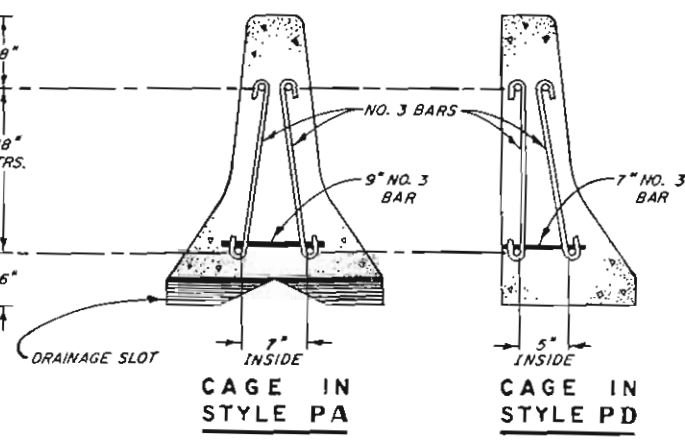

SECTIONS B - B

STATE DEPARTMENT OF HIGHWAYS
 DIVISION OF HIGHWAYS
 STATE OF COLORADO

**GUARD RAIL-TYPE 4
 CONCRETE BARRIER**

APPROVED BY: *[Signature]*
 STAFF DESIGN ENGINEER
 DATE: FEBRUARY 18, 1983





STANDARD PLAN NO
M-606-12
 SHEET 4 OF 9

STANDARD M-606-12

(SHEET 5)

FEDERAL ROAD REGION NO.	DIVISION	PROJ. NO.	SHEET NO.	TOTAL SHEETS
VIII	COLORADO			

REVISIONS	

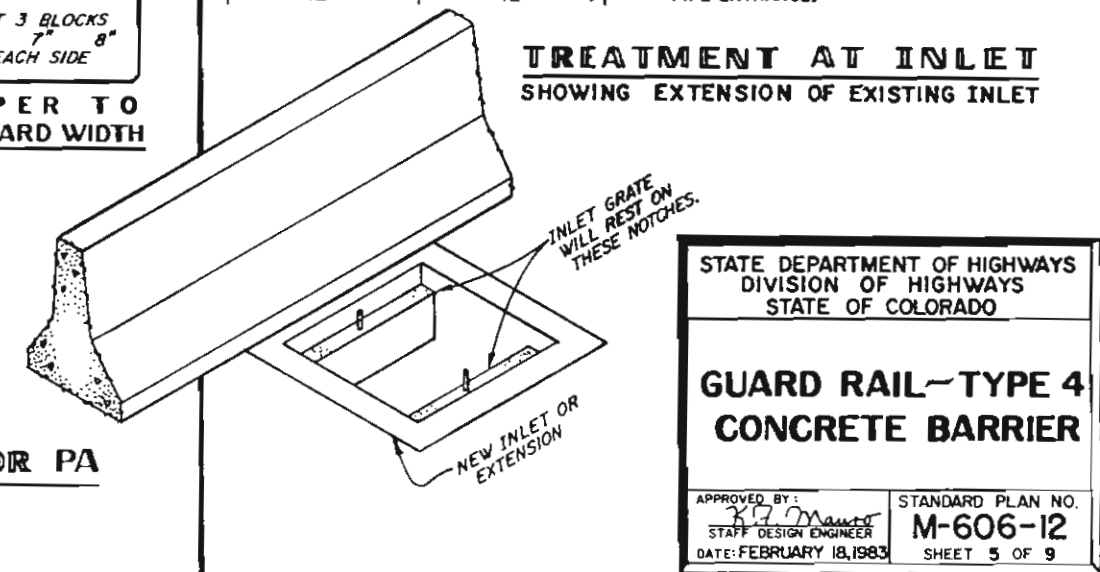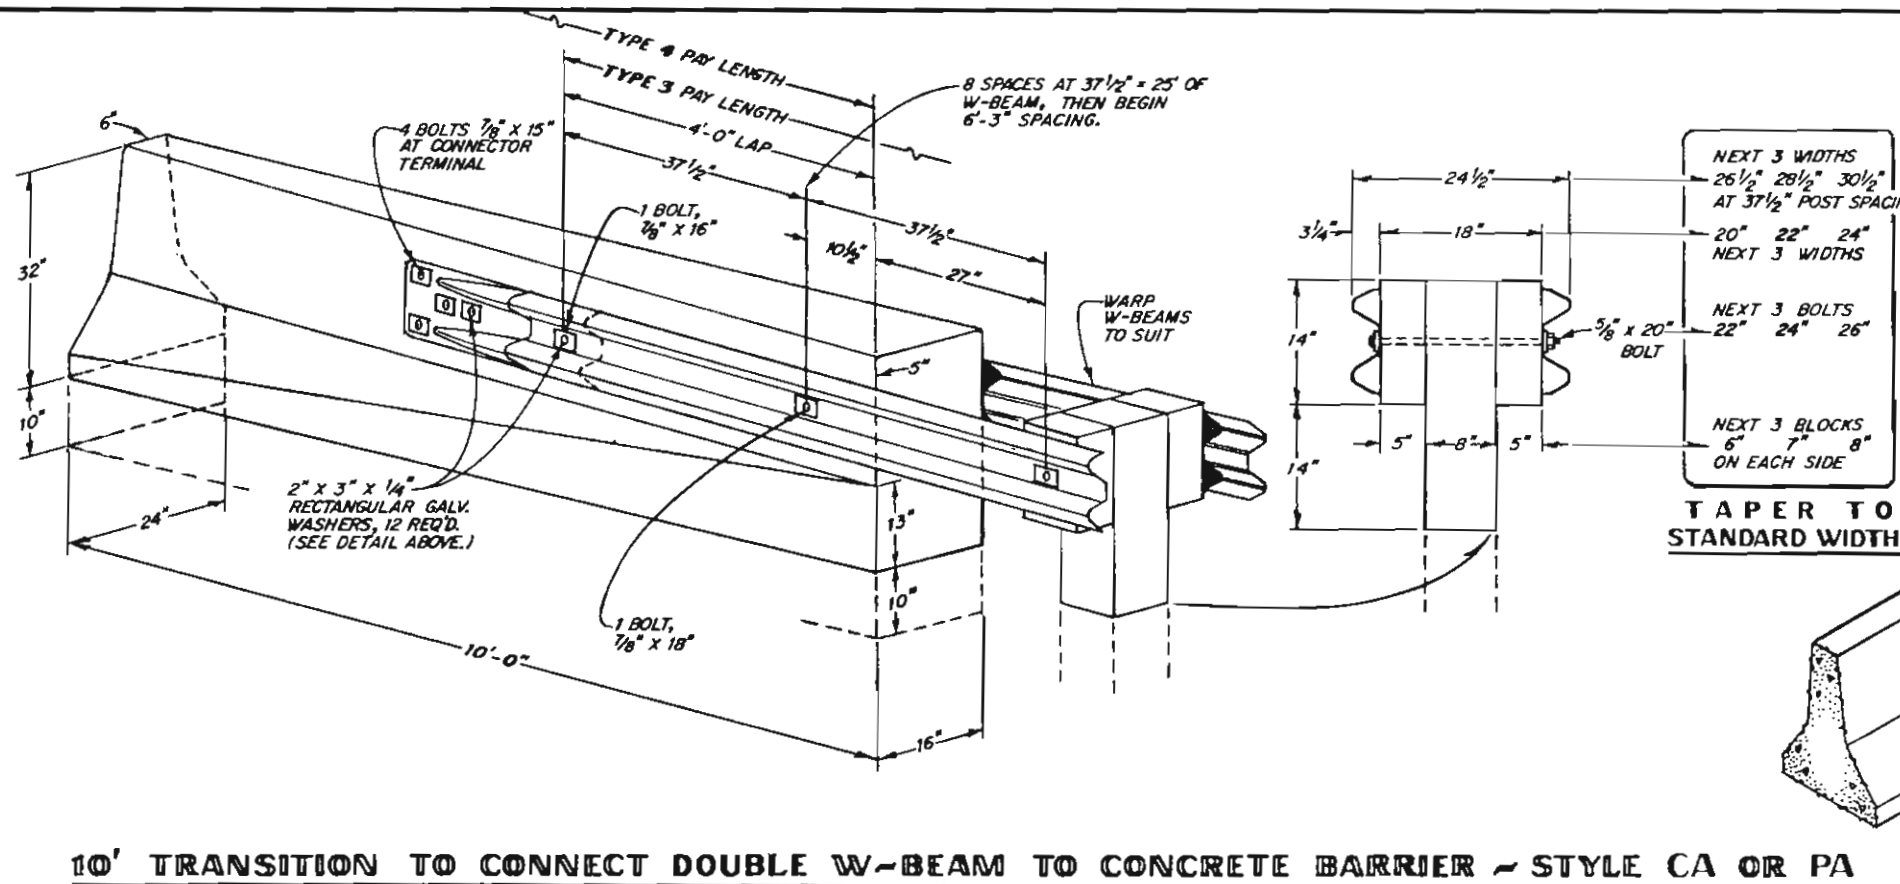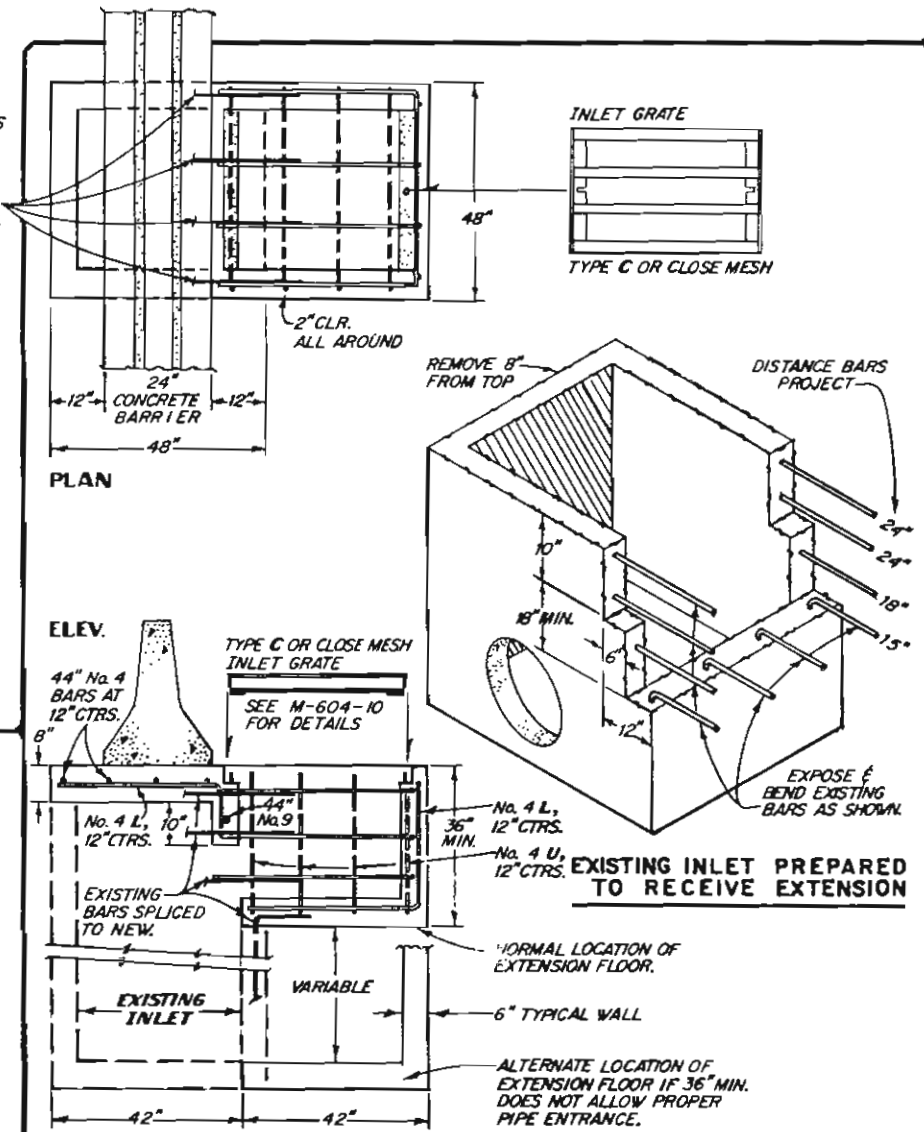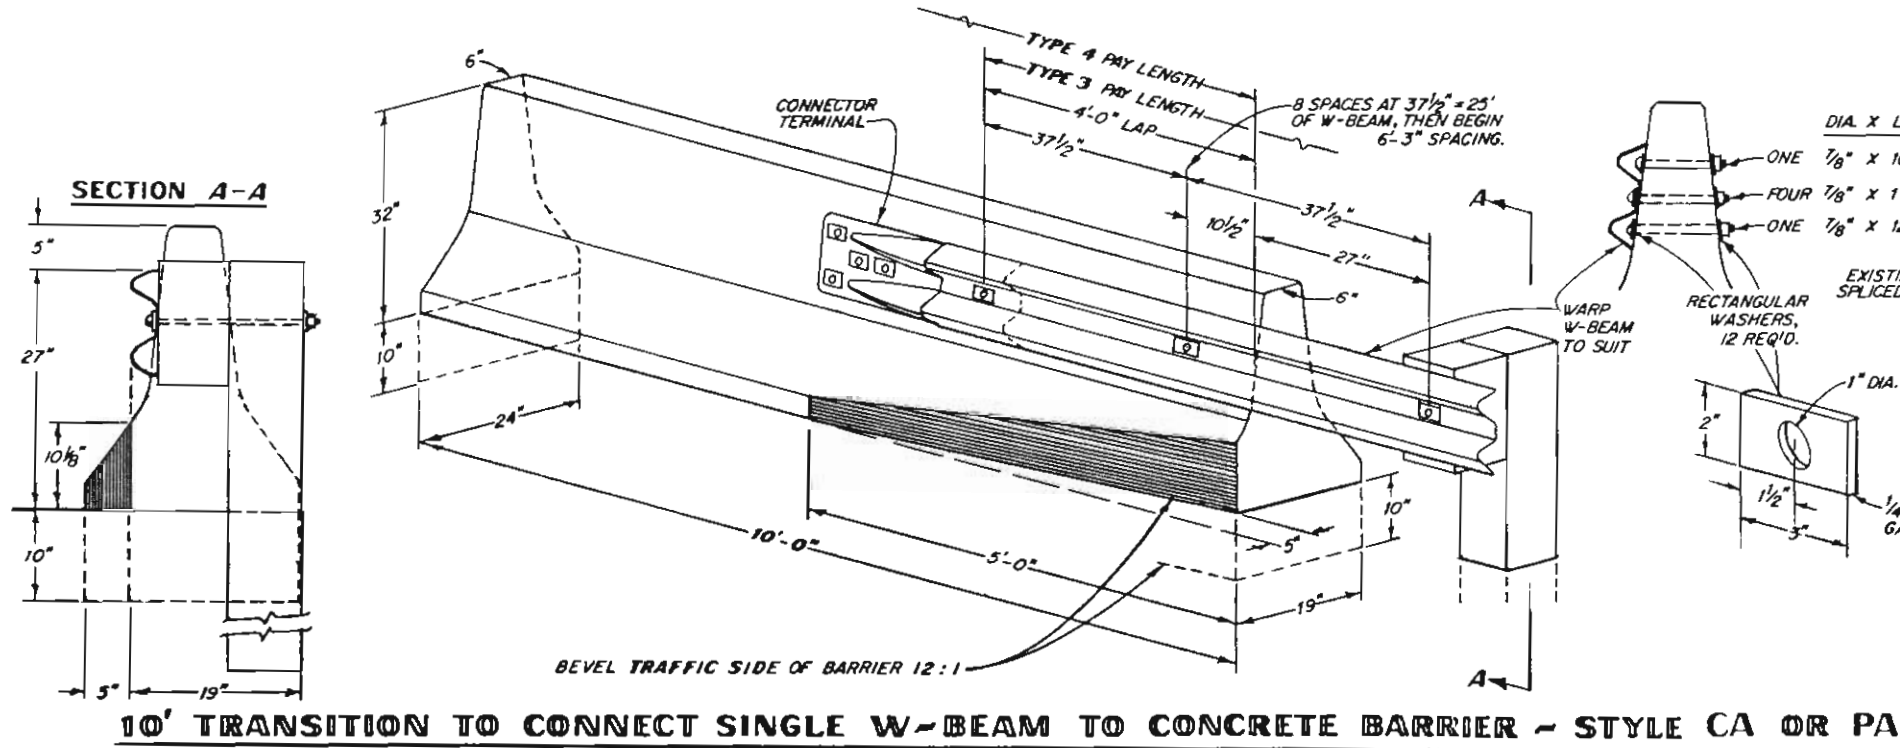

STATE DEPARTMENT OF HIGHWAYS
DIVISION OF HIGHWAYS
STATE OF COLORADO

**GUARD RAIL - TYPE 4
CONCRETE BARRIER**

APPROVED BY: *R. J. Mauer*
STAFF DESIGN ENGINEER
DATE: FEBRUARY 18, 1983


STANDARD PLAN NO.
M-606-12
SHEET 5 OF 9

STANDARD M-606-12


(SHEET 6)

FEDERAL ROAD REGION NO.	DIVISION	PROJ. NO.	SHEET NO.	TOTAL SHEETS
VIII	COLORADO			

REVISIONS	

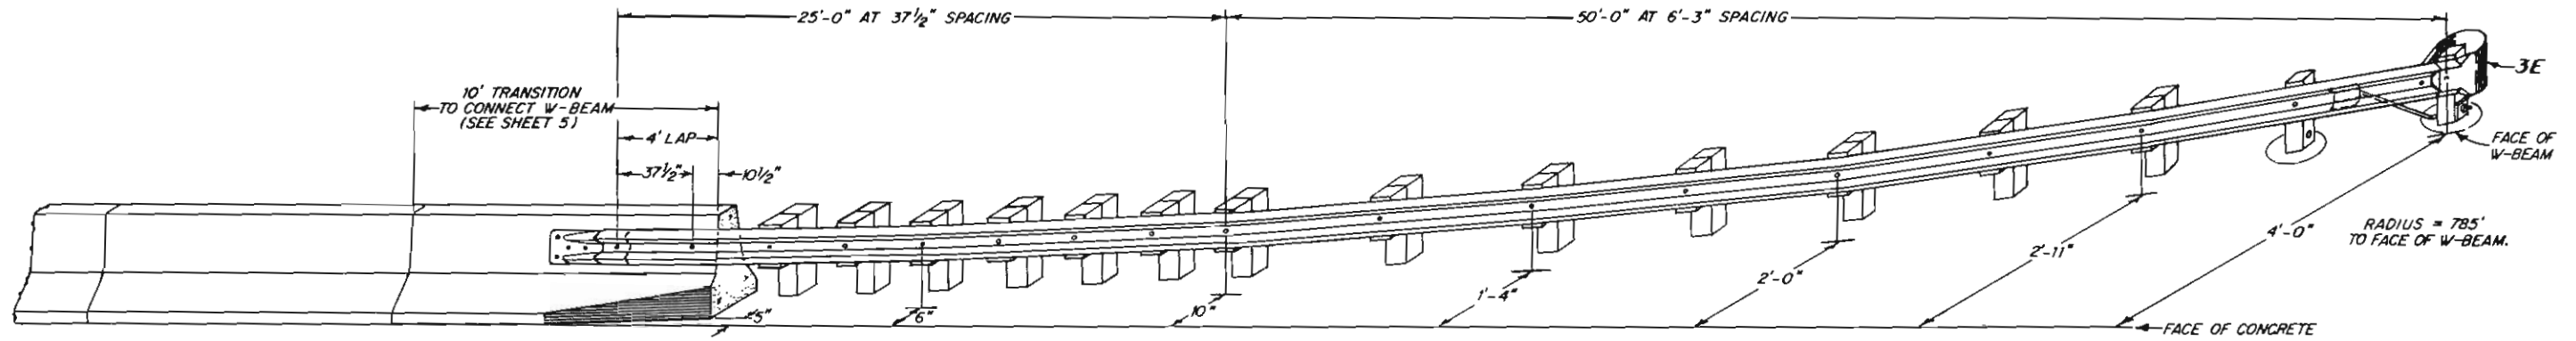

CONCRETE BARRIER WITH TYPE 3 FLARE

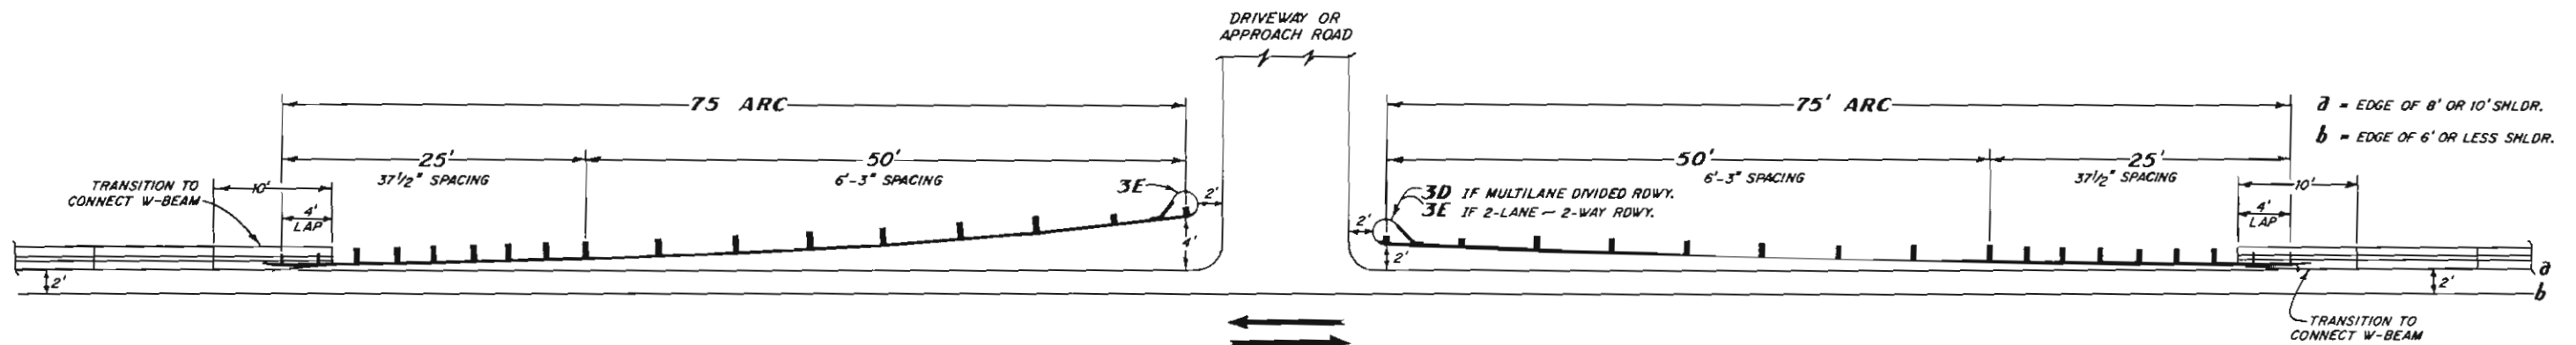

LAYOUT FOR INTERRUPTED SHOULDER BARRIER

STATE DEPARTMENT OF HIGHWAYS
 DIVISION OF HIGHWAYS
 STATE OF COLORADO

**GUARD RAIL - TYPE 4
 CONCRETE BARRIER**

APPROVED BY:
K. J. Mauer
 STAFF DESIGN ENGINEER
 DATE: FEBRUARY 18, 1983

STANDARD PLAN NO.
M-606-12
 SHEET 6 OF 9

MULTILANE DIVIDED HIGHWAYS
 (DEPRESSED MEDIAN)


STANDARD M - 606 - 12
 (SHEET 7)

FEDERAL ROAD REGION NO.	DIVISION	PROJ. NO.	SHEET NO.	TOTAL SHEETS
VIII	COLORADO			

REVISIONS	

21' to 30' MEDIANS


		21	22	23	24	25	26	27	28	29	30
M		170	120	130	140	150	160	170	180	190	200
S	4' SHLDR.	170	120	130	140	150	160	170	180	190	200
	8' SHLDR.	30	40	50	60	70	80	90	100	110	120

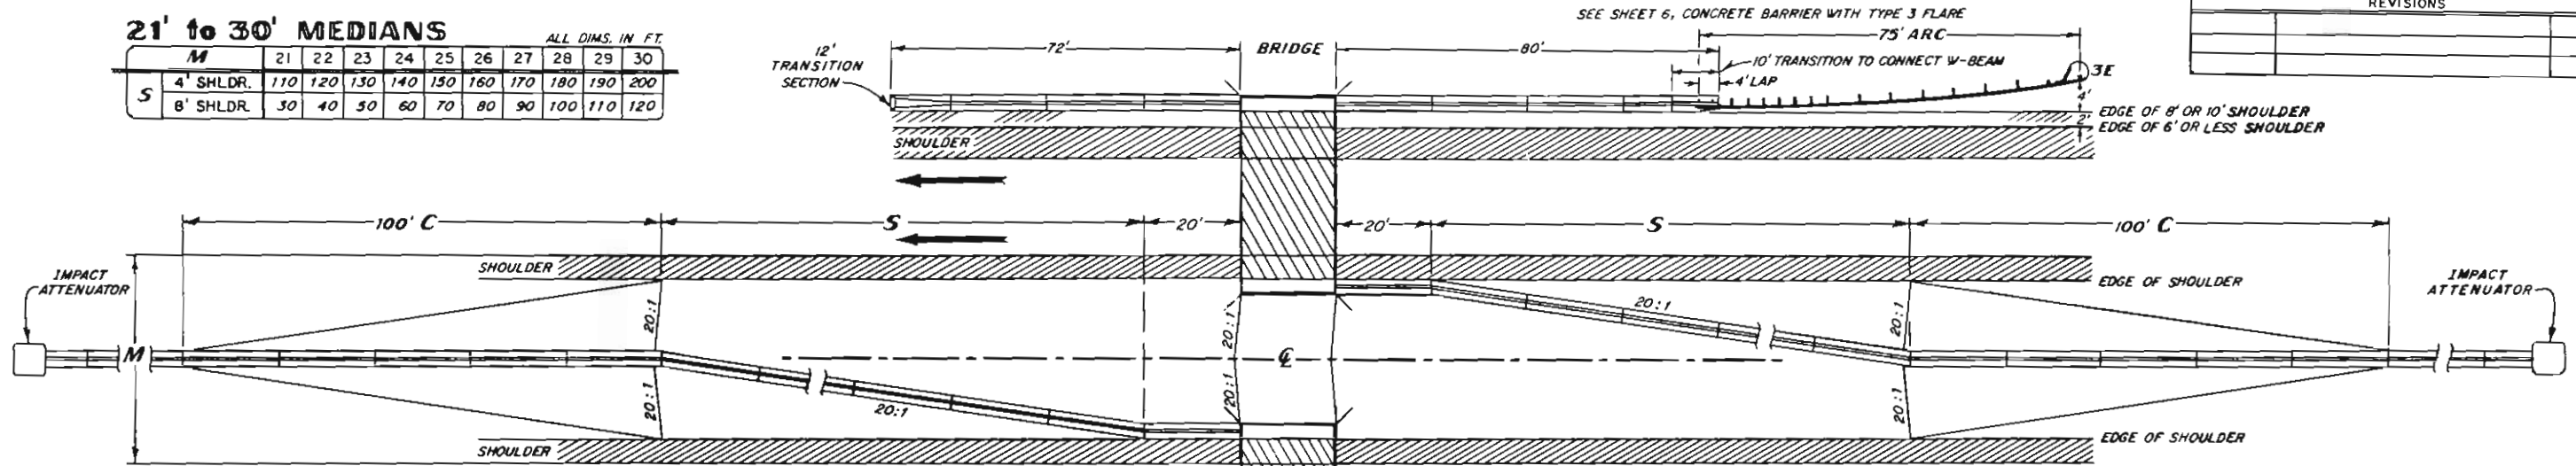

31' to 59' MEDIANS

		31	32	33	34	35	36	37	38	39	40	41	42	43	44	45
M		71	79	86	94	101	109	118	124	131	139	146	154	161	169	176
4' SHLDR.	S	71	79	86	94	101	109	118	124	131	139	146	154	161	169	176
	L	162	170	177	185	192	200	207	215	222	230	237	245	252	260	267
8' SHLDR.	S	59	59	59	59	59	59	59	64	71	79	86	94	101	109	116
	L	150	150	150	150	150	150	150	155	162	170	177	185	192	200	207

		46	47	48	49	50	51	52	53	54	55	56	57	58	59
M		184	191	199	206	214	221	229	236	244	251	259	266	274	281
4' SHLDR.	S	184	191	199	206	214	221	229	236	244	251	259	266	274	281
	L	275	282	290	297	305	312	320	327	335	342	350	357	365	372
8' SHLDR.	S	124	132	139	147	154	162	169	177	184	192	199	207	214	222
	L	215	223	230	238	245	253	260	268	275	283	290	298	305	313

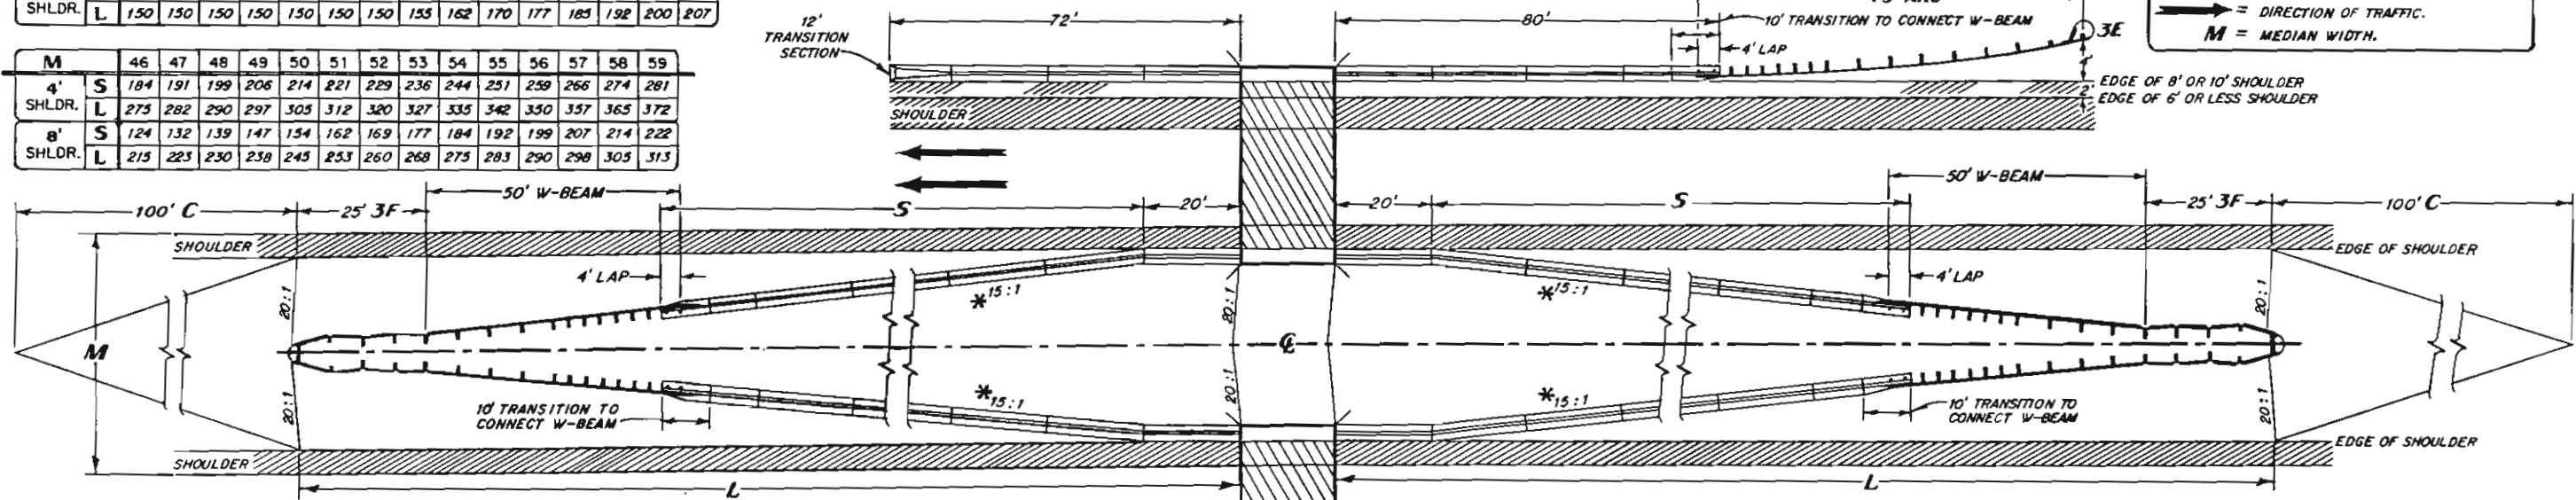

LEGEND

- S = STRAIGHT TRANSITION OF CONCRETE BARRIER.
- C = CHANGE: 100' TRANSITION TO NORMAL SLOPE.
- 3E & 3F = STANDARD END TREATMENTS FOR W-BEAM RAIL.
- L = TOTAL LENGTH.
- = DIRECTION OF TRAFFIC.
- M = MEDIAN WIDTH.

*15:1 FLARE RATE BASED ON A 55 MPH OPERATING SPEED.

STATE DEPARTMENT OF HIGHWAYS
 DIVISION OF HIGHWAYS
 STATE OF COLORADO

GUARD RAIL TYPE 4
 CONCRETE BARRIER

APPROVED BY: *K. J. M...*
 STAFF DESIGN ENGINEER
 DATE: FEBRUARY 18, 1983




STANDARD PLAN NO
 M-606-12
 SHEET 7 OF 9

2 LANE - 2 WAY HIGHWAYS



STANDARD M-606-12
(SHEET 9 OF 9)

FEDERAL ROAD REGION NO.	DIVISION	PROJ. NO.	SHEET NO.	TOTAL SHEETS
VIII	COLORADO			

REVISIONS	

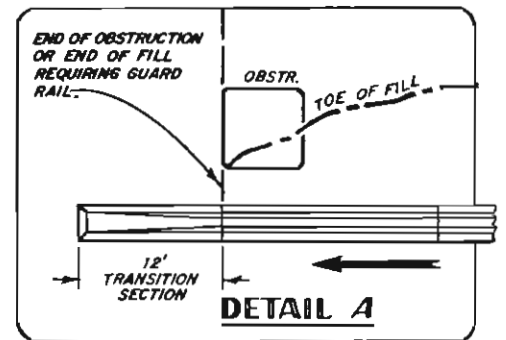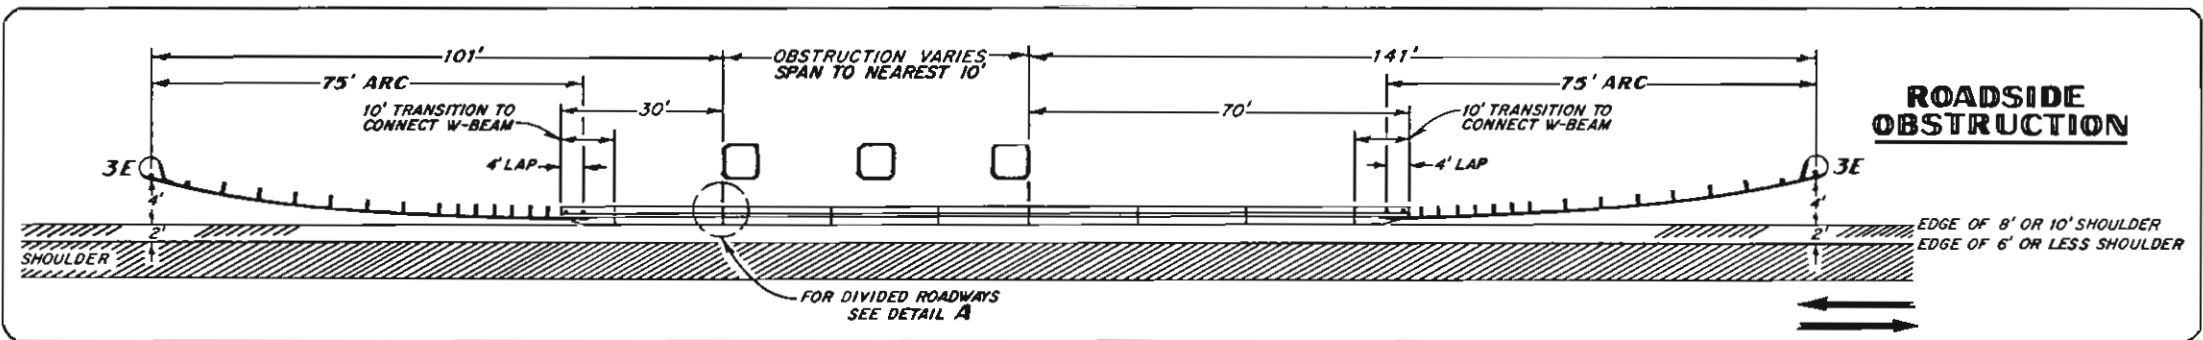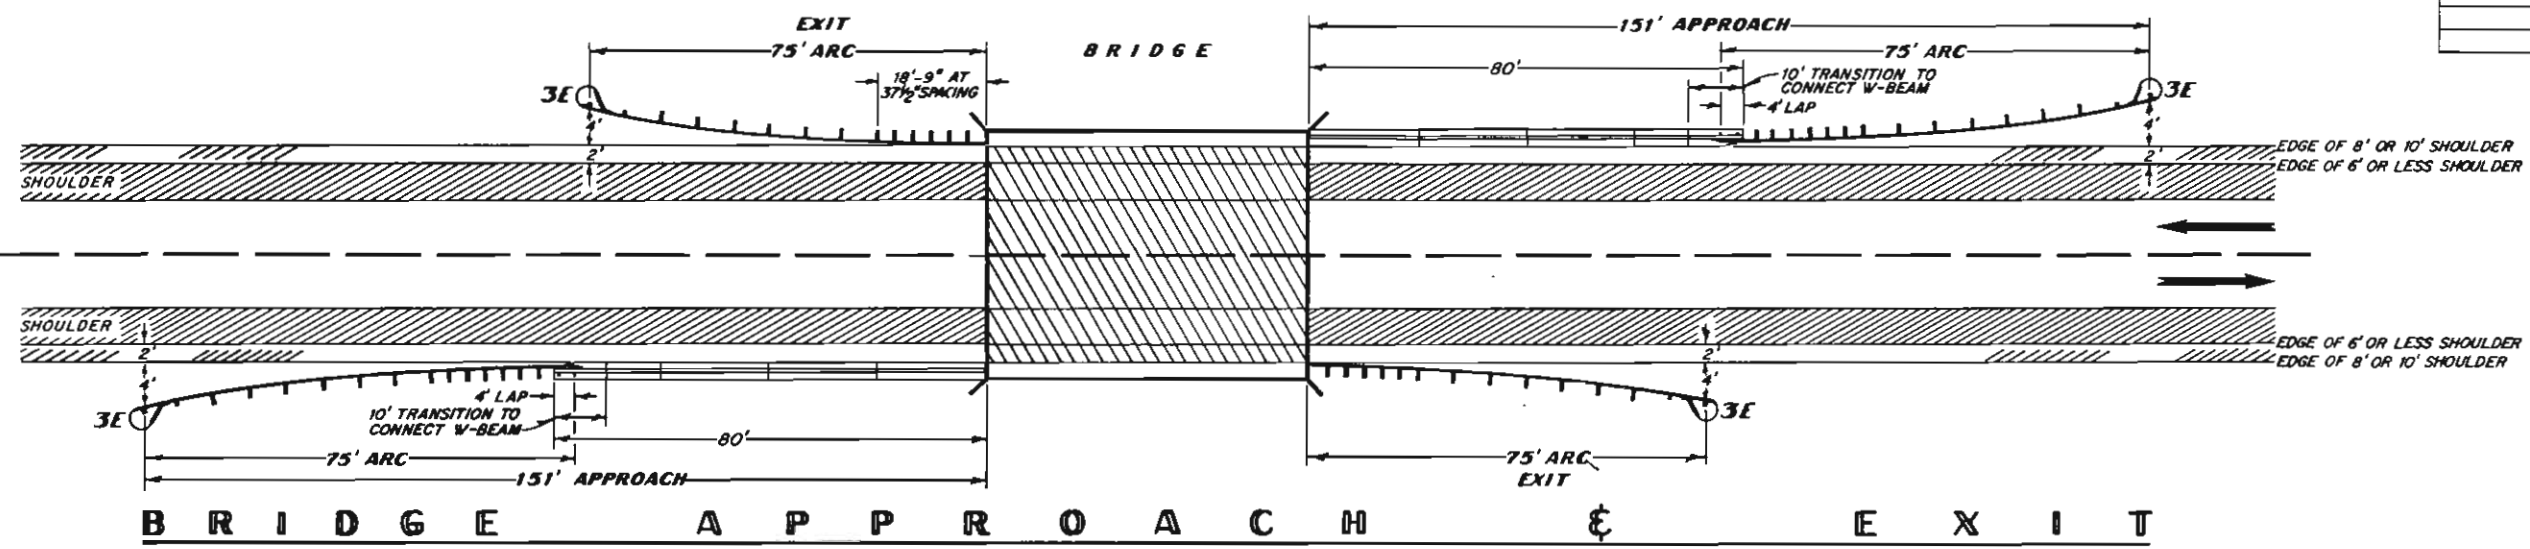

(FOR DIVIDED ROADWAYS)

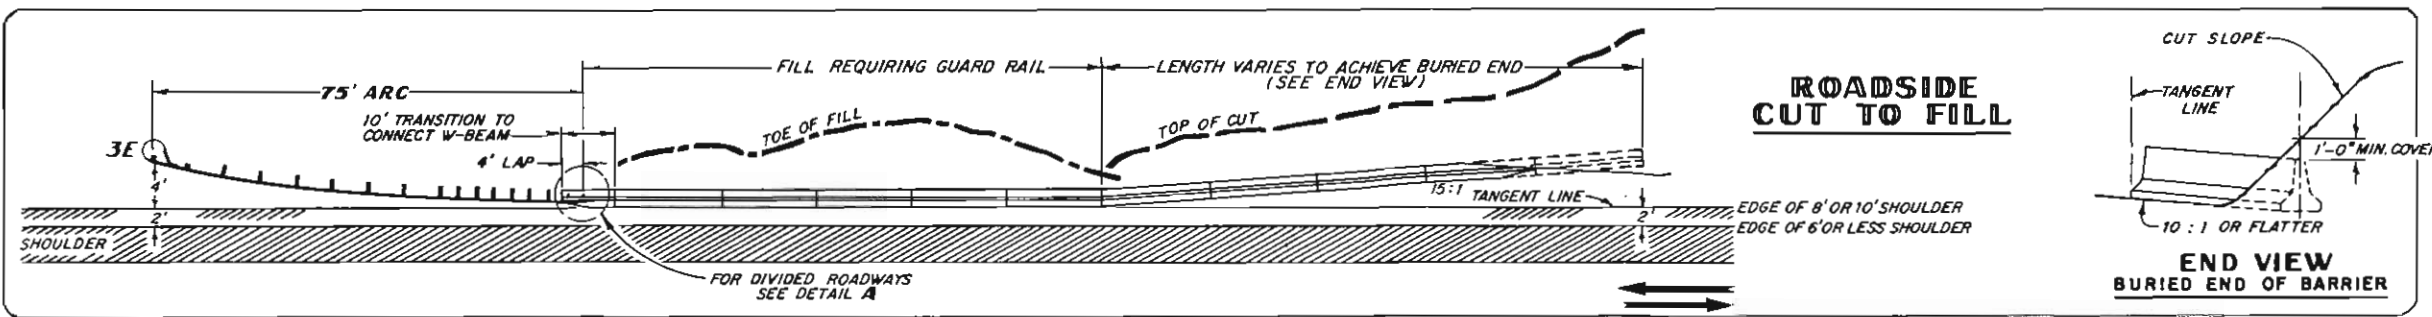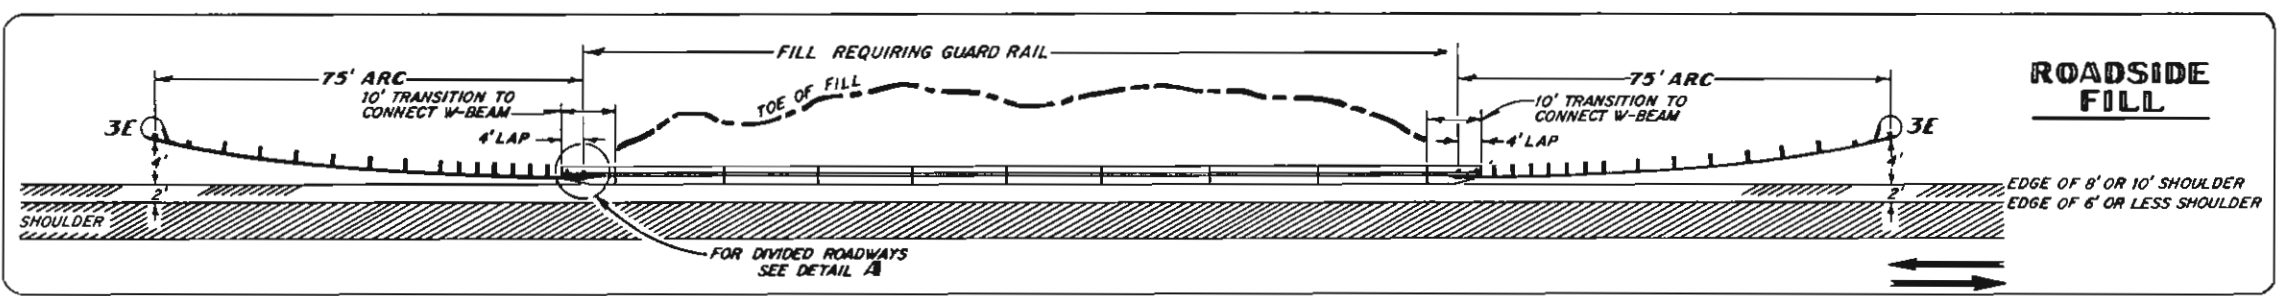

STATE DEPARTMENT OF HIGHWAYS
DIVISION OF HIGHWAYS
STATE OF COLORADO

**GUARD RAIL - TYPE 4
CONCRETE BARRIER**

APPROVED BY: *[Signature]*
STAFF DESIGN ENGINEER
DATE: FEBRUARY 18, 1983

STANDARD PLAN NO
M-606-12
SHEET 9 OF 9