

See Standard M-100-1 for STANDARD SYMBOLS

STATE DEPARTMENT OF HIGHWAYS DIVISION OF HIGHWAYS—STATE OF COLORADO

PLAN AND PROFILE OF PROPOSED
COLORADO PROJECT NO. MP 12-0053-03
STATE HIGHWAY NO. 53
ADAMS COUNTY

PROJECT NO.	DIVISION	PROJECT NO.	SHEET NO.
MP 12-0053-03		MP 12-0053-03	1

NO REVISIONS	AS CONSTRUCTED	REVISIONS	VOO
--------------	----------------	-----------	-----


NO REVISIONS	AS CONSTRUCTED	REVISIONS	VOO
--------------	----------------	-----------	-----

INDEX OF SHEETS

SHEET NO.

- 1 TITLE SHEET
- 2 STANDARD PLANS LIST
- 3 TYPICAL SECTIONS AND GENERAL NOTES
- 4-5 SUMMARY OF APPROXIMATE QUANTITIES
- 6 TABULATION OF SURFACING, SUMMARY OF EARTHWORK, AND IRRIGATION TABULATION
- 7 TABULATION OF REMOVALS, RESETS, AND ADJUSTMENTS, SURVEY TIES, AND RIGHT OF WAY PRIOR TO 1980
- 8-11 ALIGNMENT PLAN AND PROFILE
- 12-13 TRAFFIC SIGNAL PLANS
- 14-18 TABULATION OF SIGNING QUANTITIES

SCALE OF ORIGINAL DIMENSIONS
ON PLAN: 1 IN. = 20 FT.
ON PROFILE: 1 IN. = 20 FT. HORIZONTAL
1 IN. = 5 FT. VERTICAL

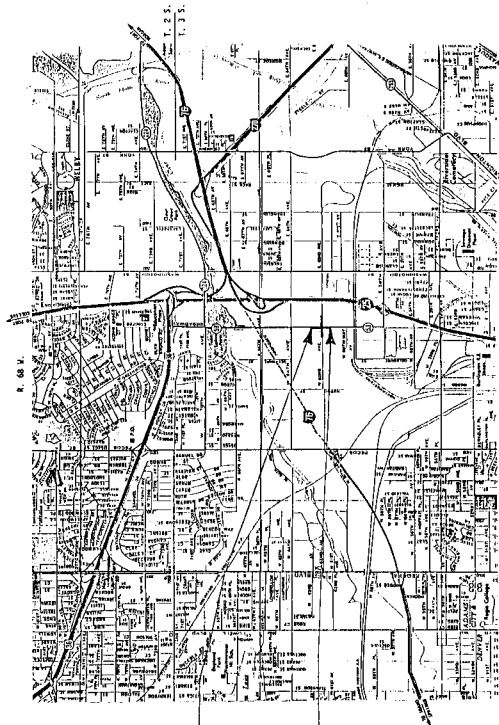

STA. 15+00 BEGIN MP 12-0053-03 =
STA. 89+41.08 PROJ. C 12-0053-00 =
MILE POST 0.723

STA. 23+65 END MP 12-0053-03 =
STA. 89+00.00 PROJ. C 12-0053-00 =
MILE POST 0.889

*Adams County is acquiring
ROW per R. Foster 8/2/80
C. Gray*

AS CONSTRUCTED INFORMATION	
CONTRACTOR	DATE
DESIGNER	
PROJECT STARTED	
PROJECT COMPLETED	
AS CONSTRUCTED PLANS APPROVED	

NO REVISIONS		AS CONSTRUCTED		VOID	
REVISIONS		REVISED		VOID	

GENERAL DATA	DIVISION	PROJECT NO.	SHEET
VII	COLUMBIA	MPF-0053-03	2


Plan No.	Title	Page	Plan No.	Title	Page
☒ M-100-1	STANDARD SYMBOLS	1	☐ S-612-1	TYPICAL DELINEATOR INSTALLATIONS	(4 SHEETS) 75
☐ M-107-1	TEMPORARY EROSION CONTROL	2	☐ S-614-1	TYPICAL GROUND SIGN PLACEMENT	79
☐ M-203-1	APPROACH ROADS, PLANKING, CUT SLOPE TREATMENT, BRIDGE & CREST WIDENING	3	☐ S-614-2	CLASS I GROUND SIGN INSTALLATIONS	80
☐ M-203-2	DITCH TYPES	4	☐ S-614-3	CLASS II GROUND SIGN INSTALLATIONS	81
☐ M-203-10	SUPERELEVATION OF CURVES - CROWNED HIGHWAYS	5	☐ S-614-4	CLASS III SIGNS, LAMINATED ALUMINUM PANELS AND POST SPACING TABLE	(12 SHEETS) 82
☐ M-203-11	SUPERELEVATION OF CURVES - DIVIDED HIGHWAYS - SHOULDER PAVT	6	☐ S-614-5	BREAK-AWAY SIGN SUPPORT DETAILS FOR GROUND SIGNS	(12 SHEETS) 84
☐ M-203-12	SUPERELEVATION OF CURVES - STREETS	7	☐ S-614-6	CONCRETE FOOTINGS AND SIGN ISLANDS FOR GROUND SIGNS	(12 SHEETS) 86
☐ M-203-13	SUPERELEVATION OF CURVES - DIVIDED HIGHWAYS - CENTER PAVT	8	☐ S-614-10	TYPICAL MARKER ASSEMBLY INSTALLATIONS	88
☒ M-206-1	EXCAVATION AND BACKFILL FOR STRUCTURES	(2 SHEETS) 9	☐ S-614-11	MILEPOST SIGN AND INSTALLATION	89
☐ M-206-2	EXCAVATION AND BACKFILL FOR BRIDGES	10	☐ S-614-12	STRUCTURE NUMBER INSTALLATION (BRIDGE INFORMATION SHEET)	90
☐ M-214-1	PLANTING DETAILS	11	☐ S-614-13	STANDARD RAILROAD CROSSING SIGNS AND MARKINGS	91
☐ M-412-1	CONCRETE PAVEMENT JOINTS	12	☐ S-614-20	TYPICAL POLE MOUNT SIGN INSTALLATION	92
☐ M-504-1	STEEL CRIBBING	13	☐ S-614-22	CONCRETE BARRIER SIGN POST INSTALLATIONS	93
☐ M-506-1	GABIONS AND SLOPE MATRESS	14	☐ S-614-23	TYPICAL MULTI-SIGN INSTALLATIONS	94
☐ M-510-1	STRUCTURAL PLATE CULVERT PIPE - H-20 LOADING	15	☐ S-614-30	INTERSTATE ROUTE MARKERS	95
☐ M-601-1	SINGLE CONCRETE BOX CULVERT	16	☐ S-614-31	U. S. & COLORADO ROUTE MARKERS	96
☐ M-601-2	DOUBLE CONCRETE BOX CULVERT	18	☐ S-614-32	AUXILIARY MARKERS	97
☐ M-601-3	TRIPLE CONCRETE BOX CULVERT	19	☐ S-614-40	TRAFFIC SIGNAL INSTALLATION DETAILS	(3 SHEETS) 98
☐ M-601-10	HEADWALL FOR PIPE CULVERTS	20	☒ S-614-50	TRAFFIC SIGNALS FOR HIGHWAY CONSTRUCTION	(4 SHEETS) 101
☐ M-601-11	TYPE "S" SADDLE HEADWALL FOR PIPE CULVERTS	21	☐ S-614-51	BARRICADES, DRUMS, CONCRETE BARRIER	105
☐ M-601-12	HEADWALL, INTERCEPTING HEADWALL AND CULVERT OUTLET PAVING	22	☒ S-627-1	TYPICAL PAVEMENT MARKINGS	(13 SHEETS) 106
☐ M-601-20	VINYLMASTERS FOR PIPE OR BOX CULVERTS	23			
☒ M-603-1	METAL CULVERT PIPE - H-20 LOADING	(12 SHEETS) 25			
☒ M-603-2	PRECAST CONCRETE PIPE	27			
☐ M-603-3	CONCRETE AND METAL END SECTIONS	28			
☒ M-604-1	PIPE SEWER IN TRENCH	30			
☐ M-604-10	INLET, TYPE C	31			
☐ M-604-11	INLET, TYPE D	32			
☒ M-604-12	CURB INLET, TYPE R	(2 SHEETS) 33			
☐ M-604-13	CONCRETE INLET, TYPE 13	35			
☐ M-604-20	MANHOLES	36			
☐ M-604-21	STEPS FOR MANHOLES & INLETS	37			
☐ M-604-22	GUARD RAIL, TYPE 3, W-BEAM	(8 SHEETS) 38			
☐ M-606-1	GUARD RAIL, TYPE 3, W-BEAM FOR LOCAL ROADS & STREETS	(4 SHEETS) 46			
☐ M-606-2	GUARD RAIL, TYPE 4, CONCRETE BARRIER, CAST-IN-PLACE	50			
☐ M-606-10	GUARD RAIL, TYPE 4, CONCRETE BARRIER, PRECAST-PORTABLE	51			

THE STANDARD PLAN SHEETS INDICATED HEREON BY A MARKED BOX ARE TO BE USED TO CONSTRUCT THIS PROJECT.

DEPARTMENT OF HIGHWAYS
STATE OF COLORADO
DIVISION OF HIGHWAYS

STANDARD PLANS LIST


M & S STANDARDS JANUARY, 1982

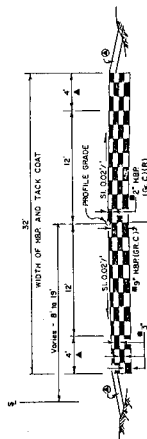

32nd AVE WEST of BROADWAY

APPROXIMATE THICKNESS

② 4" TOPSOIL @ 6:1 Slope

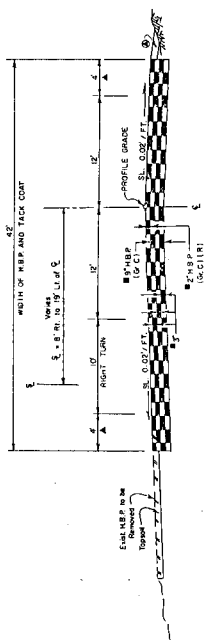

32nd AVE. EAST of BROADWAY

RECEIVED

NO REVISIONS ☐ REVISED ☐ VOID ☐

FIELD ROAD SECTION	DIVISION	PROJECT NO.	SHEET NO.	SHEET TOTALS
VIII	COLO.	MP12-0033-03	3	

GENERAL NOTES

FOR PRELIMINARY PLAN QUANTITIES OF SURFACING MATERIALS, THE FOLLOWING RATES OF APPLICATION WERE USED:

BITUMINOUS PAVEMENT AT 110 LBS. PER SQ. YD. PER INCH
TACK COAT DILUTED EMULSIFIED ASPHALT (SLOW-SETTING) AT

TAKE COAT DILUTED EMULSION ASPHALT
0.10 GAL. PER SQ. YD. (DILUTED)
TAKE COAT OF EMULSIFIED ASPHALT (SLOW SETTING)

THE ENGINEER SHALL BE RESPONSIBLE FOR THE DESIGN OF THE COAT. THE COAT SHALL BE DESIGNED TO BE APPLIED BETWEEN PAVEMENT COURSES TO IMPROVE THE BOND. DILATED AND UNDESIRABLE APPEARANCE SHALL BE AVOIDED. THE COAT SHALL BE APPLIED TO THE PAVEMENT SURFACE IN A MANNER THAT WILL PROTECT THE PAVEMENT FROM WEAR AND TEAR. THE COAT SHALL BE APPLIED TO THE PAVEMENT SURFACE IN A MANNER THAT WILL PROTECT THE PAVEMENT FROM WEAR AND TEAR. THE COAT SHALL BE APPLIED TO THE PAVEMENT SURFACE IN A MANNER THAT WILL PROTECT THE PAVEMENT FROM WEAR AND TEAR.

40 WILL BE AT WASHINGTON BEC OF CHANGING TO BE AT THE
HOTEL IN WASHINGTON TO STAY
TWO DAYS.

APPLICATION.

THE FOLLOWING SHALL BE FURNISHED WITH EACH COPY OF THE REPORT:

AT 1374 OF 13877 BY 121439 7444 725 &
FAXED ONE LINE TODAY. NO 125 FROM
KOREA.

1960 PART OF COMBOD, LINE AND STAGES:

DEPTH OF MOISTURE-DENSITY CONTROL FOR THIS FRACTION - 100

WAVE, ONE CITY AND
FULL DEPTH OF ALL
EVIDENCE FILED
LOOK 8-1-80

TOOT & N. STAFF NEW 6412 40 5230

THE TYPE OF COMPACTION FOR EXISTENCE SHALL BE MAINTAINED.

EXISTING DITCH LINES ARE TO BE UNIFORM 16' GRADED TO DRAINAGE AND ARE DISCLOSED.

INFORMATION. THE CONTRACTOR'S ATTENTION IS DIRECTED TO PARAGRAPHS 107.28 OF THE SUPPLEMENTAL SPECIFICATION CONCERNING UTILITIES. THE CONTRACTOR WILL CALL 834-4700 FOR UTILITY LOCATION AT LEAST 3 WORKING DAYS PRIOR TO ANY DIGGING.

IT IS SUGGESTED THAT THE CONTRACTOR INITIATE A REQUEST TO THE PUBLIC SERVICE COMMISSION FOR AN INTERIM ORDER AUTHORIZING THE USE OF TEMPORARY ELECTRICAL POWER SOURCES AS SOON AS POSSIBLE.

COMPANY FOR ANY CONSTRUCTION-RELATED CONTRACTS OR AGREEMENTS AS POSSIBLE. IN SOME INSTANCES OF 30 DAYS MAY BE REQUIRED TO PROVIDE THE REQUEST IS TO BE PROCESSED THROUGH: PUBLIC SERVICE COMPANY OF SOUTHERN

COLORADO - STREET LIGHTING AT 3831 5TH AVE-2298.

RECEIVED
JAN 10 1968
U.S. DEPT. OF JUSTICE
FEDERAL BUREAU OF INVESTIGATION
WASHINGTON, D.C.

AS SUBSIDIARY TO THAT OPERATION AND WILL NOT BE PAID FOR SEPARATELY. IT IS ESTIMATED THAT 16

CUBIC YARDS WILL BE REQUIRED AND WILL BE OBTAINED FROM AN UNDESIGNATED SOURCE. THE THICKNESS OF TURFILL SHALL BE 4 INCHES. ALL THE KINIKON TURFILL SHALL BE OBTAINED FROM AN UNDESIGNATED SOURCE. WWW.KINIKON.COM KINIKON, KINIKON.COM

*SOIL PREPARATION, SEEDLING (NATIVE) PLANTS, AND MULCHING FOR APPROXIMATELY 0.22 ACRE WILL BE REQUIRED FOR THIS PROJECT. *FERTILIZING WITH COMMERCIAL FERTILIZER, AND MULCHING A WOOD CELLULOSE FIBER SHALL BE APPLIED AT THE RATE OF 1 1/2 TONS PER ACRE. *SEEDLING (NATIVE) PLANTS SHALL BE APPLIED AT THE RATE OF 2,000 PER ACRE.

FOR RECORDS OF THE FBI, THE FOLLOWING TYPES AND DATES
FOR MARK IN COMBINATION WITH MOLCH TACKIFIER.
SHALL BE USED:

CONJUG. PAGE	ISOTOPICAL PAGE	ROOM NO.
BUTYLA GLASS (TREATED)	NUCLEAR BATTERIES	14
WESTERN MEATCANS	ACROSTROM METAL	13
WESTERN MEATCANS	ACROSTROM METAL	13
SLIM-O-GRASS	NUCLEAR BATTERIES	4
WHITE CLOTHES	MUTUALITY CORPUSCULA	4
WHITE CLOTHES	MUTUALITY CORPUSCULA	4
ROCKY MOUNTAIN	NUCLEAR BATTERIES	3
ROCKY MOUNTAIN	NUCLEAR BATTERIES	3
WESTERN MEATCANS	ACROSTROM METAL	1
WESTERN MEATCANS	ACROSTROM METAL	0.5
WESTERN MEATCANS	ACROSTROM METAL	14.5

FERTILIZER		DATE 1981 / ACRES
FERTILIZER (AVAILABLE N)	43	
FERTILIZER (AVAILABLE P)	113	

PROJECT TOTALS	
* SOIL PREPARATION	0.22 ACRES
SEEDING	0.22 ACRES
* FERTILIZER (AVAIL. M)	10 TBS.
* FERTILIZER (AVAIL. P)	25 LBS.
MULCHING (HYDRAULIC)	0.22 ACRES

ALL INFORMATION CONTAINED HEREIN IS UNCLASSIFIED

SUMMARY OF APPROXIMATE QUANTITIES

NO REVISIONS		AS CONSTRUCTED		CITY OF DENVER		PROJECT NO.	
VOID		H		COLO.		MP 12-0253-03	
SHEET NO.		4		PROJECT TOTALS		PLAN	

INDEX	CONTRACT ITEM NO.	CONTRACT ITEM	UNIT	ROADWAY		AS CONSTRUCTED		PROJECT TOTALS	
				PLAN	AS CONST.	PLAN	AS CONST.	PLAN	AS CONST.
201	CLEARING AND GRUBBING	L S	1					1	
202	REMOVAL OF STRUCTURE	EACH	6					6	
203	REMOVAL OF PIPE	EACH	2					2	
204	REMOVAL OF PIPE	LF	310					310	
205	REMOVAL OF ASPHALT MAT	SY	430					430	
206	REMOVAL OF GROUND SIGN	EACH	13					13	
207	REMOVAL OF FENCE	LF	525					525	
208	REMOVAL OF GUARD RAIL TYPE 3	LF	20					20	
209	UNCLASSIFIED EXCAVATION (COMPLETE IN PLACE)	CY	1,535					1,535	
210	STRUCTURE EXCAVATION	CY	97					97	
211	STRUCTURE BACKFILL (CLASS 2)	CY	110					110	
212	TOPSOIL (HAIL)	CY	116					116	
213	RECYCLED MATERIAL STRUCTURE	EACH	1					1	
214	RECYCLED MATERIAL SERVICE	EACH	2					2	
215	RECYCLED MATERIAL HYDRANT	EACH	1					1	
216	RECYCLED MATERIAL SIGN	EACH	2					2	
217	ADJUST MANHOLE	EACH	4					4	
218	ADJUST VALVE BOX	EACH	2					2	
219	ADJUST (NATIVE)	ACRE	80.22					80.22	
220	ADJUST (NATIVE)	ACRE	80.22					80.22	
221	ADJUST (NATIVE)	TON	3,871					3,871	
222	ADJUST (NATIVE)	TON	804					804	
223	ADJUST (NATIVE)	TON	1,112					1,112	
224	ADJUST (NATIVE)	SY	51					51	
225	ADJUST (NATIVE)	SY	1					1	
226	ADJUST (NATIVE)	LF	220					220	
227	ADJUST (NATIVE)	LF	78					78	
228	ADJUST (NATIVE)	LF	114					114	
229	ADJUST (NATIVE)	EACH	3					3	
230	ADJUST (NATIVE)	LF	575					575	
231	ADJUST (NATIVE)	LF	20					20	
232	ADJUST (NATIVE)	TON	750					750	

SUMMARY OF APPROXIMATE QUANTITIES


INDEX		CONTRACT ITEM NO.	CONTRACT ITEM	UNIT	RAILWAY		HIGHWAY		AS CONSTRUCTED	CITY, ROAD, DIVISION D. REGION		PROJ. NO.	SHEET NO.
BOOK	PAGE SHEET				PLAN	AS CONST.	PLAN	AS CONST.		NO. REVISIONS	REVISED		
		614	TRAFFIC CONTROL SUPERVISOR	DAY	45								
		614	SIGN PANEL (GLASS 1)	SF	35								
		614	TIMES SIGN POST 4X4 10X5	LF	58								
		614	PRELIMINARY SIGNAL FACE (16)	EACH	8								
		614	TRAFFIC SIGNAL FACE (12-12-12)	EACH	10								
		614	TRAFFIC SIGNAL FACE (12-12-12-12)	EACH	2								
		614	TRAFFIC SIGNAL FACE (12-12-12-12-12)	EACH	1								
		614	PRELIMINARY PUSH BUTTON	EACH	8								
		614	LOOP DETECTOR WIRE	LF	1,428								
		614	TRAFFIC SIGNAL VEHICLE DETECTOR (ONCE TYPE)	EACH	7								
		614	CONSTRUCTION TRAFFIC SIGN (PANEL SIZE A)	EACH	12								
		614	CONSTRUCTION TRAFFIC SIGN (PANEL SIZE B)	EACH	4								
		614	VERTICAL PANEL	EACH	58								
		614	VERTICAL PANEL (OPEN LIGHT FLASHING)	EACH	18								
		614	TRAFFIC CORE	EACH	58								
		614	TRAFFIC SIGNAL SPIN WIRE PILE (18 1/2")	EACH	4								
		614	TRAFFIC SIGNAL CONTROLLER (TYPE 178)	EACH	1								
		625	CONSTRUCTION SURVEYING	L S	1								
		626	MEABILIZATION	L S	1								
		627	PAVEMENT MARKING PAINT	TON	7								
		627	THERMOPLASTIC PAVEMENT MARKING	SF	1,952								
		627	PRESIGNED PLASTIC PAVEMENT MARKING (68 1/2")	SF	380								
		700	TRAFFIC ACCOUNT										
		700	F/A HIGH CONTRACT REVISIONS	F A	1								
		700	F/A SURVEY MODIFICATION	F A	1								
		700	F/A PORTABLE UTILITIES	F A	1								

AS CONSTRUCTED					
NO REVISIONS			REVISED		VOID
	DESIGNED BY	DW/STH	DATE	08/07/00	SHEET NO.
	VILL	CCLQ	PROJECT NO.	MP-2-0053-03	6


IRRIGATION TABULATION

NOTE NO.	LOCATION	MANHOLE SPECIAL		PIPE SIZE				FLOW LINE ELEV.				LINE		STREET. ELEV.	STREET. BASEFILL (CL. 2)	CONC.	REMARKS
		H	ELEVATION	C.S.P.	R.C.P.			IN	OUT	FROM	TO	GRADE (CL. 2)					
					6"	12"	18"										
													LBS. FT.				
MANH 18	BRANDYAW 18+50 LT.	2.08	94.43	92.10				93.0	92.1	MAN19	MAN18	1.07	24	22			
MANH 19	19+75 LT.	1.90	94.9	92.10		1/36		93.7	93.0	MAN21	MAN19	0.51	34	36			
MANH 20	20+17 LT.	1.90	95.6	93.7				93.6	93.0	15"	MAN21	0.13	35	23		CONNECT TO EXIST. 12" OUT	
20B	20+17 LT.				10											0.1	HEADWALL WITH SLICE GATE
10A	62ND AVE. 9+50 TO 10+64 RT					1/4		89.8	89.2				16	30			
PROJECT TOTALS		*	10	114	220	78							97	110		0.1	

DETAILS OF MANHOLE SPECIAL

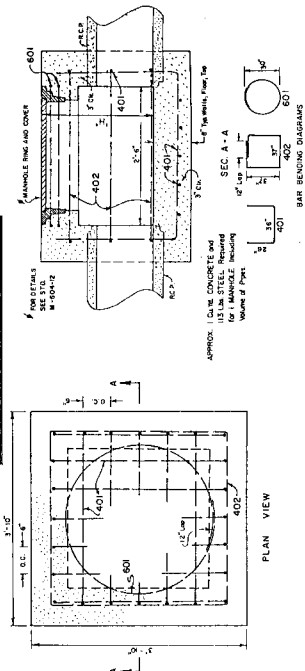

HEADWALL DETAILS

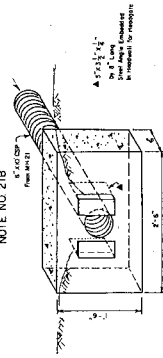

SUMMARY OF EARTHWORK

[illegible]

* INCLUDES EXISTING ASPHALT NOT EXCEPT AT 42ND AVE. REALIGNMENT.

TABULATION OF SURFACING

[illegible]

NOTE: THE BOTTOM LAYER OF E.B.P. GR. C QUANTITY INCLUDES
10% FOR ESTIMATED WEAR 1112 GALS. OF EMULGIFIED ASPHALT (8-6)
WILL BE REQUIRED FOR THIS PROJECT.

⊗ INCLUDES 6120 AVE. RETENAS

51 20 YDS CONCRETE PAVEMENT (8 INCH) REQ'D.
FOR BUS PAD AT STA 8+ RT.

NO REVISIONS ☐ INVERT ☐ VOID ☐

AS CONSTRUCTED

DATE: 10-11-2000

PROJ. NO.: 10-11-2000

DRAWN: 10-11-2000

CHECKED: 10-11-2000


7

TABULATION OF REMOVALS, RESETS AND ADJUSTMENTS

LOCATION STATION	SIDE	REMOVAL OF			RESET			ADJUST		REMARKS				
		STR. EACH	TREE EACH	PIPE LN. FT.	ASPH. SQ. YD.	GROUND SIG.	FENCE LN. FT.	GUARD RAIL LN. FT.	WATER SERV. EACH		WALKWAY STR. EACH	MANHOLE EACH	VALVE BOX EACH	
BROADWAY														
101+03	RT.			44										0" Above, Empty Pipe
101+05	RT.													
101+60	LT.													
101+72	RT.													
101+95	RT.													
101+05	RT.													
101+32 to 101+8	RT.													
101+15 to 101+45	LT.													
101+35	RT.													
101+50	RT.													
101+32 to 201+00	LT.	1		63										4 Stick Gate Posts 10" Empty Pipe
101+82 to 101+76	RT.													
101+82	RT.													
201+37	RT.													
201+50	LT.													
201+63 to 2+1/2	LT.	1												
101+00 to 2+17	RT.			142										100' x 12" 300 0.6 x 0.6 200 100' 3000 0.6 x 0.6 200
201+00 to 2+12	RT.			41										
221+60	RT.													
2ND AVENUE														
5+1+50 to 9+50	RT.													
5+1+50 to 10+00	LT.													
5+40	RT.													
10+05 to 10+00	RT.	2												Break Ball and Frame Seal
PROJECT TOTALS		6	2	310	430	8	525	30				4	2	

NO REVISIONS		REMOVED		VDD	
AS CONSTRUCTED					
DESIGNED BY	DESIGNED BY	DATE	DATE	REV. NO.	SHEET NO.
				MP12-0053-03	11

62ND AVENUE

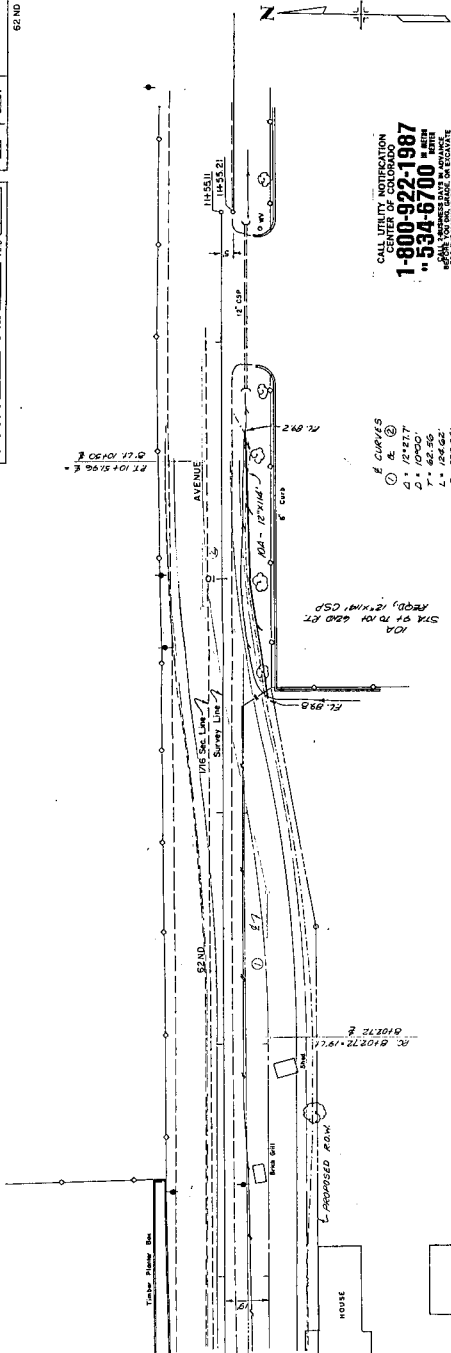

CALL UTILITY NOTIFICATION
CENTER OF COLORADO
1-800-922-1987
"534-6700" IN EITHER
BUSINESS DAYS IN ADVANCE
OR 24 HOURS BEFORE EXCAVATE
FOR THE PLACING OF UNDERGROUND
UTILITY LITERATURE

4 CURVES

①	&	②
$\Delta = 12^\circ 27.7'$		
$\phi = 10^\circ 00'$		
$T = 62.56$		
$L = 124.62'$		
$R = 572.96'$		

10A
STA 9 TO 104 62ND RT
REQD, 12"x14" CSP

[illegible]

FEDERAL ROAD DISTRICT NO. DISTRICT STATE	DISTRICT DISTRICT NO. DISTRICT STATE	PROJECT NO. PROJECT NO. PROJECT NO. PROJECT NO.	SHEET SHEET NO. SHEET NO. SHEET NO.	TOTAL SHEETS SHEETS SHEETS
100-000000 100-000000 100-000000 100-000000	100-000000 100-000000 100-000000 100-000000	100-000000 100-000000 100-000000 100-000000	100-000000 100-000000 100-000000 100-000000	100-000000 100-000000 100-000000 100-000000

NOTES

1. Loop detector wire shall be duct type.
2. All pull boxes shall be concrete and 24 inches in diameter unless otherwise noted on the plans.
3. All backfills shall be lowered type.
4. Signal poles shall be painted with silver/white enamel, 4625 Fir Green with the appropriate primer.
5. WMS #77 shall be used for future left turn phase.
6. C&G/107/0332.

SIGNAL FACES.

TYPE	WIRE DESCRIPTION	UNIT	QUANTITY
E13	2 INCH ELECTRICAL CONDUIT	LF	37.5
E15	3 INCH ELECTRICAL CONDUIT	LF	3.0
B14	PEDESTRIAN SIGNAL FACE(16)	EACH	8
B14	TRAFFIC SIGNAL FACE (12,12,12)	EACH	10
B14	TRAFFIC SIGNAL FACE (12,12,12,12)	EACH	2
B14	TRAFFIC SIGNAL FACE (12,12,12,12)	EACH	1
B14	LOOP DETECTOR WIRE	LF	1450
B14	TRAFFIC SIGNAL VEHICLE DETECTION (TYPE)	EACH	7
B14	PEDESTRIAN PUSH BUTTON	EACH	8
B14	TRAFFIC SIGNAL SPAN WIRE POLE (10")	EACH	4
B14	TRAFFIC SIGNAL CONTROLLER (TYPE 175)	EACH	1

THE COLORADO DEPARTMENT OF HIGHWAYS
DIVISION OF HIGHWAYS
DISTRICT VI
TRAFFIC ENGINEERING SECTION
— MAY 1990 — KMH


POWER SOURCE DETAILS FOR SIGNALS WITH LUMINAIRES

NO SCALE

NO REVISIONS		AS CONSTRUCTED		DESIGNED		PROJECT NO.		SHEET NO.	
REVISED		BY		DATE		PROJECT NO.		SHEET NO.	
				DATE		PROJECT NO.		SHEET NO.	

NOTES

1. See Standards M-613-1 & S-614-40.
2. Luminaire tube furnished and installed by PSCO.
3. For street light luminaires on span wire installations - two (2) number 12 AWG copper TW insulated building wires shall be installed in the pull box and run to the luminaire through the pole along the span wire cable to the signal pole. The wires shall be run in the pull box with approximately 5 feet of extra wiring coiled in the pull box at the base of the pole.
4. For street light luminaires on mast arm installations - two (2) number 12 AWG copper TW insulated building wires shall be installed by the contractor from the end of the luminaire arm, through the pole, to the pull box. The wires shall be run in the pull box with approximately 5 feet of extra wiring coiled in the pull box. The wires shall also install the same size wiring from the pull box of the base of the luminaire to the pull box of the signal pole. The conduit nearest to the pull boxes at other signal poles with luminaires.
5. All wiring for luminaires shall be included in work and not paid for separately.
6. All splices of luminaire wiring shall be done by PSCO.
7. Wiring for street light luminaires shall be tagged per standard specifications.
8. 40ft. of extra No. 4 wire shall be coiled at the base of the power source.

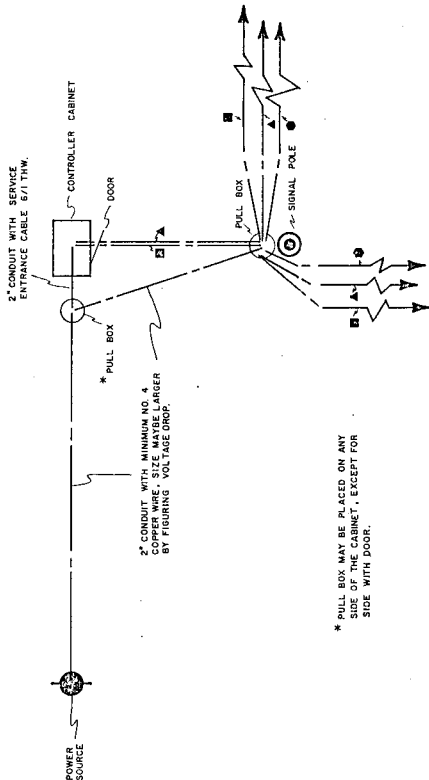

* PULL BOX MAY BE PLACED ON ANY SIDE OF THE SIGNAL POLE, EXCEPT FOR THE SIDE WITH DOOR.

- 2" CONDUIT FOR LOOP DETECTOR WIRE, PEDESTRIAN PUSH BUTTONS, AND COMMUNICATION LINES.
- ▲ 3" CONDUIT FOR TRAFFIC SIGNAL FIELD WIRES.
- 2" CONDUIT FOR LUMINAIRE WIRING TO BE PROVIDED BY PSCO TO BE INSTALLED BY CONTRACTOR FOR UNDER THE UTM CONDUIT (INSTALL ONLY) CONDUIT DELIVERY AT 371-2005.

SCHEDULE OF CONSTRUCTION TRAFFIC SIGNS

[illegible]

FOR CONSTRUCTION SIGNING SEE STANDARD S-614-50
CASE V.

PAVEMENT MARKING QUANTITIES

S.H. 53 (BROADWAY)
THERMOPLASTIC PAVEMENT MARKING - (FOR 8" CHANNELIZING AND DOUBLE 4-YELLOW)

WHITE	600 SQ.FT.
YELLOW	1,300 SQ.FT.

PREFORMED PLASTIC PAVEMENT MARKING (50 MILS.) -
(FOR CROSSWALK BARS AND LEFT TURN ARROWS)

WHITE **320 SQ. FT.**



62 ND AVE.

PAVEMENT MARKING PAINT

WHITE	2 GALS
YELLOW	5 GALS

SIGNING AND STRIPING PLAN BROADWAY


AS CONSTRUCTED		REVISED		VOCD	
NO REVISIONS					
DESIGNED	DIVISION	PROJECT	DATE		
VII	CDLO	MP 12-0053-03	1/5		

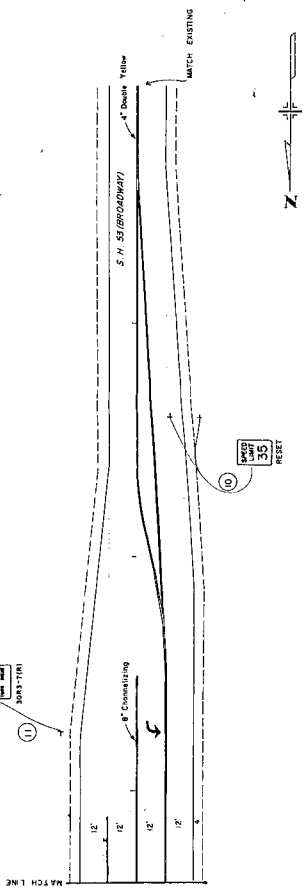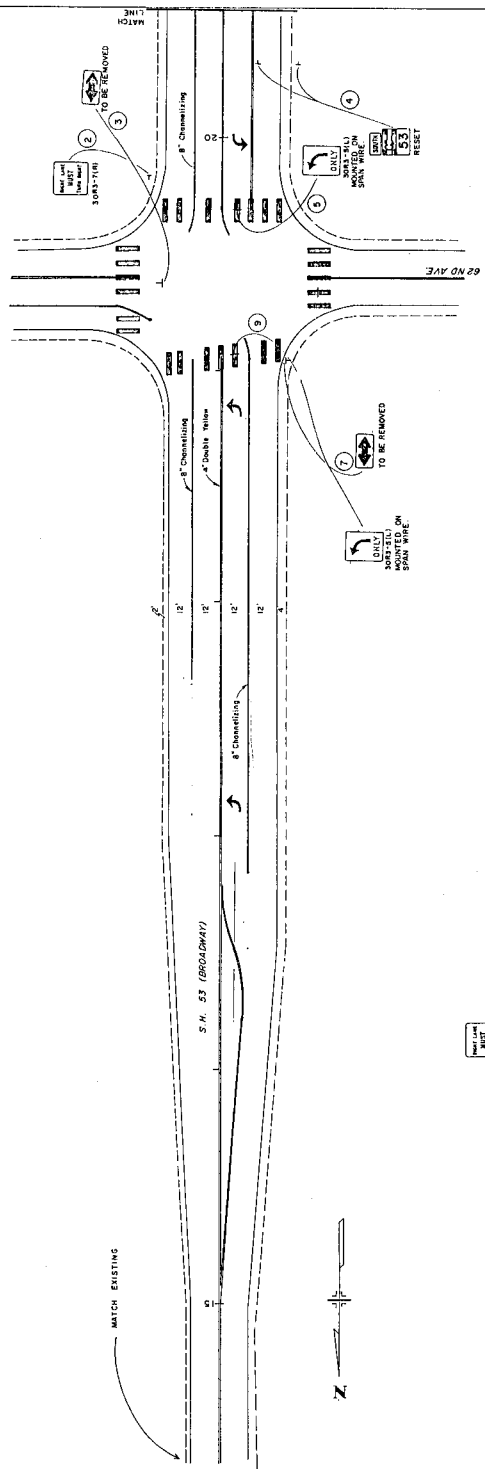

ALL SIGNS NOT SHOWN TO REMAIN IN PLACE.
EXISTING SIGNS MARKED TO BE REMOVED.

62 ND AVE.

NO REVISIONS	☐	REVISED	☐	VOID	☐
--------------	--------------------------	---------	--------------------------	------	--------------------------

 


ALL SIGNS NOT SHOWN TO REMAIN IN PLACE.
EXISTING SIGNS MARKED  TO BE REMOVED.

APPROVED FOR CONSTRUCTION		PROJECT		SHEET	
DESIGNED BY	REVIEWED BY	DATE	NO.	OF	SHEETS
		10/12/03	103	1	1


TYPICAL PAVEMENT MARKINGS LONGITUDINAL (CONTINENTAL) TYPE CROSSWALKS

CROSSWALK LINE DETAIL

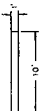

GENERAL NOTES

Center crosswalks on highway routes where both lanes are provided. At signalized intersections having no median crosswalk, center crosswalks on signalized street practice, as shown.

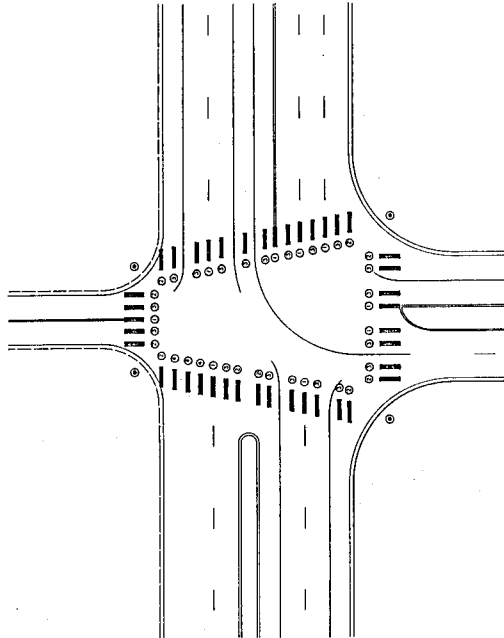

LAYOUT KEY

- ① Center on two-lane or one-lane road.
- ② Center on extended two-lane road.
- ③ Center between adjacent lanes.
- ④ Lines and spaces in opposition of center pattern.

See Standard M-100-A for STANDARD SYMBOLS

STATE DEPARTMENT OF HIGHWAYS DIVISION OF HIGHWAYS—STATE OF COLORADO

PLAN AND PROFILE OF PROPOSED
COLORADO PROJECT NO. MP12-0053-03
STATE HIGHWAY NO. 53
ADAMS COUNTY

INDEX OF SHEETS

SECTION NO.	DATE	PROJECT NO.
1	SEP 6 1989	MP12-0053-03


NO REVISIONS	AS CONSTRUCTED	VOO
--------------	----------------	-----

SCALE OF ORIGINAL DRAWINGS
ON PLAN 1" = 50 FT
ON PROFILE 1" = 50 FT HORIZONTAL
1" = 10 FT VERTICAL

FIELD INSPECTION
DATE SEP 6 1989
ROADWAY PLANS

TABULATION OF LENGTH

STATION	ROADWAY
STA 69+00.00 ON C12-0053-00	
STA 69+50.00 ON C12-0053-00	Lim Ft
Sta 77+33.00 ON MP12-0053-03	
Sta 77+33.00 ON C12-0053-00	Lim Ft
ROADWAY TOTAL	Lim Ft
SUMMARY	Lim Ft
Lim Ft	MILES
Total Net 1 Gross Length of Roadway	
Design Speed as Posted	
Design Traffic Volume	
NOT	

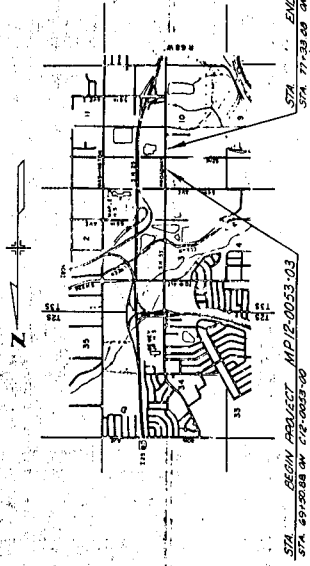

Original Scale 1" = 2000'

AS CONSTRUCTED INFORMATION	
CONTRACTOR	ENGINEER
PROJECT STARTED	PROJECT COMPLETED
AS CONSTRUCTED PLANS	APPROVED
TITLE	DATE

AS CONSTRUCTED		VOID	
NO REVISIONS	REVISED	VOID	

FEDERAL ROAD DISTRICT	INVESTIGATOR	PROJECT NO.	SHEET
W-111	COLLADO	W-111-0033-03	2

Plan No.	Title	Page	Plan No.	Title	Page
■ M-100-1	STANDARD SYMBOLS.....	1	□ S-612-1	TYPICAL DELINEATOR INSTALLATIONS.....(4 SHEETS) 75	
■ M-107-1	TEMPORARY EROSION CONTROL.....	2	□ S-614-1	TYPICAL GROUND SIGN PLACEMENT.....	79
□ M-203-1	APPROACH ROADS, FLARING, OUT SLOPE TREATMENT, BRIDGE & CREST WIDENING.....	3	□ S-614-2	CLASS I GROUND SIGN INSTALLATIONS.....	80
□ M-203-2	DITCH TYPES.....	4	□ S-614-3	CLASS II GROUND SIGN INSTALLATIONS.....	81
□ M-203-10	SUPERELEVATION OF CURVES - CROWNED HIGHWAYS.....	5	□ S-614-4	CLASS III SIGNS, LAMINATED ALUMINUM PANELS AND POST SPACING TABLE.....(2 SHEETS) 82	
□ M-203-11	SUPERELEVATION OF CURVES - DIVIDED HIGHWAYS - SHOULDER PIVOT.....	6	□ S-614-5	BREAK-AWAY SIGN SUPPORT DETAILS FOR GROUND SIGNS.....(2 SHEETS) 84	
□ M-203-12	SUPERELEVATION OF CURVES - STREETS.....	7	□ S-614-6	CONCRETE FOOTINGS AND SIGN ISLANDS FOR CLASS III SIGNS.....(2 SHEETS) 86	
□ M-203-13	SUPERELEVATION OF CURVES - DIVIDED HIGHWAYS - CENTER PIVOT.....	8	□ S-614-10	TYPICAL MARKER ASSEMBLY INSTALLATIONS.....	88
■ M-206-1	EXCAVATION AND BACKFILL FOR STRUCTURES.....(12 SHEETS) 9		□ S-614-11	MILEPOST SIGN AND INSTALLATION.....	89
□ M-206-2	EXCAVATION AND BACKFILL FOR BRIDGES.....	11	□ S-614-12	STRUCTURE NUMBER INSTALLATION (BRIDGE INFORMATION SHEET).....	90
□ M-214-1	PLANTING DETAILS.....	12	□ S-614-13	STANDARD RAILROAD CROSSING SIGNS AND MARKINGS.....	91
□ M-412-1	CONCRETE PAVEMENT JOINTS.....	13	□ S-614-20	TYPICAL POLE MOUNT SIGN INSTALLATION.....	92
□ M-504-1	STEEL CRIBBING.....	14	□ S-614-21	CONCRETE BARRIER SIGN POST INSTALLATIONS.....	93
□ M-506-1	GABIONS AND SLOPE MATRESS.....	15	□ S-614-22	TYPICAL MULTI-SIGN INSTALLATIONS.....	94
□ M-510-1	STRUCTURAL PLATE CULVERT PIPE - H-20 LOADING.....(2 SHEETS) 16		□ S-614-30	INTERSTATE ROUTE MARKERS.....	95
□ M-601-1	SINGLE CONCRETE BOX CULVERT.....	18	□ S-614-31	U. S. & COLORADO ROUTE MARKERS.....	96
□ M-601-2	DOUBLE CONCRETE BOX CULVERT.....	19	□ S-614-32	AUXILIARY MARKERS.....	97
□ M-601-3	TRIPLE CONCRETE BOX CULVERT.....	20	□ S-614-40	TRAFFIC SIGNAL INSTALLATION DETAILS.....(3 SHEETS) 98	
□ M-601-10	HEADWALL FOR PIPE CULVERTS.....	21	■ S-614-50	TRAFFIC CONTROLS FOR HIGHWAY CONSTRUCTION.....(4 SHEETS) 101	
□ M-601-11	TYPE "S" SADDLE HEADWALL FOR PIPE CULVERTS.....	22	□ S-614-51	BARRICADES, DRUMS, CONCRETE BARRIER (TEMP) & VERTICAL PANELS.....	105
□ M-601-12	HEADWALL FOR PIPE CULVERTS - TYPICAL AND CULVERT OUTLET PAVING.....	23	■ S-627-1	TYPICAL PAVEMENT MARKINGS.....(3 SHEETS) 106	
□ M-601-20	VINDWALLS FOR PIPE OR BOX CULVERTS.....	24			
■ M-603-1	METAL CULVERT PIPE - H-20 LOADING.....(12 SHEETS) 25				
■ M-603-2	REINFORCED CONCRETE PIPE.....	27			
□ M-603-3	PRECAST CONCRETE BOX CULVERT.....	28			
■ M-603-10	CONCRETE AND METAL END SECTIONS.....	29			
□ M-604-1	PIPE SEWER IN TRENCH.....	30			
□ M-604-10	INLET, TYPE C.....	31			
□ M-604-11	INLET, TYPE D.....	32			
□ M-604-12	CURB INLET, TYPE R.....(12 SHEETS) 33				
□ M-604-13	CONCRETE INLET, TYPE 13.....	35			
□ M-604-20	MANHOLES.....	36			
□ M-604-21	STEPS FOR MANHOLES & INLETS.....	37			
□ M-606-1	GUARD RAIL, TYPE 3, W-BEAM.....(8 SHEETS) 38				
□ M-606-2	GUARD RAIL, TYPE 3, W-BEAM FOR LOCAL ROADS & STREETS.....	40			
□ M-606-10	GUARD RAIL, TYPE 4, CONCRETE BARRIER, CAST-IN-PLACE.....(4 SHEETS) 46				
□ M-606-11	GUARD RAIL, TYPE 4, CONCRETE BARRIER, PRECAST-PORTABLE.....	50			


THE STANDARD PLAN SHEETS INDICATED HEREON BY A MARKED BOX ARE TO BE USED TO CONSTRUCT THIS PROJECT.

DEPARTMENT OF HIGHWAYS
STATE OF COLORADO
DIVISION OF HIGHWAYS

STANDARD PLANS LIST

M & S STANDARDS - JANUARY, 1982

3	NO	π
---	----	---

 


TOTAL PLS PER ACRES SOWN	36.5
--------------------------	------

FERTILIZER		DATE LBS. / ACRES
FERTILIZER (AVAILABLE P)		45
FERTILIZER (AVAILABLE P)		115

PROJECT TOTALS

• FOR INFORMATION ONLY

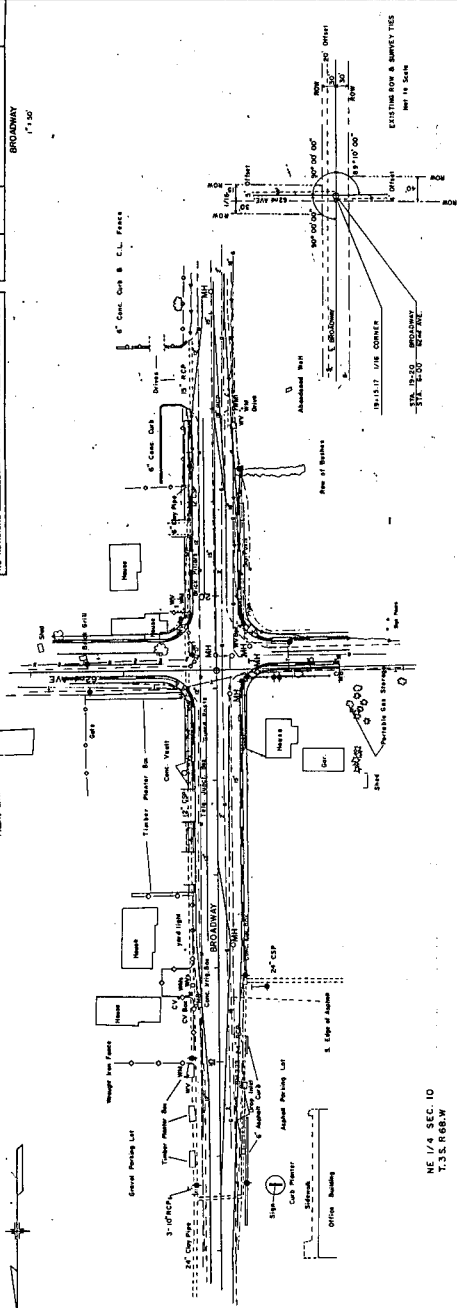

NE 1/4 SEC. 10
T.35. R.68.W

 
3200
3195
3190
3185

2+00 2+10 2+20 2+30 2+40 2+50

Gravelly sandstone
Sandstone
Shale
Limestone

2+00 2+10 2+20 2+30 2+40 2+50

3200
3195
3190
3185

62nd AVE

371	NO 22 BOOK	UNRECORDED NOTED ALIGNMENT CHECKED S. W. S. NOTED S. W. S. NOTED CH. 10
-----	------------	--

