

Oversight / NHS

FHWA REGION VIII OVERSIGHT? ☒ NO ☐ YES

NATIONAL HIGHWAY SYSTEM? ☒ NO ☐ YES

DEPARTMENT OF TRANSPORTATION
STATE OF COLORADO

HIGHWAY CONSTRUCTION BID PLANS OF PROPOSED
COLORADO PROJECT NO. MTCE 0091-039

STATE HIGHWAY NO. 9
SUMMIT COUNTY
CONSTRUCTION PROJECT CODE NO. 18777
SH 9 FIBER NETWORK/SIGNAL INTERCONNECT

Related Projects:

P. E. UNDER PROJECT:
Project Number
Project Code:

R.O.W. Projects:

R.O.W. Project Description


AD PLANS

JULY 19, 2012

TABULATION OF LENGTH & DESIGN DATA

STATION	FEET
	ROADWAY SH 9
APPROACH TO PROJECT	
SH 9: BEGIN MP = 86.26	59549
END MP = 96.97	
TOTAL	59549
SUMMARY OF PROJECT LENGTH	FEET
PROJECT GROSS LENGTH	59549

DESIGN DATA	SH 9
MAXIMUM POSTED SPEED	50 MPH
2010 DESIGN TRAFFIC	DHV = 1890 ADT = 21000
DHV TRUCK %	2.70%

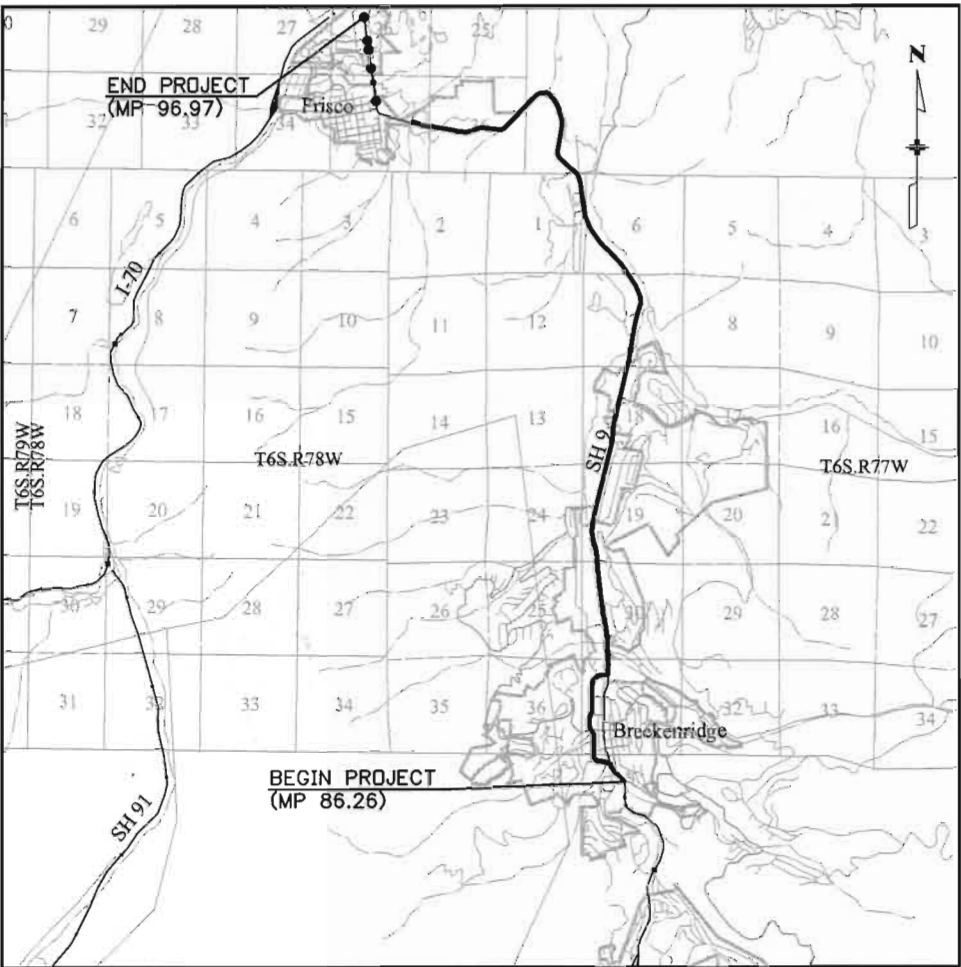

PROJECT LOCATION MAP

INDEX OF SHEETS

SHEET NO.

TITLE

1	TITLE SHEET
2	STANDARD PLANS LIST
3 - 4	GENERAL NOTES
5 - 8	SUMMARY OF APPROXIMATE QUANTITIES
9	CONSTRUCTION NOTES
10	INTERCONNECT PLANS INDEX SHEET
11 - 56	INTERCONNECT PLANS
57 - 58	NETWORK DIAGRAMS
59 - 77	SPLICING DIAGRAMS
78 - 81	DETAILS
82 - 85	STORMWATER MANAGEMENT PLANS
86	TRAFFIC CONTROL NOTES AND TABULATIONS



Know what's below.
Call before you dig.

Print Date: 7/12/2012

File Name: 18777TRAF_TitleSht.dgn

Horiz. Scale: 1:1

Vert. Scale: As Noted

Unit Information

Unit Leader Initials

MULLER

Muller Engineering Co., Inc.
Consulting Engineers

apexdesign

P:10-028.03 - Parker Rd Interconnect\Traffic\ITS

Sheet Revisions

Date:	Comments	Init.

Colorado Department of Transportation



Region 1

18500 East Colfax Avenue
Aurora, CO 80011
Phone: 303-757-9648 FAX: 303-757-9746

SS

As Constructed

No Revisions:

Revised:

Void:

Contract Information

Contractor:

Resident Engineer: SS

Project Engineer: SH

PROJECT STARTED: / / ACCEPTED: / /

Comments:

Project No./Code

MTCE 0091-039

18777

Sheet Number 1

PLAN NUMBER	NEW OR REVISED	M STANDARD TITLE	PAGE NUMBER
<input type="checkbox"/> M-100-1		STANDARD SYMBOLS (3 SHEETS).....	1-3
<input type="checkbox"/> M-203-1		APPROACH ROADS.....	4
<input type="checkbox"/> M-203-2		DITCH TYPES.....	5
<input type="checkbox"/> M-203-11		SUPERELEVATION CROWNED AND DIVIDED HIGHWAYS (3 SHEETS).....	6-8
<input type="checkbox"/> M-203-12		SUPERELEVATION STREETS (2 SHEETS).....	9-10
<input type="checkbox"/> M-206-1		EXCAVATION AND BACKFILL FOR STRUCTURES (2 SHEETS).....	11-12
<input type="checkbox"/> M-206-2		EXCAVATION AND BACKFILL FOR BRIDGES (2 SHEETS)	13-14
<input type="checkbox"/> M-208-1	<input checked="" type="checkbox"/>	TEMPORARY EROSION CONTROL (12 SHEETS) (REVISED ON JULY 29, 2011) ...	15-21
<input type="checkbox"/> M-210-1		MAILBOX SUPPORTS (2 SHEETS).....	22-23
<input type="checkbox"/> M-214-1		PLANTING DETAILS.....	24
<input type="checkbox"/> M-412-1	<input type="checkbox"/>	CONCRETE PAVEMENT JOINTS (5 SHEETS) (REVISED ON JULY 29, 2011)	25-29
<input type="checkbox"/> M-510-1		STRUCTURAL PLATE PIPE H-20 LOADING	30
<input type="checkbox"/> M-601-1		SINGLE CONCRETE BOX CULVERT (2 SHEETS).....	31-32
<input type="checkbox"/> M-601-2		DOUBLE CONCRETE BOX CULVERT (2 SHEETS).....	33-34
<input type="checkbox"/> M-601-3		TRIPLE CONCRETE BOX CULVERT (2 SHEETS).....	35-36
<input type="checkbox"/> M-601-10		HEADWALL FOR PIPES	37
<input type="checkbox"/> M-601-11		TYPE "S" SADDLE HEADWALLS FOR PIPE.....	38
<input type="checkbox"/> M-601-12		HEADWALLS AND PIPE OUTLET PAVING	39
<input type="checkbox"/> M-601-20		WINGWALLS FOR PIPE OR BOX CULVERTS.....	40
<input type="checkbox"/> M-603-1	<input type="checkbox"/>	METAL PIPE (4 SHEETS) (REVISED ON FEBRUARY 25, 2010)	41-42
<input type="checkbox"/> M-603-2		REINFORCED CONCRETE PIPE	43
<input type="checkbox"/> M-603-3	<input type="checkbox"/>	PRECAST CONCRETE BOX CULVERT (REVISED ON JULY 29, 2011)	44
<input type="checkbox"/> M-603-4	<input type="checkbox"/>	CORRUGATED POLYETHYLENE PIPE (AASHTO M294) (REV. ON FEB. 25, 2010)	
<input type="checkbox"/> M-603-5	<input type="checkbox"/>	POLYVINYL CHLORIDE (PVC) PIPE (AASHTO M304) (NEW ON FEB. 25, 2010)	
<input type="checkbox"/> M-603-10		CONCRETE AND METAL END SECTIONS (2 SHEETS).....	45-46
<input type="checkbox"/> M-604-10		INLET, TYPE C.....	47
<input type="checkbox"/> M-604-11		INLET, TYPE D.....	48
<input type="checkbox"/> M-604-12		CURB INLET TYPE R (2 SHEETS).....	49-50
<input type="checkbox"/> M-604-13		CONCRETE INLET TYPE 13.....	51
<input type="checkbox"/> M-604-20		MANHOLES (3 SHEETS).....	52-54
<input type="checkbox"/> M-604-25		VANE GRATE INLET (5 SHEETS).....	55-59
<input type="checkbox"/> M-605-1	<input type="checkbox"/>	SUBSURFACE DRAINS (REVISED ON JULY 09, 2009)	60
<input type="checkbox"/> M-606-1	<input type="checkbox"/>	GUARDRAIL TYPE 3 W-BEAM (18 SHEETS) (REVISED ON MAY 05, 2011)	61-76
<input type="checkbox"/> M-606-13		GUARDRAIL TYPE 7 F-SHAPE BARRIER (4 SHEETS)	77-80
<input type="checkbox"/> M-606-14		PRECAST TYPE 7 CONCRETE BARRIER (3 SHEETS).....	81-83

PLAN NUMBER	NEW OR REVISED	M STANDARD TITLE	PAGE NUMBER
<input type="checkbox"/> M-607-1		WIRE FENCES AND GATES (3 SHEETS).....	84-86
<input type="checkbox"/> M-607-2		CHAIN LINK FENCE (3 SHEETS)	87-89
<input type="checkbox"/> M-607-3		BARRIER FENCE.....	90
<input type="checkbox"/> M-607-4		DEER FENCE AND GATES (2 SHEETS).....	91-92
<input type="checkbox"/> M-607-10		PICKET SNOW FENCE	93
<input type="checkbox"/> M-607-15		ROAD CLOSURE GATE (9 SHEETS).....	94-102
<input type="checkbox"/> M-608-1	<input checked="" type="checkbox"/>	CURB RAMPS (6 SHEETS) (REVISED ON MAY 05, 2011)	103-106
<input type="checkbox"/> M-609-1	<input checked="" type="checkbox"/>	CURBS, GUTTERS, AND SIDEWALKS (4 SHEETS) (REVISED ON JULY 09, 2009)	107-109
<input type="checkbox"/> M-611-1		CATTLE GUARD (2 SHEETS).....	110-111
<input type="checkbox"/> M-613-1		ROADWAY LIGHTING (4 SHEETS).....	112-115
<input type="checkbox"/> M-614-1		RUMBLE STRIPS (3 SHEETS).....	116-118
<input type="checkbox"/> M-614-2		SAND BARREL ARRAYS (2 SHEETS).....	119-120
<input type="checkbox"/> M-615-1		EMBANKMENT PROTECTOR TYPE 3.....	121
<input type="checkbox"/> M-615-2		EMBANKMENT PROTECTOR TYPE 5.....	122
<input type="checkbox"/> M-616-1		INVERTED SIPHON.....	123
<input type="checkbox"/> M-620-1		FIELD LABORATORY CLASS 1.....	124
<input type="checkbox"/> M-620-2		FIELD LABORATORY CLASS 2	125
<input type="checkbox"/> M-620-11		FIELD OFFICE CLASS 1	126
<input type="checkbox"/> M-620-12		FIELD OFFICE CLASS 2	127
<input type="checkbox"/> M-629-1		SURVEY MONUMENTS (2 SHEETS).....	128-129

PLAN NUMBER	NEW OR REVISED	S STANDARD TITLE	PAGE NUMBER
<input type="checkbox"/> S-612-1	<input checked="" type="checkbox"/>	DELINEATOR INSTALLATIONS (6 SHEETS) (REVISED, JULY 01, 2010) ...	134-136
<input checked="" type="checkbox"/> S-614-1		GROUND SIGN PLACEMENT (2 SHEETS).....	136-137
<input type="checkbox"/> S-614-2		CLASS I SIGNS	138
<input type="checkbox"/> S-614-3		CLASS II SIGNS	139
<input type="checkbox"/> S-614-4	<input type="checkbox"/>	CLASS III SIGNS (3 SHEETS) (REVISED, DECEMBER 29, 2009)	140-142
<input type="checkbox"/> S-614-5		BREAK-AWAY SIGN SUPPORT DETAILS	143-144
<input type="checkbox"/> S-614-6		CONCRETE FOOTINGS AND SIGN ISLANDS	145-146
<input type="checkbox"/> S-614-8	<input type="checkbox"/>	TUBULAR STEEL SIGN SUPPORT DETAILS (5 SHEETS) (REVISED ON SEPT. 01, 2010)	147-151
<input type="checkbox"/> S-614-10		MARKER ASSEMBLY INSTALLATIONS	152
<input type="checkbox"/> S-614-11	<input type="checkbox"/>	MILEPOST SIGN DETAIL FOR HIGH SNOW AREAS (NEW, JUNE 22, 2009)	
<input type="checkbox"/> S-614-12		STRUCTURE NUMBER INSTALLATION	153
<input type="checkbox"/> S-614-14		FLASHING BEACON AND SIGN INSTALLATIONS (3 SHEETS) .	154-156
<input type="checkbox"/> S-614-20		TYPICAL POLE MOUNT SIGN INSTALLATIONS	157
<input type="checkbox"/> S-614-21	<input type="checkbox"/>	CONCRETE BARRIER SIGN POST INSTALLATIONS (REVISED ON JUNE 24, 2011)	158
<input type="checkbox"/> S-614-22		TYPICAL MULTI-SIGN INSTALLATIONS.	159
<input type="checkbox"/> S-614-40		TYPICAL TRAFFIC SIGNAL INSTALLATION DETAILS	160-166
<input type="checkbox"/> S-614-40A		ALTERNATIVE TRAFFIC SIGNAL INSTALLATION DETAILS	167-171
<input type="checkbox"/> S-614-50		MONOTUBE OVERHEAD SIGNS (14 SHEETS).....	172-185
<input type="checkbox"/> S-627-1	<input type="checkbox"/>	PAVEMENT MARKINGS (5 SHEETS) (REVISED ON OCTOBER 01, 2010)	186-190
<input type="checkbox"/> S-630-1	<input checked="" type="checkbox"/>	TRAFFIC CONTROLS FOR HIGHWAY CONSTRUCTION..... (42-19 SHEETS) (REVISED ON MARCH 26, 2012)	191-202
<input checked="" type="checkbox"/> S-630-2		BARRICADES, DRUMS, CONCRETE BARRIERS (TEMP).....	203
<input type="checkbox"/> S-630-3	<input type="checkbox"/>	FLASHING BEACON (PORTABLE) DETAILS (REVISED ON JUNE 27, 2011)	204
<input type="checkbox"/> S-630-4	<input type="checkbox"/>	STEEL SIGN SUPPORT (TEMPORARY) INSTALLATION DETAILS... (NEW, MARCH 22, 2010)	
<input type="checkbox"/> S-630-5	<input type="checkbox"/>	PORTABLE RUMBLE STRIPS (TEMPORARY)..... (NEW, MAY 05, 2011)	
<input type="checkbox"/> S-630-6	<input type="checkbox"/>	EMERGENCY PULL-OFF AREA (TEMPORARY)..... (NEW, MAY 05, 2011)	
<input type="checkbox"/> S-630-7	<input type="checkbox"/>	ROLLING ROADBLOCKS FOR TRAFFIC CONTROL	(NEW, MAY 05, 2011)

THE STANDARD PLAN SHEETS INDICATED HEREON BY A MARKED BOX ARE TO BE USED TO CONSTRUCT THIS PROJECT.

ALL OF THE M&S STANDARD PLANS, AS SUPPLEMENTED AND REVISED, APPLY TO THIS PROJECT WHEN USED BY DESIGNATED PAY ITEM OR SUBSIDIARY ITEM.

COLORADO
DEPARTMENT OF TRANSPORTATION

STANDARD PLANS LIST
M&S STANDARDS
July 04, 2006
Revised on March 26, 2012

Computer File Information			<div><div><div>R-X</div><div>R-X</div><div>R-X</div><div>R-X</div></div></div>	Sheet Revisions		<div><div><div><div>Colorado Department of Transportation</div><div><div><div><div><div><div><div></div><div>DOT</div></div></div><div><div>DEPARTMENT OF TRANSPORTATION</div></div></div><div><div>4201 East Arkansas Avenue</div><div>Denver, Colorado 80222</div><div>Phone: (303) 757-9083</div><div>Fax: (303) 757-9820</div></div></div><div><div>Project Development Branch</div><div>DD/LTA</div></div></div></div></div></div></div>	STANDARDS PLANS LIST		STANDARD PLAN NO.	
Creation Date: 07/04/06		Initials: DD		Date:	Comments		NA			
Last Modification Date: 03/26/12		Initials: LTA								
Full Path: www.dot.state.co.us/DesignSupport/										
Drawing File Name: Standards Plans List.dwg										
CAD Ver.: MicroStation	Scale: Not to Scale	Units: English					Issued By: Project Development Branch July 04, 2006			
						Sheet No. 1 of 1		2		

5/22/2012 4:02:23 PM P:\10-028.13 Region 1 Umbrella 2011 CDDT\102 - SH 9 Signal Interconnect\18777\Traffic_ITS\Drawings\18777TRAF_GenlNote01.dgn

GENERAL NOTES

- 1. The Project consists of furnishing and installing pull boxes, conduit, fiber optic cable, and associated communications equipment for CDOT Region 1. For specific details of infrastructure installation, see the corresponding sections of these plan sheets and the Project Special Provisions. All work shall be in accordance with the Colorado Department of Transportation's (CDOT) Standard Specifications for Road and Bridge Construction, 2011 Edition, and CDOT's Standard Plans, M & S Standard Plans, 2009 Edition, the Manual of Uniform Traffic Control Devices, 2009 Edition, and the National Electric Code (NEC).
- 2. The Contractor shall not close or obstruct business or residential driveways unless approved in writing by the Engineer.
- 3. No construction vehicles shall be in the traveled way at any time without appropriate construction traffic control.
- 4. Any and all sidewalks and designated bike paths shall remain open at all times, unless approved in writing by the Project Engineer.
- 5. Upon completion of the work, the Contractor shall submit record drawings, "AS-CONSTRUCTED" Plans to CDOT, showing the actual location of conduit, fiber optic cable, pull boxes, and other significant work items at no additional cost to the project. Pull box locations shall be recorded on the as-constructed drawings with GPS verified longitude and latitude. "AS-CONSTRUCTED" Plans shall be the construction plan set with changes marked in red ink. This will not be paid for separately, but shall be included in the cost of the project. Documents in the form of prints shall be submitted at the time the system acceptance tests begin.
- 6. Right-of-way shown on the plans is based on GIS record information available at time of print. The information is provided to the Contractor to identify construction constraints. Prior to working in an area, the Contractor shall field verify the apparent available right-of-way (as identified by fences, monuments, buildings, maintained private property, etc) to verify construction constraints. All construction shall be within CDOT rights-of-way, or easements.
- 7. There are many different monuments that may be in the areas of the construction for this project. These monuments could range from CDOT Control Monuments, CDOT ROW Monuments, High Accuracy Reference Network (HARN) Monuments, first, second, or third order benchmarks, and public land survey monuments. All of which are very costly to replace, minimum of \$5,000 to as high as \$66,000+ per mark. The Contractor shall make adjustments in the field to avoid the monuments. CDOT in no way accepts the liability of finding all monumentation on all construction sites. The Contractor is ultimately responsible for the replacement of any monuments disturbed and/or destroyed by the construction of the improvements within the construction limits.
- 8. All staging areas shall be submitted to the Engineer for approval.
- 9. All excavations left unattended shall be fenced with orange safety fence and metal posts driven into the ground on a maximum of 10' centers.
- 10. The bid quantities of the project are the result of a careful quantity takeoff by the Engineer. The Contractor shall, however, satisfy himself as to the accuracy of all quantities and bring any discrepancies to the attention of the Engineer, in writing, at his earliest opportunity.
- 11. All item locations are approximate and are to be field located by the appropriate agencies.
- 12. The Contractor is required to submit a minimum of three (3) copies of the material data sheets to CDOT for review. CDOT shall review the required submittals and return comments within 14 days.
- 13. Multiple conduit installation crews may be required to complete the work within the contract completion time.

UTILITY NOTES

- 14. If potholing in a concrete sidewalk, the Contractor may be allowed to patch the sidewalk; however, this would be at the discretion of the project Engineer and the Town of Breckenridge and/or the Town of Frisco. It is estimated that approximately **139 SY** of concrete sidewalk replacement will be required for conduit installation.

- 15. The Contractor's attention is directed to Subsection 105.11 of the Standard Specifications concerning utilities and the Utility Specification for this project. The Contractor shall verify and be responsible for all utility features, including all underground and above ground utilities, prior to beginning any work. The Contractor shall be responsible for field locating and verifying all utility information. For utility construction coordination, the Contractor shall contact the Utility Notification Center for Colorado at 811.
- 16. Potholing will be required on this project and paid for separately as Item 203 - Potholing. It is estimated that **150** hours of potholing will be required for this project. The Contractor shall locate and pothole all potential conflicts with existing buried utility facilities within the proposed construction limits, as shown by field location markings. If a conflict exists, modify proposed construction plans to avoid all existing buried utility facilities. Potholing in concrete shall be at the direction of the project Engineer.

CONDUIT/SIGNAL NOTES

- 17. A locating wire (one #12 AWG insulated) and pull tape shall be placed in all conduit. This work shall be included in the unit price for fiber and will not be paid separately. Pavement and/or sidewalk shall be replaced in kind at bore pit locations. Pavement and sidewalk replacement shall not be paid for separately but shall be included in the cost of conduit.
- 18. All conduit shall be Schedule 80 HDPE. Directional bored conduit shall be installed at a minimum depth as shown in the "Conduit Installation Detail" sheet, unless otherwise directed by the Engineer.
- 19. Street cuts for conduits on existing pavements shall not be allowed, unless otherwise shown on the plans.
- 20. This project includes pulling fiber optic cables through a portion of existing conduit. Contractor shall not damage any existing cables in the existing conduit.
- 21. Contractor shall ream and clean all conduit prior to installing new fiber optic cable(s) to verify whether the conduit is useable. Contractor shall notify CDOT of any damaged, or unusable, segments of existing conduit.
- 22. Salvage all traffic signal equipment to CDOT Region 1 Frisco Maintenance Facility, 219 CR 1003, and Frisco, CO 80443. Contact Steve Smith 970-485-0136.
- 23. The Contractor should expect to encounter rocky soil conditions during conduit trenching and boring activities.
- 24. At the direction of the project engineer, a 24" shallow trench may be used where very rocky soil conditions are encountered (see Conduit Installation Detail Sheet). Conduit installed on a shallow trench shall be paid for as "Electrical Conduit (Plastic)(Multiduct)".
- 25. All new pull boxes shall be marked with a flat slat location marker. Placement of location maker in the Town of Breckenridge shall be 4' in height above ground surface.

FIBER OPTIC CABLE NOTES

- 26. Fiber acceptance test results shall be provided in paper and electronic formats upon completion. The Contractor shall provide any software necessary to view electronic tests results. This shall be included in the cost of Item 614 – Test Fiber Optic Cable.
- 27. Contact Jim Chase, CDOT Region 1 at 303-981-0922 at least 3 days prior to splicing to review splicing details.
- 28. The Contractor shall splice the fiber optic cable only at approved splice locations as shown on the plans. All backbone fiber optic cable shall run continuously and un-spliced from end to end with intermediate reel-to-reel splices at no less than 3 mile intervals. Mid-sheath splices shall be performed at lateral locations and only fibers being spliced shall be cut.
- 29. It is estimated that **412** fiber optic fusion splices will be required for this project.
- 30. Contractor shall contact the appropriate agency staff prior to installing fiber optic cable for direction as to which existing conduit to use and which fiber cable to remove and which fiber cable(s) to protect in place.
- 31. Fiber testing cannot commence until all fiber work is complete.
- 32. It is estimated that approximately **13,371** linear feet of existing fiber shall be removed.

Print Date: 5/22/2012		Sheet Revisions			Colorado Department of Transportation		As Constructed		GENERAL NOTES			Project No./Code		
Drawing File Name: 18777TRAF_GenlNote01.dgn							No Revisions:					MTCE 0091-039		
Horiz. Scale: 1:1		0000	Date:	Comments	Init.		Revised:		Designer:	KEB	Structure	18777		
Unit Information							Void:		Detailer:	PJS	Numbers	Sheet Number		
Unit Leader Initials									Sheet Subset:	NOTES	Subset Sheets:	1 of 2	3	
 Muller Engineering Co., Inc. Consulting Engineers														
P:\10-028.13 - SH 9 Interconnect\Traffic_ITS							Region 1		SS					


EROSION CONTROL NOTES

33. The Contractor shall replace any damaged landscape, including but not limited to, topsoil, grass, irrigation system components, trees, shrubs, ground covers and mulch, to its original condition. Sod shall match existing. In areas not sodded, seeding (native), mulching (weed free), and mulch tackifier shall be used. The Contractor shall coordinate with the Owner's landscape maintenance personnel at least five (5) working days in advance of starting work in the area. With proper and timely notification, the Owner's landscape maintenance personnel shall mark and identify the irrigation system components. This is in no way all inclusive of all utilities or all of the irrigation system. No landscape shall be without watering services during the growing season. If the irrigation service is interrupted for more than three days, the Contractor shall be liable to hand/truck water and possibly all plant replacement in the affected landscape. Landscape restoration shall be considered complete when the landscape and irrigation system is restored to its original condition and approved by the maintaining personnel. The Owner's landscape maintenance personnel, prior to burial, shall inspect all repair work to any irrigation components, and provide acceptance of said work. Work shall be paid for as bid Item 700 - Erosion Control Force Account.
34. All erosion/sediment control and stormwater responsibilities stated in the Stormwater Management Plan and Standard Specifications Subsections 101, 107, and 208 shall be followed or amended, as noted in the Special Provisions. It is estimated that **500** linear feet of Item 208 – Gravel Bag will be required for this project.
35. Erosion logs shall be placed around the boring operations to contain the slurry. Protection shall be mobile in nature. It is estimated that **4000** linear feet of Item 208 – Erosion Logs will be required for this project. One-time re-use of logs is permitted only if log cover is intact and no excelsior is able to discharge. Logs around a protected area; i.e., pull box, bore pit, etc, must have good overlap. Prior to moving logs for re-use, the area must be permanently stabilized by seeding and or mulching. Approved spray-on products are allowed.

ENVIRONMENTAL NOTES

36. The Contractor shall ensure that no materials, equipment, or vehicles are staged or parked near wetland, drainage areas, or open space. The Contractor shall remove, in a timely manner, all sediment, mud, debris or other potential pollutants which may be discharged to, or accumulate in, the flow lines and public rights-of-way as a result of construction activities associated with this project.
37. The Contractor shall keep all environmentally sensitive areas, such as waterways, ditches, prairie dog colonies, wetlands, and the like, free and clear of debris. No parking or staging shall be allowed in any such areas either.
38. A piping plover and burrowing owl nest survey will need to be completed by the CDOT Wildlife Biologist no more than 7 days prior to any ground disturbance activities. Contact Jim Eussen, R1 Biologist at 303-365-7041.
- Migratory Bird Treaty Act: No clearing, grubbing, removal of vegetation or any work on or under bridges may occur during the primary nesting season between April 1 and August 31 to avoid violation of the Migratory Bird Treaty Act. If the proposed construction occurs during the primary nesting season, or at any other time which may result in the take of migratory birds, a qualified biologist will need to conduct a field survey of the affected habitats and structures prior to ground disturbance. The survey should occur during the nesting season and not more than one week (7 days) prior to the proposed disturbance activity. Contact Jim Eussen, R1 Biologist at 303-365-7041.
39. Short grass prairie initiative: all off-pavement disturbances will be tracked and the final square feet of disturbance will be reported to the CDOT Environmental Project Manager at the conclusion of construction.

LEGEND:

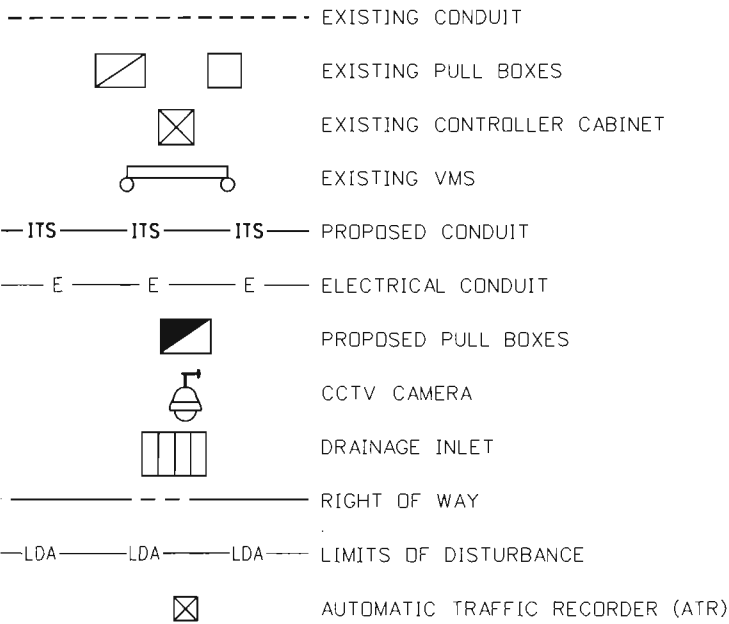

5/22/2012 3:01:12 PM P:\10-028.13 Region 1 Umbrella 2011 CDDT\102 - SH 9 Signal Interconnect\18777\Traffic_ITS\Drawings\18777TRAF_GenNote01.dgn

Print Date: 5/22/2012		Sheet Revisions			Colorado Department of Transportation		As Constructed		GENERAL NOTES AND LEGEND			Project No./Code	
Drawing File Name: 18777TRAF_GenNote01.dgn							No Revisions:					MTCE 0091-039	
Horiz. Scale: 1:1		Vert. Scale: As Noted		<div><div></div><div></div><div></div><div></div></div>					Designer: KEB		18777		
Unit Information		Unit Leader Initials							Detailer: PJS		Sheet Number		
<div><div>MULLER</div><div>Muller Engineering Co., Inc. Consulting Engineers</div></div>		<div><div>apexdesign</div><div>P:\10-028.13 - SH 9 Interconnect\Traffic_ITS</div></div>							Sheet Subset: NOTES		Subset Sheets: 2 of 2		
									Void:		Sheet Number 4		
					<div><div></div><div>18500 East Colfax Avenue Aurora, CO 80011 Phone: 303-757-9648 FAX: 303-757-9746</div></div>		SS						
					Region 1								

5/23/2012 3:00:29 PM P:\10-028.13 Region 1 Umbrello 2011 CDDT\102 - SH 9 SignalInterconnect\18777\Traffic_ITS\Drawings\18777TRAF_SAQ.dgn

ITEM	DESCRIPTION	UNIT	TRAFFIC SIGNAL INTERCONNECT SUBSET SHEET																														
			1	2	3	4	5	6	7	8	9	10	11	12	13	14	15	16	17	18	19	20	21	22	23	24	25	26	27	28	29	30	31
202-00827	REMOVAL OF PULL BOX	EA									1																						
203-00000	UNCLASSIFIED EXCAVATION	CY			3		8																										
203-01500	BLADING	HR																															
203-01597	POTHOLING	HR																															
208-00002	EROSION LOG (12 INCH)	LF																															
208-00034	GRAVEL BAG	LF																															
208-00045	CONCRETE WASHOUT STRUCTURE	EA																															
208-00103	REMOVAL AND DISPOSAL OF SEDIMENT (LABOR)	HR																															
208-00105	REMOVAL AND DISPOSAL OF SEDIMENT (EQUIPMENT)	HR																															
208-00106	SWEEPING (SEDIMENT REMOVAL)	HR																															
208-00107	REMOVAL OF TRASH	HR																															
208-00205	EROSION CONTROL SUPERVISOR	HR																															
210-00090	RESET DELINEATOR	EA																															
210-00810	RESET GROUND SIGN	EA						7	2																								
212-00006	SEEDING (NATIVE)	ACRE																															
212-00032	SOIL CONDITIONING	ACRE																															
213-00002	MULCHING (WEED FREE HAY)	ACRE																															
213-00012	SPRAY-ON MULCH BLANKET	ACRE																															
213-00061	MULCH TACKIFIER	LB																															
216-00201	SOIL RETENTION BLANKET (STRAW-COCONUT)(BIODEGRADABLE CLASS 1)	SY																															
608-00000	CONCRETE SIDEWALK	SY			83	24	32																										
612-00270	LOCATION MARKER (UTILITY) (FLAT SLAT)	EA																															
613-00300	3 INCH ELECTRICAL CONDUIT	LF																				110											
613-03491	ELECTRICAL CONDUIT (PLASTIC) (MULTIDUCT)	LF		10	10		10	1175	690											680	1385	1230	1385	1300	1210	1260	1305	1280	400	610	1230	1360	
613-03492	ELECTRICAL CONDUIT (PLASTIC) (MULTIDUCT) (BORED)	LF	935	105	725	1350	1535	175	70										95			105		70	150	140	85	55		65	55		
613-03500	ELECTRICAL CONDUIT (PLASTIC) (MULTIDUCT) (SPECIAL)	LF			75		200																										
613-04125	1 1/4 INCH ELECTRICAL CONDUIT (LIQUIDTIGHT FLEXIBLE METAL)	LF	40							15									30														
613-07023	PULL BOX (24"X36"X24")	EA	1	1	1		3	3	1		1									1		3	1	2	4	4	2	2	1	1	2	2	
613-07040	PULL BOX (30"X48"X24")	EA				1																1											
613-07060	PULL BOX (18"X30"X18") DEEP	EA			3	2	2		2										1														
613-07070	EMS BALL MARKER	EA																															
613-10000	WMRING	LS																	1														
614-72830	COMMUNICATIONS CABINET	EA	1							1										1													

* Included in the Cost of Fiber Optic Cable (Single Mode) (96 Strands)

** Included in the Cost of CCTV Camera (Traffic Surveillance)

Print Date: 5/23/2012

Drawing File Name: 18777TRAF_SAQ.dgn

Horiz. Scale: 1:1

Vert. Scale: As Noted

Unit Information

Unit Leader Initials



Muller Engineering Co., Inc.
Consulting Engineers

apexdesign

P:\10-028.13 - SH 9 Interconnect\Traffic_ITS

Sheet Revisions

Date:	Comments	Init.

Colorado Department of Transportation



Region 1

18500 East Colfax Avenue
Aurora, CO 80011
Phone: 303-757-9648 FAX: 303-757-9746

SS

As Constructed

No Revisions:

Revised:

Void:

SUMMARY OF APPROXIMATE QUANTITIES

Designer:	KEB/PJS	Structure	
Detailer:	PJS	Numbers	
Sheet Subset:	QTY	Subset Sheets:	1 of 4

Project No./Code

MTCE 0091-039

18777

Sheet Number

5

5/23/2012 3:00:50 PM P:\10-028.13 Region 1 Umbrella 2011 CDDT\102 - SH 9 Signal Interconnect\18777\Traffic_ITS\Drawings\18777TRAF_SAQ.dgn

ITEM	DESCRIPTION	UNIT	TRAFFIC SIGNAL INTERCONNECT SUBSET SHEET																								PROJECT TOTALS		
			32	33	34	35	36	37	38	39	40	41	42	43	44	45	46											OTHER	PLAN
202-00827	REMOVAL OF PULL BOX	EA																										1	1
203-00000	UNCLASSIFIED EXCAVATION	CY	50																									61	61
203-01500	BLADING	HR																								20	20	53	
203-01597	POTHOLING	HR																								150	150	211	
208-00002	EROSION LOG (12 INCH)	LF																								4000	4000	2482	
208-00034	GRAVEL BAG	LF																								500	500	155	
208-00045	CONCRETE WASHOUT STRUCTURE	EA																								4	4	1	
208-00103	REMOVAL AND DISPOSAL OF SEDIMENT (LABOR)	HR																								50	50	83	
208-00105	REMOVAL AND DISPOSAL OF SEDIMENT (EQUIPMENT)	HR																								20	20	104	
208-00106	SWEEPING (SEDIMENT REMOVAL)	HR																								54	54	17	
208-00107	REMOVAL OF TRASH	HR																								36	36	26	
208-00205	EROSION CONTROL SUPERVISOR	HR																								300	300	10	
210-00090	RESET DELINEATOR	EA																								50	50	0	
210-00810	RESET GROUND SIGN	EA																									9	0	
212-00006	SEEDING (NATIVE)	ACRE																								5	5	3.9	
212-00032	SOIL CONDITIONING	ACRE																								5	5	3.9	
213-00002	MULCHING (WEED FREE HAY)	ACRE																								5	5	5.3	
213-00012	SPRAY-ON MULCH BLANKET	ACRE																								3	3	4.3	
213-00061	MULCH TACKIFIER	LB																								1000	1000	400	
216-00201	SOIL RETENTION BLANKET (STRAW-COCONUT)(BIODEGRADABLE CLASS 1)	SY																								500	500	0	
608-00000	CONCRETE SIDEWALK	SY																									139	155	
612-00270	LOCATION MARKER (UTILITY) (FLAT SLAT)	EA																								100	100	48	
613-00300	3 INCH ELECTRICAL CONDUIT	LF																									110	110	
613-03491	ELECTRICAL CONDUIT (PLASTIC) (MULTIDUCT)	LF		1255	1380	1300	1345	315																			22125	20,900	
613-03492	ELECTRICAL CONDUIT (PLASTIC) (MULTIDUCT) (BORED)	LF																									5715	3,640	
613-03500	ELECTRICAL CONDUIT (PLASTIC) (MULTIDUCT) (SPECIAL)	LF	1355																								1630	3,340	
613-04125	1 1/4 INCH ELECTRICAL CONDUIT (LIQUIDTIGHT FLEXIBLE METAL)	LF																									85	15	
613-07023	PULL BOX (24"X36"X24")	EA	1	1	1		1	1																			41	41	
613-07040	PULL BOX (30"X48"X24")	EA																									2	2	
613-07060	PULL BOX (18"X30"X18") DEEP	EA																									10	8	
613-07070	EMS BALL MARKER	EA																								100	100	48	
613-10000	WMRING	LS																									1	1	
614-72830	COMMUNICATIONS CABINET	EA																									3	3	

* Included in the Cost of Fiber Optic Cable (Single Mode) (96 Strands) ** Included in the Cost of CCTV Camera (Traffic Surveillance)

Print Date: 5/23/2012

Drawing File Name: 18777TRAF_SAQ.dgn

Unit Information

Unit Leader Initials

Horiz. Scale: 1:1

Vert. Scale: As Noted

MULLER

Muller Engineering Co., Inc.
Consulting Engineers

apexdesign

P:\10-028.13 - SH 9 Interconnect\Traffic_ITS

Sheet Revisions		
Date:	Comments	Init.

Colorado Department of Transportation



18500 East Colfax Avenue
Aurora, CO 80011
Phone: 303-757-9648 FAX: 303-757-9746

Region 1

SS

As Constructed

No Revisions:

Revised:

Void:

SUMMARY OF APPROXIMATE QUANTITIES

Designer: KEB/PJS

Detailer: PJS

Sheet Subset: QTY

Structure Numbers

Subset Sheets: 3 of 4

Project No./Code

MTCE 0091-039

18777

Sheet Number 7

5/23/2012 3:00:58 PM P:\10-028.13 Region 1 Umbrella 2011 CDDT\102 - SH 9 Signal Interconnect\18777\Traffic\ITS\Drawings\18777TRAF_SAO.dgn

ITEM	DESCRIPTION	UNIT	TRAFFIC SIGNAL INTERCONNECT SUBSET SHEET																										PROJECT TOTALS	
			32	33	34	35	36	37	38	39	40	41	42	43	44	45	46											OTHER	PLAN	AS CONST.
614-86007	SERIAL TO IP CONVERTER	EA						1		1		1	1	1	1	1												18	18	
614-87006	FIBER OPTIC TERMINATION PANEL - 6 FIBER*	EA																										3	3	
614-87010	FIBER OPTIC CABLE (SINGLE MODE) (12 FIBER)	LF																										590	1,975	
614-87012	FIBER OPTIC TERMINATION PANEL - 12 FIBER*	EA						1		1				1														10	10	
614	FIBER OPTIC TERMINATION PANEL - 24 FIBER*	EA									1																	1	1	
614-87015	BUFFER TUBE FAN OUT KIT	EA																										12	12	
614-87310	TRAFFIC MANAGEMENT SYSTEM BUILDING EQUIPMENT	LS									1																	1	1	
614-87320	CLOSED CIRCUIT TELEVISION	EA						1		1		1		1														16	16	
614-87325	CLOSED CIRCUIT TELEVISION POLE	EA																										3	2	
614	CLOSED CIRCUIT TELEVISION CABLE**	LF						165		100		85		135														1495	1,495	
614-87350	TEST FIBER OPTIC CABLE	LS																								1	1	1	1	
614-87496	FIBER OPTIC CABLE (SINGLE MODE) (96 STRANDS)	LF	1405	1305	1430	1300	1395	1400	1425	2335	880																	58590	61,300	
614-87690	ETHERNET SWITCH	EA						1		1		1	1	1	1	1	1											20	20	
614	FIBER OPTIC SPLICE CLOSURE*	EA						1		1																		14	14	
620-00020	SANITARY FACILITY	EA																								1	1	1	1	
626-00005	MOBILIZATION	LS																								1	1	1	1	
630-00000	FLAGGING	HR																								350	350	134	134	
630-00007	TRAFFIC CONTROL INSPECTION	DAY																								48	48	47	47	
630-00012	TRAFFIC CONTROL MANAGEMENT	DAY																								120	120	87	87	
630-80335	BARRICADE (TYPE 3 M-A) (TEMPORARY)	EA																								2	2	0	0	
630-80341	CONSTRUCTION TRAFFIC SIGN (PANEL SIZE A)	EA																								8	8	5	5	
630-80342	CONSTRUCTION TRAFFIC SIGN (PANEL SIZE B)	EA																								24	24	21	21	
630-80343	CONSTRUCTION TRAFFIC SIGN (PANEL SIZE C)	EA																								8	8	0	0	
630-80355	PORTABLE MESSAGE SIGN PANEL	EA																								2	2	2	2	
630-80358	ADVANCED WARNING FLASHING OR SEQUENCING ARROW PANEL (C TYPE)	EA																								2	2	1	1	
630-80360	DRUM CHANNELIZING DEVICE	EA																								50	50	50	50	
630-80380	TRAFFIC CONE	EA																								100	100	96	96	
630-85040	IMPACT ATTENUATOR (TRUCK MOUNTED ATTENUATOR) (TEMPORARY)	EA																								1	1	1	1	
700-70010	F/A MINOR CONTRACT REVISIONS	FA																								1	1			
700-70011	F/A PARTNERING	FA																								1	1	0	0	
700-70016	F/A FUEL COST ADJUSTMENTS	FA																								1	1	0	0	
700-70380	F/A EROSION CONTROL	FA																								1	1	0	0	

* Included in the Cost of Fiber Optic Cable (Single Mode) (96 Strands)

** Included in the Cost of CCTV Camera (Traffic Surveillance)

Print Date: 5/23/2012

Drawing File Name: 18777TRAF_SAO.dgn

Horiz. Scale: 1:1

Vert. Scale: As Noted

Unit Information

Unit Leader Initials

MULLER Muller Engineering Co., Inc.
Consulting Engineers

apexdesign

P:\10-028.13 - SH 9 Interconnect\Traffic\ITS

Sheet Revisions

Date:	Comments	Init.

Colorado Department of Transportation



Region 1

18500 East Colfax Avenue
Aurora, CO 80011
Phone: 303-757-9648 FAX: 303-757-9746

SS

As Constructed

No Revisions:

Revised:

Void:

SUMMARY OF APPROXIMATE QUANTITIES

Designer:	KEB/PJS	Structure	
Detailer:	PJS	Numbers	
Sheet Subset:	QTY	Subset Sheets:	4 of 4

Project No./Code

MTCE 0091-039

18777

Sheet Number

8

5/22/2012 3:00:51 PM P:\10-028.13 Region 1 Umbrella 2011 CDDT\102 - SH 9 Signal Interconnect\18777\Traffic\ITS Drawings\18777TRAF_ConstNote01.dgn

CONSTRUCTION NOTES

- 1

EXISTING VMS (GROUND MOUNTED)
- 2

EXISTING PULL BOX (12" X 18")
- 3

NOT USED
- 4

EXISTING PULL BOX (13" X 24")
- 5

EXISTING PULL BOX (17" X 30")
- 6

EXISTING PULL BOX (24" X 36")
- 7

EXISTING PULL BOX (30" X 48")
- 8

EXISTING PULL BOX
- 9

EXISTING TRAFFIC SIGNAL CONTROLLER CABINET
- 10

EXISTING POLE MOUNTED VMS CABINET
- 11

EXISTING 2" ELECTRICAL CONDUIT
- 12

EXISTING 3" ELECTRICAL CONDUIT
- 13

EXISTING ELECTRICAL CONDUIT
- 14

EXISTING FIBER OPTIC CABLE (SINGLE MODE) (12 STRAND)
- 15

EXISTING FIBER OPTIC CABLE (SINGLE MODE) (24 STRAND)
- 16

EXISTING FIBER OPTIC CABLE (SINGLE MODE) (96 STRAND)
- 17

PROTECT IN PLACE
- 18

REMOVE EXISTING FIBER BACKBONE CABLE
- 19

REMOVE EXISTING PULL BOX
- 20

PULL BOX (18" X 30" X 18")
- 21

PULL BOX (24" X 36" X 24")
- 22

2-2 INCH ELECTRICAL CONDUIT (MULTIDUCT) (PLASTIC)
- 23

2-2 INCH ELECTRICAL CONDUIT (MULTIDUCT) (BORED)
- 24

3 INCH ELECTRICAL CONDUIT - SEE CONDUIT ATTACHMENT TO BLUE RIVER STRUCTURE DETAIL
- 25

PULL BOX (30" X 48" X 24")
- 26

INSTALL 2-2 INCH ELECTRICAL CONDUITS BETWEEN ADJACENT PULL BOXES
- 27

1-¼ INCH ELECTRICAL CONDUIT (LIQUIDTIGHT FLEXIBLE METAL)
- 28

CLOSED CIRCUIT TELEVISION CAMERA (TRAFFIC SURVEILLANCE)
- 29

CLOSED CIRCUIT TELEVISION CABLE
- 30

FIBER OPTIC CABLE (SINGLE MODE) (12 STRANDS) (LATERAL)
- 31

NOT USED
- 32

FIBER OPTIC CABLE (SINGLE MODE) (96 STRANDS) (BACKBONE)
- 33

COIL 10 LINEAR FEET OF EACH FIBER OPTIC LATERAL CABLE IN CABINET FOR SLACK
- 34

COIL 25 LINEAR FEET OF EACH FIBER OPTIC LATERAL CABLE IN PULL BOX FOR SLACK
- 35

COIL 25 LINEAR FEET OF EACH FIBER OPTIC BACKBONE CABLE IN PULL BOX FOR SLACK
- 36

COIL 50 LINEAR FEET OF EACH FIBER OPTIC BACKBONE CABLE IN PULL BOX FOR SLACK
- 37

COIL 100 LINEAR FEET OF EACH FIBER OPTIC BACKBONE CABLE IN PULL BOX FOR SLACK
- 38

FIBER OPTIC SPLICE CLOSURE. FUSION SPLICE FIBERS PER SPLICING DETAIL SHEETS.
- 39

FIBER OPTIC TERMINATION PANEL - 6 FIBER
- 40

FIBER OPTIC TERMINATION PANEL - 12 FIBER
- 41

FIBER OPTIC TERMINATION PANEL - 24 FIBER
- 42

NOT USED
- 43

NOT USED
- 44

TRAFFIC MANAGEMENT SYSTEM BUILDING EQUIPMENT - INCLUDING CABINET AND ETHERNET SWITCH (CORE)
- 45

NOT USED
- 46

ETHERNET SWITCH
- 47

SERIAL TO IP CONVERTER
- 48

NOT USED
- 49

STORM DRAIN INLET PROTECTION
- 50

INSTALL PULL BOX IN CONCRETE SIDEWALK AND REPLACE PANEL
- 51

EXISTING AUTOMATIC TRAFFIC RECORDER (ATR)
- 52

CLOSED CIRCUIT TELEVISION POLE AND COMMUNICATIONS CABINET
- 53

COIL 200 LINEAR FEET OF EACH FIBER OPTIC BACKBONE CABLE IN PULL BOX FOR SLACK
- 54

SERIAL CABLE
- 55

EXISTING FIBER OPTIC TERMINATION PANEL - 12 FIBER
- 56

CONDUIT TO BE INSTALLED PER THE SHALLOW TRENCH DETAIL IF SUBSURFACE CONDITIONS WARRANT
- 57

EXISTING FIBER OPTIC TERMINATION PANEL - 6 FIBER
- 58

REMOVE EXISTING FIBER OPTIC TERMINATION PANEL - 6 FIBER
- 59

WIRING. THE CONTRACTOR SHALL BE RESPONSIBLE FOR DETERMINING THE MINIMUM AMPACITY AND SIZE OF THE CONDUCTORS FOR THIS RUN BASED ON A MAXIMUM VOLTAGE DROP OF 3% BASED ON ARTICLES 210-19, 215-2, OR 230-31 OF THE NEC, AS APPLICABLE. THE MAXIMUM TOTAL VOLTAGE DROP FOR A COMBINATION OF BOTH BRANCH CIRCUIT AND FEEDER SHALL NOT EXCEED 5%. GROUNDING CONDUCTORS SHALL CONFORM TO ARTICLE 250-122 OF THE NEC.
- 60

2 - 2 INCH ELECTRICAL CONDUIT (PLASTIC) (MULTIDUCT) (SPECIAL)

Print Date: 5/22/2012	
Drawing File Name:18777TRAF_ConstNote01.dgn	
Horiz. Scale: 1:1	Vert. Scale: As Noted
Unit Information	Unit Leader Initials
<div><div>MULLER</div><div>Muller Engineering Co., Inc. Consulting Engineers P:10-028.13 - SH 9 Interconnect\Traffic-ITS</div></div>	<div><div>apexdesign</div></div>

Sheet Revisions		
Date:	Comments	Init.

Colorado Department of Transportation

DOT

DEPARTMENT OF TRANSPORTATION


Region 1

18500 East Colfax Avenue
Aurora, CO 80011
Phone: 303-757-9648 FAX: 303-757-9746

SS

As Constructed		CONSTRUCTION NOTES			Project No./Code
No Revisions:					MTCE 0091-039
Revised:		Designer: KEB	Structure Numbers		18777
Void:		Detailer: PJS			
		Sheet Subset: C-NOTES	Subset Sheets: 1 of 1		Sheet Number 9

5/22/2012 3:08:36 PM P:\10-028.13 Region 1 Umbrell 2011 CDDT\102 - SH 9 Signal Interconnect\18777\Traffic\ITS\Drawings\18777TRAF_SheetIndex.dgn

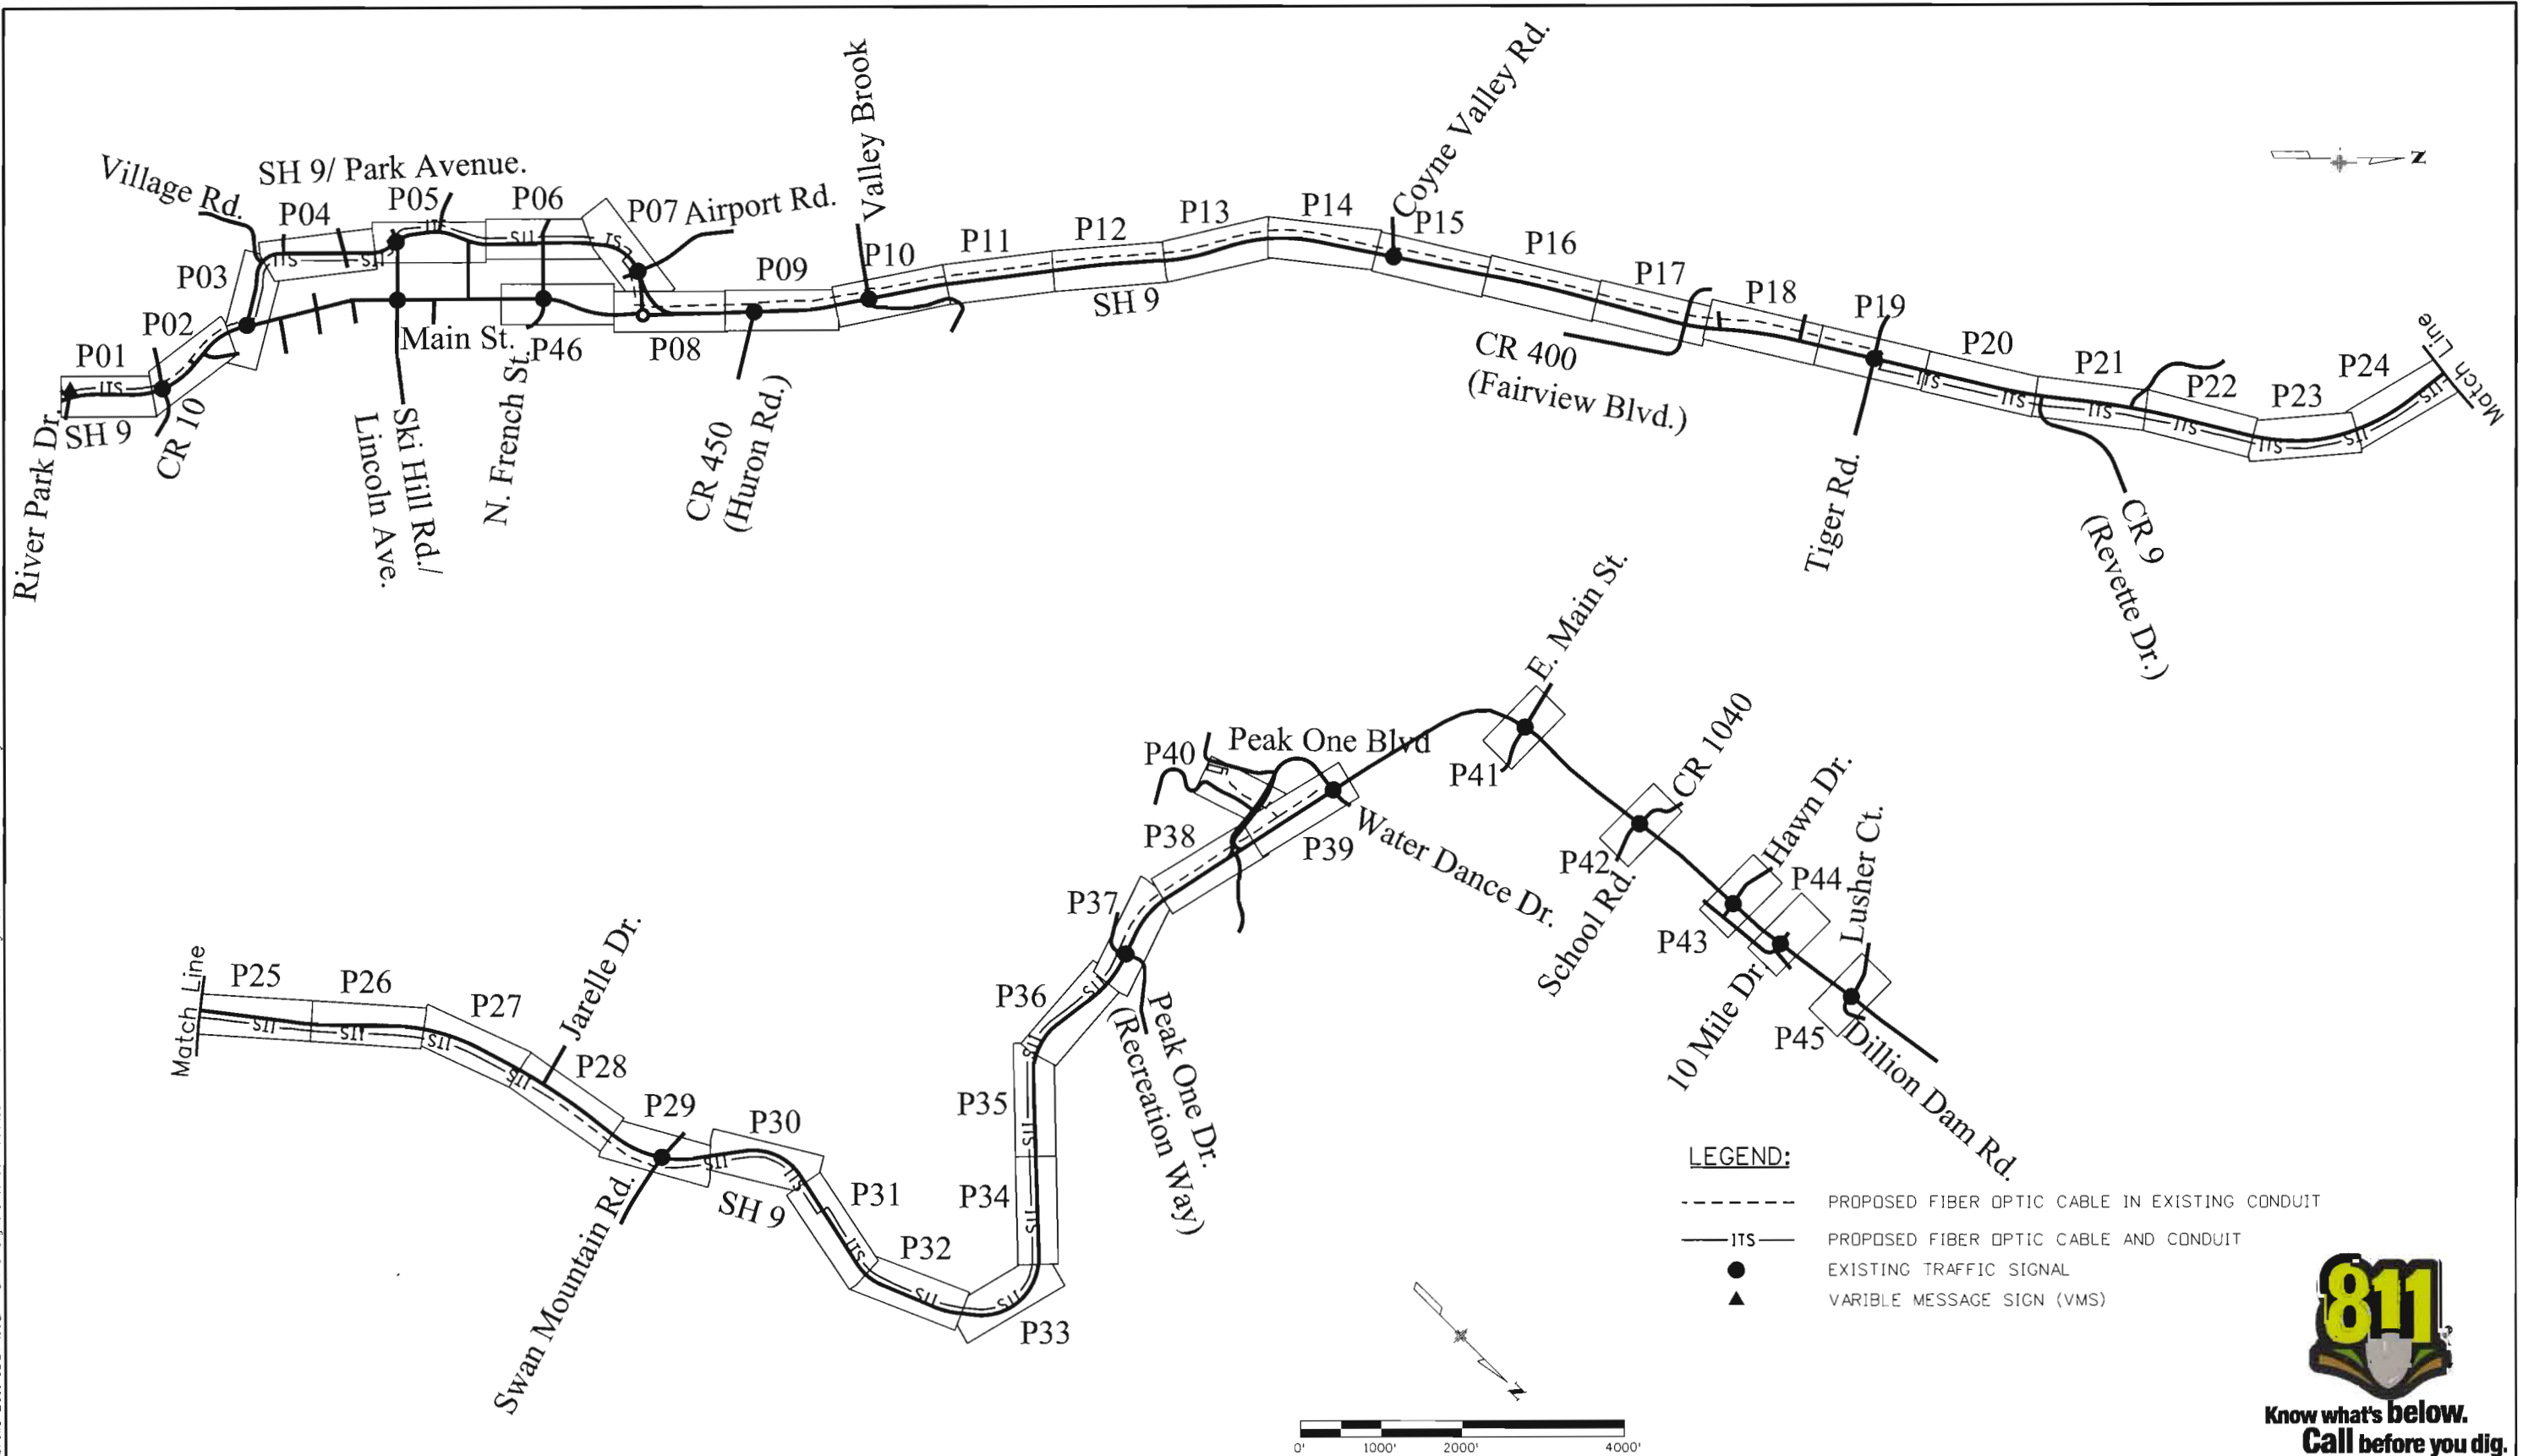


Know what's below.
Call before you dig.

Print Date: 5/22/2012		Sheet Revisions			Colorado Department of Transportation		As Constructed		INTERCONNECT PLANS INDEX SHEET			Project No./Code	
Drawing File Name:18777TRAF_SheetIndex.dgn							No Revisions:					MTCE 0091-039	
Horiz. Scale: 1:2000		Vert. Scale: As Noted		Revised:			Designer: KEB		Structure		18777		
Unit Information		Unit Leader Initials		Void:			Detailer: PJS		Numbers		Sheet Number		
<div>MULLER Muller Engineering Co., Inc. Consulting Engineers</div>		<div>apexdesign</div>				18500 East Colfax Avenue Aurora, CO 80011 Phone: 303-757-9648 FAX: 303-757-9746						10	
				Region 1		SS		Sheet Subset: INDEX		Subset Sheets: 1 of 1			



- SWMP NOTES:
1. ECS SHALL PLACE BMPs IN THE FIELD AS DIRECTED BY THE SWMP NARRATIVES AND AS REQUIRED BY CDDT SPECIFICATIONS AND THE CDPS-SCP TO ENSURE ALL POTENTIAL POLLUTANTS FROM CONSTRUCTION WILL NOT ENTER STATE WATERS. ECS SHALL SHOW AND UPDATE BMPs ON PLAN SHEETS, SIGN AND DATE WHEN INSTALLED.
 2. CONSTRUCTION BOUNDARY IS EXISTING ROW
 3. SEE SWMP TYPICAL SECTIONS FOR LIMITS OF DISTURBANCE

- | | |
|--|--|
| 1 EXISTING VMS (GROUND MOUNTED) | 37 COIL 100 LINEAR FEET OF EACH FIBER OPTIC BACKBONE CABLE IN PULL BOX FOR SLACK |
| 10 EXISTING POLE MOUNTED VMS CABINET | 38 FIBER OPTIC SPLICE CLOSURE, FUSION SPLICE FIBERS PER SPLICING DETAIL SHEETS. |
| 21 PULL BOX (24" X 36" X 24") | 39 FIBER OPTIC TERMINATION PANEL - 6 FIBER |
| 23 2-2 INCH ELECTRICAL CONDUIT (MULTIDUCT) (BORED) | 46 ETHERNET SWITCH |
| 27 1-1/4 INCH ELECTRICAL CONDUIT (LIQUIDTIGHT FLEXIBLE METAL) | 47 SERIAL TO IP CONVERTER |
| 28 CLOSED CIRCUIT TELEVISION CAMERA (TRAFFIC SURVEILLANCE) | 52 CLOSED CIRCUIT TELEVISION POLE AND COMMUNICATIONS CABINET |
| 29 CLOSED CIRCUIT TELEVISION CABLE | 54 SERIAL CABLE |
| 30 FIBER OPTIC CABLE (SINGLE MODE) (12 STRANDS) (LATERAL) | |
| 32 FIBER OPTIC CABLE (SINGLE MODE) (96 STRANDS) (BACKBONE) | |
| 34 COIL 25 LINEAR FEET OF EACH FIBER OPTIC LATERAL CABLE IN PULL BOX FOR SLACK | |

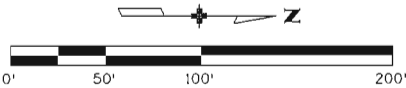

5/22/2012 3:01:17 PM P:\10-028.13 Region 1 Umbrella 2011 CDDT\102 - SH 9 Signal Interconnect\18777\Traffic_ITS\Drawings\18777TRAF_Plan01.dgn


Print Date: 5/22/2012	
Drawing File Name: 18777TRAF_Plan01.dgn	
Horiz. Scale: 1:100	Vert. Scale: As Noted
Unit Information	Unit Leader Initials
MULLER Muller Engineering Co., Inc. Consulting Engineers	apexdesign
P:10-028.13 - SH 9 Interconnect\Traffic_ITS	

Sheet Revisions		
Date:	Comments	Init.

Colorado Department of Transportation	
	18500 East Colfax Avenue Aurora, CO 80011 Phone: 303-757-9648 FAX: 303-757-9746
Region 1	SS

As Constructed		TRAFFIC SIGNAL INTERCONNECT		Project No./Code	
No Revisions:				MTCE 0091-039	
Revised:		Designer: KEB	Structure Numbers	18777	
Void:		Detailer: PJS			
		Sheet Subset: ITS	Subset Sheets: 1 of 46	Sheet Number	11

5/22/2012 3:01:26 PM P:\10-028.13 Region 1 Umbrella 2011 CDDT\102 - SH 9 SignalInterconnect\18777\Traffic_ITS\Drawings\18777TRAF_Plan02.dgn

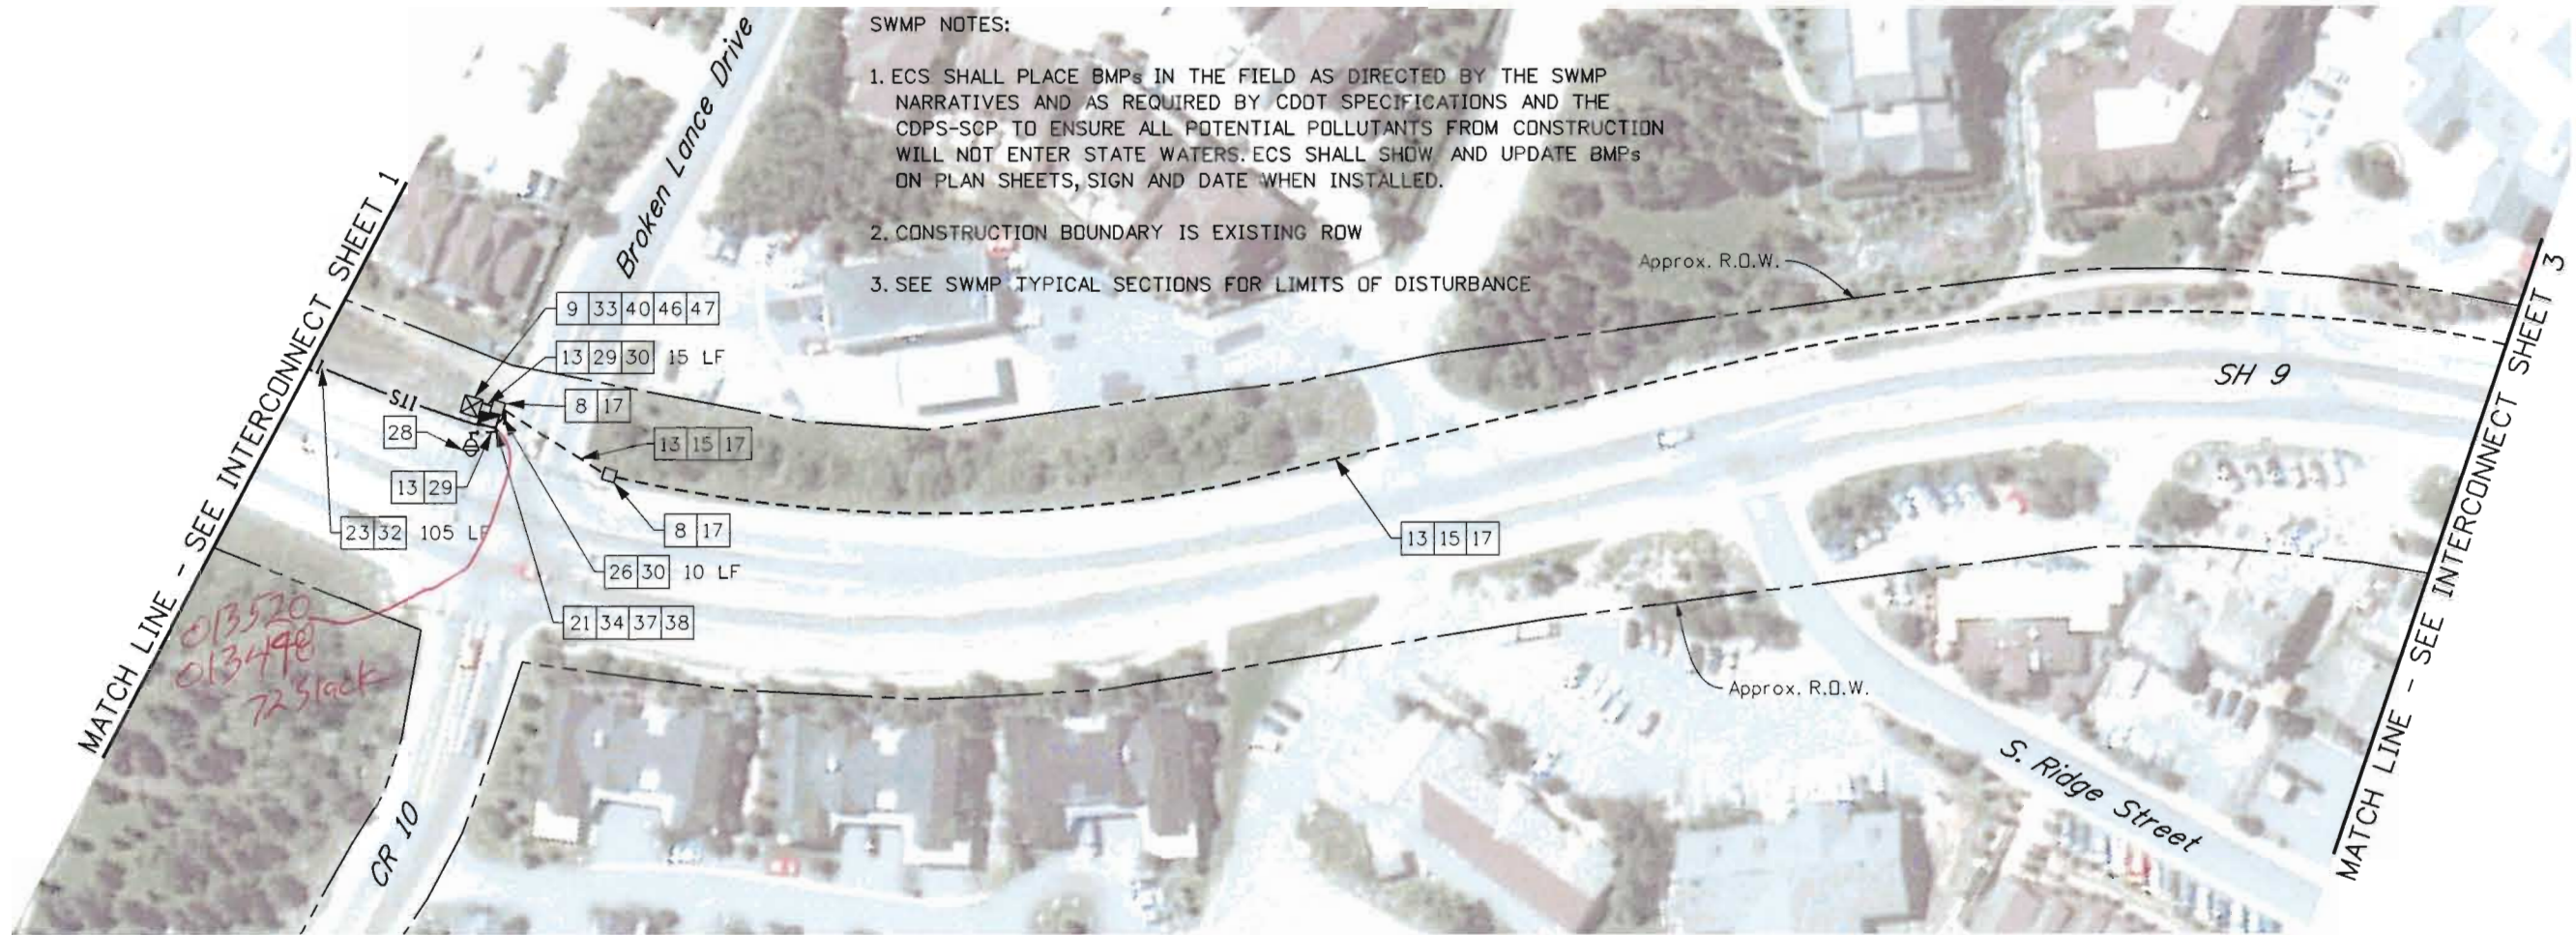

SWMP NOTES:


1. ECS SHALL PLACE BMPs IN THE FIELD AS DIRECTED BY THE SWMP NARRATIVES AND AS REQUIRED BY CDOT SPECIFICATIONS AND THE CDPS-SCP TO ENSURE ALL POTENTIAL POLLUTANTS FROM CONSTRUCTION WILL NOT ENTER STATE WATERS. ECS SHALL SHOW AND UPDATE BMPs ON PLAN SHEETS, SIGN AND DATE WHEN INSTALLED.
2. CONSTRUCTION BOUNDARY IS EXISTING ROW
3. SEE SWMP TYPICAL SECTIONS FOR LIMITS OF DISTURBANCE

- 8 EXISTING PULL BOX
- 9 EXISTING TRAFFIC SIGNAL CONTROLLER CABINET
- 13 EXISTING ELECTRICAL CONDUIT
- 15 EXISTING FIBER OPTIC CABLE (SINGLE MODE) (24 STRAND)
- 17 PROTECT IN PLACE
- 21 PULL BOX (24" X 36" X 24")
- 23 2-2 INCH ELECTRICAL CONDUIT (MULTIDUCT) (BORED)
- 26 INSTALL 2-2 INCH ELECTRICAL CONDUITS BETWEEN ADJACENT PULL BOXES
- 28 CLOSED CIRCUIT TELEVISION CAMERA (TRAFFIC SURVEILLANCE)
- 29 CLOSED CIRCUIT TELEVISION CABLE

- 30 FIBER OPTIC CABLE (SINGLE MODE) (12 STRANDS) (LATERAL)
- 32 FIBER OPTIC CABLE (SINGLE MODE) (96 STRANDS) (BACKBONE)
- 33 COIL 10 LINEAR FEET OF EACH FIBER OPTIC LATERAL CABLE IN CABINET FOR SLACK
- 34 COIL 25 LINEAR FEET OF EACH FIBER OPTIC LATERAL CABLE IN PULL BOX FOR SLACK
- 37 COIL 100 LINEAR FEET OF EACH FIBER OPTIC BACKBONE CABLE IN PULL BOX FOR SLACK
- 38 FIBER OPTIC SPLICE CLOSURE. FUSION SPLICE FIBERS PER SPLICING DETAIL SHEETS.
- 40 FIBER OPTIC TERMINATION PANEL - 12 FIBER
- 46 ETHERNET SWITCH
- 47 SERIAL TO IP CONVERTER




Know what's below.
Call before you dig.

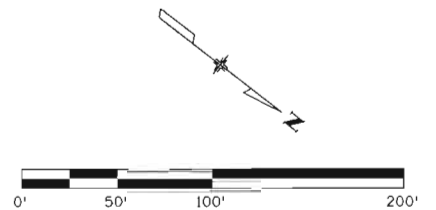


Print Date: 5/22/2012	
Drawing File Name: 18777TRAF_Plan02.dgn	
Horiz. Scale: 1:100	Vert. Scale: As Noted
Unit Information	Unit Leader Initials
MULLER Muller Engineering Co., Inc. Consulting Engineers	apexdesign
P:10-028.13 - SH 9 Interconnect\Traffic_ITS	

Sheet Revisions		
Date:	Comments	Init.

Colorado Department of Transportation	
	18500 East Colfax Avenue Aurora, CO 80011 Phone: 303-757-9648 FAX: 303-757-9746
Region 1	SS

As Constructed		TRAFFIC SIGNAL INTERCONNECT		Project No./Code	
No Revisions:				MTCE 0091-039	
Revised:		Designer: KEB	Structure Numbers	18777	
Void:		Detailer: PJS			
		Sheet Subset: ITS	Subset Sheets: 2 of 46	Sheet Number	12

5/22/2012 3:01:35 PM P:\10-028.13 Region 1 Umbrella 2011 CDDT\102 - SH 9 Signal Interconnect\18777\Traffic_ITS\Drawings\18777\TRAF_Plan03.dgn

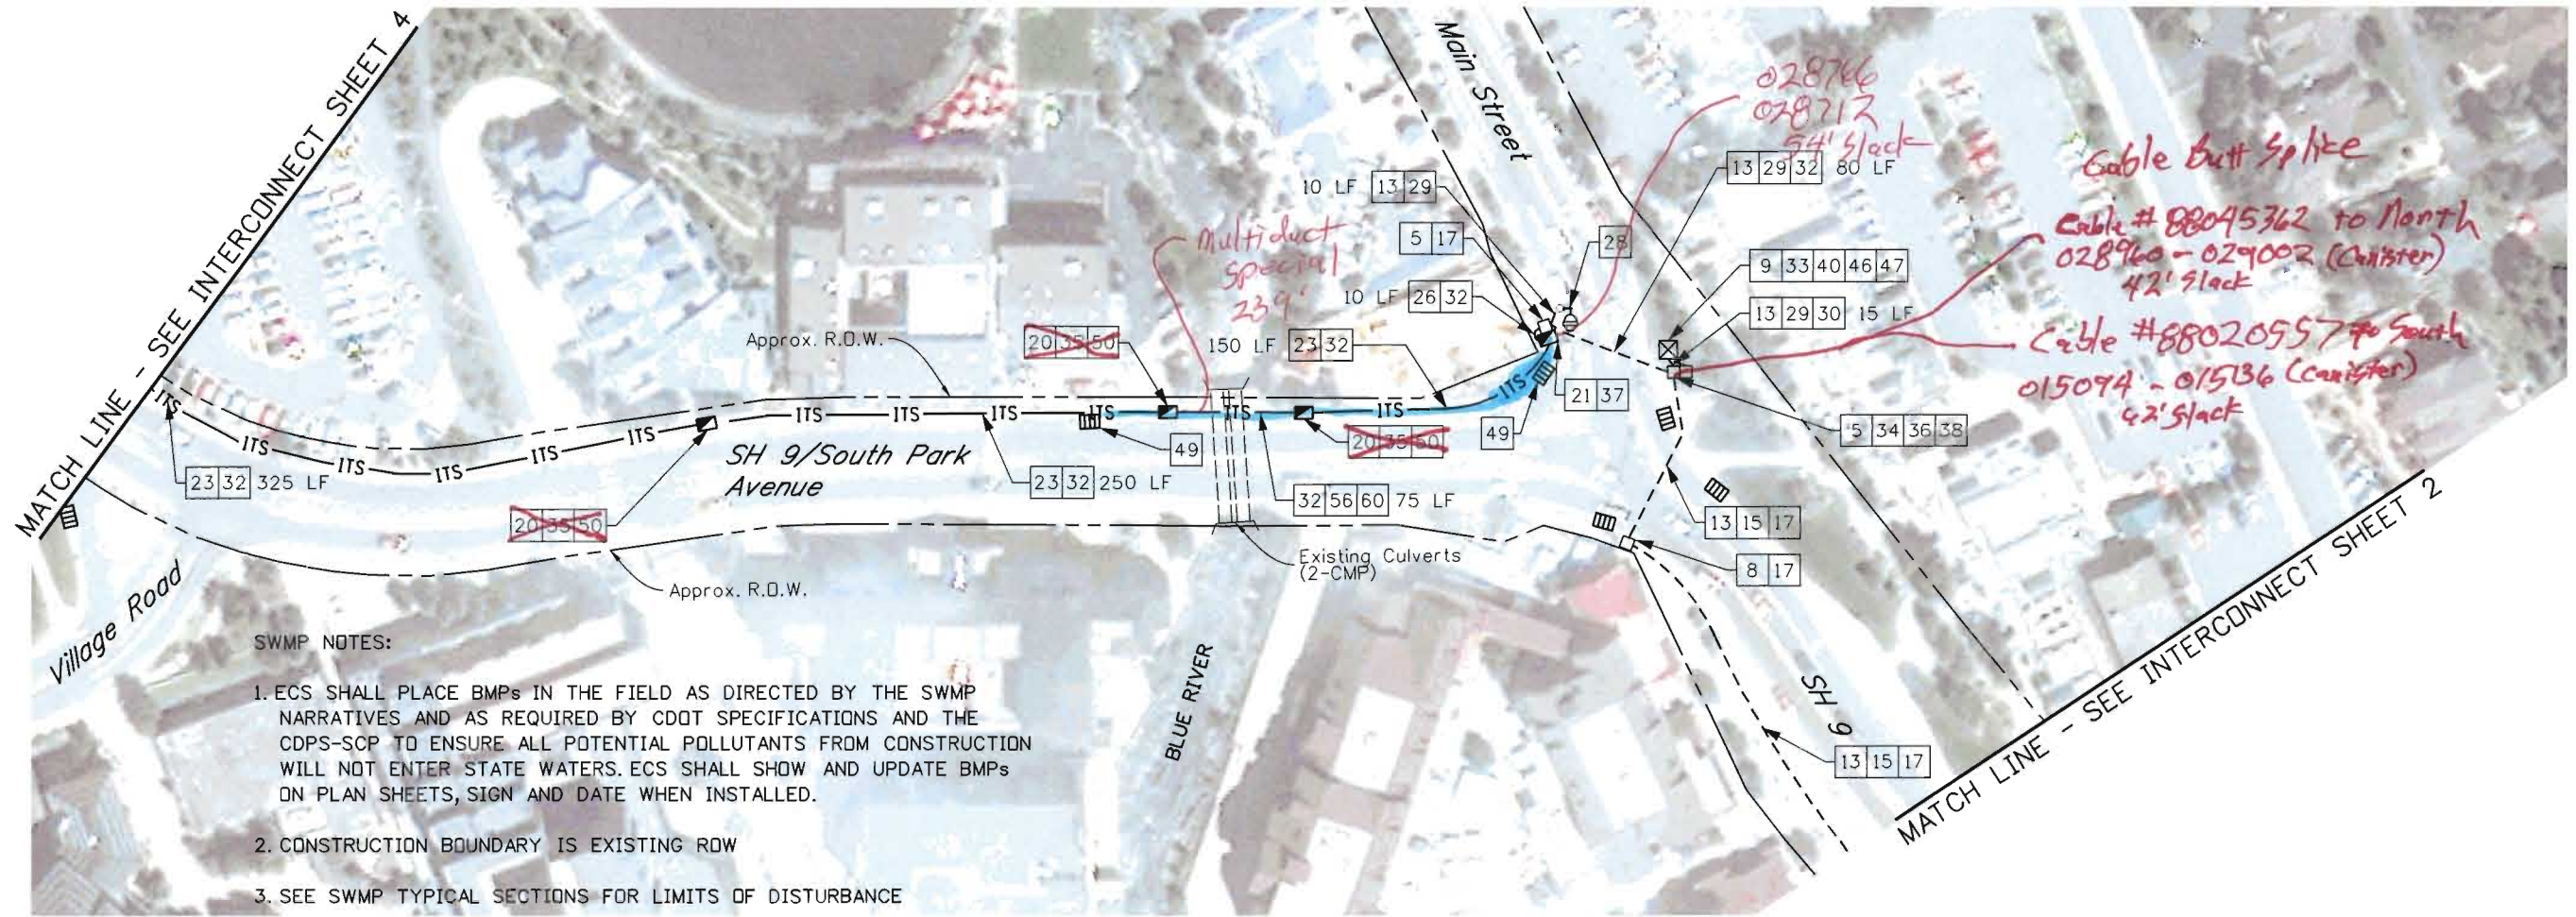

SWMP NOTES:

1. ECS SHALL PLACE BMPs IN THE FIELD AS DIRECTED BY THE SWMP NARRATIVES AND AS REQUIRED BY CDDT SPECIFICATIONS AND THE CDPS-SCP TO ENSURE ALL POTENTIAL POLLUTANTS FROM CONSTRUCTION WILL NOT ENTER STATE WATERS. ECS SHALL SHOW AND UPDATE BMPs ON PLAN SHEETS, SIGN AND DATE WHEN INSTALLED.
2. CONSTRUCTION BOUNDARY IS EXISTING ROW
3. SEE SWMP TYPICAL SECTIONS FOR LIMITS OF DISTURBANCE


- 5 EXISTING PULL BOX (17" X 30")
- 8 EXISTING PULL BOX
- 9 EXISTING TRAFFIC SIGNAL CONTROLLER CABINET
- 13 EXISTING ELECTRICAL CONDUIT
- 15 EXISTING FIBER OPTIC CABLE (SINGLE MODE) (24 STRAND)
- 17 PROTECT IN PLACE
- 20 PULL BOX (18" X 30" X 18")
- 21 PULL BOX (24" X 36" X 24")
- 23 2-2 INCH ELECTRICAL CONDUIT (MULTIDUCT) (BORED)
- 26 INSTALL 2-2 INCH ELECTRICAL CONDUITS BETWEEN ADJACENT PULL BOXES
- 28 CLOSED CIRCUIT TELEVISION CAMERA (TRAFFIC SURVEILLANCE)

- 29 CLOSED CIRCUIT TELEVISION CABLE
- 30 FIBER OPTIC CABLE (SINGLE MODE) (12 STRANDS) (LATERAL)
- 32 FIBER OPTIC CABLE (SINGLE MODE) (96 STRANDS) (BACKBONE)
- 33 COIL 10 LINEAR FEET OF EACH FIBER OPTIC LATERAL CABLE IN CABINET FOR SLACK
- 34 COIL 25 LINEAR FEET OF EACH FIBER OPTIC LATERAL CABLE IN PULL BOX FOR SLACK
- 35 COIL 25 LINEAR FEET OF EACH FIBER OPTIC BACKBONE CABLE IN PULL BOX FOR SLACK
- 36 COIL 50 LINEAR FEET OF EACH FIBER OPTIC BACKBONE CABLE IN PULL BOX FOR SLACK
- 37 COIL 100 LINEAR FEET OF EACH FIBER OPTIC BACKBONE CABLE IN PULL BOX FOR SLACK
- 38 FIBER OPTIC SPLICE CLOSURE, FUSION SPLICE FIBERS PER SPLICING DETAIL SHEETS.
- 40 FIBER OPTIC TERMINATION PANEL - 12 FIBER
- 46 ETHERNET SWITCH

- 47 SERIAL TO IP CONVERTER
- 49 STORM DRAIN INLET PROTECTION
- 50 INSTALL PULL BOX IN CONCRETE SIDEWALK AND REPLACE PANEL
- 56 CONDUIT TO BE INSTALLED PER THE SHALLOW TRENCH DETAIL
- 60 2 - 2 INCH ELECTRICAL CONDUIT (PLASTIC) (MULTIDUCT) (SPECIAL)



Know what's below.
Call before you dig.

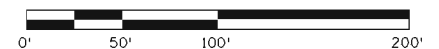


Print Date: 5/22/2012	
Drawing File Name: 18777TRAF_Plan03.dgn	
Horiz. Scale: 1:100	Vert. Scale: As Noted
Unit Information	Unit Leader Initials
MULLER	Muller Engineering Co., Inc. Consulting Engineers P:\10-028.13 - SH 9 Interconnect\Traffic_ITS
apexdesign	

Sheet Revisions		
Date:	Comments	Init.


Colorado Department of Transportation	
	18500 East Colfax Avenue Aurora, CO 80011 Phone: 303-757-9648 FAX: 303-757-9746
Region 1	SS

As Constructed		TRAFFIC SIGNAL INTERCONNECT			Project No./Code
No Revisions:					MTCE 0091-039
Revised:		Designer: KEB	Structure Numbers		18777
Void:		Detailer: PJS			
		Sheet Subset: ITS	Subset Sheets: 3 of 46		Sheet Number 13

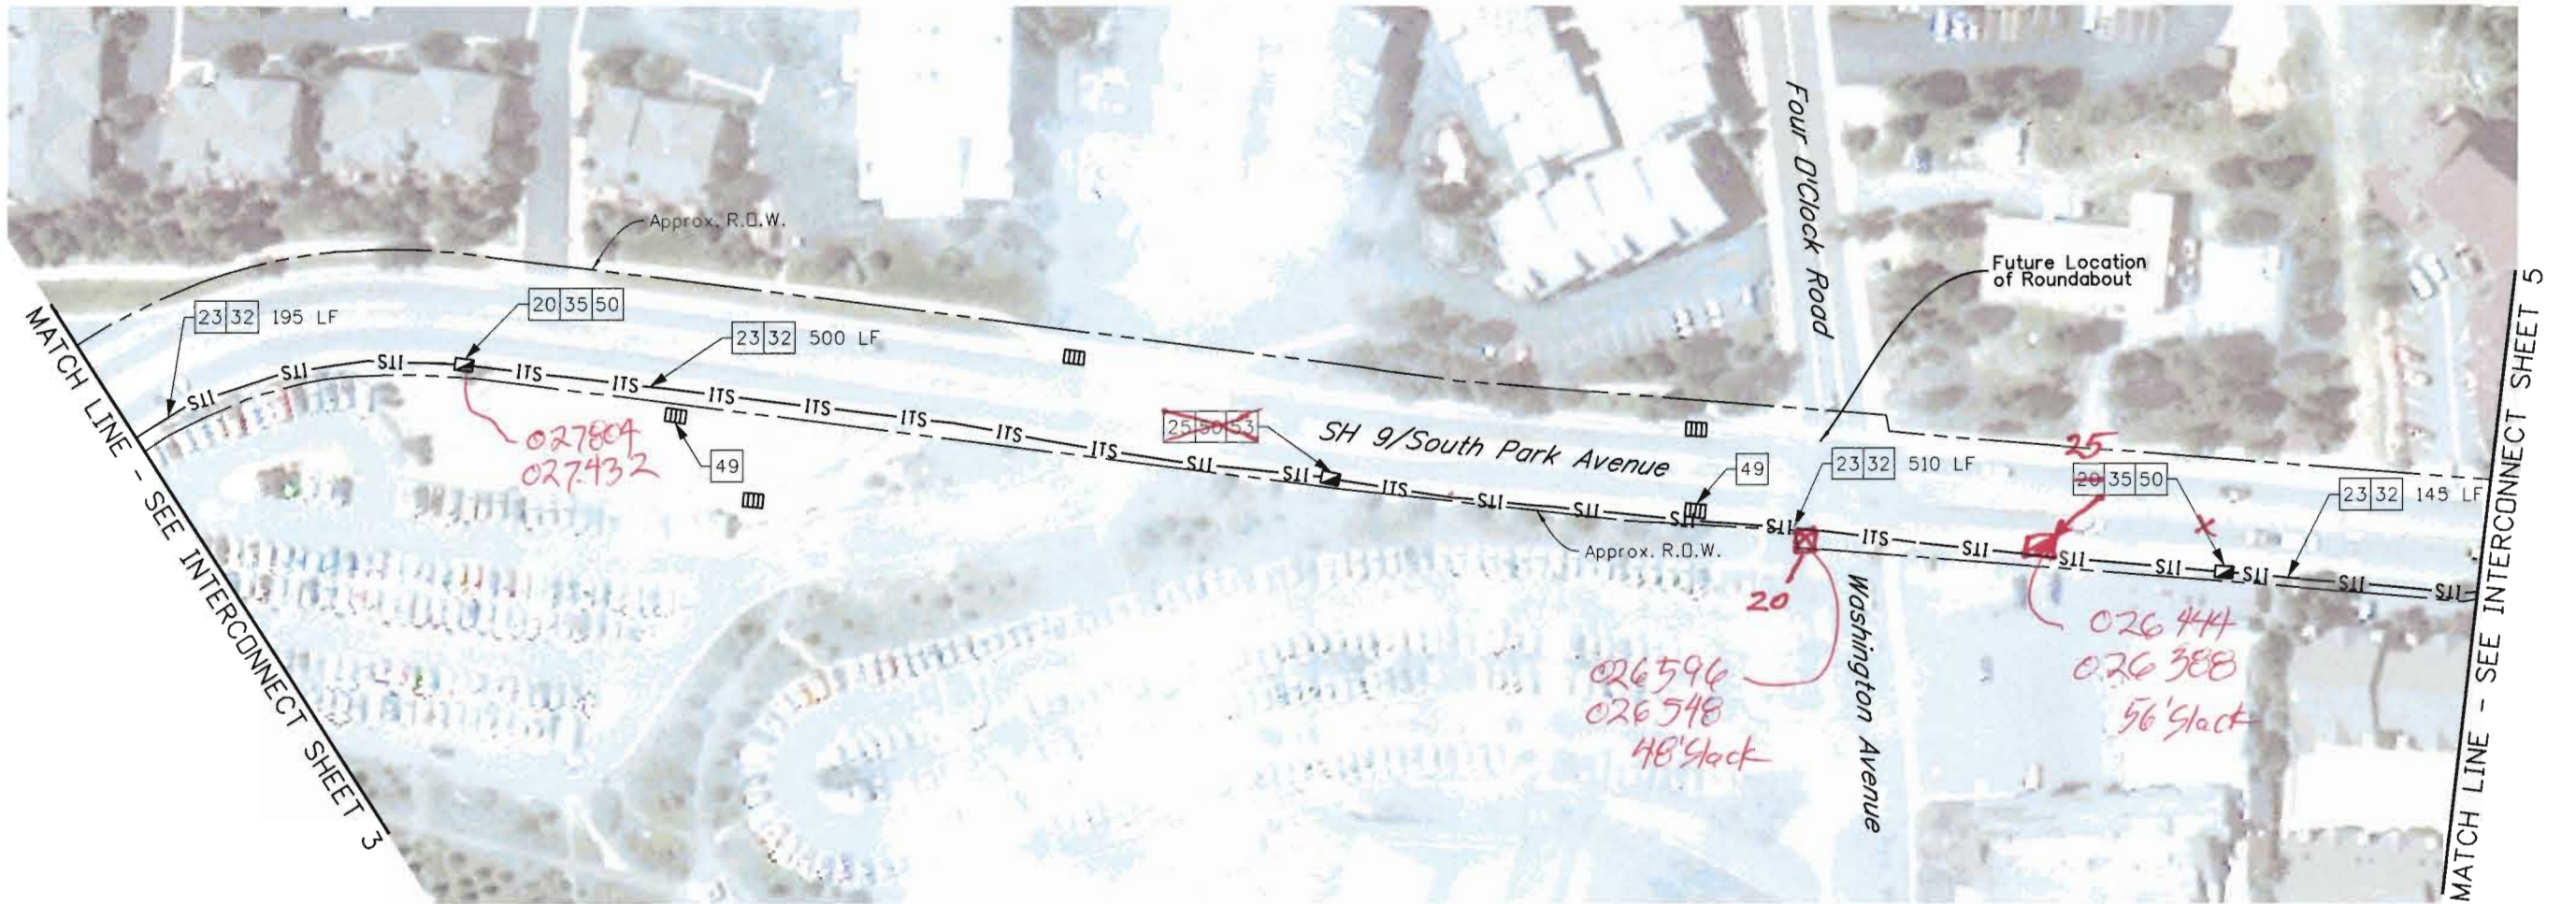

- 20 PULL BOX (18" X 30" X 18")
- 23 2-2 INCH ELECTRICAL CONDUIT (MULTIDUCT) (BORED)
- 25 PULL BOX (30" X 48" X 24")
- 32 FIBER OPTIC CABLE (SINGLE MODE) (96 STRANDS) (BACKBONE)
- 35 COIL 25 LINEAR FEET OF EACH FIBER OPTIC BACKBONE CABLE IN PULL BOX FOR SLACK
- 49 STORM DRAIN INLET PROTECTION
- 50 INSTALL PULL BOX IN CONCRETE SIDEWALK AND REPLACE PANEL
- 53 COIL 200 LINEAR FEET OF EACH FIBER OPTIC BACKBONE CABLE IN PULL BOX FOR SLACK

- SWMP NOTES:
- ECS SHALL PLACE BMPs IN THE FIELD AS DIRECTED BY THE SWMP NARRATIVES AND AS REQUIRED BY CDOT SPECIFICATIONS AND THE CDPS-SCP TO ENSURE ALL POTENTIAL POLLUTANTS FROM CONSTRUCTION WILL NOT ENTER STATE WATERS. ECS SHALL SHOW AND UPDATE BMPs ON PLAN SHEETS, SIGN AND DATE WHEN INSTALLED.
 - CONSTRUCTION BOUNDARY IS EXISTING ROW
 - SEE SWMP TYPICAL SECTIONS FOR LIMITS OF DISTURBANCE

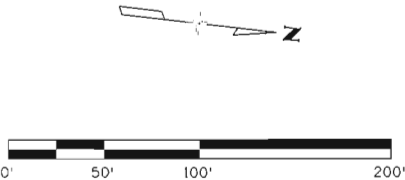

5/22/2012 3:01:45 PM P:\10-028.13 Region 1 Umbrello 2011 CDOT\102 - SH 9 Signal Interconnect\18777Trafic_ITS\Drawings\18777TRAF_Plan04.dgn

Print Date: 5/22/2012	
Drawing File Name: 18777TRAF_Plan04.dgn	
Horiz. Scale: 1:100	Vert. Scale: As Noted
Unit Information	Unit Leader Initials
MULLER Muller Engineering Co., Inc. Consulting Engineers P:\10-028.13 - SH 9 Interconnect\Traffic_ITS	apexdesign

Sheet Revisions		
Date:	Comments	Init.



Colorado Department of Transportation


18500 East Colfax Avenue
Aurora, CO 80011
Phone: 303-757-9648 FAX: 303-757-9746

Region 1

SS

As Constructed		TRAFFIC SIGNAL INTERCONNECT				Project No./Code	
No Revisions:						MTCE 0091-039	
Revised:		Designer:	KEB	Structure		18777	
		Detailer:	PJS	Numbers			
Void:		Sheet Subset:	ITS	Subset Sheets:	4 of 46	Sheet Number	14

MATCH LINE - SEE INTERCONNECT SHEET 4

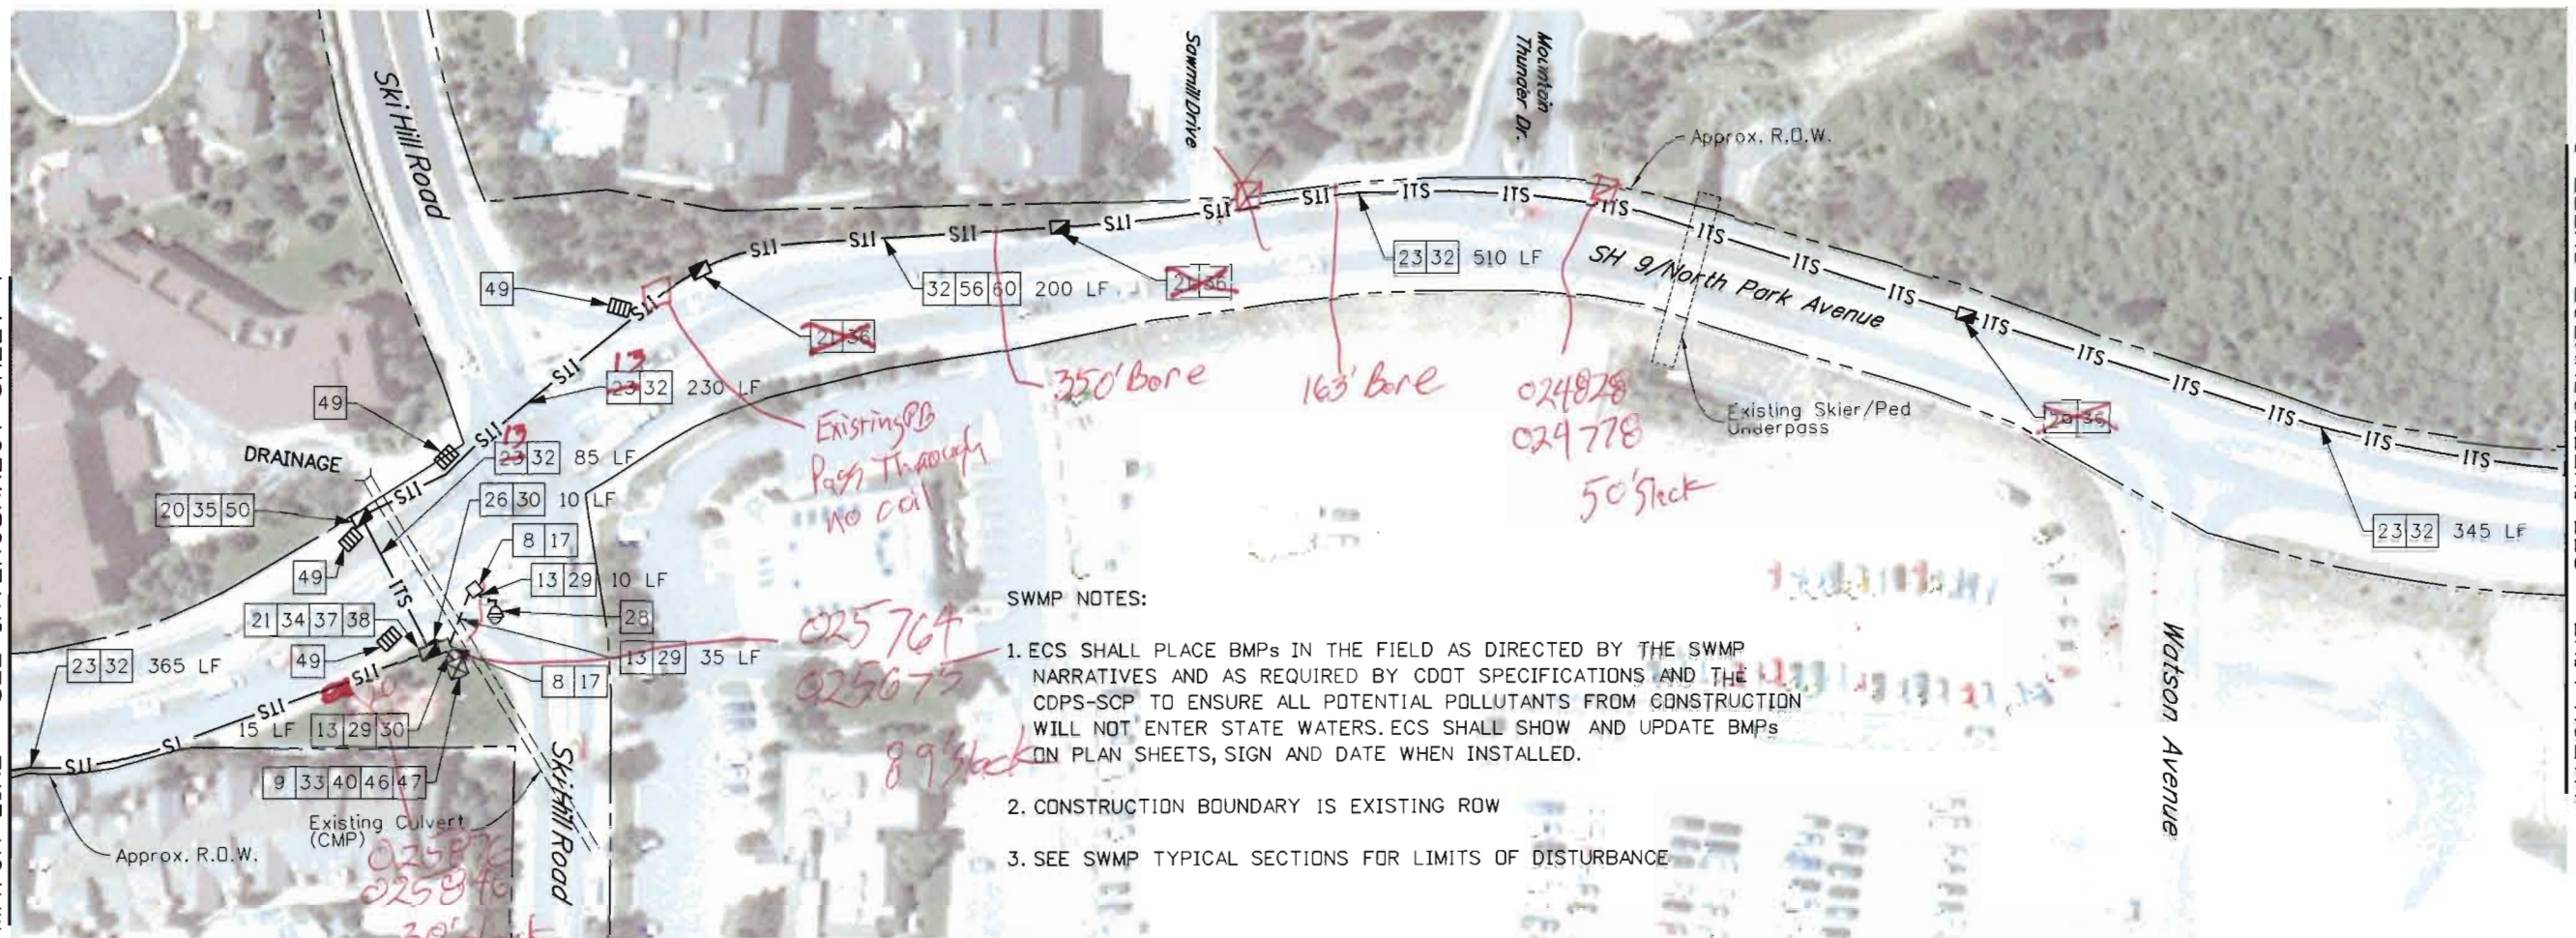

MATCH LINE - SEE INTERCONNECT SHEET 6

SWMP NOTES:

1. ECS SHALL PLACE BMPs IN THE FIELD AS DIRECTED BY THE SWMP NARRATIVES AND AS REQUIRED BY CDDT SPECIFICATIONS AND THE CDDT-SCP TO ENSURE ALL POTENTIAL POLLUTANTS FROM CONSTRUCTION WILL NOT ENTER STATE WATERS. ECS SHALL SHOW AND UPDATE BMPs ON PLAN SHEETS, SIGN AND DATE WHEN INSTALLED.
2. CONSTRUCTION BOUNDARY IS EXISTING ROW
3. SEE SWMP TYPICAL SECTIONS FOR LIMITS OF DISTURBANCE


- 8 EXISTING PULL BOX
- 9 EXISTING TRAFFIC SIGNAL CONTROLLER CABINET
- 13 EXISTING ELECTRICAL CONDUIT
- 17 PROTECT IN PLACE
- 20 PULL BOX (18" X 30" X 18")
- 21 PULL BOX (24" X 36" X 24")
- 23 2-2 INCH ELECTRICAL CONDUIT (MULTIDUCT) (BORED)
- 26 INSTALL 2-2 INCH ELECTRICAL CONDUITS BETWEEN ADJACENT PULL BOXES
- 28 CLOSED CIRCUIT TELEVISION CAMERA (TRAFFIC SURVEILLANCE)
- 29 CLOSED CIRCUIT TELEVISION CABLE
- 30 FIBER OPTIC CABLE (SINGLE MODE) (12 STRANDS) (LATERAL)

- 32 FIBER OPTIC CABLE (SINGLE MODE) (96 STRANDS) (BACKBONE)
- 33 COIL 10 LINEAR FEET OF EACH FIBER OPTIC LATERAL CABLE IN CABINET FOR SLACK
- 34 COIL 25 LINEAR FEET OF EACH FIBER OPTIC LATERAL CABLE IN PULL BOX FOR SLACK
- 35 COIL 25 LINEAR FEET OF EACH FIBER OPTIC BACKBONE CABLE IN PULL BOX FOR SLACK
- 36 COIL 50 LINEAR FEET OF EACH FIBER OPTIC BACKBONE CABLE IN PULL BOX FOR SLACK
- 37 COIL 100 LINEAR FEET OF EACH FIBER OPTIC BACKBONE CABLE IN PULL BOX FOR SLACK
- 38 FIBER OPTIC SPLICE CLOSURE. FUSION SPLICE FIBERS PER SPLICING DETAIL SHEETS.
- 40 FIBER OPTIC TERMINATION PANEL - 12 FIBER
- 46 ETHERNET SWITCH
- 47 SERIAL TO IP CONVERTER
- 49 STORM DRAIN INLET PROTECTION

- 50 INSTALL PULL BOX IN CONCRETE SIDEWALK AND REPLACE PANEL
- 56 CONDUIT TO BE INSTALLED PER THE SHALLOW TRENCH DETAIL IF SUBSURFACE CONDITIONS WARRANT
- 60 2 - 2 INCH ELECTRICAL CONDUIT (PLASTIC) (MULTIDUCT) (SPECIAL)



Know what's below.
Call before you dig.

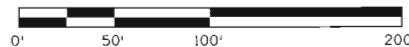

Print Date: 5/22/2012

Drawing File Name: 18777TRAF_Plan05.dgn

Horiz. Scale: 1:100

Vert. Scale: As Noted

Unit Information

Unit Leader Initials

MULLER

Muller Engineering Co., Inc.
Consulting Engineers

apexdesign

P:10-028.13 - SH 9 Interconnect\Traffic\ITS

Sheet Revisions

Date:	Comments	Init.

Colorado Department of Transportation



18500 East Colfax Avenue
Aurora, CO 80011
Phone: 303-757-9648 FAX: 303-757-9746

Region 1

SS

As Constructed

No Revisions:

Revised:

Void:

TRAFFIC SIGNAL INTERCONNECT

Designer:	KEB	Structure	
Detailer:	PJS	Numbers	
Sheet Subset:	ITS	Subset Sheets:	5 of 46

Project No./Code


MTCE 0091-039

18777

Sheet Number 15

5/22/2012 3:02:05 PM P:\10-028.13 Region 1 Umbrella 2011 CDDT\102 - SH 9 Signal Interconnect\18777\Traffic_ITS\Drawings\18777\TRAF_Plan06.dgn

MATCH LINE - SEE INTERCONNECT SHEET 5

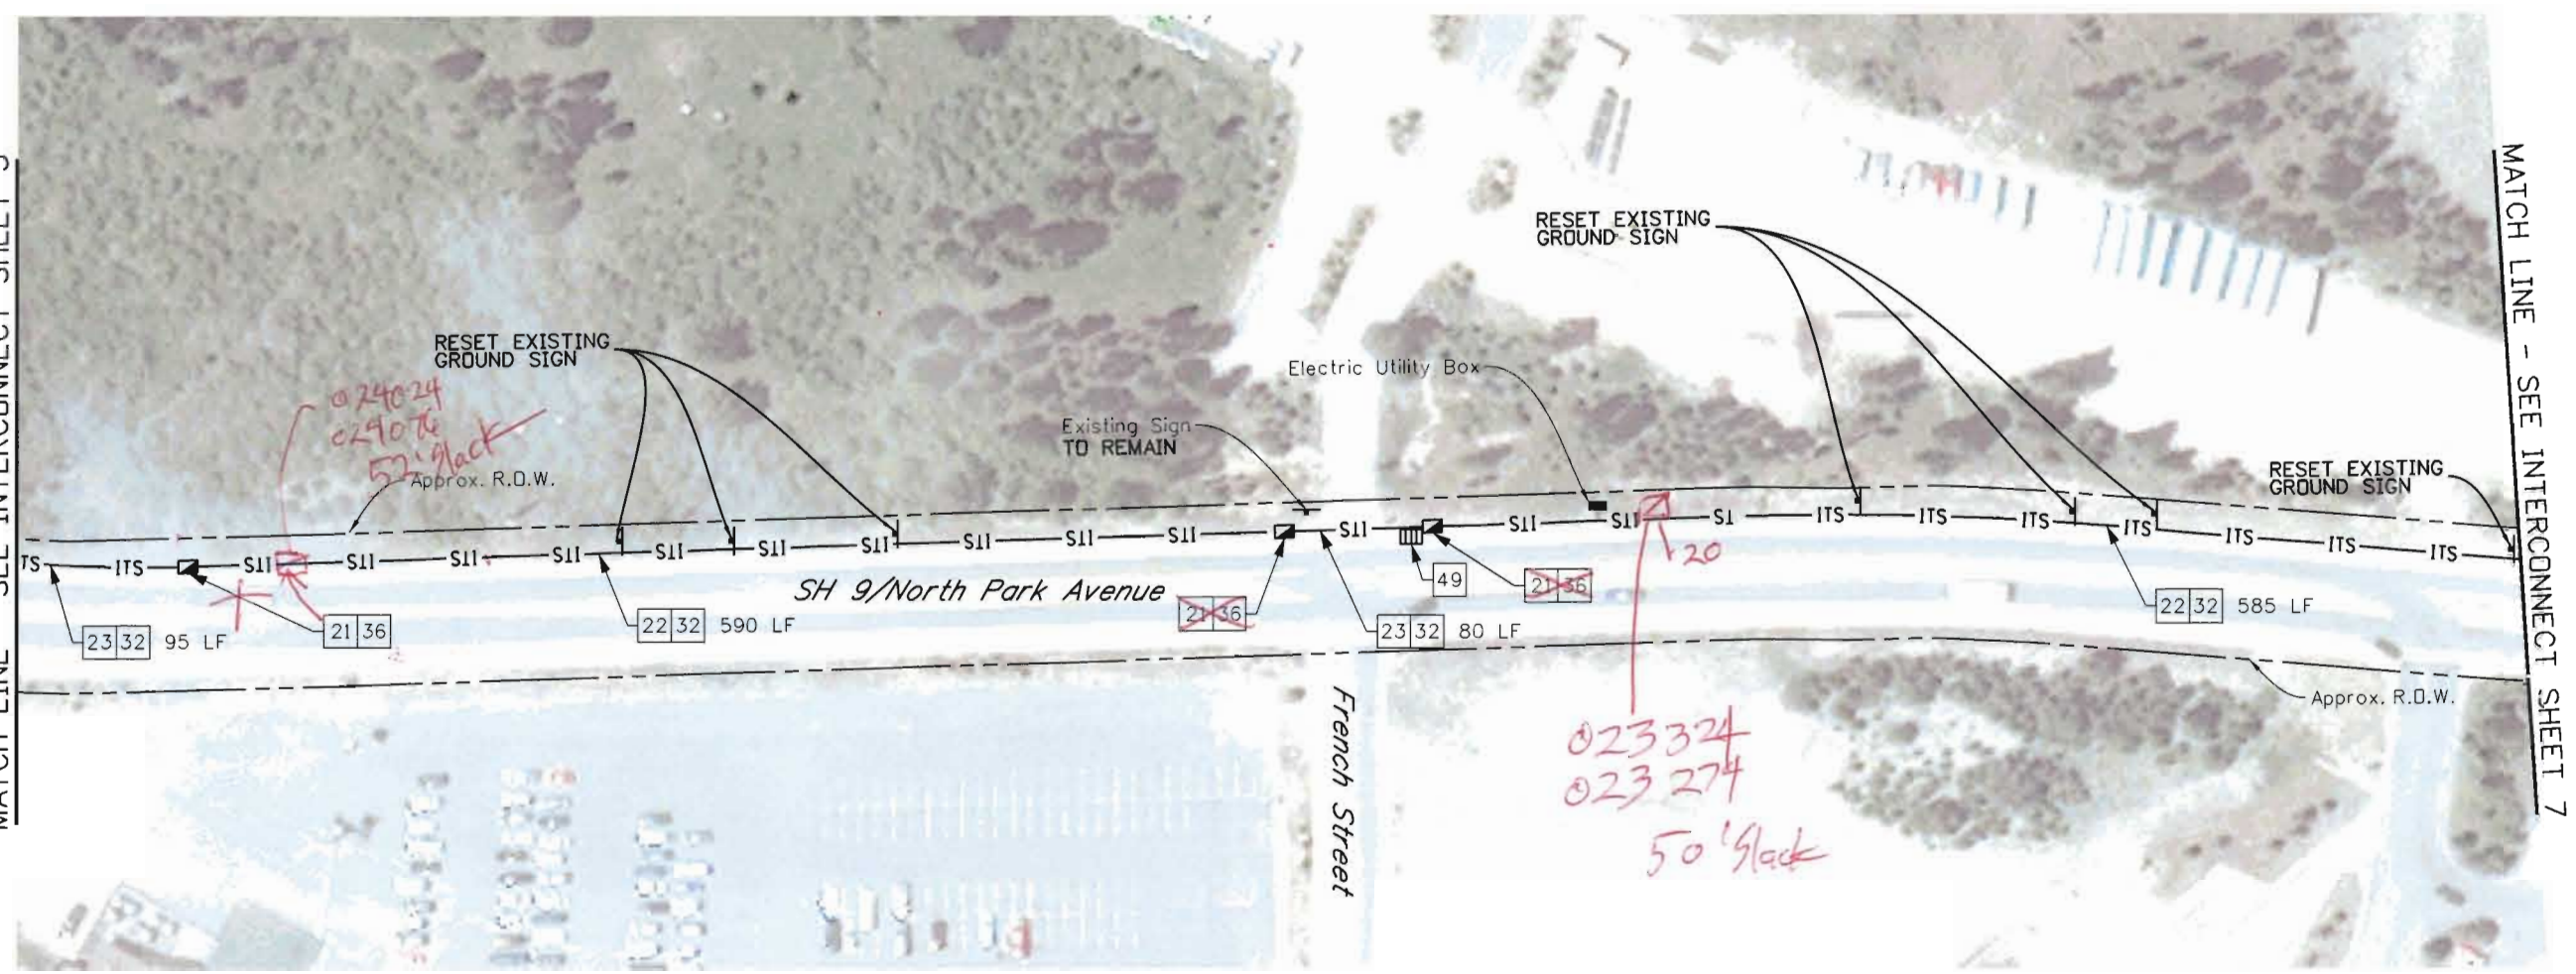


- 21 PULL BOX (24" X 36" X 24")
- 22 2-2 INCH ELECTRICAL CONDUIT (MULTIDUCT) (PLASTIC)
- 23 2-2 INCH ELECTRICAL CONDUIT (MULTIDUCT) (BORED)
- 32 FIBER OPTIC CABLE (SINGLE MODE) (96 STRANDS) (BACKBONE)
- 36 COIL 50 LINEAR FEET OF EACH FIBER OPTIC BACKBONE CABLE IN PULL BOX FOR SLACK
- 49 STORM DRAIN INLET PROTECTION

- SWMP NOTES:
- ECS SHALL PLACE BMPs IN THE FIELD AS DIRECTED BY THE SWMP NARRATIVES AND AS REQUIRED BY CDOT SPECIFICATIONS AND THE CDPS-SCP TO ENSURE ALL POTENTIAL POLLUTANTS FROM CONSTRUCTION WILL NOT ENTER STATE WATERS. ECS SHALL SHOW AND UPDATE BMPs ON PLAN SHEETS, SIGN AND DATE WHEN INSTALLED.
 - CONSTRUCTION BOUNDARY IS EXISTING ROW
 - SEE SWMP TYPICAL SECTIONS FOR LIMITS OF DISTURBANCE




Know what's below.
Call before you dig.

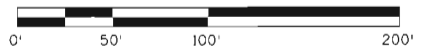

Print Date: 5/22/2012	
Drawing File Name: 18777TRAF_Plan06.dgn	
Horiz. Scale: 1:100	Vert. Scale: As Noted
Unit Information	Unit Leader Initials
MULLER	Muller Engineering Co., Inc. Consulting Engineers P:10-028.13 - SH 9 Interconnect\Traffic_ITS

Sheet Revisions		
Date:	Comments	Init.

Colorado Department of Transportation



18500 East Colfax Avenue
Aurora, CO 80011
Phone: 303-757-9648 FAX: 303-757-9746


Region 1

SS


As Constructed		TRAFFIC SIGNAL INTERCONNECT				Project No./Code	
No Revisions:						MTCE 0091-039	
Revised:		Designer:	KEB	Structure		18777	
Void:		Detailer:	PJS	Numbers		Sheet Number 16	
		Sheet Subset:	ITS	Subset Sheets:	6 of 46		

SWMP NOTES:

1. ECS SHALL PLACE BMPs IN THE FIELD AS DIRECTED BY THE SWMP NARRATIVES AND AS REQUIRED BY CDOT SPECIFICATIONS AND THE CDPS-SCP TO ENSURE ALL POTENTIAL POLLUTANTS FROM CONSTRUCTION WILL NOT ENTER STATE WATERS. ECS SHALL SHOW AND UPDATE BMPs ON PLAN SHEETS, SIGN AND DATE WHEN INSTALLED.
2. CONSTRUCTION BOUNDARY IS EXISTING ROW
3. SEE SWMP TYPICAL SECTIONS FOR LIMITS OF DISTURBANCE

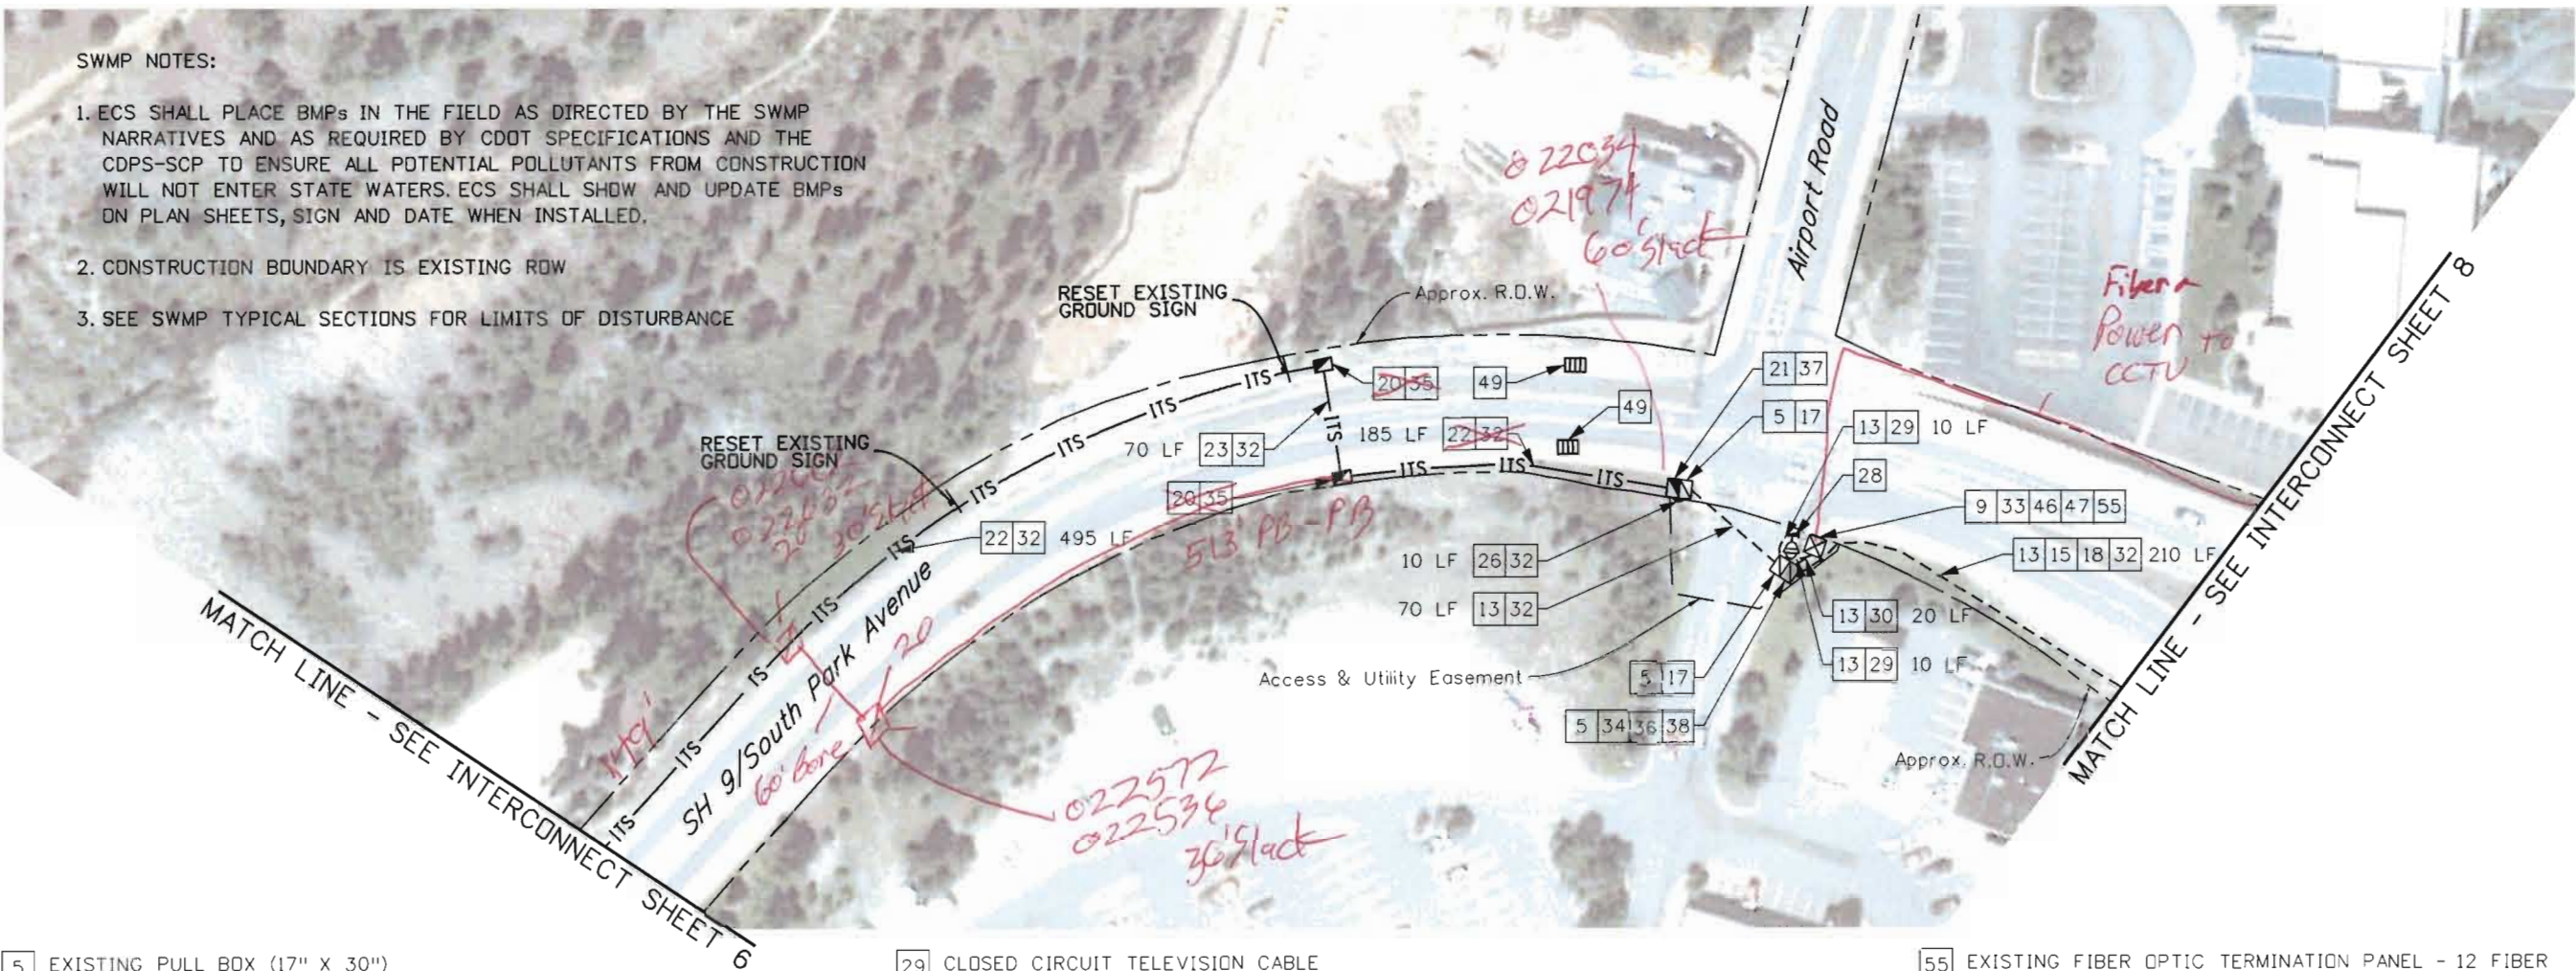


- | | | |
|---|--|--|
| 5 EXISTING PULL BOX (17" X 30") | 29 CLOSED CIRCUIT TELEVISION CABLE | 55 EXISTING FIBER OPTIC TERMINATION PANEL - 12 FIBER |
| 9 EXISTING TRAFFIC SIGNAL CONTROLLER CABINET | 30 FIBER OPTIC CABLE (SINGLE MODE) (12 STRANDS) (LATERAL) | |
| 13 EXISTING ELECTRICAL CONDUIT | 32 FIBER OPTIC CABLE (SINGLE MODE) (96 STRANDS) (BACKBONE) | |
| 15 EXISTING FIBER OPTIC CABLE (SINGLE MODE) (24 STRAND) | 33 COIL 10 LINEAR FEET OF EACH FIBER OPTIC LATERAL CABLE IN CABINET FOR SLACK | |
| 17 PROTECT IN PLACE | 34 COIL 25 LINEAR FEET OF EACH FIBER OPTIC LATERAL CABLE IN PULL BOX FOR SLACK | |
| 18 REMOVE EXISTING FIBER BACKBONE CABLE | 35 COIL 25 LINEAR FEET OF EACH FIBER OPTIC BACKBONE CABLE IN PULL BOX FOR SLACK | |
| 20 PULL BOX (18" X 30" X 18") | 36 COIL 50 LINEAR FEET OF EACH FIBER OPTIC BACKBONE CABLE IN PULL BOX FOR SLACK | |
| 21 PULL BOX (24" X 36" X 24") | 37 COIL 100 LINEAR FEET OF EACH FIBER OPTIC BACKBONE CABLE IN PULL BOX FOR SLACK | |
| 22 2-2 INCH ELECTRICAL CONDUIT (MULTIDUCT) (PLASTIC) | 38 FIBER OPTIC SPLICE CLOSURE. FUSION SPLICE FIBERS PER SPLICING DETAIL SHEETS. | |
| 23 2-2 INCH ELECTRICAL CONDUIT (MULTIDUCT) (BORED) | 46 ETHERNET SWITCH | |
| 26 INSTALL 2-2 INCH ELECTRICAL CONDUITS BETWEEN ADJACENT PULL BOXES | 47 SERIAL TO IP CONVERTER | |
| 28 CLOSED CIRCUIT TELEVISION CAMERA (TRAFFIC SURVEILLANCE) | 49 STORM DRAIN INLET PROTECTION | |

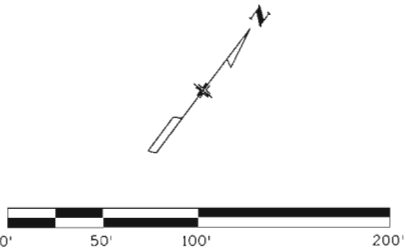

Print Date: 5/22/2012		Sheet Revisions			Colorado Department of Transportation		As Constructed		TRAFFIC SIGNAL INTERCONNECT			Project No./Code	
Drawing File Name: 18777TRAF_Plan07.dgn												MTCE 0091-039	
Horiz. Scale: 1:100		Vert. Scale: As Noted		<div>00000000</div>					Designer: KEB		Structure Numbers	18777	
Unit Information		Unit Leader Initials							Detailer: PJS			Sheet Number 17	
<div>MULLER Muller Engineering Co., Inc. Consulting Engineers P:10-028.13 - SH 9 Interconnect\Traffic_ITS</div>		<div>apexdesign</div>							Sheet Subset: ITS		Subset Sheets: 7 of 46		

5/22/2012 3:02:13 PM P:\10-028.13 Region 1\Umbrella 2011\CDOT\102 - SH 9 SignalInterconnect\18777\Traffic_ITS\Drawings\18777TRAF_Plan07.dgn

5/22/2012 3:02:22 PM P:\10-028.13 Region 1 Umbrella 2011 CDDT\102 - SH 9 Signal Interconnect\18777\Traffic\ITS\Drawings\18777TRAF_Plan08.dgn

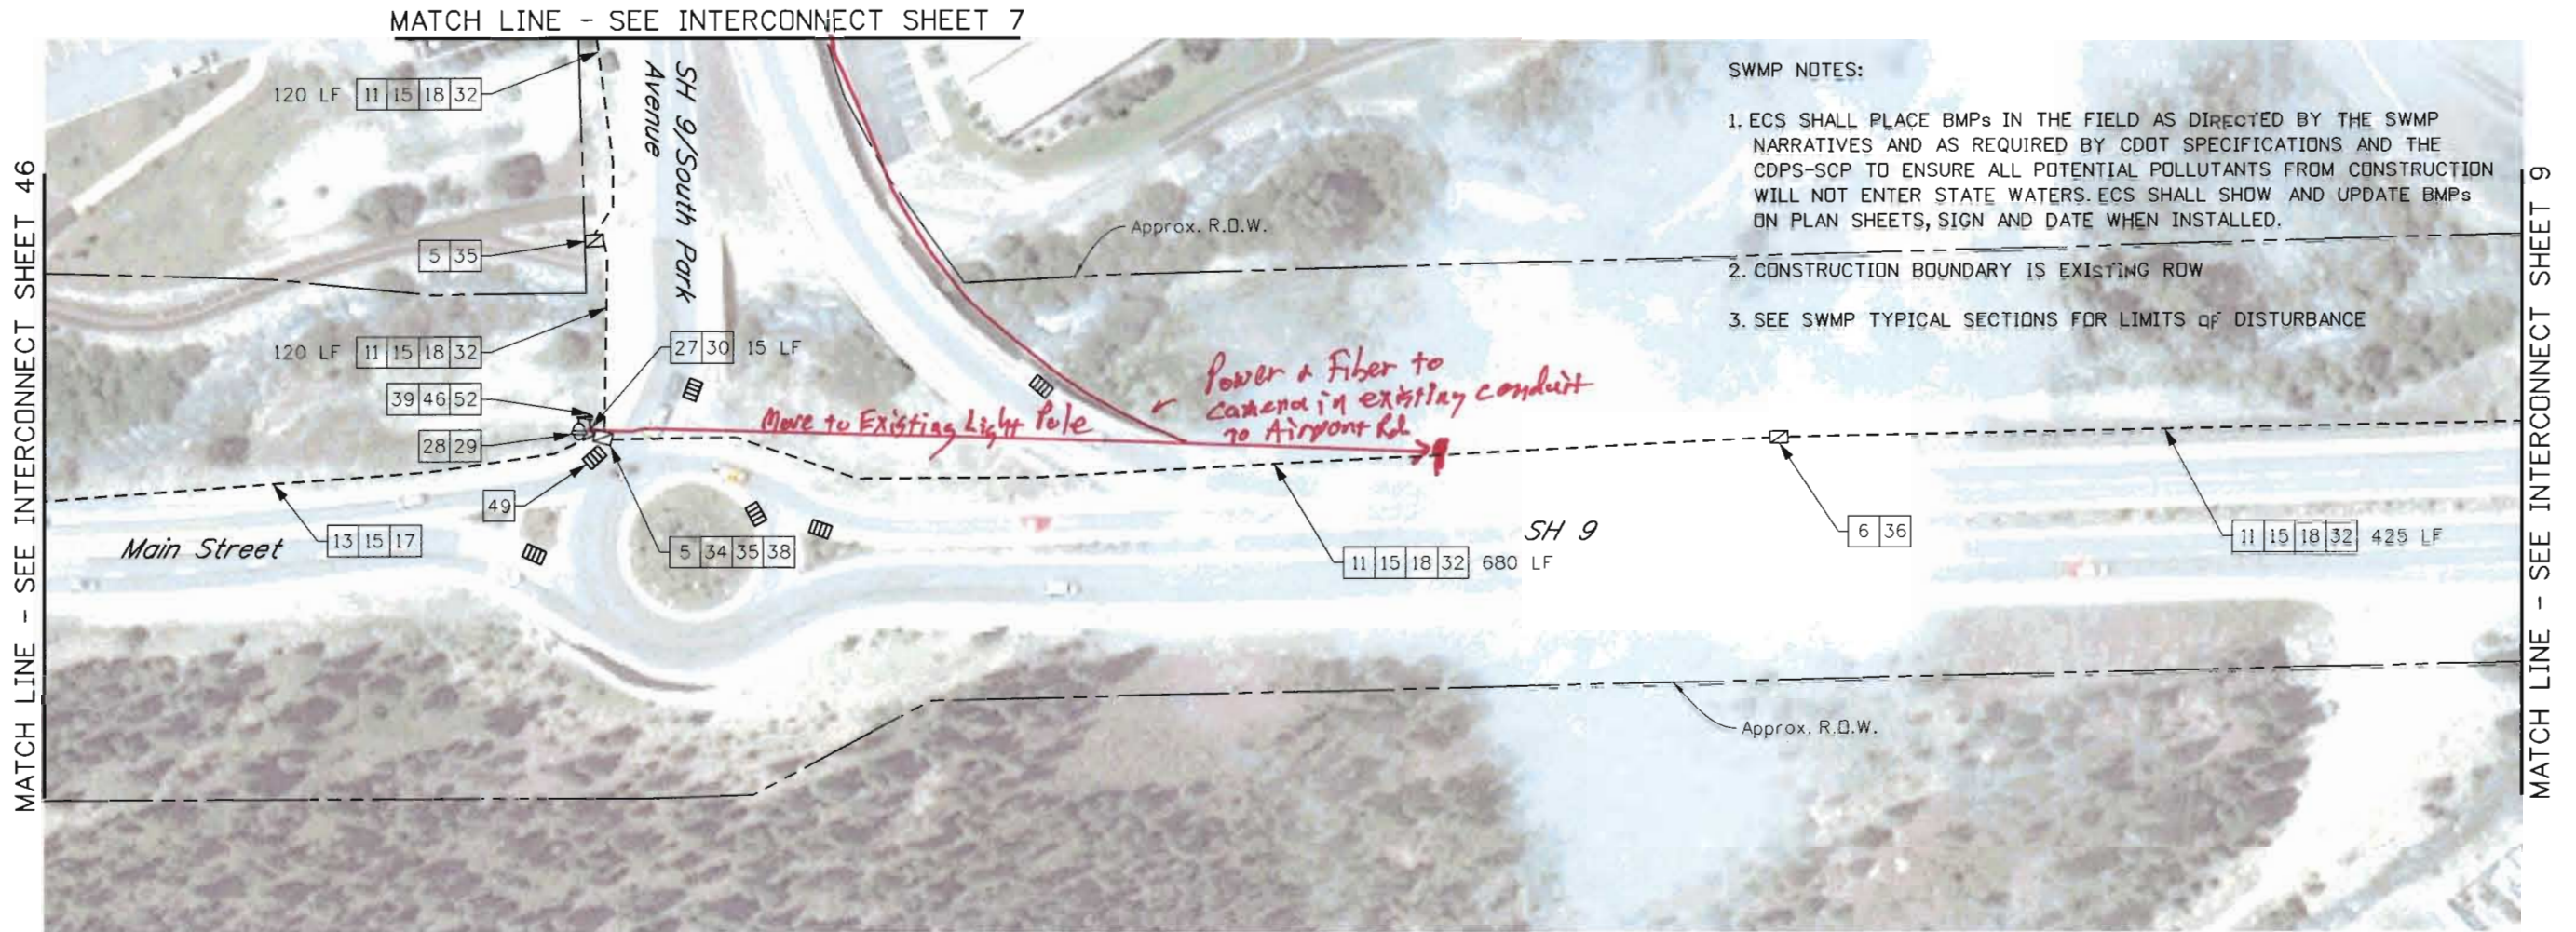

- 5 EXISTING PULL BOX (17" X 30")
- 6 EXISTING PULL BOX (24" X 36")
- 11 EXISTING 2" ELECTRICAL CONDUIT
- 13 EXISTING ELECTRICAL CONDUIT
- 15 EXISTING FIBER OPTIC CABLE (SINGLE MODE) (24 STRAND)
- 17 PROTECT IN PLACE
- 18 REMOVE EXISTING FIBER BACKBONE CABLE
- 27 1-1/4 INCH ELECTRICAL CONDUIT (LIQUIDTIGHT FLEXIBLE METAL)
- 28 CLOSED CIRCUIT TELEVISION CAMERA (TRAFFIC SURVEILLANCE)
- 29 CLOSED CIRCUIT TELEVISION CABLE

- 30 FIBER OPTIC CABLE (SINGLE MODE) (12 STRANDS) (LATERAL)
- 32 FIBER OPTIC CABLE (SINGLE MODE) (96 STRANDS) (BACKBONE)
- 34 COIL 25 LINEAR FEET OF EACH FIBER OPTIC LATERAL CABLE IN PULL BOX FOR SLACK
- 35 COIL 25 LINEAR FEET OF EACH FIBER OPTIC BACKBONE CABLE IN PULL BOX FOR SLACK
- 36 COIL 50 LINEAR FEET OF EACH FIBER OPTIC BACKBONE CABLE IN PULL BOX FOR SLACK
- 38 FIBER OPTIC SPLICE CLOSURE. FUSION SPLICE FIBERS PER SPLICING DETAIL SHEETS.
- 39 FIBER OPTIC TERMINATION PANEL - 6 FIBER
- 46 ETHERNET SWITCH
- 49 STORM DRAIN INLET PROTECTION
- 52 CLOSED CIRCUIT TELEVISION POLE AND COMMUNICATIONS CABINET




Know what's below.
Call before you dig.




Print Date: 5/22/2012	
Drawing File Name: 18777TRAF_Plan08.dgn	
Horiz. Scale: 1:100	Vert. Scale: As Noted
Unit Information	Unit Leader Initials
MULLER Muller Engineering Co., Inc. Consulting Engineers	apexdesign
P:\10-028.13 - SH 9 Interconnect\Traffic\ITS	

Sheet Revisions		
Date:	Comments	Init.

Colorado Department of Transportation	
	18500 East Colfax Avenue Aurora, CO 80011 Phone: 303-757-9648 FAX: 303-757-9746
Region 1	SS

As Constructed		TRAFFIC SIGNAL INTERCONNECT		Project No./Code	
No Revisions:				MTCE 0091-039	
Revised:		Designer: KEB	Structure Numbers	18777	
Void:		Detailer: PJS		Sheet Number 18	
		Sheet Subset: ITS	Subset Sheets: 8 of 46		

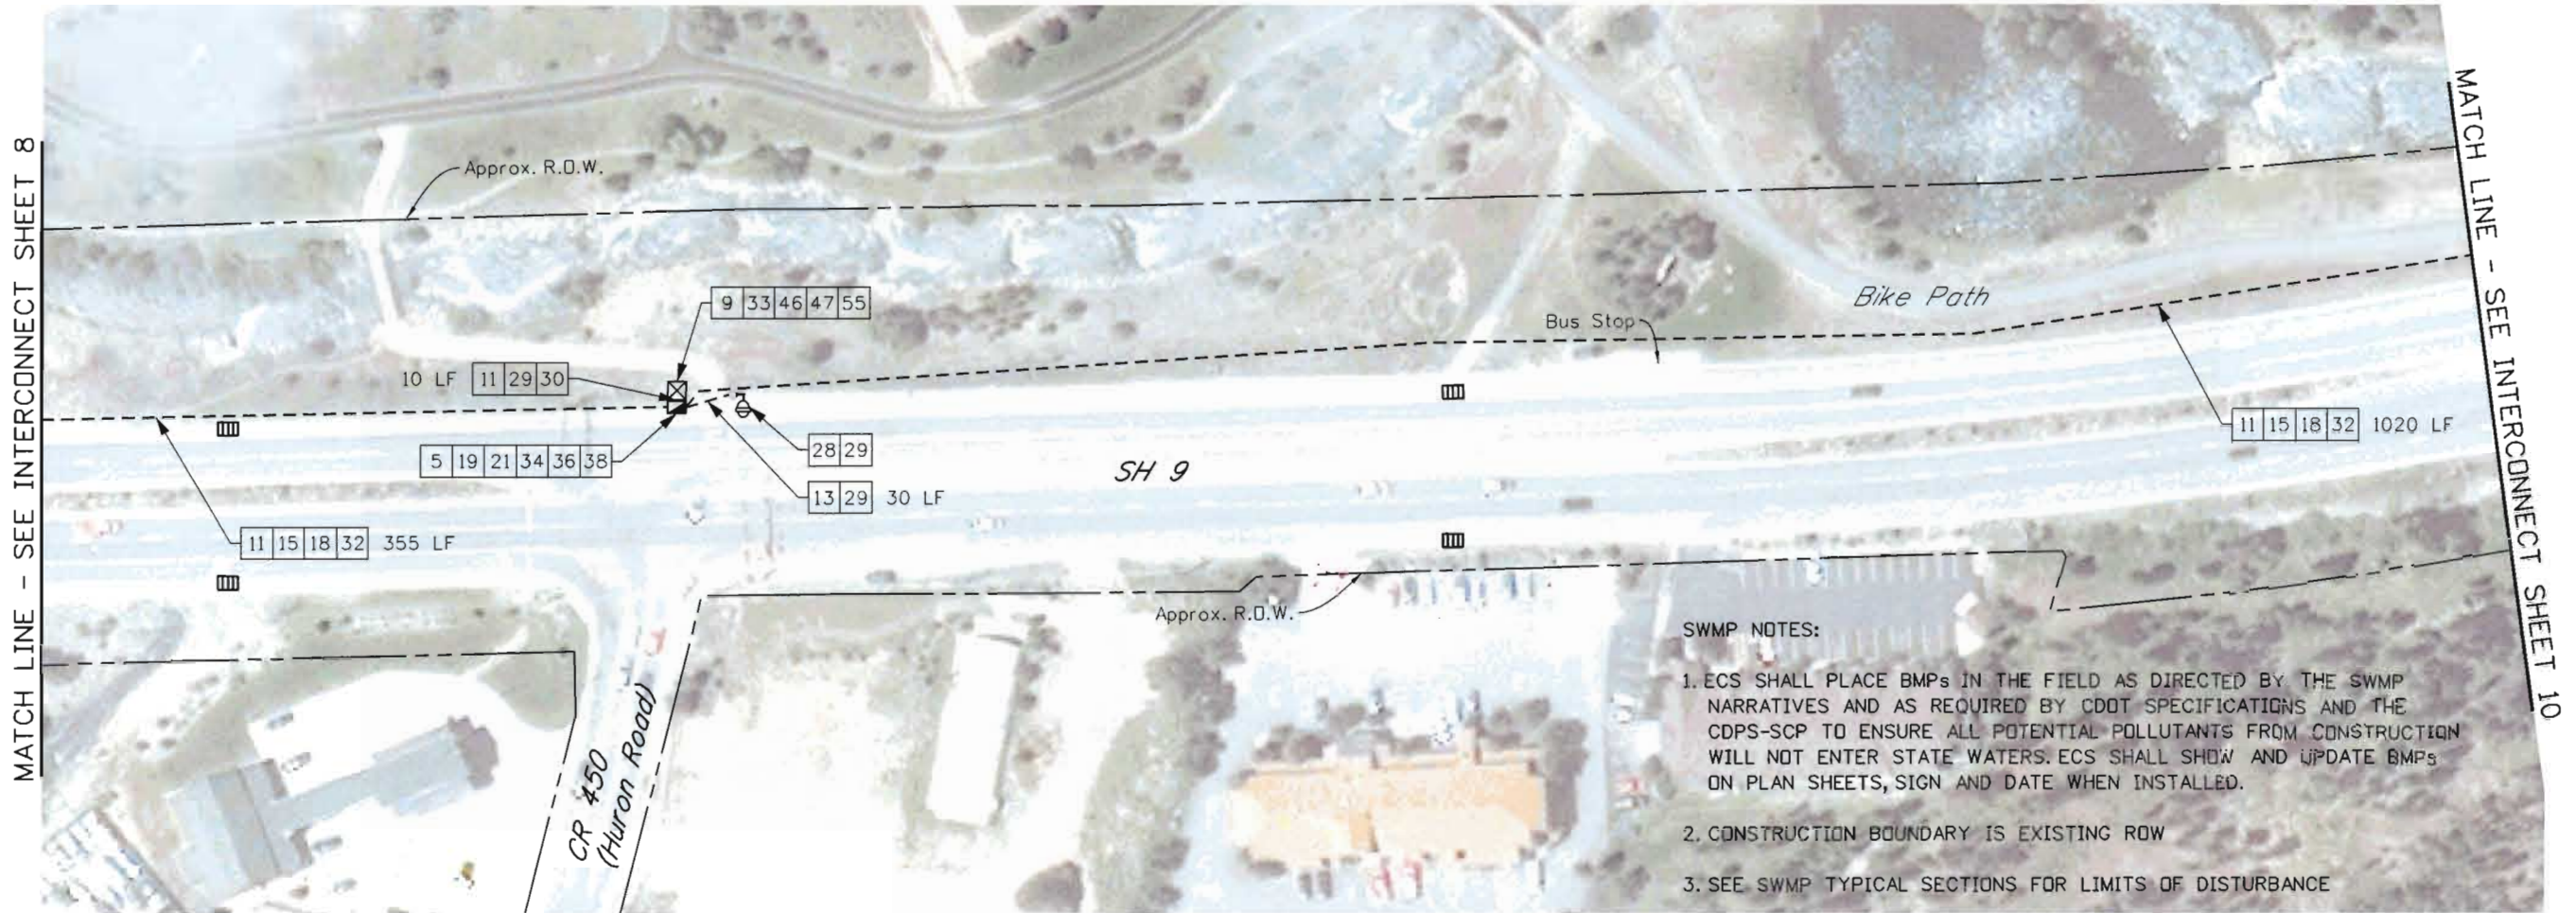

SWMP NOTES:


1. ECS SHALL PLACE BMPs IN THE FIELD AS DIRECTED BY THE SWMP NARRATIVES AND AS REQUIRED BY CDOT SPECIFICATIONS AND THE CDPS-SCP TO ENSURE ALL POTENTIAL POLLUTANTS FROM CONSTRUCTION WILL NOT ENTER STATE WATERS. ECS SHALL SHOW AND UPDATE BMPs ON PLAN SHEETS, SIGN AND DATE WHEN INSTALLED.

2. CONSTRUCTION BOUNDARY IS EXISTING ROW

3. SEE SWMP TYPICAL SECTIONS FOR LIMITS OF DISTURBANCE

- 5 EXISTING PULL BOX (17" X 30")
- 9 EXISTING TRAFFIC SIGNAL CONTROLLER CABINET
- 11 EXISTING 2" ELECTRICAL CONDUIT
- 13 EXISTING ELECTRICAL CONDUIT
- 15 EXISTING FIBER OPTIC CABLE (SINGLE MODE) (24 STRAND)
- 18 REMOVE EXISTING FIBER BACKBONE CABLE
- 19 REMOVE EXISTING PULL BOX
- 21 PULL BOX (24" X 36" X 24")
- 28 CLOSED CIRCUIT TELEVISION CAMERA (TRAFFIC SURVEILLANCE)
- 29 CLOSED CIRCUIT TELEVISION CABLE


- 30 FIBER OPTIC CABLE (SINGLE MODE) (12 STRANDS) (LATERAL)
- 32 FIBER OPTIC CABLE (SINGLE MODE) (96 STRANDS) (BACKBONE)
- 33 COIL 10 LINEAR FEET OF EACH FIBER OPTIC LATERAL CABLE IN CABINET FOR SLACK
- 34 COIL 25 LINEAR FEET OF EACH FIBER OPTIC LATERAL CABLE IN PULL BOX FOR SLACK
- 36 COIL 50 LINEAR FEET OF EACH FIBER OPTIC BACKBONE CABLE IN PULL BOX FOR SLACK
- 38 FIBER OPTIC SPLICE CLOSURE. FUSION SPLICE FIBERS PER SPLICING DETAIL SHEETS.
- 46 ETHERNET SWITCH
- 47 SERIAL TO IP CONVERTER
- 55 EXISTING FIBER OPTIC TERMINATION PANEL - 12 FIBER

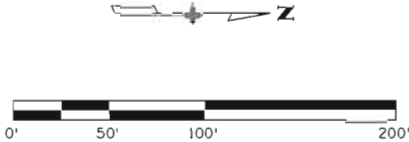

5/22/2012 3:02:30 PM P:\10-028.13 Region 1 Umbrello 2011 CDOT\102 - SH 9 Signal Interconnect\18777\Traffic\ITS\Drawings\18777\TRAFFIC_Plan09.dgn

Print Date: 5/22/2012	
Drawing File Name: 18777\TRAFFIC_Plan09.dgn	
Horiz. Scale: 1"=100'	Vert. Scale: As Noted
Unit Information Unit Leader Initials	
<div><div>MULLER</div><div>Muller Engineering Co., Inc. Consulting Engineers P:\10-028.13 - SH 9 Interconnect\Traffic\ITS</div></div> <div><div>apexdesign</div></div>	

Sheet Revisions		
Date:	Comments	Init.



Colorado Department of Transportation


Region 1

18500 East Colfax Avenue
Aurora, CO 80011
Phone: 303-757-9648 FAX: 303-757-9746

SS

As Constructed		TRAFFIC SIGNAL INTERCONNECT			Project No./Code
No Revisions:					MTCE 0091-039
Revised:		Designer: KEB	Structure Numbers		18777
Void:		Detailer: PJS	Subset Sheets: 9 of 46		Sheet Number 19

5/22/2012 3:02:38 PM P:\10-028.13 Region 1 Umbrella 2011 CDDT\102 - SH 9 Signal Interconnect\18777-Traffic-ITS\Drawings\18777TRAF_Plan10.dgn

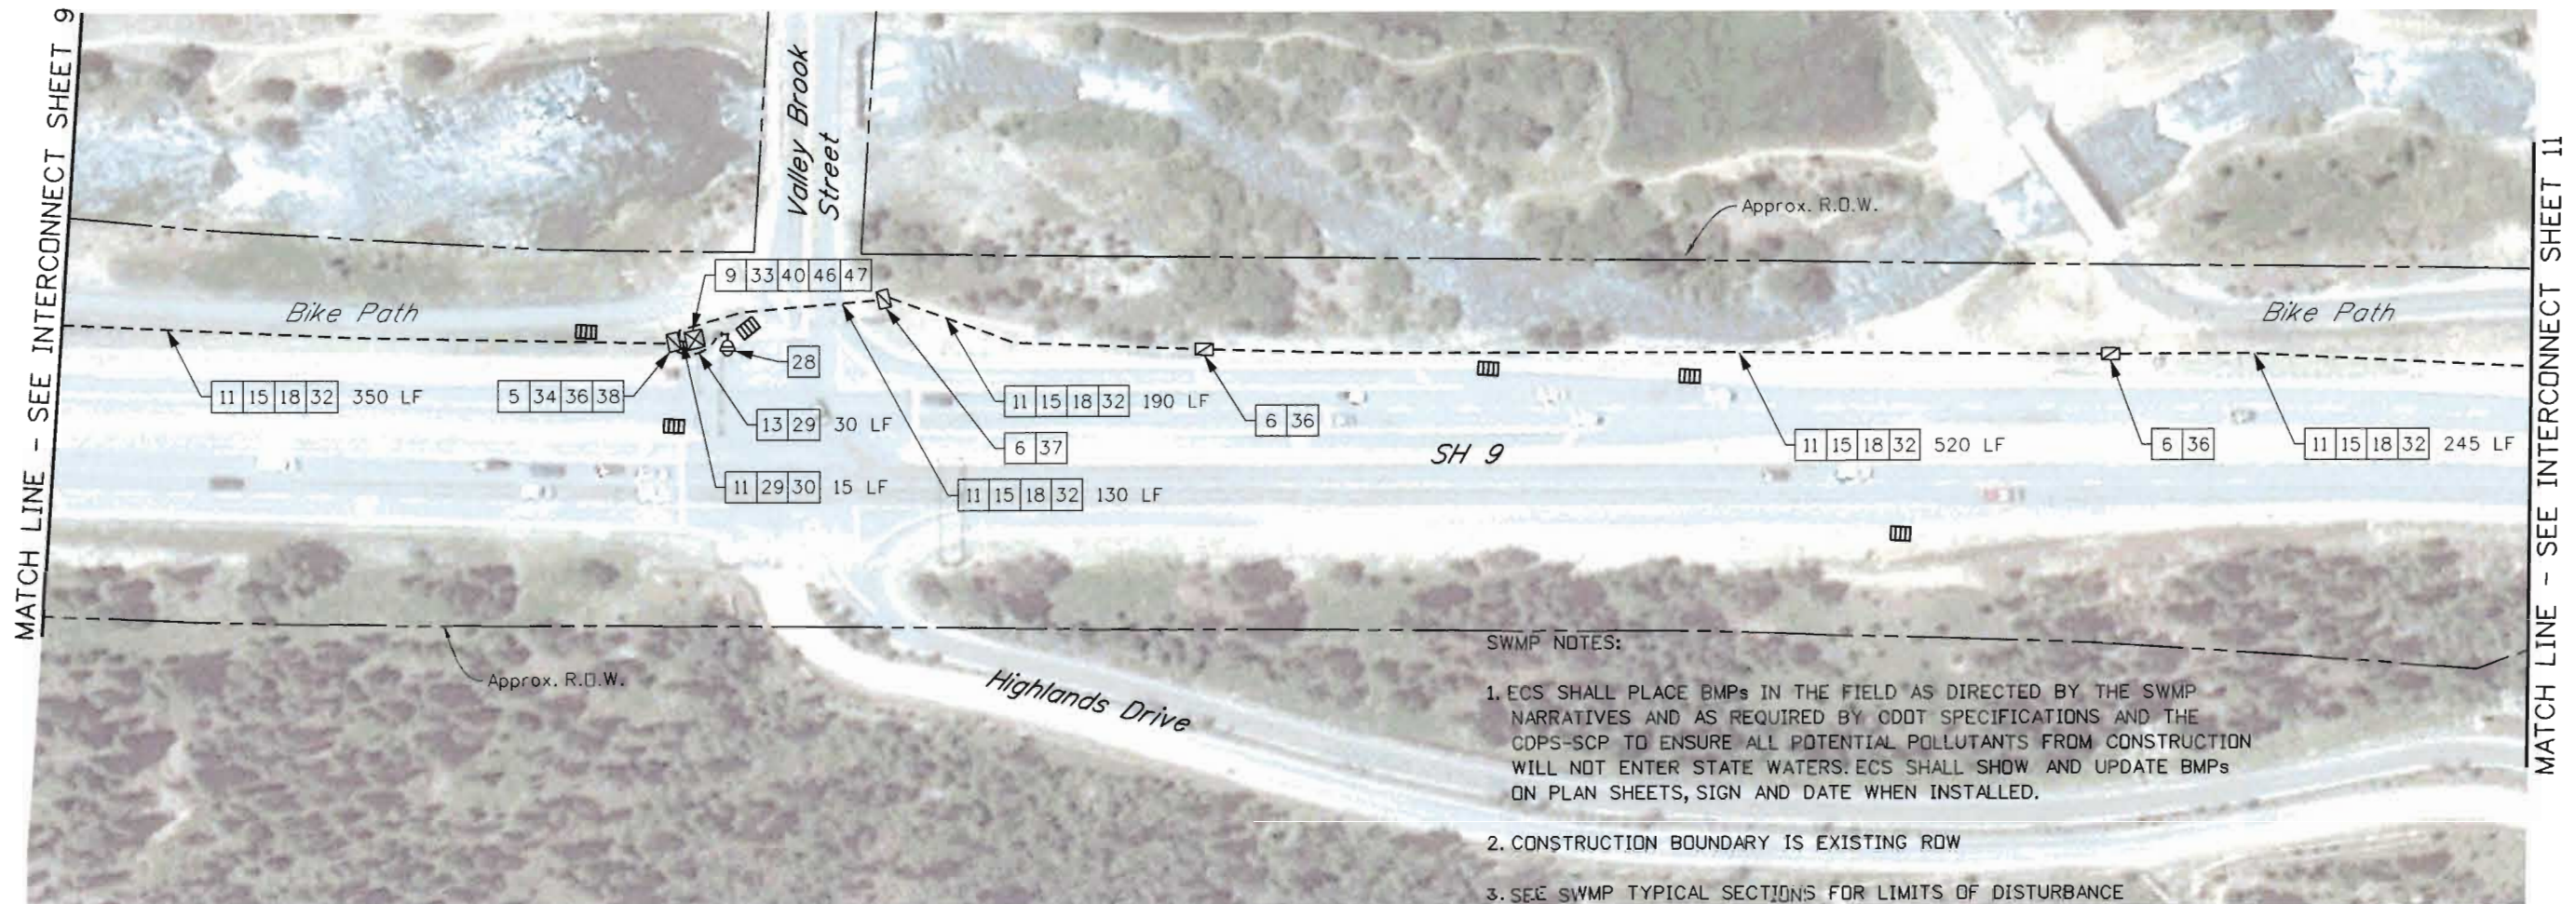

SWMP NOTES:


1. ECS SHALL PLACE BMPs IN THE FIELD AS DIRECTED BY THE SWMP NARRATIVES AND AS REQUIRED BY CDDT SPECIFICATIONS AND THE COPS-SCP TO ENSURE ALL POTENTIAL POLLUTANTS FROM CONSTRUCTION WILL NOT ENTER STATE WATERS. ECS SHALL SHOW AND UPDATE BMPs ON PLAN SHEETS, SIGN AND DATE WHEN INSTALLED.
2. CONSTRUCTION BOUNDARY IS EXISTING ROW
3. SEE SWMP TYPICAL SECTIONS FOR LIMITS OF DISTURBANCE

- 5 EXISTING PULL BOX (17" X 30")
- 6 EXISTING PULL BOX (24" X 36")
- 9 EXISTING TRAFFIC SIGNAL CONTROLLER CABINET
- 11 EXISTING 2" ELECTRICAL CONDUIT
- 13 EXISTING ELECTRICAL CONDUIT
- 15 EXISTING FIBER OPTIC CABLE (SINGLE MODE) (24 STRAND)
- 18 REMOVE EXISTING FIBER BACKBONE CABLE
- 28 CLOSED CIRCUIT TELEVISION CAMERA (TRAFFIC SURVEILLANCE)
- 29 CLOSED CIRCUIT TELEVISION CABLE
- 30 FIBER OPTIC CABLE (SINGLE MODE) (12 STRANDS) (LATERAL)

- 32 FIBER OPTIC CABLE (SINGLE MODE) (96 STRANDS) (BACKBONE)
- 33 COIL 10 LINEAR FEET OF EACH FIBER OPTIC LATERAL CABLE IN CABINET FOR SLACK
- 34 COIL 25 LINEAR FEET OF EACH FIBER OPTIC LATERAL CABLE IN PULL BOX FOR SLACK
- 36 COIL 50 LINEAR FEET OF EACH FIBER OPTIC BACKBONE CABLE IN PULL BOX FOR SLACK
- 37 COIL 100 LINEAR FEET OF EACH FIBER OPTIC BACKBONE CABLE IN PULL BOX FOR SLACK
- 38 FIBER OPTIC SPLICE CLOSURE. FUSION SPLICE FIBERS PER SPLICING DETAIL SHEETS.
- 40 FIBER OPTIC TERMINATION PANEL - 12 FIBER
- 46 ETHERNET SWITCH
- 47 SERIAL TO IP CONVERTER




**Know what's below.
Call before you dig.**

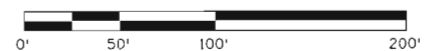


Print Date: 5/22/2012	
Drawing File Name: 18777TRAF_Plan10.dgn	
Horiz. Scale: 1"=100'	Vert. Scale: As Noted
Unit Information	Unit Leader Initials
MULLER Muller Engineering Co., Inc. Consulting Engineers	apexdesign
P:\10-028.13 - SH 9 Interconnect\Traffic-ITS	

Sheet Revisions		
Date:	Comments	Init.

Colorado Department of Transportation	
	18500 East Colfax Avenue Aurora, CO 80011 Phone: 303-757-9648 FAX: 303-757-9746
Region 1	SS

As Constructed		TRAFFIC SIGNAL INTERCONNECT			Project No./Code
No Revisions:					MTCE 0091-039
Revised:		Designer: KEB	Structure Numbers		18777
Void:		Detailer: PJS			
		Sheet Subset: ITS	Subset Sheets: 10 of 46		Sheet Number 20

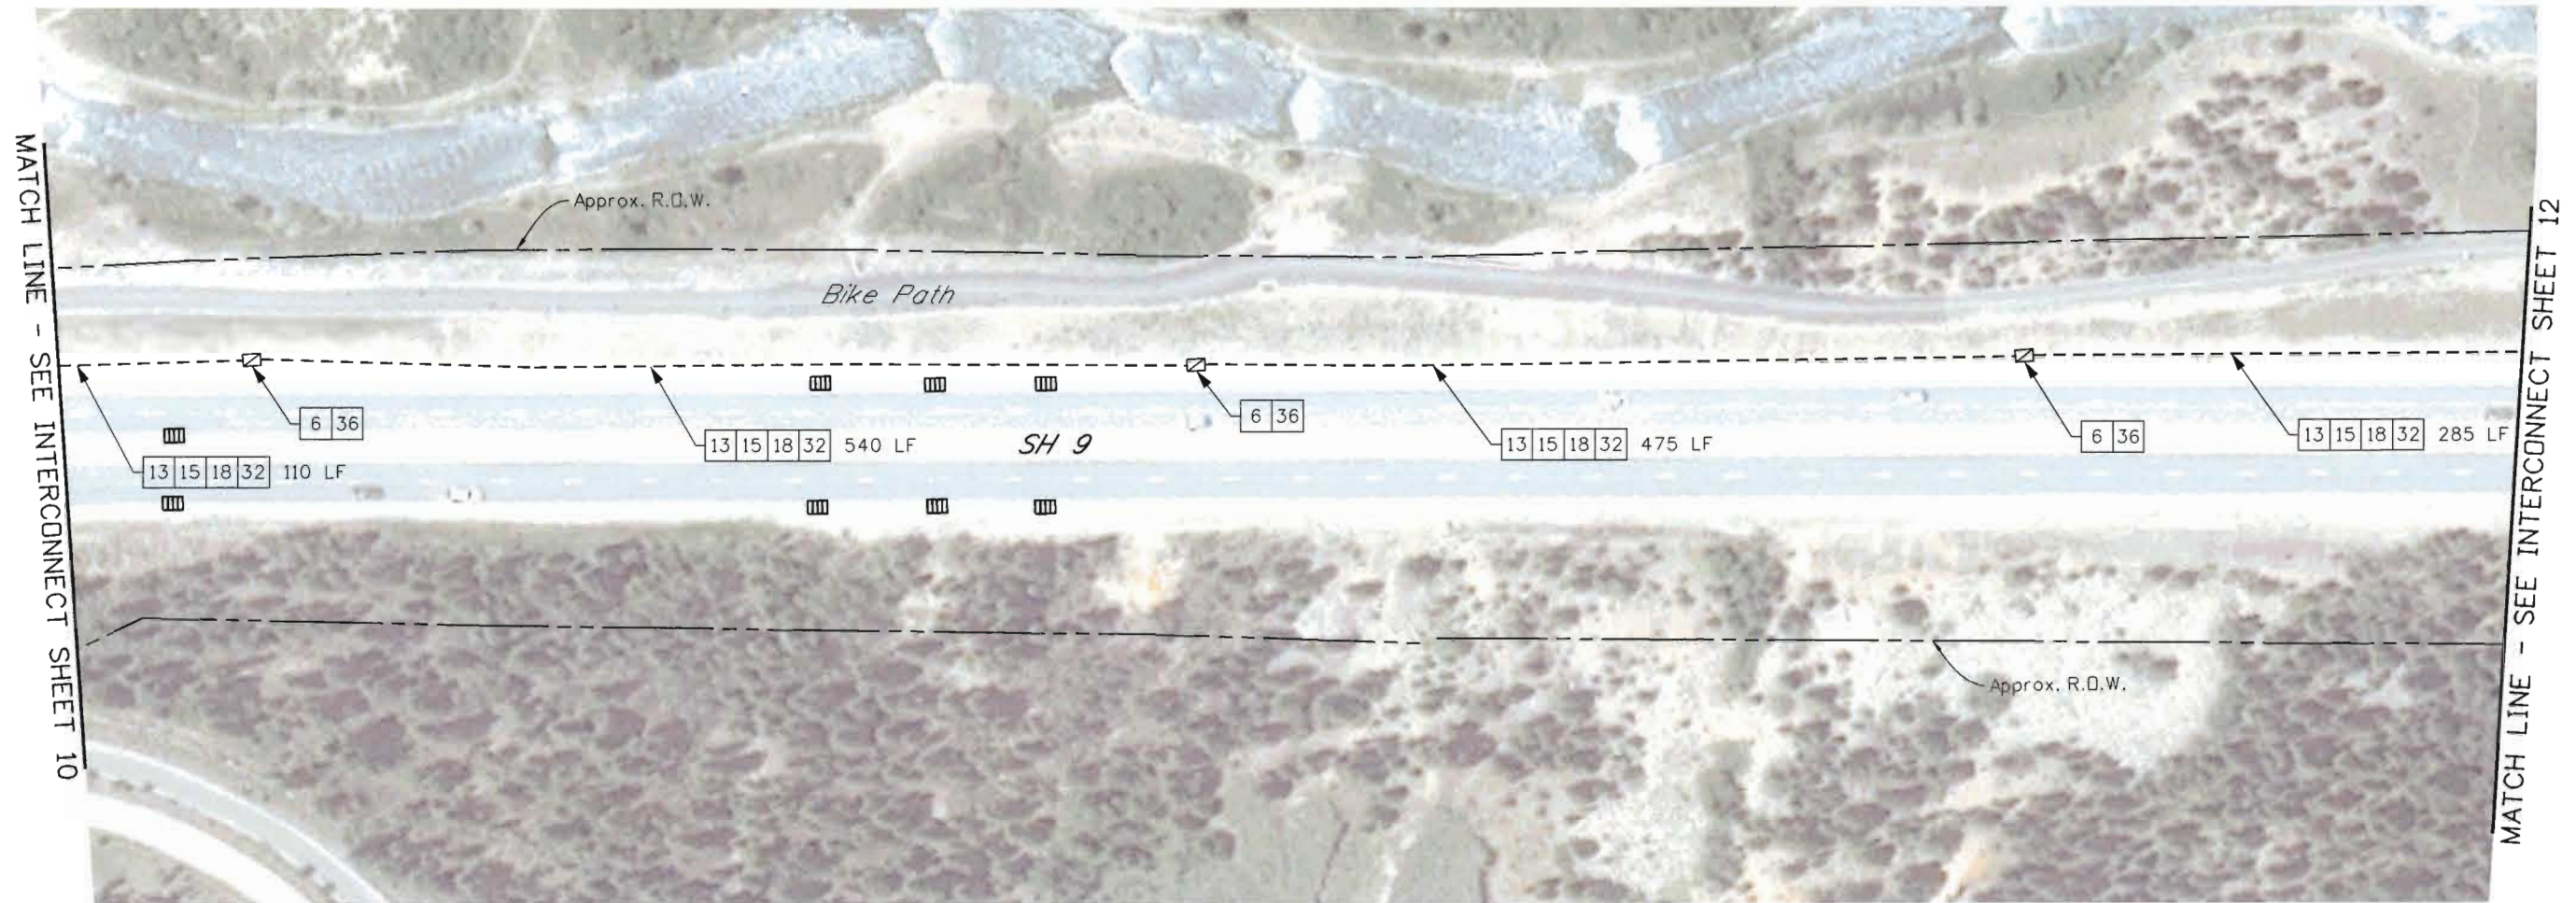


- 6 EXISTING PULL BOX (24" X 36")
- 13 EXISTING ELECTRICAL CONDUIT
- 15 EXISTING FIBER OPTIC CABLE (SINGLE MODE) (24 STRAND)
- 18 REMOVE EXISTING FIBER BACKBONE CABLE
- 32 FIBER OPTIC CABLE (SINGLE MODE) (96 STRANDS) (BACKBONE)
- 36 COIL 50 LINEAR FEET OF EACH FIBER OPTIC BACKBONE CABLE IN PULL BOX FOR SLACK

SWMP NOTES:

- ECS SHALL PLACE BMPs IN THE FIELD AS DIRECTED BY THE SWMP NARRATIVES AND AS REQUIRED BY CDOT SPECIFICATIONS AND THE CDPS-SCP TO ENSURE ALL POTENTIAL POLLUTANTS FROM CONSTRUCTION WILL NOT ENTER STATE WATERS. ECS SHALL SHOW AND UPDATE BMPs ON PLAN SHEETS, SIGN AND DATE WHEN INSTALLED.
- CONSTRUCTION BOUNDARY IS EXISTING ROW
- SEE SWMP TYPICAL SECTIONS FOR LIMITS OF DISTURBANCE




Know what's below.
Call before you dig.

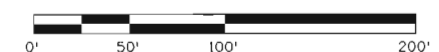

5/22/2012 3:02:47 PM P:\10-028.13 Region 1 Umbrello 2011 CDDT\102 - SH 9 Signal Interconnect\18777\Traffic_ITS\Drawings\18777TRAF_Plan1.dgn

Print Date: 5/22/2012	
Drawing File Name: 18777TRAF_Plan1.dgn	
Horiz. Scale: 1:100	Vert. Scale: As Noted
Unit Information Unit Leader Initials	
<div><div>MULLER</div><div>Muller Engineering Co., Inc. Consulting Engineers P:10-028.13 - SH 9 Interconnect\Traffic_ITS</div></div> <div><div>apexdesign</div></div>	

Sheet Revisions		
Date:	Comments	Init.


Region 1

Colorado Department of Transportation

18500 East Colfax Avenue
Aurora, CO 80011
Phone: 303-757-9648 FAX: 303-757-9746

SS


As Constructed	TRAFFIC SIGNAL INTERCONNECT				Project No./Code
No Revisions:					MTCE 0091-039
Revised:	Designer:	KEB	Structure		18777
	Detoiler:	PJS	Numbers		
Void:	Sheet Subset:	ITS	Subset Sheets:	11 of 46	Sheet Number 21




- 6 EXISTING PULL BOX (24" X 36")
- 13 EXISTING ELECTRICAL CONDUIT
- 15 EXISTING FIBER OPTIC CABLE (SINGLE MODE) (24 STRAND)
- 18 REMOVE EXISTING FIBER BACKBONE CABLE
- 32 FIBER OPTIC CABLE (SINGLE MODE) (96 STRANDS) (BACKBONE)
- 36 COIL 50 LINEAR FEET OF EACH FIBER OPTIC BACKBONE CABLE IN PULL BOX FOR SLACK

SWMP NOTES:


- ECS SHALL PLACE BMPs IN THE FIELD AS DIRECTED BY THE SWMP NARRATIVES AND AS REQUIRED BY CDOT SPECIFICATIONS AND THE CDPS-SCP TO ENSURE ALL POTENTIAL POLLUTANTS FROM CONSTRUCTION WILL NOT ENTER STATE WATERS. ECS SHALL SHOW AND UPDATE BMPs ON PLAN SHEETS, SIGN AND DATE WHEN INSTALLED.
- CONSTRUCTION BOUNDARY IS EXISTING ROW
- SEE SWMP TYPICAL SECTIONS FOR LIMITS OF DISTURBANCE

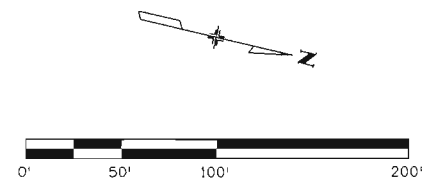

5/22/2012 3:03:03 PM P:\10-028.13 Region 1 Umbrella 2011 CDDT\102 - SH 9 SignalInterconnect\18777TRAFFIC_ITS\Drawings\18777TRAFFIC_Plan13.dgn

Print Date: 5/22/2012		Sheet Revisions			Colorado Department of Transportation		As Constructed		TRAFFIC SIGNAL INTERCONNECT				Project No./Code				
Drawing File Name:18777TRAF_Plan13.dgn																	
Horiz. Scale: 1:100		Vert. Scale: As Noted		<div>0000</div>	Date:	Comments	Init.	<div> 18500 East Colfax Avenue Aurora, CO 80011 Phone: 303-757-9648 FAX: 303-757-9746 Region 1 SS</div>	No Revisions:		Designer: KEB		Structure Numbers	MTCE 0091-039			
Unit Information		Unit Leader Initials							Revised:					Detailer: PJS		18777	
<div><div>MULLER</div><div>Muller Engineering Co., Inc. Consulting Engineers P:\10-028.13 - SH 9 Interconnect\Traffic_ITS</div></div>		apexdesign								Void:		Sheet Subset: ITS		Subset Sheets: 13 of 46		Sheet Number 23	


5/22/2012 3:03:14 PM P:\10-028.13 Region 1 Umbrello 2011 CDDT\102 - SH 9 SignalInterconnect\18777\Traffic_ITS\Drawings\18777TRAF_Plan14.dgn

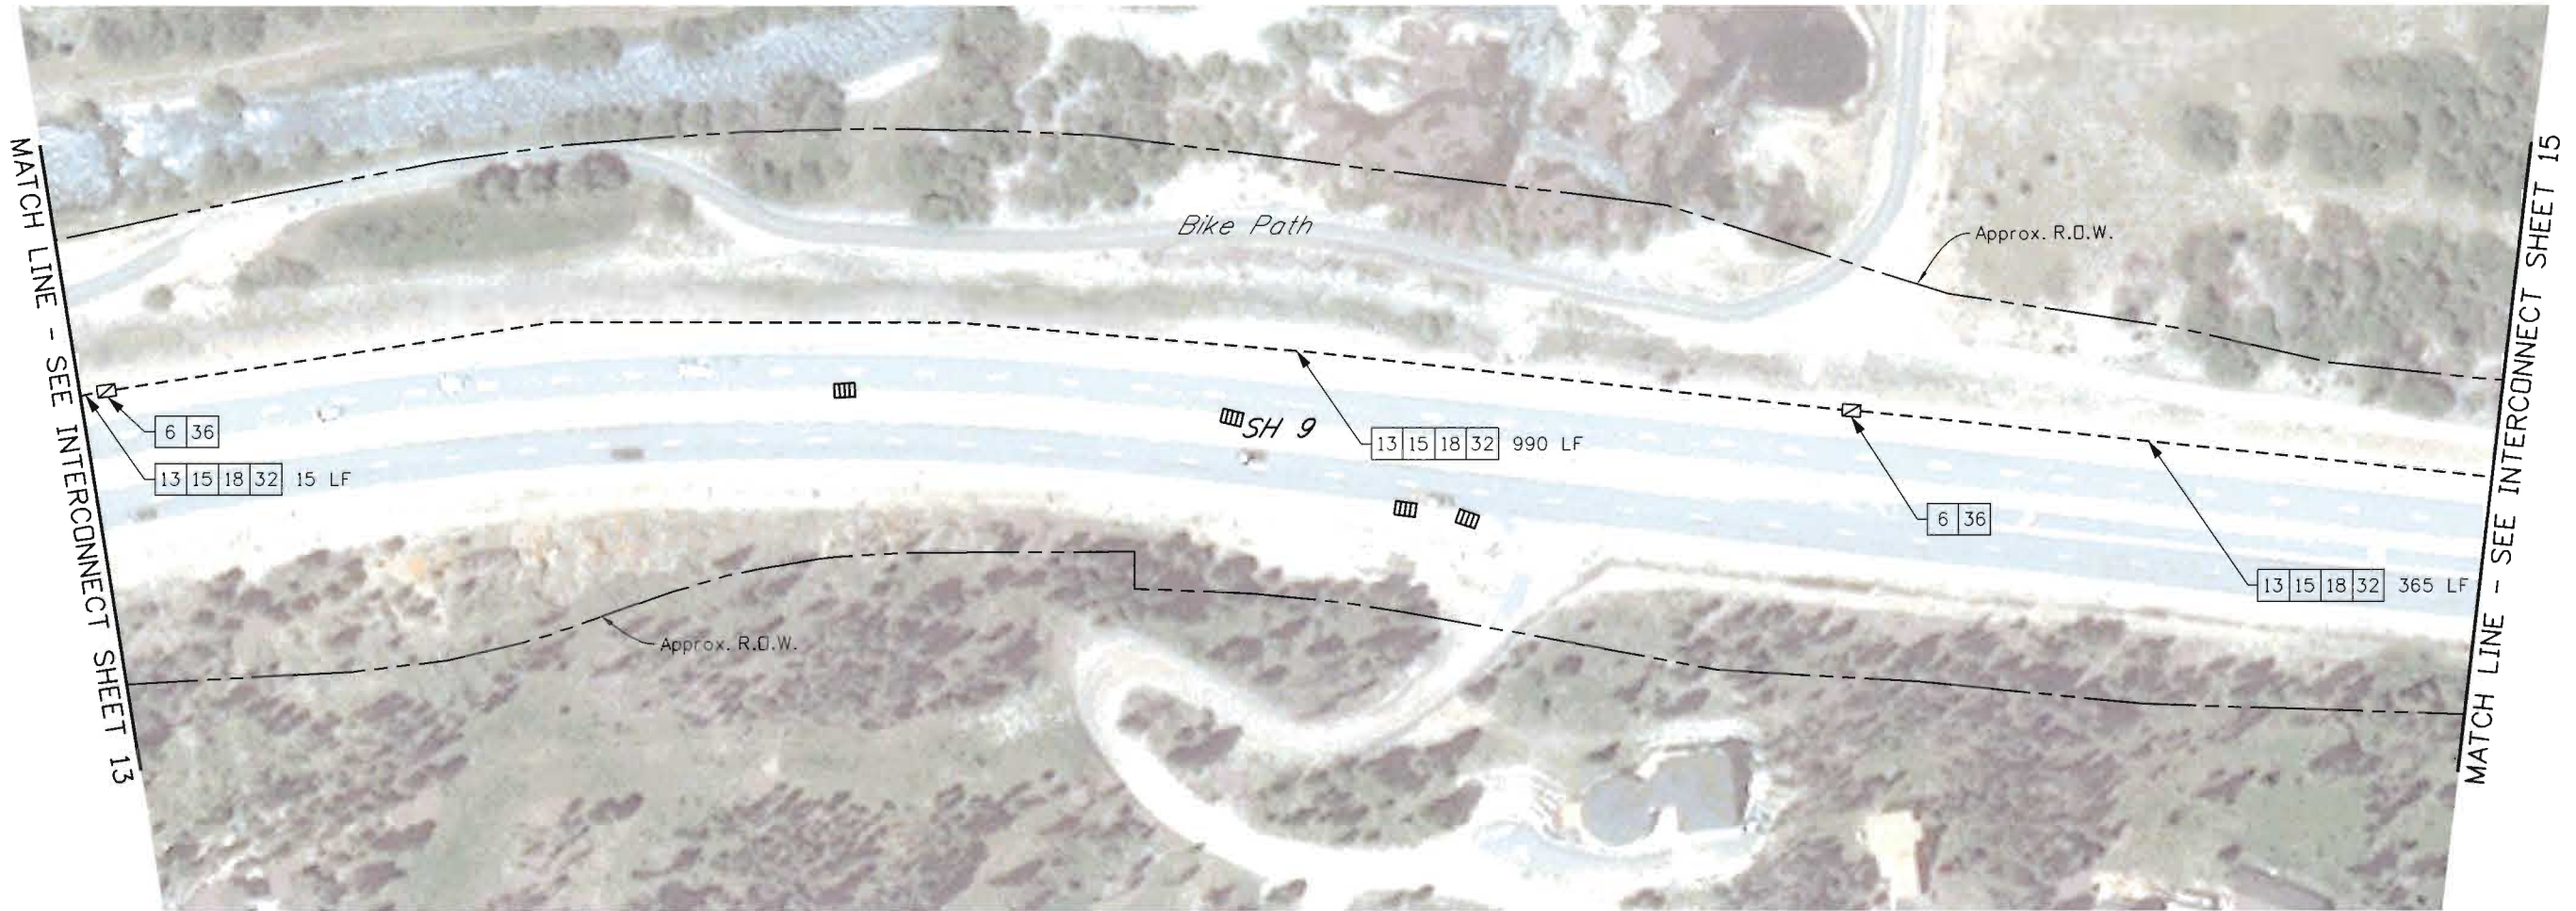

- 6 EXISTING PULL BOX (24" X 36")
- 13 EXISTING ELECTRICAL CONDUIT
- 15 EXISTING FIBER OPTIC CABLE (SINGLE MODE) (24 STRAND)
- 18 REMOVE EXISTING FIBER BACKBONE CABLE
- 32 FIBER OPTIC CABLE (SINGLE MODE) (96 STRANDS) (BACKBONE)
- 36 COIL 50 LINEAR FEET OF EACH FIBER OPTIC BACKBONE CABLE IN PULL BOX FOR SLACK

SWMP NOTES:


1. ECS SHALL PLACE BMPs IN THE FIELD AS DIRECTED BY THE SWMP NARRATIVES AND AS REQUIRED BY CDDT SPECIFICATIONS AND THE CDPS-SCP TO ENSURE ALL POTENTIAL POLLUTANTS FROM CONSTRUCTION WILL NOT ENTER STATE WATERS. ECS SHALL SHOW AND UPDATE BMPs ON PLAN SHEETS, SIGN AND DATE WHEN INSTALLED.
2. CONSTRUCTION BOUNDARY IS EXISTING ROW
3. SEE SWMP TYPICAL SECTIONS FOR LIMITS OF DISTURBANCE

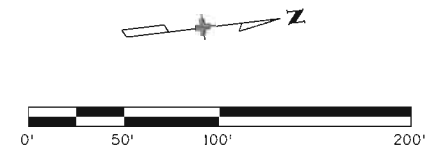

Print Date: 5/22/2012	
Drawing File Name: 18777TRAF_Plan14.dgn	
Horiz. Scale: 1:100	Vert. Scale: As Noted
Unit Information	Unit Leader Initials
MULLER	Muller Engineering Co., Inc. Consulting Engineers P:10-028.13 - SH 9 Interconnect\Traffic_ITS
apexdesign	

Sheet Revisions		
Date:	Comments	Init.

Colorado Department of Transportation




18500 East Colfax Avenue
Aurora, CO 80011
Phone: 303-757-9648 FAX: 303-757-9746

Region 1

SS

As Constructed		TRAFFIC SIGNAL INTERCONNECT		Project No./Code	
No Revisions:				MTCE 0091-039	
Revised:		Designer: KEB	Structure Numbers	18777	
Void:		Detailer: PJS		Sheet Number 24	
		Sheet Subset: ITS	Subset Sheets: 14 of 46		

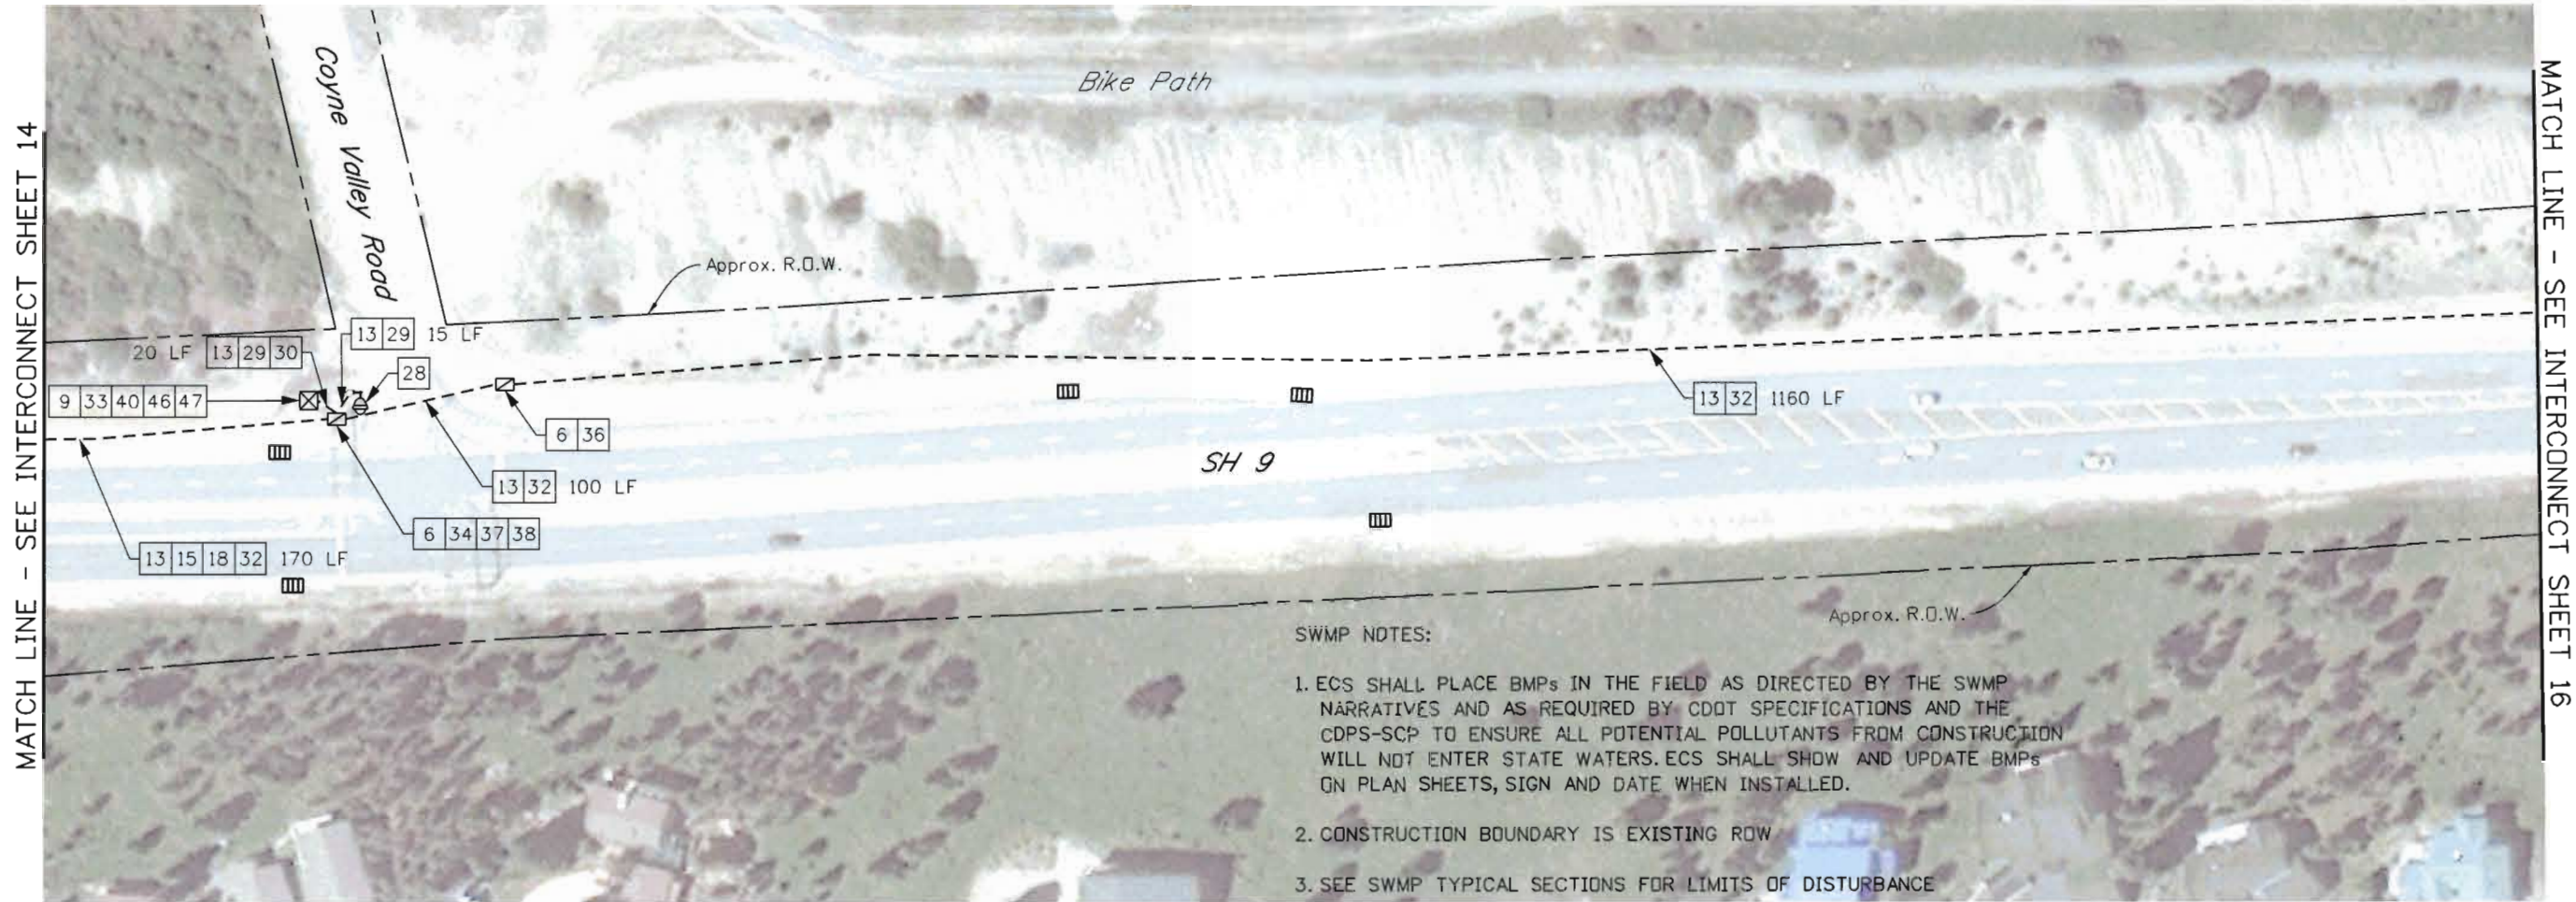


- 6 EXISTING PULL BOX (24" X 36")
- 9 EXISTING TRAFFIC SIGNAL CONTROLLER CABINET
- 13 EXISTING ELECTRICAL CONDUIT
- 15 EXISTING FIBER OPTIC CABLE (SINGLE MODE) (24 STRAND)
- 18 REMOVE EXISTING FIBER BACKBONE CABLE
- 28 CLOSED CIRCUIT TELEVISION CAMERA (TRAFFIC SURVEILLANCE)
- 29 CLOSED CIRCUIT TELEVISION CABLE
- 30 FIBER OPTIC CABLE (SINGLE MODE) (12 STRANDS) (LATERAL)
- 32 FIBER OPTIC CABLE (SINGLE MODE) (96 STRANDS) (BACKBONE)

- 33 COIL 10 LINEAR FEET OF EACH FIBER OPTIC LATERAL CABLE IN CABINET FOR SLACK
- 34 COIL 25 LINEAR FEET OF EACH FIBER OPTIC LATERAL CABLE IN PULL BOX FOR SLACK
- 36 COIL 50 LINEAR FEET OF EACH FIBER OPTIC BACKBONE CABLE IN PULL BOX FOR SLACK
- 37 COIL 100 LINEAR FEET OF EACH FIBER OPTIC BACKBONE CABLE IN PULL BOX FOR SLACK
- 38 FIBER OPTIC SPLICE CLOSURE. FUSION SPLICE FIBERS PER SPLICING DETAIL SHEETS.
- 40 FIBER OPTIC TERMINATION PANEL - 12 FIBER
- 46 ETHERNET SWITCH
- 47 SERIAL TO IP CONVERTER




Know what's below.
Call before you dig.

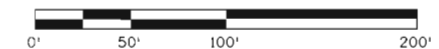

5/22/2012 3:03:23 PM P:\10-028.13 Region 1 Umbrella 2011 CDOT\102 - SH 9 SignalInterconnect\18777\Traffic ITS\Drawings\18777TRAF_Plan15.dgn

Print Date: 5/22/2012	
Drawing File Name: 18777TRAF_Plan15.dgn	
Horiz. Scale: 1:100	Vert. Scale: As Noted
Unit Information	Unit Leader Initials
MULLER	Muller Engineering Co., Inc. Consulting Engineers P:\10-028.13 - SH 9 Interconnect\Traffic ITS
apexdesign	


Sheet Revisions		
Date:	Comments	Init.

Colorado Department of Transportation	
	18500 East Colfax Avenue Aurora, CO 80011 Phone: 303-757-9648 FAX: 303-757-9746
Region 1	SS

As Constructed		TRAFFIC SIGNAL INTERCONNECT			Project No./Code
No Revisions:					MTCE 0091-039
Revised:		Designer: KEB	Structure		18777
Void:		Detailer: PJS	Numbers		
		Sheet Subset: ITS	Subset Sheets:	15 of 46	Sheet Number 25

MATCH LINE - SEE INTERCONNECT SHEET 15

MATCH LINE - SEE INTERCONNECT SHEET 17

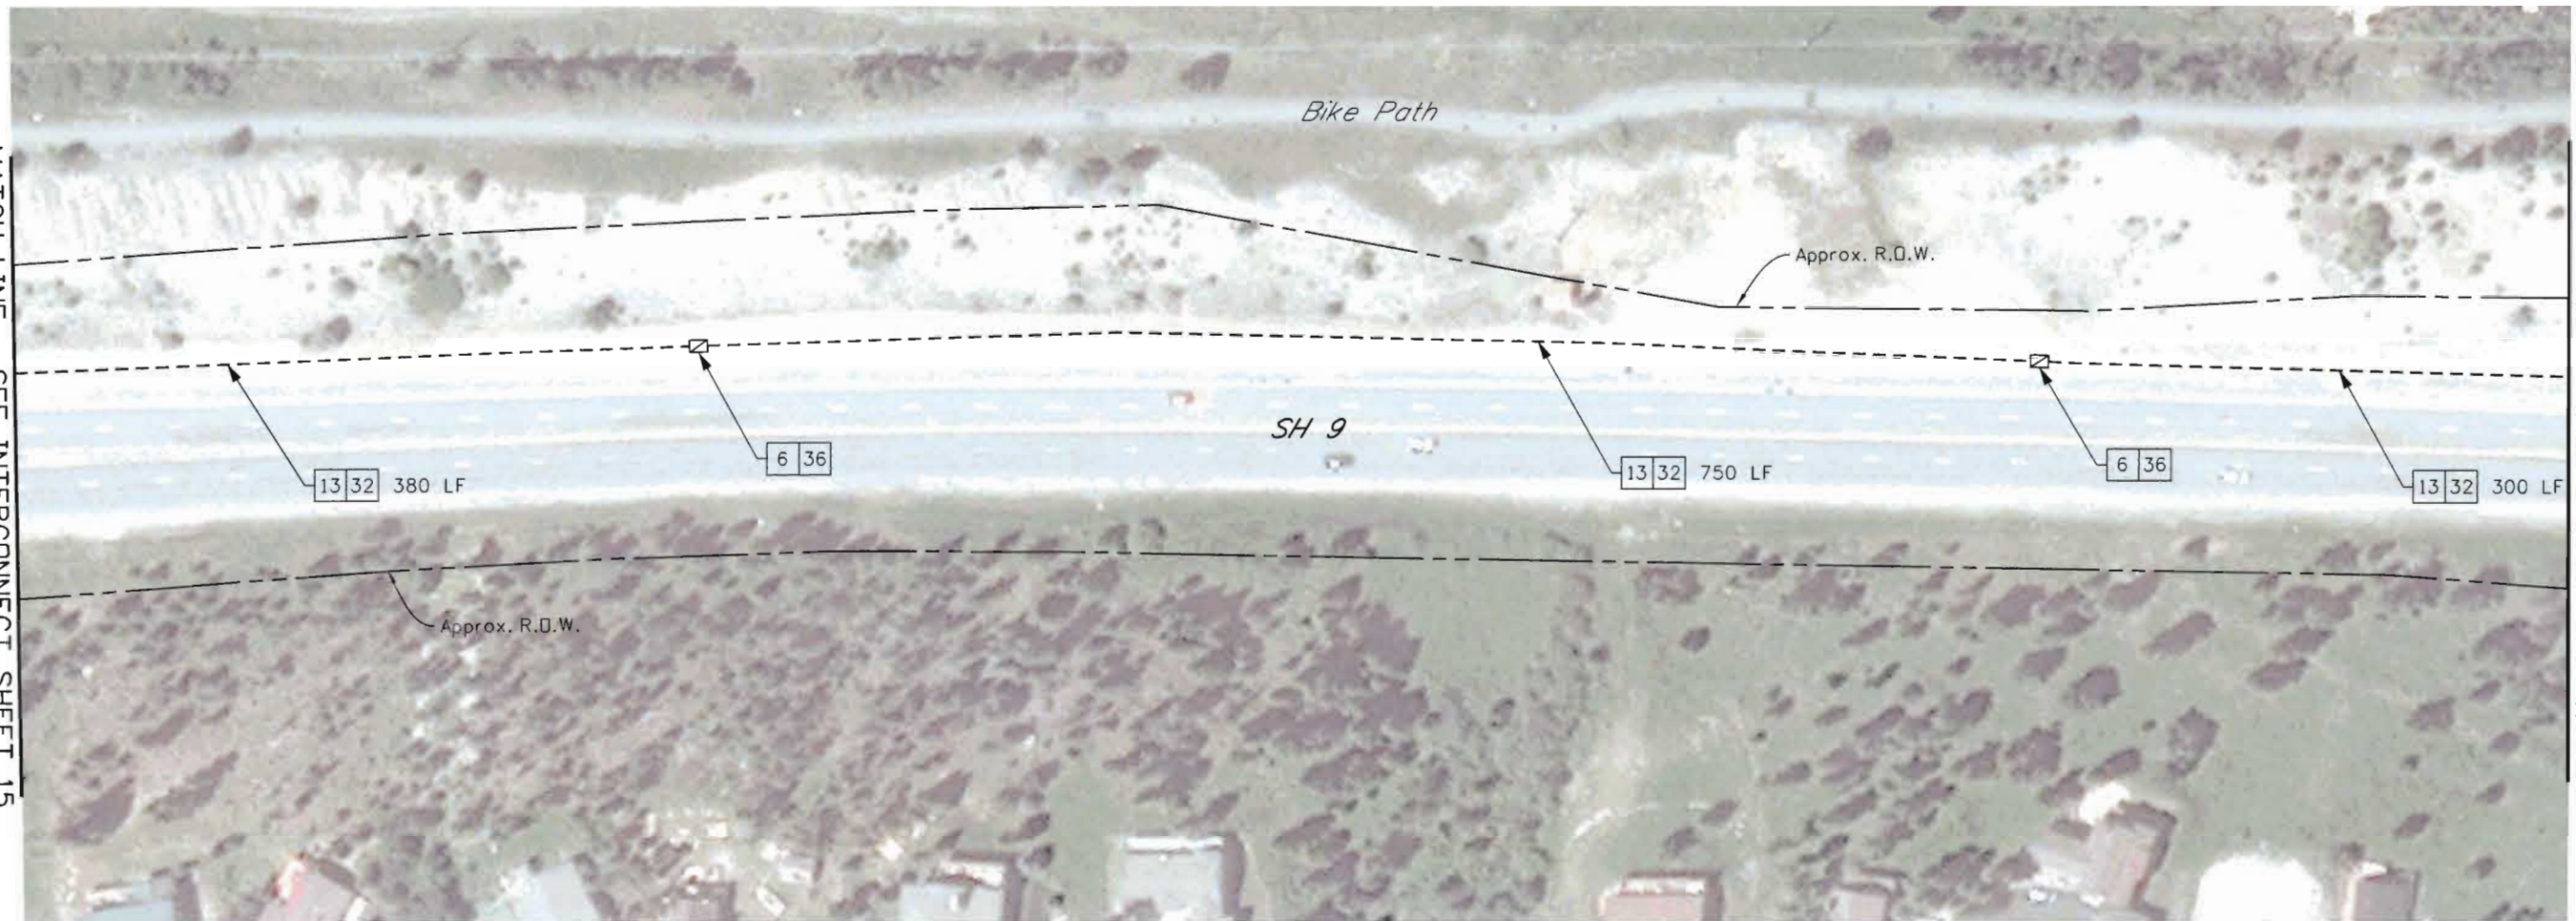

- [6] EXISTING PULL BOX (24" X 36")
- [13] EXISTING ELECTRICAL CONDUIT
- [32] FIBER OPTIC CABLE (SINGLE MODE) (96 STRANDS) (BACKBONE)
- [36] COIL 50 LINEAR FEET OF EACH FIBER OPTIC BACKBONE CABLE IN PULL BOX FOR SLACK

SWMP NOTES:

1. ECS SHALL PLACE BMPs IN THE FIELD AS DIRECTED BY THE SWMP NARRATIVES AND AS REQUIRED BY CDOT SPECIFICATIONS AND THE CDPS-SCP TO ENSURE ALL POTENTIAL POLLUTANTS FROM CONSTRUCTION WILL NOT ENTER STATE WATERS. ECS SHALL SHOW AND UPDATE BMPs ON PLAN SHEETS, SIGN AND DATE WHEN INSTALLED.
2. CONSTRUCTION BOUNDARY IS EXISTING ROW
3. SEE SWMP TYPICAL SECTIONS FOR LIMITS OF DISTURBANCE




Know what's below.
Call before you dig.



5/22/2012 3:03:31 PM P:\10-028.13 Region 1 Umbrella 2011 CDOT\102 - SH 9 Signal Interconnect\18777\Traffic_ITS\Drawings\18777\TRAF_Plan16.dgn

Print Date: 5/22/2012	
Drawing File Name: 18777TRAF_Plan16.dgn	
Horiz. Scale: 1:100	Vert. Scale: As Noted
Unit Information	Unit Leader Initials
MULLER Muller Engineering Co., Inc. Consulting Engineers	apexdesign
P:\10-028.13 - SH 9 Interconnect\Traffic_ITS	


Sheet Revisions		
Date:	Comments	Init.

Colorado Department of Transportation	
	18500 East Colfax Avenue Aurora, CO 80011 Phone: 303-757-9648 FAX: 303-757-9746
Region 1	SS

As Constructed		TRAFFIC SIGNAL INTERCONNECT		Project No./Code	
No Revisions:				MTCE 0091-039	
Revised:		Designer: KEB	Structure Numbers	18777	
Void:		Detailer: PJS		Sheet Number 26	
		Sheet Subset: ITS	Subset Sheets: 16 of 46		

5/22/2012 3:03:39 PM P:\10-028.13 Region 1 Umbrella 2011 CDOT\102 - SH 9 SignalInterconnect\18777Traffic_ITS\Drawings\18777TRAFF_Plan17.dgn

MATCH LINE - SEE INTERCONNECT SHEET 16

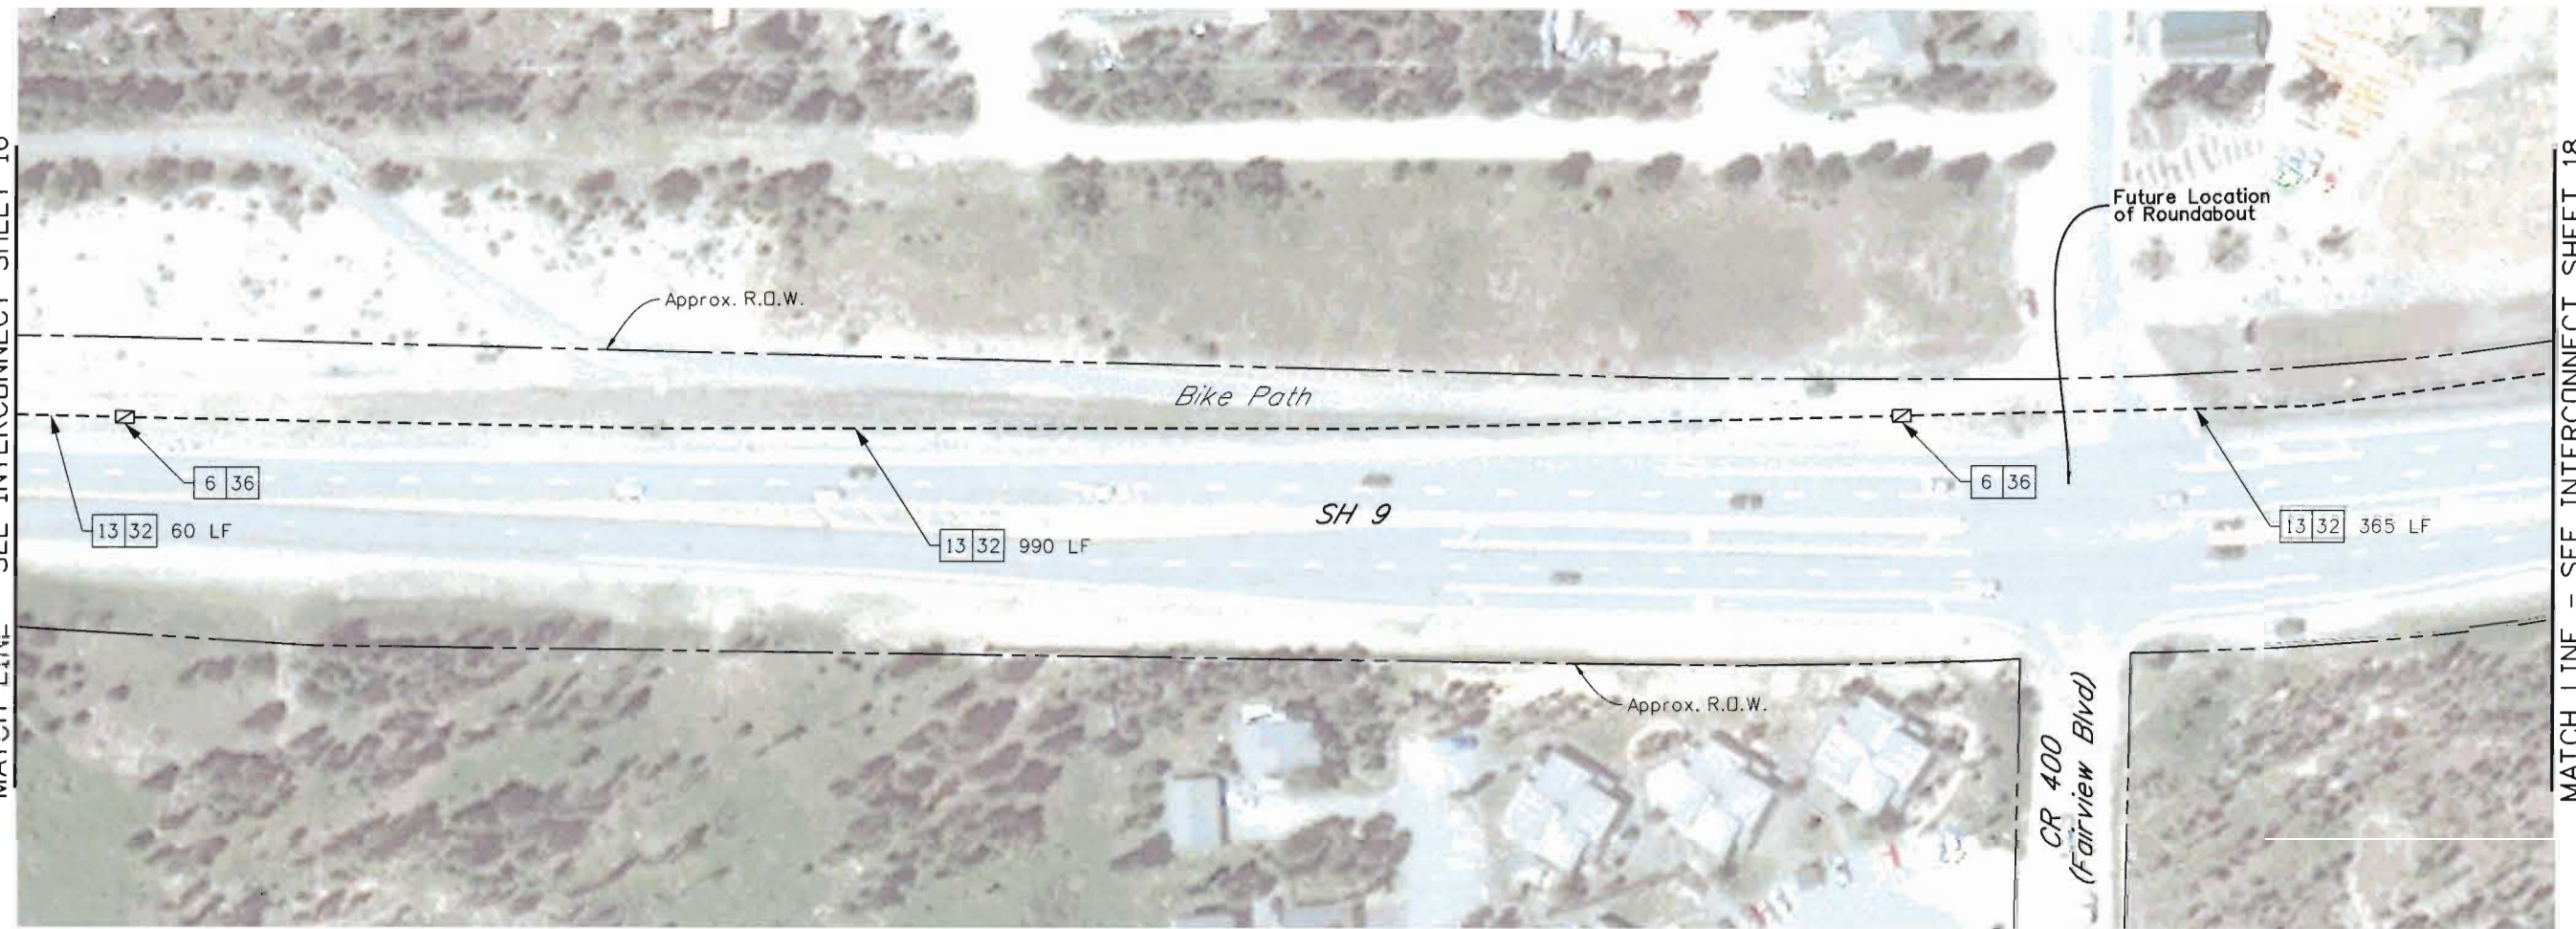

MATCH LINE - SEE INTERCONNECT SHEET 18


- 6 EXISTING PULL BOX (24" X 36")
- 13 EXISTING ELECTRICAL CONDUIT
- 32 FIBER OPTIC CABLE (SINGLE MODE) (96 STRANDS) (BACKBONE)
- 36 COIL 50 LINEAR FEET OF EACH FIBER OPTIC BACKBONE CABLE IN PULL BOX FOR SLACK

SWMP NOTES:

1. ECS SHALL PLACE BMPs IN THE FIELD AS DIRECTED BY THE SWMP NARRATIVES AND AS REQUIRED BY CDOT SPECIFICATIONS AND THE CDPS-SCP TO ENSURE ALL POTENTIAL POLLUTANTS FROM CONSTRUCTION WILL NOT ENTER STATE WATERS. ECS SHALL SHOW AND UPDATE BMPs ON PLAN SHEETS, SIGN AND DATE WHEN INSTALLED.
2. CONSTRUCTION BOUNDARY IS EXISTING ROW
3. SEE SWMP TYPICAL SECTIONS FOR LIMITS OF DISTURBANCE




Know what's below.
Call before you dig.

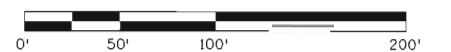

Print Date: 5/22/2012	
Drawing File Name: 18777TRAFF_Plan17.dgn	
Horiz. Scale: 1:100	Vert. Scale: As Noted
Unit Information	Unit Leader Initials
MULLER Consulting Engineers	apexdesign
P:\10-028.13 - SH 9 Interconnect\Traffic_ITS	


Sheet Revisions		
Date:	Comments	Init.

Colorado Department of Transportation		As Constructed		TRAFFIC SIGNAL INTERCONNECT		Project No./Code	
 18500 East Colfax Avenue Aurora, CO 80011 Phone: 303-757-9648 FAX: 303-757-9746 Region 1 SS		No Revisions:		Designer: KEB		MTCE 0091-039	
		Revised:		Detailer: PJS		18777	
		Void:		Sheet Subset: ITS		Sheet Number 27	
				Structure Numbers		Subset Sheets: 17 of 46	

5/22/2012 3:03:54 PM P:\10-028.13 Region 1 Umbrella 2011 CDDT\102 - SH 9 Signal Interconnect\18777\Traffic_ITS\Drawings\18777TRAF_Plan18.dgn

MATCH LINE - SEE INTERCONNECT SHEET 17

MATCH LINE - SEE INTERCONNECT SHEET 19

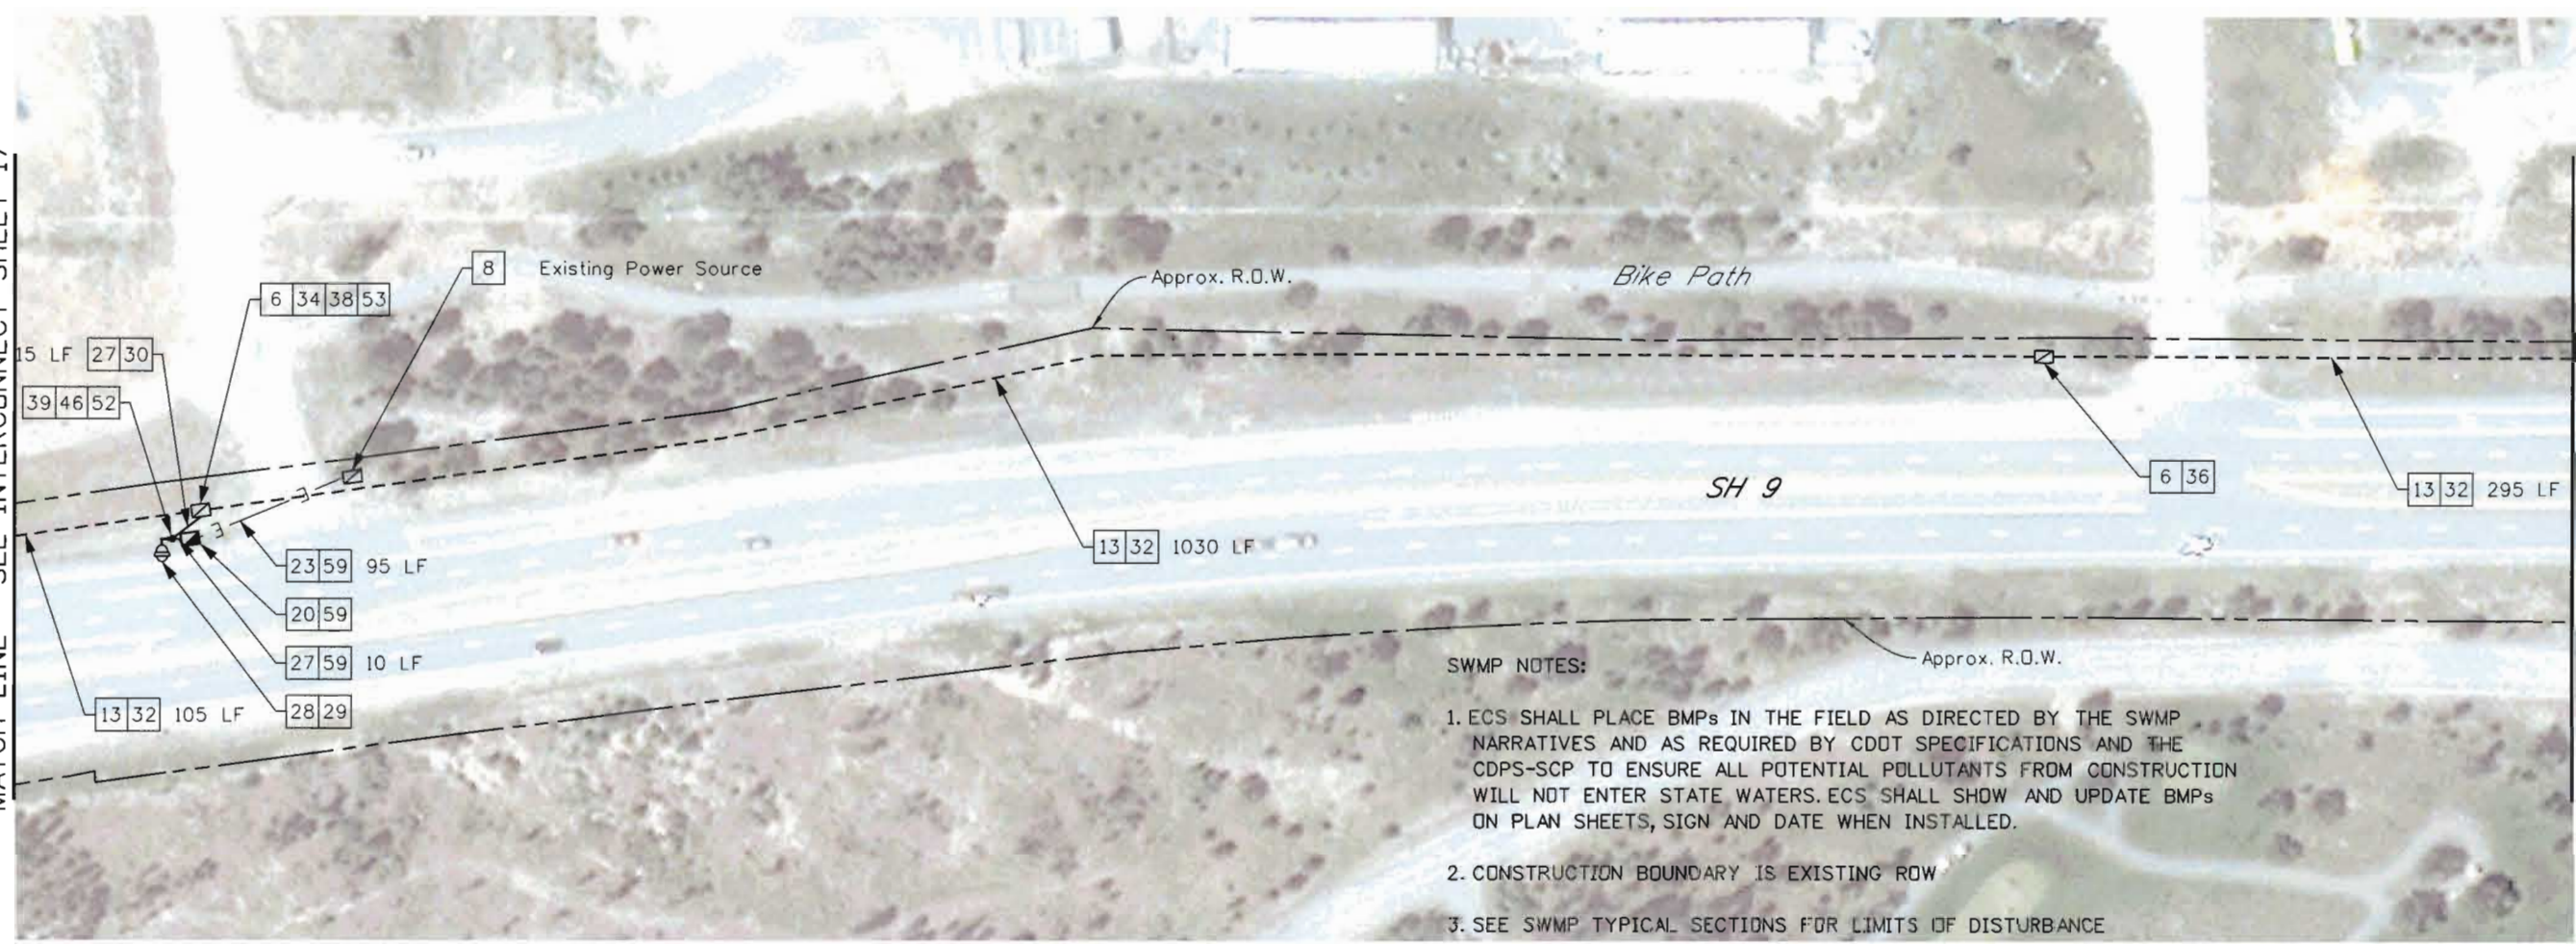

SWMP NOTES:

1. ECS SHALL PLACE BMPs IN THE FIELD AS DIRECTED BY THE SWMP NARRATIVES AND AS REQUIRED BY CDDT SPECIFICATIONS AND THE CDPS-SCP TO ENSURE ALL POTENTIAL POLLUTANTS FROM CONSTRUCTION WILL NOT ENTER STATE WATERS. ECS SHALL SHOW AND UPDATE BMPs ON PLAN SHEETS, SIGN AND DATE WHEN INSTALLED.
2. CONSTRUCTION BOUNDARY IS EXISTING ROW
3. SEE SWMP TYPICAL SECTIONS FOR LIMITS OF DISTURBANCE

- 6 EXISTING PULL BOX (24" X 36")
- 8 EXISTING PULL BOX
- 13 EXISTING ELECTRICAL CONDUIT
- 20 PULL BOX (18" X 30" 18")
- 23 2-2 INCH ELECTRICAL CONDUIT (MULTIDUCT) (BORED)
- 27 1-1/4 INCH ELECTRICAL CONDUIT (LIQUIDTIGHT FLEXIBLE METAL)
- 28 CLOSED CIRCUIT TELEVISION CAMERA (TRAFFIC SURVEILLANCE)
- 29 CLOSED CIRCUIT TELEVISION CABLE
- 30 FIBER OPTIC CABLE (SINGLE MODE) (12 STRANDS) (LATERAL)
- 32 FIBER OPTIC CABLE (SINGLE MODE) (96 STRANDS) (BACKBONE)

- 34 COIL 25 LINEAR FEET OF EACH FIBER OPTIC LATERAL CABLE IN PULL BOX FOR SLACK
- 36 COIL 50 LINEAR FEET OF EACH FIBER OPTIC BACKBONE CABLE IN PULL BOX FOR SLACK
- 38 FIBER OPTIC SPLICE CLOSURE. FUSION SPLICE FIBERS PER SPLICING DETAIL SHEETS.
- 39 FIBER OPTIC TERMINATION PANEL - 6 FIBER
- 46 ETHERNET SWITCH
- 52 CLOSED CIRCUIT TELEVISION POLE AND COMMUNICATIONS CABINET
- 53 COIL 200 LINEAR FEET OF EACH FIBER OPTIC BACKBONE CABLE IN PULL BOX FOR SLACK
- 59 WIRING. THE CONTRACTOR SHALL BE RESPONSIBLE FOR DETERMINING THE MINIMUM AMPACITY AND SIZE OF THE CONDUCTORS FOR THIS RUN BASED ON A MAXIMUM VOLTAGE DROP OF 3% BASED ON ARTICLES 210-19, 215-2, OR 230-31 OF THE NEC, AS APPLICABLE. THE MAXIMUM TOTAL VOLTAGE DROP FOR A COMBINATION OF BOTH BRANCH CIRCUIT AND FEEDER SHALL NOT EXCEED 5%. GROUNDING CONDUCTORS SHALL CONFORM TO ARTICLE 250-122 OF THE NEC.




**Know what's below.
Call before you dig.**



Print Date: 5/22/2012		Sheet Revisions		Colorado Department of Transportation		As Constructed		TRAFFIC SIGNAL INTERCONNECT				Project No./Code	
Drawing File Name:18777TRAF_Plan18.dgn													
Horiz. Scale: 1:100		Vert. Scale: As Noted		 18500 East Colfax Avenue Aurora, CO 80011 Phone: 303-757-9648 FAX: 303-757-9746 Region 1SS		No Revisions:		Designer: KEB		Structure		MTCE 0091-039	
Unit Information		Unit Leader Initials				Revised:		Detailer: PJS		Numbers		18777	
 Muller Engineering Co., Inc. Consulting Engineers P:\10-028.13 - SH 9 Interconnect\Traffic_ITS						Void:		Sheet Subset: ITS		Subset Sheets: 18 of 46		Sheet Number 28	

5/22/2012 3:04:02 PM P:\10-026\13 Region 1 Umbrella 2011 CDOT\102 - SH 9 Signal Interconnect\18777-Traffic-ITS\Drawings\18777TRAF_Plan19.dgn

MATCH LINE - SEE INTERCONNECT SHEET 18

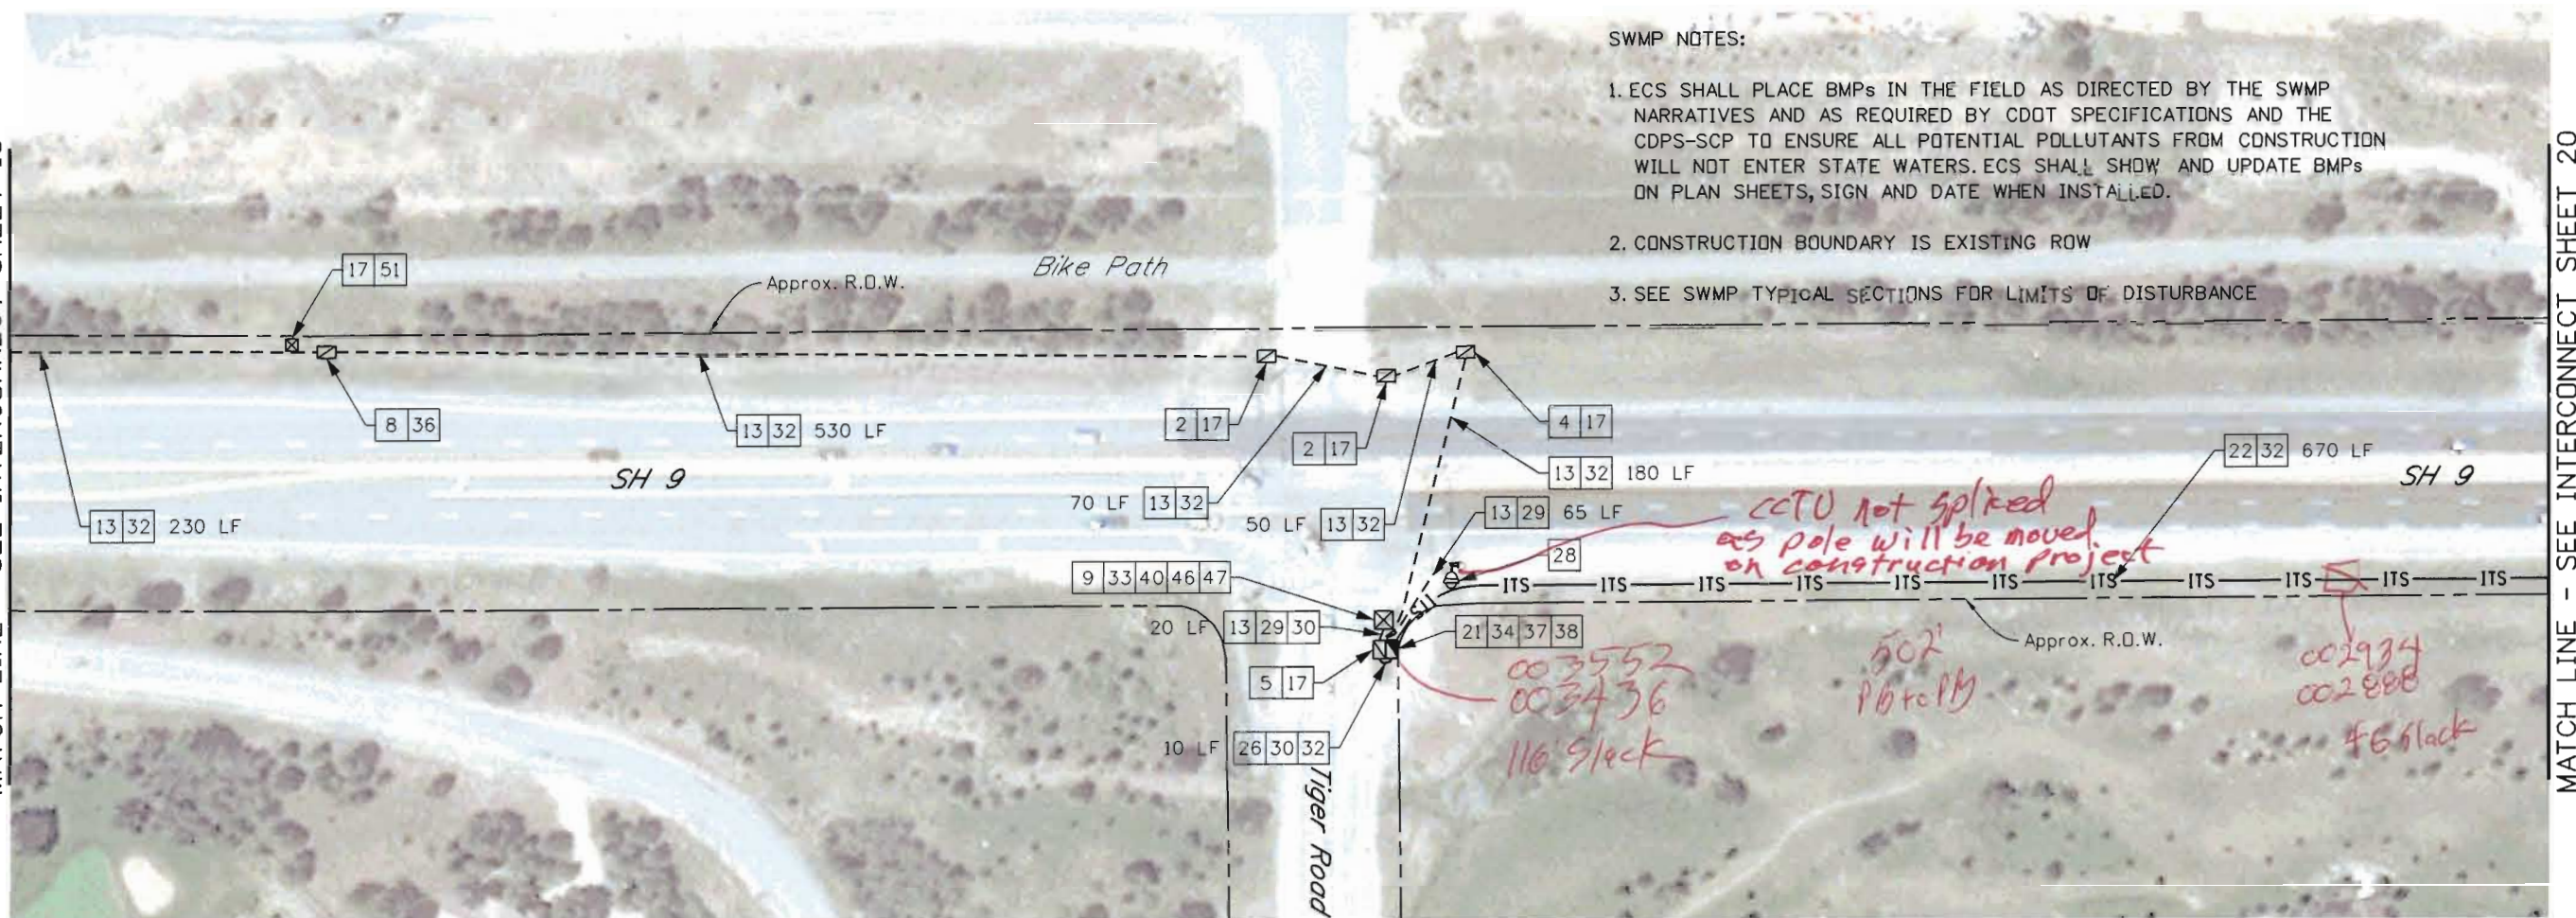

SWMP NOTES:

1. ECS SHALL PLACE BMPs IN THE FIELD AS DIRECTED BY THE SWMP NARRATIVES AND AS REQUIRED BY CDOT SPECIFICATIONS AND THE CDPS-SCP TO ENSURE ALL POTENTIAL POLLUTANTS FROM CONSTRUCTION WILL NOT ENTER STATE WATERS. ECS SHALL SHOW AND UPDATE BMPs ON PLAN SHEETS, SIGN AND DATE WHEN INSTALLED.
2. CONSTRUCTION BOUNDARY IS EXISTING ROW
3. SEE SWMP TYPICAL SECTIONS FOR LIMITS OF DISTURBANCE


MATCH LINE - SEE INTERCONNECT SHEET 20

- 2 EXISTING PULL BOX (12" X 18")
- 4 EXISTING PULL BOX (13" X 24")
- 5 EXISTING PULL BOX (17" X 30")
- 8 EXISTING PULL BOX
- 9 EXISTING TRAFFIC SIGNAL CONTROLLER CABINET
- 13 EXISTING ELECTRICAL CONDUIT
- 17 PROTECT IN PLACE
- 21 PULL BOX (24" X 36" X 24")
- 22 2-2 INCH ELECTRICAL CONDUIT (MULTIDUCT) (PLASTIC)
- 26 INSTALL 2-2 INCH ELECTRICAL CONDUITS BETWEEN ADJACENT PULL BOXES
- 28 CLOSED CIRCUIT TELEVISION CAMERA (TRAFFIC SURVEILLANCE)
- 29 CLOSED CIRCUIT TELEVISION CABLE

- 30 FIBER OPTIC CABLE (SINGLE MODE) (12 STRANDS) (LATERAL)
- 32 FIBER OPTIC CABLE (SINGLE MODE) (96 STRANDS) (BACKBONE)
- 33 COIL 10 LINEAR FEET OF EACH FIBER OPTIC LATERAL CABLE IN CABINET FOR SLACK
- 34 COIL 25 LINEAR FEET OF EACH FIBER OPTIC LATERAL CABLE IN PULL BOX FOR SLACK
- 36 COIL 50 LINEAR FEET OF EACH FIBER OPTIC BACKBONE CABLE IN PULL BOX FOR SLACK
- 37 COIL 100 LINEAR FEET OF EACH FIBER OPTIC BACKBONE CABLE IN PULL BOX FOR SLACK
- 38 FIBER OPTIC SPLICE CLOSURE. FUSION SPLICE FIBERS PER SPLICING DETAIL SHEETS.
- 40 FIBER OPTIC TERMINATION PANEL - 12 FIBER
- 46 ETHERNET SWITCH
- 47 SERIAL TO IP CONVERTER
- 51 EXISTING AUTOMATIC TRAFFIC RECORDER (ATR)



Know what's below.
Call before you dig.

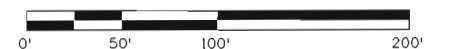

Print Date: 5/22/2012	
Drawing File Name: 18777TRAF_Plan19.dgn	
Horiz. Scale: 1:100	Vert. Scale: As Noted
Unit Information Unit Leader Initials	
<div>MULLER Muller Engineering Co., Inc. Consulting Engineers apexdesign</div>	
P:\10-026\13 - SH 9 Interconnect\Traffic-ITS	


Sheet Revisions		
Date:	Comments	Unit.

Colorado Department of Transportation	
	18500 East Colfax Avenue Aurora, CO 80011 Phone: 303-757-9648 FAX: 303-757-9746
Region 1	SS

As Constructed		TRAFFIC SIGNAL INTERCONNECT		Project No./Code	
No Revisions:				MTCE 0091-039	
Revised:		Designer: KEB	Structure	18777	
Void:		Detailer: PJS	Numbers	Sheet Number 29	
		Sheet Subset: ITS	Subset Sheets: 19 of 46		

5/22/2012 3:04:19 PM P:\10-028\13 Region 1 Umbrella 2011\CDOT\102 - SH 9 Signal Interconnect\18777-Traffic-ITS\Drawings\18777TRAF_Plan21.dgn

MATCH LINE - SEE INTERCONNECT SHEET 20

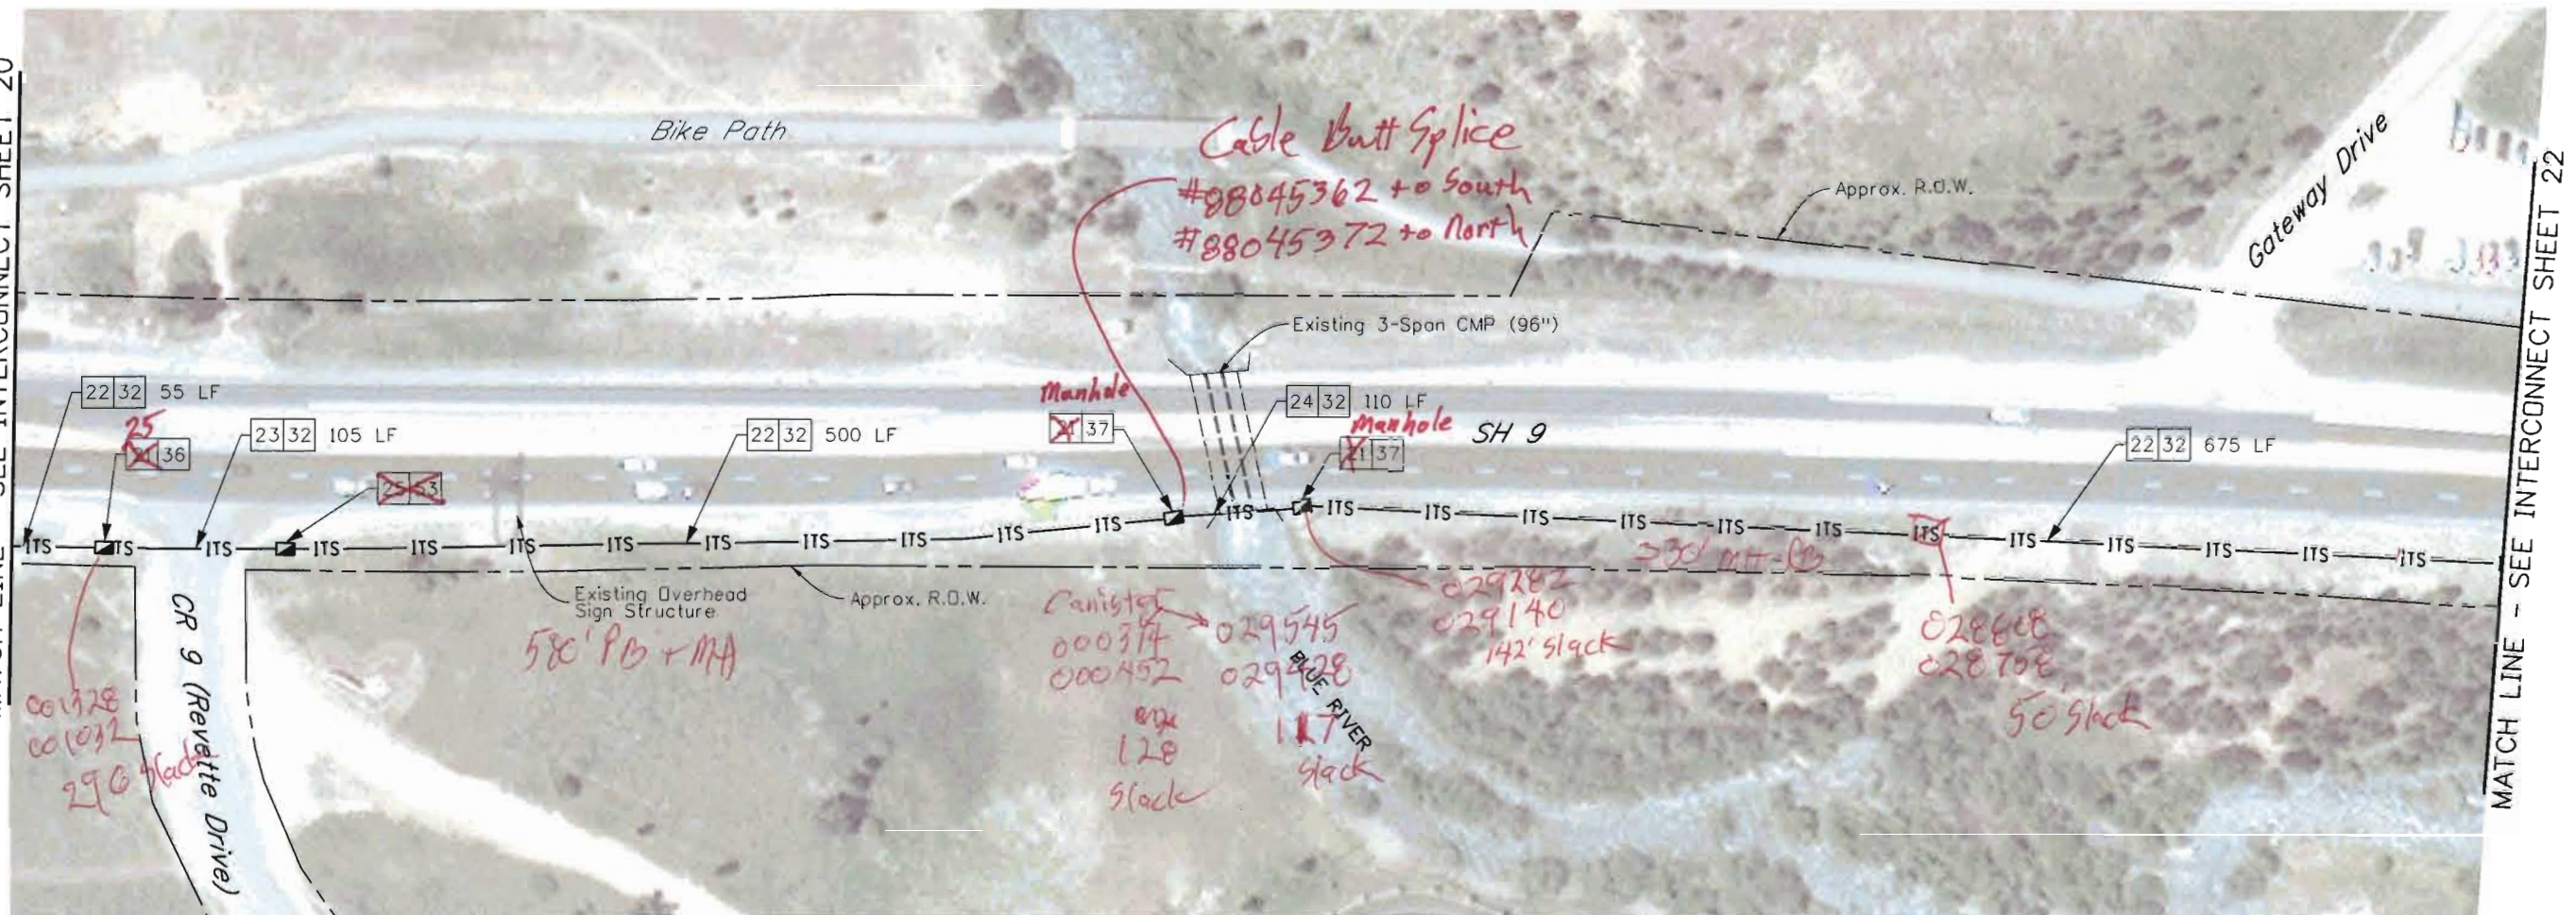

MATCH LINE - SEE INTERCONNECT SHEET 22


- [21] PULL BOX (24" X 36" X 24")
- [22] 2-2 INCH ELECTRICAL CONDUIT (MULTIDUCT) (PLASTIC)
- [23] 2-2 INCH ELECTRICAL CONDUIT (MULTIDUCT) (BORED)
- [24] 3 INCH ELECTRICAL CONDUIT - SEE CONDUIT ATTACHMENT TO BLUE RIVER STRUCTURE DETAIL
- [25] PULL BOX (30" X 48" X 24")
- [32] FIBER OPTIC CABLE (SINGLE MODE) (96 STRANDS) (BACKBONE)
- [36] COIL 50 LINEAR FEET OF EACH FIBER OPTIC BACKBONE CABLE IN PULL BOX FOR SLACK
- [37] COIL 100 LINEAR FEET OF EACH FIBER OPTIC BACKBONE CABLE IN PULL BOX FOR SLACK
- [53] COIL 200 LINEAR FEET OF EACH FIBER OPTIC BACKBONE CABLE IN PULL BOX FOR SLACK

SWMP NOTES:

1. ECS SHALL PLACE BMPs IN THE FIELD AS DIRECTED BY THE SWMP NARRATIVES AND AS REQUIRED BY CDOT SPECIFICATIONS AND THE CDPS-SCP TO ENSURE ALL POTENTIAL POLLUTANTS FROM CONSTRUCTION WILL NOT ENTER STATE WATERS. ECS SHALL SHOW AND UPDATE BMPs ON PLAN SHEETS, SIGN AND DATE WHEN INSTALLED.
2. CONSTRUCTION BOUNDARY IS EXISTING ROW
3. SEE SWMP TYPICAL SECTIONS FOR LIMITS OF DISTURBANCE




Know what's below.
Call before you dig.

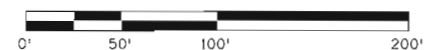

Print Date: 5/22/2012	
Drawing File Name: 18777TRAF_Plan21.dgn	
Horiz. Scale: 1"=100'	Vert. Scale: As Noted
Unit Information	Unit Leader Initials
MULLER Muller Engineering Co., Inc. Consulting Engineers	apexdesign
P10-028\13 - SH 9 Interconnect\Traffic-ITS	


Sheet Revisions		
Date:	Comments	Init.

Colorado Department of Transportation	
	18500 East Colfax Avenue Aurora, CO 80011 Phone: 303-757-9648 FAX: 303-757-9746
Region 1	SS

As Constructed		TRAFFIC SIGNAL INTERCONNECT		Project No./Code
No Revisions:		Designer: KEB		MTCE 0091-039
Revised:		Detailer: PJS	Structure Numbers	18777
Void:		Sheet Subset: ITS	Subset Sheets: 21 of 46	Sheet Number 31

5/22/2012 3:04:32 PM P:\10-028.13 Region 1 Umbrella 2011 CDOT\102 - SH 9 Signal Interconnect\18777\Traffic_ITS\Drawings\18777TRAF_Plan22.dgn

MATCH LINE - SEE INTERCONNECT SHEET 21

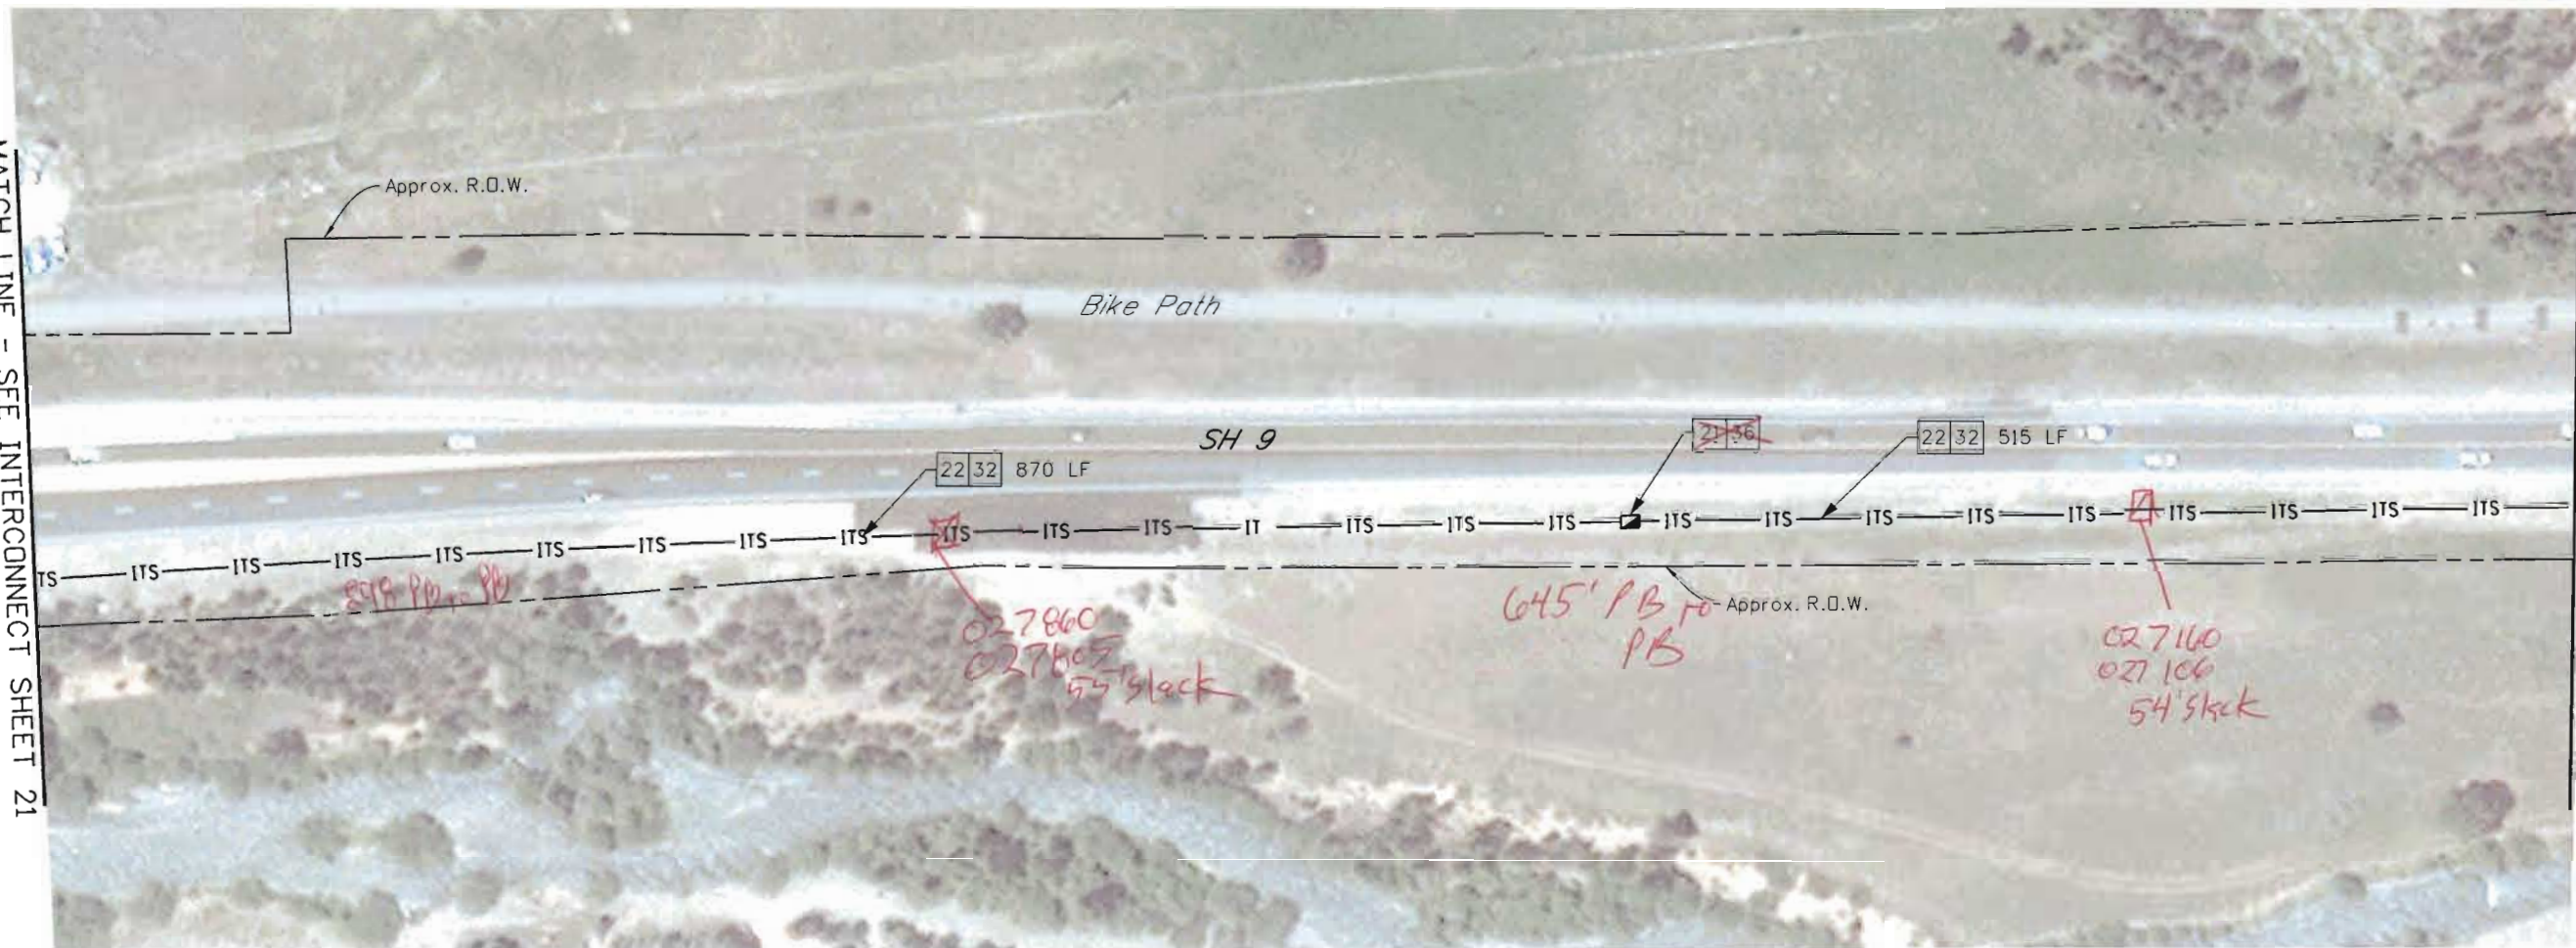

MATCH LINE - SEE INTERCONNECT SHEET 23

- 21 PULL BOX (24" X 36" X 24")
- 22 2-2 INCH ELECTRICAL CONDUIT (MULTIDUCT) (PLASTIC)
- 32 FIBER OPTIC CABLE (SINGLE MODE) (96 STRANDS) (BACKBONE)
- 36 COIL 50 LINEAR FEET OF EACH FIBER OPTIC BACKBONE CABLE IN PULL BOX FOR SLACK

SWMP NOTES:

1. ECS SHALL PLACE BMPs IN THE FIELD AS DIRECTED BY THE SWMP NARRATIVES AND AS REQUIRED BY CDOT SPECIFICATIONS AND THE CDPS-SCP TO ENSURE ALL POTENTIAL POLLUTANTS FROM CONSTRUCTION WILL NOT ENTER STATE WATERS. ECS SHALL SHOW AND UPDATE BMPs ON PLAN SHEETS, SIGN AND DATE WHEN INSTALLED.
2. CONSTRUCTION BOUNDARY IS EXISTING ROW
3. SEE SWMP TYPICAL SECTIONS FOR LIMITS OF DISTURBANCE




Know what's below.
Call before you dig.




Print Date: 5/22/2012	
Drawing File Name: 18777TRAF_Plan22.dgn	
Horiz. Scale: 1"=100'	Vert. Scale: As Noted
Unit Information	
Unit Leader Initials	
MULLER Muller Engineering Co., Inc. Consulting Engineers	
apexdesign	
P10-028.13 - SH 9 Interconnect\Traffic_ITS	

Sheet Revisions		
Date:	Comments	Init.

Colorado Department of Transportation	
	18500 East Colfax Avenue Aurora, CO 80011 Phone: 303-757-9648 FAX: 303-757-9746
Region 1	SS

As Constructed		TRAFFIC SIGNAL INTERCONNECT		Project No./Code	
No Revisions:				MTCE 0091-039	
Revised:		Designer: KEB	Structure Numbers	18777	
Void:		Detailer: PJS		Sheet Number 32	
		Sheet Subset: ITS	Subset Sheets: 22 of 46		

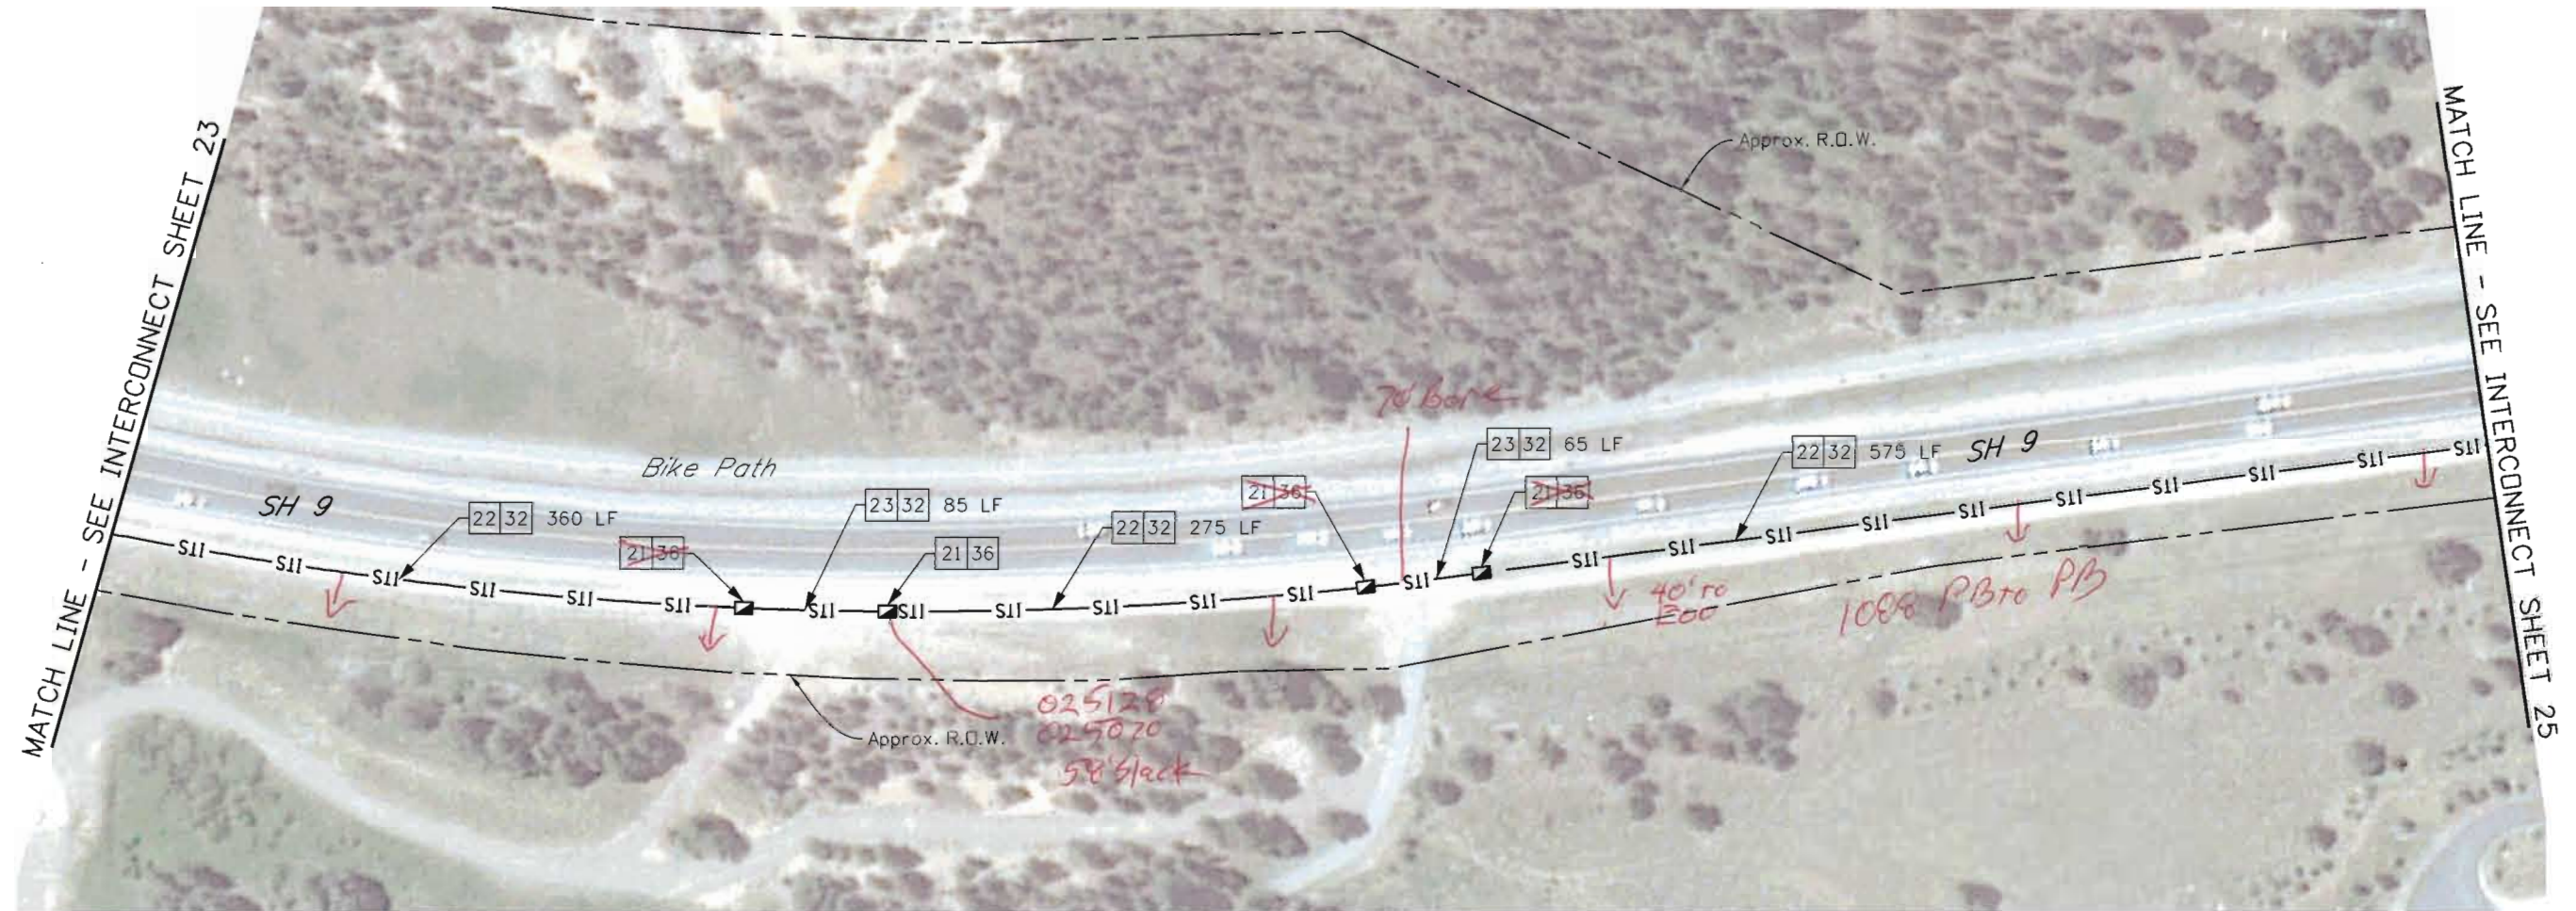


- [21] PULL BOX (24" X 36" X 24")
- [22] 2-2 INCH ELECTRICAL CONDUIT (MULTIDUCT) (PLASTIC)
- [23] 2-2 INCH ELECTRICAL CONDUIT (MULTIDUCT) (BORED)
- [32] FIBER OPTIC CABLE (SINGLE MODE) (96 STRANDS) (BACKBONE)
- [36] COIL 50 LINEAR FEET OF EACH FIBER OPTIC BACKBONE CABLE IN PULL BOX FOR SLACK

SWMP NOTES:

1. ECS SHALL PLACE BMPs IN THE FIELD AS DIRECTED BY THE SWMP NARRATIVES AND AS REQUIRED BY CDOT SPECIFICATIONS AND THE CDPS-SCP TO ENSURE ALL POTENTIAL POLLUTANTS FROM CONSTRUCTION WILL NOT ENTER STATE WATERS. ECS SHALL SHOW AND UPDATE BMPs ON PLAN SHEETS, SIGN AND DATE WHEN INSTALLED.
2. CONSTRUCTION BOUNDARY IS EXISTING ROW
3. SEE SWMP TYPICAL SECTIONS FOR LIMITS OF DISTURBANCE



Know what's below.
Call before you dig.

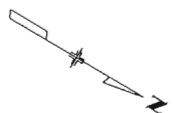

5/22/2012 3:04:49 PM P:\10-028.13 Region 1\Lincoln\102 - SH 9 SignalInterconnect\18777\Traffic_ITS\Drawings\18777TRAF_Plan24.dgn


Print Date: 5/22/2012	
Drawing File Name: 18777TRAF_Plan24.dgn	
Horiz. Scale: 1:100	Vert. Scale: As Noted
Unit Information	Unit Leader Initials
MULLER Muller Engineering Co., Inc. Consulting Engineers	apexdesign
P:10-028.13 - SH 9 Interconnect\Traffic_ITS	

Sheet Revisions		
Date:	Comments	Init.

Colorado Department of Transportation	
	18500 East Colfax Avenue Aurora, CO 80011 Phone: 303-757-9648 FAX: 303-757-9746
Region 1	SS

As Constructed		TRAFFIC SIGNAL INTERCONNECT		Project No./Code	
No Revisions:		Designer: KEB		MTCE 0091-039	
Revised:		Detailer: PJS		18777	
Void:		Sheet Subset: ITS		Sheet Number 34	
		Structure Numbers		Subset Sheets: 24 of 46	

MATCH LINE - SEE INTERCONNECT SHEET 24

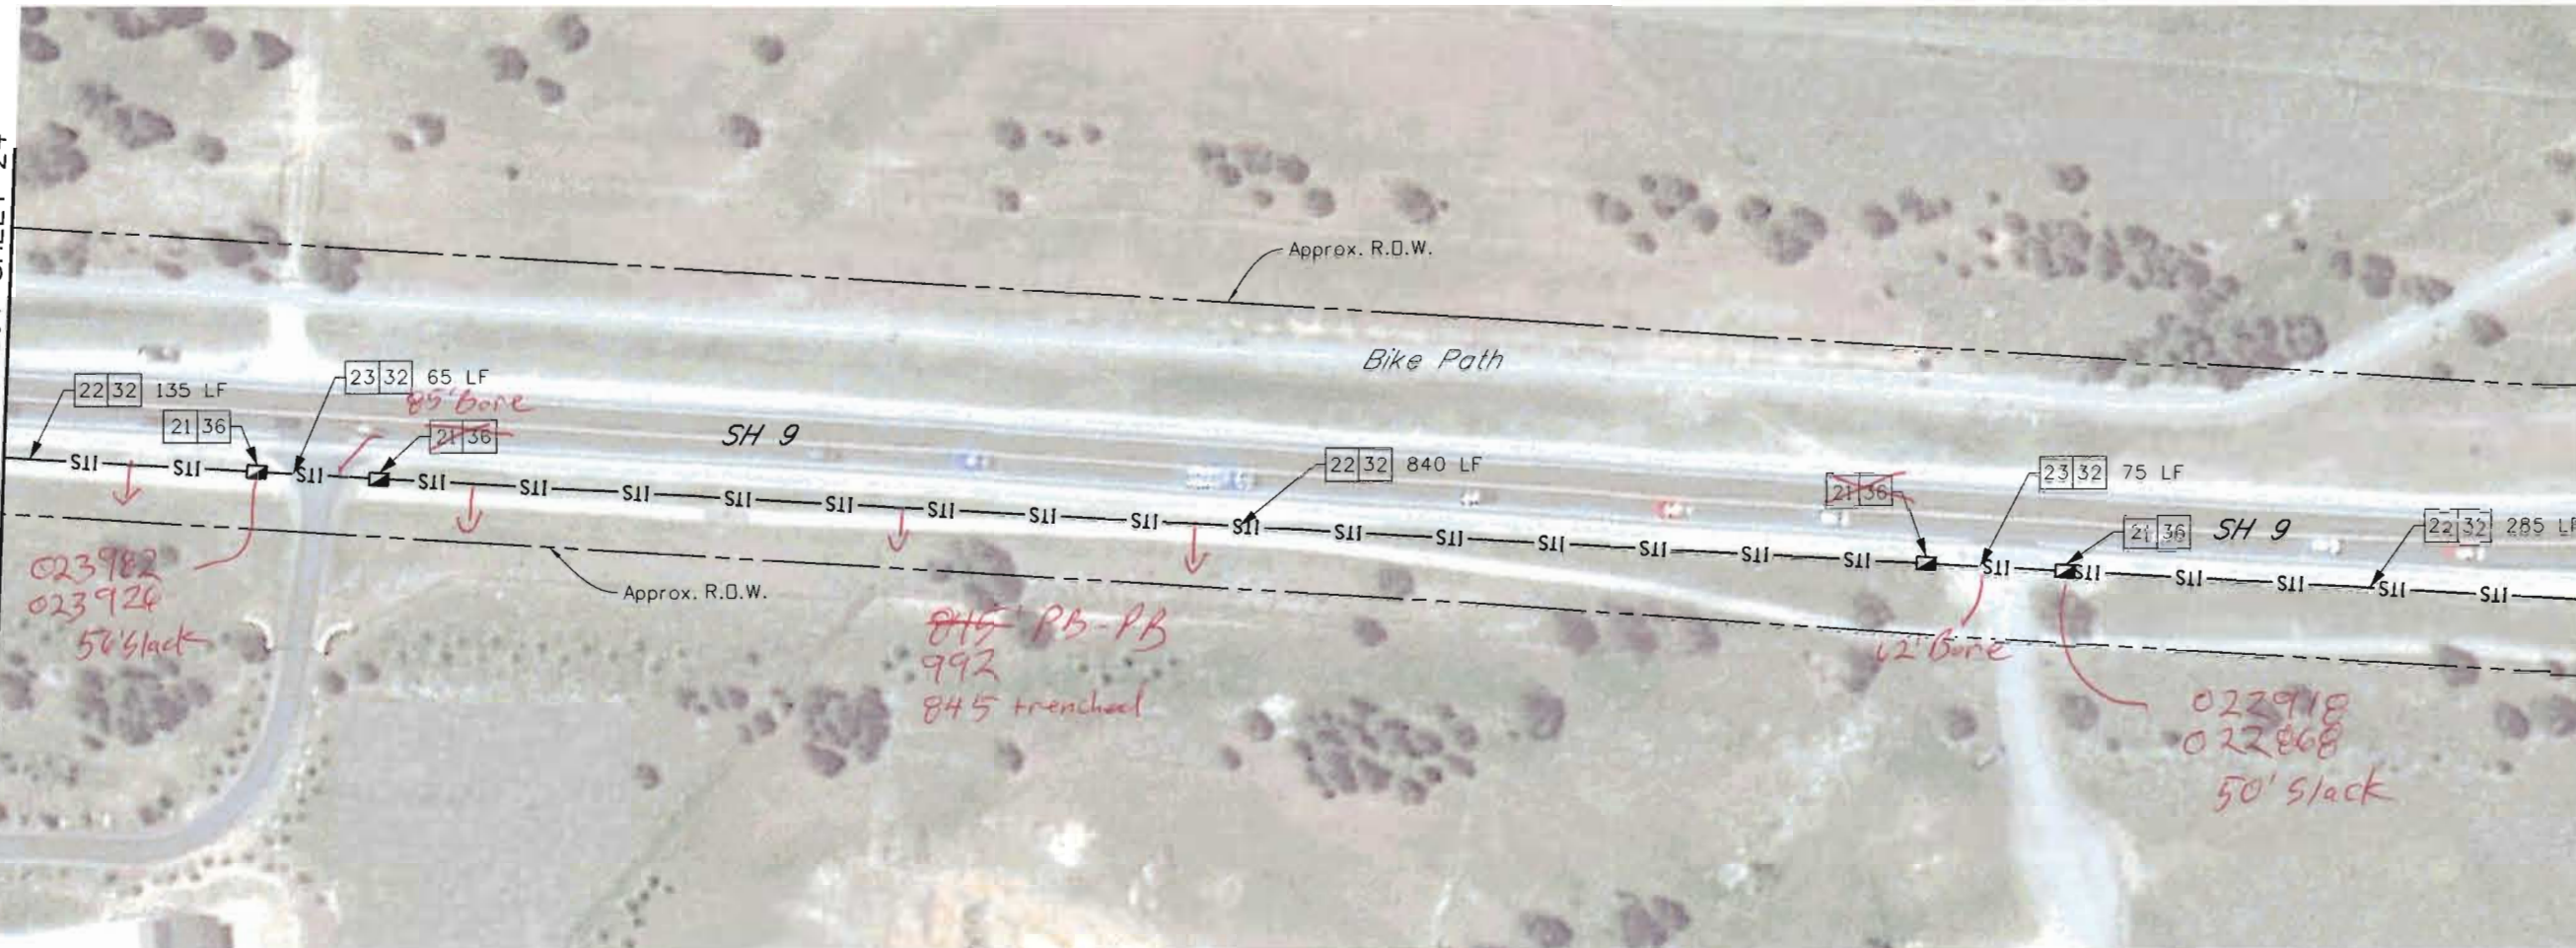

MATCH LINE - SEE INTERCONNECT SHEET 26


- [21] PULL BOX (24" X 36" X 24")
- [22] 2-2 INCH ELECTRICAL CONDUIT (MULTIDUCT) (PLASTIC)
- [23] 2-2 INCH ELECTRICAL CONDUIT (MULTIDUCT) (BORED)
- [32] FIBER OPTIC CABLE (SINGLE MODE) (96 STRANDS) (BACKBONE)
- [36] COIL 50 LINEAR FEET OF EACH FIBER OPTIC BACKBONE CABLE IN PULL BOX FOR SLACK

SWMP NOTES:

1. ECS SHALL PLACE BMPs IN THE FIELD AS DIRECTED BY THE SWMP NARRATIVES AND AS REQUIRED BY CDOT SPECIFICATIONS AND THE CDPS-SCP TO ENSURE ALL POTENTIAL POLLUTANTS FROM CONSTRUCTION WILL NOT ENTER STATE WATERS. ECS SHALL SHOW AND UPDATE BMPs ON PLAN SHEETS, SIGN AND DATE WHEN INSTALLED.
2. CONSTRUCTION BOUNDARY IS EXISTING ROW
3. SEE SWMP TYPICAL SECTIONS FOR LIMITS OF DISTURBANCE



Know what's below.
Call before you dig.

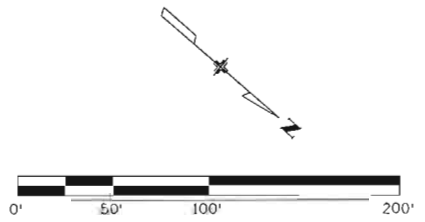

5/22/2012 3:04:57 PM P:\10-028.13 Region 1 Umbrello 2011 CDOT\102 - SH 9 Signal Interconnect\18777\Traffic_ITS\Drawings\18777TRAF_Plan25.dgn

Print Date: 5/22/2012
Drawing File Name: 18777TRAF_Plan25.dgn
Horiz. Scale: 1:100
Unit Information

Vert. Scale: As Noted
Unit Leader Initials

MULLER
Muller Engineering Co., Inc.
Consulting Engineers
Pj10-028.13 - SH 9 Interconnect\Traffic_ITS

apexdesign

Sheet Revisions		
Date:	Comments	Init.


Region 1

18500 East Colfax Avenue
Aurora, CO 80011
Phone: 303-757-9648 FAX: 303-757-9746
SS

As Constructed		TRAFFIC SIGNAL INTERCONNECT				Project No./Code	
No Revisions:						MTCE 0091-039	
Revised:		Designer:	KEB	Structure		18777	
Void:		Detailer:	PJS	Numbers		Sheet Number 35	
		Sheet Subset:	ITS	Subset Sheets:	25 of 46		

5/22/2012 3:05:12 PM P:\10-028.13 Region 1 Umbrella 2011 CDDT\102 - SH 9 SignalInterconnect\18777\Traffic_ITS\Drawings\18777TRAF_Plan26.dgn

MATCH LINE - SEE INTERCONNECT SHEET 25

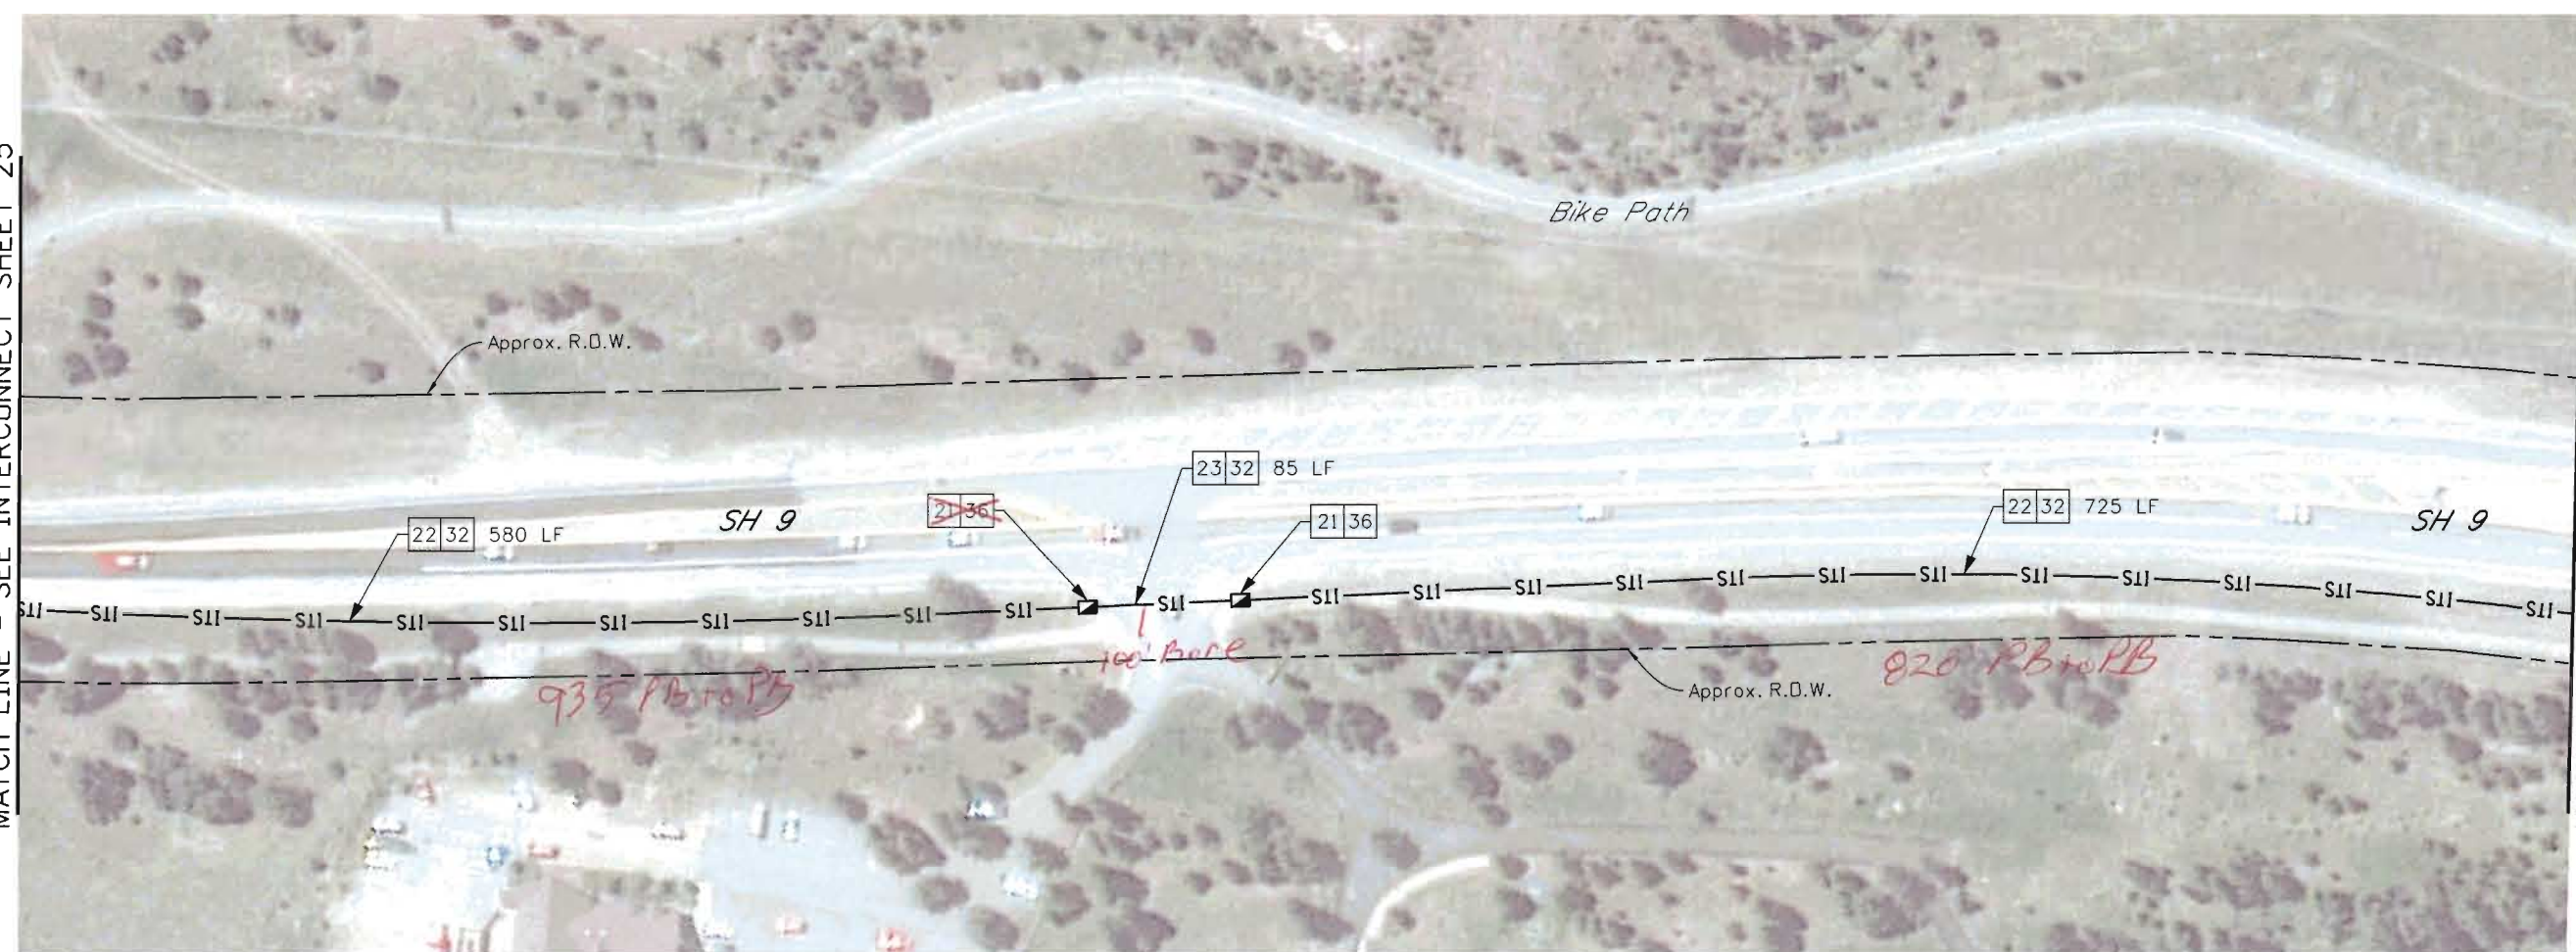

MATCH LINE - SEE INTERCONNECT SHEET 27


- 21 PULL BOX (24" X 36" X 24")
- 22 2-2 INCH ELECTRICAL CONDUIT (MULTIDUCT) (PLASTIC)
- 23 2-2 INCH ELECTRICAL CONDUIT (MULTIDUCT) (BORED)
- 32 FIBER OPTIC CABLE (SINGLE MODE) (96 STRANDS) (BACKBONE)
- 36 COIL 50 LINEAR FEET OF EACH FIBER OPTIC BACKBONE CABLE IN PULL BOX FOR SLACK

SWMP NOTES:

- ECS SHALL PLACE BMPs IN THE FIELD AS DIRECTED BY THE SWMP NARRATIVES AND AS REQUIRED BY CDOT SPECIFICATIONS AND THE CDPS-SCP TO ENSURE ALL POTENTIAL POLLUTANTS FROM CONSTRUCTION WILL NOT ENTER STATE WATERS. ECS SHALL SHOW AND UPDATE BMPs ON PLAN SHEETS, SIGN AND DATE WHEN INSTALLED.
- CONSTRUCTION BOUNDARY IS EXISTING ROW
- SEE SWMP TYPICAL SECTIONS FOR LIMITS OF DISTURBANCE



Know what's below.
Call before you dig.

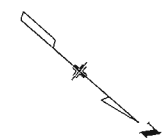

Print Date: 5/22/2012

Drawing File Name:18777TRAF_Plan26.dgn

Horiz. Scale: 1:100

Unit Information

MULLER

Muller Engineering Co., Inc.
Consulting Engineers
P:10-028.13 - SH 9 Interconnect\Traffic_ITS

apexdesign

Sheet Revisions

Date:	Comments	Init.

Colorado Department of Transportation

DOT

DEPARTMENT OF TRANSPORTATION

18500 East Colfax Avenue
Aurora, CO 80011
Phone: 303-757-9648 FAX: 303-757-9746

Region 1

SS

As Constructed

No Revisions:

Revised:

Void:

TRAFFIC SIGNAL INTERCONNECT

Designer: KEB

Detailer: PJS

Sheet Subset: ITS

Structure

Numbers

Subset Sheets: 26 of 46

Project No./Code

MTCE 0091-039

18777


Sheet Number 36

5/22/2012 3:05:21 PM P:\10-028.13 Region 1 Umbrella 2011 CDOT\102 - SH 9 SignalInterconnect\18777\Traffic_ITS\Drawings\18777TRAF_Plan27.dgn




- 21 PULL BOX (24" X 36" X 24")
- 22 2-2 INCH ELECTRICAL CONDUIT (MULTIDUCT) (PLASTIC)
- 23 2-2 INCH ELECTRICAL CONDUIT (MULTIDUCT) (BORED)
- 32 FIBER OPTIC CABLE (SINGLE MODE) (96 STRANDS) (BACKBONE)
- 36 COIL 50 LINEAR FEET OF EACH FIBER OPTIC BACKBONE CABLE IN PULL BOX FOR SLACK

- SWMP NOTES:
- ECS SHALL PLACE BMPs IN THE FIELD AS DIRECTED BY THE SWMP NARRATIVES AND AS REQUIRED BY CDOT SPECIFICATIONS AND THE CDPS-SCP TO ENSURE ALL POTENTIAL POLLUTANTS FROM CONSTRUCTION WILL NOT ENTER STATE WATERS. ECS SHALL SHOW AND UPDATE BMPs ON PLAN SHEETS, SIGN AND DATE WHEN INSTALLED.
 - CONSTRUCTION BOUNDARY IS EXISTING ROW
 - SEE SWMP TYPICAL SECTIONS FOR LIMITS OF DISTURBANCE

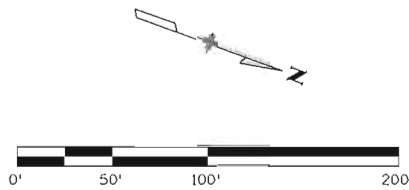

Print Date: 5/22/2012		Sheet Revisions			Colorado Department of Transportation		As Constructed		TRAFFIC SIGNAL INTERCONNECT			Project No./Code	
Drawing File Name: 18777TRAF_Plan27.dgn													
Horiz. Scale: 1:100		000											

5/22/2012 3:05:39 PM P:\10-028.13 Region 1 Umbrella 2011 CDOT\102 - SH 9 SignalInterconnect\18777\Traffic_ITS\Drawings\18777TRAF_Plan29.dgn

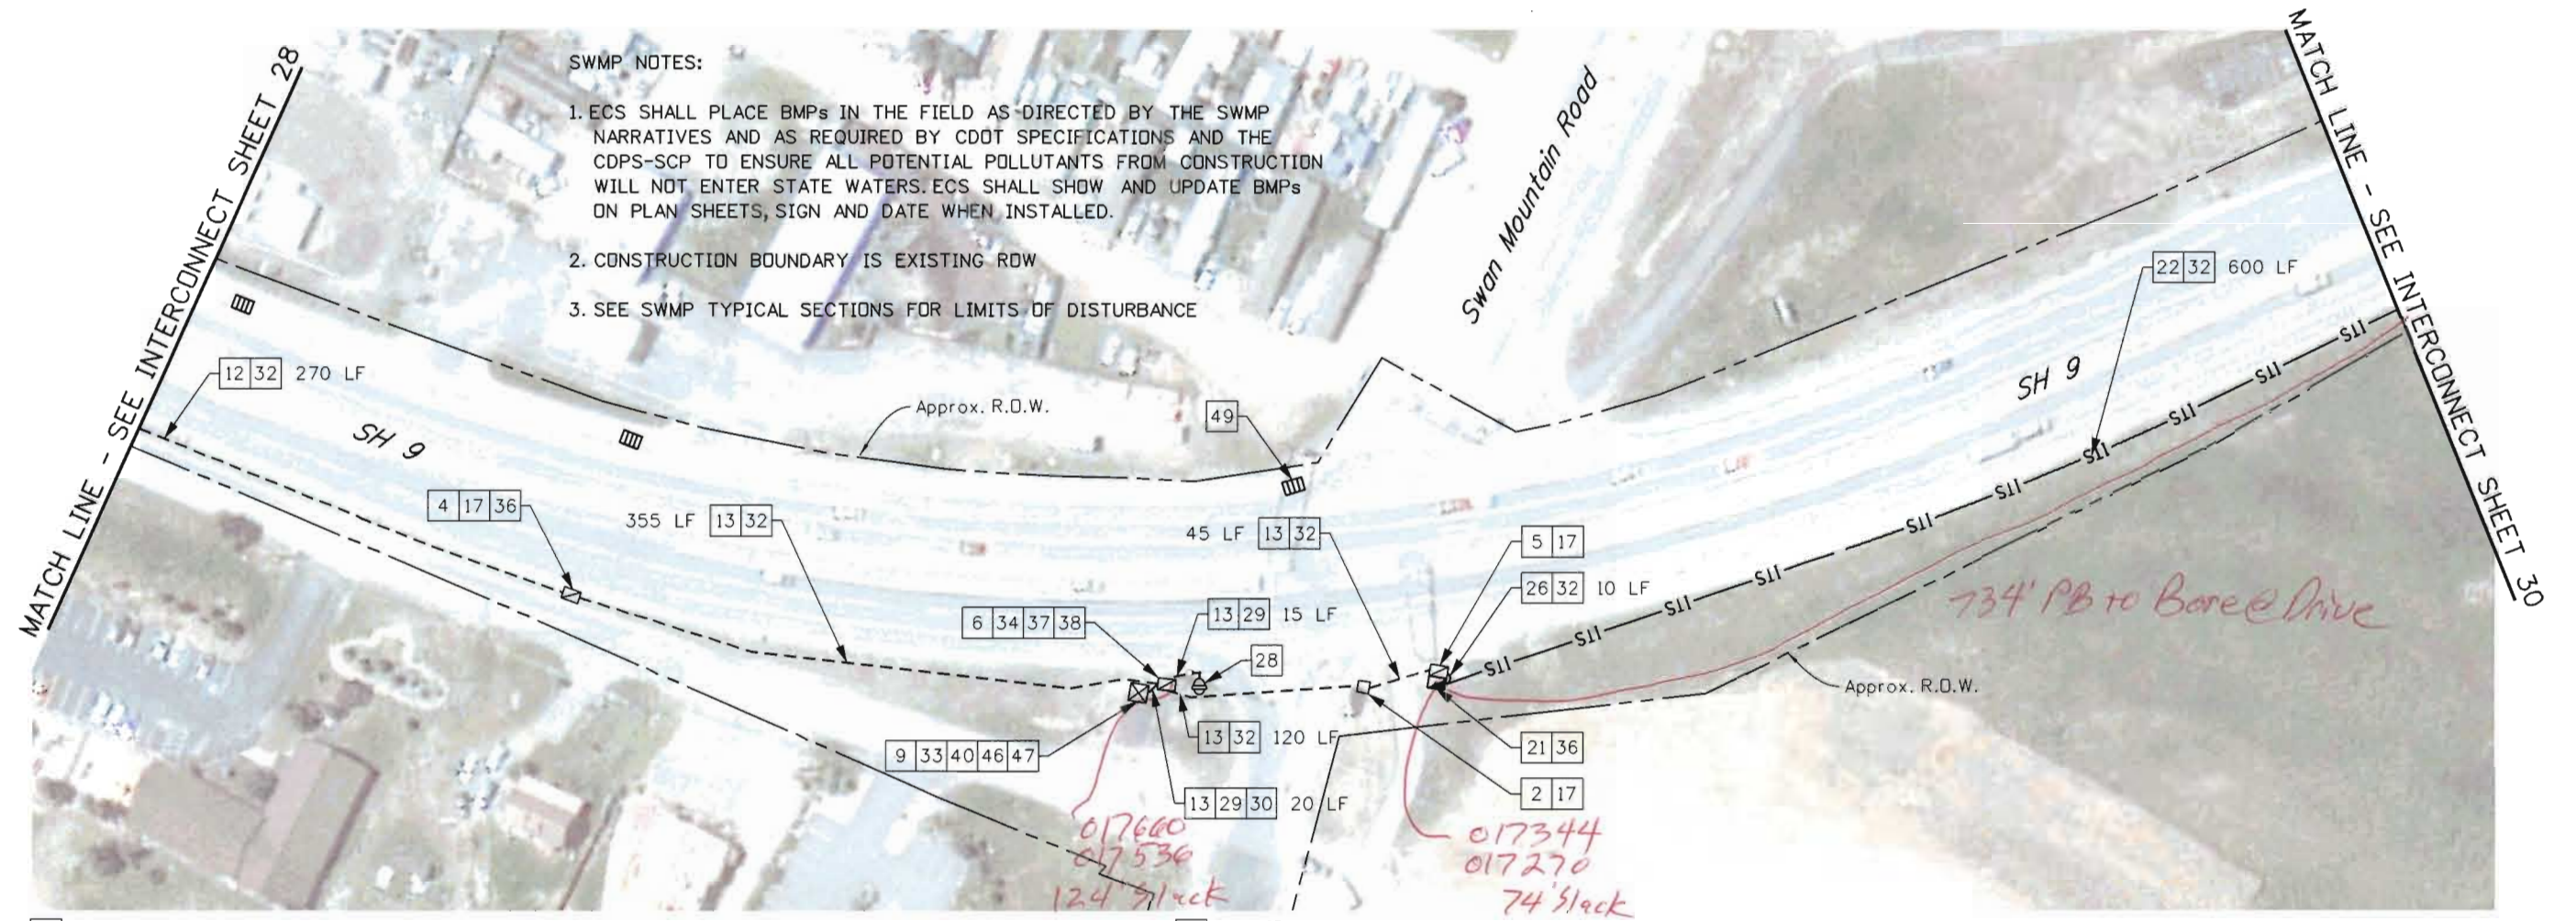

SWMP NOTES:



1. ECS SHALL PLACE BMPs IN THE FIELD AS DIRECTED BY THE SWMP NARRATIVES AND AS REQUIRED BY CDOT SPECIFICATIONS AND THE CDPS-SCP TO ENSURE ALL POTENTIAL POLLUTANTS FROM CONSTRUCTION WILL NOT ENTER STATE WATERS. ECS SHALL SHOW AND UPDATE BMPs ON PLAN SHEETS, SIGN AND DATE WHEN INSTALLED.
2. CONSTRUCTION BOUNDARY IS EXISTING ROW
3. SEE SWMP TYPICAL SECTIONS FOR LIMITS OF DISTURBANCE

- 2 EXISTING PULL BOX (12" X 18")
- 4 EXISTING PULL BOX (13" X 24")
- 5 EXISTING PULL BOX (17" X 30")
- 6 EXISTING PULL BOX (24" X 36")
- 9 EXISTING TRAFFIC SIGNAL CONTROLLER CABINET
- 12 EXISTING 3" ELECTRICAL CONDUIT
- 13 EXISTING ELECTRICAL CONDUIT
- 17 PROTECT IN PLACE
- 21 PULL BOX (24" X 36" X 24")
- 22 2-2 INCH ELECTRICAL CONDUIT (MULTIDUCT) (PLASTIC)
- 26 INSTALL 2-2 INCH ELECTRICAL CONDUITS BETWEEN ADJACENT PULL BOXES
- 28 CLOSED CIRCUIT TELEVISION CAMERA (TRAFFIC SURVEILLANCE)

- 29 CLOSED CIRCUIT TELEVISION CABLE
- 30 FIBER OPTIC CABLE (SINGLE MODE) (12 STRANDS) (LATERAL)
- 32 FIBER OPTIC CABLE (SINGLE MODE) (96 STRANDS) (BACKBONE)
- 33 COIL 10 LINEAR FEET OF EACH FIBER OPTIC LATERAL CABLE IN CABINET FOR SLACK
- 34 COIL 25 LINEAR FEET OF EACH FIBER OPTIC LATERAL CABLE IN PULL BOX FOR SLACK
- 36 COIL 50 LINEAR FEET OF EACH FIBER OPTIC BACKBONE CABLE IN PULL BOX FOR SLACK
- 37 COIL 100 LINEAR FEET OF EACH FIBER OPTIC BACKBONE CABLE IN PULL BOX FOR SLACK
- 38 FIBER OPTIC SPLICE CLOSURE. FUSION SPLICE FIBERS PER SPLICING DETAIL SHEETS.
- 40 FIBER OPTIC TERMINATION PANEL - 12 FIBER
- 46 ETHERNET SWITCH
- 47 SERIAL TO IP CONVERTER
- 49 STORM DRAIN INLET PROTECTION




Know what's below.
Call before you dig.

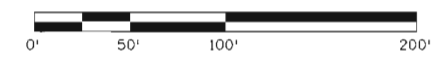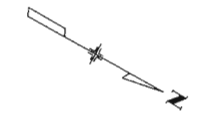

Print Date: 5/22/2012	
Drawing File Name: 18777TRAF_Plan29.dgn	
Horiz. Scale: 1:100	Vert. Scale: As Noted
Unit Information	Unit Leader Initials
MULLER Muller Engineering Co., Inc. Consulting Engineers	apexdesign
P:10-028.13 - SH 9 Interconnect\Traffic_ITS	

Sheet Revisions		
Date:	Comments	Init.

Colorado Department of Transportation



18500 East Colfax Avenue
Aurora, CO 80011
Phone: 303-757-9648 FAX: 303-757-9746


Region 1

SS

As Constructed
No Revisions:
Revised:
Void:

TRAFFIC SIGNAL INTERCONNECT			
Designer:	KEB	Structure	
Detailer:	PJS	Numbers	
Sheet Subset:	ITS	Subset Sheets:	29 of 46


Project No./Code	
MTCE 0091-039	
18777	
Sheet Number	39

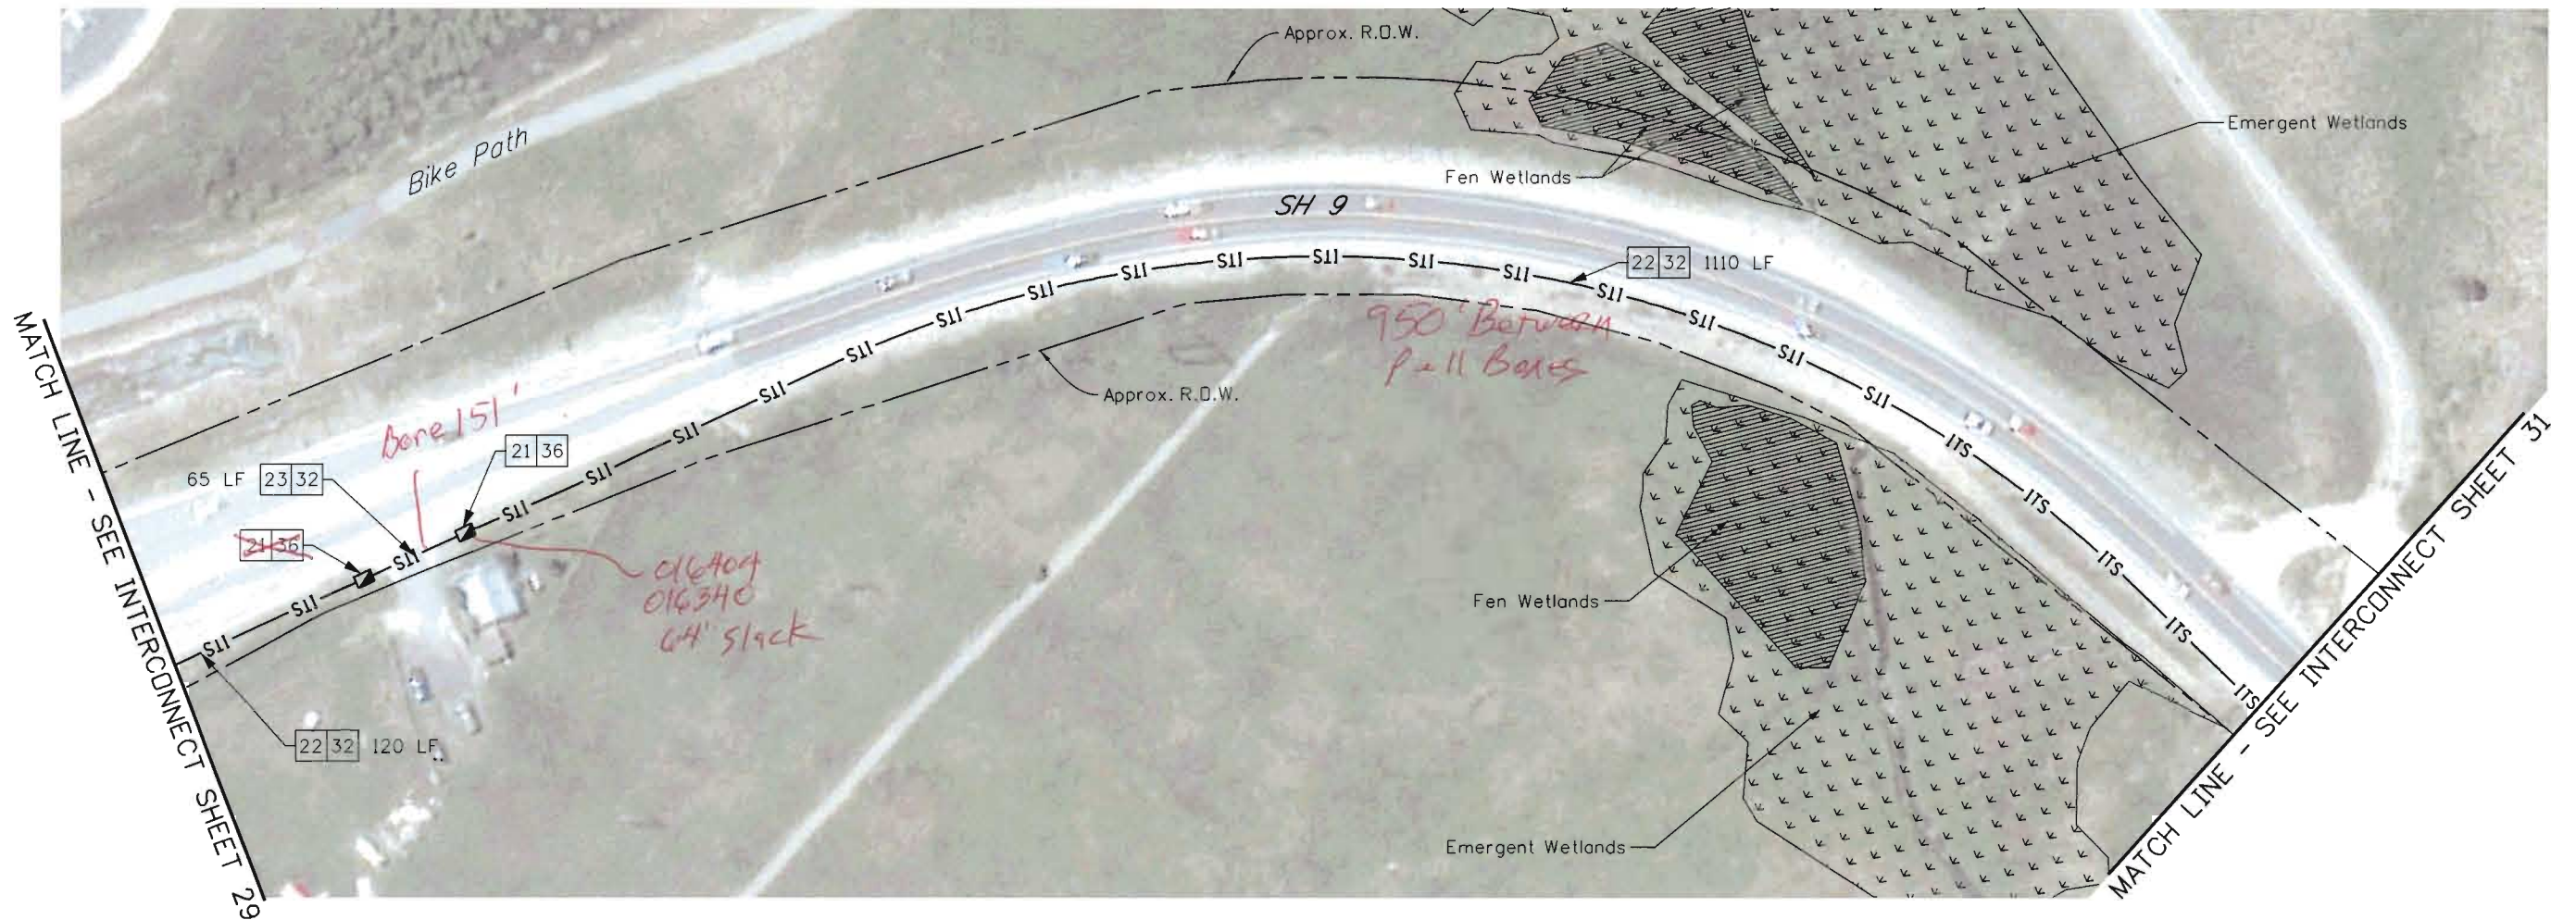


- 21 PULL BOX (24" X 36" X 24")
- 22 2-2 INCH ELECTRICAL CONDUIT (MULTIDUCT) (PLASTIC)
- 23 2-2 INCH ELECTRICAL CONDUIT (MULTIDUCT) (BORED)
- 32 FIBER OPTIC CABLE (SINGLE MODE) (96 STRANDS) (BACKBONE)
- 36 COIL 50 LINEAR FEET OF EACH FIBER OPTIC BACKBONE CABLE IN PULL BOX FOR SLACK

SWMP NOTES:

- ECS SHALL PLACE BMPs IN THE FIELD AS DIRECTED BY THE SWMP NARRATIVES AND AS REQUIRED BY CDOT SPECIFICATIONS AND THE CDPS-SCP TO ENSURE ALL POTENTIAL POLLUTANTS FROM CONSTRUCTION WILL NOT ENTER STATE WATERS. ECS SHALL SHOW AND UPDATE BMPs ON PLAN SHEETS, SIGN AND DATE WHEN INSTALLED.
- CONSTRUCTION BOUNDARY IS EXISTING ROW
- SEE SWMP TYPICAL SECTIONS FOR LIMITS OF DISTURBANCE

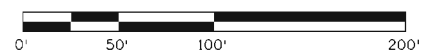


5/22/2012 3:05:52 PM P:\10-028.13 Region 1 Umbrella 2011 CDOT\102 - SH 9 SignalInterconnect\18777\Traffic_ITS\Drawings\18777TRAF_Plan30.dgn

Print Date: 5/22/2012		<div>0000</div>	Sheet Revisions			Colorado Department of Transportation  Region 1 SS	As Constructed		TRAFFIC SIGNAL INTERCONNECT				Project No./Code	
Drawing File Name:18777TRAF_Plan30.dgn			Date:	Comments	Init.		No Revisions:		MTCE 0091-039					
Horiz. Scale: 1:100 Vert. Scale: As Noted							Revised:		Designer:	KEB	Structure		18777	
Unit Information Unit Leader Initials							Detailer:		PJS	Numbers				
<div><div>MULLER</div><div>Muller Engineering Co., Inc. Consulting Engineers P:10-028.13 ~ SH 9 Interconnect\Traffic_ITS</div></div> <div>apexdesign</div>							Void:		Sheet Subset:	ITS	Subset Sheets:	30 of 46	Sheet Number 40	

5/22/2012 3:06:00 PM P:\10-028.13 - Region 1 Umbrello 2011 CDDT\102 - SH 9 SignalInterconnect\18777\Traffic_ITS\Drawings\18777TRAF_Plan31.dgn

MATCH LINE - SEE INTERCONNECT SHEET 30

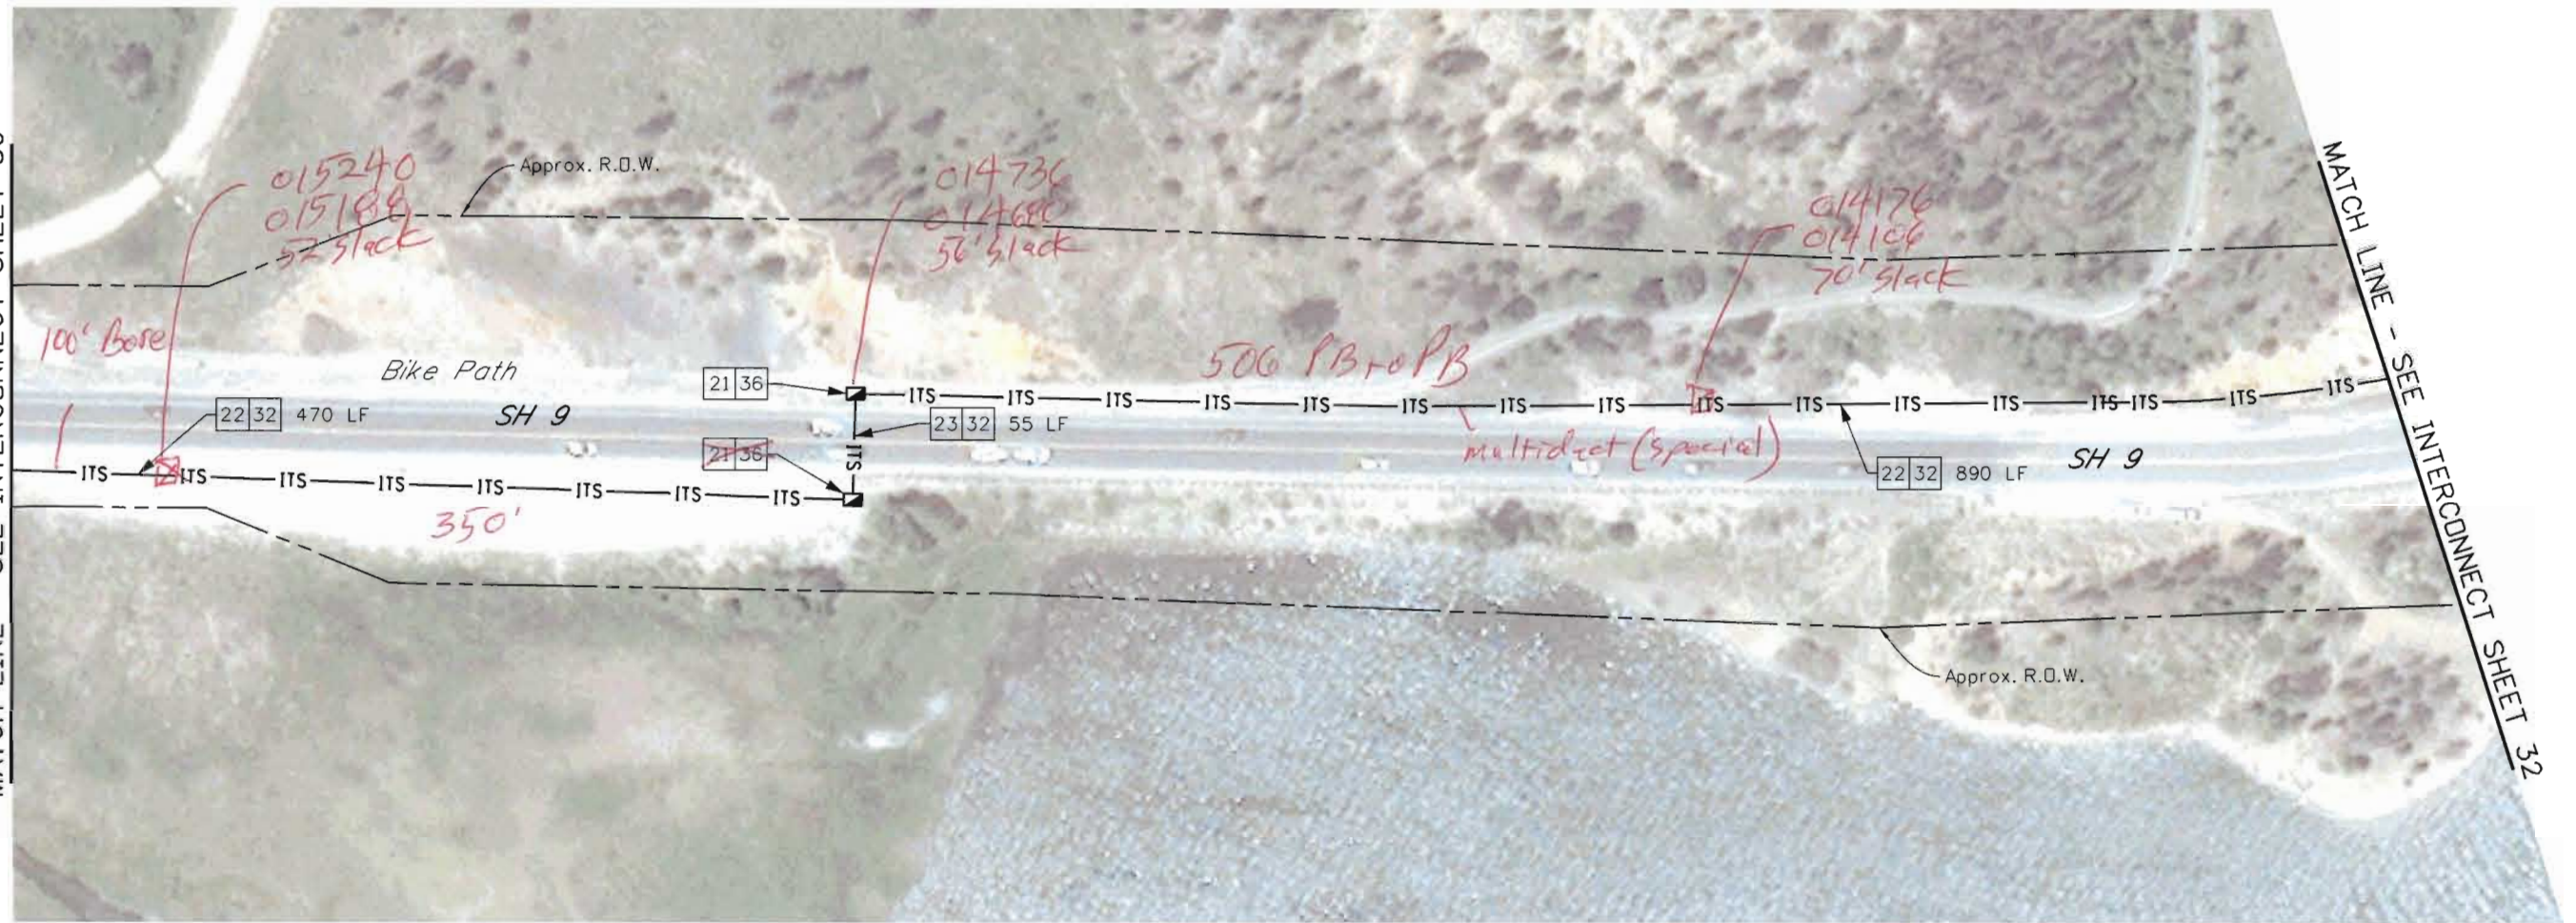

- [21] PULL BOX (24" X 36" X 24")
- [22] 2-2 INCH ELECTRICAL CONDUIT (MULTIDUCT) (PLASTIC)
- [23] 2-2 INCH ELECTRICAL CONDUIT (MULTIDUCT) (BORED)
- [32] FIBER OPTIC CABLE (SINGLE MODE) (96 STRANDS) (BACKBONE)
- [36] COIL 50 LINEAR FEET OF EACH FIBER OPTIC BACKBONE CABLE IN PULL BOX FOR SLACK

SWMP NOTES:

1. ECS SHALL PLACE BMPs IN THE FIELD AS DIRECTED BY THE SWMP NARRATIVES AND AS REQUIRED BY CDOT SPECIFICATIONS AND THE CDPS-SCP TO ENSURE ALL POTENTIAL POLLUTANTS FROM CONSTRUCTION WILL NOT ENTER STATE WATERS. ECS SHALL SHOW AND UPDATE BMPs ON PLAN SHEETS, SIGN AND DATE WHEN INSTALLED.
2. CONSTRUCTION BOUNDARY IS EXISTING ROW
3. SEE SWMP TYPICAL SECTIONS FOR LIMITS OF DISTURBANCE




Know what's below.
Call before you dig.



Print Date: 5/22/2012	
Drawing File Name: 18777TRAF_Plan31.dgn	
Horiz. Scale: 1:100	Vert. Scale: As Noted
Unit Information	Unit Leader Initials
MULLER Muller Engineering Co., Inc. Consulting Engineers	apexdesign
P:\10-028.13 - SH 9 Interconnect\Traffic_ITS	

Sheet Revisions		
Date:	Comments	Init.

Colorado Department of Transportation	
	18500 East Colfax Avenue Aurora, CO 80011 Phone: 303-757-9648 FAX: 303-757-9746
Region 1	SS


As Constructed		TRAFFIC SIGNAL INTERCONNECT		Project No./Code
No Revisions:				MTCE 0091-039
Revised:		Designer: KEB	Structure Numbers	18777
Void:		Detailer: PJS		
		Sheet Subset: ITS	Subset Sheets: 31 of 46	Sheet Number 41



- [21] PULL BOX (24" X 36" X 24")
- [32] FIBER OPTIC CABLE (SINGLE MODE) (96 STRANDS) (BACKBONE)
- [36] COIL 50 LINEAR FEET OF EACH FIBER OPTIC BACKBONE CABLE IN PULL BOX FOR SLACK
- [56] CONDUIT TO BE INSTALLED PER THE SHALLOW TRENCH DETAIL IF SUBSURFACE CONDITIONS WARRANT
- [60] 2 - 2 INCH ELECTRICAL CONDUIT (PLASTIC) (MULTIDUCT) (SPECIAL)


SWMP NOTES:

1. ECS SHALL PLACE BMPs IN THE FIELD AS DIRECTED BY THE SWMP NARRATIVES AND AS REQUIRED BY CDOT SPECIFICATIONS AND THE CDPS-SCP TO ENSURE ALL POTENTIAL POLLUTANTS FROM CONSTRUCTION WILL NOT ENTER STATE WATERS. ECS SHALL SHOW AND UPDATE BMPs ON PLAN SHEETS, SIGN AND DATE WHEN INSTALLED.
2. CONSTRUCTION BOUNDARY IS EXISTING ROW
3. SEE SWMP TYPICAL SECTIONS FOR LIMITS OF DISTURBANCE

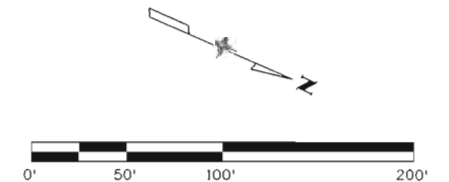

5/22/2012 3:06:11 PM
P:\10-028.13 Region 1 Umbrello 2011 CDOT\102 - SH 9 SignalInterconnect\18777\Traffic\ITS\Drawings\18777TRAF_Plan32.dgn

Print Date: 5/22/2012		Sheet Revisions			Colorado Department of Transportation		As Constructed		TRAFFIC SIGNAL INTERCONNECT			Project No./Code			
Drawing File Name: 18777TRAF_Plan32.dgn															
Horiz. Scale: 1:100		Vert. Scale: As Noted		<div><div></div><div>DOT</div><div>DEPARTMENT OF TRANSPORTATION</div></div> <div>18500 East Colfax Avenue Aurora, CO 80011 Phone: 303-757-9648 FAX: 303-757-9746</div> <div>Region 1SS</div>		No Revisions:		MTCE 0091-039							
Unit Information		Unit Leader Initials													
<div><div>MULLER</div><div>Muller Engineering Co., Inc. Consulting Engineers P:\10-028.13 - SH 9 Interconnect\Traffic_ITS</div></div> <div>apexdesign</div>															
		Date:		Comments		Init.		Revised:		Designer: KEB		Structure Numbers		18777	
								Void:		Detailer: PJS					
										Sheet Subset: ITS		Subset Sheets: 32 of 46		Sheet Number 42	

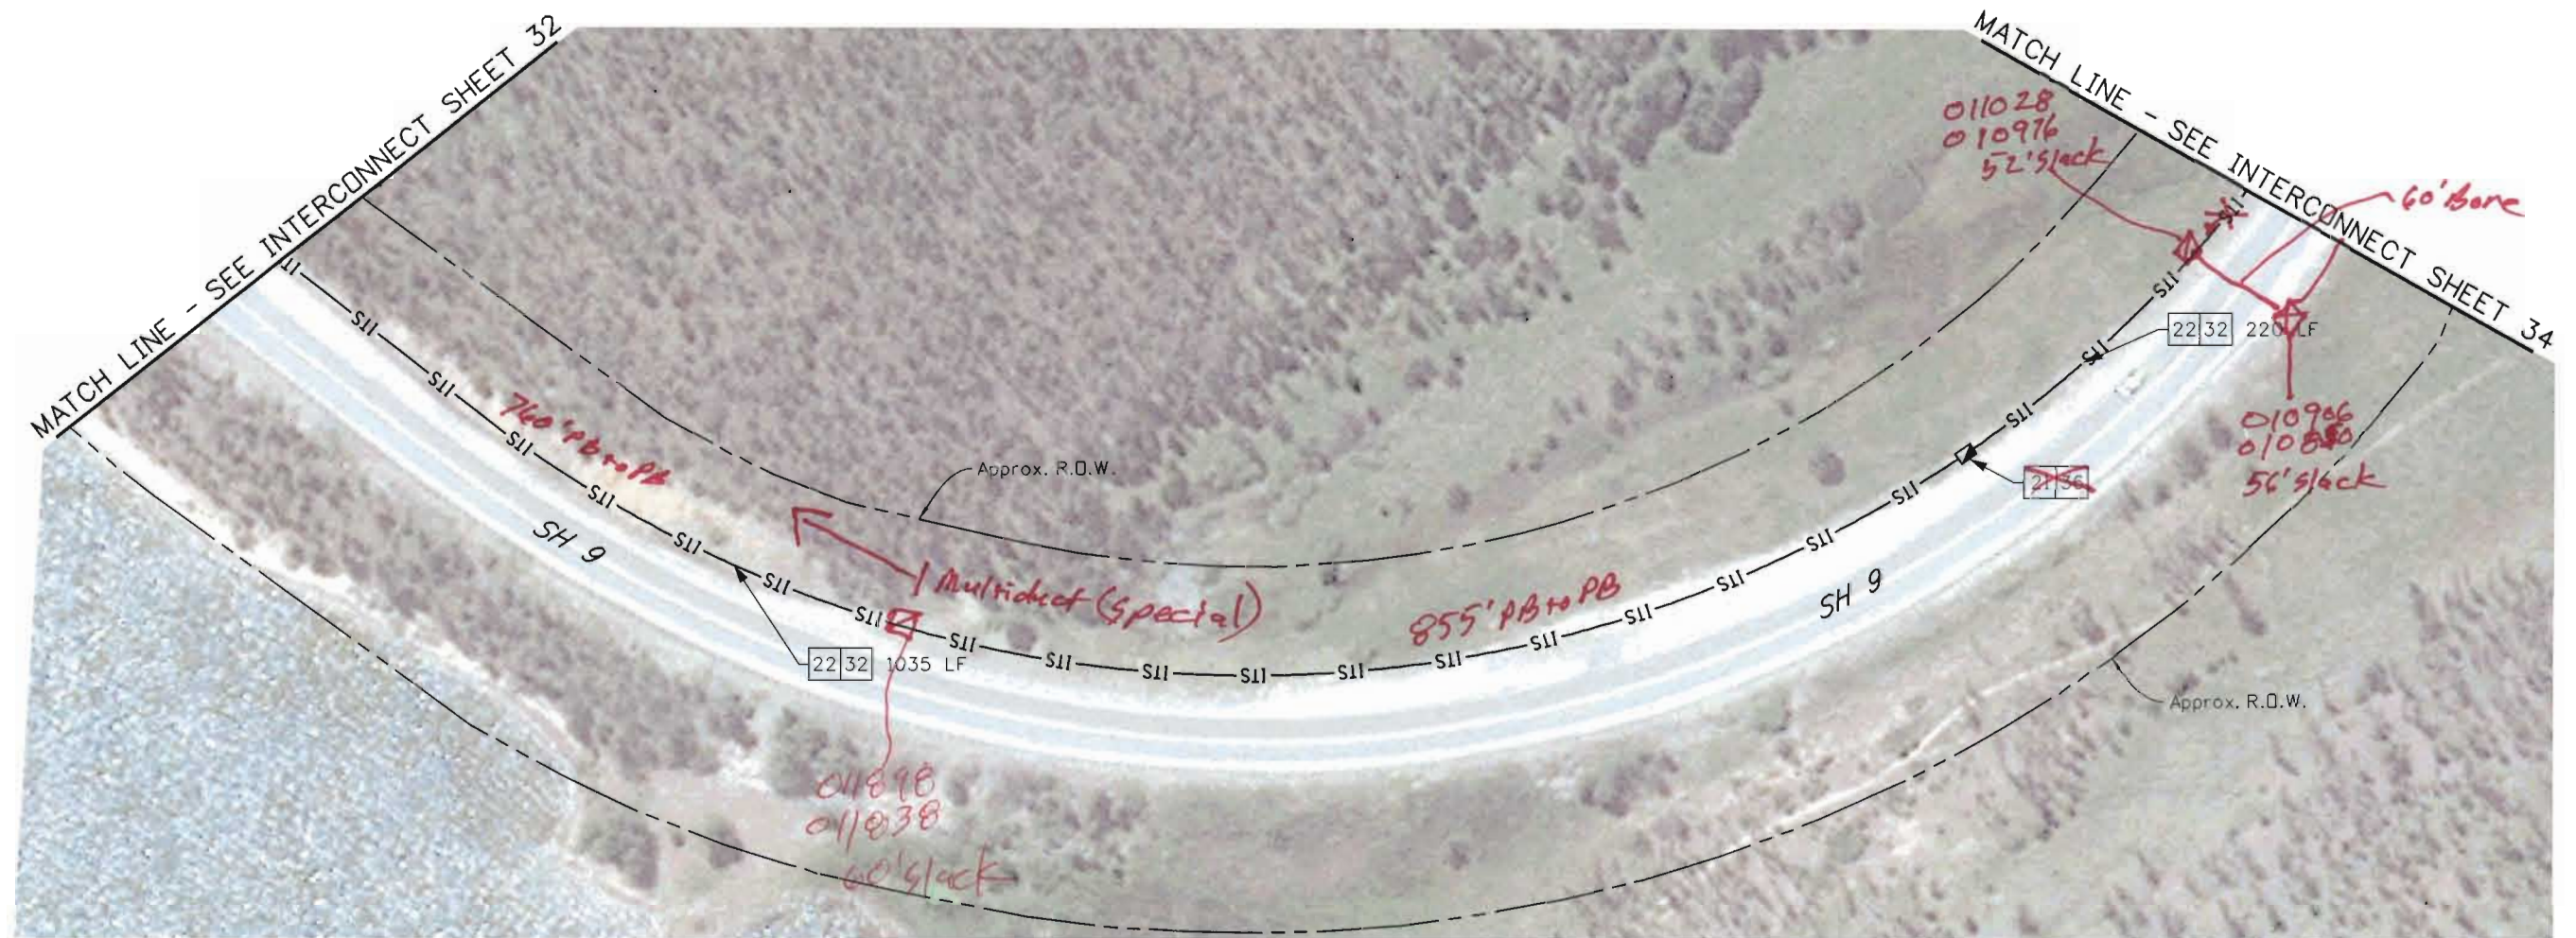


- | | |
|----|--|
| 21 | PULL BOX (24" X 36" X 24") |
| 22 | 2-2 INCH ELECTRICAL CONDUIT (MULTIDUCT) (PLASTIC) |
| 32 | FIBER OPTIC CABLE (SINGLE MODE) (96 STRANDS) (BACKBONE) |
| 36 | COIL 50 LINEAR FEET OF EACH FIBER OPTIC BACKBONE CABLE IN PULL BOX FOR SLACK |

SWMP NOTES:

1. ECS SHALL PLACE BMPs IN THE FIELD AS DIRECTED BY THE SWMP NARRATIVES AND AS REQUIRED BY CDOT SPECIFICATIONS AND THE CDPS-SCP TO ENSURE ALL POTENTIAL POLLUTANTS FROM CONSTRUCTION WILL NOT ENTER STATE WATERS. ECS SHALL SHOW AND UPDATE BMPs ON PLAN SHEETS, SIGN AND DATE WHEN INSTALLED.
2. CONSTRUCTION BOUNDARY IS EXISTING ROW
3. SEE SWMP TYPICAL SECTIONS FOR LIMITS OF DISTURBANCE




**Know what's below.
Call before you dig.**

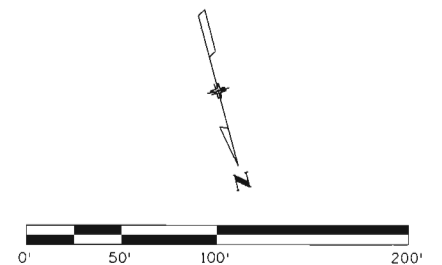

Print Date: 5/22/2012		<div style="display: flex; align-items: center;"><div style="writing-mode: vertical-rl; transform: rotate(180deg); font-weight: bold; margin-right: 10px;">00000</div><div><div style="border: 1px solid black; padding: 2px; margin-bottom: 5px;">Sheet Revisions</div><table style="width: 100%; border-collapse: collapse;"><tr><th style="width: 15%;">Date:</th><th style="width: 55%;">Comments</th><th style="width: 30%;">Init.</th></tr><tr><td> </td><td> </td><td> </td></tr><tr><td> </td><td> </td><td> </td></tr><tr><td> </td><td> </td><td> </td></tr><tr><td> </td><td> </td><td> </td></tr></table></div></div>		Date:	Comments	Init.													<div style="display: flex; align-items: center;"><div style="text-align: center; margin-right: 10px;"> Colorado Department of Transportation 18500 East Colfax Avenue Aurora, CO 80011 Phone: 303-757-9648 FAX: 303-757-9746 Region 1</div><div style="font-size: 2em; font-weight: bold; margin-left: 20px;">SS</div></div>		As Constructed		TRAFFIC SIGNAL INTERCONNECT		Project No./Code MTCE 0091-039	
Date:	Comments			Init.																						
No Revisions:																										
Drawing File Name: 18777TRAF_Plan33.dgn		Horiz. Scale: 1:100		Vert. Scale: As Noted		Unit Information		Unit Leader Initials																		
<div style="display: flex; align-items: center;"><div style="border: 1px solid black; padding: 2px; margin-right: 10px;">MULLER</div><div style="display: flex; flex-direction: column; align-items: flex-start;"><div>Muller Engineering Co., Inc.</div><div>Consulting Engineers</div><div>P:10-028.13 - SH 9 Interconnect\Traffic_ITS</div></div><div style="margin-left: 10px; font-weight: bold; font-size: 1.5em;">apexdesign</div></div>		Revised:		Designer: KEB		Structure		18777																		
		Void:		Detailer: PJS		Numbers																				
P:10-028.13 - SH 9 Interconnect\Traffic_ITS		Sheet Subset: ITS		Subset Sheets: 33 of 46		Sheet Number		43																		

5/22/2012 3:06:31 PM P:\10-028.13 Region 1 Umbrella 2011 CDOT\102 - SH 9 Signal Interconnect\18777\Traffic_ITS\Drawings\18777TRAF_Plan34.dgn

MATCH LINE - SEE INTERCONNECT SHEET 33

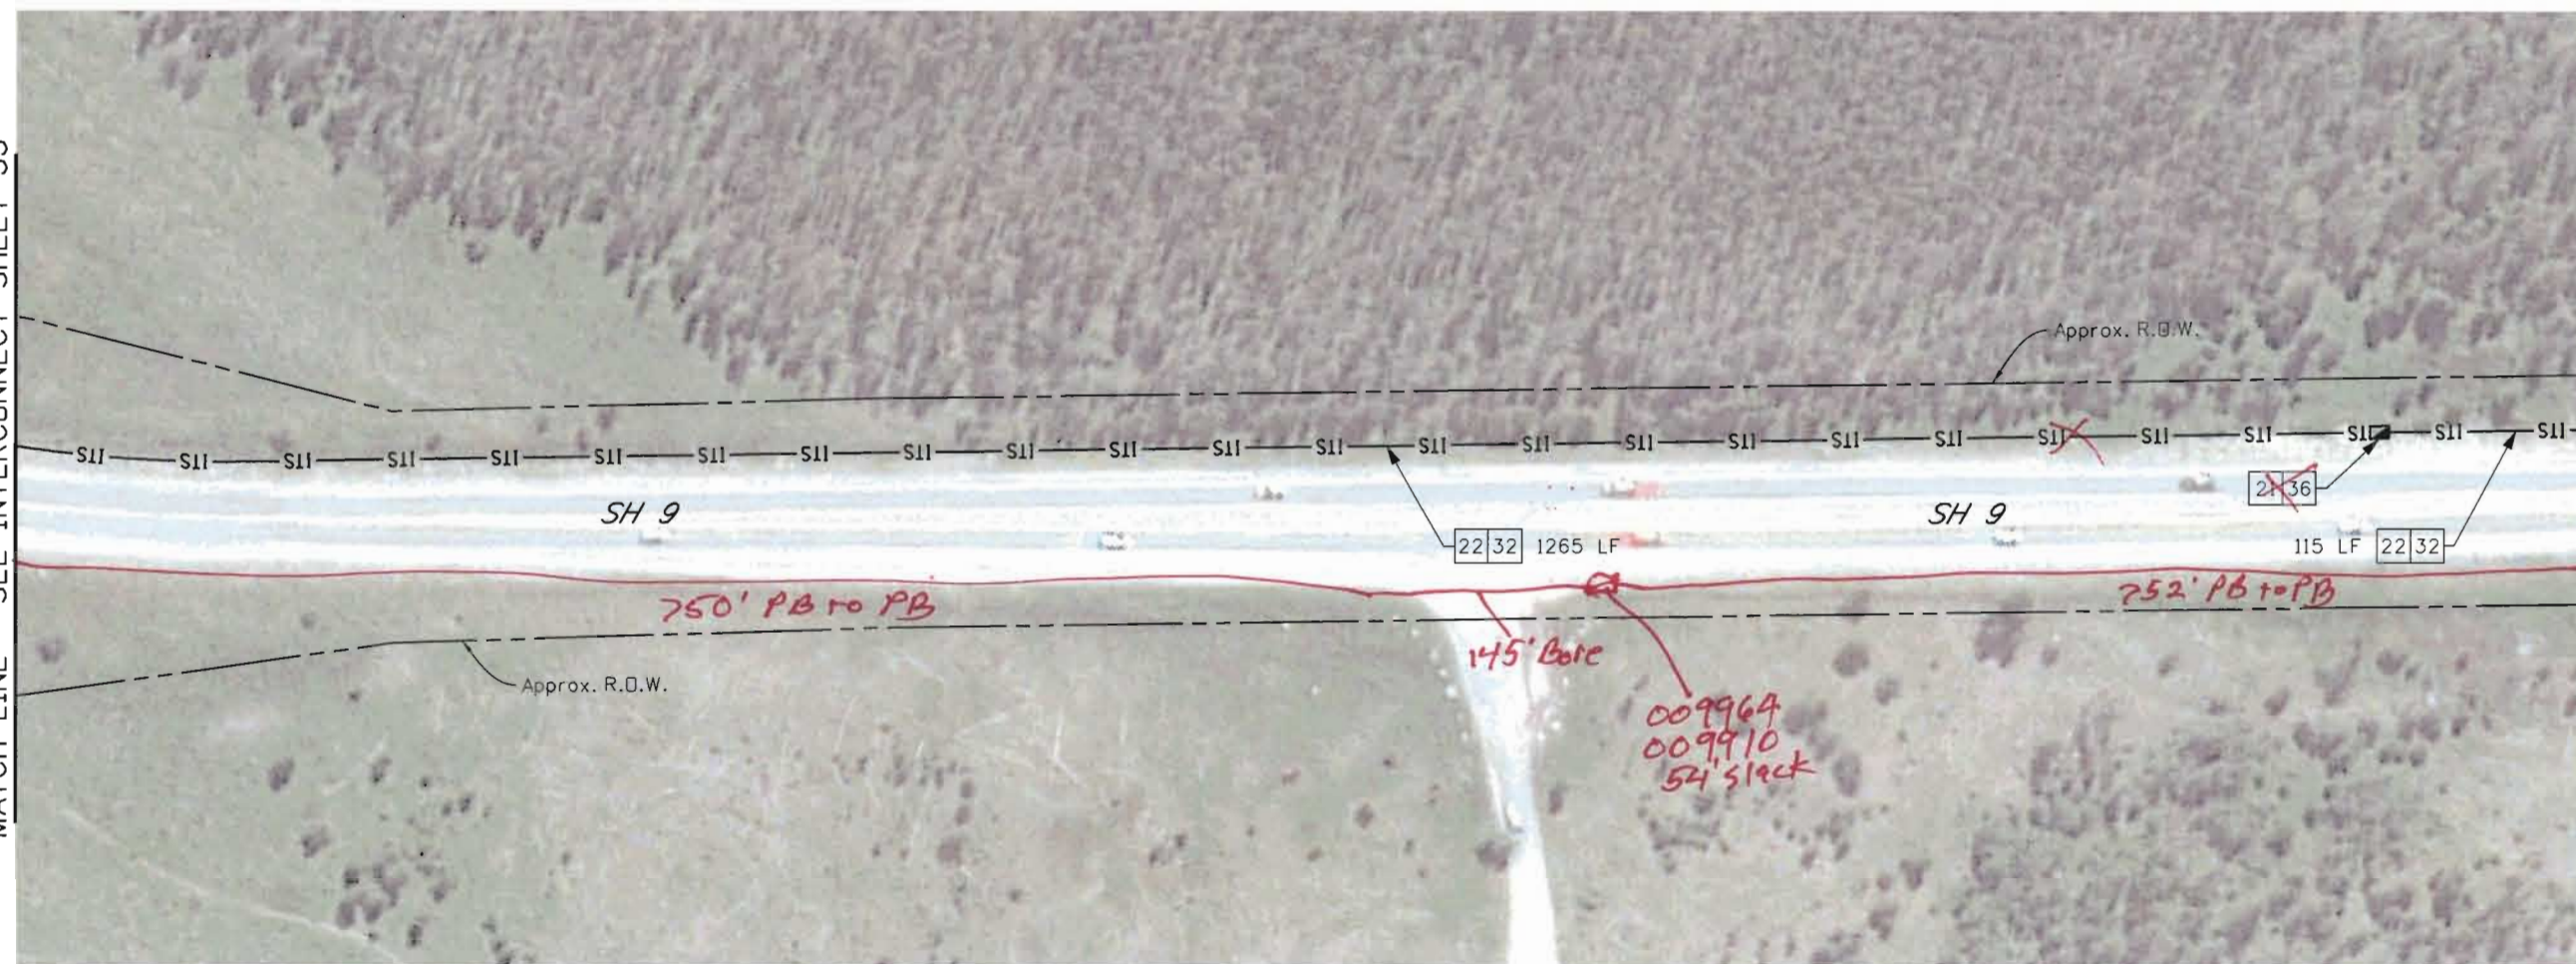

MATCH LINE - SEE INTERCONNECT SHEET 35


- 21 PULL BOX (24" X 36" X 24")
- 22 2-2 INCH ELECTRICAL CONDUIT (MULTIDUCT) (PLASTIC)
- 32 FIBER OPTIC CABLE (SINGLE MODE) (96 STRANDS) (BACKBONE)
- 36 COIL 50 LINEAR FEET OF EACH FIBER OPTIC BACKBONE CABLE IN PULL BOX FOR SLACK

SWMP NOTES:

1. ECS SHALL PLACE BMPs IN THE FIELD AS DIRECTED BY THE SWMP NARRATIVES AND AS REQUIRED BY CDOT SPECIFICATIONS AND THE CDPS-SCP TO ENSURE ALL POTENTIAL POLLUTANTS FROM CONSTRUCTION WILL NOT ENTER STATE WATERS. ECS SHALL SHOW AND UPDATE BMPs ON PLAN SHEETS, SIGN AND DATE WHEN INSTALLED.
2. CONSTRUCTION BOUNDARY IS EXISTING ROW
3. SEE SWMP TYPICAL SECTIONS FOR LIMITS OF DISTURBANCE



Know what's below.
Call before you dig.

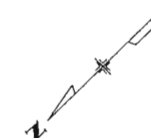

Print Date: 5/22/2012	
Drawing File Name: 18777TRAF_Plan34.dgn	
Horiz. Scale: 1:100	Vert. Scale: As Noted
Unit Information	Unit Leader Initials
MULLER Muller Engineering Co., Inc. Consulting Engineers	apexdesign
P:\10-028.13 - SH 9 Interconnect\Traffic_ITS	

Sheet Revisions		
Date:	Comments	Init.



Colorado Department of Transportation

18500 East Colfax Avenue
Aurora, CO 80011
Phone: 303-757-9648 FAX: 303-757-9746

Region 1 SS

As Constructed
No Revisions:
Revised:
Void:

TRAFFIC SIGNAL INTERCONNECT			
Designer:	KEB	Structure	
Detailer:	PJS	Numbers	
Sheet Subset:	ITS	Subset Sheets:	34 of 46

Project No./Code
MTCE 0091-039
18777
Sheet Number 44


MATCH LINE - SEE INTERCONNECT SHEET 34



- 22 2-2 INCH ELECTRICAL CONDUIT (MULTIDUCT) (PLASTIC)
- 32 FIBER OPTIC CABLE (SINGLE MODE) (96 STRANDS) (BACKBONE)

SWMP NOTES:


1. ECS SHALL PLACE BMPs IN THE FIELD AS DIRECTED BY THE SWMP NARRATIVES AND AS REQUIRED BY CDDT SPECIFICATIONS AND THE CDPS-SCP TO ENSURE ALL POTENTIAL POLLUTANTS FROM CONSTRUCTION WILL NOT ENTER STATE WATERS. ECS SHALL SHOW AND UPDATE BMPs ON PLAN SHEETS, SIGN AND DATE WHEN INSTALLED.
2. CONSTRUCTION BOUNDARY IS EXISTING ROW
3. SEE SWMP TYPICAL SECTIONS FOR LIMITS OF DISTURBANCE

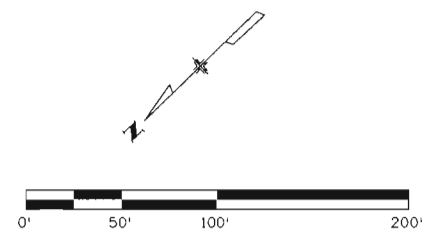


5/22/2012 3:06:39 PM P:\10-028.13 Region 1 Umbrella 2011 CDDT\102 - SH 9 Signal Interconnect\18777\Traffic_ITS\Drawings\18777TRAF_Plan35.dgn

Print Date: 5/22/2012	
Drawing File Name: 18777TRAF_Plan35.dgn	
Horiz. Scale: 1:100	Vert. Scale: As Noted
Unit Information	Unit Leader Initials
MULLER Muller Engineering Co., Inc. Consulting Engineers	apexdesign
P:10-028.13 - SH 9 Interconnect\Traffic_ITS	

Sheet Revisions		
Date:	Comments	Init.

Colorado Department of Transportation	
	18500 East Colfax Avenue Aurora, CO 80011 Phone: 303-757-9648 FAX: 303-757-9746
Region 1	SS

As Constructed		TRAFFIC SIGNAL INTERCONNECT			Project No./Code	
No Revisions:					MTCE 009I-039	
Revised:	Designer: KEB	Structure		18777		
	Detailer: PJS	Numbers				
Void:	Sheet Subset: ITS	Subset Sheets:	35 of 46	Sheet Number	45	

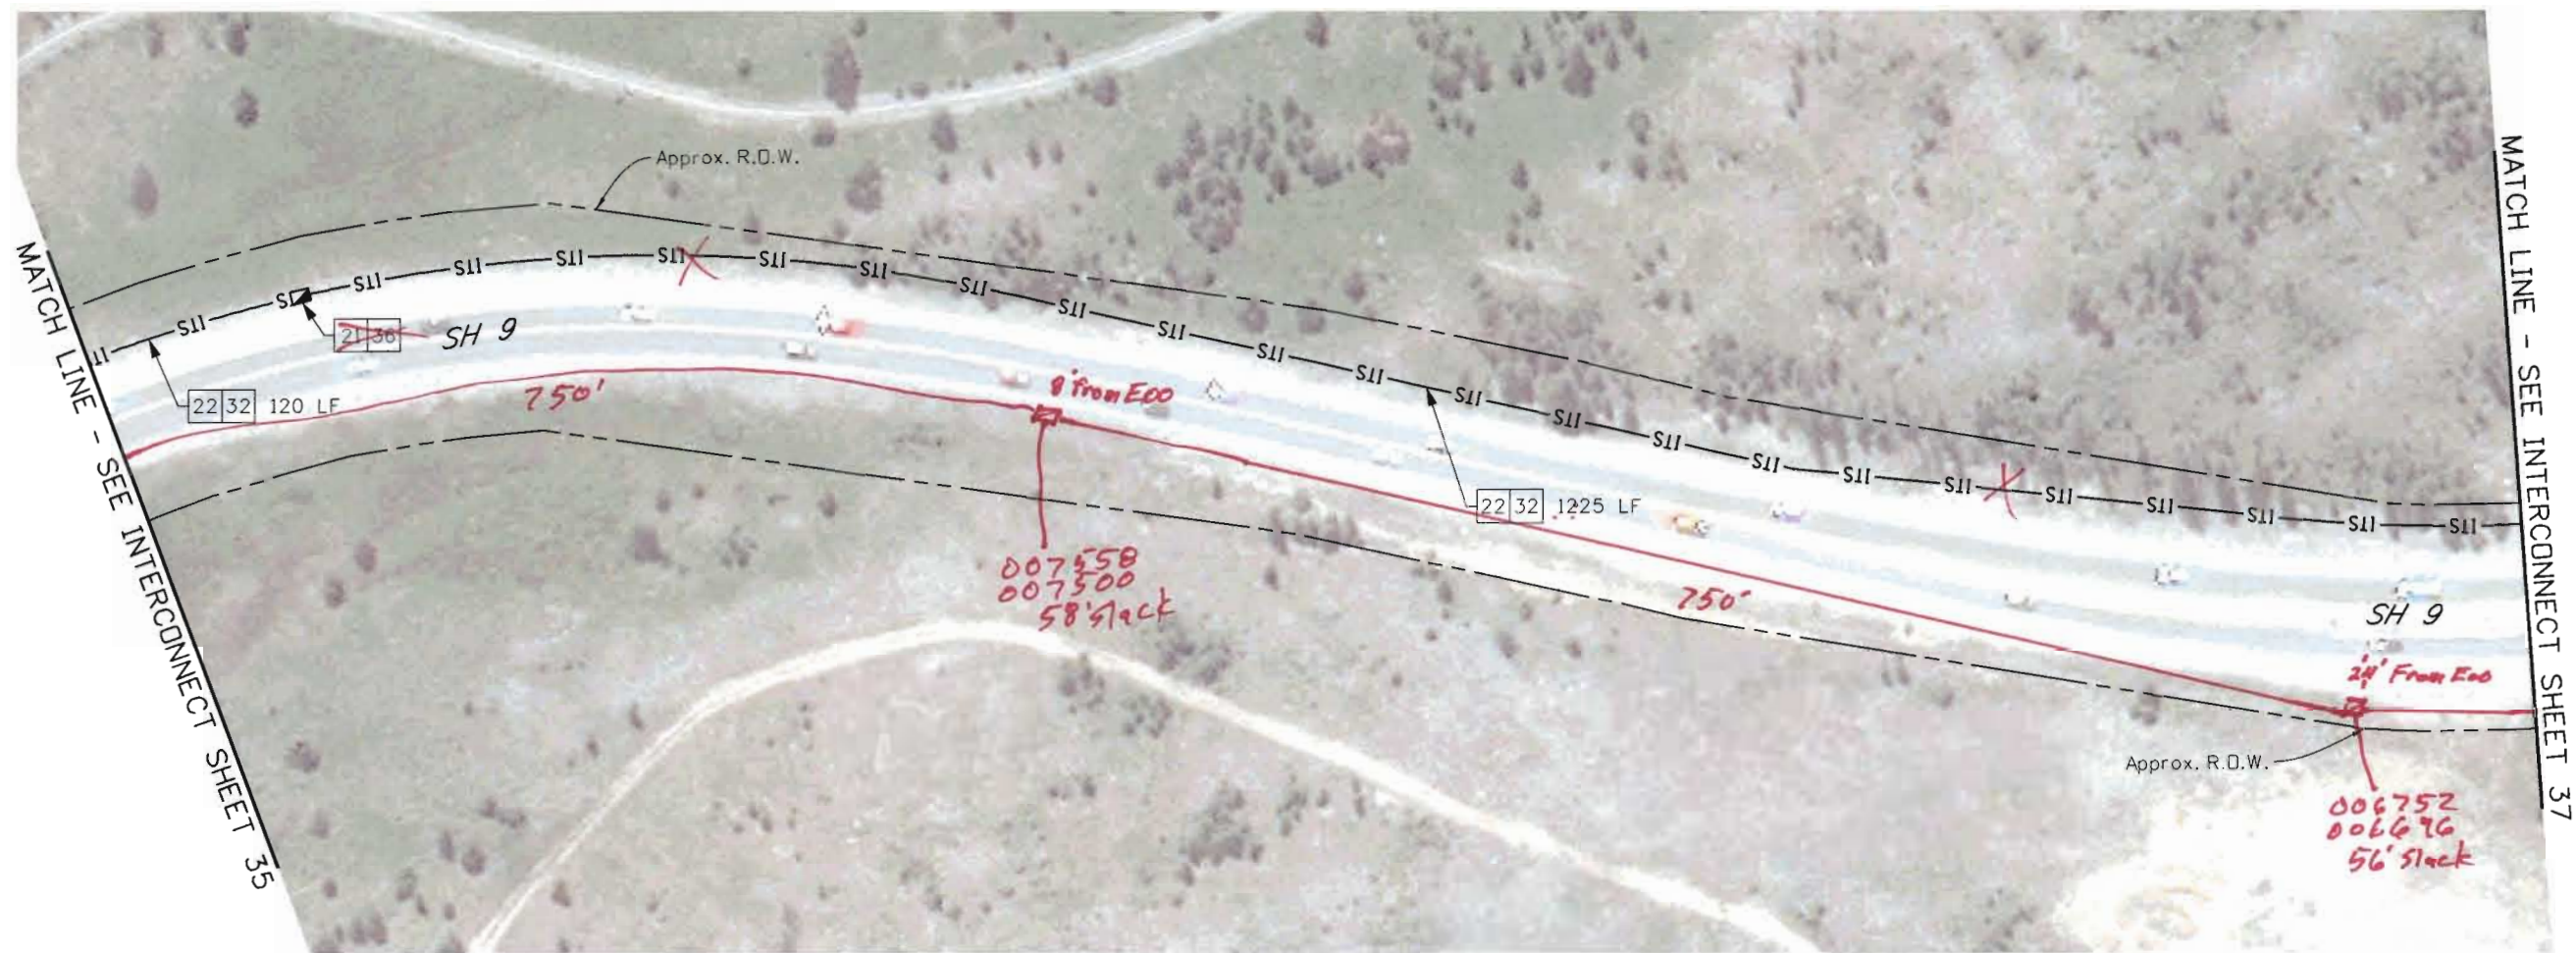


- 21 PULL BOX (24" X 36" X 24")
- 22 2-2 INCH ELECTRICAL CONDUIT (MULTIDUCT) (PLASTIC)
- 32 FIBER OPTIC CABLE (SINGLE MODE) (96 STRANDS) (BACKBONE)
- 36 COIL 50 LINEAR FEET OF EACH FIBER OPTIC BACKBONE CABLE IN PULL BOX FOR SLACK

SWMP NOTES:


- ECS SHALL PLACE BMPs IN THE FIELD AS DIRECTED BY THE SWMP NARRATIVES AND AS REQUIRED BY CDOT SPECIFICATIONS AND THE CDPS-SCP TO ENSURE ALL POTENTIAL POLLUTANTS FROM CONSTRUCTION WILL NOT ENTER STATE WATERS. ECS SHALL SHOW AND UPDATE BMPs ON PLAN SHEETS, SIGN AND DATE WHEN INSTALLED.
- CONSTRUCTION BOUNDARY IS EXISTING RDW
- SEE SWMP TYPICAL SECTIONS FOR LIMITS OF DISTURBANCE




Know what's below.
Call before you dig.

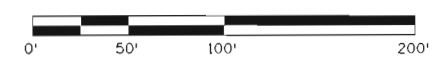

5/22/2012 3:06:50 PM P:\10-028.13 Region 1 Umbrella 2011 CDOT\102 - SH 9 Signal Interconnect\18777\Traffic\ITS\Drawings\18777TRAF_Plan36.dgn

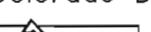Print Date: 5/22/2012		<div>0000</div>	Sheet Revisions			<div><div>Colorado Department of Transportation</div><div>18500 East Colfax Avenue Aurora, CO 80011 Phone: 303-757-9648 FAX: 303-757-9746</div><div>Region 1SS</div></div>	As Constructed		TRAFFIC SIGNAL INTERCONNECT			Project No./Code		
Drawing File Name:18777TRAF_Plan36.dgn			Date:	Comments	Init.		No Revisions:					MTCE 0091-039		
Horiz. Scale: 1:100			Vert. Scale: As Noted						Revised:		Designer: KEB		Structure	
Unit Information			Unit Leader Initials						Detailer: PJS		Numbers		18777	
<div><div>MULLER</div><div>Muller Engineering Co., Inc. Consulting Engineers P:10-028.13 ~ SH 9 Interconnect\Traffic_ITS</div></div> <div>apexdesign</div>									Void:		Sheet Subset: ITS		Subset Sheets: 36 of 46	
											Sheet Number 46			


5/22/2012 3:06:59 PM
P:\10-028.13 Region 1 Umbrella 2011 CDDT\102 - SH 9 Signal Interconnect\18777\Traffic\ITS Drawings\18777\TRAFFIC_Plan37.dgn

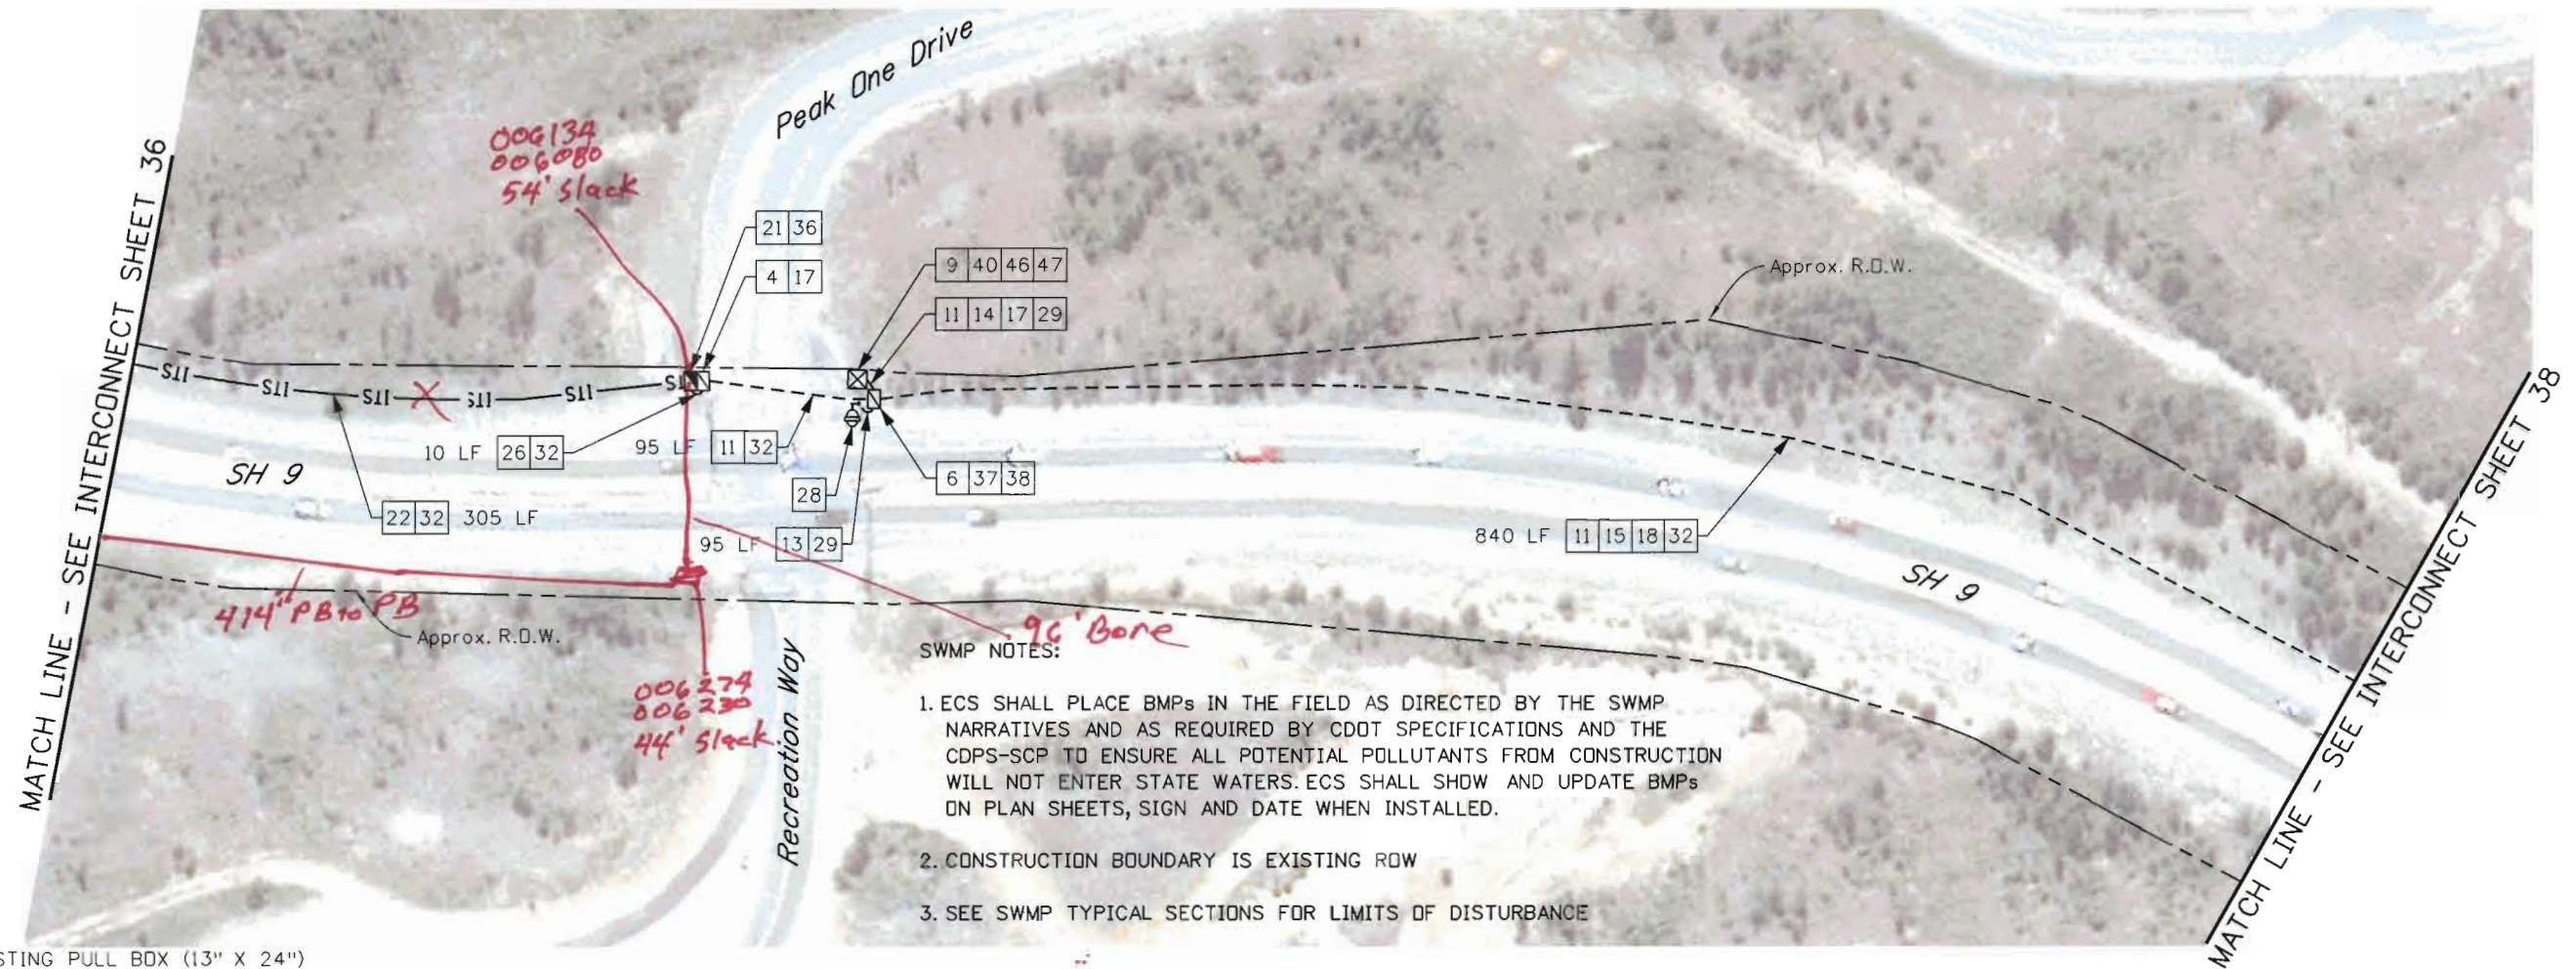

- [4] EXISTING PULL BOX (13" X 24")
- [6] EXISTING PULL BOX (24" X 36")
- [9] EXISTING TRAFFIC SIGNAL CONTROLLER CABINET
- [11] EXISTING 2" ELECTRICAL CONDUIT
- [13] EXISTING ELECTRICAL CONDUIT
- [14] EXISTING FIBER OPTIC CABLE (SINGLE MODE) (12 STRAND)
- [15] EXISTING FIBER OPTIC CABLE (SINGLE MODE) (24 STRAND)
- [17] PROTECT IN PLACE
- [18] REMOVE EXISTING FIBER BACKBONE CABLE
- [21] PULL BOX (24" X 36" X 24")
- [22] 2-2 INCH ELECTRICAL CONDUIT (MULTIDUCT) (PLASTIC)
- [26] INSTALL 2-2 INCH ELECTRICAL CONDUITS BETWEEN ADJACENT PULL BOXES

- SWMP NOTES:
1. ECS SHALL PLACE BMPs IN THE FIELD AS DIRECTED BY THE SWMP NARRATIVES AND AS REQUIRED BY CDDT SPECIFICATIONS AND THE CDPS-SCP TO ENSURE ALL POTENTIAL POLLUTANTS FROM CONSTRUCTION WILL NOT ENTER STATE WATERS. ECS SHALL SHOW AND UPDATE BMPs ON PLAN SHEETS, SIGN AND DATE WHEN INSTALLED.
 2. CONSTRUCTION BOUNDARY IS EXISTING ROW
 3. SEE SWMP TYPICAL SECTIONS FOR LIMITS OF DISTURBANCE


- [28] CLOSED CIRCUIT TELEVISION CAMERA (TRAFFIC SURVEILLANCE)
- [29] CLOSED CIRCUIT TELEVISION CABLE
- [32] FIBER OPTIC CABLE (SINGLE MODE) (96 STRANDS) (BACKBONE)
- [36] COIL 50 LINEAR FEET OF EACH FIBER OPTIC BACKBONE CABLE IN PULL BOX FOR SLACK
- [37] COIL 100 LINEAR FEET OF EACH FIBER OPTIC BACKBONE CABLE IN PULL BOX FOR SLACK
- [38] FIBER OPTIC SPLICE CLOSURE. FUSION SPLICE FIBERS PER SPLICING DETAIL SHEETS.
- [40] FIBER OPTIC TERMINATION PANEL - 12 FIBER
- [46] ETHERNET SWITCH
- [47] SERIAL TO IP CONVERTER

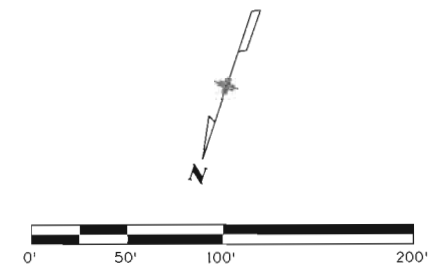

Print Date: 5/22/2012		Sheet Revisions			Colorado Department of Transportation		As Constructed		TRAFFIC SIGNAL INTERCONNECT				Project No./Code			
Drawing File Name:18777\TRAF_Plan37.dgn																
Horiz. Scale: 1"=100		Vert. Scale: As Noted		<div><div></div><div></div><div></div><div></div><div></div></div>	Date:	Comments	Init.	No Revisions:		Designer: KEB		Structure	MTCE 0091-039			
Unit Information		Unit Leader Initials						Revised:		Detailer: PJS		Numbers	18777			
MULLER Muller Engineering Co., Inc. Consulting Engineers		apexdesign						Void:		Sheet Subset: ITS		Subset Sheets:	37 of 46			
P:\10-028.13 - SH 9 Interconnect\Traffic_ITS														Sheet Number 47		
					<div><div><div></div><div></div><div></div></div><div>DOT</div><div>DEPARTMENT OF TRANSPORTATION</div></div>		18500 East Colfax Avenue Aurora, CO 80011 Phone: 303-757-9648 FAX: 303-757-9746									
					Region 1		SS									

5/22/2012 3:07:07 PM P:\10-028.13 Region 1 Umbrello 2011 CDDT\102 - SH 9 SignalInterconnect\18777\Traffic_ITS\Drawings\18777TRAF_Plan38.dgn

MATCH LINE - SEE INTERCONNECT SHEET 37

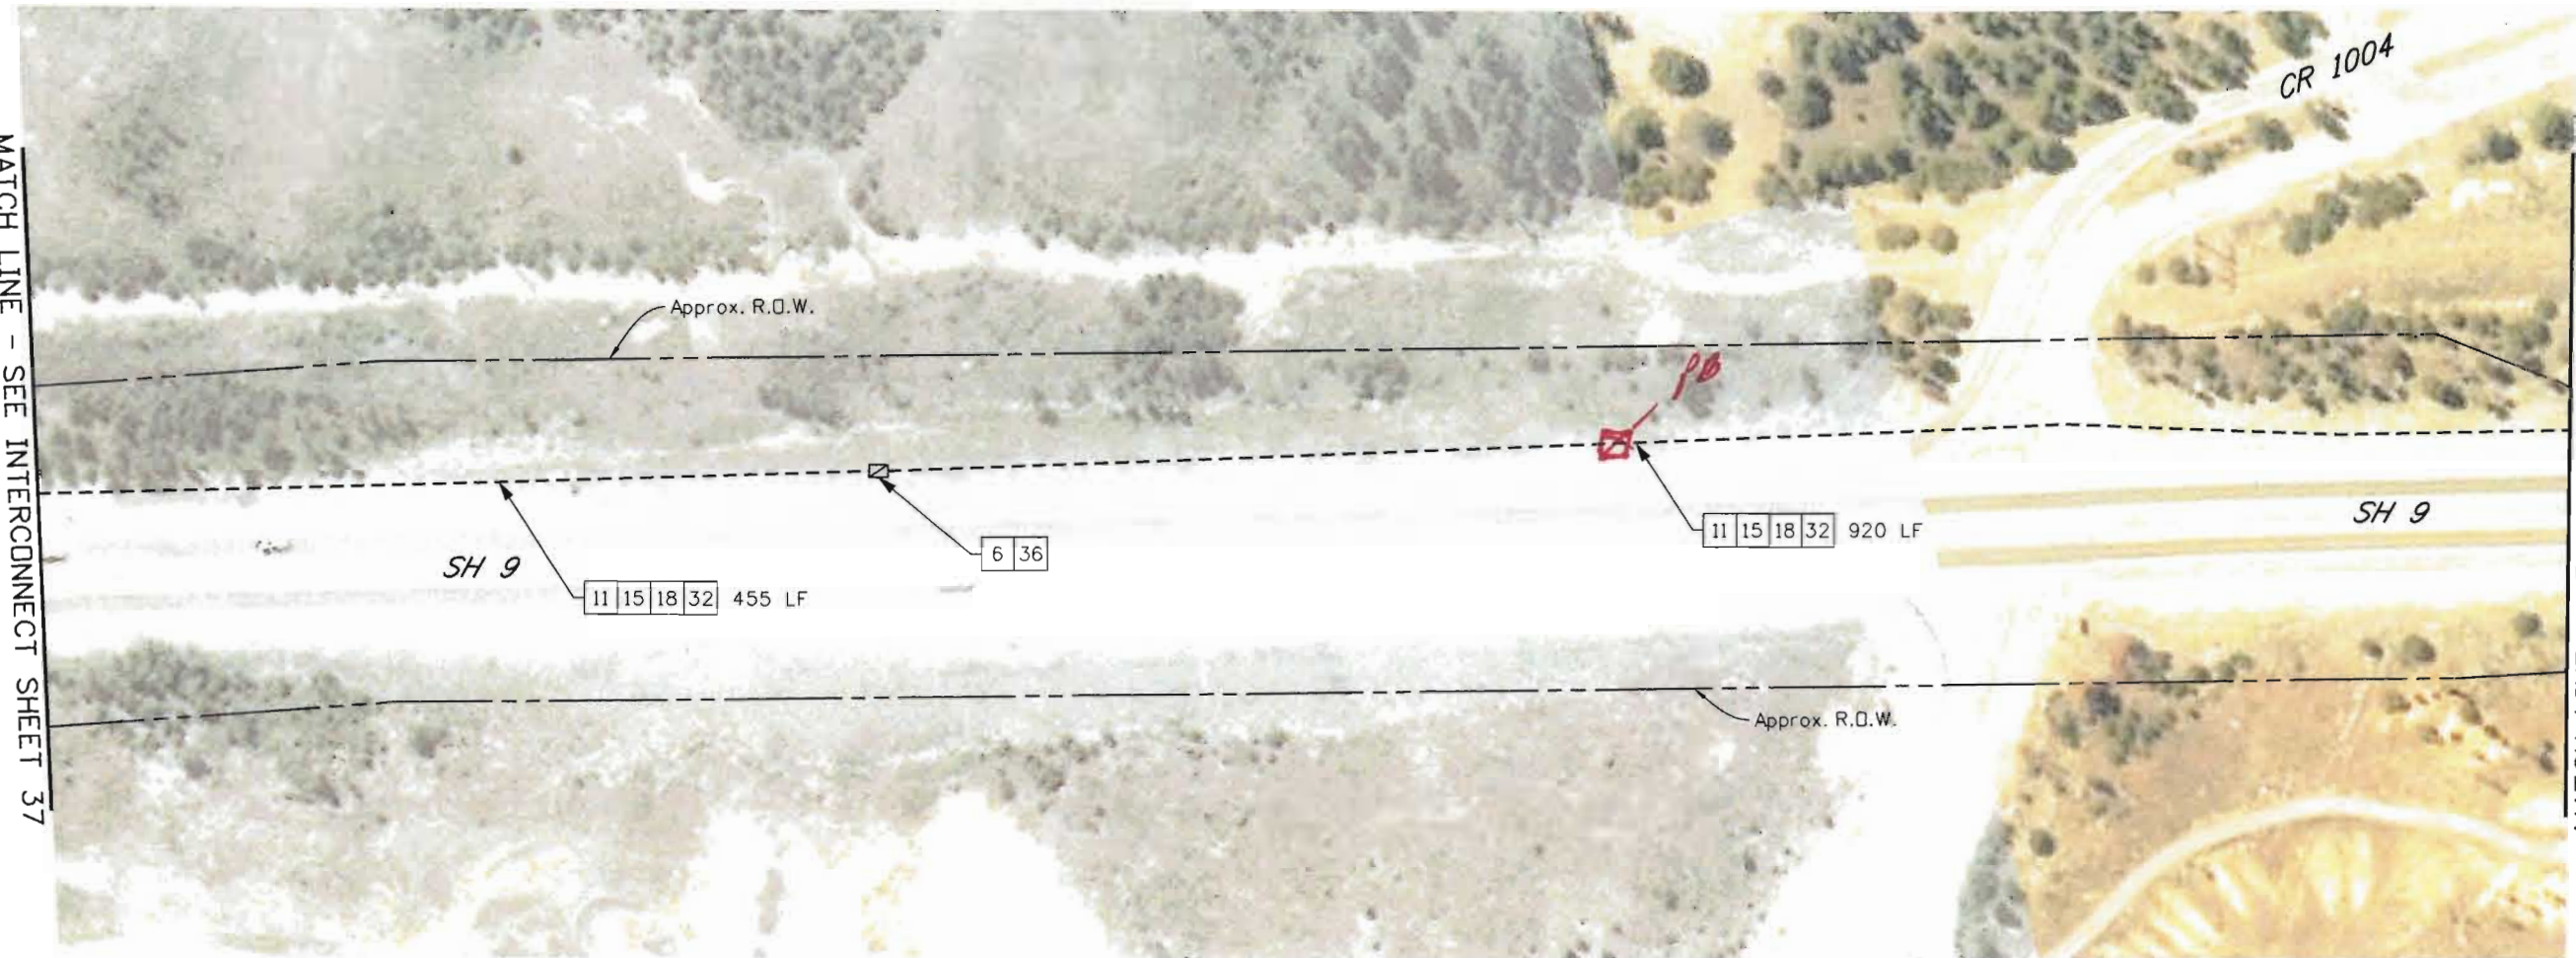

MATCH LINE - SEE INTERCONNECT SHEET 39


- 6 EXISTING PULL BOX (24" X 36")
- 11 EXISTING 2" ELECTRICAL CONDUIT
- 15 EXISTING FIBER OPTIC CABLE (SINGLE MODE) (24 STRAND)
- 18 REMOVE EXISTING FIBER BACKBONE CABLE
- 32 FIBER OPTIC CABLE (SINGLE MODE) (96 STRANDS) (BACKBONE)
- 36 COIL 50 LINEAR FEET OF EACH FIBER OPTIC BACKBONE CABLE IN PULL BOX FOR SLACK

SWMP NOTES:

1. ECS SHALL PLACE BMPs IN THE FIELD AS DIRECTED BY THE SWMP NARRATIVES AND AS REQUIRED BY CDDT SPECIFICATIONS AND THE CDPS-SCP TO ENSURE ALL POTENTIAL POLLUTANTS FROM CONSTRUCTION WILL NOT ENTER STATE WATERS. ECS SHALL SHOW AND UPDATE BMPs ON PLAN SHEETS, SIGN AND DATE WHEN INSTALLED.
2. CONSTRUCTION BOUNDARY IS EXISTING ROW
3. SEE SWMP TYPICAL SECTIONS FOR LIMITS OF DISTURBANCE




Know what's below.
Call before you dig.

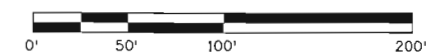


Print Date: 5/22/2012	
Drawing File Name: 18777TRAF_Plan38.dgn	
Horiz. Scale: 1:100	Vert. Scale: As Noted
Unit Information	Unit Leader Initials
MULLER Muller Engineering Co., Inc. Consulting Engineers	apexdesign
P:\10-028.13 - SH 9 Interconnect\Traffic_ITS	

Sheet Revisions		
Date:	Comments	Init.

Colorado Department of Transportation	
	18500 East Colfax Avenue Aurora, CO 80011 Phone: 303-757-9648 FAX: 303-757-9746
Region 1	SS


As Constructed		TRAFFIC SIGNAL INTERCONNECT		Project No./Code
No Revisions:				MTCE 0091-039
Revised:		Designer: KEB	Structure Numbers	18777
Void:		Detailer: PJS		Sheet Number 48
		Sheet Subset: ITS	Subset Sheets: 38 of 46	

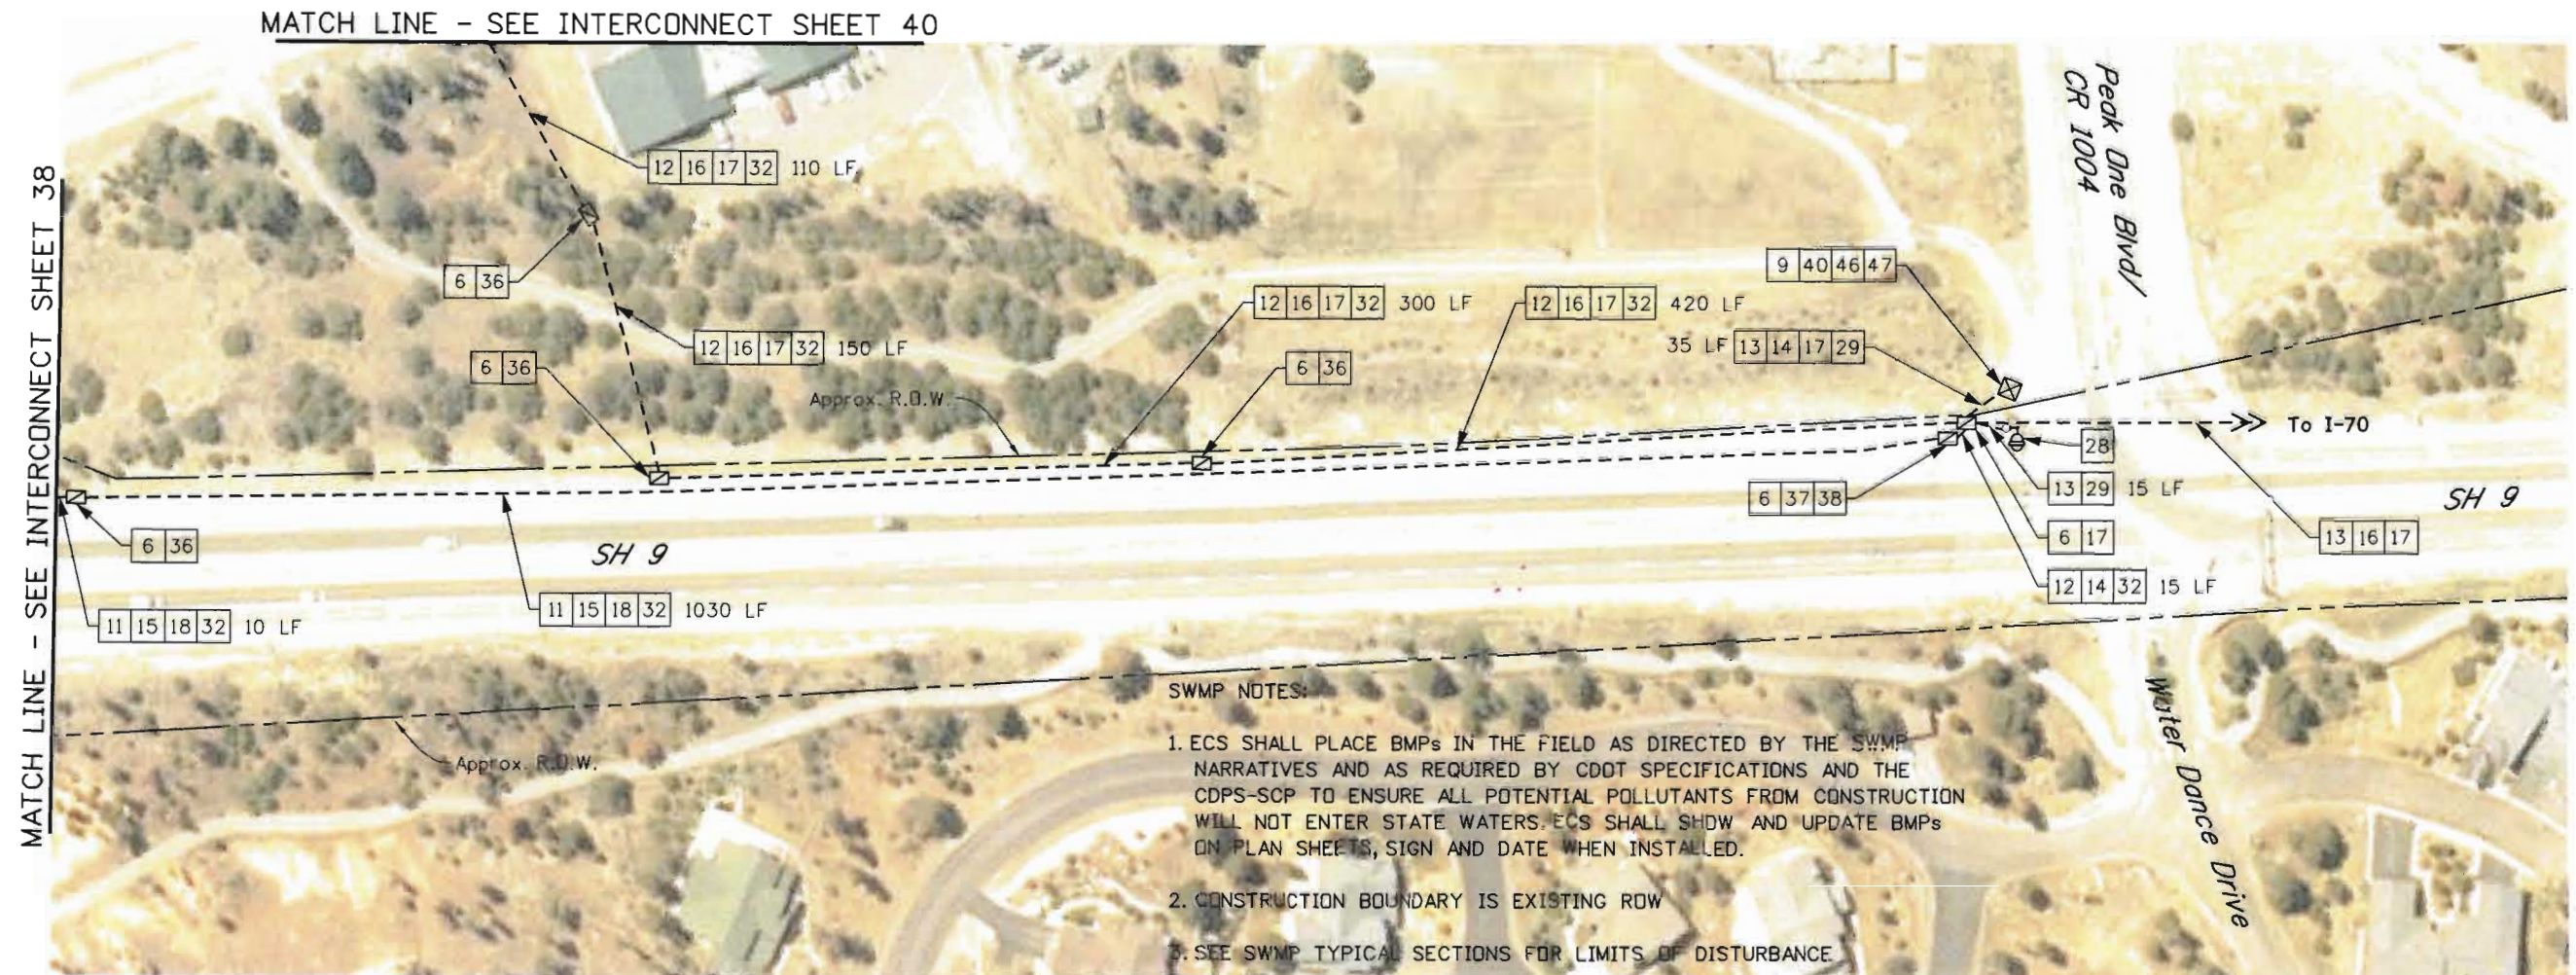


- | | | | |
|----|--|----|---|
| 6 | EXISTING PULL BOX (24" X 36") | 29 | CLOSED CIRCUIT TELEVISION CAMERA |
| 9 | EXISTING TRAFFIC SIGNAL CONTROLLER CABINET | 32 | FIBER OPTIC CABLE (SINGLE MODE) (96 STRANDS) (BACKBONE) |
| 11 | EXISTING 2" ELECTRICAL CONDUIT | 36 | COIL 50 LINEAR FEET OF EACH FIBER OPTIC BACKBONE CABLE IN PULL BOX FOR SLACK |
| 12 | EXISTING 3" ELECTRICAL CONDUIT | 37 | COIL 100 LINEAR FEET OF EACH FIBER OPTIC BACKBONE CABLE IN PULL BOX FOR SLACK |
| 13 | EXISTING ELECTRICAL CONDUIT | 38 | FIBER OPTIC SPLICE CLOSURE. FUSION SPLICE FIBERS PER SPLICING DETAIL SHEETS. |
| 14 | EXISTING FIBER OPTIC CABLE (SINGLE MODE) (12 STRAND) | 40 | FIBER OPTIC TERMINATION PANEL - 12 FIBER |
| 15 | EXISTING FIBER OPTIC CABLE (SINGLE MODE) (24 STRAND) | 46 | ETHERNET SWITCH |
| 16 | EXISTING FIBER OPTIC CABLE (SINGLE MODE) (96 STRAND) | 47 | SERIAL TO IP CONVERTER |
| 17 | PROTECT IN PLACE | | |
| 18 | REMOVE EXISTING FIBER BACKBONE CABLE | | |
| 28 | CLOSED CIRCUIT TELEVISION CAMERA (TRAFFIC SURVEILLANCE) (MOUNTED ON SIGNAL POLE) | | |



**Know what's below.
Call before you dig.**

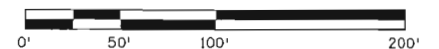


Print Date: 5/22/2012		<div><div></div><div></div><div></div><div></div></div>	Sheet Revisions			Colorado Department of Transportation		As Constructed		TRAFFIC SIGNAL INTERCONNECT			Project No./Code	
Drawing File Name:18777TRAF_Plan39.dgn			Date:	Comments	Init.	<div><div><div></div><div>DOT</div><div>DEPARTMENT OF TRANSPORTATION</div></div><div>18500 East Colfax Avenue Aurora, CO 80011 Phone: 303-757-9648 FAX: 303-757-9746</div><div>Region 1SS</div></div>		No Revisions:		MTCE 0091-039			18777	
Horiz. Scale: 1:100 Vert. Scale: As Noted														
Unit Information			Unit Leader Initials					Revised:		Designer:	KEB	Structure		
<div><div>MULLER</div><div>Muller Engineering Co., Inc. Consulting Engineers P:10-028.13 - SH 9 Interconnect\Traffic_ITS</div></div> <div>apexdesign</div>								Void:		Detailer:	PJS	Numbers		
								Sheet Subset:	ITS	Subset Sheets:	39 of 46	Sheet Number 49		

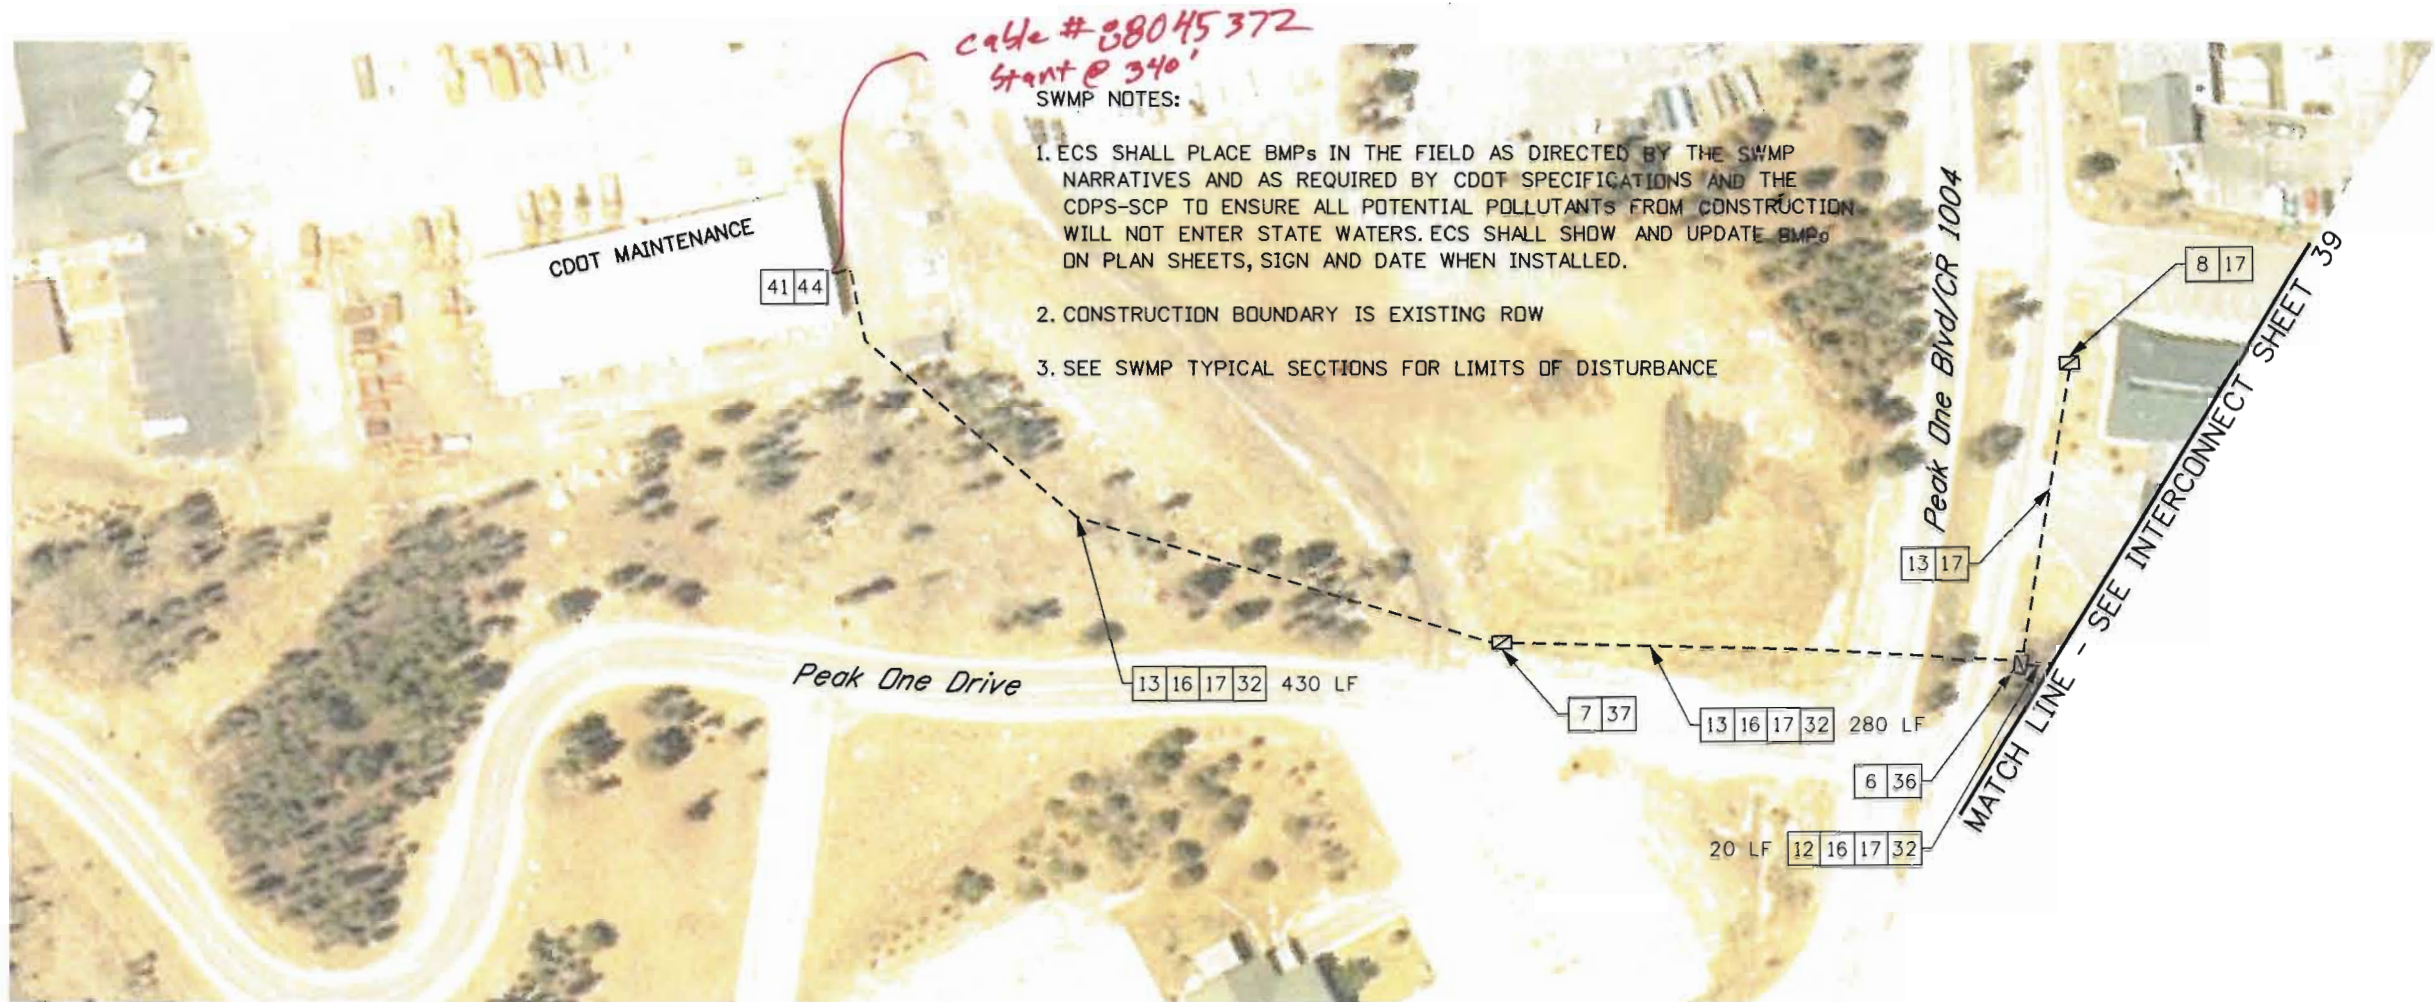


- | | |
|---|--|
| 6 EXISTING PULL BOX (24" X 36") | 37 COIL 100 LINEAR FEET OF EACH FIBER OPTIC BACKBONE CABLE FOR SLACK |
| 7 EXISTING PULL BOX (30" X 48") | 41 FIBER OPTIC TERMINATION PANEL - 24 FIBER |
| 8 EXISTING PULL BOX | 44 TRAFFIC MANAGEMENT SYSTEM BUILDING EQUIPMENT - INCLUDING CABINET AND ETHERNET SWITCH (CORE) |
| 12 EXISTING 3" ELECTRICAL CONDUIT | |
| 13 EXISTING ELECTRICAL CONDUIT | |
| 16 EXISTING FIBER OPTIC CABLE (SINGLE MODE) (96 STRAND) | |
| 17 PROTECT IN PLACE | |
| 32 FIBER OPTIC CABLE (SINGLE MODE) (96 STRANDS) (BACKBONE) | |
| 36 COIL 50 LINEAR FEET OF EACH FIBER OPTIC BACKBONE CABLE IN PULL BOX FOR SLACK | |




Know what's below.
Call before you dig.

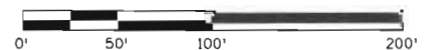

5/22/2012 3:07:24 PM P:\10-028.13 Region 1 Umbrello 2011 CDOT\102 - SH 9 Signal Interconnect\18777\Traffic\ITS\Drawings\18777TRAF_Plan40.dgn

Print Date: 5/22/2012		<div>0000</div> <div>0000</div> <div>0000</div> <div>0000</div>	Sheet Revisions			<div> Colorado Department of Transportation 18500 East Colfax Avenue Aurora, CO 80011 Phone: 303-757-9648 FAX: 303-757-9746 Region 1 SS</div>	As Constructed		TRAFFIC SIGNAL INTERCONNECT				Project No./Code	
Drawing File Name: 18777TRAF_Plan40.dgn			Date:	Comments	Init.		No Revisions:		MTCE 0091-039					
Horiz. Scale: 1:100							Revised:		Designer:	KEB	Structure		18777	
Unit Information							Void:		Detailer:	PJS	Numbers		Sheet Number 50	
Unit Leader Initials									Sheet Subset:	ITS	Subset Sheets:	40 of 46		
<div><div>MULLER</div><div>Muller Engineering Co., Inc. Consulting Engineers P:\10-028.13 - SH 9 Interconnect\Traffic_ITS</div></div> <div>apexdesign</div>														

5/22/2012 3:07:33 PM P:\10-028.13 - Region 1 Umbrella 2011 CDDT\102 - SH 9 Signal Interconnect\18777-Traffic_ITS\Drawings\18777TRAF_Plan42 CD Rd 1040.dgn

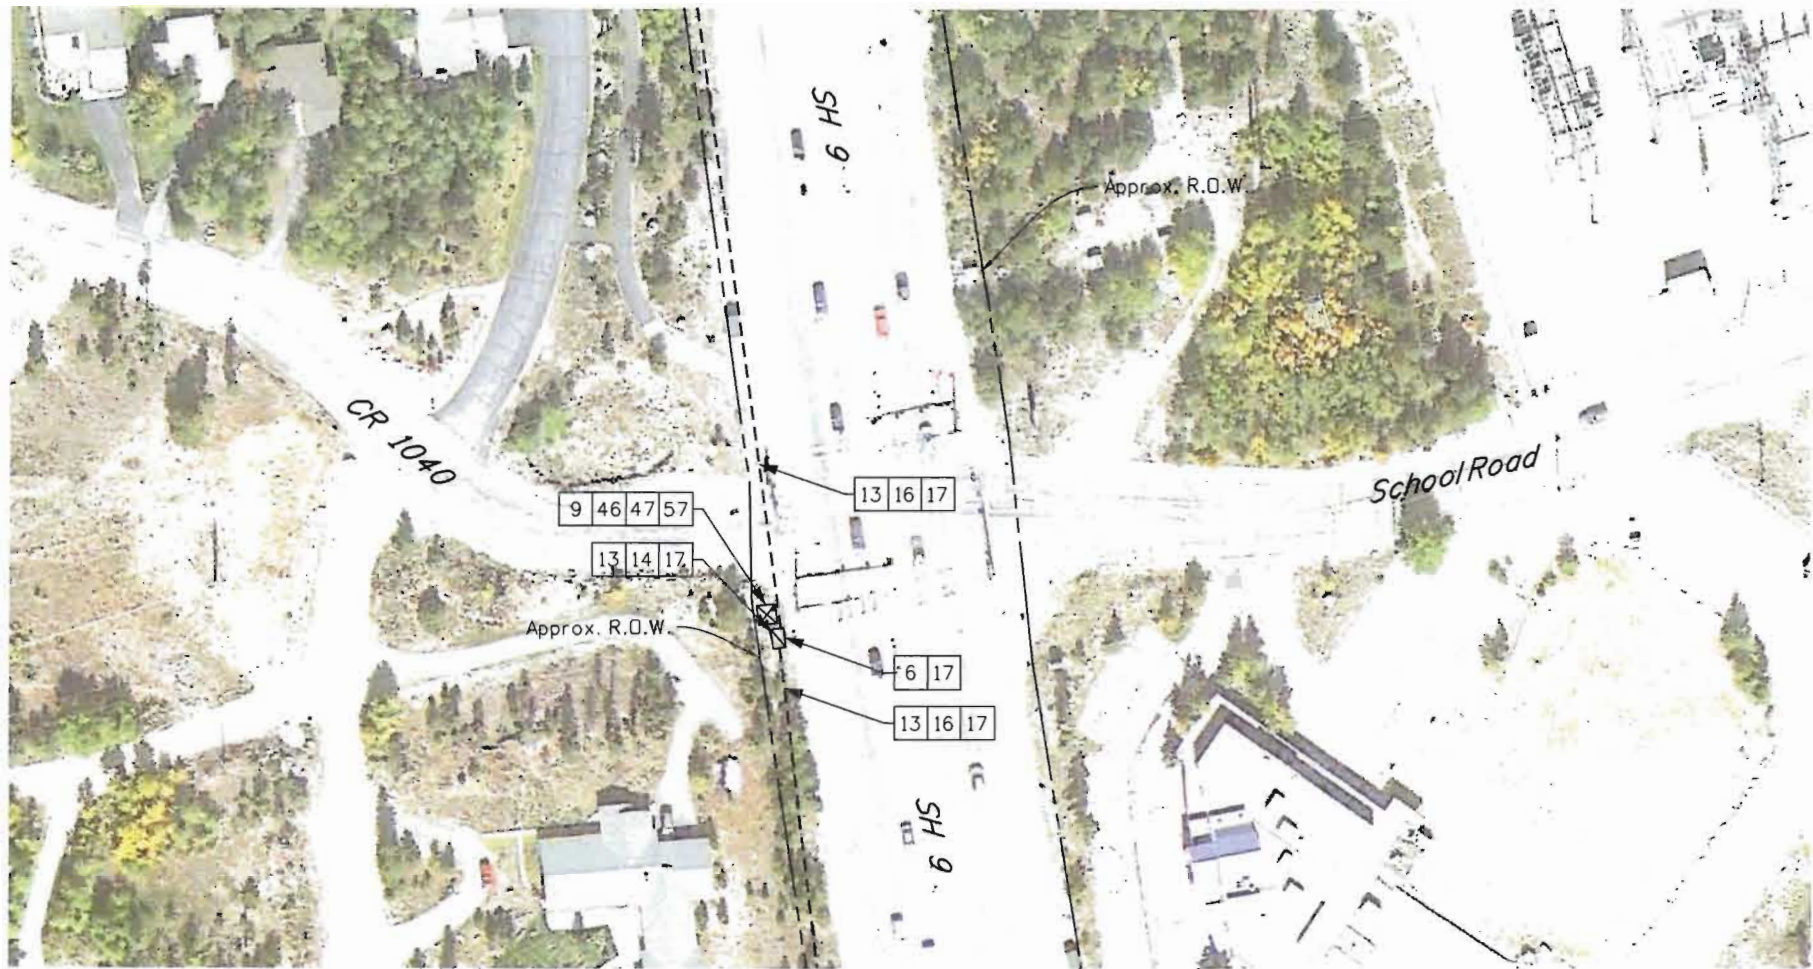


- 6 EXISTING PULL BDX (24" X 36")
- 9 EXISTING TRAFFIC SIGNAL CONTROLLER CABINET
- 13 EXISTING ELECTRICAL CONDUIT
- 14 EXISTING FIBER OPTIC CABLE (SINGLE MODE) (12 STRAND)
- 16 EXISTING FIBER OPTIC CABLE (SINGLE MODE) (96 STRAND)
- 17 PROTECT IN PLACE
- 46 ETHERNET SWITCH
- 47 SERIAL TO IP CONVERTER
- 57 EXISTING FIBER OPTIC TERMINATION PANEL - 6 FIBER

SWMP NOTES:

1. ECS SHALL PLACE BMPs IN THE FIELD AS DIRECTED BY THE SWMP NARRATIVES AND AS REQUIRED BY CDOT SPECIFICATIONS AND THE CDPS-SCP TO ENSURE ALL POTENTIAL POLLUTANTS FROM CONSTRUCTION WILL NOT ENTER STATE WATERS. ECS SHALL SHOW AND UPDATE BMPs ON PLAN SHEETS, SIGN AND DATE WHEN INSTALLED.
2. CONSTRUCTION BOUNDARY IS EXISTING ROW
3. SEE SWMP TYPICAL SECTIONS FOR LIMITS OF DISTURBANCE



Know what's below.
Call before you dig.

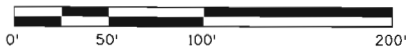

Print Date: 5/22/2012	
Drawing File Name: 18777TRAF_Plan42 CD Rd 1040.dgn	
Horiz. Scale: 1:100	Vert. Scale: As Noted
Unit Information	Unit Leader Initials
MULLER Muller Engineering Co., Inc. Consulting Engineers	apexdesign
P:\10-028.13 - SH 9 Interconnect\Traffic_ITS	

Sheet Revisions		
Date:	Comments	Init.

Colorado Department of Transportation		As Constructed		TRAFFIC SIGNAL INTERCONNECT		Project No./Code	
18500 East Colfax Avenue Aurora, CO 80011 Phone: 303-757-9648 FAX: 303-757-9746		No Revisions:		Designer: KEB		MTCE 0091-039	
Region 1		Revised:		Detailer: PJS		18777	
SS		Void:		Sheet Subset: ITS		Sheet Number 52	
				Structure Numbers		Subset Sheets: 42 of 46	

5/22/2012 3:07:39 PM P:\10-02813 Region 1 Umbrella 2011 CDDT\102 - SH 9 SignalInterconnect\18777\Traffic_ITS\Drawings\18777TRAF_Plan43 Hawn Dr-10 Mile Rd.dgn



- 4 EXISTING PULL BOX (13" X 24")
- 5 EXISTING PULL BOX (17" X 30")
- 6 EXISTING PULL BOX (24" X 36")
- 9 EXISTING TRAFFIC SIGNAL CONTROLLER CABINET
- 13 EXISTING ELECTRICAL CONDUIT
- 14 EXISTING FIBER OPTIC CABLE (SINGLE MODE) (12 STRAND)
- 16 EXISTING FIBER OPTIC CABLE (SINGLE MODE) (96 STRAND)
- 17 PROTECT IN PLACE
- 28 CLOSED CIRCUIT TELEVISION CAMERA (TRAFFIC SURVEILLANCE)


- 29 CLOSED CIRCUIT TELEVISION CABLE
- 40 FIBER OPTIC TERMINATION PANEL - 12 FIBER
- 46 ETHERNET SWITCH
- 47 SERIAL TO IP CONVERTER
- 58 REMOVE EXISTING FIBER OPTIC TERMINATION PANEL - 6 FIBER

SWMP NOTES:

1. ECS SHALL PLACE BMPs IN THE FIELD AS DIRECTED BY THE SWMP NARRATIVES AND AS REQUIRED BY CDOT SPECIFICATIONS AND THE CDPS-SCP TO ENSURE ALL POTENTIAL POLLUTANTS FROM CONSTRUCTION WILL NOT ENTER STATE WATERS. ECS SHALL SHOW AND UPDATE BMPs ON PLAN SHEETS, SIGN AND DATE WHEN INSTALLED.
2. CONSTRUCTION BOUNDARY IS EXISTING ROW
3. SEE SWMP TYPICAL SECTIONS FOR LIMITS OF DISTURBANCE




Know what's below.
Call before you dig.

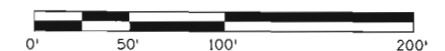


Print Date: 5/22/2012	
Drawing File Name:18777TRAF_Plan43 Hawn Dr-10 Mile Rd.dgn	
Horiz. Scale: 1:100	Vert. Scale: As Noted
Unit Information	Unit Leader Initials
MULLER Muller Engineering Co., Inc. Consulting Engineers P:\10-02813 - SH 9 Interconnect\Traffic_ITS	apexdesign

Sheet Revisions		
Date:	Comments	Init.

Colorado Department of Transportation	
	18500 East Colfax Avenue Aurora, CO 80011 Phone: 303-757-9648 FAX: 303-757-9746
Region 1	SS

As Constructed		TRAFFIC SIGNAL INTERCONNECT			Project No./Code
No Revisions:					MTCE 0091-039
Revised:		Designer: KEB	Structure		18777
Void:		Detailer: PJS	Numbers		
		Sheet Subset: ITS	Subset Sheets: 43 of 46	Sheet Number 53	

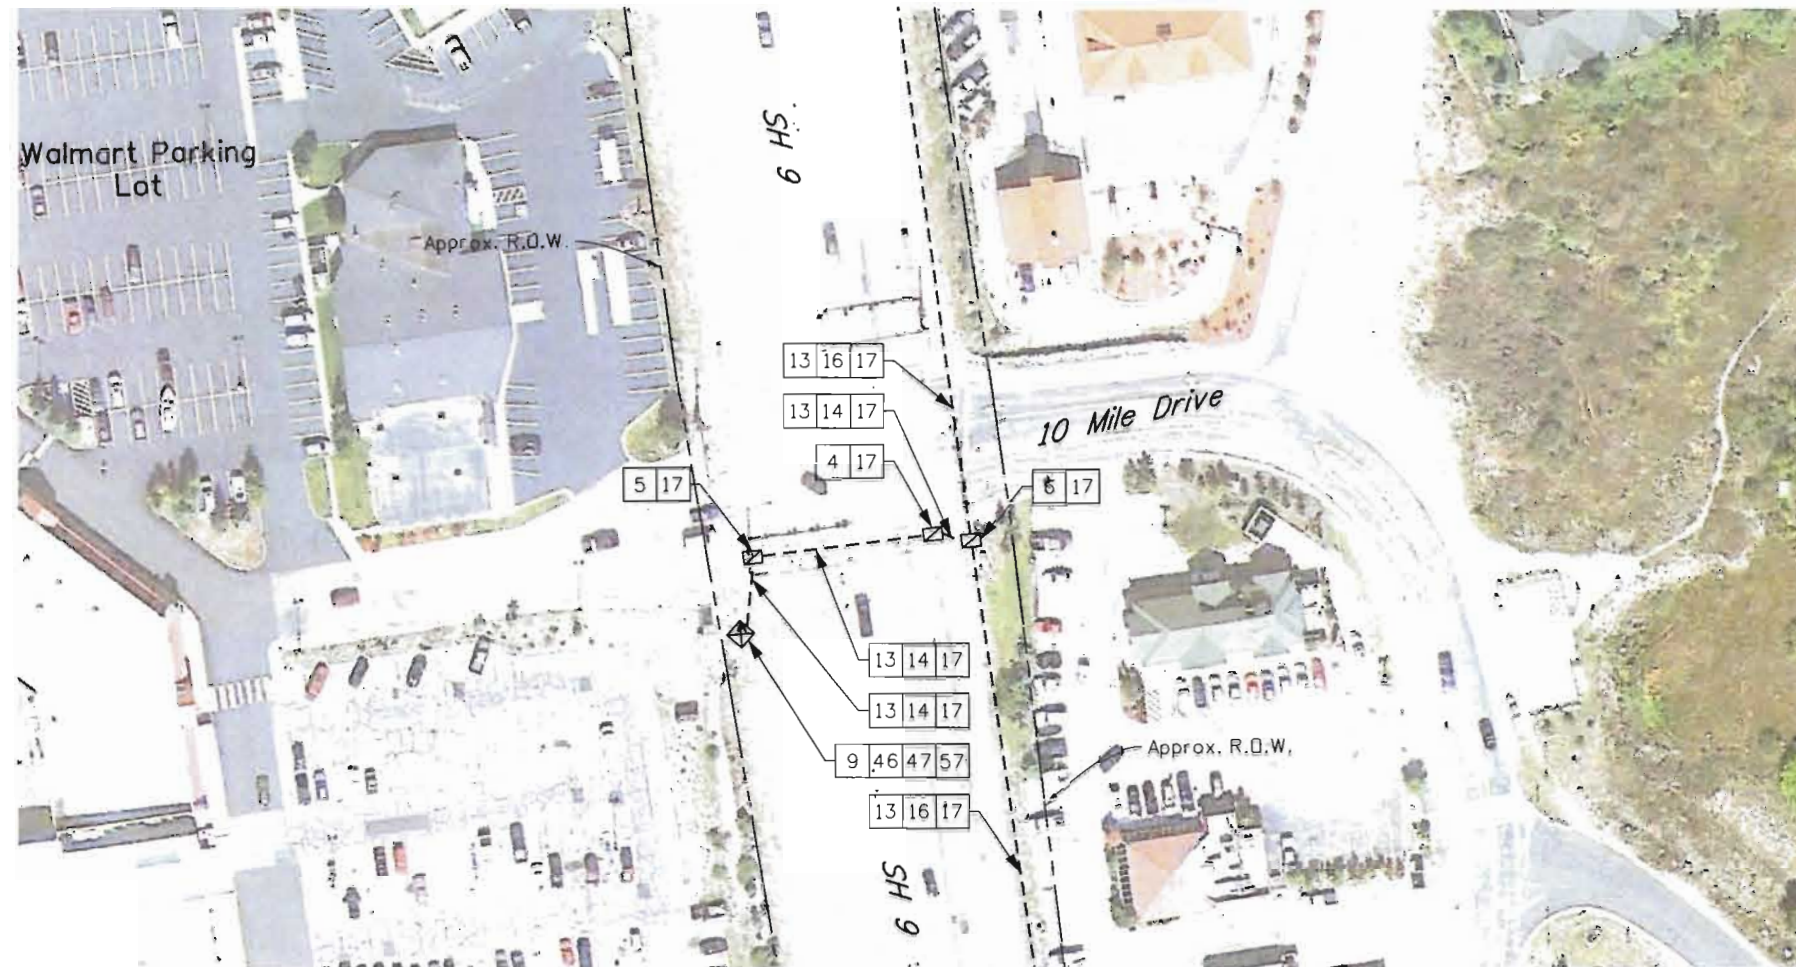

- 4 EXISTING PULL BOX (13" X 24")
- 5 EXISTING PULL BOX (17" X 30")
- 6 EXISTING PULL BOX (24" X 36")
- 9 EXISTING TRAFFIC SIGNAL CONTROLLER CABINET
- 13 EXISTING ELECTRICAL CONDUIT
- 14 EXISTING FIBER OPTIC CABLE (SINGLE MODE) (12 STRAND)
- 16 EXISTING FIBER OPTIC CABLE (SINGLE MODE) (96 STRAND)
- 17 PROTECT IN PLACE
- 46 ETHERNET SWITCH


- 47 SERIAL TO IP CONVERTER
- 57 EXISTING FIBER OPTIC TERMINATION PANEL - 6 FIBER

SWMP NOTES:

- ECS SHALL PLACE BMPs IN THE FIELD AS DIRECTED BY THE SWMP NARRATIVES AND AS REQUIRED BY CDOT SPECIFICATIONS AND THE CDPS-SCP TO ENSURE ALL POTENTIAL POLLUTANTS FROM CONSTRUCTION WILL NOT ENTER STATE WATERS. ECS SHALL SHOW AND UPDATE BMPs ON PLAN SHEETS, SIGN AND DATE WHEN INSTALLED.
- CONSTRUCTION BOUNDARY IS EXISTING ROW
- SEE SWMP TYPICAL SECTIONS FOR LIMITS OF DISTURBANCE



Know what's below.
Call before you dig.

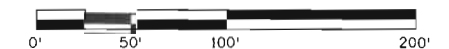


5/22/2012 3:07:44 PM P:\10-028.13 Region 1 Umbrella 2011 CDOT\102 - SH 9 Signal Interconnect\18777\Traffic_ITS\Drawings\18777TRAF_Plan44 10 Mile Drive.dgn

Print Date: 5/22/2012	
Drawing File Name: 18777TRAF_Plan44 10 Mile Drive.dgn	
Horiz. Scale: 1:100	Vert. Scale: As Noted
Unit Information	Unit Leader Initials
MULLER Muller Engineering Co., Inc. Consulting Engineers	apexdesign
P:\10-028.13 - SH 9 Interconnect\Traffic_ITS	

Sheet Revisions		
Date:	Comments	Init.

Colorado Department of Transportation




18500 East Colfax Avenue
Aurora, CO 80011
Phone: 303-757-9648 FAX: 303-757-9746

Region 1

SS

As Constructed		TRAFFIC SIGNAL INTERCONNECT		Project No./Code
No Revisions:				MTCE 0091-039
Revised:		Designer: KEB	Structure Numbers	18777
Void:		Detailer: PJS		
		Sheet Subset: ITS	Subset Sheets: 44 of 46	Sheet Number 54

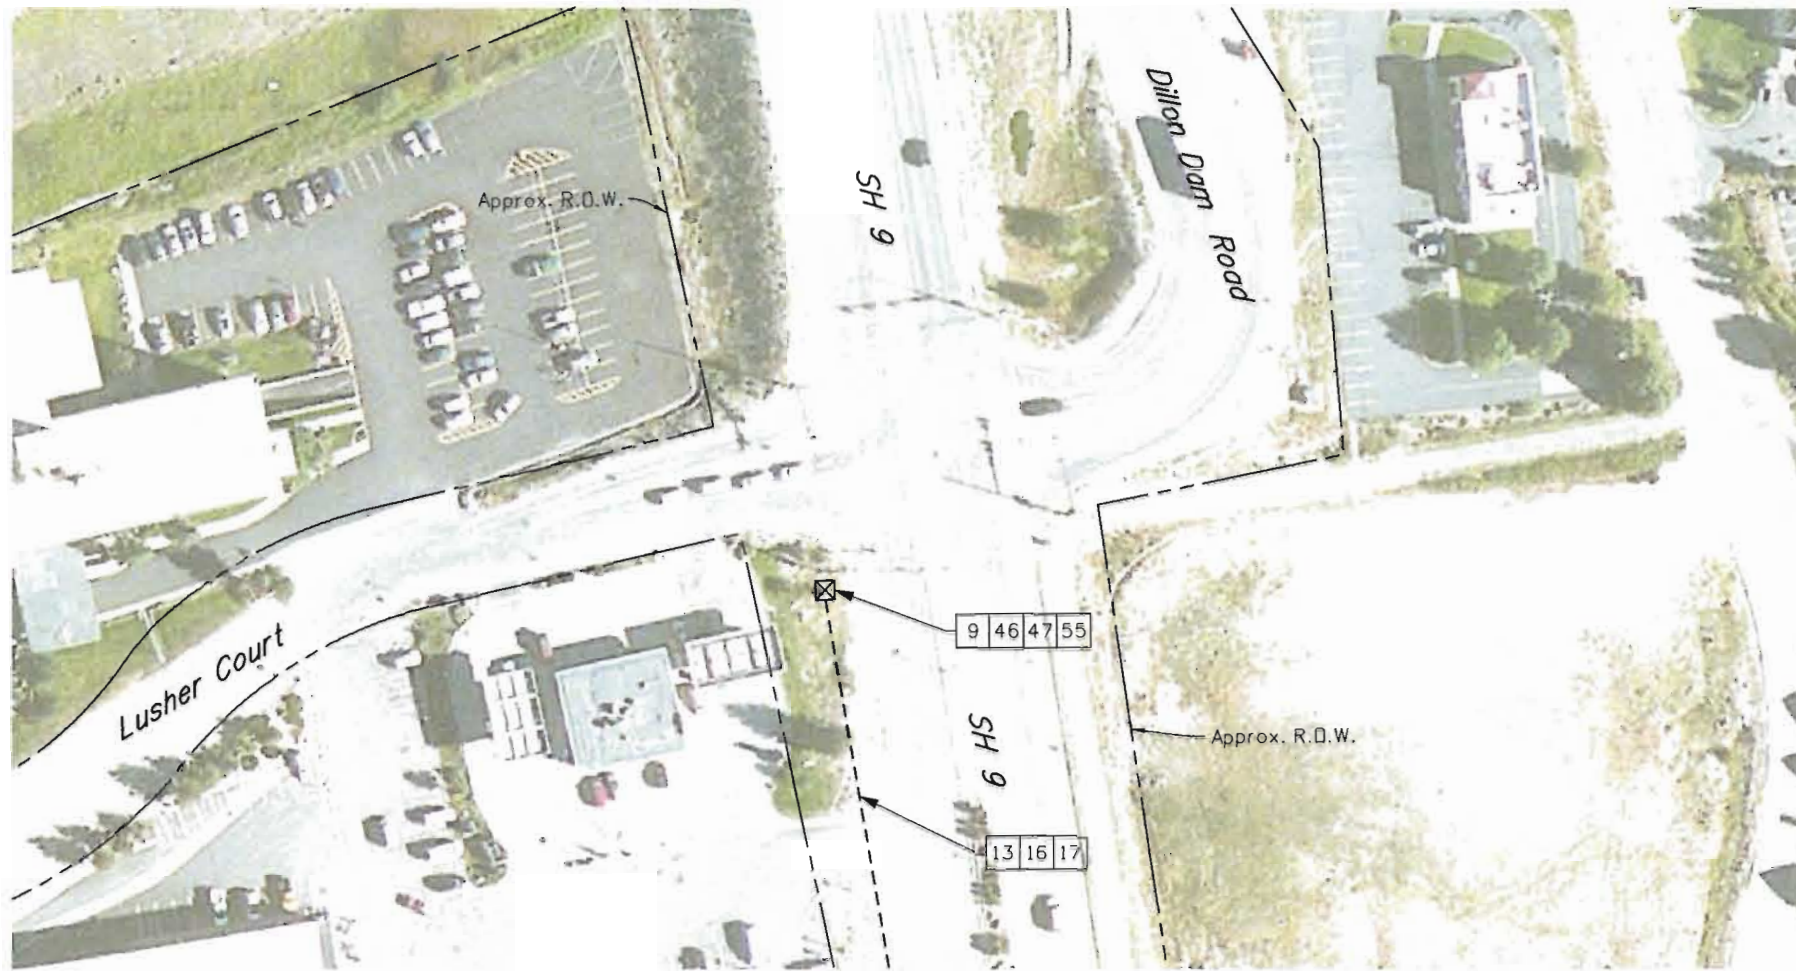

- 9 EXISTING TRAFFIC SIGNAL CONTROLLER CABINET
- 13 EXISTING ELECTRICAL CONDUIT
- 16 EXISTING FIBER OPTIC CABLE (SINGLE MODE) (96 STRAND)
- 17 PROTECT IN PLACE
- 46 ETHERNET SWITCH
- 47 SERIAL TO IP CONVERTER
- 55 EXISTING FIBER OPTIC TERMINATION PANEL - 12 FIBER

SWMP NOTES:

1. ECS SHALL PLACE BMPs IN THE FIELD AS DIRECTED BY THE SWMP NARRATIVES AND AS REQUIRED BY CDOT SPECIFICATIONS AND THE CDPS-SCP TO ENSURE ALL POTENTIAL POLLUTANTS FROM CONSTRUCTION WILL NOT ENTER STATE WATERS. ECS SHALL SHOW AND UPDATE BMPs ON PLAN SHEETS, SIGN AND DATE WHEN INSTALLED.
2. CONSTRUCTION BOUNDARY IS EXISTING ROW
3. SEE SWMP TYPICAL SECTIONS FOR LIMITS OF DISTURBANCE




Know what's below.
Call before you dig.



5/22/2012 3:07:51 PM P:\10-026.13 Region 1 Umbrella 2011 CDOT\102 - SH 9 Signal Interconnect\18777\Traffic_ITS\Drawings\18777\TRAF_Plan45 Dillon Dam Rd.dgn

Print Date: 5/22/2012	
Drawing File Name: 18777TRAF_Plan45 Dillon Dam Rd.dgn	
Horiz. Scale: 1:100	Vert. Scale: As Noted
Unit Information	
Unit Leader Initials	
MULLER	Muller Engineering Co., Inc. Consulting Engineers
apexdesign	
P:\10-026.13 - SH 9 Interconnect\Traffic_ITS	

Sheet Revisions		
Date:	Comments	Init.




Colorado Department of Transportation

Region 1

18500 East Colfax Avenue
Aurora, CO 80011
Phone: 303-757-9648 FAX: 303-757-9746

SS

As Constructed		TRAFFIC SIGNAL INTERCONNECT			Project No./Code
No Revisions:					MTCE 0091-039
Revised:		Designer: KEB	Structure Numbers		18777
Void:		Detailer: PJS			
		Sheet Subset: ITS	Subset Sheets: 45 of 46		Sheet Number 55

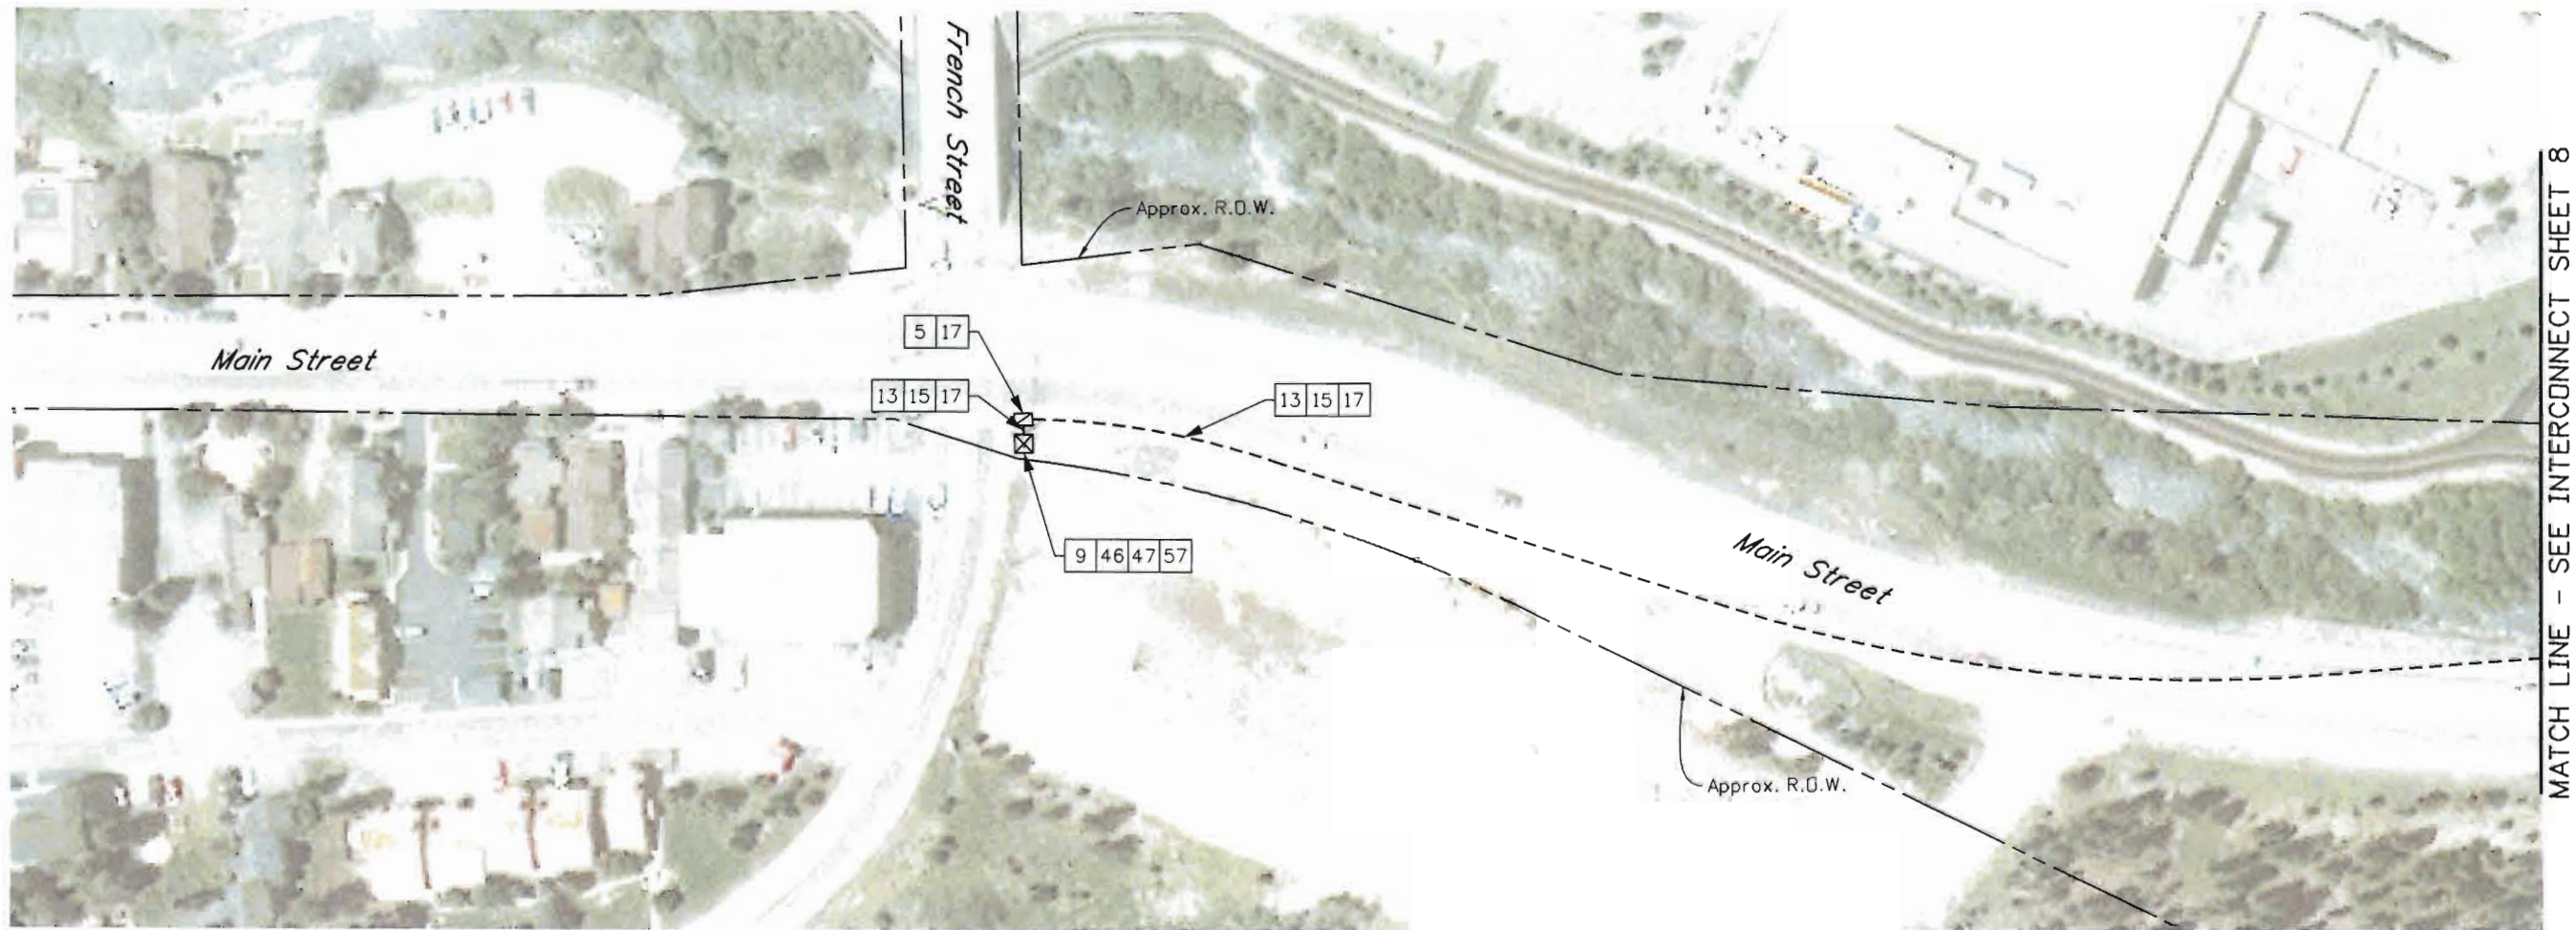


- 5 EXISTING PULL BDX (17" X 30")
- 9 EXISTING TRAFFIC SIGNAL CONTROLLER CABINET
- 13 EXISTING ELECTRICAL CONDUIT
- 15 EXISTING FIBER OPTIC CABLE (SINGLE MODE) (24 STRAND)
- 17 PROTECT IN PLACE
- 46 ETHERNET SWITCH
- 47 SERIAL TO IP CONVERTER
- 57 EXISTING FIBER OPTIC TERMINATION PANEL - 6 FIBER

SWMP NOTES:

1. ECS SHALL PLACE BMPs IN THE FIELD AS DIRECTED BY THE SWMP NARRATIVES AND AS REQUIRED BY CDOT SPECIFICATIONS AND THE CDPS-SCP TO ENSURE ALL POTENTIAL POLLUTANTS FROM CONSTRUCTION WILL NOT ENTER STATE WATERS. ECS SHALL SHOW AND UPDATE BMPs ON PLAN SHEETS, SIGN AND DATE WHEN INSTALLED.
2. CONSTRUCTION BOUNDARY IS EXISTING ROW
3. SEE SWMP TYPICAL SECTIONS FOR LIMITS OF DISTURBANCE



Know what's below.
Call before you dig.

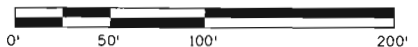

5/22/2012 3:07:56 PM
P:\10-028.13 Region 1 Umbrella 2011 CDDT\102 - SH 9 SignalInterconnect\18777\Traffic\ITS\Drawings\18777\TRAF_Plan46 Main_French.dgn


Print Date: 5/22/2012	
Drawing File Name: 18777TRAF_Plan46 Main_French.dgn	
Horiz. Scale: 1:100	Vert. Scale: As Noted
Unit Information	
Unit Leader Initials	
	Muller Engineering Co., Inc. Consulting Engineers
	apexdesign
P:\10-028.13 - SH 9 Interconnect\Traffic\ITS	

Sheet Revisions		
Date:	Comments	Init.

Colorado Department of Transportation	
	18500 East Colfax Avenue Aurora, CO 80011 Phone: 303-757-9648 FAX: 303-757-9746
	Region 1 SS

As Constructed		TRAFFIC SIGNAL INTERCONNECT		Project No./Code
No Revisions:				MTCE 0091-039
Revised:		Designer: KEB	Structure Numbers	18777
Void:		Detailer: PJS		
		Sheet Subset: ITS	Subset Sheets: 46 of 46	Sheet Number 56

5/1/2012 4:15:53 PM C:\Apex\Projects\18777\Traffic_ITS\Drawings\18777TRAF_Network01.dgn

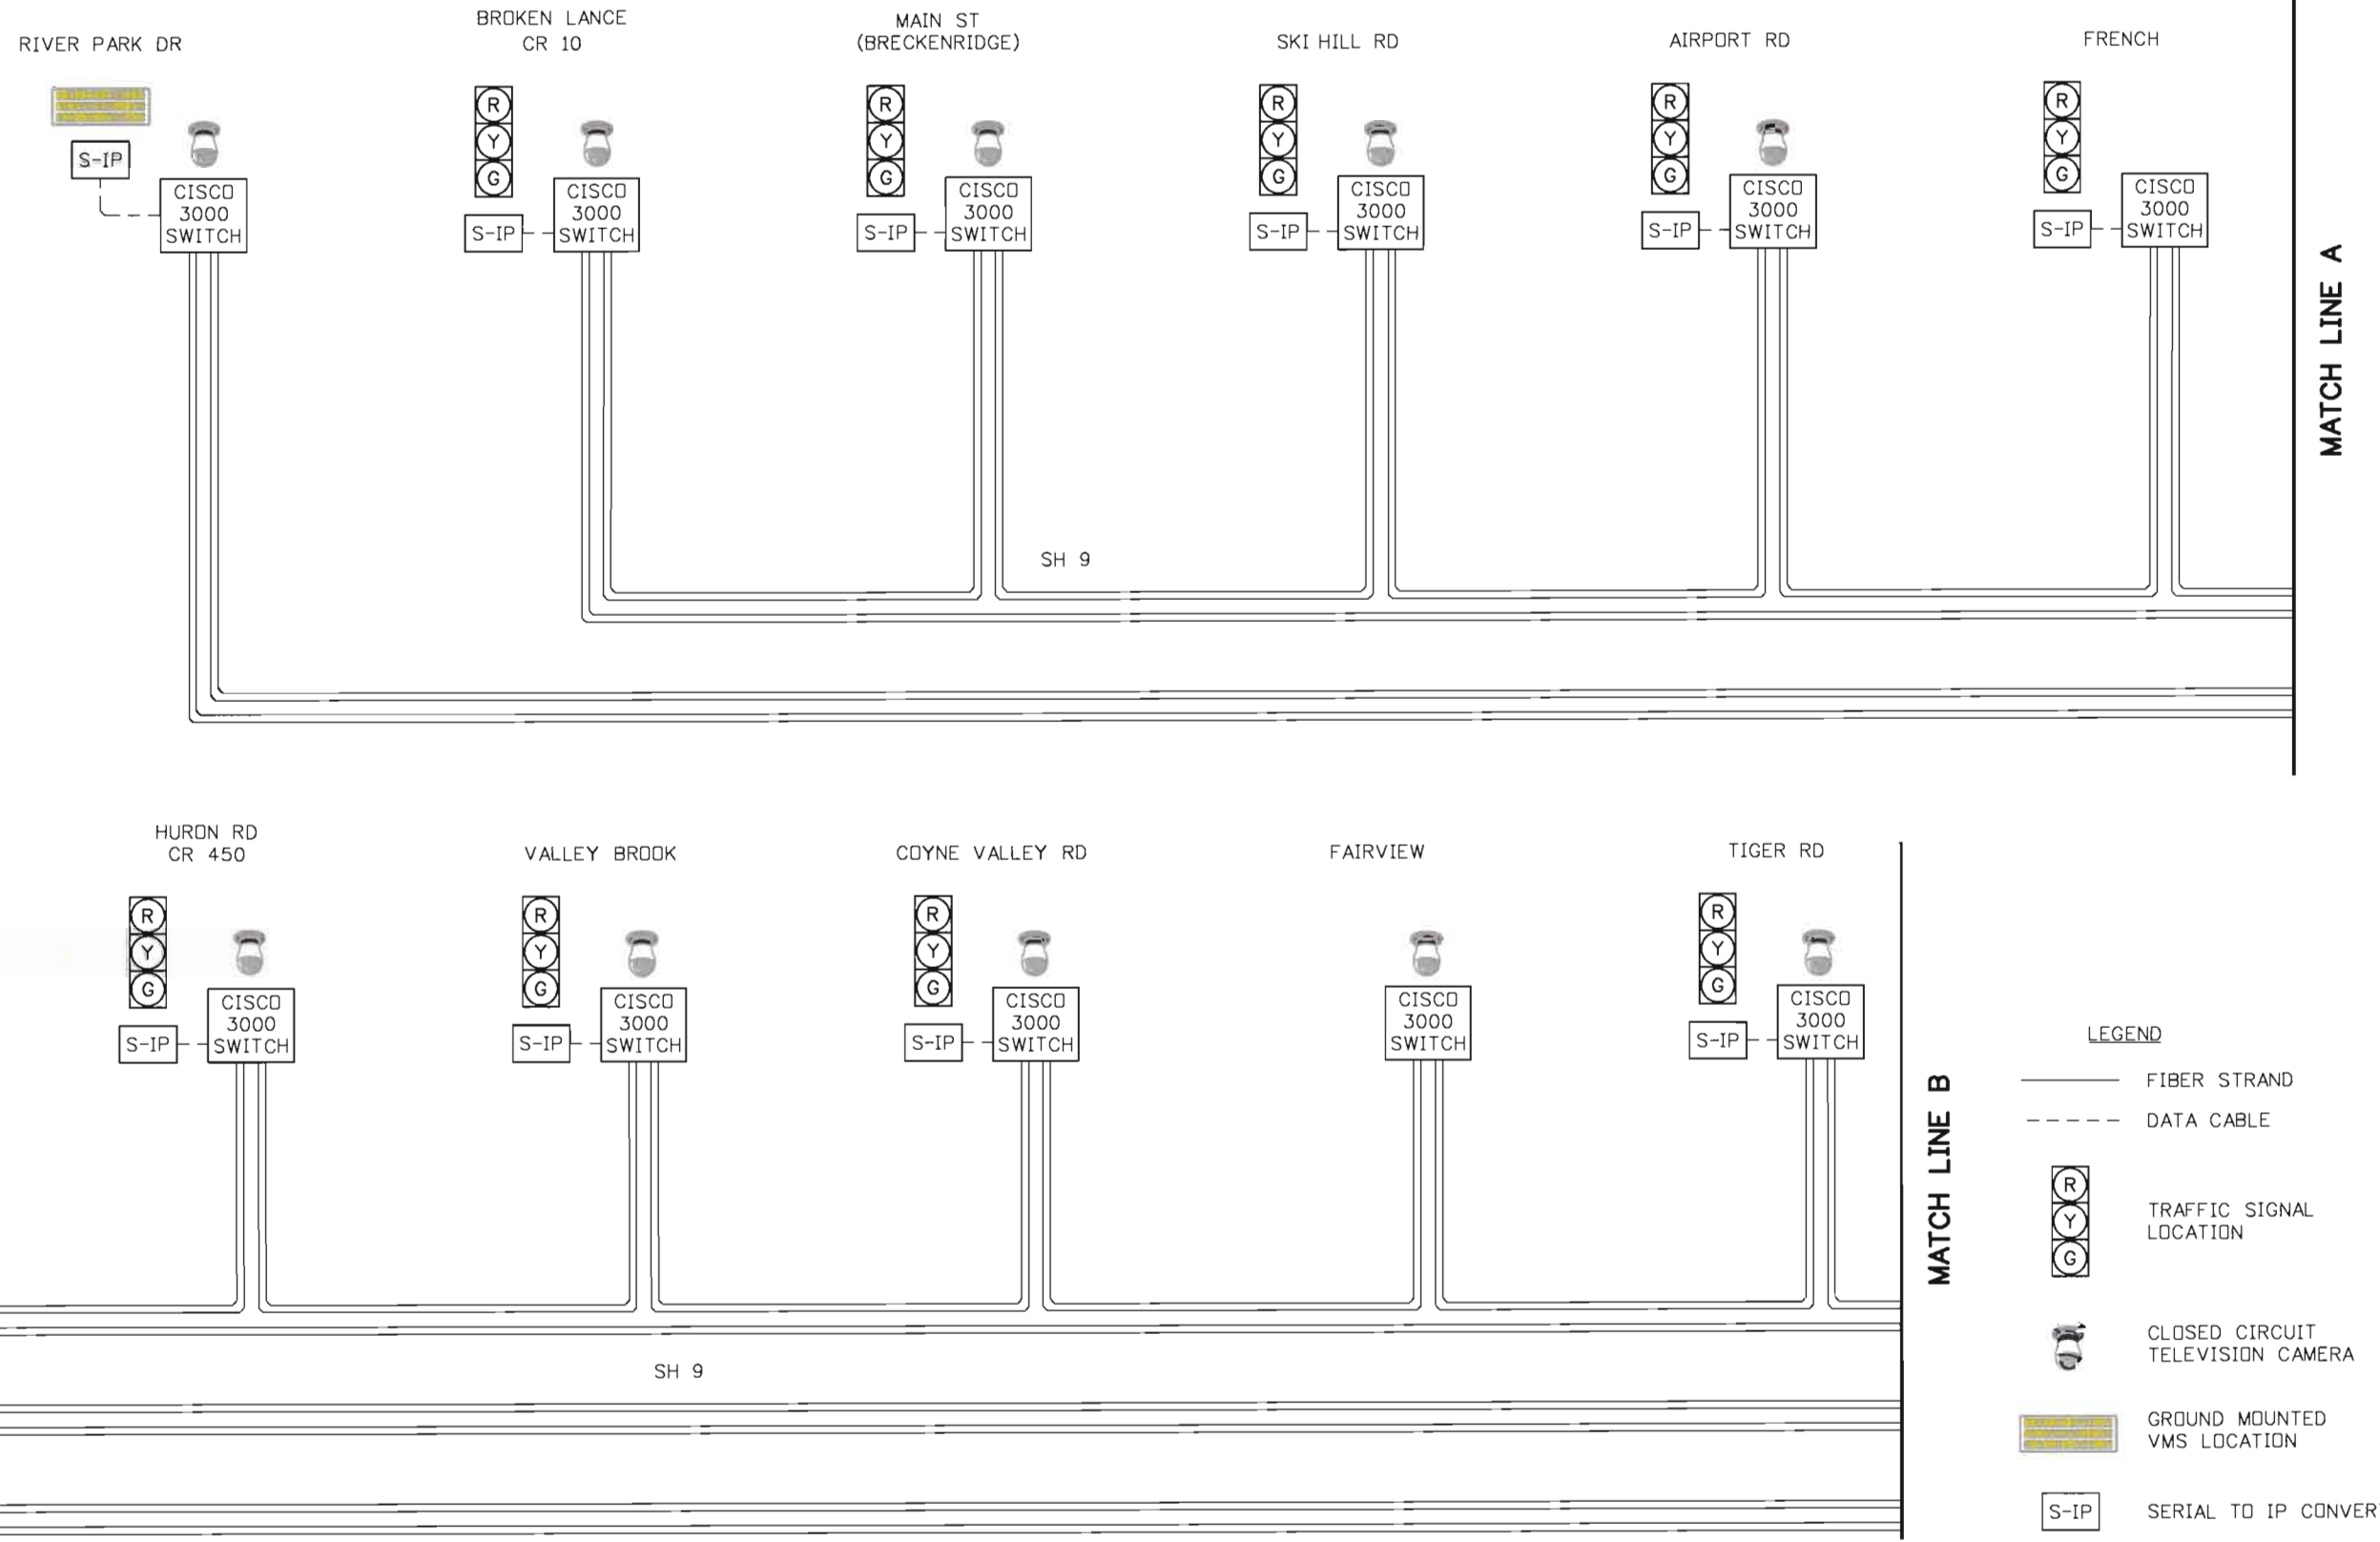

Print Date: 5/1/2012	
Drawing File Name: 18777TRAF_Network01.dgn	
Horiz. Scale: NOT TO SCALE	Vert. Scale: As Noted
Unit Information	Unit Leader Initials
MULLER	Muller Engineering Co., Inc. Consulting Engineers apexdesign
P10-028.13 - SH 9 Interconnect\Traffic_ITS	

Sheet Revisions		
Date:	Comments	Init.


Colorado Department of Transportation

 18500 East Colfax Avenue
Aurora, CO 80011
Phone: 303-757-9648 FAX: 303-757-9746

Region 1 SS

As Constructed		NETWORK DIAGRAM		Project No./Code
No Revisions:				MTCE 0091-039
Revised:		Designer: C. SIGSBURY	Structure Numbers	18777
Void:		Detailer: C. SIGSBURY		
		Sheet Subset: NETWORK	Subset Sheets: 1 of 2	Sheet Number 57

5/1/2012 4:15:55 PM C:\Apex\Projects\18777\Traffic\ITS\Drawings\18777TRAF_Network02.dgn

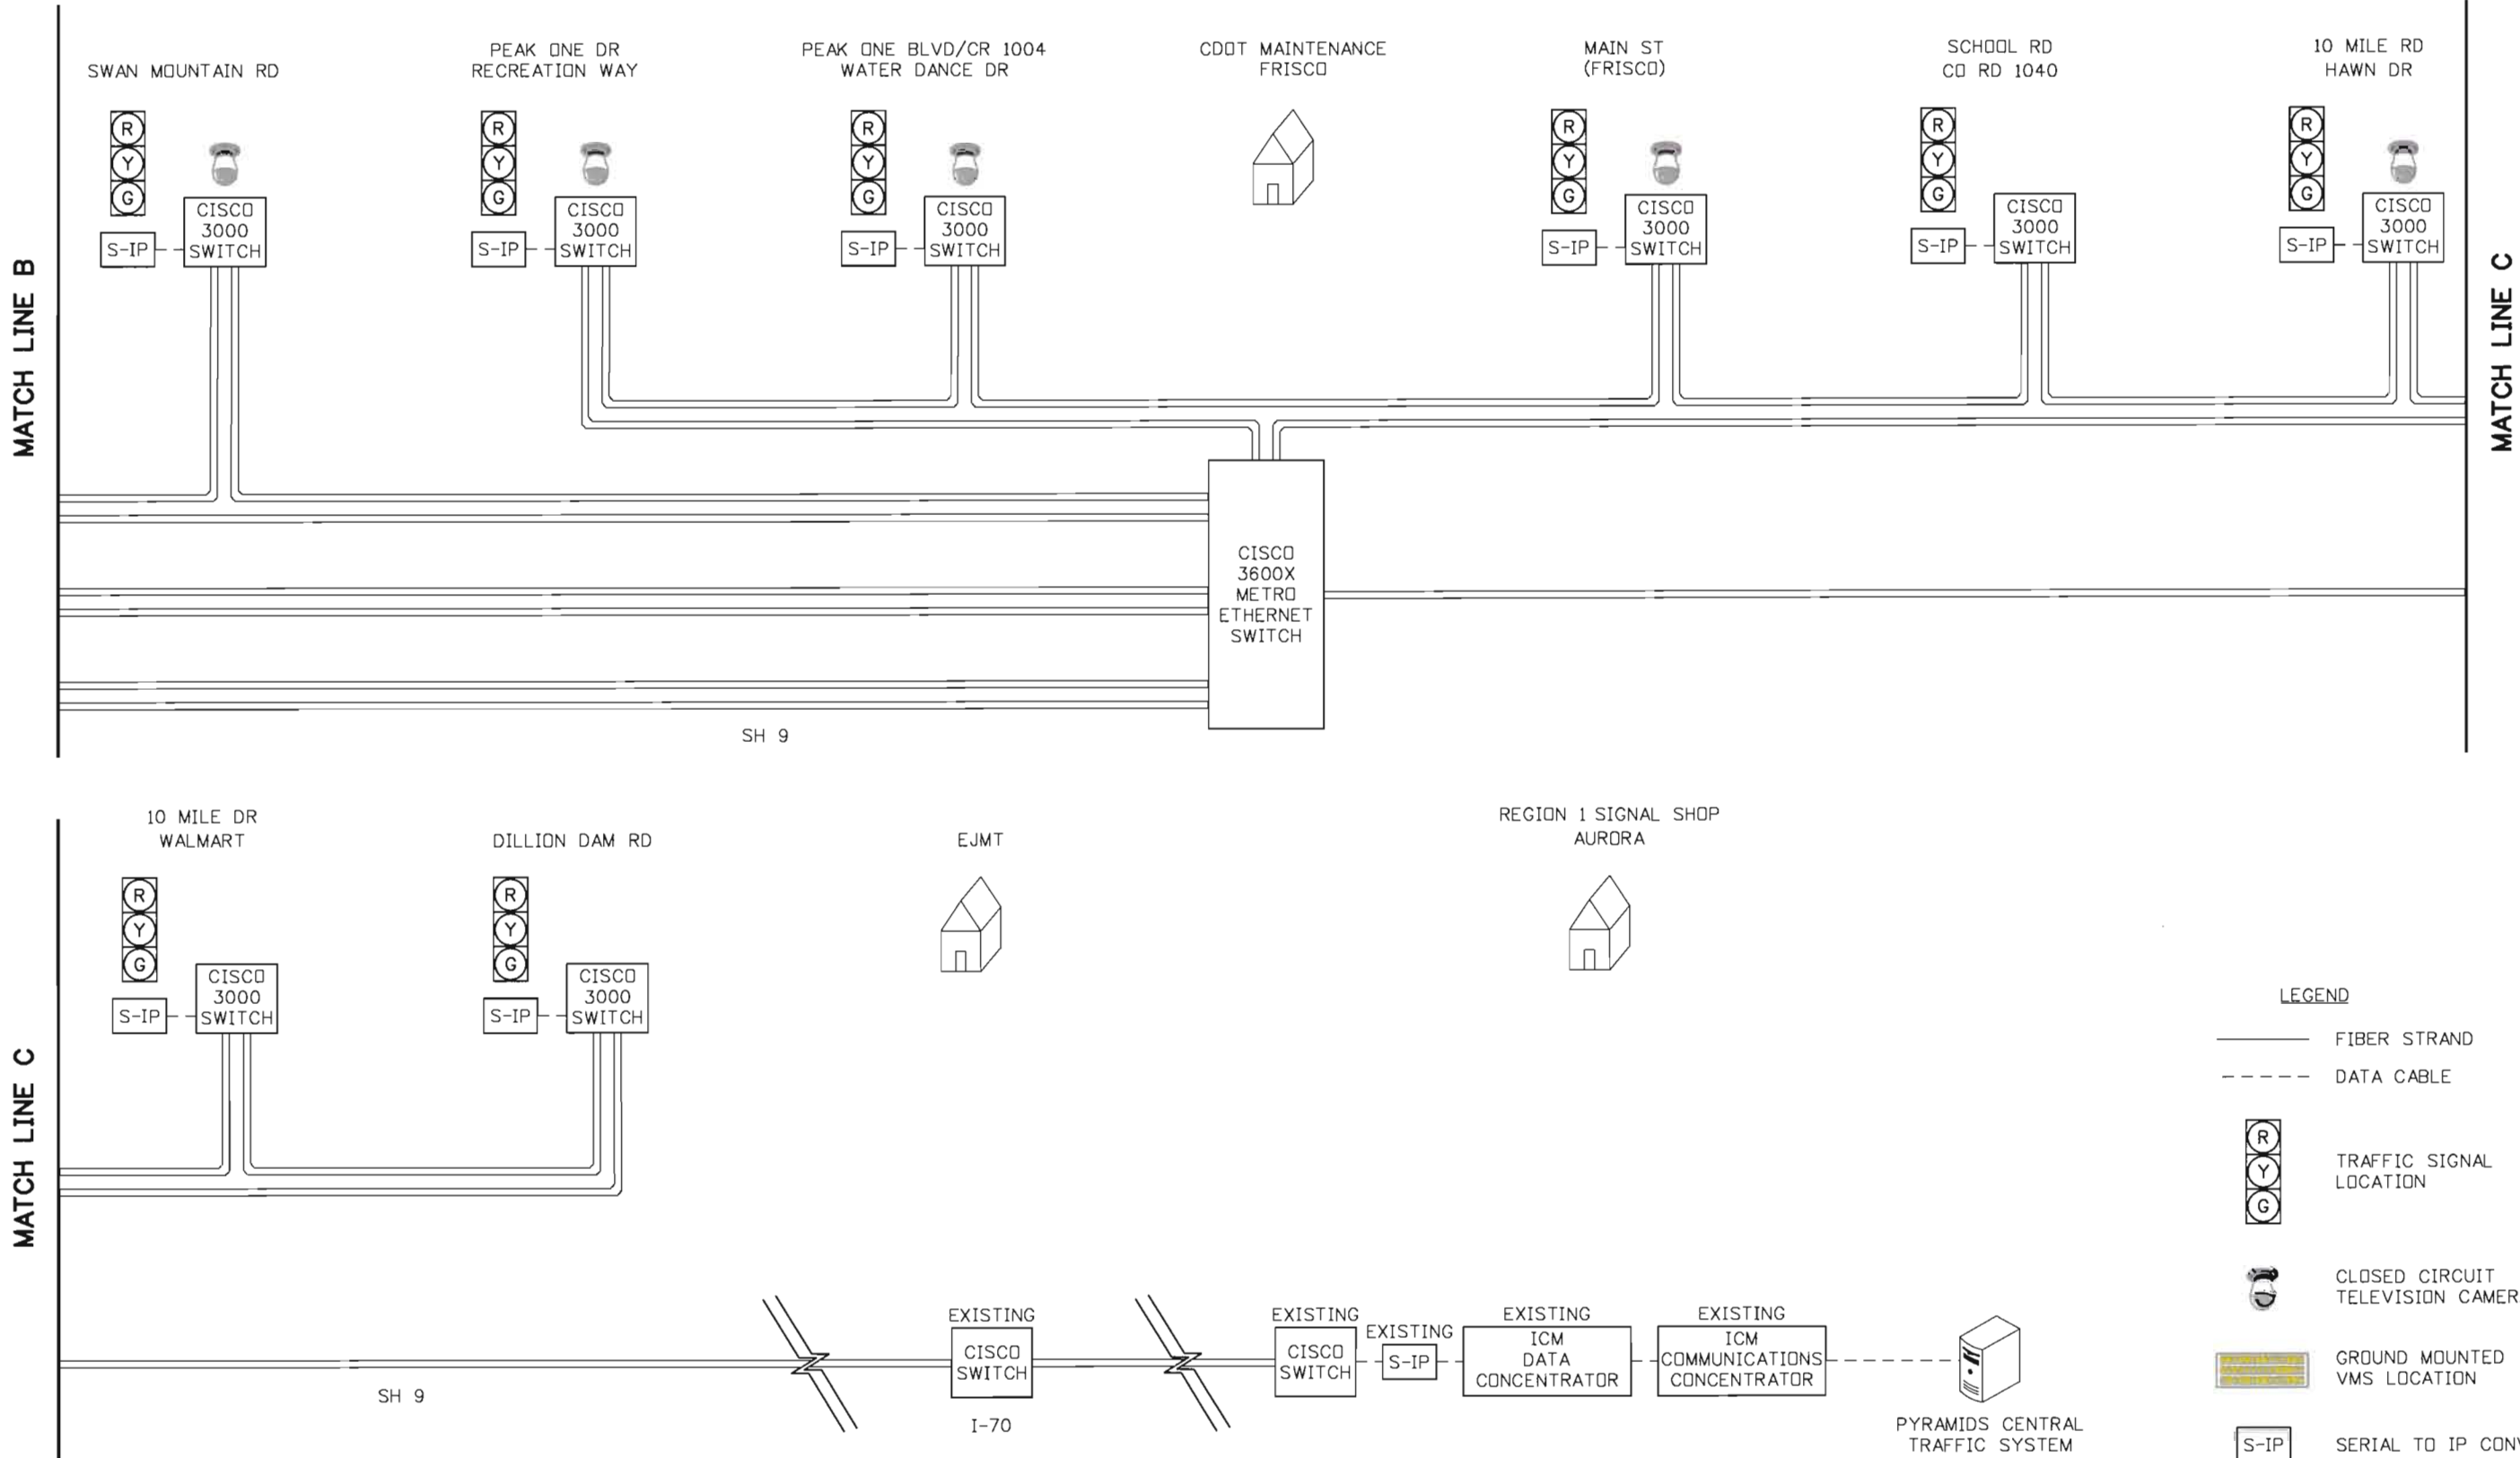

Print Date: 5/1/2012

Drawing File Name: 18777TRAF_Network02.dgn

Hariz. Scale: NOT TO SCALE Vert. Scale: As Noted

Unit Information Unit Leader Initials

MULLER

Muller Engineering Co., Inc.
Consulting Engineers
P:303-028.13 - SH 9 Interconnect\Traffic\ITS

apexdesign

Sheet Revisions		
Date:	Comments	Init.


Colorado Department of Transportation

18500 East Colfax Avenue
Aurora, CO 80011
Phone: 303-757-9648 FAX: 303-757-9746

Region 1

SS

As Constructed		NETWORK DIAGRAM		Project No./Code
No Revisions:		Designer: C. SIGSBURY		MTCE 0091-039
Revised:		Detailer: C. SIGSBURY	Structure Numbers	18777
Void:		Sheet Subset: NETWORK	Subset Sheets: 2 of 2	Sheet Number 58

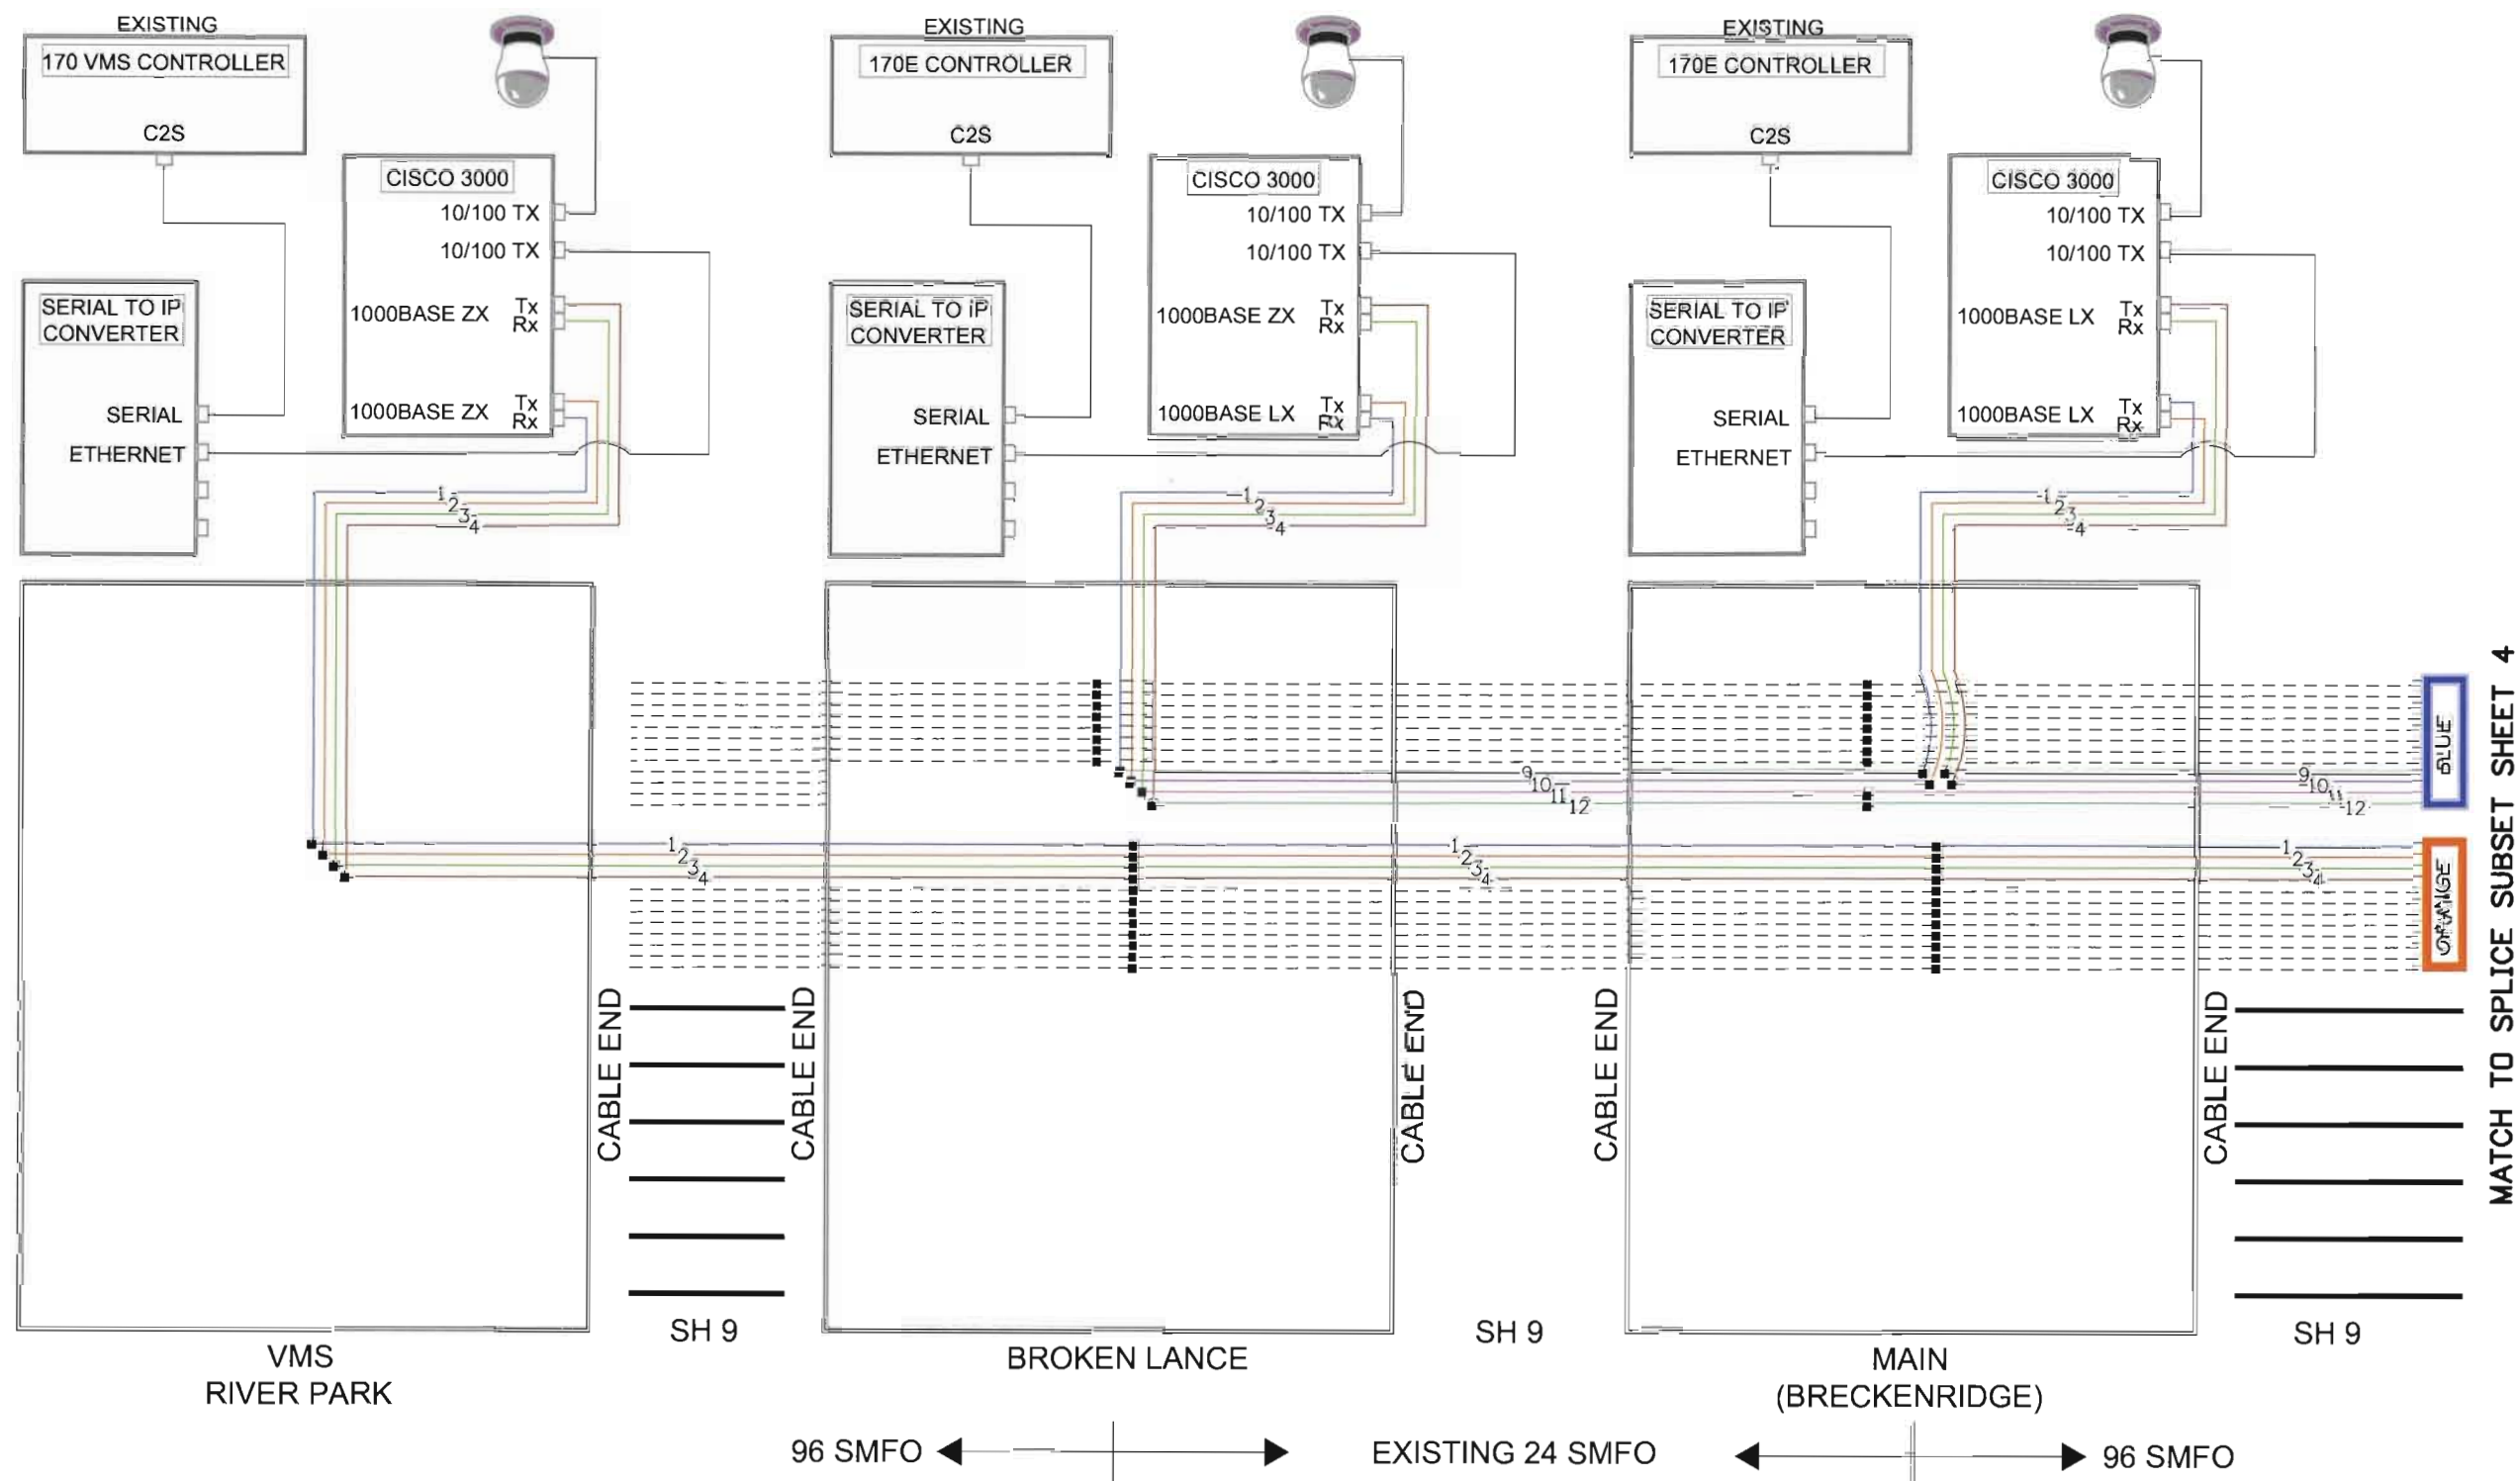

5/1/2012 4:15:55 PM
C:\Apex\Projects\18777\Traffic_ITS\Drawings\18777TRAF_Splice01.dgn

Print Date: 5/1/2012	
Drawing File Name: 18777TRAF_Splice01.dgn	
Horiz. Scale: NDT TO SCALE	Vert. Scale: As Noted
Unit Information	Unit Leader Initials
MULLER Muller Engineering Co., Inc. Consulting Engineers	apexdesign
P:10-028.13 - SH 9 Interconnect\Traffic_ITS	

Sheet Revisions		
Date:	Comments	Init.

Colorado Department of Transportation	
	18500 East Colfax Avenue Aurora, CO 80011 Phone: 303-757-9648 FAX: 303-757-9746
Region 1	SS

As Constructed	SPLICING DIAGRAM		Project No./Code
No Revisions:			MTCE 0091-039
Revised:	Designer: C. SIGSBURY	Structure Numbers	18777
Void:	Detailer: C. SIGSBURY	Sheet Subset: SPLICE	Sheet Number 59
		Subset Sheets: 1 of 19	

5/1/2012 4:15:56 PM C:\Apex\Projects\18777\Traffic_ITS\Drawings\18777TRAF_Splice02.dgn

FIBER CABLE SPLICE TABLE								
VMS ON SH 9/RIVER PARK								
CABLE DESCRIPTION	BUFFER COLOR	FIBER		SPliced TO	CABLE DESCRIPTION	BUFFER COLOR	FIBER	
		NO.	COLOR				NO.	COLOR
96 BACKBONE TO NORTH	ORANGE	1	BLUE		12 LATERAL	BLUE	1	BLUE
96 BACKBONE TO NORTH	ORANGE	2	ORANGE		12 LATERAL	BLUE	2	ORANGE
96 BACKBONE TO NORTH	ORANGE	3	GREEN		12 LATERAL	BLUE	3	GREEN
96 BACKBONE TO NORTH	ORANGE	4	BROWN	12 LATERAL	BLUE	4	BROWN	

PATCH PANEL TABLE					
VMS ON SH 9/RIVER PARK					
CABLE DESCRIPTION	BUFFER COLOR	FIBER		PATCH NO.	PATCHED TO
		NO.	COLOR		
12 LATERAL	BLUE	1	BLUE	1	CISCO RECEIVE
12 LATERAL	BLUE	2	ORANGE	2	CISCO TRANSMIT
12 LATERAL	BLUE	3	GREEN	3	CISCO RECEIVE
12 LATERAL	BLUE	4	BROWN	4	CISCO TRANSMIT

FIBER CABLE SPLICE TABLE								
SH 9/BROKEN LANCE								
CABLE DESCRIPTION	BUFFER COLOR	FIBER			CABLE DESCRIPTION	BUFFER COLOR	FIBER	
		NO.	COLOR				NO.	COLOR
24 BACKBONE TO NORTH	BLUE	9	YELLOW	SPliced TO	12 LATERAL TO TRAFFIC CABINET	BLUE	1	BLUE
24 BACKBONE TO NORTH	BLUE	10	VIOLET		12 LATERAL TO TRAFFIC CABINET	BLUE	2	ORANGE
24 BACKBONE TO NORTH	BLUE	11	ROSE		12 LATERAL TO TRAFFIC CABINET	BLUE	3	GREEN
24 BACKBONE TO NORTH	BLUE	12	AQUA		12 LATERAL TO TRAFFIC CABINET	BLUE	4	BROWN
24 BACKBONE TO NORTH	BLUE	1	BLUE		96 BACKBONE TO SOUTH	BLUE	1	BLUE
24 BACKBONE TO NORTH	BLUE	2	ORANGE		96 BACKBONE TO SOUTH	BLUE	2	ORANGE
24 BACKBONE TO NORTH	BLUE	3	GREEN		96 BACKBONE TO SOUTH	BLUE	3	GREEN
24 BACKBONE TO NORTH	BLUE	4	BROWN		96 BACKBONE TO SOUTH	BLUE	4	BROWN
24 BACKBONE TO NORTH	BLUE	5	SLATE		96 BACKBONE TO SOUTH	BLUE	5	SLATE
24 BACKBONE TO NORTH	BLUE	6	WHITE		96 BACKBONE TO SOUTH	BLUE	6	WHITE
24 BACKBONE TO NORTH	BLUE	7	RED		96 BACKBONE TO SOUTH	BLUE	7	RED
24 BACKBONE TO NORTH	BLUE	8	BLACK		96 BACKBONE TO SOUTH	BLUE	8	BLACK
24 BACKBONE TO NORTH	ORANGE	1	BLUE		96 BACKBONE TO SOUTH	ORANGE	1	BLUE
24 BACKBONE TO NORTH	ORANGE	2	ORANGE		96 BACKBONE TO SOUTH	ORANGE	2	ORANGE
24 BACKBONE TO NORTH	ORANGE	3	GREEN		96 BACKBONE TO SOUTH	ORANGE	3	GREEN
24 BACKBONE TO NORTH	ORANGE	4	BROWN		96 BACKBONE TO SOUTH	ORANGE	4	BROWN
24 BACKBONE TO NORTH	ORANGE	5	SLATE		96 BACKBONE TO SOUTH	ORANGE	5	SLATE
24 BACKBONE TO NORTH	ORANGE	6	WHITE		96 BACKBONE TO SOUTH	ORANGE	6	WHITE
24 BACKBONE TO NORTH	ORANGE	7	RED		96 BACKBONE TO SOUTH	ORANGE	7	RED
24 BACKBONE TO NORTH	ORANGE	8	BLACK		96 BACKBONE TO SOUTH	ORANGE	8	BLACK
24 BACKBONE TO NORTH	ORANGE	9	YELLOW		96 BACKBONE TO SOUTH	ORANGE	9	YELLOW
24 BACKBONE TO NORTH	ORANGE	10	VIOLET		96 BACKBONE TO SOUTH	ORANGE	10	VIOLET
24 BACKBONE TO NORTH	ORANGE	11	ROSE		96 BACKBONE TO SOUTH	ORANGE	11	ROSE
24 BACKBONE TO NORTH	ORANGE	12	AQUA		96 BACKBONE TO SOUTH	ORANGE	12	AQUA

PATCH PANEL TABLE					
SH 9/BROKEN LANCE					
CABLE DESCRIPTION	BUFFER COLOR	FIBER		PATCH NO.	PATCHED TO
		NO.	COLOR		
12 LATERAL TO TRAFFIC CABINET	BLUE	1	BLUE	1	CISCO RECEIVE
12 LATERAL TO TRAFFIC CABINET	BLUE	2	ORANGE	2	CISCO TRANSMIT
12 LATERAL TO TRAFFIC CABINET	BLUE	3	GREEN	3	CISCO RECEIVE
12 LATERAL TO TRAFFIC CABINET	BLUE	4	BROWN	4	CISCO TRANSMIT

Print Date: 5/1/2012	
Drawing File Name: 18777TRAF_Splice02.dgn	
Horiz. Scale: NOT TO SCALE	Vert. Scale: As Noted
Unit Information Unit Leader Initials	
	Muller Engineering Co., Inc. Consulting Engineers P:10-028.13 - SH 9 Interconnect\Traffic_ITS

Sheet Revisions		
Date:	Comments	Init.

Colorado Department of Transportation	
	18500 East Colfax Avenue Aurora, CO 80011 Phone: 303-757-9648 FAX: 303-757-9746
Region 1	SS

As Constructed		SPLICING TABLES		Project No./Code	
No Revisions:				MTCE 0091-039	
Revised:		Designer: C. SIGSBURY	Structure Numbers	18777	
Void:		Detailer: C. SIGSBURY			
		Sheet Subset: SPLICE	Subset Sheets: 2 of 19	Sheet Number	60

5/1/2012 4:16:03 PM C:\Apex\Projects\18777\Traffic_ITS\Drawings\18777TRAF_Splice03.dgn

FIBER CABLE SPLICE TABLE SH 9/MAIN STREET								
CABLE DESCRIPTION	BUFFER COLOR	FIBER			CABLE DESCRIPTION	BUFFER COLOR	FIBER	
		NO.	COLOR				NO.	COLOR
96 BACKBONE TO SOUTH	BLUE	9	YELLOW	SPliced TO	12 LATERAL TO TRAFFIC CABINET	BLUE	1	BLUE
96 BACKBONE TO SOUTH	BLUE	10	VIOLET		12 LATERAL TO TRAFFIC CABINET	BLUE	2	ORANGE
96 BACKBONE TO NORTH	BLUE	9	YELLOW		12 LATERAL TO TRAFFIC CABINET	BLUE	3	GREEN
96 BACKBONE TO NORTH	BLUE	10	VIOLET		12 LATERAL TO TRAFFIC CABINET	BLUE	4	BROWN
96 BACKBONE TO NORTH	BLUE	1	BLUE		24 BACKBONE TO SOUTH	BLUE	1	BLUE
96 BACKBONE TO NORTH	BLUE	2	ORANGE		24 BACKBONE TO SOUTH	BLUE	2	ORANGE
96 BACKBONE TO NORTH	BLUE	3	GREEN		24 BACKBONE TO SOUTH	BLUE	3	GREEN
96 BACKBONE TO NORTH	BLUE	4	BROWN		24 BACKBONE TO SOUTH	BLUE	4	BROWN
96 BACKBONE TO NORTH	BLUE	5	SLATE		24 BACKBONE TO SOUTH	BLUE	5	SLATE
96 BACKBONE TO NORTH	BLUE	6	WHITE		24 BACKBONE TO SOUTH	BLUE	6	WHITE
96 BACKBONE TO NORTH	BLUE	7	RED		24 BACKBONE TO SOUTH	BLUE	7	RED
96 BACKBONE TO NORTH	BLUE	8	BLACK		24 BACKBONE TO SOUTH	BLUE	8	BLACK
96 BACKBONE TO NORTH	BLUE	11	ROSE		24 BACKBONE TO SOUTH	BLUE	11	ROSE
96 BACKBONE TO NORTH	BLUE	12	AQUA		24 BACKBONE TO SOUTH	BLUE	12	AQUA
96 BACKBONE TO NORTH	ORANGE	1	BLUE		24 BACKBONE TO SOUTH	ORANGE	1	BLUE
PATCH PANEL TABLE SH 9/MAIN STREET					
CABLE DESCRIPTION	BUFFER COLOR	FIBER		PATCH NO.	PATCHED TO
		NO.	COLOR		
12 LATERAL TO TRAFFIC CABINET	BLUE	1	BLUE	1	CISCO TRANSMIT
12 LATERAL TO TRAFFIC CABINET	BLUE	2	ORANGE	2	CISCO RECEIVE
12 LATERAL TO TRAFFIC CABINET	BLUE	3	GREEN	3	CISCO RECEIVE
12 LATERAL TO TRAFFIC CABINET	BLUE	4	BROWN	4	CISCO TRANSMIT

Print Date: 5/1/2012	
Drawing File Name: 18777TRAF_Splice03.dgn	
Horiz. Scale: NOT TO SCALE	Vert. Scale: As Noted
Unit Information Unit Leader Initials	
<div><div><div>MULLER</div><div>Muller Engineering Co., Inc. Consulting Engineers</div></div><div>apexdesign</div></div>	
P:10-028.13 - SH 9 Interconnect\Traffic_ITS	

Sheet Revisions		
Date:	Comments	Init.

Colorado Department of Transportation	
<div><div><div><div></div><div>DOT</div></div><div>DEPARTMENT OF TRANSPORTATION</div></div><div>18500 East Colfax Avenue Aurora, CO 80011 Phone: 303-757-9648 FAX: 303-757-9746</div></div>	
Region 1	SS


As Constructed		SPLICING TABLES			Project No./Code	
No Revisions:					MTCE 0091-039	
Revised:		Designer: C. SIGSBURY	Structure Numbers	18777		
		Detailer: C. SIGSBURY				
Void:		Sheet Subset: SPLICE	Subset Sheets: 3 of 19		Sheet Number 61	

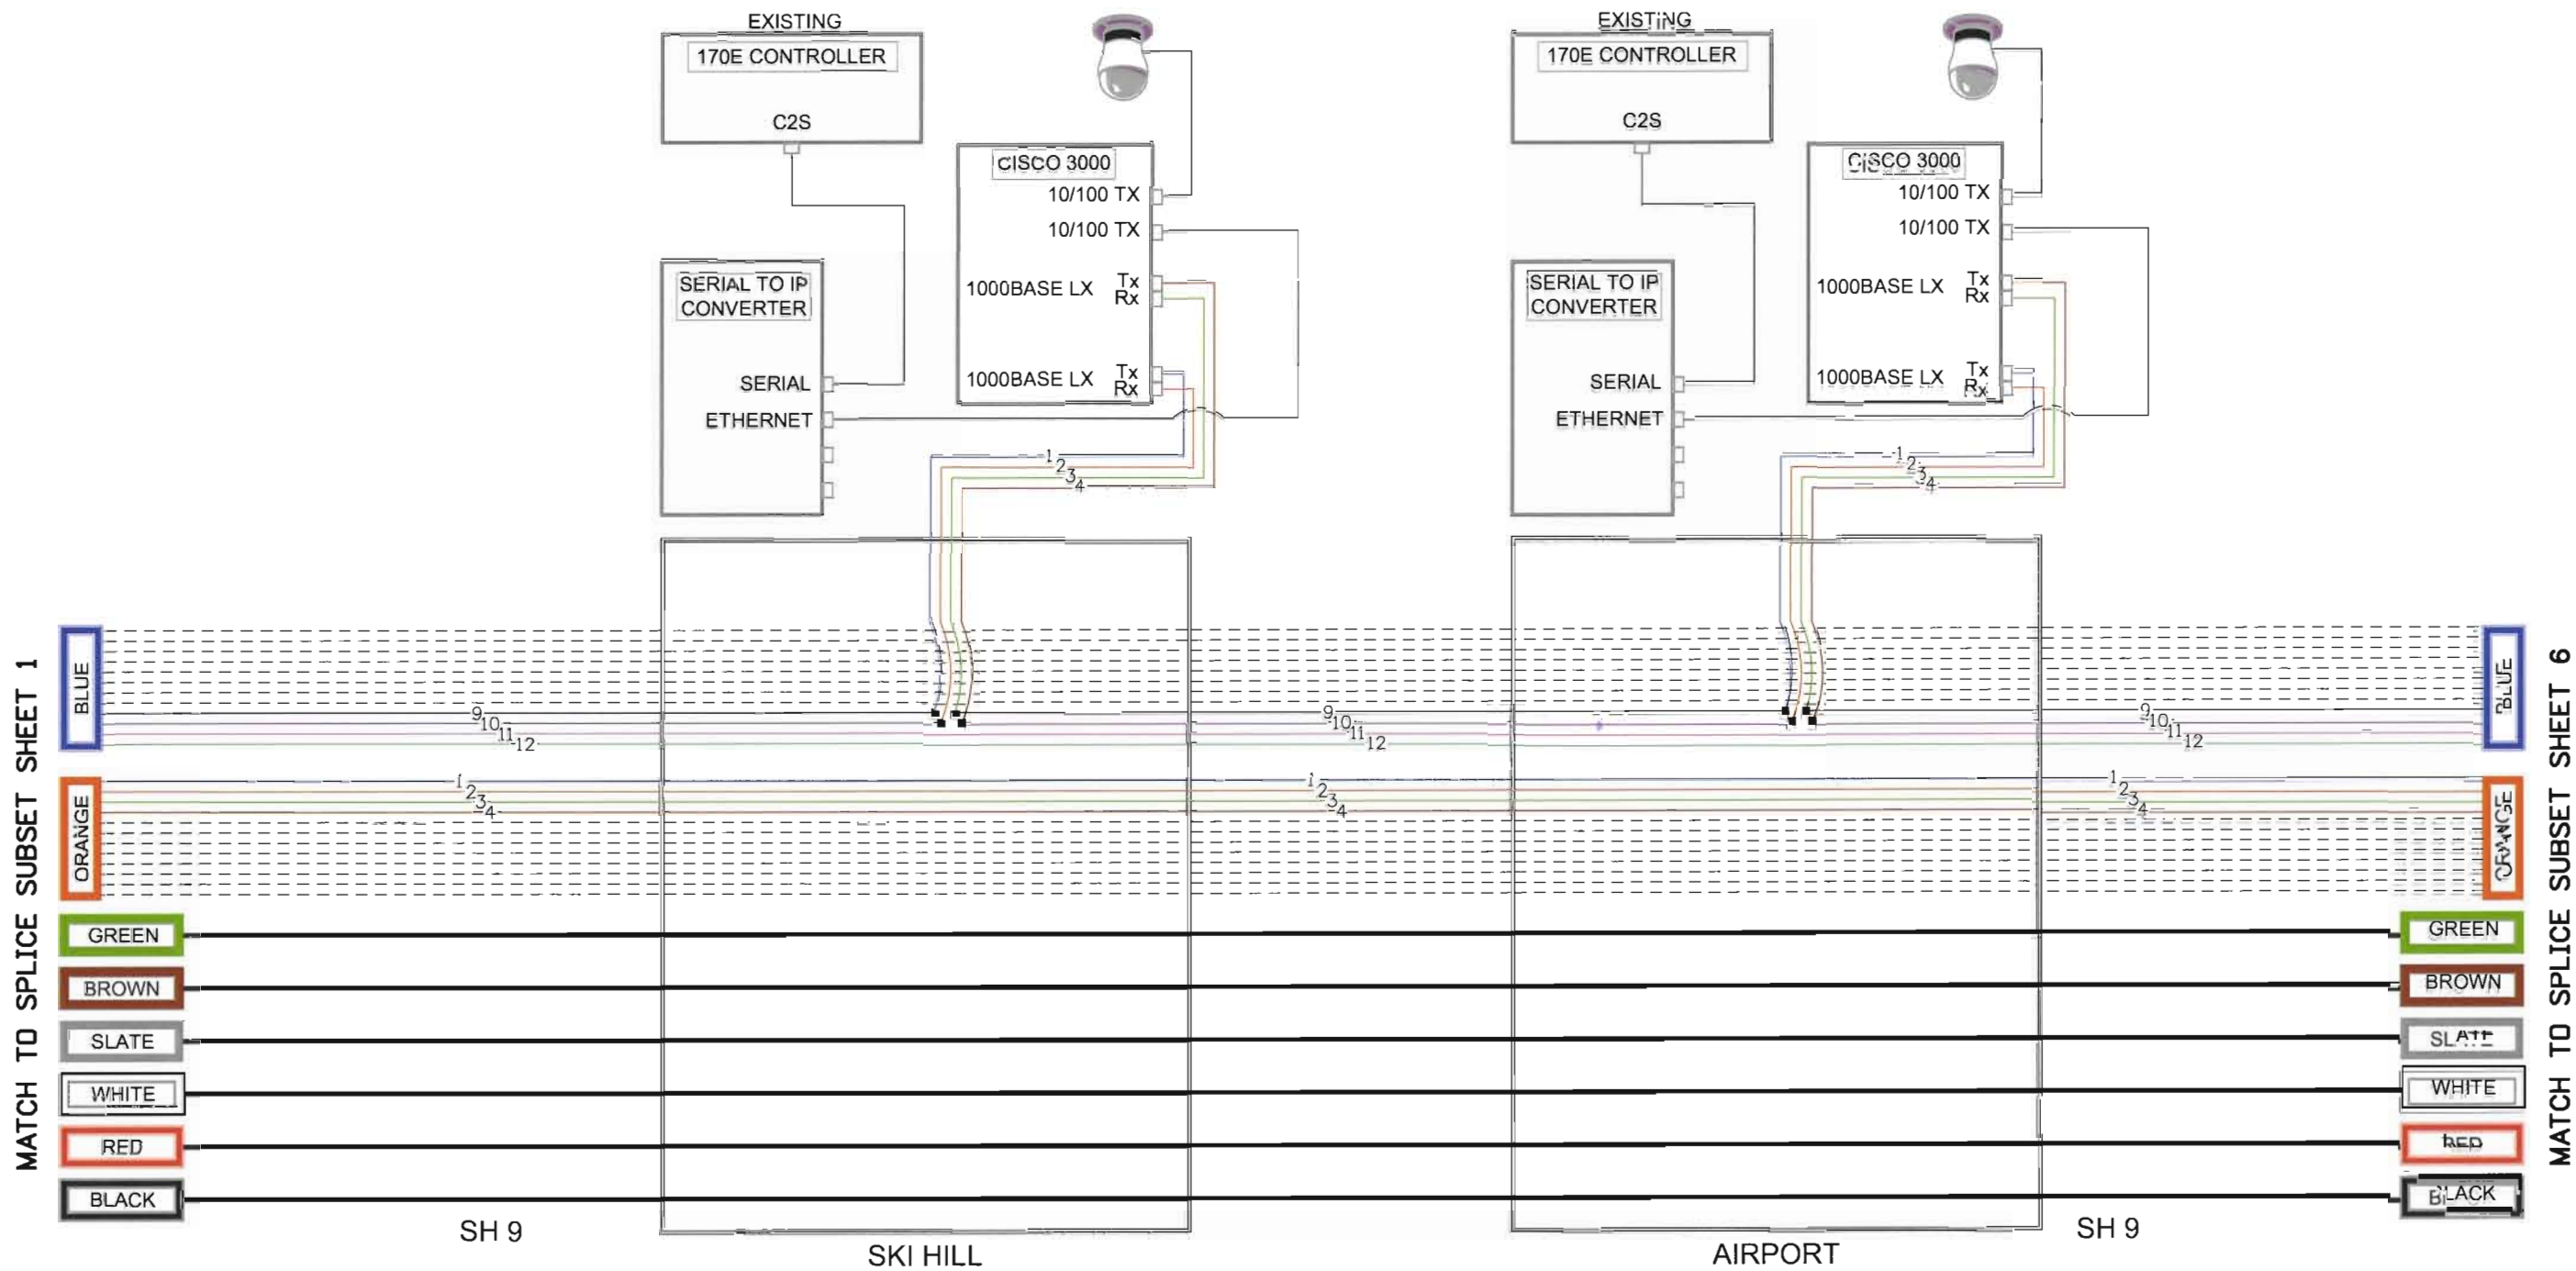

5/1/2012 4:16:07 PM
C:\Apex\Projects\18777\Traffic_ITS\Drawings\18777TRAF_Splice04.dgn

Print Date: 5/1/2012	
Drawing File Name: 18777TRAF_Splice04.dgn	
Horiz. Scale: NOT TO SCALE	Vert. Scale: As Noted
Unit Information	
Unit Leader Initials	
MULLER Muller Engineering Co., Inc. Consulting Engineers	
apexdesign	
P10-028.13 - SH 9 Interconnect\Traffic_ITS	

Sheet Revisions		
Date:	Comments	Init.



Colorado Department of Transportation
18500 East Colfax Avenue
Aurora, CO 80011
Phone: 303-757-9648 FAX: 303-757-9746
Region 1

SS

As Constructed		SPLICING DIAGRAM			Project No./Code	
No Revisions:					MTCE 0091-039	
Revised:		Designer: C. SIGSBURY	Structure		18777	
		Detailer: C. SIGSBURY	Numbers			
Void:		Sheet Subset: SPLICE	Subset Sheets:	4 of 19	Sheet Number	62

FIBER CABLE SPLICE TABLE								
SH 9/SKI HILL ROAD								
CABLE DESCRIPTION	BUFFER COLOR	FIBER		SPliced TO	CABLE DESCRIPTION	BUFFER COLOR	FIBER	
		NO.	COLOR				NO.	COLOR
96 BACKBONE TO SOUTH	BLUE	9	YELLOW		12 LATERAL TO TRAFFIC CABINET	BLUE	1	BLUE
96 BACKBONE TO SOUTH	BLUE	10	VIOLET		12 LATERAL TO TRAFFIC CABINET	BLUE	2	ORANGE
96 BACKBONE TO NORTH	BLUE	9	YELLOW		12 LATERAL TO TRAFFIC CABINET	BLUE	3	GREEN
96 BACKBONE TO NORTH	BLUE	10	VIOLET		12 LATERAL TO TRAFFIC CABINET	BLUE	4	BROWN

PATCH PANEL TABLE SH 9/SKI HILL ROAD					
CABLE DESCRIPTION	BUFFER COLOR	FIBER		PATCH NO.	PATCHED TO
		NO.	COLOR		
12 LATERAL TO TRAFFIC CABINET	BLUE	1	BLUE	1	CISCO TRANSMIT
12 LATERAL TO TRAFFIC CABINET	BLUE	2	ORANGE	2	CISCO RECEIVE
12 LATERAL TO TRAFFIC CABINET	BLUE	3	GREEN	3	CISCO RECEIVE
12 LATERAL TO TRAFFIC CABINET	BLUE	4	BROWN	4	CISCO TRANSMIT

FIBER CABLE SPLICE TABLE SH 9/AIRPORT								
CABLE DESCRIPTION	BUFFER COLOR	FIBER		SPliced TO	CABLE DESCRIPTION	BUFFER COLOR	FIBER	
		NO.	COLOR				NO.	COLOR
96 BACKBONE TO SOUTH	BLUE	9	YELLOW		12 LATERAL TO TRAFFIC CABINET	BLUE	1	BLUE
96 BACKBONE TO SOUTH	BLUE	10	VIOLET		12 LATERAL TO TRAFFIC CABINET	BLUE	2	ORANGE
96 BACKBONE TO NORTH	BLUE	9	YELLOW		12 LATERAL TO TRAFFIC CABINET	BLUE	3	GREEN
96 BACKBONE TO NORTH	BLUE	10	VIOLET		12 LATERAL TO TRAFFIC CABINET	BLUE	4	BROWN

PATCH PANEL TABLE SH 9/AIRPORT					
CABLE DESCRIPTION	BUFFER COLOR	FIBER		PATCH NO.	PATCHED TO
		NO.	COLOR		
12 LATERAL TO TRAFFIC CABINET	BLUE	1	BLUE	1	CISCO TRANSMIT
12 LATERAL TO TRAFFIC CABINET	BLUE	2	ORANGE	2	CISCO RECEIVE
12 LATERAL TO TRAFFIC CABINET	BLUE	3	GREEN	3	CISCO RECEIVE
12 LATERAL TO TRAFFIC CABINET	BLUE	4	BROWN	4	CISCO TRANSMIT

5/1/2012 4:16:09 PM C:\Apex\Projects\18777\Traffic\ITS\Drawings\18777TRAF_Splice05.dgn

Print Date: 5/1/2012

Drawing File Name: 18777TRAF_Splice05.dgn

Horiz. Scale: NDT TO SCALE Vert. Scale: As Noted

Unit Information Unit Leader Initials

MULLER

Muller Engineering Co., Inc.
Consulting Engineers

apexdesign

P:10-028.13 - SH 9 Interconnect\Traffic_ITS

Sheet Revisions		
Date:	Comments	Init.

Colorado Department of Transportation




18500 East Colfax Avenue
Aurora, CO 80011
Phone: 303-757-9648 FAX: 303-757-9746


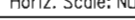
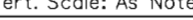
Region 1

SS

As Constructed	SPLICING TABLES			Project No./Code
No Revisions:				MTCE 0091-039
Revised:	Designer: C. SIGSBURY	Structure Numbers		18777
Void:	Detailer: C. SIGSBURY			
	Sheet Subset: SPLICE	Subset Sheets: 5 of 19		Sheet Number 63

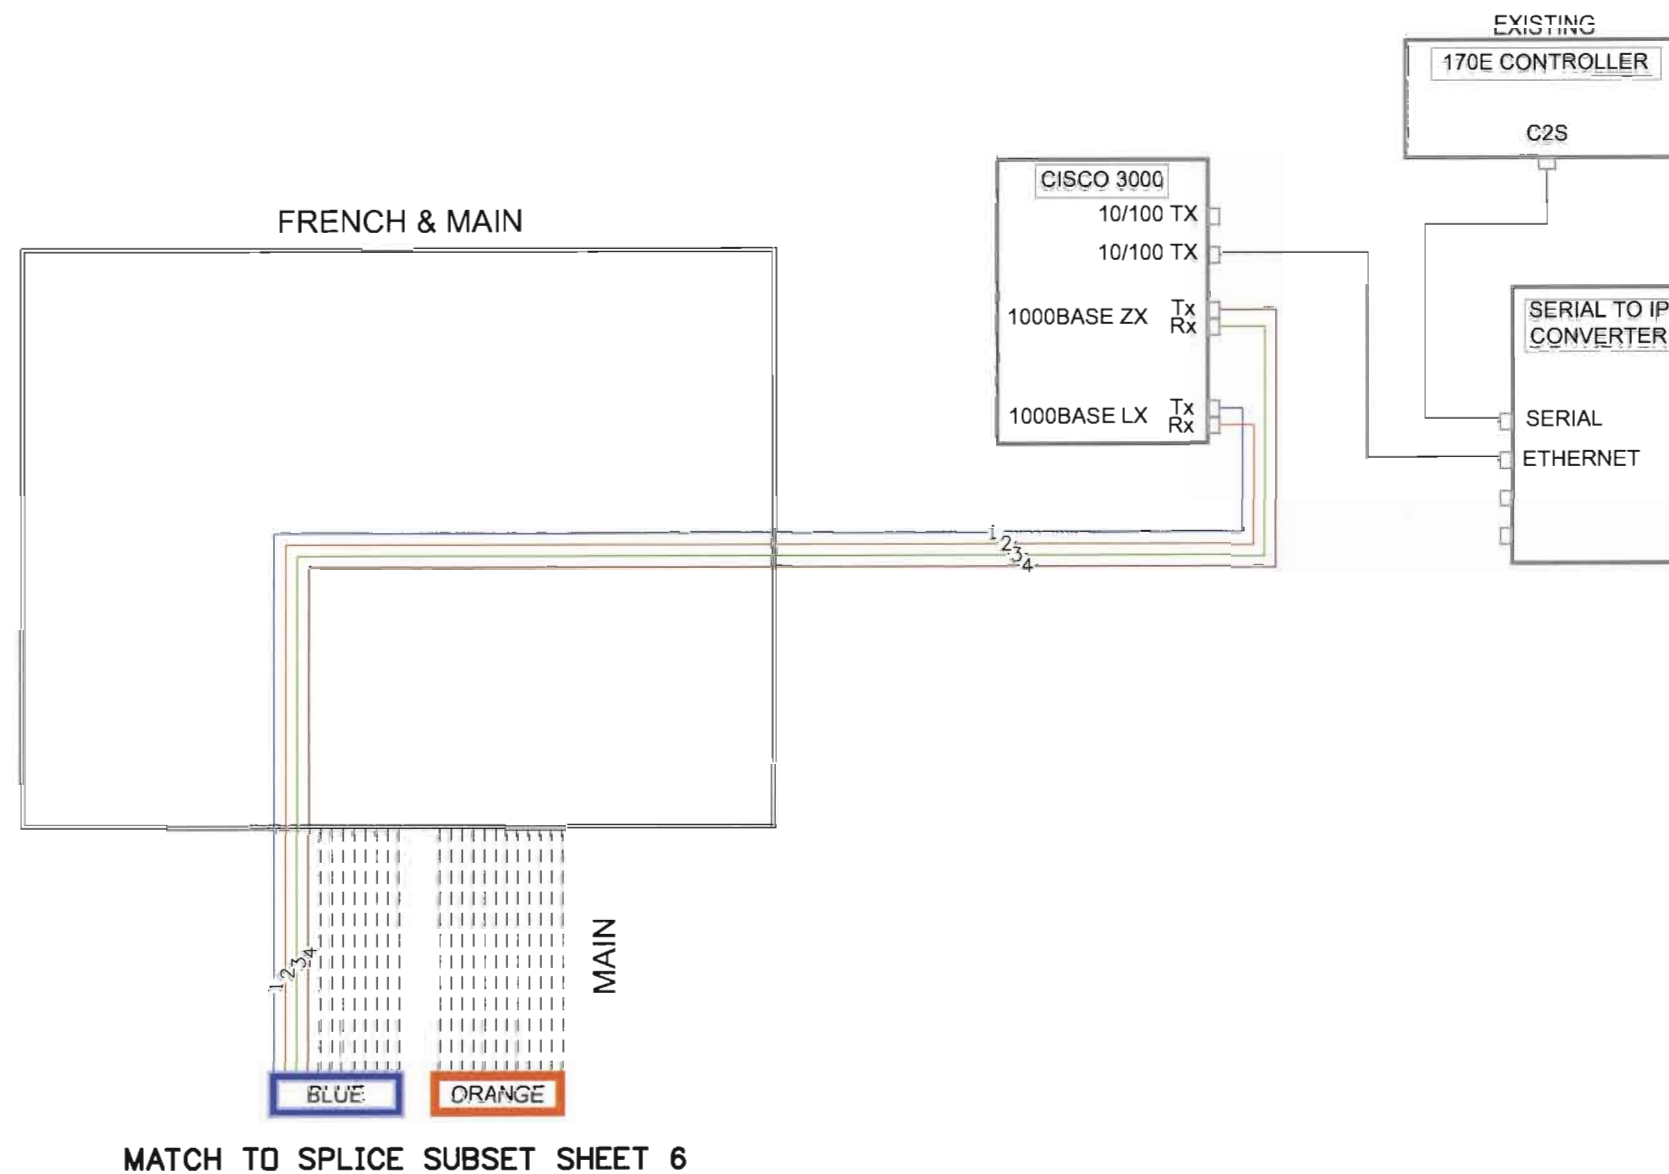

5/1/2012 4:16:19 PM C:\Apex\Projects\18777\Traffic_ITS\Drawings\18777TRAF_Splice08.dgn

Print Date: 5/1/2012		Sheet Revisions			Colorado Department of Transportation		As Constructed		SPLICING DIAGRAM			Project No./Code	
Drawing File Name: 18777TRAF_Splice08.dgn							No Revisions:					MTCE 0091-039	
Horiz. Scale: NOT TO SCALE		Date:		Comments	Init.	 18500 East Colfax Avenue Aurora, CO 80011 Phone: 303-757-9648 FAX: 303-757-9746 Region 1 SS		Revised:		Designer: C. SIGSBURY	Structure	18777	
Unit Information								Void:		Detailer: C. SIGSBURY	Numbers		
										Sheet Subset: SPLICE	Subset Sheets:	8 of 19	Sheet Number 66
 Muller Engineering Co., Inc. Consulting Engineers P:10-028.13 - SH 9 Interconnect\Traffic-ITS													

MULLER

Muller Engineering Co., Inc.
Consulting Engineers

apexdesign


P:10-028.13 - SH 9 Interconnect\Traffic_ITS

PATCH PANEL TABLE					
FRENCH/MAIN					
CABLE DESCRIPTION	BUFFER COLOR	FIBER		PATCH NO.	PATCHED TO
		NO.	COLOR		
24 LATERAL TO NORTH	BLUE	1	BLUE	1	CISCO TRANSMIT
24 LATERAL TO NORTH	BLUE	2	ORANGE	2	CISCO RECEIVE
24 LATERAL TO NORTH	BLUE	3	GREEN	3	CISCO RECEIVE
24 LATERAL TO NORTH	BLUE	4	BROWN	4	CISCO TRANSMIT

5/1/2012 4:16:20 PM C:\Apex\Projects\18777\Traffic\ITS\Drawings\18777TRAF_Splice09.dgn

Print Date: 5/1/2012	
Drawing File Name: 18777TRAF_Splice09.dgn	
Horiz. Scale: NOT TO SCALE	Vert. Scale: As Noted
Unit Information	Unit Leader Initials
<div><div>MULLER</div><div>Muller Engineering Co., Inc. Consulting Engineers</div></div>	<div><div>apexdesign</div><div>P:10-028.13 - SH 9 Interconnect\Traffic\ITS</div></div>

Sheet Revisions		
Date:	Comments	Init.



Region 1

SS


Colorado Department of Transportation

18500 East Colfax Avenue
Aurora, CO 80011
Phone: 303-757-9648 FAX: 303-757-9746

As Constructed
No Revisions:
Revised:
Void:

SPLICING TABLES		
Designer: C. SIGSBURY	Structure	
Detailer: C. SIGSBURY	Numbers	
Sheet Subset: SPLICE	Subset Sheets:	9 of 19

Project No./Code
MTCE 0091-039
18777
Sheet Number 67

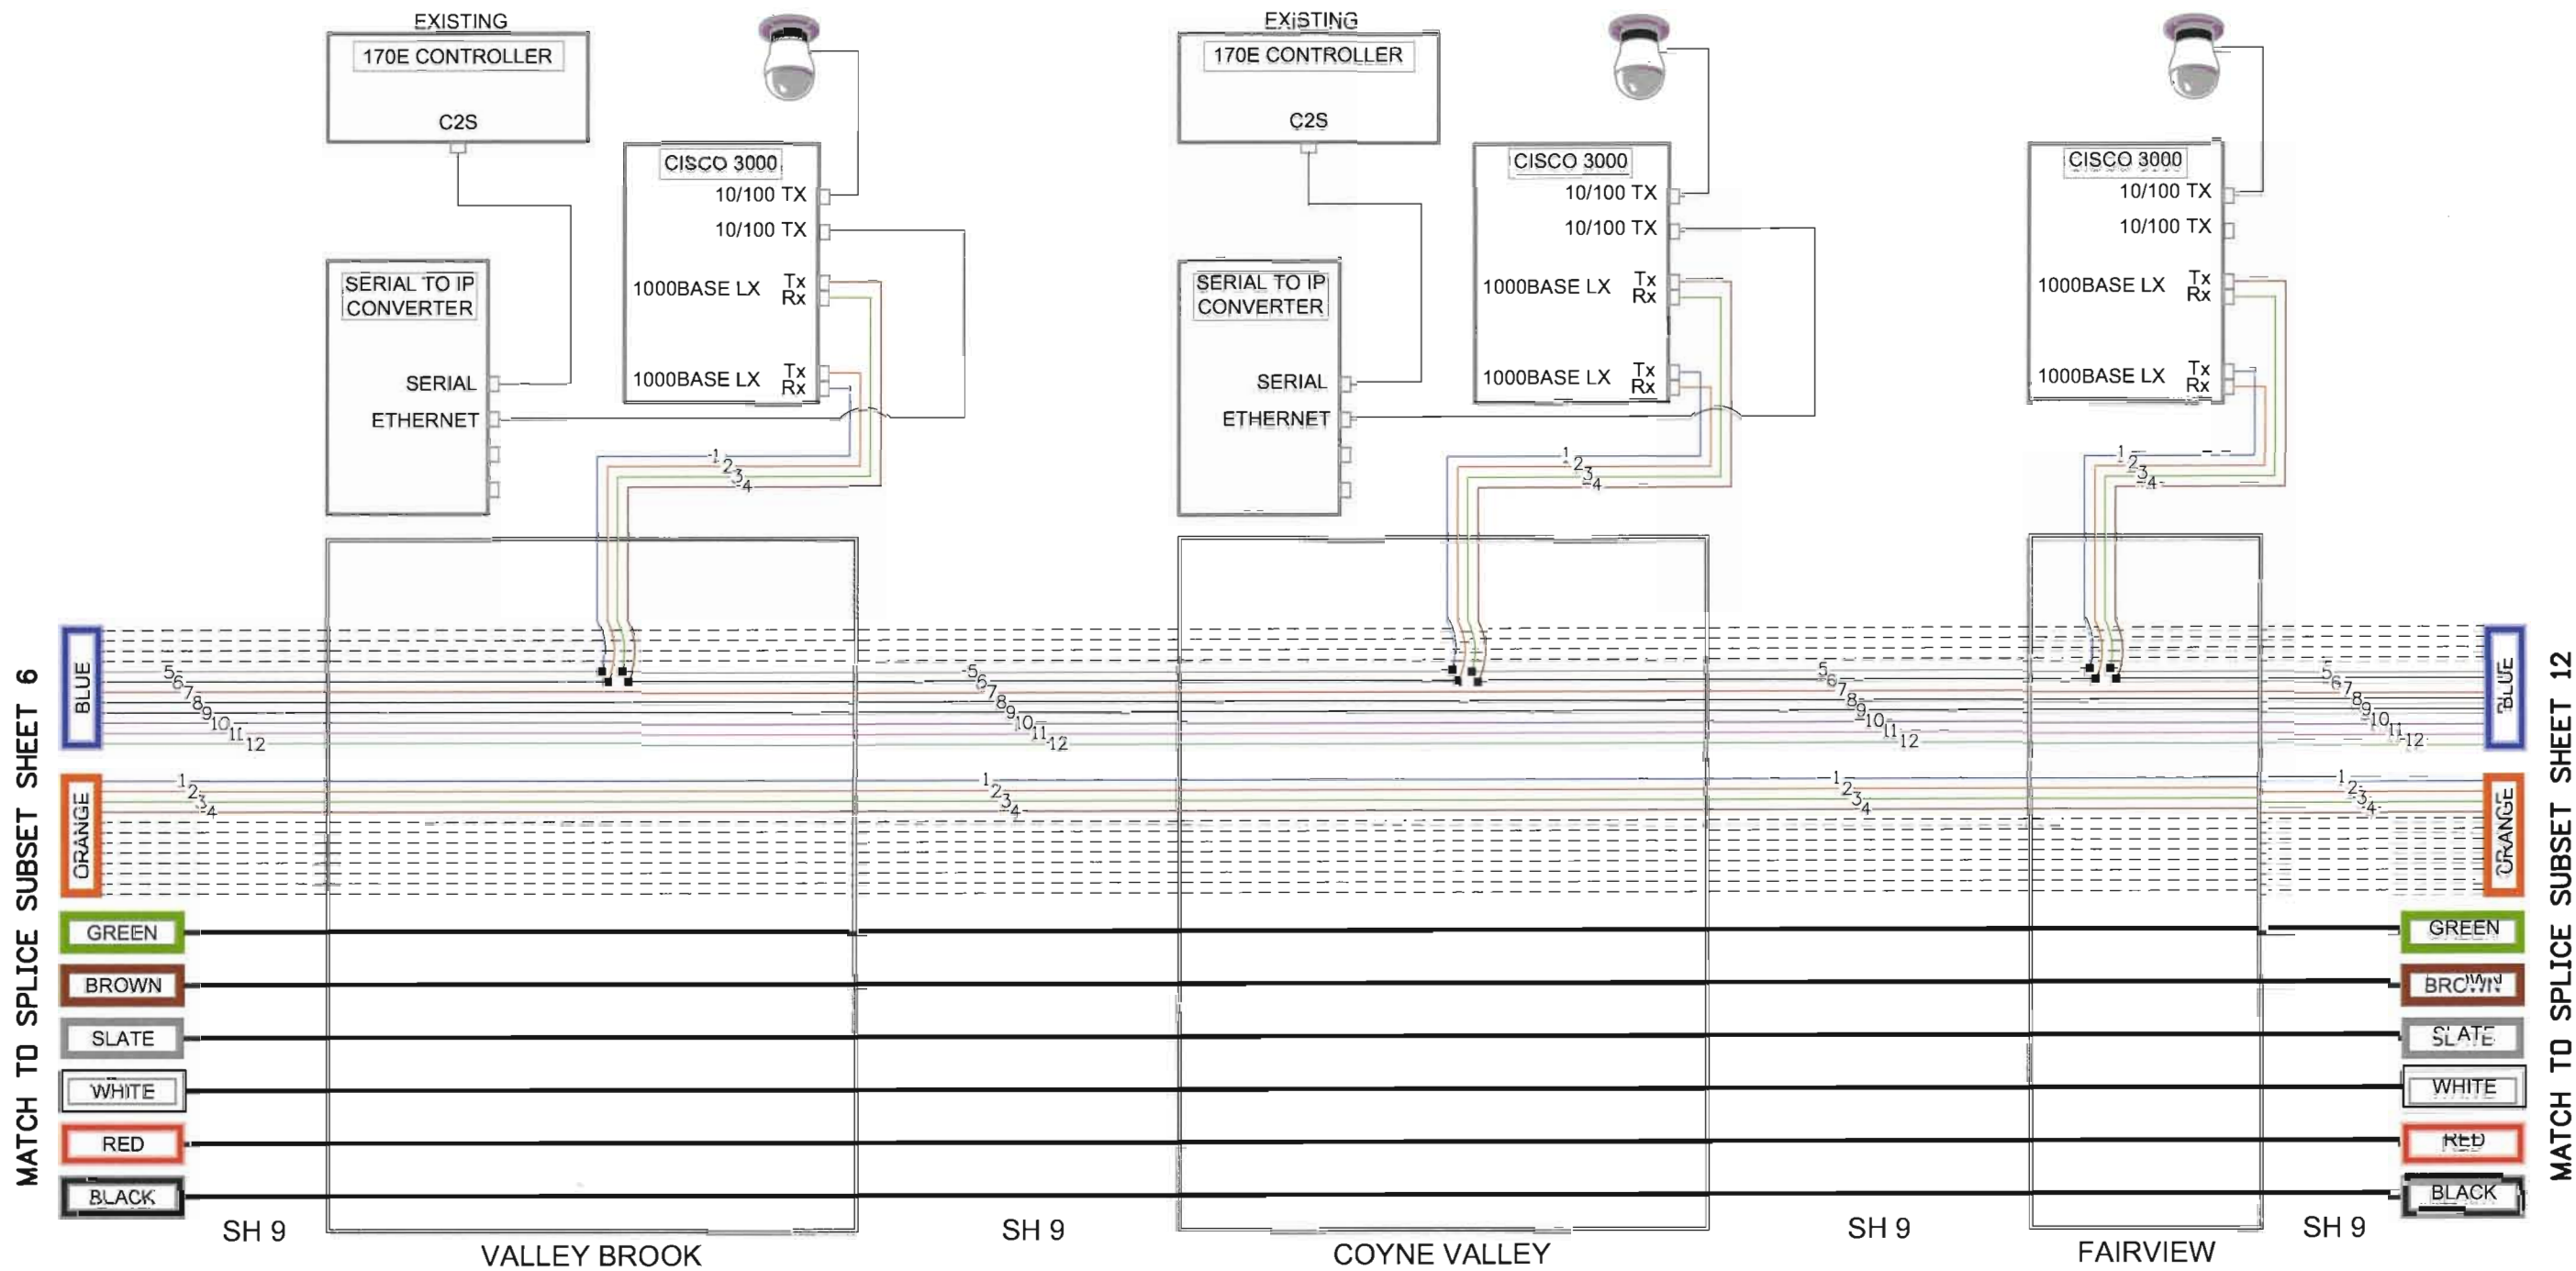

5/1/2012 4:16:23 PM C:\Apex\Projects\18777\Traffic_ITS\Drawings\18777TRAF_Splice10.dgn

Print Date: 5/1/2012	
Drawing File Name: 18777TRAF_Splice10.dgn	
Horiz. Scale: NOT TO SCALE	Vert. Scale: As Noted
Unit Information Unit Leader Initials	
<div><div>MULLER</div><div>Muller Engineering Co., Inc. Consulting Engineers</div></div> <div><div>apexdesign</div><div></div></div>	
P:10-028.13 - SH 9 Interconnect\Traffic_ITS	

Sheet Revisions		
Date:	Comments	Init.


Region 1

Colorado Department of Transportation

18500 East Colfax Avenue
Aurora, CO 80011
Phone: 303-757-9648 FAX: 303-757-9746

SS

As Constructed		SPLICING DIAGRAM		Project No./Code	
No Revisions:				MTCE 0091-039	
Revised:		Designer: C. SIGSBURY	Structure Numbers	18777	
Void:		Detailer: C. SIGSBURY		Sheet Number 68	
		Sheet Subset: SPLICE	Subset Sheets: 10 of 19		

FIBER CABLE SPLICE TABLE SH 9/VALLEY BROOK								
CABLE DESCRIPTION	BUFFER COLOR	FIBER		SPliced TO	CABLE DESCRIPTION	BUFFER COLOR	FIBER	
		NO.	COLOR				NO.	COLOR
96 BACKBONE TO SOUTH	BLUE	5	SLATE		12 LATERAL TO TRAFFIC CABINET	BLUE	1	BLUE
96 BACKBONE TO SOUTH	BLUE	6	WHITE		12 LATERAL TO TRAFFIC CABINET	BLUE	2	ORANGE
96 BACKBONE TO NORTH	BLUE	5	SLATE		12 LATERAL TO TRAFFIC CABINET	BLUE	3	GREEN
96 BACKBONE TO NORTH	BLUE	6	WHITE		12 LATERAL TO TRAFFIC CABINET	BLUE	4	BROWN

PATCH PANEL TABLE SH 9/VALLEY BROOK					
CABLE DESCRIPTION	BUFFER COLOR	FIBER		PATCH NO.	PATCHED TO
		NO.	COLOR		
12 LATERAL TO TRAFFIC CABINET	BLUE	1	BLUE	1	CISCO RECEIVE
12 LATERAL TO TRAFFIC CABINET	BLUE	2	ORANGE	2	CISCO TRANSMIT
12 LATERAL TO TRAFFIC CABINET	BLUE	3	GREEN	3	CISCO RECEIVE
12 LATERAL TO TRAFFIC CABINET	BLUE	4	BROWN	4	CISCO TRANSMIT

FIBER CABLE SPLICE TABLE SH 9/COYNE VALLEY								
CABLE DESCRIPTION	BUFFER COLOR	FIBER		SPliced TO	CABLE DESCRIPTION	BUFFER COLOR	FIBER	
		NO.	COLOR				NO.	COLOR
96 BACKBONE TO SOUTH	BLUE	5	SLATE		12 LATERAL TO TRAFFIC CABINET	BLUE	1	BLUE
96 BACKBONE TO SOUTH	BLUE	6	WHITE		12 LATERAL TO TRAFFIC CABINET	BLUE	2	ORANGE
96 BACKBONE TO NORTH	BLUE	5	SLATE		12 LATERAL TO TRAFFIC CABINET	BLUE	3	GREEN
96 BACKBONE TO NORTH	BLUE	6	WHITE		12 LATERAL TO TRAFFIC CABINET	BLUE	4	BROWN

PATCH PANEL TABLE SH 9/COYNE VALLEY					
CABLE DESCRIPTION	BUFFER COLOR	FIBER		PATCH NO.	PATCHED TO
		NO.	COLOR		
12 LATERAL TO TRAFFIC CABINET	BLUE	1	BLUE	1	CISCO TRANSMIT
12 LATERAL TO TRAFFIC CABINET	BLUE	2	ORANGE	2	CISCO RECEIVE
12 LATERAL TO TRAFFIC CABINET	BLUE	3	GREEN	3	CISCO RECEIVE
12 LATERAL TO TRAFFIC CABINET	BLUE	4	BROWN	4	CISCO TRANSMIT

FIBER CABLE SPLICE TABLE SH 9/FAIRVIEW								
CABLE DESCRIPTION	BUFFER COLOR	FIBER		SPliced TO	CABLE DESCRIPTION	BUFFER COLOR	FIBER	
		NO.	COLOR				NO.	COLOR
96 BACKBONE TO SOUTH	BLUE	5	SLATE		12 LATERAL TO TRAFFIC CABINET	BLUE	1	BLUE
96 BACKBONE TO SOUTH	BLUE	6	WHITE		12 LATERAL TO TRAFFIC CABINET	BLUE	2	ORANGE
96 BACKBONE TO NORTH	BLUE	5	SLATE		12 LATERAL TO TRAFFIC CABINET	BLUE	3	GREEN
96 BACKBONE TO NORTH	BLUE	6	WHITE		12 LATERAL TO TRAFFIC CABINET	BLUE	4	BROWN

PATCH PANEL TABLE SH 9/FAIRVIEW					
CABLE DESCRIPTION	BUFFER COLOR	FIBER		PATCH NO.	PATCHED TO
		NO.	COLOR		
12 LATERAL TO TRAFFIC CABINET	BLUE	1	BLUE	1	CISCO TRANSMIT
12 LATERAL TO TRAFFIC CABINET	BLUE	2	ORANGE	2	CISCO RECEIVE
12 LATERAL TO TRAFFIC CABINET	BLUE	3	GREEN	3	CISCO RECEIVE
12 LATERAL TO TRAFFIC CABINET	BLUE	4	BROWN	4	CISCO TRANSMIT


5/1/2012 4:16:24 PM C:\Apex\Projects\18777\Traffic\ITS\Drawings\18777TRAF_Splice11.dgn

Print Date: 5/1/2012	
Drawing File Name: 18777TRAF_Splice11.dgn	
Horiz. Scale: NOT TO SCALE	Vert. Scale: As Noted
Unit Information	Unit Leader Initials
 Muller Engineering Co., Inc. Consulting Engineers	
P:10-028.13 - SH 9 Interconnect\Traffic_ITS	

Sheet Revisions		
Date:	Comments	Init.

Colorado Department of Transportation	
	18500 East Colfax Avenue Aurora, CO 80011 Phone: 303-757-9648 FAX: 303-757-9746
Region 1	SS


As Constructed		SPLICING TABLES		Project No./Code	
No Revisions:				MTCE 0091-039	
Revised:		Designer: C. SIGSBURY	Structure	18777	
Void:		Detailer: C. SIGSBURY	Numbers		
		Sheet Subset: SPLICE	Subset Sheets: 11 of 19	Sheet Number	69

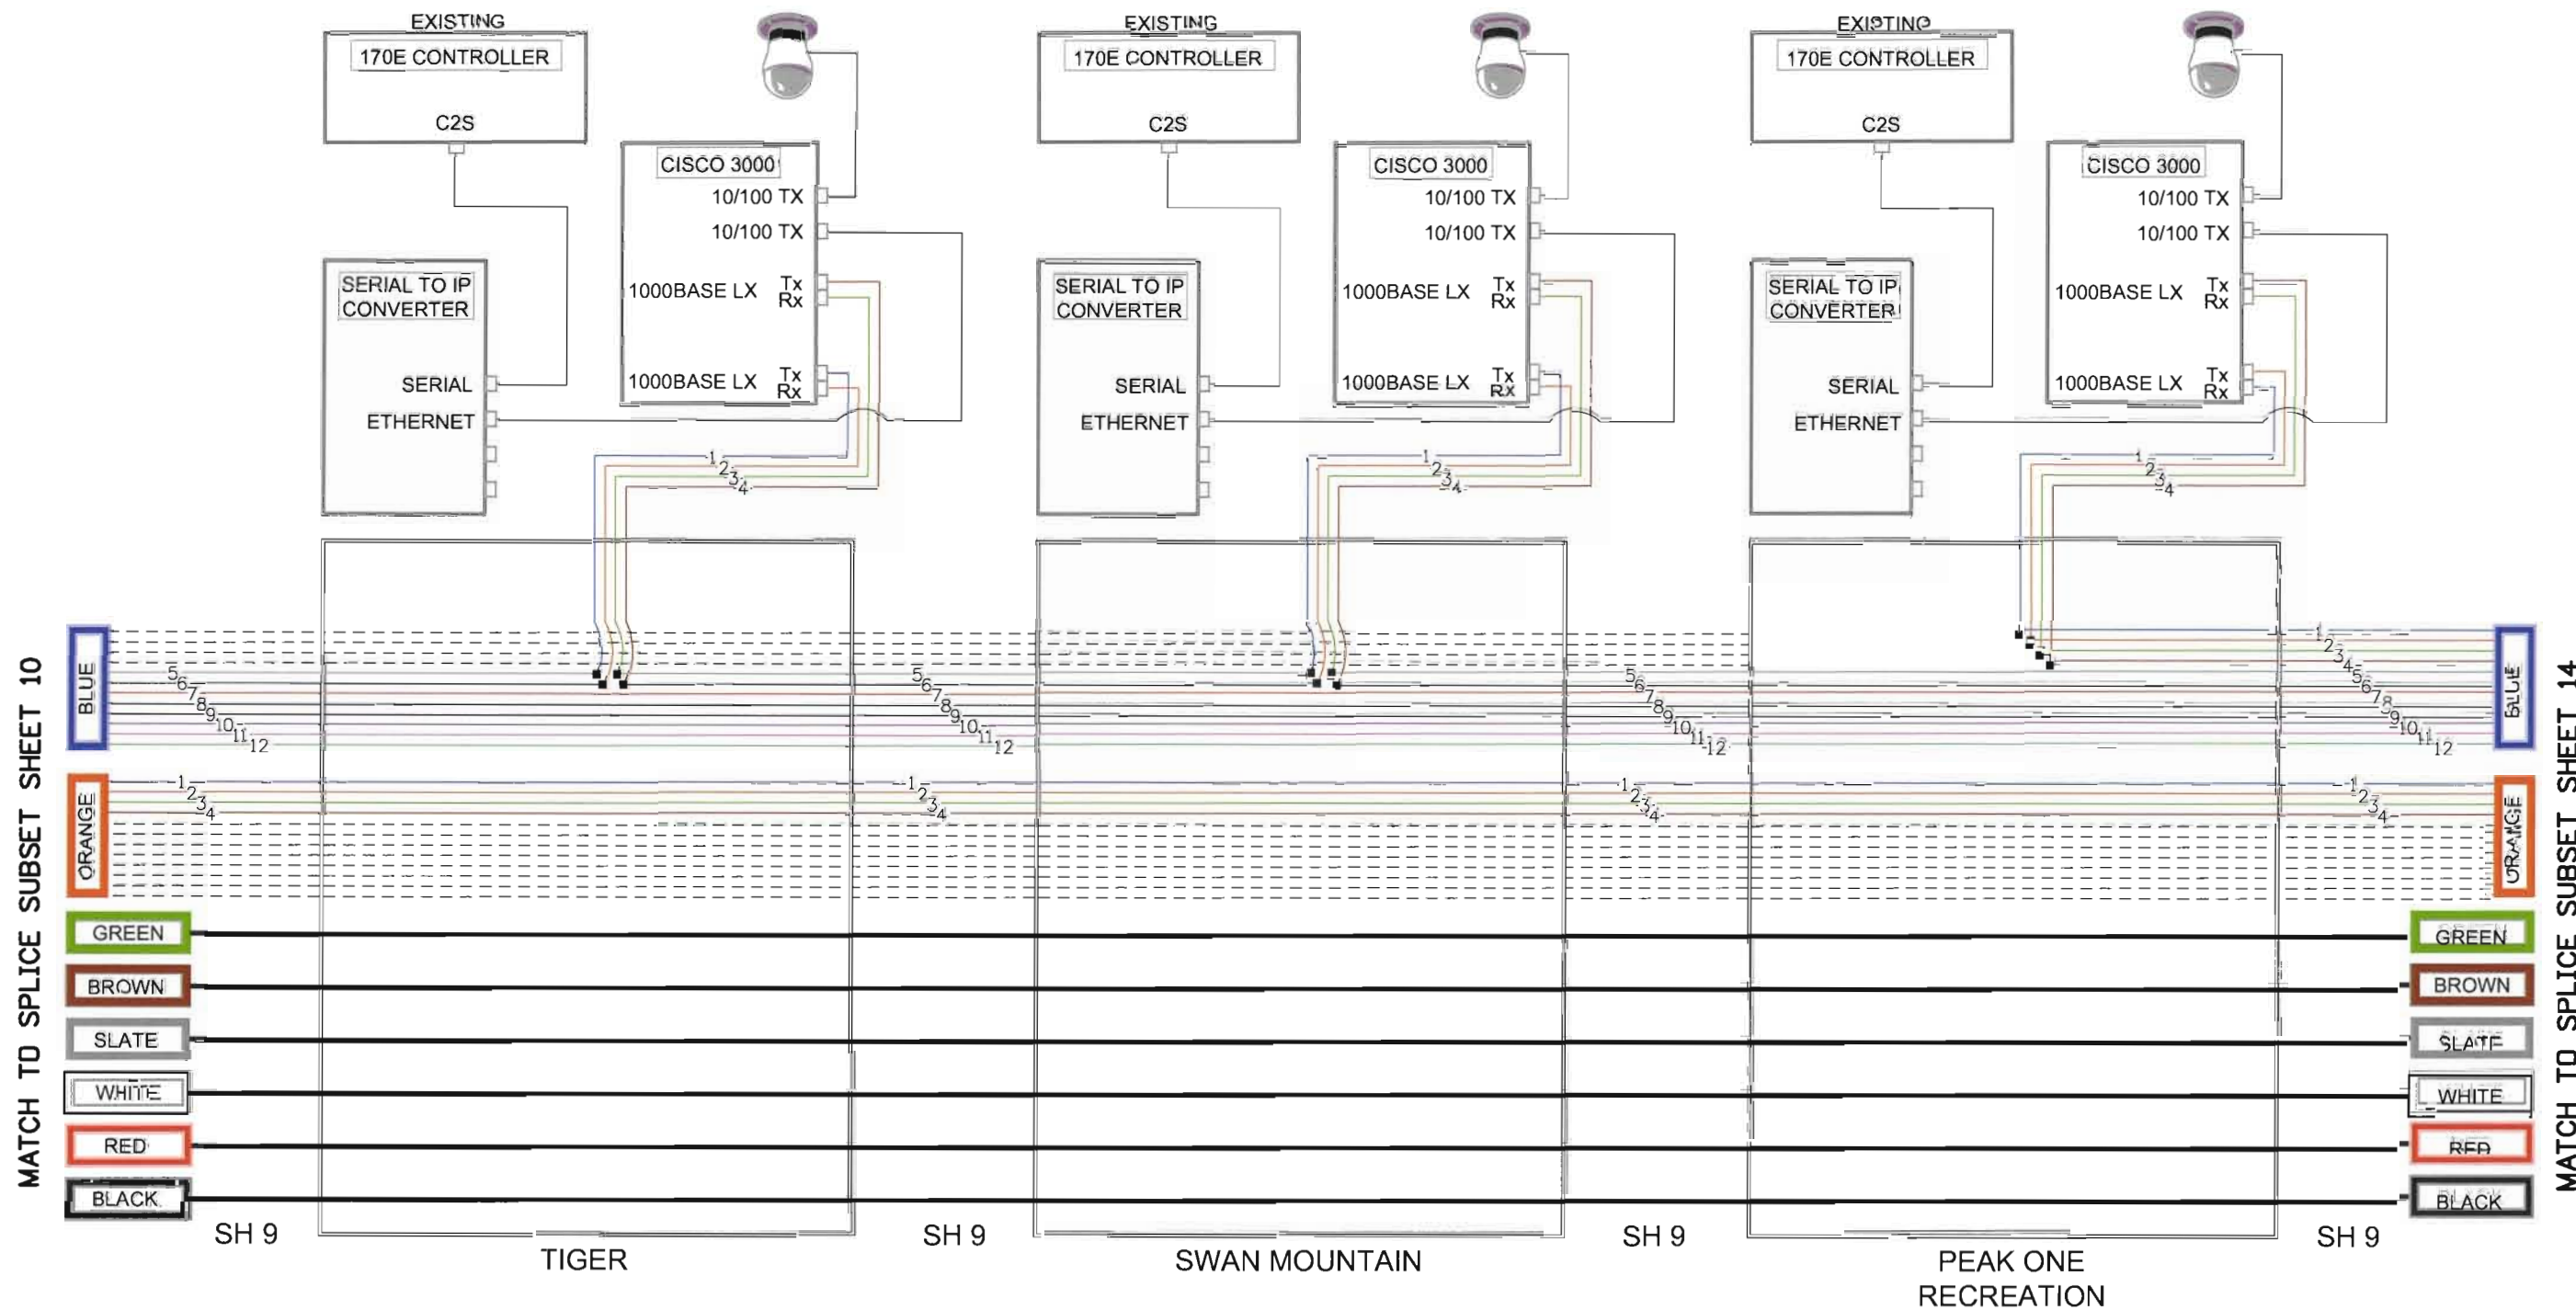

5/1/2012 4:16:29 PM C:\Apex\Projects\18777\Traffic_ITS\Drawings\18777TRAF_Splice12.dgn

Print Date: 5/1/2012	
Drawing File Name: 18777TRAF_Splice12.dgn	
Horiz. Scale: NOT TO SCALE	Vert. Scale: As Noted
Unit Information	Unit Leader Initials
MULLER	Muller Engineering Co., Inc. Consulting Engineers P: 303-528-1133 - SH 9 Interconnect\Traffic_ITS
apexdesign	

Sheet Revisions		
Date:	Comments	Init.

Colorado Department of Transportation	
	18500 East Colfax Avenue Aurora, CO 80011 Phone: 303-757-9648 FAX: 303-757-9746
Region 1	SS

As Constructed	SPLICING DIAGRAM		Project No./Code
No Revisions:	Designer: C. SIGSBURY		MTCE 0091-039
Revised:	Detailer: C. SIGSBURY	Structure Numbers	18777
Void:	Sheet Subset: SPLICE	Subset Sheets: 12 of 19	Sheet Number 70

FIBER CABLE SPLICE TABLE								
SH 9/TIGER								
CABLE DESCRIPTION	BUFFER COLOR	FIBER		SPICED TO	CABLE DESCRIPTION	BUFFER COLOR	FIBER	
		NO.	COLOR				NO.	COLOR
96 BACKBONE TO SOUTH	BLUE	5	SLATE		12 LATERAL TO TRAFFIC CABINET	BLUE	1	BLUE
96 BACKBONE TO SOUTH	BLUE	6	WHITE		12 LATERAL TO TRAFFIC CABINET	BLUE	2	ORANGE
96 BACKBONE TO NORTH	BLUE	5	SLATE		12 LATERAL TO TRAFFIC CABINET	BLUE	3	GREEN
96 BACKBONE TO NORTH	BLUE	6	WHITE		12 LATERAL TO TRAFFIC CABINET	BLUE	4	BROWN

PATCH PANEL TABLE SH 9/TIGER					
CABLE DESCRIPTION	BUFFER COLOR	FIBER		PATCH NO.	PATCHED TO
		NO.	COLOR		
12 LATERAL TO TRAFFIC CABINET	BLUE	1	BLUE	1	CISCO TRANSMIT
12 LATERAL TO TRAFFIC CABINET	BLUE	2	ORANGE	2	CISCO RECEIVE
12 LATERAL TO TRAFFIC CABINET	BLUE	3	GREEN	3	CISCO RECEIVE
12 LATERAL TO TRAFFIC CABINET	BLUE	4	BROWN	4	CISCO TRANSMIT

FIBER CABLE SPLICE TABLE SH 9/SWAN MOUNTAIN								
CABLE DESCRIPTION	BUFFER COLOR	FIBER		SPICED TO	CABLE DESCRIPTION	BUFFER COLOR	FIBER	
		NO.	COLOR				NO.	COLOR
96 BACKBONE TO SOUTH	BLUE	5	SLATE		12 LATERAL TO TRAFFIC CABINET	BLUE	1	BLUE
96 BACKBONE TO SOUTH	BLUE	6	WHITE		12 LATERAL TO TRAFFIC CABINET	BLUE	2	ORANGE
96 BACKBONE TO NORTH	BLUE	5	SLATE		12 LATERAL TO TRAFFIC CABINET	BLUE	3	GREEN
96 BACKBONE TO NORTH	BLUE	6	WHITE		12 LATERAL TO TRAFFIC CABINET	BLUE	4	BROWN

PATCH PANEL TABLE SH 9/SWAN MOUNTAIN					
CABLE DESCRIPTION	BUFFER COLOR	FIBER		PATCH NO.	PATCHED TO
		NO.	COLOR		
12 LATERAL TO TRAFFIC CABINET	BLUE	1	BLUE	1	CISCO TRANSMIT
12 LATERAL TO TRAFFIC CABINET	BLUE	2	ORANGE	2	CISCO RECEIVE
12 LATERAL TO TRAFFIC CABINET	BLUE	3	GREEN	3	CISCO RECEIVE
12 LATERAL TO TRAFFIC CABINET	BLUE	4	BROWN	4	CISCO TRANSMIT


FIBER CABLE SPLICE TABLE SH 9/PEAK ONE/RECREATION								
CABLE DESCRIPTION	BUFFER COLOR	FIBER		SPICED TO	CABLE DESCRIPTION	BUFFER COLOR	FIBER	
		NO.	COLOR				NO.	COLOR
96 BACKBONE TO NORTH	BLUE	1	BLUE		12 LATERAL TO TRAFFIC CABINET	BLUE	1	BLUE
96 BACKBONE TO NORTH	BLUE	2	ORANGE		12 LATERAL TO TRAFFIC CABINET	BLUE	2	ORANGE
96 BACKBONE TO NORTH	BLUE	3	GREEN		12 LATERAL TO TRAFFIC CABINET	BLUE	3	GREEN
96 BACKBONE TO NORTH	BLUE	4	BROWN		12 LATERAL TO TRAFFIC CABINET	BLUE	4	BROWN

PATCH PANEL TABLE SH 9/PEAK ONE/RECREATION					
CABLE DESCRIPTION	BUFFER COLOR	FIBER		PATCH NO.	PATCHED TO
		NO.	COLOR		
12 LATERAL TO TRAFFIC CABINET	BLUE	1	BLUE	1	CISCO RECEIVE
12 LATERAL TO TRAFFIC CABINET	BLUE	2	ORANGE	2	CISCO TRANSMIT
12 LATERAL TO TRAFFIC CABINET	BLUE	3	GREEN	3	CISCO RECEIVE
12 LATERAL TO TRAFFIC CABINET	BLUE	4	BROWN	4	CISCO TRANSMIT


5/1/2012 4:16:30 PM C:\Apex\Projects\18777\Traffic\ITS\Drawings\18777TRAF_Splice13.dgn

Print Date: 5/1/2012
Drawing File Name: 18777TRAF_Splice13.dgn
Horiz. Scale: NDT TO SCALE
Unit Information


Vert. Scale: As Noted
Unit Leader Initials



Muller Engineering Co., Inc.
Consulting Engineers
P: 310-028.13 - SH 9 Interconnect\Traffic\ITS



Sheet Revisions		
Date:	Comments	Init.



Colorado Department of Transportation
18500 East Colfax Avenue
Aurora, CO 80011
Phone: 303-757-9648 FAX: 303-757-9746
Region 1

SS

As Constructed
No Revisions:
Revised:
Void:

SPLICING TABLES


Designer: C. SIGSBURY
Detailer: C. SIGSBURY
Sheet Subset: SPLICE

Structure Numbers
Subset Sheets: 13 of 19

Project No./Code
MTCE 0091-039
18777
Sheet Number 71

MATCH TO SPLICE SUBSET SHEET 12

MATCH TO SPLICE SUBSET SHEET 16

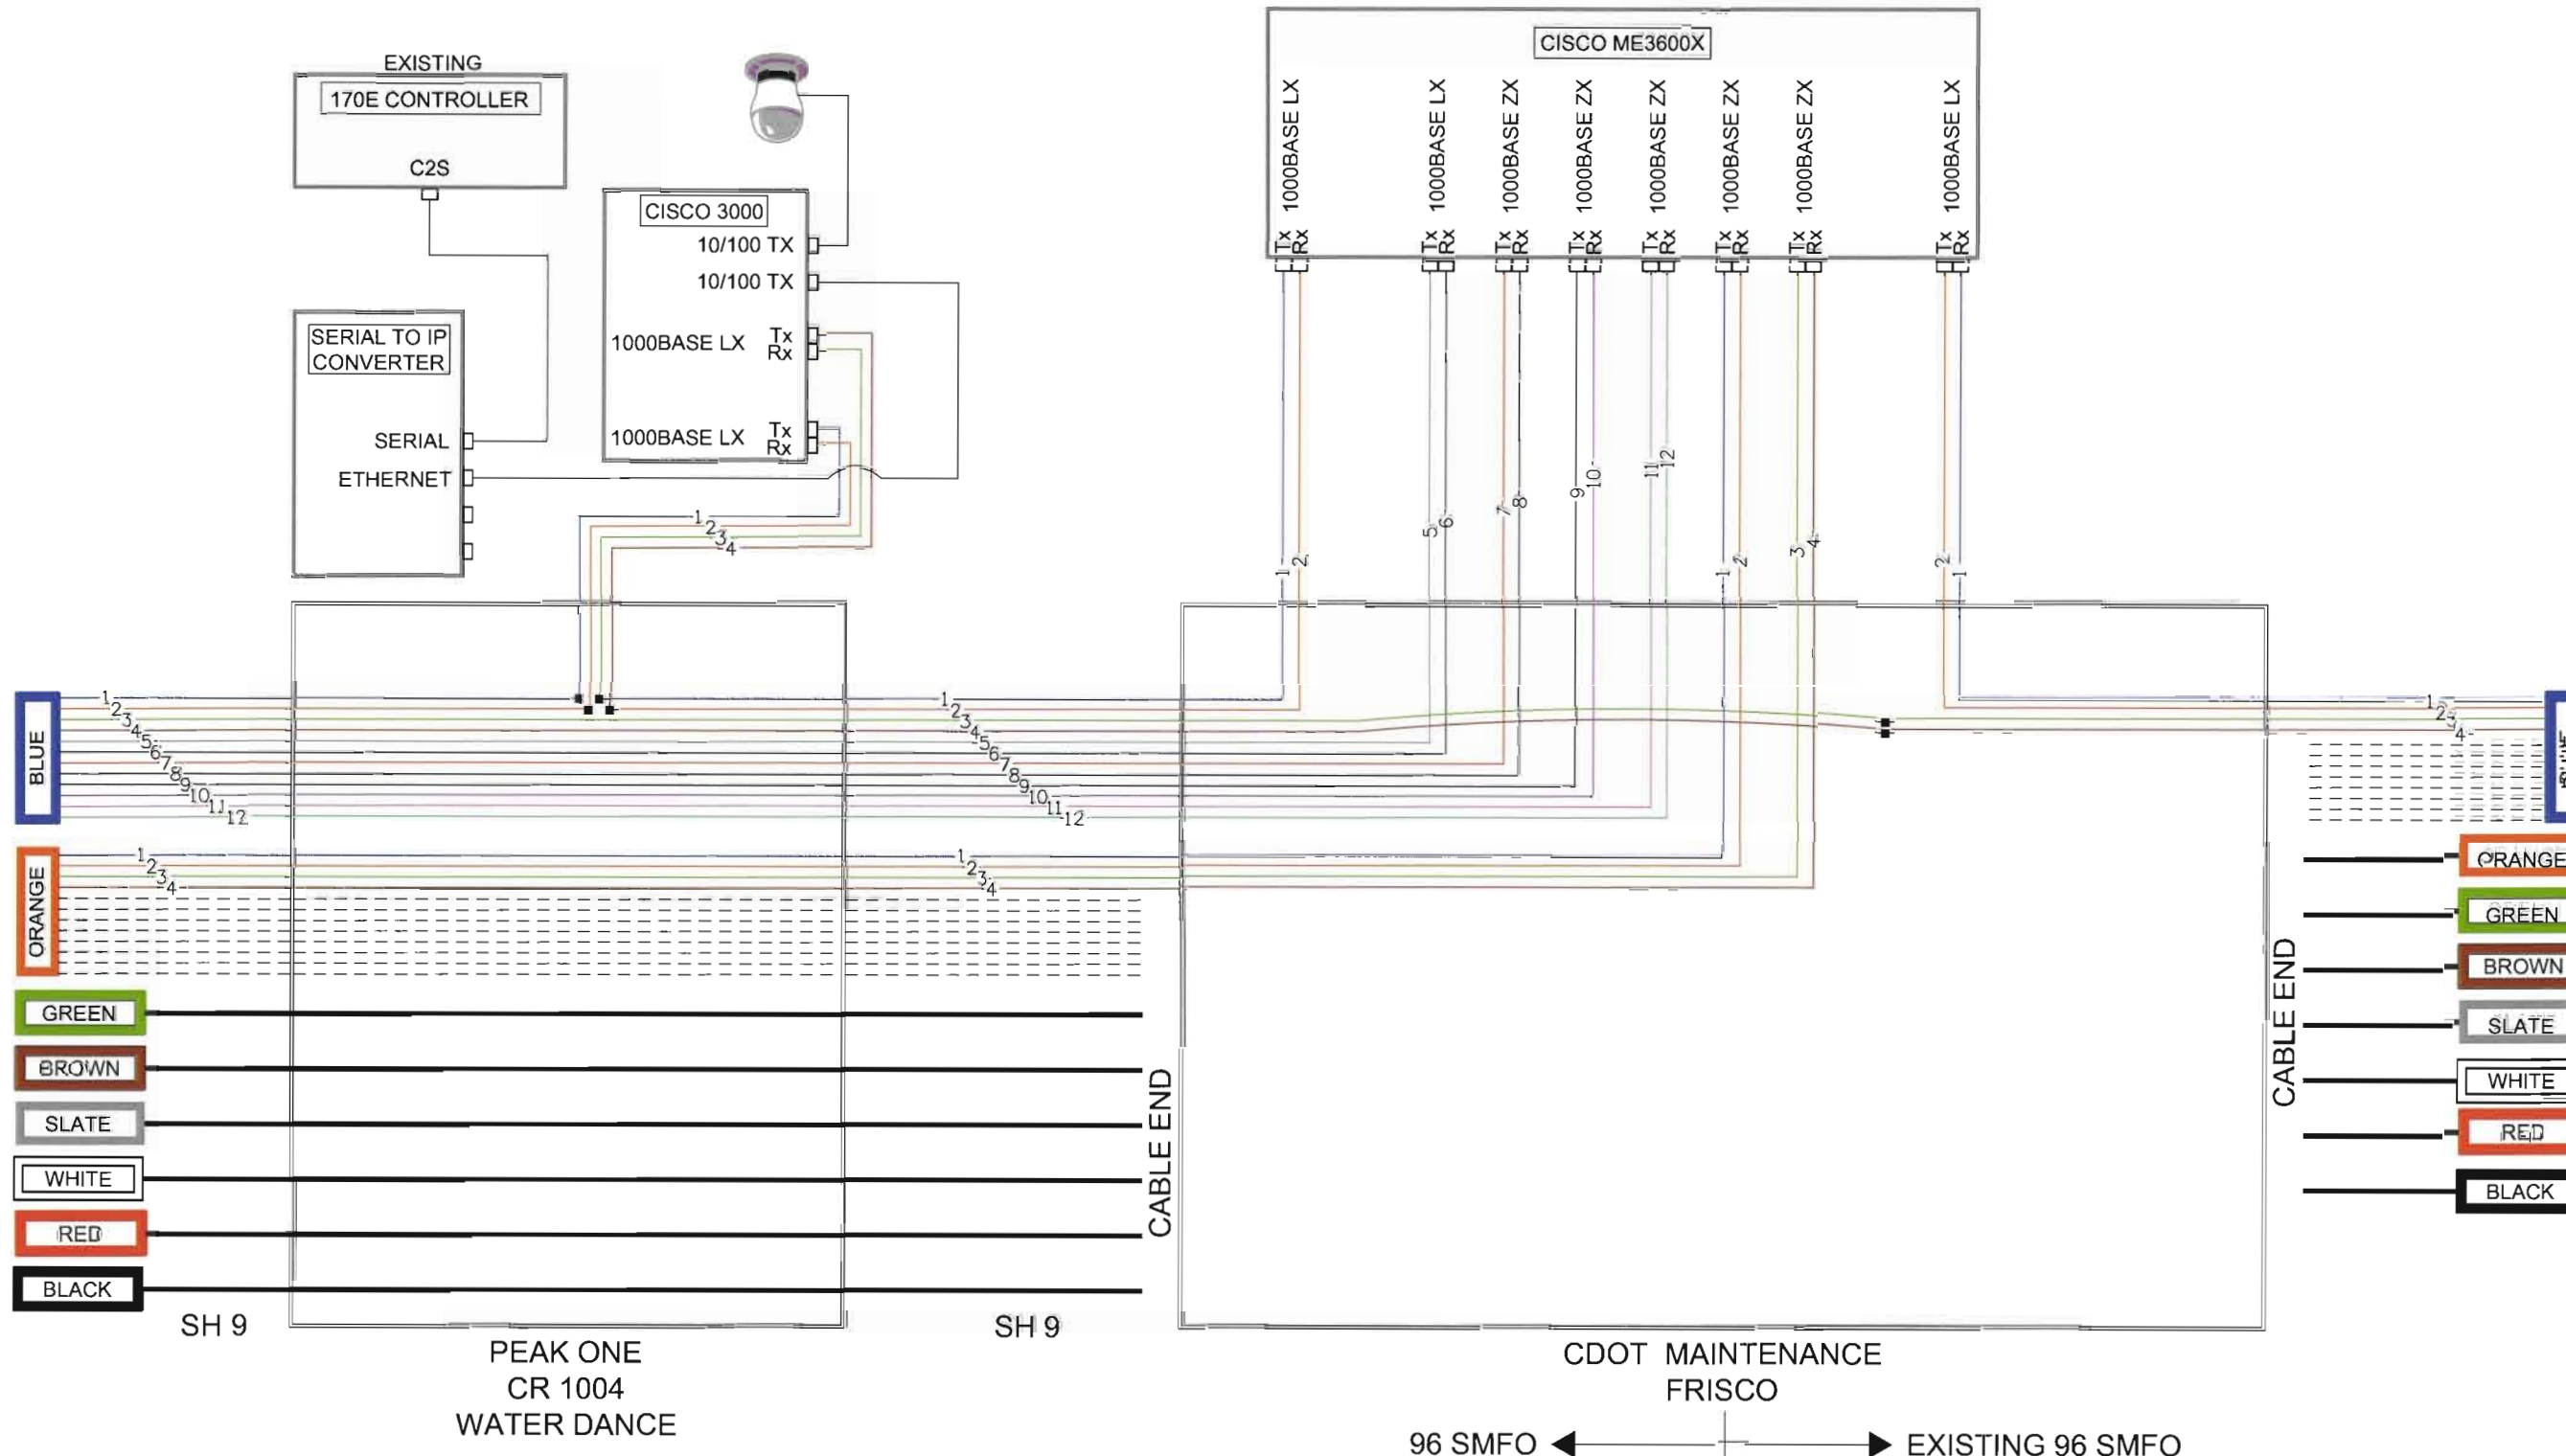

5/1/2012 4:16:36 PM C:\Apex\Projects\18777\Traffic_ITS\Drawings\18777TRAF_Splice14.dgn

Print Date: 5/1/2012	
Drawing File Name: 18777TRAF_Splice14.dgn	
Horiz. Scale: NDT TO SCALE	Vert. Scale: As Noted
Unit Information	Unit Leader Initials
MULLER Muller Engineering Co., Inc. Consulting Engineers	apexdesign
P10-028.13 - SH 9 Interconnect\Traffic_ITS	

Sheet Revisions		
Date:	Comments	Init.

Colorado Department of Transportation

 18500 East Colfax Avenue
Aurora, CO 80011
Phone: 303-757-9648 FAX: 303-757-9746

Region 1

SS

As Constructed
No Revisions:
Revised:
Void:

SPLICING DIAGRAM	
Designer: C. SIGSBURY	Structure Numbers
Detailer: C. SIGSBURY	
Sheet Subset: SPLICE	Subset Sheets: 14 of 19

Project No./Code
MTCE 0091-039
18777
Sheet Number 72

5/1/2012 4:16:37 PM C:\Apex\Projects\18777\Traffic_ITS\Drawings\18777TRAF_Splice15.dgn

FIBER CABLE SPLICE TABLE								
SH 9/PEAK ONE/CR 1004/WATER DANCE								
CABLE DESCRIPTION	BUFFER COLOR	FIBER		SPICED TO	CABLE DESCRIPTION	BUFFER COLOR	FIBER	
		NO.	COLOR				NO.	COLOR
96 BACKBONE TO SOUTH	BLUE	1	BLUE		12 LATERAL TO TRAFFIC CABINET	BLUE	1	BLUE
96 BACKBONE TO SOUTH	BLUE	2	ORANGE		12 LATERAL TO TRAFFIC CABINET	BLUE	2	ORANGE
96 BACKBONE TO NORTH	BLUE	1	BLUE		12 LATERAL TO TRAFFIC CABINET	BLUE	3	GREEN
96 BACKBONE TO NORTH	BLUE	2	ORANGE		12 LATERAL TO TRAFFIC CABINET	BLUE	4	BROWN

FIBER CABLE SPLICE TABLE								
CDOT MAINTENACE YARD IN FRISCO								
CABLE DESCRIPTION	BUFFER COLOR	FIBER		SPICED TO	CABLE DESCRIPTION	BUFFER COLOR	FIBER	
		NO.	COLOR				NO.	COLOR
96 BACKBONE TO SOUTH	BLUE	3	GREEN		96 BACKBONE TO NORTH	BLUE	3	GREEN
96 BACKBONE TO SOUTH	BLUE	4	BROWN		96 BACKBONE TO NORTH	BLUE	4	BROWN

PATCH PANEL TABLE					
SH 9/PEAK ONE/CR 1004/WATER DANCE					
CABLE DESCRIPTION	BUFFER COLOR	FIBER		PATCH NO.	PATCHED TO
		NO.	COLOR		
12 LATERAL TO TRAFFIC CABINET	BLUE	1	BLUE	1	CISCO TRANSMIT
12 LATERAL TO TRAFFIC CABINET	BLUE	2	ORANGE	2	CISCO RECEIVE
12 LATERAL TO TRAFFIC CABINET	BLUE	3	GREEN	3	CISCO RECEIVE
12 LATERAL TO TRAFFIC CABINET	BLUE	4	BROWN	4	CISCO TRANSMIT


PATCH PANEL TABLE					
CDOT MAINTENACE YARD IN FRISCO					
CABLE DESCRIPTION	BUFFER COLOR	FIBER		PATCH NO.	PATCHED TO
		NO.	COLOR		
96 BACKBONE TO SOUTH	BLUE	1	BLUE	1	CISCO TRANSMIT
96 BACKBONE TO SOUTH	BLUE	2	ORANGE	2	CISCO RECEIVE
96 BACKBONE TO SOUTH	BLUE	5	SLATE	5	CISCO TRANSMIT
96 BACKBONE TO SOUTH	BLUE	6	WHITE	6	CISCO RECEIVE
96 BACKBONE TO SOUTH	BLUE	7	RED	7	CISCO TRANSMIT
96 BACKBONE TO SOUTH	BLUE	8	BLACK	8	CISCO RECEIVE
96 BACKBONE TO SOUTH	BLUE	9	YELLOW	9	CISCO TRANSMIT
96 BACKBONE TO SOUTH	BLUE	10	VIOLET	10	CISCO RECEIVE
96 BACKBONE TO SOUTH	BLUE	11	ROSE	11	CISCO TRANSMIT
96 BACKBONE TO SOUTH	BLUE	12	AQUA	12	CISCO RECEIVE
96 BACKBONE TO SOUTH	ORANGE	1	BLUE	13	CISCO TRANSMIT
96 BACKBONE TO SOUTH	ORANGE	2	ORANGE	14	CISCO RECEIVE
96 BACKBONE TO SOUTH	ORANGE	3	GREEN	15	CISCO TRANSMIT
96 BACKBONE TO SOUTH	ORANGE	4	BROWN	16	CISCO RECEIVE
96 BACKBONE TO NORTH	BLUE	1	BLUE	17	CISCO RECEIVE
96 BACKBONE TO NORTH	BLUE	2	ORANGE	18	CISCO TRANSMIT

Print Date: 5/1/2012	
Drawing File Name: 18777TRAF_Splice15.dgn	
Horiz. Scale: NOT TO SCALE	Vert. Scale: As Noted
Unit Information Unit Leader Initials	
<div><div>MULLER</div><div>Muller Engineering Co., Inc. Consulting Engineers</div></div>	<div><div>apexdesign</div><div>P:10-028.13 - SH 9 Interconnect\Traffic_ITS</div></div>

Sheet Revisions		
Date:	Comments	Init.

Colorado Department of Transportation	
<div><div></div><div>Region 1</div></div>	<div><div>18500 East Colfax Avenue Aurora, CO 80011 Phone: 303-757-9648 FAX: 303-757-9746</div><div>SS</div></div>


As Constructed		SPLICING TABLES			Project No./Code	
No Revisions:					MTCE 0091-039	
Revised:	Designer: C. SIGSBURY		Structure Numbers		18777	
	Detailer: C. SIGSBURY					
Void:	Sheet Subset: SPLICE		Subset Sheets: 15 of 19		Sheet Number 73	

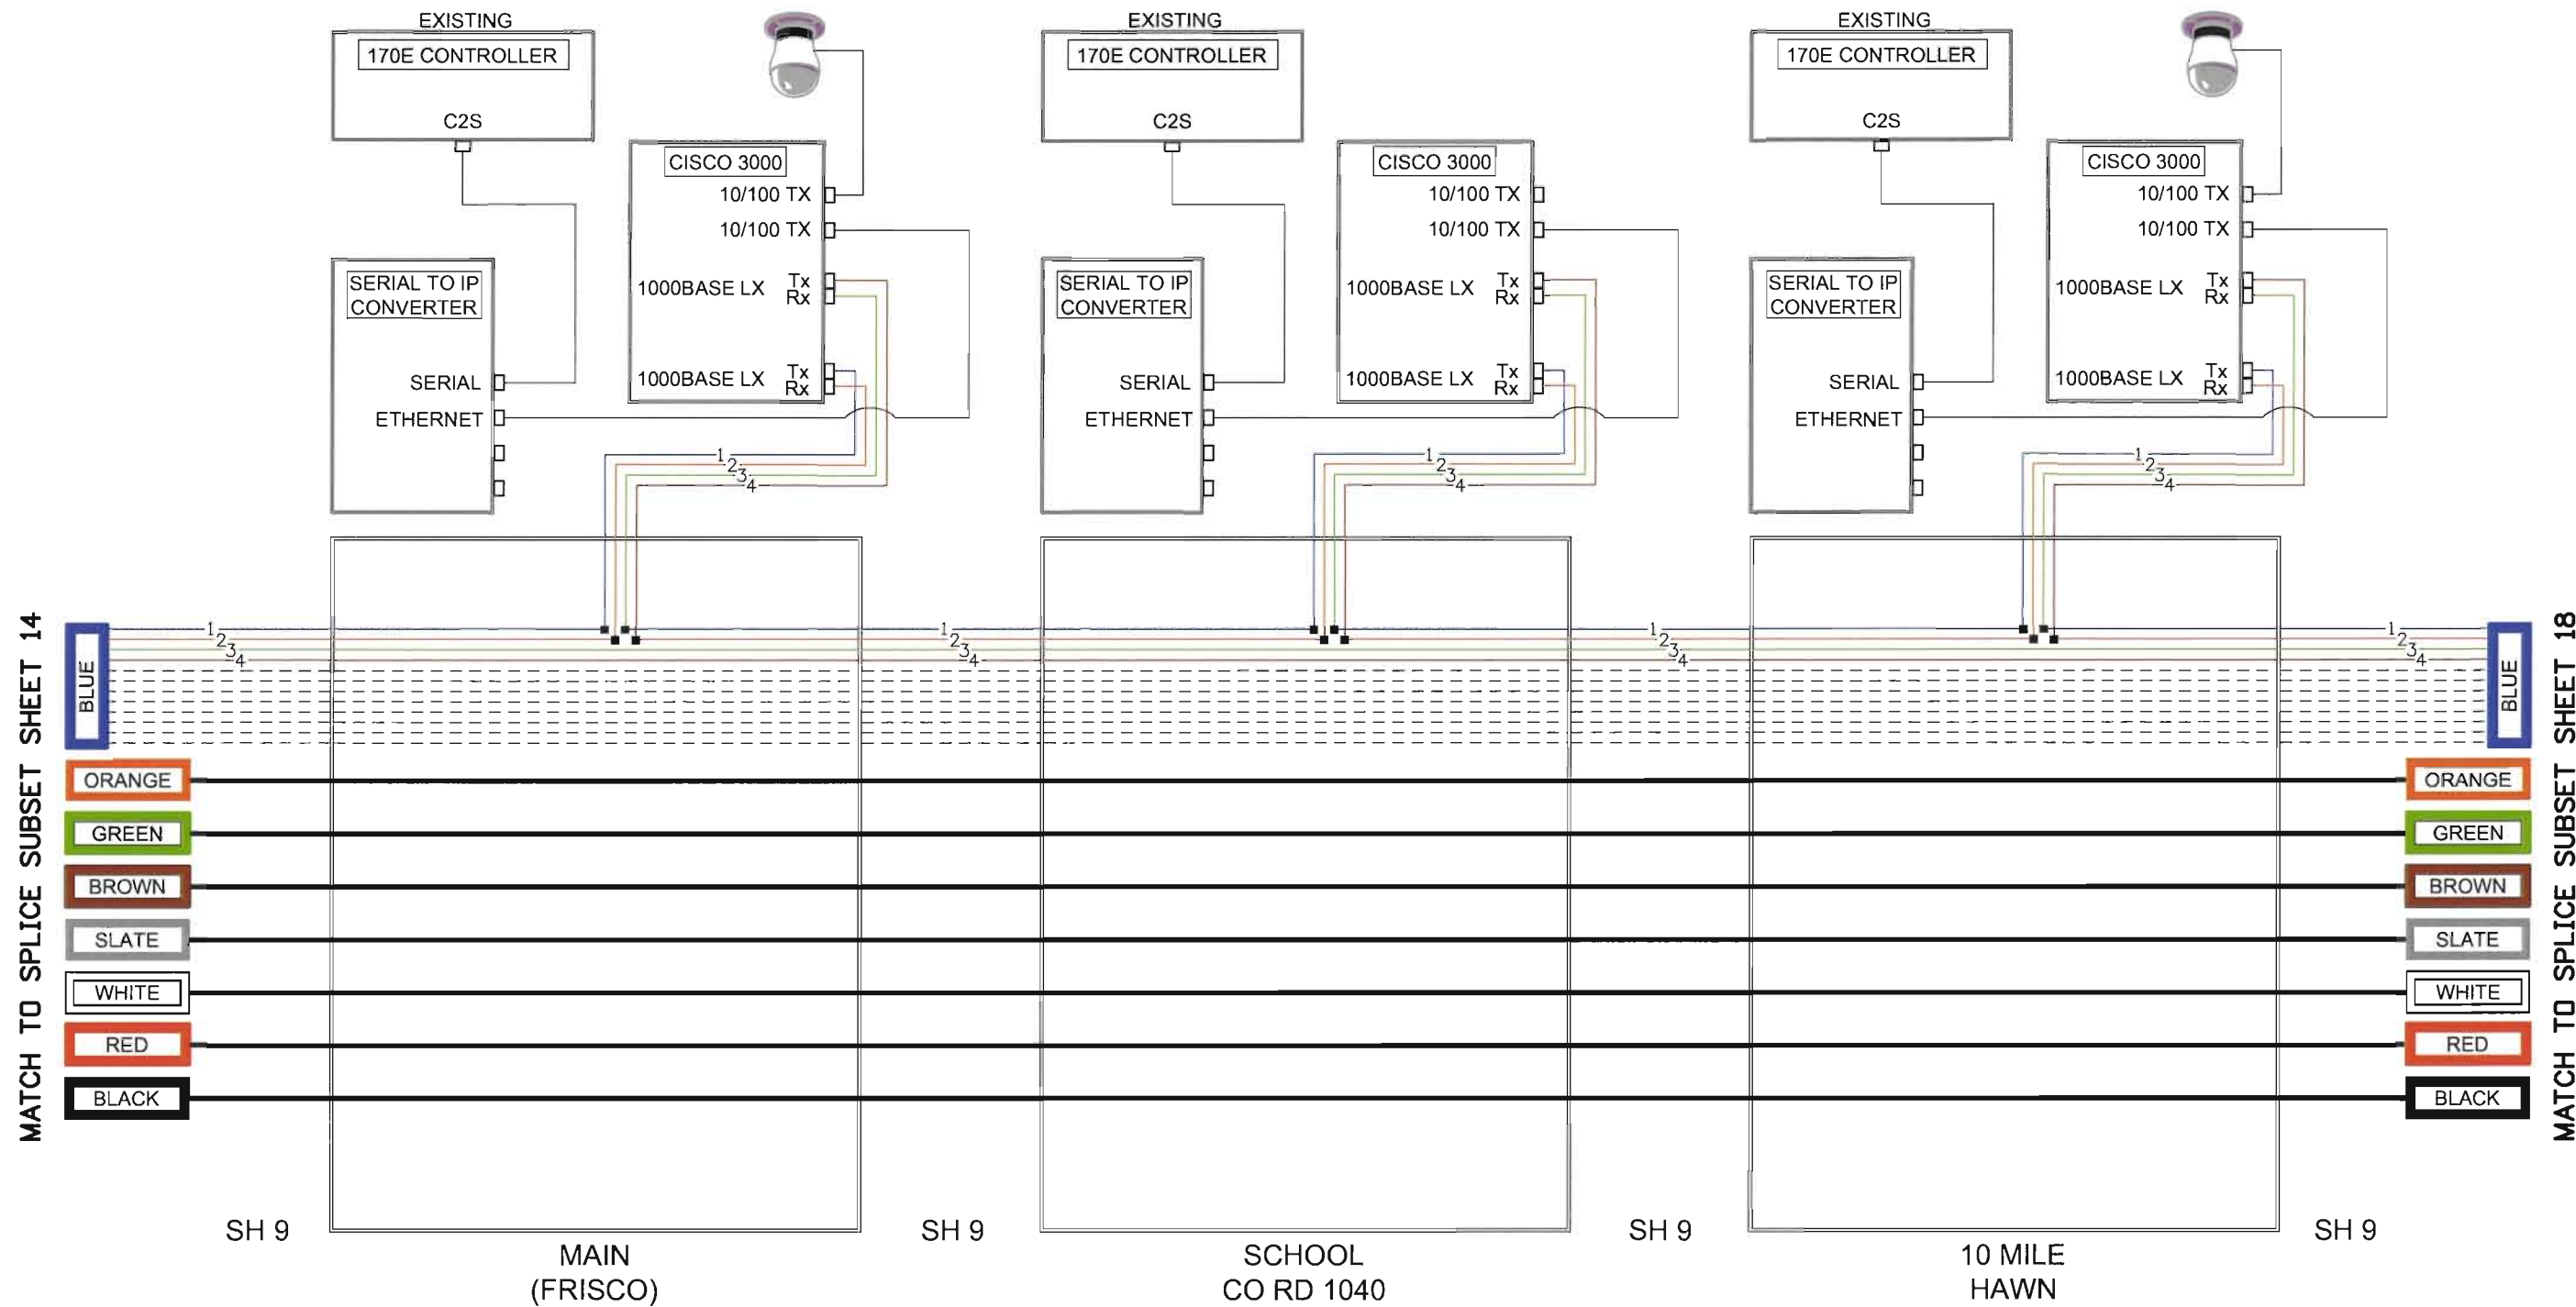

5/1/2012 4:16:42 PM C:\Apex\Projects\18777\Traffic_ITS\Drawings\18777\TRAF_Splice16.dgn

Print Date: 5/1/2012	
Drawing File Name: 18777TRAF_Splice16.dgn	
Horiz. Scale: NOT TO SCALE	Vert. Scale: As Noted
Unit Information	Unit Leader Initials
MULLER	Muller Engineering Co., Inc. Consulting Engineers P:\10-028.13 - SH 9 Interconnect\Traffic_ITS
apexdesign	

Sheet Revisions		
Date:	Comments	Init.



Colorado Department of Transportation
18500 East Colfax Avenue
Aurora, CO 80011
Phone: 303-757-9648 FAX: 303-757-9746
Region 1

SS

As Constructed
No Revisions:
Revised:
Void:

SPLICING DIAGRAM			
Designer: C. SIGSBURY	Structure		
Detailer: C. SIGSBURY	Numbers		
Sheet Subset: SPLICE	Subset Sheets: 16 of 19		

Project No./Code
MTCE 0091-039
18777
Sheet Number 74

FIBER CABLE SPLICE TABLE								
SH 9/MAIN								
CABLE DESCRIPTION	BUFFER COLOR	FIBER		SPliced TO	CABLE DESCRIPTION	BUFFER COLOR	FIBER	
		NO.	COLOR				NO.	COLOR
96 BACKBONE TO SOUTH	BLUE	1	BLUE		12 LATERAL TO TRAFFIC CABINET	BLUE	1	BLUE
96 BACKBONE TO SOUTH	BLUE	2	ORANGE		12 LATERAL TO TRAFFIC CABINET	BLUE	2	ORANGE
96 BACKBONE TO NORTH	BLUE	1	BLUE		12 LATERAL TO TRAFFIC CABINET	BLUE	3	GREEN
96 BACKBONE TO NORTH	BLUE	2	ORANGE		12 LATERAL TO TRAFFIC CABINET	BLUE	4	BROWN

PATCH PANEL TABLE SH 9/MAIN					
CABLE DESCRIPTION	BUFFER COLOR	FIBER		PATCH NO.	PATCHED TO
		NO.	COLOR		
12 LATERAL TO TRAFFIC CABINET	BLUE	1	BLUE	1	CISCO TRANSMIT
12 LATERAL TO TRAFFIC CABINET	BLUE	2	ORANGE	2	CISCO RECEIVE
12 LATERAL TO TRAFFIC CABINET	BLUE	3	GREEN	3	CISCO RECEIVE
12 LATERAL TO TRAFFIC CABINET	BLUE	4	BROWN	4	CISCO TRANSMIT

FIBER CABLE SPLICE TABLE SH 9/SCHOOL/CO RD 1040								
CABLE DESCRIPTION	BUFFER COLOR	FIBER		SPliced TO	CABLE DESCRIPTION	BUFFER COLOR	FIBER	
		NO.	COLOR				NO.	COLOR
96 BACKBONE TO SOUTH	BLUE	1	BLUE		12 LATERAL TO TRAFFIC CABINET	BLUE	1	BLUE
96 BACKBONE TO SOUTH	BLUE	2	ORANGE		12 LATERAL TO TRAFFIC CABINET	BLUE	2	ORANGE
96 BACKBONE TO NORTH	BLUE	1	BLUE		12 LATERAL TO TRAFFIC CABINET	BLUE	3	GREEN
96 BACKBONE TO NORTH	BLUE	2	ORANGE		12 LATERAL TO TRAFFIC CABINET	BLUE	4	BROWN


PATCH PANEL TABLE SH 9/SCHOOL/CO RD 1040					
CABLE DESCRIPTION	BUFFER COLOR	FIBER		PATCH NO.	PATCHED TO
		NO.	COLOR		
12 LATERAL TO TRAFFIC CABINET	BLUE	1	BLUE	1	CISCO TRANSMIT
12 LATERAL TO TRAFFIC CABINET	BLUE	2	ORANGE	2	CISCO RECEIVE
12 LATERAL TO TRAFFIC CABINET	BLUE	3	GREEN	3	CISCO RECEIVE
12 LATERAL TO TRAFFIC CABINET	BLUE	4	BROWN	4	CISCO TRANSMIT

FIBER CABLE SPLICE TABLE SH 9/10 MILE/HAWN								
CABLE DESCRIPTION	BUFFER COLOR	FIBER		SPliced TO	CABLE DESCRIPTION	BUFFER COLOR	FIBER	
		NO.	COLOR				NO.	COLOR
96 BACKBONE TO SOUTH	BLUE	1	BLUE		12 LATERAL TO TRAFFIC CABINET	BLUE	1	BLUE
96 BACKBONE TO SOUTH	BLUE	2	ORANGE		12 LATERAL TO TRAFFIC CABINET	BLUE	2	ORANGE
96 BACKBONE TO NORTH	BLUE	1	BLUE		12 LATERAL TO TRAFFIC CABINET	BLUE	3	GREEN
96 BACKBONE TO NORTH	BLUE	2	ORANGE		12 LATERAL TO TRAFFIC CABINET	BLUE	4	BROWN

PATCH PANEL TABLE SH 9/10 MILE/HAWN					
CABLE DESCRIPTION	BUFFER COLOR	FIBER		PATCH NO.	PATCHED TO
		NO.	COLOR		
12 LATERAL TO TRAFFIC CABINET	BLUE	1	BLUE	1	CISCO TRANSMIT
12 LATERAL TO TRAFFIC CABINET	BLUE	2	ORANGE	2	CISCO RECEIVE
12 LATERAL TO TRAFFIC CABINET	BLUE	3	GREEN	3	CISCO RECEIVE
12 LATERAL TO TRAFFIC CABINET	BLUE	4	BROWN	4	CISCO TRANSMIT

5/1/2012 4:18:43 PM C:\Apex\Projects\18777\Traffic_ITS\Drawings\18777TRAF_Splices17.dgn


Print Date: 5/1/2012		<div>0000</div>	Sheet Revisions			<div><div>Colorado Department of Transportation</div><div>18500 East Colfax Avenue Aurora, CO 80011 Phone: 303-757-9648 FAX: 303-757-9746</div><div>Region 1SS</div></div>	As Constructed		SPLICING TABLES			Project No./Code	
Drawing File Name: 18777TRAF_Splices17.dgn			Date:	Comments	Init.		No Revisions:					MTCE 0091-039	
Horiz. Scale: NOT TO SCALE							Revised:		Designer: C. SIGSBURY	Structure Numbers	18777		
Unit Information							Void:		Detailer: C. SIGSBURY		Sheet Number 75		
Unit Leader Initials									Sheet Subset: SPLICE	Subset Sheets: 17 of 19			
<div><div>MULLER</div><div>Muller Engineering Co., Inc. Consulting Engineers P10-028.13 - SH 9 Interconnect\Traffic_ITS</div></div> <div>apexdesign</div>													

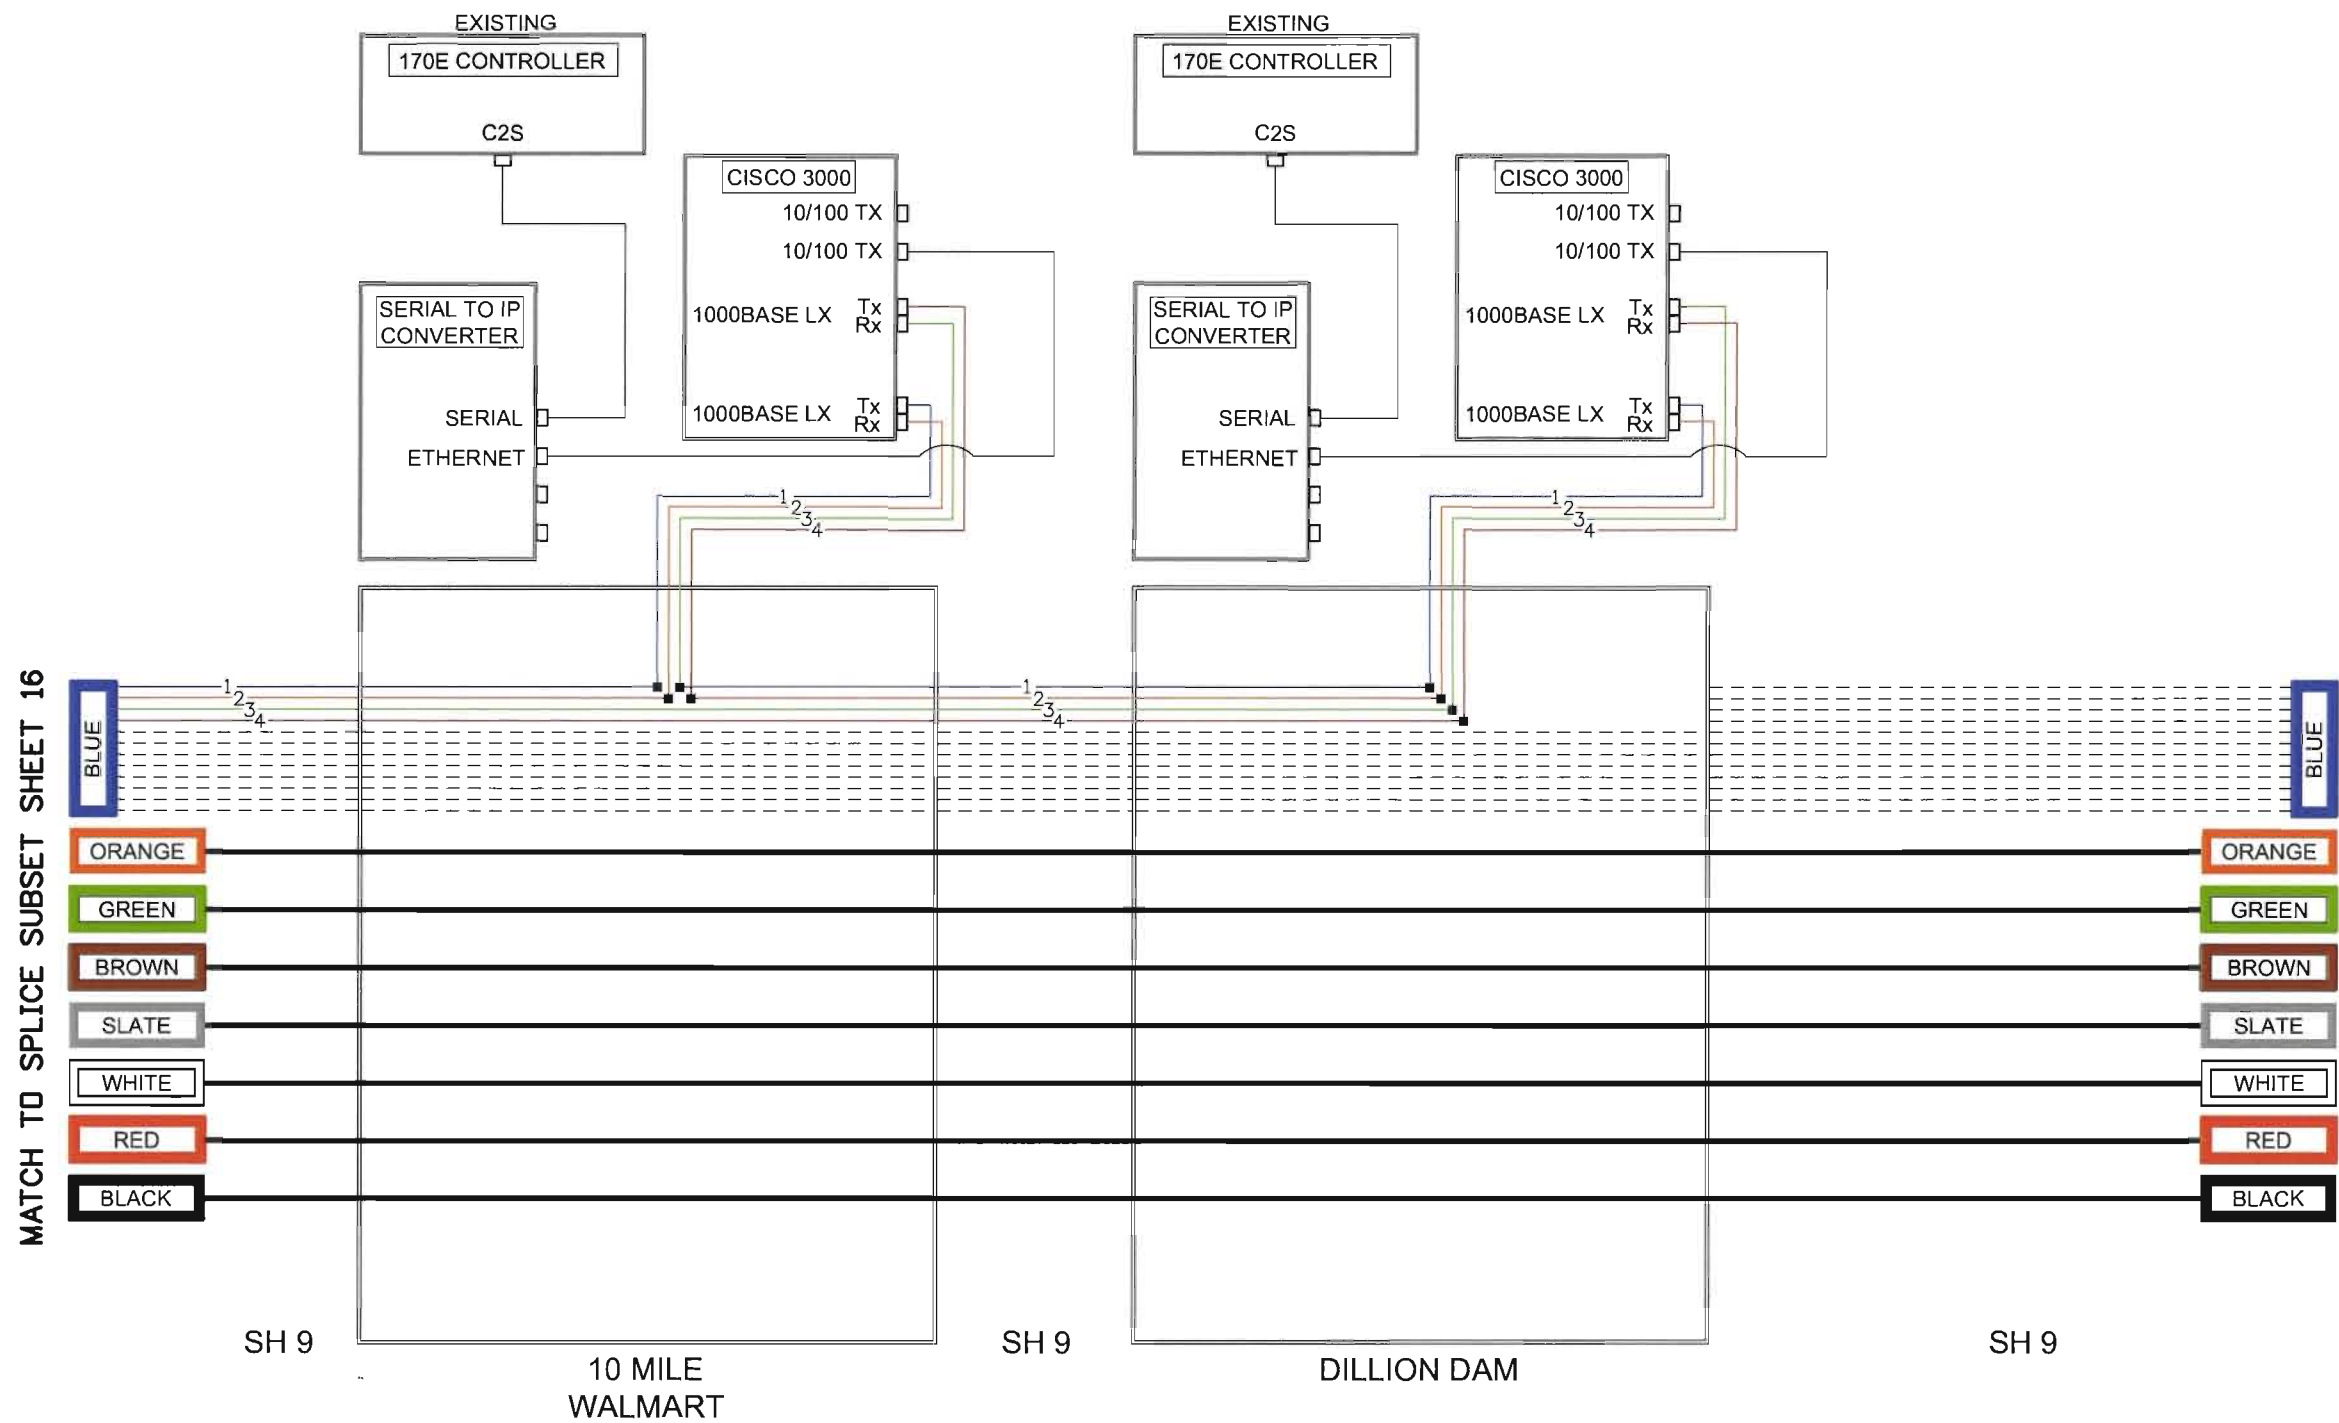

5/1/2012 4:16:48 PM C:\Apex\Projects\18777\Traffic_ITS\Drawings\18777TRAF_Splice18.dgn

Print Date: 5/1/2012	
Drawing File Name: 18777TRAF_Splice18.dgn	
Horiz. Scale: NOT TO SCALE	Vert. Scale: As Noted
Unit Information	Unit Leader Initials
MULLER	Muller Engineering Co., Inc. Consulting Engineers P:\10-028.13 - SH 9 Interconnect\Traffic_ITS
apexdesign	

Sheet Revisions		
Date:	Comments	Init.

Colorado Department of Transportation	
	18500 East Colfax Avenue Aurora, CO 80011 Phone: 303-757-9648 FAX: 303-757-9746
Region 1	SS

As Constructed
No Revisions:
Revised:
Void:

SPLICING DIAGRAM			
Designer:	C. SIGSBURY	Structure	
Detailer:	C. SIGSBURY	Numbers	
Sheet Subset:	SPLICE	Subset Sheets:	18 of 19

Project No./Code
MTCE 0091-039
18777
Sheet Number 76

FIBER CABLE SPLICE TABLE SH 9/10 MILE/WALMART								
CABLE DESCRIPTION	BUFFER COLOR	FIBER		SPliced TO	CABLE DESCRIPTION	BUFFER COLOR	FIBER	
		NO.	COLOR				NO.	COLOR
96 BACKBONE TO SOUTH	BLUE	1	BLUE		12 LATERAL TO TRAFFIC CABINET	BLUE	1	BLUE
96 BACKBONE TO SOUTH	BLUE	2	ORANGE		12 LATERAL TO TRAFFIC CABINET	BLUE	2	ORANGE
96 BACKBONE TO NORTH	BLUE	1	BLUE		12 LATERAL TO TRAFFIC CABINET	BLUE	3	GREEN
96 BACKBONE TO NORTH	BLUE	2	ORANGE		12 LATERAL TO TRAFFIC CABINET	BLUE	4	BROWN

PATCH PANEL TABLE SH 9/10 MILE/WALMART					
CABLE DESCRIPTION	BUFFER COLOR	FIBER		PATCH NO.	PATCHED TO
		NO.	COLOR		
12 LATERAL TO TRAFFIC CABINET	BLUE	1	BLUE	1	CISCO TRANSMIT
12 LATERAL TO TRAFFIC CABINET	BLUE	2	ORANGE	2	CISCO RECEIVE
12 LATERAL TO TRAFFIC CABINET	BLUE	3	GREEN	3	CISCO RECEIVE
12 LATERAL TO TRAFFIC CABINET	BLUE	4	BROWN	4	CISCO TRANSMIT

FIBER CABLE SPLICE TABLE SH 9/DILLION DAM								
CABLE DESCRIPTION	BUFFER COLOR	FIBER		SPICED TO	CABLE DESCRIPTION	BUFFER COLOR	FIBER	
		NO.	COLOR				NO.	COLOR
96 BACKBONE TO SOUTH	BLUE	1	BLUE		12 LATERAL TO TRAFFIC CABINET	BLUE	1	BLUE
96 BACKBONE TO SOUTH	BLUE	2	ORANGE		12 LATERAL TO TRAFFIC CABINET	BLUE	2	ORANGE
96 BACKBONE TO SOUTH	BLUE	3	GREEN		12 LATERAL TO TRAFFIC CABINET	BLUE	3	GREEN
96 BACKBONE TO SOUTH	BLUE	4	BROWN		12 LATERAL TO TRAFFIC CABINET	BLUE	4	BROWN

PATCH PANEL TABLE SH 9/DILLION DAM					
CABLE DESCRIPTION	BUFFER COLOR	FIBER		PATCH NO.	PATCHED TO
		NO.	COLOR		
12 LATERAL TO TRAFFIC CABINET	BLUE	1	BLUE	1	CISCO TRANSMIT
12 LATERAL TO TRAFFIC CABINET	BLUE	2	ORANGE	2	CISCO RECEIVE
12 LATERAL TO TRAFFIC CABINET	BLUE	3	GREEN	3	CISCO TRANSMIT
12 LATERAL TO TRAFFIC CABINET	BLUE	4	BROWN	4	CISCO RECEIVE

5/1/2012 4:16:50 PM C:\Apex\Projects\18777\Traffic_ITS\Drawings\18777TRAF_Splice19.dgn

Print Date: 5/1/2012

Drawing File Name: 18777TRAF_Splice19.dgn

Unit Information

Horiz. Scale: NOT TO SCALE

Vert. Scale: As Noted

Unit Leader Initials

MULLER

Muller Engineering Co., Inc.
Consulting Engineers

P:10-028.13 - SH 9 Interconnect\Traffic_ITS

0000

apexdesign

Sheet Revisions		
Date:	Comments	Init.

Colorado Department of Transportation



18500 East Colfax Avenue
Aurora, CO 80011
Phone: 303-757-9648 FAX: 303-757-9746

Region 1

SS

As Constructed

No Revisions:

Revised:

Void:

SPLICING TABLES

Designer: C. SIGSBURY

Detailer: C. SIGSBURY

Sheet Subset: SPLICE

Structure Numbers


Subset Sheets: 19 of 19

Project No./Code

MTCE 0091-039

18777



Sheet Number 77

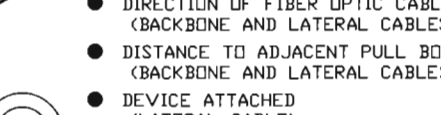- 
- DIRECTION OF FIBER OPTIC CABLE RUN
(BACKBONE AND LATERAL CABLES)
- DISTANCE TO ADJACENT PULL BOXES
(BACKBONE AND LATERAL CABLES)
- DEVICE ATTACHED
(LATERAL CABLE)
- TYPE OF CABLE
(BACKBONE AND LATERAL CABLES)
- NUMBER OF FIBERS IN CABLE
(BACKBONE AND LATERAL CABLES)
- DATE OF INSTALLATION
(BACKBONE AND LATERAL CABLES)

TO BE ATTACHED TO EACH FIBER OPTIC CABLE
LOCATED IN ALL PULL BOXES AND MANHOLES

1. CONDUITS DEPICTED ON THIS SHEET ARE REPRESENTATIVE ONLY. EXACT NUMBER OF CONDUITS INSTALLED AND CONDUIT SIZE SHALL BE AS TABULATED AND SHOWN ON THE PLANS.
2. DESIGNATION FOR THE INSTALLATION OF ELECTRICAL WIRING AND FIBER OPTIC CABLE IN THE BACKBONE CONDUIT SYSTEM IS DESCRIBED IN THE PROJECT SPECIFICATIONS.
3. CONDUIT CENTERLINE SHALL BE ALIGNED WITHIN THE PULL BOX TO FACILITATE FIBER OPTIC CABLE PULLING.
4. CONDUIT PLUGS SHALL BE INSTALLED IN ALL CONDUITS, BOTH WITH AND WITHOUT WIRE OR CABLE AND SHALL BE INCLUDED IN THE COST OF ELECTRICAL CONDUIT ITEM.
5. WEATHERPROOF TAGS SHALL BE INSTALLED ON ALL FIBER CABLES AND SHALL BE INCLUDED IN THE COST OF ELECTRICAL CONDUIT ITEM.
6. TRACER WIRE AND PULL TAPE SHALL BE INCLUDED IN THE COST OF FIBER OPTIC CABLE ITEM.
 - IF INSTALLATION INCLUDES MULTIPLE RUNS OF CONDUIT, PULL TAPE SHALL BE INSTALLED IN EACH INDIVIDUAL CONDUIT. TRACER WIRE SHALL BE INSTALLED IN ONLY ONE CONDUIT.
 - IF INSTALLATION INCLUDES ONLY ONE RUN OF CONDUIT, PULL ROPE AND TRACER WIRE SHALL BE INSTALLED IN SAME CONDUIT AS FIBER CABLE.
7. SEE 612 - MARKER SPECIFICATION FOR TRACER BALL REQUIREMENTS

8. ALL PULL BOX TYPES SHALL BE PAID FOR UNDER THE CORRESPONDING PULL BOX ITEM, AND SHALL BE SIZED AS TABULATED AND SHOWN IN THE PLANS.
9. SEE PROJECT SPECIFICATIONS FOR THE QUANTITY OF BOTH FIBER OPTIC BACKBONE AND LATERAL CABLE TO BE COILED IN EACH PULL BOX.
10. FIBER OPTIC CABLE COILS WITHIN PULL BOXES SHALL BE TIED TO EACH CABLE RACK. PLASTIC WIRE TIES SHALL NOT BE ALLOWED. CAUTION SHALL BE TAKEN TO COIL THE FIBER CABLE PER MANUFACTURER'S RECOMMENDATIONS.
11. ALL LANDSCAPE RESTORATION SHALL BE PAID FOR AS PART OF PULL BOX.
12. PULL BOX TYPES AS DEPICTED ON THIS PROJECT DETAIL SHEET SHALL NOT BE INSTALLED IN THE ASPHALT OR CONCRETE SHOULDER OF THE ROADWAY.
13. PULL BOXES SHALL HAVE A CONCRETE APRON SLOPED AWAY FROM PULL BOX OPENING. THE COST OF THE CONCRETE APRON SHALL BE PAID FOR AS PART OF THE PULL BOX ITEM.

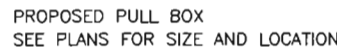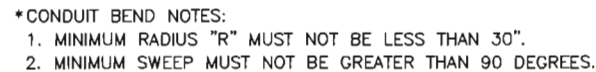

ITS PULL BOX INSTALLATION

5/22/2012 3:08:58 PM

Drawing File Name:18777TRAF_DetailPullBox.dgn

Unit Information	Unit Leader Initials
------------------	----------------------

MULLER

Muller Engineering Co., Inc.
Consulting Engineers

apexdesign

Date:	Comments	Init.
-------	----------	-------

--	--	--



Region 1

SS

No Revisions:

Revised:

Void:

Designer: C. SIGSBURY	Structure Numbers	
Detailer: C. SIGSBURY		
Sheet Subset: DETAIL	Subset Sheets:	1 of 4


MTCE 0091-039

18777


Sheet Number	78
--------------	----

NOTES:


- 1. CONTRACTOR SHALL CONFORM TO THE APPLICABLE AGENCY REQUIREMENTS AND SPECIFICATION FOR BORE CROSSINGS.
- 2. EXCAVATIONS AND DISTURBANCE LIMITS REQUIRE SEEDING AND MULCHING.
- 3. REFER TO SPECIAL PROVISIONS FOR REQUIREMENTS ON HANDLING AND DISPOSING OF BORING SLUDGE.
- 4. CONDUIT SPLICE CONNECTION EXCAVATION AND CONDUIT SPLICE SHALL NOT BE PAID SEPARATELY, BUT SHALL BE INCLUDED IN THE WORK.
- 5. CONTRACTOR SHALL BACKFILL AND REGRADE SITE TO MATCH EXISTING CONDITIONS.
- 6. CONTRACTOR MUST REPAIR ANY DAMAGE TO PAVEMENT CAUSED BY ERRANT BORING AT THEIR COST.
- 7. TRENCHES SHALL BE FILLED IN BY THE END OF THE WORK DAY. CONTRACTOR SHALL USE A BMP ON THE DOWNSTREAM SIDE OF ANY REMAINING SPOILS TO PREVENT THE TRANSPORT OF THE SEDIMENT DURING A RAIN EVENT.

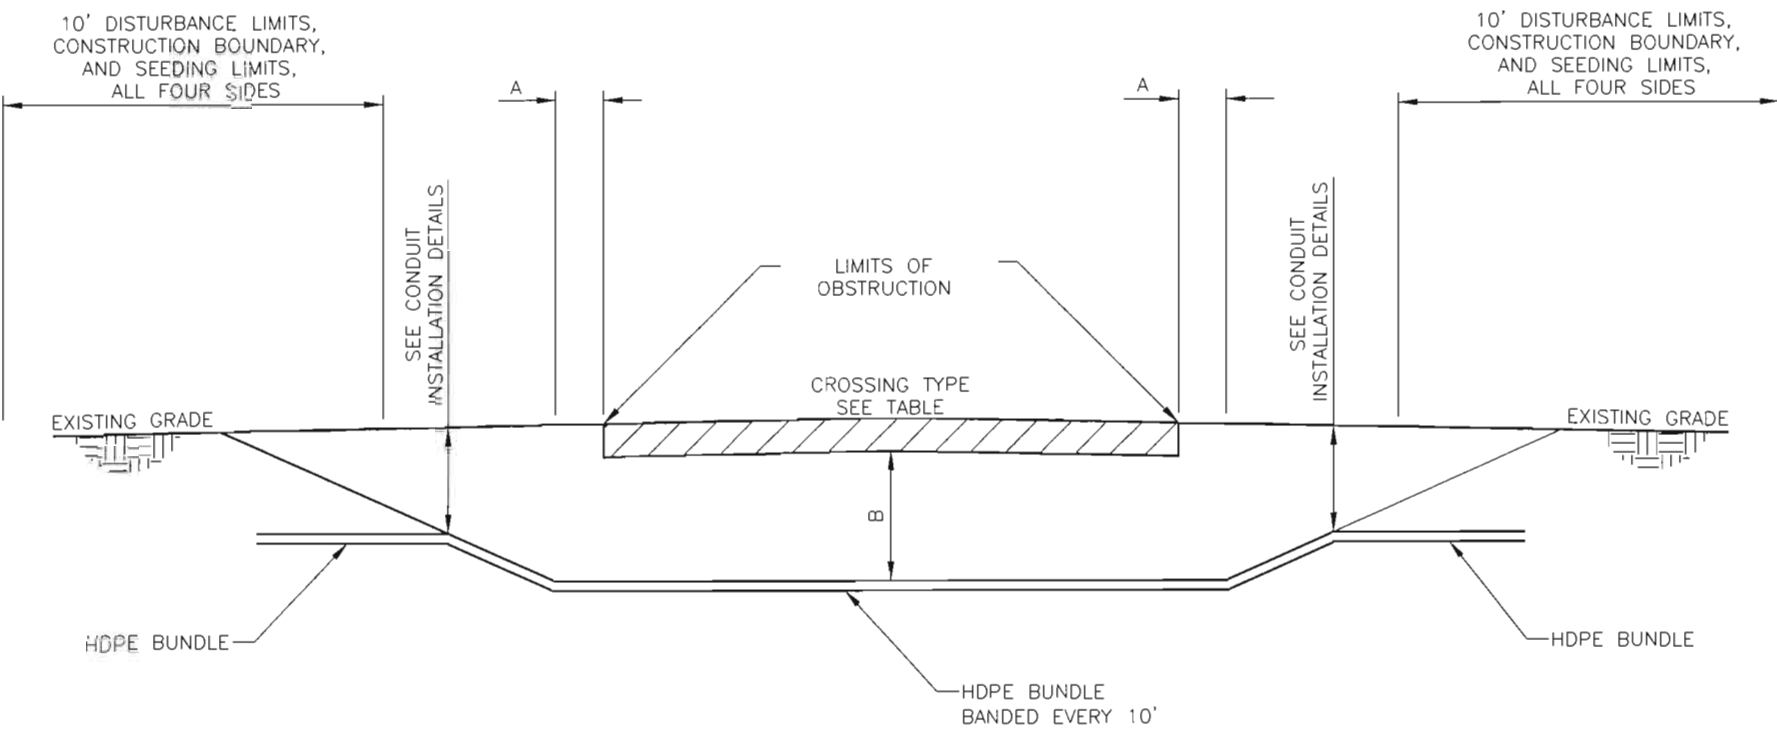


DIRECTIONAL BORE PROFILE
NTS

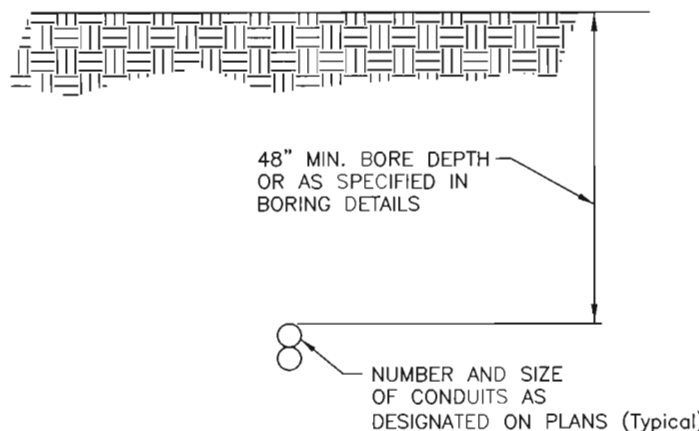

DIRECTIONAL BORE
NTS

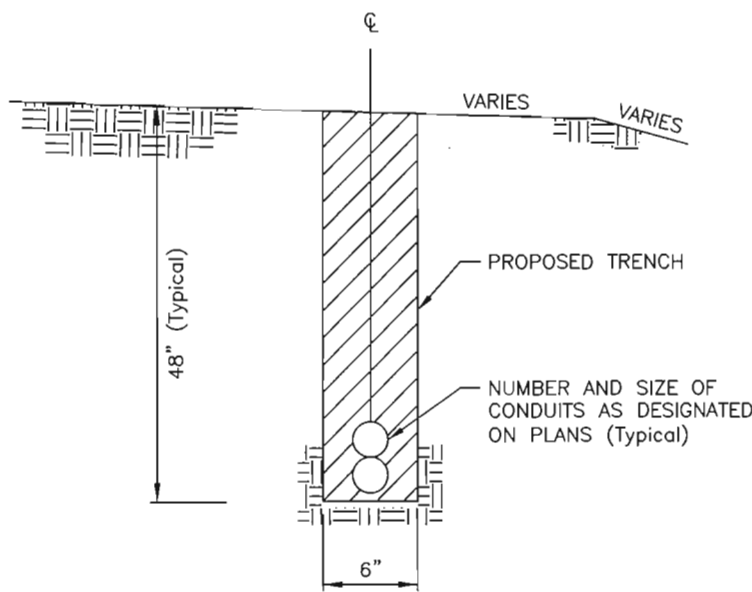

TRENCHING IN FILL
NTS

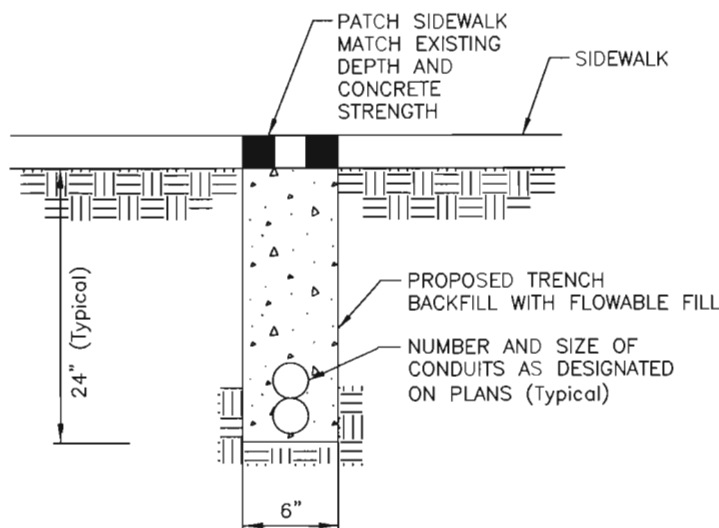

NOTE: SHALLOW TRENCH TO BE USED AS DIRECTED BY THE ENGINEER IN AREAS OF ROCKY SUBSURFACE CONDITIONS AND TO AVOID UTILITIES.

SHALLOW TRENCH
NTS

CROSSING TYPE	A	B
CULVERT	5' MIN	48" MIN
DRIVEWAY	5' MIN	48" MIN
DITCH	15' MIN	48" MIN
CROSS ROAD	15' MIN	48" MIN
FREEWAY	15' MIN	48" MIN
PRAIRIE DOGS	15' MIN	84" MIN
TREE	20' MIN	84" MIN
WATERWAY	50' MIN	48" MIN
WETLAND	50' MIN	48" MIN

5/22/2012 3:06:55 PM P:\10-028.13 Region 1 Umbrello 2011 CDDT\102 - SH 9 Signal Interconnect\18777\Traffic-ITS\Drawings\18777TRAF_DetailConduit.dgn

Print Date: 5/22/2012

Drawing File Name: 18777TRAF_DetailConduit.dgn

Horiz. Scale: NOT TO SCALE Vert. Scale: As Noted

Unit Information Unit Leader Initials

MULLER

Muller Engineering Co., Inc.
Consulting Engineers

P:\10-028.13 - SH 9 Interconnect\Traffic-ITS

apexdesign

Sheet Revisions		
Date:	Comments	Init.

Colorado Department of Transportation




18500 East Colfax Avenue
Aurora, CO 80011
Phone: 303-757-9648 FAX: 303-757-9746

Region 1

SS

As Constructed		CONDUIT INSTALLATION DETAIL			Project No./Code
No Revisions:					MTCE 0091-039
Revised:		Designer: C. SIGSBURY	Structure Numbers		18777
Void:		Detailer: C. SIGSBURY			
		Sheet Subset: DETAIL	Subset Sheets: 2 of 4		Sheet Number 79

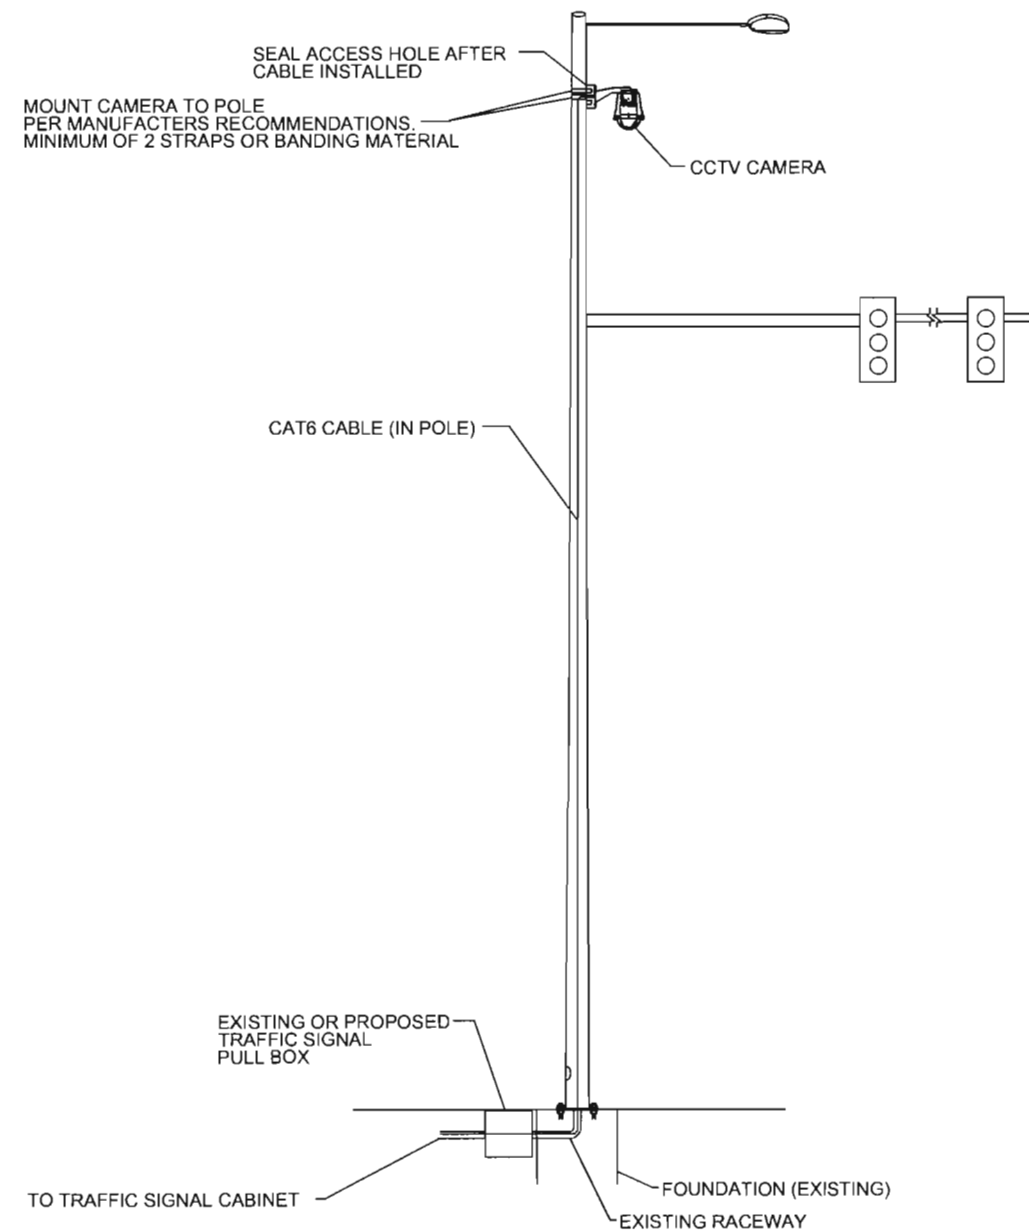

CCTV INSTALLATION DETAIL


NOTES:

1. STEEL STRAPS USED FOR ATTACHING BOTH THE POLE MOUNT ADAPTER AND CCTV CABINET TO THE POLE SHALL HAVE A MINIMUM WIDTH OF 3/4" AND BE MANUFACTURED OUT OF TYPE 201 STAINLESS STEEL. THEY SHOULD BE USED IN CONJUNCTION WITH TYPE 201 STAINLESS STEEL BUCKLES.
2. ALL DRILLED HOLES SHALL BE A MAXIMUM OF ONE INCH AND SHALL BE FREE OF BURS AND SHARP EDGES PRIOR TO THE INSTALLATION OF THE ETHERNET CABLE. GALVANIZING DAMAGED BY DRILLING OR ERECTION SHALL BE PAINTED WITH ZINC-RICH PAINT IN ACCORDANCE WITH CDOT SPECIFICATION 509.29.


5/22/2012 3:08:52 PM P:\10-028.13 Region 1 Umbrella 2011 CDOT\102 - SH 9 Signal Interconnect\18777\Traffic_ITS\Drawings\18777TRAF_DetailCamera.dgn

Print Date: 5/22/2012	
Drawing File Name: 18777TRAF_DetailCamera.dgn	
Horiz. Scale: NOT TO SCALE	Vert. Scale: As Noted
Unit Information	Unit Leader Initials
MULLER Muller Engineering Co., Inc. Consulting Engineers	apexdesign
P:\10-028.13 - SH 9 Interconnect\Traffic_ITS	

Sheet Revisions		
Date:	Comments	Init.

Colorado Department of Transportation	
	18500 East Colfax Avenue Aurora, CO 80011 Phone: 303-757-9648 FAX: 303-757-9746
Region 1	SS


As Constructed		CAMERA INSTALLATION DETAIL		Project No./Code
No Revisions:				MTCE 0091-039
Revised:		Designer: C. SIGSBURY	Structure Numbers	18777
Void:		Detailer: C. SIGSBURY		Sheet Number 80
		Sheet Subset: DETAIL	Subset Sheets: 3 of 4	

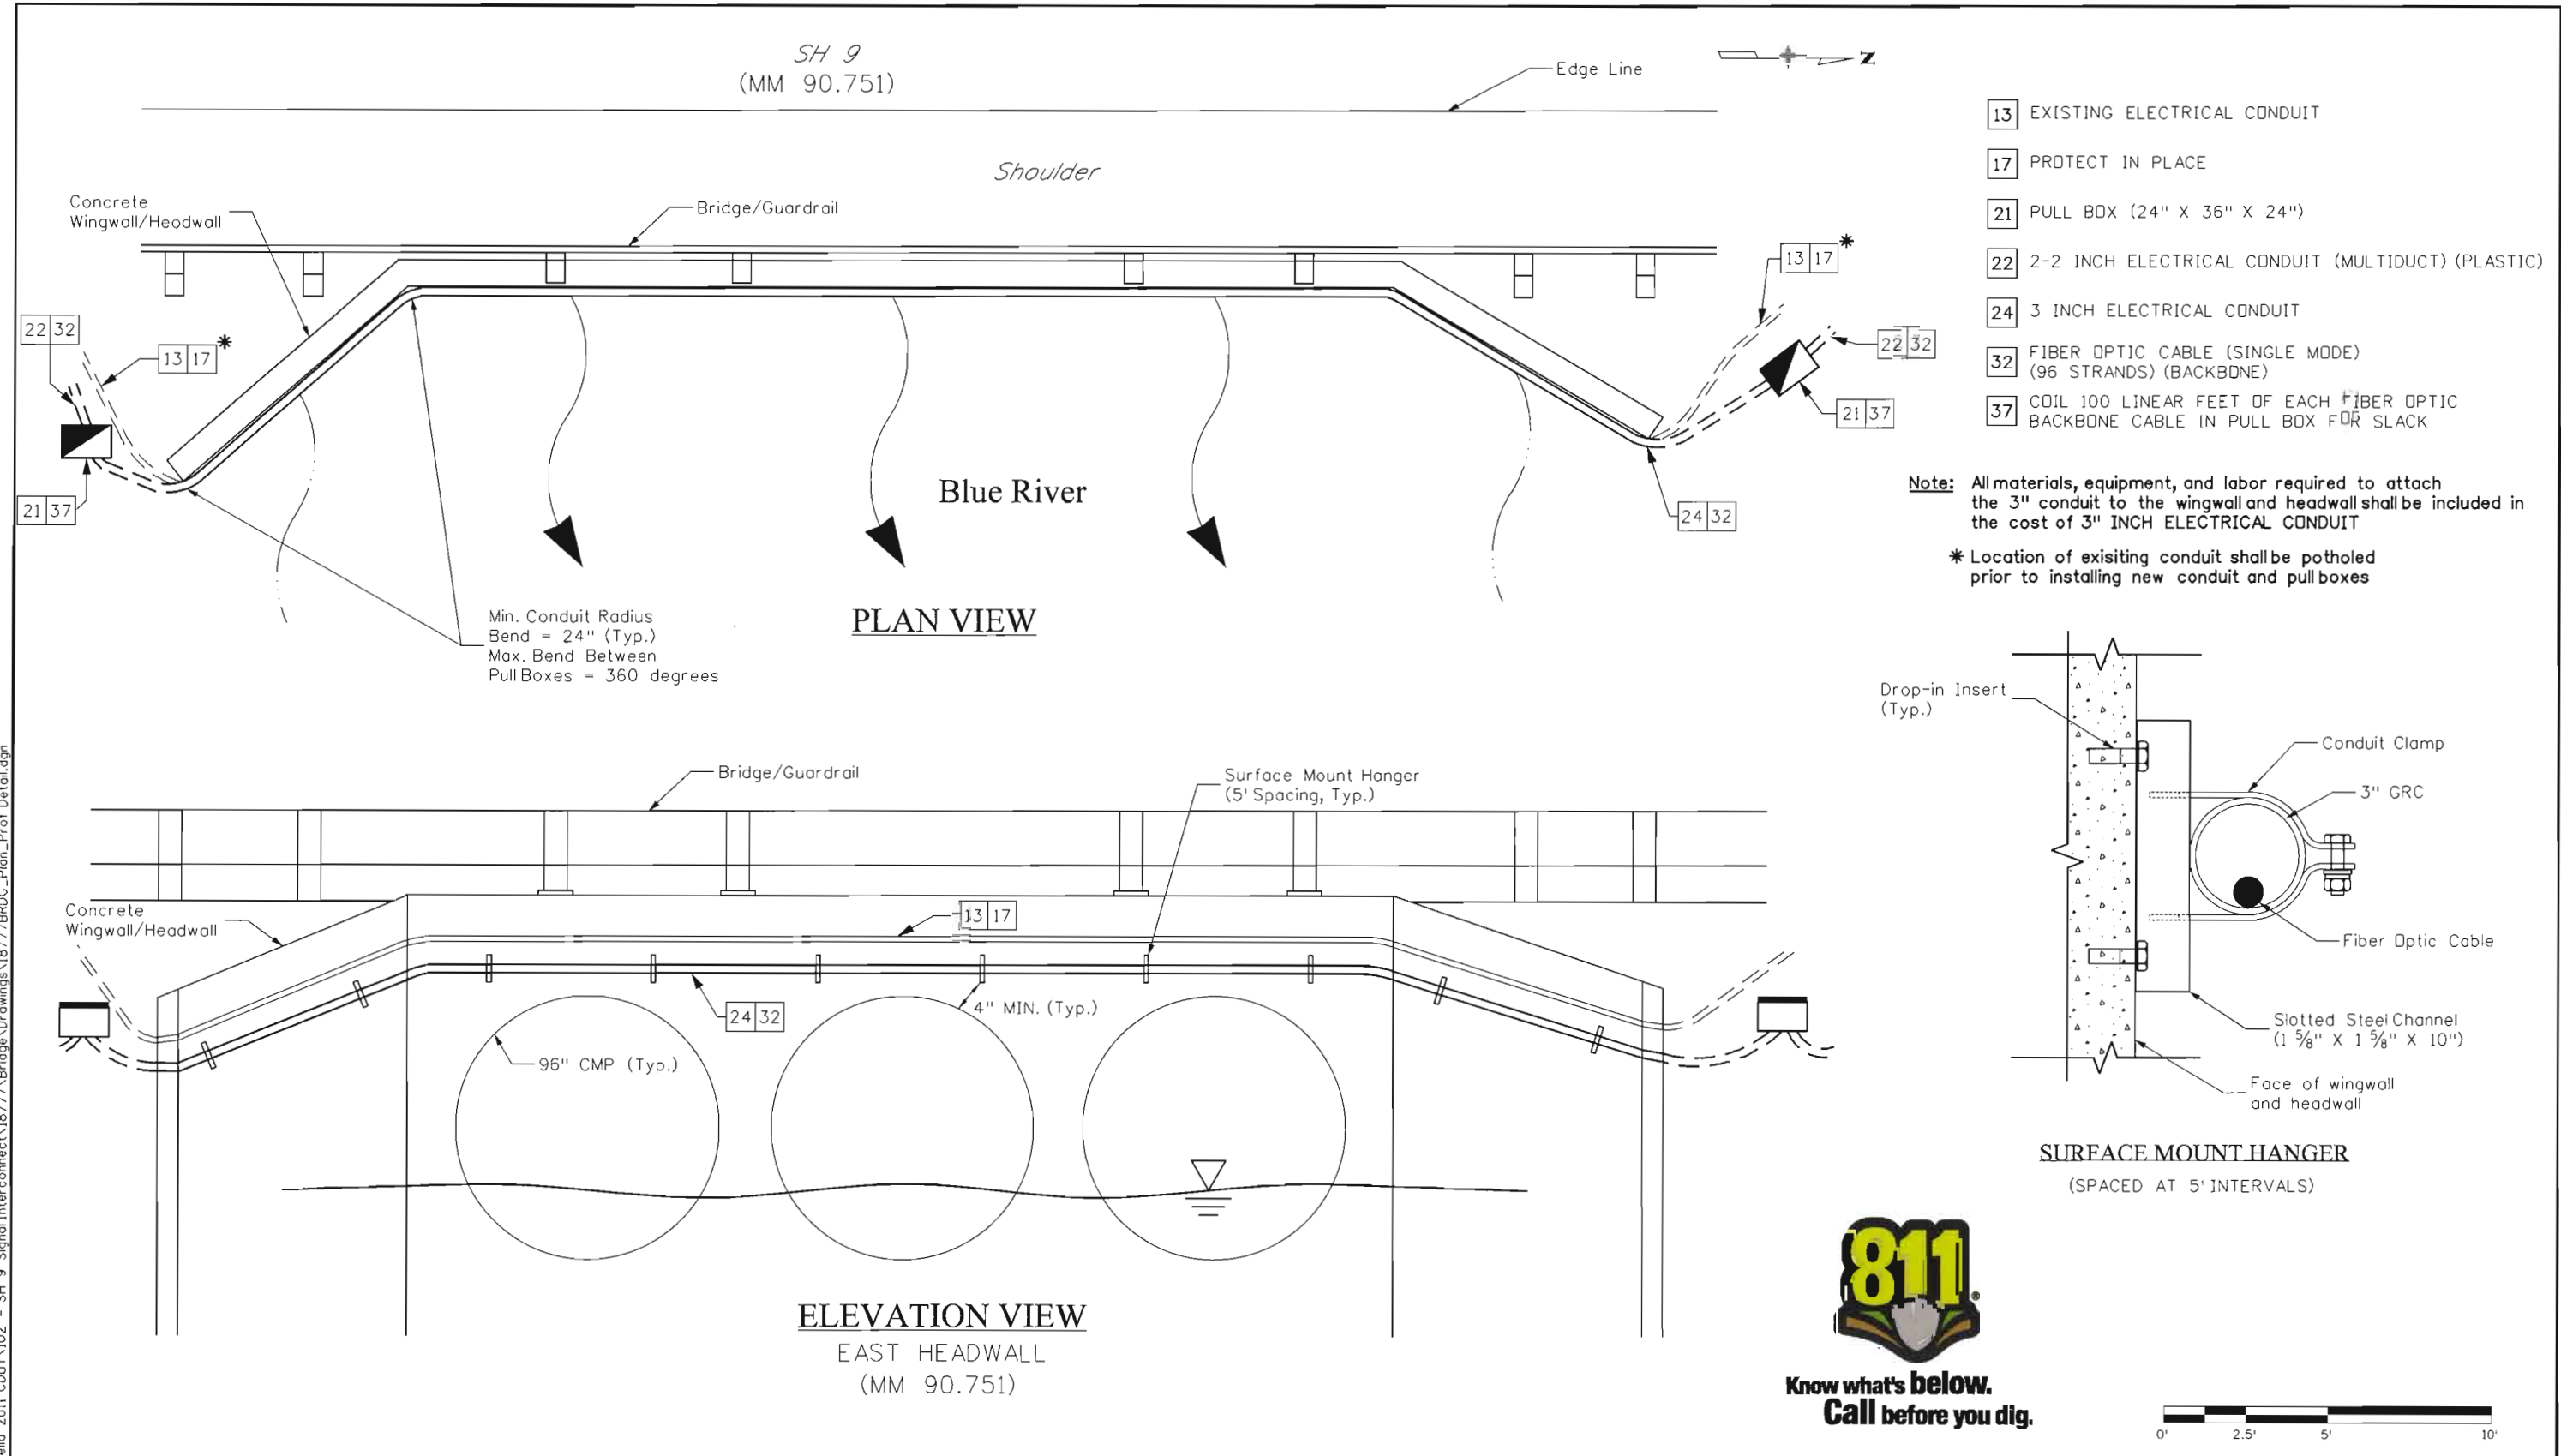

- 13 EXISTING ELECTRICAL CONDUIT
- 17 PROTECT IN PLACE
- 21 PULL BOX (24" X 36" X 24")
- 22 2-2 INCH ELECTRICAL CONDUIT (MULTIDUCT) (PLASTIC)
- 24 3 INCH ELECTRICAL CONDUIT
- 32 FIBER OPTIC CABLE (SINGLE MODE) (96 STRANDS) (BACKBONE)
- 37 COIL 100 LINEAR FEET OF EACH FIBER OPTIC BACKBONE CABLE IN PULL BOX FOR SLACK

Note: All materials, equipment, and labor required to attach the 3" conduit to the wingwall and headwall shall be included in the cost of 3" INCH ELECTRICAL CONDUIT


* Location of existing conduit shall be potholed prior to installing new conduit and pull boxes

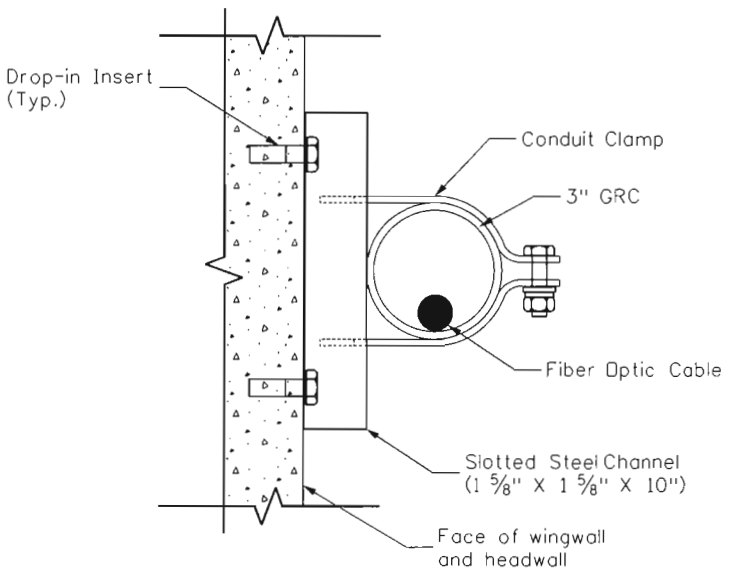

SURFACE MOUNT HANGER
(SPACED AT 5' INTERVALS)



**Know what's below.
Call before you dig.**

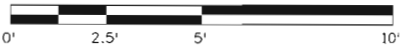

5/22/2012 3:08:49 PM P:\10-028.13 Region 1 Umbrella 2011 CDDT\102 - SH 9 Signal Interconnect\18777 Bridge\Drawings\18777 BRDG_Plan_Prof Detail.dgn

Print Date: 5/22/2012		<div><div></div><div></div><div></div><div></div><div></div></div>		Sheet Revisions		<div><div><div><div></div><div></div></div><div>DOT</div><div>Department of Transportation</div></div><div>Colorado Department of Transportation</div><div>18500 East Colfax Avenue Aurora, CO 80011 Phone: 303-757-9648 FAX: 303-757-9746</div><div>Region 1SS</div></div>		As Constructed		CONDUIT ATTACHMENT TO BLUE RIVER STRUCTURE (F-12-AX) – MM 90.751			Project No./Code	
Drawing File Name: I8777BRDC_Plan_Prof Detail.dgn				No Revisions:				MTCE 0091-039						
Horiz. Scale: 1:5 Vert. Scale: 1:5								Revised:		Designer: KEB	Structure Numbers	F-12-AX	18777	
Unit Information Unit Leader Initials										Detailer: PJS				
<div><div>MULLER</div><div>Muller Engineering Co., Inc. Consulting Engineers P:\10-028.13 - SH 9 Interconnect\Traffic_ITS</div></div>				apexdesign						Void:		Sheet Subset: DETAIL	Subset Sheets: 4 of 4	Sheet Number 81

1. SITE DESCRIPTION

For Information Only to fulfill the CDPS-SCP (Colorado Discharge Permit System - Stormwater Construction Permit) Update to reflect current project site conditions.

A. PROJECT SITE DESCRIPTION: Construction activities for this project will include boring and trenching of 2" plastic conduit along SH 9 from south of Breckenridge (MM 86.0) to east of Frisco (MM 95.4). In areas where there is existing conduit, new fiber optic cable will be installed in the existing conduit. Work also includes installing CCTV cameras on existing signal poles and minor work to install communications equipment in existing traffic signal cabinets.

B. PROPOSED SEQUENCING FOR MAJOR ACTIVITIES: The primary sequence will be to install the new conduit, then install pull boxes, pull fiber optic cable into the conduit and then install CCTV cameras and communications equipment at the signalized intersections.

C. ACRES OF DISTURBANCE:

- 1. Total area of construction site: 109 acres
- 2. Total area of disturbance: 5 acres
- 3. Acreage of seeding: 5 acres

D. EXISTING SOIL DATA: Existing soils in the project area consist of cobbly loams which are generally deep, nearly level to moderately steep, with sandy and gravelly soils on the uplands and loamy and sandy soils on floodplains and terraces.

E. EXISTING VEGETATION, INCLUDING PERCENT COVER: A survey of existing vegetation shall be conducted by CDOT Landscape Architect/Specialist prior to construction commencing. Project shall contact Jennifer Klaetsch (CDOT Landscape Specialist) at 303-757-9481 to arrange time and date.

F. POTENTIAL POLLUTANTS SOURCES: See First Construction Activities under Potential Pollutant Sources. The ECS shall prepare a list of all potential pollutants and their locations in accordance with subsection 107.25.

G. RECEIVING WATER:

- 1. Outfall locations: See Plan Sheets for locations
- 2. Names of receiving water(s) on site and the ultimate receiving water: The Blue River and a few unnamed tributaries to the Blue River are on site. The Blue River is the ultimate receiving water.
- 3. Distance ultimate receiving water is from project: The Blue River is approximately 200 feet from project.

H. ALLOWABLE NON-STORMWATER DISCHARGES: Concrete washout is anticipated on project.

- 1. Groundwater and stormwater dewatering: Discharges to the ground of water from construction dewatering activities may be authorized provided that:
 - a. the source is groundwater and/or groundwater combined with stormwater that does not contain pollutants
 - b. the source and BMPs are identified in the SWMP
 - c. discharges do not leave the site as surface runoff or to surface waters.
- 2. If discharges do not meet the above criteria a separate permit from the Department of Health will be required. Contaminated groundwater requiring coverage under a separate permit may include groundwater contaminated with pollutants from a landfill, mining activities, Industrial pollutant plumes, underground storage tank, etc.

I. ENVIRONMENTAL IMPACTS:

- 1. Wetland Impacts: YES NO
- 2. Stream Impacts: YES NO
- 3. Threatened and Endangered Species: None anticipated on project.

2. SITE MAP COMPONENTS*:

Pre-construction:

A. PROJECT CONSTRUCTION POTENTIAL SITE BOUNDARIES: See Plan Sheets

B. ALL AREAS OF GROUND SURFACE DISTURBANCE: See SWMP Boring and Trenching Typical Section and Plan View sheet

C. AREAS OF CUT AND FILL: None anticipated on project.

D. LOCATION OF ALL STRUCTURAL BMPs IDENTIFIED IN THE SWMP: See Plan Sheets

E. LOCATION OF NON-STRUCTURAL BMPs AS APPLICABLE IN THE SWMP: See Plan Sheets

F. SPRINGS, STREAMS, WETLANDS AND OTHER SURFACE WATER: See Plan Sheets

G. PROTECTION OF TREES, SHRUBS, CULTURAL RESOURCES AND MATURE VEGETATION:

H. AREAS USED FOR STORING AND STOCKPILING OF MATERIALS, STAGING AREAS (field trailer, fueling, etc) and BATCH PLANTS: See Plan Sheets

*ECS to revise site maps in accordance to 208.03

3. SWMP ADMINSTRATOR FOR DESIGN: CDOT Landscape Specialist

4. STORMWATER MANAGEMENT CONTROLS FIRST CONSTRUCTION ACTIVITIES

THE CONTRACTOR SHALL PERFORM THE FOLLOWING:

A. DESIGNATE A SWMP ADMINISTRATOR/EROSION CONTROL SUPERVISOR (To be filled out at time of construction; designate the individual(s) responsible for implementing, maintaining and revising SWMP, including the title and contact information. The activities and responsibilities of the administrator shall address all aspects of the projects SWMP.)

Name/Title: Contact information:

B. POTENTIAL POLLUTANT SOURCES
Evaluate, identify and describe all potential sources of pollutants at the site in accordance with subsection 107.25 and place in the SWMP notebook. All BMPs related to potential pollutants shall be shown on the SWMP site map by the contractor's ECS.

C. BEST MANAGEMENT PRACTICES (BMPs) FOR STORMWATER POLLUTION PREVENTION

PHASED BMP IMPLEMENTATION

During Design: "BMP as Designed" boxes are marked when used in the SWMP. During construction: the ECS shall update the "In use on site" boxes to match which BMPs are currently in use on site. Clearly describe the relationship between the phases of construction and the implementation of BMP controls.

STRUCTURAL BMPs that may be potentially used on the project for erosion and sediment control; practices may include, but are not limited to:

BMP	TYPE OF CONTROL	BMP as Designed	In use on site	FIRST CONSTRUCTION ACTIVITIES	DURING CONSTRUCTION	INTERIM/FINAL STABILIZATION
Earth Berm/Diversion	erosion			x	x	
*Check Dams	sediment	x		x	x	
Silt Fence	sediment			x	x	
Erosion Logs	sediment	x		x	x	
Temporary Sediment Trap	sediment			x	x	
Permanent Sediment Basin (used as temporary BMP)	sediment				x	x
Embankment Protector	erosion				x	x
Inlet Protection	erosion	x		x	x	
Outlet Protection	erosion	x			x	
Concrete Washouts	construction	x			x	
Vehicle Tracking Pad	construction			x	x	
Dewatering	sediment				x	
Temporary Stream Crossing	erosion			x	x	
Clean water diversion					x	
Other						

NON-STRUCTURAL BMPs that may be potentially used on the project for erosion and sediment control; practices may include, but are not limited to:

BMP	TYPE OF CONTROL	BMP as Designed	In use on site	FIRST CONSTRUCTION ACTIVITIES	DURING CONSTRUCTION	INTERIM/FINAL STABILIZATION
Surface Roughening/Grading Techniques	erosion	x			x	
Seeding Permanent	erosion	x				x
Seeding Temporary	erosion				x	
Mulch/Mulch Tackifier	erosion	x			x	x
Soil Binder	erosion				x	
Soil Retention Blanket	erosion	x			x	x
Turf Reinforcement Mat	erosion				x	x
Vegetative Buffer Strips	erosion	x		x	x	x
Protection of Trees	erosion			x	x	
Preservation of Mature Vegetation	erosion			x	x	x
Spray-on Mulch Blanket	erosion	x			x	x

*Check dams may be rock, erosion logs, silt dike, silt berm, etc. as indicated in the narratives and SWMP site map. Erosion control devices are used to limit the amount of soil loss on site. Sediment control devices are designed to capture sediment on the project site. Construction control are BMPs related to construction access and staging. BMP locations are indicated on the SWMP site map.

Print Date: 2/21/2012	<div><div>(R-X)</div><div></div><div></div><div></div></div>	Sheet Revisions			Colorado Department of Transportation		As Constructed		STORMWATER MANAGEMENT PLAN		Project No./Code	
File Name: 18777_SWMP_typsec_planview.dgn		Date:	Comments	Init.	18500 East Colfax Avenue Aurora, CO 80013 Phone: 303-757-9648 FAX: 303-757-9746		No Revisions:				WTCE 10091-039	
Horiz. Scale: NOT TO SCALE Vert. Scale: As Noted					Region 1		Revised:		Designer: JMK Structure Numbers		18777	
Unit Information Unit Leader Initials					SIS		Void:		Sheet Subsect: SWMP Subsect Sheets: 1 of 4		Sheet Number 82	

I:\Users\kloetschj\Documents\18777_SH 9 Fiber_signal\interconnect\18777_SWMP_typsec_planview.kiaetschj 11:

NARRATIVES

Trenching Operations

1. When trenching operations go through or directly adjacent to shrubs or trees, vegetation shall be protected from unnecessary encroachment by installing fence (plastic) and erosion logs. When necessary, trees and shrubs within the 10' work zone may be trimmed to the ground at no additional cost to the project.
2. Trenching operations – trenching shall be kept to a maximum disturbance (includes trench, spoils, equipment) width of 10 feet centered on the trench. When trenching occurs adjacent to a ditch or wetlands, prior to construction commencing, orange plastic fence shall be placed in combination with erosion log to prevent encroachment of construction traffic and sediment into state waters (i.e. ditches, wetlands). Fence (plastic) shall be placed adjacent to the wetlands; erosion logs shall be placed between the plastic fence and disturbance area. Logs shall be placed to direct flows away from or filter water running into wetlands from disturbance areas.
3. The Contractor shall limit construction activities to those areas within the limits of disturbance. Disturbance is limited to a 10' wide swath that is centered on the trench. Any disturbance beyond these limits shall be restored to its original condition by the contractor at their expense.
4. The Contractor shall limit trenching activities to a maximum of 300 LF open trenching at any one time. All material removed during trenching shall be replaced in the order in which it was removed. Backfilling of trenches will be accomplished by the end of each work day.

Erosion Logs

Erosion logs are used to filter sediment laden run-off from disturbed areas during construction.

1. All trenching material shall be kept out of the roadway ditch line and existing wetlands. When trenching occurs adjacent to or on slope above a ditch or wetland, a determination where erosion logs shall be placed to prevent sediment from reaching the ditch shall be made. Erosion log locations and associated narrative shall be added to the site map by ECS.
2. If trench line crosses a ditch a log shall be placed as a check to reduce the potential of sediment from trenching operations going down the ditch line.
3. All inlets that are within the work area, where there is a potential for sediment from trenching operations reaching the inlet, shall be protected with erosion logs. Locations and associated narrative shall be added to the site map.
4. At boring locations, perimeter control (erosion logs) shall be used to prevent erosion from water used during boring operations. Locations shall be added to the site map. A detail and associated narratives shall be added to the SWMP notebook.
5. Pull box operations – place erosion logs on down hill side of pull box operations to prevent sediment from pull box operations from entering state waters (i.e. ditches, wetlands). Maximum allowable work area at pull box locations is 10' x 10'.
6. Boring operations – prior to boring operations commencing erosion logs shall be placed at the low points surrounding work area. Erosion logs shall be trenched into the ground a minimum of 2 inches to ensure water from boring operation and sediment laden stormwater cannot run directly underneath the log. J-hook ends of the logs up gradient to prevent water from flowing around the logs. Inspect logs throughout boring operations to ensure water is not running underneath, around logs or causing rilling.

Boring shall be not take place within 50 feet of states waters, including wetlands and other aquatic features.

7. Culvert inlet protection – prior to work commencing, erosion logs shall be placed at existing culverts where disturbance may be occurring adjacent to pipe and cause sediment laden water to enter pipe.
8. Type C/D inlets – prior to work commencing, erosion logs shall be placed at Type C/D inlets where disturbance may be occurring adjacent to inlet and cause sediment laden water to enter system.

Concrete

Concrete/debris and waste from placing new signs, pull boxes, etc. and any spoils from digging new holes shall be picked up and disposed of properly to an offsite location at the end of each day. Removal of spoils, concrete, debris and waste shall not be paid for separately but will be included in the cost of work.

Vegetative Buffer Strips

Existing vegetation shall be used as a BMP on the project. Existing vegetation aids with erosion and sediment control, and protects water quality. Areas of preserved vegetation shall be marked on the site map; preserved vegetation are those areas outside of disturbance (shoulder operation limit) line to the right of way fence. The amount of sediment reaching buffer strips shall be kept to a minimum by placing temporary and permanent erosion control features on disturbed slopes. If sediment does enter buffer strips, within disturbance areas, and covers existing vegetation it shall be cleaned/re-seeded/mulched/mulch tackified as directed. Sediment outside of disturbance areas shall be cleaned/re-seeded/mulch/mulch tackified at the expense of the Contractor. Sediment in vegetative ditches shall be kept to a minimum to prevent sediment laden water from exiting the project site or state waters.

Landform

Landforms prevent sediment from entering/exiting onto a site. When a landform is present other BMPs may not be necessary. If a landform directs flow of water to a concentrated outfall point, the outfall point shall be protected to prevent erosion. If BMPs are needed at outfall point the ECS shall add location, type and appropriate narrative to the plans or SWMP notebook. ECS shall mark landforms on the site map when they are being used as a BMP.

NARRATIVES (CONT.)

Permanent Seeding

Seeding is used to control runoff and erosion on disturbed areas. Completed areas shall be seeded within 48 hours. Seeded areas shall be inspected frequently for areas of failure. See Interim and Final Stabilization for application.

Mulch and Mulch Tackifier

Mulch and mulch tackifier shall be in accordance with subsection 213.03 (a). Crimping in ditch lines shall follow the contour, crimp rows running down a ditch line shall not be allowed.

Spray-on Mulch Blanket

Spray-on mulch blanket is used to stabilize erodible stockpiles that may be in place for an extended period of time or may be used in lieu of mulch/mulch tackifier or blanket in seeding operations. Spray-on mulch blanket shall not be used in areas of concentrated flows (i.e. ditch lines). Spray-on mulch blanket can be used in small disturbed areas requiring seeding when crimping of mulch will be difficult.

BMP DETAILS AND NARRATIVES NOT COVERED BY THE SWMP OR STANDARD PLAN M-208-1 SHALL BE ADDED TO THE SWMP NOTEBOOK BY THE ECS.

D. OFFSITE DRAINAGE (RUN ON WATER)

1. Describe and record BMPs on the SWMP site map that has been implemented to address off site run-on water in accordance with subsection 208.03.

E. VEHICLE TRACKING PAD/VEHICLE TRACKING CONTROL

1. BMPs shall be implemented in accordance with subsection 208.04.

F. PERIMETER CONTROL

1. Perimeter control shall be established as the first item on the SWMP to prevent the potential for pollutants leaving the construction site boundaries, entering the stormwater drainage system, or discharging to state waters.
2. Perimeter control may consist of vegetation buffers, berms, silt fence, erosion logs, existing landforms, or other BMPs as approved.
3. Perimeter control shall be in accordance with subsection 208.04.

5. DURING CONSTRUCTION

RESPONSIBILITIES OF THE SWMP ADMINISTRATOR/EROSION CONTROL SUPERVISOR DURING CONSTRUCTION

The SWMP should be considered a "living document" that is continuously reviewed and modified. During construction, the following items shall be added, updated, or amended as needed by the SWMP Administrator/Erosion Control Supervisor (ECS) in accordance with Section 208.

During construction, indicate how items that have not been addressed during design are being handled in construction. If items are covered in the template or other sections of the SWMP notebook indicate below what section the discussion takes place.

- A. STOCKPILE MANAGEMENT - shall be done in accordance with subsection 101.95 and 208.07
- B. CONCRETE WASHOUT - Concrete wash out water or waste from field laboratories and paving equipment shall be contained in accordance with subsection 208.05.
- C. SAW CUTTING - shall be done in accordance with subsection 101.95, 208.04, 208.05
- D. STREET CLEANING - shall be done in accordance with subsection 208.04

6. INSPECTIONS

- A. Inspections shall be in accordance with subsection 208.03 (c).

7. BMP MAINTENANCE

- A. Maintenance shall be in accordance with subsection 208.04 (f).

8. RECORD KEEPING

- A. Records shall be kept in accordance with subsection 208.03 (c).

Print Date: 2/21/2012	<div><div>(R-X)</div><div></div><div></div><div></div></div>	Sheet Revisions			<div>Colorado Department of Transportation</div> <div><div><div><div></div></div><div>DOT</div><div>DEPARTMENT OF TRANSPORTATION</div></div><div>13500 East Colfax Avenue Aurora, CO 80011 Phone: 303-757-9648 FAX: 303-757-9746</div><div>Region 1SS</div></div>	As Constructed	STORMWATER MANAGEMENT PLAN			Project No./Code	
File Name: 18777_SWMP_typsec_planview.dgn		Date:	Comments	Init.		No Revisions:				MTCE 0091-039	
Horiz. Scale: NOT TO SCALE Vert. Scale: As Noted						Revised:				18777	
Unit Information Unit Leader Initials						Void:				Sheet Number	83.
							Designer: JMK	Structure Numbers			
							Detaler: JMK				
							Sheet Subset: SWMP	Subset Sheets: 2 of 4.			

9. INTERIM AND FINAL STABILIZATION

A. **SEEDING PLAN** Soil preparation, soil conditioning or topsoil, seeding (native), mulching (weed free) and mulch tackifier will be required for an estimated 5 acres of disturbed area within the right-of-way limits which are not surfaced. The following types and rates shall be used:

COMMON NAME	BOTANICAL NAME	LBS. PLS PER ACRE
Blue grama	<i>Bouteloua gracilis</i> 'Hachita'	0.5
Arizona fescue	<i>Festuca arizonica</i> 'Redondo'	1.0
Idaho fescue	<i>Festuca Idahoensis</i>	2.0
Canada wildrye	<i>Elymus canadensis</i>	6.2
Sandberg bluegrass	<i>Poa sandbergii</i>	0.2
Western wheatgrass	<i>Pascopyrum smithii</i> 'Rosanna'	6.5
Mountain brome	<i>Bromus marginatus</i> 'Bromar'	4.0
Prairie junegrass	<i>Koeleria macrantha</i>	0.1
Slender wheatgrass	<i>Elymus trachycaulus ssp. trachycaulus</i> 'Pryor'	1.0
Oats	<i>Avena sativa</i>	3.0
Western yarrow	<i>Achillea millefolium var. occidentalis</i>	0.1
Rocky Mountain penstemon	<i>Penstemon strictus</i>	1.0
TOTAL		25.6

B. **SEEDING APPLICATION:** Drill seed 0.25 inch to 0.5 inch into the soil. In small areas not accessible to a drill, hand broadcast at double the rate and rake 0.25 inch to 0.5 inch into the soil.

C. **MULCHING APPLICATION:** Apply a minimum of 1 ½ tons of certified weed free native hay per acre and in accordance with Section 212, and mechanically crimp it into the soil in combination with an organic mulch tackifier.

D. **SPECIAL REQUIREMENTS:** Due to high failure rates, hydromulching and/or hydroseeding will not be allowed.

E. **SOIL CONDITIONING AND FERTILIZER REQUIREMENTS:** [Minimum requirements for all disturbances to receive seeding (native). Compost is optional within areas above 8000 ft in elevation]

Soil conditioner paid for as Item 212- Soil Conditioning (Acre)		
Biological nutrient organic based fertilizer (lbs/acre)*	Humate (lbs/acre)	Compost (cys/acre) (1/2 inch depth)
600	200	65

*Biological nutrient shall not exceed 8-8-8 (N-P-K). Humate based material shall be in accordance to Section 212 and compost shall be in accordance to Special Provision 212. Refer to Project Special- Topsoil for additional topsoil amendments.[Include Topsoil Project Special] Placing compost when required to amend embankment and as soil conditioner may be combined as a single application.

F. **BLANKET APPLICATION:** On slopes and ditches requiring a blanket, the blanket shall be placed in lieu of mulch and mulch tackifier. See SWMP for blanket locations.

G. RESEEDING OPERATIONS/CORRECTIVE STABILIZATION

Prior to final acceptance.

- Seeded areas shall be reviewed during the 14 day inspections by the Erosion Control Supervisor for bare soils caused by surface or wind erosion. Bare areas caused by surface or gully erosion, blown away mulch, etc. shall be regraded, seeded, mulched and have mulch tackifier (or blanket) applied as necessary, at no additional cost to the project.
- Areas where seed has not germinated after one season shall be evaluated by the Engineer and CDOT Landscape Architect. Areas that have not germinated shall have seed, mulch and mulch tackifier (or blanket) reapplied. Work shall be paid for by the appropriate bid item.

10. PRIOR TO FINAL ACCEPTANCE

A. Final Acceptance shall be in accordance with subsection 208.10.

11. TABULATION OF STORMWATER QUANTITIES


Pay Item	Description	Pay Unit	*Quantity
203	Blading	Hour	20
208	Sweeping (Sediment Removal)	Hour	54
208	Removal of Trash	Hour	36
208	Erosion Log (12 Inch)	LF	4000
208	Concrete Washout Structure	Each	4
208	Removal and Disposal of Sediment (Equipment)	Hour	20
208	Removal and Disposal of Sediment (Labor)	Hour	50
208	Erosion Control Supervisor	Hour	300
208	Gravel Bag	LF	500
212	Seeding (Native)	Acre	5
212	Soil Conditioning	Acre	5
213	Mulching (Weed Free Hay)	Acre	5
213	Mulch Tackifier	LB	1000
213	Spray-on Mulch Blanket	Acre	3
210	Soil Retention Blanket (Straw/Coconut) (Biodegradable Class 1)	SF	500
700	Erosion Control	FA	1

*It is anticipated that additional BMPs and BMP quantities not shown on the SWMP Site Maps shall be required on the project for unforeseen conditions and replacement of items that are beyond their useful service life, see subsection 208.03 and 208.04 (e). Quantities for all BMPs shown above are estimated, and have been increased for unforeseen Project conditions.

- A. BMP sediment removal and disposal shall be paid for as: 208 Removal and Disposal of Sediment (Equipment) and 208 Removal and Disposal of Sediment (Labor). All other BMP maintenance shall be included in the cost of the BMP Device.
- B. It is estimated that 20 hours of blading may be required for miscellaneous erosion control work as directed by the Engineer. Work shall be paid for as: 203 Blading.

Print Date: 5/23/2012		<div>R-X</div> <div></div> <div></div> <div></div>	Sheet Revisions			<div><div>Colorado Department of Transportation</div><div>18500 East Colfax Avenue Aurora, CO 80011 Phone: 303-757-9648 FAX: 303-757-9746</div><div>Region 1SS</div></div>	As Constructed		STORMWATER MANAGEMENT PLAN			Project No./Code	
File Name: 18777_SWMP_typsec_planview.dgn			Date:	Comments	Init.		No Revisions:					MTCE 0091-039	
Horiz. Scale: NDT TO SCALE Vert. Scale: As Noted							Revised:		Designer: JMK	Structure	18777		
Unit Information Unit Leader Initials							Void:		Detailer: JMK	Numbers	Sheet Number 84		
									Sheet Subset: SWMP	Subset Sheets: 3 of 4			

Colorado Department of Transportation



18500 East Colfax Avenue
Aurora, CO 80011
Phone: 303-757-9648 FAX: 303-757-9746

Region 1

SS

TABULATION OF TRAFFIC CONTROL ITEMS

ITEM NO.	ITEM	UNIT	TOTALS
630	FLAGGING	hour	350
630	TRAFFIC CONTROL INSPECTION	DAY	48
630	TRAFFIC CONTROL MANAGEMENT	DAY	120
630	BARRICADE (TYPE 3 M-A) (TEMPORARY)	EA	2
630	CONSTRUCTION TRAFFIC SIGN (PANEL SIZE A)	EA	8
630	CONSTRUCTION TRAFFIC SIGN (PANEL SIZE B)	EA	24
630	CONSTRUCTION TRAFFIC SIGN (PANEL SIZE C)	EA	8
630	PORTABLE MESSAGE SIGN PANEL	EA	2
630	ADVANCE WARNING FLASHING OR SEQUENCING ARROW PANEL (C TYPE)	EA	2
630	DRUM CHANNELIZING DEVICE	EA	50
630	TRAFFIC CONE	EA	100
630	IMPACT ATTENUATOR (TRUCK MOUNTED ATTENUATOR) (TEMPORARY)	EA	1

NOTES:

QUANTITIES OF TRAFFIC CONTROL DEVICES ARE FOR ONE (1) LOCATION ONLY. SHOULD THE CONTRACTOR CHOOSE TO WORK ON MORE THAN ONE LOCATION AT THE SAME TIME, ALL ADDITIONAL TRAFFIC CONTROL DEVICES SHALL BE FURNISHED BY THE CONTRACTOR AT HIS OWN EXPENSE.


THE CONTRACTOR WILL BE REQUIRED TO COVER ANY EXISTING SIGNS WHICH CONFLICT WITH CONSTRUCTION SIGNS AS REQUIRED IN SECTION 630.11 OF THE 2011 CDOT STANDARD SPECIFICATION FOR ROAD & BRIDGE CONSTRUCTION.



SCHEDULE OF CONSTRUCTION TRAFFIC CONTROL SIGNS

SIGN CODE	LEGEND	DIMENSION	PANEL SIZE		
			A	B	C
			EA	EA	EA
W20-1	ROAD WORK AHEAD	48 x 48		4	
W20-4	ONE LANE ROAD XX FT	48 x 48		2	
W20-7a	FLAGGER	48 x 48		2	
W21-5	SHOULDER WORK	48 x 48		4	
W21-5b	SHOULDER CLOSED (DIST)	48 x 48		4	
R9-9	SIDEWALK CLOSED	24 x 12	2		
R52-6b	BEGIN FINES DOUBLE IN WORK ZONE	48 x 60			4
R52-6c	END FINES DOUBLE IN WORK ZONE	48 x 60			4
R52-6	FINES DOUBLE	48 x 48		4	
M4-9a	BIKE/PED DETOUR	30 x 24	2		
G20-5	WORK ZONE	48 x 12	4		
G20-10	XYZ CONSTRUCTION THANKS YOU	48 x 48		4	
TOTALS			8	24	8



5/22/2012 3:00:54 PM P:\10-028.13 Region 1 Umbrella 2011 CDOT\102 - SH 9 SignalInterconnect\18777\Traffic\ITS\Drawings\18777TRAF_Control.dgn



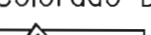
Print Date: 5/22/2012		Sheet Revisions			Colorado Department of Transportation		As Constructed		TRAFFIC CONTROL NOTES AND TABULATION				Project No./Code	
Drawing File Name: 18777TRAF_Control.dgn													MTCE 0091-039	
Horiz. Scale: 1:100		Vert. Scale: As Noted		<div>0000</div>	Date:	Comments	Init.	No Revisions:	Designer: KEB		Structure	18777		
Unit Information		Unit Leader Initials						Revised:	Detoiler: PJS		Numbers	Sheet Number 86		
<div>MULLER</div> Muller Engineering Co., Inc. Consulting Engineers		apexdesign						Void:	Sheet Subset: CTC		Subset Sheets: 1 of 1			
P:\10-028.13 - SH 9 Interconnect\Traffic\ITS														
					<div> 18500 East Colfax Avenue Aurora, CO 80011 Phone: 303-757-9648 FAX: 303-757-9746</div>			SS						
					Region 1									

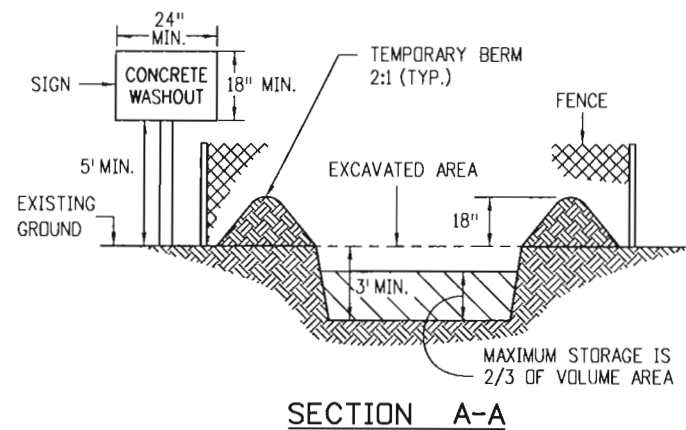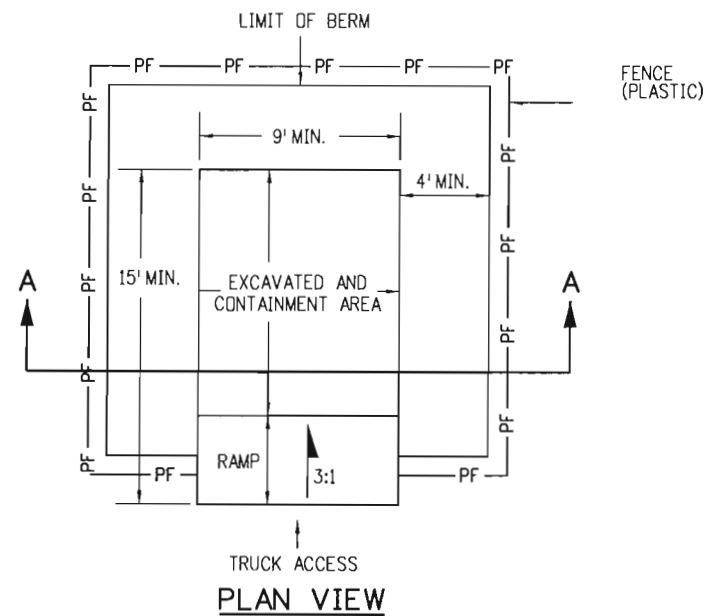

NOTES:

1. EROSION BALES MAY BE USED AS AN ALTERNATIVE FOR THE BERM.
2. A FENCE (PLASTIC) CONFORMING TO SUBSECTION 607.02 SHALL BE INSTALLED AROUND THE CONCRETE WASHOUT AREA, EXCEPT AT THE OPENING.
3. THE CONCRETE WASHOUT SIGN SHALL HAVE LETTERS AT LEAST 3 INCHES HIGH AND CONFORM TO SUBSECTION 630.02.

CONCRETE WASHOUT STRUCTURE

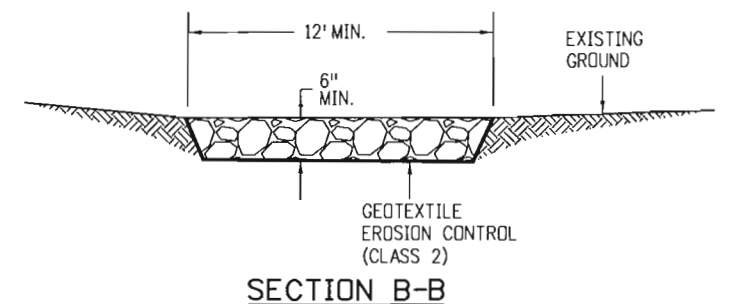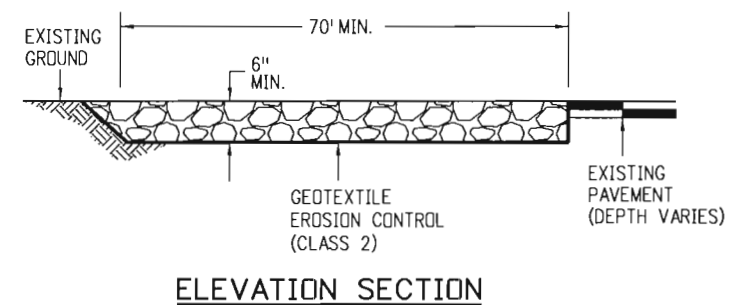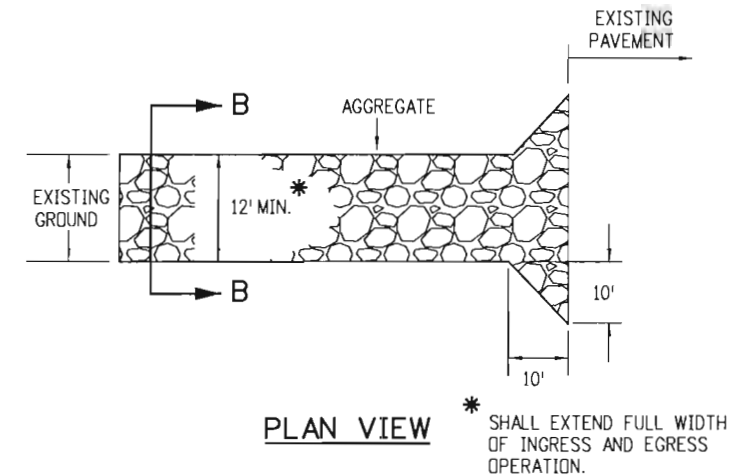


NOTES:


1. AGGREGATE FOR THE CONSTRUCTION ENTRANCE SHALL CONFORM TO SUBSECTION 208.02 (K).
2. THE CONTRACTOR SHALL PROTECT CURB AND GUTTER THAT CROSSES THE ENTRANCE FROM DAMAGE. PROTECTION OF THE CURB AND GUTTER WILL NOT BE PAID FOR SEPARATELY, BUT SHALL BE INCLUDED IN THE WORK.

VEHICLE TRACKING PAD


Computer File Information		Sheet Revisions		Colorado Department of Transportation 4201 East Arkansas Avenue Denver, Colorado 80222 Phone: (303) 757-9083 Fax: (303) 757-9820 Project Development Branch DD/LTA	TEMPORARY EROSION CONTROL	STANDARD PLAN NO. M-208-1 Sheet No. 1 of 12
Creation Date: 06/08/10	Initials: DD	Date:	Comments			
Last Modification Date: 07/29/11	Initials: LTA	(R-X) 08/26/10	Revised to meet new water quality standards.		Issued By: Project Development Branch on July 04, 2006	
Full Path: www.dot.state.co.us/DesignSupport/		(R-X)	Revised sheets 1-7 and added sheets 8-12.			
Drawing File Name: 2080101012.dgn		(R-X) 07/29/11	Revised sheet 5 of 12.			
CAD Ver.: MicroStation V8	Scale: Not to Scale Units: English					

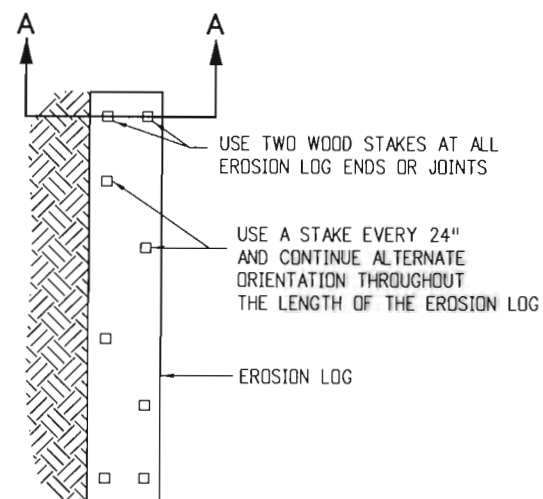


PLAN VIEW

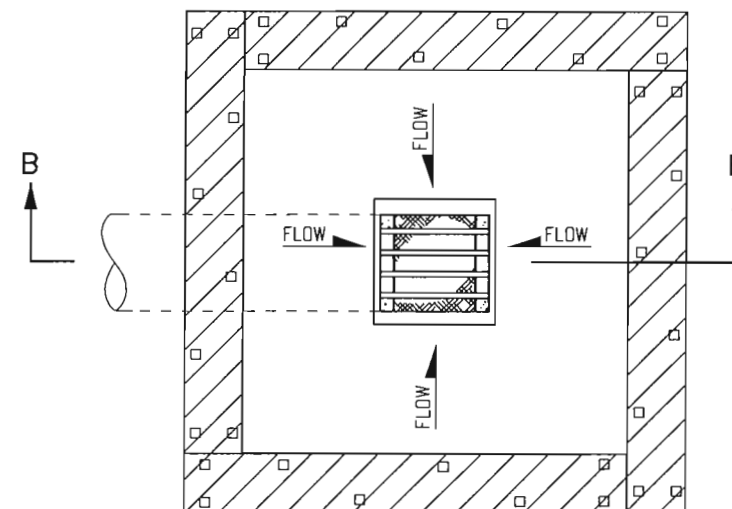

PLAN VIEW

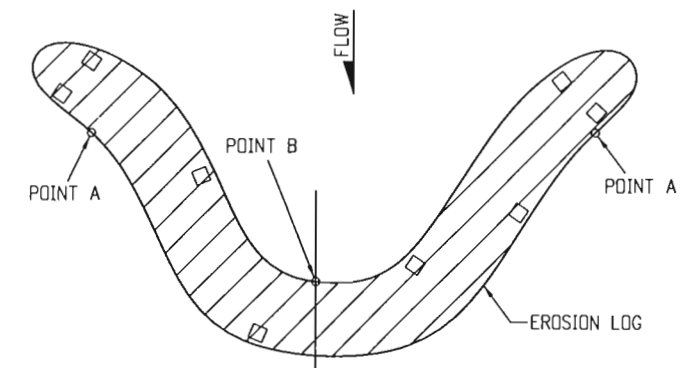


PLAN VIEW

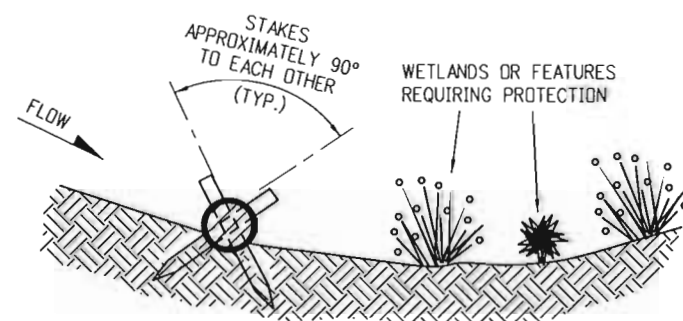

SECTION A-A


TYPICAL STAKE INSTALLATION

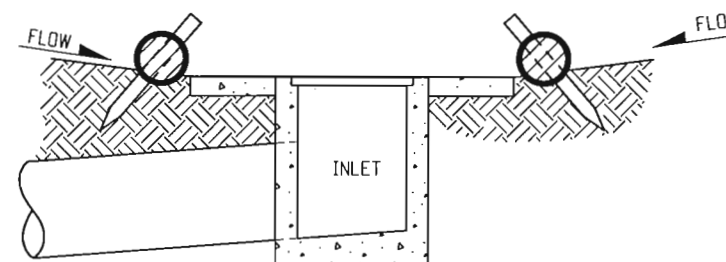

SECTION B-B

NOTE: LOCATE EROSION LOGS AT THE OUTSIDE EDGE OF THE CONCRETE APRON.

EROSION LOG FILTER AT DROP INLET

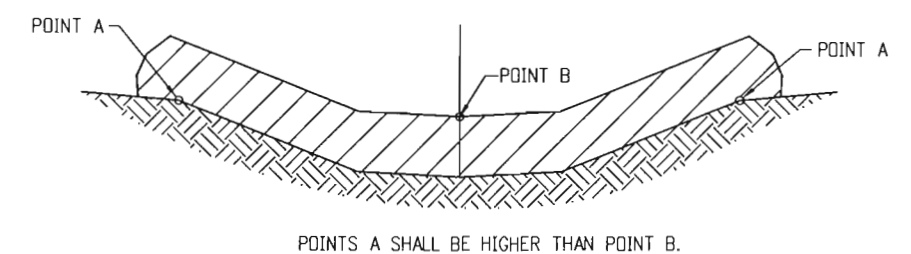

POINTS A SHALL BE HIGHER THAN POINT B.


ELEVATION


EROSION LOG DITCH INSTALLATION

EROSION LOG APPLICATIONS


NOTES

1. EROSION LOGS SHALL BE EMBEDDED 2 INCHES INTO THE SOIL.
2. STAKES SHALL BE EMBEDDED TO A MINIMUM DEPTH OF 12 INCHES.
3. EROSION LOGS SHALL BE TIGHTLY ABUTTED WITH NO GAPS.

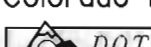Computer File Information		<div>(R-X)</div> <div>(R-X)</div> <div>(R-X)</div> <div>(R-X)</div>	Sheet Revisions		<div>Colorado Department of Transportation</div> <div> 4201 East Arkansas Avenue Denver, Colorado 80222 Phone: (303) 757-9083 Fax: (303) 757-9820</div> <div>Project Development Branch DD/LTA</div>	TEMPORARY		STANDARD PLAN NO.	
Creation Date: 06/08/10	Initials: DD		Date:	Comments		EROSION CONTROL		M-208-1	
Last Modification Date: 07/29/11	Initials: LTA		08/26/10	Revised to meet new water quality standards.					
Full Path: www.dot.state.co.us/DesignSupport/				Revised sheets 1-7.					
Drawing File Name: 2080102012.dgn				Added sheets 8-12.					
CAD Ver.: MicroStation V8	Scale: Not to Scale Units: English								
					Issued By: Project Development Branch on July 04, 2006		Sheet No. 2 of 12		

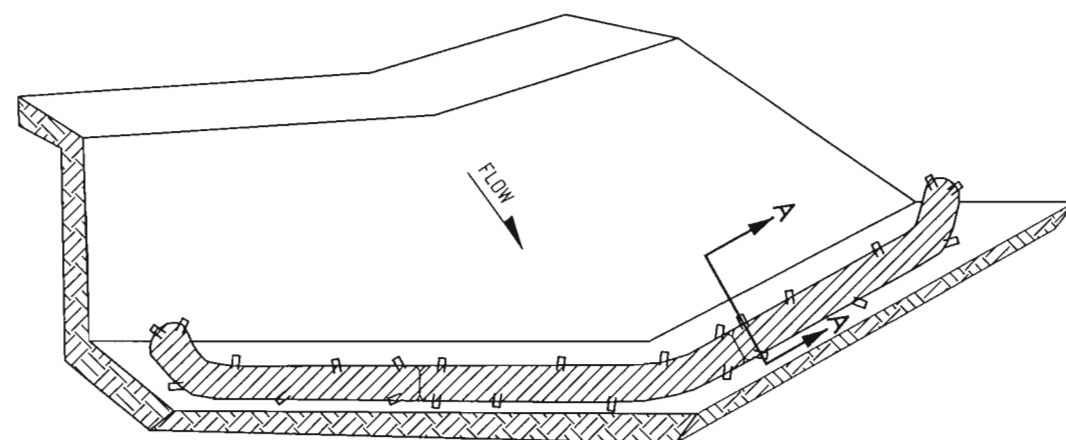

ISOMETRIC VIEW

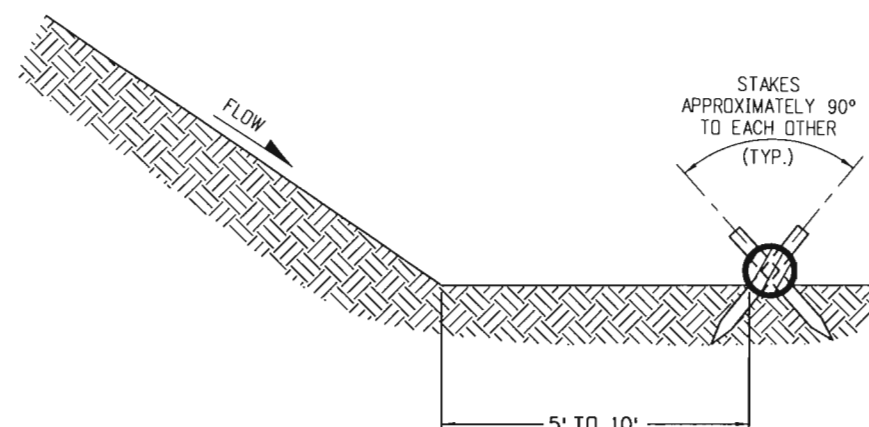


SECTION A-A


NOTES:

1. EROSION LOGS USED AT TOE OF SLOPE SHALL BE PLACED 5 TO 10 FEET BEYOND TOE OF SLOPE TO PROVIDE STORAGE CAPACITY.
2. EROSION LOGS SHALL BE PLACED ON THE CONTOUR, WITH ENDS FLARED UP SLOPE.

EROSION LOG TOE OF SLOPE PROTECTION

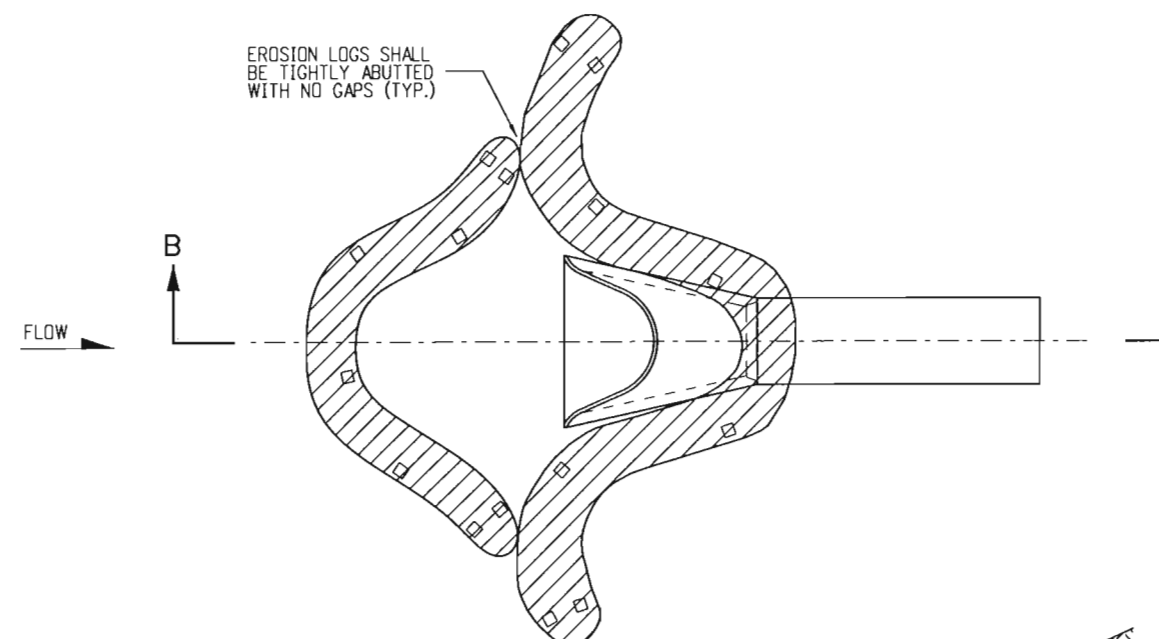


PLAN VIEW

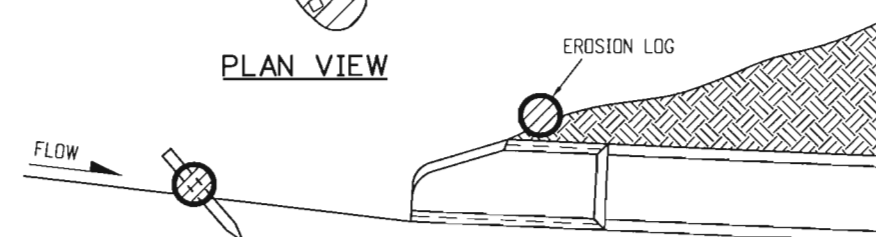


SECTION B-B


EROSION LOG CULVERT INLET PROTECTION

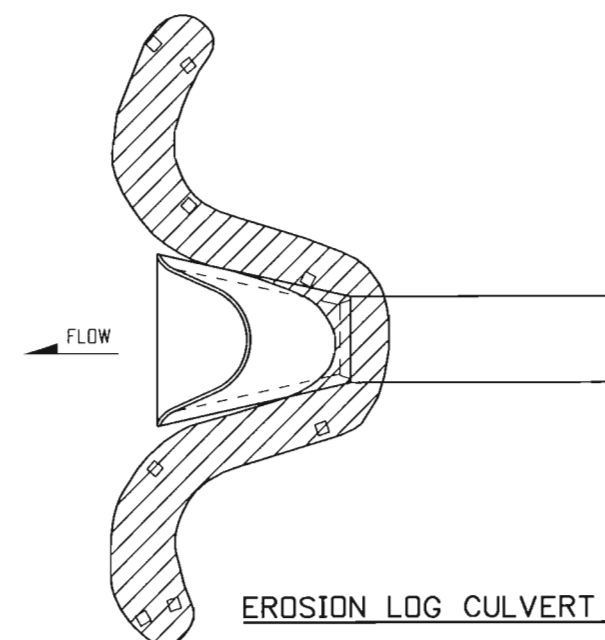

EROSION LOG CULVERT OUTLET PROTECTION


EROSION LOG APPLICATIONS

Computer File Information		Sheet Revisions		<div> <div>Colorado Department of Transportation</div> <div>  <div> 4201 East Arkansas Avenue Denver, Colorado 80222 Phone: (303) 757-9083 Fax: (303) 757-9820 </div> </div> <div>Project Development Branch DD/LTA</div> </div>	TEMPORARY EROSION CONTROL		STANDARD PLAN NO.
Creation Date: 06/08/10	Initials: DD	Date:	Comments				M-208-1
Last Modification Date: 07/29/11	Initials: LTA	08/26/10	Revised to meet new water quality standards.				
Full Path: www.dot.state.co.us/DesignSupport/			Revised sheets 1-7.				
Drawing File Name: 2080103012.dgn			Added sheets 8-12.				
CAD Ver.: MicroStation V8 Scale: Not to Scale Units: English					Issued By: Project Development Branch on July 04, 2006		Sheet No. 3 of 12

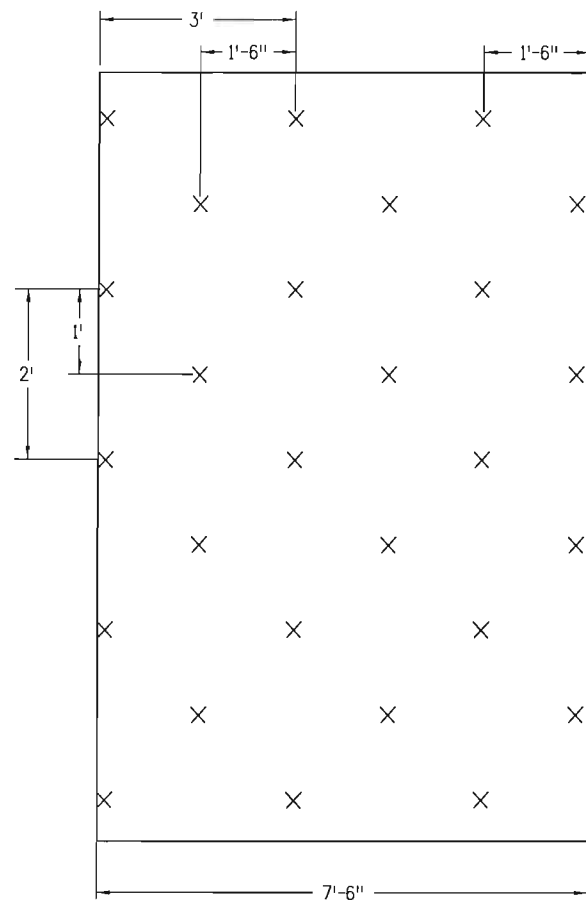


TYPICAL STAPLE PATTERN FOR CHANNEL APPLICATION

SEE SUBSECTION 216.05.

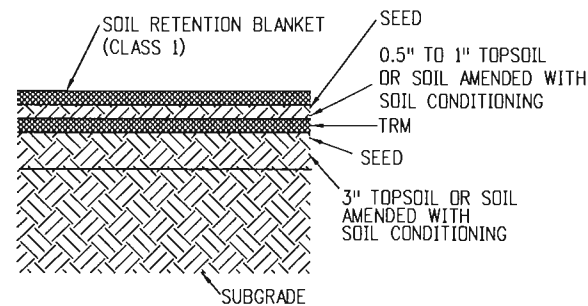


SOIL FILLED TRM APPLICATION

1. PLACE 3" TOPSOIL OR SOIL AMENDED WITH SOIL CONDITIONING.
2. APPLY SEED AND RAKE INTO SOIL.
3. INSTALL TRM.
4. PLACE 0.5" TO 1" TOPSOIL OR SOIL AMENDED WITH SOIL CONDITIONING.
5. APPLY SEED AND RAKE INTO SOIL.
6. INSTALL SOIL RETENTION BLANKET (CLASS 1).

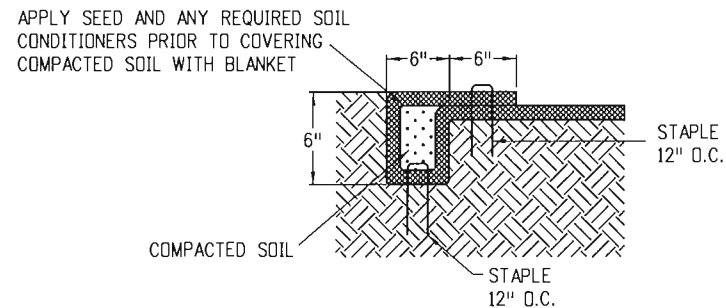


ANCHOR TRENCH SECTION (A)

TO BE USED AT THE BEGINNING AND END OF THE CHANNEL ACROSS IT'S ENTIRE WIDTH.

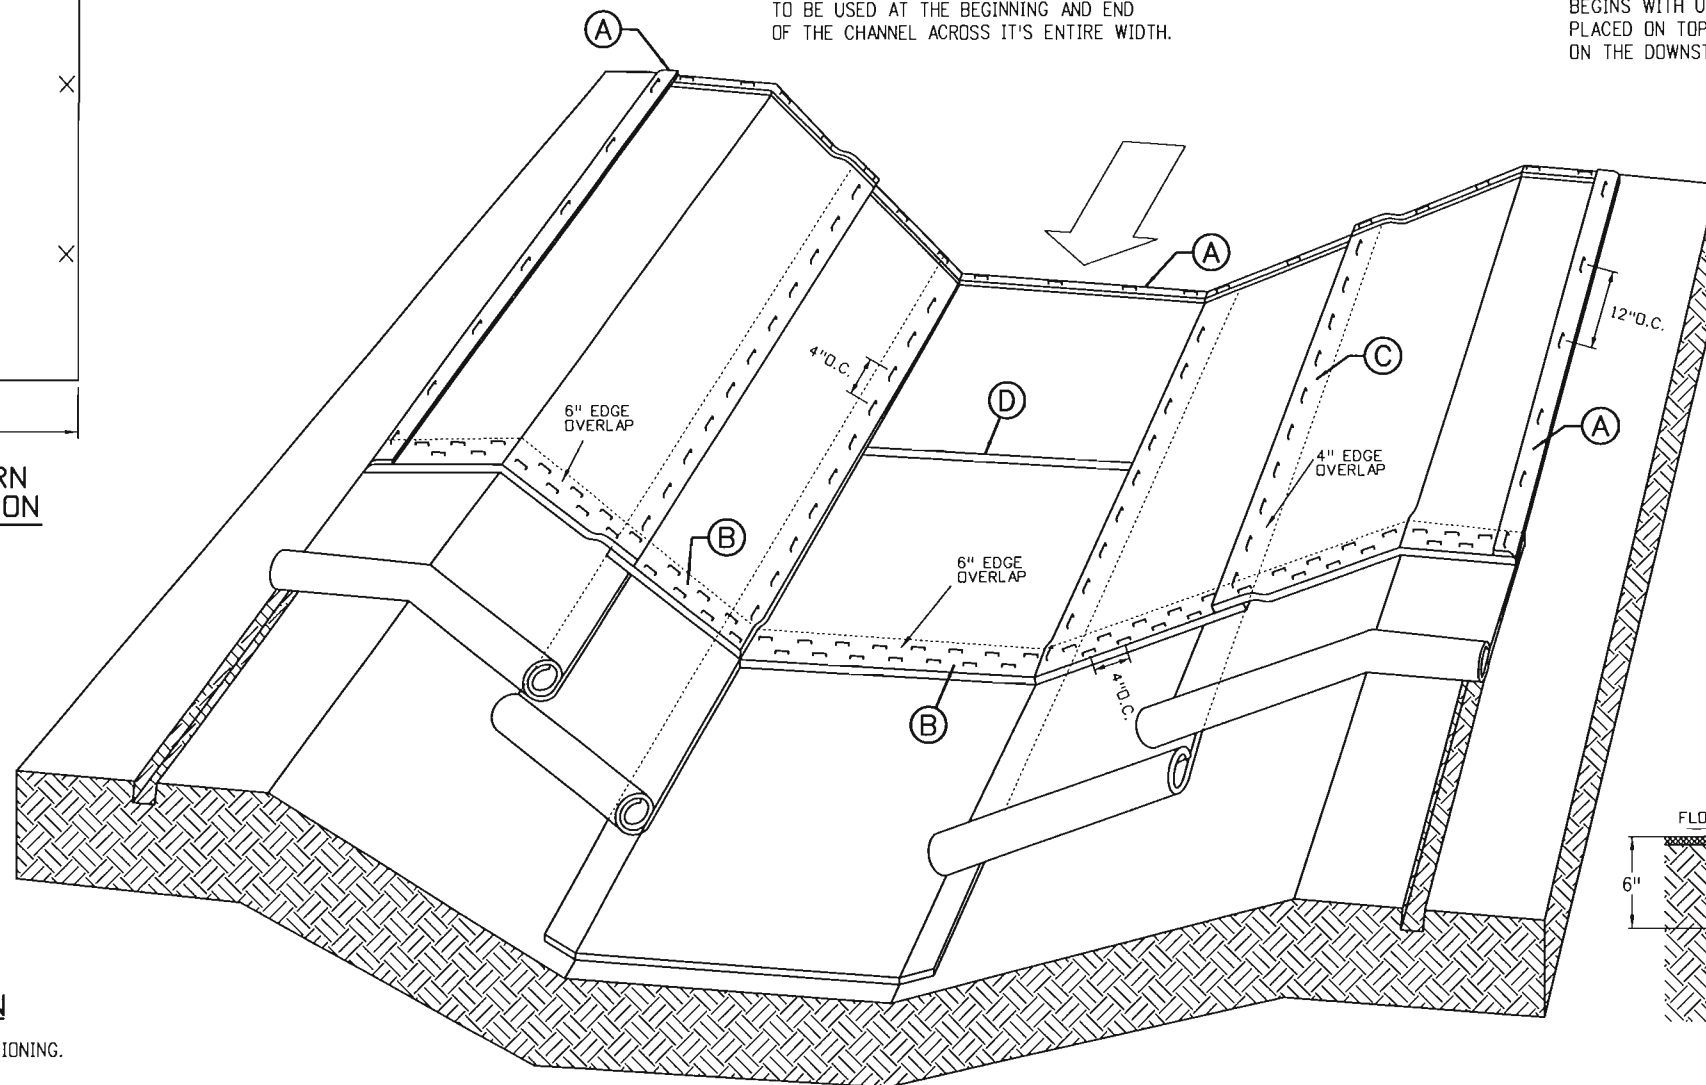


SOIL RETENTION BLANKETS/TURF REINFORCEMENT MATS (TRM) CHANNEL APPLICATION

IN ACCORDANCE WITH SECTION 216.

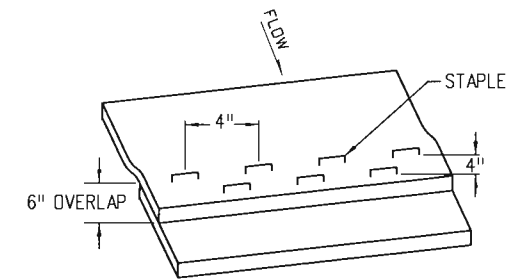


CONSECUTIVE ROLL OVERLAP SECTION (B)

TO BE USED WHEREVER ONE ROLL OF BLANKET ENDS AND ANOTHER BEGINS WITH UPSTREAM BLANKET PLACED ON TOP OF THE BLANKET ON THE DOWNSTREAM SIDE.

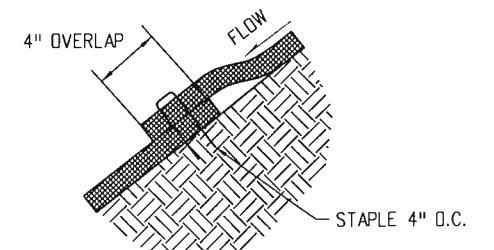

SIDE SEAM OVERLAP SECTION (C)


TO BE USED FOR OVERLAP WHEN 2 WIDTHS OF BLANKET ARE APPLIED SIDE BY SIDE WITH THE UPHILL BLANKET PLACED ON TOP OF THE BLANKET ON THE DOWNHILL SIDE.

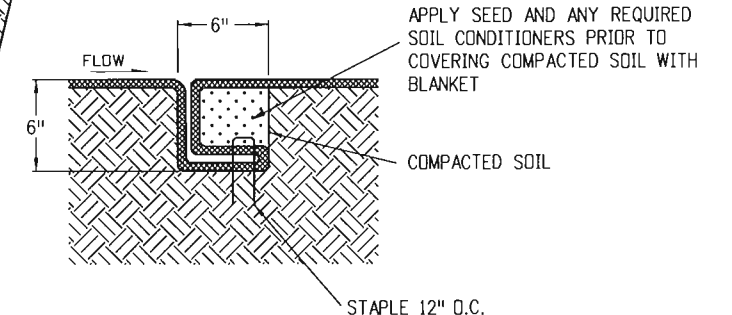

CHANNEL CHECK SLOT SECTION (D)


TO BE USED AT 30' INTERVALS IN CHANNEL FLOWLINE.

Computer File Information		Sheet Revisions		<div> <div>Colorado Department of Transportation</div> <div>  <div> 4201 East Arkansas Avenue Denver, Colorado 80222 Phone: (303) 757-9083 Fax: (303) 757-9820 </div> </div> <div>Project Development Branch DD/LTA</div> </div>	TEMPORARY EROSION CONTROL		STANDARD PLAN NO.
Creation Date: 06/08/10	Initials: DD	Date:	Comments				M-208-1
Last Modification Date: 07/29/11	Initials: LTA	08/26/10	Revised to meet new water quality standards.				
FullPath: www.dot.state.co.us/DesignSupport/			Revised sheets 1-7.				
Drawing File Name: 2080104012.dgn			Added sheets 8-12.				
CAD Ver.: MicroStation V8	Scale: Not to Scale Units: English				Issued By: Project Development Branch on July 04, 2006		Sheet No. 4 of 12

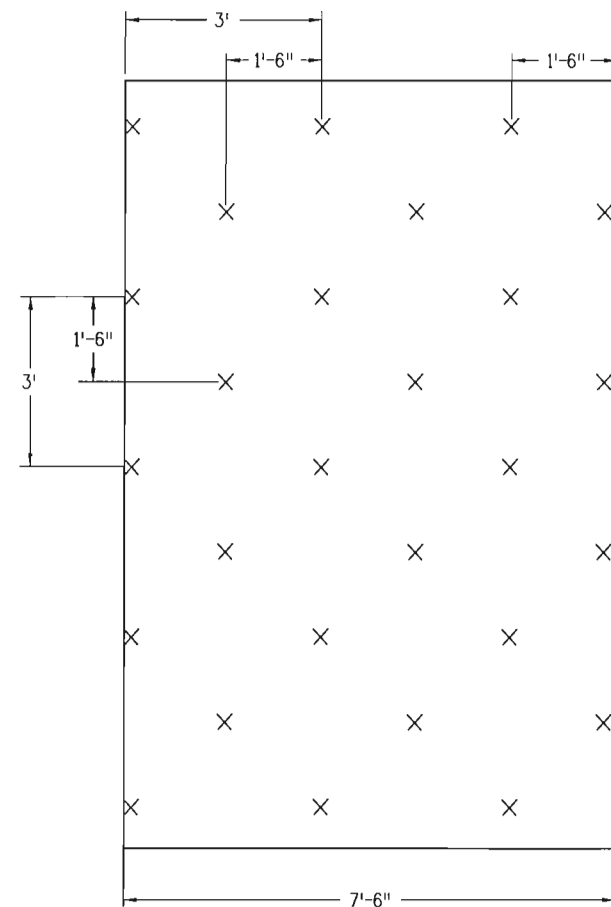


TYPICAL STAPLE PATTERN FOR SLOPE APPLICATION

SEE SUBSECTION 216.04.

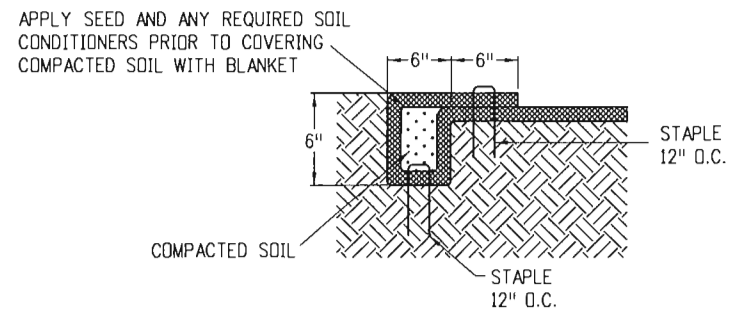


ANCHOR TRENCH SECTION (A)

TO BE USED AT THE UPSLOPE AND DOWNSLOPE ENDS OF BLANKET ACROSS THE ENTIRE WIDTH OF SLOPE UNLESS SLOPE RUNS INTO RECEIVING WATER. (SEE DOWNSLOPE END STAPLE CHECK).

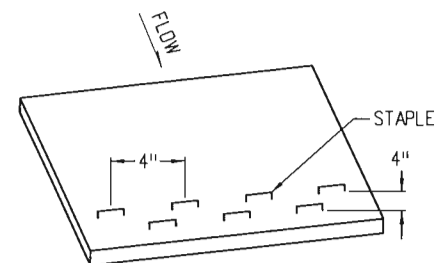


DOWNSLOPE END STAPLE CHECK

TO BE USED WHEN SLOPE RUNS INTO A RECEIVING WATER AND CANNOT BE EXTENDED 3 FEET BEYOND SLOPE.

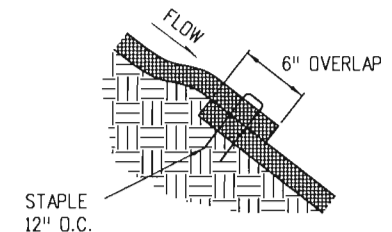


CONSECUTIVE ROLL OVERLAP SECTION (B)

TO BE USED WHEREVER ONE ROLL OF BLANKET ENDS AND ANOTHER BEGINS WITH THE UPHILL BLANKET PLACED ON TOP OF THE BLANKET ON THE DOWNHILL SIDE.

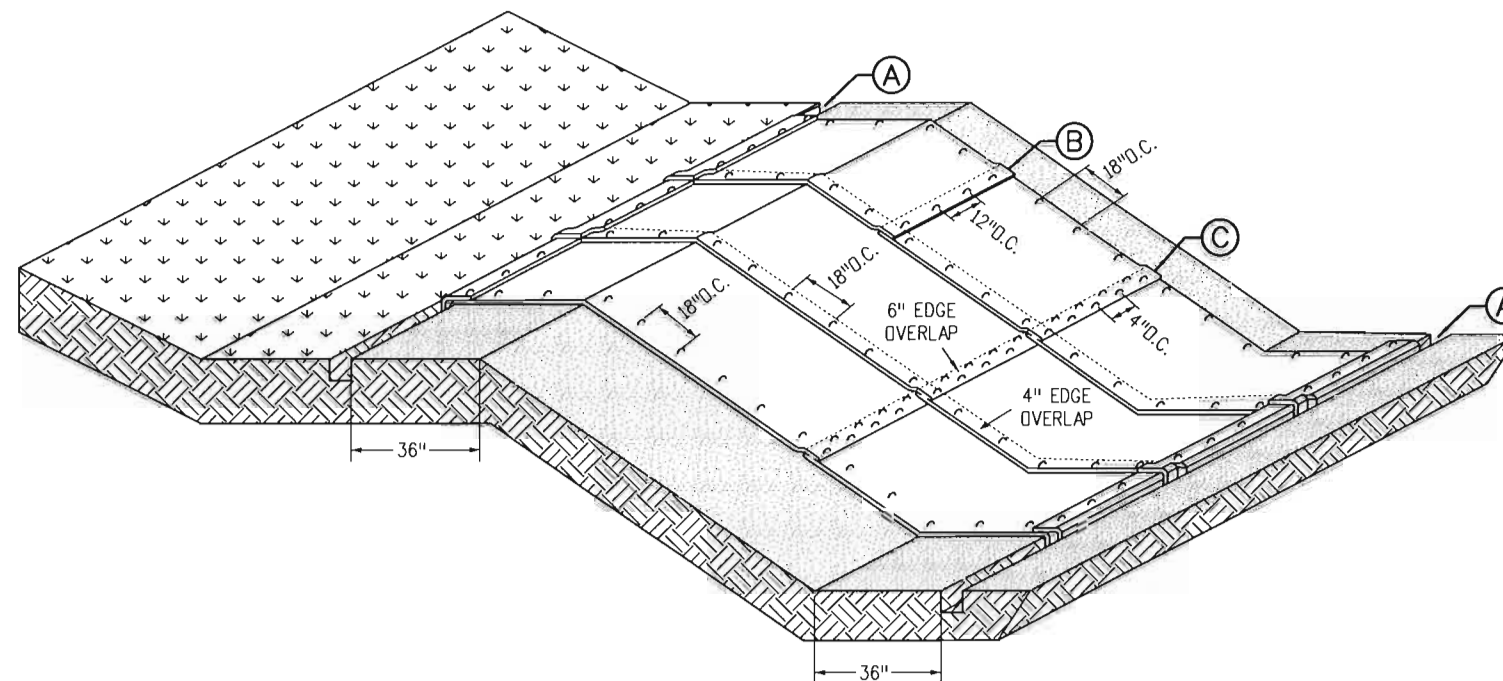

SOIL RETENTION BLANKETS/TURF REINFORCEMENT MATS (TRM) SLOPE APPLICATION

IN ACCORDANCE WITH SECTION 216.



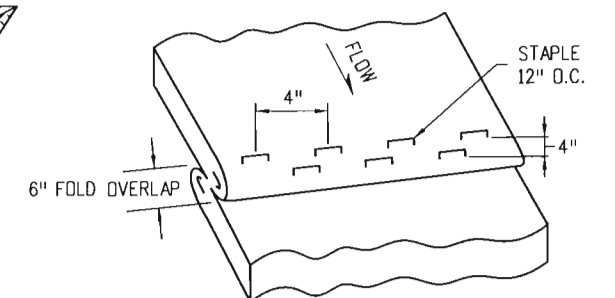


STAPLE CHECK SECTION (C)

NOTES:



1. Z SHAPED FOLD TO BE USED ON SLOPE EVERY 35 FEET MAXIMUM.
2. STAPLE CHECK LOCATIONS SHOULD BE AT LEAST 15 FEET FROM THE BOTTOM OF SLOPE.

Computer File Information		Sheet Revisions		 Colorado Department of Transportation 4201 East Arkansas Avenue Denver, Colorado 80222 Phone: (303) 757-9083 Fax: (303) 757-9820 Project Development Branch DD/LTA	TEMPORARY EROSION CONTROL Issued By: Project Development Branch on July 04, 2006	STANDARD PLAN NO.	
Creation Date: 06/08/10	Initials: DD	Date:	Comments			M-208-1	
Last Modification Date: 07/29/11	Initials: LTA	08/26/10	Revised to meet new water quality standards.	  		Sheet No. 5 of 12	
Full Path: www.dot.state.co.us/DesignSupport/			Revised sheets 1-7.				
Drawing File Name: 2080105012.dgn			Added sheets 8-12.				
CAD Ver.: MicroStation V8	Scale: Not to Scale	Units: English	07/29/11				
			Revised Staple Check Detail.				

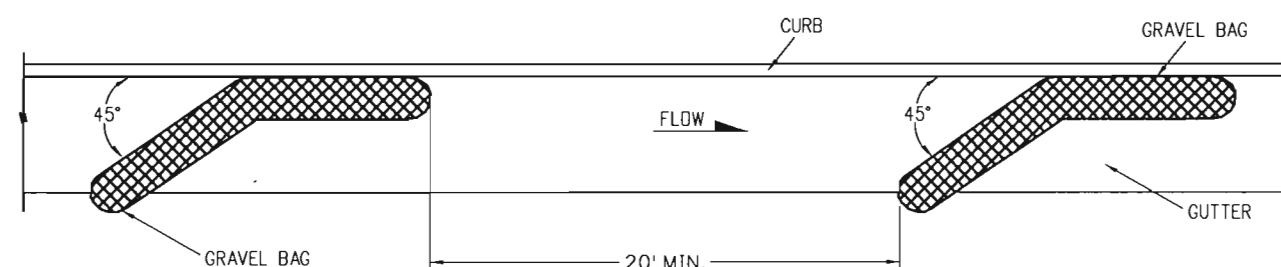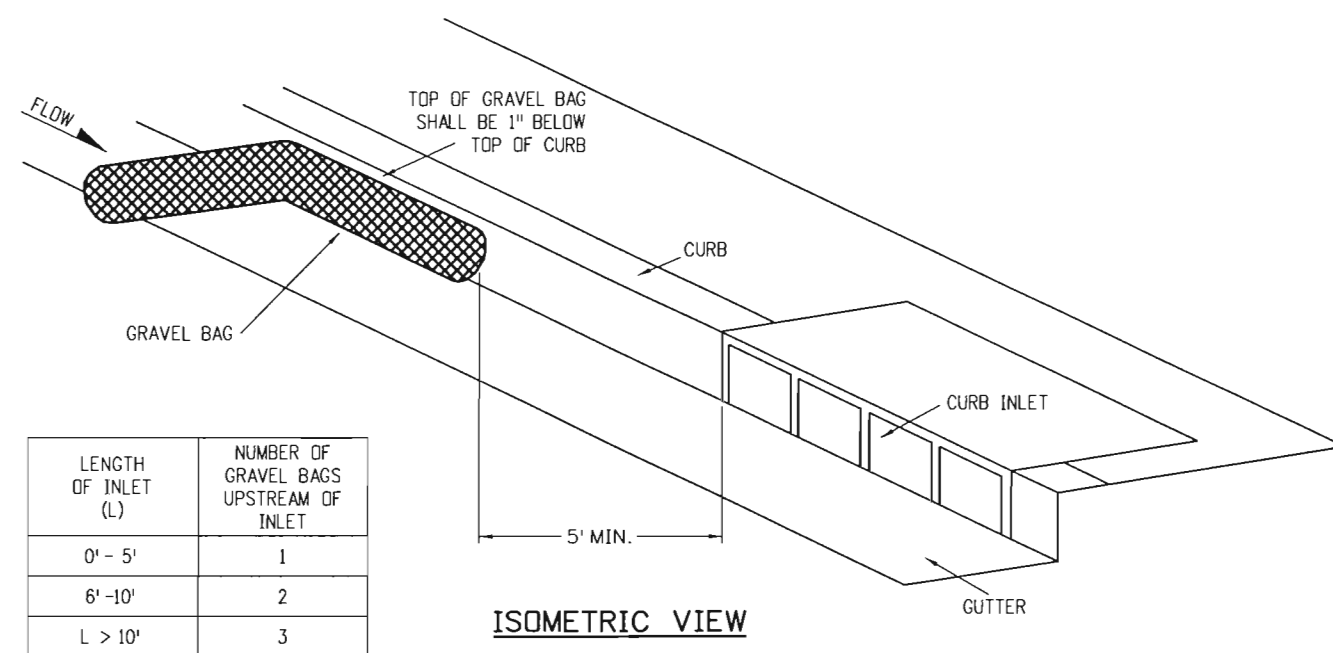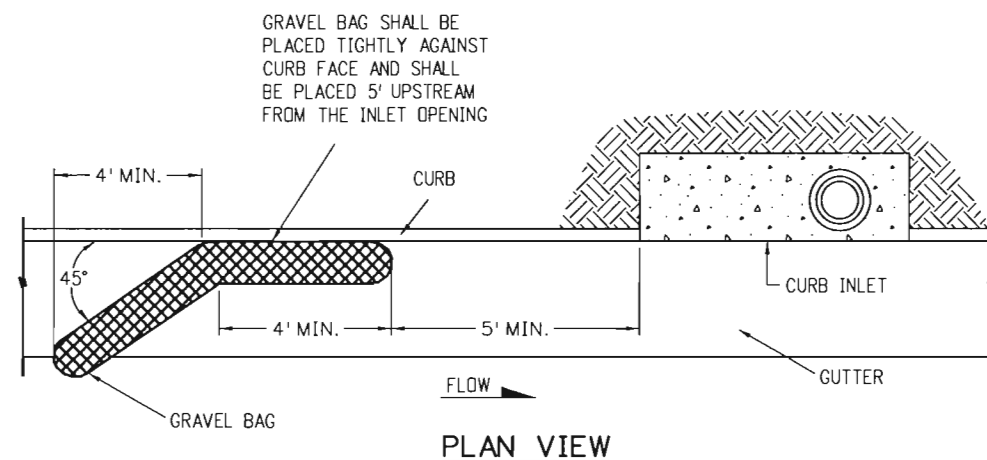


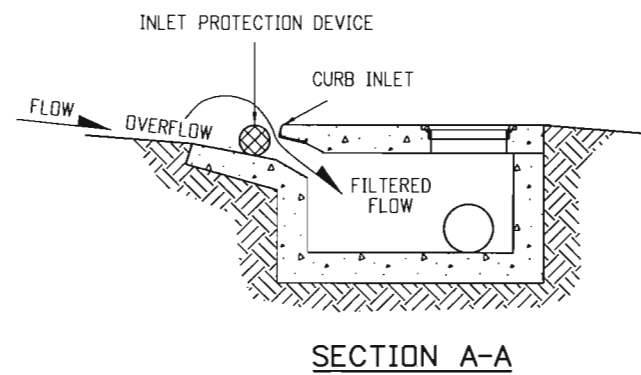
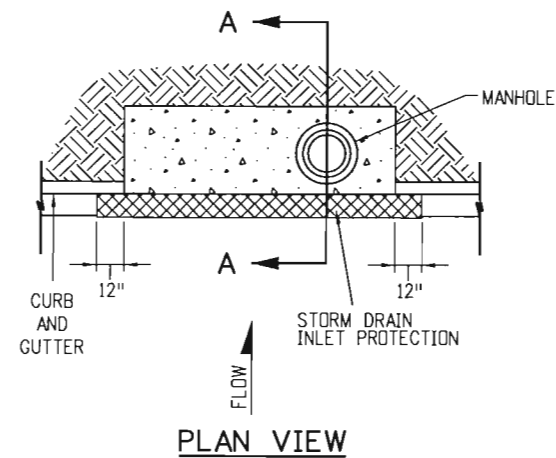
GRAVEL BAG CURB CHECK

GRAVEL BAG APPLICATIONS

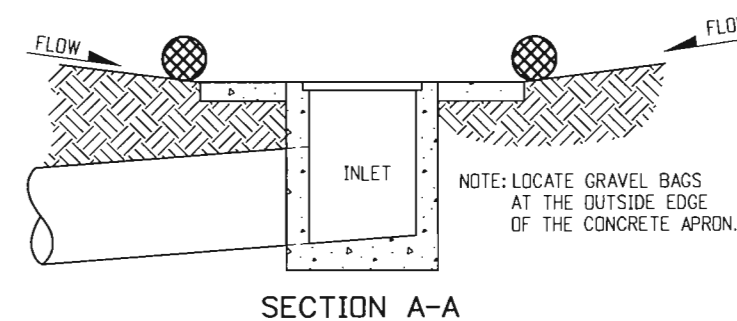
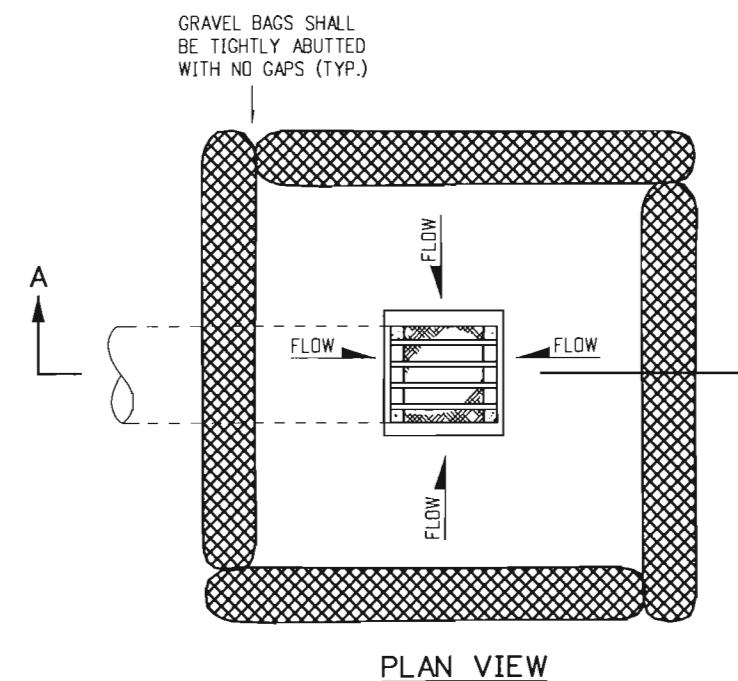


GRAVEL BAG FILTER AT DROP INLET


Computer File Information		Sheet Revisions		<div> <div>Colorado Department of Transportation</div> <div>  <div> 4201 East Arkansas Avenue Denver, Colorado 80222 Phone: (303) 757-9083 Fax: (303) 757-9820 </div> </div> <div>Project Development Branch DD/LTA</div> </div>	TEMPORARY EROSION CONTROL		STANDARD PLAN NO.
Creation Date: 07/04/06	Initials: DD	Date:	Comments		Issued By: Project Development Branch on July 04, 2006		M-208-1
Last Modification Date: 07/29/11	Initials: LTA	08/26/10	Revised to meet new water quality standards.				
FullPath: www.dot.state.co.us/DesignSupport/			Revised sheets 1-7.				
Drawing File Name: 2080106012.dgn			Added sheets 8-12.				Sheet No. 6 of 12
CAD Ver.: MicroStation V8	Scale: Not to Scale Units: English						



STORM DRAIN INLET PROTECTION (TYPE I)
INLET PROTECTION SHALL EXTEND 12 IN. PAST EACH END OF THE INLET.

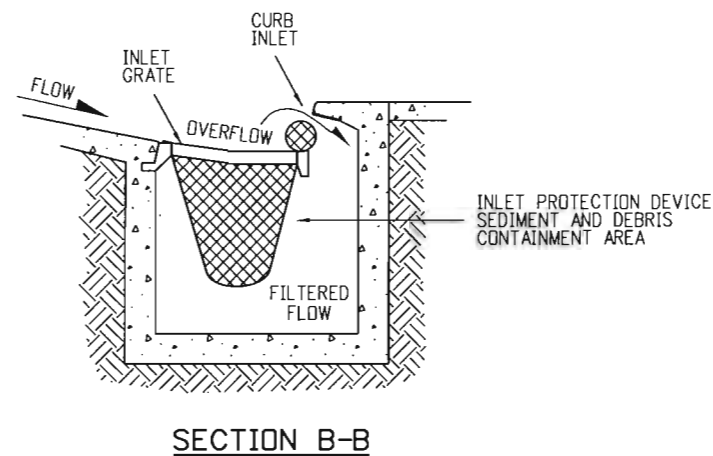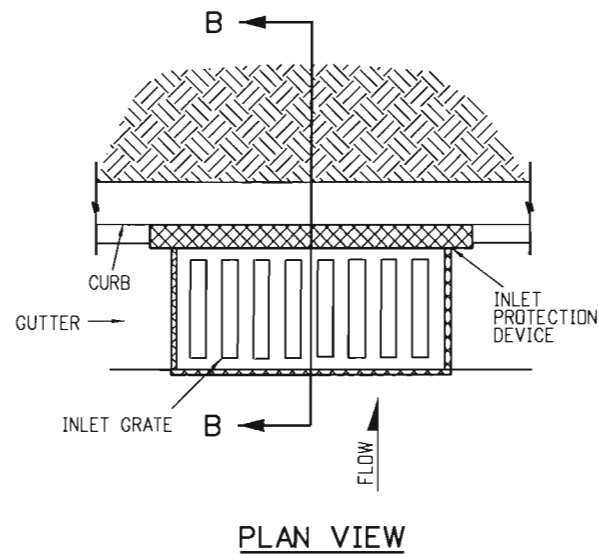


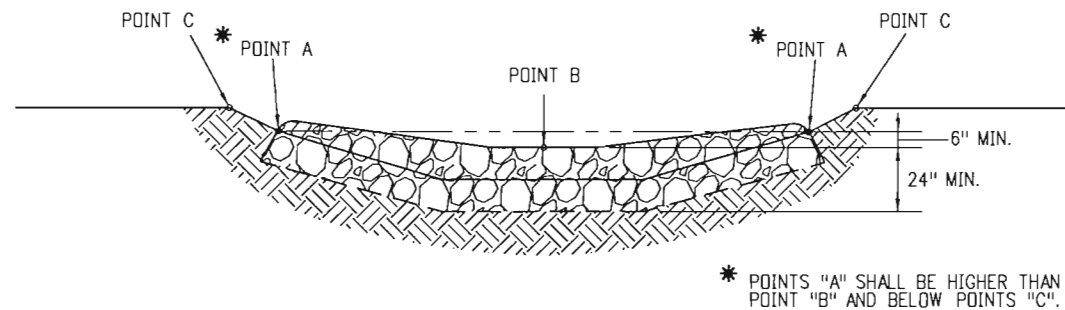
**STORM DRAIN INLET PROTECTION (TYPE II)
OPTION A**

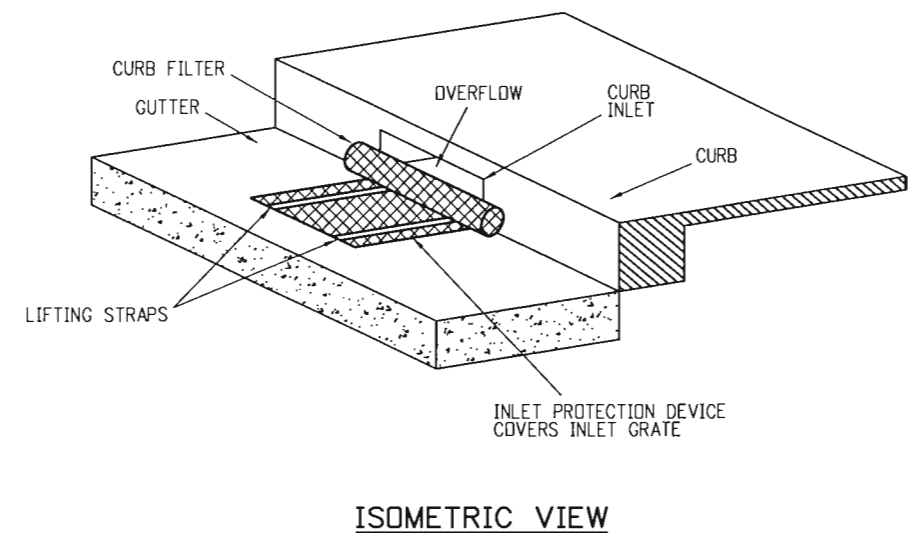


**ISOMETRIC VIEW
STORM DRAIN INLET PROTECTION (TYPE II)
OPTION B**

STORM DRAIN INLET PROTECTION


Computer File Information		Sheet Revisions		<div> <div>Colorado Department of Transportation</div> <div>  <div> 4201 East Arkansas Avenue Denver, Colorado 80222 Phone: (303) 757-9083 Fax: (303) 757-9820 </div> </div> <div>Project Development Branch DD/LTA</div> </div>	TEMPORARY EROSION CONTROL		STANDARD PLAN NO.
Creation Date: 07/04/06	Initials: DD	Date:	Comments		M-208-1		
Last Modification Date: 07/29/11	Initials: LTA	08/26/10	Revised to meet new water quality standards.		Issued By: Project Development Branch on July 04, 2006		Sheet No. 7 of 12
Full Path: www.dot.state.co.us/DesignSupport/			Revised sheets 1-7.				
Drawing File Name: 2080107012.dgn			Added sheets 8-12.				
CAD Ver.: MicroStation V8	Scale: Not to Scale Units: English						



TYPICAL SECTION VIEW

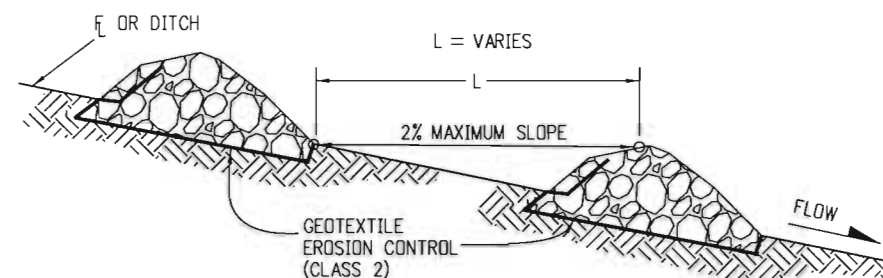


SECTION VIEW ALONG DITCH FLOWLINE

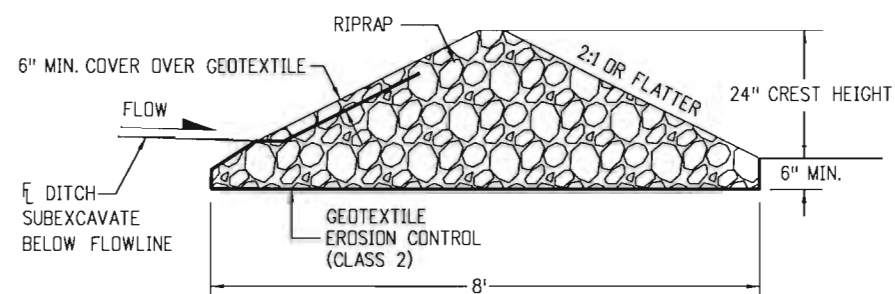


SECTION DETAIL

- NOTES:
1. RIPRAP SIZE D_{50} = 6" OR AS SHOWN ON THE PLANS.
 2. THE ENDS OF RIPRAP CHECK DAM SHALL BE A MINIMUM OF 6 IN. HIGHER THAN CENTER OF CHECK DAM.

ROCK CHECK DAM

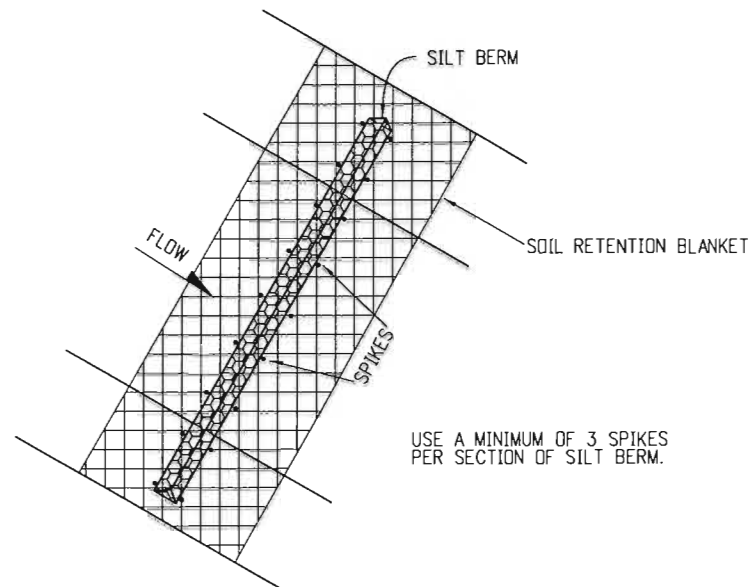


PLAN VIEW

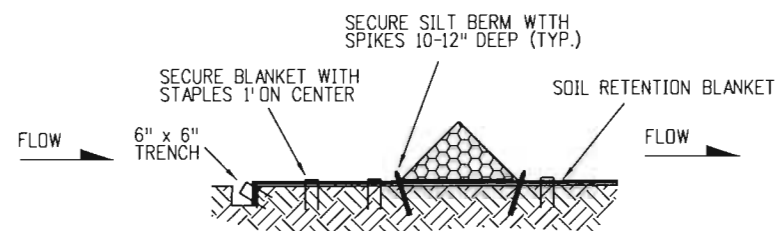


TYPICAL SECTION VIEW

- NOTES:
1. ANCHOR SOIL RETENTION BLANKET INTO TRENCH WITH 8" MINIMUM STAPLES PLACED AT 1.5' INTERVALS ALONG EDGE.
 2. FILL AND COMPACT TRENCH.
 3. SECTIONS OF THE SILT BERM SHALL BE OVERLAPPED WITH NO GAPS.

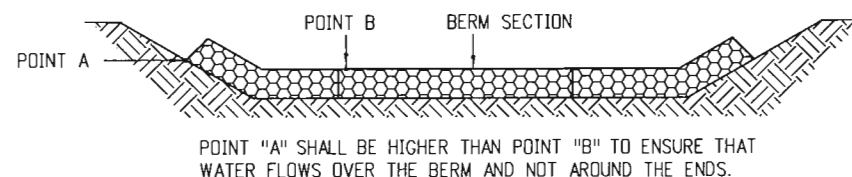


FRONT VIEW

SILT BERM-VELOCITY CHECKS

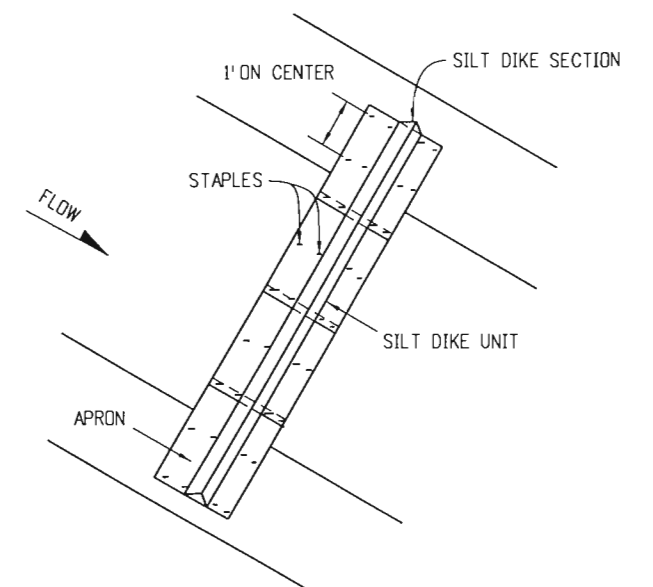


PLAN VIEW

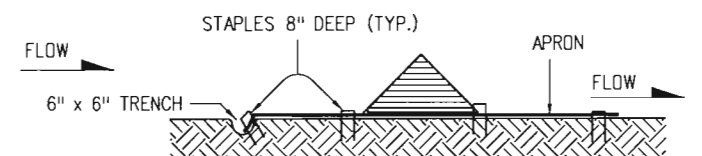

TYPICAL SECTION

- NOTES:
1. ANCHOR APRON INTO TRENCH WITH 8" MINIMUM STAPLES PLACED AT 1.5' INTERVALS ALONG EDGE.
 2. FILL AND COMPACT TRENCH.
 3. THE APRON SHALL EXTEND A MINIMUM OF 2 FEET BEYOND EACH SIDE OF THE TRIANGLE.

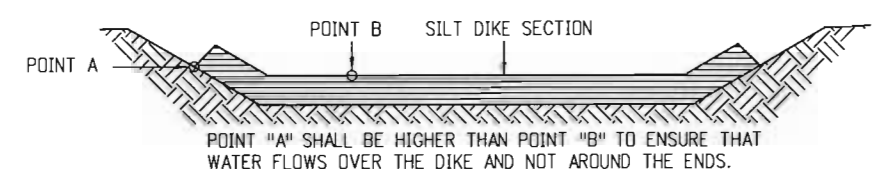


FRONT VIEW

SILT DIKE-INSTALLATION

DRAINAGE DITCH APPLICATIONS


Computer File Information		<div><div></div><div>(R-X)</div><div>(R-X)</div><div>(R-X)</div><div>(R-X)</div></div>	Sheet Revisions		<div><div>Colorado Department of Transportation</div><div><div>4201 East Arkansas Avenue Denver, Colorado 80222 Phone: (303) 757-9083 Fax: (303) 757-9820</div></div><div>Project Development Branch</div><div>DD/LTA</div></div>	TEMPORARY EROSION CONTROL		STANDARD PLAN NO.	
Creation Date: 07/04/06	Initials: DD		Date:	Comments		M-208-1			
Last Modification Date: 07/29/11	Initials: LTA		08/26/10	Revised to meet new water quality standards.		Issued By: Project Development Branch on July 04, 2006			
Full Path: www.dot.state.co.us/DesignSupport/				Revised sheets 1-7.					
Drawing File Name: 2080108012.dgn				Added sheets 8-12.					
CAD Ver.: MicroStation V8	Scale: Not to Scale			Units: English					
						Sheet No. 8 of 12			

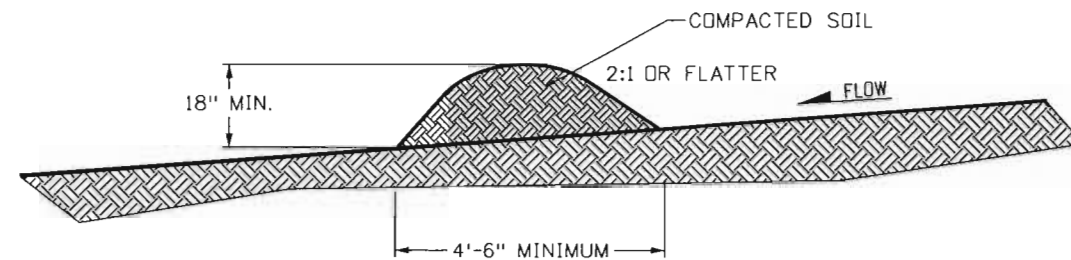

TEMPORARY BERM


NOTES:

1. BERMS SHALL HAVE A HEIGHT OF 18 INCHES, SIDE SLOPES OF 2:1 OR FLATTER AND A MINIMUM BASE WIDTH OF 4.5 FEET.
2. BERMS SHALL BE USED TO INTERCEPT AND DIVERT DRAINAGE TO A DESIGNATED OUTLET.
3. BERMS SHALL NOT BE USED WHERE DRAINAGE AREA EXCEEDS 10 ACRES.

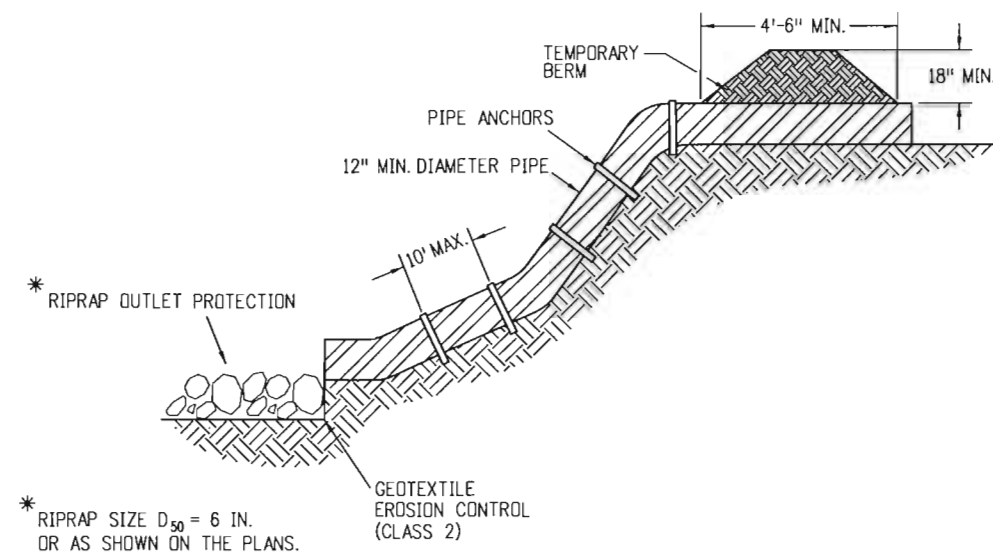

TEMPORARY SLOPE DRAIN


ANCHOR SIZE VARIES ACCORDING TO PIPE SIZE.

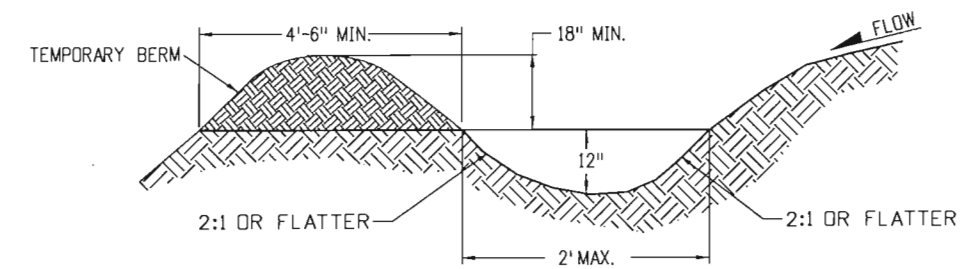


TEMPORARY DIVERSION

NOTES:

1. TEMPORARY DIVERSION DITCH SHALL BE CONSTRUCTED ACROSS THE SLOPE TO INTERCEPT RUNOFF AND DIRECT IT TO A STABLE OUTLET OR SEDIMENT TRAP.
2. USE IMMEDIATELY ABOVE A NEW CUT OR FILL SLOPE OR AROUND THE PERIMETER OF A DISTURBED AREA.
3. GRADIENT ALONG THE FLOW PATH SHALL HAVE A POSITIVE GRADE TO ASSURE DRAINAGE, BUT SHALL NOT BE SO STEEP AS TO RESULT IN EROSION DUE TO HIGH VELOCITY.

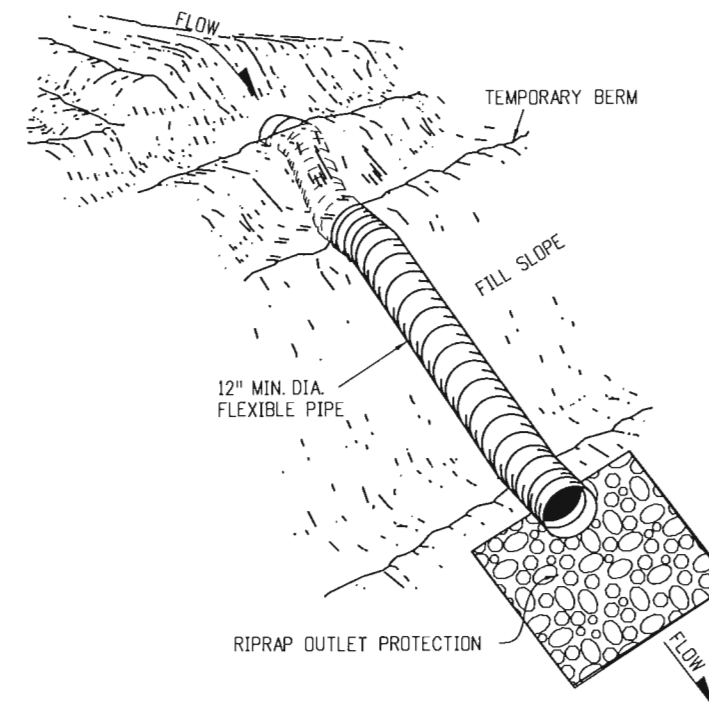

Computer File Information		<div>(R-X)</div> <div>(R-X)</div> <div>(R-X)</div> <div>(R-X)</div>	Sheet Revisions		<div>Colorado Department of Transportation</div> <div> 4201 East Arkansas Avenue Denver, Colorado 80222 Phone: (303) 757-9083 Fax: (303) 757-9820</div> <div>Project Development Branch DD/LTA</div>	TEMPORARY		STANDARD PLAN NO.	
Creation Date: 06/08/10	Initials: DD		Date:	Comments		EROSION CONTROL		M-208-1	
Last Modification Date: 07/29/11	Initials: LTA		08/26/10	Revised to meet new water quality standards.					
Full Path: www.dot.state.co.us/DesignSupport/				Revised sheets 1-7.					
Drawing File Name: 2080109012.dgn				Added sheets 8-12.					
CAD Ver.: MicroStation V8	Scale: Not to Scale Units: English				Issued By: Project Development Branch on July 04, 2006		Sheet No. 9 of 12		

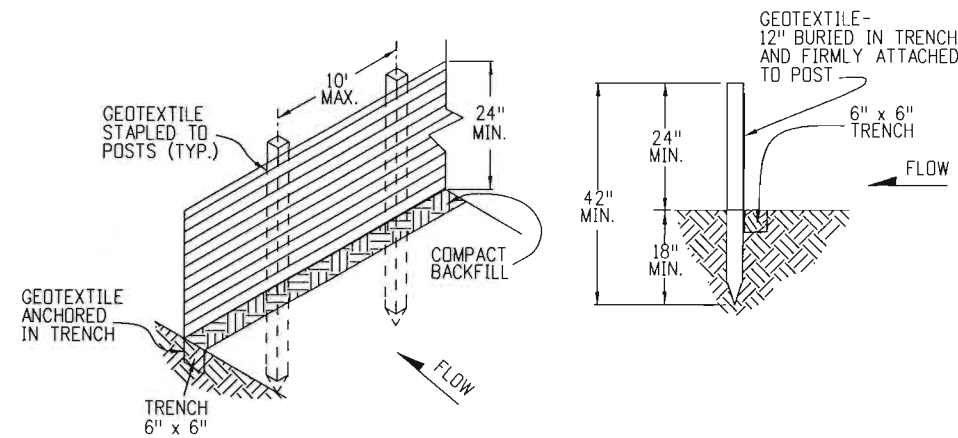


SILT FENCE

GEOTEXTILE SHALL BE ATTACHED TO WOOD POSTS WITH THREE OR MORE STAPLES PER POST.


STAPLES SHALL BE 1/2"

WOOD POST SHALL BE 1 1/2" X 1 1/2" NOMINAL.

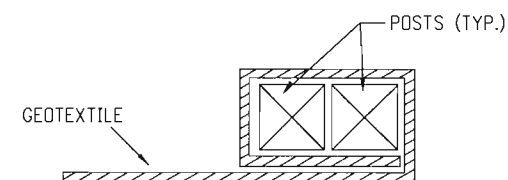

END SECTION DETAIL (PLAN VIEW)

GEOTEXTILE SHALL BE FOLDED AROUND TWO POSTS ONE FULL TURN. SECURE GEOTEXTILE TO POST WITH THREE STAPLES MINIMUM.

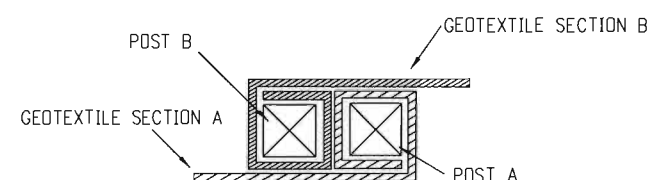

JOINING SECTION DETAIL (PLAN VIEW)


FOLD GEOTEXTILE AROUND EACH POST ONE FULL TURN. SECURE GEOTEXTILE TO POST WITH THREE STAPLES MINIMUM.

POSTS SHALL BE TIGHTLY ABUTTED WITH NO GAPS TO PREVENT POTENTIAL FLOW-THROUGH OF SEDIMENT AT JOINT.


SILT FENCE APPLICATION

NOTES

1. SILT FENCE SHALL HAVE A MAXIMUM DRAINAGE AREA OF ONE-QUARTER ACRE PER 100 FEET OF SILT FENCE LENGTH; MAXIMUM SLOPE LENGTH BEHIND BARRIER IS 100 FEET; MAXIMUM GRADIENT BEHIND THE BARRIER IS 2:1.
2. SILT FENCE USED AT TOE OF SLOPE SHALL BE PLACED 5 TO 10 FEET BEYOND TOE OF SLOPE TO PROVIDE STORAGE CAPACITY.
3. SILT FENCE SHALL BE PLACED ON THE CONTOUR, WITH ENDS FLARED UP SLOPE.

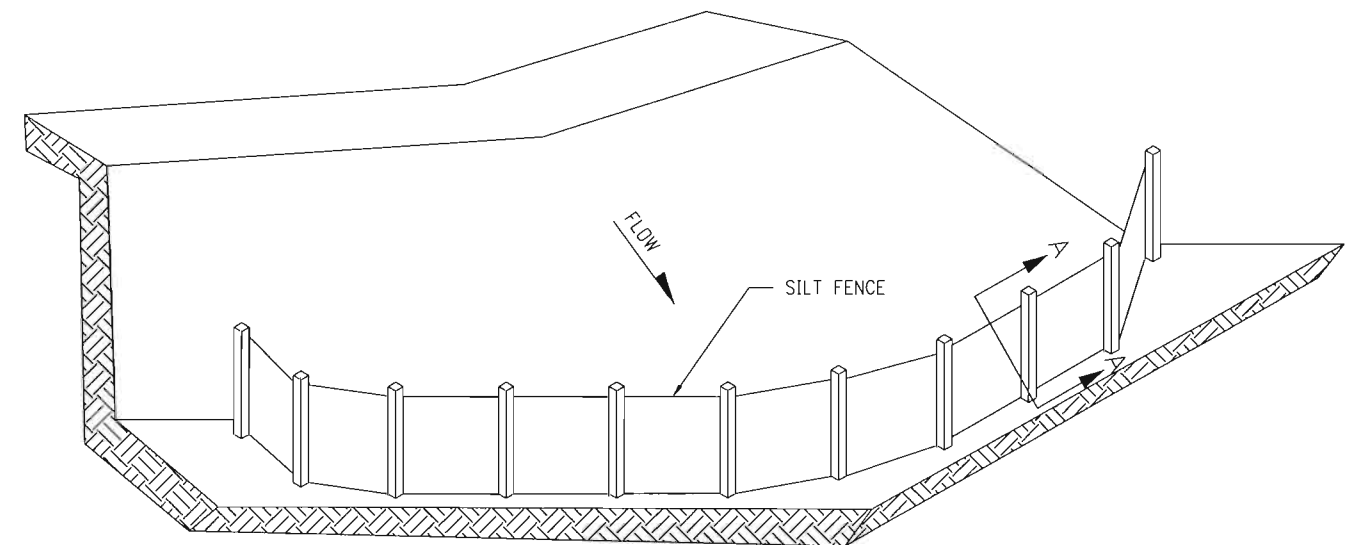


ISOMETRIC VIEW

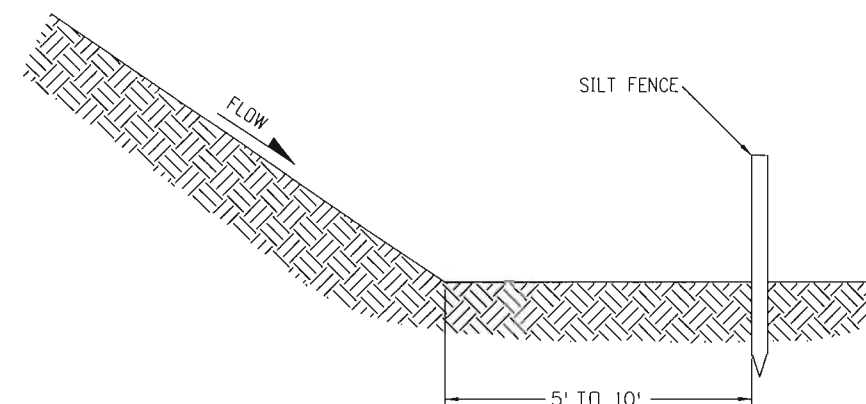

SECTION A-A



TOE OF SLOPE PROTECTION

Computer File Information		Sheet Revisions		<div> <div>Colorado Department of Transportation</div> <div>  <div> 4201 East Arkansas Avenue Denver, Colorado 80222 Phone: (303) 757-9083 Fax: (303) 757-9820 </div> </div> <div>Project Development Branch</div> <div>DD/LTA</div> </div>	<div>TEMPORARY</div> <div>EROSION CONTROL</div> <div>Issued By: Project Development Branch on July 04, 2006</div>	STANDARD PLAN NO.
Creation Date: 06/08/10	Initials: DD	Date:	Comments			M-208-1
Last Modification Date: 07/29/11	Initials: LTA	08/26/10	Revised to meet new water quality standards.			Sheet No. 10 of 12
Full Path: www.dot.state.co.us/DesignSupport/			Revised sheets 1-7.			
Drawing File Name: 20801010012.dgn			Added sheets 8-12.			
CAD Ver.: MicroStation V8	Scale: Not to Scale Units: English					

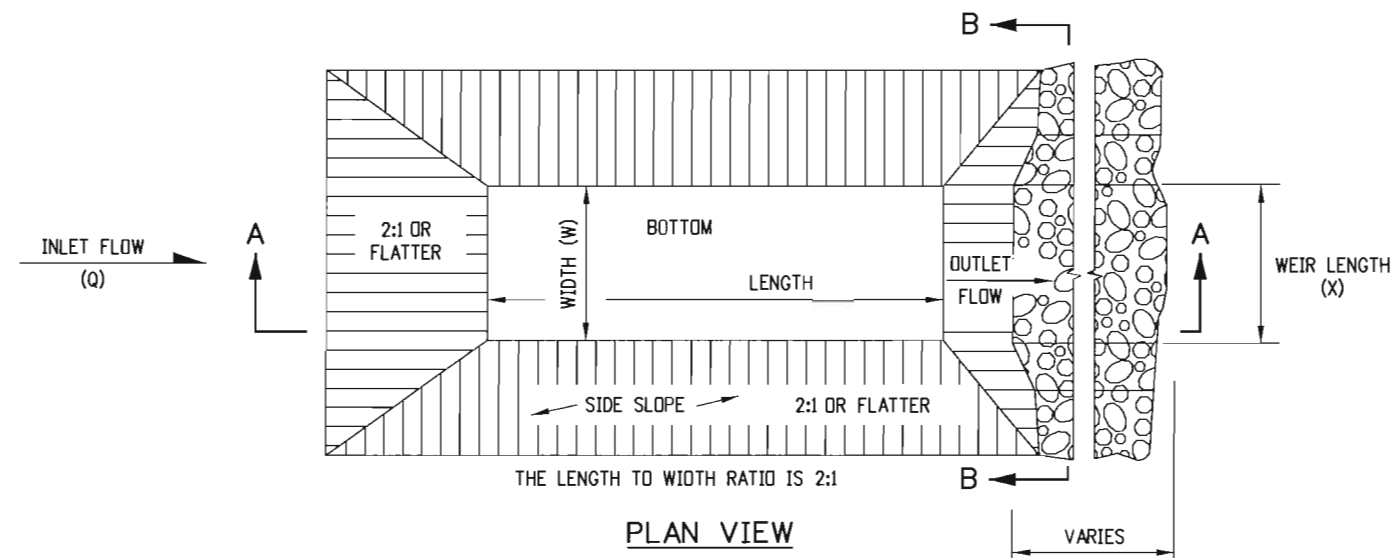

NOTES

1. THE MAXIMUM DRAINAGE AREA IS 5 ACRES.
2. THE MAXIMUM STRUCTURE LIFE IS 2 YEARS.
3. THE STORAGE AREA IS 1800 CUBIC FEET PER ACRE.
4. THE MAXIMUM EMBANKMENT HEIGHT SHALL BE 5 FT. MEASURED ON THE DOWNSTREAM SIDE.
5. THE LENGTH/WIDTH RATIO MAY BE ADJUSTED TO MEET SITE CONDITIONS WHEN APPROVED BY THE ENGINEER.
6. WIDTH (W) OF SEDIMENT TRAP IS APPROXIMATELY EQUAL TO THE WEIR LENGTH (X).
7. SEDIMENT TRAP DESIGN SHALL BE APPROVED BY THE ENGINEER.


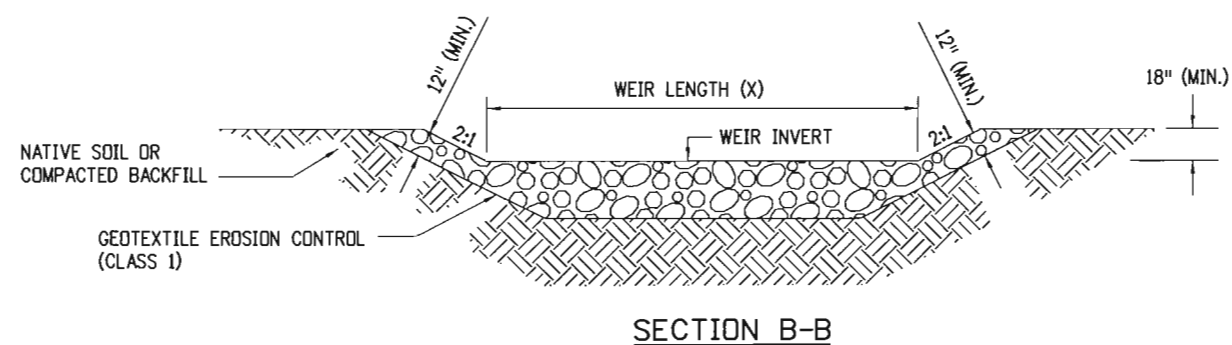
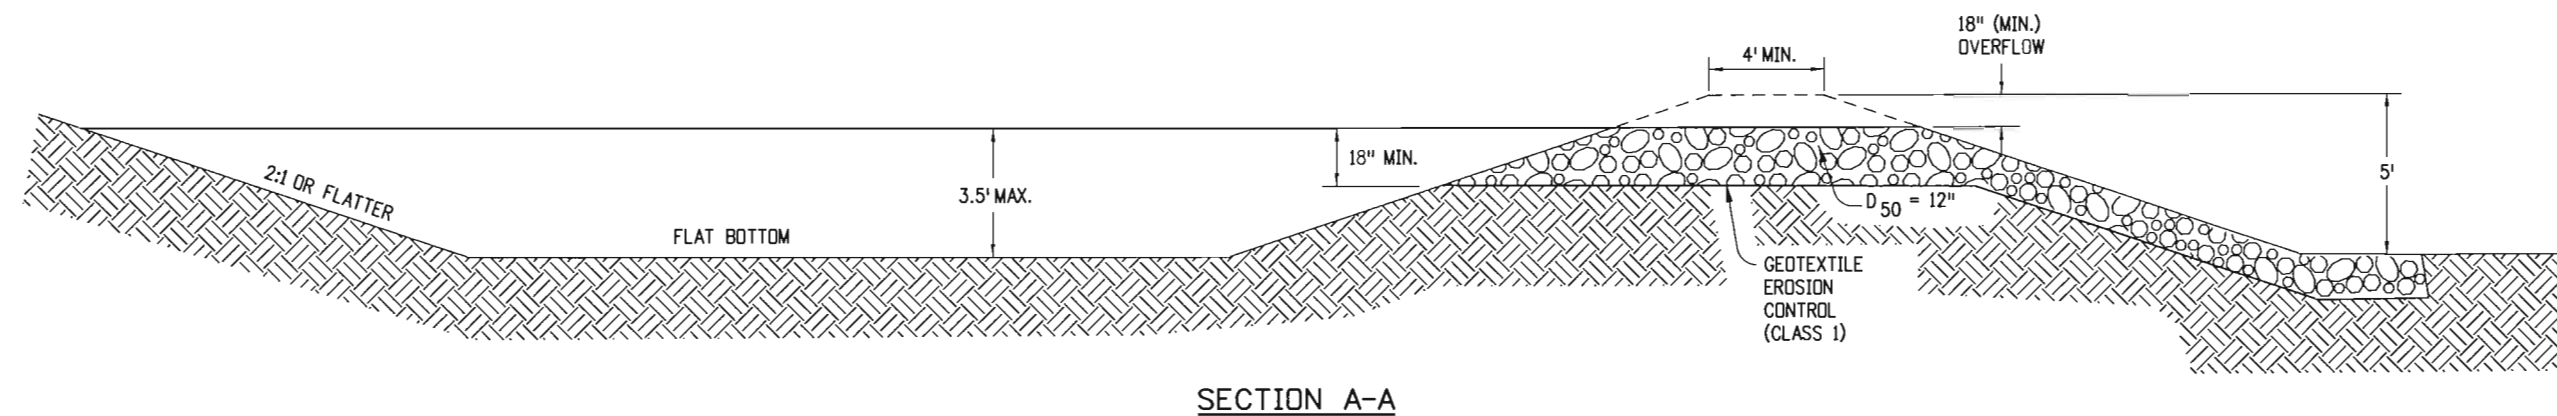


DRAINAGE AREA (ACRES)	WEIR LENGTH (FEET)
1	4
2	6
3	8
4	10
5	12


WEIR LENGTH TABLE

SEDIMENT TRAP

Computer File Information		Sheet Revisions		<div> <div>Colorado Department of Transportation</div> <div>  <div> 4201 East Arkansas Avenue Denver, Colorado 80222 Phone: (303) 757-9083 Fax: (303) 757-9820 </div> </div> </div>	<div>TEMPORARY EROSION CONTROL</div> <div>Issued By: Project Development Branch on July 04, 2006</div>	STANDARD PLAN NO.
Creation Date: 06/08/10	Initials: DD	Date:	Comments			M-208-1
Last Modification Date: 07/29/11	Initials: LTA	08/26/10	Revised to meet new water quality standards.	Project Development Branch DD/LTA		Sheet No. 11 of 12
Full Path: www.dot.state.co.us/DesignSupport/			Revised sheets 1-7.			
Drawing File Name: 20801011012.dgn			Added sheets 8-12.			
CAD Ver.: MicroStation V8 Scale: Not to Scale Units: English						

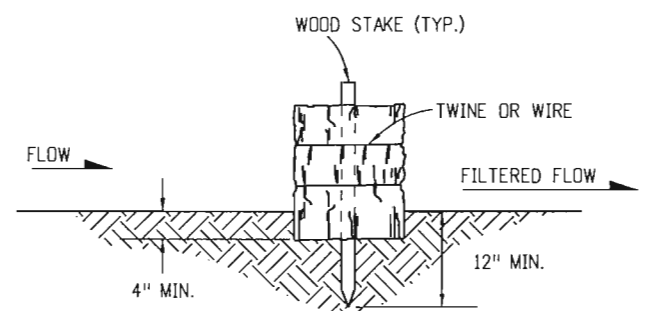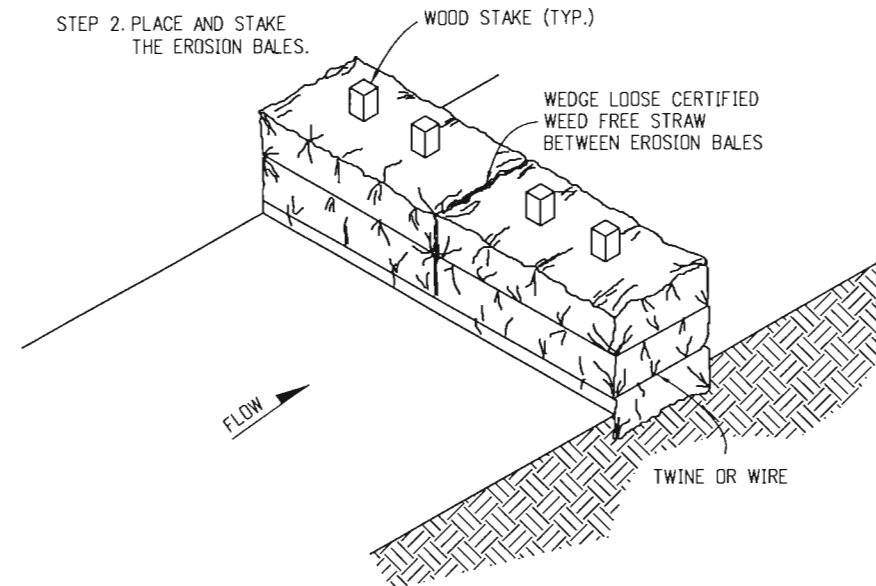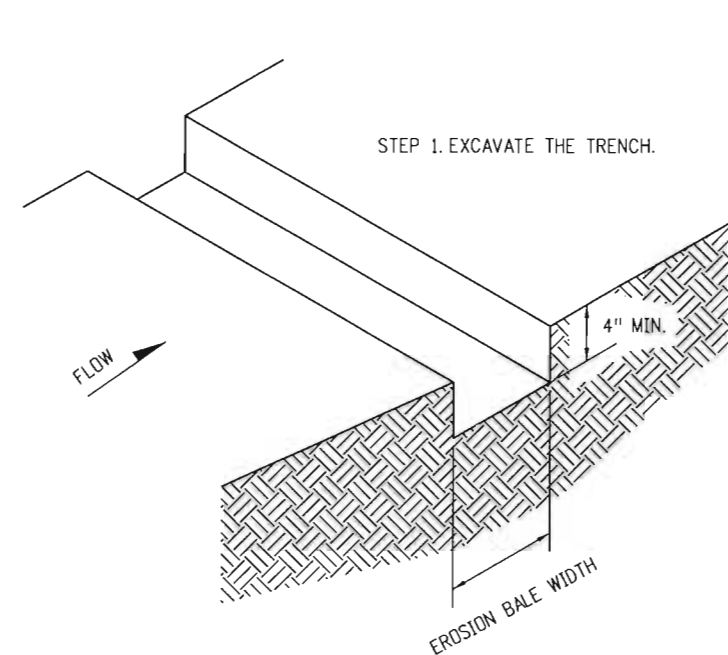


EROSION BALE TRENCHING AND STAKING

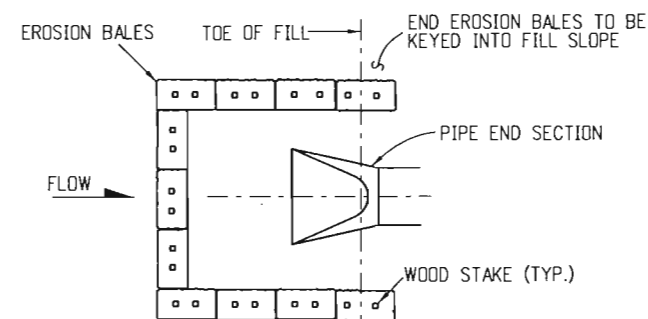


PLAN VIEW
EROSION BALE CULVERT INLET PROTECTION

NOTES

1. STAKES SHALL BE WOOD AND SHALL BE 2" X 2" NOMINAL.
2. EROSION BALES SHALL BE 18" X 18" X 36".
3. EROSION BALES SHALL BE ENTRENCHED 4 IN. MINIMUM INTO THE SOIL, THIGHTLY ABUTTED WITH NO GAPS, STAKED, AND BACKFILLED AROUND THE ENTIRE OUTSIDE PERIMETER.

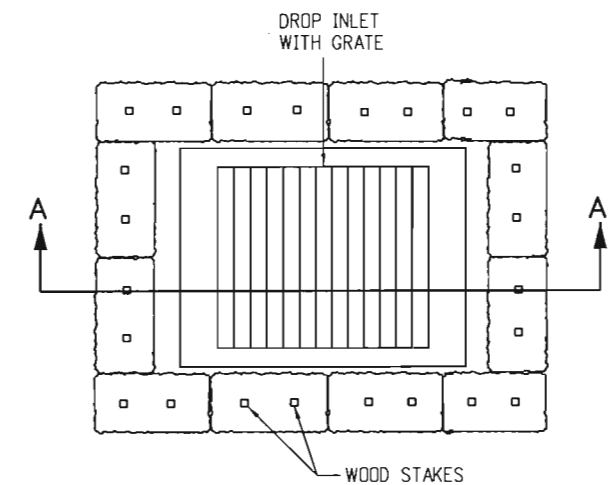


PLAN VIEW

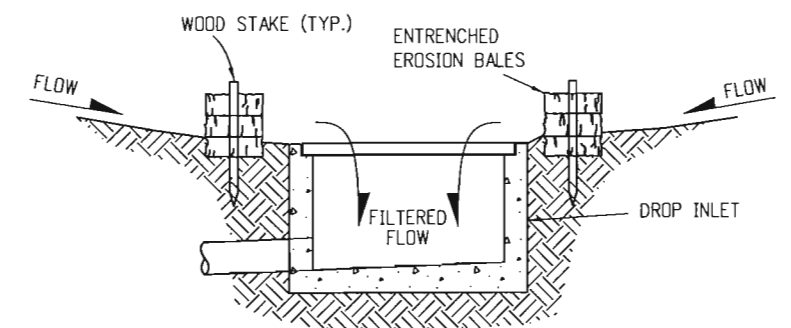


SECTION A-A
EROSION BALE FILTER AT DROP INLET

EROSION BALE APPLICATIONS


Computer File Information		Sheet Revisions		 Colorado Department of Transportation 4201 East Arkansas Avenue Denver, Colorado 80222 Phone: (303) 757-9083 Fax: (303) 757-9820 Project Development Branch DD/LTA	TEMPORARY EROSION CONTROL	STANDARD PLAN NO.	
Creation Date: 06/08/10	Initials: DD	Date:	Comments			M-208-1	
Last Modification Date: 07/29/11	Initials: LTA	08/26/10	Revised to meet new water quality standards.			Sheet No. 12 of 12	
Full Path: www.dot.state.co.us/DesignSupport/			Revised sheets 1-7.				
Drawing File Name: 20801012012.dgn			Added sheets 8-12.		Issued By: Project Development Branch on July 04, 2006		
CAD Ver.: MicroStation V8 Scale: Not to Scale Units: English							

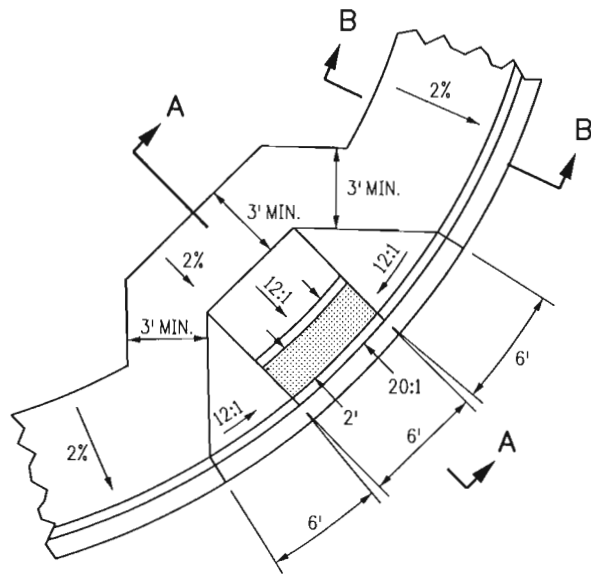


SIDEWALK RAMP TYPE 1A

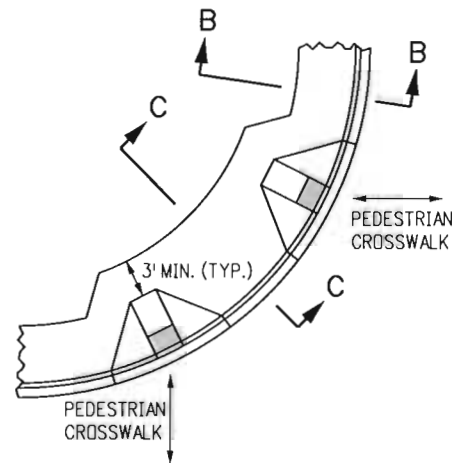

SIDEWALK RAMP TYPE 1B

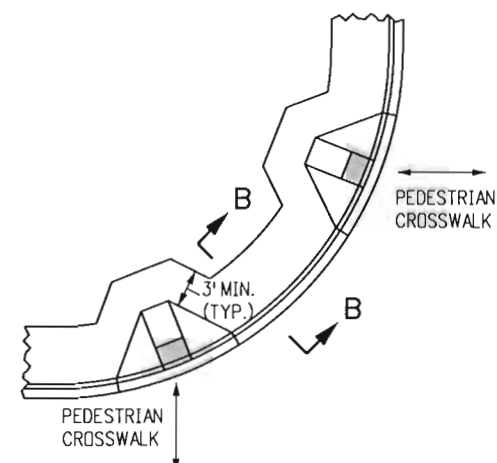


SIDEWALK RAMP TYPE 1C

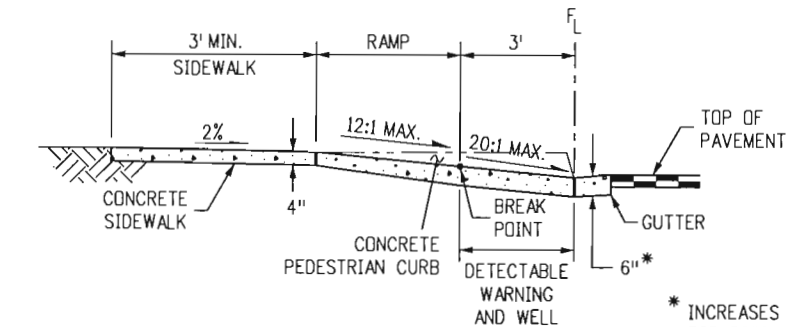


SECTION A-A


* INCREASES TO 8" FOR BRICK PAVERS.

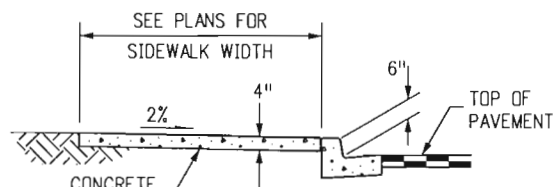

SECTION B-B

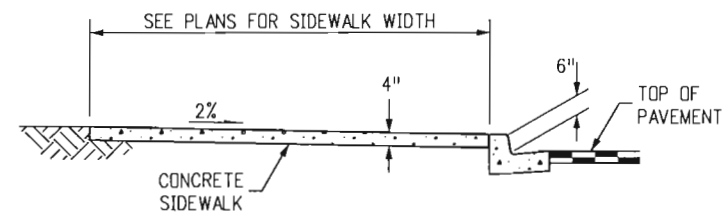


SECTION C-C

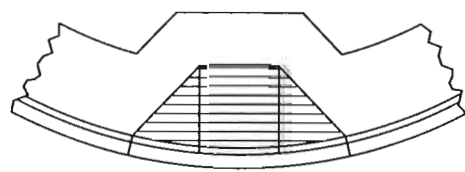


RAMP PAY AREA

FOR SIDEWALK RAMP
TYPES 1A, 1B, 1C, 1D.

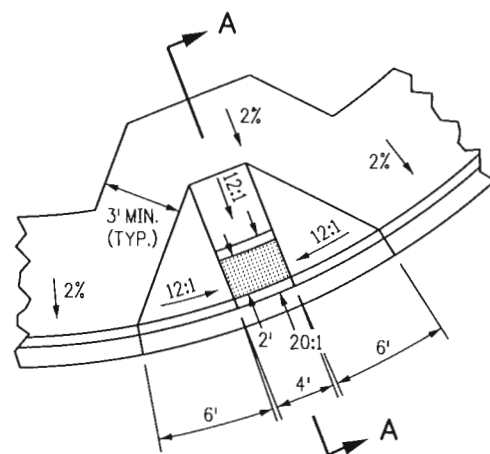


RAMP DETAIL

FOR SIDEWALK RAMP
TYPES 1B, 1C, 1D.

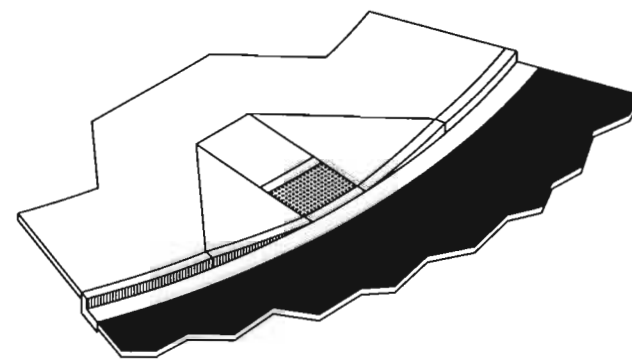

ISOMETRIC VIEW

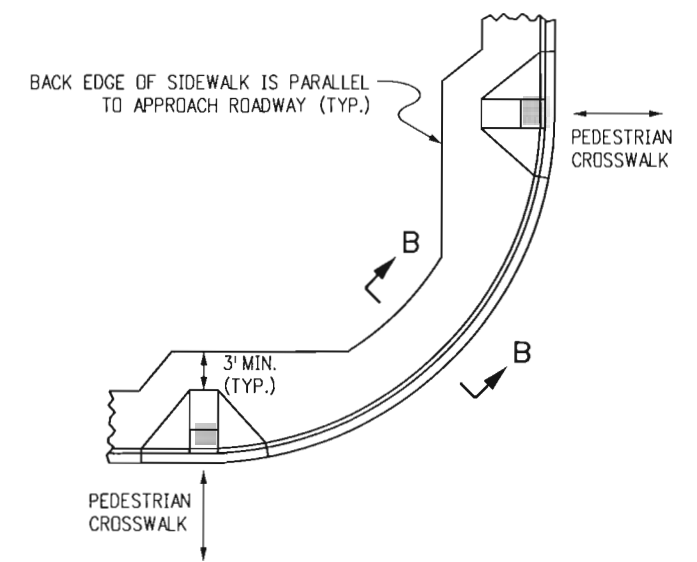

SIDEWALK RAMP TYPE 1D

GENERAL NOTES

1. THE DETECTABLE WARNINGS SHALL BE INSTALLED AT SIDEWALK TO STREET TRANSITIONS. THEY SHALL HAVE A TRUNCATED DOME SURFACE. THE DOMES SHALL BE IN A SQUARE GRID PATTERN.
2. ALL DETECTABLE WARNING AREAS SHALL START A MINIMUM OF 6 IN. FROM THE FLOW LINE OF THE CURB AND NOT BE MORE THAN A MAXIMUM OF 8 IN. FROM ANY POINT ON THE FLOW LINE OF THE CURB. ALL DETECTABLE WARNING AREAS SHALL BE 2 FT. IN LENGTH AND COVER THE COMPLETE WIDTH OF THE RAMP AREA ONLY.
3. RAMP SLOPES SHALL BE 12:1 OR FLATTER. THE DETECTABLE WARNING SLOPES SHALL BE 20:1 OR FLATTER.
4. MINIMUM SIDEWALK WIDTH IS 3 FT.
5. DO NOT INSTALL DRAINAGE STRUCTURES, TRAFFIC SIGNAL EQUIPMENT, JUNCTION BOXES, AND OTHER OBSTRUCTIONS IN FRONT OF THE RAMP ACCESS AREAS.
6. CONSTRUCTION OF THE CONCRETE PEDESTRIAN CURB ADJACENT TO THE RAMP AREAS SHALL BE INCLUDED IN THE BID PRICE OF THE CONCRETE CURB RAMP.
7. DETECTABLE WARNINGS SHALL MEET SECTION 705 OF THE USDOT ADA STANDARDS FOR TRANSPORTATION FACILITIES.

Computer File Information

Creation Date: 07/09/09 Initials: DD
Last Modification Date: 05/05/11 Initials: LTA
Full Path: www.dot.state.co.us/DesignSupport/
Drawing File Name: 608010106.dgn
CAD Ver.: MicroStation V8 Scale: Not to Scale Units: English

Sheet Revisions

Date:	Comments
05/05/11	Changed gutter thickness to 6".
05/05/11	Changed sheet numbers.
05/05/11	Add General Notes 1 through 4.
05/05/11	Added the Plate option.

Colorado Department of Transportation



4201 East Arkansas Avenue
Denver, Colorado 80222
Phone: (303) 757-9083
Fax: (303) 757-9820

Project Development Branch

DD/LTA


CURB RAMPS

Issued By: Project Development Branch on July 04, 2006


STANDARD PLAN NO.

M-608-1

Sheet No. 1 of 6

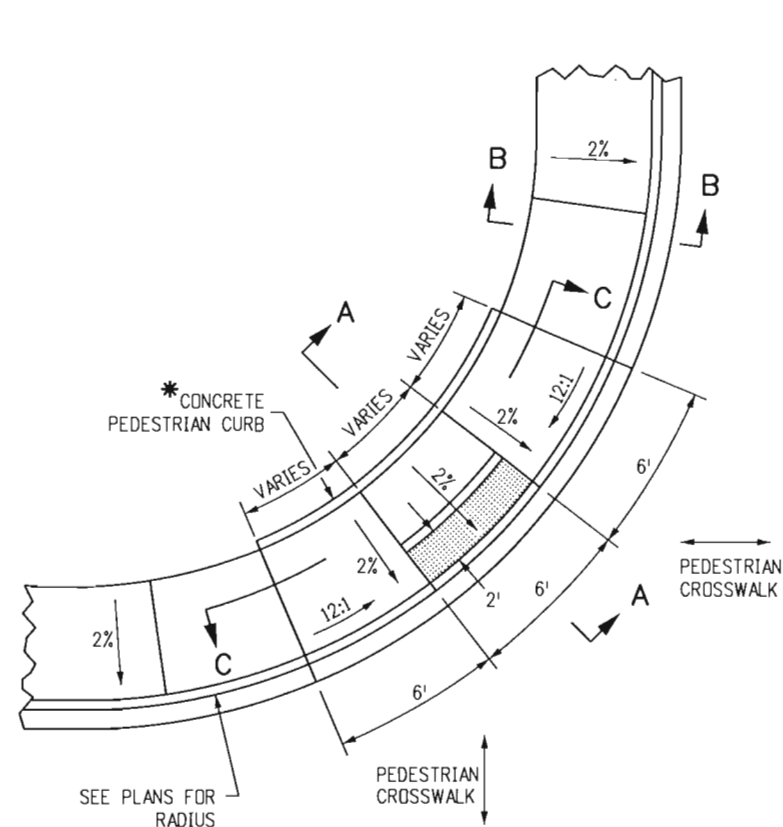


SIDEWALK RAMP TYPE 2A

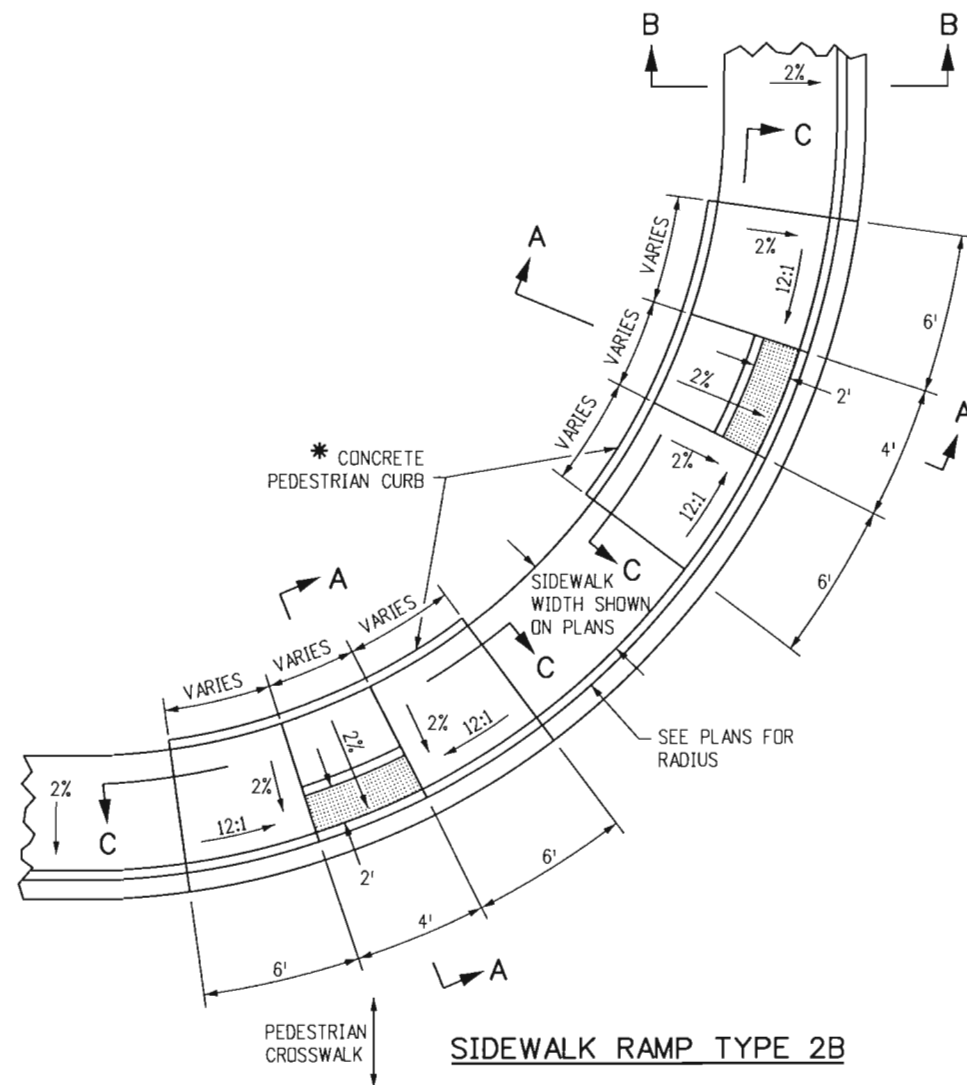


SIDEWALK RAMP TYPE 2B

- NOTES**
1. SIDEWALK RAMP TYPE 2A MAY BE USED IN MID-BLOCK.

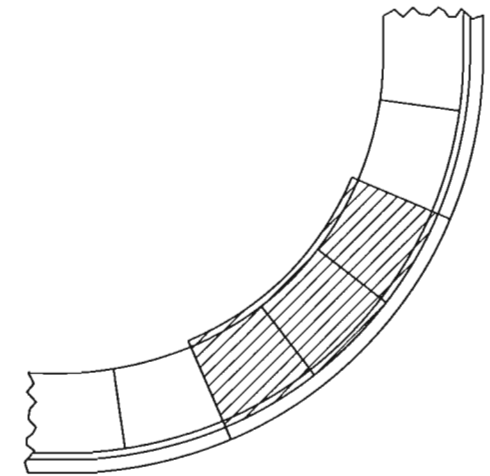


RAMP PAY AREA


- FOR SIDEWALK RAMP TYPES 2A AND 2B.
* INCLUDES CONCRETE PEDESTRIAN CURB AS SHOWN.

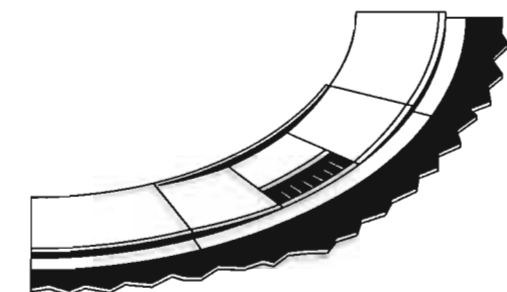


ISOMETRIC VIEW

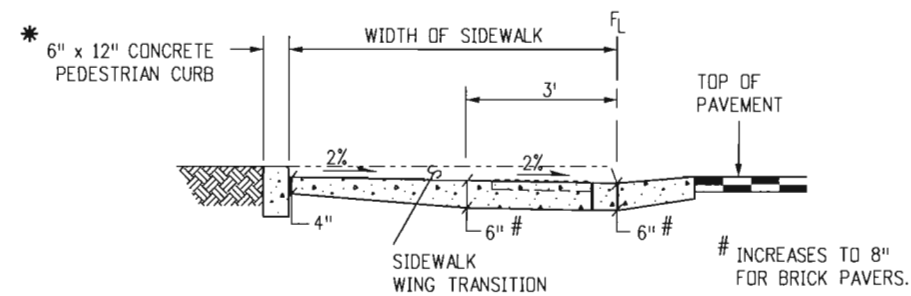

SECTION A-A

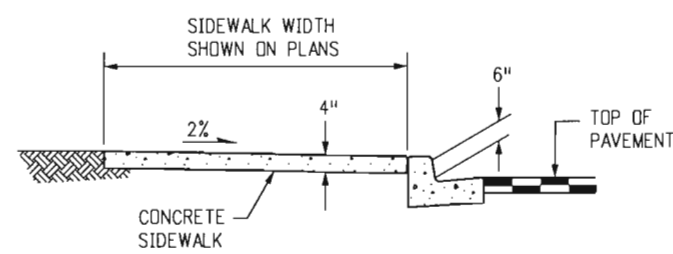


SECTION B-B

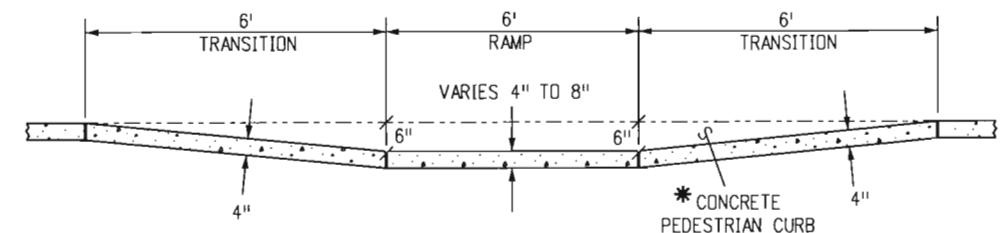


SECTION C-C

Computer File Information		Sheet Revisions		Colorado Department of Transportation		STANDARD PLAN NO.
Creation Date: 07/09/09	Initials: DD	Date:	Comments			
Last Modification Date: 05/05/11	Initials: LTA	05/05/11	Changed gutter thickness to 6".	 4201 East Arkansas Avenue Denver, Colorado 80222 Phone: (303) 757-9083 Fax: (303) 757-9820	CURB RAMPS	M-608-1
Full Path: www.dot.state.co.us/DesignSupport/		05/05/11	Added ramp pay area footnote.			
Drawing File Name: 608010206.dgn						
CAD Ver.: MicroStation V8	Scale: Not to Scale	Units: English				
				Project Development Branch	DD/LTA	Sheet No. 2 of 6
				Issued By: Project Development Branch on July 04, 2006		

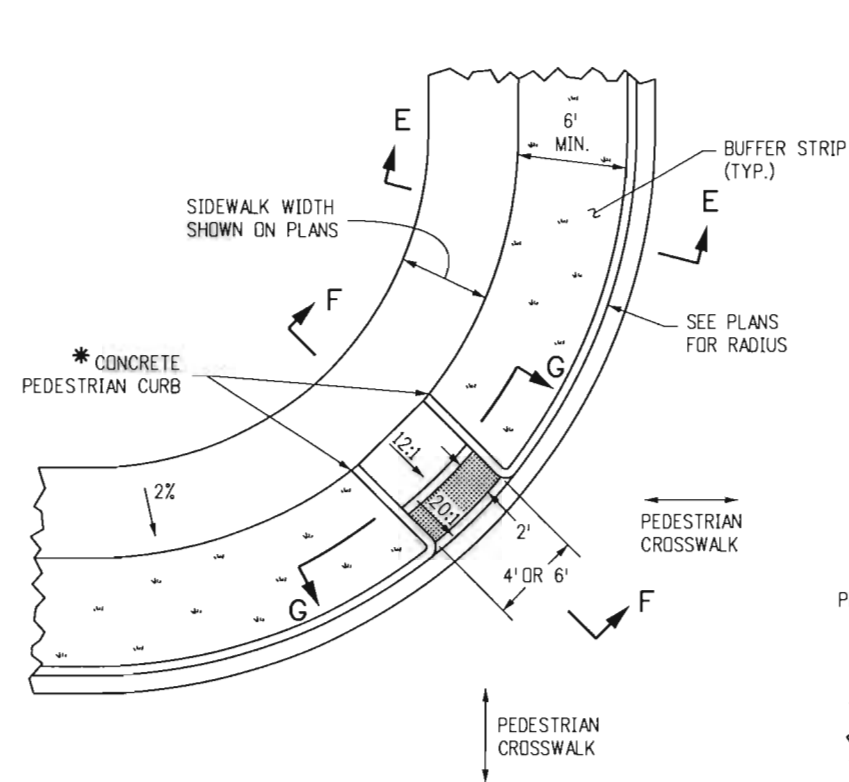


SIDEWALK RAMP TYPE 3A

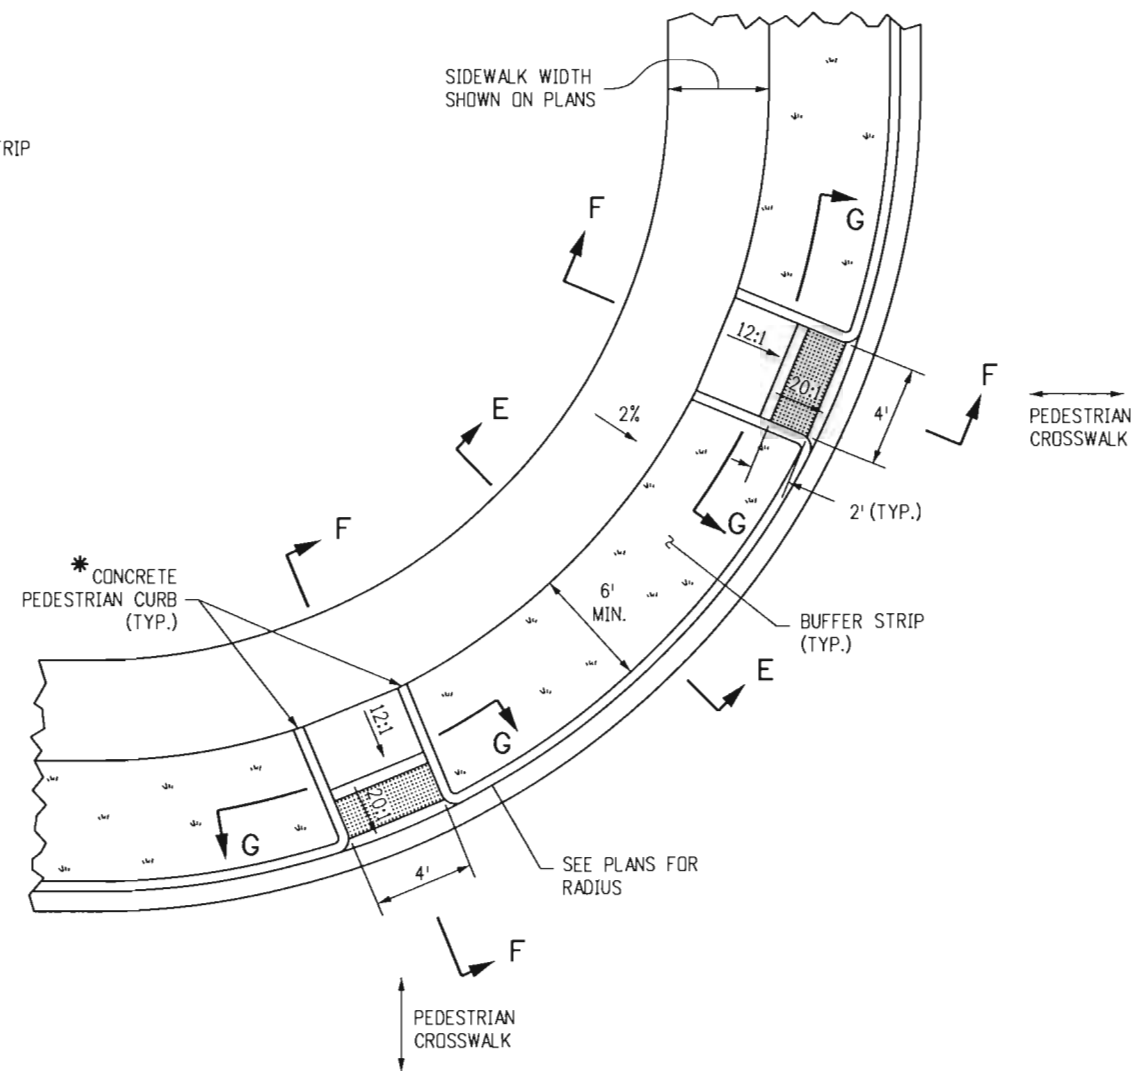


SIDEWALK RAMP TYPE 3B


NOTES
1. SIDEWALK RAMP TYPE 3A MAY BE USED IN MID-BLOCK.

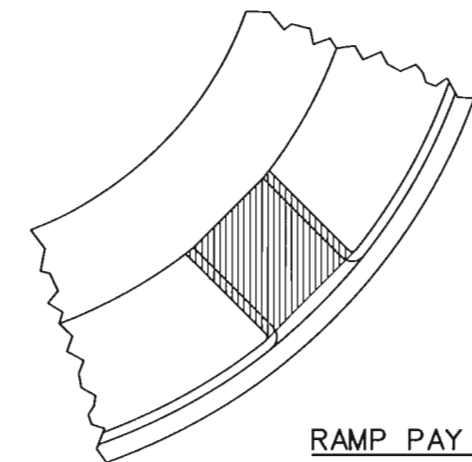


FOR SIDEWALK RAMP TYPES 3A AND 3B.
* INCLUDES CONCRETE PEDESTRIAN CURB AS SHOWN.

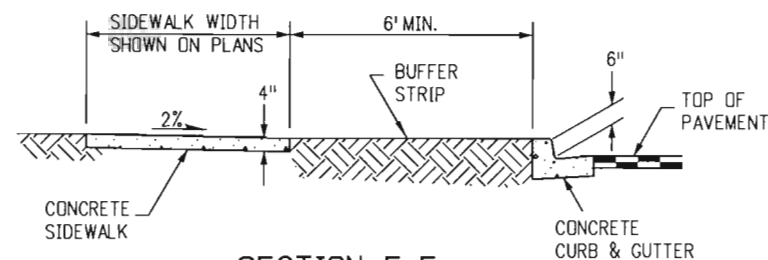


SECTION E-E

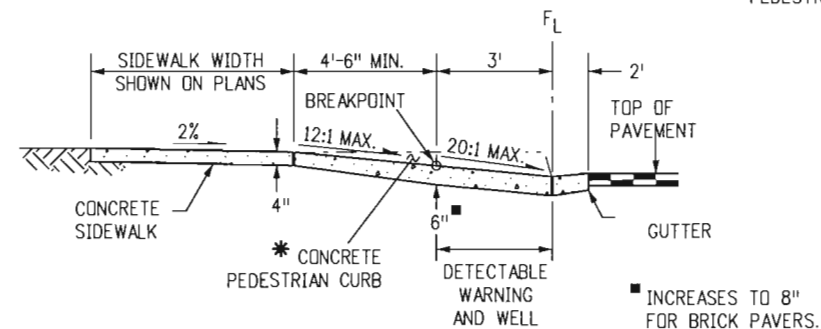

SECTION F-F

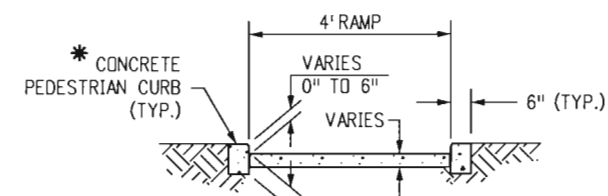


SECTION G-G

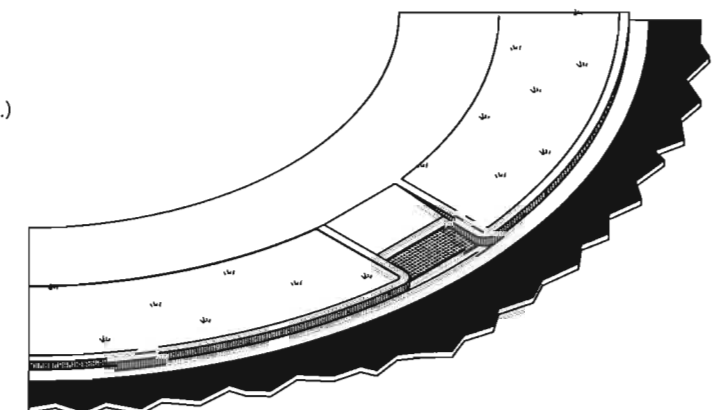


ISOMETRIC VIEW


Computer File Information		<div><div>(R-1)</div><div>(R-X)</div><div>(R-X)</div><div>(R-X)</div></div>	Sheet Revisions		Colorado Department of Transportation		CURB RAMPS		STANDARD PLAN NO.		
Creation Date: 07/09/09	Initials: DD		Date:	Comments	<div><div><div><div></div><div>C</div></div><div><div>DOT</div><div>DEPARTMENT OF TRANSPORTATION</div></div></div><div>4201 East Arkansas Avenue Denver, Colorado 80222 Phone: (303) 757-9083 Fax: (303) 757-9820</div></div>	M-608-1					
Last Modification Date: 05/05/11	Initials: LTA		05/05/11	Changed gutter thickness to 6".		Project Development Branch DD/LTA		Issued By: Project Development Branch on July 04, 2006		Sheet No. 3 of 6	
Full Path: www.dot.state.ca.us/DesignSupport/			05/05/11	Added ramp pay area footnote.							
Drawing File Name: 608010306.dgn											
CAD Ver.: MicroStation V8	Scale: Not to Scale		Units: English								

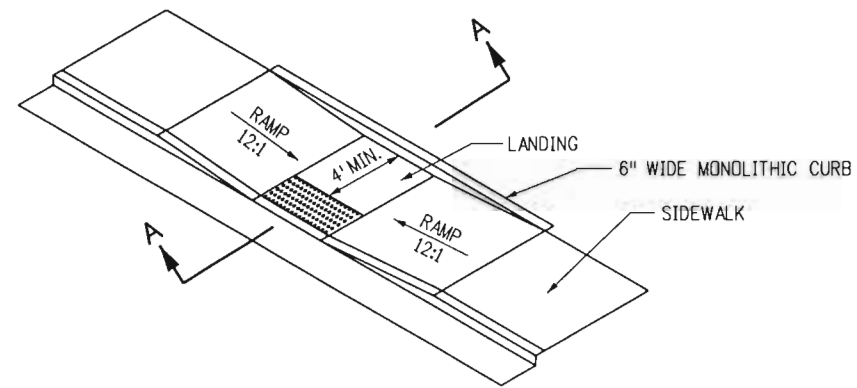


PARALLEL SIDEWALK RAMP

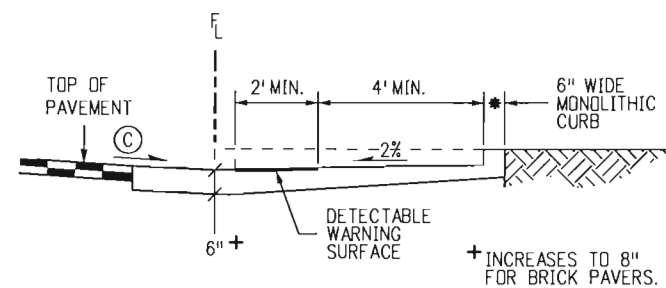


SECTION A-A

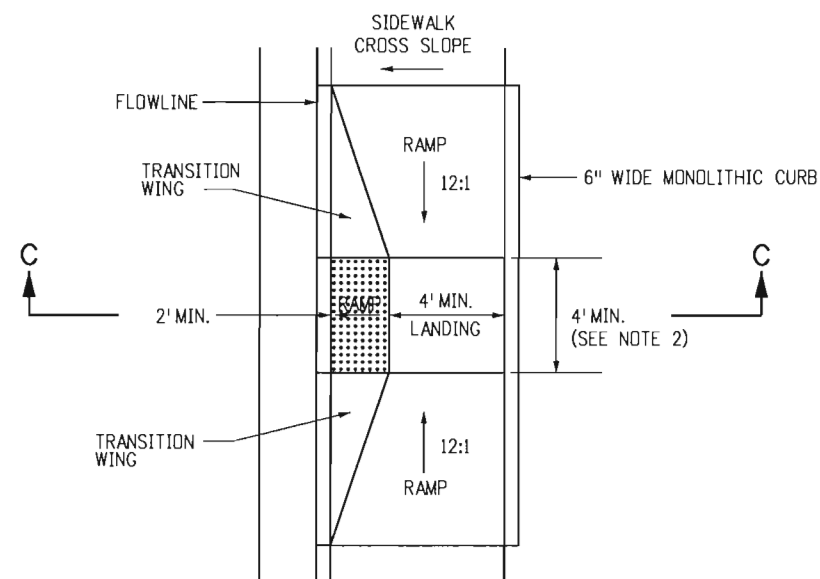

PEDESTRIAN ACCESS RAMP WITHIN SIDEWALK

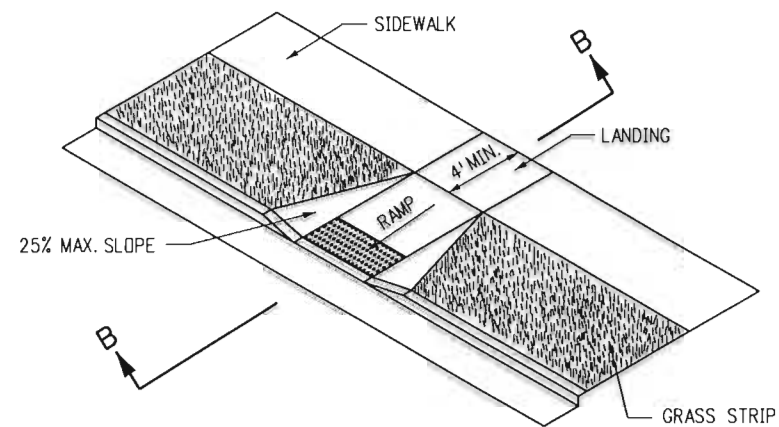


PERPENDICULAR PEDESTRIAN RAMP

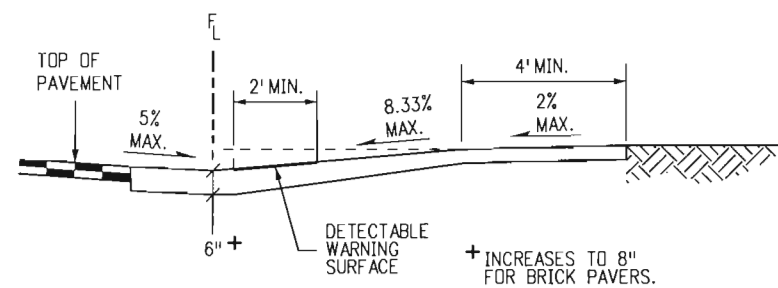

SECTION B-B


*INCLUDES CONCRETE PEDESTRIAN CURB AS SHOWN.

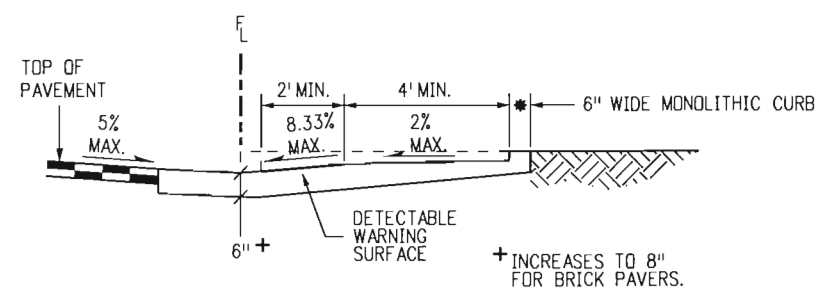

SECTION C-C


NOTES

1. PERPENDICULAR AND PARALLEL PEDESTRIAN RAMPS SHOWN ON THIS DRAWING ARE ACCEPTABLE FOR USE AT MID-BLOCK INSTALLATIONS.
2. SITE CONDITIONS WILL VARY. CONFIGURATION OF RAMPS, LANDINGS, AND TRANSITIONS MAY BE CHANGED BUT THEY MUST MEET THE DIMENSIONS AND SLOPES SHOWN HERE. THE USE OF FLARES, CURBWALLS, ETC. ARE AT THE DISCRETION OF THE ENGINEER.
3. PROVIDE DETECTABLE WARNING SURFACE FOR FULL WIDTH OF CURB CUT. SEE "PLAN VIEW OF DETECTABLE WARNING" DETAIL ON SHEET 5 FOR DETECTABLE WARNING SURFACE DIMENSIONS.
4. LOCATE CURB CUT WITHIN CROSSWALK.
5. RAMP GRADE BREAK MUST BE PERPENDICULAR TO THE RUNNING SLOPE.

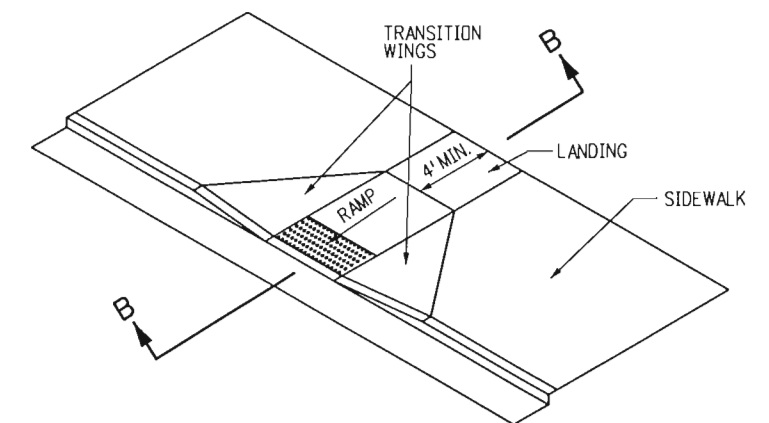


PERPENDICULAR PEDESTRIAN RAMP WITHIN SIDEWALK


Computer File Information		Sheet Revisions		<div> <div>Colorado Department of Transportation</div> <div>  <div> 4201 East Arkansas Avenue Denver, Colorado 80222 Phone: (303) 757-9083 Fax: (303) 757-9820 </div> </div> <div>Project Development Branch</div> <div>DD/LTA</div> </div>	STANDARD PLAN NO.	
Creation Date: 07/09/06	Initials: DD	Date: 05/05/11	Comments: New Ramp Designs		M-608-1	
Last Modification Date: 05/05/11	Initials: LTA				Sheet No. 4 of 6	
Full Path: www.dot.state.co.us/DesignSupport/						
Drawing File Name: 608010406.dgn						
CAD Ver.: MicroStation V8 Scale: Not to Scale Units: English				Issued By: Project Development Branch on July 04, 2006		

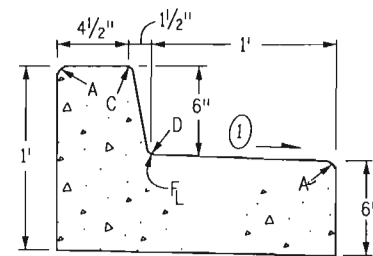


CURB AND GUTTER TYPE 2
(SECTION IB)
(6 IN. BARRIER - 1 FT. GUTTER)

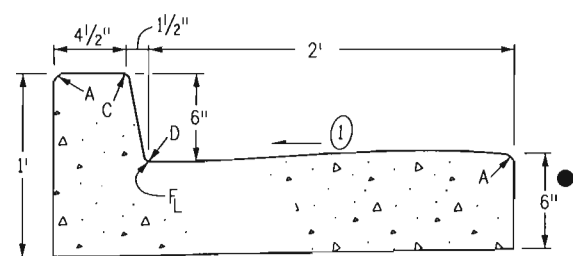


CURB AND GUTTER TYPE 2
(SECTION IIB)
(6 IN. BARRIER - 2 FT. GUTTER)

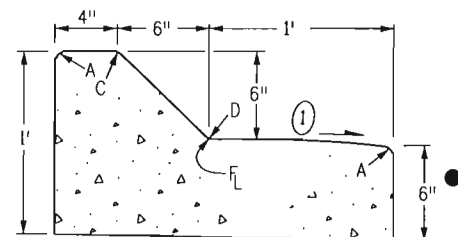

CURB AND GUTTER TYPE 2
(SECTION IM)
(6 IN. MOUNTABLE - 1 FT. GUTTER)

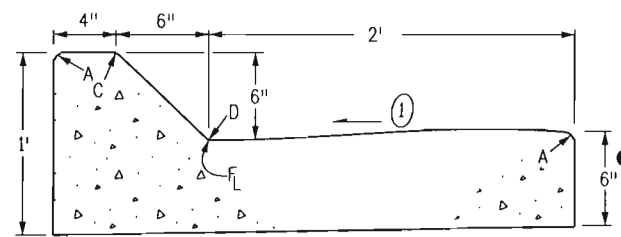


CURB AND GUTTER TYPE 2
(SECTION IIM)
(6 IN. MOUNTABLE - 2 FT. GUTTER)

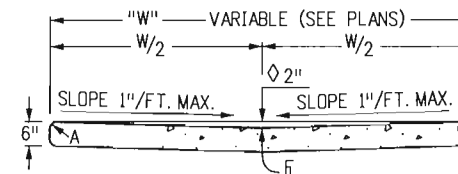


2 IN. DEPTH WHEN USED AS A
CROSSSPAN IN AN INTERSECTION


GUTTER TYPE 2

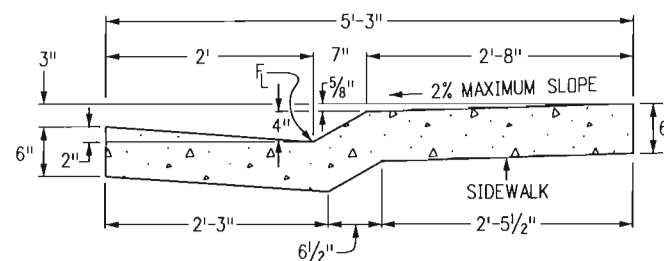

CURB AND GUTTER TYPE 2
(SECTION MS)
(4 IN. MOUNTABLE WITH SIDEWALK)

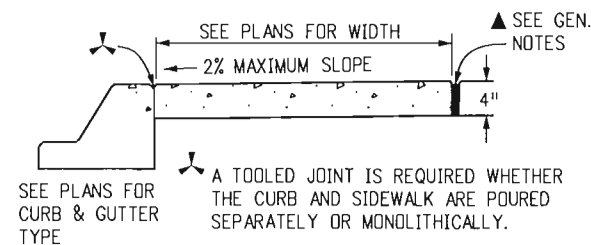

CONCRETE SIDEWALK

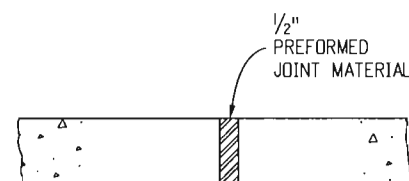

NOTES: 1. EXPANSION JOINTS SHALL BE PLACED
IN THE SIDEWALK AT INTERVALS OF
NOT MORE THAN 500 FT.

2. EXPANSION JOINTS MAY BE SEALED
WHEN SPECIFIED ON THE PLANS.

SIDEWALK EXPANSION JOINT

GENERAL NOTES


- ON ROADWAY CURVES WITH A RADIUS OF 1,900 FT. OR LESS, CURBS AND GUTTERS ARE TO BE PLACED ON THE ARC OF THE CURVE, UNLESS OTHERWISE NOTED ON THE PLANS. A MAXIMUM CHORD LENGTH OF 10 FT. MAY BE USED WHEN THE CURVE RADIUS IS GREATER THAN 1,900 FT.
- CONCRETE SHALL BE CLASS B.
- PROFILE GRADE OF CURBS AND GUTTERS SHALL BE LOCATED AT THE FLOW LINE.
- CURB TYPE 4 (KEY-WAY) MAY BE USED IN LIEU OF CURB AND GUTTER TYPE 2 (SECTIONS IB AND IM) UNLESS OTHERWISE SPECIFIED ON THE PLANS.
- GUTTER CROSS SLOPES MAY BE ADJUSTED TO FACILITATE DRAINAGE FOR PROFILE GRADES AS SHOWN ON THE PLANS.
- THICKNESS OF CURB AND GUTTER SECTION SHALL MATCH CONCRETE PAVEMENT THICKNESS IF SHOWN ON THE PLANS. CURB AND GUTTER SHALL BE CLASS P CONCRETE IF PLACED MONOLITHICALLY WITH CONCRETE PAVEMENT.
- INCREASE SIDEWALK THICKNESS TO 6 IN. AT LOCATIONS SHOWN ON THE PLANS.

▲ EXPANSION JOINTS SHALL BE INSTALLED WHEN ABUTTING EXISTING CONCRETE OR FIXED STRUCTURE. EXPANSION JOINT MATERIAL SHALL BE 1/2 IN. THICK AND SHALL EXTEND THE FULL DEPTH OF CONTACT SURFACE.

① GUTTER CROSS SLOPES SHALL BE 1/2 IN./FT. WHEN DRAINING AWAY FROM CURB AND 1 IN./FT. WHEN DRAINING TOWARD CURB.

● WHEN TIE BARS ARE REQUIRED, THE GUTTER THICKNESS SHALL BE INCREASED TO THE PAVEMENT THICKNESS (T). BARS SHALL BE EPOXY-COATED #4 CONFORMING TO AASHTO M 284 AND SPACED AT 2 FT.-6 IN. INTERVALS. THEY SHALL BE INSERTED 1/2 AND 1/2 LENGTH INTO THE GUTTER.

LEGEND FOR RADII	
A	= 1/8" TO 1/4"
B	= 1"
C	= 1 1/2"
D	= 1 1/2" TO 2"

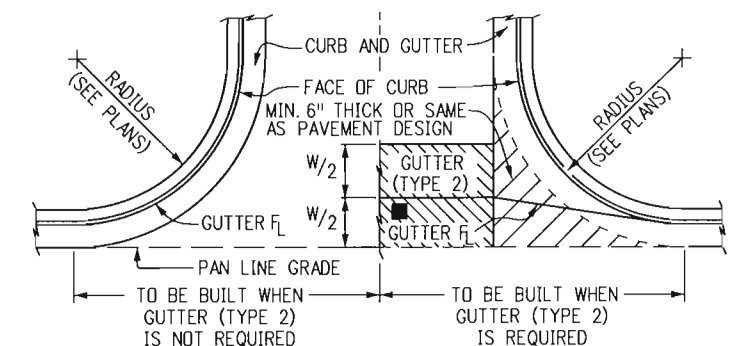


THIS AREA SHALL BE POURED MONOLITHICALLY WITH CURB AND GUTTER AND PAID FOR AS "CONCRETE PAVEMENT".


■ FLOW LINE LOCATION WILL BE ESTABLISHED BY W/2 SHOWN ON PLANS.

CONSTRUCTION OF CONCRETE GUTTERS AT INTERSECTION


Computer File Information		Sheet Revisions		Colorado Department of Transportation 4201 East Arkansas Avenue Denver, Colorado 80222 Phone: (303) 757-9083 Fax: (303) 757-9820 Project Development Branch DD/LTA	CURB, GUTTERS, AND SIDEWALKS	STANDARD PLAN NO. M-609-1
Creation Date: 07/04/06	Initials: DD	Date:	Comments			
Last Modification Date: 07/09/09	Initials: LTA	07/09/09	Added Note 2 to Sidewalk Expansion Joint detail.			
Full Path: www.dot.state.co.us/DesignSupport/		07/09/09	Revised General Note 4.			
Drawing File Name: 609010104.dgn		07/09/09	Rev sheets 1 and 2. Add sheet 4.			
CAD Ver.: MicroStation V8	Scale: Not to Scale	Units: English			Issued By: Project Development Branch on July 04, 2006	Sheet No. 1 of 4

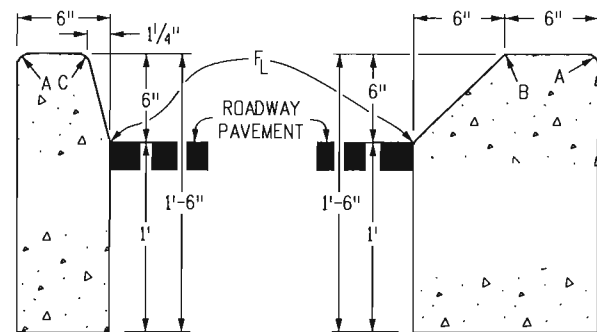


CURB TYPE 2
(SECTION B)
6 IN. BARRIER

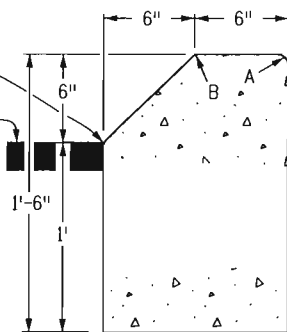

CURB TYPE 2
(SECTION M)
6 IN. MOUNTABLE

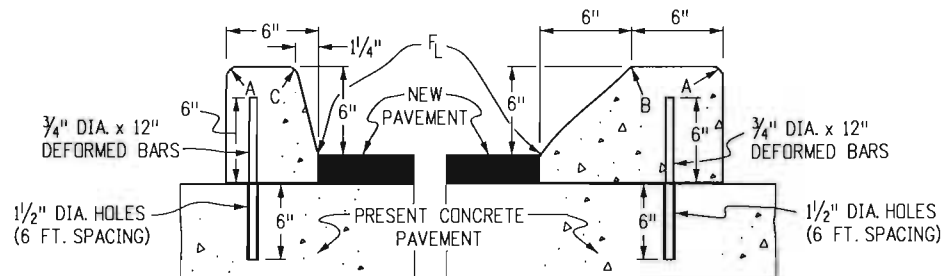


CURB TYPE 4
(SECTION B)
6 IN. BARRIER

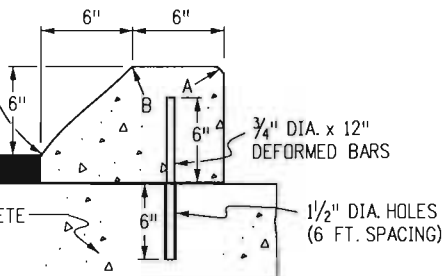

CURB TYPE 4
(SECTION M)
6 IN. MOUNTABLE


3/4" DIA. x 12" DEFORMED BARS
1/2" DIA. HOLES (6 FT. SPACING)
NEW PAVEMENT
PRESENT CONCRETE PAVEMENT
3/4" DIA. x 12" DEFORMED BARS
1/2" DIA. HOLES (6 FT. SPACING)
3/4" DIA. x 12" DEFORMED REINFORCING BARS AT 6 FT. SPACING SHALL BE GROUTED IN 1/4" DIA. HOLES IN EXISTING CONCRETE. GROUT SHALL CONSIST OF 2 PARTS CLEAN SAND AND 1 PART CEMENT. COST OF INSTALLATION SHALL BE INCLUDED IN THE PRICE BID FOR CURB.

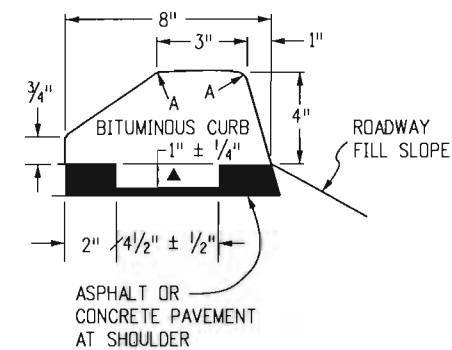

CURB TYPE 6
(SECTION M)
4 IN. MOUNTABLE

NOTE: BITUMINOUS OR CONCRETE * UNLESS OTHERWISE SPECIFIED ON THE PLANS.

▲ KEY-WAY MAY BE OMITTED WHEN PLACED UNDER GUARDRAIL.

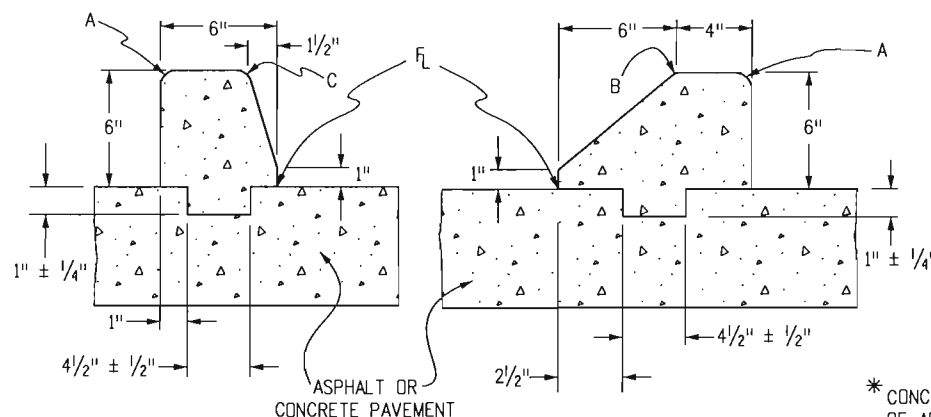


(SECTION B)

(SECTION M)


CURB TYPE 4 (KEY-WAY) *

* CONCRETE SHALL CONTAIN 1.5 POUNDS PER CUBIC YARD OF APPROVED POLYPROPYLENE FIBERS AND MAY HAVE A NOMINAL AGGREGATE SIZE OF 3/8 IN. THE CONCRETE SHALL HAVE A MINIMUM COMPRESSIVE STRENGTH OF 3,000 PSI.

LEGEND FOR RADII	
A	= 1/8 TO 1/4"
B	= 1"
C	= 1 1/2"
D	= 1 1/2" TO 2"

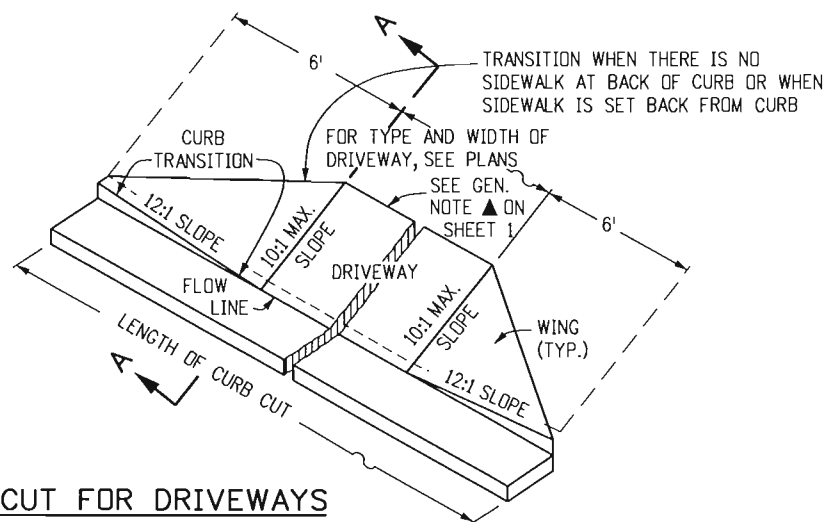


CURB CUT FOR DRIVEWAYS
(WITHOUT ATTACHED SIDEWALK)

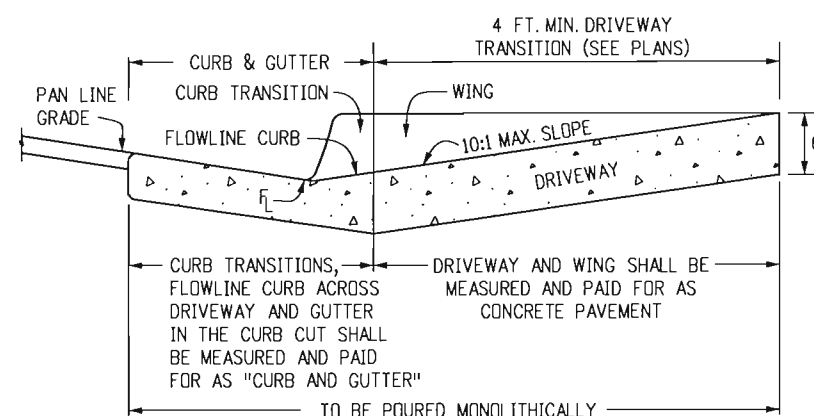

SECTION A-A


CONCRETE PAVEMENT (DRIVEWAYS)

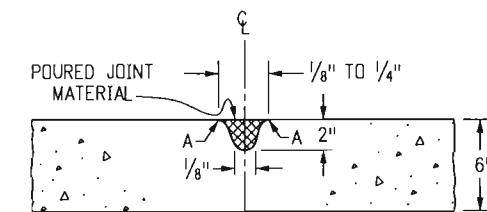




NOTE: RECOMMENDED JOINT SPACING IS EVERY 8 FOOT ALONG THE WIDTH AND LENGTH OF DRIVEWAY. FOR DRIVEWAYS WIDER THAN 12 FEET, JOINTS ARE REQUIRED.

TRANSVERSE CONTRACTION JOINT
FOR CONCRETE PAVEMENT (DRIVEWAYS)


Computer File Information		Sheet Revisions		Colorado Department of Transportation 4201 East Arkansas Avenue Denver, Colorado 80222 Phone: (303) 757-9083 Fax: (303) 757-9820 Project Development Branch DD/LTA	CURB, GUTTERS, AND SIDEWALKS	STANDARD PLAN NO.	
Creation Date: 07/04/06	Initials: DD	Date:	Comments			M-609-1	
Last Modification Date: 7/09/09	Initials: LTA	07/09/09	Added Keyway to Bituminous Curb detail.	(R-1)	Issued By: Project Development Branch on July 04, 2006	Sheet No. 2 of 4	
Full Path: www.dot.state.co.us/DesignSupport/		07/09/09	Revised notes to Transverse Joint and Curb Type 6 details.				
Drawing File Name: 609010204.dgn				(R-2)			
CAD Ver.: MicroStation V8	Scale: Not to Scale	Units: English					

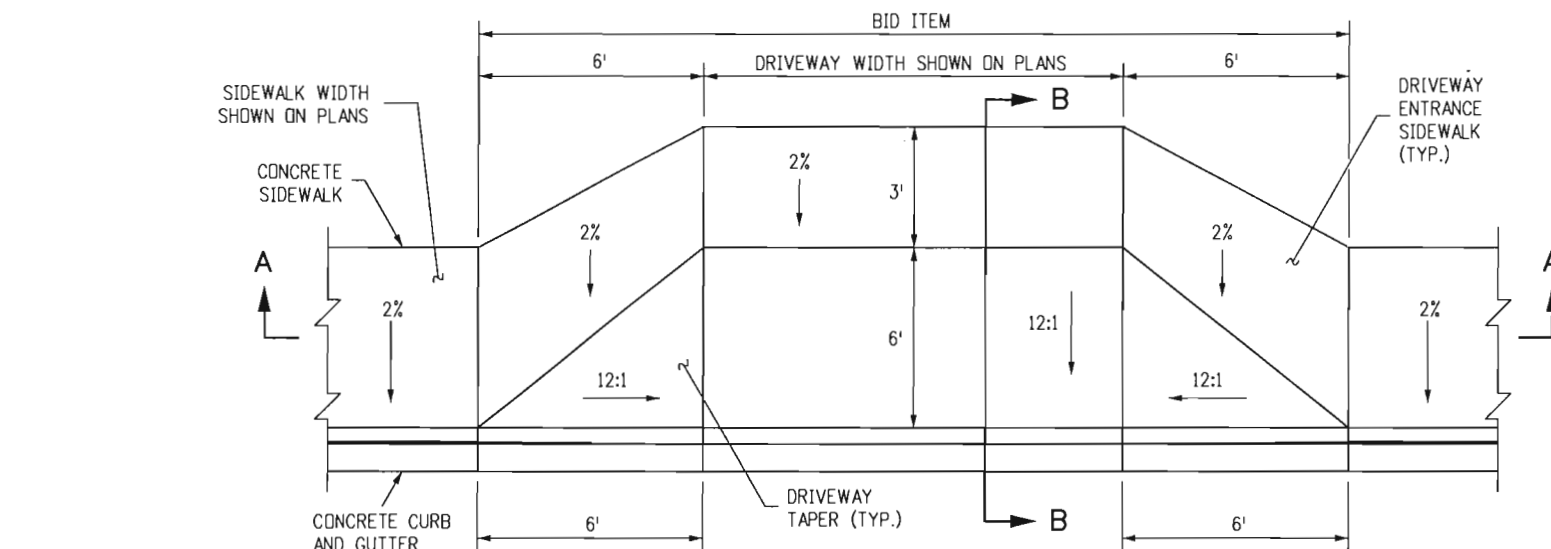


CONCRETE DRIVEWAY ENTRANCE TYPE 1

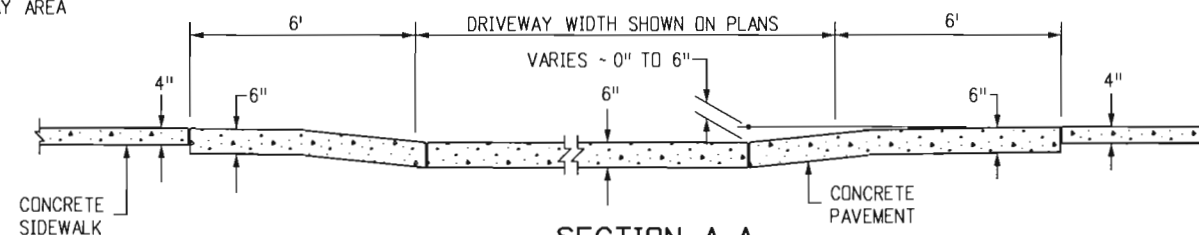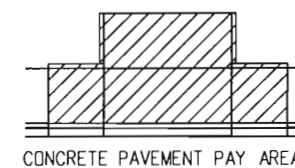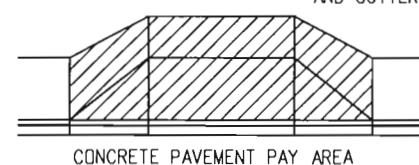


SECTION A-A

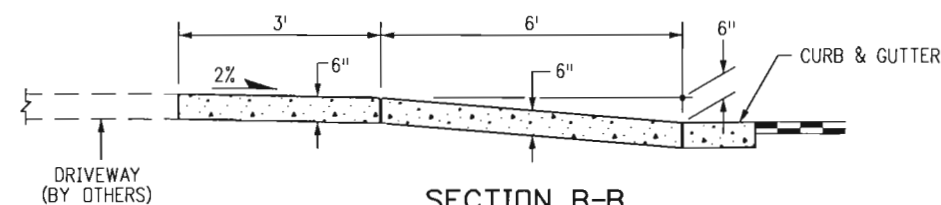


SECTION B-B

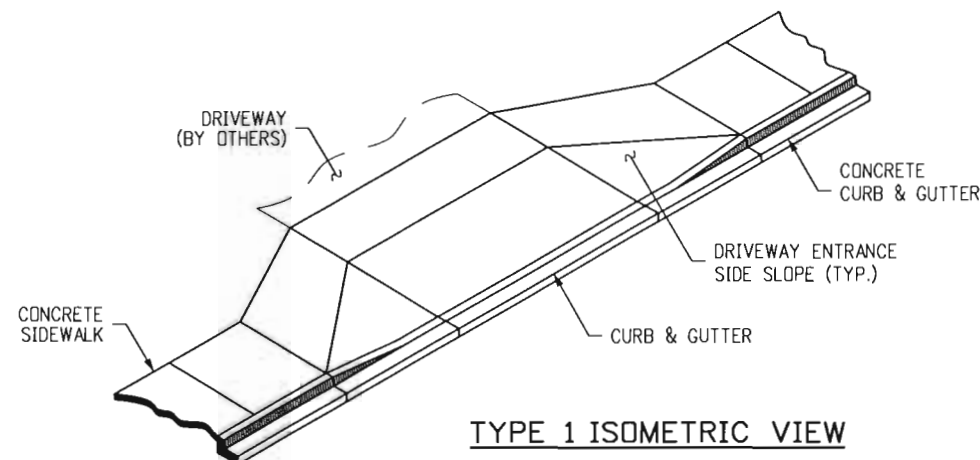


TYPE 1 ISOMETRIC VIEW

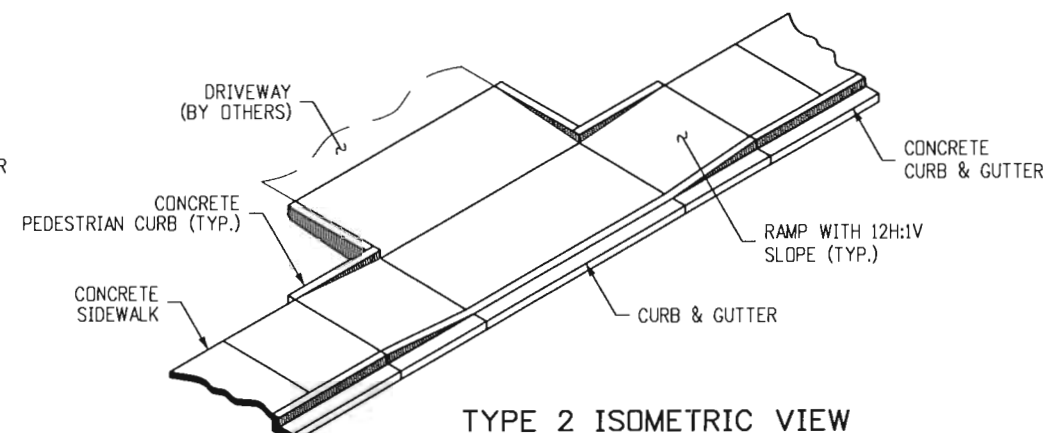


TYPE 2 ISOMETRIC VIEW

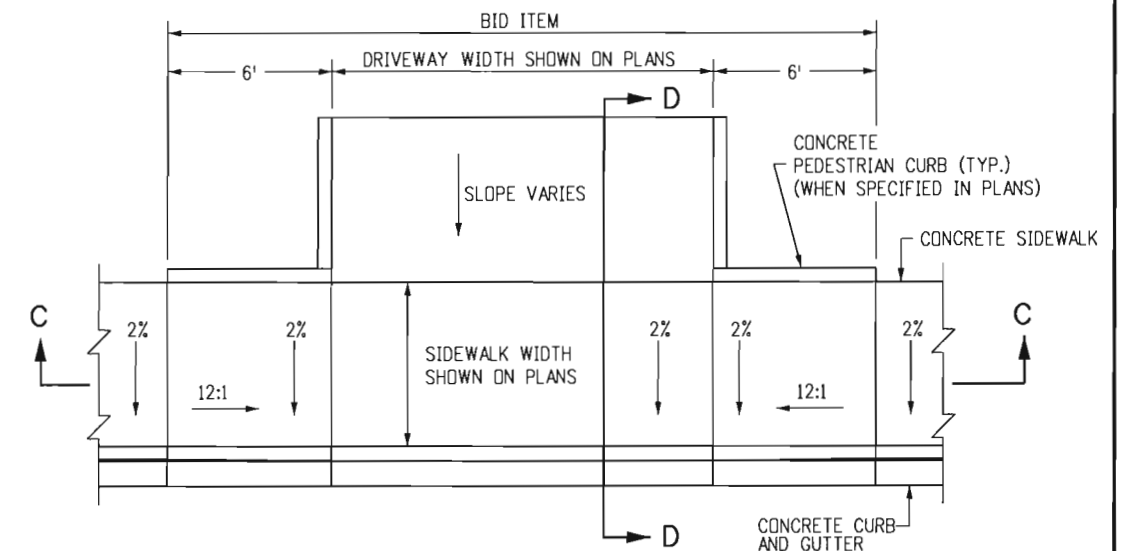

CONCRETE DRIVEWAY ENTRANCE TYPE 2

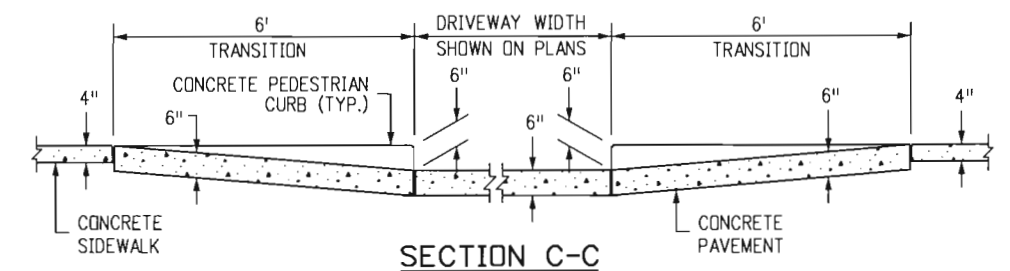

SECTION C-C

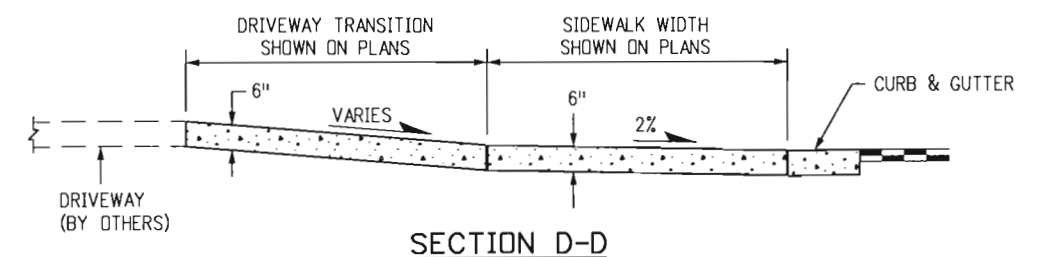

SECTION D-D

NOTES

1. DRAINAGE STRUCTURES, TRAFFIC SIGNAL EQUIPMENT, JUNCTION BOXES, AND OTHER OBSTRUCTIONS SHOULD NOT BE PLACED IN FRONT OF THE DRIVEWAY RAMP ACCESS AREAS.
2. FOR THE CURB AND GUTTER SHOWN, SEE PLANS FOR CURB TYPE.
3. RAMP SLOPES SHALL BE 12:1 OR FLATTER.
4. CONSTRUCTION OF THE CONCRETE PEDESTRIAN CURB SHALL BE INCLUDED IN THE BID PRICE OF THE CONCRETE PAVEMENT.

Computer File Information

Creation Date: 07/04/06 Initials: DD
 Last Modification Date: 07/09/09 Initials: LTA
 Full Path: www.dot.state.co.us/DesignSupport/
 Drawing File Name: 609010304.dgn
 CAD Ver.: MicroStation V8 Scale: Not to Scale Units: English

Sheet Revisions

Date:	Comments
(R-X)	
(R-X)	
(R-X)	
(R-X)	

Colorado Department of Transportation
 4201 East Arkansas Avenue
 Denver, Colorado 80222
 Phone: (303) 757-9083
 Fax: (303) 757-9820
 Project Development Branch DD/LTA


CURB, GUTTERS, AND SIDEWALKS

Issued By: Project Development Branch on July 04, 2006


STANDARD PLAN NO.

M-609-1


Sheet No. 3 of 4

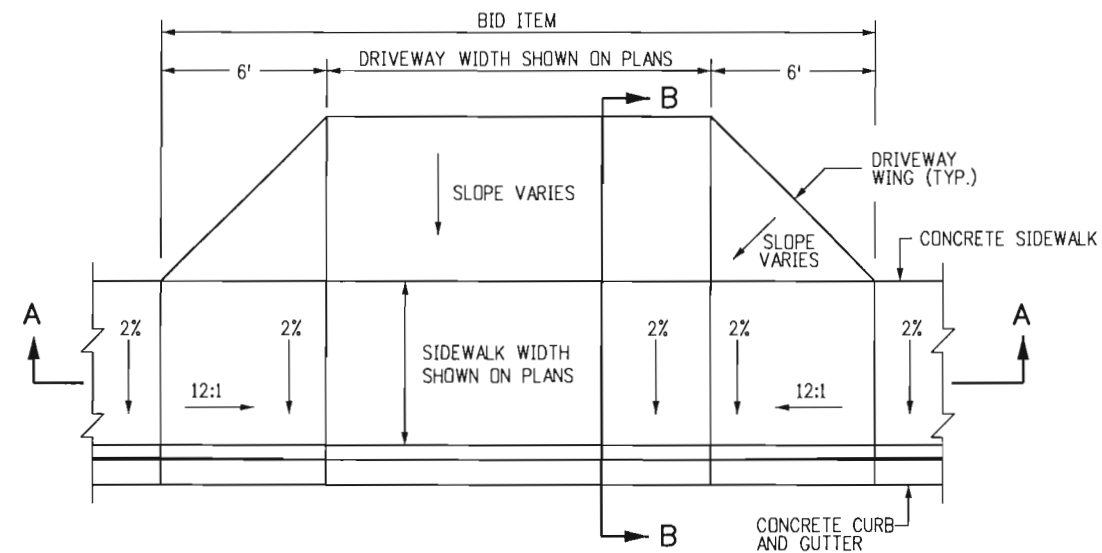


CONCRETE DRIVEWAY ENTRANCE TYPE 3

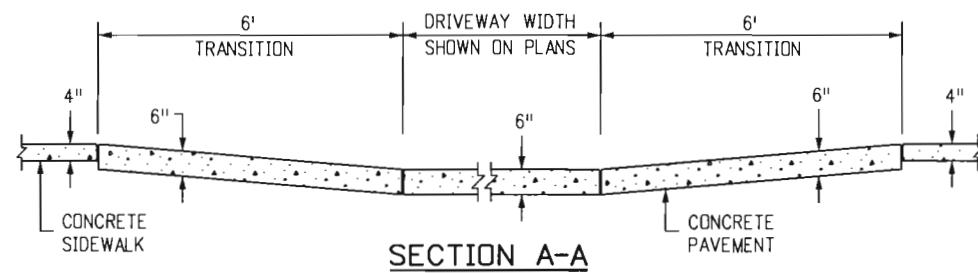

SECTION A-A

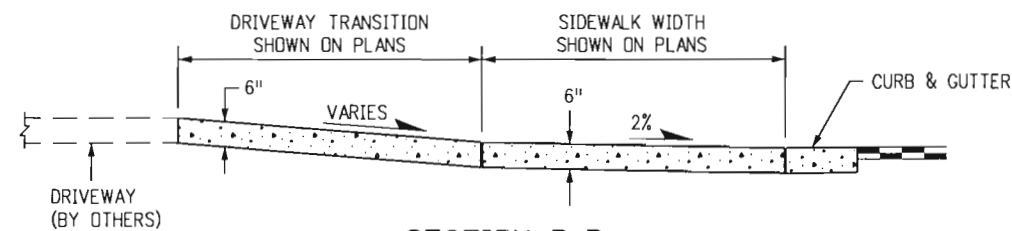


SECTION B-B

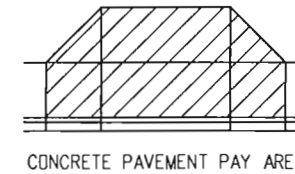

CONCRETE PAVEMENT PAY AREA

NOTES

1. DRAINAGE STRUCTURES, TRAFFIC SIGNAL EQUIPMENT, JUNCTION BOXES, AND OTHER OBSTRUCTIONS SHOULD NOT BE PLACED IN FRONT OF THE DRIVEWAY RAMP ACCESS AREAS.
2. FOR THE CURB AND GUTTER SHOWN, SEE PLANS FOR CURB TYPE.
3. RAMP SLOPES SHALL BE 12:1 OR FLATTER.

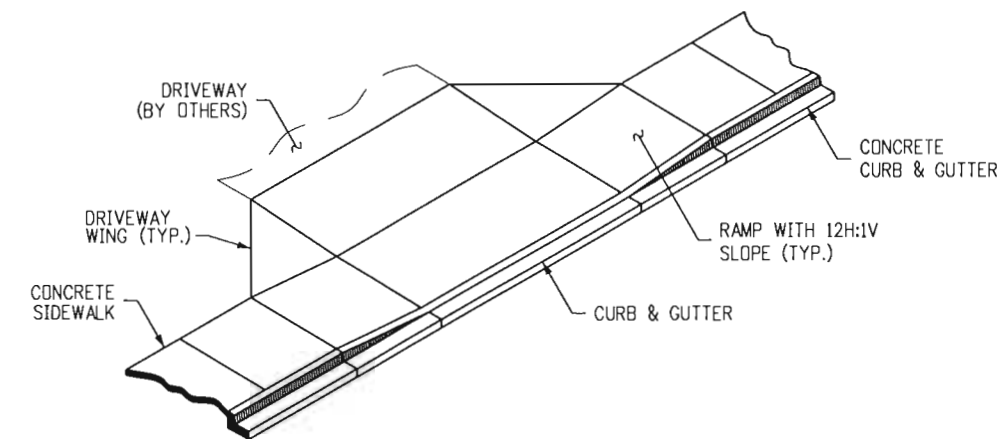

TYPE 3 ISOMETRIC VIEW

Computer File Information		Sheet Revisions		Colorado Department of Transportation 4201 East Arkansas Avenue Denver, Colorado 80222 Phone: (303) 757-9083 Fax: (303) 757-9820 Project Development Branch DD/LTA	CURB, GUTTERS, AND SIDEWALKS	STANDARD PLAN NO.	
Creation Date: 07/09/09	Initials: DD	Date:	Comments			M-609-1	
Last Modification Date: 07/09/09	Initials: LTA	07/09/09	Added Sheet 4 with Concrete Driveway Entrance Type 3.			Sheet No. 4 of 4	
Full Path: www.dot.state.co.us/DesignSupport/	(R-I)						
Drawing File Name: 609010404.dgn	(R-X)						
CAD Ver.: MicroStation V8 Scale: Not to Scale Units: English	(R-X)				Issued By: Project Development Branch on July 04, 2006		

SPACING FOR DELINEATOR POSTS ON HORIZONTAL CURVES


RADIUS (FEET)	DEGREE OF CURVE	SPACING ON CURVE (FEET)	SPACING IN ADVANCE OF AND BEYOND CURVE (FEET)		
			FIRST SPACE	SECOND SPACE	THIRD SPACE
20000	0° 17'	300	300	300	300
17000	0° 20'	300	300	300	300
14000	0° 25'	300	300	300	300
12000	0° 29'	300	300	300	300
10000	0° 34'	299	300	300	300
8000	0° 43'	267	300	300	300
6000	0° 57'	231	300	300	300
5000	1° 09'	211	300	300	300
4000	1° 26'	189	300	300	300
3500	1° 38'	176	300	300	300
3000	1° 55'	163	300	300	300
2500	2° 18'	148	297	300	300
2000	2° 52'	132	265	300	300
1800	3° 11'	125	251	300	300
1600	3° 35'	118	236	300	300
1400	4° 06'	110	220	300	300
1200	4° 47'	102	203	300	300
1000	5° 44'	92	185	277	300
900	6° 22'	87	175	262	300
800	7° 10'	82	164	246	300
700	8° 11'	76	153	229	300
600	9° 33'	70	141	211	300
500	11° 28'	64	127	191	300
450	12° 44'	60	120	180	300
400	14° 20'	56	112	168	300
350	16° 22'	52	104	156	300
300	19° 06'	47	95	142	285
250	22° 55'	42	85	127	255
200	28° 39'	37	73	110	220
150	38° 12'	30	60	90	180
100	57° 18'	21	42	64	127
75	76° 24'	20	30	45	90

* ON CONVENTIONAL ROADWAYS OMIT THE "THIRD SPACE" AND DOUBLE THE SPACING "ON THE CURVE" AND "IN ADVANCE OF AND BEYOND THE CURVE" (300' MAX.)


● SPACING FOR CURVES NOT SHOWN MAY BE COMPUTED FROM THE FORMULA: $S = 3\sqrt{R-50}$

SPACING IN ADVANCE OF AND BEYOND THE CURVE IS: FIRST SPACE = 2S, SECOND SPACE = 3S AND THIRD SPACE = 6S. SPACES SHOULD NOT BE LESS THAN 20 FT. OR GREATER THAN 300 FT. RESIDUAL SPACE AFTER "ON CURVE" SPACING IS APPLIED, SHALL BE DIVIDED EQUALLY AMONG ALL OF THE "ON CURVE" SPACES SO THAT THE LAST DELINEATOR FALLS AT THE P.T. OR C.S. OF THE CURVE.

TYPICAL INSTALLATION SINGLE DIRECTION

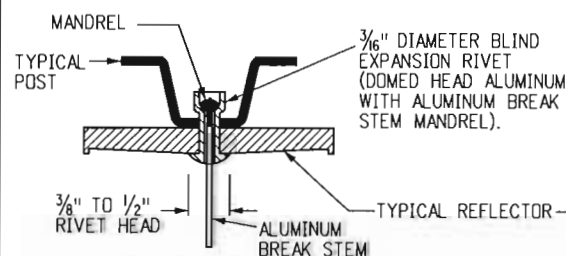


TYPICAL INSTALLATION BACK - TO - BACK

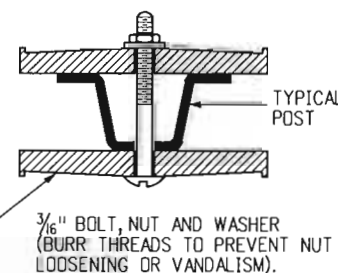

TYPICAL DELINEATOR FABRICATION DETAILS

GENERAL NOTES

- SEE THE TABULATION OF QUANTITIES INCLUDED IN THE PLANS FOR THE NUMBERS AND LOCATIONS OF DELINEATORS REQUIRED.
- THE COLOR OF DELINEATORS SHALL, IN ALL CASES, CONFORM TO THE COLOR OF EDGE LINES, EXCEPT:
A. RED, GREEN AND BLUE DELINEATORS
B. TYPE III DELINEATORS (3 YELLOW).
- THE COLOR OF DELINEATOR POSTS AND ALL SPECIAL MOUNTING BRACKETS SHALL BE INTERSTATE GREEN.
- DELINEATORS ARE MANDATORY ON ALL ROADWAYS ON THE STATE HIGHWAY SYSTEM. THEY ARE OPTIONAL WHERE FIXED SOURCE LIGHTING IS IN OPERATION; HOWEVER, ALL CONCRETE BARRIER AND TYPE 3 GUARDRAIL SHALL HAVE REFLECTORS OR SUPPLEMENTAL TABS.
- TYPE I (YELLOW) DELINEATORS ARE MANDATORY ON THE LEFT SIDE OF EXPRESSWAY ROADWAYS (MEDIAN).
- RED DELINEATORS MAY BE INSTALLED ON THE REVERSE SIDE OF ANY DELINEATOR AND/OR A SEPARATE POST ON ONE-WAY ROADWAYS OR RAMP WHERE INVESTIGATION SHOWS A NEED FOR WRONG-WAY MOVEMENT PROTECTION.
- TYPE III (3-YELLOW) DELINEATORS ARE TO BE INSTALLED TO WARN OF THE EXISTENCE OF OBJECTS NOT ACTUALLY IN THE ROADWAY BUT THAT MAY BE SO CLOSE TO THE EDGE OF THE ROADWAY THAT THEY NEED A MARKER. THESE INCLUDE UNDERPASS PIERS, BRIDGE ABUTMENTS, HANDRAILS, AND CULVERTS HEADS. THE INSIDE EDGE OF THE MARKER SHALL BE IN LINE WITH THE INNER EDGE OF THE OBSTRUCTION.
- INTERCHANGE RAMP SHALL BE DELINEATED ON THE RIGHT SIDE, THE LEFT SIDE, OR BOTH SIDES WITH TYPE I DELINEATORS OF THE APPROPRIATE COLOR (CRYSTAL OR YELLOW) AS ILLUSTRATED ON SHEET NUMBER 3.
- FRONTAGE ROAD DELINEATORS ARE NOT TO BE INSTALLED WHERE THEY MIGHT BE MISLEADING TO MAINLINE TRAFFIC.
- SPACING OF DELINEATORS FOR TUNNELS AND SNOW SHEDS SHALL BE AS SHOWN ON THE PLANS.
- WHERE PRACTICABLE THE APPROACH ENDS OF ISLANDS AND MEDIANS SHOULD BE DELINEATED.
- NORMAL SPACING WILL BE 528 FEET FOR TANGENT SECTIONS AND A 200 FOOT MINIMUM WILL APPLY TO A "LAST SPACE". (MAXIMUM SPACING IS ALSO 528 FEET.) AT ALL OTHER LOCATIONS, SUCH AS A & D LANES, RAMPS, WIDTH TRANSITIONS AND TURN LANES A "LAST SPACE" SHOULD NOT BE LESS THAN 50% OF THE SPACING SHOWN FOR THAT LOCATION.
- TYPE II DELINEATORS SHALL BE INSTALLED AT 100 FOOT SPACING ON ALL ACCELERATION LANES AND TAPERS, DECELERATION LANES AND TAPERS, AND LANE TRANSITIONS INVOLVING PAVEMENT WIDTH REDUCTIONS IN THE DIRECTION OF TRAFFIC. TYPE II DELINEATORS ARE NOT REQUIRED FOR REDIRECT TAPERS, FOR TRAFFIC MOVING IN THE DIRECTION OF WIDER PAVEMENT OR ON THE SIDE OF THE ROADWAY WHERE THE ALIGNMENT IS NOT AFFECTED BY THE LANE REDUCTION. TYPE II (YELLOW) DELINEATORS SHALL ONLY BE USED WHEN A RAISED OR DEPRESSED MEDIAN IS PRESENT. FOR WIDTH TRANSITIONS WHERE TRAFFIC MOVES IN THE DIRECTION OF WIDER PAVEMENT, THE NORMAL SPACING SHALL BE ADJUSTED SO THERE IS A DELINEATOR AT EACH OF THE ANGLE POINTS OF THE WIDTH TRANSITION.
- TYPE I DELINEATORS SHALL BE INSTALLED AT 100 FOOT SPACING ON INTERCHANGE RAMP TANGENT SECTION AND BY THE SPACING TABLE ON RAMP CURVES. SPACING "IN ADVANCE OF AND BEYOND CURVE" DOES NOT APPLY TO RAMP CURVES.
- FOR SPACING ON A CURVE THAT FOLLOWS A TANGENT SECTION WITH SPACES SHORTER THAN THOSE SHOWN IN THE CURVE SPACING TABLE: MODIFY THE TABLE SO THAT THE CURVE SPACING IS NO GREATER THAN THE TANGENT SPACING,
- WHERE GUARDRAIL INTRUDES INTO THE SPACE BETWEEN THE PAVEMENT EDGE AND THE LINE OF DELINEATORS, PLACE THE DELINEATORS IMMEDIATELY ABOVE OR BEHIND THE RAIL FACE, AND DELINEATOR SPACING SHALL BE THE SAME BEHIND THE RAIL FACE.
- WHEN NORMAL SPACING FALLS ON AN INTERSECTING ROADWAY, DRIVEWAY, ETC. THE DELINEATOR MAY BE MOVED EITHER DIRECTION A DISTANCE NOT EXCEEDING ONE-QUARTER OF THE NORMAL SPACING.
- THE ANGULAR PLACEMENT FOR ALL DELINEATORS SHOULD BE BY THE "TRAFFIC ORIENTING" METHOD: AIM THE FACE OF THE DELINEATOR AT THE CENTERLINE OF THE NEAREST LANE OF APPROACHING TRAFFIC AT A POINT 300 FEET AWAY (OR AS DIRECTED BY THE ENGINEER FOR SPECIAL OR LOCATIONS AND CURVES HAVING A DEGREE OF CURVATURE GREATER THAN 6 DEGREES).

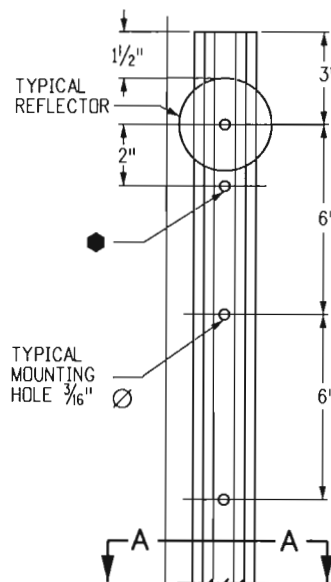


TYPICAL 1,12# DELINEATOR POST

ALLOWABLE TOLERANCE DIMENSION:


1" AND UP	± 1/8"
1/2" TO 1"	± 1/16"
1/2" AND BELOW	± 1/32"

WEIGHT:

MINUS 3/2% OF THE WEIGHT OF ANY ONE POST.

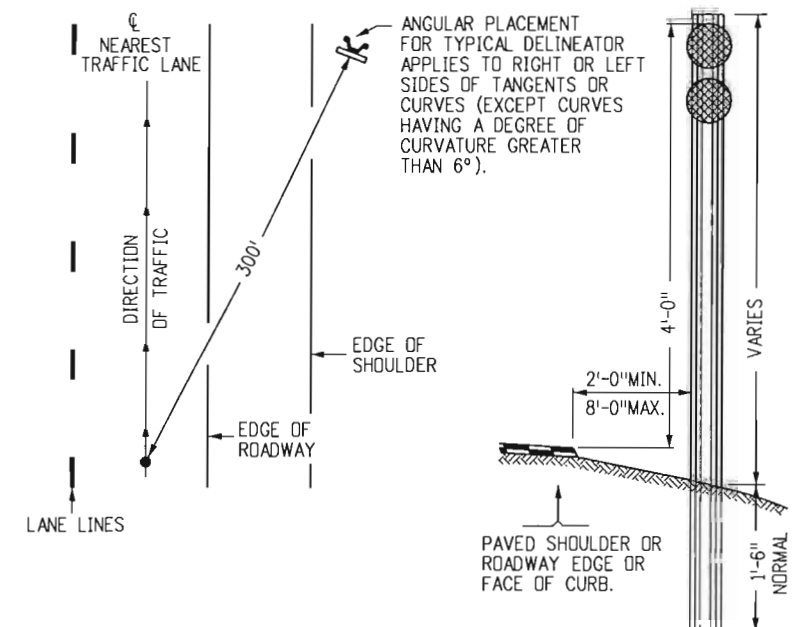

TYPICAL DELINEATOR PLACEMENT

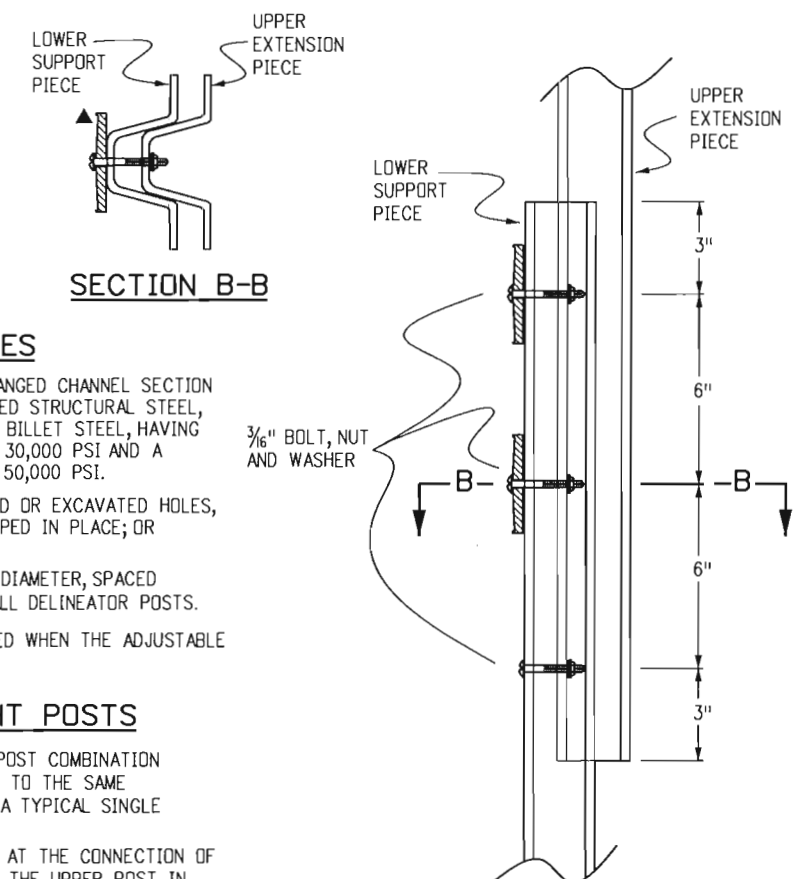

TYPICAL DOUBLE HEIGHT INSTALLATION

POST NOTES

- POSTS SHALL BE A UNIFORM FLANGED CHANNEL SECTION (U-SHAPE) MADE FROM HOT ROLLED STRUCTURAL STEEL, RE-ROLLED RAIL STEEL, OR NEW BILLET STEEL, HAVING A MINIMUM YIELD STRENGTH OF 30,000 PSI AND A MINIMUM TENSILE STRENGTH OF 50,000 PSI.
- POSTS SHALL BE SET IN DRILLED OR EXCAVATED HOLES, PLACED PLUMB AND FIRMLY TAMPED IN PLACE; OR MAY BE DRIVEN PLUMB.
- A MINIMUM OF 3 HOLES OF 3/16" DIAMETER, SPACED AS SHOWN, ARE REQUIRED FOR ALL DELINEATOR POSTS.
- AN ADDITIONAL HOLE IS REQUIRED WHEN THE ADJUSTABLE REFLECTOR BRACKET IS USED.

DOUBLE HEIGHT POSTS

- THE LOWER SECTION OF THE 2-POST COMBINATION SHALL BE INSTALLED ACCORDING TO THE SAME PLACEMENT SPECIFICATIONS AS A TYPICAL SINGLE POST INSTALLATION.
- REFLECTORS SHALL BE MOUNTED AT THE CONNECTION OF THE POSTS AND AT THE TOP OF THE UPPER POST IN ACCORDANCE WITH THE APPROPRIATE CONFIGURATION FOR THE APPLICATION.
- THE LENGTH OF THE UPPER EXTENSION PIECE SHALL NOT EXCEED 7 FEET.

Computer File Information

Creation Date: 07/04/06	Initials: KCM
Last Modification Date: 07/04/06	Initials: JSW
Full Path: www.dot.state.co.us/DesignSupport/	
Drawing File Name: Sheet_S-612-01_1of5.dgn	
CAD Ver.: MicroStation V8	Scale: Not to Scale Units: English

(R-1)
(R-2)
(R-X)
(R-X)

Sheet Revisions

Date:	Comments
08/19/09	REVISED SHEET 2
07/01/10	ADDED NEW SHEET 5 AND CONVERTED OLD SHEET 5 TO SHEET 6

Colorado Department of Transportation



4201 East Arkansas Avenue
Denver, Colorado 80222
Phone: (303) 757-9543
Fax: (303) 757-9458

Safety & Traffic Engineering Branch

KCM/JSW


DELINEATOR INSTALLATIONS

Issued By: Safety & Traffic Engineering Branch July 4, 2006


STANDARD PLAN NO.

S-612-1


Sheet No. 1 of 6

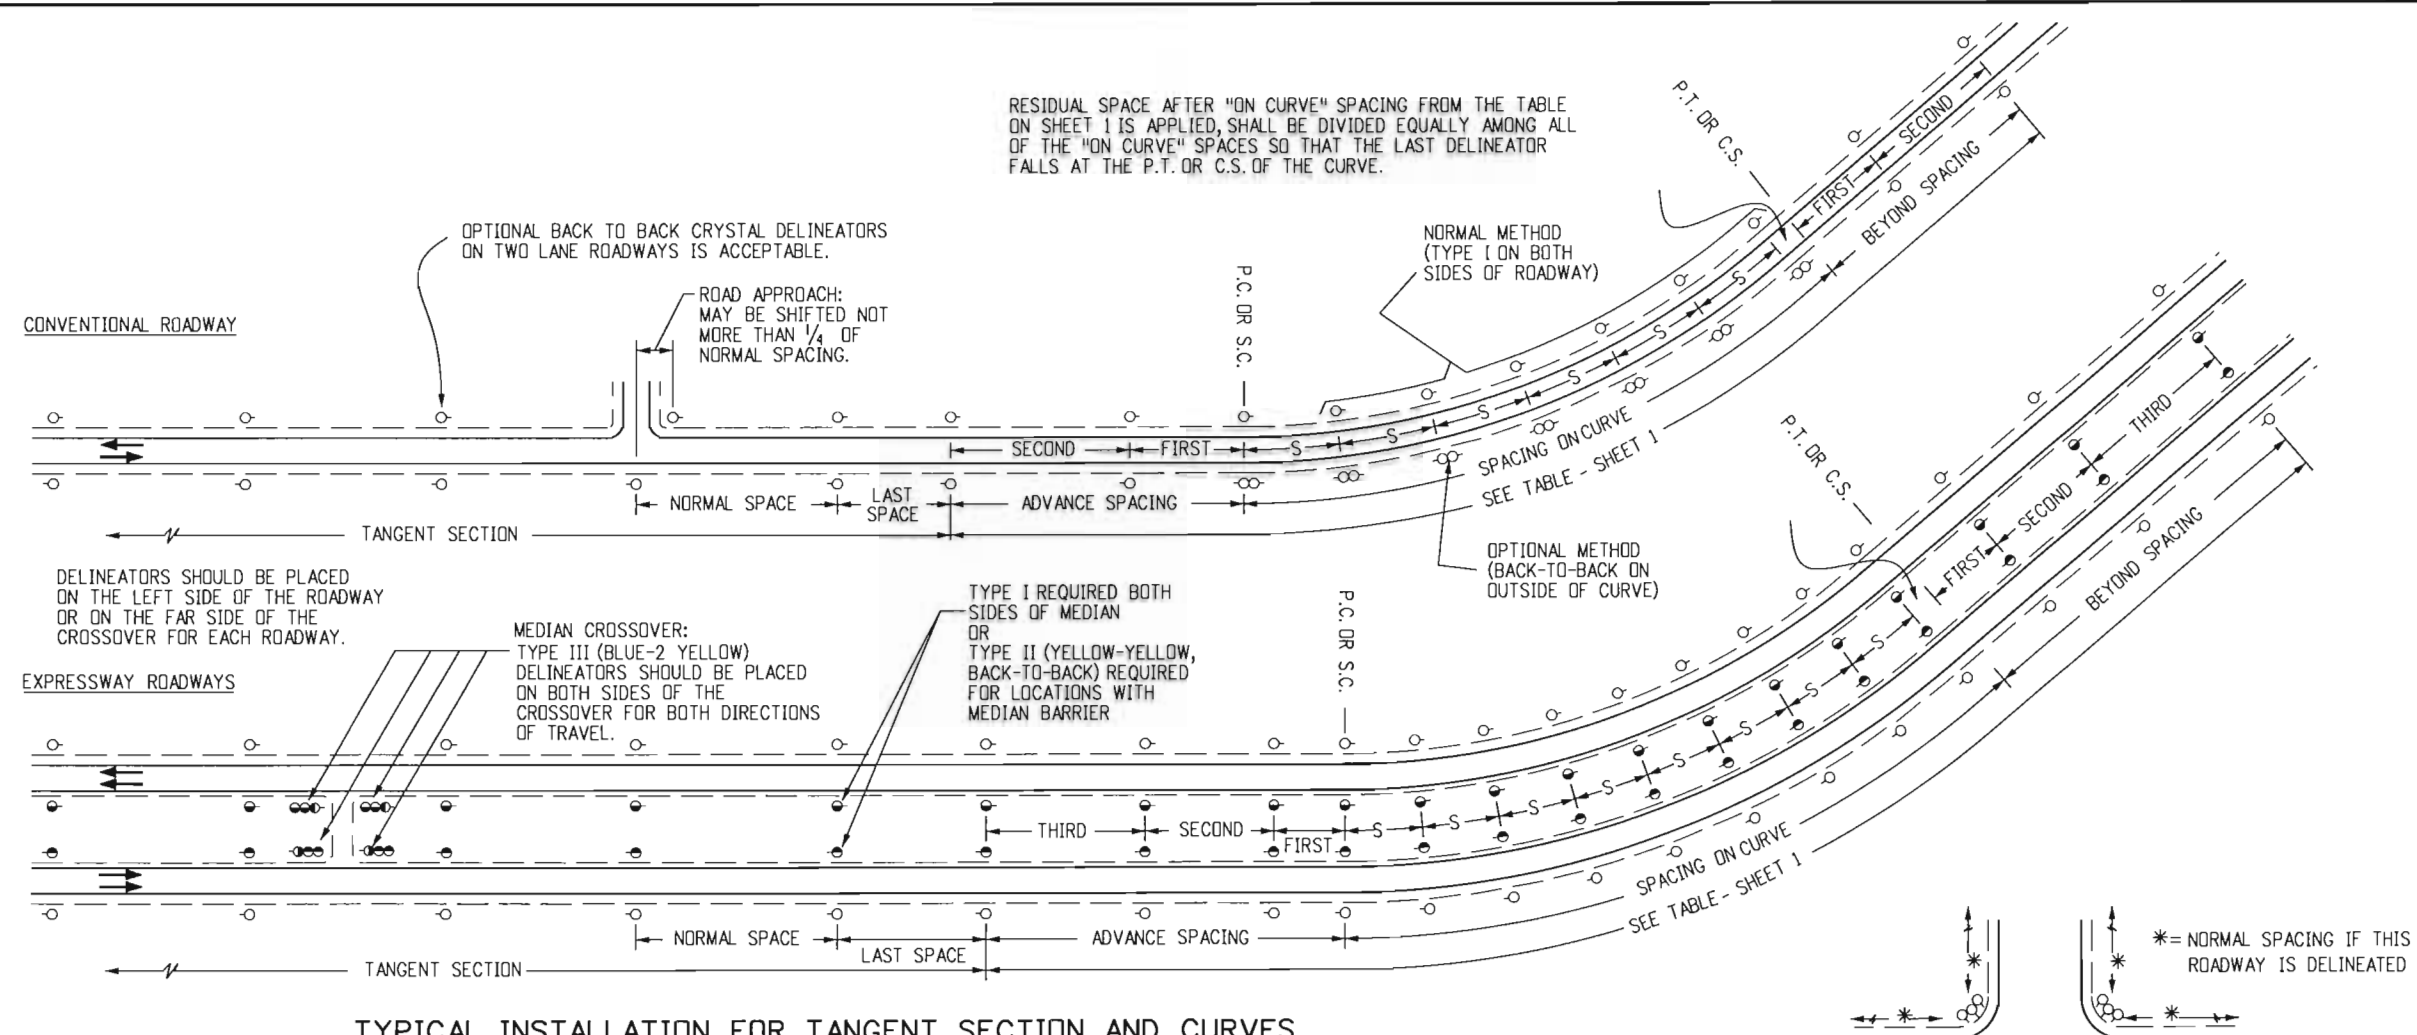

TYPICAL INSTALLATION FOR TANGENT SECTION AND CURVES

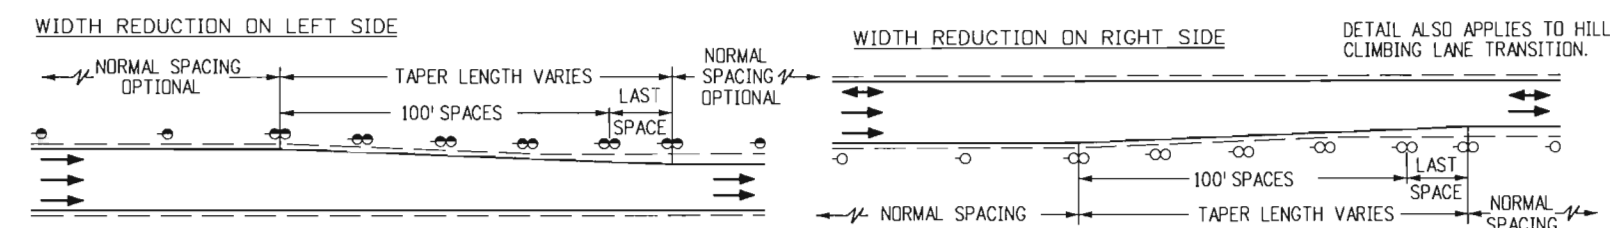


TYPICAL INSTALLATION FOR LANE TRANSITION

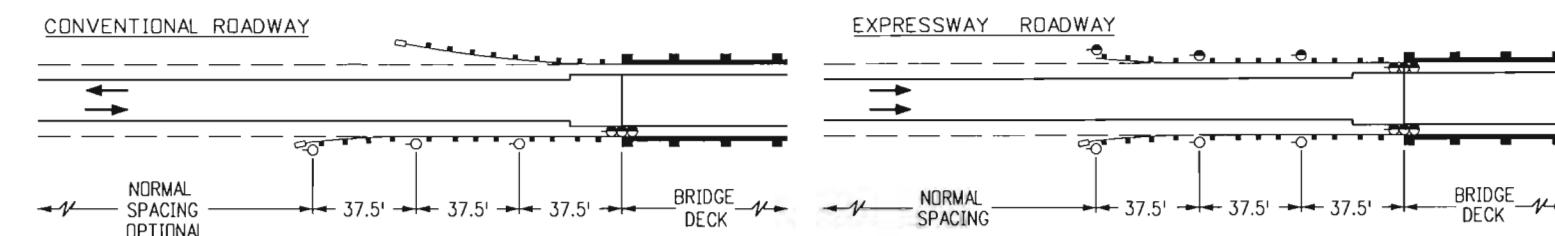

TYPICAL INSTALLATION FOR BRIDGE APPROACHES

DELINEATOR SYMBOLS AND TYPICAL CONFIGURATION

- TYPE I (CRYSTAL)
- TYPE I (YELLOW)
- TYPE I (RED)
- TYPE I (GREEN) (MAINTENANCE MARKER)
- TYPE I (BLUE) (MAINTENANCE MARKER)
- TYPE II (2 CRYSTAL)
- TYPE II (2 YELLOW)
- TYPE II (CRYSTAL-CRYSTAL BACK-TO-BACK)
- TYPE II (YELLOW-YELLOW, BACK-TO-BACK)
- TYPE II (CRYSTAL-RED, BACK-TO-BACK)
- TYPE II (YELLOW-RED, BACK-TO-BACK)
- TYPE III (3 YELLOW)
- TYPE III (2 CRYSTAL-RED, BACK-TO-BACK)
- TYPE III (2 YELLOW-RED, BACK-TO-BACK)
- TYPE III (GREEN)
- TYPE III (BLUE)
- TYPE III (BLUE-2 YELLOW)

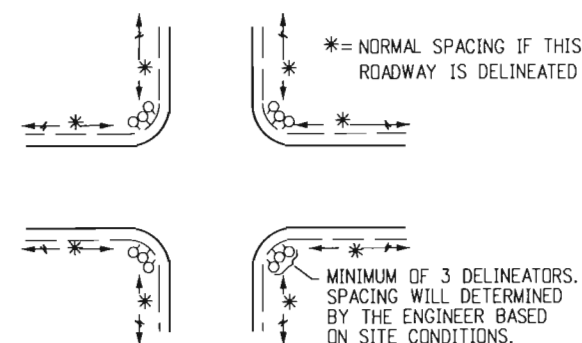


TYPICAL INSTALLATION FOR MINOR INTERSECTION


BRIDGE NOTES

1. WHERE CURB TO CURB WIDTH OF BRIDGE IS EQUAL TO OR GREATER THAN ROADWAY WIDTH PLUS USABLE SHOULDER WIDTH, USE THE TYPE III DELINEATOR (3 YELLOW) ONLY AND OMIT ALL THE TYPE I DELINEATORS.
2. FOR GUARD RAIL INSTALLATIONS WHERE APPROACH END IS NOT FLARED, PLACE A TYPE III DELINEATOR (3 YELLOW) IMMEDIATELY IN ADVANCE OF APPROACH END.
3. ALL TYPE I DELINEATORS ARE TO BE MOUNTED ABOVE OR IMMEDIATELY BEHIND GUARD RAIL AND ARE NOT A CONSTANT DISTANCE FROM THE ROADWAY.


Computer File Information		Sheet Revisions		Colorado Department of Transportation		DELINEATOR INSTALLATIONS		STANDARD PLAN NO.	
Creation Date: 07/04/06	Initials: KCM	<div><div>(R=)</div><div>(R-X)</div><div>(R-X)</div><div>(R-X)</div></div>	Date:	Comments	<div><div></div><div>4201 East Arkansas Avenue Denver, Colorado 80222 Phone: (303) 757-9543 Fax: (303) 757-9458</div></div>	Issued By: Safety & Traffic Engineering Branch July 4, 2006		S-612-1	
Last Modification Date: 08/19/09	Initials: KEN		08/19/09	CHANGED TYPE I DELINEATORS TO TYPE I (YELLOW) ALONG LEFT SHOULDER OF EACH DETAIL.					
Full Path: www.dot.state.co.us/DesignSupport/									
Drawing File Name: Sheet_S-612-01_2of5.dgn									
CAD Ver.: MicroStation V8	Scale: Not to Scale		Units: English						
				Safety & Traffic Engineering Branch KCM/KEN				Sheet No. 2 of 6	

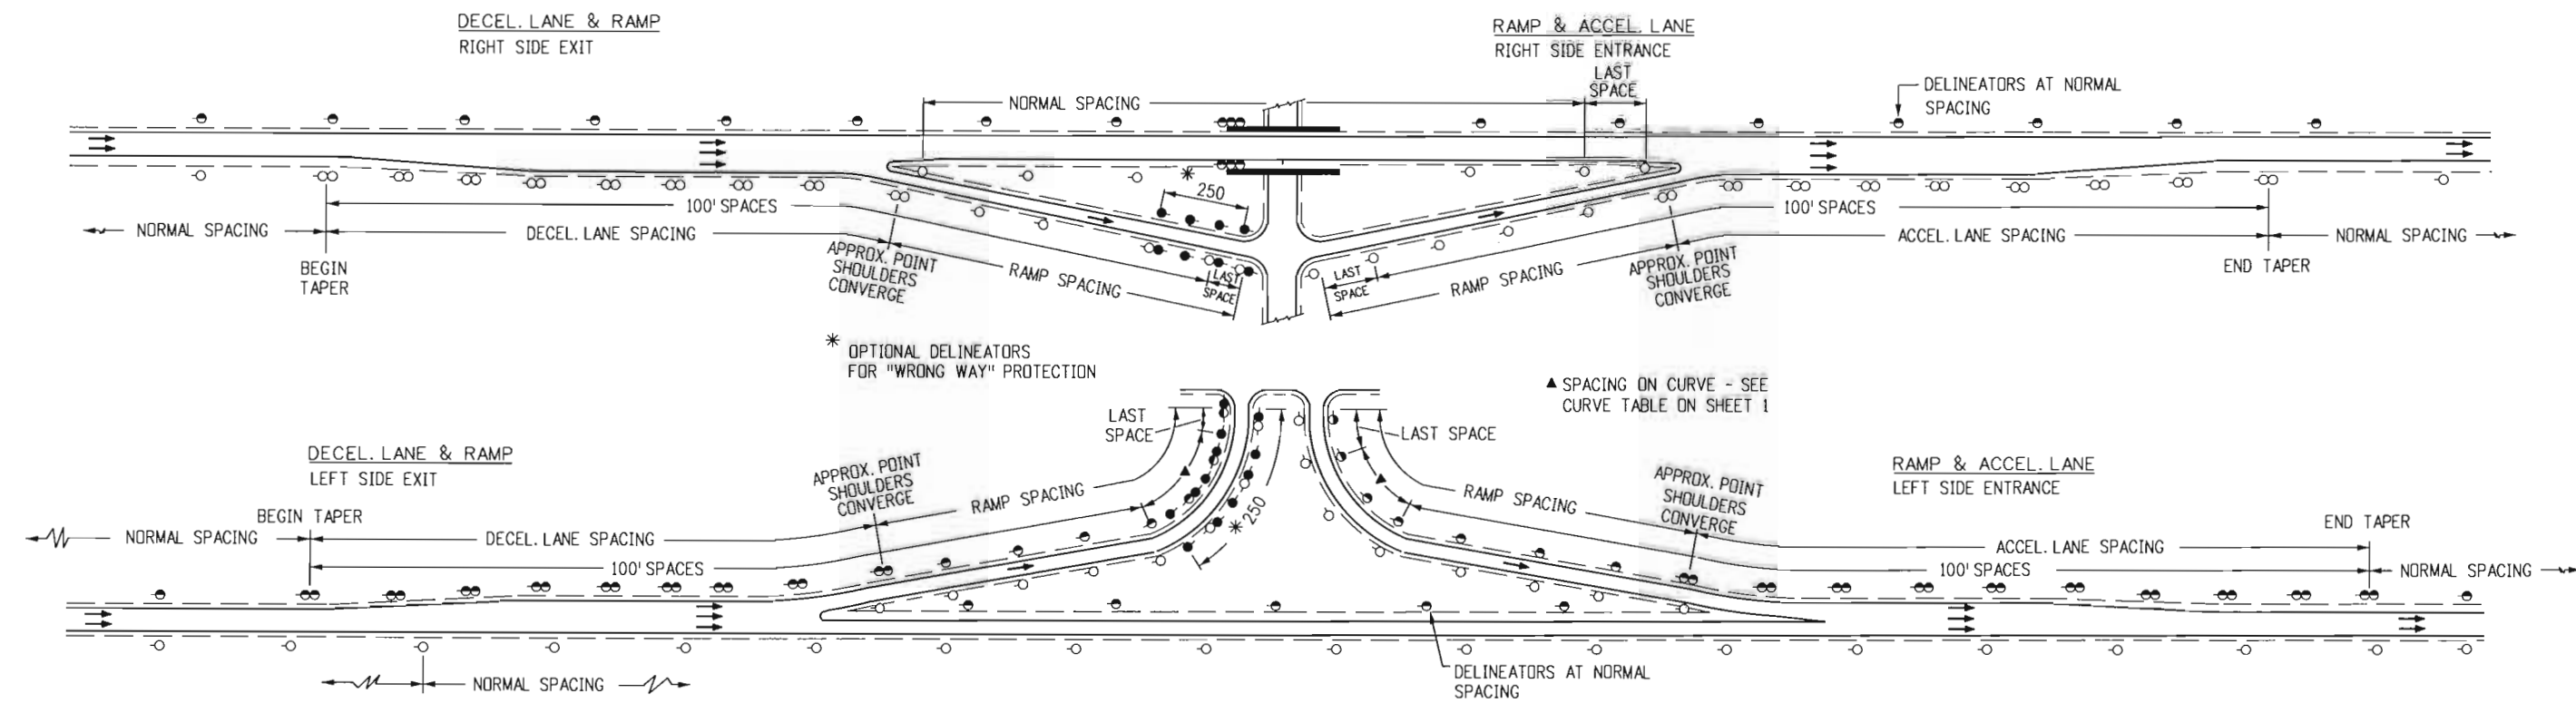


TYPICAL INSTALLATION FOR INTERCHANGES

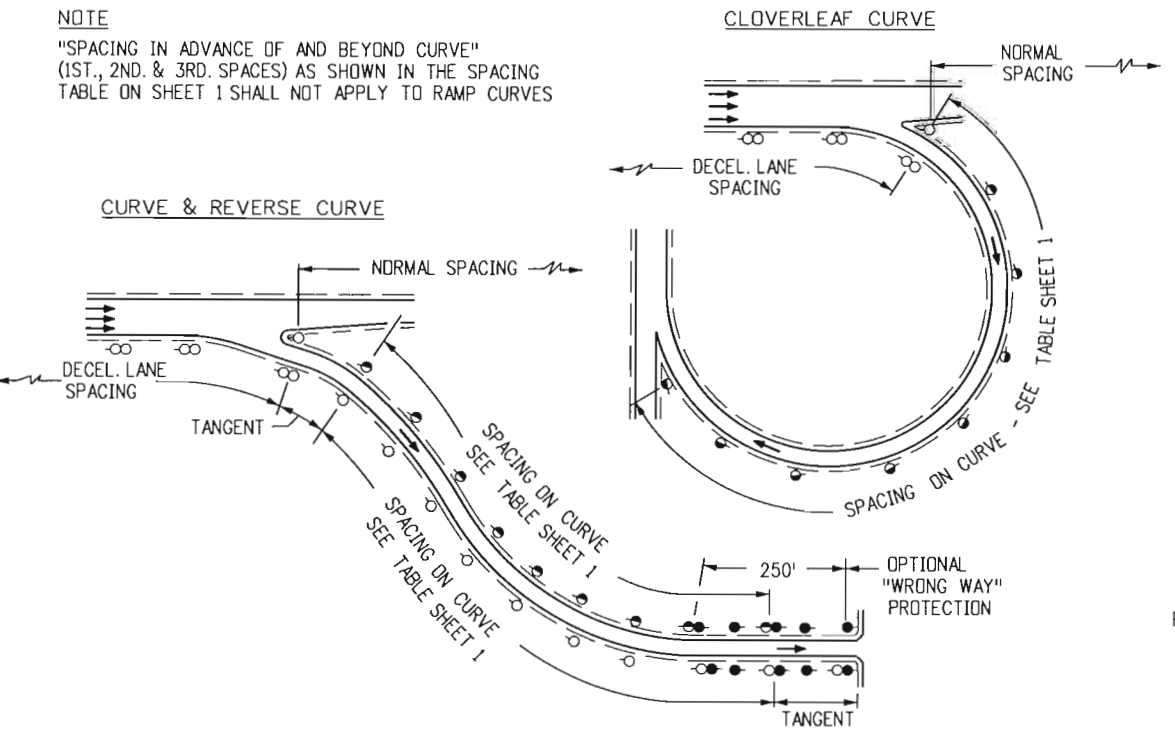

TYPICAL INSTALLATION FOR RAMP CURVES

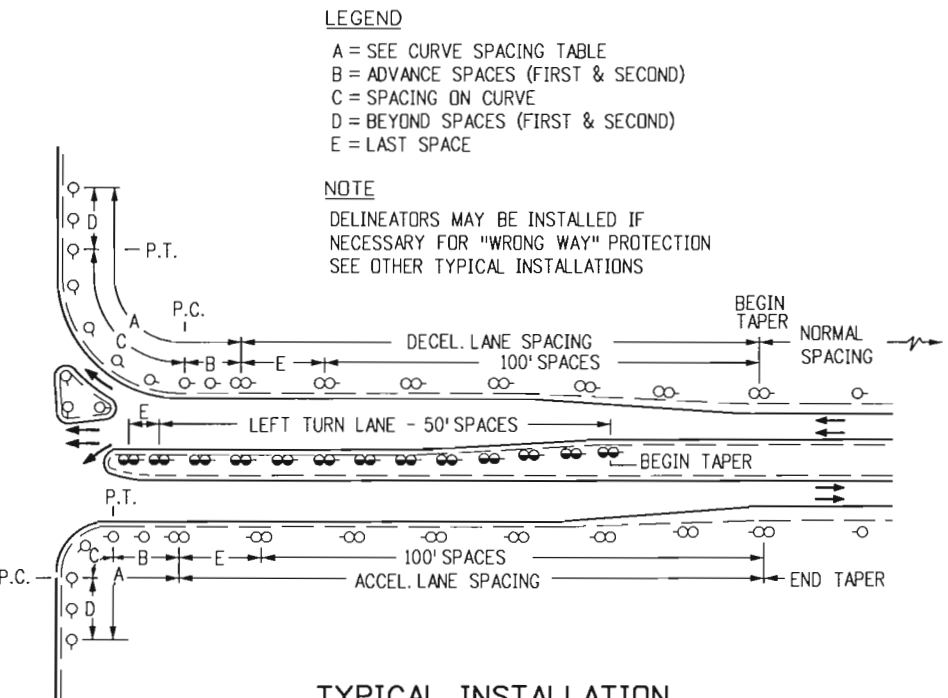


TYPICAL INSTALLATION FOR INTERSECTIONS WITH ACCEL. & DECEL. LANES

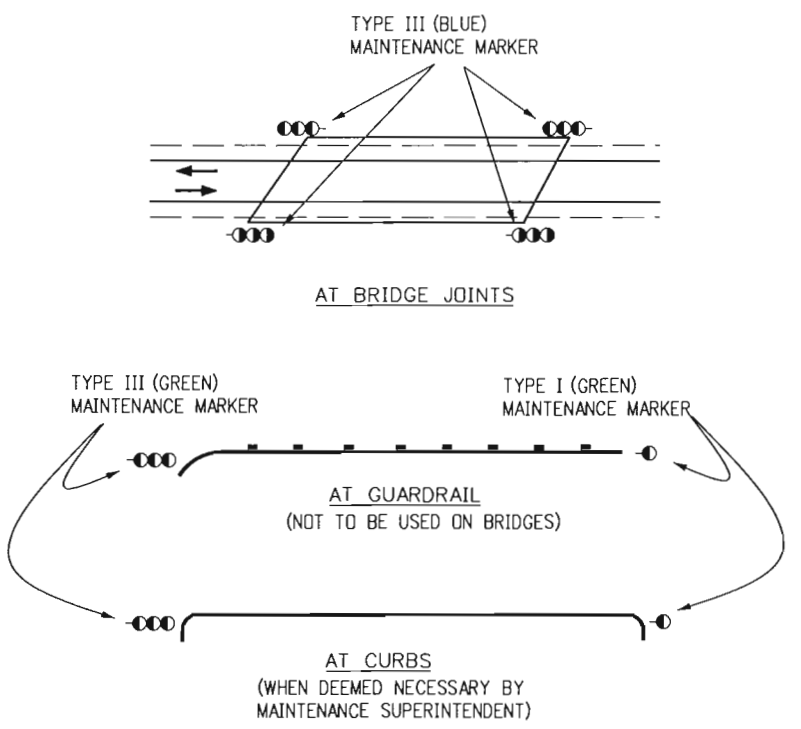


MAINTENANCE MARKER LOCATIONS FOR OBSTRUCTIONS

Computer File Information		<div><div></div><div></div><div></div><div></div><div></div></div>	Sheet Revisions		<div><div><div><div></div><div></div></div><div>DOT</div><div>DEPARTMENT OF TRANSPORTATION</div></div><div><div>Colorado Department of Transportation</div><div>4201 East Arkansas Avenue Denver, Colorado 80222 Phone: (303) 757-9543 Fax: (303) 757-9458</div><div>Safety & Traffic Engineering Branch</div><div>KCM/JSW</div></div></div>	DELINEATOR INSTALLATIONS		STANDARD PLAN NO.
Creation Date: 07/04/06	Initials: KCM		Date:	Comments		S-612-1		
Last Modification Date: 07/04/06	Initials: JSW							
Full Path: www.dot.state.co.us/DesignSupport/								
Drawing File Name: Sheet_S-612-01_3of5.dgn								
CAD Ver.: MicroStation V8 Scale: Not to Scale Units: English						Issued By: Safety & Traffic Engineering Branch July 04, 2006		Sheet No. 3 of 6

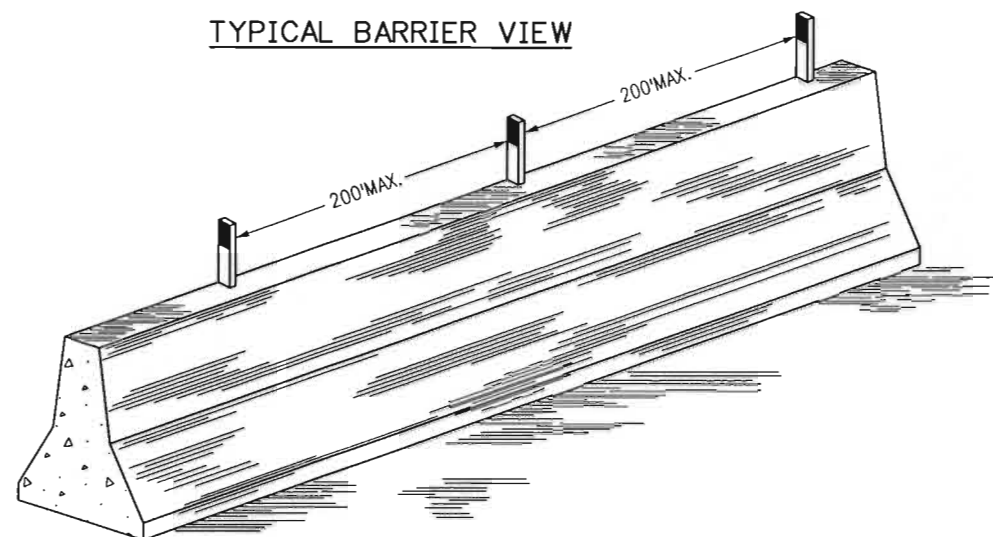


TYPICAL REFLECTOR DETAILS FOR CONCRETE BARRIER

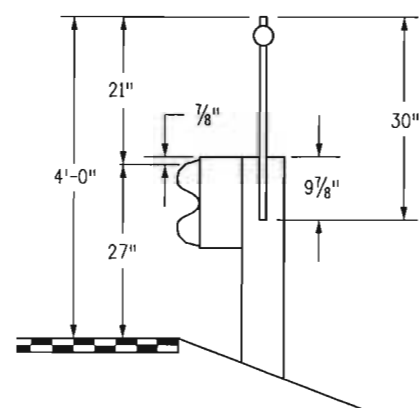


TYPICAL GUARDRAIL POST MOUNT DELINEATORS


POST MOUNT DELINEATORS SHALL BE ATTACHED BY A METHOD APPROVED BY THE ENGINEER OR A METHOD REQUIRED BY THE DEVICE MANUFACTURER.

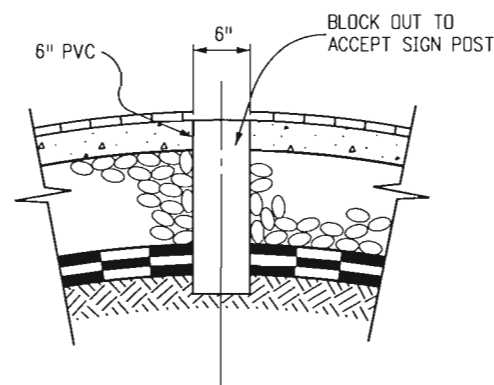

TYPICAL SLEEVE INSTALLATION FOR MEDIAN DELINEATOR POSTS

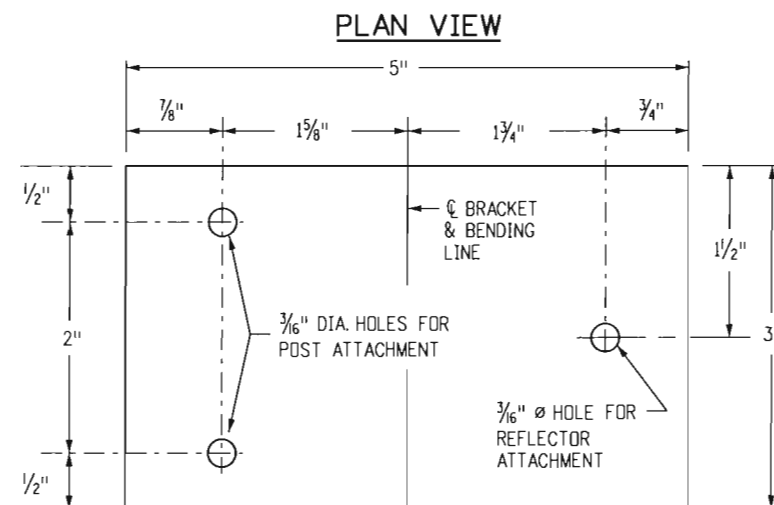


TYPICAL ADJUSTABLE REFLECTOR BRACKET

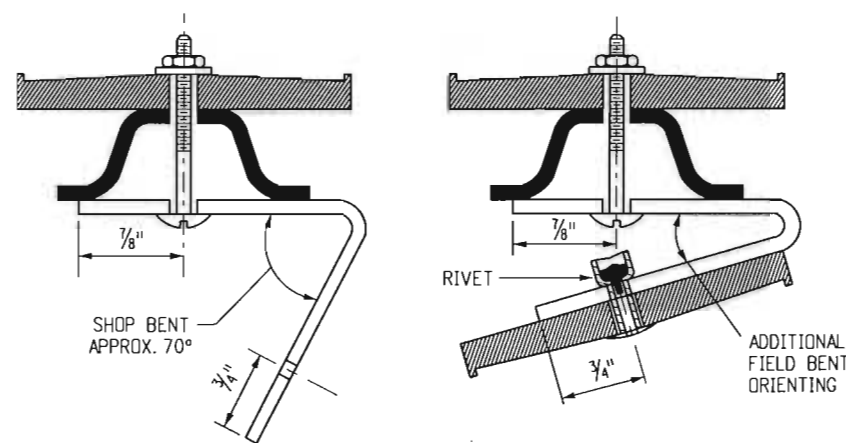


TYPICAL BRACKET FABRICATION DETAILS

BRACKET NOTES

1. THE ADJUSTABLE REFLECTOR BRACKET IS TO BE USED TO "TRAFFIC ORIENT" BACK-TO-BACK DELINEATORS USED ON CURVES.
2. REFLECTOR BRACKETS SHALL BE FABRICATED FROM EITHER GALVANIZED STEEL NOT LESS THAN 16 GAGE, OR ALUMINUM NOT LESS THAN 0.100 INCH THICKNESS.
3. BOLTS, NUTS AND WASHERS SHALL BE GALVANIZED OR CADMIUM PLATED.
4. ALL BRACKET HOLES ARE 3/16 IN. DIAMETER AND DELINEATOR POSTS REQUIRE AN ADDITIONAL HOLE 2 IN. BELOW THE TOP HOLE PROVIDED IN THE POST.
5. SHOP BEND THE BRACKET APPROX. 70 DEGREES AS SHOWN, ATTACH TO THE DELINEATOR POST WITH 3/16 IN. BOLTS AND FIELD BEND AS NECESSARY TO TRAFFIC ORIENT. THEN THE BRACKET REFLECTOR CAN BE ATTACHED WITH A 3/16 IN. BLIND EXPANSION RIVET OR A BOLT.
6. BURR THE THREADS OF ALL BOLTS TO PREVENT NUT LOOSENING OR VANDALISM.

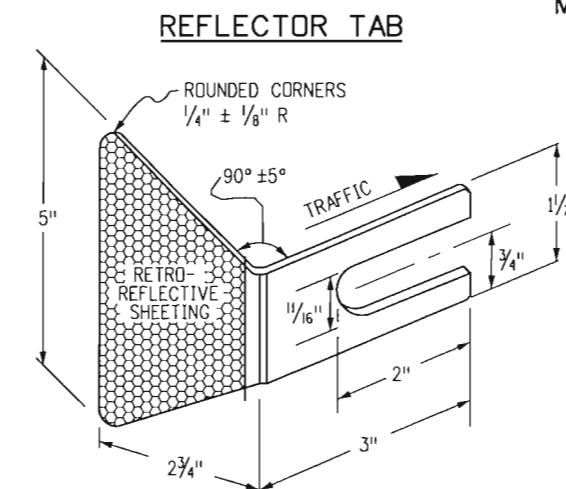

MOUNTING POSITION ON GUARD RAIL TYPE 3

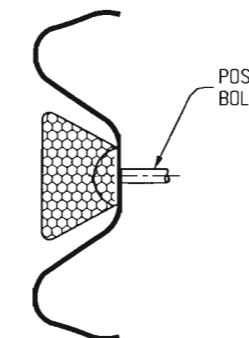

TYPICAL GUARDRAIL REFLECTOR TAB


SEE THE APPROPRIATE GUARDRAIL STANDARD PLANS FOR REFLECTOR TAB FABRICATION AND PLACEMENT DETAILS.

BARRIER REFLECTOR NOTES




1. BARRIER REFLECTORS, REGARDLESS OF TYPE, SHALL MEET THE RETROREFLECTIVE QUALITIES SPECIFIED IN SECTION 713 OF THE STANDARD SPECIFICATIONS FOR DELINEATOR REFLECTORS, AND BE PAID FOR AS DELINEATOR (TYPE ...) (BARRIER) (EACH). USE OF THESE REFLECTORS IS MANDATORY.
2. THE COLOR OF REFLECTIVE SURFACE SHALL MATCH THE COLOR OF THE ADJACENT EDGE LINE.
3. CONCRETE SURFACE PREPARATION, ADHESIVE, AND METHOD OF APPLICATION SHALL BE AS RECOMMENDED BY THE REFLECTOR MANUFACTURER.
4. UNLESS OTHERWISE NOTED IN THE PLANS OR DIRECTED BY THE ENGINEER, A 200 FOOT MAXIMUM TANGENT AND CURVE SPACING APPLIES TO BARRIER REFLECTORS.
5. TOP MOUNT REFLECTORS ARE STANDARD. SIDEMOUNT BARRIER REFLECTORS OR 6 INCH WIDE REFLECTOR STRIPS MAY BE REQUIRED IF SPECIFIED IN THE PLANS.
6. MEDIAN BARRIER REFLECTORS SHALL BE TYPE II (YELLOW-YELLOW, BACK-TO-BACK).
7. FOR A TWO-WAY ROADWAY BARRIER, REFLECTORS SHALL BE TYPE II (CRYSTAL-CRYSTAL, BACK-TO-BACK).
8. FOR TEMPORARY CONCRETE BARRIER, REFLECTORS SHALL BE INSTALLED THAT MEET THE MINIMUM REQUIREMENTS OF STANDARD TYPICAL DELINEATOR INSTALLATIONS, EXCEPT THE MAXIMUM SPACING SHALL BE 50 FT., AND THEY WILL NOT BE PAID FOR, BUT ARE INCLUDED IN THE WORK.

Computer File Information		Sheet Revisions		<div>Colorado Department of Transportation</div> <div> 4201 East Arkansas Avenue Denver, Colorado 80222 Phone: (303) 757-9543 Fax: (303) 757-9458 </div> <div>Safety & Traffic Engineering Branch KCM/KEN</div>	DELINEATOR INSTALLATIONS		STANDARD PLAN NO.
Creation Date: 07/04/06	Initials: KCM	Date:	Comments:				S-612-1
Last Modification Date:	Initials:						
Full Path: www.dot.state.co.us/DesignSupport/							Sheet No. 4 of 6
Drawing File Name: Sheet_S-612-01_4of5.dgn					Issued By: Safety & Traffic Engineering Branch July 04, 2006		
CAD Ver.: MicroStation V8 Scale: Not to Scale Units: English							

TYPICAL INSTALLATION DETAIL FOR CONCRETE BARRIERS

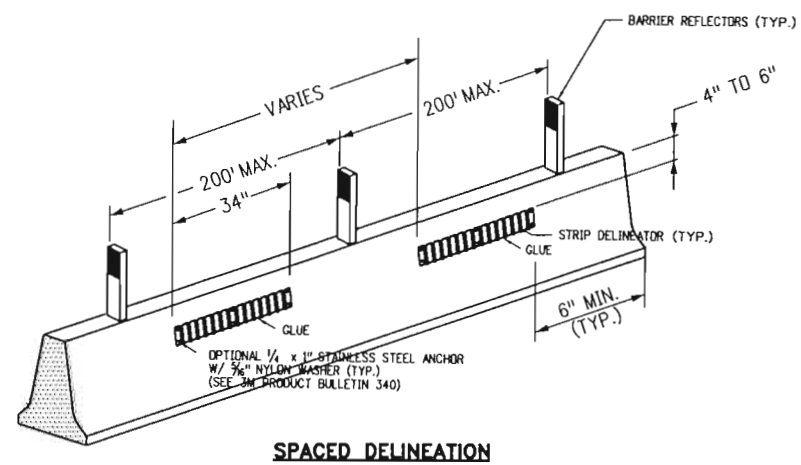

TYPICAL INSTALLATION DETAIL FOR GUARDRAIL TYPE 3

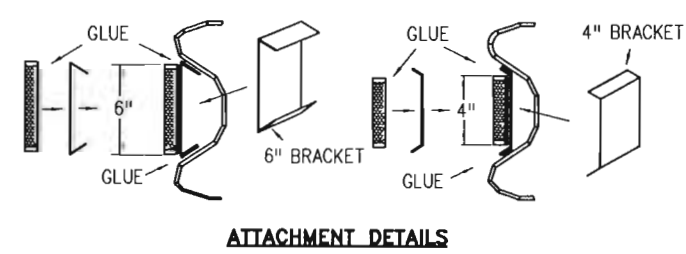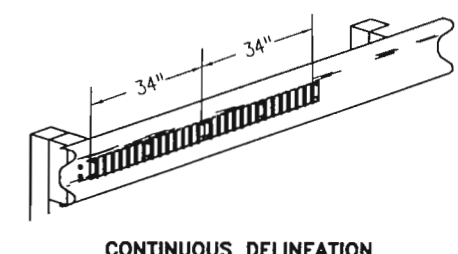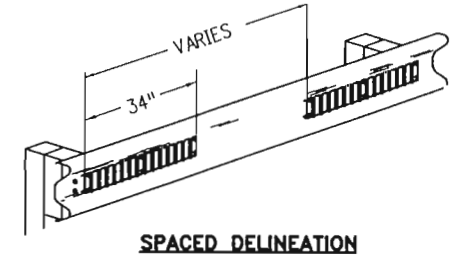

TYPICAL STRIP DELINEATOR INSTALLATION

1. THIS DEVICE SHALL BE INSTALLED PER MANUFACTURER'S RECOMMENDATIONS. IT IS THE RESPONSIBILITY OF THE INSTALLER TO CONTACT THE MANUFACTURER REPRESENTATIVE WHENEVER THERE IS A QUESTION REGARDING APPLICATION PROCEDURES OR SUBSTRATE CONDITIONS.
2. THE COLOR OF THE REFLECTIVE SURFACE SHALL MATCH THE COLOR OF THE ADJACENT ROADWAY EDGE LINE.
3. AT TIME OF INSTALLATION, CONTACTING SURFACE SHALL BE DRY AND MOISTURE-FREE.
4. AFTER DELINEATOR INSTALLATION, SURFACES SHOULD STAY DRY WITHOUT RAIN IN THE FORECAST FOR AT LEAST 8 HOURS.
5. SURFACE PREPARATION, BRACKETS AND GLUE (OR EQUIVALENT) SHALL BE INCLUDED IN THE COST OF EACH DELINEATOR STRIP.


CONCRETE BARRIER REFLECTOR NOTES

1. CONCRETE SURFACE PREPARATION, ADHESIVE, AND METHOD OF APPLICATION SHALL BE AS RECOMMENDED BY THE REFLECTOR MANUFACTURER.
2. TO ASSURE A STRAIGHT LEVEL APPLICATION, SNAP A CHALK LINE ACROSS THE BARRIER.
3. FOR MOUNTING THE STRIP DELINEATORS TO CONCRETE BARRIER, INCLUDING THE BRACKETS, USE 3M WINDO-WELD SUPER FAST URETHANE GLUE OR EQUIVALENT APPLIED AT 60 DEGREES FAHRENHEIT IN DRY WEATHER IS RECOMMENDED. THIS PRODUCT IS AVAILABLE IN STANDARD CAULKING TUBE AND SHOULD BE APPLIED TO THE BRACKETS AND PANELS WITH A CONSTRUCTION STYLE CAULKING GUN, AND/OR USE 1/4" X 1" STAINLESS STEEL ANCHOR WITH 5/16" NYLON WASHER, AS SPECIFIED IN 3M PRODUCT BULLETIN 340.
4. UNLESS OTHERWISE NOTED IN THE PLANS OR DIRECTED BY THE ENGINEER, A 200-FOOT MAXIMUM TANGENT AND CURVE SPACING APPLIES TO BARRIER REFLECTORS ALONG THE TOP OF THE BARRIER.


W-BEAM GUARDRAIL NOTES

1. TWO DIFFERENT STYLES OF DELINEATOR MOUNTING BRACKETS ARE AVAILABLE. THERE IS ONE TYPE FOR THE 4" DELINEATOR AND ANOTHER FOR THE 6" DELINEATOR. THE BRACKETS MUST BE MATCHED TO FIT THE EXACT 4" OR 6" WIDE DELINEATOR PANELS. SIZE OF THE DELINEATOR PANELS SHALL BE SPECIFIED IN THE PLANS.
2. IN SNOWPLOW AREAS, USE THE 4" PANELS THAT WILL RECESS INTO THE W-BEAM GUARDRAIL, WHICH PROTECTS IT FROM THE SNOWPLOW DAMAGE.
3. METAL GUARDRAIL SHALL BE WIRE BRUSHED/SANDED, THEN CLEANED WITH ISOPROPYL ALCOHOL WHERE THE BRACKETS WILL ADHERE TO THE GUARDRAIL.
4. FOR MOUNTING THE STRIP DELINEATORS TO GUARDRAIL, INCLUDING THE BRACKETS, THE USE OF 3M WINDO-WELD SUPER FAST URETHANE GLUE OR EQUIVALENT APPLIED AT 60 DEGREES FAHRENHEIT IN DRY WEATHER IS RECOMMENDED. THIS PRODUCT IS AVAILABLE IN STANDARD CAULKING TUBE AND SHOULD BE APPLIED TO THE BRACKETS AND PANELS WITH A CONSTRUCTION STYLE CAULKING GUN, AS SPECIFIED IN BY 3M PRODUCT BULLETIN 340.
5. MUST USE MINIMUM THREE BRACKETS PER PANEL CORRESPONDING TO THE PRE-DRILLED DELINEATOR HOLES.


Computer File Information		Sheet Revisions		Colorado Department of Transportation  4201 East Arkansas Avenue Denver, Colorado 80222 Phone: (303) 757-9543 Fax: (303) 757-9458 Safety & Traffic Engineering Branch KCM/KEN	DELINEATOR INSTALLATIONS	STANDARD PLAN NO.
Creation Date: 06/24/10	Initials: KEN	Date: 07/01/10	Comments: NEW SHEET 5, AND MOVED OLD SHEET 5 TO SHEET 6			S-612-1
Last Modification Date:	Initials:					
Full Path: www.dot.state.co.us/DesignSupport/					Issued By: Safety & Traffic Engineering Branch July 04, 2006	Sheet No. 5 of 6
Drawing File Name: Sheet_S-612-01_5of6.dgn						
CAD Ver.: MicroStation V8	Scale: Not to Scale	Units: English				

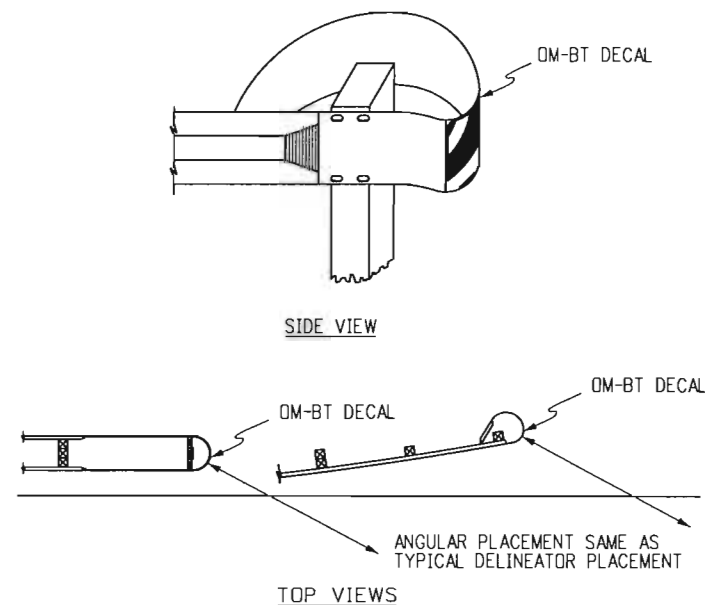


BUFFER TERMINALS (BT)

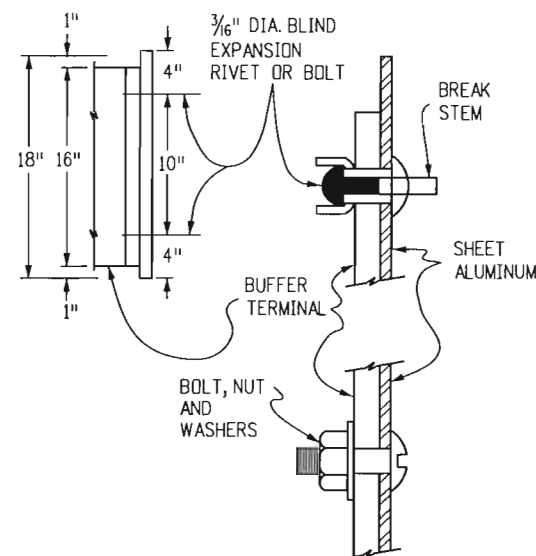


BUFFER PANEL ATTACHMENT DETAILS

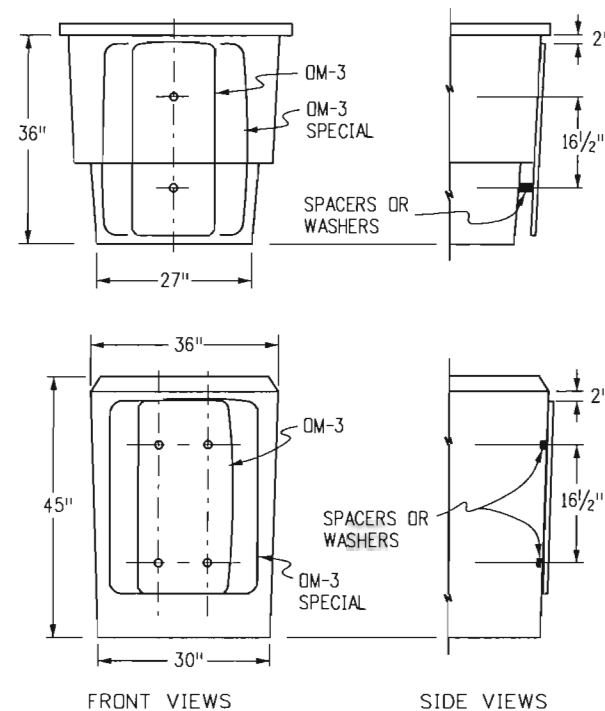


IMPACT ATTENUATOR (SAND FILLED)

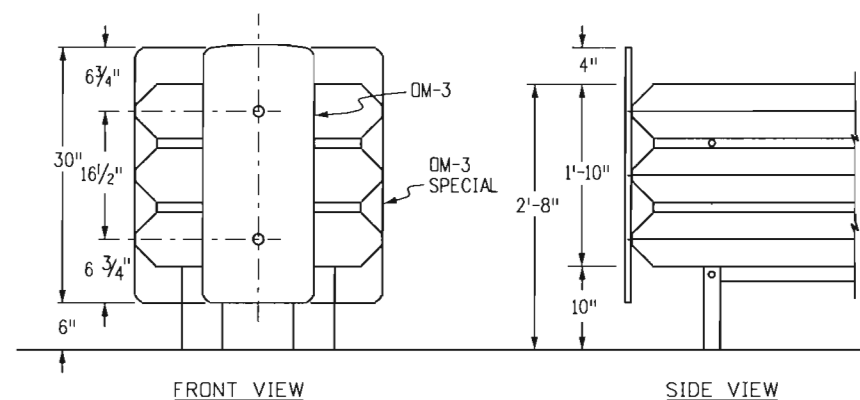

IMPACT ATTENUATOR (MODULAR)

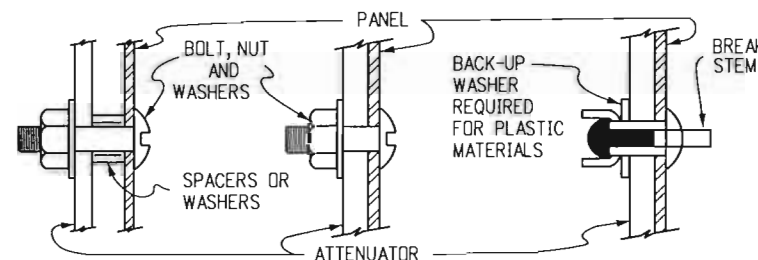

ATTENUATOR PANEL ATTACHMENT DETAILS

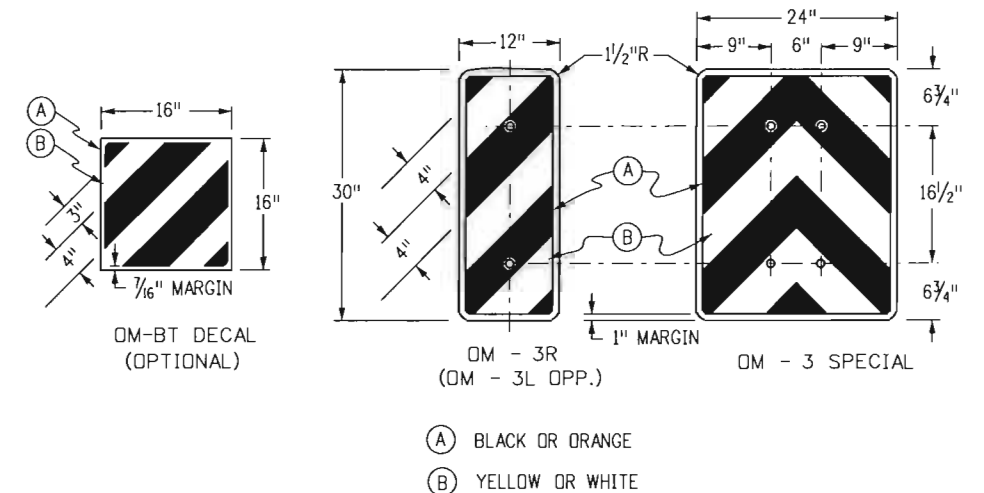

SUPPLEMENTAL DELINEATION DETAILS

SUPPLEMENTAL PANEL NOTES

- ALL SUPPLEMENTAL DELINEATION PANELS SHALL BE SINGLE SHEET ALUMINUM, 0.080" MINIMUM THICKNESS.
- A) PANELS SHALL BE FASTENED DIRECTLY TO THE IMPACT ATTENUATOR WITH 2 OR 4-3/16 IN. DIA. BLIND EXPANSION RIVETS, OR 2 OR 4-3/16 IN. BOLTS, NUTS AND WASHERS.
B) EXPANSION RIVETS SHALL BE DOMED HEAD ALUMINUM WITH ALUMINUM BREAK STEM MANDREL, AND SHALL HAVE A BACK-UP WASHER WHEN USED WITH PLASTIC MATERIALS.
C) BOLTS, NUTS AND WASHERS SHALL BE GALVANIZED OR CADMIUM PLATED.
D) SPACERS, OR SPACING WASHERS SHALL BE USED AS NECESSARY FOR SAND FILLED ATTENUATORS.
- OM-BT DECAL (BUFFER TERMINAL OBJECT MARKER) SHALL BE PRESSURE SENSITIVE REFLECTIVE SHEETING AND SHALL BE APPLIED DIRECTLY TO THE GUARDRAIL END TREATMENT (FLARED OR NON-FLARED).
- RETROREFLECTIVE SHEETING SHALL CONFORM TO ASTM D4956, TYPE III. THE SHEETING SHALL BE YELLOW FOR PERMANENT INSTALLATIONS.
OM-BT DECAL AND OM-3 PANELS SHALL HAVE YELLOW SHEETING BACKGROUND WITH STENCIL BLACK STRIPES.
THE SHEETING FOR TEMPORARY (CONSTRUCTION ZONE) INSTALLATIONS SHALL BE AS FOLLOWS:
OM-BT DECAL AND OM-3 PANELS SHALL HAVE ALTERNATING ORANGE AND WHITE REFLECTORIZED STRIPES.
- SUPPLEMENTAL DELINEATION PANELS OR PRESSURE SENSITIVE RETROREFLECTIVE SHEETING DECALS SHALL BE INCLUDED IN THE COST OF THE GUARDRAIL END ANCHOR OR THE IMPACT ATTENUATOR ITEM.

**SUPPLEMENTAL DELINEATION FOR GUARD RAIL
BUFFER TERMINALS AND IMPACT ATTENUATORS**

Computer File Information		Sheet Revisions		<div> Colorado Department of Transportation  4201 East Arkansas Avenue Denver, Colorado 80222 Phone: (303) 757-9543 Fax: (303) 757-9458 Safety & Traffic Engineering Branch KCM/KEN </div>	<div> DELINEATOR INSTALLATIONS </div>	STANDARD PLAN NO.
Creation Date: 07/04/06	Initials: KCM	Date: 07/01/10	Comments: FORMERLY SHEET 5			S-612-1
Last Modification Date: 06/24/10	Initials: KEN					
Full Path: www.dot.state.co.us/DesignSupport/						
Drawing File Name: Sheet_S-612-01_5of5.dgn						Sheet No. 6 of 6
CAD Ver.: MicroStation V8	Scale: Not to Scale	Units: English			Issued By: Safety & Traffic Engineering Branch July 4, 2006	

GENERAL NOTES

1. ALL CONSTRUCTION ZONE TRAFFIC CONTROL DEVICES, INCLUDING BUT NOT LIMITED TO BARRICADES, SIGNS, ARROW PANELS, FLASHING BEACON (PORTABLE), AND CHANNELIZING DEVICES, SHALL BE FURNISHED, INSTALLED, MAINTAINED (INCLUDING WASHING), REPLACED IF DAMAGED, REMOVED WHEN TEMPORARILY NOT IN USE AND RETURNED WHEN REQUIRED, RESET AS NECESSARY DURING THE PROGRESS OF CONSTRUCTION, AND REMOVED ENTIRELY WHEN THE PROJECT IS COMPLETED. ALL DEVICES SHALL MEET THE REQUIREMENTS OF THE LATEST EDITION OF THE ATSSA "QUALITY STANDARDS FOR WORK ZONE TRAFFIC CONTROL.

2. WORK ON THE PROJECT SHALL NOT BE STARTED UNTIL ALL REQUIRED TRAFFIC CONTROL DEVICES ARE IN PLACE, AND APPROVED BY THE ENGINEER.

3. WHEN SPEED LIMIT REDUCTION IS REQUIRED, SUCH REDUCTION SHALL BE IN ACCORDANCE WITH CDOT FORM 568, "AUTHORIZATION AND DECLARATION OF TEMPORARY SPEED LIMITS."

WHEN A CHANGE IN AN EXISTING SPEED LIMIT IS REQUIRED, THE R2-1 SIGNS, SHOWN ON THE SCHEDULE OF CONSTRUCTION TRAFFIC CONTROL DEVICES, SHOULD BE INSTALLED AT THE LOCATIONS SHOWN ON THE TYPICAL CASES BY R2-1 (OPTIONAL) SIGNS.

AN ADVISORY SPEED PLATE (W13-1P) MAY BE USED WITH A WARNING SIGN WHEN THE MAXIMUM RECOMMENDED SPEED FOR CONDITION NAMED IS LOWER THAN THE POSTED SPEED LIMIT.

THE REGULATORY OR ADVISORY SPEED REDUCTION DISPLAYED SHALL NOT EXCEED 15 MPH PER SIGN INSTALLATION.

4. ANY TRAFFIC CONTROL DEVICE THAT IS DAMAGED, WEATHERED, WORN, OR OTHERWISE DEEMED UNACCEPTABLE BY THE ENGINEER, SHALL BE REPLACED.

5. CONTRACTOR AND PERSONAL VEHICLE PARKING IS PROHIBITED WITHIN THE RIGHT-OF-WAY UNLESS DESIGNATED ON THE PLANS, OR APPROVED BY THE ENGINEER.

6. CONSTRUCTION TRAFFIC SIGNS SHALL BE MEASURED BY THE FOLLOWING SIZES AND DESCRIPTIONS:

PANEL SIZE A	0.01 TO 9.00 SQ. FT. (INCLUDING TYPE 1 AND TYPE 2 BARRICADES).
PANEL SIZE B	9.01 TO 16.00 SQ. FT.
PANEL SIZE C	GREATER THAN 16 SQ. FT.

CONSTRUCTION TRAFFIC SIGN (SPECIAL), SQ. FT., MAY BE USED FOR SOME PROJECT SPECIFIC INFORMATION SIGNS.

FOR DETAILED DIMENSIONS OF SIGNS WITH SIGN CODE NUMBERS, SEE "STANDARD HIGHWAY SIGNS" AND THE "COLORADO SUPPLEMENT" THERETO. SIGN LAYOUTS FOR OTHER SIGNS WILL BE FURNISHED IN THE PLANS, TRANSMITTED TO THE ENGINEER AFTER AWARD, OR MAY BE AVAILABLE UPON REQUEST.

W20-5 WARNING SIGNS SHALL BE FURNISHED WITH EXCHANGEABLE PLAQUES READING "RIGHT", "LEFT", "CENTER", "RIGHT 2", ETC. AT NO ADDITIONAL COST.

7. ALL WARNING AND REGULATORY SIGNS SHALL BE POSTED ON BOTH SIDES OF THE ROADWAY ON DIVIDED HIGHWAYS, MULTI-LANE RAMPS, ONE-WAY STREETS, AND AS DIRECTED BY THE ENGINEER, EXCEPT WHERE ONLY ONE SHOULDER IS CLOSED (EX: CASE 11 ON SHEET 6).

8. ADDITIONAL TRAFFIC CONTROL DEVICES ADDRESSING FLAGGING, SPEED REDUCTION, ETC. WILL BE NECESSARY FOR SET-UP AND TAKE-DOWN OF MOST CASE APPLICATIONS; DAILY WORK SITE ACCESS; AND PAVEMENT MARKING REMOVAL AND INSTALLATION OPERATIONS.

9. BASED ON SIGHT DISTANCE AND OTHER CONSIDERATIONS, THE FINAL LOCATIONS OF SIGNS ARE SUBJECT TO APPROVAL OF THE ENGINEER.

10. IF CONSTRUCTION RELATED TRAFFIC CONGESTION BACKS UP BEYOND THE INSTALLED ADVANCE SIGN SEQUENCE, ADDITIONAL ADVANCE SIGNING SHALL BE PLACED BEYOND THE CONGESTION.

11. ALL SIGN MATERIAL SHALL BE SOUND AND DURABLE TO THE DEGREE NECESSARY FOR MAINTAINING EFFECTIVE AND NEAT APPEARING TRAFFIC CONTROLS, AND:

- a. SIGN PANELS MAY BE FABRICATED FROM PLYWOOD, STEEL, ALUMINUM, OR OTHER SUITABLE MATERIAL.
- b. REFLECTIVE SHEETING SHALL CONFORM TO ASTM D4956. THE TYPE SHALL BE AS DESCRIBED IN THE STANDARD SPECIFICATIONS AND/OR AS SHOWN ON THE PLANS.
- c. SYMBOLS AND LEGEND SHALL BE OF GOOD WORKMANSHIP (UNEVEN OR HAND LETTERING WILL NOT BE ACCEPTED).
- d. PORTABLE OR TEMPORARY MOUNTING SHALL NOT BE CONSTRUCTED OR WEIGHTED BY ANY METHOD OR MATERIAL THAT MAKES THEM HAZARDOUS TO TRAFFIC.
- e. CERTAIN POST SIZES AND SHAPES REQUIRE A "BREAK-AWAY" DEVICE. SEE THE APPLICABLE STANDARD PLAN. OTHER POST DESIGNS OR SYSTEMS REQUIRE THE SUBMITTAL OF AN FHWA LETTER OF ACCEPTANCE TO THE ENGINEER, AND MUST BE APPROVED BY THE ENGINEER PRIOR TO THEIR USE.

12. ALL CONSTRUCTION SIGN PLACEMENT SHALL BE IN ACCORDANCE WITH STANDARD PLAN "TYPICAL GROUND SIGN PLACEMENT" UNLESS OTHERWISE APPROVED.

SIGNS APPROVED TO BE MOUNTED ON PORTABLE SUPPORTS, OR APPROPRIATE SIGNS MOUNTED ON BARRICADES, MAY BE AT LOWER HEIGHTS, BUT THE BOTTOM OF THE SIGNS SHALL NOT BE LESS THAN ONE FOOT ABOVE THE PAVEMENT ELEVATION.

13. SIGNS MOUNTED ON THE MEDIAN OF DIVIDED HIGHWAYS WHERE MEDIAN BARRIER IS IN PLACE MAY BE MOUNTED ON THE BARRIER WITH A SADDLE TYPE BRACKET. IF THE BRACKET ALLOWS THE SIGN PANEL TO BE TURNED PARALLEL TO THE ROADWAY, THE SIGN MAY REMAIN IN PLACE WHEN NOT APPLICABLE, BUT LAYING THE SIGN PANEL DOWN IN A HORIZONTAL POSITION IS NOT PERMITTED.

14. TRAFFIC CONES SHALL BE AT LEAST 28 INCHES IN HEIGHT. HOWEVER, THE MINIMUM SIZE SHALL BE 36 INCHES WHEN THEY ARE USED ON FREEWAYS AND EXPRESSWAYS, OR DURING NIGHT TIME WORKING HOURS. THEY SHOULD ALSO BE 36 INCHES WHEN USED ON OTHER HIGH SPEED ROADWAYS (45 MPH OR MORE) WITH AN ADT OF 6,000 OR MORE.

15. TYPE I BARRICADES SHALL NOT BE USED ON FREEWAYS, EXPRESSWAYS, OR OTHER HIGH SPEED ROADWAYS (45 MPH OR MORE).

16. WHEN TWO-WAY TRAFFIC IS PLACED ON ONE ROADWAY OF A NORMALLY DIVIDED HIGHWAY, OPPOSING TRAFFIC SHALL BE SEPARATED EITHER WITH CONCRETE BARRIER (TEMPORARY), OR WITH CHANNELIZING DEVICES APPROVED FOR THIS APPLICATION, THROUGHOUT THE LENGTH OF TWO-WAY OPERATION. THE TRANSITION ZONES SHALL HAVE CONCRETE BARRIER (TEMPORARY). THE BARRIER SHALL BE TIED TO AN EXISTING STRUCTURE OR GUARD RAIL, FLARED OR EXTENDED, TO MEET CLEAR ZONE REQUIREMENTS, OR FITTED WITH AN IMPACT ATTENUATION DEVICE.

17. CHANNELIZING DEVICE SPACING, IN FEET, SHALL BE AS FOLLOWS:

- a. FOR TAPERS AND TRANSITIONS, SPACING EQUALS THE NUMERICAL VALUE OF THE SPEED LIMIT. (e.g. 45 MPH = 45 FEET)
- b. FOR TANGENTS ALONG THE BUFFER SPACE OR WORK AREA, SPACING MAY NOT BE GREATER THAN TWO TIMES THE SPEED LIMIT. (e.g. 50 MPH = 50 FEET TO 100 FEET MAXIMUM)

18. FOR DETAILS ON BARRICADES, CONCRETE BARRIER (TEMPORARY), VERTICAL PANELS, AND FLASHING BEACON (PORTABLE), SEE THE APPLICABLE STANDARD PLANS.

19. FLOOD LIGHTS SHALL BE USED TO ILLUMINATE FLAGGER STATIONS DURING THE HOURS OF DARKNESS UNLESS OTHERWISE APPROVED. A TYPICAL LIGHT SHOULD PROVIDE THE FOLLOWING: A FULLY DIRECTIONAL SWIVEL MOUNT QUARTZ LIGHT SOURCE (500 WATT MINIMUM), SELF-SUPPORTING STAND WITH VARIABLE LIGHT HEIGHT FROM A MINIMUM OF EIGHT FEET ABOVE THE ROADWAY, AND A POWER SOURCE. IT SHALL ILLUMINATE THE STATION AREA AND A FLAGGER ESCAPE PATH, BUT SHALL NOT PRESENT ANY GLARE TO TRAFFIC.

20. IF WORK ON THE ROADWAY IS FOR A LONG-TERM STATIONARY PERIOD, AS DEFINED IN SECTION 6G.02 OF THE MUTCD, INAPPLICABLE PAVEMENT MARKINGS ARE TO BE REMOVED, AND FULL COMPLIANCE PAVEMENT MARKINGS ARE TO BE INSTALLED IN ACCORDANCE WITH THE APPLICABLE SPECIFICATIONS, (PAVEMENT MARKING - GENERAL), AND/OR AS DETAILED ON THE PLANS.

FOR ADDITIONAL PAVEMENT MARKING DETAILS, SEE STANDARD PLAN "TYPICAL PAVEMENT MARKINGS".

21. BUFFER SPACE IS OPTIONAL. NEED MUST BE DETERMINED ON A PROJECT OR SITE SPECIFIC BASIS AS DIRECTED BY THE ENGINEER. WHEN A BUFFER SPACE IS USED, DIMENSIONS AND/OR DEVICES USED ARE TO BE INCORPORATED IN THE TRAFFIC CONTROL PLAN (TCP) OR THE CONTRACTOR'S METHOD OF HANDLING TRAFFIC (MHT).

22. ADDITIONAL VMS SIGNAGE SHOULD BE CONSIDERED AT LEAST A MILE IN ADVANCE OF THE SIGNING SHOWN IN THE DETAIL FOR ANY LANE CLOSURES ON INTERSTATE AND OTHER HIGH SPEED FACILITIES ESPECIALLY WHEN THE LEVEL OF SERVICE IS SIGNIFICANTLY REDUCED AS A RESULT OF CONSTRUCTION. THE LEGENDS SHOULD BE CHANGED TO ADVISE MOTORISTS OF UPCOMING TRAFFIC CONDITIONS AND TO ALERT THEM OF UPCOMING LANE USAGE.

ADDITIONAL ADVANCE WARNING SIGNAGE IS ENCOURAGED IN ALL CASES WHERE TRAFFIC VOLUMES AND SPEEDS ARE HIGH AND/OR WHERE THERE ARE INFREQUENT EXITS. ADDITIONAL SIGNAGE IS ALSO ENCOURAGED IN LOCATIONS WHERE DRIVERS' LINE OF SIGHT TO ADVANCE WARNING SIGNS IS OBSTRUCTED.

23. WHEN ARROW BOARDS ARE USED TO CLOSE MULTIPLE LANES, A SEPARATE ARROW BOARD SHALL BE USED FOR EACH CLOSED LANE.

IF ARROW BOARDS ARE USED FOR SHOULDER WORK, BLOCKING THE SHOULDER, FOR ROADSIDE WORK NEAR THE SHOULDER, OR FOR TEMPORARILY CLOSING ONE LANE ON A TWO-LANE, TWO-WAY ROADWAY, USE THE ARROW BOARDS ONLY IN THE CAUTION MODE.

24. RAISED PAVEMENT MARKERS MAY BE USED TO SUPPLEMENT TEMPORARY STRIPING DURING NON-SNOW PERIODS. THEIR USE IS ENCOURAGED ON HIGHER SPEED FACILITIES WHEN TRAFFIC IS BEING DIVERTED FROM ITS USUAL COURSE.

25. THE TYPICAL CASES DEPICTED IN THIS STANDARD REFLECT THE MINIMUM REQUIREMENTS, UNLESS AS OTHERWISE DIRECTED BY THE PROJECT PLANS AND SPECIFICATIONS, AND/OR THE PROJECT ENGINEER.

26. A SIGNIFICANT PROJECT IS DEFINED AS ONE THAT, ALONE OR IN COMBINATION WITH OTHER CONCURRENT PROJECTS NEARBY, IS ANTICIPATED TO CAUSE SUSTAINED WORK ZONE IMPACTS AT A LOCATION FOR THREE OR MORE CONSECUTIVE DAYS WITH EITHER INTERMITTENT OR CONTINUOUS LANE CLOSURES.

Computer File Information		Sheet Revisions	
		Date:	Comments
Creation Date: 07/04/06	Initials: KCM	(R-1) 03/05/07	REVISED SHEET 8
Last Modification Date: 03/26/12	Initials: KEN	(R-2) 06/24/09	SHEET 1 - REV. NOTE 20, ADD NOTE 25
Full Path: www.coloradodot.info/library/traffic/traffic-s-standard-plans		(R-2) 06/24/09	ADDED SHEETS 13-19:
Drawing File Name: S-630-01_1of19.dgn		(R-2) 06/24/09	REVISED SHEETS 2-11 & 19
CAD Ver.: MicroStation V8	Scale: Not to Scale	(R-3) 12/07/09	REVISED SHEETS 2-15 & 19
	Units: English	(R-4) 02/17/10	REVISED SHEET 7
		(R-5) 02/24/11	REVISED SHEET 16
		(R-6) 02/13/12	SHEET 1 - REV. NOTES 24-26, ADD NOTE 23
		(R-7) 03/26/12	SHEET 1 - REVISED NOTE 23

Colorado Department of Transportation



4201 East Arkansas Avenue
Denver, Colorado 80222
Phone: (303) 757-9543
Fax: (303) 757-9458

Safety & Traffic Engineering Branch

KCM/KEN


TRAFFIC CONTROLS
FOR HIGHWAY
CONSTRUCTION

Issued By: Safety & Traffic Engineering Branch July 4, 2006


STANDARD PLAN NO.

S-630-1


Sheet No. 1 of 19

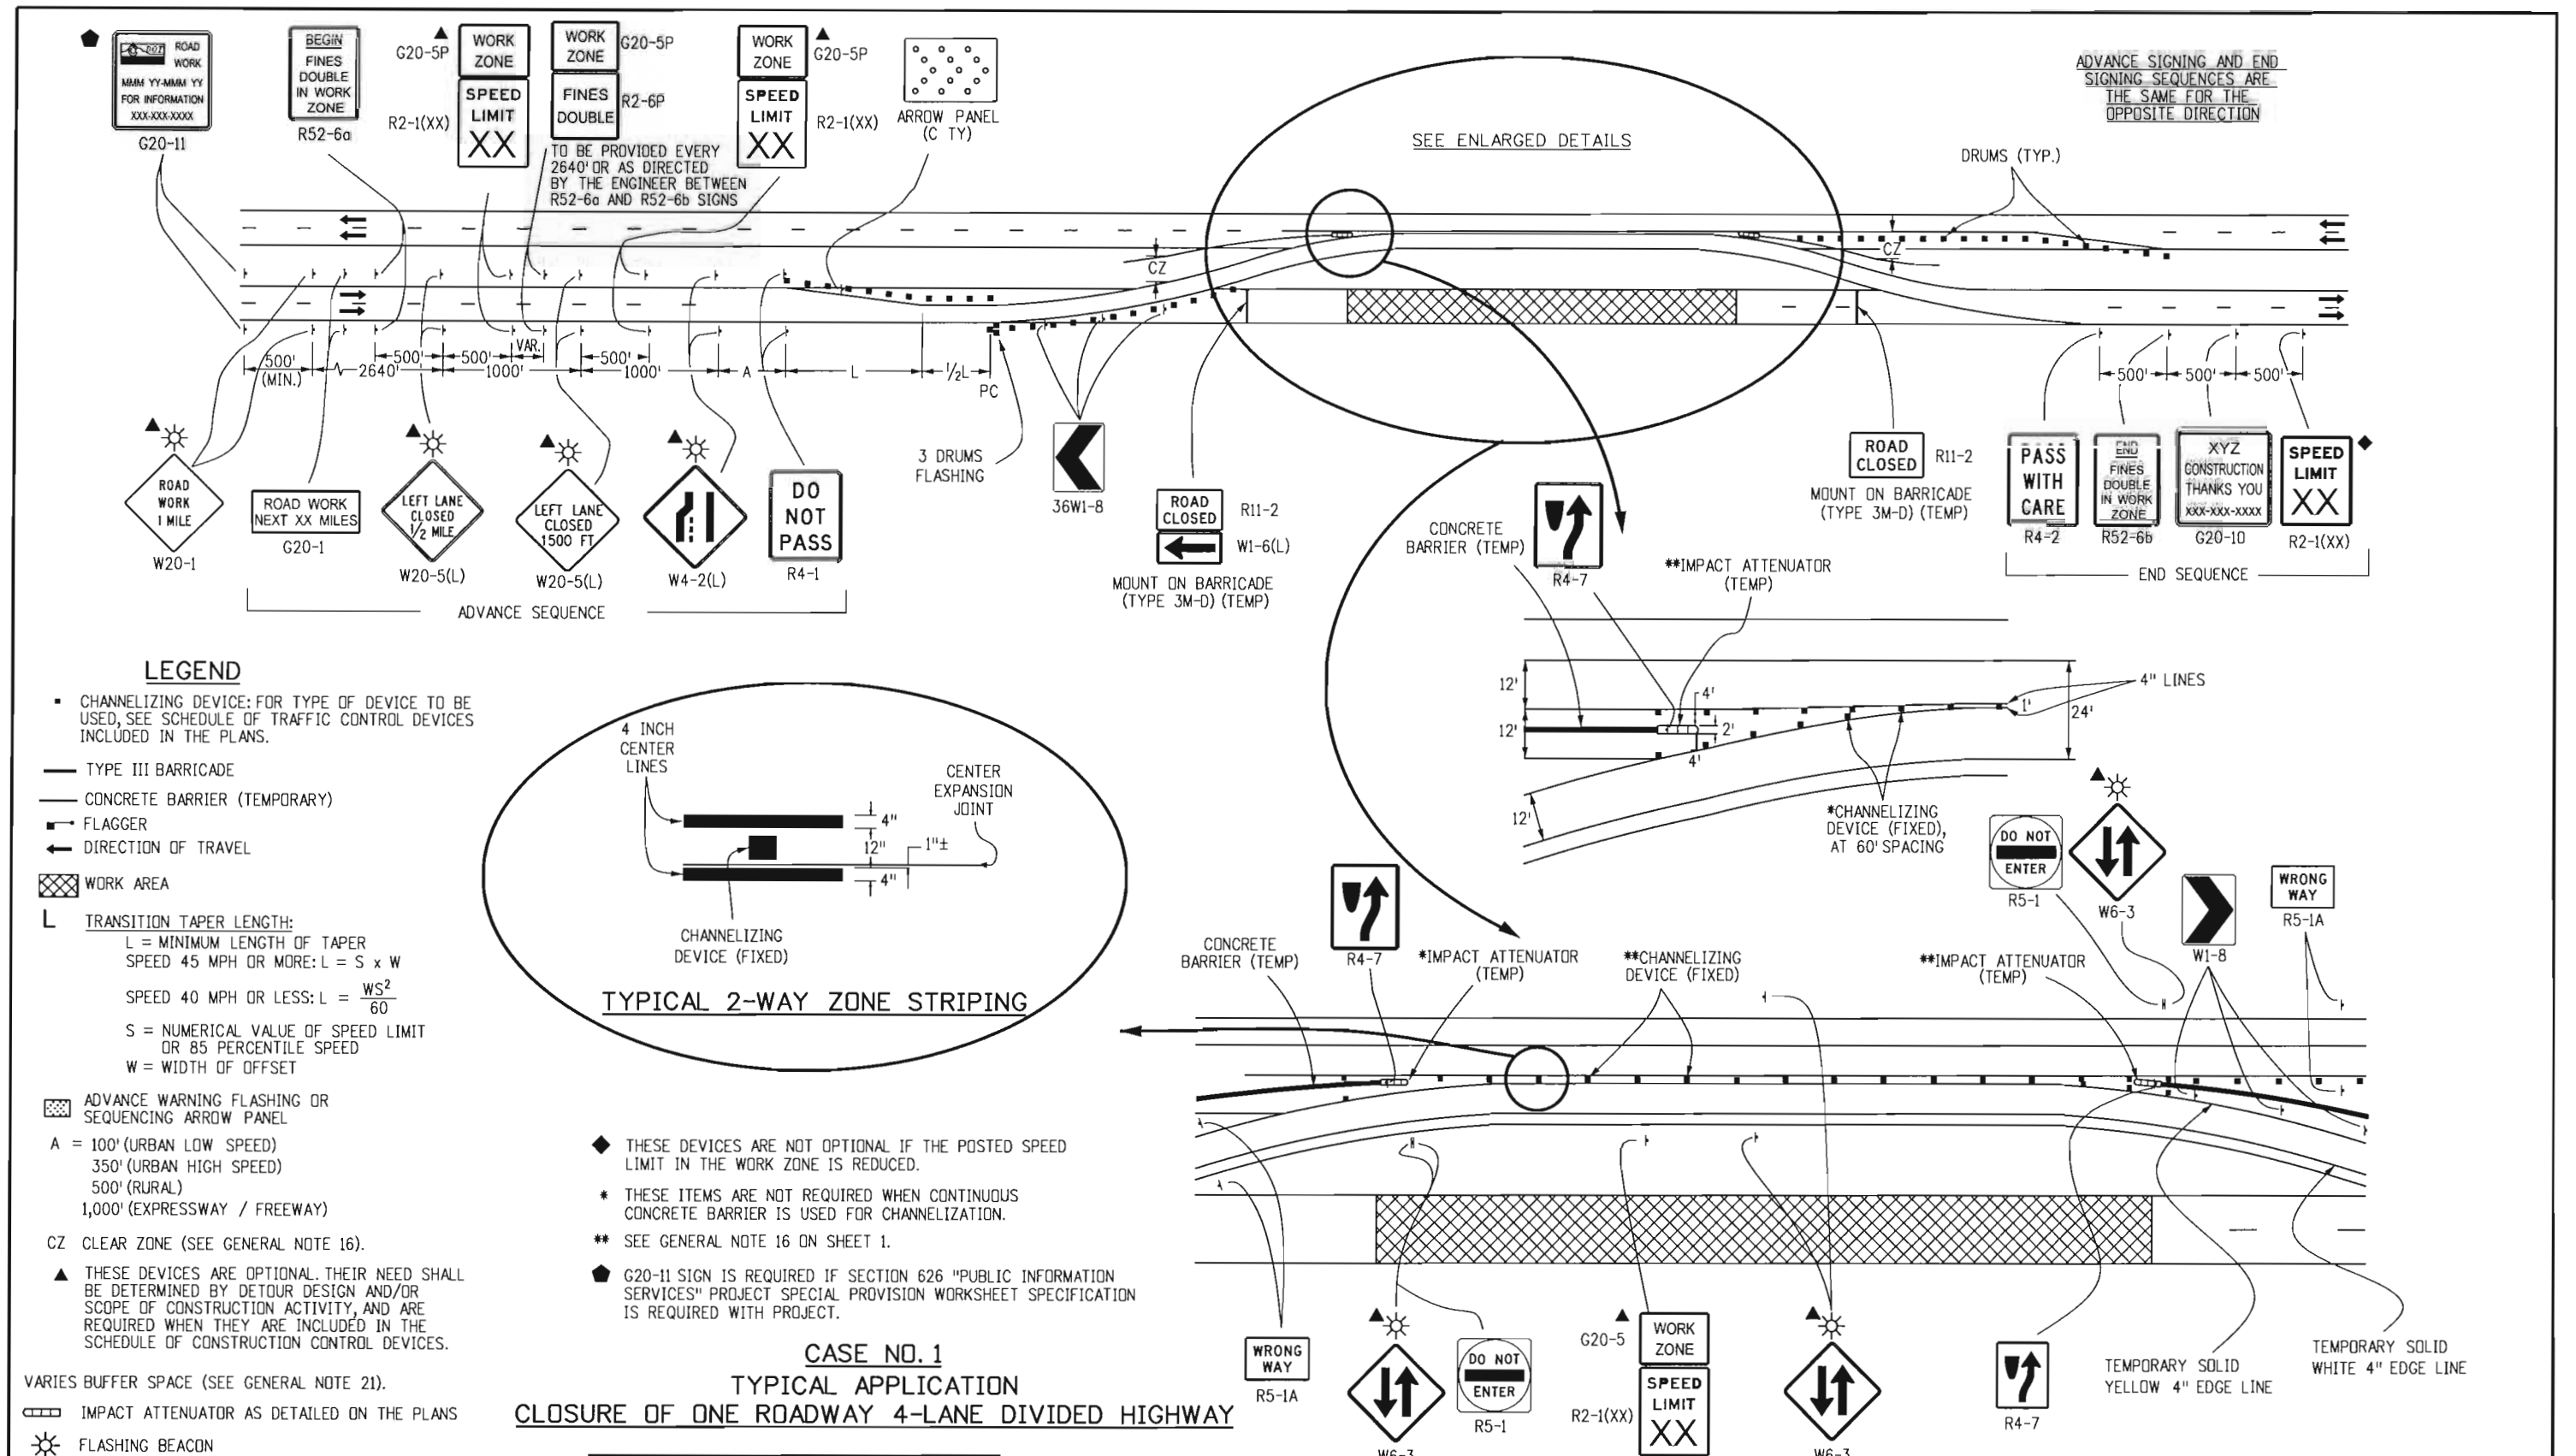

Computer File Information		Sheet Revisions		Colorado Department of Transportation 4201 East Arkansas Avenue Denver, Colorado 80222 Phone: (303) 757-9543 Fax: (303) 757-9458 Safety & Traffic Engineering Branch	TRAFFIC CONTROLS FOR HIGHWAY CONSTRUCTION Issued By: Safety & Traffic Engineering Branch July 4, 2006	STANDARD PLAN NO. S-630-1 Sheet No. 2 of 19
Creation Date: 07/04/06	Initials: KCM	Date:	Comments			
Last Modification Date: 12/07/09	Initials: KEN	06/24/09	ADDED R52-6a, R52-6b & G20-5 SIGNS (REVISED SHEET NUMBER TO 2 OF 19)	KCM/KEN		
Full Path: www.coloradodot.info/library/traffic/traffic-s-standard-plans		06/24/09	ADDED * & ** NOTES, EXTENDED FLARED ENDS OF CONCRETE BARRIER			
Drawing File Name: S-630-01_2of19.dgn		06/24/09	ADDED OPTIONAL FLASHING BEACONS ON ADVANCED WARNING SIGNS			
CAD Ver.: MicroStation V8 Scale: Not to Scale Units: English		12/07/09	SELECTED OPTION SYMBOL FOR WORK ZONE SPEED LIMIT SIGN (R2-100) ADDED SYMBOL IN SPEED LIMIT SIGN (R2-100) AFTER R52-6b SIGN ADDED R2-4/G20-4 PLACED AFTER G20-11 SIGN AND 6 SYMBOL ADDED			

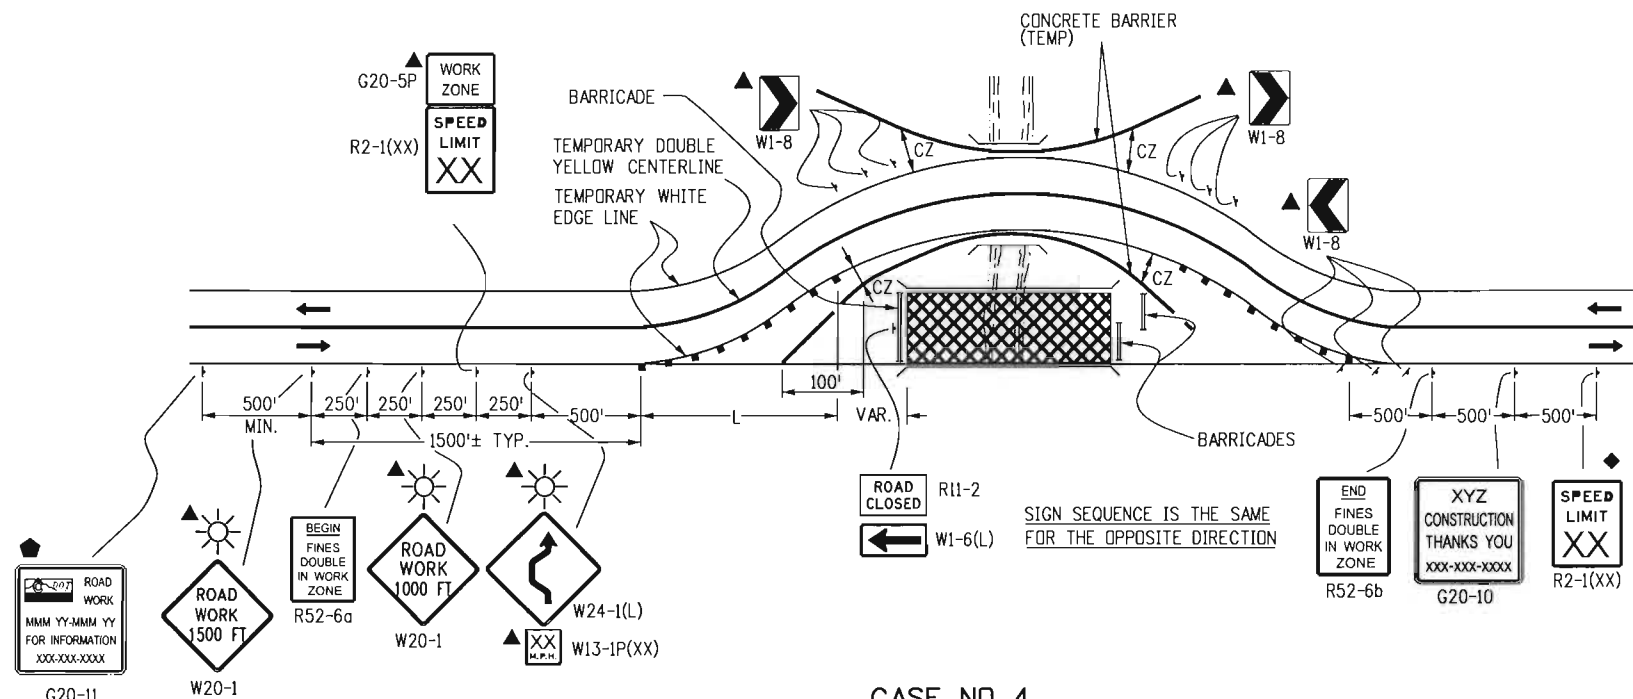

CASE NO. 4
TYPICAL APPLICATION
ROAD CLOSURE, BYPASS DETOUR PROVIDED

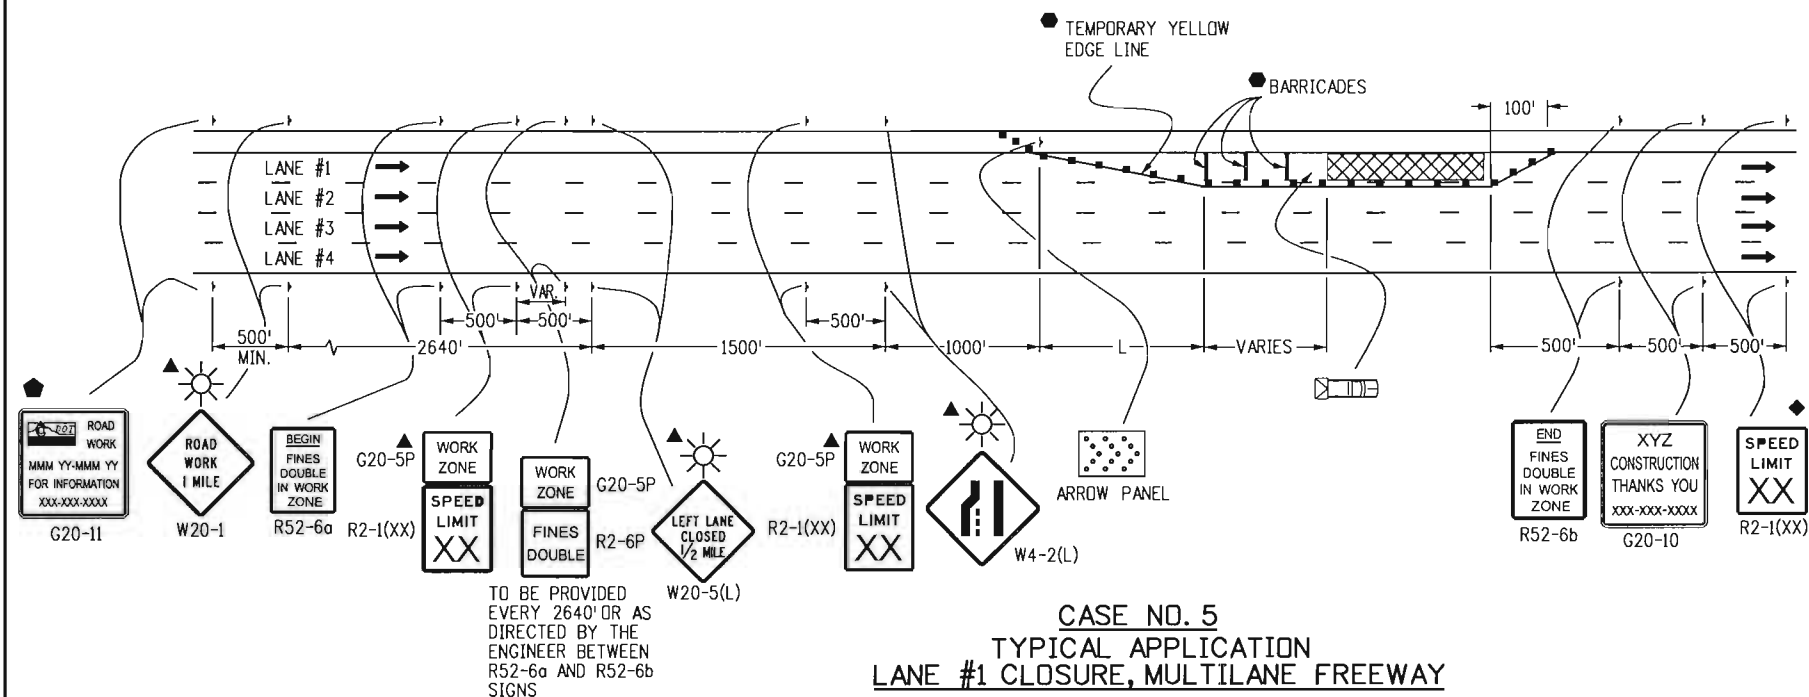


CASE NO. 5
TYPICAL APPLICATION
LANE #1 CLOSURE, MULTILANE FREEWAY

LEGEND


- CHANNELIZING DEVICE: FOR TYPE OF DEVICE TO BE USED, SEE THE SCHEDULE OF CONSTRUCTION TRAFFIC CONTROL DEVICES INCLUDED IN THE PLANS.
- TYPE III BARRICADE
- CONCRETE BARRIER (TEMPORARY)
- FLAGGER
- ← DIRECTION OF TRAVEL
- ▨ WORK AREA
- L TRANSITION TAPER LENGTH:
L = MINIMUM LENGTH OF TAPER
SPEED 45 MPH OR MORE: $L = S \times W$
SPEED 40 MPH OR LESS: $L = \frac{WS^2}{60}$
S = NUMERICAL VALUE OF SPEED LIMIT OR 85 PERCENTILE SPEED
W = WIDTH OF OFFSET
SHOULDER TAPER = $\frac{1}{3} L$
- ▨ ADVANCE WARNING FLASHING OR SEQUENCING ARROW PANEL
- CZ CLEAR ZONE (SEE GENERAL NOTE 16).
- ▲ THESE DEVICES ARE OPTIONAL. THEIR NEED SHALL BE DETERMINED BY DETOUR DESIGN AND/OR SCOPE OF CONSTRUCTION ACTIVITY, AND ARE REQUIRED WHEN THEY ARE INCLUDED IN THE SCHEDULE OF CONSTRUCTION CONTROL DEVICES.
- ◆ THESE DEVICES ARE NOT OPTIONAL IF THE POSTED SPEED LIMIT IN THE WORK ZONE IS REDUCED.
- VARIES BUFFER SPACE (SEE GENERAL NOTE 21).
- REQUIRED WHEN WORK OCCUPIES THE LOCATION FOR MORE THAN 3 DAYS.
- ◆ G20-11 SIGN IS REQUIRED WHEN SECTION 626 "PUBLIC INFORMATION SERVICES" PROJECT SPECIAL PROVISION WORKSHEET SPECIFICATION IS REQUIRED WITH PROJECT.
- ▨ TRUCK MOUNTED ATTENUATOR (TMA)
- ☀ FLASHING BEACON

Computer File Information		Sheet Revisions		<div> <p>Colorado Department of Transportation 4201 East Arkansas Avenue Denver, Colorado 80222 Phone: (303) 757-9543 Fax: (303) 757-9458</p> </div>	<div> <p>TRAFFIC CONTROLS FOR HIGHWAY CONSTRUCTION</p> <p>Issued By: Safety & Traffic Engineering Branch July 4, 2006</p> </div>	STANDARD PLAN NO.
Creation Date: 07/04/06	Initials: KCM	Date:	Comments			S-630-1
Last Modification Date: 12/07/09	Initials: KEN	06/24/09	ADDED R-52a, R52-6b & G20-5 SIGNS REVISED SHEET NUMBER TO 4 OF 18			
Full Path: www.coloradodot.info/library/traffic/traffic-s-standard-plans		06/24/09	EXTEND CONCRETE BARRIER IN CASE 4, ADDED OPTIONAL FLASHING BEACON TO ADVANCED WARNING SIGNS.			
Drawing File Name: S-630-01 (4of19).dgn		12/07/09	ADDED OPTICAL SHEET FOR WORK ZONE SPEED LIMIT SIGN (R52-6b) AND R52-6a AND R52-6b PLACED BETWEEN R52-6a AND R52-6b SIGNS. ADDED R52-6b SPEED LIMIT SIGN (R52-6b) AFTER R52-6a SIGN. ADDED R52-6b SIGN AND R52-6b SIGN.			
CAD Ver.: MicroStation V8	Scale: Not to Scale	Units: English		Safety & Traffic Engineering Branch	KCM/KEN	Sheet No. 4 of 19

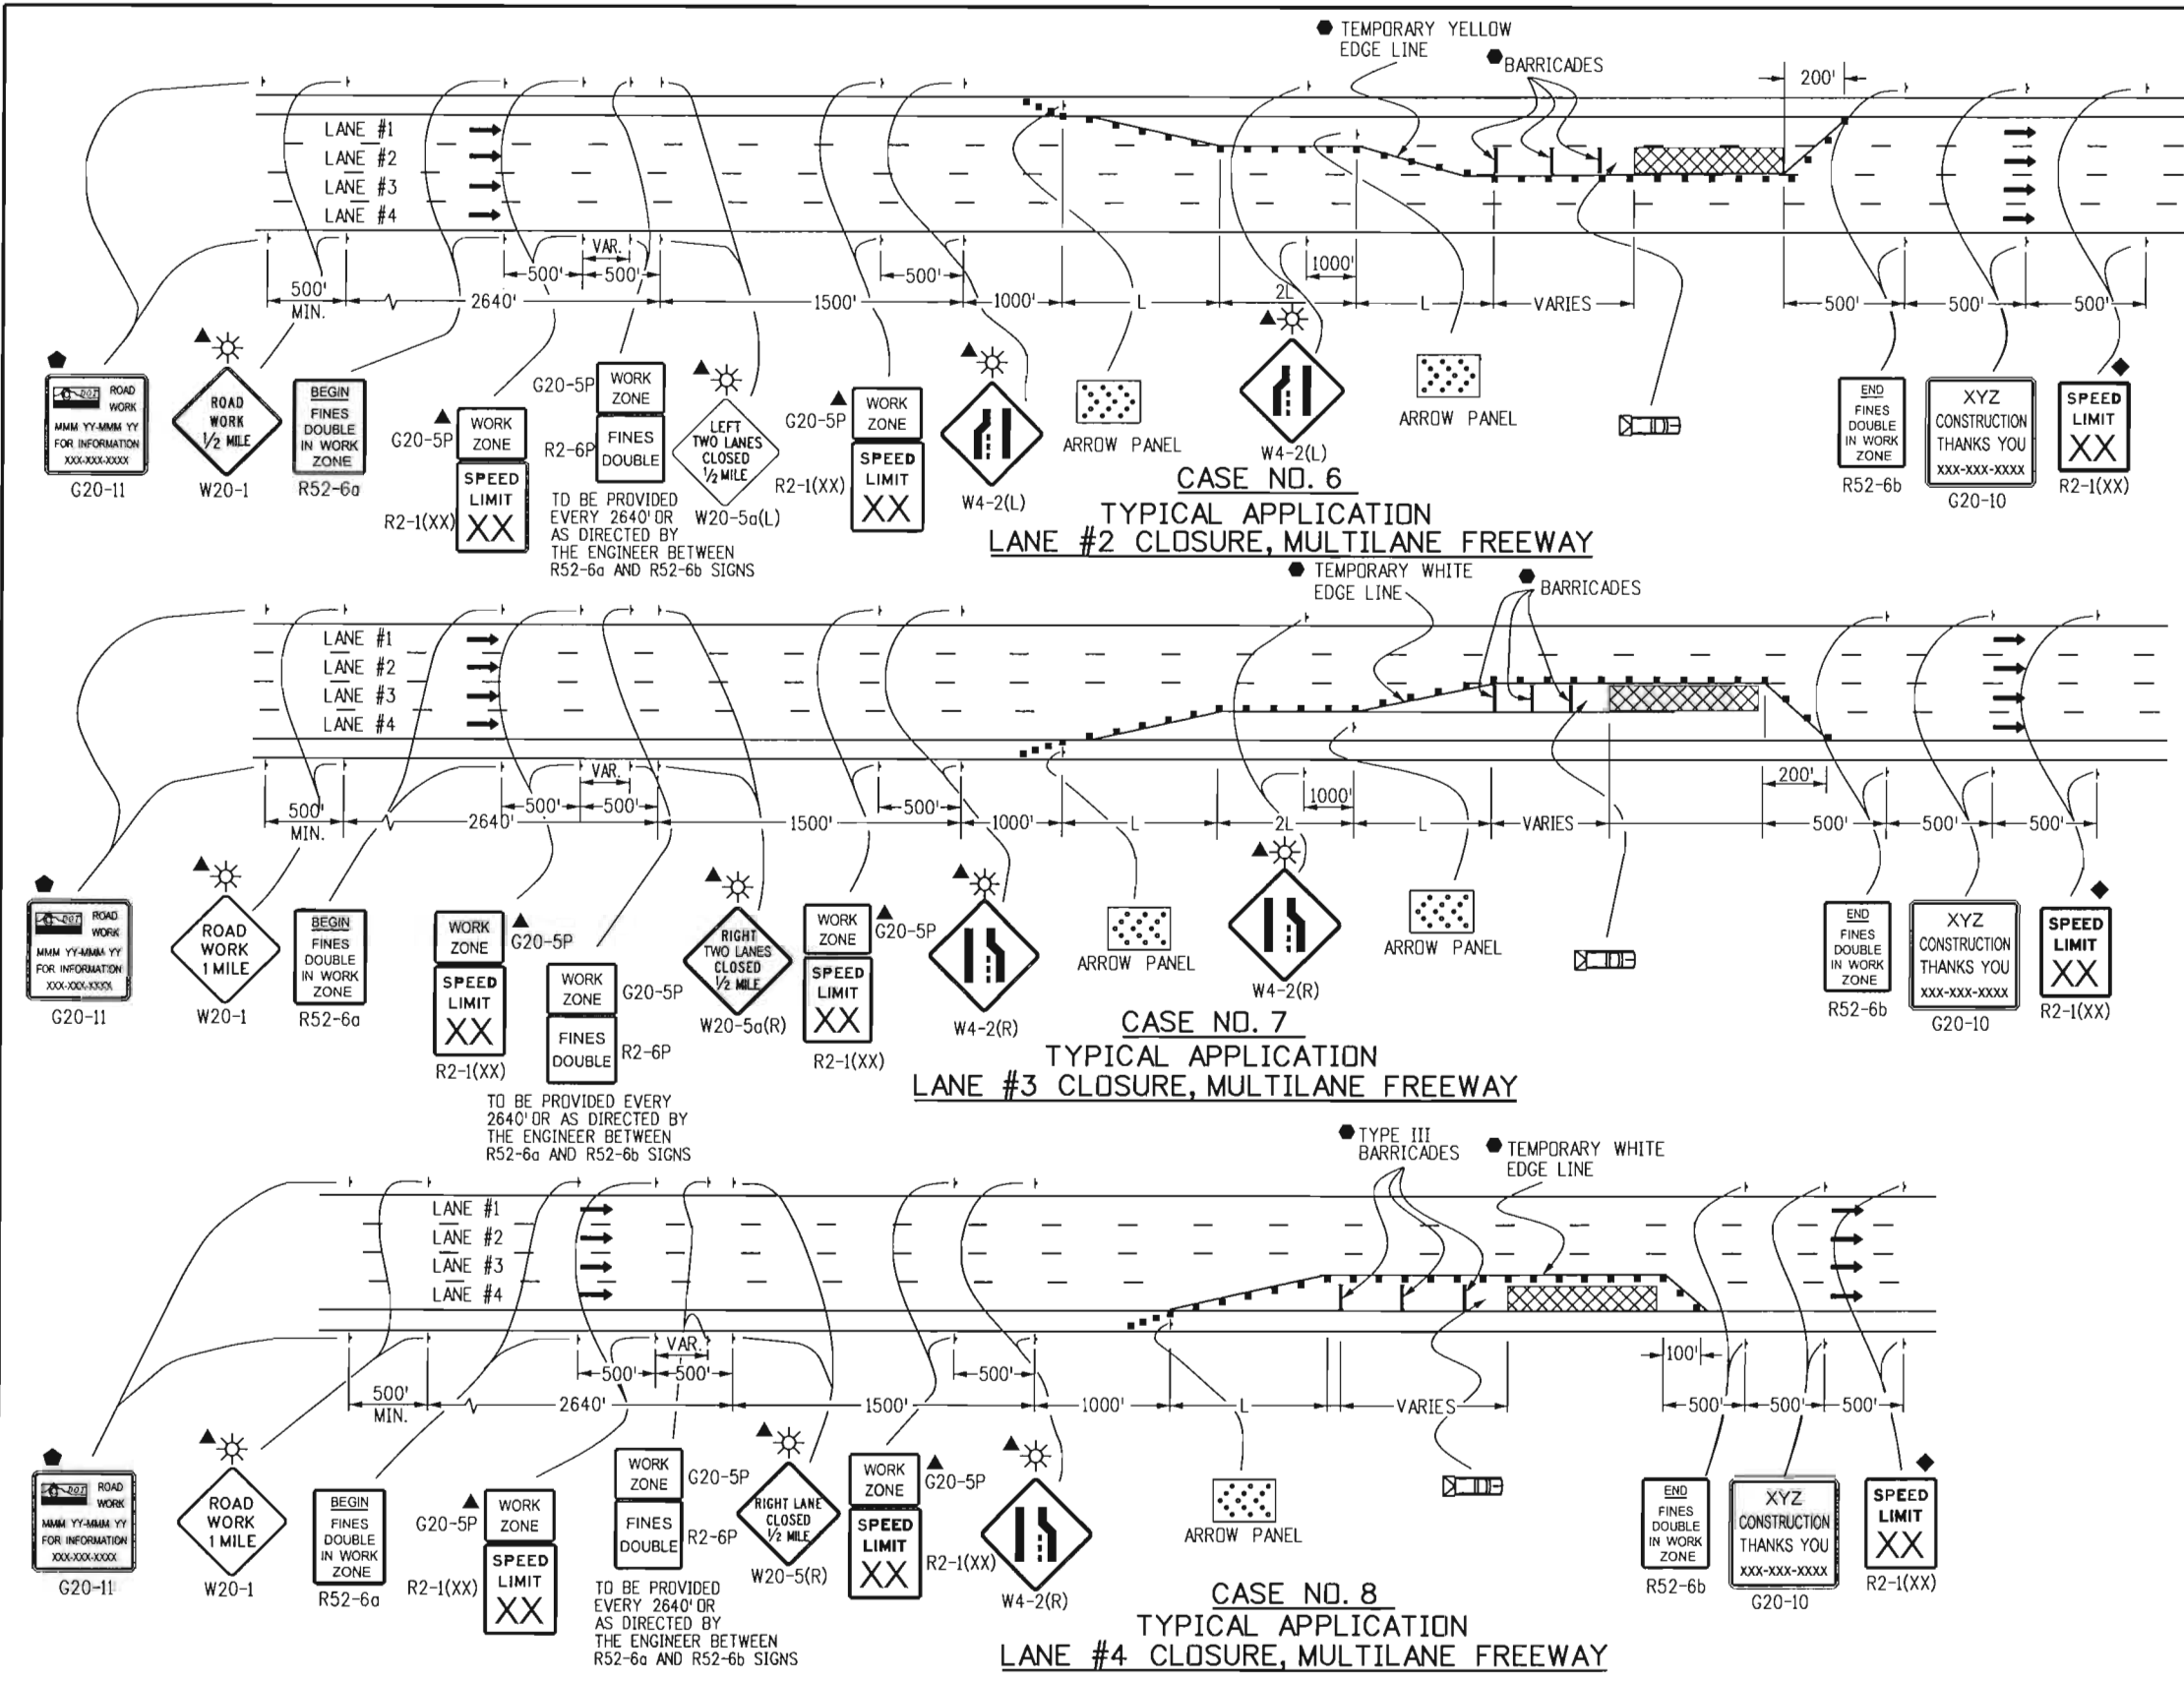


- ### LEGEND
- CHANNELIZING DEVICE: FOR TYPE OF DEVICE TO BE USED, SEE THE SCHEDULE OF CONSTRUCTION TRAFFIC CONTROL DEVICES INCLUDED IN THE PLANS.
 - TYPE III BARRICADE
 - CONCRETE BARRIER (TEMPORARY)
 - FLAGGER
 - ← DIRECTION OF TRAVEL
 - ▨ WORK AREA
 - L TRANSITION TAPER LENGTH:
 $L = \text{MINIMUM LENGTH OF TAPER}$
 SPEED 45 MPH OR MORE: $L = S \times W$
 SPEED 40 MPH OR LESS: $L = \frac{WS^2}{60}$
 S = NUMERICAL VALUE OF SPEED LIMIT OR 85 PERCENTILE SPEED
 W = WIDTH OF OFFSET
 SHOULDER TAPER = 1/3 L
 - ▨ ADVANCE WARNING FLASHING OR SEQUENCING ARROW PANEL
 - CZ CLEAR ZONE (SEE GENERAL NOTE 16).
 - ▲ THESE DEVICES ARE OPTIONAL. THEIR NEED SHALL BE DETERMINED BY DETOUR DESIGN AND/OR SCOPE OF CONSTRUCTION ACTIVITY, AND ARE REQUIRED WHEN THEY ARE INCLUDED IN THE SCHEDULE OF CONSTRUCTION CONTROL DEVICES.
 - ◆ THESE DEVICES ARE NOT OPTIONAL IF THE POSTED SPEED LIMIT IN THE WORK ZONE IS REDUCED.
 - VARIES BUFFER SPACE (SEE GENERAL NOTE 21).
 - REQUIRED WHEN WORK OCCUPIES THE LOCATION FOR MORE THAN 3 DAYS.
 - ◆ G20-11 SIGN IS REQUIRED WHEN SECTION 626 "PUBLIC INFORMATION SERVICES" PROJECT SPECIAL PROVISION WORKSHEET SPECIFICATION IS REQUIRED WITH PROJECT.
 - ▨ TRUCK MOUNTED ATTENUATOR (TMA)
 - ☼ FLASHING BEACON




Computer File Information		<div><div></div><div>(R-2)</div><div>(R-2)</div><div>(R-3)</div><div></div></div>	Sheet Revisions		<div><div>Colorado Department of Transportation</div><div><div>4201 East Arkansas Avenue Denver, Colorado 80222 Phone: (303) 757-9543 Fax: (303) 757-9458</div></div><div>Safety & Traffic Engineering Branch</div><div>KCM/KEN</div></div>	TRAFFIC CONTROLS FOR HIGHWAY CONSTRUCTION		STANDARD PLAN NO.
Creation Date: 07/04/06	Initials: KCM		Date:	Comments				S-630-1
Last Modification Date: 12/07/09	Initials: KEN		06/24/09	ADDED R52-6a, R52-6b & G20-5 SIGNS; REVISED SHEET NUMBER TO 5 OF 19.				
Full Path: www.coloradodot.info/library/traffic/traffic-s-standard-plans			06/24/09	ADDED OPTIONAL FLASHING BEACONS TO ADVANCED WARNING SIGNS.				
Drawing File Name: S-630-01_5of19.dgn			12/07/09	DELETED OPTIONAL SYMBOL FOR WORK ZONE SPEED LIMIT SIGN (R2-10X). ADDED * SYMBOL IN SPEED LIMIT SIGN (R-100) AFTER R52-6b SIGN. ADDED R2-5a/R2-5b PLACARDS; ADDED G20-11 SIGN AND * SYMBOL (NOTE).				
CAD Ver.: MicroStation V8	Scale: Not to Scale	Units: English			Issued By: Safety & Traffic Engineering Branch July 4, 2006		Sheet No. 5 of 19	

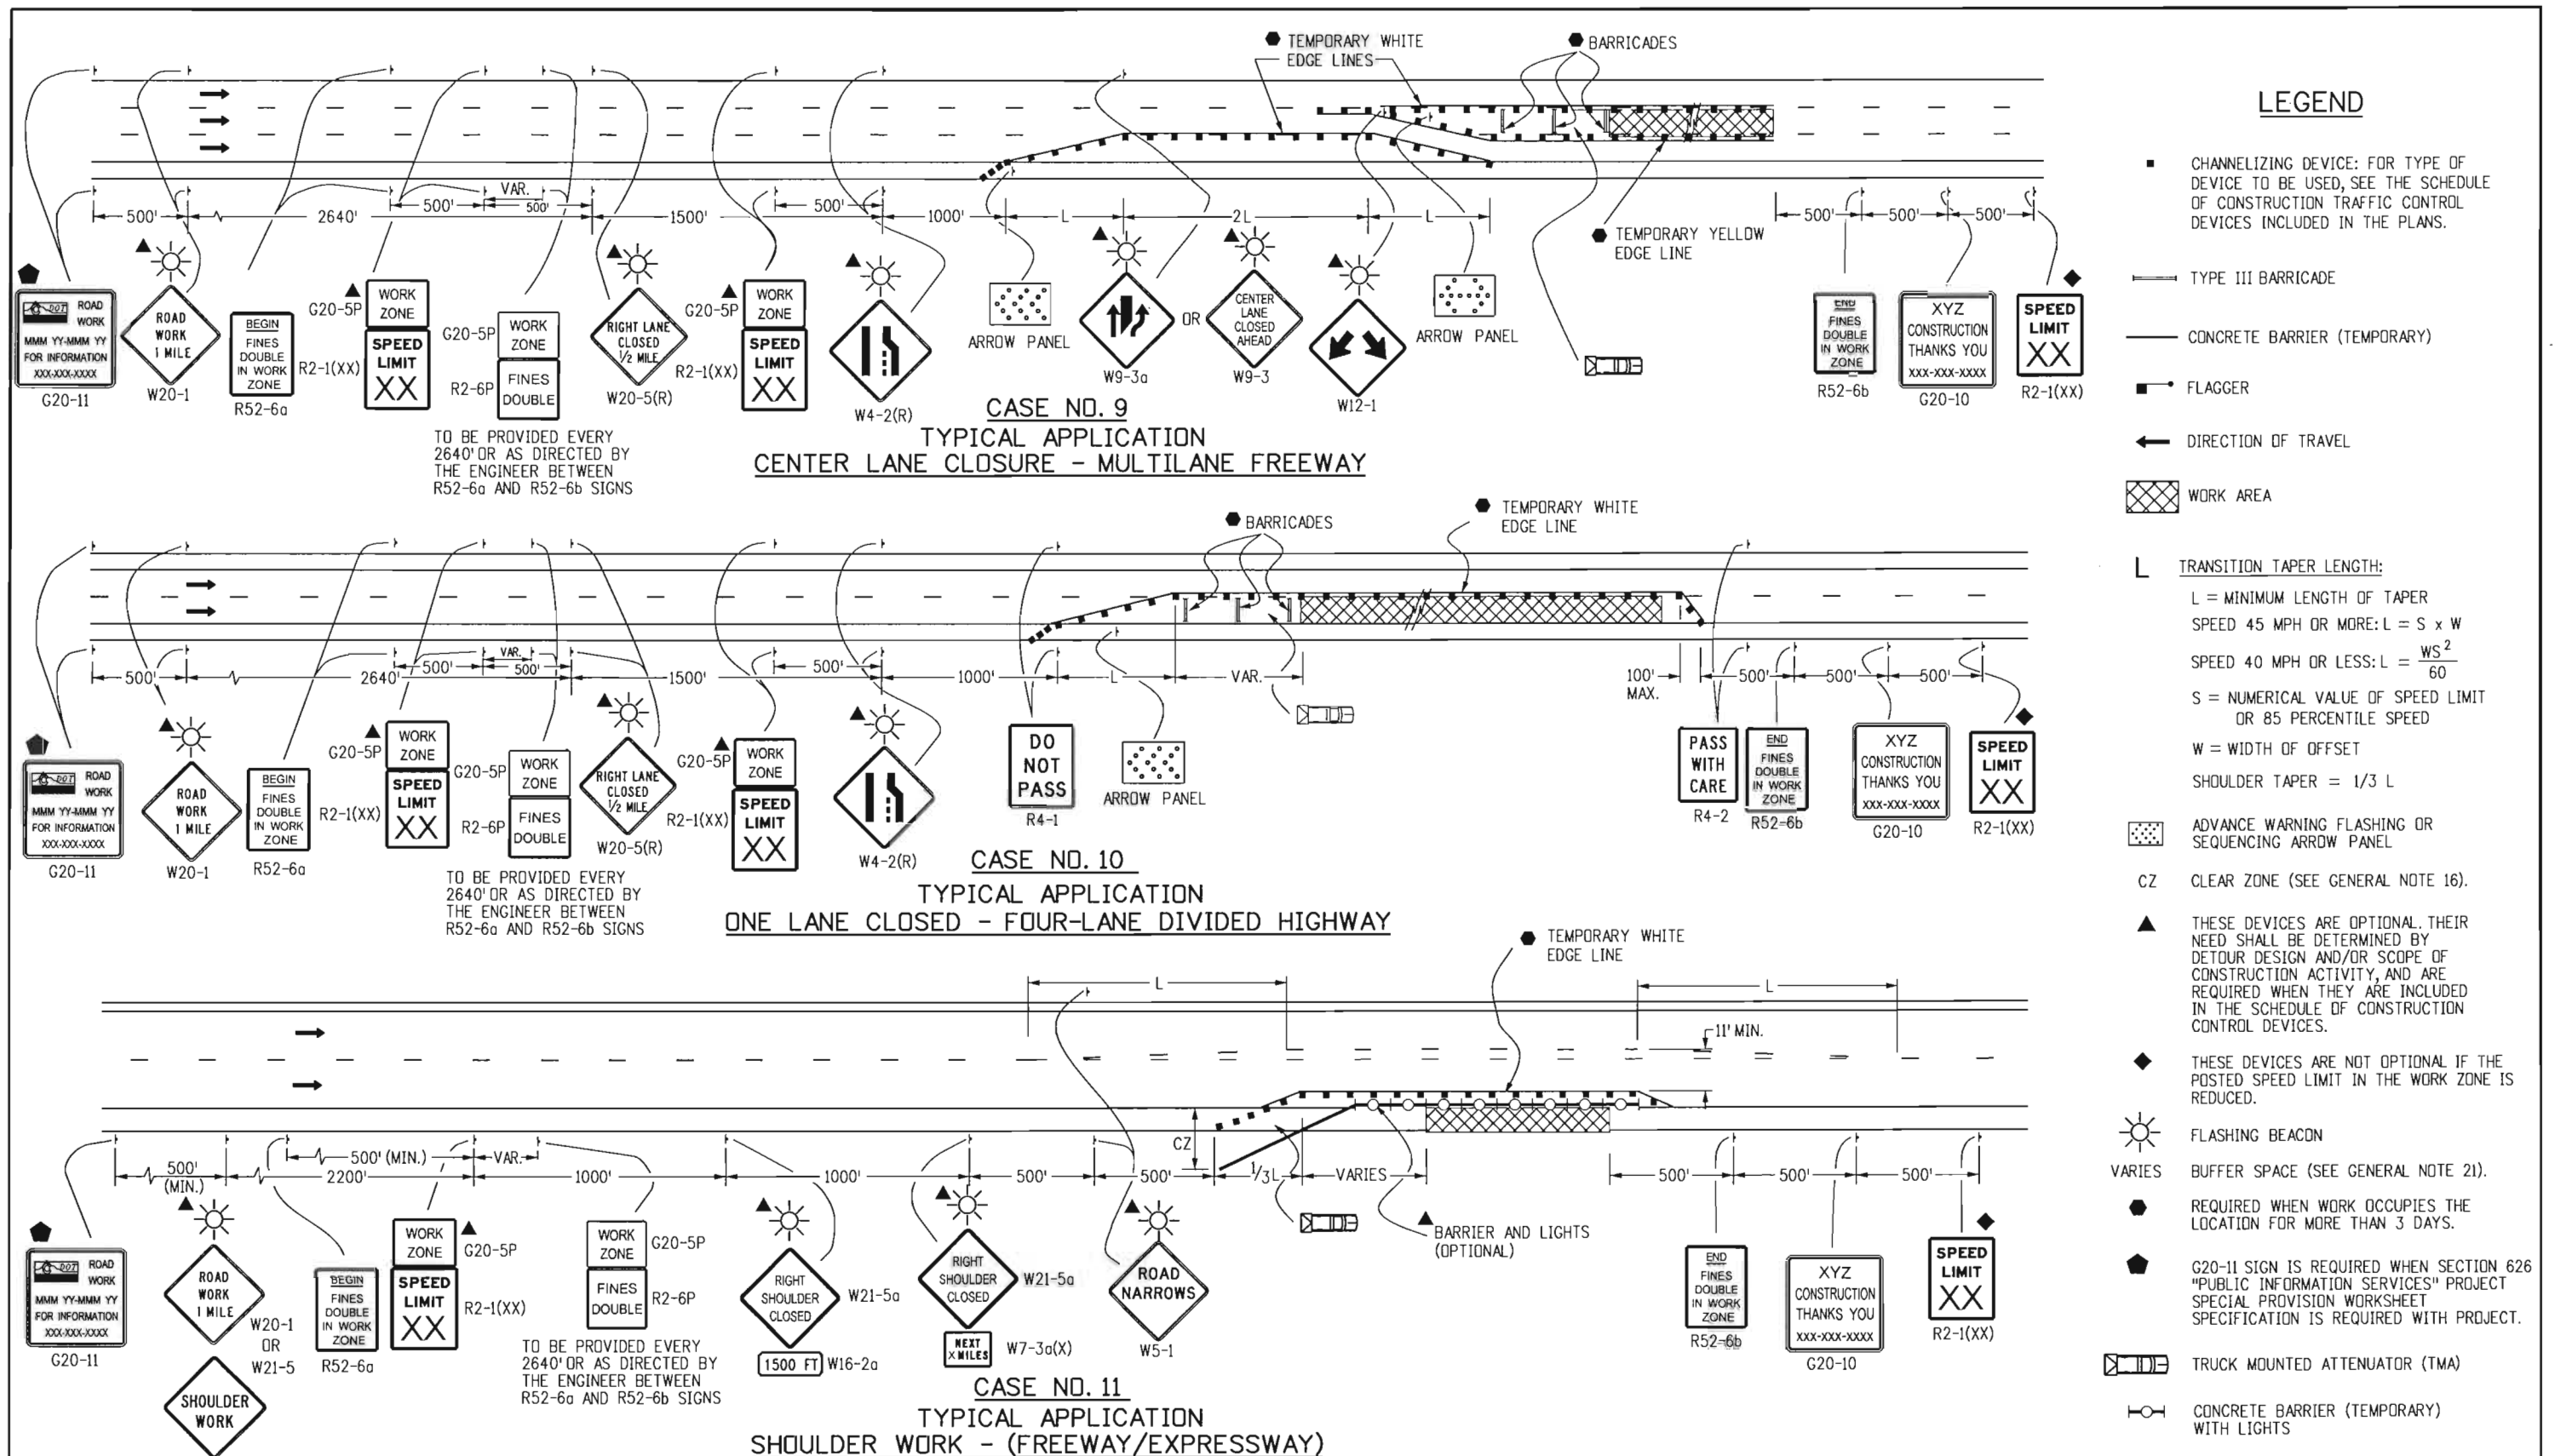


Computer File Information		Sheet Revisions		Colorado Department of Transportation 4201 East Arkansas Avenue Denver, Colorado 80222 Phone: (303) 757-9543 Fax: (303) 757-9458 Safety & Traffic Engineering Branch KCM/KEN	TRAFFIC CONTROLS FOR HIGHWAY CONSTRUCTION Issued By: Safety & Traffic Engineering Branch July 4, 2006	STANDARD PLAN NO. S-630-1 Sheet No. 6 of 19
Creation Date: 07/04/06	Initials: KCM	Date:	Comments			
Last Modification Date: 12/07/09	Initials: KEN	06/24/09	ADDED R52-6a, R52-6b & G20-5 SIGNS REVISED SHEET NUMBER TO 6 OF 18			
Full Path: www.coloradodot.info/library/traffic/traffic-s-standard-plans		06/24/09	ADDED OPTIONAL FLASHING BEACON TO ADVANCED WARNING SIGNS.			
Drawing File Name: S-630-01 (6of19).dgn		06/24/09	MINIMUM LANE WIDTH TO 11' AT WORK ZONE.			
CAD Ver.: MicroStation V8 Scale: Not to Scale Units: English		12/07/09	DELETED OPTIONAL SYMBOL FOR WORK ZONE SPEED LIMIT SIGN (R2-1XX) IN WORK ZONE. DELETED OPTIONAL SYMBOL FOR WORK ZONE SPEED LIMIT SIGN (R2-1XX) IN WORK ZONE. DELETED OPTIONAL SYMBOL FOR WORK ZONE SPEED LIMIT SIGN (R2-1XX) IN WORK ZONE.			

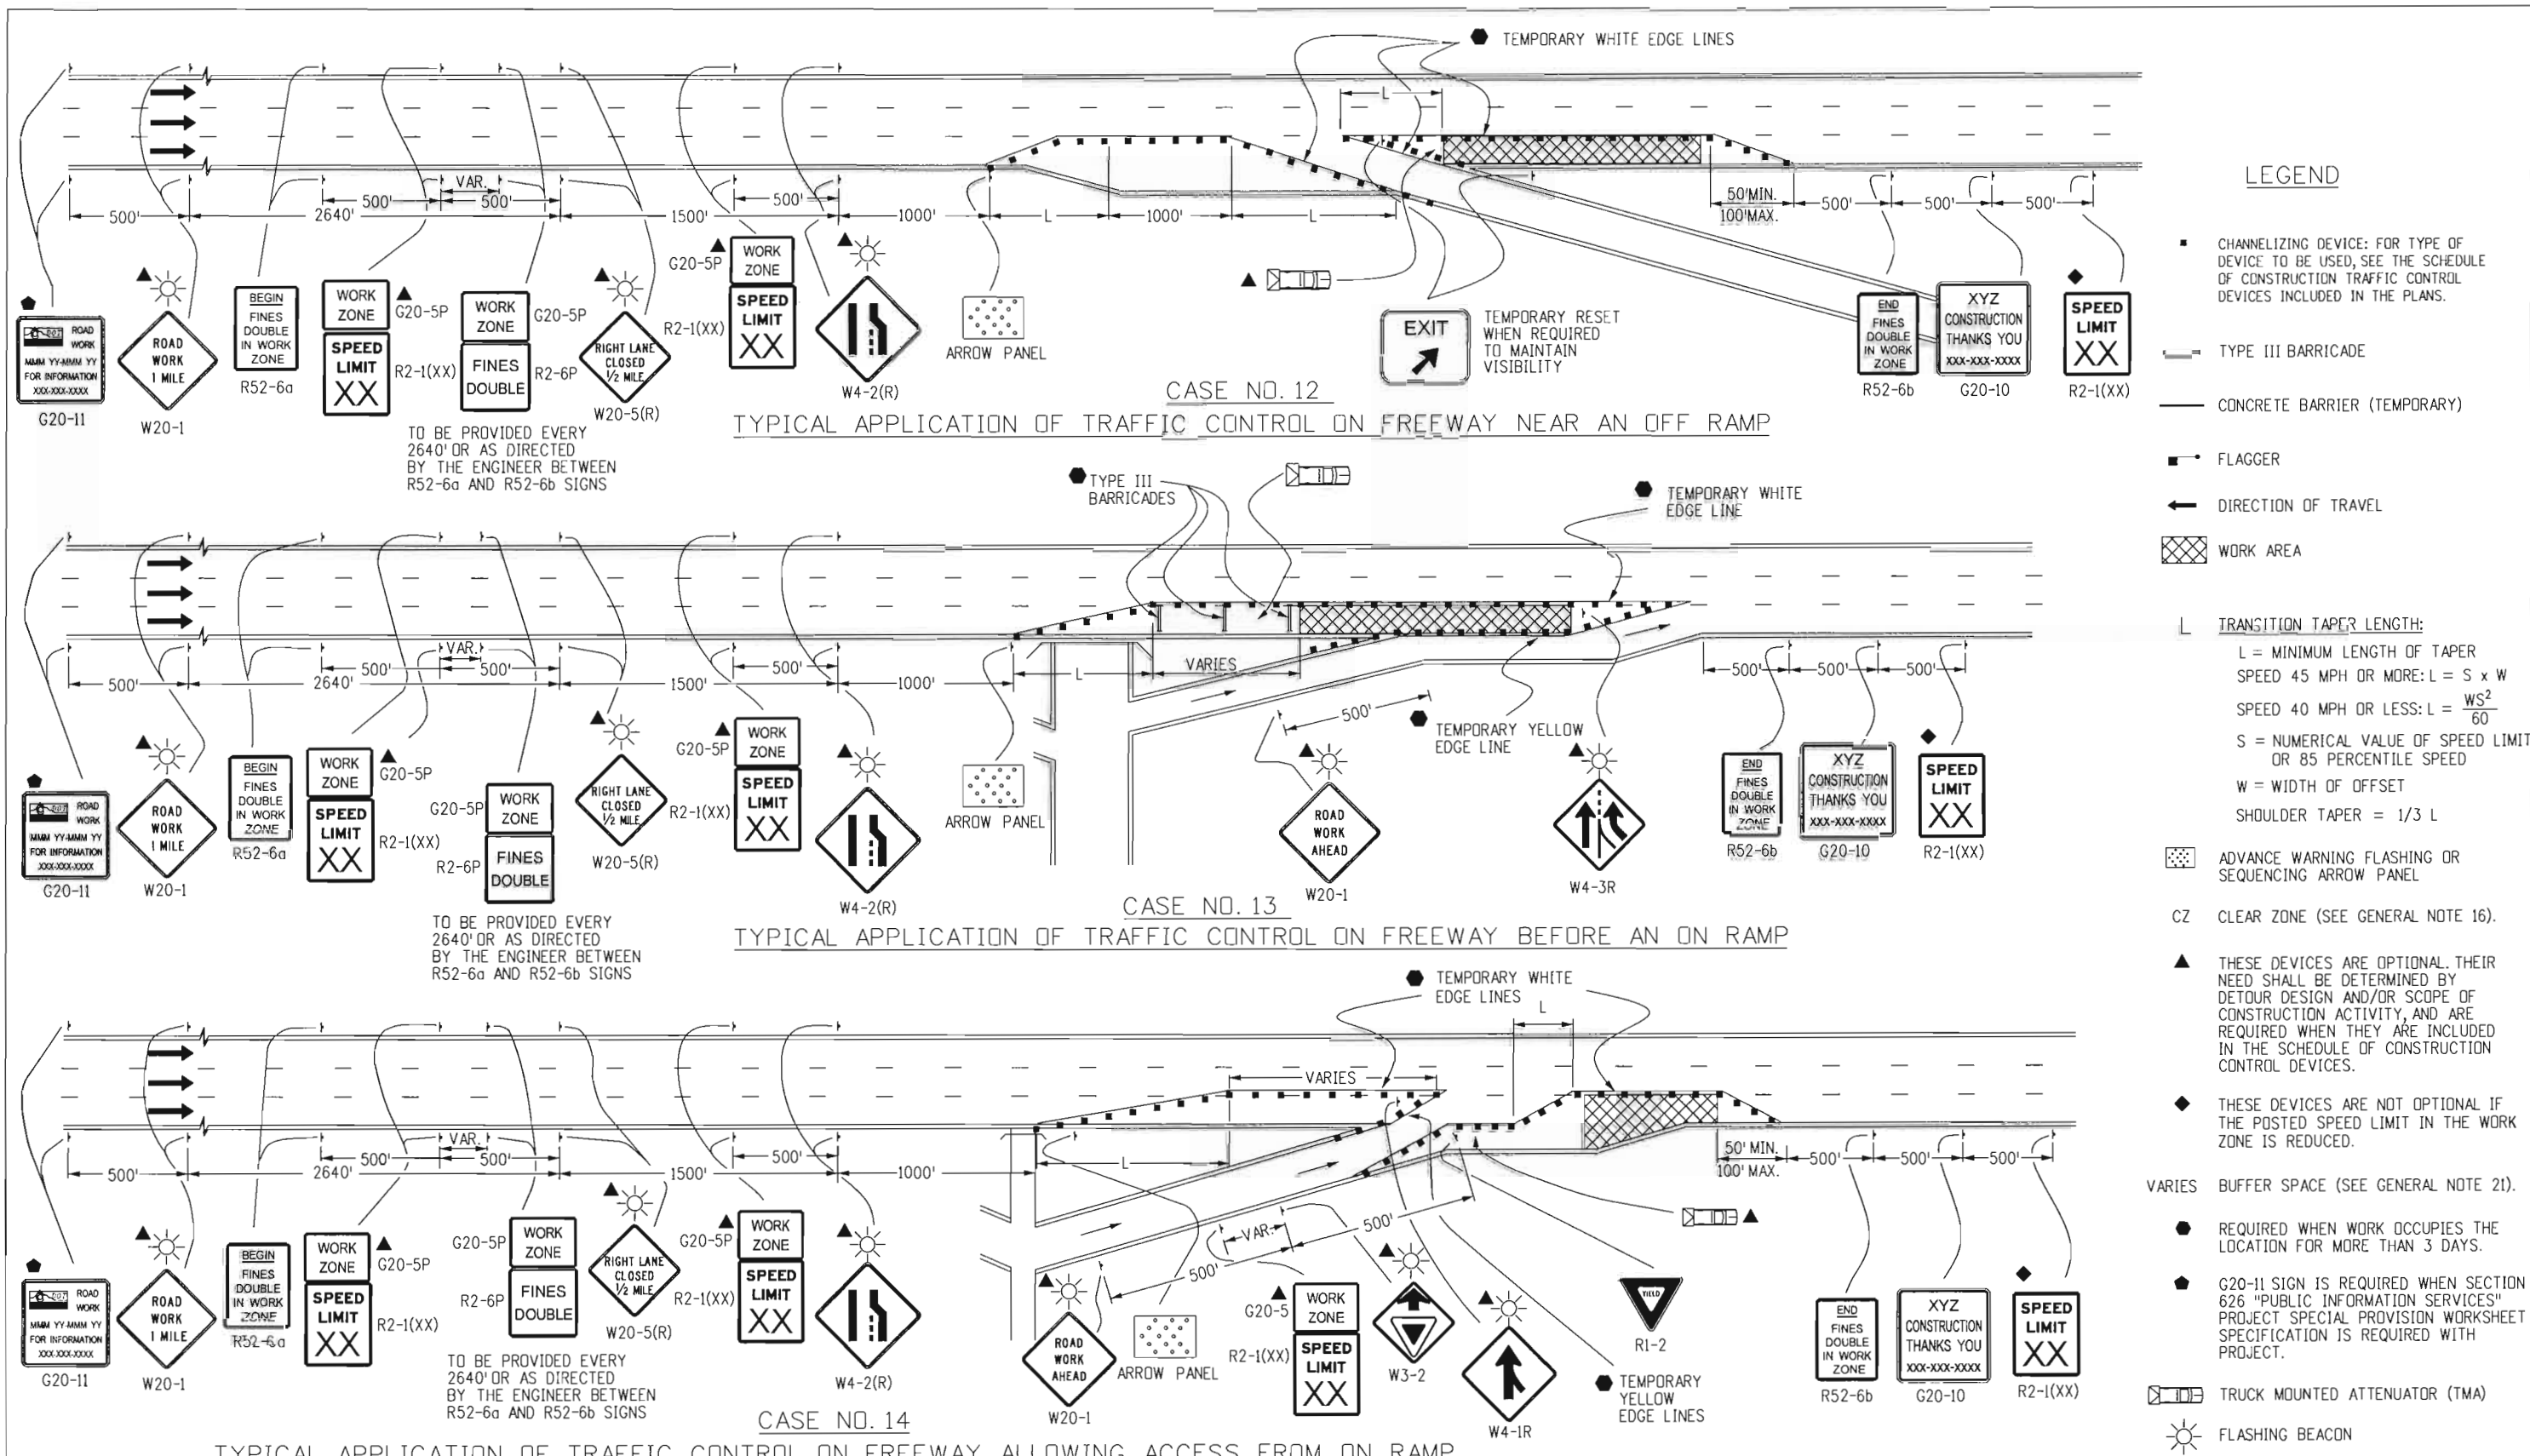


Computer File Information		Sheet Revisions		Colorado Department of Transportation		TRAFFIC CONTROLS FOR HIGHWAY CONSTRUCTION		STANDARD PLAN NO.		
Creation Date: 07/04/06	Initials: KCM	Date:	Comments	 4201 East Arkansas Avenue Denver, Colorado 80222 Phone: (303) 757-9543 Fax: (303) 757-9458	Safety & Traffic Engineering Branch	KCM/KEN	Issued By: Safety & Traffic Engineering Branch July 4, 2006		S-630-1	
Last Modification Date: 02/17/10	Initials: KEN	(R-2)	06/24/09							ADDED R52-6a, R52-6b & G20-5 SIGNS REVISED SHEET NUMBER TO 7 OF 19
Full Path: www.coloradodot.info/library/traffic/traffic-s-standard-plans		(R-2)	06/24/09							ADDED OPTIONAL FLASHING BEACONS TO ADVANCE WARNING SIGNS
Drawing File Name: S-630-01 (7of19).dgn		(R-3)	12/07/09							DELETED OPTIONAL SPEED LIMIT SIGN AND SPEED LIMIT SIGN

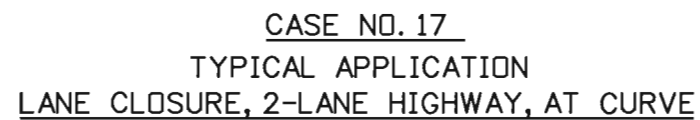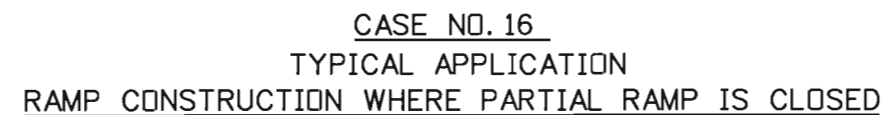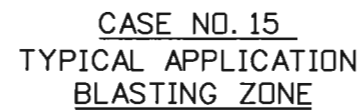

Sheet No. 8 of 19

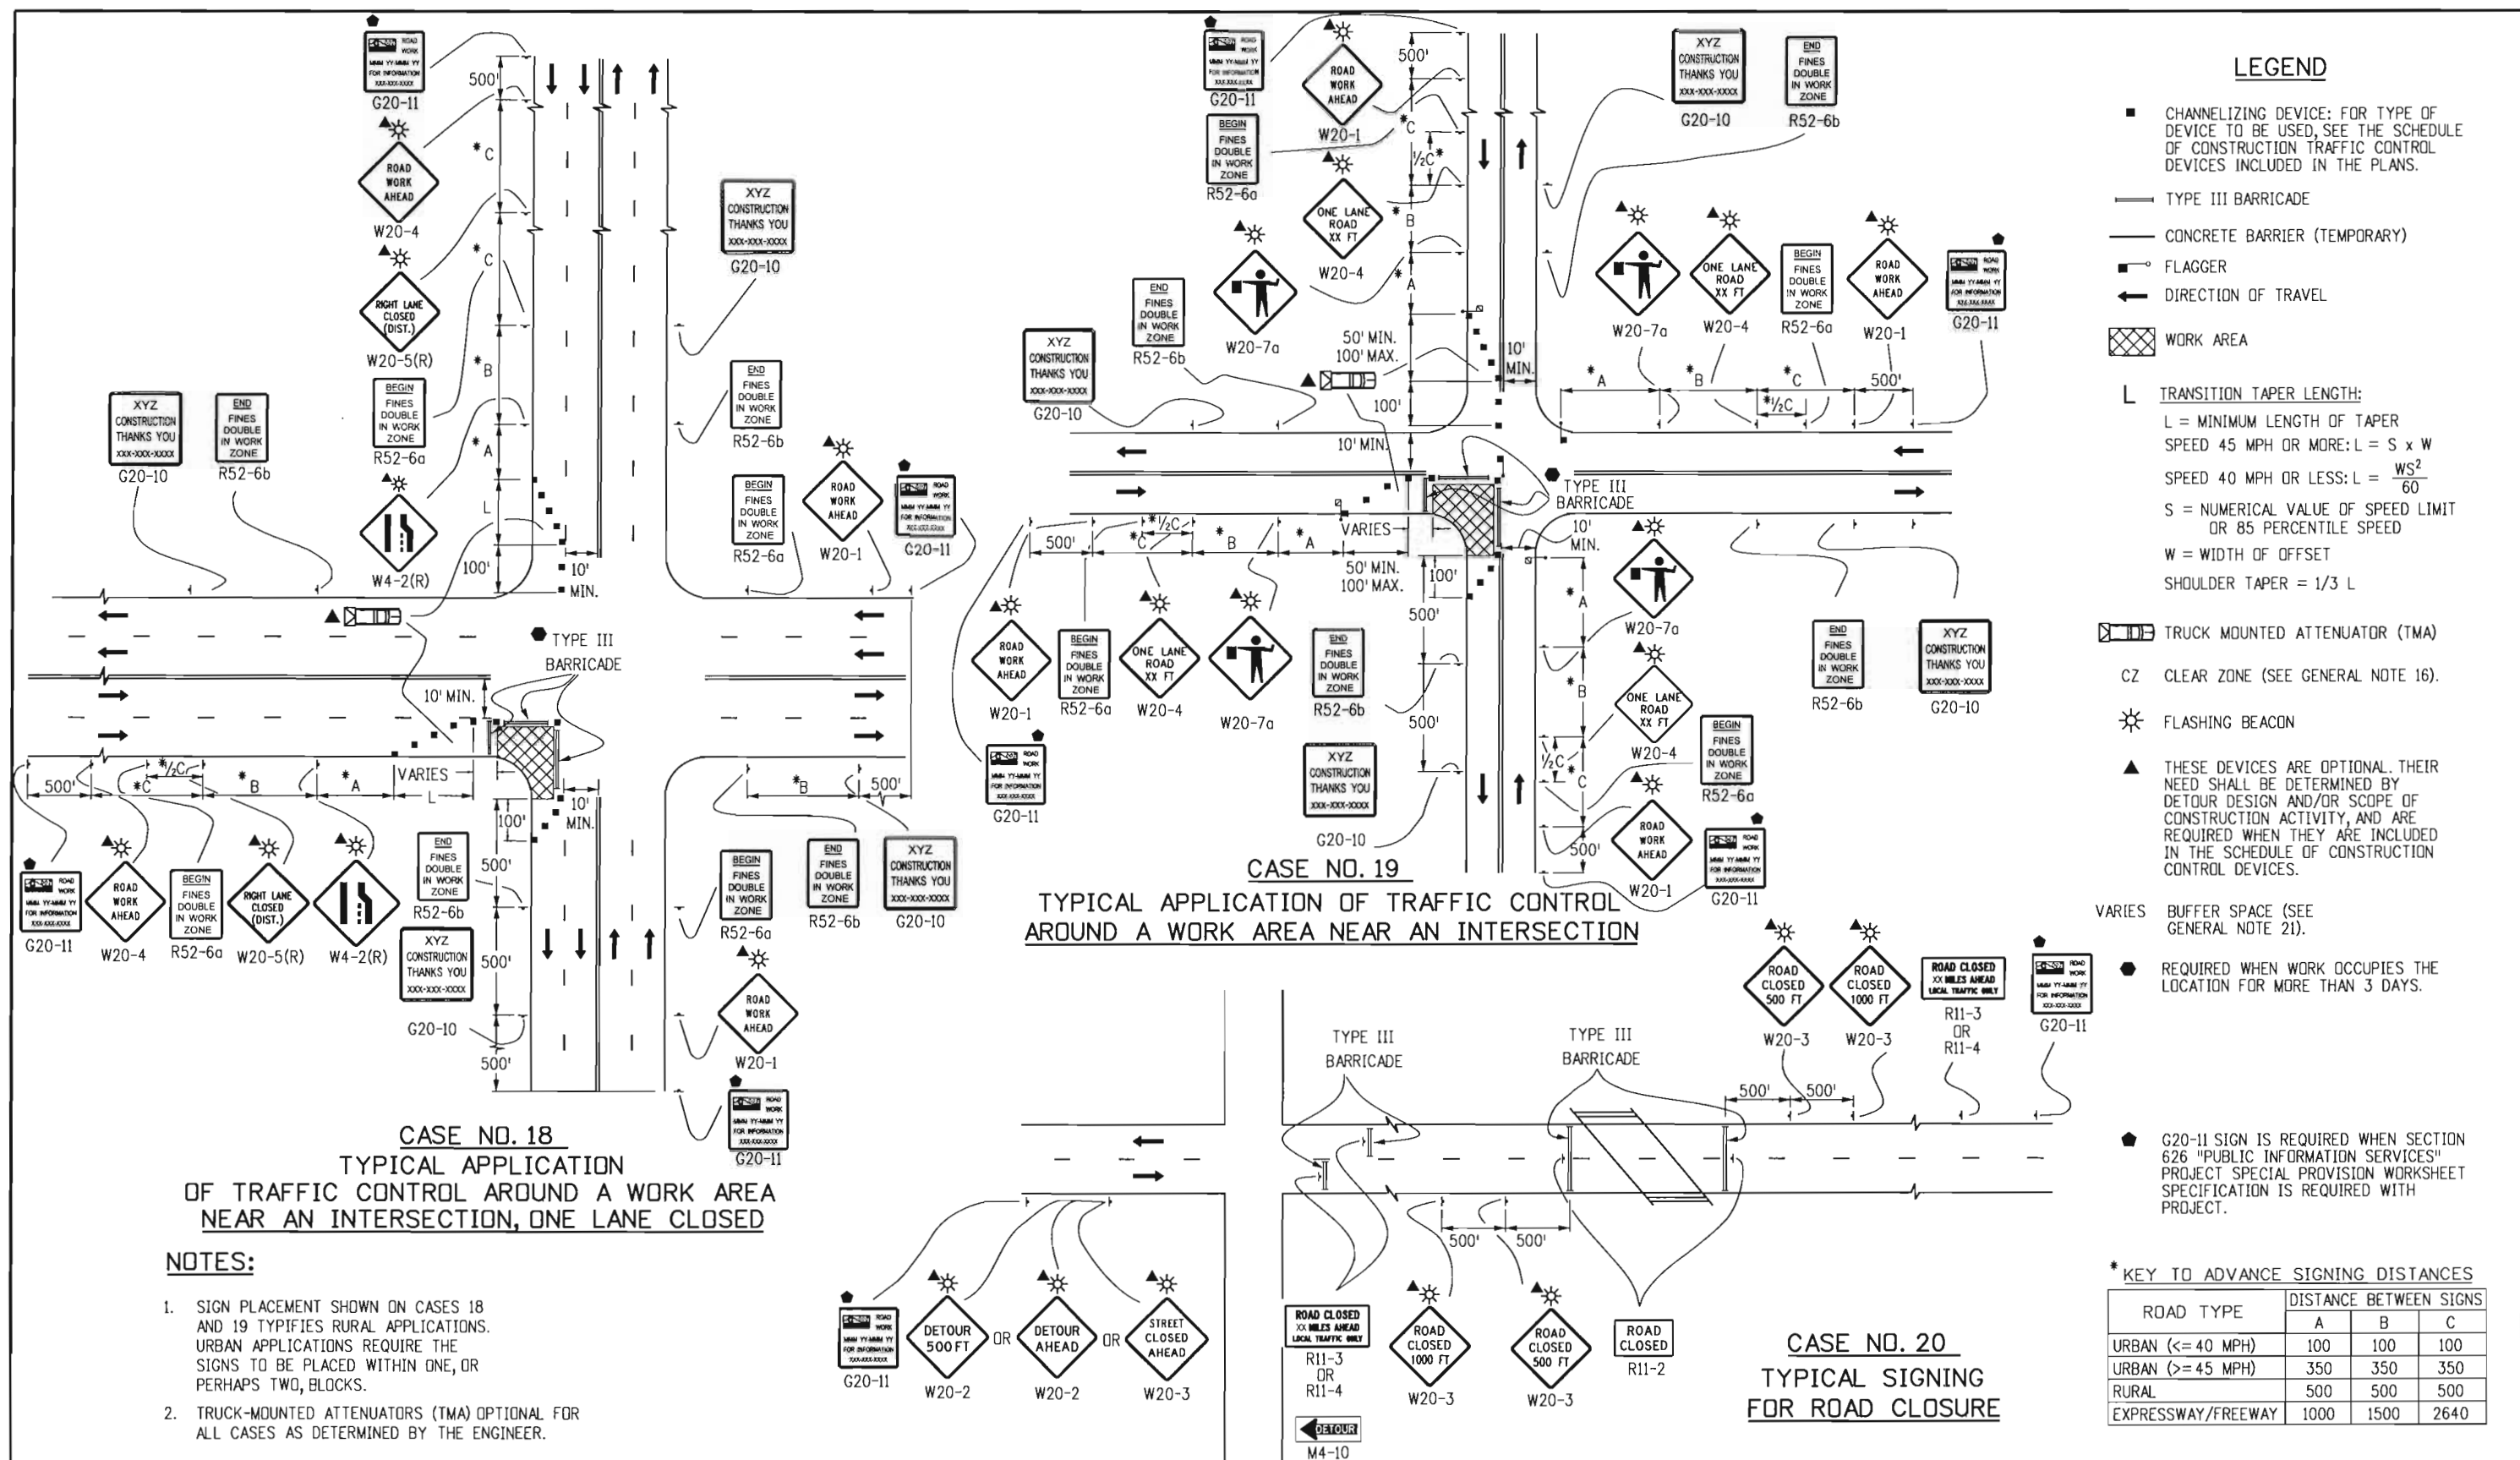

Computer File Information		Sheet Revisions		Colorado Department of Transportation	TRAFFIC CONTROLS FOR HIGHWAY CONSTRUCTION	STANDARD PLAN NO. S-630-1
Creation Date: 07/04/06	Initials: KCM	Date:	Comments			
Last Modification Date: 12/07/09	Initials: KEN	06/24/09	ADDED R52-6a, R52-6b & G20-5 SIGNS. REVISED SHEET # TO 9 OF 19.	<div> </div> 4201 East Arkansas Avenue Denver, Colorado 80222 Phone: (303) 757-9543 Fax: (303) 757-9458	Issued By: Safety & Traffic Engineering Branch July 4, 2006	Sheet No. 9 of 19
Full Path: www.coloradodot.info/library/traffic/traffic-standard-plans		12/07/09	ADDED NOTE 2 IN LEGEND. ADDED OPTIONAL FLASHING BEACON TO ADVANCED WARNING SIGNS. ADDED G20-11 SIGN AND @ SYMBOL/NOTE.			
Drawing File Name: S-630-01 (9of19).dgn				Safety & Traffic Engineering Branch	KCM/KEN	
CAD Ver.: MicroStation V8 Scale: Not to Scale Units: English						

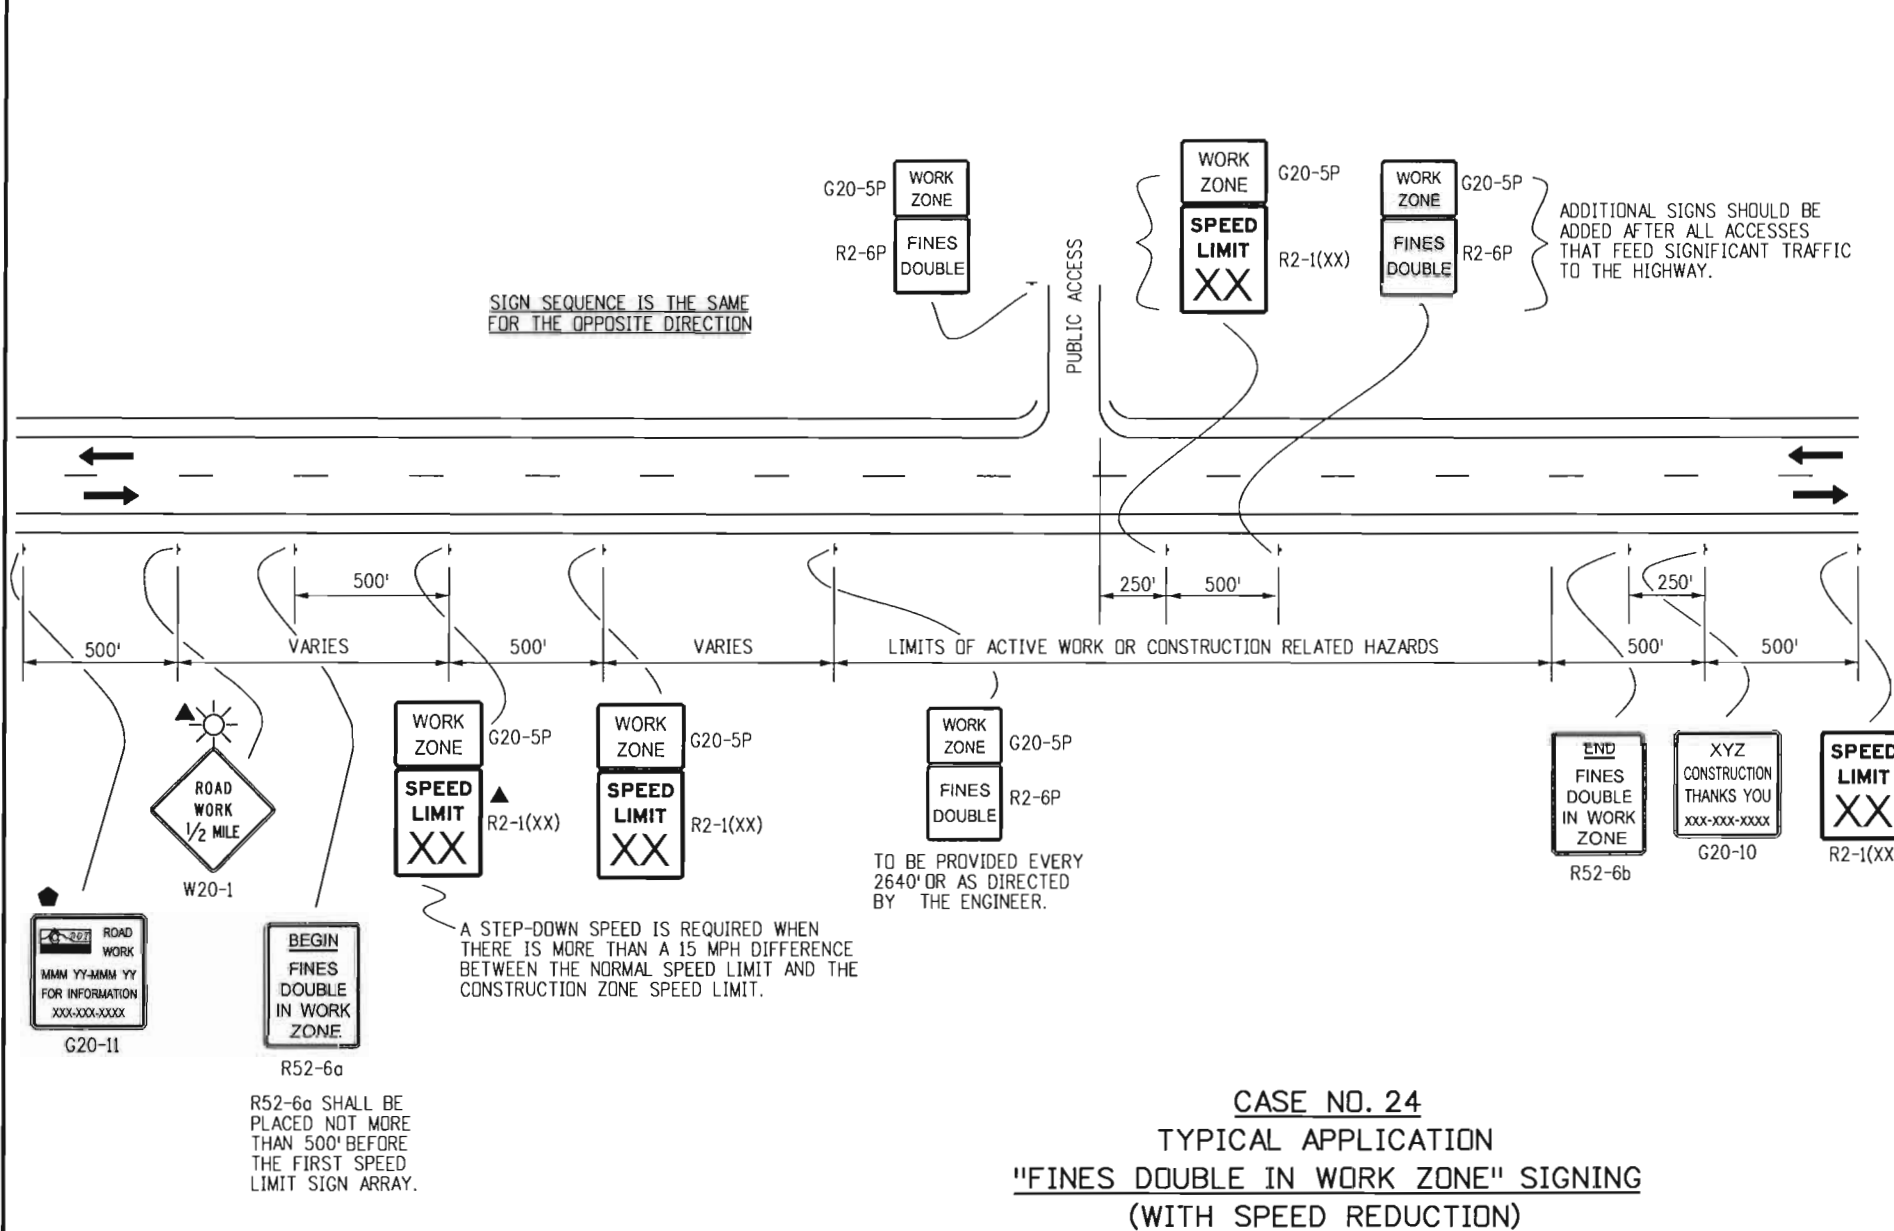

LEGEND

- ← DIRECTION OF TRAVEL
- ▲ THESE DEVICES ARE OPTIONAL. THEIR NEED WILL BE DETERMINED BY THE DESIGNER BASED ON DETOUR DESIGN AND/OR SCOPE OF THE CONSTRUCTION ACTIVITY, AND ARE REQUIRED WHEN THEY ARE INCLUDED IN THE PLANS.
- ◆ G20-11 SIGN IS REQUIRED WHEN SECTION 626 "PUBLIC INFORMATION SERVICES" PROJECT SPECIAL PROVISION WORKSHEET SPECIFICATION IS REQUIRED WITH PROJECT.
- ☀ FLASHING BEACON

DOUBLE FINES (SPEED REDUCTION) SIGNING NOTES:


- SIGNS SHALL NOT BE PLACED SOONER THAN FOUR HOURS BEFORE WORK IS TO BEGIN AND SHALL BE REMOVED AS SOON AS WORK ACTIVITIES ARE CONCLUDED, UNLESS POTENTIAL HAZARDS INTRODUCED AS A RESULT OF THE WORK ARE STILL PRESENT AT THE END OF THE WORK DAY. IF SIGNS ARE LEFT IN PLACE AFTER WORK ACTIVITIES, THE TRAFFIC CONTROL SUPERVISOR SHALL MAKE AN ENTRY IN THEIR DAILY DIARY THAT JUSTIFIES THEIR USE.

"HAZARDS" INCLUDE BUT ARE NOT LIMITED TO:

EDGE DROP OFFS
EQUIPMENT, WORKERS OR NON-SHIELDED OBJECTS IN THE CLEAR ZONE
ROUGH PAVEMENT
MAJOR CHANGE IN ALIGNMENT
REDUCED SHOULDER WIDTH
TEMPORARY GUARD RAIL OR BARRIER
LANE CLOSURE

- SIGNS SHALL ONLY BE PLACED WHERE WORKERS ARE PRESENT IN THE ROADWAY OR CLEAR ZONE OR ARE AT RISK, OR WHERE THERE ARE HAZARDS IN THE TRAVELWAY, SHOULDERS OR CLEAR ZONE.
- SIGNS SHOULD BE PLACED SO THAT MOTORISTS IMMEDIATELY ASSOCIATE THE SIGNS WITH PRESENT WORK ACTIVITIES. IF THE ZONE OF WORK ACTIVITY MOVES, THE SIGNS SHOULD BE MOVED ACCORDINGLY.
- SIGNING SHOWN IS REQUIRED TO ENFORCE DOUBLE FINES IN A WORK ZONE. ADDITIONAL SIGNING SHALL BE IN ACCORDANCE WITH THAT NORMALLY REQUIRED FOR THE PARTICULAR WORK ZONE. PLACEMENT OF "FINES DOUBLE" SIGNING MAY BE ADJUSTED AS NEEDED TO PROVIDE A MINIMUM 250' SPACING BETWEEN OTHER SIGNING REQUIRED FOR THE SPECIFIC WORK ZONE SETUP.

Computer File Information		Sheet Revisions		Colorado Department of Transportation		TRAFFIC CONTROLS FOR HIGHWAY CONSTRUCTION		STANDARD PLAN NO.					
Creation Date: 07/04/06	Initials: KCM	<div>R-2</div> <div>R-2</div> <div>R-3</div> <div></div>	Date:	Comments	<div> DEPARTMENT OF TRANSPORTATION</div> <div>4201 East Arkansas Avenue Denver, Colorado 80222 Phone: (303) 757-9543 Fax: (303) 757-9458</div>	Safety & Traffic Engineering Branch		KCM/KEN		Issued By: Safety & Traffic Engineering Branch July 4, 2006		S-630-1	
Last Modification Date: 12/07/09	Initials: KEN		06/24/09	DELETE CASE NO. 25 TYPICAL APPLICATION CHANGE SIZE OF G20-5 "WORK ZONE" PLAQUES REVISED SHEET NUMBER TO 11 OF 19. ADDED OPTIONAL FLASHING BEACON TO ADVANCED WARNING SIGN								Sheet No. 11 of 19	
Full Path: www.coloradodot.info/library/traffic/traffic-s-standard-plans			06/24/09										
Drawing File Name: S-630-01 (11of19).dgn			12/07/09	CHANGED NOTES HEADING TO "DOUBLE FINES (SPEED REDUCTION) SIGNING NOTES. ADDED G20-11 SIGN AND ☀ SYMBOL/NOTE.									
CAD Ver.: MicroStation V8	Scale: Not to Scale	Units: English											

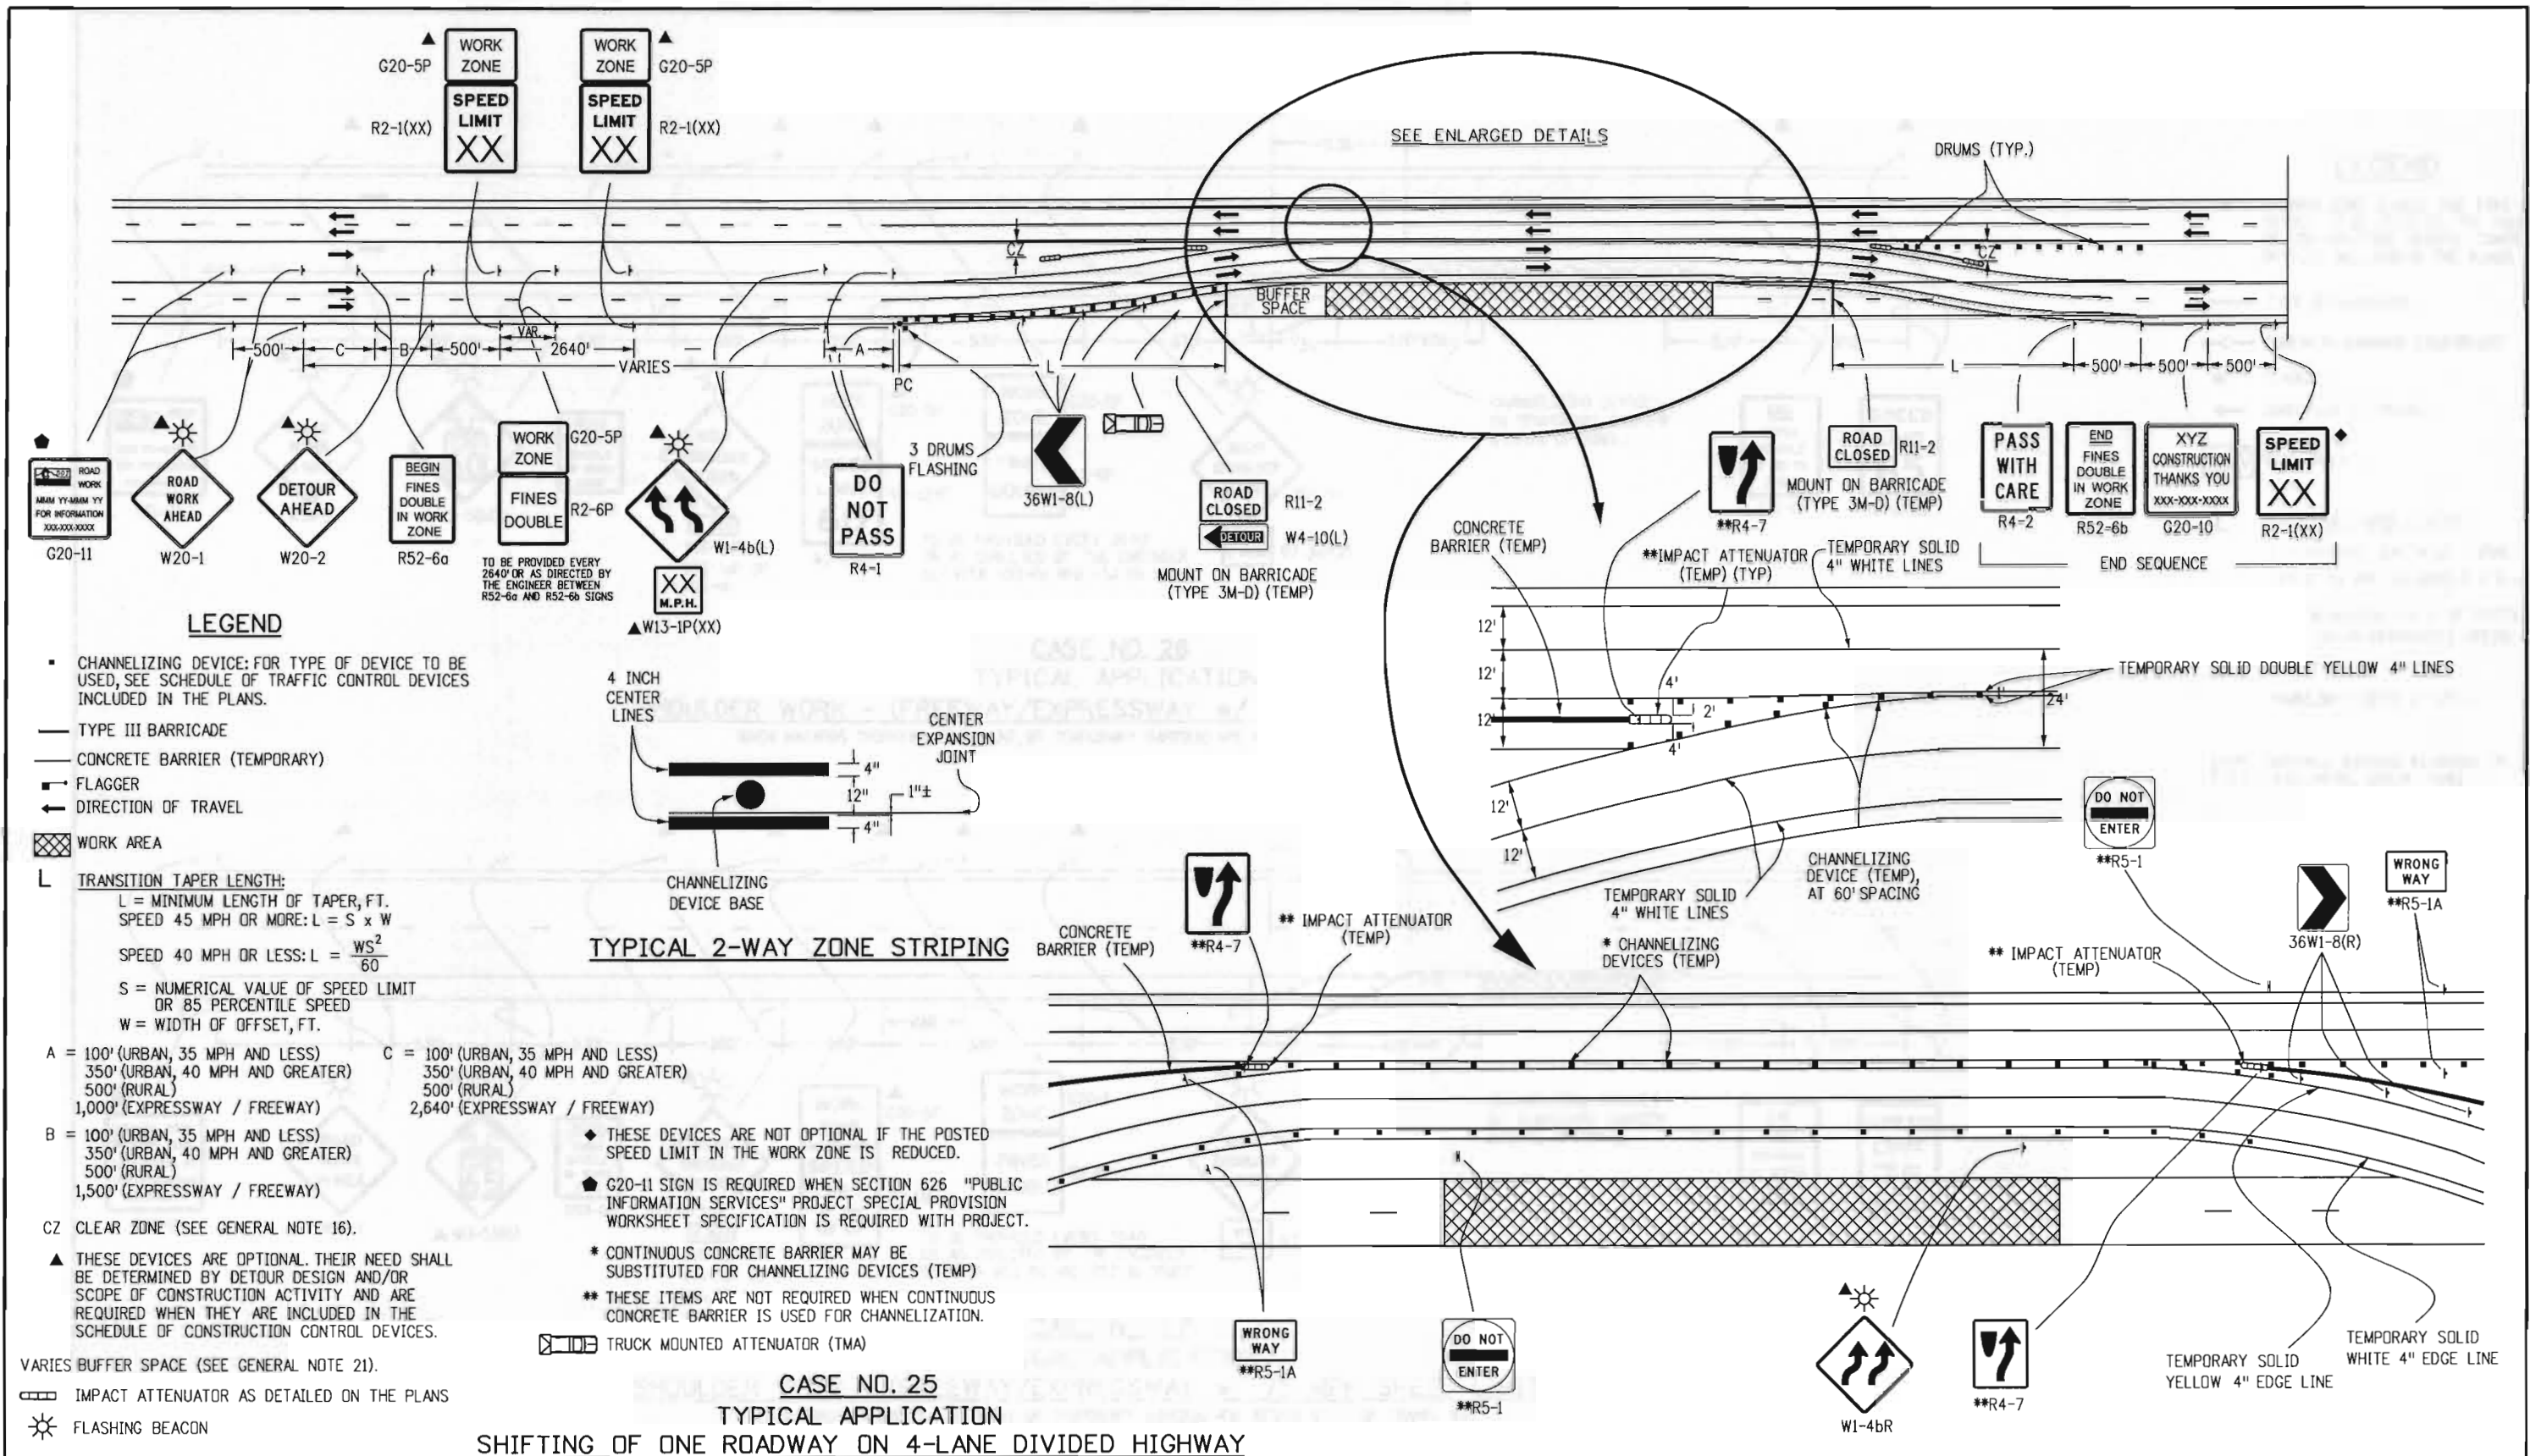

Computer File Information		Sheet Revisions		Colorado Department of Transportation	TRAFFIC CONTROLS FOR HIGHWAY CONSTRUCTION	STANDARD PLAN NO.
Creation Date: 06/24/09	Initials: KEN	Date:	Comments:			
Last Modification Date: 12/07/09	Initials: KEN	12/07/09	ADDED * SYMBOL IN SPEED LIMIT SIGN (R-20) AFTER R52-6b SIGN ADDED R2-1 & R20-5 PLACQUES BETWEEN R52-6b & R52-6b SIGNS ADDED G20-11 SIGN AND * SYMBOL NOTE DELETED (OPTIONAL * SYMBOL ON R2-10) SIGN SHOWN WORK ZONE	4201 East Arkansas Avenue Denver, Colorado 80222 Phone: (303) 757-9543 Fax: (303) 757-9219	Issued By: Safety & Traffic Engineering Branch June 24, 2009	S-630-1 Sheet No. 12 of 19
Full Path: www.coloradodot.info/library/traffic/traffic-s-standard-plans						
Drawing File Name: S-630-01 (12of19).dgn				Safety & Traffic Engineering Branch KCM/KEN		
CAD Ver.: MicroStation V8 Scale: Not to Scale Units: English						

THESE SIGNING NOTES ARE INTENDED AS A QUICK REFERENCE
FOR TYPICAL SIGN USE AND PLACEMENT IN CONSTRUCTION ZONES.

G20-1	"ROAD/WORK/NEXT XX MILES" - THIS SIGN SHALL BE ERECTED AT THE LIMITS OF ANY ROAD CONSTRUCTION OR MAINTENANCE PROJECT OF MORE THAN TWO (2) MILES IN LENGTH WHERE TRAFFIC IS MAINTAINED THROUGH THE PROJECT.
G20-4	"PILOT CAR/FOLLOW ME" - THIS SIGN SHALL BE MOUNTED IN A CONSPICUOUS POSITION ON THE REAR OF A VEHICLE USED FOR GUIDING ONE-WAY TRAFFIC THROUGH OR AROUND THE PROJECT.
G20-5P	"WORK ZONE" - THIS PLAQUE SHALL BE MOUNTED JUST ABOVE THE WORK ZONE SPEED LIMIT SIGNS PRIOR TO THE WORK ZONE AREA.
G20-10	"THANK YOU SIGN" - THIS SIGN SHOULD BE ERECTED APPROXIMATELY 500 FEET BEYOND THE END OF THE PROJECT.
G20-11	CONSTRUCTION PROJECT INFORMATION SIGN - THIS SIGN SHOULD BE ERECTED AS DESCRIBED IN THE SECTION 626 STANDARD SPECIFICATION.
G20-55(X)	"X MINUTE CLOSURE EXPECT DELAYS" - THIS SIGN IS INTENDED FOR USE 500 FEET PAST THE "WORK ZONE"/SPEED LIMIT SIGN.
M4-9()	"DETOUR/<<<<" - THIS SIGN IS USED FOR UNNUMBERED ROUTES; FOR USE IN EMERGENCY SITUATIONS; FOR PERIODS OF SHORT DURATION; OR WHERE, OVER RELATIVELY SHORT DISTANCES, IT IS NOT NECESSARY TO SHOW ROUTE MARKERS TO GUIDE TRAFFIC ALONG THE DETOUR AND BACK TO ITS AUTHORIZED ROUTE.
M4-10()	"DETOUR ARROW" - THIS SIGN SHOULD BE MOUNTED JUST BELOW THE ROAD CLOSED SIGN AT THE POINT WHERE THE DETOUR ROADWAY OR ROUTE HAS BEEN ESTABLISHED DUE TO THE CLOSURE OF THE STREET OR HIGHWAY TO THROUGH TRAFFIC.
R2-1()	"SPEED/LIMIT/XX" - THESE SIGNS ARE INTENDED TO REDUCE TRAFFIC SPEED IN ADVANCE OF THE DAILY WORK AREA WITHIN THE OVERALL PROJECT LIMITS.
R2-1(XX)	"SPEED/LIMIT/XX" - THIS SIGN IS INTENDED FOR USE 500 FEET PAST THE "THANK YOU" SIGN TO BRING TRAFFIC BACK TO ORIGINAL POSTED SPEED.
R2-6P	"FINES DOUBLE" - THIS SIGN IS INTENDED FOR USE WITHIN WORK ZONES TO PROVIDE NOTICE OF INCREASED FINES FOR TRAFFIC VIOLATIONS WITHIN WORK ZONES.
R4-1	"DO NOT PASS" - THIS SIGN SHOULD BE PLACED AT TRANSITION TAPER POINT.
R4-2	"PASS WITH CARE" - THIS SIGN SHOULD BE PLACED AT TRANSITION TAPER POINT.
R11-2	"ROAD/CLOSED" - THIS SIGN IS TO BE MOUNTED ON THE BARRICADE THAT IS PLACED BEFORE THE WORK ZONE ENTRANCE TO PROHIBIT TRAFFIC FROM ENTERING THE WORK ZONE.
R11-3	"ROAD CLOSED/X MILES AHEAD/L.T.O." - THIS SIGN SHOULD BE PLACED WHERE THROUGH TRAFFIC MUST DETOUR TO AVOID THE CLOSURE OF THE ROAD SOME DISTANCE BEYOND, BUT WHERE THE ROAD IS OPEN TO LOCAL TRAFFIC UP TO THE POINT OF CLOSURE.
R11-4	"ROAD CLOSED/TO/THRU TRAFFIC" FOR URBAN USE - THIS SIGN SHOULD BE PLACED WHERE THROUGH TRAFFIC MUST DETOUR TO AVOID THE CLOSURE OF THE ROAD SOME DISTANCE BEYOND, BUT WHERE THE ROAD IS OPEN TO LOCAL TRAFFIC UP TO THE POINT OF CLOSURE.
R52-6a	"BEGIN FINES DOUBLE IN WORK ZONE" SIGN IS PLACED AT THE BEGINNING OF THE ADVANCED WARNING AREA OF THE TRAFFIC CONTROL ZONE.
R52-6b	"END FINES DOUBLE IN WORK ZONE" SIGN IS PLACED AFTER WORK ZONE AREA, PAST DOWNSTREAM TAPER SECTION.
W1-1()	"TURN ARROW" - THIS SIGN IS INTENDED FOR USE WHERE ENGINEERING INVESTIGATIONS OF ROADWAY CONDITIONS SHOW THE RECOMMENDED SPEED ON THE TURN TO BE 30 MPH OR LESS.*
W1-2()	"CURVE ARROW" - THIS SIGN IS INTENDED FOR USE WHERE ENGINEERING INVESTIGATIONS OF ROADWAY CONDITIONS SHOW THE RECOMMENDED SPEED ON THE CURVE TO BE IN THE RANGE BETWEEN 30 AND 60 MILES PER HOUR.*
W1-3()	"REVERSE TURN ARROW" - THIS SIGN IS INTENDED FOR USE WHERE TWO TURNS OR THE CURVE AND A TURN IN OPPOSITE DIRECTIONS ARE SEPARATED BY A TANGENT OF LESS THAN 600 FEET.*
W1-4()	"REVERSE CURVE ARROW" - THIS SIGN IS INTENDED FOR USE WHERE TWO CURVES IN OPPOSITE DIRECTIONS ARE SEPARATED BY A TANGENT OF LESS THAN 600 FEET.*
W1-6()	"ARROW" - THIS SIGN SHOULD BE MOUNTED JUST BELOW THE ROAD CLOSED SIGN AT THE POINT WHERE THE DIVERSION HAS BEEN ESTABLISHED DUE TO THE LANE CLOSURE.
W3-2	"YIELD AHEAD" - THIS SIGN IS INTENDED FOR USE AT THE APPROACH TO THE YIELD SIGN THAT IS NOT VISIBLE FOR A SUFFICIENT DISTANCE TO PERMIT THE DRIVER TO BRING HIS VEHICLE TO A STOP AT THE YIELD SIGN.*
W3-4	"BE PREPARED TO STOP" - THIS SIGN TO BE PLACED 1.5 MILES IN ADVANCED OF A FLAGGER.
W4-2(X)	"LEFT (RIGHT) LANE TRANSITION SYMBOL" - THIS SIGN IS INTENDED FOR USE IN ADVANCE OF THE REDUCTION IN THE NUMBER OF TRAFFIC LANES IN THE DIRECTION OF TRAVEL ON THE MULTILANE HIGHWAY.*
W4-50	"USE BOTH LANES DURING CONGESTION" - THIS SIGN IS INTENDED FOR USE IN ADVANCE OF THE "ROAD WORK X MILE" ADVANCED WARNING SIGN.
W4-51	"USE BOTH LANES TO MERGE POINT" - THIS SIGN IS INTENDED TO DIRECT MOTORISTS TO USE BOTH TRAVEL LANES UNTIL THE LANES ARE REDUCED TO ONE LANE.
W4-52	"TAKE TURNS MERGE HERE" - THIS SIGN IS INTENDED TO WARN MOTORISTS IN ADVANCED TO MOVE FROM THE CLOSED TRAVEL LANE TO THE OPEN TRAVEL LANE, USUALLY 500 FEET IN ADVANCED OF THE START OF THE TRANSITION TAPER .
W5-1	"ROAD NARROWS" - THIS SIGN IS INTENDED FOR USE IN ADVANCE OF THE TRANSITION ON THE ROAD WHERE THE PAVEMENT WIDTH IS REDUCED ABRUPTLY TO A WIDTH SUCH THAT TWO CARS CANNOT PASS WITHOUT REDUCING SPEED.*
W5-2a	"NARROW BRIDGE SYMBOL" - THIS SIGN IS INTENDED FOR USE IN ADVANCE OF A BRIDGE OR CULVERT HAVING A CLEAR TWO-WAY ROADWAY WIDTH OF 16 TO 18 FEET OR ANY BRIDGE OR CULVERT HAVING A ROADWAY CLEARANCE LESS THAN THE WIDTH OF THE APPROACH PAVEMENT.*

TYPICAL CONSTRUCTION ZONE SIGNS

W5-3	"ONE LANE/BRIDGE" - THIS SIGN SHOULD BE PLACED ON TWO-WAY ROADWAYS IN ADVANCE OF THE BRIDGES OR CULVERTS WHERE THE ROADWAY WIDTH IS LESS THAN 16 FEET (18 FEET FOR COMMERCIAL VEHICLES) OR WHEN THE ALIGNMENT IS POOR ON THE APPROACH TO THE STRUCTURE HAVING A CLEAR ROADWAY WIDTH OF 18 FEET OR LESS.*
W6-1	"DIVIDED HIGHWAY SYMBOL" - THIS SIGN SHOULD BE PLACED ON THE APPROACHES TO THE SECTION OF HIGHWAY WHERE OPPOSING FLOWS OF TRAFFIC ARE SEPARATED BY A PHYSICAL MEDIAN.
W6-2	"DIVIDED HIGHWAY ENDS SYMBOL" - THIS SIGN SHOULD BE PLACED AT THE END OF THE SECTION OF PHYSICALLY DIVIDED HIGHWAY AS A WARNING OF TWO-WAY TRAFFIC AHEAD.
W6-3	"TWO-WAY TRAFFIC SYMBOL" - THIS SIGN IS INTENDED FOR USE TO GIVE WARNING OF TRANSITION FROM A SEPARATED ONE-WAY ROADWAY TO A TWO-WAY ROADWAY.*
W7-1	"HILL SYMBOL" - THIS SIGN SHOULD BE PLACED AT A POINT IN ADVANCE OF THE DOWNGRADE WHERE THE LENGTH, PERCENT OF GRADE, HORIZONTAL CURVATURE, OR OTHER PHYSICAL FEATURES REQUIRE SPECIAL CONSIDERATION ON THE PART OF DRIVERS.*
W8-1,W8-2	"BUMP"/"DIP" - THESE SIGNS ARE INTENDED FOR USE TO GIVE WARNING OF A SHARP RISE OR DEPRESSION IN THE PROFILE OF THE ROAD THAT IS SUFFICIENTLY ABRUPT TO AFFECT VEHICLE OPERATION OR CAUSE CONSIDERABLE DISCOMFORT TO PASSENGERS.*
W8-3a	"PAVEMENT ENDS SYMBOL" - THIS SIGN IS INTENDED FOR USE IN ADVANCE OF A POINT WHERE THE PAVEMENT SURFACE CHANGES FROM A HARD-SURFACED PAVEMENT TO THE LOW-TYPE SURFACE OR EARTH ROAD.*
W8-4	"SOFT SHOULDER" - THIS SIGN IS INTENDED FOR USE TO WARN OF A SOFT SHOULDER CONDITION THAT COULD PRESENT A PROBLEM TO VEHICLES THAT MAY GET OFF THE PAVEMENT.*
W8-5	"SLIPPERY WHEN WET SYMBOL" - THIS SIGN SHOULD BE PLACED IN ADVANCE OF THE CONDITION WHERE THE HIGHWAY SURFACE IS SLIPPERY BEYOND WHAT IS ORDINARY WHEN WET.*
W8-9a	"SHOULDER DROP-OFF" - THIS SIGN IS INTENDED FOR USE IN ADVANCE OF A SHOULDER DROP-OFF THAT EXCEEDS THREE INCHES IN HEIGHT.*
W8-11	"UNEVEN LANES" - THIS SIGN IS INTENDED FOR USE IN ADVANCE OF AN UNEVEN ADJACENT LANE SITUATION THAT EXCEEDS ONE INCH IN HEIGHT.*
W9-1()	"LEFT (RIGHT) LANE ENDS" - THIS SIGN IS INTENDED FOR USE IN ADVANCE OF THE PAVEMENT WIDTH TRANSITION SIGN (W4-2).
W9-2()	"LANE ENDS/MERGE LEFT (RIGHT)" - THIS SIGN IS INTENDED FOR USE AS A SUPPLEMENT TO THE PAVEMENT WIDTH TRANSITION SIGN (W4-2).
W9-3 OR W9-3a()	"CENTER LANE CLOSED AHEAD" - THIS SIGN SHOULD BE USED IN ADVANCE OF THE POINT WHERE WORK OCCUPIES THE CENTER LANE AND TRAFFIC IS DIRECTED TO THE RIGHT OR LEFT OF THE WORK ZONE.*
W12-1	"DOUBLE ARROW SYMBOL" - THIS SIGN SHOULD BE PLACED AT THE POINT OF THE OBSTRUCTION IN THE ROADWAY, WHERE TRAFFIC IS PERMITTED TO PASS ON EITHER SIDE OF THE OBSTRUCTION.
W12-2	"LOW CLEARANCE SYMBOL" - THIS SIGN IS INTENDED FOR USE IN ADVANCE OF AN OBSTRUCTION TO WARN VEHICLE OPERATORS OF CLEARANCES LESS THAN THE MAXIMUM VEHICLE HEIGHT PERMITTED PLUS 12 INCHES.*
W13-1P()	"ADVISORY SPEED PLAQUE" - THIS PLAQUE IS INTENDED TO SUPPLEMENT WARNING SIGNS ONLY AND SHALL NOT BE MOUNTED ALONE. IT IS USED TO INDICATE THE MAXIMUM RECOMMENDED SPEED FOR THE INDICATED CONDITION.
W13-3	"ADVISORY RAMP SPEED" - THIS SIGN IS TO BE POSTED TO INFORM MOTORISTS WHAT THE SUGGESTED SPEED LIMIT IS ON A RAMP.
W20-1	"ROAD/WORK/AHEAD" - THIS SIGN IS TO BE LOCATED IN ADVANCE OF THE INITIAL ACTIVITY OR DETOUR A DRIVER MAY ENCOUNTER, AND IS INTENDED TO BE USED AS A WARNING OF OBSTRUCTIONS OR RESTRICTIONS.
W20-2	"DETOUR/(DIST.)" - THIS SIGN IS INTENDED FOR USE IN ADVANCE OF THE POINT AT WHICH TRAFFIC IS DIVERTED OVER A TEMPORARY ROADWAY OR ROUTE.
W20-3	"ROAD/CLOSED/(DIST.)" - THIS SIGN IS INTENDED FOR USE IN ADVANCE OF A POINT AT WHICH A ROADWAY IS CLOSED TO ALL TRAFFIC OR TO ALL BUT LOCAL TRAFFIC.
W20-4	"ONE LANE/ROAD/(DIST.)" - THIS SIGN IS INTENDED FOR USE IN ADVANCE OF A POINT WHERE TRAFFIC IN BOTH DIRECTIONS MUST USE A SINGLE LANE.
W20-5()	"XXX LANE/CLOSED/(DIST.)" - THIS SIGN IS INTENDED FOR USE IN ADVANCE OF A POINT WHERE ONE LANE OF A MULTIPLE-LANE ROADWAY IS CLOSED. IT SHOULD BE PROVIDED WITH INTERCHANGEABLE PLAQUES READING "RIGHT", "LEFT", AND "CENTER" AT NO ADDITIONAL COST TO THE PROJECT.
W20-7a	"FLAGGER SYMBOL" - THIS SIGN IS INTENDED FOR USE IN ADVANCE OF ANY POINT AT WHICH A FLAGGER HAS BEEN STATIONED TO CONTROL TRAFFIC THROUGH OR AROUND THE PROJECT.*
W20-52	"GROOVED/PAVEMENT/AHEAD" - THIS SIGN IS INTENDED TO BE USED IN ADVANCE OF A ROADWAY THAT HAS BEEN GROOVED AND/OR ROTO MILLED.
W21-1a	"WORKER SYMBOL" - THIS SIGN IS INTENDED FOR USE IN CONJUNCTION WITH MINOR MAINTENANCE AND PUBLIC UTILITY OPERATIONS FOR THE PROTECTION OF MEN WORKING IN OR NEAR THE ROADWAY.
W21-2	"FRESH/OIL" - THIS SIGN IS INTENDED FOR USE WHERE RE-SURFACING OPERATIONS HAVE RENDERED THE SURFACE OF THE PAVEMENT TEMPORARILY WET, AND OBJECTIONABLE SPLASHING ON VEHICLES MAY OCCUR.*
W21-3	"ROAD/MACHINERY/AHEAD" - THIS SIGN IS INTENDED FOR USE IN ADVANCE OF THE AREAS WHERE HEAVY EQUIPMENT IS OPERATING IN OR ADJACENT TO THE ROADWAY.*

W21-4	"ROAD/WORK/(DIST.)" - THIS SIGN IS INTENDED FOR USE IN ADVANCE OF MAINTENANCE FOR MINOR RECONSTRUCTION OPERATIONS IN THE ROADWAY.
W21-5	"SHOULDER/WORK" - THIS SIGN IS INTENDED FOR USE IN ADVANCE OF THE PROJECT INVOLVING THE SHOULDER, WHERE THE TRAVELED WAY REMAINS UNOBSTRUCTED.
W21-6	"SURVEY/CREW" - THIS SIGN IS INTENDED FOR USE IN ADVANCE OF A POINT WHERE A SURVEYING CREW IS WORKING IN OR ADJACENT TO THE ROADWAY.*
W22-1	"BLASTING/ZONE/(DIST.)" - THIS SIGN IS INTENDED FOR USE IN ADVANCE OF ANY POINT OR WORK SITE WHERE THERE ARE EXPLOSIVES BEING USED. THE W22-2 AND W22-3 SIGNS MUST BE USED IN SEQUENCE WITH THIS SIGN.
W22-2	"TURN OFF/2-WAY RADIOS/AND/CELLULAR/PHONES" - THIS SIGN IS TO BE USED IN SEQUENCE WITH THE W22-1 AND W22-3 SIGNS AND PLACED AT LEAST 1000 FEET FROM THE BEGINNING OF THE BLASTING ZONE.
W22-3	"END/BLASTING/ZONE" - THIS SIGN IS TO BE USED TO DENOTE THE END OF THE RADIO INFLUENCE AREA AND SHALL BE PLACED A MINIMUM OF 1000 FEET FROM THE BLASTING ZONE, EITHER WITH OR PRECEDING THE END CONSTRUCTION SIGN.
W22-50(X)	"ROCK SCALING X MILE(S)" - THIS SIGN IS INTENDED TO BE USED IN ADVANCE OF A FLAGGER IN ADVANCED OF THE WORK ZONE AREA.

ADVANCE PLACEMENT OF WARNING SIGNS

POSTED OR 85TH PERCENTILE SPEED	+ CONDITION A	ADVANCE PLACEMENT DISTANCE (FEET)							
		++ CONDITION B: DECLARATION TO THE LISTED ADVISORY SPEED (MPH) FOR THE CONDITION							
		MPH							
		0	10	20	30	40	50	60	70
20	225	●	●	—	—	—	—	—	—
25	325	●	●	●	—	—	—	—	—
30	450	●	●	●	—	—	—	—	—
35	550	●	●	●	●	—	—	—	—
40	650	125	●	●	●	—	—	—	—
45	750	175	125	●	●	●	—	—	—
50	850	250	200	150	100	●	—	—	—
55	950	325	275	225	175	100	●	—	—
60	1100	400	350	300	250	175	●	—	—
65	1200	475	425	400	350	275	175	●	—
70	1250	550	525	500	425	350	250	150	—
75	1350	650	625	600	525	450	350	250	100

+ CONDITION A: SPEED REDUCTION AND LANE CHANGING IN HEAVY TRAFFIC. TYPICAL SIGNS ARE "MERGE" AND "RIGHT LANE ENDS".

++ CONDITION B: TYPICAL CONDITIONS ARE THE WARNING OF A POTENTIAL STOP SITUATION AND LOCATIONS WHERE THE ROAD USER MUST DECREASE SPEED TO MANEUVER THROUGH THE WARNED CONDITION. TYPICAL SIGNS ARE "STOP AHEAD", "SIGNAL AHEAD", "YIELD AHEAD", "CURVE", "REVERSE CURVE", "TURN".

● NO SUGGESTED DISTANCES ARE PROVIDED AT THESE SPEEDS, AS THE PLACEMENT IS DEPENDENT ON SITE CONDITIONS AND OTHER SIGNING.

A SUPPLEMENTAL PLAQUE MAY BE USED WITH WARNING SIGNS SPECIFYING THE DISTANCE TO THE CONDITION IF THERE IS AN IN-BETWEEN INTERSECTION THAT MIGHT CONFUSE THE MOTORIST.

* PLACEMENT SHOULD BE IN ACCORDANCE WITH WARNING SIGN PLACEMENT TABLE.

Computer File Information		Sheet Revisions		<div>Colorado Department of Transportation</div> <div> 4201 East Arkansas Avenue Denver, Colorado 80222 Phone: (303) 757-9543 Fax: (303) 757-9458</div> <div>Safety & Traffic Engineering Branch KCM/KEN</div>	TRAFFIC CONTROLS FOR HIGHWAY CONSTRUCTION		STANDARD PLAN NO.	
Creation Date: 07/04/06	Initials: KCM	Date:	Comments		S-630-1		Sheet No. 19 of 19	
Last Modification Date: 12/07/09	Initials: KEN	06/24/09	SHEET NO. CHANGED FROM 12 TO 19. ADDED NOTES FOR R52-6a, R52-6b, R52-6c, R52-6d, R52-6e, R52-6f, R52-6g, R52-6h, R52-6i, R52-6j, R52-6k, R52-6l, R52-6m, R52-6n, R52-6o, R52-6p, R52-6q, R52-6r, R52-6s, R52-6t, R52-6u, R52-6v, R52-6w, R52-6x, R52-6y, R52-6z, R52-7a, R52-7b, R52-7c, R52-7d, R52-7e, R52-7f, R52-7g, R52-7h, R52-7i, R52-7j, R52-7k, R52-7l, R52-7m, R52-7n, R52-7o, R52-7p, R52-7q, R52-7r, R52-7s, R52-7t, R52-7u, R52-7v, R52-7w, R52-7x, R52-7y, R52-7z, R52-8a, R52-8b, R52-8c, R52-8d, R52-8e, R52-8f, R52-8g, R52-8h, R52-8i, R52-8j, R52-8k, R52-8l, R52-8m, R52-8n, R52-8o, R52-8p, R52-8q, R52-8r, R52-8s, R52-8t, R52-8u, R52-8v, R52-8w, R52-8x, R52-8y, R52-8z, R52-9a, R52-9b, R52-9c, R52-9d, R52-9e, R52-9f, R52-9g, R52-9h, R52-9i, R52-9j, R52-9k, R52-9l, R52-9m, R52-9n, R52-9o, R52-9p, R52-9q, R52-9r, R52-9s, R52-9t, R52-9u, R52-9v, R52-9w, R52-9x, R52-9y, R52-9z, R52-10a, R52-10b, R52-10c, R52-10d, R52-10e, R52-10f, R52-10g, R52-10h, R52-10i, R52-10j, R52-10k, R52-10l, R52-10m, R52-10n, R52-10o, R52-10p, R52-10q, R52-10r, R52-10s, R52-10t, R52-10u, R52-10v, R52-10w, R52-10x, R52-10y, R52-10z, R52-11a, R52-11b, R52-11c, R52-11d, R52-11e, R52-11f, R52-11g, R52-11h, R52-11i, R52-11j, R52-11k, R52-11l, R52-11m, R52-11n, R52-11o, R52-11p, R52-11q, R52-11r, R52-11s, R52-11t, R52-11u, R52-11v, R52-11w, R52-11x, R52-11y, R52-11z, R52-12a, R52-12b, R52-12c, R52-12d, R52-12e, R52-12f, R52-12g, R52-12h, R52-12i, R52-12j, R52-12k, R52-12l, R52-12m, R52-12n, R52-12o, R52-12p, R52-12q, R52-12r, R52-12s, R52-12t, R52-12u, R52-12v, R52-12w, R52-12x, R52-12y, R52-12z, R52-13a, R52-13b, R52-13c, R52-13d, R52-13e, R52-13f, R52-13g, R52-13h, R52-13i, R52-13j, R52-13k, R52-13l, R52-13m, R52-13n, R52-13o, R52-61n, R52-61o, R52-61p, R52-61q, R52-61r, R52-61s, R52-61t, R52-61u, R52-61v, R52-61w, R52-61x, R52-61y, R52-61z, R52-62a, R52-62b, R52-62c, R52-62d, R52-62e, R52-62f, R52-62g, R52-62h, R52-62i, R52-62j, R52-62k, R52-62l, R52-62m, R52-62n, R52-62o, R52-62p, R52-62q, R52-62r, R52-62s, R52-62t, R52-62u, R52-62v, R52-62w, R52-62x, R52-62y, R52-62z, R52-63a, R52-63b, R52-63c, R52-63d, R52-63e, R52-63f, R52-63g, R52-63h, R52-63i, R52-63j, R52-63k, R52-63l, R52-63m, R52-63n, R52-63o, R52-63p, R52-63q, R52-63r, R52-63s, R52-63t, R52-63u, R52-63v, R52-63w, R52-63x, R52-63y, R52-63z, R52-64a, R52-64b, R52-64c, R52-64d, R52-64e, R52-64f, R52-64g, R52-64h, R52-64i, R52-64j, R52-64k, R52-64l, R52-64m,					