

Room 317 Grand Junction, CO 81501 Phone: 970-683-6236 FAX: 970-683-6227

SET EASEMENT

WC

SECONDARY CONTROL

MONUMENT

PERMANENT, PROPERTY, SLOPE, & UTILITY EASEMENT LINE (PROPOSED AND EXISTING)

WITNESS CORNER

N 10.13 E 3.81 EL 0.00

DENSIFICATION

CONTROL MONUMENT

TEMPORARY EASEMENT LINE (PROPOSED AND EXISTING)

PROPERTY BOUNDARY LINE (PROPOSED AND EXISTING)

BARRIER ACCESS CONTROL LINE (PROPOSED AND EXISTING)

VIRGIN RIGHT OF WAY LINE (PROPOSED AND EXISTING)

SURVEY/ROW

TERRAIN

ACCESS CONTROL LINE (PROPOSED AND EXISTING) — 111 —

RIGHT OF WAY LINE (PROPOSED AND EXISTING)

COUNTY LINE

SECTION LINE

STATE LINE

TOP OF CUT

TOE OF FILL

TOWNSHIP LINE

QUARTER SECTION LINE

SIXTEENTH SECTION LINE

JMK

| 4 | 1/ | • | |
|---|----|---|--|

 $\langle 1 \rangle$

MARKER

 \Diamond

SECTION CORNERS (TOPO POINTI)

⊙ USGS

USGS MARKER

ROW

RIGHT OF WAY MARKER

N 10.38 E 3.81 EL 0.00

HIGH ACCURACY REFERENCE

RIGHT OF WAY

TEMPORARY

EASEMENT POINT

PROPERTY PIN NOAA MARKER QUARTER AND SIXTEENTH

O NOAA

⊙ BM

BENCH MARK

Sheet Revisions

Note: For a complete listing of symbology used within this set of plans, please refer to the M-100-1 Standard Symbols of the Colorado Department of Transportation M&S Standards Publication. Existing topo

features are shown as screened weight (gray scale). Proposed or new

features are shown as full weight without screening, except as noted

with the word (proposed).

Revisions to 2.01, 5.01, 7.03 & 7.04 Revisions to 2.01, 7.04 & 8.01

 Date
 Description

 5/3/22
 Revisions to 2.01, 5.01, 7.03, 7.04 & 8.01

SURVWEST

 $\sqrt{1}$

SECTION CORNER

RIGHT OF WAY

INFORMATIONAL POIN

1/4 AND 1/16

CORNERS

BLM MARKER

⊖ FED

FEDERAL MONUMENT

LOCAL OR PLSS

MONUMENT

PROJECT CONTROL

6501 E. Belleview Ave. Suite 300 Englewood CO 80111 Tel: (720) 259-9323 SURVEY/MAPPING UTILITY/SUE REAL ESTAT

DEPARTMENT OF TRANSPORTATION STATE OF COLORADO

Sheet Revisions

Sheet Revisions

RIGHT OF WAY PLANS OF PROPOSED STATE PROJECT NO. NHPP 0502-090 US HIGHWAY NO. 50 **GUNNISON COUNTY**

> R.D.W. Length of Project = 0.7 Miles Const. Length of Project = 1.3 Miles

19 20 23 24 29 28 Begin Construction End Construction 26 TO GUNNISON. Station 111+94.81 Station 188+00.00 GUNNISON RIVER M.P.: 134.7 M.P.: 136.0 32 133 T49N.R4W T48N.R4W TO MONTROSE End Right-of-Way Begin Right-of-Way Station 131+19.23 T48N.R3W Station 165+76.97 M.P.: 135.1 M.P.: 135.8 0 10

PROJECT LOCATION MAP

6,000'

Scale: 1" = 6,000'

Lineal Units = U.S. Survey Feet

Right of Way Plans Title Sheet

Project Number: NHPP-0502-090

RADO LICENS

Visit D. GABI.

24662

6/15/2022

Project Location: US Highway 50 Passing Lanes

MP 134.6 to 136.0

SURVEYOR STATEMENT (ROW PLAN) I, Gary D Gable , a professional land surveyor licensed in the State of Colorado, do hereby state to the Colorado Department of Transportation that based upon my knowledge information and belief, the research, calculations and evaluation of the survey evidence were performed and this Right-of-Way Plan was prepared under my responsible charge in accordance with applicable standards of practice defined by Colorado Department of Transportation

This statement is not a guaranty or warranty, either expressed or implied.

Basis of Bearings: Bearings used in the calculations of coordinates are based on a grid bearing of S78°06'46"E from Point 1347, CM-MP 134.7 to Point 1360, CM-MP 136.0. Both monuments are CDOT Type II, marked appropriately for their milepost location and control position. The survey data was obtained from a Global Positioning System (GPS) survey base on the Colorado High Accuracy Reference Network (CHARN).

- 1. This Right-of-Way Plan is not a boundary survey of the adjoining property and is prepared for the Colorado Department of Transportation purposes for this project only
- 2. For title information, The Colorado Department of Transportation relied on Title Commitments prepared by First National Title Insurance Company.
- 3. This plan set is subject to change and may not be the most current set. It is the user's responsibility to verify with CDDT that this set is the most current. The information contained on the attached drawing is not valid unless this copy bears an original signature of the Professional Land Surveyor hereon named.

NOTICE: According to Colorado law you must commence any legal action based upon any defect in this survey within three years after you first discover such defect. In no event may any action based upon any defect in this survey be commenced more than ten years from the date of the certification shown hereon.

COLORADO DEPARTMENT OF TRANSPORTATION STATE HIGHWAY PROJECT

ROW PLANS AUTHORIZED:

06/30/22 DATE

Stephen Harelson

CDOT CHIEF ENGINEER

SHEET NO. INDEX OF SHEETS

(1) Title Sheet

(1) Tabulation of Properties

2.01 3.01-3.04 (4) Project Control/Land Survey Control Diagram

5.01

(1) Monumentation Sheet

(5) Plan Sheets

7.01-7.05 8.01-8.01

(1) Ownership Map

(13) Total Sheets

Scales of Original 11"x17" Drawings Plan Sheets 1"=100" Ownership Map 1"=500"

J... ATM... SURVEYS/RIGHT OF V DAY OF , 20______ OF THE COUNTY LAND SI______ . RECEPTION NU FILING CERTIFICATION:
DEPOSITED THIS ______
IN BOOK ________
SURVEYS AT PAGE _____



Colorado Department of Transportation

222 South 6th Street
Room 317
Grand Junction, CD 81501
Phone: 970-683-6236
FAX: 970-683-6227

JMK

JMK

| | 0 0 | | I | 0: : 0 ! ! | | 1 | 0: | | |
|---------|------------------------------------|----------|-----------------|-------------|----------|------|-----------------|----------|--|
| | Sheet Revisions | | Sheet Revisions | | | | Sheet Revisions | | |
| Date | Description | Initials | Date | Description | Initials | Date | Description | Initials | |
| 5/3/22 | Changed TE-2 to RW-2 | CCP | | | | | | | |
| 6/2/22 | Revised PE-1, PE-2, RW-2 & TE-3 | CCP | | | | | | | |
| 6/15/22 | Updated TE-3 Ownership Information | CCP | | | | | | | |
| | | | | | | | | | |
| | | | | | | | | | |
| | | | | | | | | | |
| | | | | | | | | | |



Right of Way Plans Tabulation of Properties

Project Number: NHPP-0502-090
Project Location: US Highway 50 Passing Lanes
MP 134.6 to 136.0

| | | | | | _ |
|-----|-----------|----------------|--------------|-----------|---|
| roj | ect Code: | Last Mod. Date | Subset | Sheet No. | |
| | 23557 | 02-11-2022 | 2.01 to 2.01 | 2.01 | Г |

| | | Ow | nership | Name an | d Mailin | a |
|---|---------|--|-------------------|-------------|----------|---|
| | | | R. | 0.W. | TAB | L |
| | | | | | | |
| S | URVWEST | Englewood Co Tel: (720) 259 SURVEY/MAPPING | O 80111 0-9323 | REAL ESTATE | | |

| | | | | | | | | | | -41. | | |
|------------|-----------------------------|--------------------------|--------------------------|-------------------|-----------------|-------------|-------------------|--------------------|-----------------|------------------|----------|---------------------------------------|
| ı | R.O.W. TABULA | ATION OF PROPERTIE | ES IN GUNNISON | COUNTY | U.S. | HWY 50 | (Aones) | | - Book and Page | Title | TE | |
| | Ownership Name and Mailing | Site Address | 1 | | | Square Feet | 1 | 1 | No. And/Or | Commitment No. | Duration | Purpose Of Parcel |
| Parcel No. | Address | Site Address | Location | Area Of Parcel | Existing ROW | Net Area | Remainder Left | Remainder Right | Reception No. | Committement No. | (Months) | |
| PE-1 | BEAR RANCH, LLC, A COLORADO | US HIGHWAY 50 | NW 1/4 OF SECTION 35, | 1,012 SQ.FT. | | | | | | 21-PT-20-1 | | PERMANENT EASEMENT FOR CONSTRUCTION C |
| | LIMITED LIABILITY COMPANY | EAST OF SAPINERO | T49N, R4W, N.M. P.M. | (0.023 AC.) | | | | | | 3/23/2022 | | ROADWAY IMPROVEMENTS AND MAINTENANCE |
| | 1601 FORUMPLACE, SUITE 307 | | | | | | | | | | | |
| | WEST PALMBEACH, FL 33401 | | | | | | | | | | | |
| TE-1 | (SAME AS ABOVE | (SAME AS ABOVE) | NE 1/4 OF SECTION 34 AND | 8,198 SQ.FT. | | | | | | (SAME AS ABOVE) | 1 YEAR | TEMPORARY EASEMENT FOR |
| | | | NW 1/4 OF SECTION 35, | (0.188 AC.) | | | | | | | | CONSTRUCTION OF ROADWAY IMPROVEMENTS |
| | | | T49N, R4W, N.M. P.M. | | | | | | | | | |
| PE-2 | TIMOTHY LEE CARTER AND | 15011 COUNTY ROAD 26 | NW 1/4 OF SECTION 35, | 2,441 SQ.FT. | | | | | | 21-PT-19-1 | | PERMANENT EASEMENT FOR CONSTRUCTION C |
| | CYNTHIA ROLLINS CARTER, | GUNNISON, CO 81230 | T49N, R4W, N.M. P.M. | (0.056 AC.) | | | | | | 3/23/2022 | | ROADWAY IMPROVEMENTS AND MAINTENANCE |
| | AS JOINT TENANTS | BLUE MESA RESERVOIR AREA | | | | | | | | | | |
| | 605 NORTH TAYLOR STREET | | | | | | | | | | | |
| | GUNNISON, CO 81230 | | | | | | | | | | | |
| RW-2 | (SAME AS ABOVE) | (SAME AS ABOVE) | (SAME AS ABOVE) | 24,829 SQ.FT. | | | | | | (SAME AS ABOVE) | | |
| | | | | (0.570 AC.) | | | | | | | | |
| TE-3 | BUREAU OF RECLAMATION | CURECANTI NATIONAL | NE 1/4 OF SECTION 35, | 6,801 SQ.FT. | | | | | | | 1-YEAR | TEMPORARY EASEMENT FOR |
| | 1849 C STREET NW | RECREATION AREA | T49N, R4W, N.M. P.M. | (0.156 AC.) | | | | | | | | CONSTRUCTION OF ROADWAY IMPROVEMENTS |
| | WASHINGTON, DC 20240 | NEAR BLUE MESA RESERVOIR | | | | | | | | | | |
| | | | | | | | | | | | | |
| | | | | | | | | | | | | |
| | | | | | | | | - | | | | |

Colorado Department of Transportation

222 South 6th Street Grand Junction, CD 81501 Phone: 970-683-6236 FAX: 970-683-6227

JMK

| | Sheet Revisions | | | Sheet Revisions | Sheet Revisions | | | |
|------|-----------------|----------|------|-----------------|-----------------|------|-------------|-----|
| Date | Description | Initials | Date | Description | Initials | Date | Description | Ini |
| | | | | | | | | |
| | | | | | | | | |
Region 3 SURVWEST

Englewood CO 80111 Tel: (720) 259-9323 SURVEY/MAPPING UTILITY/SUE REAL ESTATE

QUARTER, SIXTEENTH, SECTION CORNER SET EASEMENT RIGHT OF WAY TEMPORARY MONUMENT O NOAA QUARTER, SIXTEENTH, BLM MARKER PROPERTY PIN NOAA MARKER O FED WC WITNESS CORNER BENCH MARK USGS MARKER FEDERAL MONUMENT ⊡ LOCAL OR PLSS SECONDARY CONTROL RIGHT OF WAY MONUMENT [♠]N 10.13 **№**N 10.38 PROJECT CONTROL DENSIFICATION HIGH ACCURACY REFERENCE

CONTROL MONUMENT

Note: For a complete listing of symbology used within this set of plans, please refer to the M-100-1 Standard Symbols of the Colorado Department of Transportation M&S Standards Publication. Existing features are shown as screened weight (gray scale). Proposed or new features are shown as full weight without screening.



Typical Control Monument Cap Not to Scale



CM-MP - Control Point Monuments set by CDDT. They are CDDT Type 2 monuments, a $3\frac{1}{4}$ " dia. aluminum control monument cap (as shown) on a $3' \times \frac{3}{4}''$ dia. aluminum security rod on a $3' \times \frac{3}{4}''$ dia. smooth aluminum rod.


General Notes:


- 1. This Project Control/ Land Survey Control Diagram is not a boundary survey of the adjoining property and is prepared for the Colorado Department of Transportation purposes only.
- 2. This plan set is subject to change and may not be the most current set. It is the user's responsibility to verify with CDDT that this set is the most current. The information contained on the attached drawing is not valid unless this copy bears an original signature of the Professional Land Surveyor hereon named.
- 3. Refer to the M-629-1 Survey Monuments of the Standard Plans found in The Colorado Department of Transportation, M & S Standards for typical survey monument descriptions.


DEPARTMENT OF TRANSPORTATION STATE OF COLORADO

PROJECT CONTROL/LAND SURVEY CONTROL DIAGRAM

US Highway 50 MP 134.6 to 136.0 Sections 34 & 35 Townships 49 North, Range 4 West of the New Mexico Principal Meridian County of Gunnison

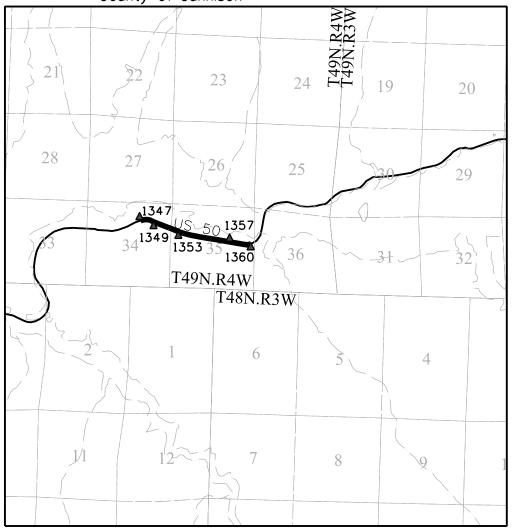

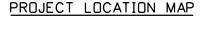

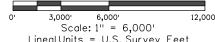

2/22/2022

Project/Land Survey Control Diagram Title Sheet

Project Number: NHPP-0502-090

Project Location: US Highway 50 Passing Lanes

MP 134.6 to 136.0

SURVEYOR STATEMENT (ROW PLAN) I, Gary D Gable , a professional land surveyor licensed in the State of Colorado, do hereby state to the Colorado Department of Transportation that based upon my knowledge information and belief, the research, calculations and evaluation of the survey evidence were performed and this Right-of-Way Plan was prepared under my responsible charge in accordance with applicable standards of practice defined by Colorado Department of Transportation

This statement is not a guaranty or warranty, either expressed or implied.

Basis of Bearings: Bearings used in the calculations of coordinates are based on a grid bearing of S78° 06'46"E from Point 1347, CM-MP 134.7 to Point 1360, CM-MP 136.0. Both monuments are CDDT Type II, marked appropriately for their milepost location and control position. The survey data was obtained from a Global Positioning System (GPS) survey base on the Colorado High Accuracy Reference Network (CHARN).

Basis of Elevations: Project elevations are based on Bench Mark R424 2020, PID: JL0507, a standard NGS bench mark stainless steel rod without sleve in well, with a NAVD 88 elevation of 7,607.04ft. R424 is a First order Class II benchmark.

CODRDINATE DATUM: Project coordinates are modified Colorado State Plane 0502 Zone NAD '83/(2011) coordinates. The combined elevation/scale factor used to modify the coordinates from state plane to project coordinates is of 1.000365063. The resulting project coordinates are truncated by

304,800.610 m in the Northing and 609,601.219 m in the Easting after converting from state plane coordinates to project coordinates. The CHARN is based on the NAD '83(2011) datum.

Project Coordinates Northing US Survey Feet = (State Plane Coordinate Northing * 1.000365063 - 304,800.610) * (3937/1200). Project Coordinates Easting US Survey Feet = (State Plane Coordinate Easting * 1.000365063 - 609.601.219) * (3937/1200).

SHEET NO. INDEX OF SHEETS

3.01-3.01 3.02-3.02

(1) Title Sheet (1) Coordinate Tables

3.03-3.04 (2) Plan Sheet

(4) Total Sheets

Lineal Units = U.S. Survey Feet

Colorado Department of Transportation 222 South 6th Street Room 317



222 South 6th Street Room 317 Grand Junction, CO 81501 Phone: 970-683-6236 FAX: 970-683-6227

JMK

| | Sheet Revisions | | Sheet Revisions | Sheet Revisions | | | | |
|------|-----------------|----------|-----------------|-----------------|----------|------|-------------|---------|
| Date | Description | Initials | Date | Description | Initials | Date | Description | Initial |
| | | | | | | | | |
| | | | | | | | | |
Project/Land Survey Control Diagram Coordinate Tables

Project Number: NHPP-0502-090

Project Location: US Highway 50 Passing Lanes
MP 134.6 to 136.0

 Project Code:
 Last Mod. Date
 Subset
 Sheet No.

 23557
 02-11-2022
 3.01 to 3.04
 3.02

SURVWEST

6501 E. Belleview Ave. Suite 300 Englewood CO 80111 Tel: (720) 259-9323 SURVEY/MAPPING UTILITY/SUE REAL ESTATE



| CHARN GEODETIC COORDINATE SUMMARY TABLE | | | | | | | | | | |
|---|----------------------|----------------------|-------------|------------------|---------------|-------------------|----------------|---------------|---|--|
| | Geodetic Coordinates | NAD-83(2011) (CHARN) | Elip Height | | Mapping Angle | | NAD 83(201 | 1) Zone 0502 | | |
| Point No. | Latitude(N) | Longitude(W) | (NAVD88)(m) | Ortho Height (m) | | Grid Scale Factor | SP Northing(m) | SP Easting(m) | Description | |
| MC05 | 38°44'22.38412" | 108°04'22.68418" | 1505.900 | 1522.820 | -1°37'21.9" | 0.9997194837 | 408564.70 | 690739.88 | NGS PID: DH6918 - NGS STATION "MESA CNTY 05" | |
| MC10 | 38°27'20.13742" | 107°52'42.39343" | 1809.455 | 1825.861 | -1°30'00.2" | 0.9997150721 | 376593.97 | 706820.32 | NGS PID: DL3585 - NGS STATION "MONTROSE CORS" | |
| R301 | 38°39'23.73971" | 107°35'27.36714" | 2025.011 | 2040.471 | -1°19'07.4" | 0.9996481890 | 398282.88 | 732421.64 | NGS PID: DL3478 - NGS STATION "CRAWFORD CORS" | |
| 35 RHM RESET | 38°26'21.12145" | 107°22'47.04432" | 2481.146 | 2495.894 | -1°11'07.9" | 0.9996129847 | 373754.53 | 750301.00 | USGS 3 1/2" BRASS CAP "35RHM 1955" | |
| N424 | 38°28'37.05657" | 107°13'41.67939" | 2287.959 | 2302.505 | -1°05'23.9" | 0.9996359467 | 377682.67 | 763604.17 | NGS 3 1/2" BRASS VERT CTL MARK "N424 1984" | |
| S424 | 38°27'35.60928" | 107°18'12.64398" | 2299.479 | 2314.107 | -1°08'14.8" | 0.9996373996 | 375916.00 | 756999.91 | NGS 3 1/2" BRASS VERT CTL MARK "S424 1984" | |
| R424 | 38°28'05.85500" | 107°16'53.96578" | 2304.034 | 2318.630 | -1°07'25.2" | 0.9996350702 | 376810.80 | 758925.36 | NGS STAINLESS STEEL ROD IN BOX "R 424 1984" | |



| | GEODETIC COORDINATE TABLE | | | | | | | | | | | |
|-----------|---------------------------|----------------------|-------------|--------------------------------|-------------------|-------------------|---------------|--------------|---|--|--|--|
| Point No. | Geodetic Coordinates | NAD-83(2011) (CHARN) | Elip Height | Outho Hoight (m) | | Cuid Coole Footen | NAD 83(201 | 1) Zone 0502 | | | | |
| Point No. | Latitude(N) | Longitude(W) | (NAVD88)(m) | Ortho Height (m) Mapping Angle | Grid Scale Factor | SP Northing(m) | SP Easting(m) | Description | | | | |
| 1347 | 38°28'05.20405" | 107°16'53.56554" | 2304.227 | 2318.823 | -1°07'25.0" | 0.9996350745 | 376790.54 | 758934.66 | FOUND CDOT TYPE II MONUMENT "CM-MP 134.7" | | | |
| 1349 | 38°28'05.54892" | 107°16'44.36840" | 2303.373 | 2317.966 | -1°07'19.2" | 0.9996351902 | 376796.80 | 759157.79 | FOUND CDOT TYPE II MONUMENT "CM-MP 134.9" | | | |
| 1353 | 38°27'57.70664" | 107°16'16.33823" | 2300.842 | 2315.430 | -1°07'01.5" | 0.9996360037 | 376541.76 | 759832.45 | FOUND CDOT TYPE II MONUMENT "CM-MP 135.3" | | | |
| 1357 | 38°27'54.36746" | 107°15'49.19880" | 2303.357 | 2317.939 | -1°06'44.4" | 0.9996357874 | 376426.02 | 760488.25 | FOUND CDOT TYPE II MONUMENT "CM-MP 135.7" | | | |
| 1360 | 38°27'51.63635" | 107°15'22.85607" | 2290.134 | 2304.711 | -1°06'27.8" | 0.9996380063 | 376329.45 | 761125.13 | FOUND CDOT TYPE II MONUMENT "CM-MP 136.0" | | | |



| | | PROJECT COORDINATE TABLE | | | | | | | | | | | |
|--------|-----------|--------------------------|-------------|----------|---|--|--|--|--|--|--|--|--|
| . [| Point No. | Project Co | ordinates | Elev(ft) | De coniuntion | | | | | | | | |
| | | Northing(ft) | Easting(ft) | (NAVD88) | Description | | | | | | | | |
| \sum | 1347 | 236638.25 | 490847.13 | 7607.67 | FOUND CDOT TYPE II MONUMENT "CM-MP 134.7" | | | | | | | | |
| _ | 1349 | 236658.80 | 491579.42 | 7604.86 | FOUND CDOT TYPE II MONUMENT "CM-MP 134.9" | | | | | | | | |
| | 1353 | 235821.74 | 493793.68 | 7596.54 | FOUND CDOT TYPE II MONUMENT "CM-MP 135.3" | | | | | | | | |
| | 1357 | 235441.87 | 495946.06 | 7604.77 | FOUND CDOT TYPE II MONUMENT "CM-MP 135.7" | | | | | | | | |
| | 1360 | 235124.93 | 498036.31 | 7561.37 | FOUND CDOT TYPE II MONUMENT "CM-MP 136.0" | | | | | | | | |



| | FOUND BOUNDARY MONUMENT COORDINATE TABLE | | | | | | | | | | |
|-----------|--|-------------|--|--|--|--|--|--|--|--|--|
| Point No. | Northing(ft) | Easting(ft) | Description | | | | | | | | |
| SA2793 | 235570.67 | 494289.07 | 2 1/2" AC POWERS ELEVATION CO INC LS# 30113 | | | | | | | | |
| SA2797 | 235319.20 | 495694.94 | 3 1/4" AC INTERIOR U.S DEPARTMENT A 133 1984 | | | | | | | | |
| SA2806 | 236497.97 | 491790.55 | 1 1/2" AC DEL-MONT 24299 | | | | | | | | |
| SA2812 | 236283.33 | 492352.59 | 1 1/2" AC DEL-MONT 24299 | | | | | | | | |



|] | | FC | OUND R.O.W. MO | NUMENT COORDINATE TABLE | | | | | |
|---|----------------------------|--------------|----------------|--|--|--|--|--|--|
| N | Point No. | Northing(ft) | Easting(ft) | Description | | | | | |
| | 4663 | 236672.71 | 492051.80 | 3 1/4" BC COLO. DEPT. OF HIGHWAYS STA. EL. R.O.W. MARKER | | | | | |
| | 4667 | 236590.23 | 490559.08 | 3 1/4" BC COLO. DEPT. OF HIGHWAYS STA. EL. R.O.W. MARKER | | | | | |
| | SA2775 | 234904.60 | 498319.79 | 3 1/4" BC STATE HIGHWAY DEPT ST. EL. R.O.W. MARKER | | | | | |
| | SA2777 | | | 3 1/4" BC STATE HIGHWAY DEPT ST. EL. R.O.W. MARKER | | | | | |
| | SA2780 | | | 3 1/4" BC STATE HIGHWAY DEPT ST. EL. R.O.W. MARKER | | | | | |
| | SA2782 | 235478.65 | 496446.90 | 3 1/4" BC STATE HIGHWAY DEPT ST. EL. R.O.W. MARKER | | | | | |
| | SA2784 | 235485.20 | 496245.32 | 3 1/4" BC STATE HIGHWAY DEPT ST. EL. R.O.W. MARKER | | | | | |
| | SA2786 | 235706.99 | 494846.71 | 3 1/4" BC STATE HIGHWAY DEPT ST. EL. R.O.W. MARKER | | | | | |
| | SA2788 | 236035.07 | 493651.96 | 3 1/4" BC STATE HIGHWAY DEPT ST. EL. R.O.W. MARKER | | | | | |
| | SA2795 235459.98 494807.43 | | 494807.43 | 3 1/4" BC STATE HIGHWAY DEPT ST. EL. R.O.W. MARKER | | | | | |
| | SA2801 236369.79 490675.88 | | | 3 1/4" BC STATE HIGHWAY DEPT ST. EL. R.O.W. MARKER | | | | | |
| | SA2810 | 236439.90 | 491958.93 | 3 1/4" BC STATE HIGHWAY DEPT ST. EL. R.O.W. MARKER | | | | | |




| FOUND ALIQUOT MONUMENT COORDINATE TABLE | | | | | | | | | |
|---|--------------|-------------|---|--|--|--|--|--|--|
| Point No. | Northing(ft) | Easting(ft) | Description | | | | | | |
| SA1007 | 234940.60 | 493070.87 | 3 1/4" AC T48N 1/4 34 35 R4W 1990 LS10738 * | | | | | | |
| SA1021 | 235043.94 | 487833.92 | 3 1/2" AC T49N R4W 1/4 33 34 1989 BLM CADASTRAL | | | | | | |
| SA1023 | 234766.16 | 498342.32 | 3 1/2" AC T49N 1/4 35 36 R4W LS 24299 1991 | | | | | | |
| SA2808 | 236293.11 | 491787.00 | 2" AC NE 1/16 34 DEL-MONT LS 24299 | | | | | | |


^{*} Survey Monument Cap is mismarked as T48N in the field. Actual Townswhip is 49 North.

CODRDINATE DATUM: Project coordinates are modified Colorado State Plane Central Zone NAD '83/(2011) coordinates. The combined elevation/scale factor used to modify the coordinates from state plane to project coordinates is 1.000365063. The resulting project coordinates are truncated by 304,800.610 meters in the Northing and 609,601.219 meters in the Easting after converting from state plane coordinates to project coordinates. The CHARN is based on the NAD '83(2011) datum.

Project Coordinates Northing US Survey Feet = (State Plane Coordinate Northing * 1.000365063 - 304,800.610) * (3937/1200).

Project Coordinates Easting US Survey Feet = (State Plane Coordinate Easting * 1000365063 - 609,601.219) * (3937/1200).

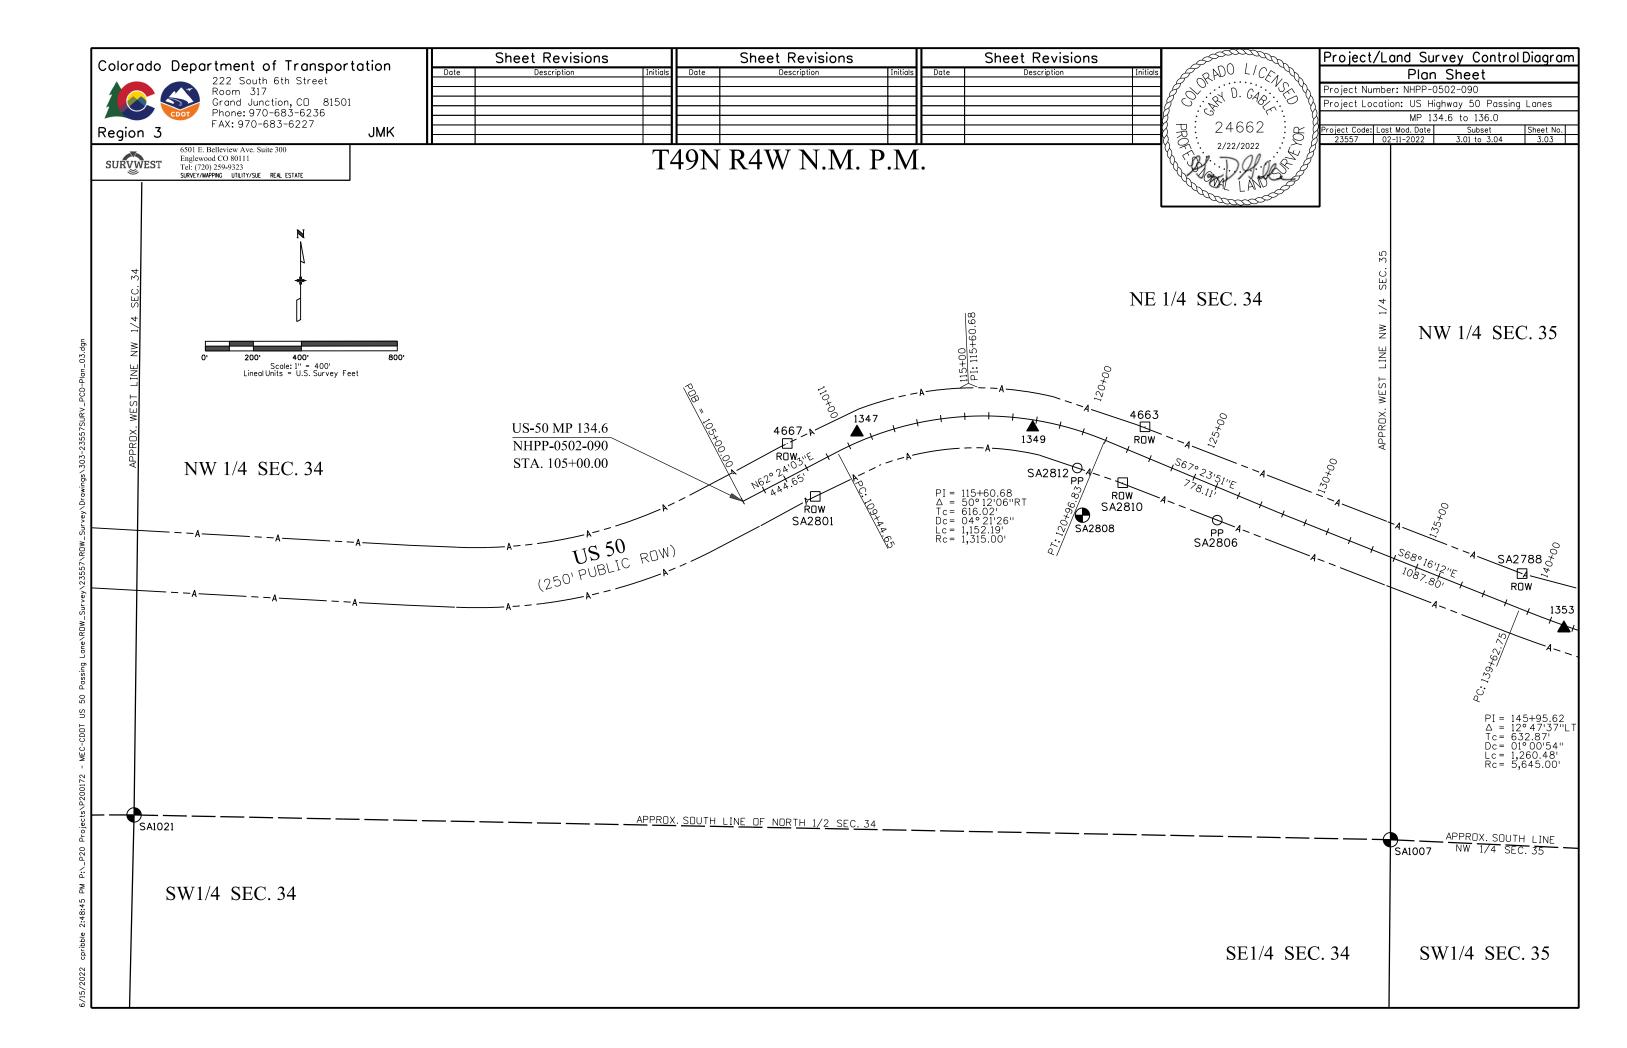

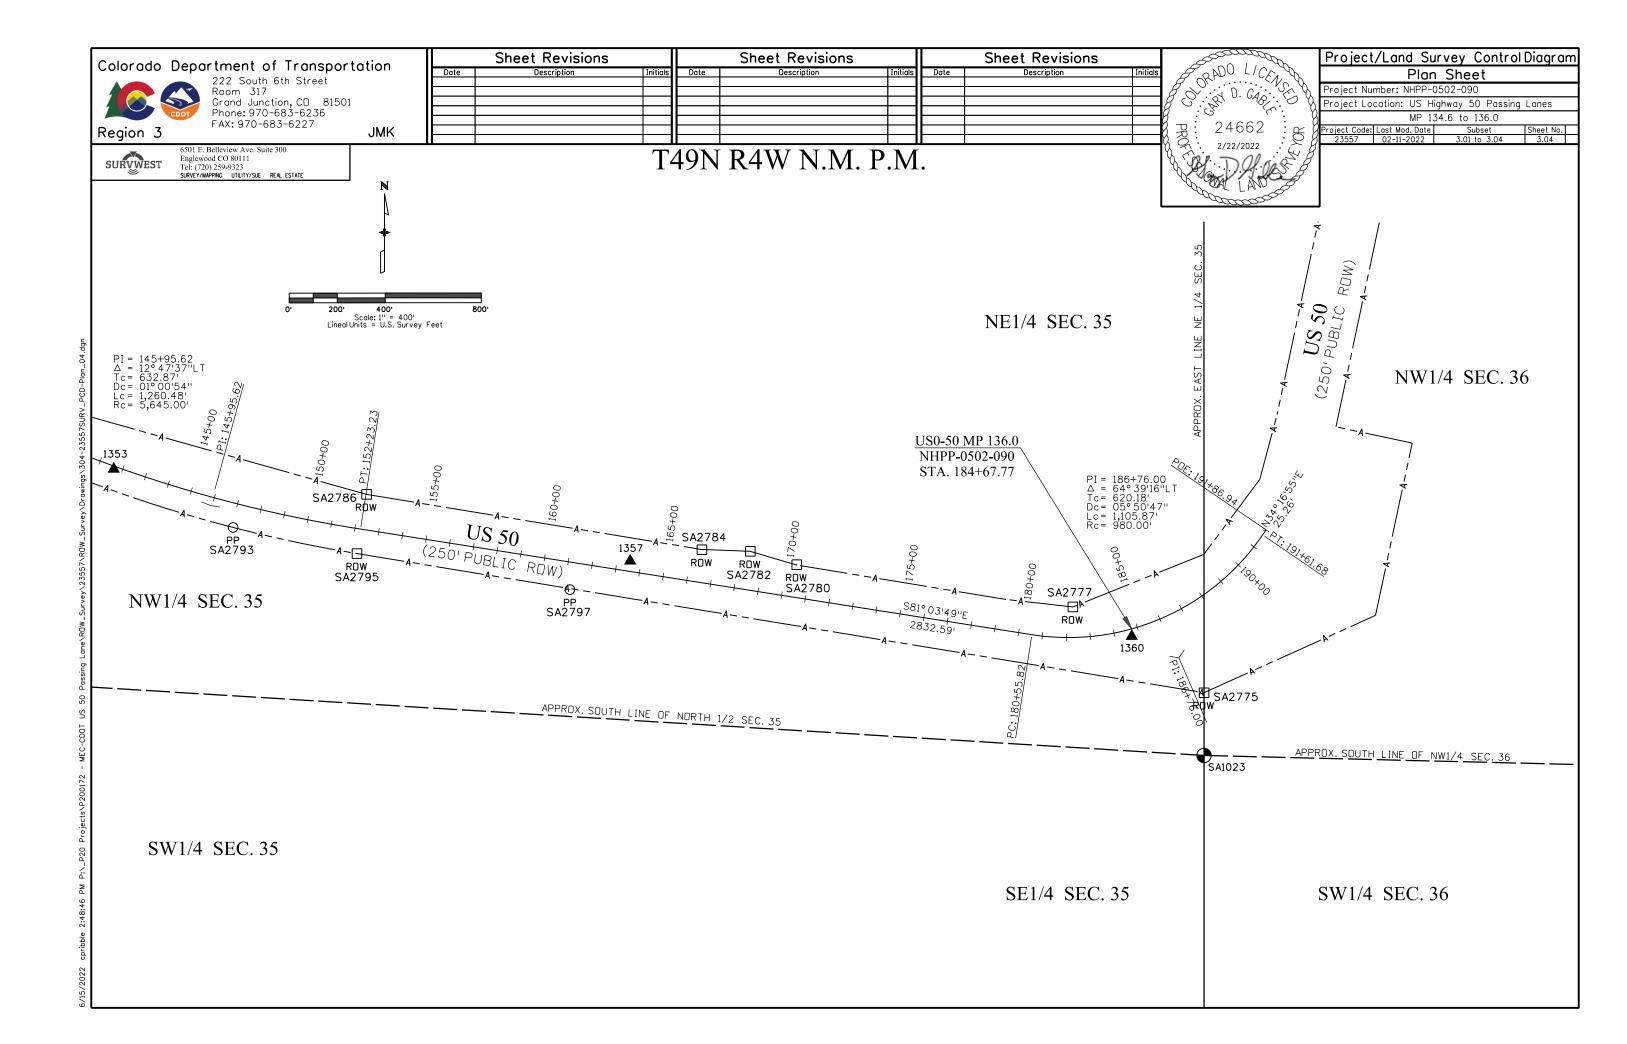

Colorado Department of Transportation



222 South 6th Street Room 317 Grand Junction, CO 81501 Phone: 970-683-6236 FAX: 970-683-6227

JMK

| | Sheet Revisions | | | Sheet Revisions | | Sheet Revisions | | | |
|--------|-----------------------------------|---------------|------|-----------------|----------|-----------------|-------------|----------|--|
| Date | Description | Initials | Date | Description | Initials | Date | Description | Initials | |
| 5/3/22 | Revised Monumentation Information | CCP | | | | | | | |
| 6/2/22 | Revised Monumentation Information | CCP | | | | | | | |
| | | | | | | | | | |
| | | | | | | | | | |
| | | | | | | | | | |
| | | $\overline{}$ | | | | | | | |

| Right of Way Plans | | | | | | | | | | |
|---|------------|--------------|------|--|--|--|--|--|--|--|
| Monumentation Sheet | | | | | | | | | | |
| Project Number: NHPP-0502-090 | | | | | | | | | | |
| Project Location: US Highway 50 Passing Lanes | | | | | | | | | | |
| MP 134.6 to 136.0 | | | | | | | | | | |
| Project Code: Last Mod. Date Subset Sheet No. | | | | | | | | | | |
| 23557 | 02-11-2022 | 5.01 to 5.01 | 5.01 | | | | | | | |

SURVWEST

Region 3

6501 E. Belleview Ave. Suite 300 Englewood CO 80111 Tel: (720) 259-9323 SURVEY/MAPPING UTILITY/SUE REAL ESTATE

| $\langle xx \rangle$ | |
|----------------------|--|

| | TABULATION OF R.O.W. MONUMENTS TO BE SET | | | | | | | | | | |
|-----------|--|-------------|---------------------------------|-----------|--------|--|--|--|--|--|--|
| Point No. | Northing(ft) | Easting(ft) | Description | Station | Offset | | | | | | |
| 100 | 235456.64 | 494829.25 | CDOT TYPE II MONUMENT TO BE SET | 152+48.18 | 112.24 | | | | | | |
| 101 | 235343.66 | 495162.48 | CDOT TYPE II MONUMENT TO BE SET | 155+94.91 | 172.07 | | | | | | |
| 102 | 235342.19 | 495451 . 71 | CDOT TYPE II MONUMENT TO BE SET | 158+80.85 | 128.60 | | | | | | |
| 103 | 235303.74 | 495694.86 | CDOT TYPE II MONUMENT TO BE SET | 161+27.03 | 128.81 | | | | | | |
| | | | | | | | | | | | |
| | | | | | | | | | | | |
| | TABULATION OF TEMPORARY EASEMENT POINTS TO BE STAKED | | | | | | | | | | | |
|-----------|--|-------------|------------------------------|-----------|--------|--|--|--|--|--|--|--|
| Point No. | Northing(ft) | Easting(ft) | Description | Station | Offset | | | | | | | |
| 300 | 236111.46 | 492783.59 | CALC'D POSITION TO BE STAKED | 131+19.23 | 112.86 | | | | | | | |
| 301 | 236002.97 | 493007.48 | CALC'D POSITION TO BE STAKED | 133+67.38 | 130.76 | | | | | | | |
| 302 | 235903.58 | 493257.89 | CALC'D POSITION TO BE STAKED | 136+36.79 | 130.37 | | | | | | | |
| 303 | 235873.17 | 493382.50 | CALC'D POSITION TO BE STAKED | 137+63.80 | 112.49 | | | | | | | |
| 308 | 235236.53 | 496119.90 | CALC'D POSITION TO BE STAKED | 165+57.34 | 129.18 | | | | | | | |
| 309 | 235248.61 | 496141.66 | CALC'D POSITION TO BE STAKED | 165+76.97 | 113.87 | | | | | | | |
| | | | | | | | | | | | | |
| | | | | | | | | | | | | |
| | | | | | | | | | | | | |
| | | | | | | | | | | | | |



QUANTITY OF MONUMENTS TO BE SET

1 1A

MONUMENT TYPE

2 2A 3 3A 4 5 5(S)

| 200 235567.37 494223.73 CDOT TYPE 6 MONUMENT 1464 201 235582.36 494227.69 CDOT TYPE 6 MONUMENT 1464 -202 235570.00 494275.25 CDOT TYPE 6 MONUMENT 1464 203 235550.56 494288.81 CDOT TYPE 6 MONUMENT 1474 204 235529.59 494443.81 CDOT TYPE 6 MONUMENT 1484 | ation Offset | | | | |
|--|----------------|--------------------------------|-------------|--------------|-----------|
| 201 235582.36 494227.69 CDOT TYPE 6 MONUMENT 1464 -202 235570.00 494275.25 CDOT TYPE 6 MONUMENT 1464 203 235550.56 494288.81 CDOT TYPE 6 MONUMENT 1474 204 235529.59 494443.81 CDOT TYPE 6 MONUMENT 1484 | I | Description Station | Easting(ft) | Northing(ft) | Point No. |
| 202 235570.00 494275.25 CDOT TYPE 6 MONUMENT 1464 203 235550.56 494288.81 CDOT TYPE 6 MONUMENT 1474 204 235529.59 494443.81 CDOT TYPE 6 MONUMENT 1484 | +44.80 127.18 | CDOT TYPE 6 MONUMENT 146+44.80 | 494223.73 | 235567.37 | 200 |
| 203 235550.56 494288.81 CDOT TYPE 6 MONUMENT 1474 204 235529.59 494443.81 CDOT TYPE 6 MONUMENT 1484 | +44.80 111.68 | CDOT TYPE 6 MONUMENT 146+44.80 | 494227.69 | 235582.36 | 201 |
| 204 235529.59 494443.81 CDOT TYPE 6 MONUMENT 148+ | 92.98 111.69 | CDOT TYPE 6 MONUMENT 146+92.98 | 494275.25 | 235570.00 | -202 |
| | +10.53 127.19 | CDOT TYPE 6 MONUMENT 147+10.53 | 494288.81 | 235550.56 | 203 |
| 205 235514.47 494440.42 CDOT TYPE 6 MONUMENT 1484 | 62.96 111.76 | CDOT TYPE 6 MONUMENT 148+62.96 | 494443.81 | 235529.59 | 204 |
| | 62.95 127.26 | CDOT TYPE 6 MONUMENT 148+62.95 | 494440.42 | 235514.47 | 205 |
| | | | | | |
| | | | | | |
| | | | | | |

General Notes:

- 1. All centerline and offset stationing may not represent the centerline as constructed in the field.
- 2. Refer to the M-629-1 Survey Monuments of the Standard Plans found in The Colorado Department of Transportation, M & S Standards for survey monument descriptions.
- 3. This plan set is subject to change and may not be the most current set. It is the user's responsibility to verify with CDOT that this set is the most current. The information contained on the attached drawing is not valid unless this copy bears an original signature of the Professional Land Surveyor hereon named.

CODRDINATE DATUM: Project coordinates are modified Colorado State Plane Central Zone NAD '83/(2011) coordinates. The combined elevation/scale factor used to modify the coordinates from state plane to project coordinates is 1.000365063. The resulting project coordinates are truncated by 304,800.610 meters in the Northing and 609,601.219 meters in the Easting after converting from state plane coordinates to project coordinates. The CHARN is based on the NAD '83(2011) datum. Project Coordinates Northing US Survey Feet = (State Plane Coordinate Northing * 1.000365063 - 304,800.610) * (3937/1200). Project Coordinates Easting US Survey Feet = (State Plane Coordinate Easting * 1000365063 - 609,601.219) * (3937/1200).


NOTICE: According to Colorado law you must commence any legal action based upon any defect in this survey within three years after you first discover such defect. In no event may any action based upon any defect in this survey be commenced more than ten years from the date of the certification shown hereon.


SURVEYOR STATEMENT FOR SET R.O.W. MONUMENTS


evidence were performed and the Right-of-Way monuments depicted on this Right-of-Way Plan were set under my responsible charge in accordance with applicable standards of practice defined by Colorado Department of Transportation publications. This statement is not a guaranty or warranty, either expressed or implied.


PLS No.


| 6/15/2022 cpribble 2:48:46 PM P:_P20 Projects\P200172 - MEC-CDOT US 50 Passing L | QUANTI |
|---|----------------------------|
| s\P200 | CAP TYPE |
| roject | REFERENCE |
| P20 F | ROW |
| ۱. ا | CONTROL |
| 46 PN | ALIQUOT CORNER |
| 2:48 | PERMANENT EASEMEN |
| pribble | PROJECT POINTS |
| 022 c | |
| 6/15/2 | WITNESS POST (REQUIRED) |

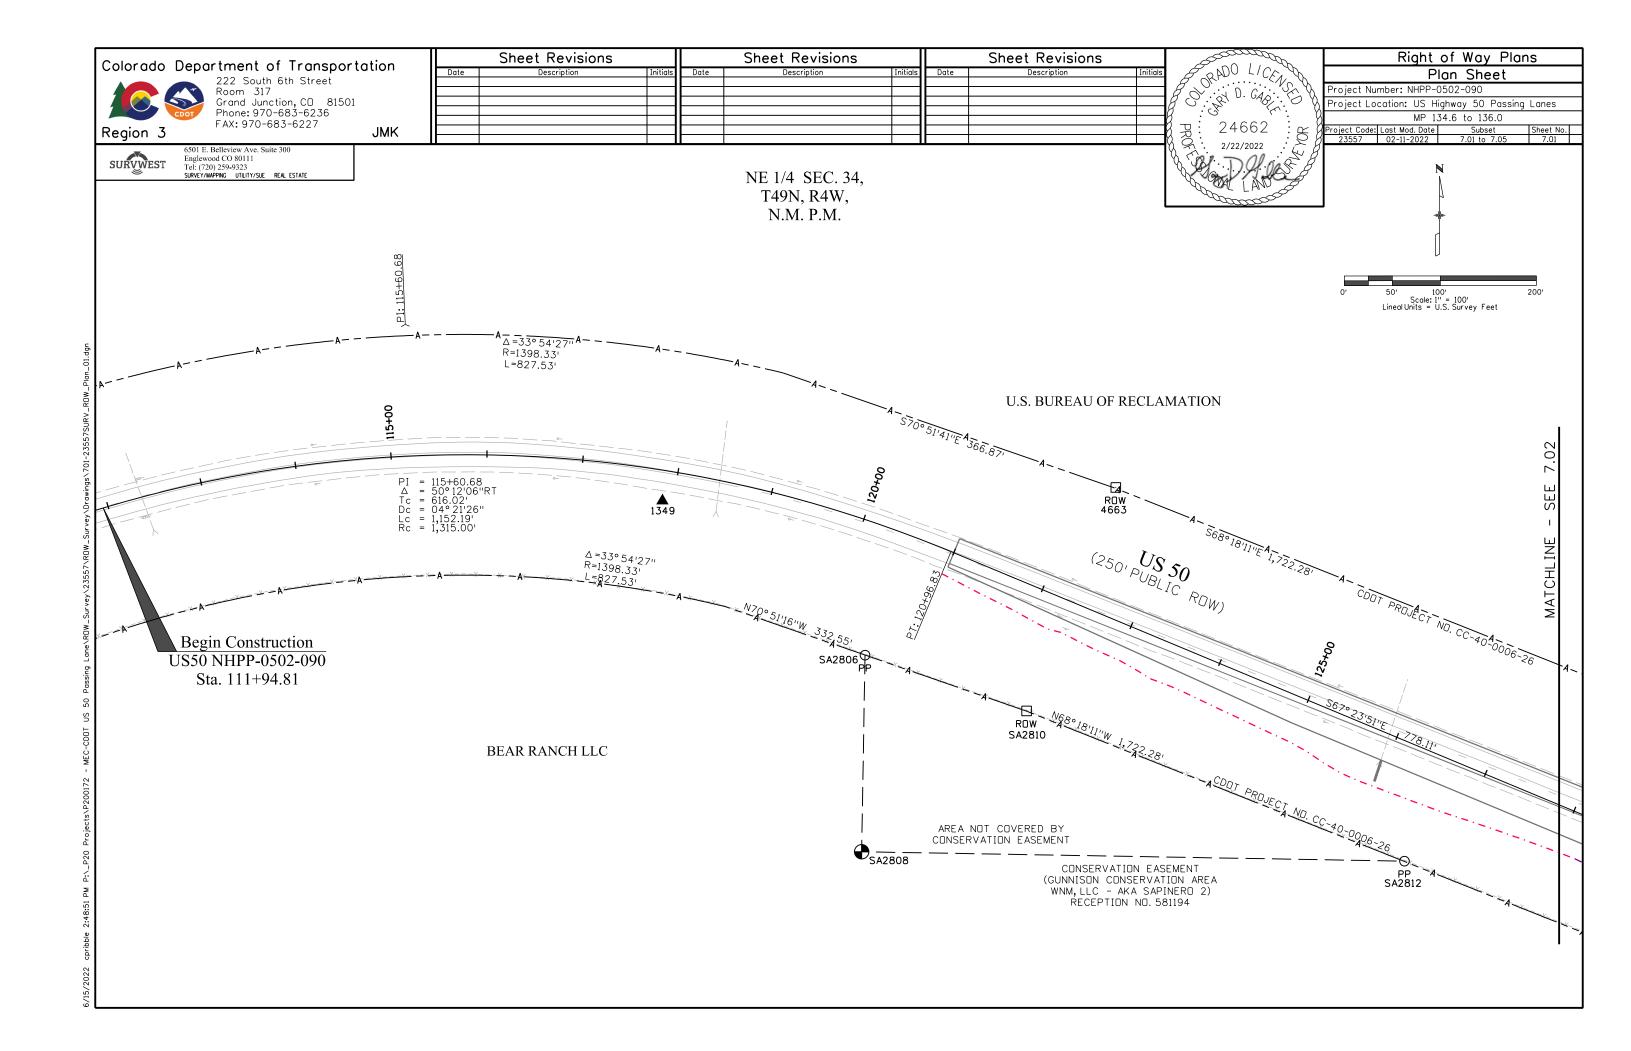

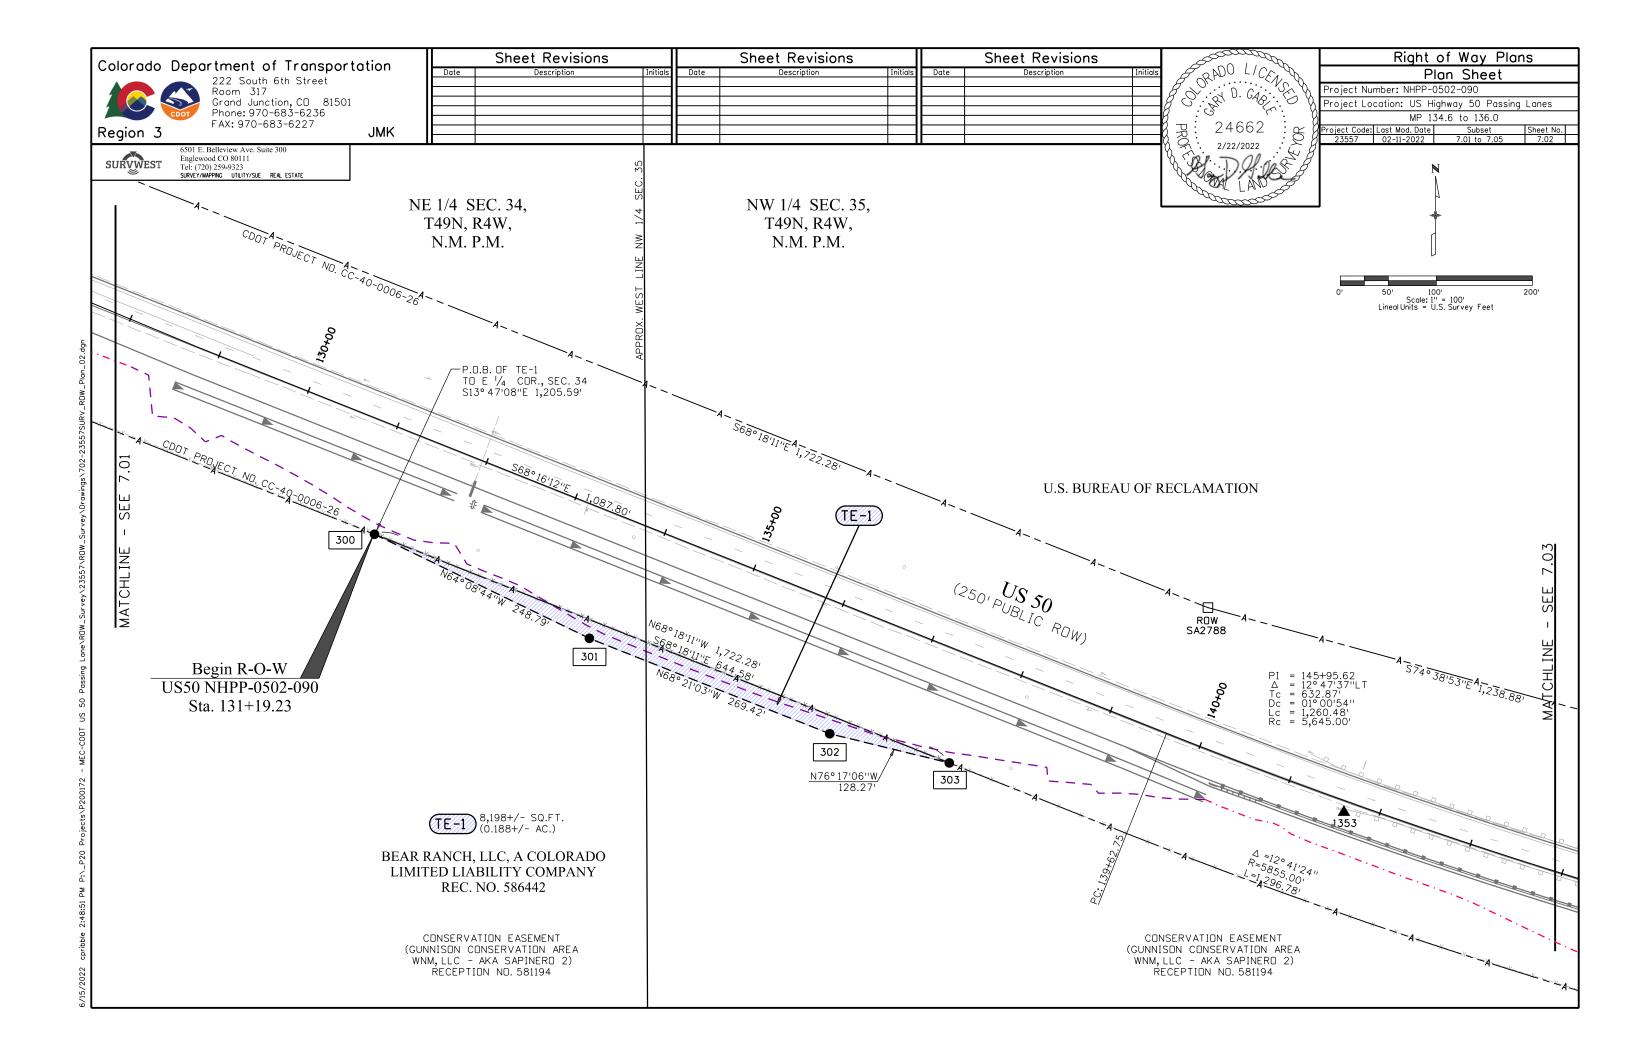

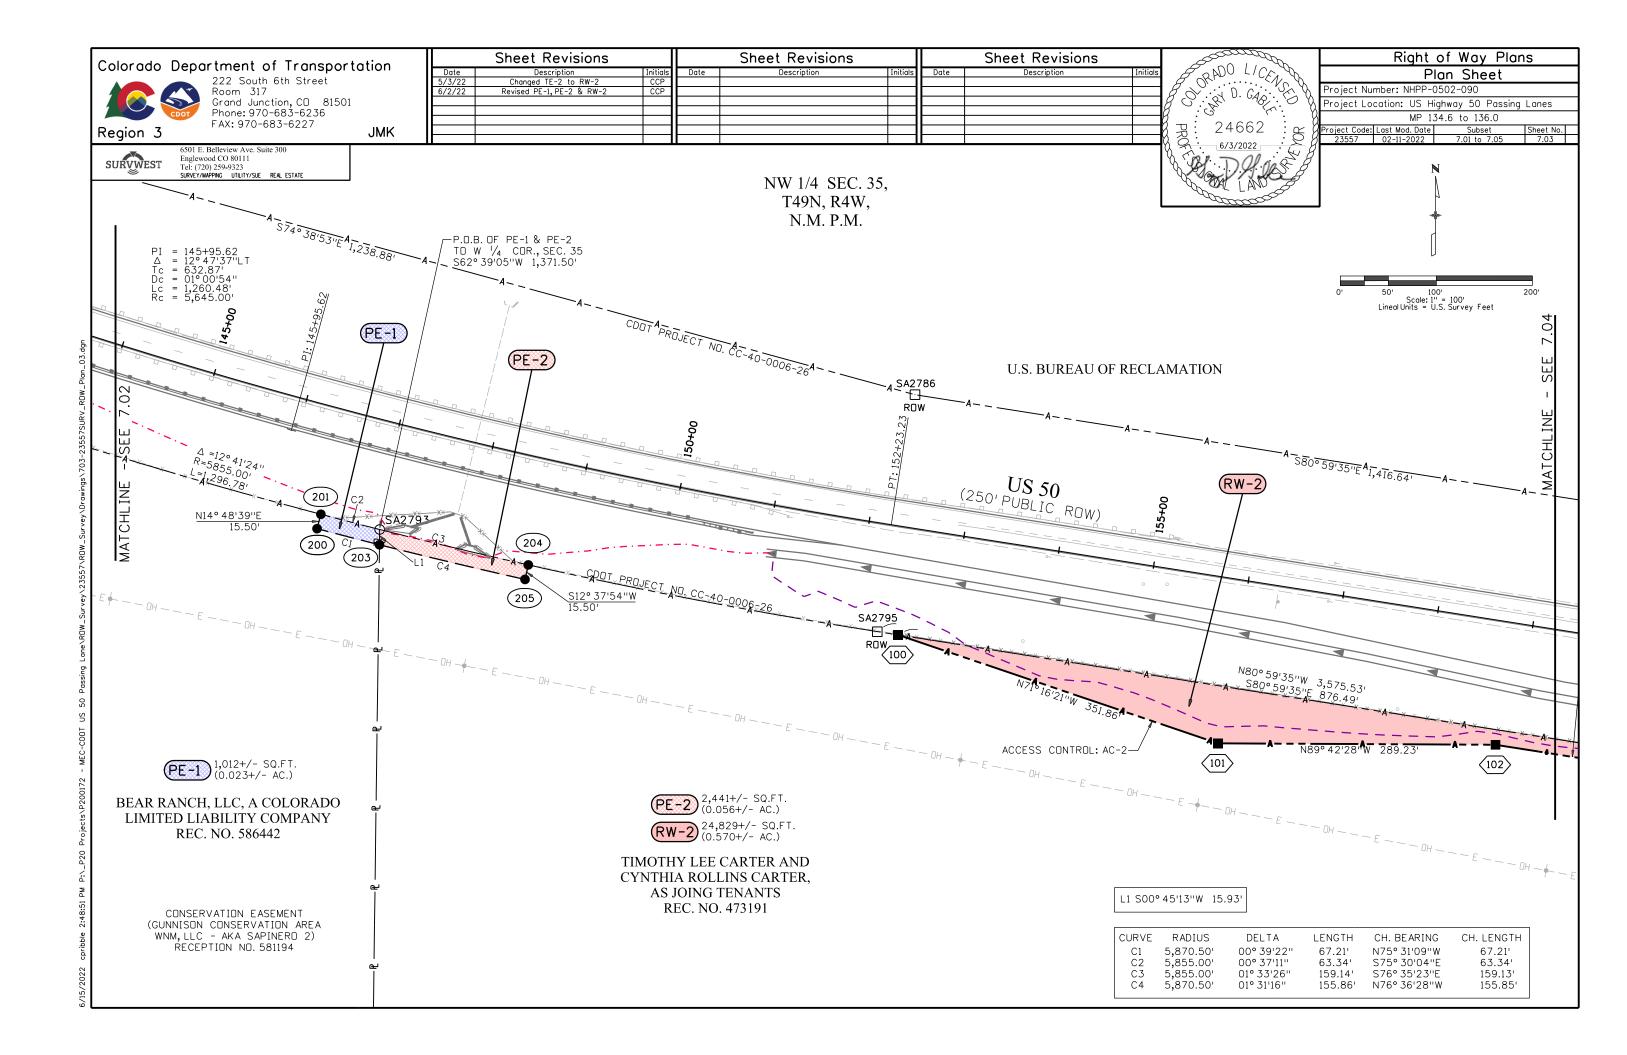

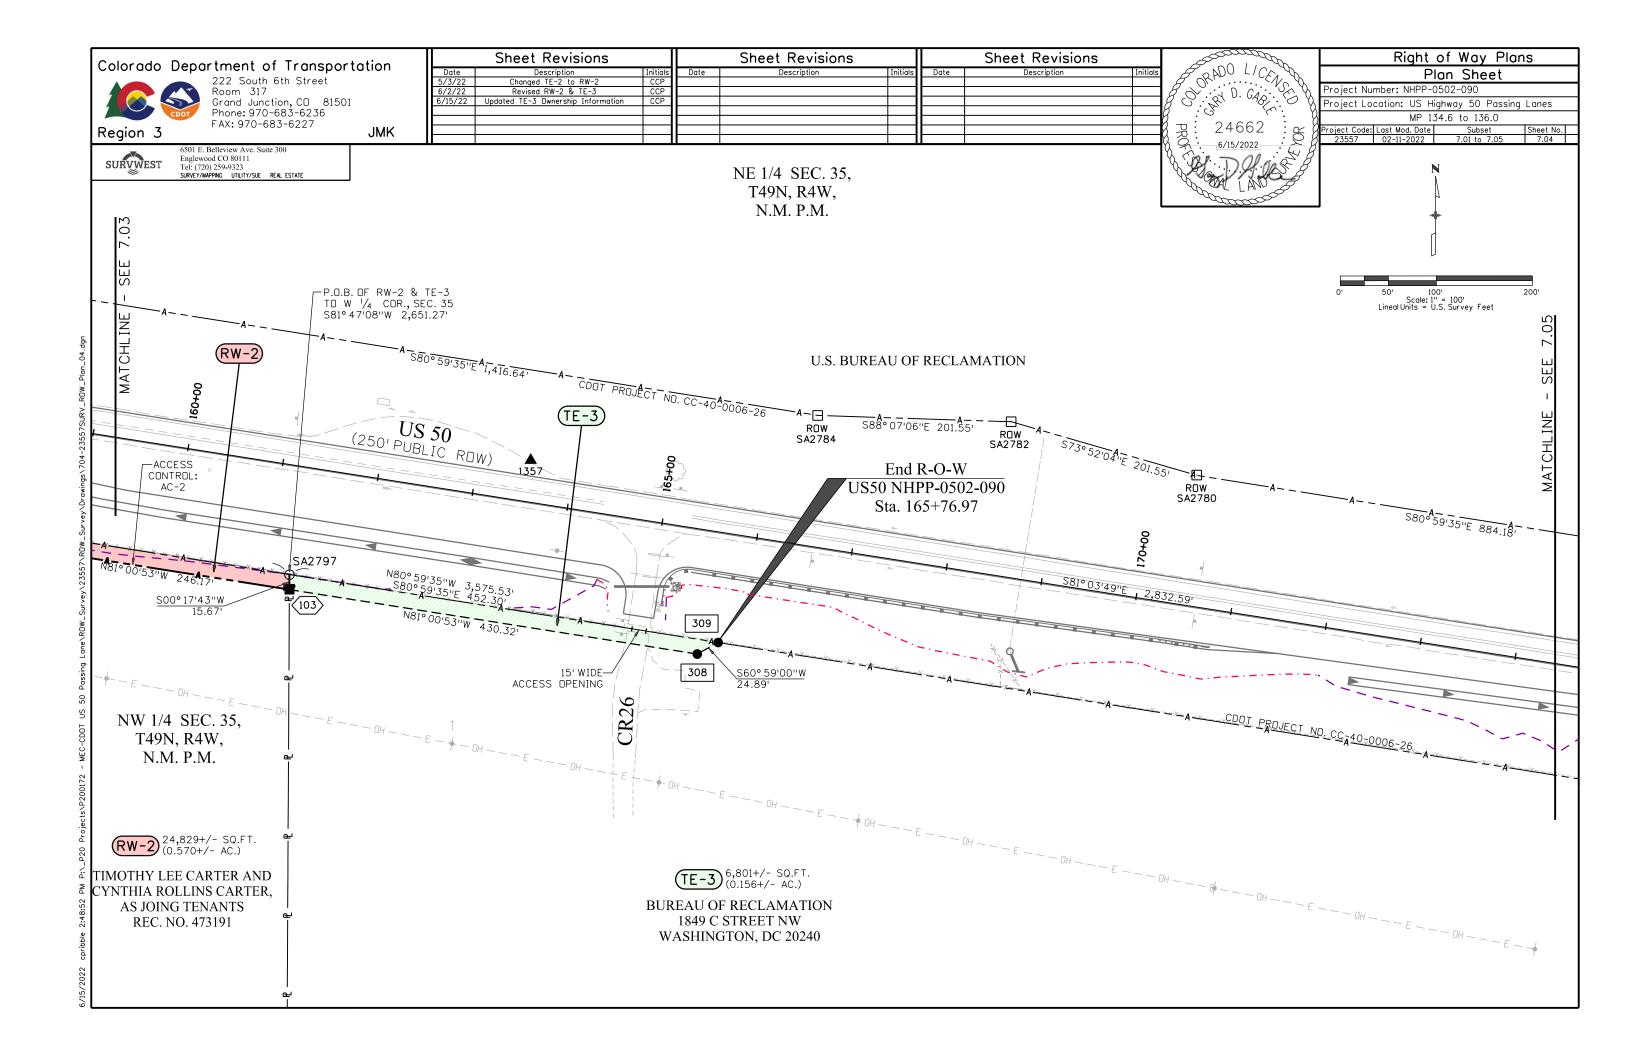

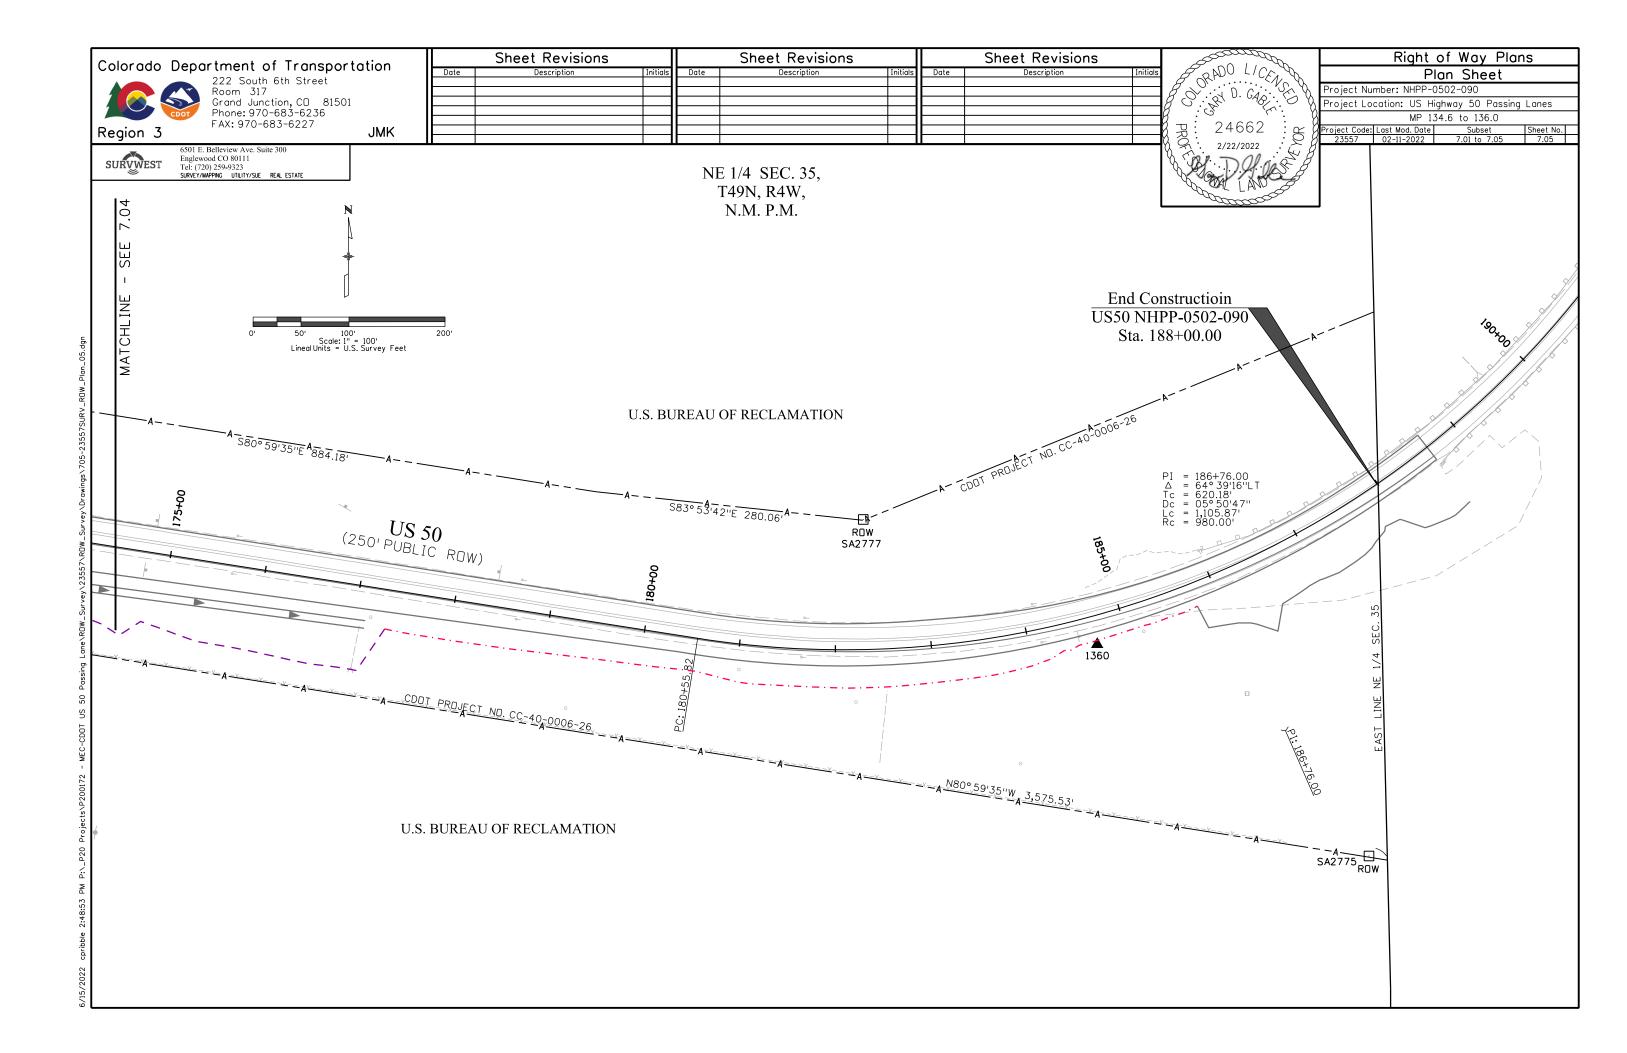

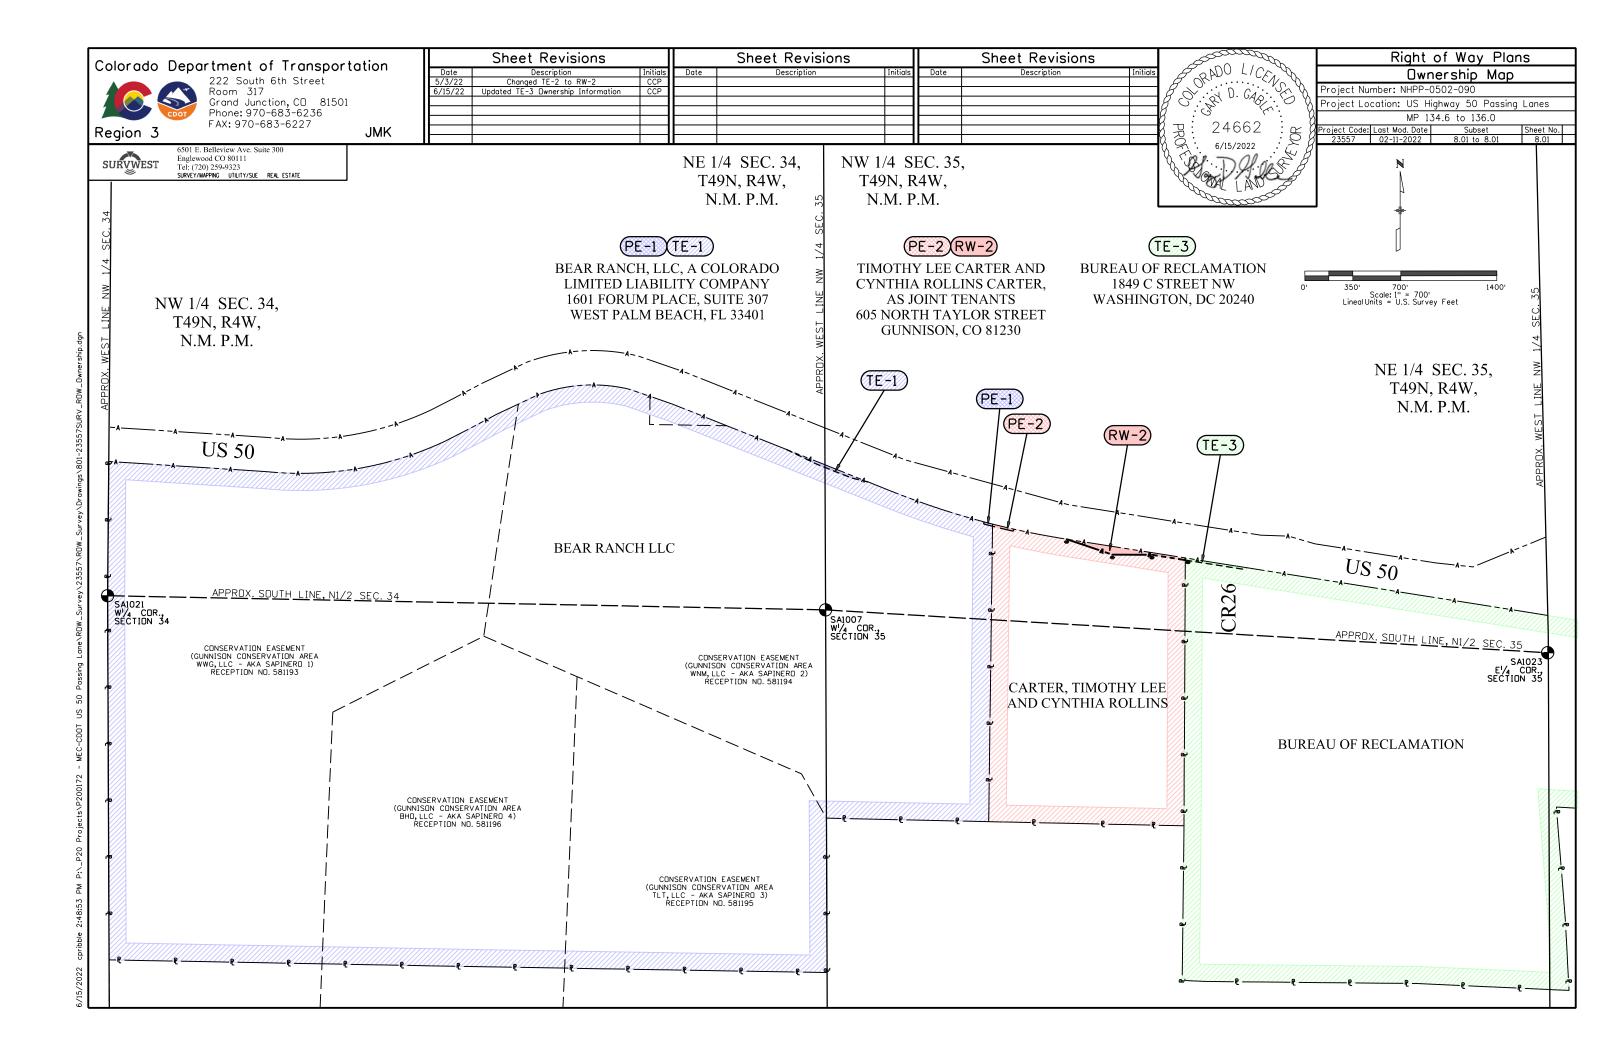


EXHIBIT "A"

PROJECT CODE: 23557 PROJECT NUMBER: NHPP-0502-090 PERMANENT EASEMENT NUMBER: PE-1 DATE: JUNE 2, 2022

LEGAL DESCRIPTION

A Permanent Easement No. PE-1 of the Department of Transportation, State of Colorado, Project Code 23557, Project Number NHPP-0502-090, containing 1,012 square feet (0.023 acres), more or less, being a portion of that parcel of land described in Bargain and Sale Deed recorded at Reception No. 586442 in the Gunnison County Clerk and Recorder's Office, situated in the Northwest 1/4 of Section 35, Township 49 North, Range 4 West of the New Mexico Principal Meridian, Gunnison County, Colorado, said Permanent Easement being more particularly described as follows:

Beginning on a point at the northeast corner of said parcel of land, also being on the southerly right-of-way line of U.S. Highway 50 as established by CDOT Project No. CC-40-0006-26, whence the West 1/4 Corner of said Section 35, being a 3.25" aluminum cap stamped "LS 10738 1990," bears South 62°39'05" West, a distance of 1,371.50 feet, said point being the TRUE POINT OF BEGINNING;

- 1. Thence along the east line of said parcel of land South 00°45'13" West, a distance of 15.93 feet to a non-tangent curve;
- 2. Thence along the arc of a curve to the right, having a radius of 5,870.50 feet and an arc angle of 00°39'22", an arc length of 67.21 feet (said curve having a chord which bears North 75°31'09" West, a distance of 67.21 feet);
- 3. Thence North 14°48'39" East, a distance of 15.50 feet to said southerly right-of-way line;
- 4. Thence along said southerly right-of-way line, being along the arc of a curve to the left, having a radius of 5,855.00 feet and an arc angle of 00°37'11", an arc length of 63.34 feet (said curve having a chord which bears South 75°30'04" East, a distance of 63.34 feet) to said TRUE POINT OF BEGINNING.

The above described Permanent Easement contains 1,012 square feet (0.023 acres), more or less.

The purpose of the above described Permanent Easement is for the construction of roadway improvements and maintenance.

Basis of Bearings: Bearings are based on a grid bearing of South 78°06'46" East from control monument CM-MP 1347, a CDOT Type II monument with a 3-\(^1\alpha\)" aluminum cap, and control monument CM-MP 1360, a CDOT Type II monument with a 3-\(^1\alpha\)" aluminum cap, both monuments marked appropriately for their milepost location and control position.

For and on Behalf of the Colorado Department of Transportation Gary D. Gable, PLS 24662 SurvWest, LLC 6501 E. Belleview Ave, Suite 300 Englewood, CO 80111

EXHIBIT "A"

PROJECT CODE: 23557
PROJECT NUMBER: NHPP-0502-090
PARCEL NUMBER: RW-2
DATE: JUNE 2, 2022

LEGAL DESCRIPTION

A Parcel of Land No. RW-2 of the Department of Transportation, State of Colorado, Project Code 23557, Project Number NHPP-0502-090, containing 24,829 square feet (0.570 acres), more or less, being a portion of that tract of land described in General Warranty Deed recorded at Reception No. 473191 in the Gunnison County Clerk and Recorder's Office, situated in the Northwest 1/4 of Section 35, Township 49 North, Range 4 West of the New Mexico Principal Meridian, Gunnison County, Colorado, said Parcel of Land being more particularly described as follows:

Beginning on a point at the northeast corner of said tract of land, also being on the southerly right-of-way line of U.S. Highway 50 as established by CDOT Project No. CC-40-0006-26, whence the West 1/4 Corner of said Section 35, being a 3.25" aluminum cap stamped "LS 10738 1990", bears South 81°47'08" West, a distance of 2,651.27 feet, said point being the TRUE POINT OF BEGINNING;

- 1. Thence along the east line of said parcel of land South 00°17'43" West, a distance of 15.67 feet;
- 2. Thence North 81°00'53" West, a distance of 246.17 feet;
- 3. Thence North 89°42'28" West, a distance of 289.23 feet;
- 4. Thence North 71°16'21" West, a distance of 351.86 feet to said southerly right-of-way line;
- 5. Thence along said southerly right-of-way line South 80°59'35" East, a distance of 876.49 feet to said TRUE POINT OF BEGINNING.

The above described parcel contains 24,829 square feet (0.570 acres), more or less.

Basis of Bearings: Bearings are based on a grid bearing of South 78°06'46" East from control monument CM-MP 1347, a CDOT Type II monument with a 3-\(^1\alpha\)" aluminum cap, and control monument CM-MP 1360, a CDOT Type II monument with a 3-\(^1\alpha\)" aluminum cap, both monuments marked appropriately for their milepost location and control position.

For and on Behalf of the Colorado Department of Transportation Gary D. Gable, PLS 24662 SurvWest, LLC 6501 E. Belleview Ave, Suite 300 Englewood, CO 80111

COLORADO DEPARTMENT OF TRANSPORTATION REAL PROPERTY

TO BE ACQUIRED

Temporary Easement Number: TE-3

FROM

Bureau of Reclamation 1849 C Street NW Washington, DC 20240

FOR

Project Code: 23557

Project Number: NHPP-0502-090

Location: U.S. Highway 50 M.P. 134.6 to M.P. 136.0

EXHIBIT "A"

PROJECT CODE: 23557 PROJECT NUMBER: NHPP-0502-090 TEMPORARY EASEMENT NUMBER: TE-3 DATE: JUNE 16, 2022

LEGAL DESCRIPTION

A Temporary Easement No. TE-3 of the Department of Transportation, State of Colorado, Project Code 23557, Project Number NHPP-0502-090, containing 6,801 square feet (0.156 acres), more or less, being a portion of that Bureau of Reclamation land situated in the Northeast 1/4 of Section 35, Township 49 North, Range 4 West of the New Mexico Principal Meridian, Gunnison County, Colorado, said Temporary Easement being more particularly described as follows:

Beginning on a point at the northwest corner of said Bureau of Reclamation land, also being on the southerly right-of-way line of U.S. Highway 50 as established by CDOT Project No. CC-40-0006-26, whence the West 1/4 Corner of said Section 35, being a 3.25" aluminum cap stamped "LS 10738 1990," bears South 81°47'08" West, a distance of 2,651.27 feet, said point being the TRUE POINT OF BEGINNING;

- 1. Thence along said southerly right-of-way line South 80°59'35" East, a distance of 452.30 feet;
- 2. Thence South 60°59'00" West, a distance of 24.89 feet;
- 3. Thence North 81°00'53" West, a distance of 430.32 feet to the west line of said Bureau of Reclamation land;
- 4. Thence along said west line North 00°17'43" East, a distance of 15.67 feet to said TRUE POINT OF BEGINNING.

The above described Temporary Easement contains 6,801 square feet (0.156 acres), more or less.

The purpose of the above described Temporary Easement is for the construction of roadway improvements.

Basis of Bearings: Bearings are based on a grid bearing of South 78°06'46" East from control monument CM-MP 1347, a CDOT Type II monument with a 3-¼" aluminum cap, and control monument CM-MP 1360, a CDOT Type II monument with a 3-¼" aluminum cap, both monuments marked appropriately for their milepost location and control position.

For and on Behalf of the Colorado Department of Transportation Casey C. Pribble, PLS 38793 SurvWest, LLC 6501 E. Belleview Ave, Suite 300 Englewood, CO 80111



| COLORADO DEPARTMENT OF TRANSPORTATION | | | | | | Project Code: | Revised Va | alues 23557 | State Highway # | | 50 | | |
|--|---|-------|------|-----------------------|-----------------------------------|---------------|---------------------------|---|------------------------|---------------------------------------|----|-------|--|
| CHIE | CHIEF ENGINEER'S RIGHT-OF-WAY COST ESTIMATE | | | | | | Project No: NHPP 0502-090 | | | | | | |
| | | | | | | | | Location: US Hwy 50 Passing Lanes MP 134.6 to 136.0 | | | | | |
| The following is the estimated cost of right of way required for the construction of the above captione required by CRS 43-1-208. As shown, the totals include the estimated value of the land to be acquired of any improvements thereon and the damage and benefits, if any, to the remaining land. This estimate and used for budgetary purposes only, and should not be considered an indication of actual market value. | | | | | red, the value ate is prepared | | CDOT Chief Enginee | r Stephen Harelsu tephen Harelson (Jun 30, 202 80/22 | H 22 11:08 N | IDT) | | | |
| Parcel | Owner | Area | Unit | Unit Value \$/Unit | 9 | % | Land Value | Improvements | Damages / (Benefits) | Land Rental (mos) Land Rental Cost | | Total | |
| PE-1 | Bear Ranch LLC | 1012 | sf | \$0.15 | @ | 90% | \$ 137 | | | | \$ | 800 | |
| TE-1 | Bear Ranch LLC | 8198 | sf | \$0.15 | @ | 10% | | | | 12 \$ 123 | \$ | 500 | |
| PE-2 | Timothy & Cynthia Carter | 2441 | sf | \$0.18 | @ | 90% | \$ 395 | | | | \$ | 800 | |
| RW-2 | Timothy & Cynthia Carter | 24829 | sf | \$0.18 | @ | 100% | \$ 4,469 | | | | \$ | 4,500 | |
| TE-3 | US Forest Service | 6801 | sf | \$0.15 | @ | 10% | | | | 12 \$ 102 | \$ | 500 | |
| | | | | (| @ | | | | | | | | |
| | | | | (| @ | | | | | | | | |
| | Sheet Totals | | | | | | \$ 5.001 | \$ - | \$ - | \$ 225 | \$ | 7.100 | |

Colorado statute, CRS 43-1-208, as interpreted by the Colorado Supreme Court in Department of Transportation, State of Colorado v. Amerco Real Estate Company, 380 P.3d 117 (Colo. 2016), requires the Chief Engineer of the Colorado Department of Transportation to "make a written report to the [transportation] commission describing the portion of the highway to be . . . changed and the portions of land of each landowner to be taken . . . together with an estimate of the damages and benefits accruing to each landowner whose land may be affected thereby" prior to any action to acquire or condemn real property for a highway purpose. CDOT must comply with this law at the outset of project development and prior to any entry on land or formal appraisal of real property. The Chief Engineer Cost Estimates are estimates of land value necessary for compliance with Colorado statute CRS 43-1-208 as interpreted by the Amerco decision. CDOT's Chief Engineer Cost Estimates do not comply with USPAP's direction that "any opinion of value" is deemed an appraisal. Because Colorado law requires an "estimate of damages" early in project development and before any entry on land or formal appraisal, CDOT is entitled to a jurisdictional exception to USPAP.

7,100