

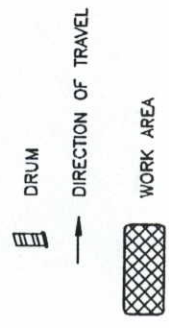
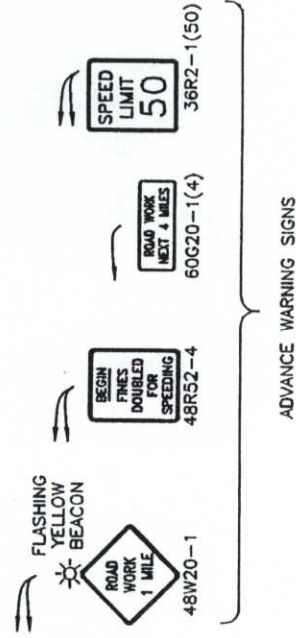
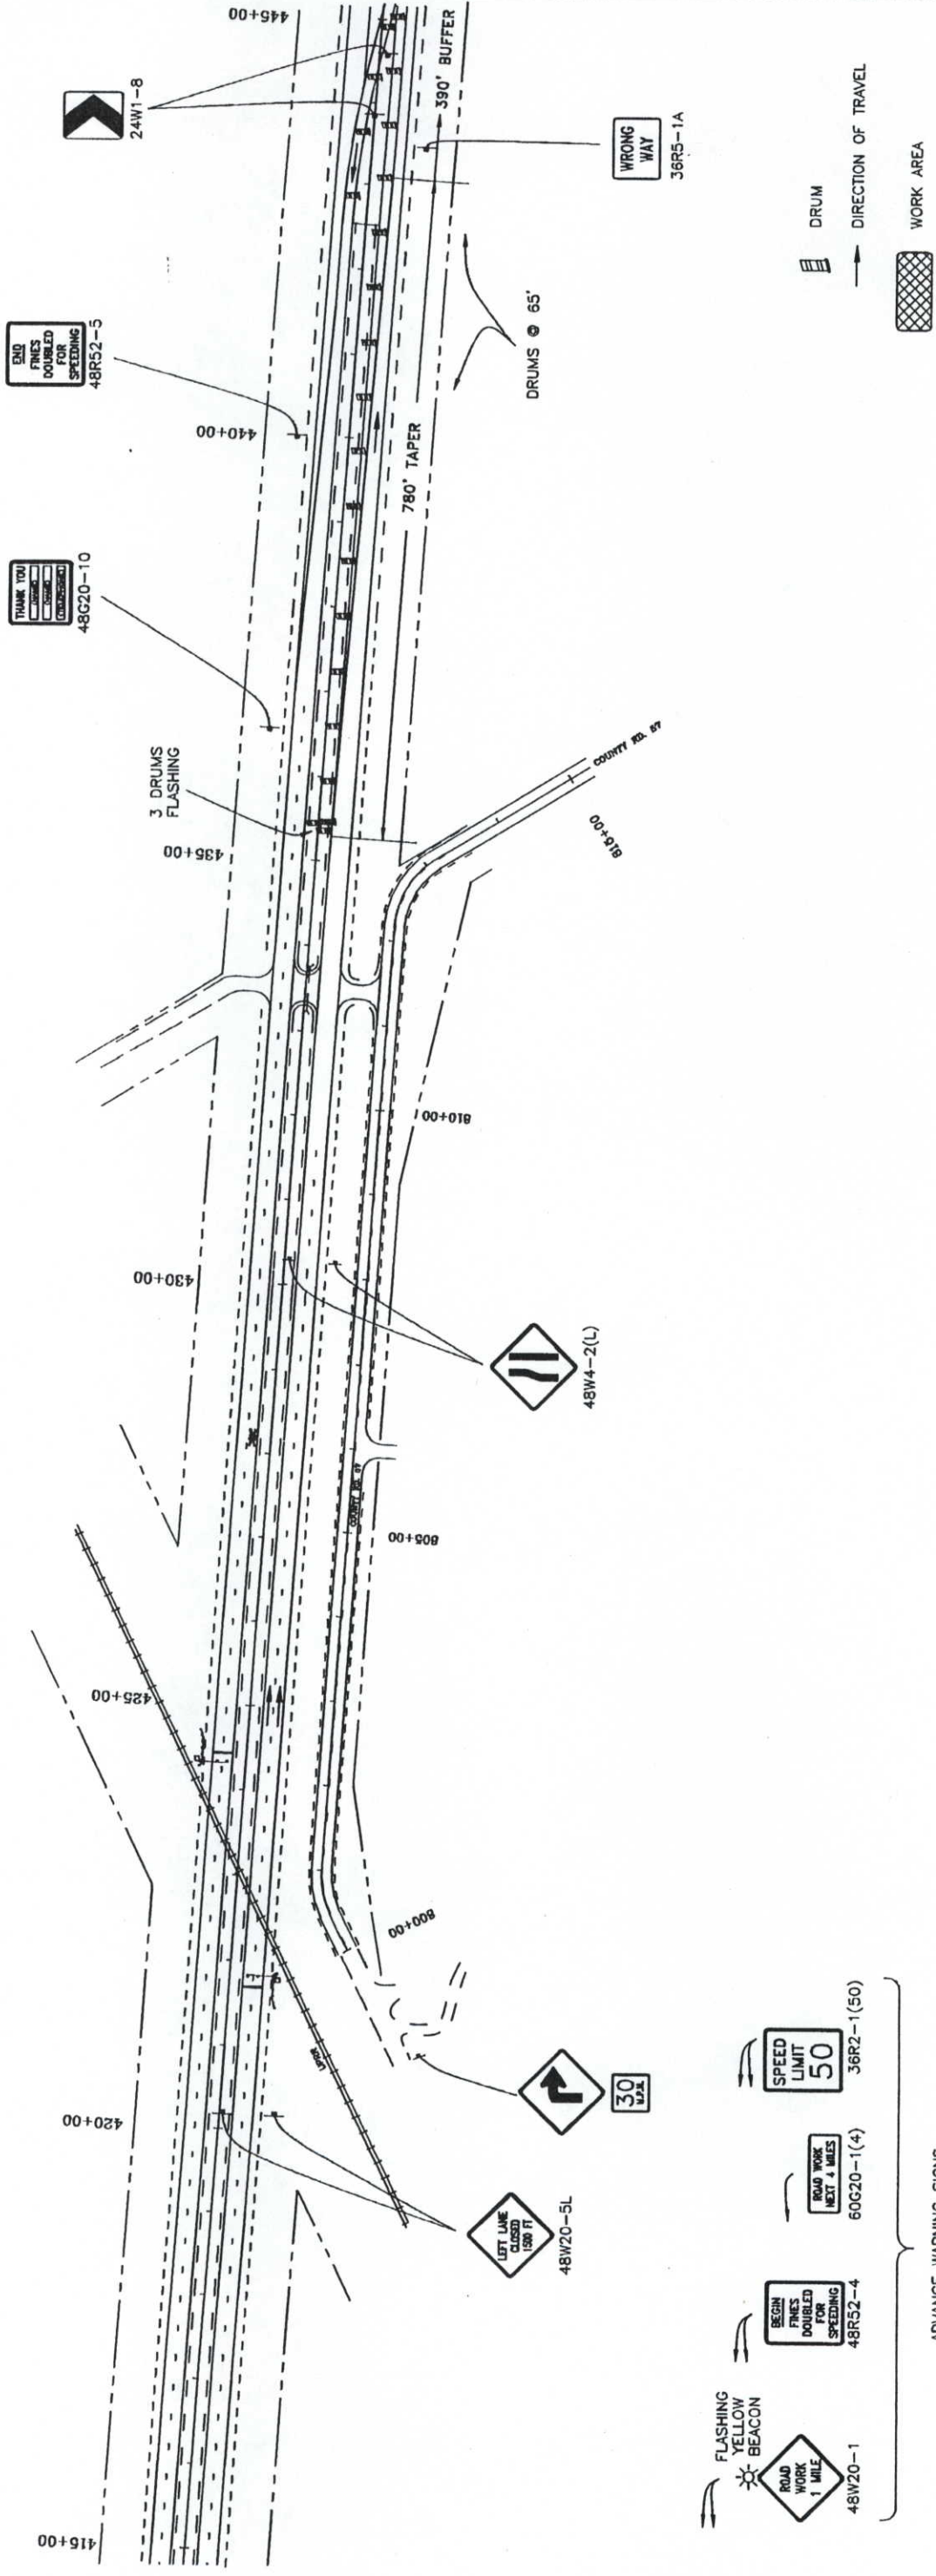
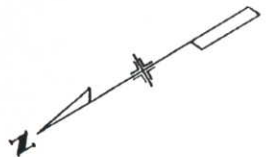


CONSTRUCTION SIGNING PLAN PHASE 2

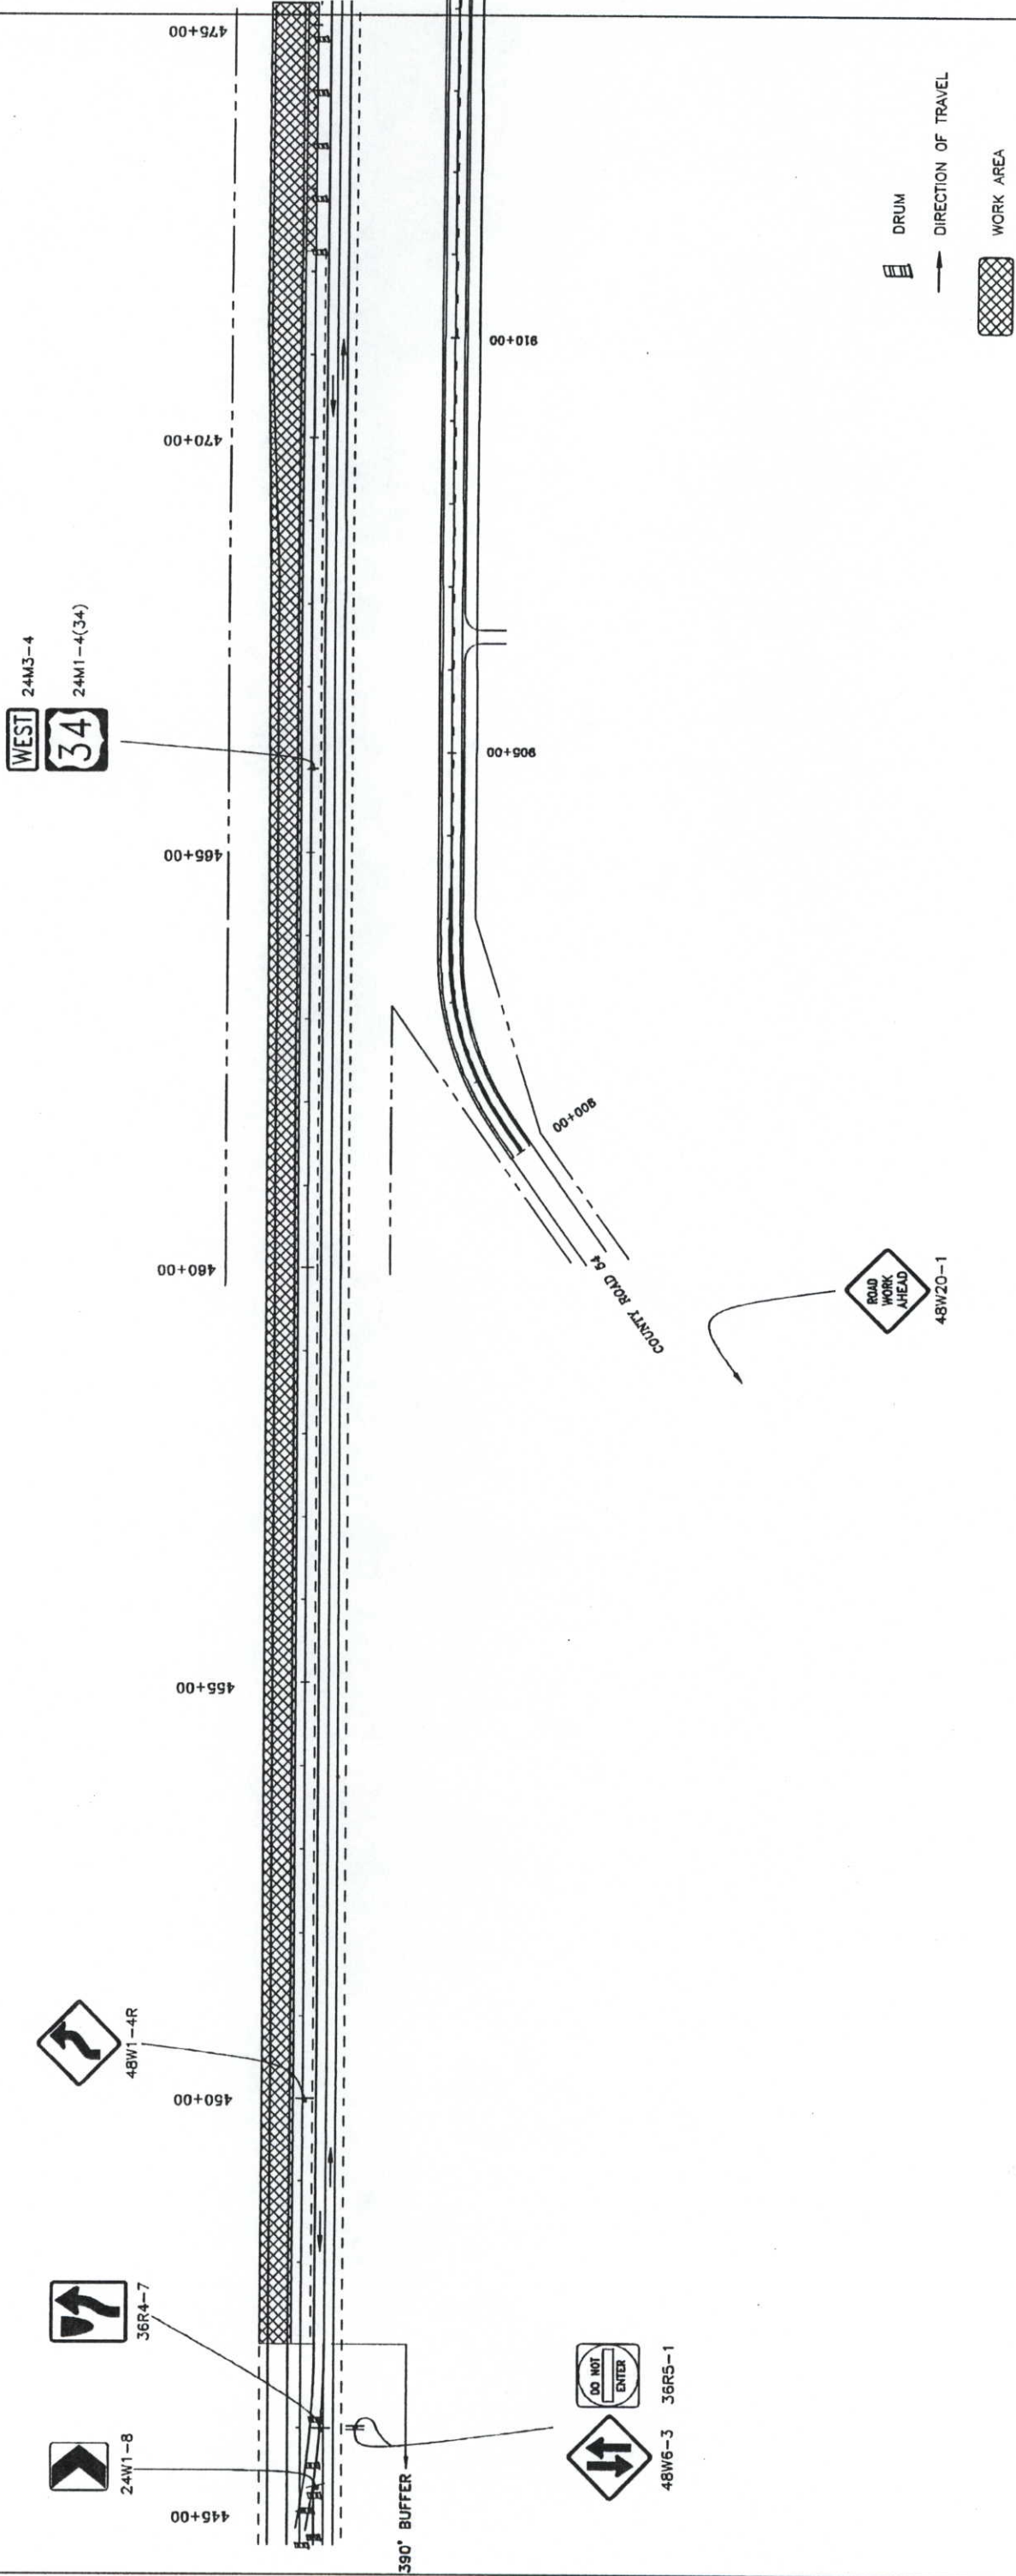



Computer File Information		Index of Revisions		As Constructed		Plan Sheet		Project No./Code	
Creation Date:	09/18/98	Initials:	SDH	No Revisions:		Designer: S.Haile Detailer: S.Haile Sheet Subset: Traffic Subset Sheet Number:		NH 0342-034 12658 Sheet Number 89	
Last Modification Date:	05/06/99	Initials:	SDH	Revised:					
Full Path:	\\R_4\34		Void: 11-2-00						
Drawing File Name:	CONST_PHASE_2_1.dwg			Colorado Department of Transportation		 1325 S. Colorado Blvd. Denver, CO 80222 Phone: 303-757-9355 FAX: 303-512-5119 Traffic Safety & Traffic Engineering			
Scale:	1" = 50 FEET								

CONSTRUCTION SIGNING PLAN PHASE 2

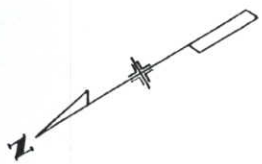


Plan Sheet		Project No./Code NH 0342-034
As Constructed	No Revisions:	Structure Numbers
Revised:	Revised:	Designer: S.Haile
Void:	Void:	Detailer: S.Haile
11-2-00	11-2-00	Sheet Subst: Traffic
Colorado Department of Transportation		Sheet Number: 90
1325 S. Colorado Blvd. Denver, CO 80222 Phone: 303-757-9355 FAX: 303-512-5119		Subst Sheet Number:
Traffic Safety & Traffic Engineering		90
Index of Revisions		
Computer File Information		
Creation Date: 09/18/98	Initials: SDH	
Last Modification Date: 05/06/99	Initials: SDH	
Full Path: \R_4\34		
Drawing File Name: CONST_PHASE_2_2.dwg		
Scale: 1" = 50 FEET		

CONSTRUCTION SIGNING PLAN PHASE 2

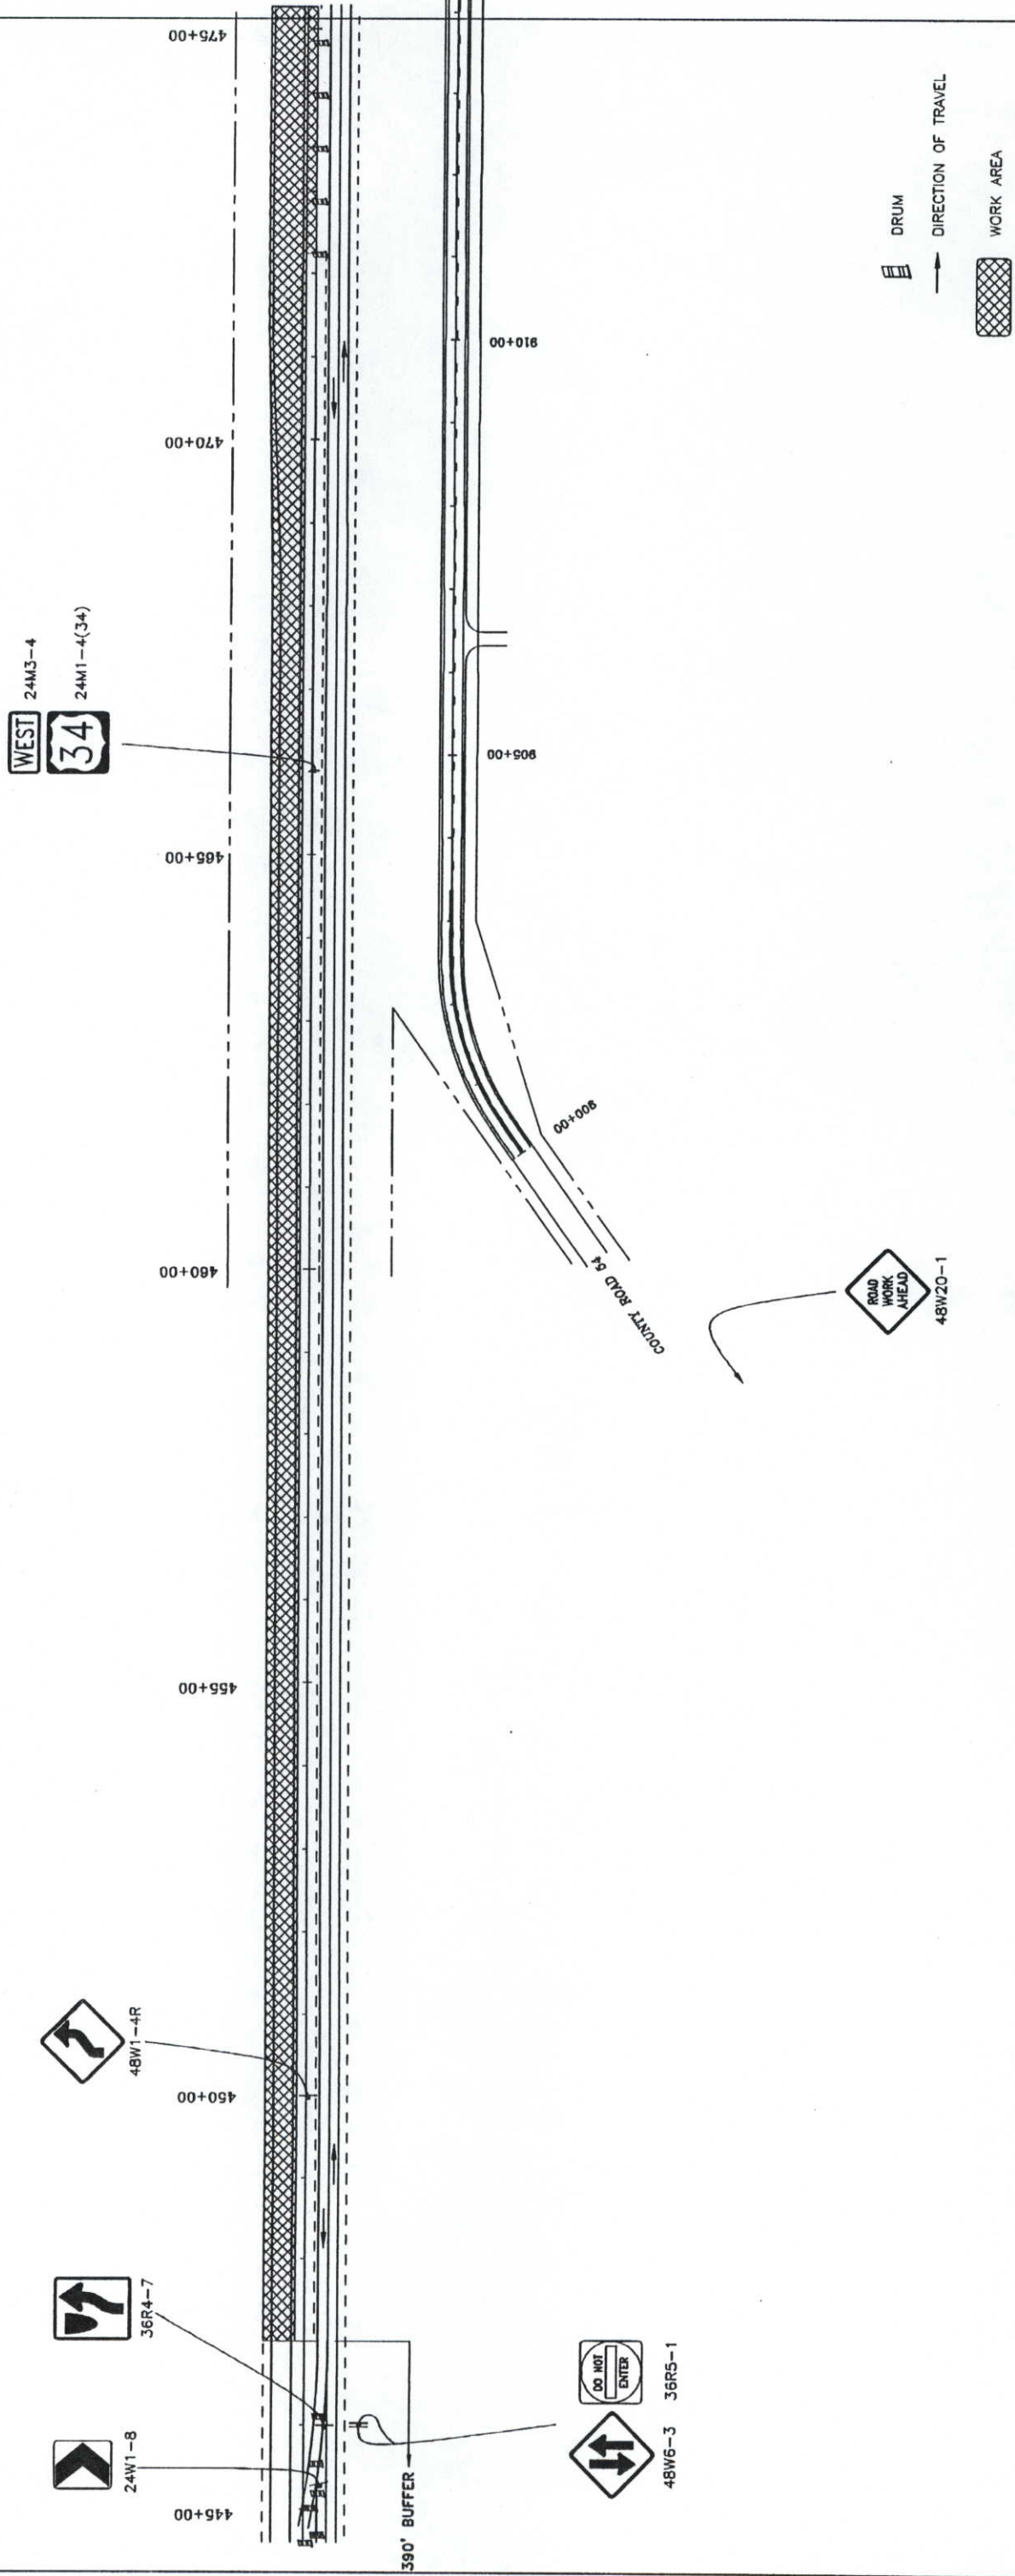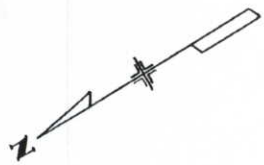


Computer File Information		Index of Revisions		As Constructed		Plan Sheet		Project No./Code	
Creation Date:	09/18/98	Initials:	SDH	No Revisions:	No Revisions:		NH 0342-034		
Last Modification Date:	05/06/99	Initials:	SDH	Revised:	Revised:		Designer: S.Haile		
Full Path:	\R_4\34			Void:	Void: 11-2-00		Detailer: S.Haile		
Drawing File Name:	CONST_PHASE_2_2.dwg						Structure Numbers		
Scale:	1" = 50 FEET						Sheet Subst: Traffic		
							Sheet Number 90		




 Colorado Department of Transportation
 1325 S. Colorado Blvd.
 Denver, CO 80222
 Phone: 303-757-9355 FAX: 303-512-5119
 Traffic Safety & Traffic Engineering

CONSTRUCTION SIGNING PLAN PHASE 2

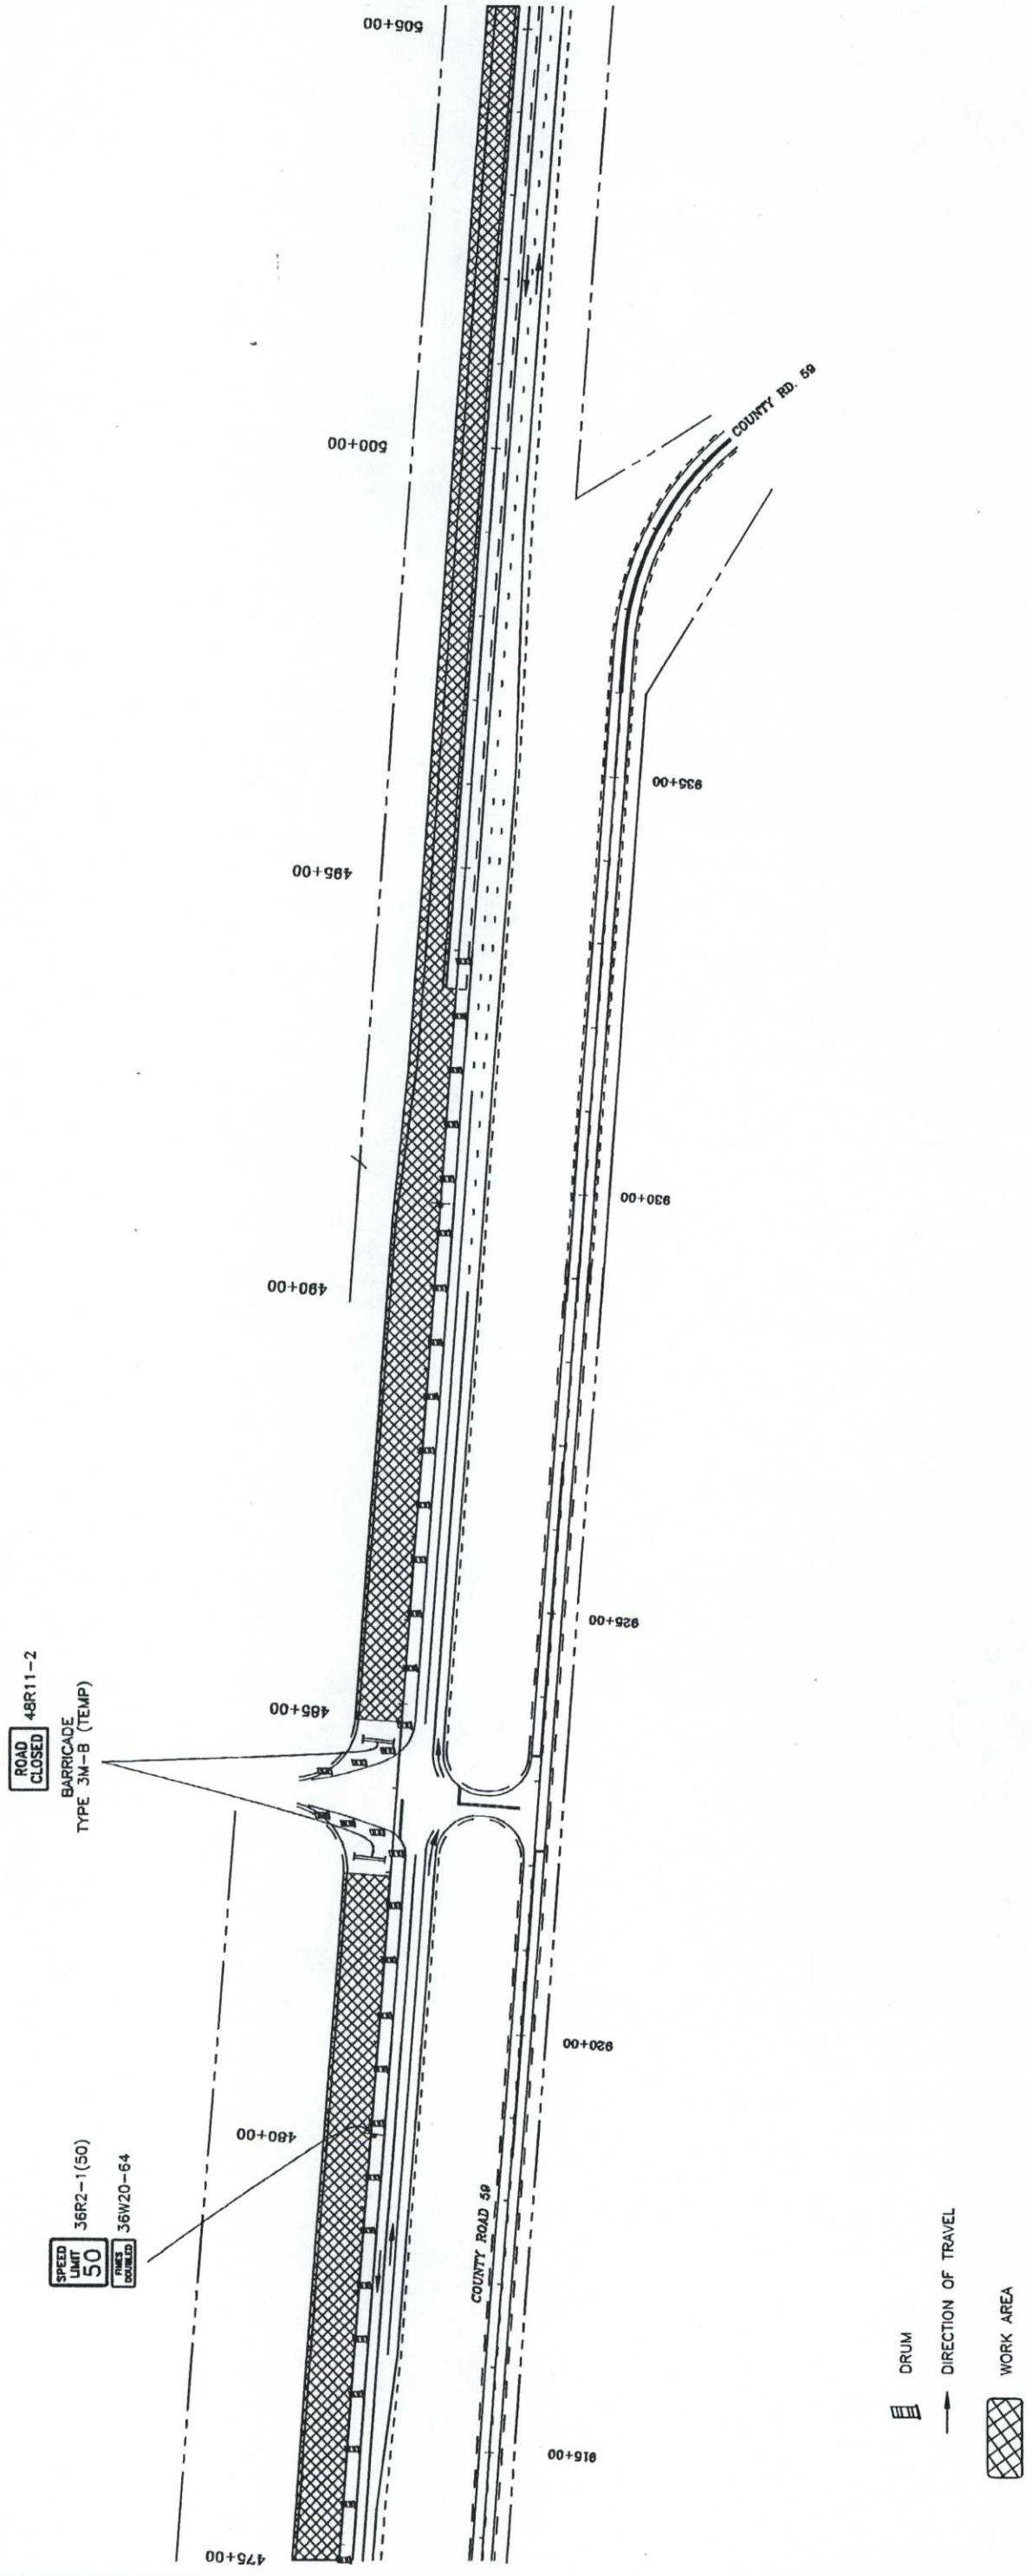


Computer File Information		Index of Revisions		As Constructed		Plan Sheet		Project No./Code	
Creation Date:	09/18/98	Initials:	SDH	No Revisions:		Designer: S.Haile Detailer: S.Haile		NH 0342-034	
Last Modification Date:	05/06/99	Initials:	SDH	Revised:					
Full Path:	\\R_4\34			Void:	11-2-00	Sheet Subset: Traffic		Sheet Number 91	
Drawing File Name:	CONST_PHASE_2_3.dwg								
Scale:	1" = 50 FEET					Colorado Department of Transportation 1325 S. Colorado Blvd. Denver, CO 80222 Phone: 303-757-9355 FAX: 303-512-5119 Traffic Safety & Traffic Engineering			


CONSTRUCTION SIGNING PLAN PHASE 2

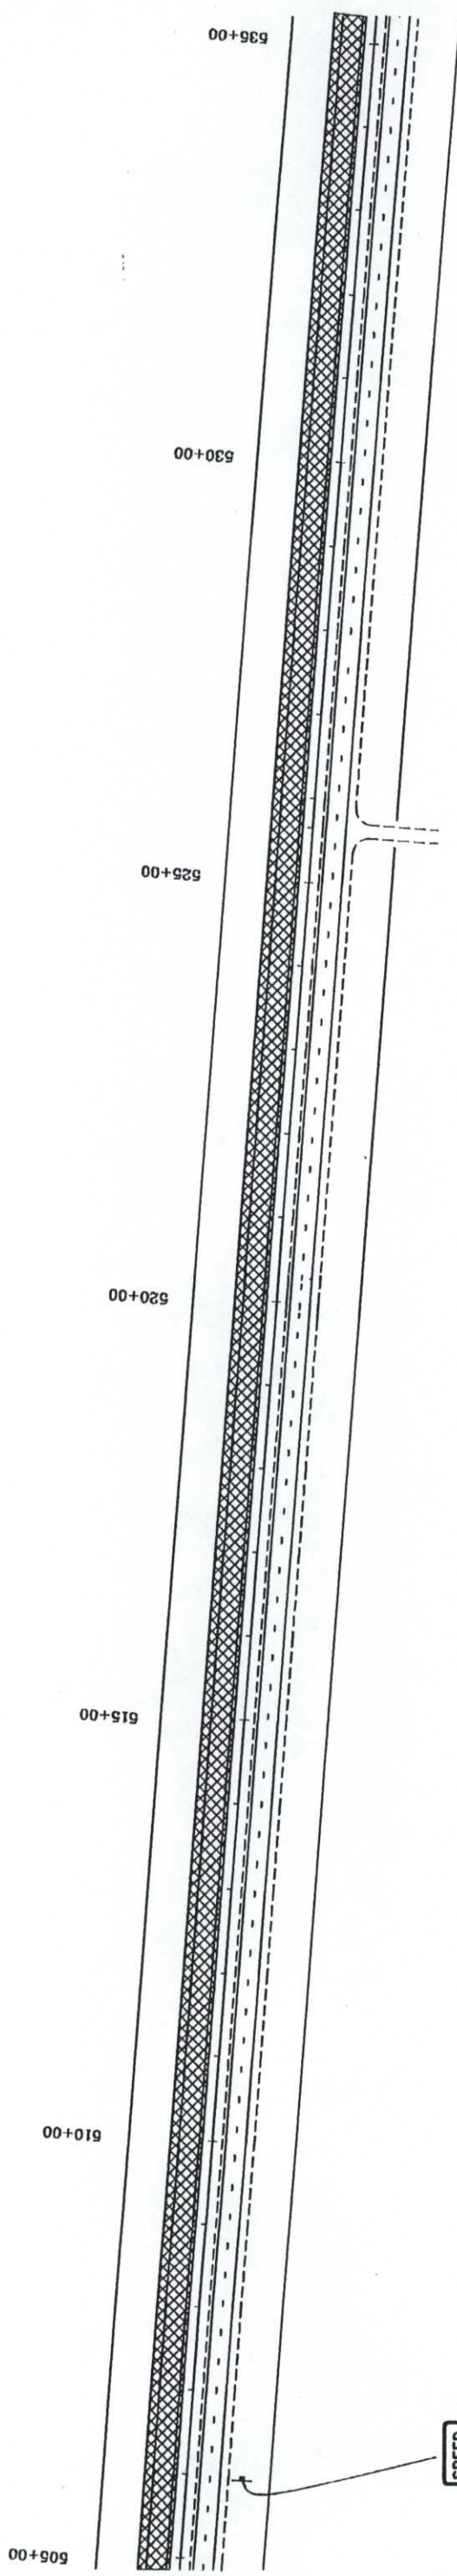




SPEED LIMIT 50 36R2-1(50)
FINES DOUBLED 36W20-64

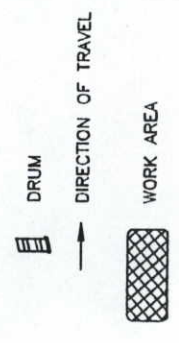


Computer File Information		Index of Revisions		As Constructed		Plan Sheet		Project No./Code	
Creation Date:	09/18/98	Initials:	SDH	No Revisions:		Designer:	S.Haile	Structure Numbers	NH 0342-034
Last Modification Date:	05/06/99	Initials:	SDH	Revised:		Detailer:	S.Haile	Sheet Number	12658
Full Path:	\R_4\34			Void:	11-2-00	Sheet Subset:	Traffic	Sheet Number	92
Drawing File Name:	CONST_PHASE_2_4.dwg								
Scale:	1" = 50 FEET								


 Colorado Department of Transportation
 1325 S. Colorado Blvd.
 Denver, CO 80222
 Phone: 303-757-9355 FAX: 303-512-5119
 Traffic Safety & Traffic Engineering


CONSTRUCTION SIGNING PLAN PHASE 2

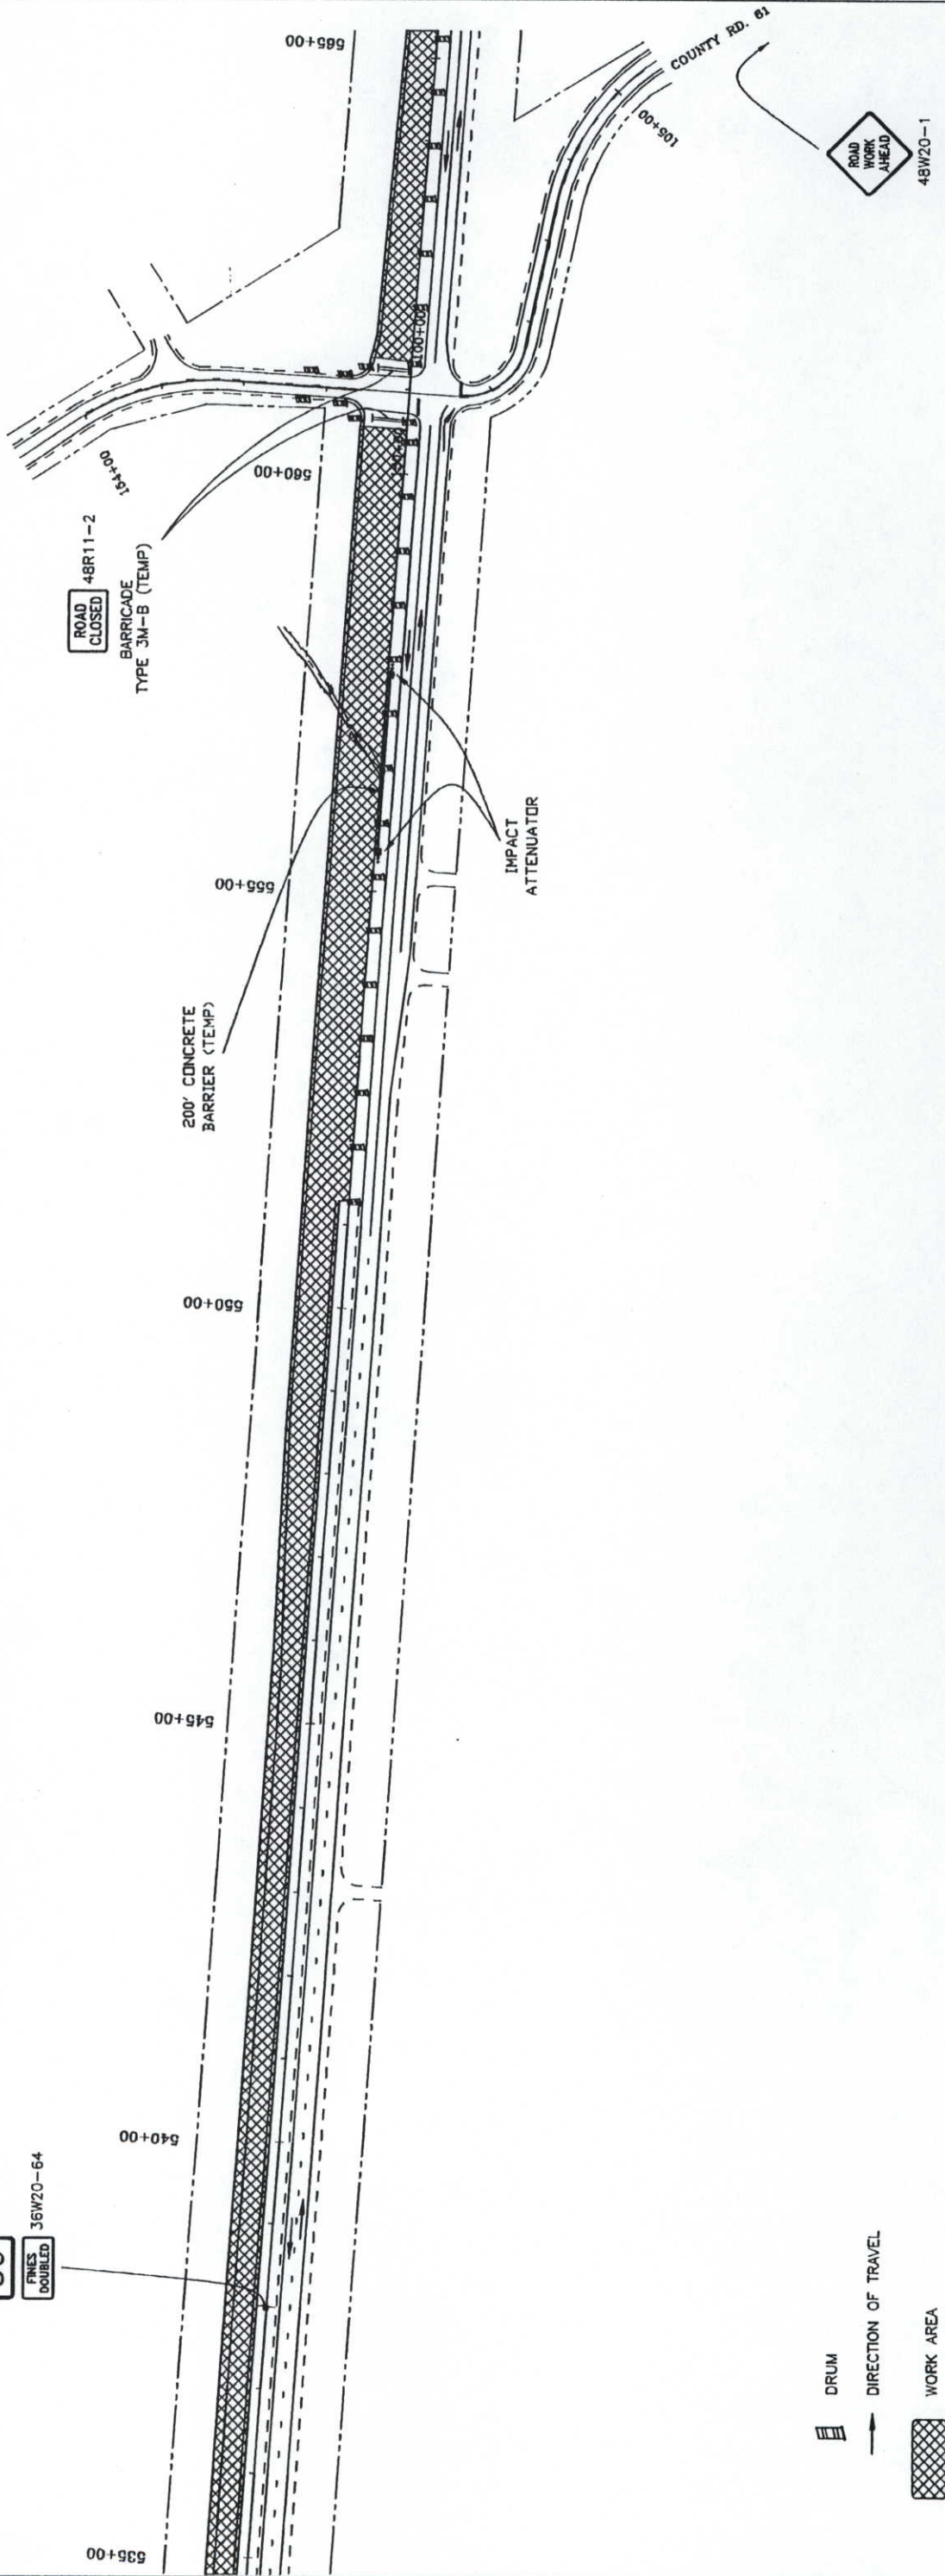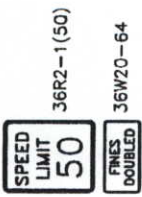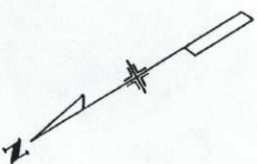

Computer File Information		Index of Revisions		As Constructed		Plan Sheet		Project No./Code	
Creation Date:	09/18/98	Initials:	SDH	No Revisions:		NH 0342-034		Project No./Code	
Last Modification Date:	05/06/99	Initials:	SDH	Revised:		S.Haile		NH 0342-034	
Full Path:	R_4\34			Void: 11-2-00		S.Haile		12658	
Drawing File Name:	CONST_PHASE_2_5.dwg			Traffic		Structure Numbers		Sheet Number 92	
Scale:	1" = 50 FEET					Subsheet Number:			


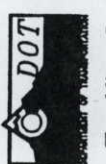

 Colorado Department of Transportation
 1325 S. Colorado Blvd.
 Denver, CO 80222
 Phone: 303-757-9355 FAX: 303-512-5119
Traffic Safety & Traffic Engineering

CONSTRUCTION SIGNING PLAN PHASE 2

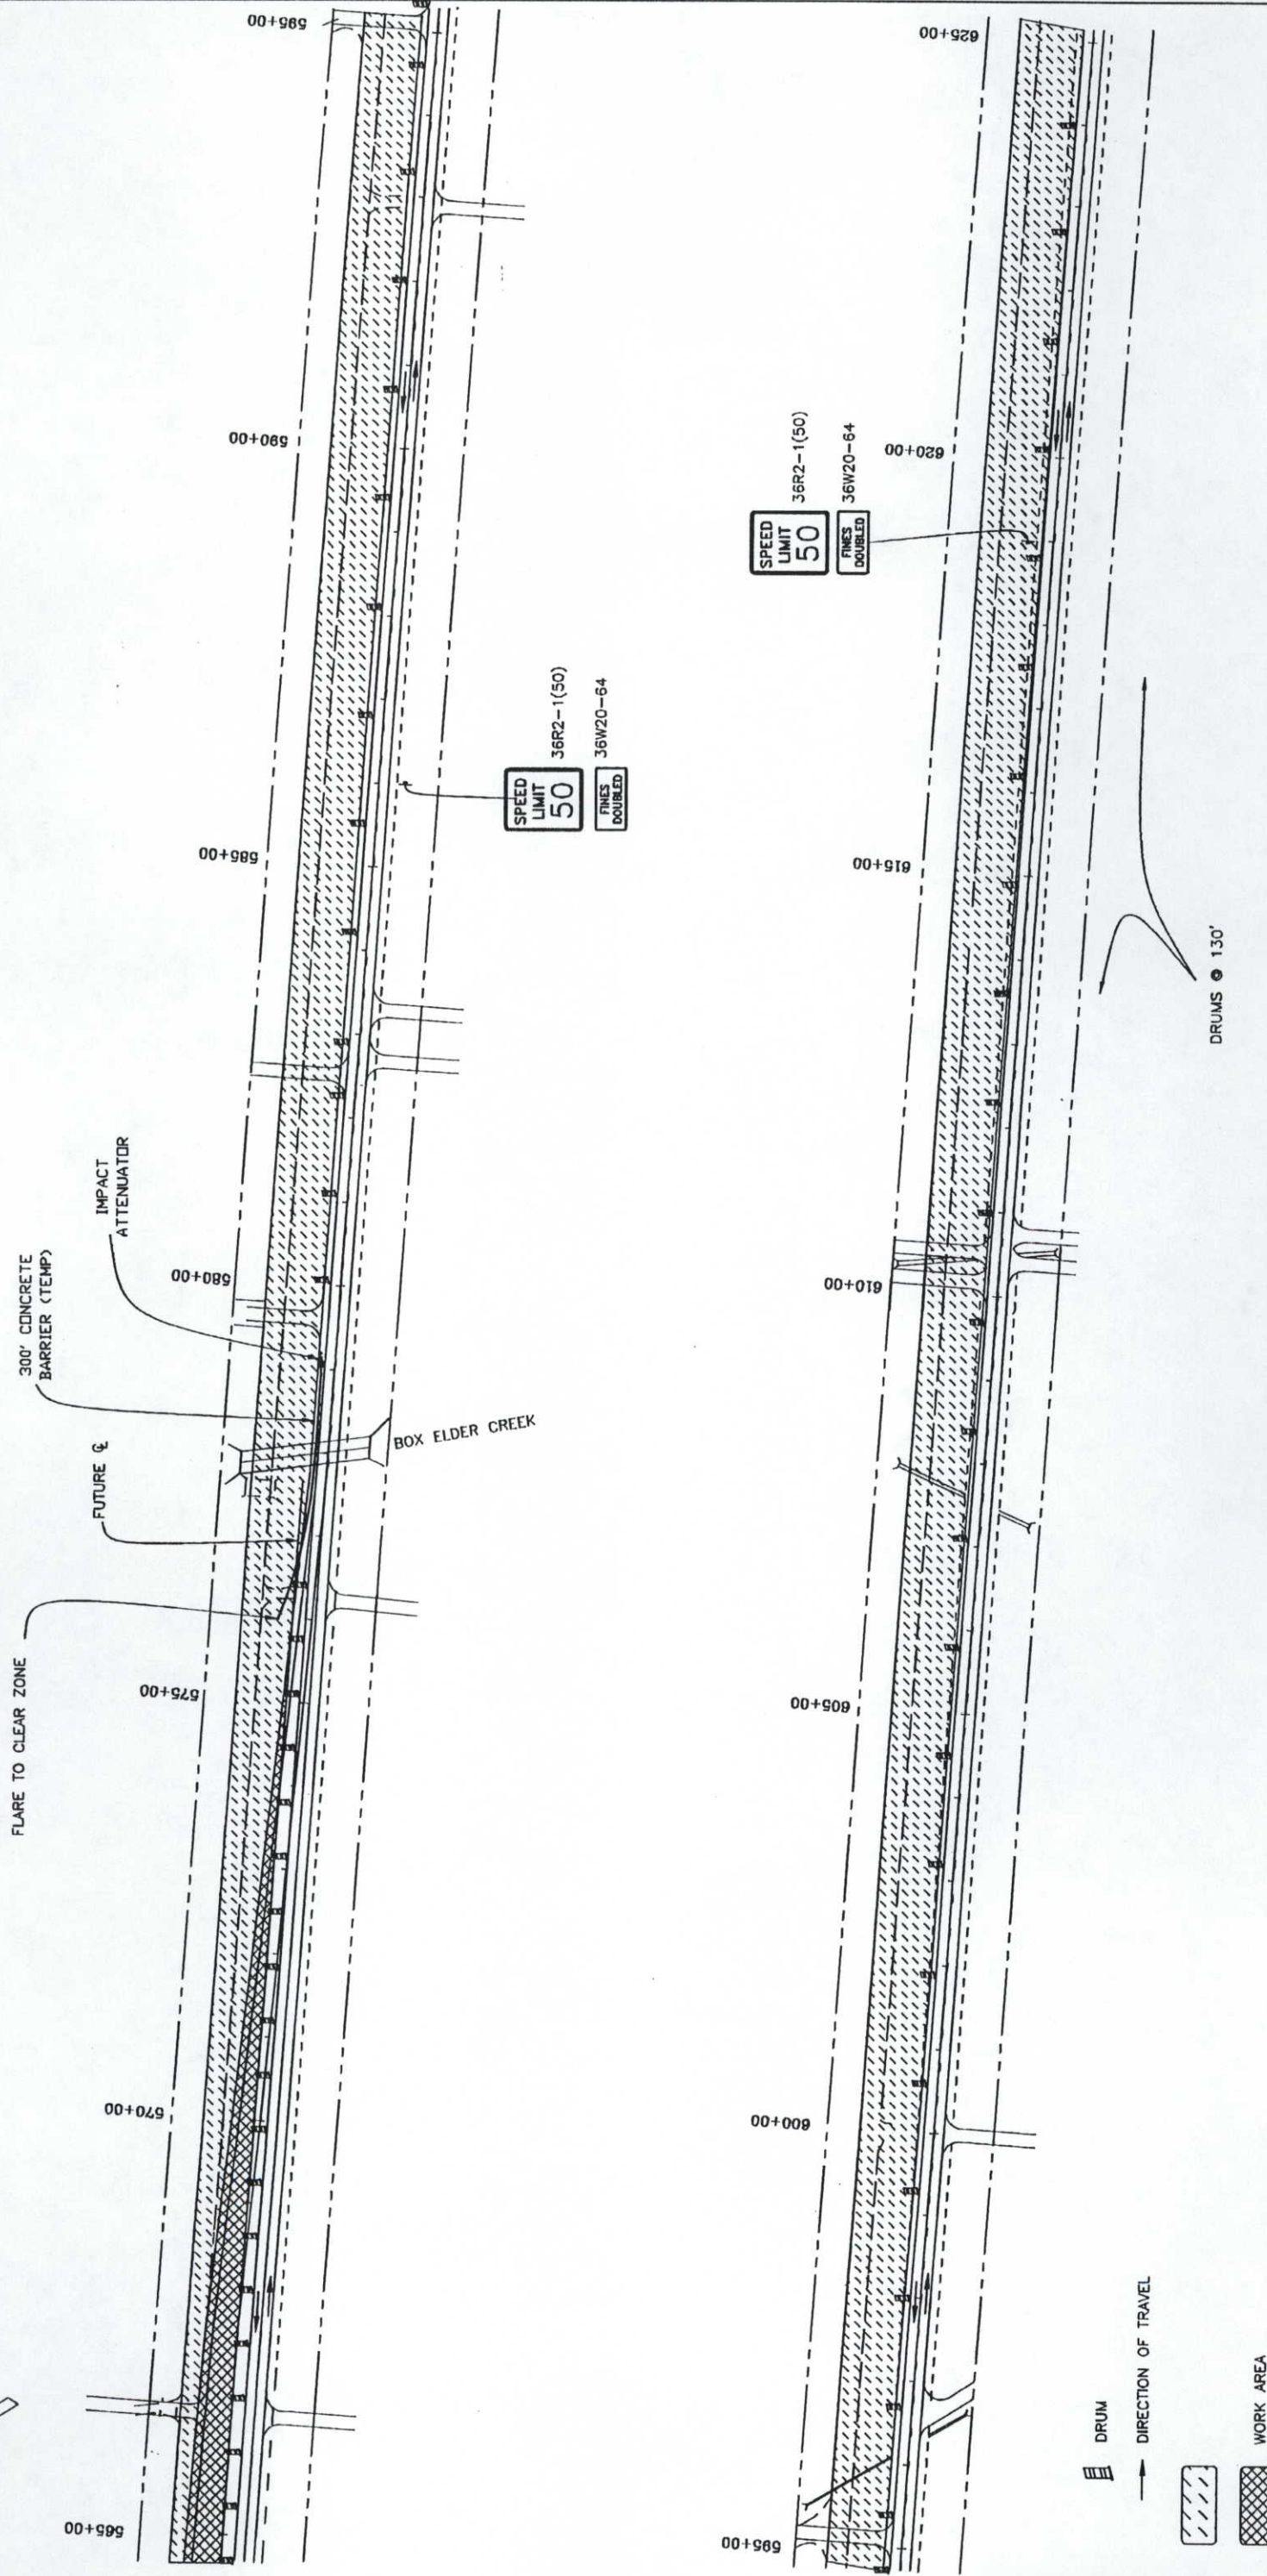

Computer File Information		Index of Revisions		As Constructed		Plan Sheet		Project No./Code		
Creation Date:	09/18/98	Initials:	SDH	No Revisions:	No Revisions		Designer: S.Haile Detailer: S.Haile		NH 0342-034	
Last Modification Date:	05/06/99	Initials:	SDH	Revised:	Revised:					Structure Numbers
Full Path:	\\R_4\34			Void:	11-7-00		Sheet Subset:	Traffic	Sheet Number	94
Drawing File Name:	CONST_PHASE_2_6.dwg			Colorado Department of Transportation						
Scale:	1" = 50 FEET			1325 S. Colorado Blvd. Denver, CO 80222 Phone: 303-757-9355 FAX: 303-512-5119						
				Traffic Safety & Traffic Engineering						


CONSTRUCTION SIGNING PLAN PHASE 2

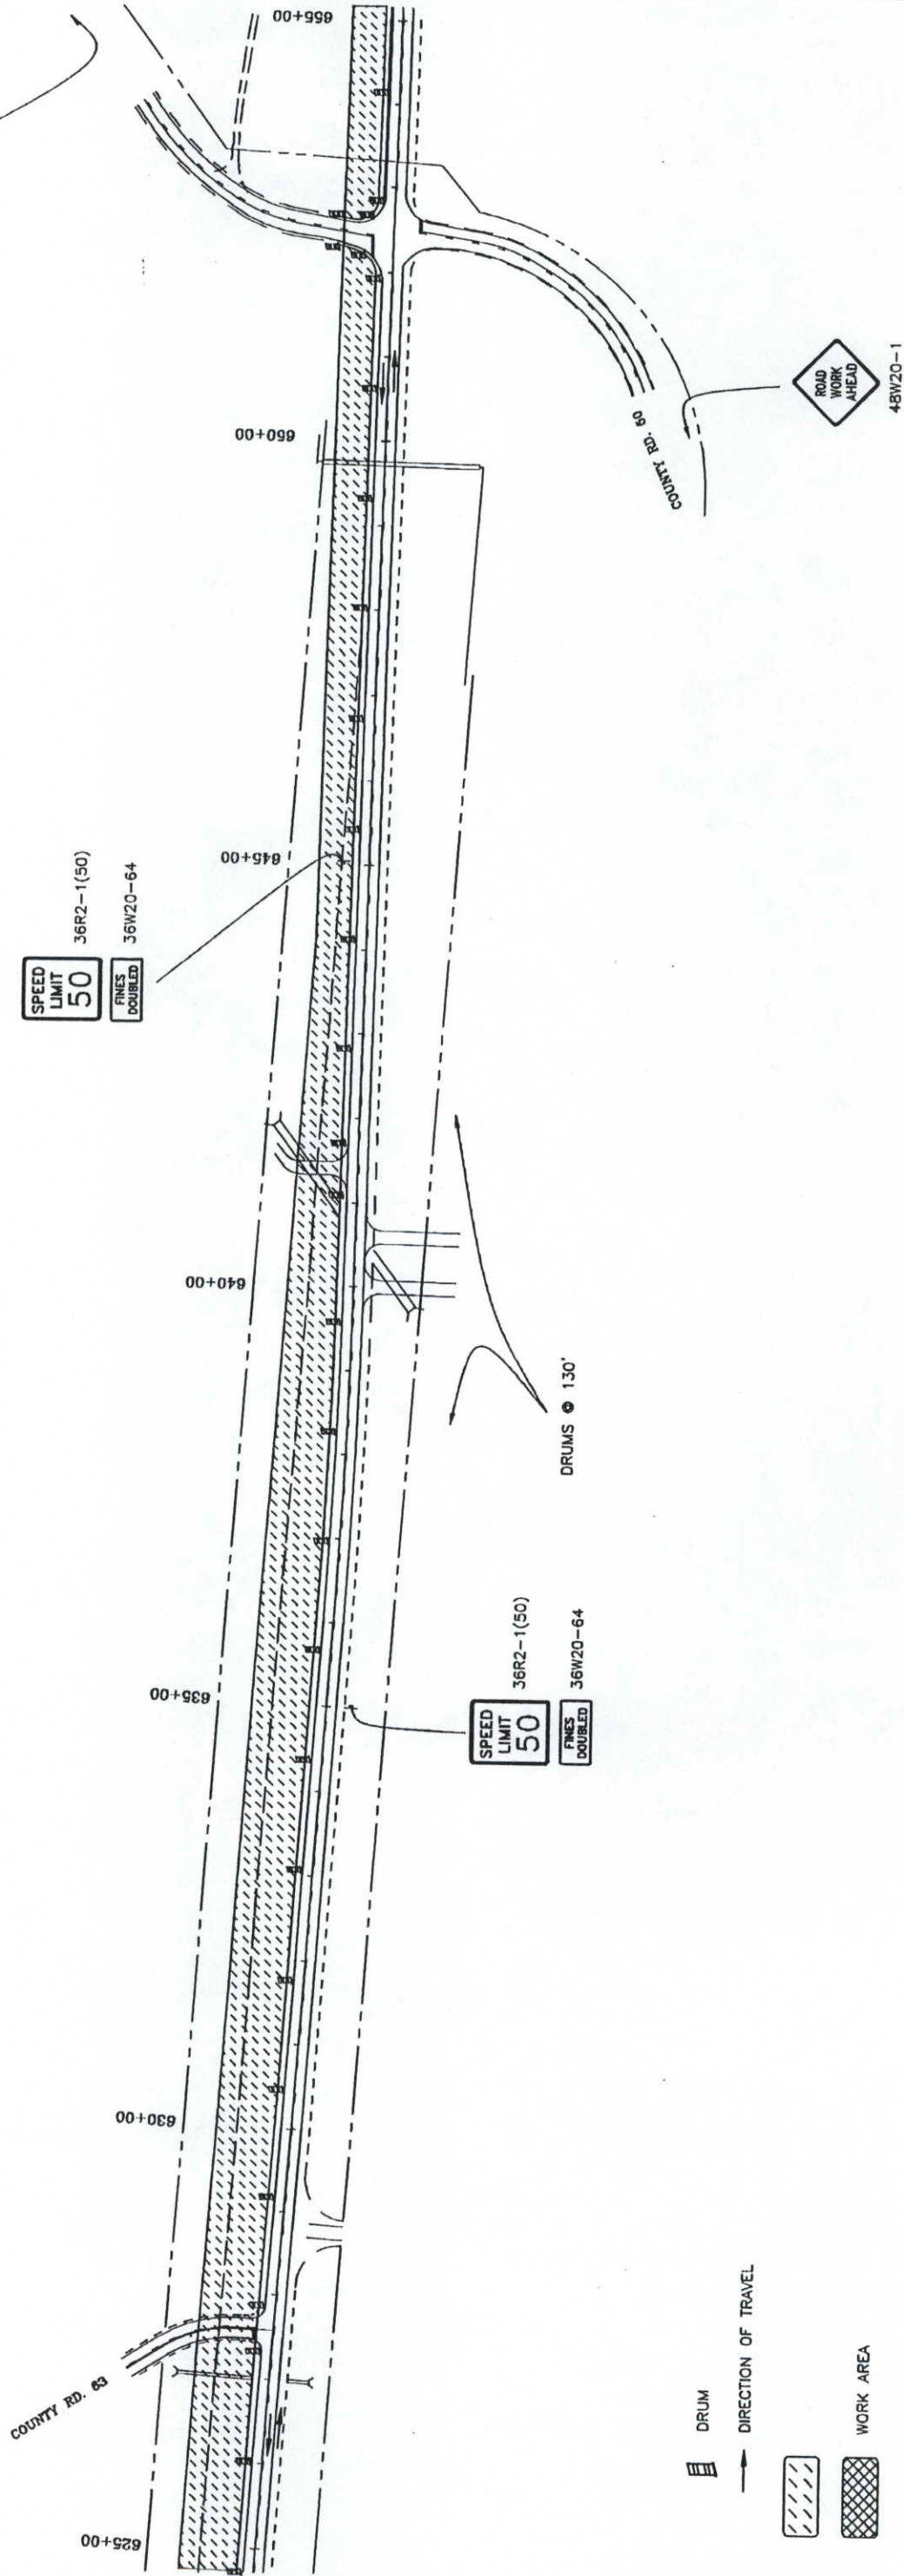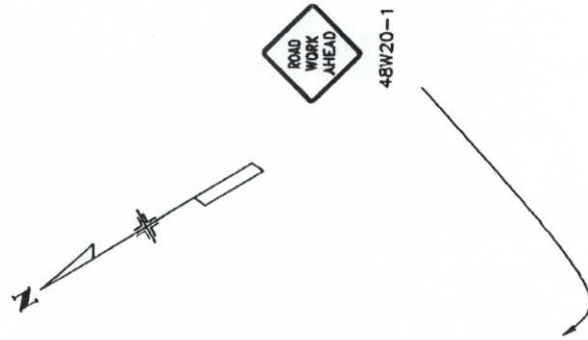




Computer File Information		Index of Revisions		As Constructed		Plan Sheet	
Creation Date:	09/18/98	Initials:	SDH	No Revisions:		Project No./Code	NH 0342-034
Last Modification Date:	05/06/99	Initials:	SDH	Revised:		Designer:	S.Haile
Full Path:	\R_4\34			Void:	11-2-00	Detailer:	S.Haile
Drawing File Name:	CONST_PHASE_2_7.dwg					Sheet Subset:	Traffic
Scale:	1" = 50 FEET					Structure Numbers	12658
						Sheet Number:	95

Colorado Department of Transportation
 1325 S. Colorado Blvd.
 Denver, CO 80222
 Phone: 303-757-9355 FAX: 303-512-5119
 Traffic Safety & Traffic Engineering

CONSTRUCTION SIGNING PLAN PHASE 2

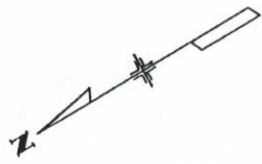

STA. 857+98.80 END PROJ. 0342-023
ON PROJ. CXFR 03-0034-13

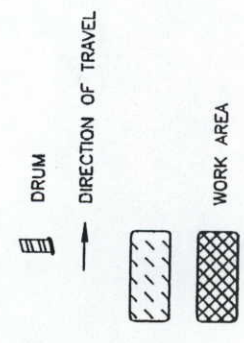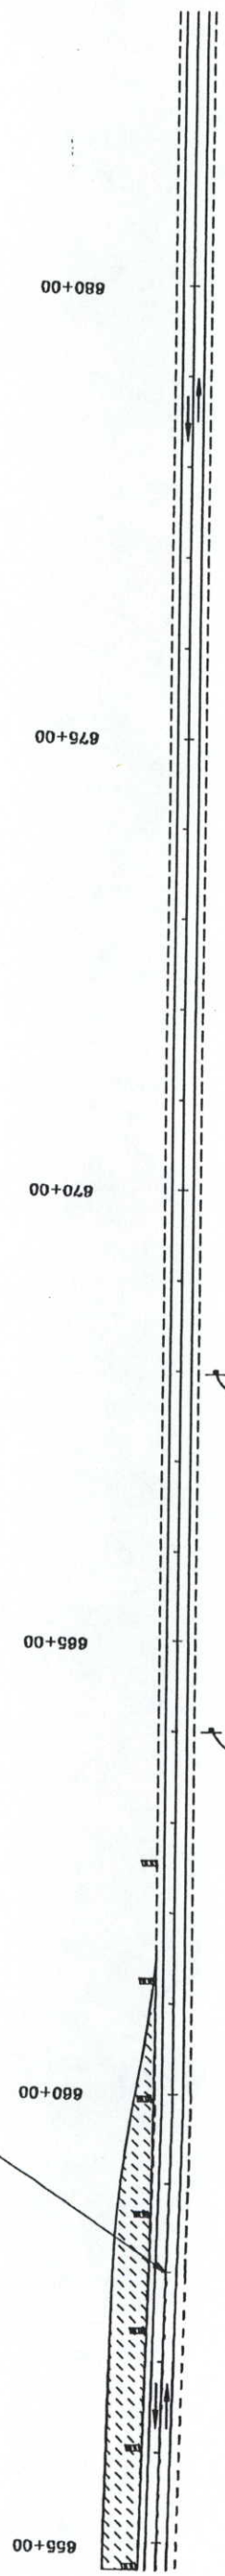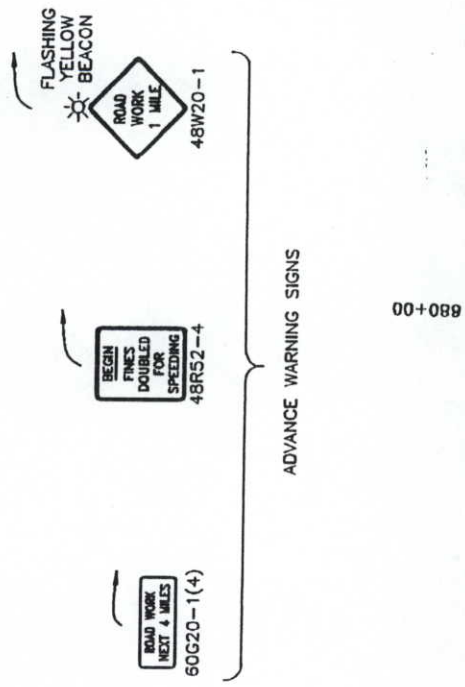

Computer File Information		Index of Revisions		As Constructed		Plan Sheet		Project No./Code	
Creation Date:	09/18/98	Initials:	SDH	No Revisions:		Designer: S.Haile Detailer: S.Haile Sheet Subset: Traffic		NH 0342-034 12658	
Last Modification Date:	05/24/99	Initials:	MCS	Revised:					
Full Path:	\\R_4\34			Void:	11-2-00				
Drawing File Name:	CONST_PHASE_2_8.dwg			Colorado Department of Transportation 1325 S. Colorado Blvd. Denver, CO 80222 Phone: 303-757-9355 FAX: 303-512-5119		Traffic Safety & Traffic Engineering		Sheet Number 96 Subset Sheet Number:	
Scale:	1" = 50 FEET								

Oversight/NHS
 FHWA Region VIII Oversight? NO YES
 National Highway System? NO YES

P.E., R.O.W. under
 Proj. CY-CX 03-0034-19
 Subaccount 90656



FED. ROAD REGION	DIVISION	PROJECT NO.	SHEET NO.
VIII	COLO.	NH 0342-034	1
NO REVISIONS			VOID
AS CONSTRUCTED			

COLORADO DEPARTMENT OF TRANSPORTATION

AS CONSTRUCTED
 PLAN AND PROFILE OF ~~PROPOSED~~
FEDERAL AID PROJECT NH 0342-034
STATE HIGHWAY NO. 34
WELD COUNTY
CONSTRUCTION SUBACCOUNT NO. 12658

SCALES OF ORIGINAL DRAWINGS
 ON PLAN 1" = 50'
 ON PROFILE 1" = 50' Horiz.
 1" = 5' Vert.
 GRADE LINE ON PROFILE IS SHOWN AS GRADE OF FINISHED ROAD

TABULATION OF LENGTH & DESIGN DATA	
Station	Major Structure
Lin. Ft.	Lin. Ft.
447+00.00 ~ Begin NH 0342-034 = 477+00 on Proj. STA 0342-019 M.P. 121.689	26.50
577+88.71 Major Str. C-19-AJ 578+15.21	26.50
657+99.60 ~ End NH 0342-034 = 708+53.20 on Proj. CXFR 03-0034-13 M.P. 125.685	26.50
Totals	21,073.10
SUMMARY	Miles
Roadway (Net Length)	3.991
Major Structure C-19-AJ	0.005
Project Gross Length	3.996
Design Data	
Maximum Degree of Curve	2° 00' 00"
Maximum Grade	2.025%
Minimum S.S.D. Horizontal	625'
Minimum S.S.D. Vertical	778'
Maximum Design Speed	70 MPH
2019 Design Data	
{ DHV = 700 ADT = 6300 Trucks = 27%	
1998 ADT = 4500	
Clear Zone Distance = 32' (Tangent)	

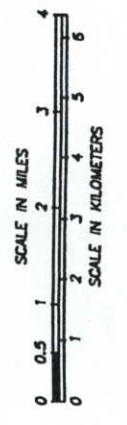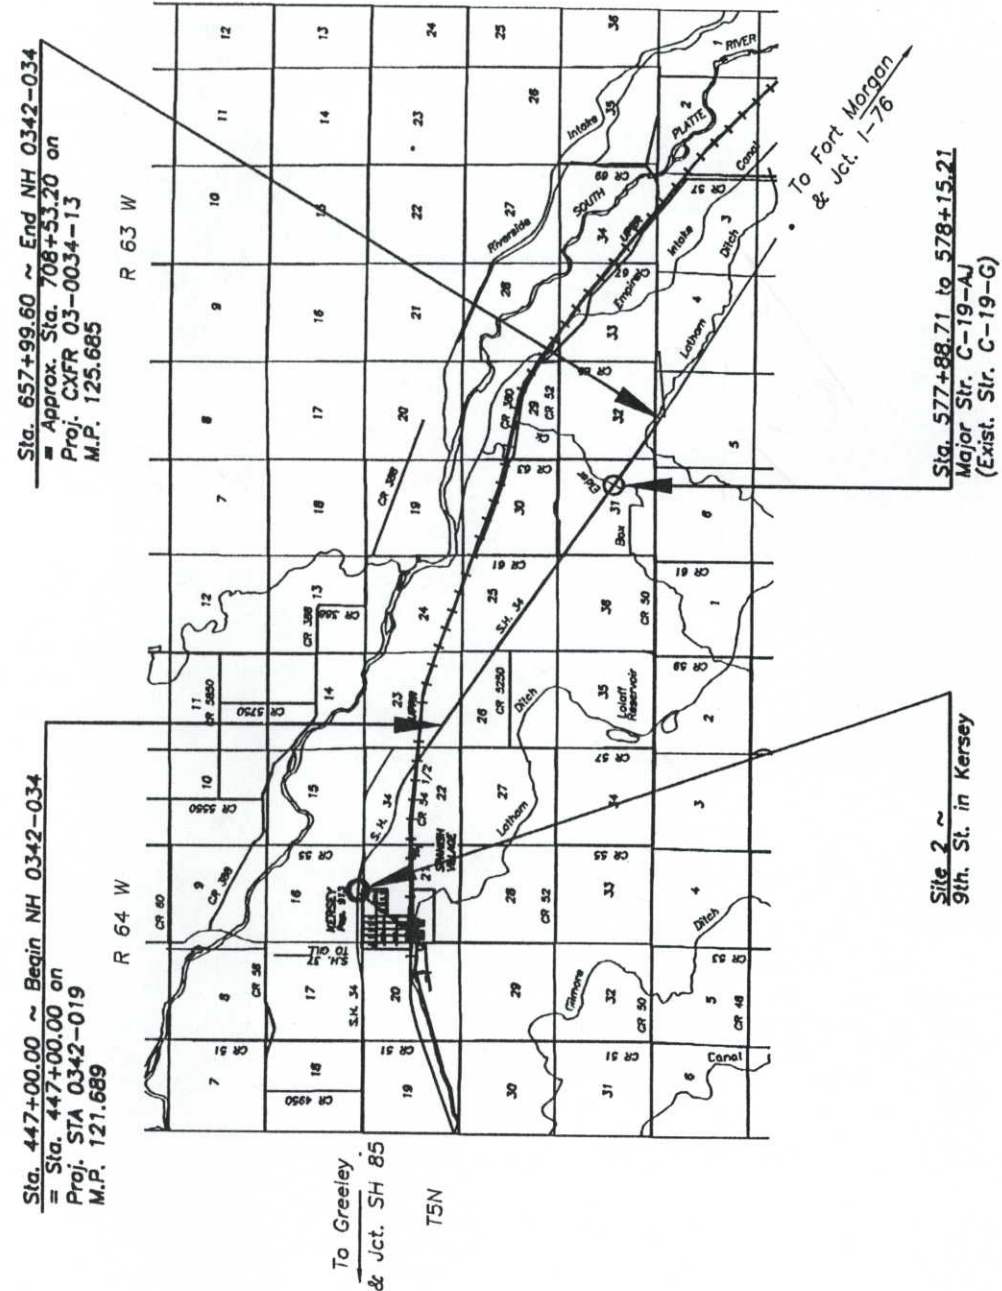

HARDIN WEST ROADWAY

SHEET NO.

SHEET NO.	INDEX OF SHEETS
1	Title Sheet
2	Standard Plans List
3-6	Typical Sections
7	General Notes
8-11	Summary of Approximate Quantities
12-15	Structure Quantities
16	Surfacing Plan
17	Earthwork Summary, Details of Embankment, Removal of Pavement
18	Single Concrete Box Culvert (Special for This Project Only)
19	Tabulation of Deineators, Tabulation of Fence & Gates, Removal of Trees
20	Coordinate Geometry ~ S.H. 34
21	Coordinate Geometry ~ Co. Rds. 61, 63, & 50
22	Control Points
23	Monfort Intersection Details
24	Co. Rd. 61 Intersection Details
25	Roadway Transition
26-55	Plan Sheets & Profile Sheets
56	Survey Tabulation Sheet
57	Stormwater Management Plan
58	Tabulation of Traffic Engineering Items, Schedule of Construction Traffic Control Devices
59-62	Tabulation of Signs
63	Tabulation of Pavement Markings
64-65	Ground Mounted Sign Support Details
66	Pavement Marking, Words and Symbols
67-68	Sand Barrel Details
69-81	Permanent Signing & Striping Plan
82-88	Construction Signing Plan ~ Phase 1
89-96	Construction Signing Plan ~ Phase 2
	R.O.W. Plans (48 sheets)

NEW & REVISED STANDARDS

- M-107-1, Temporary Erosion Control
- 03-24-97 (4 Sheets)
- M-206-1, Excavation and Backfill for Structures
- 05-07-99 (3 Sheets)
- M-412-1, Concrete Pavement Joints
- 08-21-97 (2 Sheets)
- M-601-1, Single Concrete Box Culvert
- 05-07-99 (2 Sheets)
- M-601-2, Double Concrete Box Culvert
- 05-07-99 (2 Sheets)
- M-601-10, Headwall for Pipe Culverts
- 08-26-98 (1 Sheet)
- M-601-20, Wingwalls for Pipe or Box Culverts
- 08-26-98 (1 Sheet)
- M-614-1, Rumble Strips
- 05-07-99 (2 Sheets)
- M-629-1, Survey Monuments 08-28-97 (2 Sheets)

AS CONSTRUCTED INFORMATION

Contractor **CASTLE ROCK CONSTR**

Project Engineer **MICHAEL WELLS**

Project Started **AUG 16, 1999**

Project Completed **Nov. 2, 2000**

As Constructed Plans Approved **Andrew J. Lawson 3/15/01** Resident Engr. Date

RKP/R-4