

V-File 10578

Oversight / NHS	
FHWA REGION VIII OVERSIGHT	☐ NO ☒ YES
NATIONAL HIGHWAY SYSTEM	☐ NO ☒ YES

DEPARTMENT OF TRANSPORTATION
STATE OF COLORADO
RIGHT OF WAY OF PROPOSED


Related Projects:
P. E. and R.O.W. UNDER PROJECT:
Project Number NH 1602-058
Project Code 10578

CONVENTIONAL SIGNS

- COUNTY LINE ————
TOWNSHIP OR RANGE LINE ————
LAND LINES SECTION LINE 1/4 SECTION LINE 1/16 SECTION LINE
PROPERTY OR TRACT LINE ————
CITY LIMITS ————
RAILROAD ————
EXISTING ROAD ————
NEW ROAD ————
CONTROL OF ACCESS ————
ACCESS DENIED BY DEED ————
RIGHT OF WAY LINE ————
PROTECTED BY FREEWAY LAW (VIRGIN LOCATION) ————
TOP OF CUTS ————
TOE OF FILLS ————
BARBED WIRE FENCE ————
CHAIN LINK FENCE ————
WOVEN WIRE-COMBINATION FENCE ————
SNOW FENCE ————
WOOD FENCE ————
DEER FENCE ————
SINGLE TREES ○ DECIDUOUS ★★ CONIFEROUS
TEL. & CABLE TV LINES ○ EXIST. ○ NEW ○ RELOCATED ✕ TO BE REMOVED
ELECTRIC LINES ● EXIST. ● NEW ● RELOCATED ✕ TO BE REMOVED
ELEC. TRANS. TOWER □ EXIST. □ NEW □ RELOCATED ✕ TO BE REMOVED
BURIED TEL. CABLE ———— EXIST. ———— NEW ————
BURIED ELECTRIC CABLE ———— EXIST. ———— NEW ————
FIBER OPTICS CABLE ———— EXIST. ———— NEW ————
GAS MAIN ———— EXIST. ———— NEW ————
OIL MAIN ———— EXIST. ———— NEW ————
WATER MAIN ———— EXIST. ———— NEW ————
SANITARY SEWERS ———— EXIST. ———— NEW ————
STORM DRAIN ———— EXIST. ———— NEW ————
ROAD APPROACHES ———— NEW ———— EXISTING ————
SECTION CORNER 1/6 CENTER OF SECTION ————
TIES TO SECTION CORNER ————
CULVERTS & DRAINS
PROPOSED EXISTING NO HDWL 1 HDWL 2 HDWLs END SECTIONS
PROPOSED EXISTING SIPHON CBC
BRIDGES
PROPOSED EXISTING


FEDERAL AID PROJECT NO. NH 1602-058
STATE HIGHWAY NO. 160
ALAMOSA AND RIO GRANDE COUNTIES

SCALE OF ORIGINAL DRAWINGS
PLAN SHEETS 1:1000
OWNERSHIP MAP 1:4000

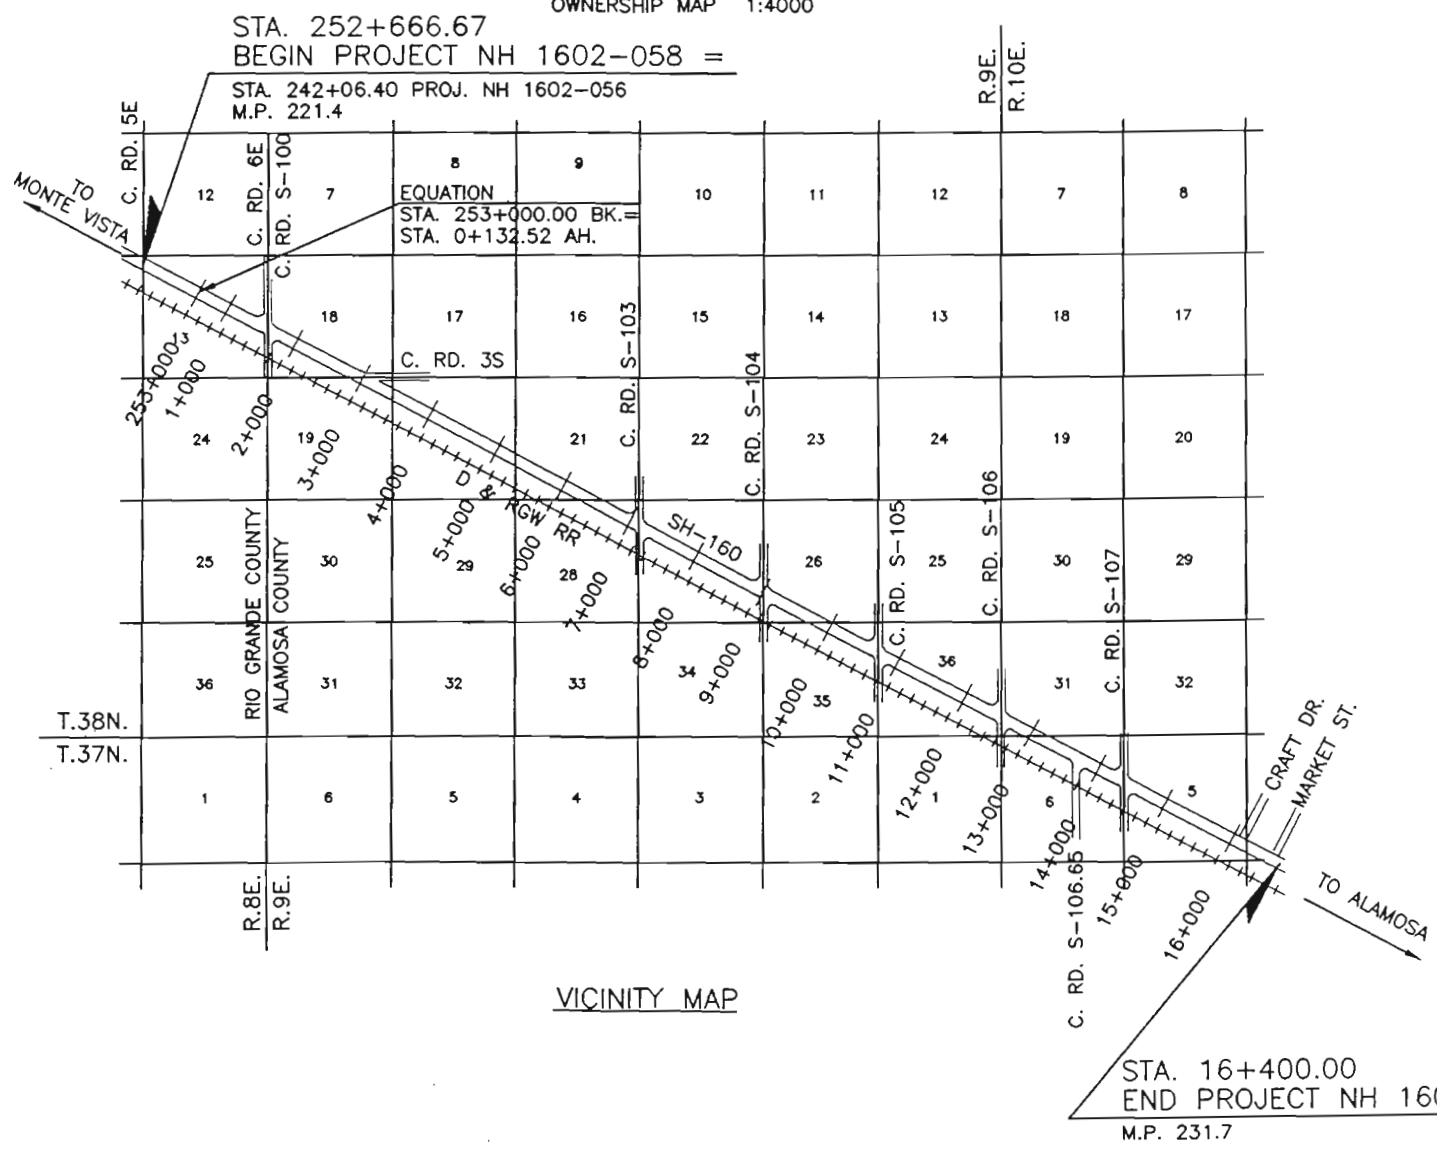

INDEX OF SHEETS

SHEET NO.	DESCRIPTION
1	TITLE SHEET
1A	INDEX OF REVISIONS
2 THRU 2H	PROPERTY OWNERSHIP TABULATION
3 THRU 3F	CONTROL AND MONUMENTATION
4 THRU 4G	SURVEY CONTROL
5 THRU 50	ROW PLAN SHEETS
51 THRU 62	OWNERSHIP MAPS

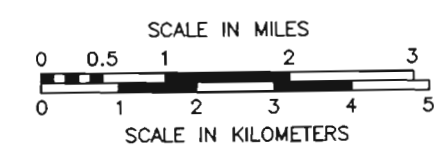

BASIS OF BEARINGS:

THE LINE BETWEEN CDOT CONTROL MONUMENT NO. 31 (A 3 1/4" ALUM. CAP) AND CDOT CONTROL MONUMENT NO. 32 (A 3 1/4" ALUM. CAP) BEARS S61°50'09"E AS DETERMINED BY G.P.S. (GEODETIC) OBSERVATION.

DEPARTMENT OF TRANSPORTATION
FEDERAL HIGHWAY ADMINISTRATION

AUTHORIZED _____ DATE _____

DIVISION ADMINISTRATOR

Computer File Information		Index of Revisions		Colorado Department of Transportation		As Constructed		TITLE SHEET		Project No./Code	
Creation Date: 06/30/97	Initials: SLA	5/7/98	INDEX OF SHEETS, BASIS	3803 North Main Avenue, Suite 300		No Revisions:		C. R. 6E TO CRAFT DR.		NH 1602-058	
Last Modification Date: 03/01/2000	Initials: JHL		OF BEARINGS DESCRIPTION	Durango, Colorado 81301		Revised:		Designer:		10578	
Full Path: BEAST F:\JOBS\CDOT\5657-003\PHASE-ONE				Phone: 970-385-1400 FAX: 970-385-1410		Void:		Detailer:		Sheet Number 1	
Drawing File Name: P-TITLE.DWG		**NOTE**: SEE SHEET 1A "INDEX OF REVISIONS" FOR PLAN SET REVISIONS.		Region 5				Sheet Subset: TITLE		Subset Sheets: 1 of 2	
Acad Ver. R14	Scale: N.T.S.										

INDEX OF REVISIONS

FOR

FEDERAL AID PROJECT NO. NH 1602-058

STATE HIGHWAY NO. 160

ALAMOSA AND RIO GRANDE COUNTIES

R1-12/1/97-EDC

- *Sheets(as noted on plans) R1 revisions were the first set of revisions made per comments from CDOT.

R2A-3/30/98-EDC

- *Sheet-7 Parcel TE-66 was converted to PE-66. Parcel TE-67 was converted to PE-67. Parcel revisions noted: TE-67A REV.
- *Sheet-8 Parcel revisions noted: PE-67 & TE-67A REV.
- *Sheet-9 Parcel TE-67A was adjusted to allow for building demolition and renamed TE-67A REV. Parcel revisions noted: PE-67.
- *Sheet-10 Parcel TE-1 adjusted to allow for building demolition and renamed TE-1 REV. Parcel revisions noted: TE-67A REV.

R2A-4/20/98-EDC

- *Sheet-30 Parcels 15, PE-15, and TE-15 were adjusted to reflect new easterly property line. Parcels 16 REV, 16A REV, PE-16 REV, and TE-16 REV were revised to reflect the new easterly and westerly property lines. Parcels 17 and PE-17 were adjusted to reflect the new westerly property line.

R2A-5/8/98-EDC

- *Sheet-51 Parcels TE-66 and TE-67 were converted to permanent easements for culvert construction and maintenance.
- *Sheet-52 Parcels TE-67AREV and TE-1REV was revised to allow for the necessary building demolition and driveway construction.
- *Sheet-56 Parcels TE-12 was added for driveway construction.
- *Sheet-57 Parcels 15, PE-15, and TE-15 were revised to reflect an updated easterly boundary line. Parcels 16REV, 16AREV, and PE-16REV were revised to reflect updated easterly and westerly boundary lines.

R2A-5/8/98-EDC(cont)

- *Sheet-57(cont) Parcels TE-16REV was revised to allow for the necessary building demolition and driveway construction. Parcels 17 and PE-17 were revised to reflect an updated westerly boundary line.
- *Sheet-58 thru 62 Parcels #52-62et.al. and 70et.al. were deleted per instructions from FHU(Steve Z.).

R2B-5/7/98-EDC

- *Sheet-1 Index of sheets revised to reflect sheet deletions and change of basis of bearings description.

R2C-5/8/98-EDC

- *Sheet-4 thru 4G Revised section line information to reflect newly recovered field evidence and monumentation upgrades performed.

R2D-5/11/98-EDC

- *Sheet-2 Revised parcel TE-1REV area and remarks to reflect the right-of-way plans.
- *Sheet-2C Revised parcels 15-16et.al. areas to reflect the right-of-way plans.
- *Sheet-2D Revised parcels 16et.al., 17, PE-17, and PE-18 areas to reflect the right-of-way plans.
- *Sheet-2E Deleted parcels #20-63et.al. and revised parcels 64B, TE-64A, and TE-64B areas to reflect the right-of-way plans.
- *Sheet-2F Revised parcels TE-64J, TE-64K, and TE-64L areas to reflect the right-of-way plans.
- *Sheet-2G Deleted parcels #68-72et.al. and revised parcels PE-67, TE-67A and TE-67B areas to reflect the right-of-way plans.
- *Sheet-2H Deleted parcels #68-72et.al. to reflect the right-of-way plans.

R2E-5/11/98-EDC

- *Sheet-2 Parcel PE-3 was added to reflect the right-of-way plans.
- *Sheet-13 Plotted additional recorded easements on parcels 2, 3, and 3A per documents provided by CDOT. Parcel PE-3 was added to replace the existing easement being effected by the right-of-way take for Hwy 160.
- *Sheet-53 Parcel PE-3 was added to reflect the right-of-way plans.

R2F-5/12/98-EDC

- *Sheet-3 thru 3H Revised and adjusted coordinates to show updated point locations after revisions. Revised sheets to show only right-of-way, county right-of-way, permanent easement and temporary easement points only.
- *Sheet-3A Added quantity of monument to be set chart.

R3-11/6/98-EDC

- *Sheet-3A Revised pnt #34 coordinates due to typo error.
- *Sheet-4 thru 4A Revised pnt #34 location and adjusted bearings and distances shown to that point.

R2G-3/1/00-JHL

- *Sheet-2A Revised to add Parcels 5D & 5E
- *Sheet-3A Revised quantity of monuments to be set.
- *Sheet-3B Revised tabulation of R.O.W. Markers to be set.
- *Sheet-3C Revised tabulation of R.O.W. Markers to be set.
- *Sheet-15 Revised to add parcels 5D & 5E.
- *Sheet-15A Revised to add parcels 5D & 5E.
- *Sheet-53 Revised to add parcels 5D & 5E.

Computer File Information		Index of Revisions		Colorado Department of Transportation		As Constructed		INDEX OF REVISIONS		Project No./Code
Creation Date: 04/06/98	Initials: EDC	☐	5/12/98	UPDATED	EDC	No Revisions:		C. R. 6E TO CRAFT DR.		NH 1602-058
Last Modification Date: 03/01/2000	Initials: JHL	☐	11/6/98	UPDATED	EDC	Revised:		Designer: EDC		10578
Full Path: BEAST F:\JOBS\CDOT\5657-003\DWGS-IN-PROGRESS		☐				Void:		Detailer: EDC		Sheet Number 1A
Drawing File Name: REVISIONS-INDEX.DWG		☐						Sheet Subset: TITLE	Subset Sheets: 1 of 1	
Acad Ver. R14	Scale: N.T.S.	Units: METRIC								



3803 North Main Avenue, Suite 300
Durango, Colorado 81301
Phone: 970-385-1400 FAX: 970-385-1410

Region 5

PROPERTY OWNERSHIP TABULATION



PARCEL NO.	OWNER	ADDRESS	LOCATION	PARCEL REC. DATA	AREA IN HECTARES (ACRES)			PARCEL NO.	REMARKS
					PARCEL	REMAINDER			
						LEFT	RIGHT		
			T. 38 N., R. 9 E., NM. P.M.						
			ALAMOSA COUNTY, CO						
1-REV	LARRY AND ANN MITCHELL	5348 ROAD 10 SOUTH	TRACTS 1,2,3 MID-VALLEY COMMERCIAL	BK 528, PG 257	0.2059	2.3521		1-REV	
		ALAMOSA, CO 81101	SUBDIVISION IN SW 1/4 Section 18		(0.5088)	(5.8120)			
1A-REV	(SAME AS ABOVE)	(SAME AS ABOVE)	(SAME AS ABOVE)		0.2221			1A-REV	FOR ALAMOSA COUNTY CO. RD. 100-SOUTH ROW
					(0.5488)				
1B-REV	(SAME AS ABOVE)	(SAME AS ABOVE)	(SAME AS ABOVE)		0.1913	2.2505		1B-REV	
					(0.4728)	(5.5609)			
1C-REV	(SAME AS ABOVE)	(SAME AS ABOVE)	(SAME AS ABOVE)		0.1272	2.1385		1C-REV	
					(0.3143)	(5.2842)			
TE-1-REV	(SAME AS ABOVE)	(SAME AS ABOVE)	(SAME AS ABOVE)		0.2442			TE-1-REV	FOR COUNTY ROAD CONSTRUCTION AND BUILDING DEMOLITION
					(0.6034)				
2	WILEY CHIROPRACTIC GROUP	P.O. BOX 510	TRACT 4 MID-VALLEY COMMERCIAL	BK 277, PG 246	0.2627	7.8481		2	
		MONTE VISTA, CO 81144	SUB. EX. IN SW 1/4 & SE 1/4 Section 18		(0.6491)	(19.3726)			
TE-2	(SAME AS ABOVE)	(SAME AS ABOVE)	(SAME AS ABOVE)		0.022			TE-2	FOR ROAD APPROACH CONSTRUCTION
					(0.054)				
3	PAUL M. AND CHERYL D. McCARTY	2095 E. ROAD 3 N.	PART OF SE 1/4 Section 18	BK 548, PG 55	0.0219	0.7634		3	
		MONTE VISTA, CO 81144			(0.0541)	(1.8863)			
3A	(SAME AS ABOVE)	(SAME AS ABOVE)	(SAME AS ABOVE)		0.0363	0.3742		3A	
					(0.0896)	(0.9246)			
PE-3	(SAME AS ABOVE)	(SAME AS ABOVE)	(SAME AS ABOVE)		0.0422			PE-3	IN FAVOR OF WILEY CHIROPRACTIC GROUP
					(0.1386)				

Computer File Information			Index of Revisions			Colorado Department of Transportation		As Constructed		PROPERTY OWNERSHIP TABULATION		Project No./Code	
Creation Date: 5/20/97	Initials: JRY		(12-97)	12/24/97	PARCELS 1-REV, 1A-REV, 1B-REV, 1C-REV, TE-1-REV	 3803 North Main Avenue, Suite 300 Durango, Colorado 81301 Phone: 970-385-1400 FAX: 970-385-1410		No Revisions:		C. R. 6E TO CRAFT DR.		NH 1602-058	
Last Modification Date: 11/24/97	Initials: EDC							Revised:		Designer: EDC		10578	
Full Path: BEAST F:\JOBS\CDOT\5657-003\PHASE-ONE								Void:		Detailer: EDC			
Drawing File Name: P-1TABS2.DWG			(R2D)	5/11/98	PARCELS TE-1REV					Sheet Subset: TABS			
Acad Ver. R14	Scale: N.T.S.	Units: METRIC	(R2E)	5/11/98	PARCELS PE-3	Region 5				Subset Sheets: 1 of 9		Sheet Number: 2	


PROPERTY OWNERSHIP TABULATION



PARCEL NO.	OWNER	ADDRESS	LOCATION	PARCEL REC. DATA	AREA IN HECTARES (ACRES)			PARCEL NO.	REMARKS
					PARCEL	REMAINDER			
						LEFT	RIGHT		
			T. 38 N., R. 9 E., NM. P.M.						
			ALAMOSA COUNTY, CO						
TE-3	PAUL M. AND CHERYL D. McCARTY	2095 E. ROAD 3 N. MONTE VISTA, CO 81144	PART OF SE 1/4 Section 18	BK 548, PG 55	0.025 (0.061)			TE-3	FOR ROAD APPROACH CONSTRUCTION
4	THE ESTATE OF DAVID O. PLANK	P.O. BOX 262591 HOUSTON, TX 77207	PART OF NE 1/4 Section 19	BK 303, PG 396	0.1367 (0.3378)	1.4811 (3.6598)		4	
TE-4	(SAME AS ABOVE)	(SAME AS ABOVE)	(SAME AS ABOVE)		0.035 (0.086)			TE-4	FOR REMOVAL OF WEIGH SCALE FOUNDATION
5	THE ESTATE OF DAVID O. PLANK & BETTY F. PLANK	P.O. BOX 262591 HOUSTON, TX 77207	PART OF NE 1/4 Section 19 AND Section 20	BK 194, PG 43	0.1716 (0.4240)	0.6122 (1.5127)		5	
5A	(SAME AS ABOVE)	(SAME AS ABOVE)	PART OF NE 1/4 Section 19 AND Section 20		0.3688 (0.9113)	8.0835 (19.9742)		5A	
5B	(SAME AS ABOVE)	(SAME AS ABOVE)	PART OF NE 1/4 Section 19 AND Section 20		0.6427 (1.5881)			5B	
5C	(SAME AS ABOVE)	(SAME AS ABOVE)	PART OF NW 1/4 Section 20		0.5173 (1.2783)			5C	FOR ALAMOSA COUNTY CO.RD. 3-SOUTH ROW
5D	(SAME AS ABOVE)	(SAME AS ABOVE)	PART OF NE 1/4 Section 19 AND Section 20		0.1451 (0.3586)			5D	FOR ALAMOSA COUNTY CO.RD. 3-SOUTH ROW
5E	(SAME AS ABOVE)	(SAME AS ABOVE)	PART OF NE 1/4 Section 19 AND Section 20		0.1071 (0.2647)			5E	FOR ALAMOSA COUNTY CO.RD. 3-SOUTH ROW
TE-5	(SAME AS ABOVE)	(SAME AS ABOVE)	PART OF NE 1/4 Section 19 AND Section 20		0.409 (1.010)			TE-5	FOR COUNTY RD. ROAD APPROACH, AND SIDE SLOPE CONSTRUCTION
TE-5A	(SAME AS ABOVE)	(SAME AS ABOVE)	PART OF NE 1/4 Section 19 AND Section 20		0.126 (0.311)			TE-5A	FOR COUNTY ROAD AND SIDE SLOPE CONSTRUCTION

Computer File Information		Index of Revisions		 Colorado Department of Transportation 3803 North Main Avenue, Suite 300 Durango, Colorado 81301 Phone: 970-385-1400 FAX: 970-385-1410 Region 5	As Constructed		PROPERTY OWNERSHIP TABULATION		Project No./Code	
Creation Date: 5\20\97 Initials: JRY					No Revisions:		C. R. 6E TO CRAFT DR.		NH 1602-058	
Last Modification Date: 03/01/2000 Initials: JHL					Revised:		Designer: EDC		10578	
Full Path: BEAST F:\JOBS\CDOT\5657-003\PHASE-ONE					Void:		Detailer: EDC			
Drawing File Name: P-1TABS2.DWG							Sheet Subset: TABS		Sheet Number: 2A	
Acad Ver. R14 Scale: N.T.S. Units: METRIC						Subset Sheets: 2 of 9				


PROPERTY OWNERSHIP TABULATION

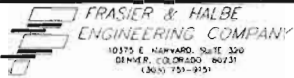

PARCEL NO.	OWNER	ADDRESS	LOCATION	PARCEL REC. DATA	AREA IN HECTARES (ACRES)			PARCEL NO.	REMARKS
					PARCEL	REMAINDER			
						LEFT	RIGHT		
			T. 38 N., R. 9 E., NM. P.M.						
			ALAMOSA COUNTY, CO						
6	COLORADO DEPARTMENT OF HIGHWAYS	STATE OF COLORADO	PART OF S 1/2 Section 21	BK 227, PG 187	1.480			6	
		DEPARTMENT OF HIGHWAYS			(3.658)				
7	BILL RUSH	1697 ROSS AVE.	TRACT 4, D-B SUBDIVISION- EXEMPTION	BK 453, PG 328	0.2593	2.2223		7	
		BURLINGTON, CO 80807	PART OF NE 1/4 Section 28		(0.6407)	(5.4913)			
8	HOWARD CATALANO	2405 PARK AVENUE	TRACT 3, D-B SUBDIVISION- EXEMPTION	RECP #283890	0.1611	2.268		8	
		ALAMOSA, CO 81101	PART OF NE 1/4 Section 28		(0.3980)	(5.6042)			
9	RAJIV BADHWAR, TRUSTEE	550 E. FLAMING GORGE WAY	TRACT 2, D-B SUBDIVISION- EXEMPTION	BK 276, PG 39	0.1565	2.4487		9	
		GREEN RIVER, WY 82935	PART OF NE 1/4 Section 28		(0.3867)	(6.0507)			
10	ROBERT B. AND JENNY E. MARQUEZ	ROUTE 1, BOX 387A	TRACT 1, D-B SUBDIVISION- EXEMPTION	BK 269, PG 79	0.1631	3.1259		10	
		ESPANOLA, NM 87532	PART OF NE 1/4 Section 28		(0.4031)	(7.7240)			
11	MONTE H. AND MARCIA M. COLLINS	4070 ROAD 103 S.	TRACT 2, COLLINS DIVISION OF LAND	BK 365, PG 73	0.7045	39.6383		11	
		ALAMOSA, CO 81101	NW 1/4 Section 27		(1.7409)	(97.9462)			
11A	(SAME AS ABOVE)	(SAME AS ABOVE)	(SAME AS ABOVE)		0.1626			11A	FOR ALAMOSA COUNTY CO. RD. 103-SOUTH ROW
					(0.4018)				
TE-11	(SAME AS ABOVE)	(SAME AS ABOVE)	(SAME AS ABOVE)		1.016			TE-11	FOR COUNTY ROAD, SIDE SLOPE, AND DRIVEWAY CONSTRUCTION
					(2.511)				
12	BONIFACIO AND RITA REYES	5146 ROAD 112.8 S.	NW 1/4 Section 27	BK 400, PG 304	0.0748	0.7354		12	
		ALAMOSA, CO 81101			(0.1848)	(1.8171)			

Computer File Information		Index of Revisions		Colorado Department of Transportation		As Constructed		PROPERTY OWNERSHIP TABULATION		Project No./Code	
Creation Date: 5/20/97				 3803 North Main Avenue, Suite 300 Durango, Colorado 81301 Phone: 970-385-1400 FAX: 970-385-1410 Region 5		No Revisions:		C. R. 6E TO CRAFT DR.		NH 1602-058	
Last Modification Date: 11/24/97						Revised:		Designer: EDC		10578	
Full Path: BEAST F:\JOBS\CDOT\5657-003\PHASE-ONE						Void:		Detailer: EDC			
Drawing File Name: P-1TABS2.DWG								Sheet Subset: TABS		Subset Sheets: 3 of 9	
Acad Ver. R14		Scale: N.T.S.		Units: METRIC						Sheet Number: 28	

PROPERTY OWNERSHIP TABULATION

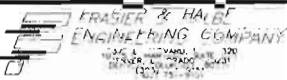

PARCEL NO.	OWNER	ADDRESS	LOCATION	PARCEL REC. DATA	AREA IN HECTARES (ACRES)			PARCEL NO.	REMARKS
					PARCEL	REMAINDER			
						LEFT	RIGHT		
			T. 38 N., R. 9 E., NM. P.M.						
			ALAMOSA COUNTY, CO						
13	ELMA G. WHITE	3599 HIGHWAY 160	TR. 2 & 3, WHITE DIVISION OF LAND NE	BK 159, PG 436	0.0344	1.668		13	
		ALAMOSA, CO 81101	1/4 Sec. 27 & PART OF SE 1/4 Sec. 27		(0.0850)	(4.122)			
13A	(SAME AS ABOVE)	(SAME AS ABOVE)	PART OF THE SE 1/4 Section 27		0.0410			13A	
					(0.1013)				
TE-13	(SAME AS ABOVE)	(SAME AS ABOVE)	PART OF THE SE 1/4 Section 27		0.036			TE-13	FOR ROAD APPROACH CONSTRUCTION
					(0.089)				
14	DANNY GAIL JOHNSON	P.O. BOX 1030	PART OF SE 1/4 Section 27	BK 455, PG 324	0.4569	12.9524		14	
		ALAMOSA, CO 81101			(1.1290)	(32.0053)			
PE-14	(SAME AS ABOVE)	(SAME AS ABOVE)	(SAME AS ABOVE)		0.3582			PE-14	PERMANENT EASEMENT FOR COMMONWEALTH IRRIGATION CO.
					(0.8851)				
15-REV	LINDA K. WARD	4673 ROAD 104 S.	PART OF SE 1/4 Section 27	BK 499, PG 29	0.1239	1.4924		15-REV	
		ALAMOSA, CO 81101			(0.3061)	(3.6877)			
PE-15	(SAME AS ABOVE)	(SAME AS ABOVE)	(SAME AS ABOVE)		0.0624			PE-15	PERMANENT EASEMENT FOR COMMONWEALTH IRRIGATION CO.
REV					(0.1541)			REV	
TE-15	(SAME AS ABOVE)	(SAME AS ABOVE)	(SAME AS ABOVE)		0.0169			TE-15	FOR ROAD APPROACH CONSTRUCTION
					(0.0418)				
16-REV2	ROY LEON SNIDER	4754 S. 104 ROAD	PART OF SW 1/4 Section 26	BK 421, PG 340	0.1533	2.0662		16-REV2	
		ALAMOSA, CO 81101			(0.3788)	(5.1055)			
16A-REV2	(SAME AS ABOVE)	(SAME AS ABOVE)	(SAME AS ABOVE)		0.1303			16A-REV2	FOR ALAMOSA COUNTY CO. RD. 104-SOUTH ROW
					(0.3219)				

Computer File Information			Index of Revisions			Colorado Department of Transportation		As Constructed		PROPERTY OWNERSHIP TABULATION		Project No./Code	
Creation Date: 5/20/97	Initials: JRY		(12-97)	12/24/97	PARCELS 16-REV,	 3803 North Main Avenue, Suite 300 Durango, Colorado 81301 Phone: 970-385-1400 FAX: 970-385-1410 Region 5		No Revisions:		C. R. 6E TO CRAFT DR.		NH 1602-058	
Last Modification Date: 11/24/97	Initials: EDC				16A-REV			Revised:		Designer: EDC		10578	
Full Path: BEAST F:\JOBS\CDOT\5657-003\PHASE-ONE			(R2D)	5/11/98	PARCELS 15-16et.al.			Void:		Detailer: EDC		Sheet Number: 2C	
Drawing File Name: P-1TABS2.DWG										Sheet Subset: TABS	Subset Sheets: 4 of 9		
Acad Ver. R14	Scale: N.T.S.	Units: METRIC											

**FRASIER & HALBE
ENGINEERING COMPANY**
10375 E. HARVARD, SUITE 320
DENVER, COLORADO 80231
(303) 751-6151

Computer File Information		Index of Revisions		Colorado Department of Transportation		As Constructed		PROPERTY OWNERSHIP TABULATION		Project No./Code	
Creation Date: 5/20/97 Initials: JRY		12/24/97 PARCELS PE-16-REV, EDC		 3803 North Main Avenue, Suite 300 Durango, Colorado 81301 Phone: 970-385-1400 FAX: 970-385-1410 Region 5		No Revisions:		C. R. 6E TO CRAFT DR.		NH 1602-058	
Last Modification Date: 11/24/97 Initials: EDC		TE-16-REV				Revised:		Designer: EDC		10578	
Full Path: BEAST F:\JOBS\CDOT\5657-003\PHASE-ONE		5/11/98 PARCELS 16et.al., 17, EDC				Void:		Detailer: EDC			
Drawing File Name: P-11ABS2.DWG		PE-17, PE-18						Sheet Subset: TABS		Subset Sheets: 5 of 9	
Acad Ver. R14 Scale: N.T.S. Units: METRIC										Sheet Number: 2D	

PROPERTY OWNERSHIP TABULATION




PARCEL NO.	OWNER	ADDRESS	LOCATION	PARCEL REC. DATA	AREA IN HECTARES (ACRES)			PARCEL NO.	REMARKS
					PARCEL	REMAINDER			
						LEFT	RIGHT		
			T. 38 N., R. 9 E., NM. P.M.						
			ALAMOSA COUNTY, CO						
19	LAURA E. SORUM	1D1 PIKE AVE.	TR. 3, HUNSAKER DIV. OF LAND PART OF	BK 91, PG 277	0.7498	16.2295		19	
		ALAMOSA, CO 81101	NE 1/4 Section 35		(1.8528)	(40.1030)			
PE-19	(SAME AS ABOVE)	(SAME AS ABOVE)	(SAME AS ABOVE)		0.0521			PE-19	PERMANENT EASEMENT FOR COMMONWEALTH IRRIGATION CO.
					(0.1288)				

NOTE: PARCELS #20 - #63 HAVE BEEN DELETED.			**NOTE**: PARCELS #20 - #63 HAVE BEEN DELETED.			**NOTE**: PARCELS #20 - #63 HAVE BEEN DELETED.			
64	SOUTHERN PACIFIC TRANSPORTATION	ONE MARKET PLAZA SUITE 870	SOUTHSIDE OF HIGHWAY 160	BK 532, PG 252	9.4117	541.519		64	FOR COUNTY ROAD AND SIDE SLOPE CONSTRUCTION
	COMPANY	SAN FRANCISCO, CA. 94105			(23.2568)	(124.320)			
64A	(SAME AS ABOVE)	(SAME AS ABOVE)	(SAME AS ABOVE)		6.8001			64A	
					(16.8034)				
64B	(SAME AS ABOVE)	(SAME AS ABOVE)	(SAME AS ABOVE)		0.2754			64B	
					(0.6805)				
TE-64	(SAME AS ABOVE)	(SAME AS ABOVE)	(SAME AS ABOVE)		0.0270			TE-64	FOR DRIVEWAY AND SIDE SLOPE CONSTRUCTION
					(0.0670)				
TE-64A	(SAME AS ABOVE)	(SAME AS ABOVE)	(SAME AS ABOVE)		0.0180			TE-64A	FOR DRIVEWAY AND SIDE SLOPE CONSTRUCTION
					(0.0440)				
TE-64B	SOUTHERN PACIFIC TRANSPORTATION	ONE MARKET PLAZA SUITE 870	SOUTHSIDE OF HIGHWAY 160	BK 532, PG 252	0.020			TE-64B	FOR COUNTY ROAD AND SIDE SLOPE CONSTRUCTION
	COMPANY	SAN FRANCISCO, CA. 94105			(0.0490)				

Computer File Information		Index of Revisions		 3803 North Main Avenue, Suite 300 Durango, Colorado 81301 Phone: 970-385-1400 FAX: 970-385-1410 Region 5	As Constructed		PROPERTY OWNERSHIP TABULATION		Project No./Code	
Creation Date: 5/20/97 Initials: JRY		(R2D) 5/11/98	DELETED #20-63et.al.		No Revisions:	C. R. 6E TO CRAFT DR.		NH 1602-058		
Last Modification Date: 11/24/97 Initials: EDC			PARCELS 64B, TE-64A,		Revised:	Designer: EDC		10578		
Full Path: BEAST F:\JOBS\CDOT\5657-003\PHASE-ONE			TE-64B		Void:	Detailer: EDC		Sheet Number: 2E		
Drawing File Name: P-1TABS2.DWG						Sheet Subset: TABS		Subset Sheets: 6 of 9		
Acad Ver. R14 Scale: N.T.S. Units: METRIC										

PROPERTY OWNERSHIP TABULATION

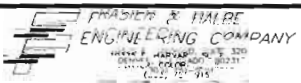

PARCEL NO.	OWNER	ADDRESS	LOCATION	PARCEL REC. DATA	AREA IN HECTARES (ACRES)			PARCEL NO.	REMARKS
					PARCEL	REMAINDER			
			T. 37 N., R.10E., NM. P.M.						
			ALAMOSA COUNTY, CO						
TE-64C	SOUTHERN PACIFIC TRANSPORTATION COMPANY	ONE MARKET PLAZA SUITE 870	SOUTH SIDE OF HIGHWAY 160	BK 532 PG 252	0.012			TE-64C	FOR DRIVEWAY AND SIDE SLOPE CONSTRUCTION
		SAN FRANCISCO, CA. 94105			(0.030)				
TE-64D	(SAME AS ABOVE)	(SAME AS ABOVE)	(SAME AS ABOVE)		0.012			TE-64D	FOR DRIVEWAY AND SIDE SLOPE CONSTRUCTION
					(0.030)				
TE-64E	(SAME AS ABOVE)	(SAME AS ABOVE)	(SAME AS ABOVE)		0.018			TE-64E	FOR COUNTY ROAD AND SIDE SLOPE CONSTRUCTION
					(0.044)				
TE-64F	(SAME AS ABOVE)	(SAME AS ABOVE)	(SAME AS ABOVE)		0.020			TE-64F	FOR COUNTY ROAD AND SIDE SLOPE CONSTRUCTION
					(0.048)				
TE-64G	(SAME AS ABOVE)	(SAME AS ABOVE)	(SAME AS ABOVE)		0.018			TE-64G	FOR DRIVEWAY AND SIDE SLOPE CONSTRUCTION
					(0.044)				
TE-64H	(SAME AS ABOVE)	(SAME AS ABOVE)	(SAME AS ABOVE)		0.018			TE-64H	FOR COUNTY ROAD AND SIDE SLOPE CONSTRUCTION
					(0.044)				
TE-64I	(SAME AS ABOVE)	(SAME AS ABOVE)	(SAME AS ABOVE)		0.018			TE-64I	FOR COUNTY ROAD AND SIDE SLOPE CONSTRUCTION
					(0.044)				
TE-64J	(SAME AS ABOVE)	(SAME AS ABOVE)	(SAME AS ABOVE)		0.018			TE-64J	FOR DRIVEWAY AND SIDE SLOPE CONSTRUCTION
					(0.044)				
TE-64K	(SAME AS ABOVE)	(SAME AS ABOVE)	(SAME AS ABOVE)		0.021			TE-64K	FOR COUNTY ROAD AND SIDE SLOPE CONSTRUCTION
					(0.052)				
TE-64L	(SAME AS ABOVE)	(SAME AS ABOVE)	(SAME AS ABOVE)		0.018			TE-64L	FOR DRIVEWAY AND SIDE SLOPE CONSTRUCTION
					(0.044)				

Computer File Information		Index of Revisions		 3803 North Main Avenue, Suite 300 Durango, Colorado 81301 Phone: 970-385-1400 FAX: 970-385-1410 Region 5	As Constructed		PROPERTY OWNERSHIP TABULATION		Project No./Code	
Creation Date: 5/20/97 Initials: JRY		(R2D) 5/11/98	PARCELS TE-64J, EDC		No Revisions:		C. R. 6E TO CRAFT DR.		NH 1602-058	
Last Modification Date: 11/24/97 Initials: EDC			TE-64K, TE-64L		Revised:		Designer: EDC		10578	
Full Path: BEAST F:\JOBS\CDOT\5657-003\PHASE-ONE					Void:		Detailer: EDC		Sheet Number: 2F	
Drawing File Name: P-1TABS2.DWG							Sheet Subset: TABS		Subset Sheets: 7 of 9	
Acad Ver. R14 Scale: N.T.S. Units: METRIC										

FRASIER & HALL
ENGINEERING COMPANY
10325 E. HAWTHORNE BLVD. SUITE 320
DENVER, COLORADO 80231
(303) 551-4551

[illegible]

NOTE: PARCELS #68 - #72 HAVE BEEN DELETED.

[illegible]

Computer File Information		Index of Revisions		Colorado Department of Transportation		As Constructed		PROPERTY OWNERSHIP TABULATION		Project No./Code	
Creation Date: 5/20/97 Initials: JRY		(R2D)	5/11/98	DELETED #68-72et.al.	EDC	No Revisions:		C. R. 6E TO CRAFT DR.		NH 1602-058	
Last Modification Date: 11/24/97 Initials: EDC				PARCELS PE-67, TE-67A		Revised:		Designer: EDC		10578	
Full Path: BEAST F:\JOBS\CDOT\5657-003\PHASE-ONE				TE-67B		Void:		Detailer: EDC		Sheet Number: 2G	
Drawing File Name: P-1TAB52.DWG								Sheet Subset: TABS		Subset Sheets: 8 of 9	
Acad Ver. R14 Scale: N.T.S. Units: METRIC											

**FRASIER & HALL
ENGINEERING COMPANY**
10375 E. HARVARD, SUITE 320
DENVER, COLORADO 80231
(303) 751-9151

Computer File Information		Index of Revisions		Colorado Department of Transportation		As Constructed		PROPERTY OWNERSHIP TABULATION		Project No./Code	
Creation Date: 5\20\97 Initials: JRY				 3803 North Main Avenue, Suite 300 Durango, Colorado 81301 Phone: 970-385-1400 FAX: 970-385-1410		No Revisions:		C. R. 6E TO CRAFT DR.		NH 1602-058	
Last Modification Date: 11/24/97 Initials: EDC						Revised:		Designer: EDC		10578	
Full Path: BEAST F:\JOBS\CDOT\5657-003\PHASE-ONE						Void:		Detailer: EDC			
Drawing File Name: P-1TAB52.DWG								Sheet Subst: TABS		Subst Sheets: 9 of 9	
Acad Ver. R14 Scale: N.T.S. Units: METRIC				Region 5						Sheet Number: 2H	

GENERAL NOTES

1. THIS RIGHT OF WAY PLAN IS NOT A COMPLETE BOUNDARY SURVEY OF ALL ADJOINING OWNERS AND IS PREPARED FOR HIGHWAY DEPARTMENT PURPOSES ONLY.
2. UTILITY EASEMENTS AND OTHER MISCELLANEOUS RIGHT OF WAYS AND EASEMENTS LOCATED OUTSIDE OF S.H. 160 CORRIDOR MAY NOT BE SHOWN.
3. FIELD SURVEY CONTROL PRECISION COMPUTED TO EXCEED 1:30,000m.
4. NOTICE: ACCORDING TO COLORADO LAW YOU MUST COMMENCE ANY LEGAL ACTION BASED UPON ANY DEFECT IN THIS SURVEY WITHIN THREE YEARS AFTER YOU FIRST DISCOVER SUCH DEFECT. IN NO EVENT, MAY ANY ACTION BASED UPON ANY DEFECT IN THIS SURVEY BE COMMENCED MORE THAN TEN YEARS FROM THE DATE OF THE CERTIFICATION SHOWN HEREON.
5. ALL R.O.W. MARKERS SET FROM SURVEY CONTROL POINTS.
6. ALL CENTERLINE AND OFFSET STATIONING IS THEORETICAL ONLY AND MAY NOT REPRESENT THE CENTERLINE AS CONSTRUCTED IN THE FIELD.
7. ALL COORDINATES LISTED ARE PROJECT COORDINATES ONLY AND ARE LISTED IN METERS.

NARRATIVE OF RIGHT-OF-WAY LINE DETERMINATION

Several components, which include physical and documented features, were considered, evidence reviewed, weighted and prioritized during the process of determining the centerline and northerly right-of-way line of Highway 160.

Existing CDOT monuments, #31 and #32, were the basis of the first phase of control. These monuments were field surveyed by Frasier & Halbe Engineering Company (FHEC) and the bearing of N 61°50'18" W was calculated and held as the basis of bearing. The distance 352.73 meters was field measured and agreed with the calculated distance between these monuments.

The next phase of control was data received from CDOT regarding the location of the existing railroad tracks. A best fit line for each surveyed rail was determined and an average of these lines was then established as the split of the existing rails. An offset of 0.855 feet to the south was used to set the centerline of the old narrow gauge railroad. An additional adjustment of 0.17 feet to the south was required to line up the centerline of the railroad throughout the length of this project with the centerline of the railroad in the Monte Vista project. The placement of this line provides a common centerline that extends the length of both projects.

The northeasterly right-of-way line is 120 feet from the centerline of the railroad throughout the majority of the project; however this width increases toward the southeasterly portion. A parallel line 120 feet northeasterly from the railroad centerline was established as the northeasterly right-of-way line of Highway 160. Several CDOT monuments were located along this right-of-way line. All of the monuments vary in offset from 1.10 feet south of to 1.02 feet north of this established right-of-way line.

Numerous property pins were also located throughout the length of the project near the established northeasterly right-of-way line. However due to the location inconsistency of these pins, limited weight was given to them in establishing the right-of-way line. More emphasis was given to these pins in the control of easterly/westerly property line placement. The next phase of control is the actual parcel property descriptions that have been tied to the existing section corners that were field surveyed. Each parcel that has a course that is either referenced to the road right-of-way line or is referenced to the centerline of the railroad and then to the road right-of-way width; that course has been placed contiguous with and on the established right-of-way line. The remaining courses of each parcel were then adjusted to form a closed figure.

Each parcel was further adjusted to provide the best location after considering existing property pins, existing surveyed section corners and dedicated road right-of-ways. The final placement of each parcel reflects the best location as determined from the above evidence; however this final placement is not to be assumed as the final location that would result from an actual boundary survey.

No pins will be set and no land survey plats developed or filed for any of these parcels. Should there be a need to determine the true location of each parcel and to monument the corners, FHEC highly recommends that a field survey be performed and a land survey plat be developed and recorded.

Computer File Information		Index of Revisions		Colorado Department of Transportation		As Constructed		CONTROL AND MONUMENTATION		Project No./Code	
Creation Date: 11/30/97	Initials: EDC			 3803 North Main Avenue, Suite 300 Durango, Colorado 81301 Phone: 970-385-1400 FAX: 970-385-1410		No Revisions:		C. R. 6E TO CRAFT DR.		NH 1602-058	
Last Modification Date: 12/2/97	Initials: EDC					Revised:		Designer: EDC		10578	
Full Path: BEAST F:\JOBS\CDOT\5657-003\DWGS-IN-PROG						Void:		Detailer: EDC			
Drawing File Name: CONT-MON.DWG								Sheet Subset: CTL&MON		Subset Sheets: 1 of 7	
Acad Ver. R14	Scale: N.T.S.	Units: METRIC		Region 5						Sheet Number: 3	

SURVEY CONTROL POINT TABULATION

POINT#	NORTHING	EASTING	DESCRIPTION
29	39720.7127	7591.1767	CP29
31	39419.888	8160.3067	CP31
32	39253.4109	8471.2846	CP32
33	39089.8495	8778.7606	CP33
34	38858.7198	9215.3603	CP34
35	38625.0013	9656.8311	CP35
36	38383.0744	10110.5688	CP36
37	38154.6565	10540.2535	CP37
38	37932.5214	10961.2877	CP38
39	37781.4096	11241.1611	CP39
40	37570.5005	11637.7507	CP40
41	37323.127	12103.932	CP41
42	37116.3629	12488.2795	CP42
43	36843.4625	13011.004	CP43
44	36599.0568	13465.8229	CP44
45	36353.4574	13924.5298	CP45
46	36109.0089	14385.4772	CP46
47	35907.1689	14766.232	CP47
48	35678.3293	15195.0827	CP48
49	35401.8379	15713.3389	CP49
50	35176.1206	16146.4249	CP50
51	34910.9765	16641.097	CP51
52	34756.3113	16931.4419	CP52
53	34539.6783	17343.0439	CP53
54	34325.1688	17755.7477	CP54
55	34089.1824	18187.3743	CP55
56	33842.1424	18657.3524	CP56
57	33577.4395	19148.76	CP57
58	33350.0228	19573.1109	CP58
59	33119.7719	20009.3261	CP59
60	32929.3544	20363.7401	CP60
61	32774.7521	20670.4323	CP61
100	39295.0844	7493.5554	VISTAPORT
101	40570.9336	7927.9215	NW S18 T38N R9E
102	39767.6190	7926.6839	W4 S18 T38N R9E
103	40565.2158	8721.2559	N4 S18 T38N R9E
104	38980.9101	7927.7641	SW S18 T38N R9E
105	38983.6643	7124.3295	S4 S13 T38N R9E
106	38941.6001	9522.1275	SE S18 T38N R9E
107	38942.2403	11173.2934	SE S17 T38N R9E
108	38121.1151	12807.9102	W4 S22 T38N R9E
109	37322.9946	12784.3909	SW S22 T38N R9E

SURVEY CONTROL POINT TABULATION

POINT#	NORTHING	EASTING	DESCRIPTION
110	37353.1915	11174.106	SW S21 T38N R9E
111	37338.1504	11979.1384	S4 S21 T38N R9E
112	36533.8477	12787.4071	W4 S27 T38N R9E
113	35745.3792	12758.153	SW S27 T38N R9E
114	37330.8981	13601.3792	N4 S27 T38N R9E
115	37346.6722	14405.763	NW S26 T38N R9E
116	36547.5981	14416.5852	W4 S26 T38N R9E
117	35740.4701	14423.91	SW S26 T38N R9E
118	34910.2277	14434.9041	W4 S35 T38N R9E
119	35737.9206	15228.5138	N4 S35 T38N R9E
120	35749.9774	15949.1883	NE S35 T38N R9E
121	36548.7662	15946.8748	E4 S26 T38N R9E
122	36547.8696	15221.4813	C4 S26 T38N R9E
124	34137.4868	18377.3963	N4 S6 T37N R10E
125	34931.5860	16755.1890	C4 S36 T37N R9E
132	34122.7874	19192.4427	NE S6 T37N R10E
136	34130.642	20805.126	NE S5 T37N R10E
139	38175.8689	7927.4644	W4 S19 T38N R9E
140	37366.029	9517.7000	SW S18 T38N R9E
141	34922.382	15952.189	W4 S36 T38N R9E
142	34149.175	15943.294	NW S1 T37N R9E
143	34141.537	16744.231	N4 S1 T37N R9E
144	33332.0884	17559.0381	E4 S1 T37N R9E
145	32521.3743	17568.6120	SE S1 T37N R9E
146	32519.596	18393.276	S4 S6 T37N R10E
147	32517.88	19197.663	SW S5 T37N R10E
148	32514.607	20000.967	S4 S5 T37N R10E
149	32511.482	20804.204	SE S5 T37N R10E
150	35749.898	15949.373	SW S25 T38N R9E
151	34941.491	17576.333	W4 S31 T38N R10E
152	35745.3580	17590.650	NW S31 T38N R10E
153	36550.724	17598.678	W4 S30 T38N R10E
154	35742.6260	16766.172	N4 S36 T38N R9E
155	35745.236	18389.630	N4 S31 T38N R10E
156	33308.954	19190.802	W4 S5 T37N R10E
158	38156.867	11178.154	W4 S21 T38N R9E
159	40597.433	6320.044	NW S13 T38N R8E
160	40578.382	7128.365	WC N1/4 S13
161	39793.894	6320.192	W4 S13 T38N R8E
162	34137.3477	17553.2086	NW S6 T37N R10E

QUANTITY OF MONUMENTS TO BE SET

CAP TYPE	MONUMENT TYPE										
	1	1A	1A	2	2A	3	3A	4	4A	5	6
REFERENCE											
RIGHT OF WAY	87										
CONTROL											
ALIQUOT CORNER											
WITNESS POST											
PERM. EASEMENT											14
C.R. RIGHT OF WAY											26

C.D.O.T. SURVEYOR'S STATEMENT

ORIGINAL CONTROL SURVEY AND TOPO WERE PREPARED UNDER MY SUPERVISION AND CHECKING.

NAME _____ P.L.S. NO. _____
DATE _____

CONTRACT SURVEYOR'S STATEMENT

R.O.W. PLANS AND LEGAL DESCRIPTIONS WERE PREPARED UNDER MY SUPERVISION AND CHECKING.

NAME James H. Luke P.L.S. NO. 14115
DATE 3-1-2000

SURVEYOR'S STATEMENT

RIGHT OF WAY MONUMENTATION WAS DONE UNDER MY SUPERVISION AND CHECKING.

NAME _____ P.L.S. NO. _____
DATE _____



Computer File Information		Index of Revisions		Colorado Department of Transportation		As Constructed		CONTROL AND MONUMENTATION		Project No./Code	
Creation Date: 11/30/97 Initials: EDC		5/5/98 PNT #'S 102, 125, 139, 144, EDC		3803 North Main Avenue, Suite 300 Durango, Colorado 81301 Phone: 970-385-1400 FAX: 970-385-1410 Region 5		No Revisions:		C. R. 6E TO CRAFT DR.		NH 1602-058	
Last Modification Date: 03/01/2000 Initials: JHL		11/6/98 PNT # 34 EDC				Revised:		Designer: EDC		10578	
Full Path: BEAST F:\JOBS\CDOT\5657-003\PHASE-ONE						Void:		Detailer: EDC			
Drawing File Name: P-1CONT-MON.DWG								Sheet Subset: CTL&MON		Sheet Number: 3A	
Acad Ver. R14 Scale: N.T.S. Units: METRIC								Subset Sheets: 2 of 7			

TABULATION OF R.O.W. MARKERS TO BE SET

POINT#	NORTHING	EASTING	STATION	OFFSET	DESCRIPTION
200	40439.3149	6320.0731			
201	40399.1068	6320.0805			
202	40225.2426	6722.78	0+260.000	-20.4743	ROW
203	40193.9133	6706.0849	0+260.000	15.0258	ROW
204	40065.6518	7022.9978	0+600.032	-20.5553	ROW
205	40034.3225	7006.3028	0+599.977	14.9447	ROW
206	39887.2858	7358.5352	0+980.032	-20.3498	ROW
207	39855.9565	7341.8402	0+979.976	15.1502	ROW
208	39727.7046	7658.7351	1+320.018	-20.166	ROW
209	39694.1285	7731.4846	1+400.020	-24.5955	ROW
210	39658.8150	7712.6973	1+399.971	15.4044	ROW
211	39595.0474	7917.8732	1+611.107	-24.4097	ROW
212	39569.8890	7959.8743	1+660.000	-21.8666	ROW
213	39471.0760	8065.8669	1+799.939	15.7566	ROW
214	39457.2167	8171.8289	1+900.041	-21.6546	ROW
215	39273.1149	8504.3099	2+280.015	-15.0708	ROW
216	39245.7569	8489.7311	2+279.984	15.9292	ROW
217	39075.9733	8875.1673	2+700.015	-15.0759	ROW
218	39048.6153	8860.5885	2+699.984	15.9241	ROW
219	39000.8789	9016.4329	2+860.000	-15.0779	ROW
220	38958.7968	9107.314	2+960.000	-20.5791	ROW
221	38860.8539	9213.8002	3+100.000	15.9192	ROW
222	38771.0429	9460.5115	3+360.000	-20.584	ROW
223	38673.1000	9566.9977	3+500.000	15.9142	ROW
224	38564.4625	9849.125	3+800.109	-20.5894	ROW
225	38532.2846	9831.8958	3+800.000	15.9106	ROW
226	38371.8529	10199.7395	4+200.108	-15.0944	ROW
227	38344.5307	10185.0933	4+200.000	15.9056	ROW
228	38184.1495	10552.8421	4+600.000	-15.0993	ROW
229	38156.7768	10538.2908	4+600.000	15.9007	ROW
230	37996.3958	10906.0393	5+000.000	-15.1042	ROW
231	37969.0231	10891.488	5+000.000	15.8958	ROW
232	37852.5589	11176.6212	5+306.437	-15.108	ROW
234	37781.2693	11244.6855	5+400.000	15.8909	ROW
236	37593.5154	11597.883	5+800.000	15.886	ROW
238	37405.7613	11951.0809	6+200.000	15.881	ROW
239	37334.7390	12158.1866	6+416.210	-18.6216	ROW
241	37236.7828	12268.9586	6+560.000	15.8766	ROW
242	37201.5321	12408.7719	6+700.000	-18.6251	ROW
243	37104.4483	12606.3163	6+920.000	-25.6278	ROW
244	37067.8043	12586.8364	6+920.000	15.8722	ROW
245	36926.0822	12941.8539	7+300.000	-25.6325	ROW
246	36889.4382	12922.374	7+300.000	15.8675	ROW
247	36700.8939	13343.1022	7+760.000	-15.1381	ROW
248	36673.5212	13328.5511	7+760.000	15.8619	ROW
249	36541.3032	13643.32	8+100.000	-15.1401	ROW
250	36513.9302	13628.7693	8+100.000	15.8599	ROW

TABULATION OF R.O.W. MARKERS TO BE SET

POINT#	NORTHING	EASTING	STATION	OFFSET	DESCRIPTION
251	36414.5692	13881.7284	8+370.000	-15.1375	ROW
252	36387.1963	13867.1778	8+370.000	15.8625	ROW
253	36219.7978	14265.1708	8+800.000	-23.1334	ROW
254	36185.3608	14246.8652	8+800.000	15.8666	ROW
255	36032.0439	14618.3683	9+200.000	-23.1295	ROW
256	35997.6071	14600.0625	9+200.000	15.8705	ROW
257	35809.0631	15020.7903	9+660.000	-15.125	ROW
258	35781.6901	15006.2396	9+660.000	15.875	ROW
259	35602.5337	15409.3077	10+100.000	-15.1208	ROW
260	35575.1608	15394.7569	10+100.000	15.8792	ROW
261	35553.2715	15519.022	10+220.000	-23.1196	ROW
262	35421.8439	15766.2601	10+500.000	-23.1169	ROW
263	35387.4070	15747.9544	10+500.000	15.8831	ROW
266	35087.0008	16313.0704	11+140.000	15.8893	ROW
268	34871.0838	16719.2475	11+600.000	15.8937	ROW
270	34683.3299	17072.445	12+000.000	15.8976	ROW
273	34514.3514	17390.3228	12+360.000	15.9011	ROW
275	34354.7606	17690.5407	12+700.000	15.9044	ROW
278	34167.0067	18043.7382	13+100.000	15.9082	ROW
280	34026.1913	18308.6363	13+400.000	15.9111	ROW
282	33838.4375	18661.8338	13+800.000	15.915	ROW
284	33660.0713	18997.3715	14+180.000	15.9187	ROW
286	33538.0323	19226.9478	14+440.002	15.8645	ROW
288	33369.0538	19544.8256	14+800.002	15.7831	ROW
291	33171.9123	19915.683	15+220.002	15.688	ROW
293	32955.9953	20321.8601	15+680.002	15.5839	ROW
295	32787.0168	20639.7379	16+040.002	15.5025	ROW
296	32618.0383	20957.6156	16+400.002	15.421	ROW
297	38732.6338	9532.7658	3+441.829	-20.585	ROW
298	38711.8006	9571.9566	3+486.213	-20.5856	ROW
299	37014.0199	12776.4278	7+112.653	-25.6302	ROW
300	36990.9784	12819.7728	7+161.742	-25.6308	ROW
301	36121.2271	14450.5993	9+010.000	-23.1313	ROW
302	35328.6511	15941.5719	10+698.543	-23.115	ROW
305	37856.5121	11176.6412	5+304.599	-18.6079	ROW
306	37717.8552	11437.4787	5+600.000	-18.6116	ROW
307	37577.0398	11702.3769	5+900.000	-18.6153	ROW
308	37436.2244	11967.275	6+200.000	-18.619	ROW
352	39576.1185	7958.04	1+655.460	-26.5102	CNTY ROW
353	39583.0782	7960.2938	1+654.190	-33.7147	CNTY ROW
354	39637.9303	7958.3245	1+626.746	-81.2485	CNTY ROW
355	39693.3471	7935.8715	1+580.943	-119.6825	CNTY ROW
545	38735.6084	9542.4921	3+449.021	-27.7771	CNTY ROW
546	38750.2862	9550.2949	3+449.021	-44.4000	CNTY ROW

Computer File Information		Index of Revisions		Colorado Department of Transportation		As Constructed		CONTROL AND MONUMENTATION		Project No./Code	
Creation Date: 11/30/97	Initials: EDC	(R2F)	5/12/98	REVISED COORDINATE LIST	EDC	No Revisions:		C. R. 6E TO CRAFT DR.		NH 1602-058	
Last Modification Date: 03/01/2000	Initials: JHL					Revised:		Designer: EDC		10578	
Full Path: BEAST F:\JOBS\CDOT\5657-003\DWGS-IN-PROG						Void:		Detailer: EDC			
Drawing File Name: CONT-MON.DWG								Sheet Subset: CTL&MON		Subset Sheets: 3 of 7	
Acad Ver. R14 Scale: N.T.S. Units: METRIC										38	



Region 5

3803 North Main Avenue, Suite 300
Durango, Colorado 81301
Phone: 970-385-1400 FAX: 970-385-1410

TABULATION OF R.O.W. MARKERS TO BE SET

POINT#	NORTHING	EASTING	STATION	OFFSET	DESCRIPTION
547	38780.8976	9557.9442	3+441.406	-75.0201	CNTY ROW
548	38851.7412	9558.0248	3+408.224	-137.6120	CNTY ROW
549	38902.6557	9571.2611	3+396.012	-188.7819	CNTY ROW
550	38931.9296	9552.0768	3+365.332	-205.6253	CNTY ROW
551	38930.9048	9663.0285	3+463.782	-256.8007	CNTY ROW
552	38926.6219	9663.0282	3+465.792	-253.0188	CNTY ROW
553	38851.7071	9588.0247	3+434.729	-151.6637	CNTY ROW
554	38780.8635	9587.9442	3+467.912	-89.0718	CNTY ROW
555	38736.2044	9576.7845	3+479.021	-44.4000	CNTY ROW
556	38721.5269	9568.9820	3+479.021	-27.7775	CNTY ROW
371	37001.5051	12814.2155	7+151.894	-32.3172	CNTY ROW
372	37050.8571	12812.4878	7+127.203	-75.0834	CNTY ROW
373	37095.6047	12794.4041	7+090.231	-106.1065	CNTY ROW
375	36135.3086	14443.6793	8+997.280	-32.3171	CNTY ROW
376	36184.6605	14441.9506	8+972.589	-75.0834	CNTY ROW
377	36221.2371	14427.1682	8+9442.368	-100.4420	CNTY ROW
499	38949.8062	9124.2269	2+979.154	-20.5794	CNTY ROW
502	38932.7639	9156.2865	3+015.462	-20.5798	CNTY ROW
536	36143.1960	14409.2721	8+963.197	-23.1318	ROW
537	36133.4482	14427.6093	8+983.964	-23.1316	ROW

TABULATION OF PERMANENT EASEMENTS MARKERS TO BE SET

POINT#	NORTHING	EASTING	STATION	OFFSET	DESCRIPTION
532	36464.9474	13786.9584	8+262.672	-15.1385	PE
534	36191.9730	14317.514	8+859.280	-23.1328	PE
540	36073.0757	14541.1803	9+112.584	-23.1303	PE
542	35829.5212	14983.8688	9+617.796	-15.8594	PE
544	35699.0893	15227.6699	9+894.293	-15.1228	PE
649	36472.0438	13786.3915	8+258.841	-21.1386	PE
650	36419.8934	13884.4955	8+369.945	-21.1375	PE
651	36225.1219	14267.9379	8+799.945	-29.1334	PE
652	36198.8010	14317.452	8+856.020	-29.1328	PE
653	36150.0092	14409.2379	8+959.968	-29.1318	PE
654	36079.8672	14541.1872	9+109.402	-29.1304	PE
655	36037.3157	14621.2339	9+200.056	-29.1295	PE
656	35835.8358	14983.8141	9+614.784	-21.4096	PE
657	35705.8068	15227.8159	9+891.269	-21.1228	PE

TABULATION OF TEMPORARY EASEMENTS TO BE STAKED

POINT#	NORTHING	EASTING	STATION	OFFSET	DESCRIPTION
484	40010.4045	7126.9277	0+717.734	-20.4916	TE
498	38954.9640	9114.5241	2+968.166	-20.5792	TE
701	40254.8139	6667.1514	0+197.000	-20.4102	TE
702	40263.6390	6671.8542	0+197.000	-30.4102	TE
703	40249.5575	6698.344	0+227.000	-30.4407	TE
704	40240.7323	6693.6412	0+227.000	-20.4407	TE
705	40021.4647	7106.1216	0+694.171	-20.5044	TE
706	40033.4089	7106.0221	0+688.482	-31.0075	TE
707	40022.2799	7126.9578	0+712.192	-30.9946	TE
708	40009.2271	7151.5122	0+740.000	-30.9796	TE
709	39999.9530	7146.5887	0+740.000	-20.4796	TE
710	39987.3731	7094.6228	0+700.000	14.9988	TE
711	39982.0736	7091.8093	0+700.000	20.9988	TE
712	39960.9513	7131.544	0+745.000	21.0231	TE
713	39966.2723	7134.3689	0+745.000	14.9988	TE
714	39851.2515	7350.691	0+990.000	15.1556	TE
715	39845.9520	7347.8775	0+990.000	21.1556	TE
716	39831.8705	7374.3673	1+020.000	21.1718	TE
717	39837.1700	7377.1808	1+020.000	15.1718	TE
718	39551.3122	7914.9287	1+629.000	15.6061	TE
719	39546.0117	7912.1171	1+629.000	21.6061	TE
720	39530.5220	7941.2559	1+662.000	21.6351	TE
721	39535.8225	7944.0675	1+662.000	15.6351	TE
722	39705.6278	7917.6562	1+559.096	-121.9955	TE
723	39698.4917	7896.5682	1+543.811	-105.8094	TE
724	39675.6608	7896.6355	1+554.569	-85.672	TE
725	39675.6929	7917.6960	1+573.159	-95.5695	TE
726	39708.8398	7935.8258	1+573.642	-133.3474	TE
727	39697.5813	7957.0082	1+597.631	-133.3278	TE
728	39588.4894	7982.9190	1+671.642	-49.0973	TE
729	39564.4359	7970.1326	1+671.6180	-21.8564	TE
730	39113.5312	8804.5144	2+620.000	-15.0749	TE
731	39123.2440	8809.6778	2+620.000	-26.0749	TE
732	39113.8564	8827.3376	2+640.000	-26.0752	TE
733	39104.1435	8822.1743	2+640.000	-15.0752	TE
734	39086.1586	8789.9631	2+620.000	15.9251	TE
735	39080.8606	8787.1468	2+620.000	21.9251	TE
736	39071.4729	8804.8066	2+640.000	21.9248	TE
737	39076.7709	8807.623	2+640.000	15.9248	TE
738	38963.6241	9119.274	2+968.295	-30.4556	TE
739	38963.6638	9135.7336	2+982.810	-38.2166	TE
740	38949.8157	9135.767	2+989.339	-26.0046	TE

Computer File Information		Index of Revisions		Colorado Department of Transportation		As Constructed		CONTROL AND MONUMENTATION		Project No./Code	
Creation Date: 11/30/97	Initials: EDC	(R2F)	5/12/98	REVISED COORDINATE LIST	EDC	 3803 North Main Avenue, Suite 300 Durango, Colorado 81301 Phone: 970-385-1400 FAX: 970-385-1410 Region 5	No Revisions:	C. R. 6E TO CRAFT DR.		NH 1602-058	
Last Modification Date: 03/01/2000	Initials: JHL						Revised:	Designer: EDC		10578	
Full Path: BEAST F:\JOBS\CDOT\5657-003\DWGS-IN-PROG							Void:	Detailer: EDC			
Drawing File Name: CONT-MON.DWG								Sheet Subset: CTL&MON	Subset Sheets: 4 of 7	Sheet Number: 3C	
Acad Ver. R14	Scale: N.T.S.	Units: METRIC									

TABULATION OF TEMPORARY EASEMENTS TO BE STAKED

POINT#	NORTHING	EASTING	STATION	OFFSET	DESCRIPTION
741	38817.9814	9372.2121	3+260.000	-20.5828	TE
742	38822.3963	9374.5591	3+260.000	-25.5828	TE
743	38789.5394	9436.3687	3+330.000	-25.5837	TE
744	38785.1245	9434.0217	3+330.000	-20.5837	TE
745	38733.5404	9535.7302	3+444.021	-22.7771	TE
746	38752.6332	9545.8799	3+444.021	-44.4	TE
747	38780.9033	9552.9442	3+436.989	-72.6781	TE
748	38787.3240	9552.9515	3+433.981	-78.351	TE
749	38787.3240	9492.9515	3+381.002	-50.1873	TE
750	38847.3240	9492.9515	3+352.838	-103.1665	TE
751	38847.3240	9553.0278	3+405.885	-131.3661	TE
752	38853.0831	9553.0344	3+403.187	-136.4544	TE
753	38931.6024	9587.5057	3+396.769	-221.9666	TE
754	38921.6219	9663.0280	3+468.139	-248.6038	TE
755	38850.8867	9593.0238	3+439.529	-153.2858	TE
756	38780.8578	9592.9442	3+472.330	-91.4138	TE
757	38733.8574	9581.1994	3+484.021	-44.4	TE
758	38714.7650	9571.0499	3+484.021	-22.7776	TE
759	37549.4188	11823.5957	6+020.000	-51.1258	TE
760	37567.0786	11832.9837	6+020.000	-71.1258	TE
761	37491.9882	11974.2686	6+180.000	-71.1405	TE
762	37474.3285	11964.8807	6+180.000	-51.1405	TE
763	37122.0069	12792.2179	7+075.907	-128.3932	TE
764	37122.2006	12812.2170	7+093.475	-137.9517	TE
765	37060.2655	12877.1550	7+179.887	-113.7454	TE
766	37037.6261	12892.3826	7+203.959	-100.9028	TE
767	36966.8866	12776.68	7+135.000	15.8695	TE
768	36961.5887	12773.8637	7+135.000	21.8695	TE
769	36947.5072	12800.3535	7+165.000	21.8692	TE
770	36952.8051	12803.1698	7+165.000	15.8692	TE
771	36484.9770	13749.2792	8+220.000	-15.139	TE
772	36495.5730	13754.9117	8+220.000	-27.139	TE
773	36481.4915	13781.4015	8+250.000	-27.1387	TE
774	36470.8955	13775.769	8+250.000	-15.1387	TE
775	36225.0704	14408.8607	8+924.403	-95.2336	TE
776	36224.9933	14400.3681	8+916.941	-91.1794	TE
777	36204.9942	14400.5496	8+926.488	-73.6053	TE
778	36205.0704	14408.9612	8+933.880	-77.6209	TE
779	36230.1221	14427.1235	8+938.1580	-108.2664	TE
780	36230.1572	14448.5866	8+957.094	-118.3717	TE
781	36165.8311	14472.4143	9+008.327	-72.7560	TE
782	36109.4801	14472.6975	9+035.026	-23.1311	TE

TABULATION OF TEMPORARY EASEMENTS TO BE STAKED

POINT#	NORTHING	EASTING	STATION	OFFSET	DESCRIPTION
786	36100.8717	14405.8038	8+980.000	15.8684	TE
787	36095.1322	14402.7529	8+980.000	22.3684	TE
788	36081.0507	14429.2427	9+010.000	22.3687	TE
789	36086.7902	14432.2937	9+010.000	15.8687	TE
790	35842.0255	14961.3018	9+592.000	-16.3083	TE
791	35855.7359	14968.5898	9+592.000	-31.8354	TE
792	35847.3314	14983.7145	9+609.300	-31.5134	TE
793	35827.4832	14987.5467	9+622.000	-15.7863	TE
794	35792.6346	15051.6951	9+695.000	-15.1247	TE
795	35805.8796	15058.7357	9+695.000	-30.1247	TE
796	35787.1042	15094.0555	9+735.000	-30.1243	TE
797	35773.8592	15087.0148	9+735.000	-15.1243	TE
798	35744.2880	15142.6434	9+798.000	-15.1237	TE
799	35760.1819	15151.0922	9+798.000	-33.1237	TE
800	35746.1004	15177.582	9+828.000	-33.1234	TE
801	35730.2064	15169.1332	9+828.000	-15.1234	TE
802	35672.7929	15211.0942	9+892.000	15.8772	TE
803	35667.4949	15208.2779	9+892.000	21.8772	TE
804	35653.4133	15234.7677	9+922.000	21.8775	TE
805	35658.7113	15237.584	9+922.000	15.8775	TE
810	35287.8974	15935.1491	10+712.000	15.8851	TE
811	35282.5994	15932.3328	10+712.000	21.8851	TE
812	35268.5179	15958.8226	10+742.000	21.8854	TE
813	35273.8159	15961.6389	10+742.000	15.8854	TE
848	34432.6785	17543.9637	12+534.000	15.9027	TE
849	34427.3805	17541.1475	12+534.000	21.9027	TE
850	34413.3345	17567.6562	12+564.000	21.8628	TE
851	34418.5969	17570.4535	12+564.000	15.903	TE
872	33866.6005	18608.8542	13+740.000	15.9144	TE
873	33861.3025	18606.038	13+740.000	21.9144	TE
874	33847.2210	18632.5278	13+770.000	21.9147	TE
875	33852.5190	18635.344	13+770.000	15.9147	TE
883	33567.6036	19171.3192	14+377.002	15.8788	TE
884	33562.3062	19168.5017	14+377.002	21.8788	TE
885	33545.8778	19199.4065	14+412.002	21.8709	TE
886	33551.1751	19202.224	14+412.002	15.8709	TE
904	33099.1576	20052.547	15+375.002	15.653	TE
905	33093.8603	20049.7295	15+375.002	21.653	TE
906	33079.7788	20076.2193	15+405.002	21.6462	TE
907	33085.0761	20079.0368	15+405.002	15.6462	TE
959	37055.2025	12869.1544	7+175.199	-105.5193	TE

Computer File Information			Index of Revisions			Colorado Department of Transportation		As Constructed		CONTROL AND MONUMENTATION		Project No./Code	
Creation Date: 11/30/97	Initials: EDC	(R2F)	5/12/98	REVISED COORDINATE LIST	EDC	 3803 North Main Avenue, Suite 300 Durango, Colorado 81301 Phone: 970-385-1400 FAX: 970-385-1410 Region 5		No Revisions:		C. R. 6E TO CRAFT DR.		NH 1602-058	
Last Modification Date: 12/2/97	Initials: EDC							Revised:	Designer: EDC		10578		
Full Path: BEAST F:\JOBS\CDOT\5657-003\DWGS-IN-PROG								Void:	Detailer: EDC				
Drawing File Name: CONT-MON.DWG								Sheet Subst: CTL&MON		Subset Sheets: 5 of 7		Sheet Number: 3D	
Acad Ver. R14	Scale: N.T.S.	Units: METRIC											

TABULATION OF TEMPORARY EASEMENTS

TO BE STAKED

POINT#	NORTHING	EASTING	STATION	OFFSET	DESCRIPTION
960	39682.7785	7803.3743	1+468.846	-48.2570	TE
961	39604.4213	7900.2393	1+591.136	-24.4273	TE
962	39680.9534	7836.8517	1+499.276	-62.3324	TE
963	39723.5186	7837.8036	1+480.170	-100.3809	TE
964	39727.5906	7876.9228	1+512.820	-122.3096	TE
965	39717.0070	7898.5201	1+536.859	-123.0806	TE
966	39707.4465	7890.3234	1+534.098	-110.7938	TE
967	39715.1015	7874.7022	1+516.711	-110.2361	TE
968	39712.5045	7849.7524	1+495.887	-96.2502	TE
969	39632.2138	7847.9567	1+531.925	-24.4794	TE


TABULATION OF TEMPORARY EASEMENTS

TO BE STAKED

POINT#	NORTHING	EASTING	STATION	OFFSET	DESCRIPTION
--------	----------	---------	---------	--------	-------------

NOTE: SHEET 7 HAS BEEN DELETED

Computer File Information			Index of Revisions			Colorado Department of Transportation		As Constructed		CONTROL AND MONUMENTATION		Project No./Code	
Creation Date: 11/30/97	Initials: EDC	☒ R2F	5/12/98	REVISED COORDINATE LIST	EDC	 3803 North Main Avenue, Suite 300 Durango, Colorado 81301 Phone: 970-385-1400 FAX: 970-385-1410 Region 5	No Revisions:	C. R. 6E TO CRAFT DR.		NH 1602-058			
Last Modification Date: 12/2/97	Initials: EDC	☐		ELIMINATED SHEET 7			Revised:	Designer: EDC		10578			
Full Path: BEAST F:\JOBS\CDOT\5657-003\DWGS-IN-PROG		☐					Void:	Detailer: EDC					
Drawing File Name: CONT-MON.DWG		☐						Sheet Subset: CTL&MON	Subset Sheets: 6 of 7	Sheet Number: 3E			
Acad Ver. R14	Scale: N.T.S.	Units: METRIC	☐										

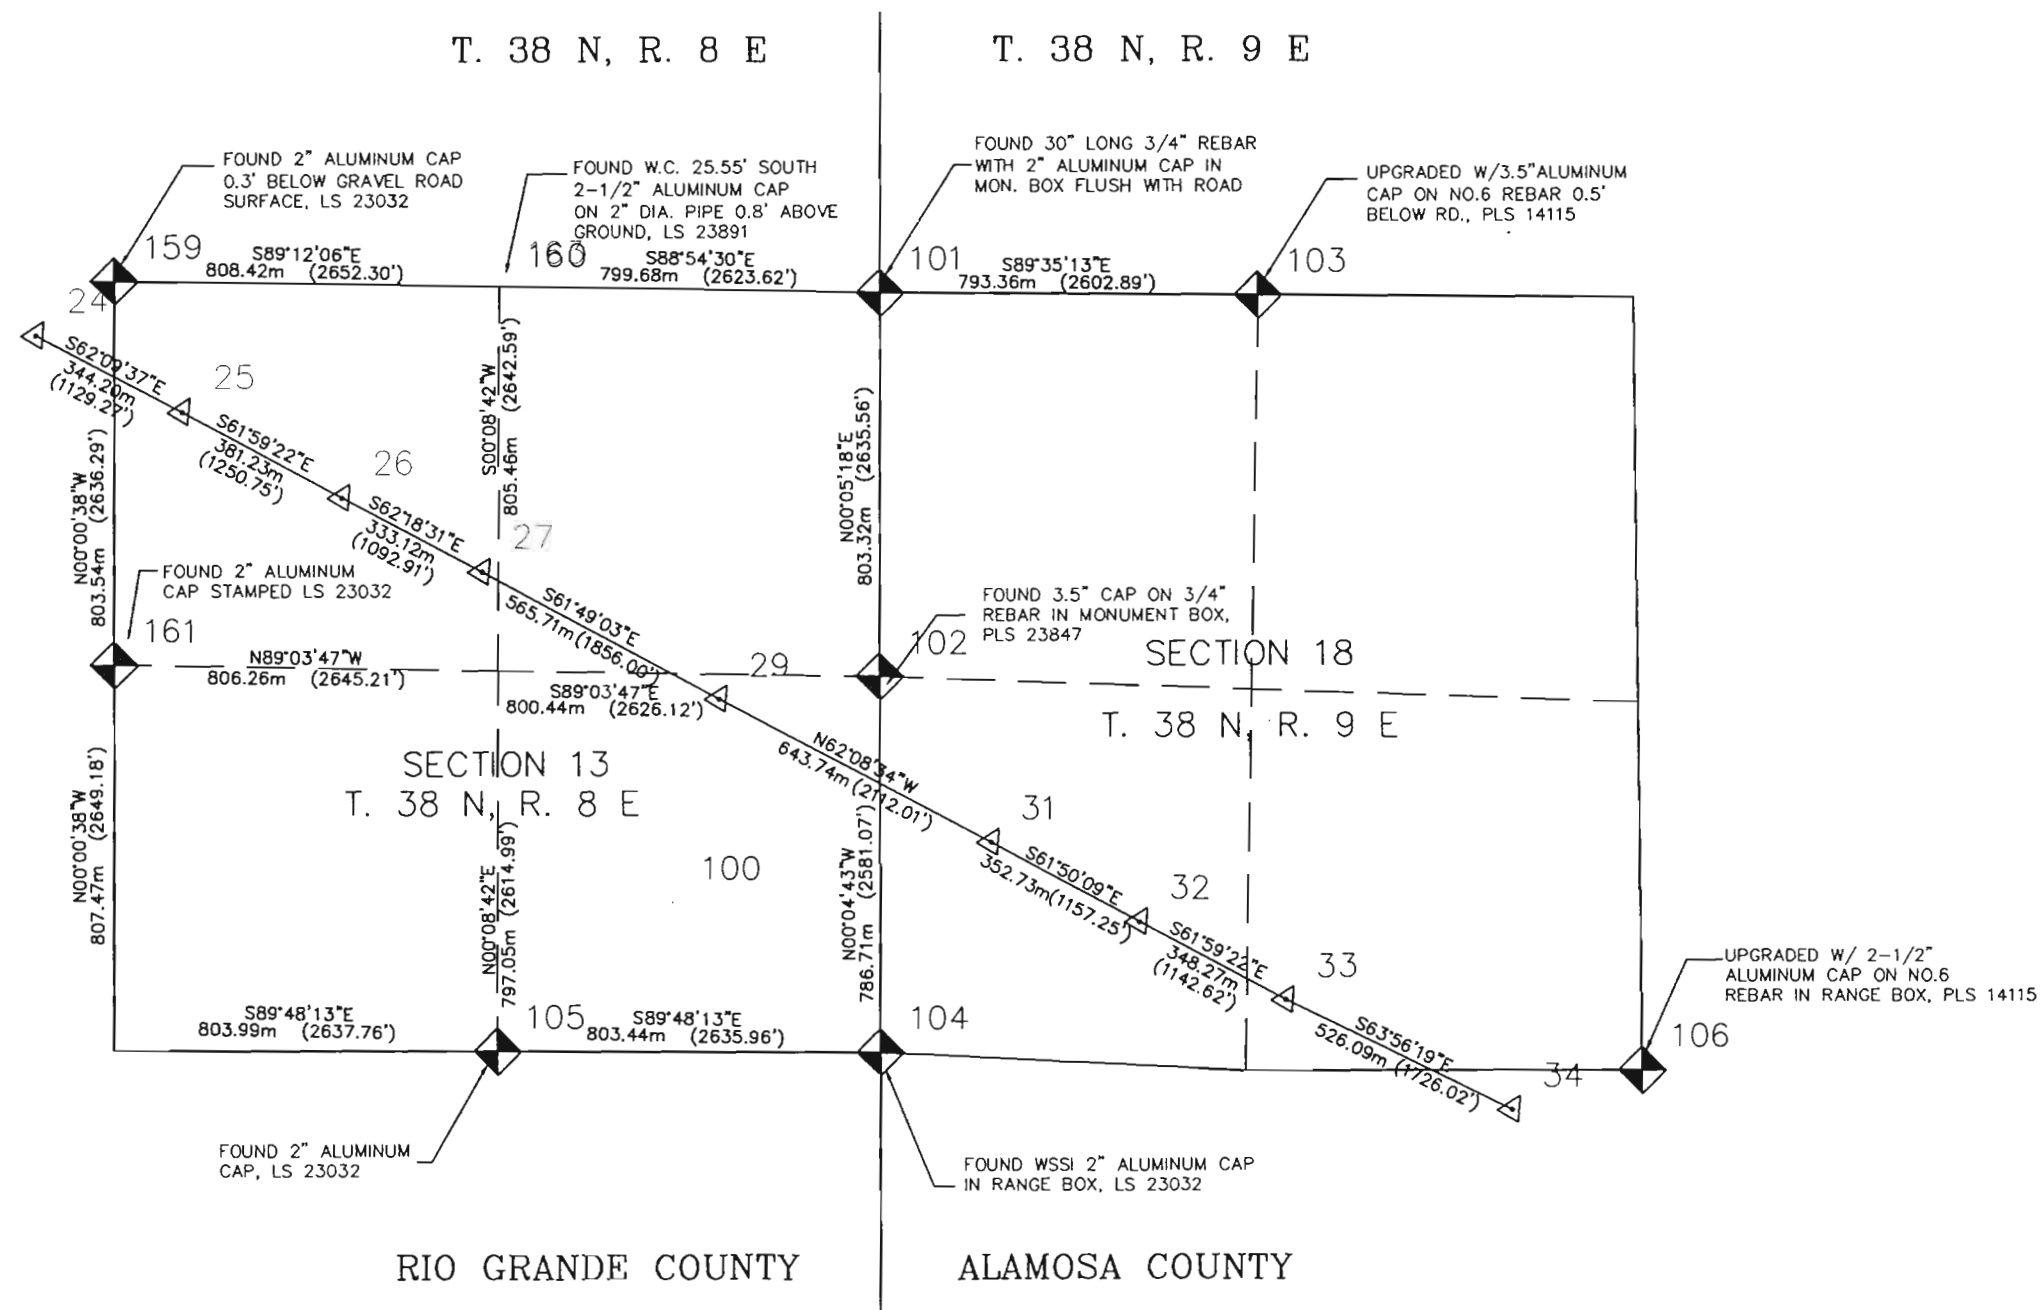


NOTE: SECTION CORNER MONUMENTS AS SHOWN
WILL BE UPGRADED TO STATE STANDARDS
ACCORDING TO RULE XIII. "PHYSICAL STANDARDS
FOR PUBLIC LAND SURVEY SYSTEM MONUMENTS"



Computer File Information			Index of Revisions			As Constructed			SURVEY CONTROL		Project No./Code	
Creation Date: 07/22/97	Initials: EDC	R2C	5/8/98	REVISED SECTION LINE INFO	EDC	No Revisions:			C. R. 6E TO CRAFT DR.		NH 1602-058	
Last Modification Date: 12/2/97	Initials: EDC					Revised:			Designer: EDC		10578	
Full Path: BEAST F:\JOBS\CDOT\5657-003\DWGS-IN-PROG						Void:			Detailer: EDC		Sheet Number 4	
Drawing File Name: CONTROL									Sheet Subset: CONTROL	Subset Sheets: 1 of 8		
Acad Ver. R14	Scale: N.T.S.	Units: METRIC										

Colorado Department of Transportation
3803 North Main Avenue, Suite 300
Durango, Colorado 81301
Phone: 970-385-1400 FAX: 970-385-1410
Region 5

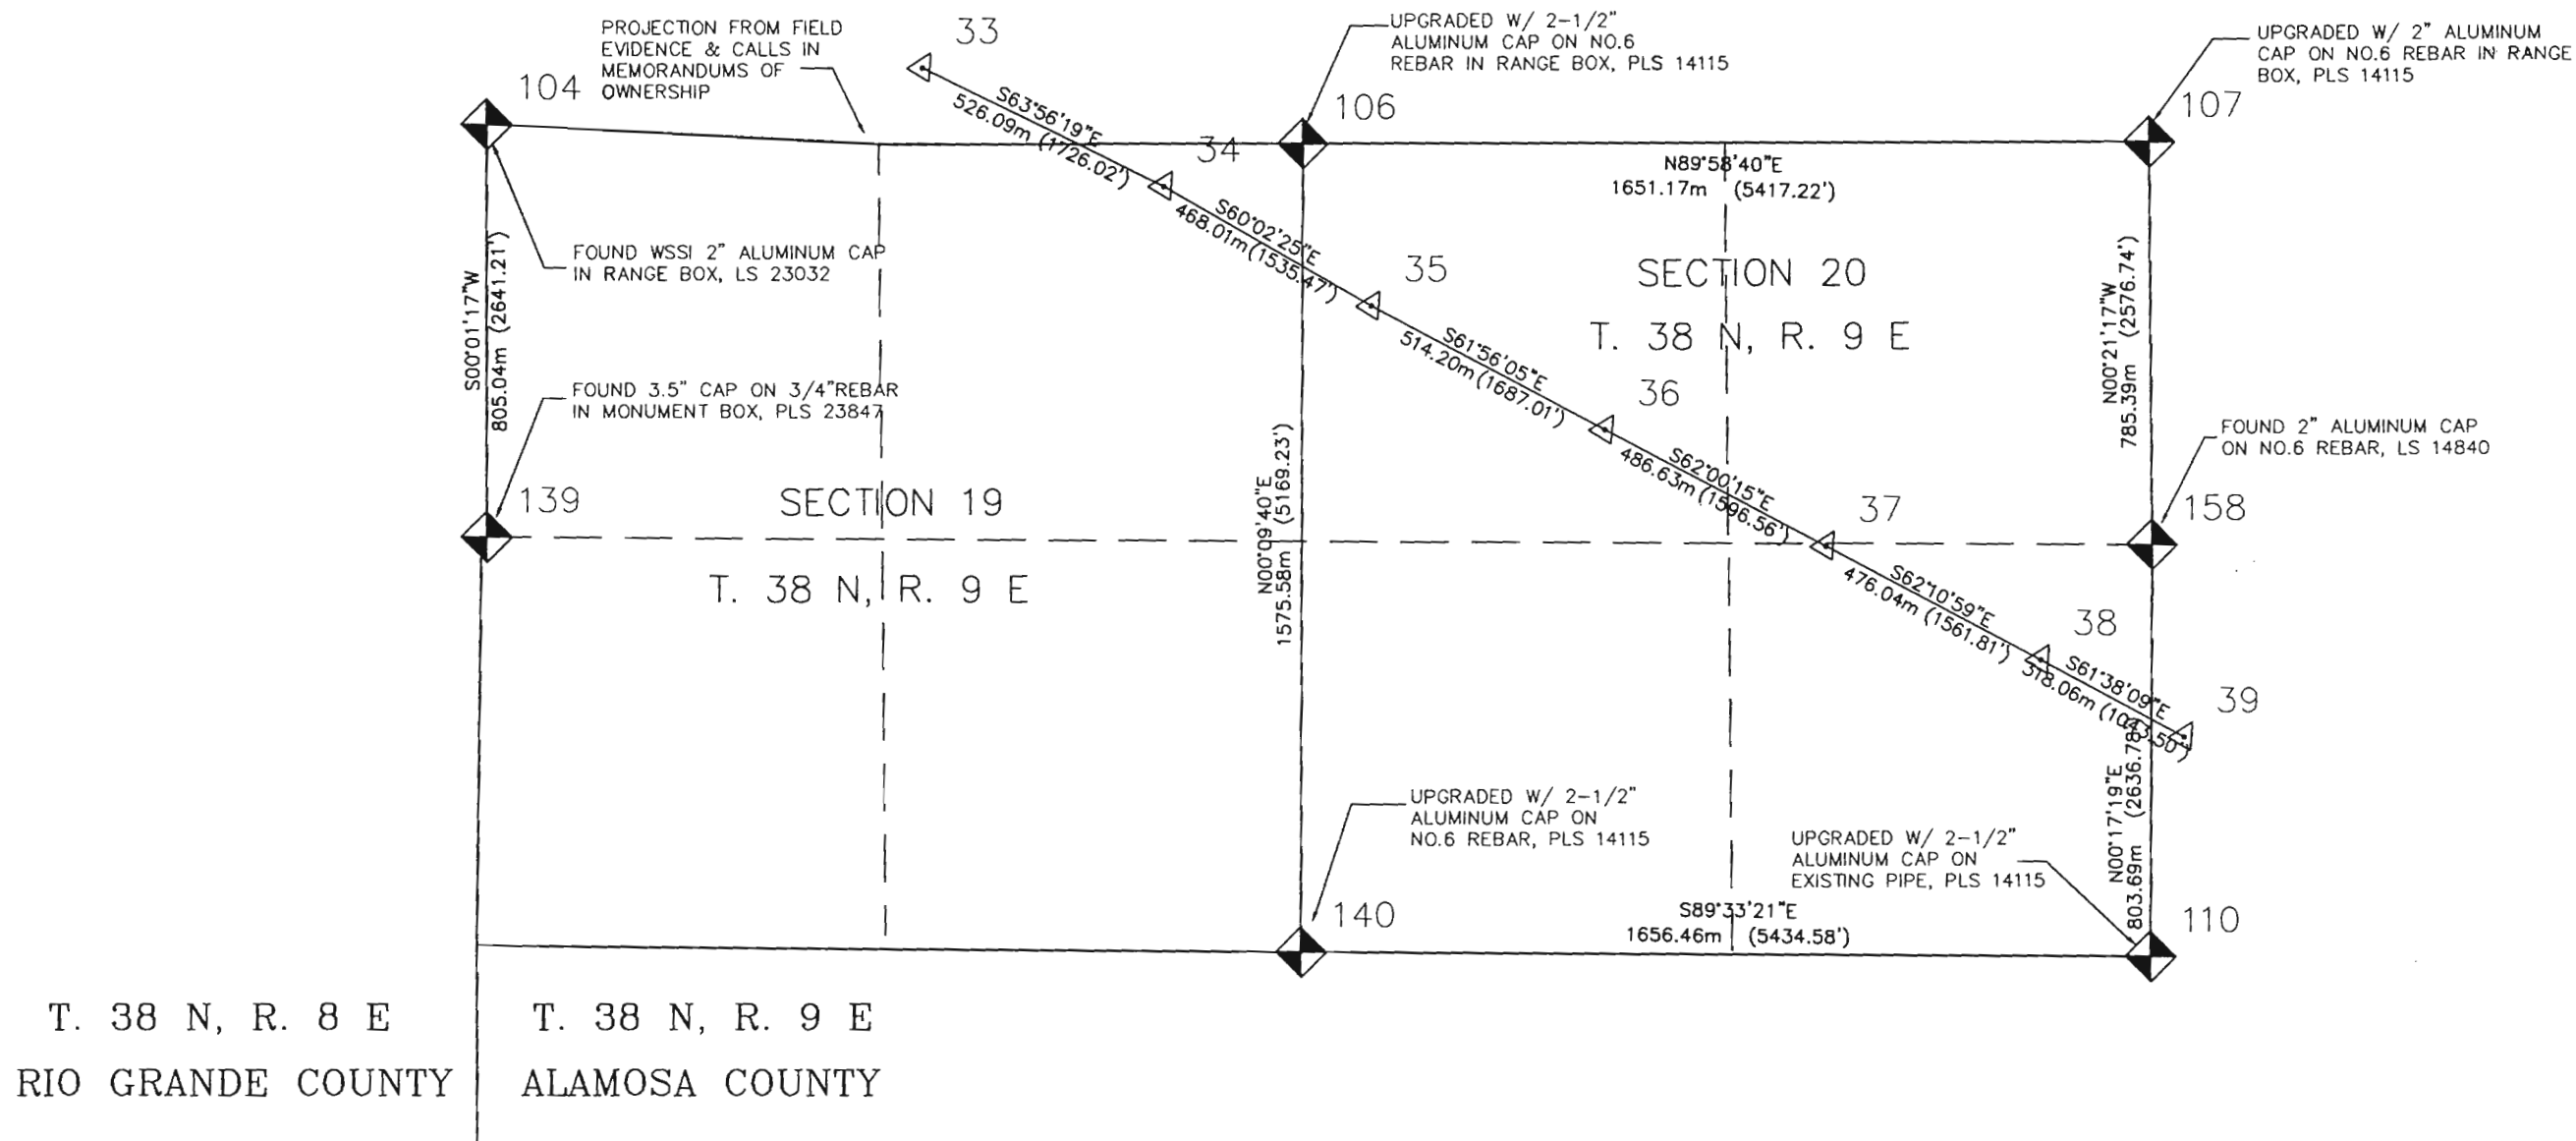


NOTE: SECTION CORNER MONUMENTS AS SHOWN
WILL BE UPGRADED TO STATE STANDARDS
ACCORDING TO RULE XIII. "PHYSICAL STANDARDS
FOR PUBLIC LAND SURVEY SYSTEM MONUMENTS"



N.T.S.

Computer File Information		Index of Revisions			As Constructed		SURVEY CONTROL		Project No./Code
Creation Date: 07/22/97	Initials: EDC	(R2C)	5/8/98	REVISED SECTION LINE INFO	EDC	No Revisions:	C. R. 6E TO CRAFT DR.		NH 1602-058
Last Modification Date: 11/13/97	Initials: EDC					Revised:	Designer: EDC		10578
Full Path: BEAST F:\JOBS\CDOT\5657-003\DWGS-IN-PROG						Void:	Detailer: EDC		
Drawing File Name: CONTROL							Sheet Subset: CONTROL	Subset Sheets: 2 of 8	Sheet Number 4A
Units: METRIC									

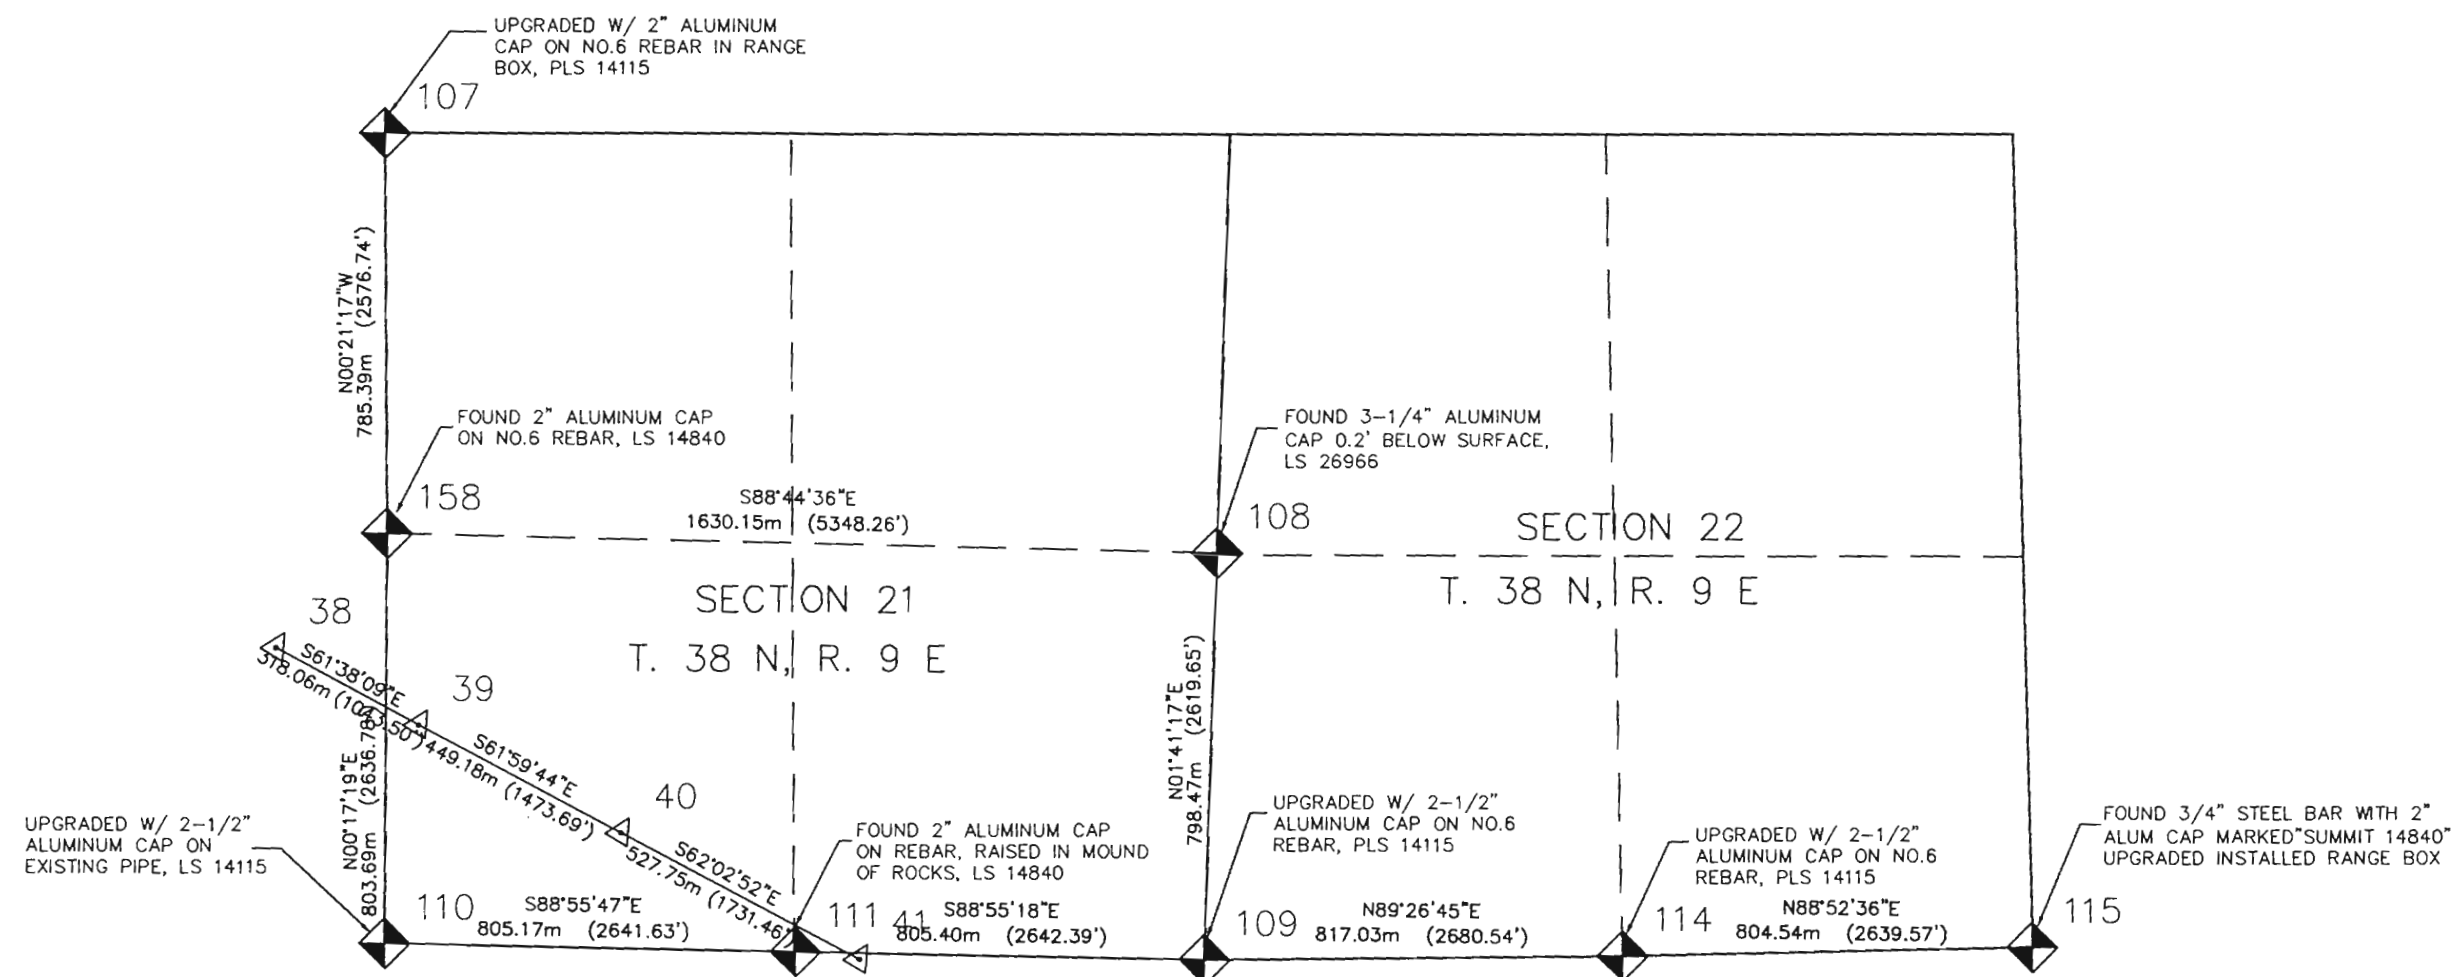


NOTE: SECTION CORNER MONUMENTS AS SHOWN
WILL BE UPGRADED TO STATE STANDARDS
ACCORDING TO RULE XIII. "PHYSICAL STANDARDS
FOR PUBLIC LAND SURVEY SYSTEM MONUMENTS"



N.T.S.

Computer File Information		Index of Revisions		Colorado Department of Transportation		As Constructed		SURVEY CONTROL		Project No./Code	
Creation Date: 07/22/97	Initials: EDC	5/8/98	REVISED SECTION LINE INFO	EDC	 3803 North Main Avenue, Suite 300 Durango, Colorado 81301 Phone: 970-385-1400 FAX: 970-385-1410 Region 5	No Revisions:		C. R. 6E TO CRAFT DR.		NH 1602-058	
Last Modification Date: 11/13/97	Initials: EDC					Revised:		Designer: EDC		10578	
Full Path: BEAST F:\JOBS\CDOT\5657-003\DWGS-IN-PROG						Void:		Detailer: EDC		Sheet Number 4B	
Drawing File Name: CONTROL								Sheet Subset: CONTROL	Subset Sheets: 3 of 8		

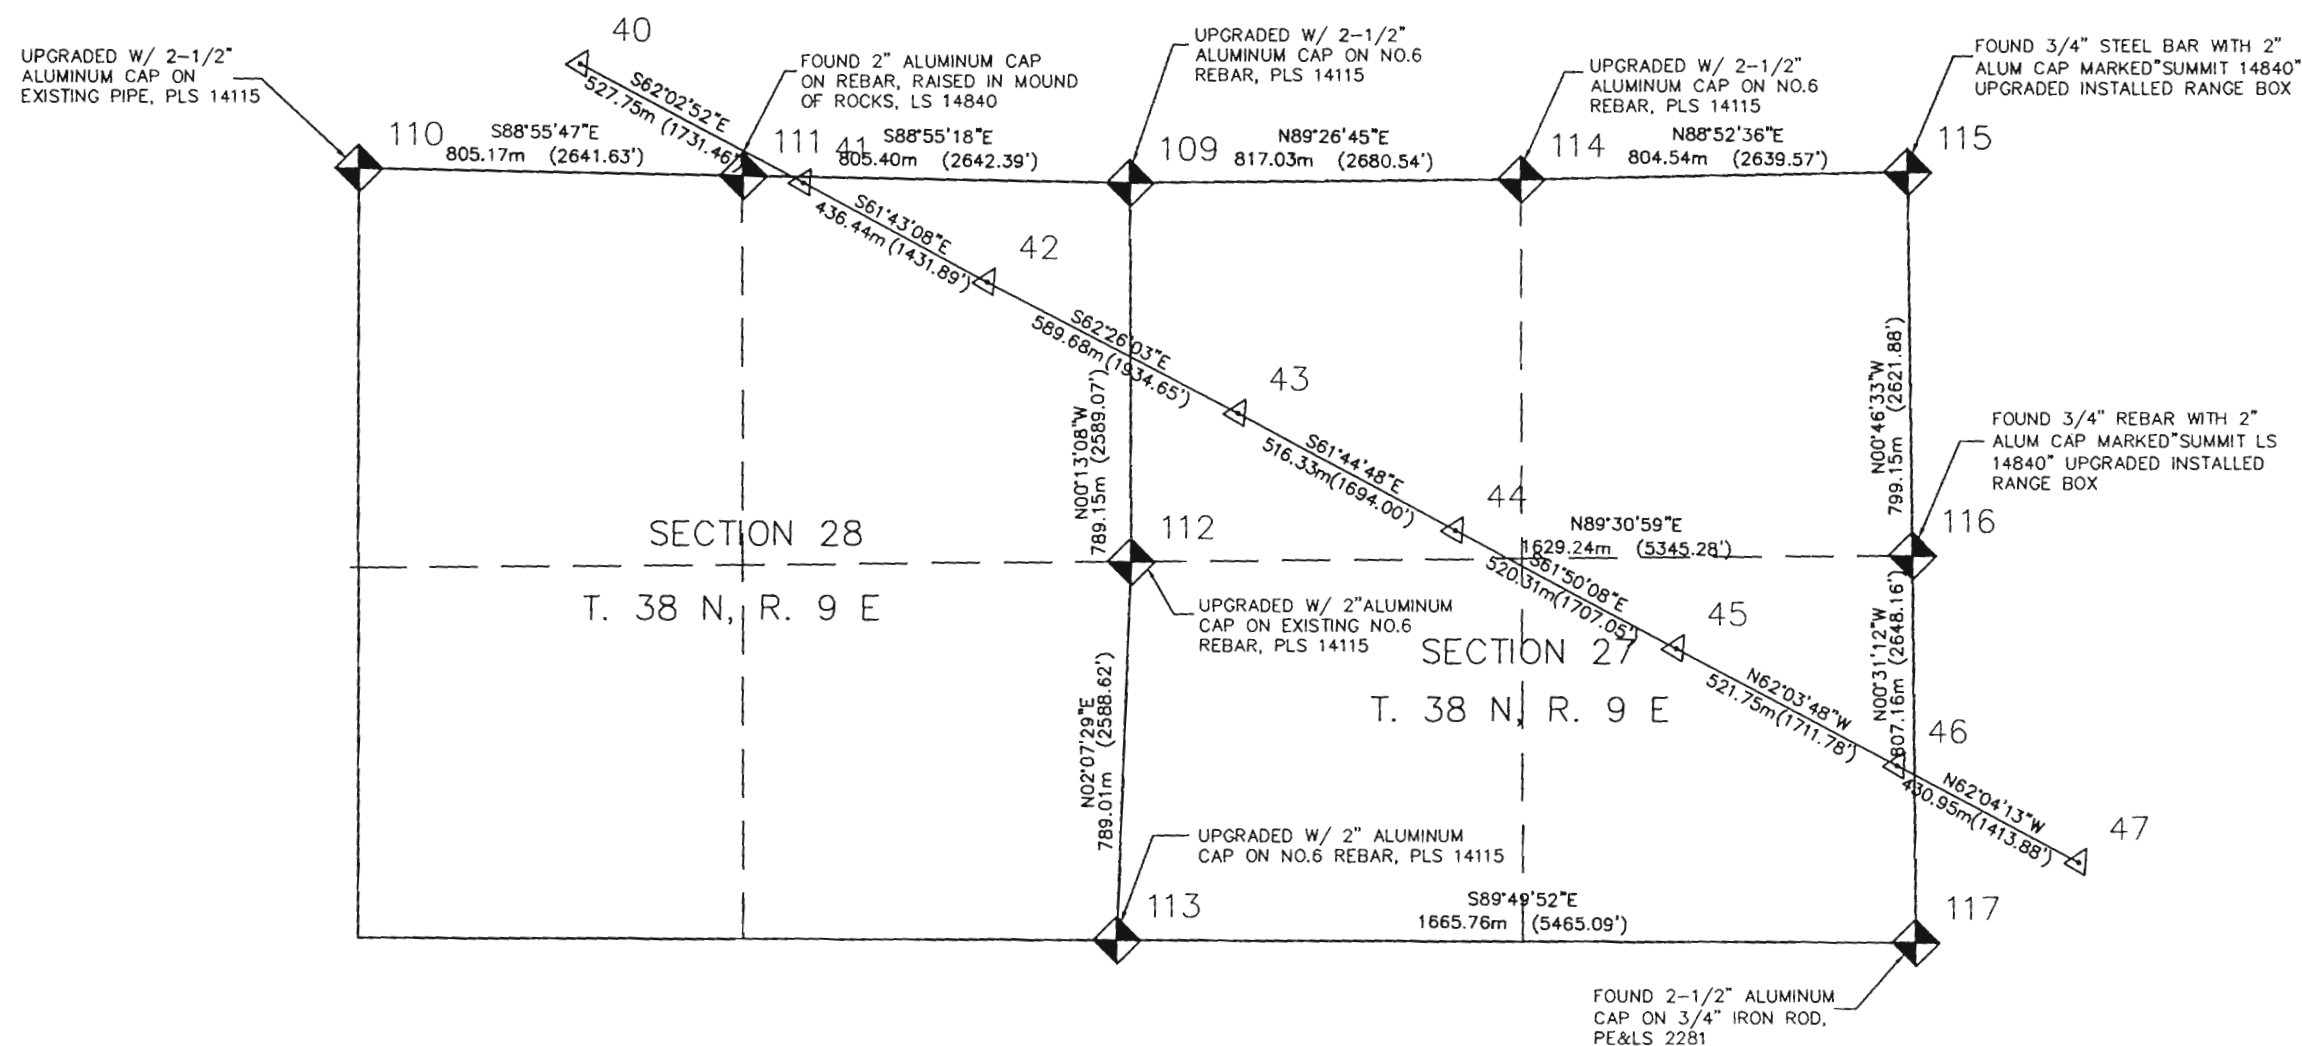


NOTE: SECTION CORNER MONUMENTS AS SHOWN
WILL BE UPGRADED TO STATE STANDARDS
ACCORDING TO RULE XIII. "PHYSICAL STANDARDS
FOR PUBLIC LAND SURVEY SYSTEM MONUMENTS"



N.T.S.

Computer File Information		Index of Revisions		Colorado Department of Transportation  3803 North Main Avenue, Suite 300 Durango, Colorado 81301 Phone: 970-385-1400 FAX: 970-385-1410 Region 5	As Constructed		SURVEY CONTROL		Project No./Code				
Creation Date: 07/22/97	Initials: EDC	(R2C)	5/8/98		REVISED SECTION LINE INFO	EDC	No Revisions:		C. R. 6E TO CRAFT DR.		NH 1602-058		
Last Modification Date: 11/13/97	Initials: EDC						Revised:		Designer: EDC		10578		
Full Path: BEAST F:\JOBS\CDOT\5657-003\DWGS-IN-PROG							Void:		Detailer: EDC				
File Name: CONTROL									Sheet Subset: CONTROL		Subset Sheets: 4 of 8		
										Sheet Number		4C	

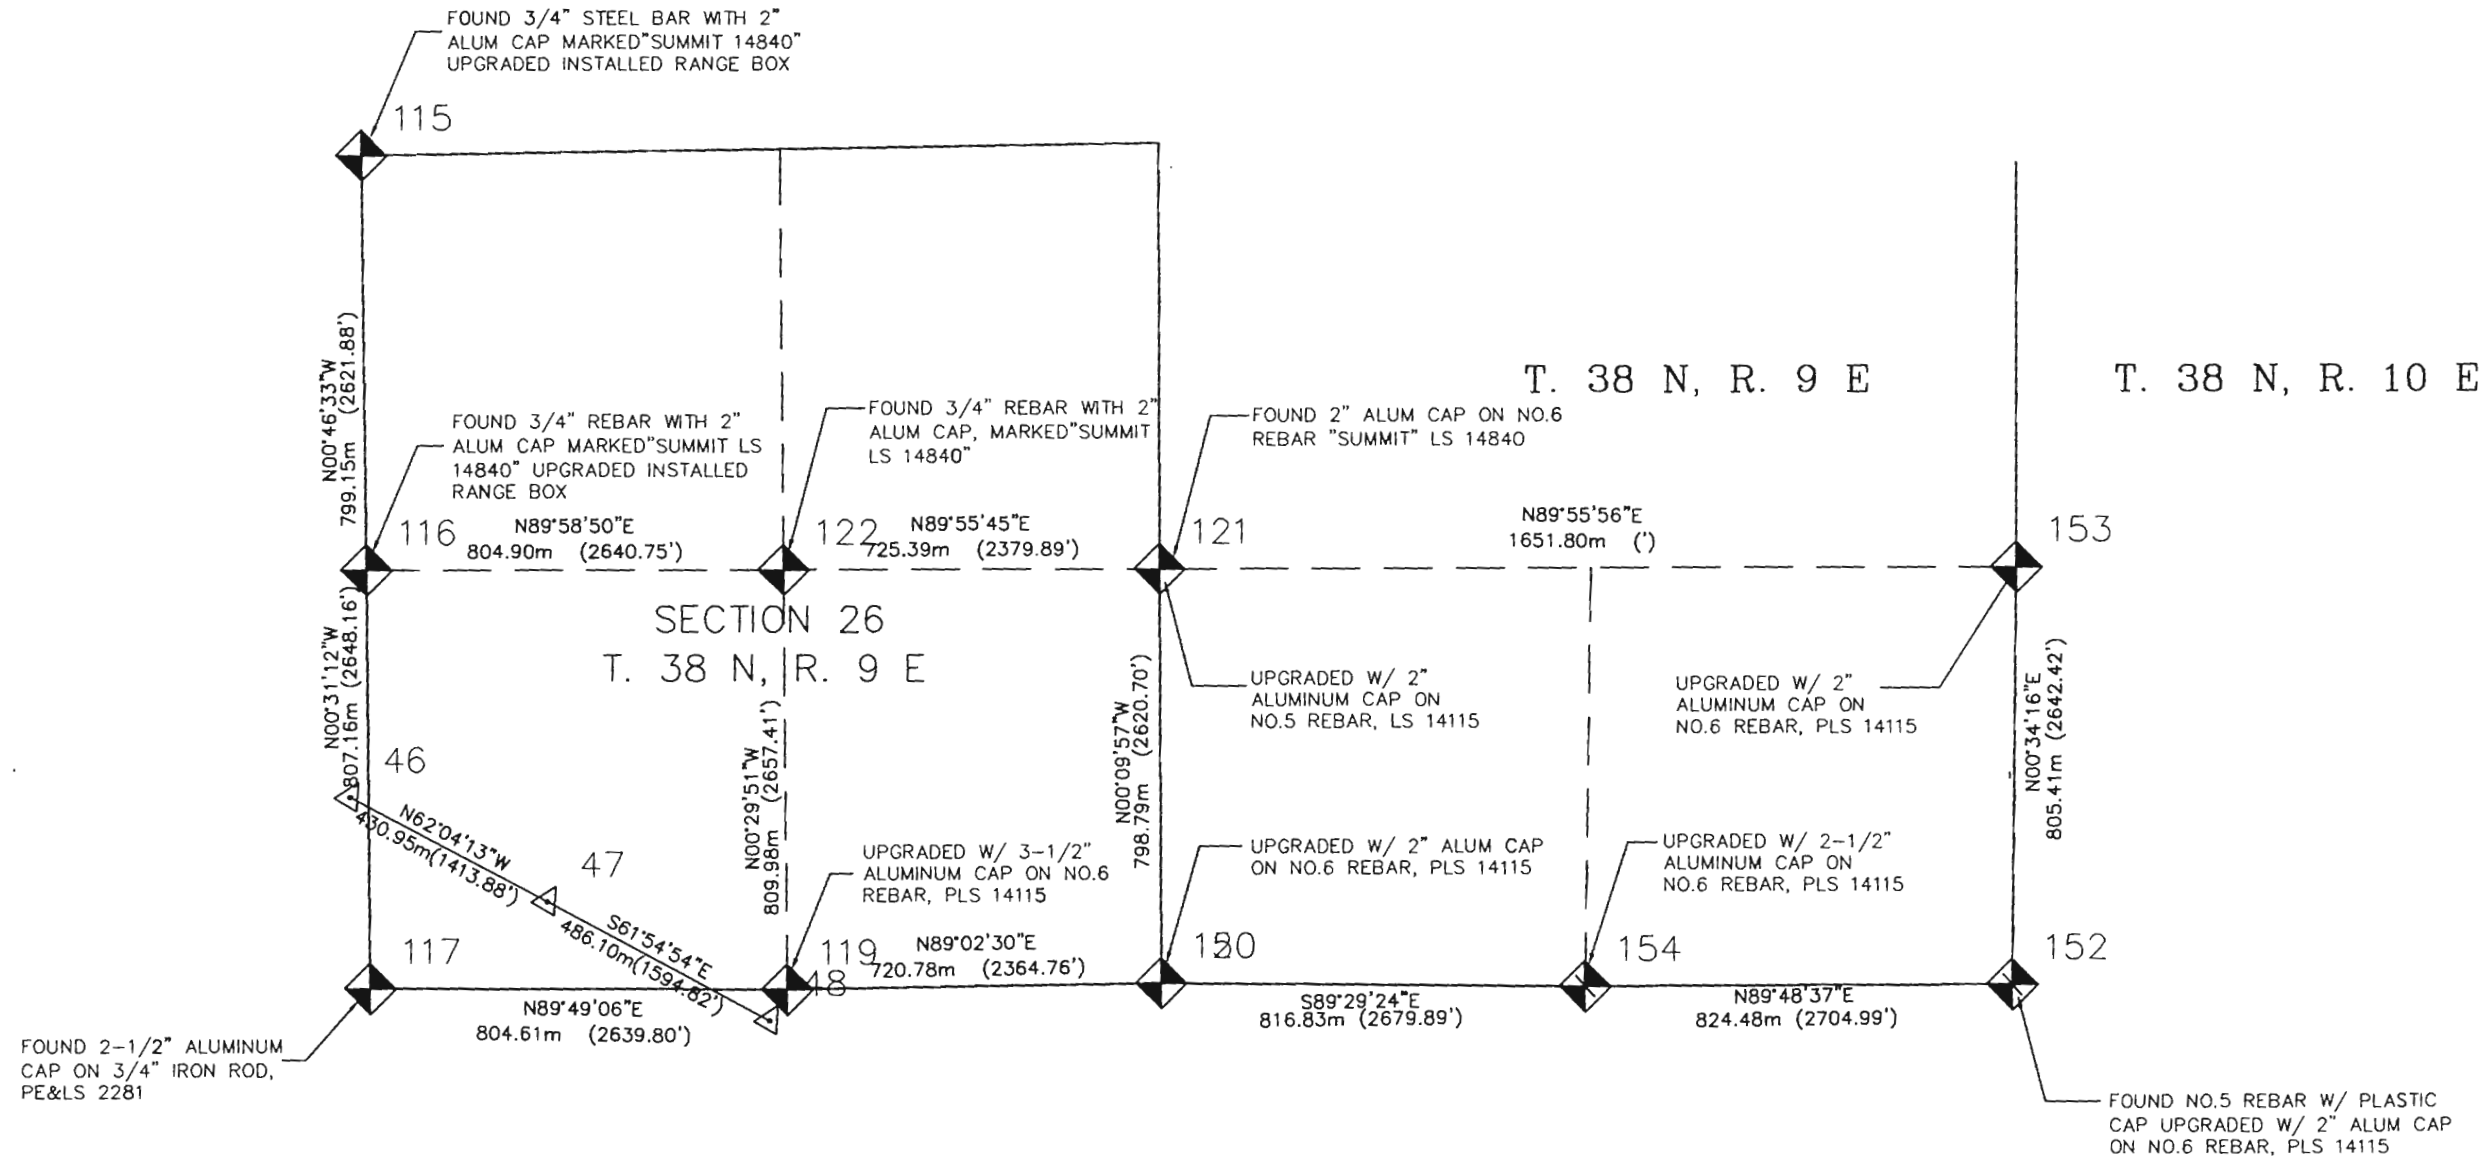


NOTE: SECTION CORNER MONUMENTS AS SHOWN WILL BE UPGRADED TO STATE STANDARDS ACCORDING TO RULE XIII. "PHYSICAL STANDARDS FOR PUBLIC LAND SURVEY SYSTEM MONUMENTS"



Computer File Information		Index of Revisions			As Constructed		SURVEY CONTROL		Project No./Code
Creation Date: 07/22/97	Initials: EDC	(R2C)	5/8/98	REVISED SECTION LINE INFO	EDC	No Revisions:	C. R. 6E TO CRAFT DR.		NH 1602-058
Last Modification Date: 12/2/97	Initials: EDC					Revised:	Designer: EDC		10578
Full Path: BEAST F:\JOBS\CDOT\5657-003\DWGS-IN-PROG						Void:	Detailer: EDC		
File Name: CONTROL							Sheet Subset: CONTROL	Subset Sheets: 5 of 8	Sheet Number 4D


Colorado Department of Transportation
3803 North Main Avenue, Suite 300
Durango, Colorado 81301
Phone: 970-385-1400 FAX: 970-385-1410
Region 5

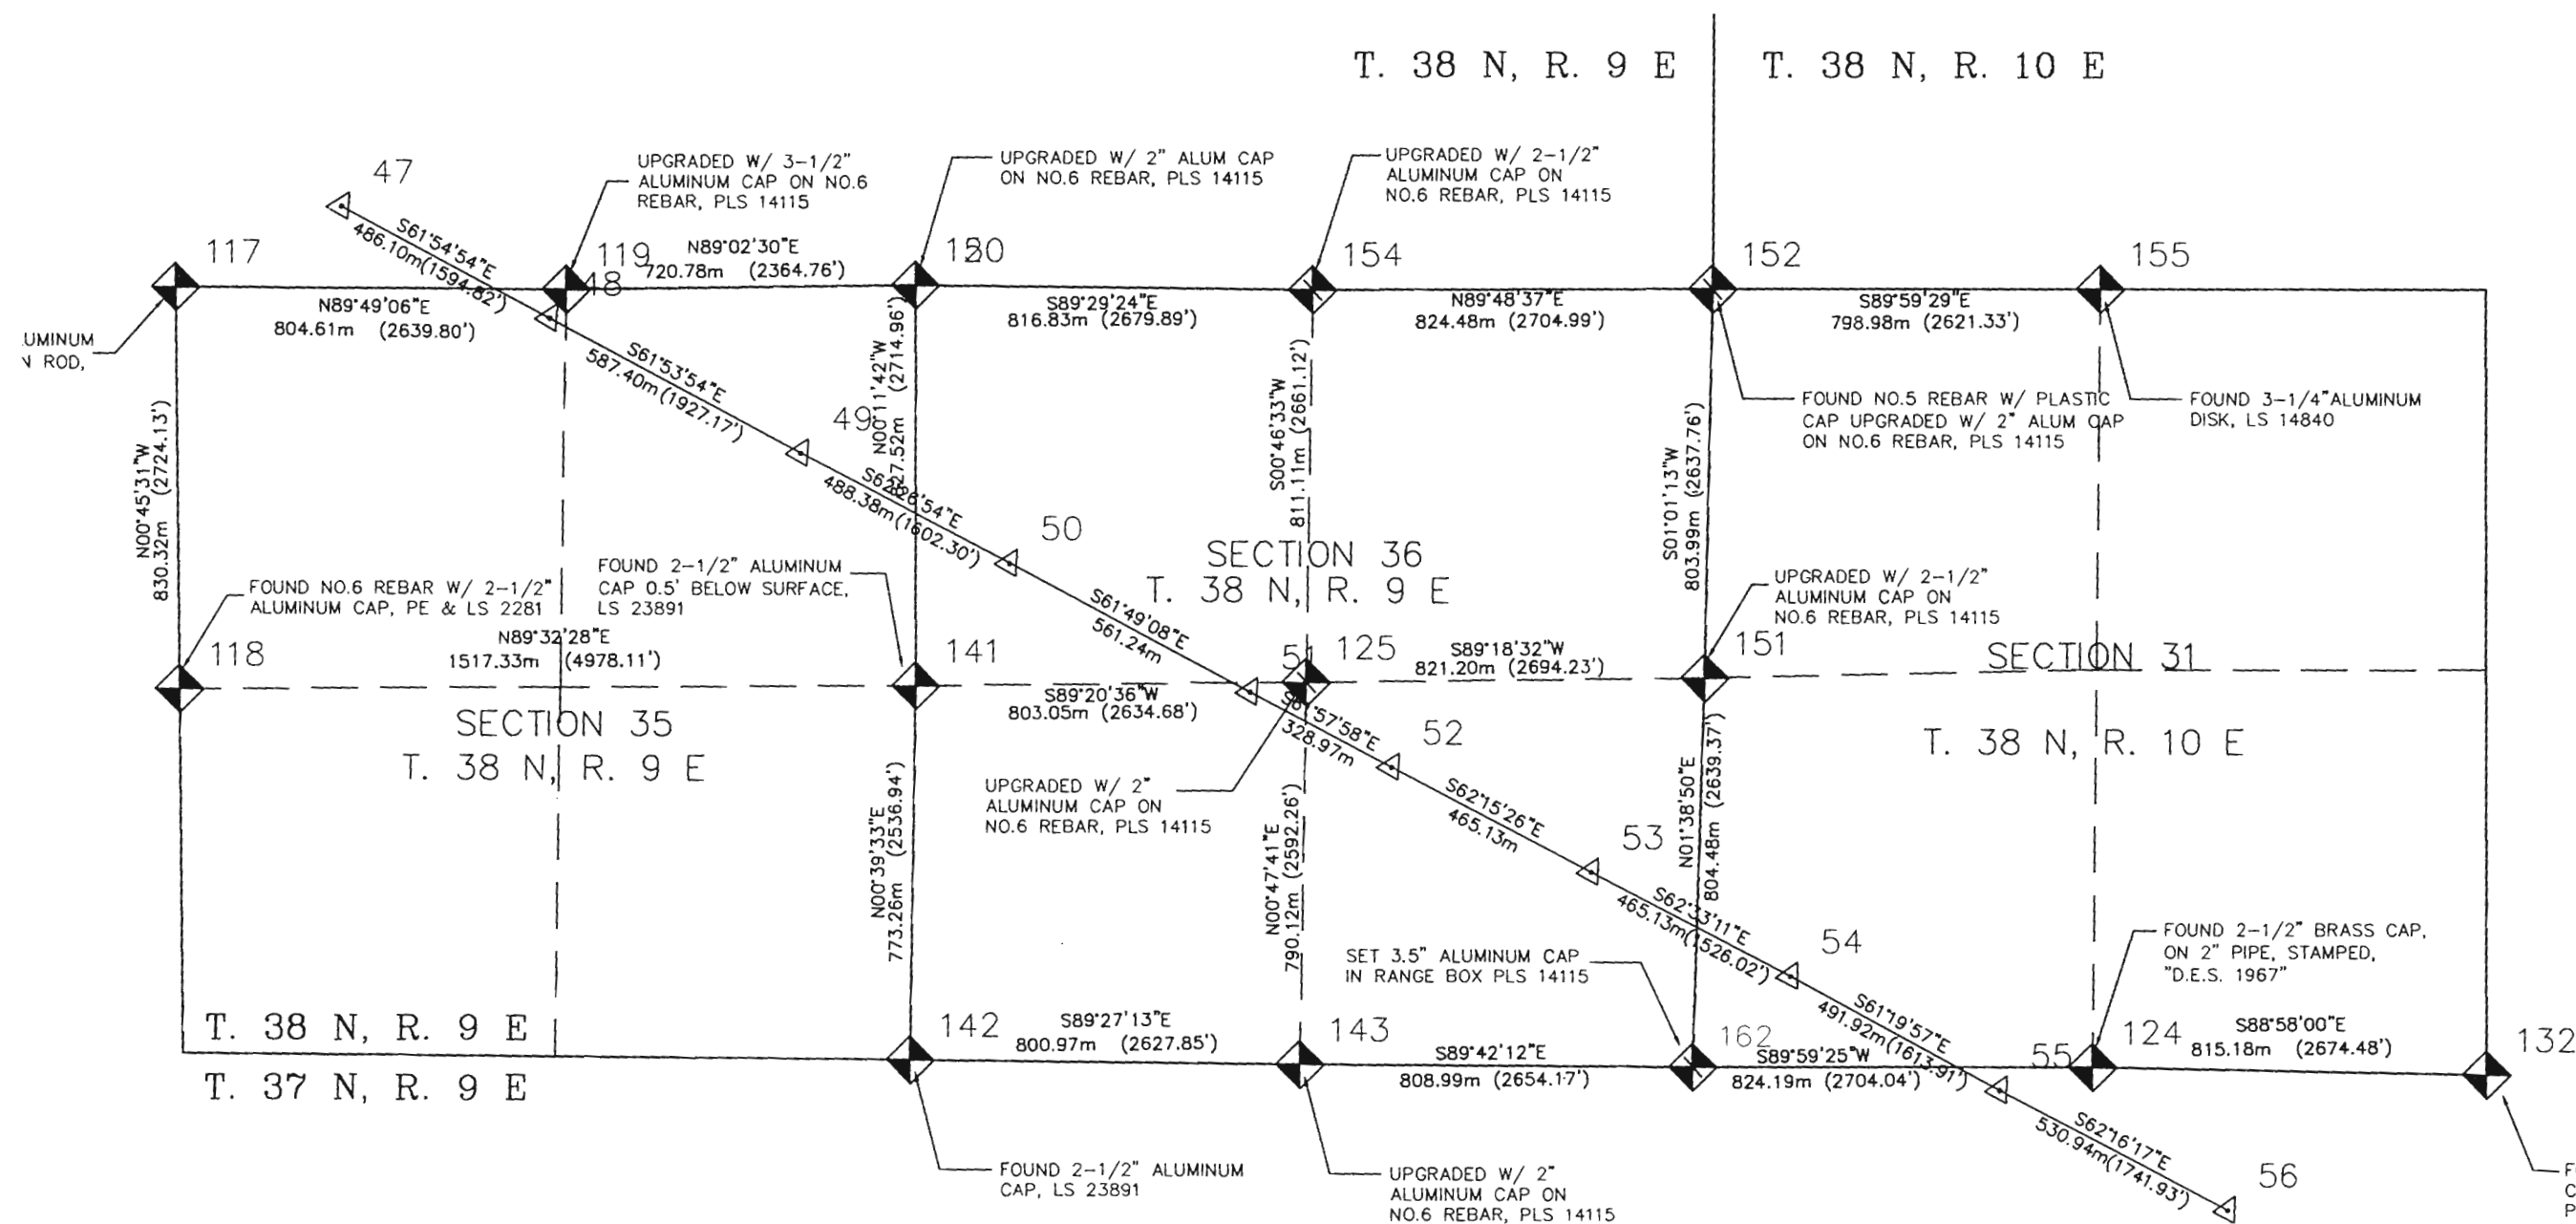

NOTE: SECTION CORNER MONUMENTS AS SHOWN
WILL BE UPGRADED TO STATE STANDARDS
ACCORDING TO RULE XIII. "PHYSICAL STANDARDS
FOR PUBLIC LAND SURVEY SYSTEM MONUMENTS"

N.T.S.


Computer File Information		Index of Revisions		Colorado Department of Transportation	As Constructed		SURVEY CONTROL		Project No./Code	
Creation Date: 07/22/97	Initials: EDC	5/8/98	REVISED SECTION LINE INFO		No Revisions:		C. R. 6E TO CRAFT DR.		NH 1602-058	
Last Modification Date: 12/2/97	Initials: EDC			 3803 North Main Avenue, Suite 300 Durango, Colorado 81301 Phone: 970-385-1400 FAX: 970-385-1410 Region 5	Revised:		Designer: EDC		10578	
Full Path: BEAST F:\JOBS\CDOT\5657-003\DWGS-IN-PROG					Void:		Detailer: EDC		Sheet Number	4E
File Name: CONTROL							Sheet Subset: CONTROL	Subset Sheets: 6 of 8		

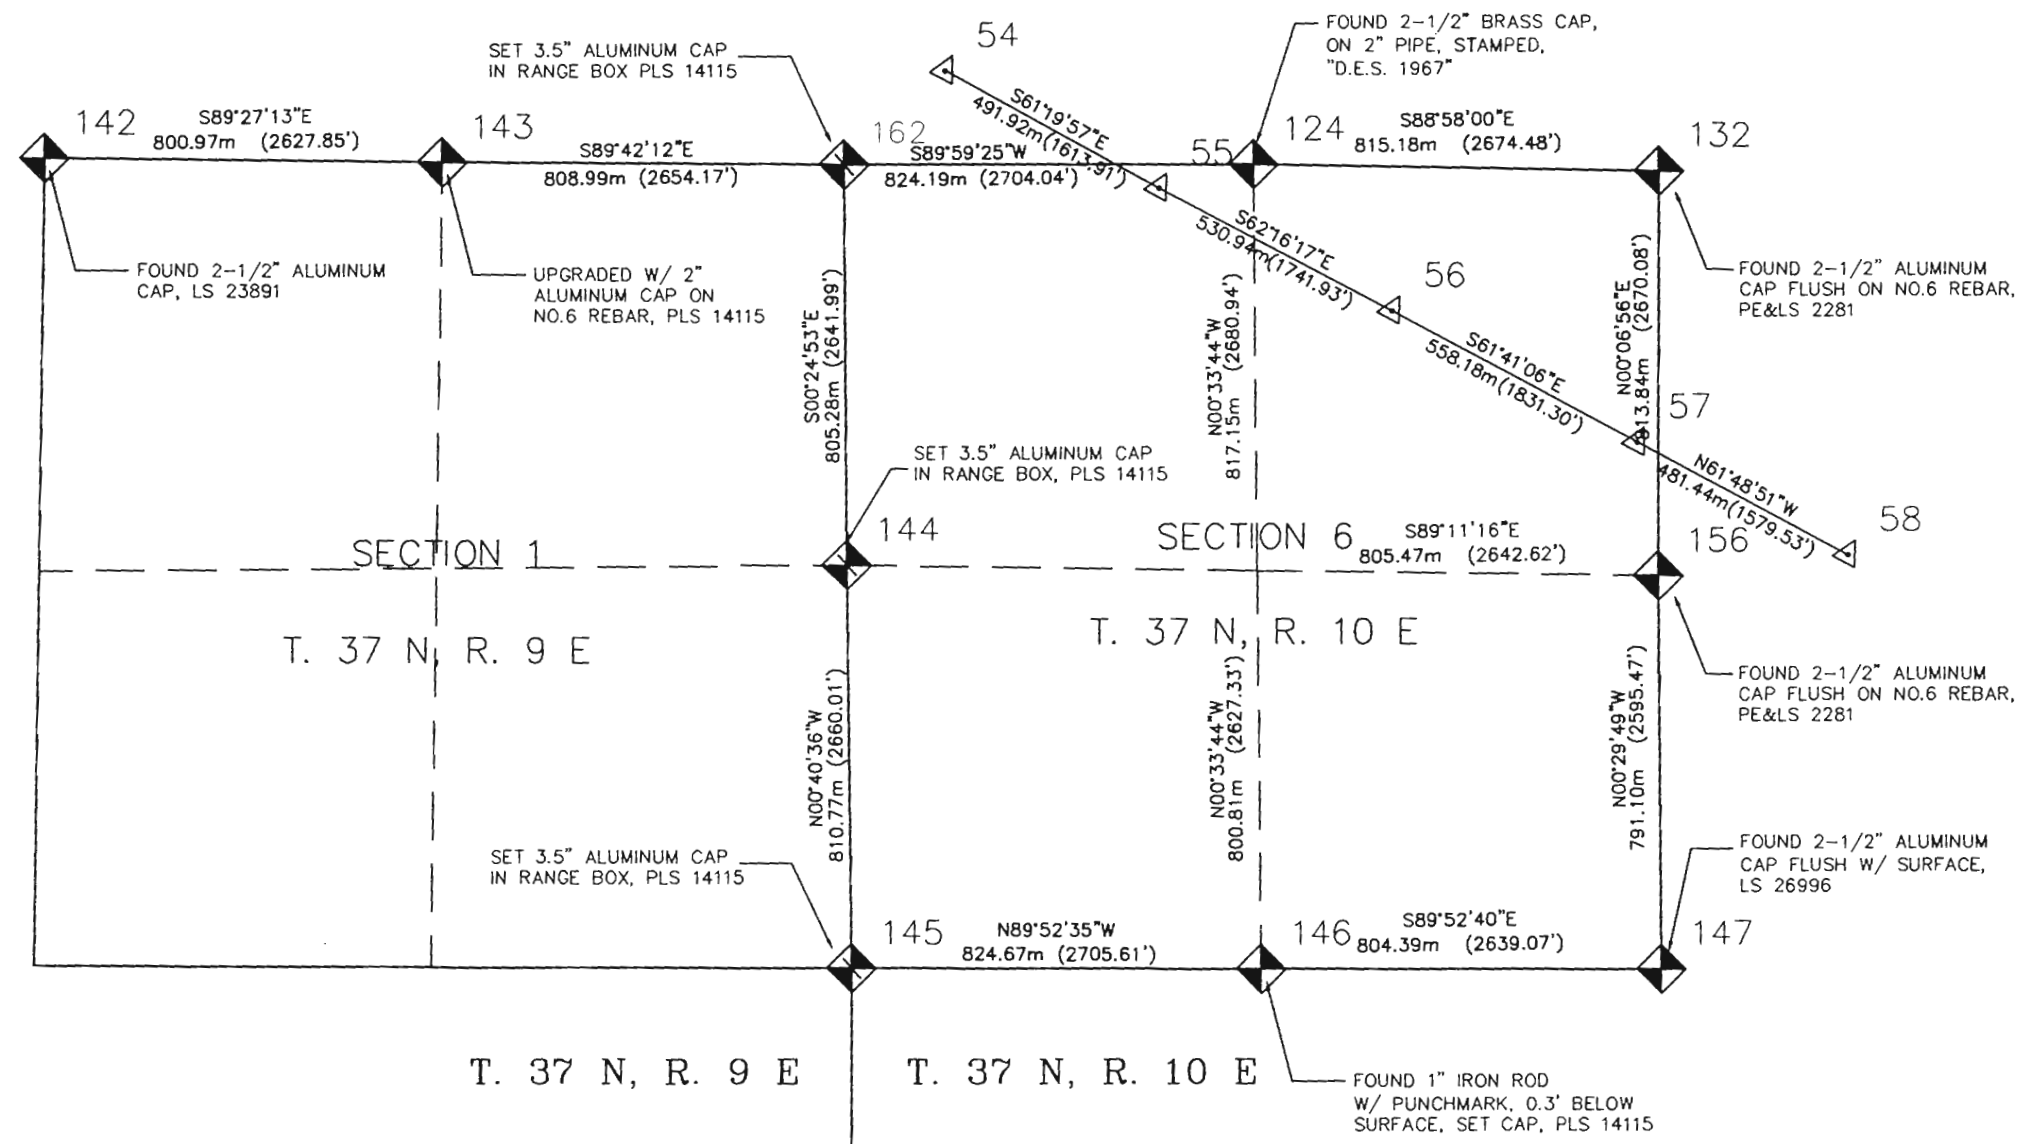

NOTE: SECTION CORNER MONUMENTS AS SHOWN
WILL BE UPGRADED TO STATE STANDARDS
ACCORDING TO RULE XIII. "PHYSICAL STANDARDS
FOR PUBLIC LAND SURVEY SYSTEM MONUMENTS"



Computer File Information		Index of Revisions		Colorado Department of Transportation		As Constructed		SURVEY CONTROL		Project No./Code	
Creation Date: 07/22/97	Initials: EDC	(R2C)	5/8/98	REVISED SECTION LINE INFO	EDC	3803 North Main Avenue, Suite 300 Durango, Colorado 81301 Phone: 970-385-1400 FAX: 970-385-1410		C. R. 6E TO CRAFT DR.		NH 1602-058	
Last Modification Date: 11/13/97	Initials: EDC					Region 5		Designer: EDC		10578	
Full Path: BEAST F:\JOBS\CDOT\5657-003\DWGS-IN-PROG								Detailer: EDC			
Drawing File Name: CONTROL								Sheet Subset: CONTROL		Subset Sheets: 7 of 8	
										Sheet Number 4F	

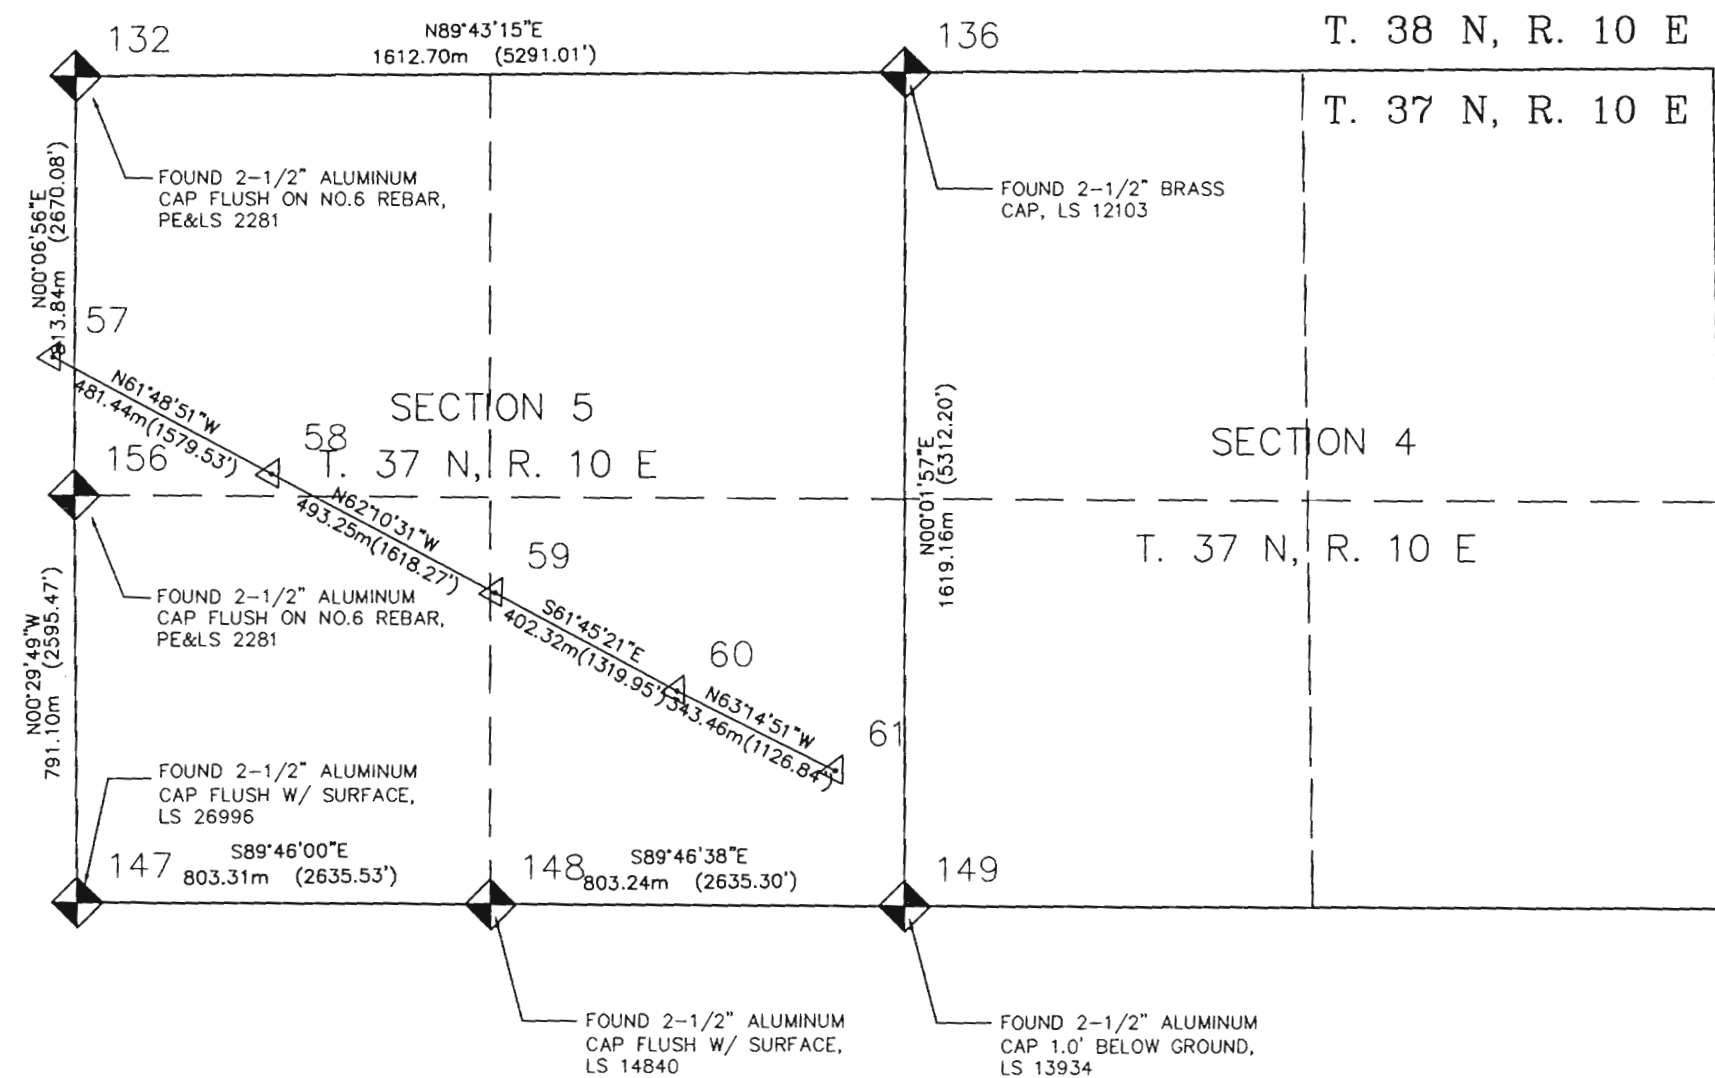

NOTE: SECTION CORNER MONUMENTS AS SHOWN
WILL BE UPGRADED TO STATE STANDARDS
ACCORDING TO RULE XIII. "PHYSICAL STANDARDS
FOR PUBLIC LAND SURVEY SYSTEM MONUMENTS"



Computer File Information			Index of Revisions			As Constructed		SURVEY CONTROL		Project No./Code	
Creation Date: 07/22/97	Initials: EDC	(R2C)	5/8/98	REVISED SECTION LINE INFO	EDC	No Revisions:		C. R. 6E TO CRAFT DR.		NH 1602-058	
Last Modification Date: 11/13/97	Initials: EDC					Revised:		Designer: EDC		10578	
Full Path: BEAST F:\JOBS\CDOT\5657-003\DWGS-IN-PROG						Void:		Detailer: EDC		Sheet Number 4G	
Drawing File Name: CONTROL								Sheet Subset: CONTROL	Subset Sheets: 8 of 8		
Acad Ver. R14	Scale: N.T.S.	Units: METRIC									



3803 North Main Avenue, Suite 300
Durango, Colorado 81301
Phone: 970-385-1400 FAX: 970-385-1410

Region 5

Colorado Department of Transportation

Colorado Department of Transportation





3803 North Main Avenue, Suite 300
Durango, Colorado 81301
Phone: 970-385-1400 FAX: 970-385-1410


Region 5



NE 1/4
SECTION 14
T 38 N, R 8 E

NW 1/4
SECTION 13
T 38 N, R 8 E

STA. 252+666.67
BEGIN PROJECT NH 1602-058=
STA. 242+06.40 PROJECT NH 1602-058
M.P. 221.4

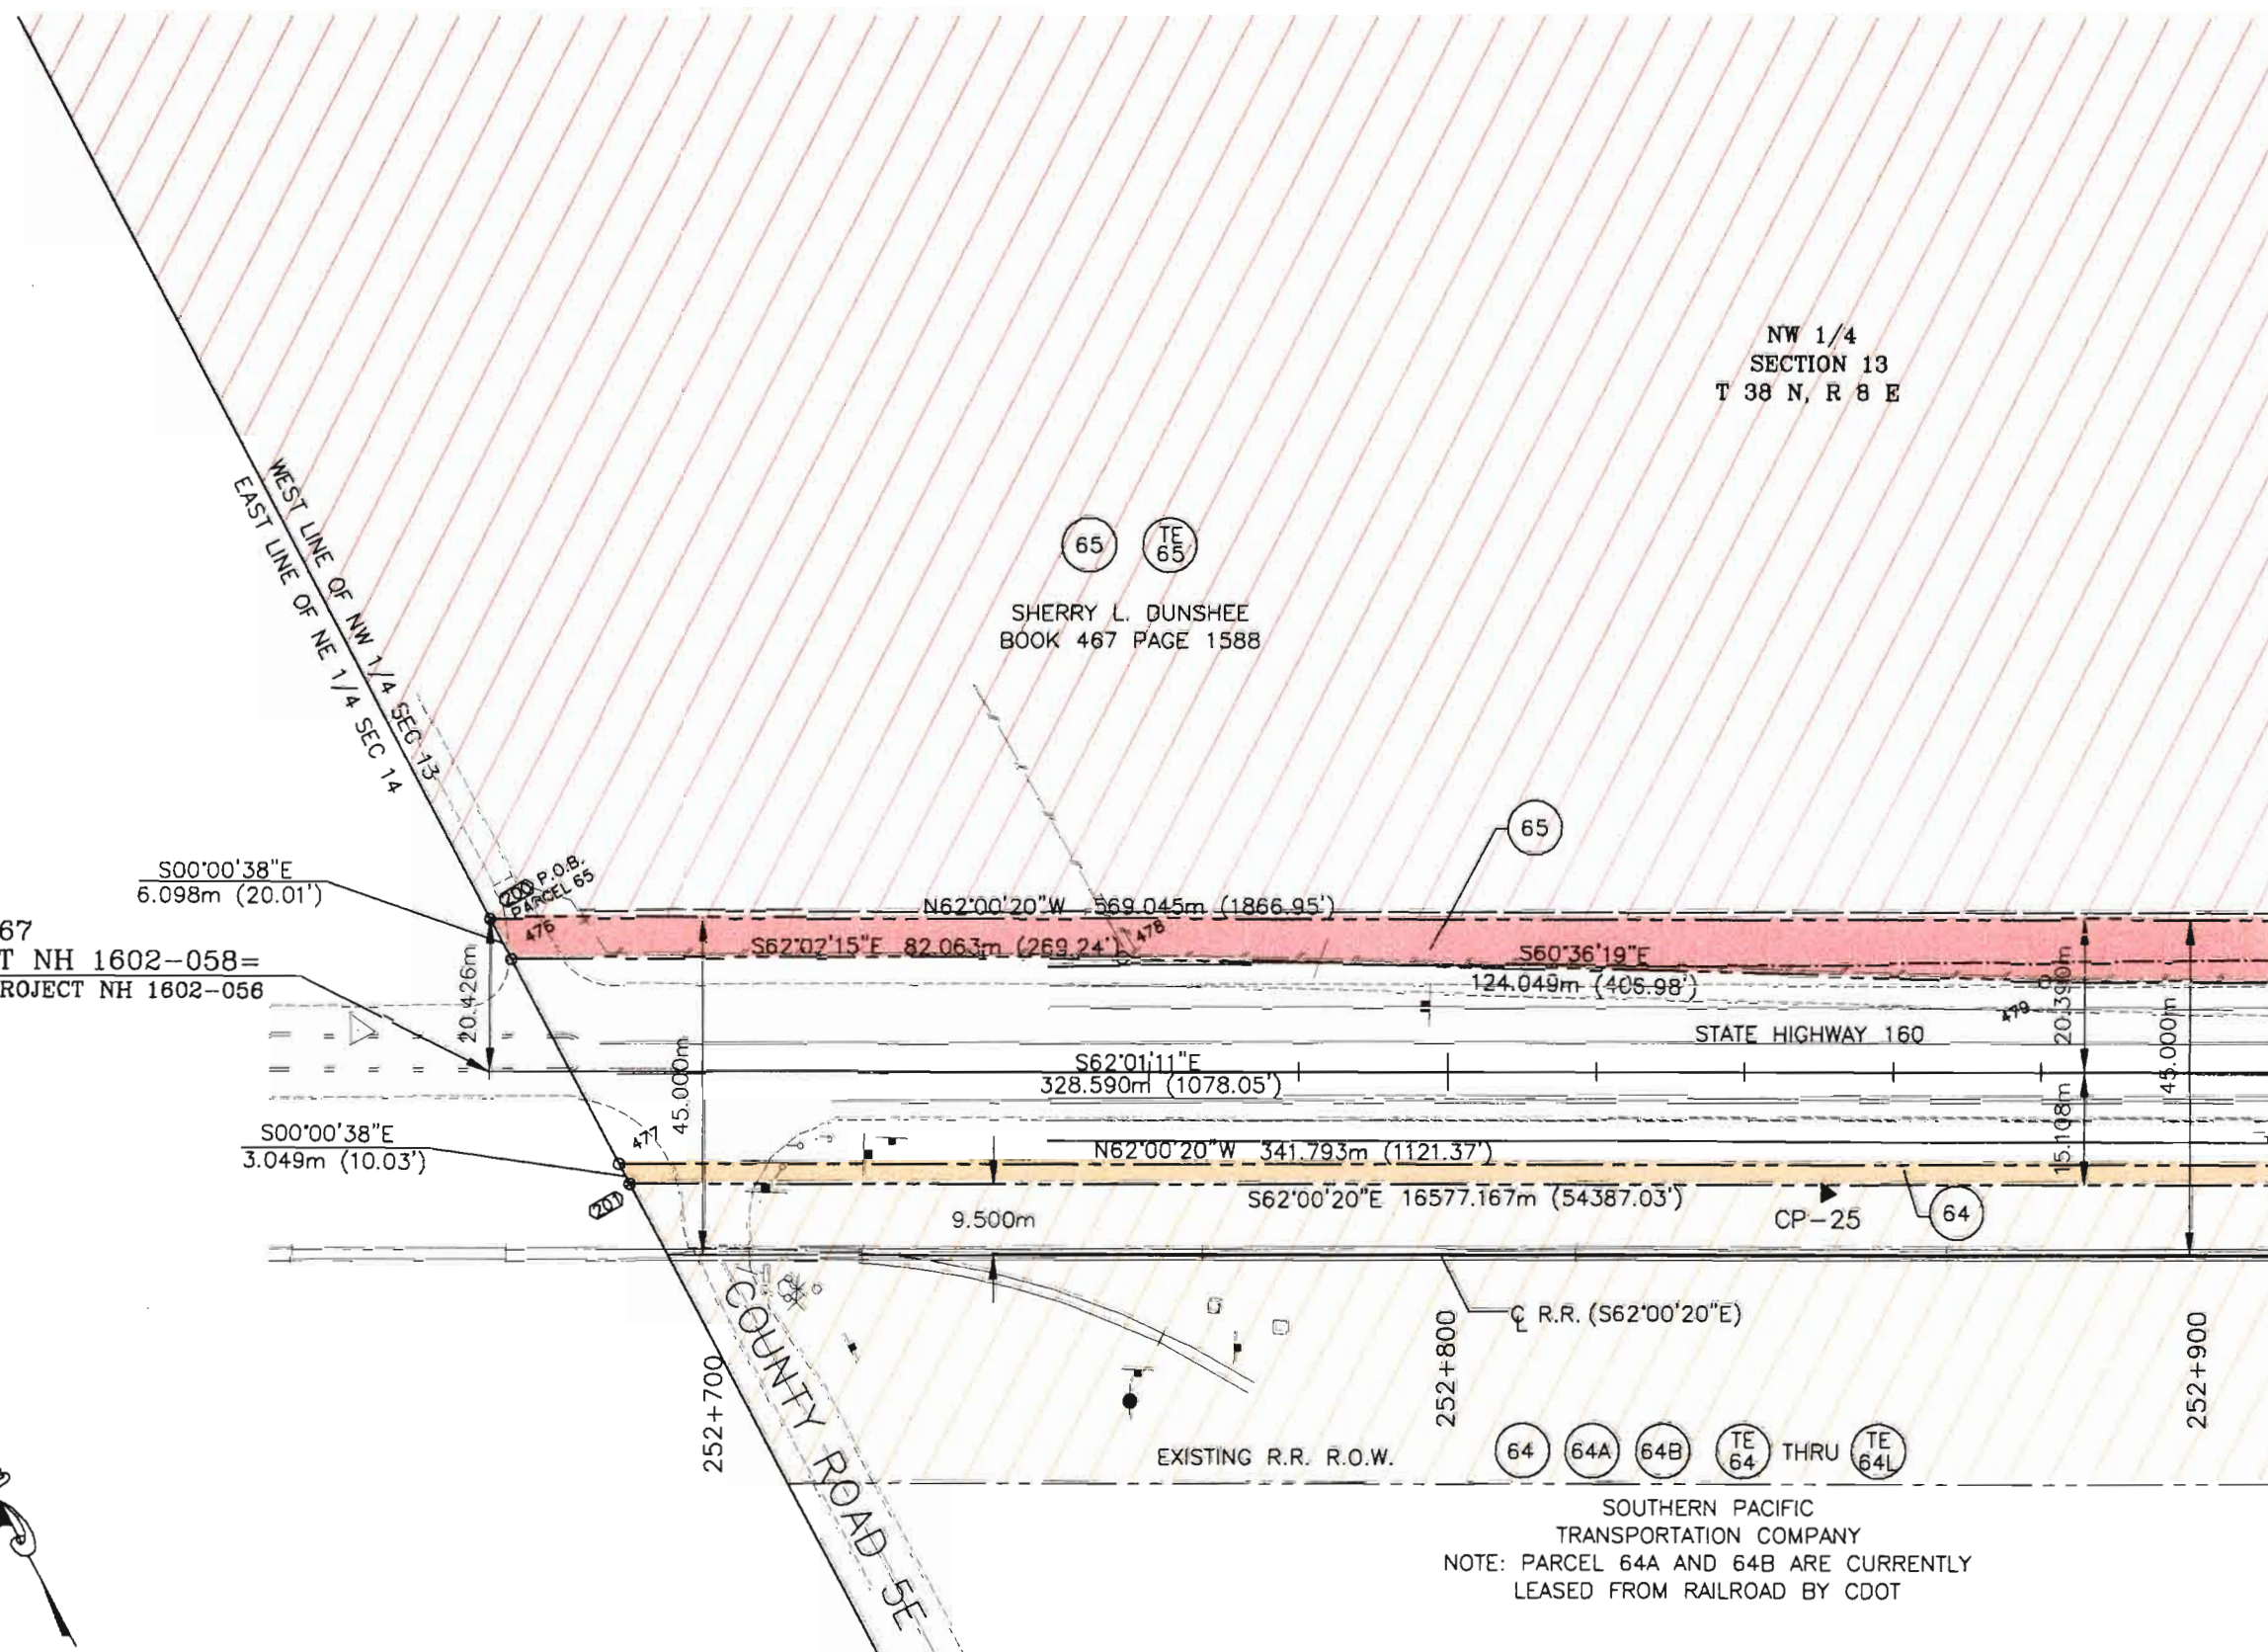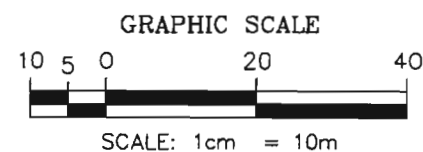

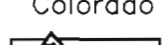Computer File Information				Index of Revisions				Colorado Department of Transportation				As Constructed		RIGHT-OF-WAY PLAN SHEET				Project No./Code	
Creation Date: 07/22/97		Initials: JRY						 3803 North Main Avenue, Suite 300 Durango, Colorado 81301 Phone: 970-385-1400 FAX: 970-385-1410 Region 5	No Revisions:		C. R. 6E TO CRAFT DR.				NH 1602-058				
Last Modification Date: 12/24/97		Initials: JRY							Revised:		Designer:				10578				
Full Path: BEAST F:\JOBS\CDOT\5657-003\PARCEL PLACEMENT											Detailer: JRY								
Drawing File Name: Rowplan3.DWG									Void:		Sheet Subset: R.O.W.		Subset Sheets: 1 OF 46		Sheet Number: 5				
Acad Ver. R14		Scale: 1:1000		Units: METRIC															

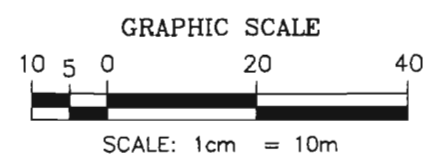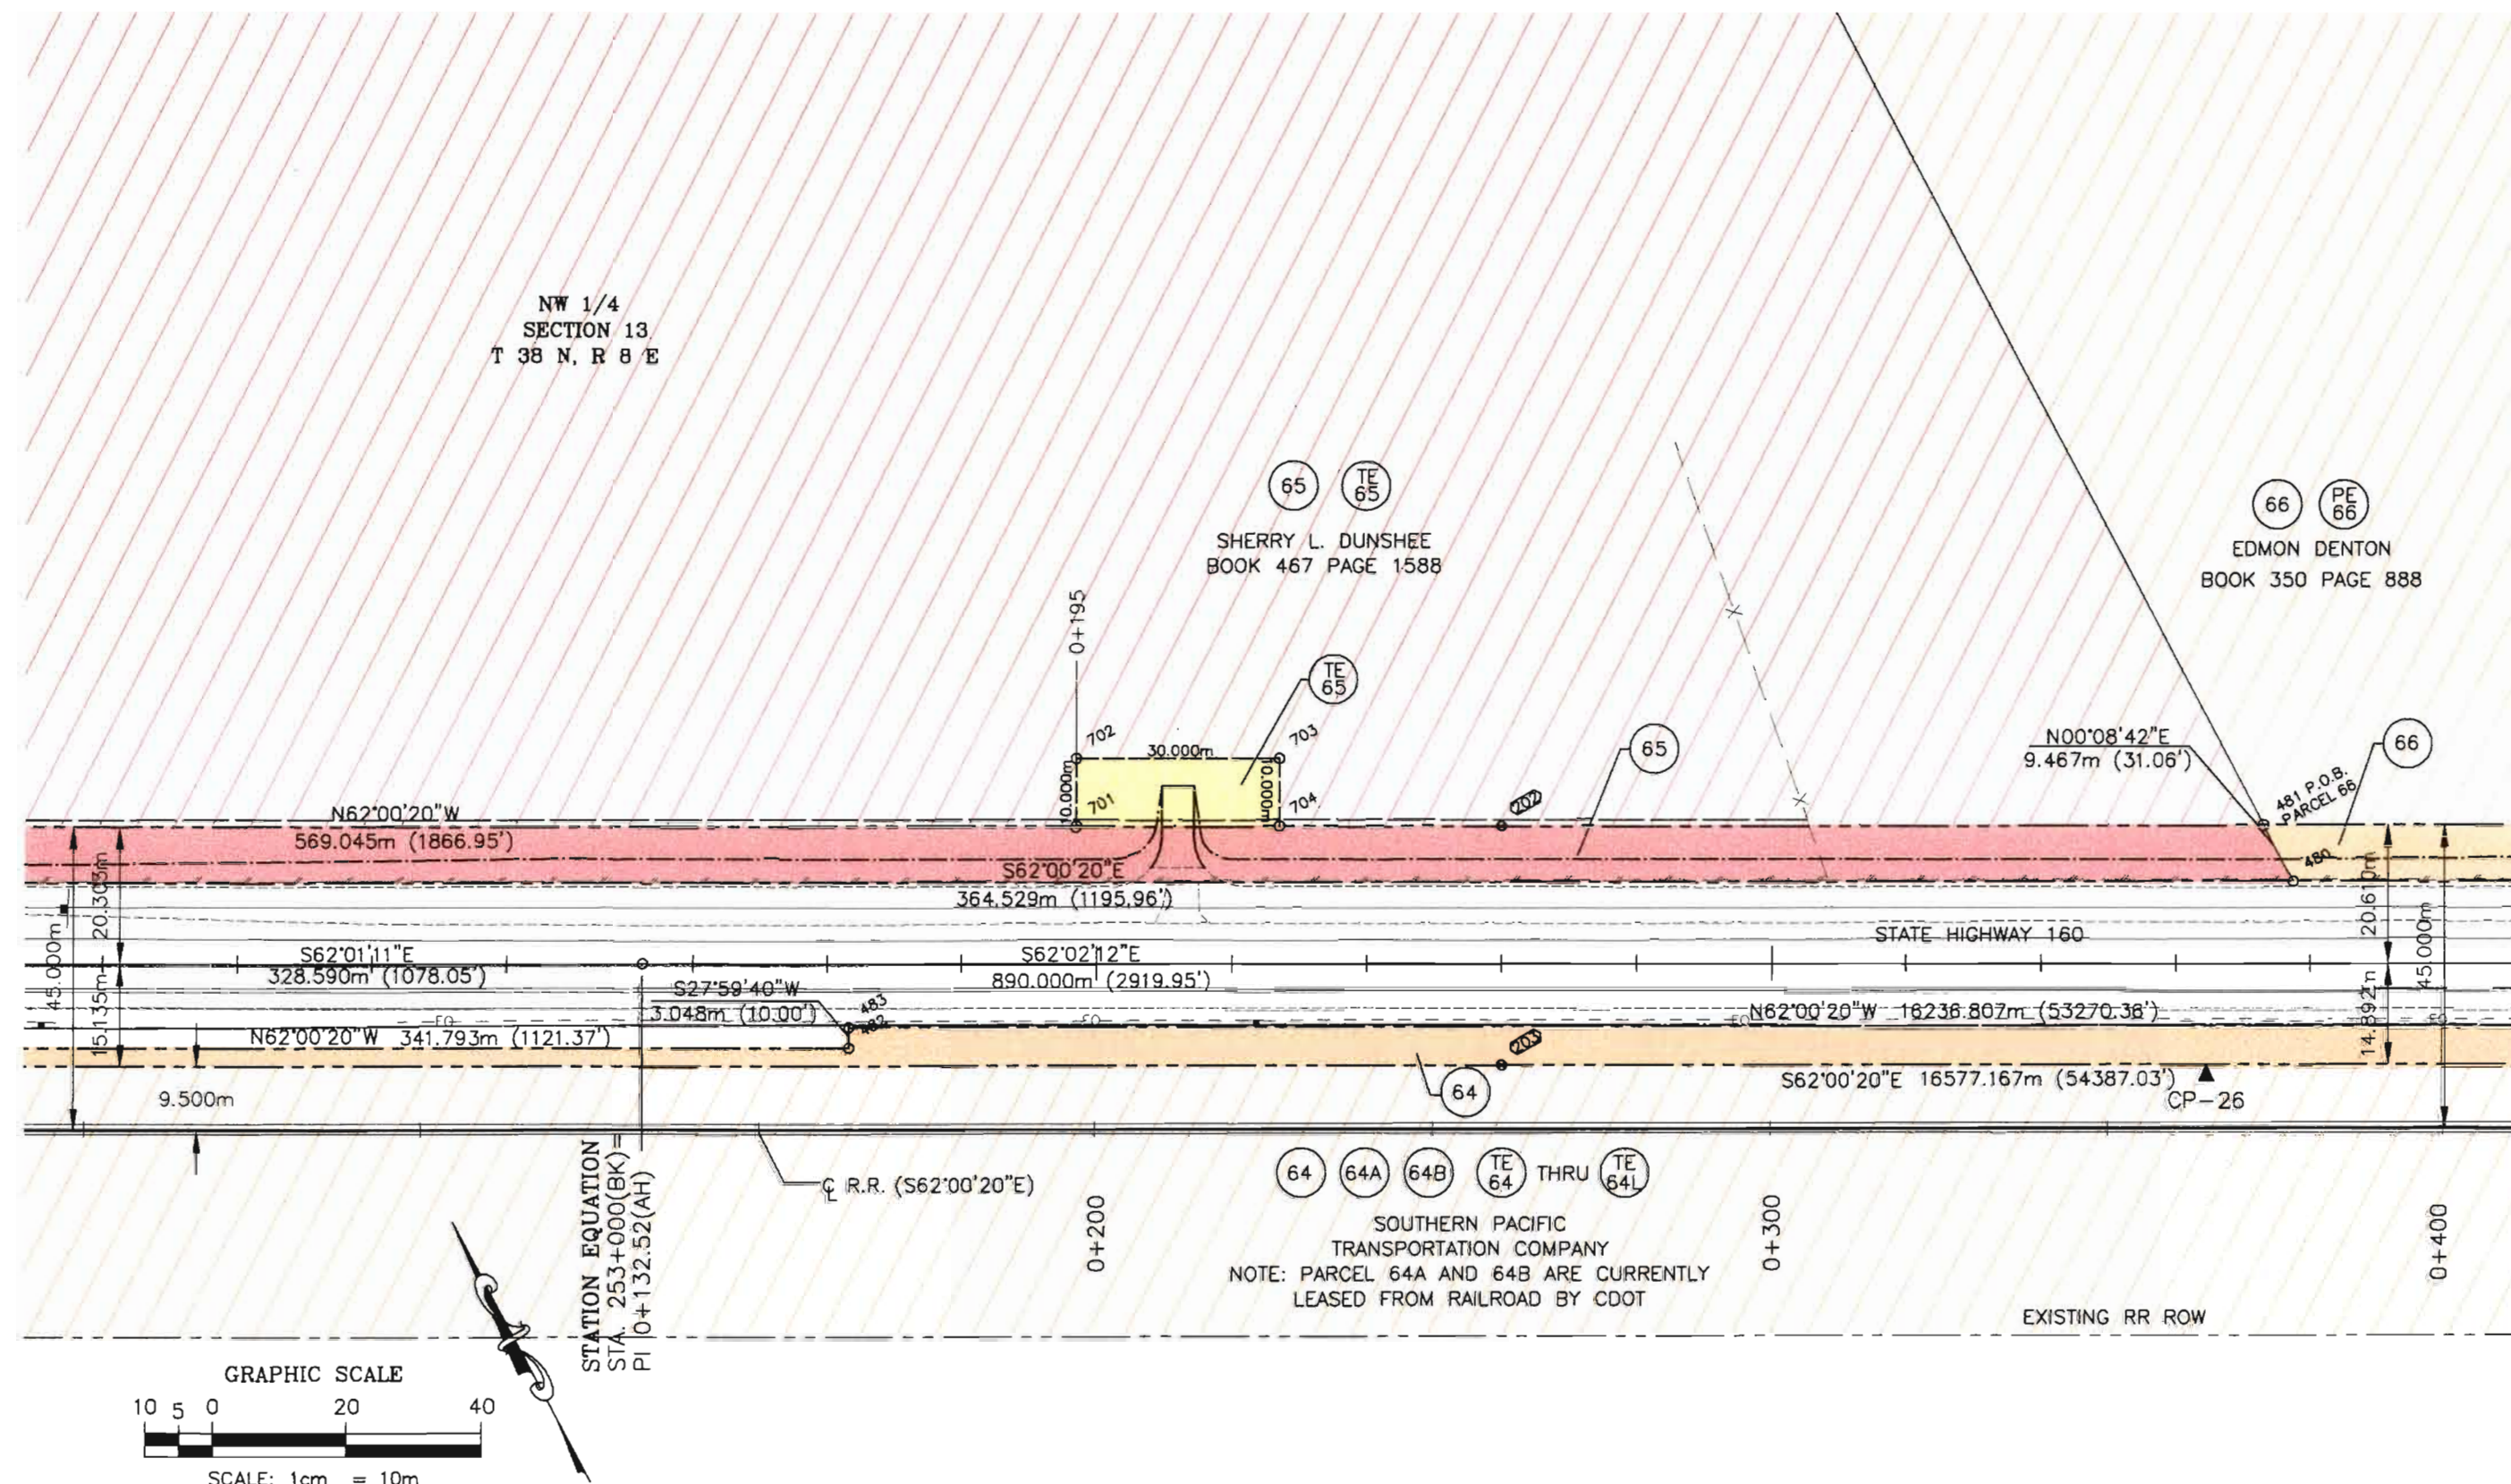



Computer File Information		Index of Revisions			As Constructed		RIGHT-OF-WAY PLAN SHEET		Project No./Code
Creation Date: 07/22/97	Initials: JRY	(R2A)	3/30/98	PARCEL PE-66	EDC	No Revisions:	C. R. 6E TO CRAFT DR.		NH 1602-058
Last Modification Date: 12/24/97	Initials: JRY					Revised:	Designer:		10578
Full Path: BEAST F:\JOBS\CDOT\5657-003\PARCEL PLACEMENT						Void:	Detailer: JRY		
Drawing File Name: Rowplan3.DWG							Sheet Subset: R.O.W.	Subset Sheets: 2 OF 46	Sheet Number: 6
Acad Ver. R14	Scale: 1:1000	Units: METRIC	 Colorado Department of Transportation 3803 North Main Avenue, Suite 300 Durango, Colorado 81301 Phone: 970-385-1400 FAX: 970-385-1410 Region 5						

NE 1/4
SECTION 13
T 38 N, R 8 E


NW 1/4
SECTION 13
T 38 N, R 8 E

66 PE 66
EDMON DENTON
BOOK 350 PAGE 888

REV. 67 PE 67 TE 67A TE 67B
DOUGLAS L. SHRIVER
BOOK 377 PAGE 970

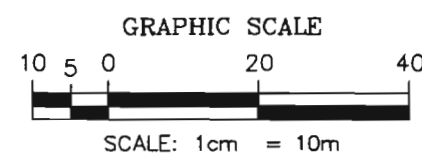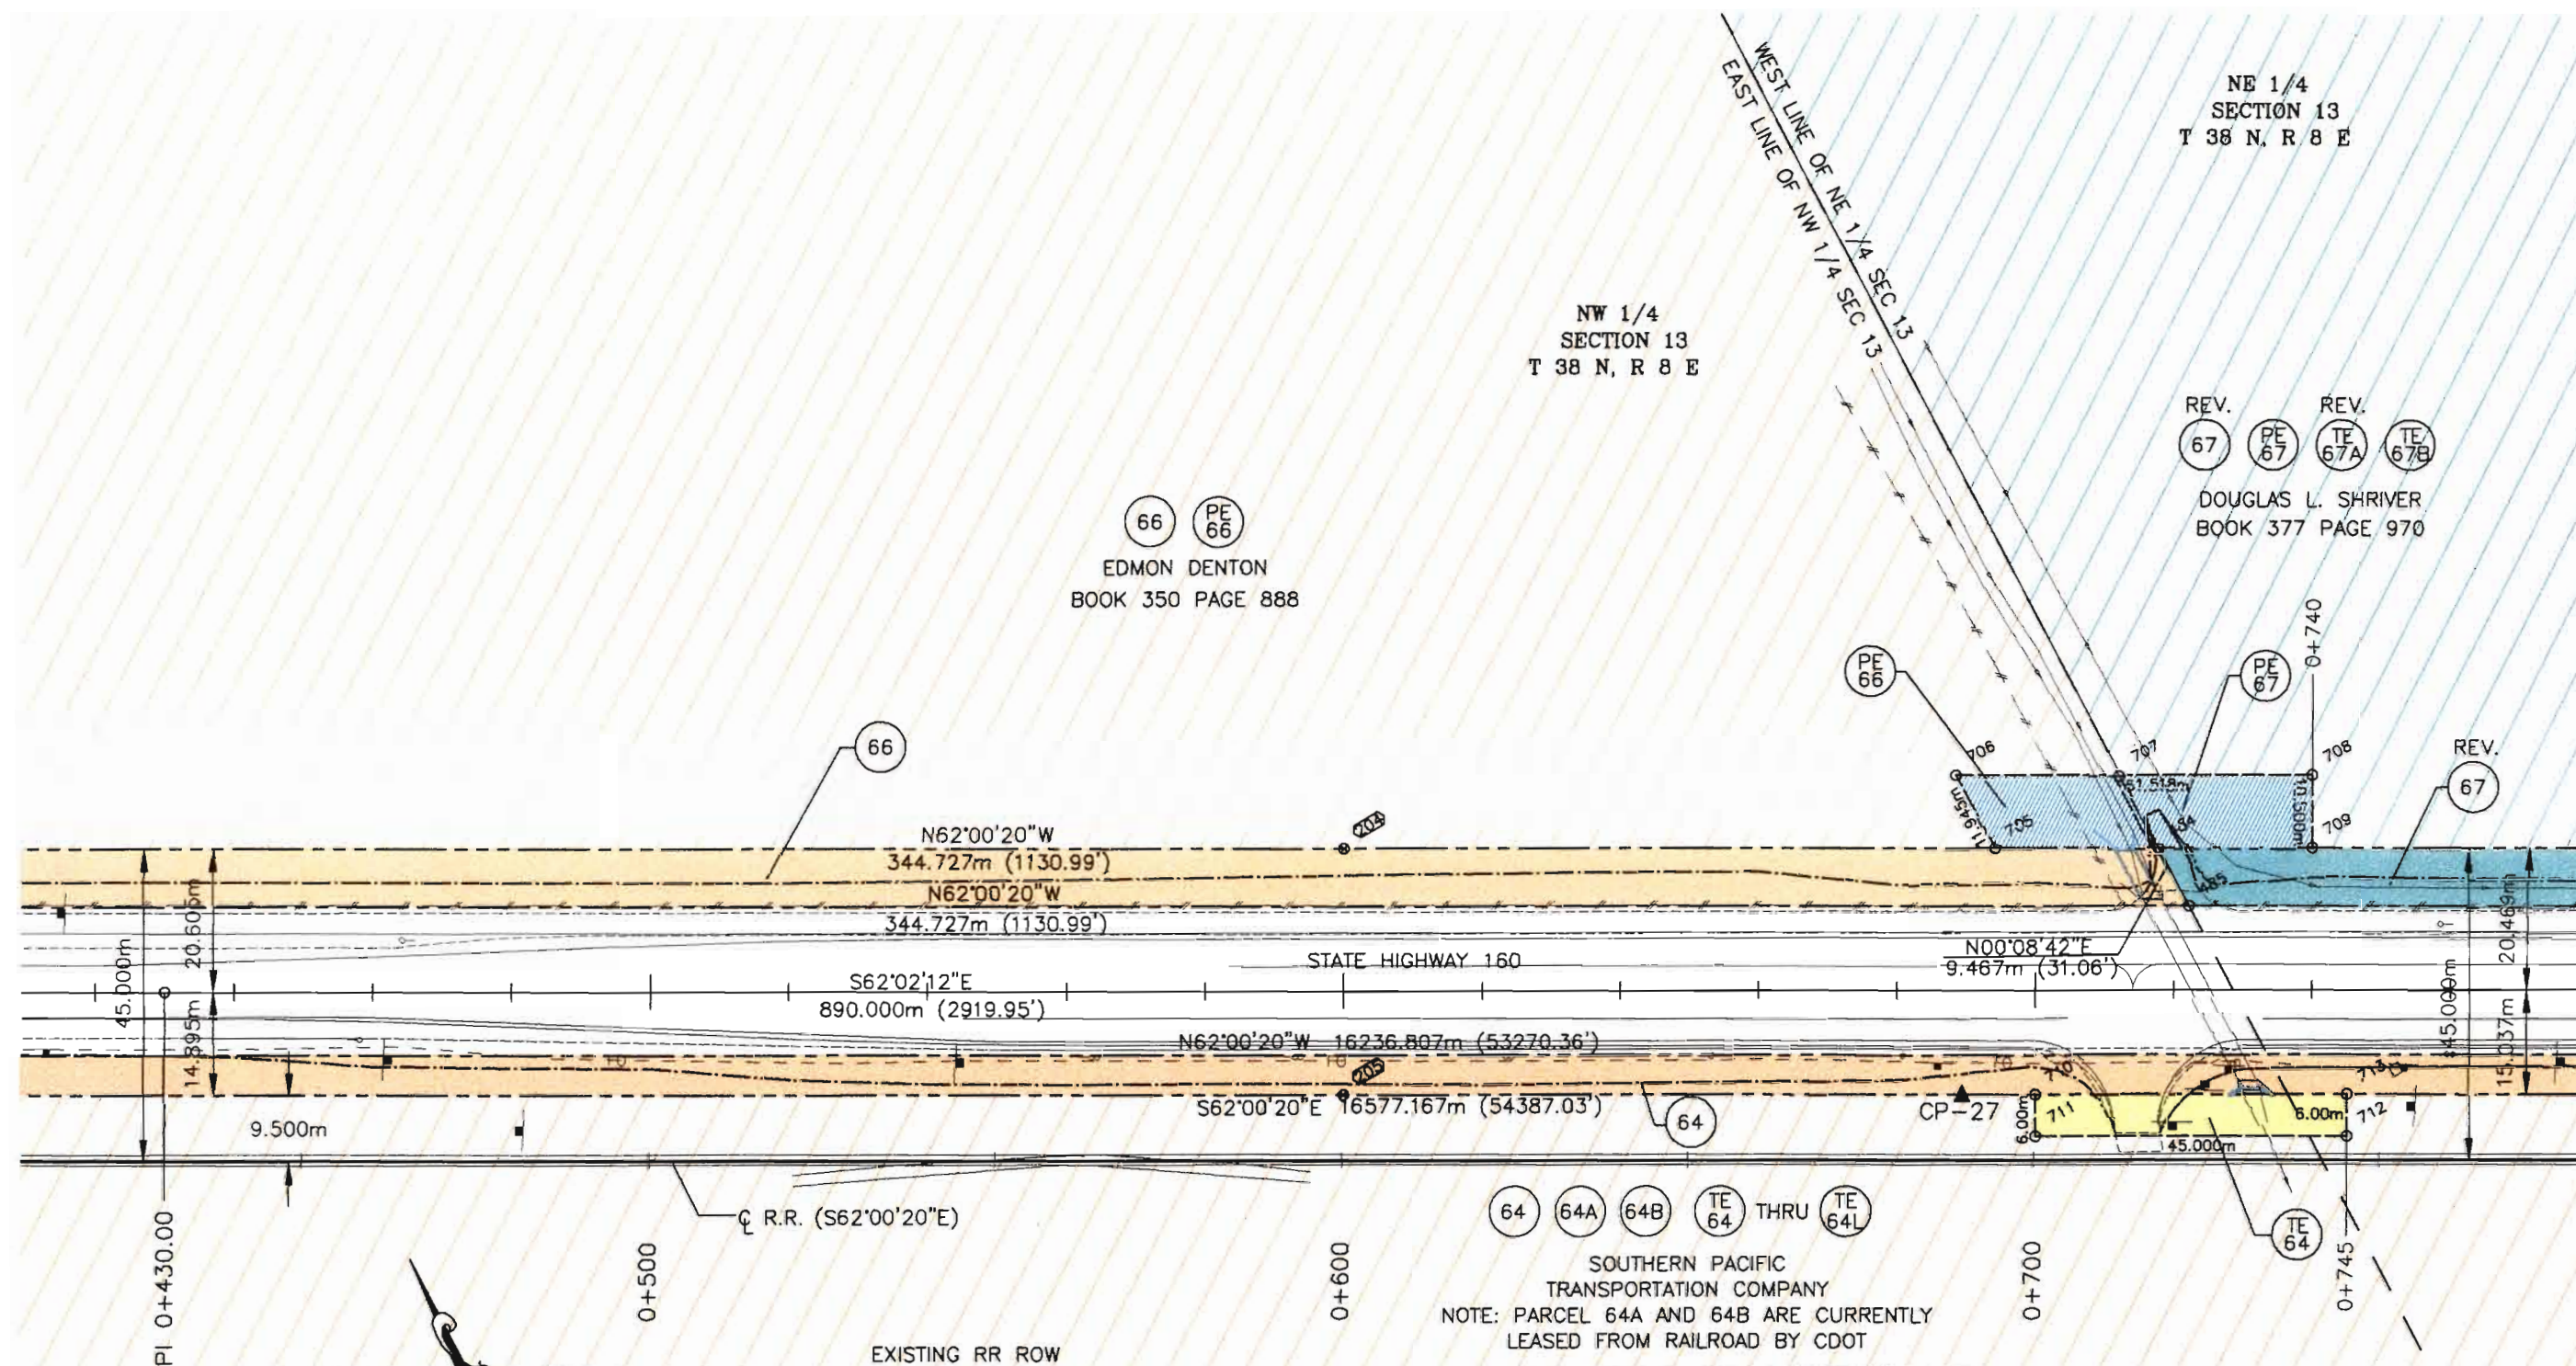

 64 64A 64B TE 64 THRU TE 64L
SOUTHERN PACIFIC
TRANSPORTATION COMPANY
NOTE: PARCEL 64A AND 64B ARE CURRENTLY
LEASED FROM RAILROAD BY CDOT

Computer File Information				Index of Revisions				Colorado Department of Transportation				As Constructed		RIGHT-OF-WAY PLAN SHEET				Project No./Code	
Creation Date: 07/22/97		Initials: JRY		☐ R1	12/1/97	PARCEL 67, TE-67	EDC	 3803 North Main Avenue, Suite 300 Durango, Colorado 81301 Phone: 970-385-1400 FAX: 970-385-1410 Region 5	No Revisions:		C. R. 6E TO CRAFT DR.				NH 1602-058				
Last Modification Date: 12/24/97		Initials: JRY		☒ R2A	3/30/98	PARCEL PE-66, PE-67, TE-67AREV	EDC		Revised:		Designer:				10578				
Full Path: BEAST F:\JOBS\CDOT\5657-003\PARCEL PLACEMENT				☐					Detailer: JRY										
Drawing File Name: Rowplan3.DWG				☐					Void:		Sheet Subset: R.O.W.		Subset Sheets: 3 OF 46		Sheet Number: 7				
Acad Ver. R14		Scale: 1:1000		Units: METRIC		☐													





Region 5



3803 North Main Avenue, Suite 300
Durango, Colorado 81301
Phone: 970-385-1400 FAX: 970-385-1410

NE 1/4
SECTION 13
T 38 N, R 6 E


REV. 67
REV. PE 67
REV. TE 67A
REV. TE 67B
DOUGLAS L. SHRIVER
BOOK 377 PAGE 970

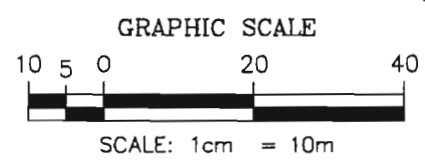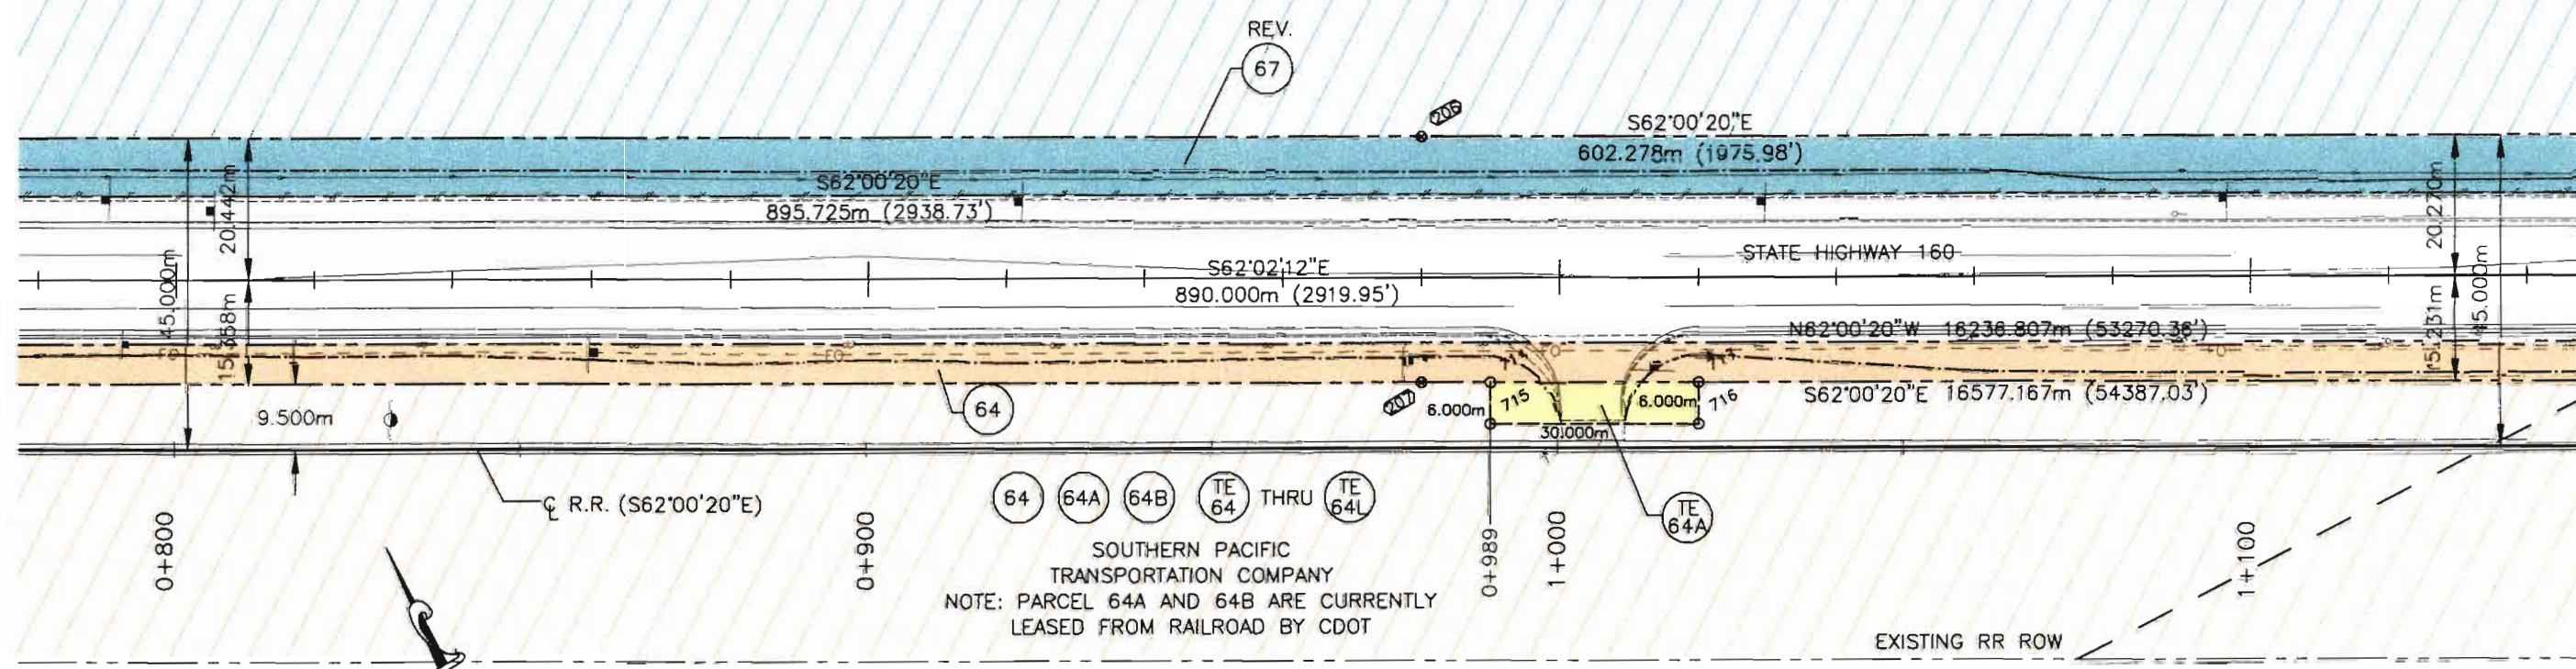


Computer File Information		Index of Revisions		Colorado Department of Transportation		As Constructed		RIGHT-OF-WAY PLAN SHEET		Project No./Code	
Creation Date: 07/22/97	Initials: JRY	(R1)	12/1/97	PARCEL 67, TE-67	EDC	No Revisions:		C. R. 6E TO CRAFT DR.		NH 1602-058	
Last Modification Date: 12/24/97	Initials: JRY	(R2A)	3/30/98	PARCEL PE-67,	EDC	Revised:		Designer:		10578	
Full Path: BEAST F:\JOBS\CDOT\5657-003\PARCEL PLACEMENT				TE-67A-REV		Void:		Detailer: JRY			
Drawing File Name: Rowplan3.DWG								Sheet Subset: R.O.W.		Subset Sheets: 4 OF 46	
Acad Ver. R14	Scale: 1:1000	Units: METRIC								Sheet Number: 8	

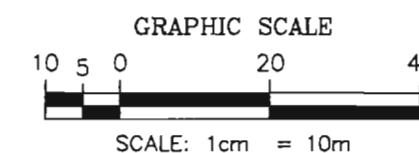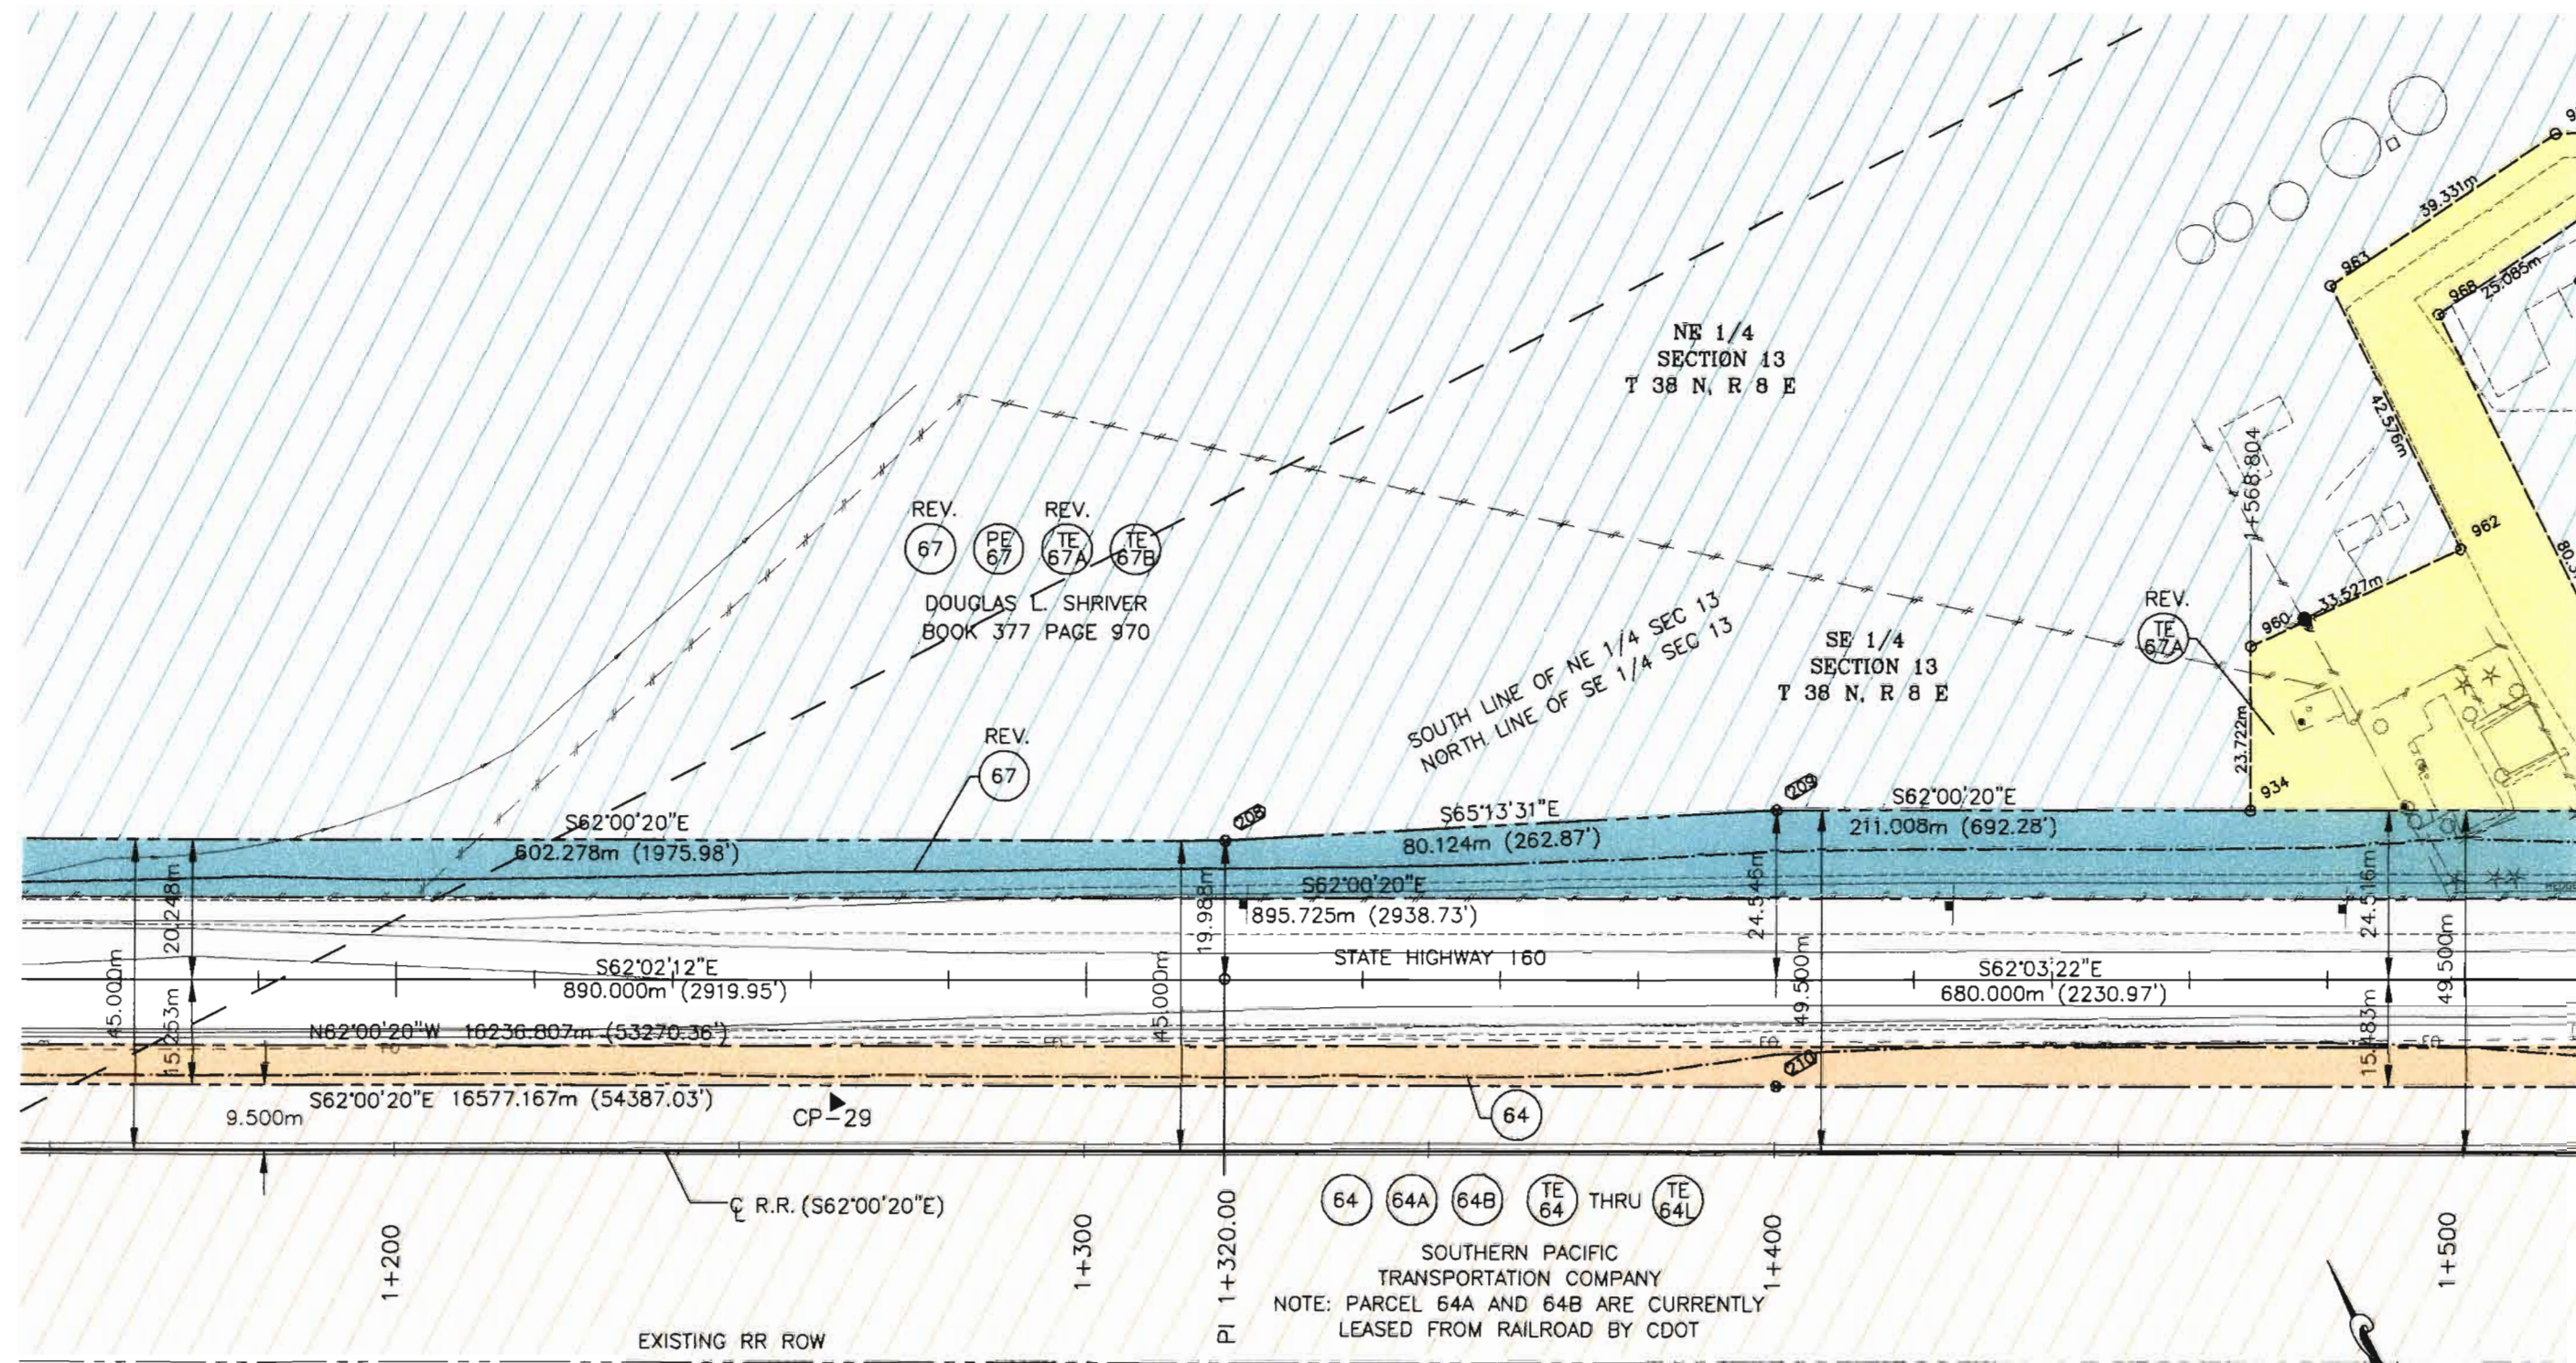


Computer File Information				Index of Revisions			Colorado Department of Transportation		As Constructed	RIGHT-OF-WAY PLAN SHEET		Project No./Code
Creation Date: 07/22/97		Initials: JRY		(R1)	12/1/97	PARCEL 67, TE-67			EDC			
Last Modification Date: 12/24/97		Initials: JRY		(R2A)	3/30/98	PARCEL PE-67,	EDC	 3803 North Main Avenue, Suite 300 Durango, Colorado 81301 Phone: 970-385-1400 FAX: 970-385-1410 Region 5	Revised:	Designer:		NH 1602-058
Full Path: BEAST F:\JOBS\CDOT\5657-003\PARCEL PLACEMENT						TE-67A REV.				Detailer: JRY		
Drawing File Name: Rowplan3.DWG												
Acad Ver. R14		Scale: 1:1000		Units: METRIC					Void:	Sheet Subset: R.O.W.	Subset Sheets: 5 OF 46	Sheet Number: 9

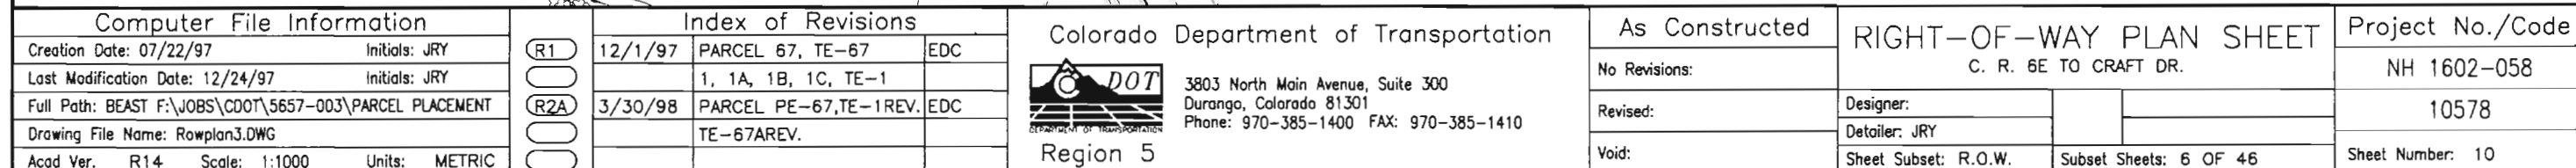


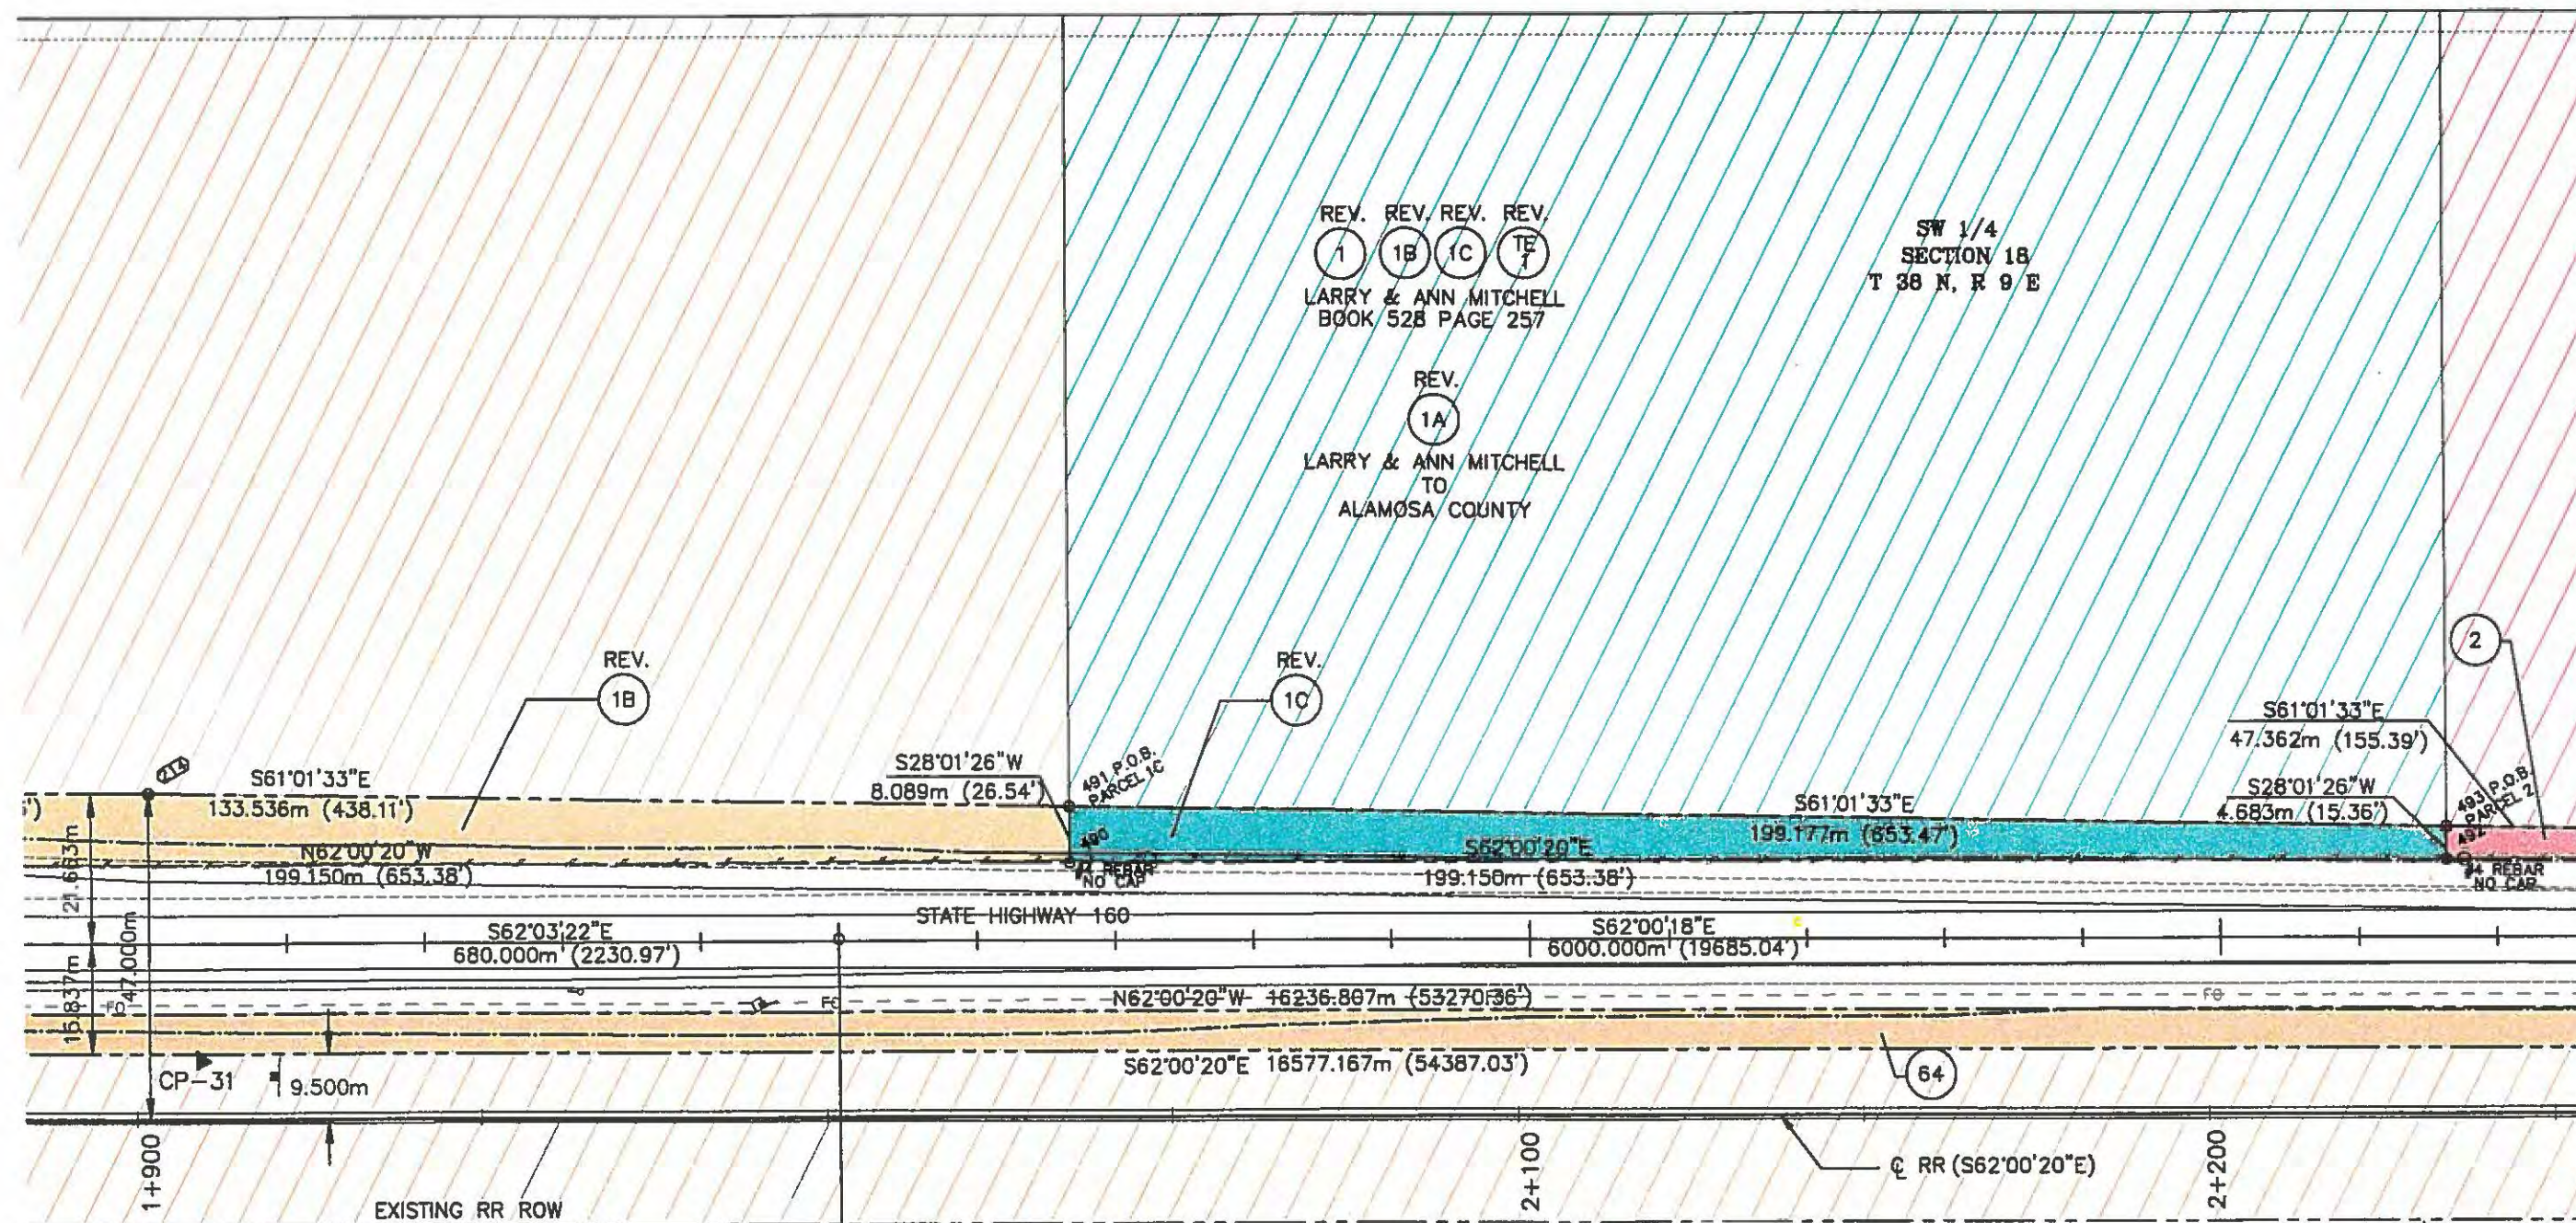


64 64A 64B TE 64 THRU TE 64L
SOUTHERN PACIFIC
TRANSPORTATION COMPANY
NOTE: PARCEL 64A AND 64B ARE CURRENTLY
LEASED FROM RAILROAD BY CDOT

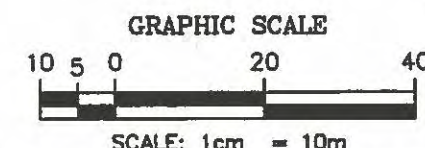


Computer File Information		Index of Revisions			Colorado Department of Transportation		As Constructed	RIGHT-OF-WAY PLAN SHEET		Project No./Code	
Creation Date: 07/22/97	Initials: JRY	(R1)	12/1/97	PARCEL 1A, 1B, 1C	EDC	 3803 North Main Avenue, Suite 300 Durango, Colorado 81301 Phone: 970-385-1400 FAX: 970-385-1410 Region 5	No Revisions:	C. R. 6E TO CRAFT DR.		NH 1602-058	
Last Modification Date: 12/24/97	Initials: JRY						Revised:	Designer:		10578	
Full Path: BEAST F:\JOBS\CDOT\5657-003\PARCEL PLACEMENT							Void:	Detailer: JRY		Sheet Number: 11	
Drawing File Name: Rowplan3.DWG								Sheet Subset: R.O.W.	Subset Sheets: 7 OF 46		
Acad Ver. R14	Scale: 1:1000	Units: METRIC									

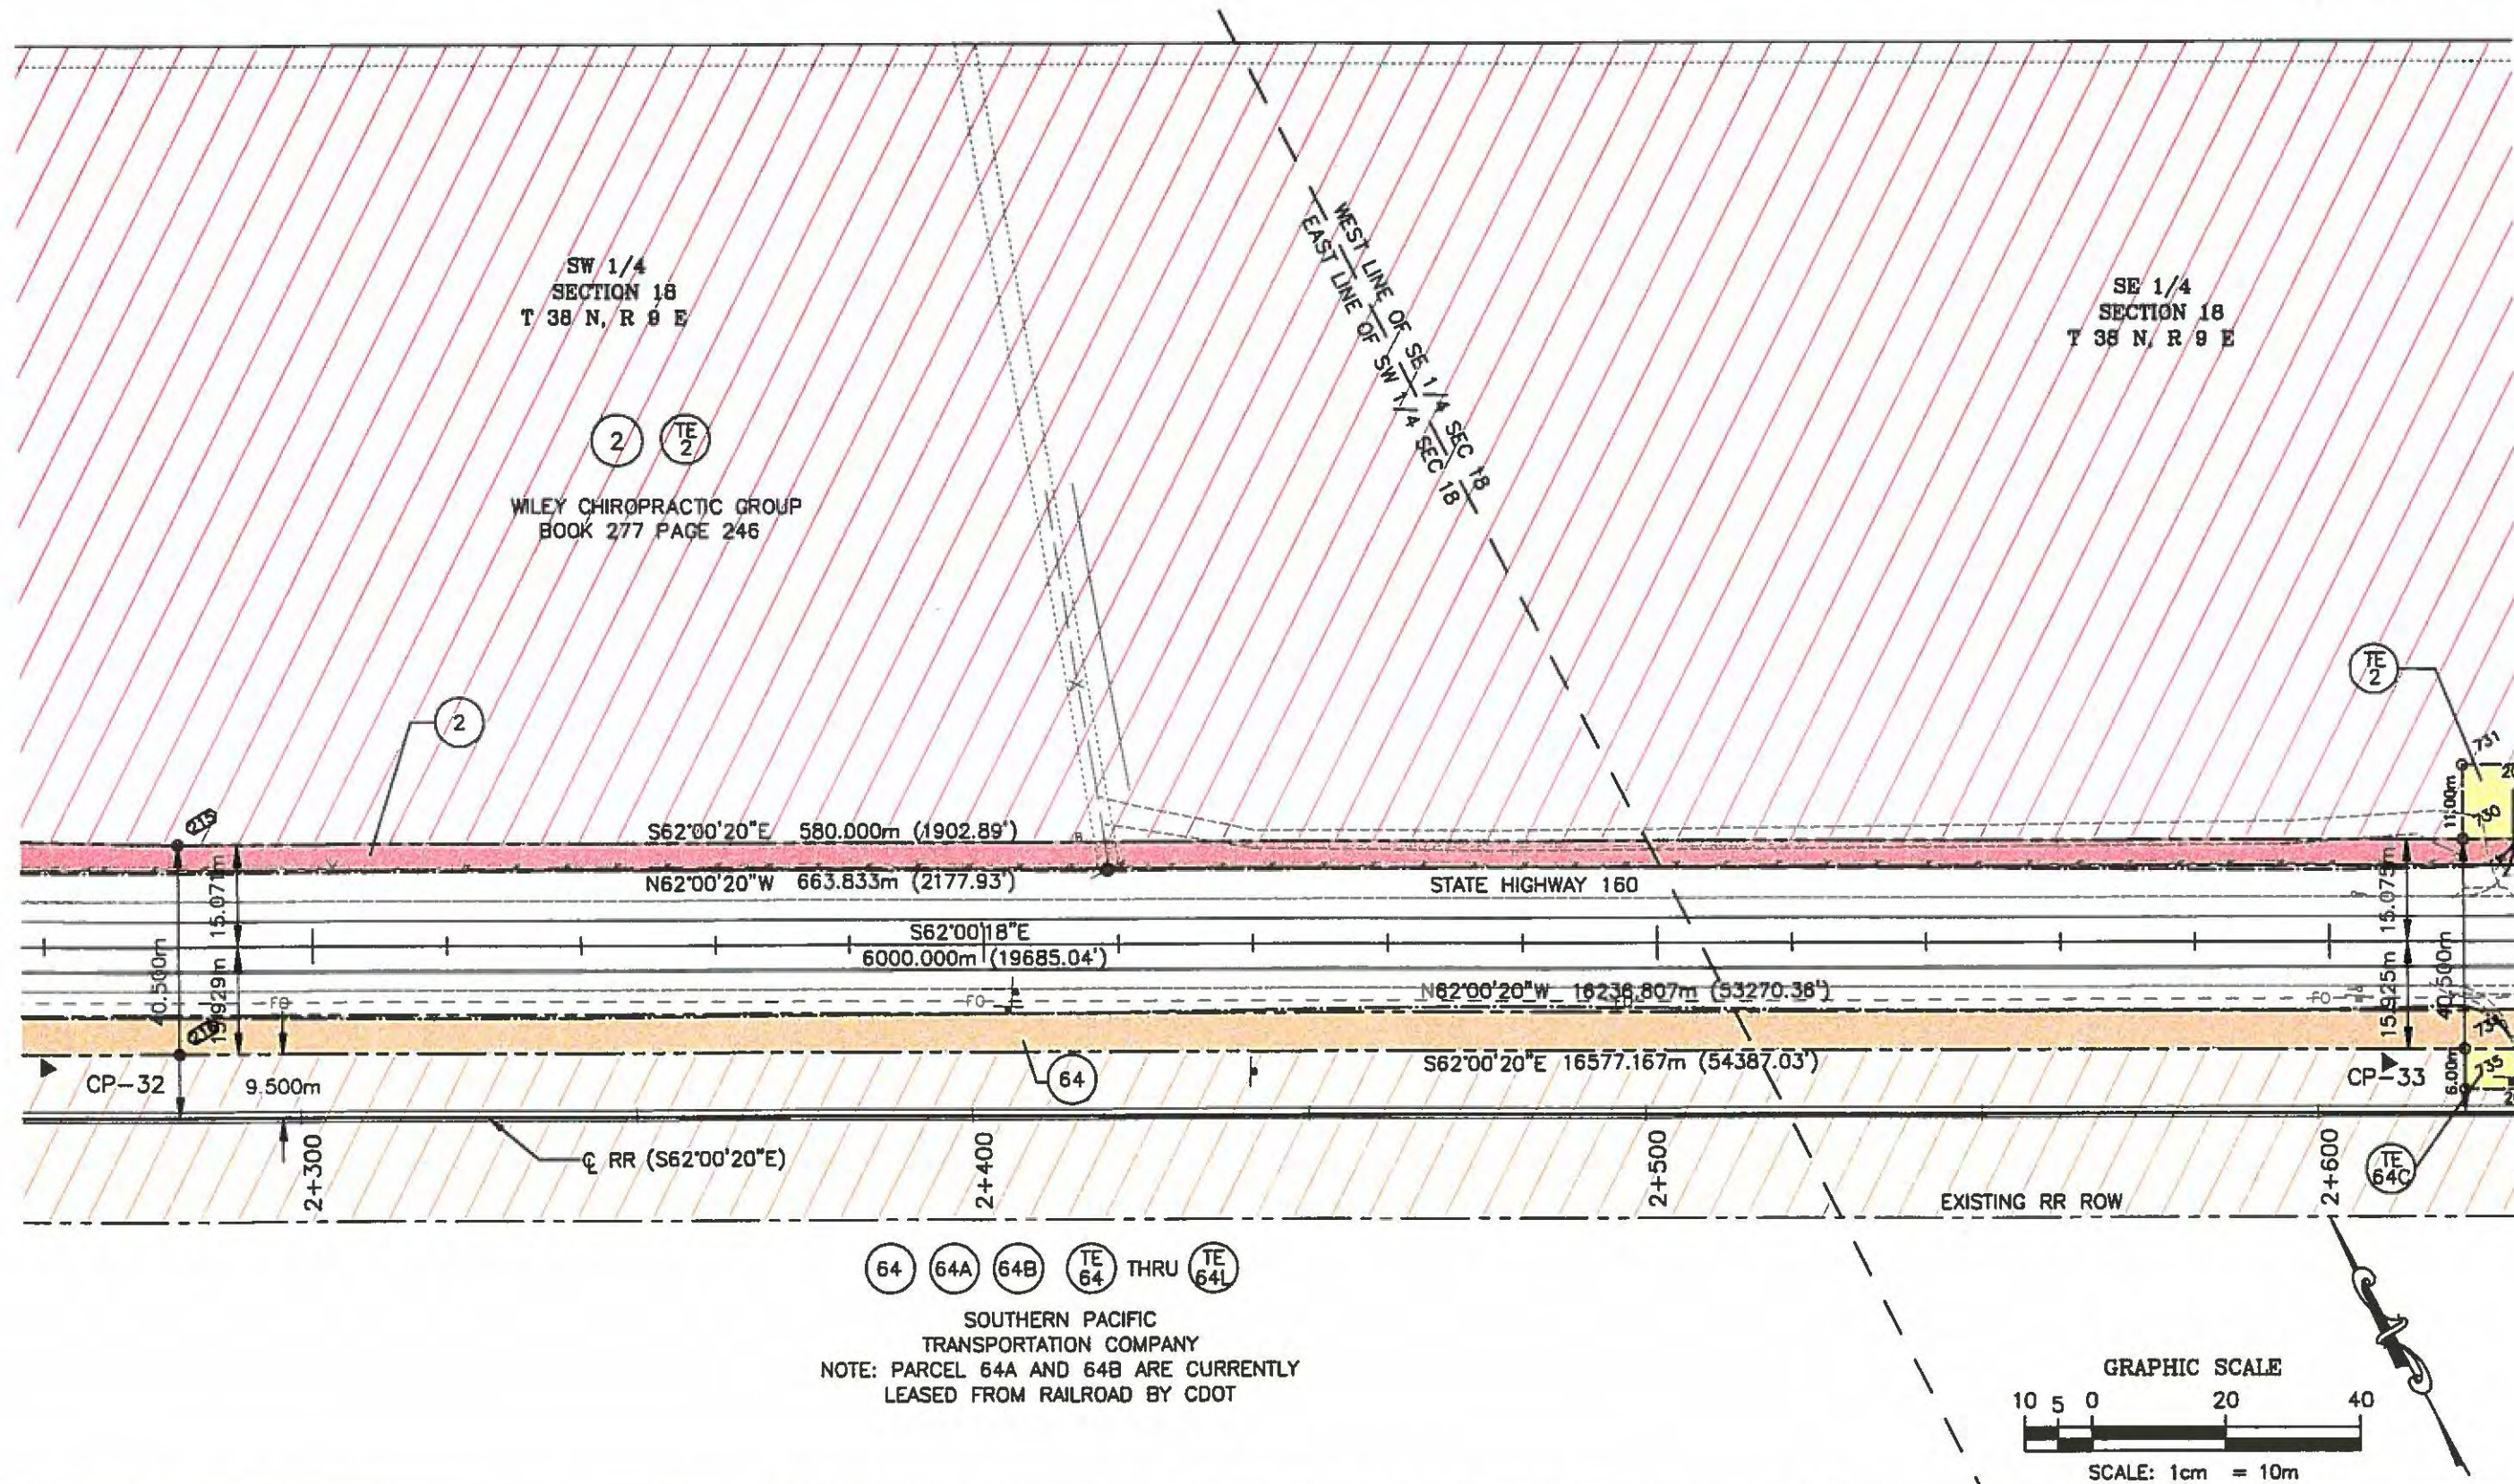


Computer File Information		Index of Revisions		Colorado Department of Transportation		As Constructed		RIGHT-OF-WAY PLAN SHEET		Project No./Code	
Creation Date: 07/22/97	Initials: JRY			 3803 North Main Avenue, Suite 300 Durango, Colorado 81301 Phone: 970-385-1400 FAX: 970-385-1410 Region 5	No Revisions:	C. R. 6E TO CRAFT DR.		Designer:		NH 1602-058	
Last Modification Date: 12/24/97	Initials: JRY					Revised:		Detailer: JRY		10578	
Full Path: BEAST F:\JOBS\CDOT\5657-003\PARCEL PLACEMENT						Void:		Sheet Subset: R.O.W.		Sheet Number: 12	
Drawing File Name: Rowplan3.DWG								Subset Sheets: 8 OF 46			
Acad Ver. R14	Scale: 1:1000	Units: METRIC									

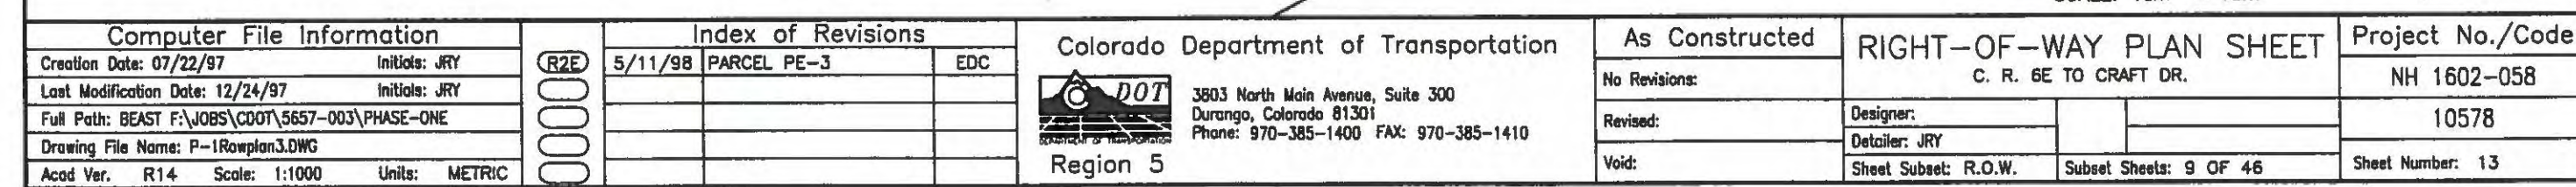


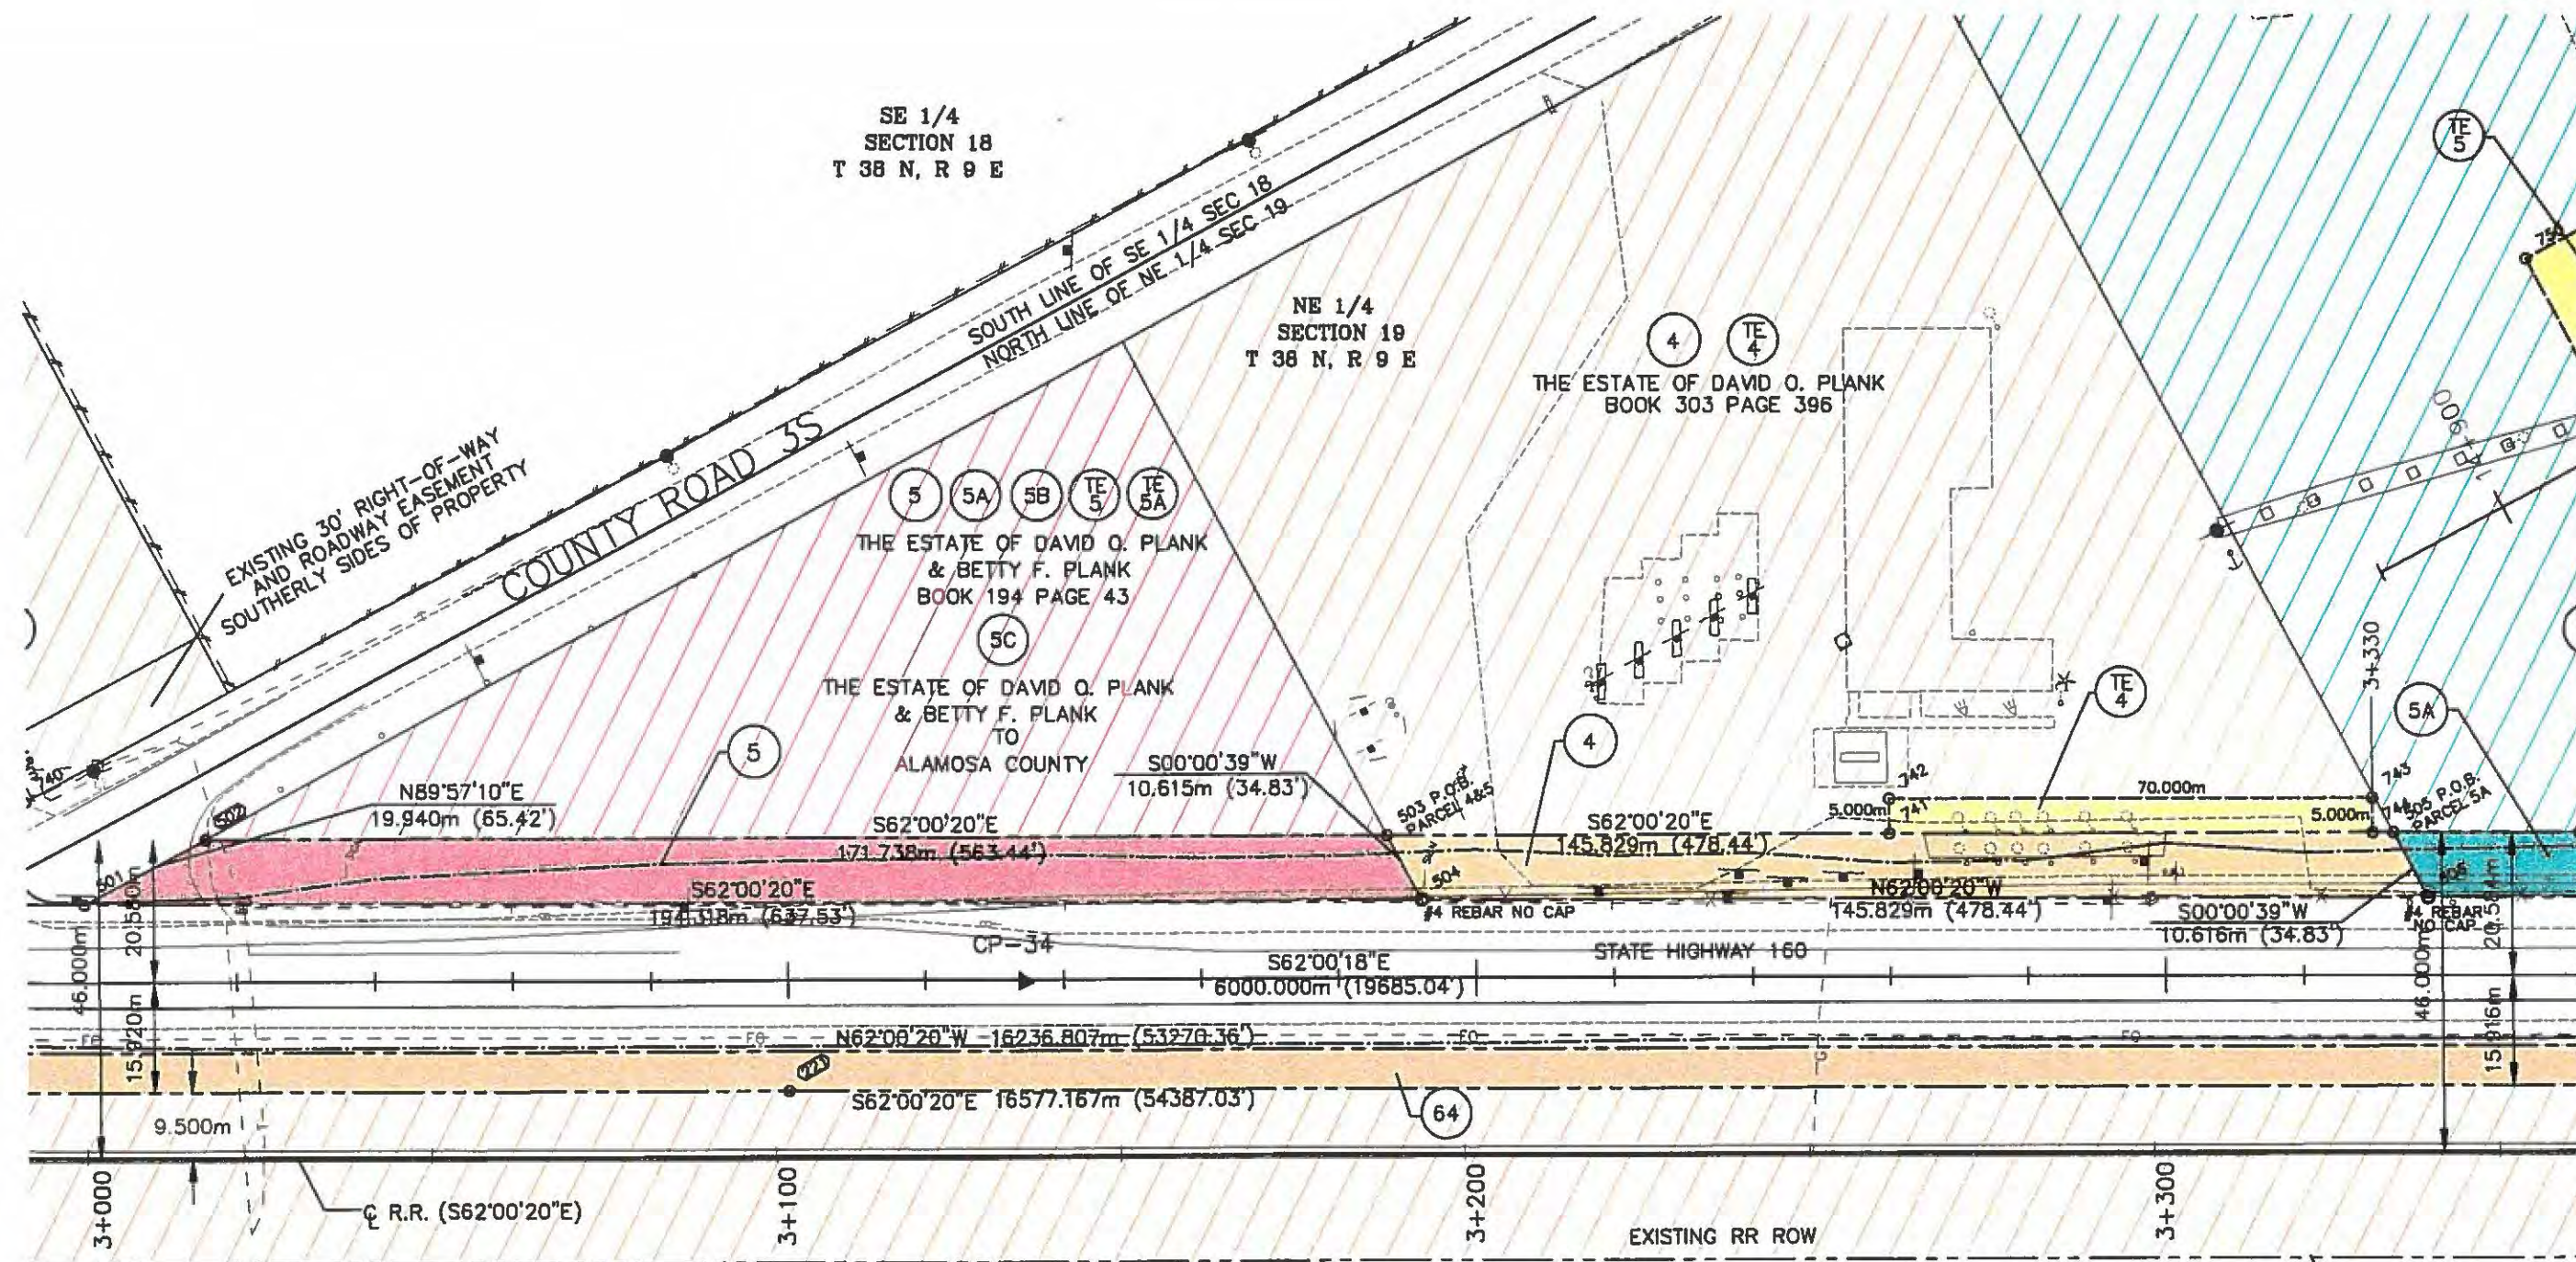


64 64A 64B TE 64 THRU TE 64L
SOUTHERN PACIFIC
TRANSPORTATION COMPANY
NOTE: PARCEL 64A AND 64B ARE CURRENTLY
LEASED FROM RAILROAD BY CDOT

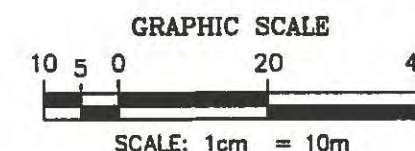


Computer File Information			Index of Revisions			Colorado Department of Transportation			As Constructed			RIGHT-OF-WAY PLAN SHEET			Project No./Code		
Creation Date: 07/22/97 Initials: JRY								 3803 North Main Avenue, Suite 300 Durango, Colorado 81301 Phone: 970-385-1400 FAX: 970-385-1410 Region 5	No Revisions:			C. R. 6E TO CRAFT DR.			NH 1602-058		
Last Modification Date: 12/24/97 Initials: JRY									Revised:			Designer:			10578		
Full Path: BEAST F:\JOBS\CDOT\5657-003\PHASE-ONE												Detailer: JRY					
Drawing File Name: P-1Rowplan3.DWG									Void:			Sheet Subset: R.O.W.			Subset Sheets: 10 OF 46		
Acad Ver. R14 Scale: 1:1000 Units: METRIC															Sheet Number: 14		

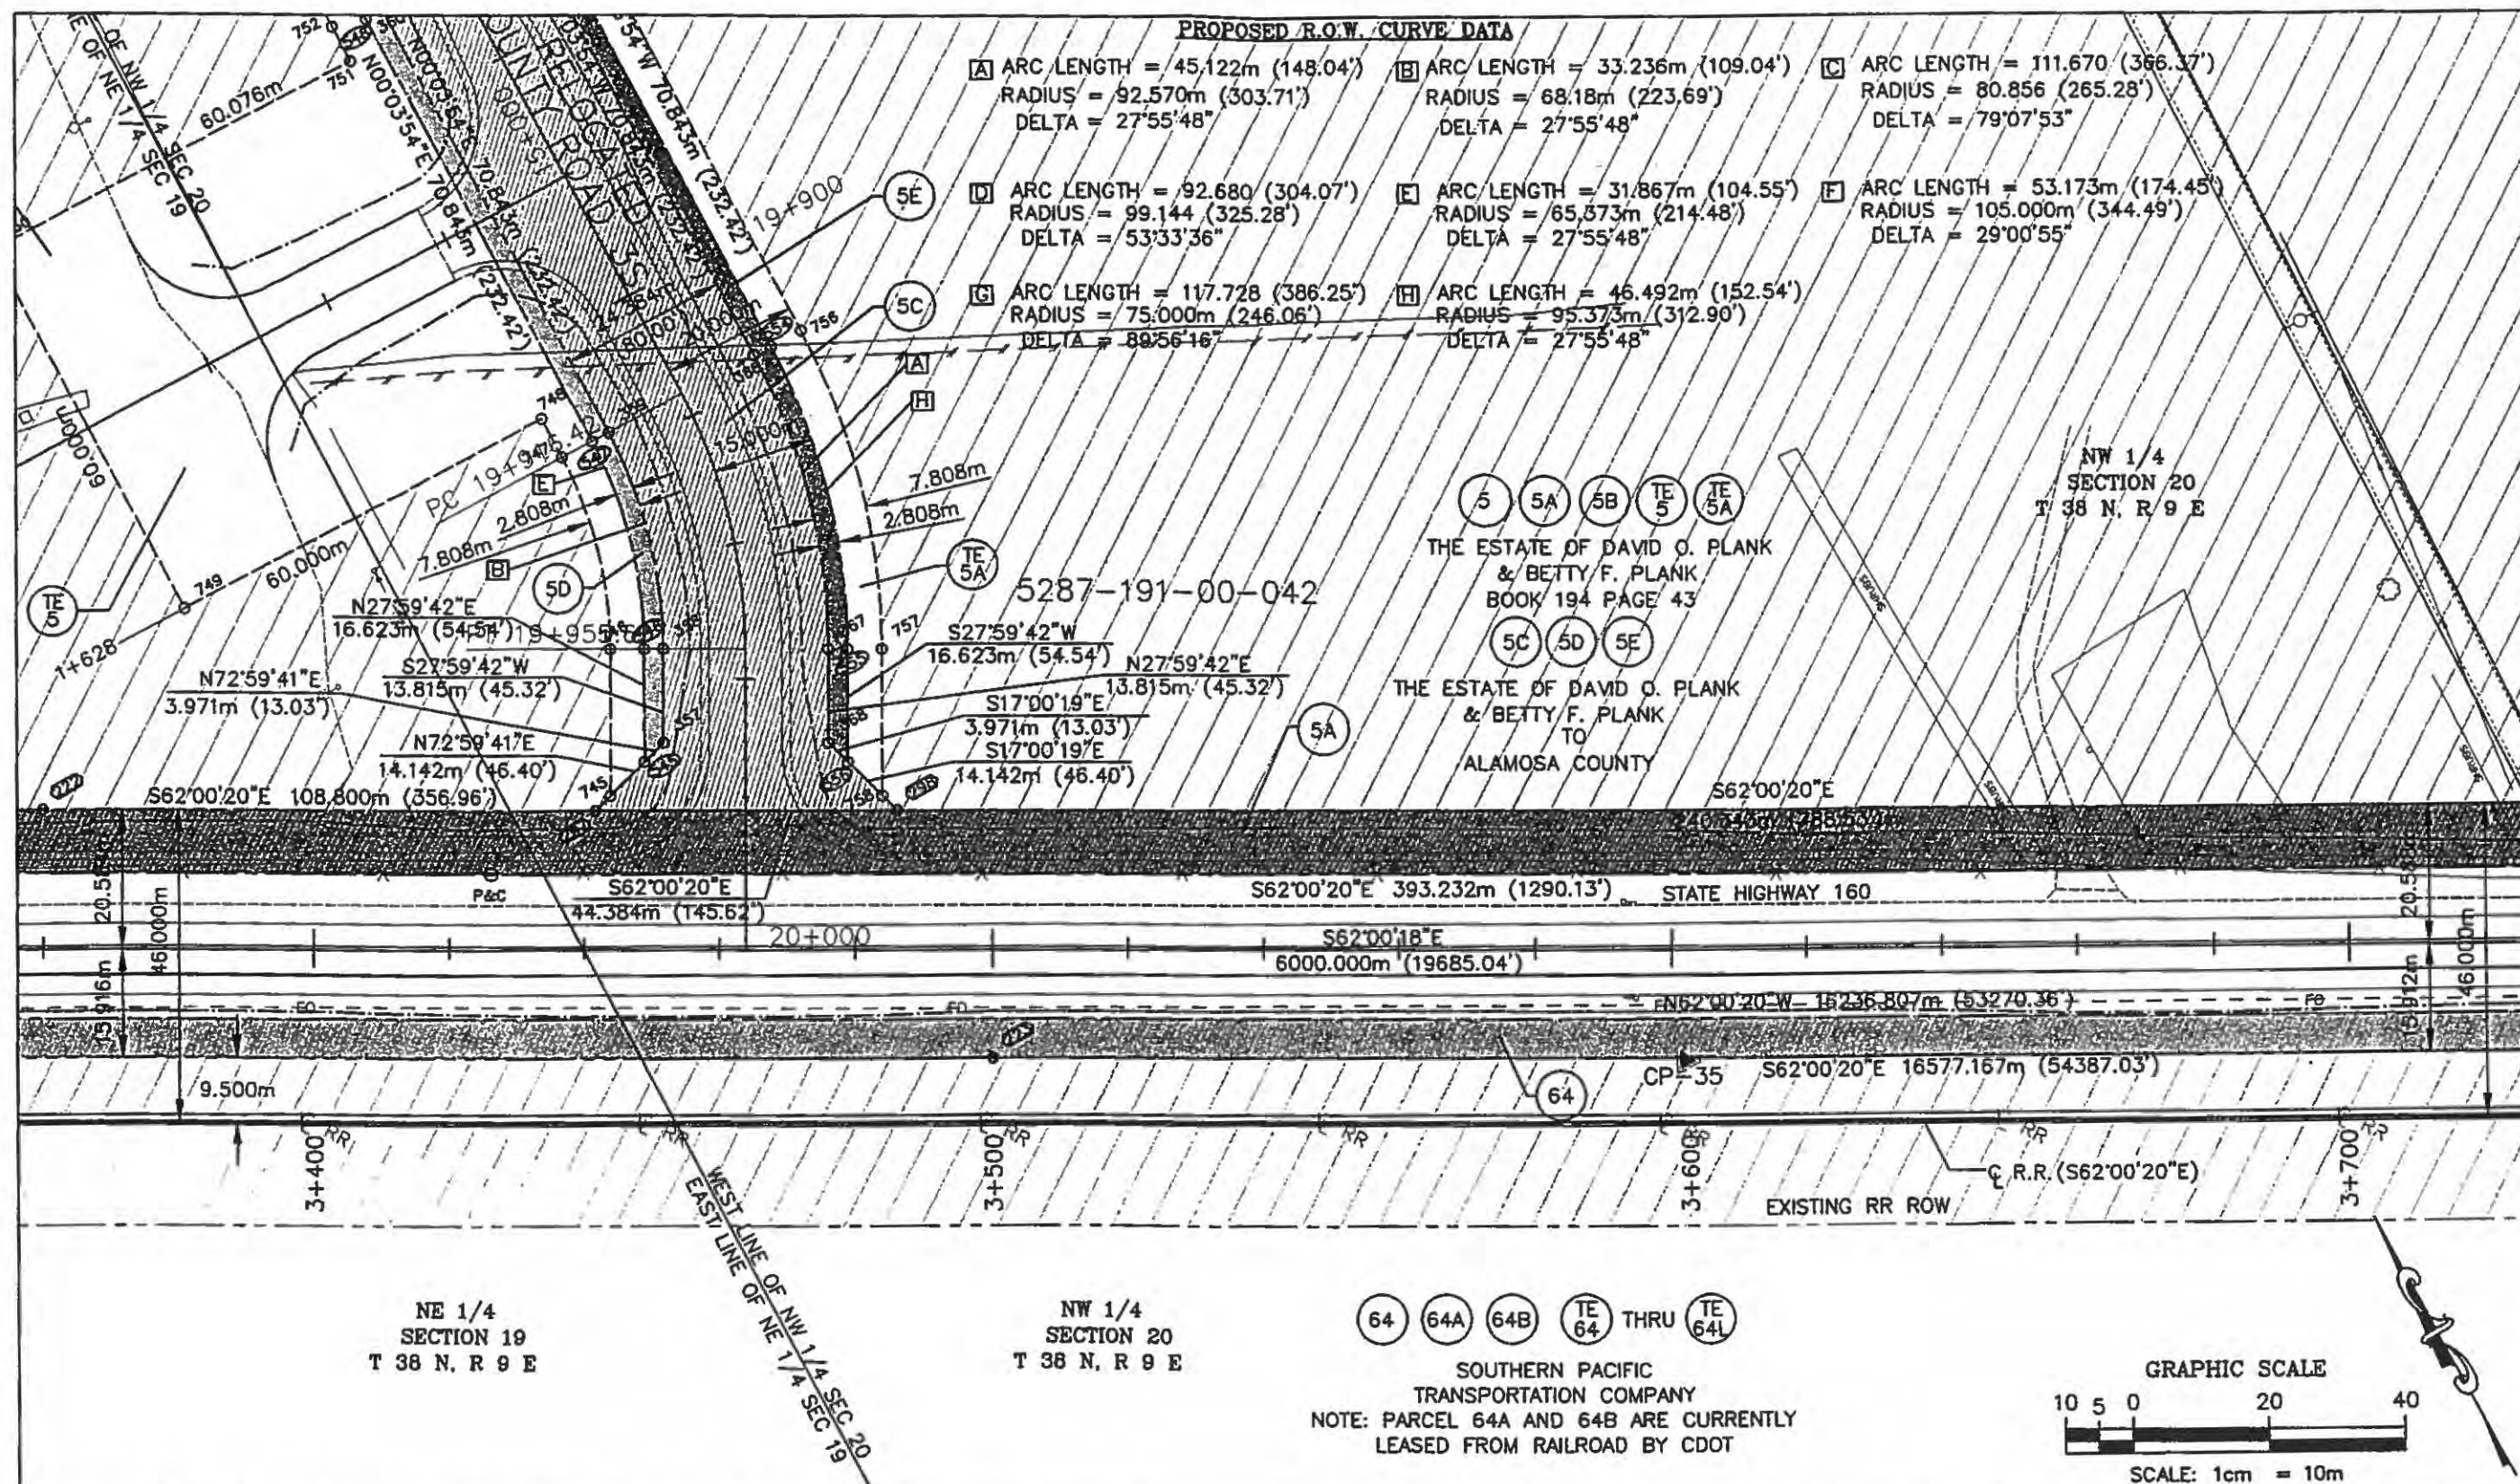


Computer File Information				Index of Revisions				Colorado Department of Transportation				As Constructed		RIGHT-OF-WAY PLAN SHEET				Project No./Code	
Creation Date: 07/22/97		Initials: JRY							 3803 North Main Avenue, Suite 300 Durango, Colorado 81301 Phone: 970-385-1400 FAX: 970-385-1410 Region 5	No Revisions:		C. R. 6E TO CRAFT DR.				NH 1602-058			
Last Modification Date: 03/01/2000		Initials: JHL									Revised:	Designer:				10578			
Full Path: BEAST F:\JOBS\CDOT\5657-003\PHASE-ONE												Detailer: JRY							
Drawing File Name: P-1Rowplan3.DWG												Sheet Subset: R.O.W.		Subset Sheets: 10 OF 46		Sheet Number: 15			
Acad Ver. R14		Scale: 1:1000		Units: METRIC							Void:								

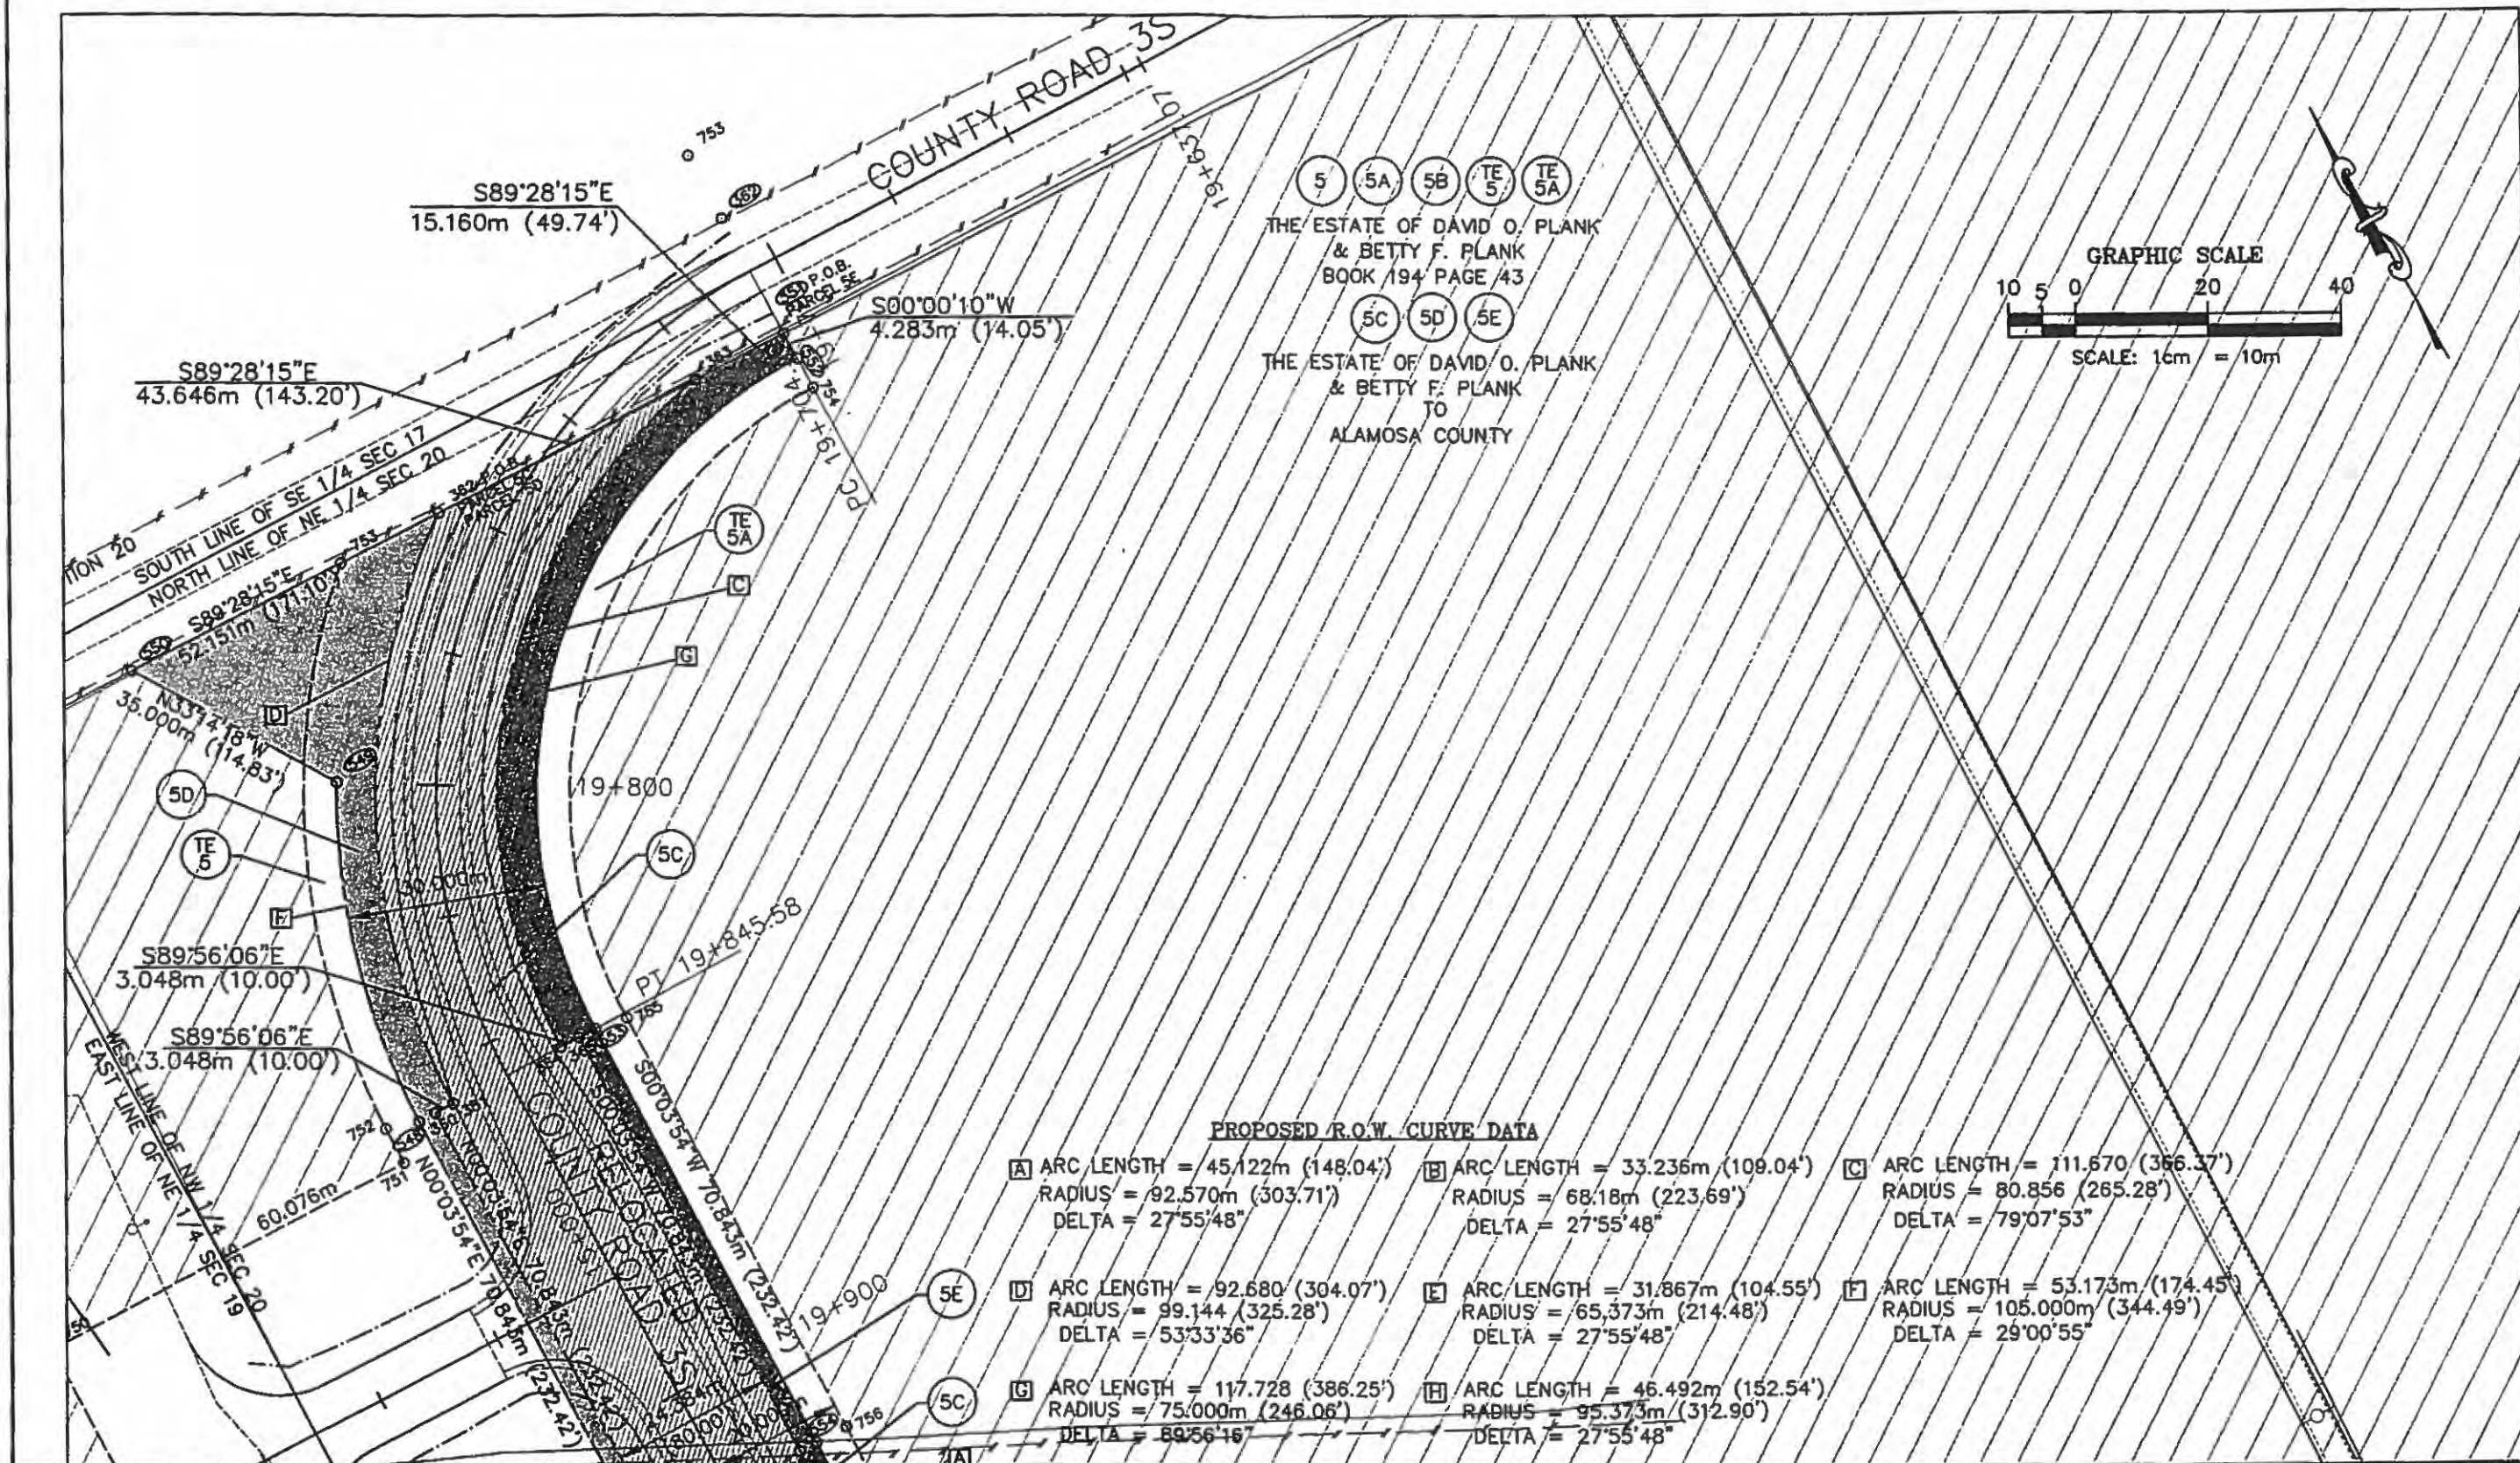


Computer File Information				Index of Revisions				Colorado Department of Transportation				As Constructed		RIGHT-OF-WAY PLAN SHEET				Project No./Code	
Creation Date: 07/22/97		Initials: JRY						 3803 North Main Avenue, Suite 300 Durango, Colorado 81301 Phone: 970-385-1400 FAX: 970-385-1410 Region 5	No Revisions:				C. R. 6E TO CRAFT DR.				NH 1602-058		
Last Modification Date: 03/01/2000		Initials: JHL										Revised:		Designer:		10578			
Full Path: BEAST F:\JOBS\CDOT\5657-003\PHASE-ONE												Detailer: JRY							
Drawing File Name: P-1Rowplan3a.DWG												Void:		Sheet Subset: R.O.W.		Subset Sheets: 10 OF 46		Sheet Number: 15A	
Acad Ver. R14		Scale: 1:1000																	
Units: METRIC																			

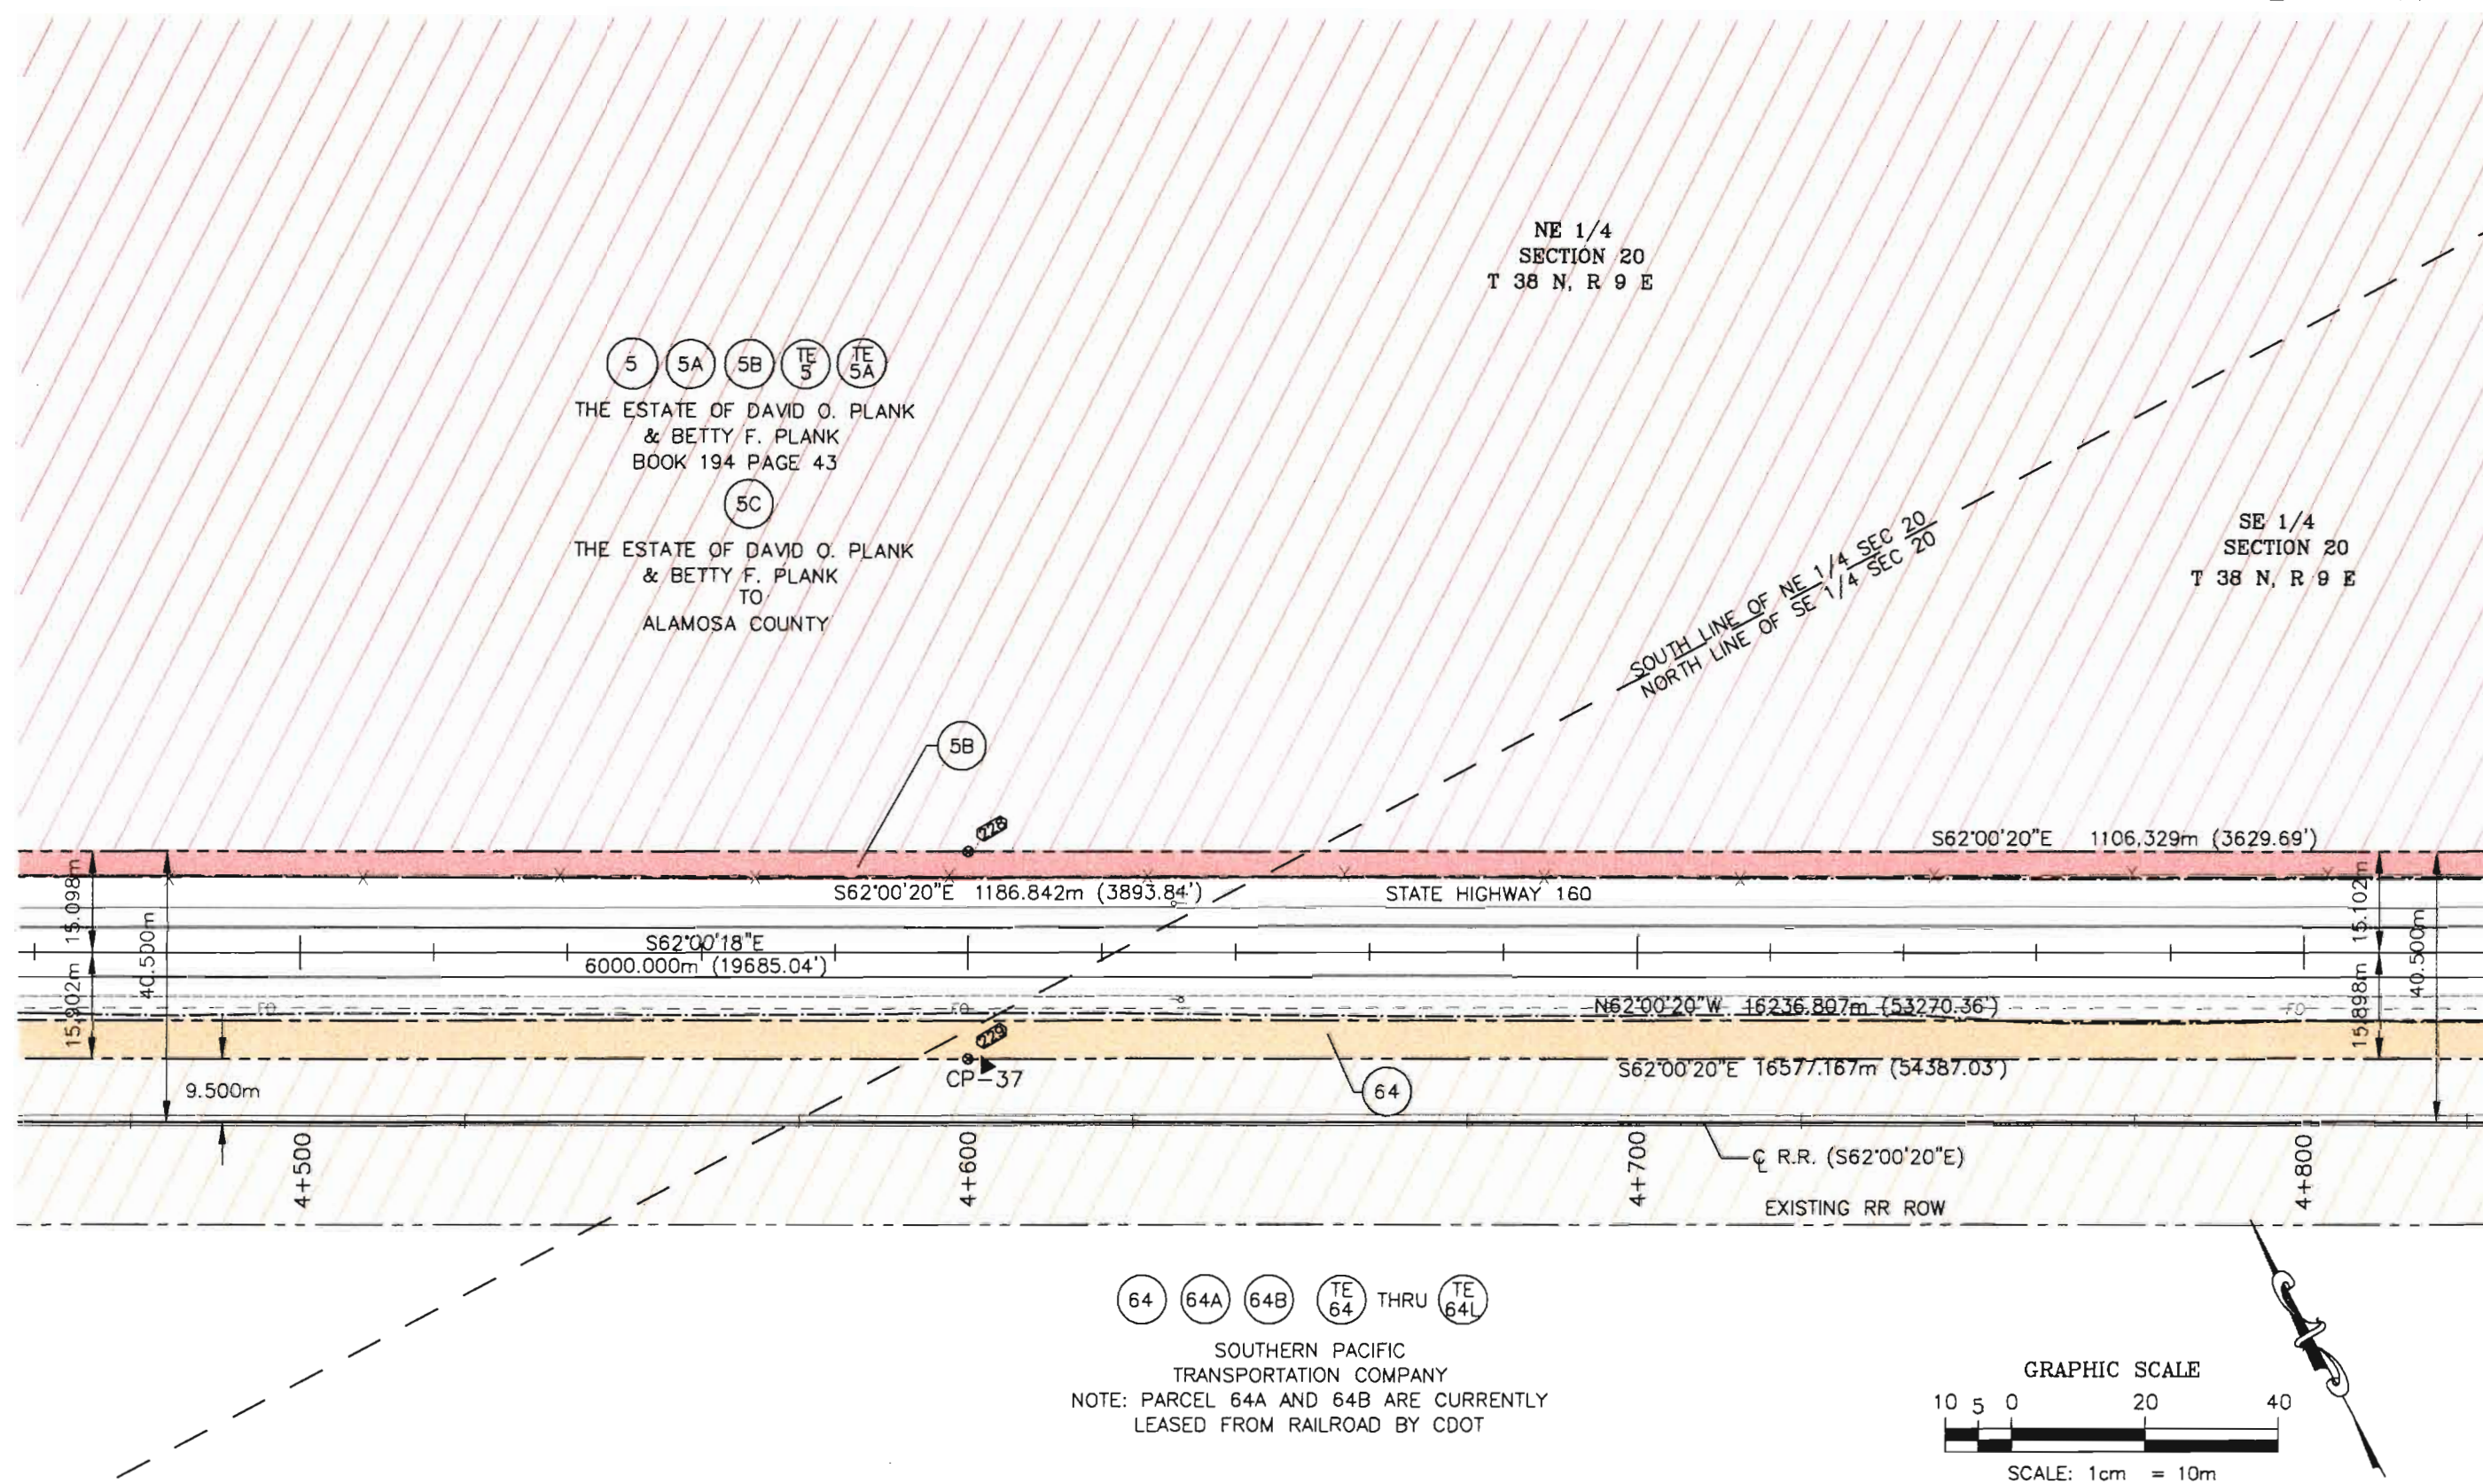


Computer File Information				Index of Revisions				Colorado Department of Transportation				As Constructed		RIGHT-OF-WAY PLAN SHEET				Project No./Cod	
Creation Date: 07/22/97		Initials: JRY						 3803 North Main Avenue, Suite 300 Durango, Colorado 81301 Phone: 970-385-1400 FAX: 970-385-1410 Region 5	No Revisions:		C. R. 6E TO CRAFT DR.				NH 1602-058				
Last Modification Date: 12/24/97		Initials: JRY								Revised:		Designer:			10578				
Full Path: BEAST F:\JOBS\CDOT\5657-003\PHASE-ONE										Void:		Detailer: JRY							
Drawing File Name: P-1Rowplan3.DWG												Sheet Subset: R.O.W.		Subset Sheets: 14 OF 46		Sheet Number: 18			
Acad Ver. R14		Scale: 1:1000																	
		Units: METRIC																	

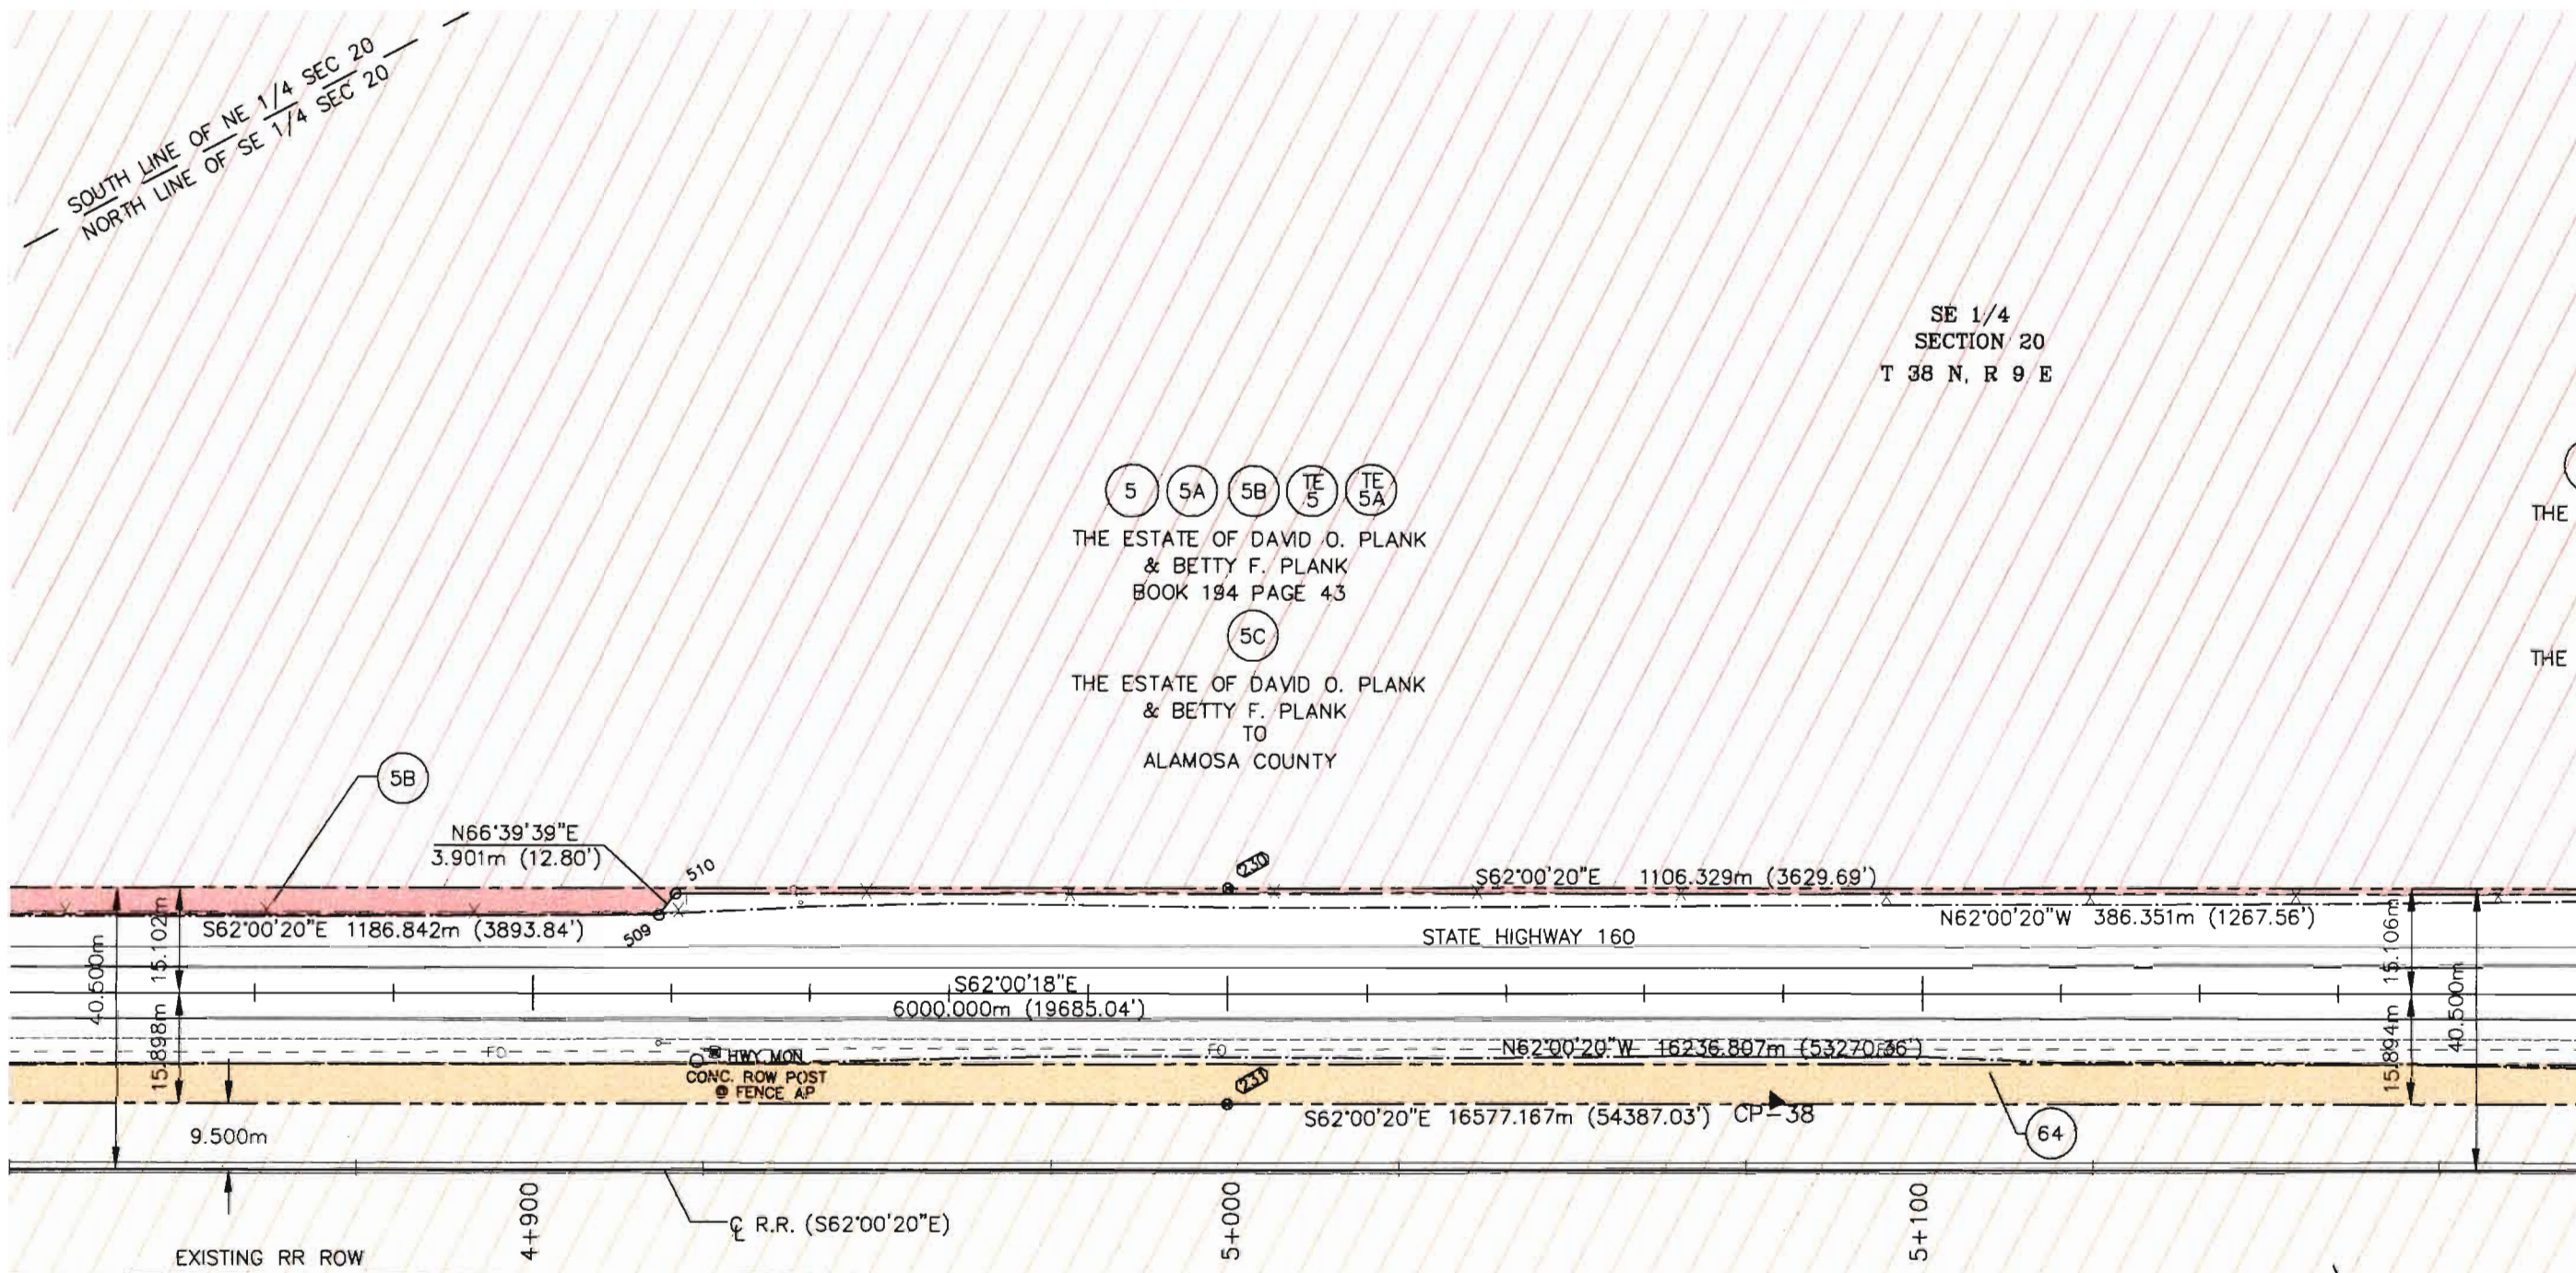

64 64A 64B TE 64 THRU TE 64L
SOUTHERN PACIFIC
TRANSPORTATION COMPANY
NOTE: PARCEL 64A AND 64B ARE CURRENTLY
LEASED FROM RAILROAD BY CDOT

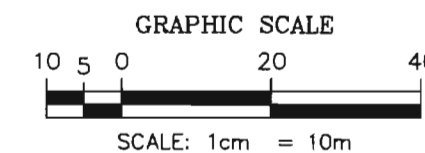


Computer File Information				Index of Revisions				Colorado Department of Transportation				As Constructed		RIGHT-OF-WAY PLAN SHEET				Project No./Code	
Creation Date: 07/22/97		Initials: JRY		☐				 3803 North Main Avenue, Suite 300 Durango, Colorado 81301 Phone: 970-385-1400 FAX: 970-385-1410 Region 5	No Revisions:		C. R. 6E TO CRAFT DR.				NH 1602-058				
Last Modification Date: 12/24/97		Initials: JRY		☐					Revised:		Designer:				10578				
Full Path: BEAST F:\JOBS\CDOT\5657-003\PHASE-ONE				☐					Void:		Detailer: JRY				Sheet Number: 19				
Drawing File Name: P-1Rowplan3.DWG				☐							Sheet Subset: R.O.W.		Subset Sheets: 15 OF 46						
Acad Ver. R14		Scale: 1:1000		Units: METRIC		☐													

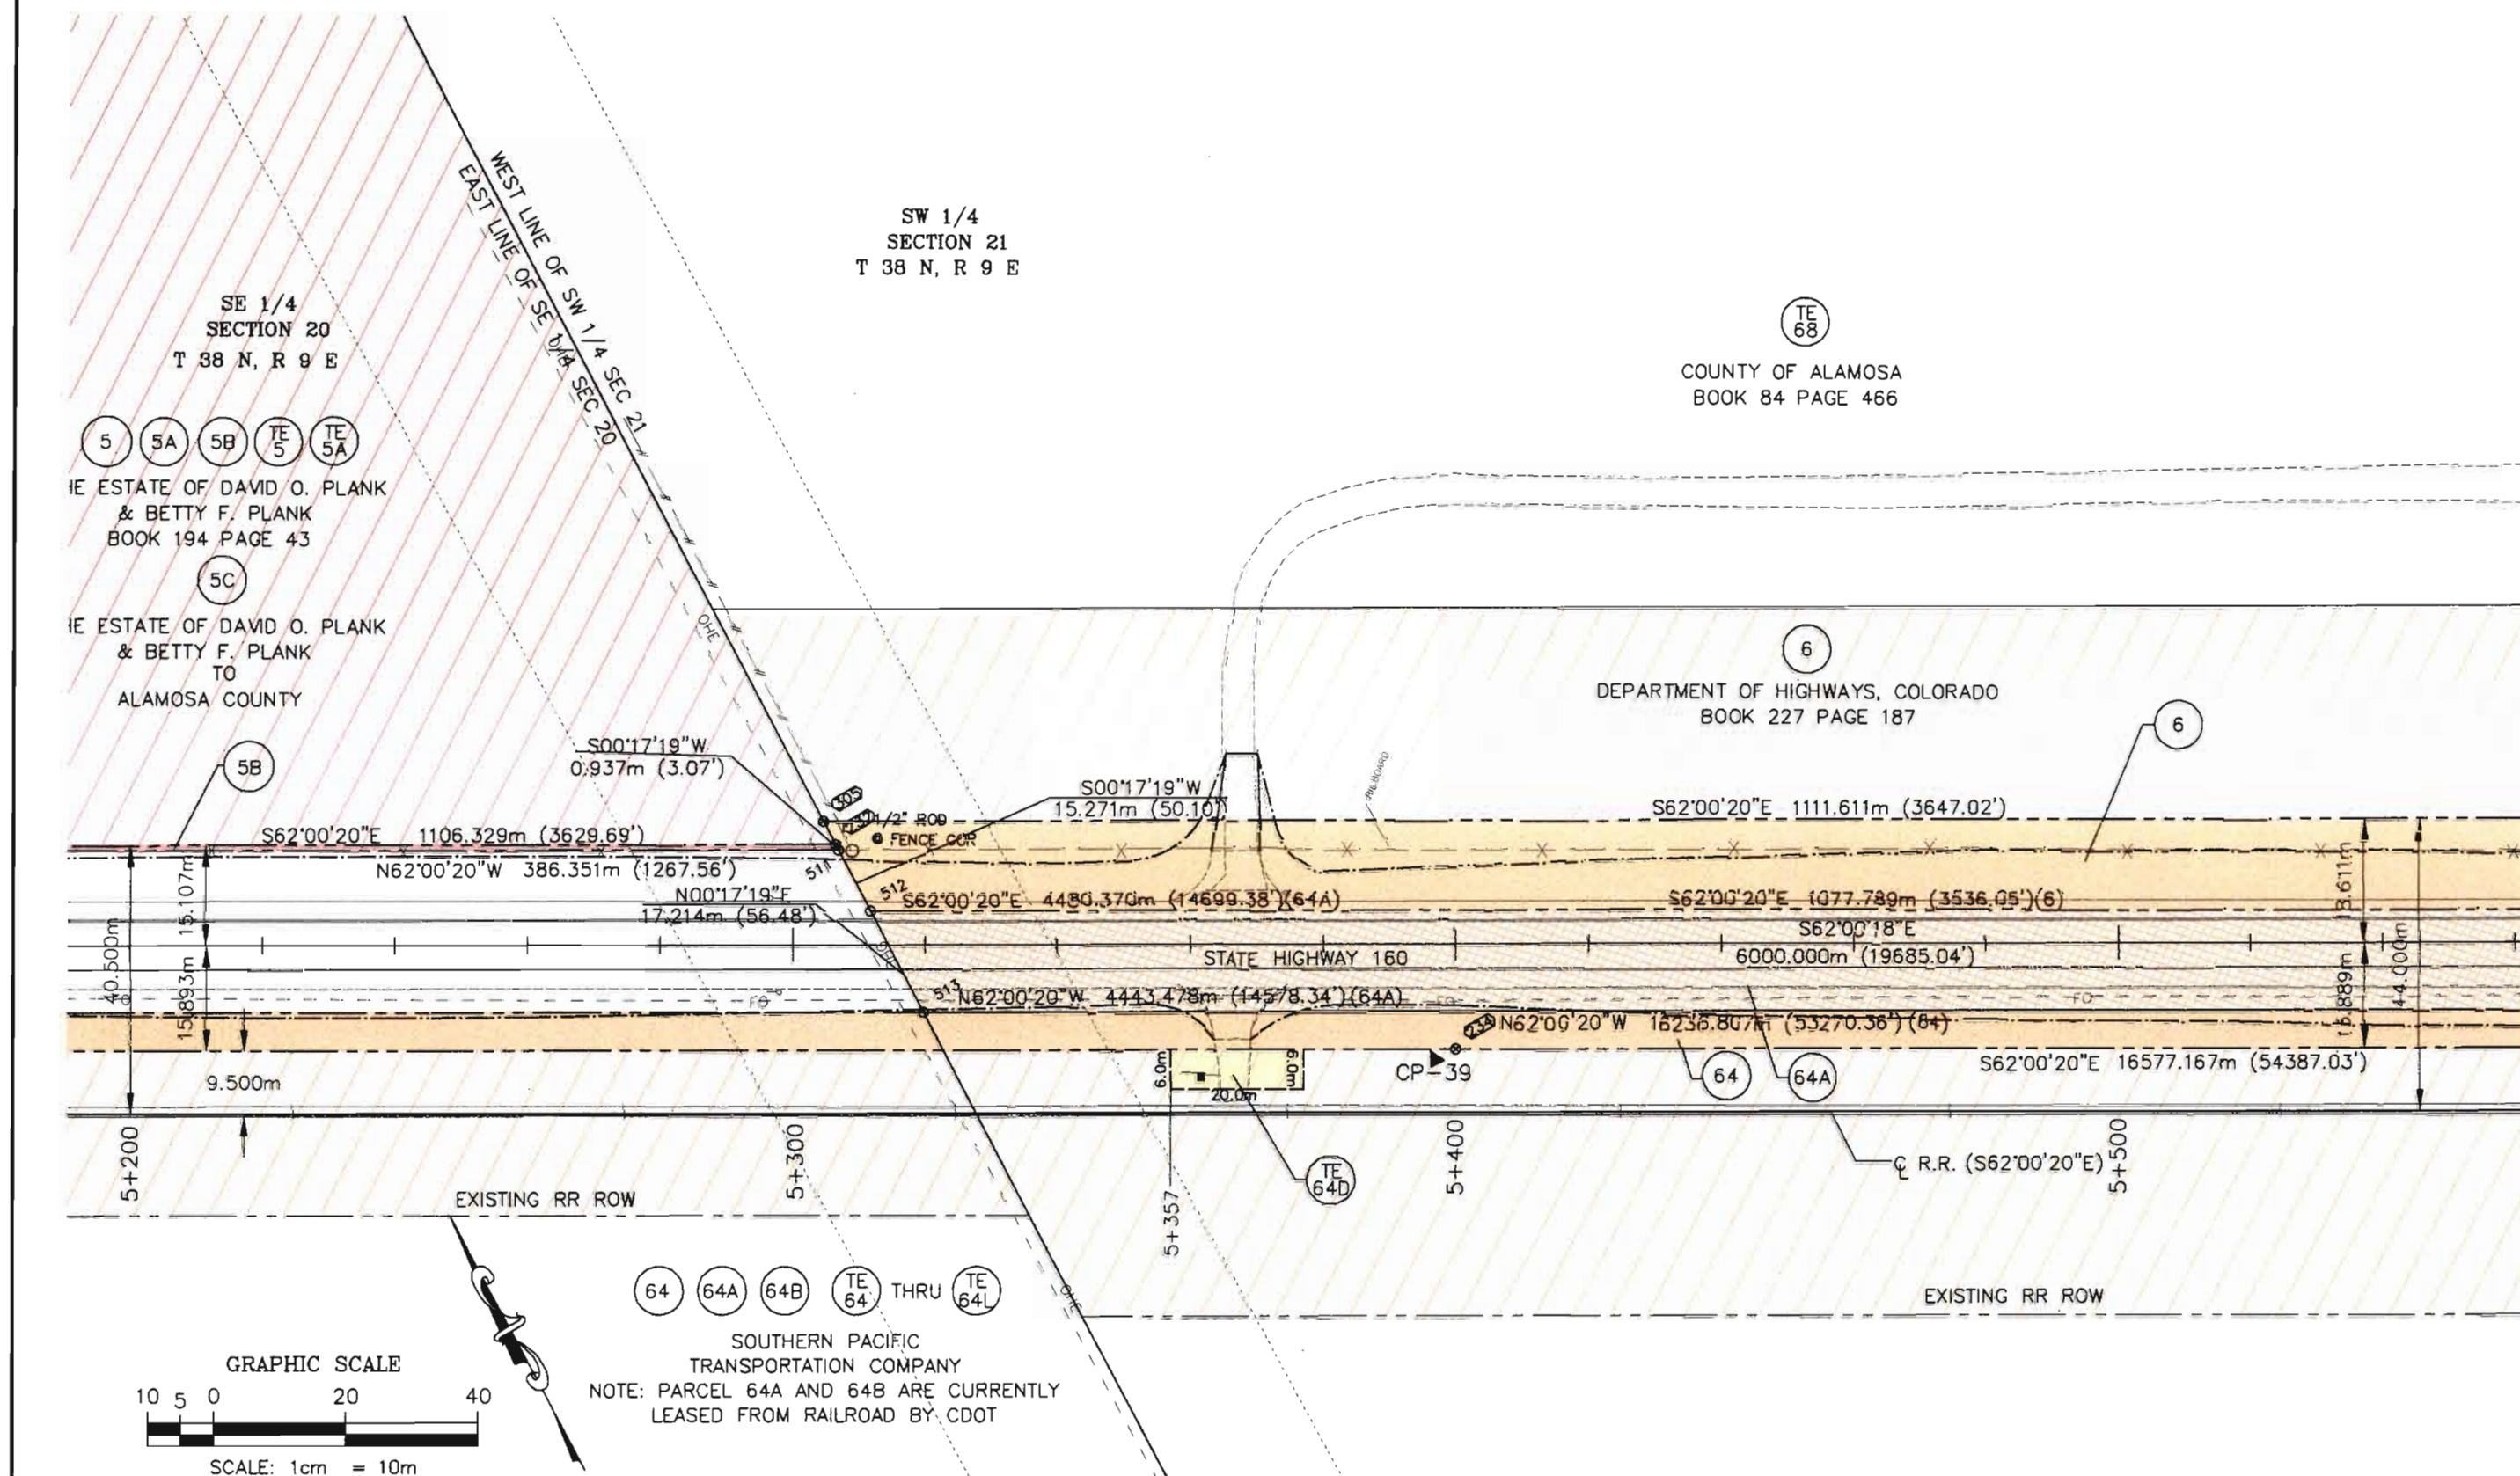


Computer File Information			Index of Revisions		As Constructed		RIGHT-OF-WAY PLAN SHEET		Project No./Code	
Creation Date: 07/22/97	Initials: JRY				No Revisions:		C. R. 6E TO CRAFT DR.		NH 1602-058	
Last Modification Date: 12/24/97	Initials: JRY				Revised:		Designer:		10578	
Full Path: BEAST F:\JOBS\CDOT\5657-003\PHASE-ONE					Void:		Detailer: JRY		Sheet Number: 20	
Drawing File Name: P-1Rowplan3.DWG							Sheet Subset: R.O.W.	Subset Sheets: 16 OF 46		
Acad Ver. R14	Scale: 1:1000	Units: METRIC								

SW 1/4
SECTION 21
T 38 N, R 9 E

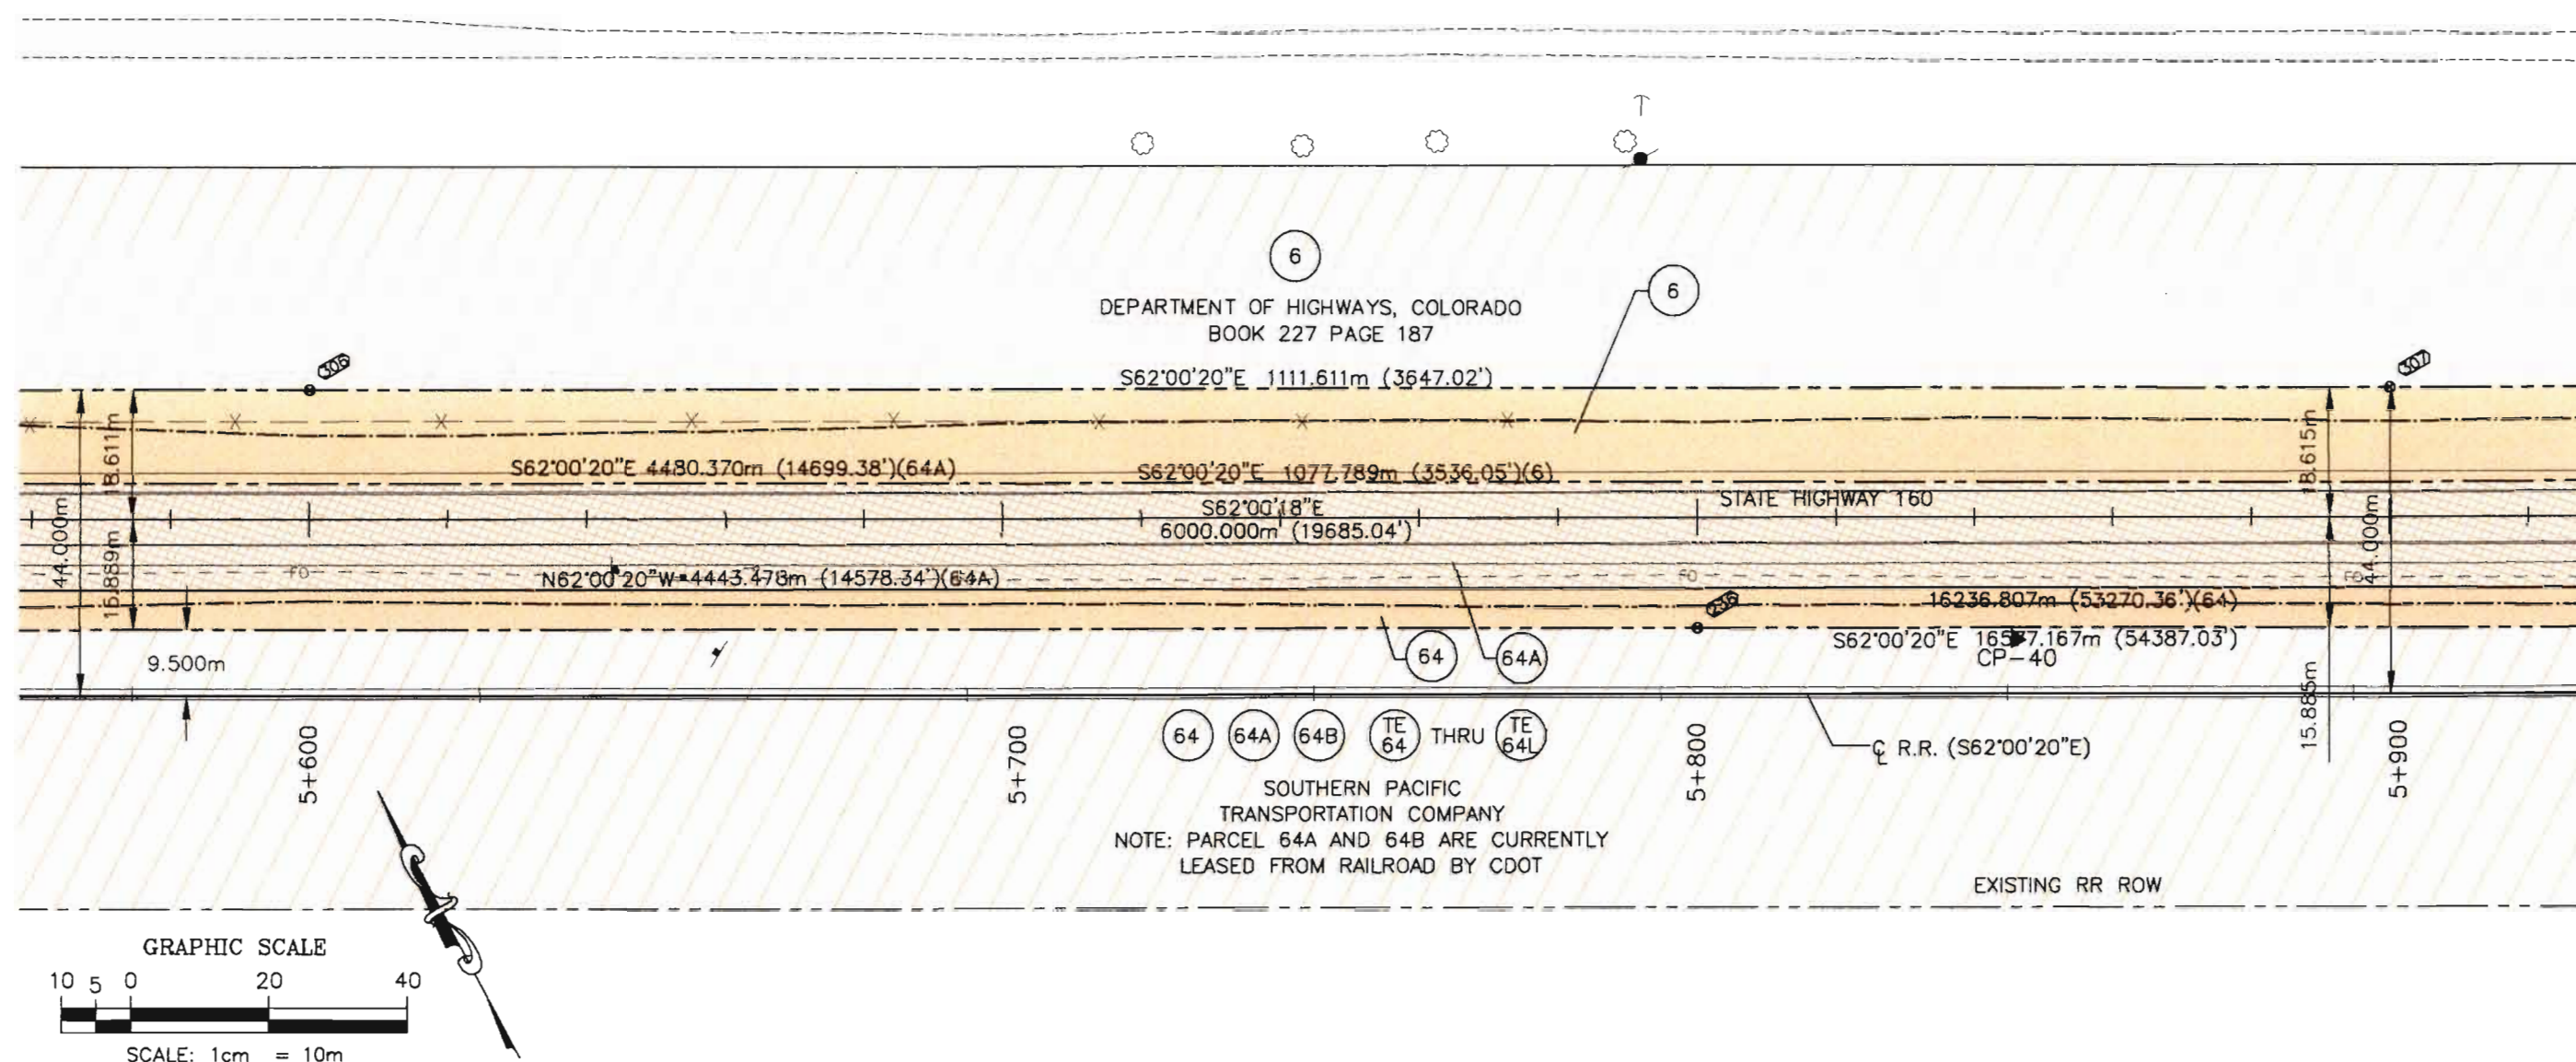

Computer File Information				Index of Revisions				Colorado Department of Transportation				As Constructed				RIGHT-OF-WAY PLAN SHEET				Project No./Code			
Creation Date: 07/22/97 Initials: JRY									 3803 North Main Avenue, Suite 300 Durango, Colorado 81301 Phone: 970-385-1400 FAX: 970-385-1410 Region 5	No Revisions:				C. R. 6E TO CRAFT DR.				NH 1602-058					
Last Modification Date: 12/24/97 Initials: JRY										Revised:				Designer:				10578					
Full Path: BEAST F:\JOBS\CDOT\5657-003\PHASE-ONE										Void:				Detailer: JRY									
Drawing File Name: P-1Rowplan3.DWG														Sheet Subset: R.O.W.		Subset Sheets: 17 OF 46		Sheet Number: 21					
Acad Ver. R14 Scale: 1:1000 Units: METRIC																							

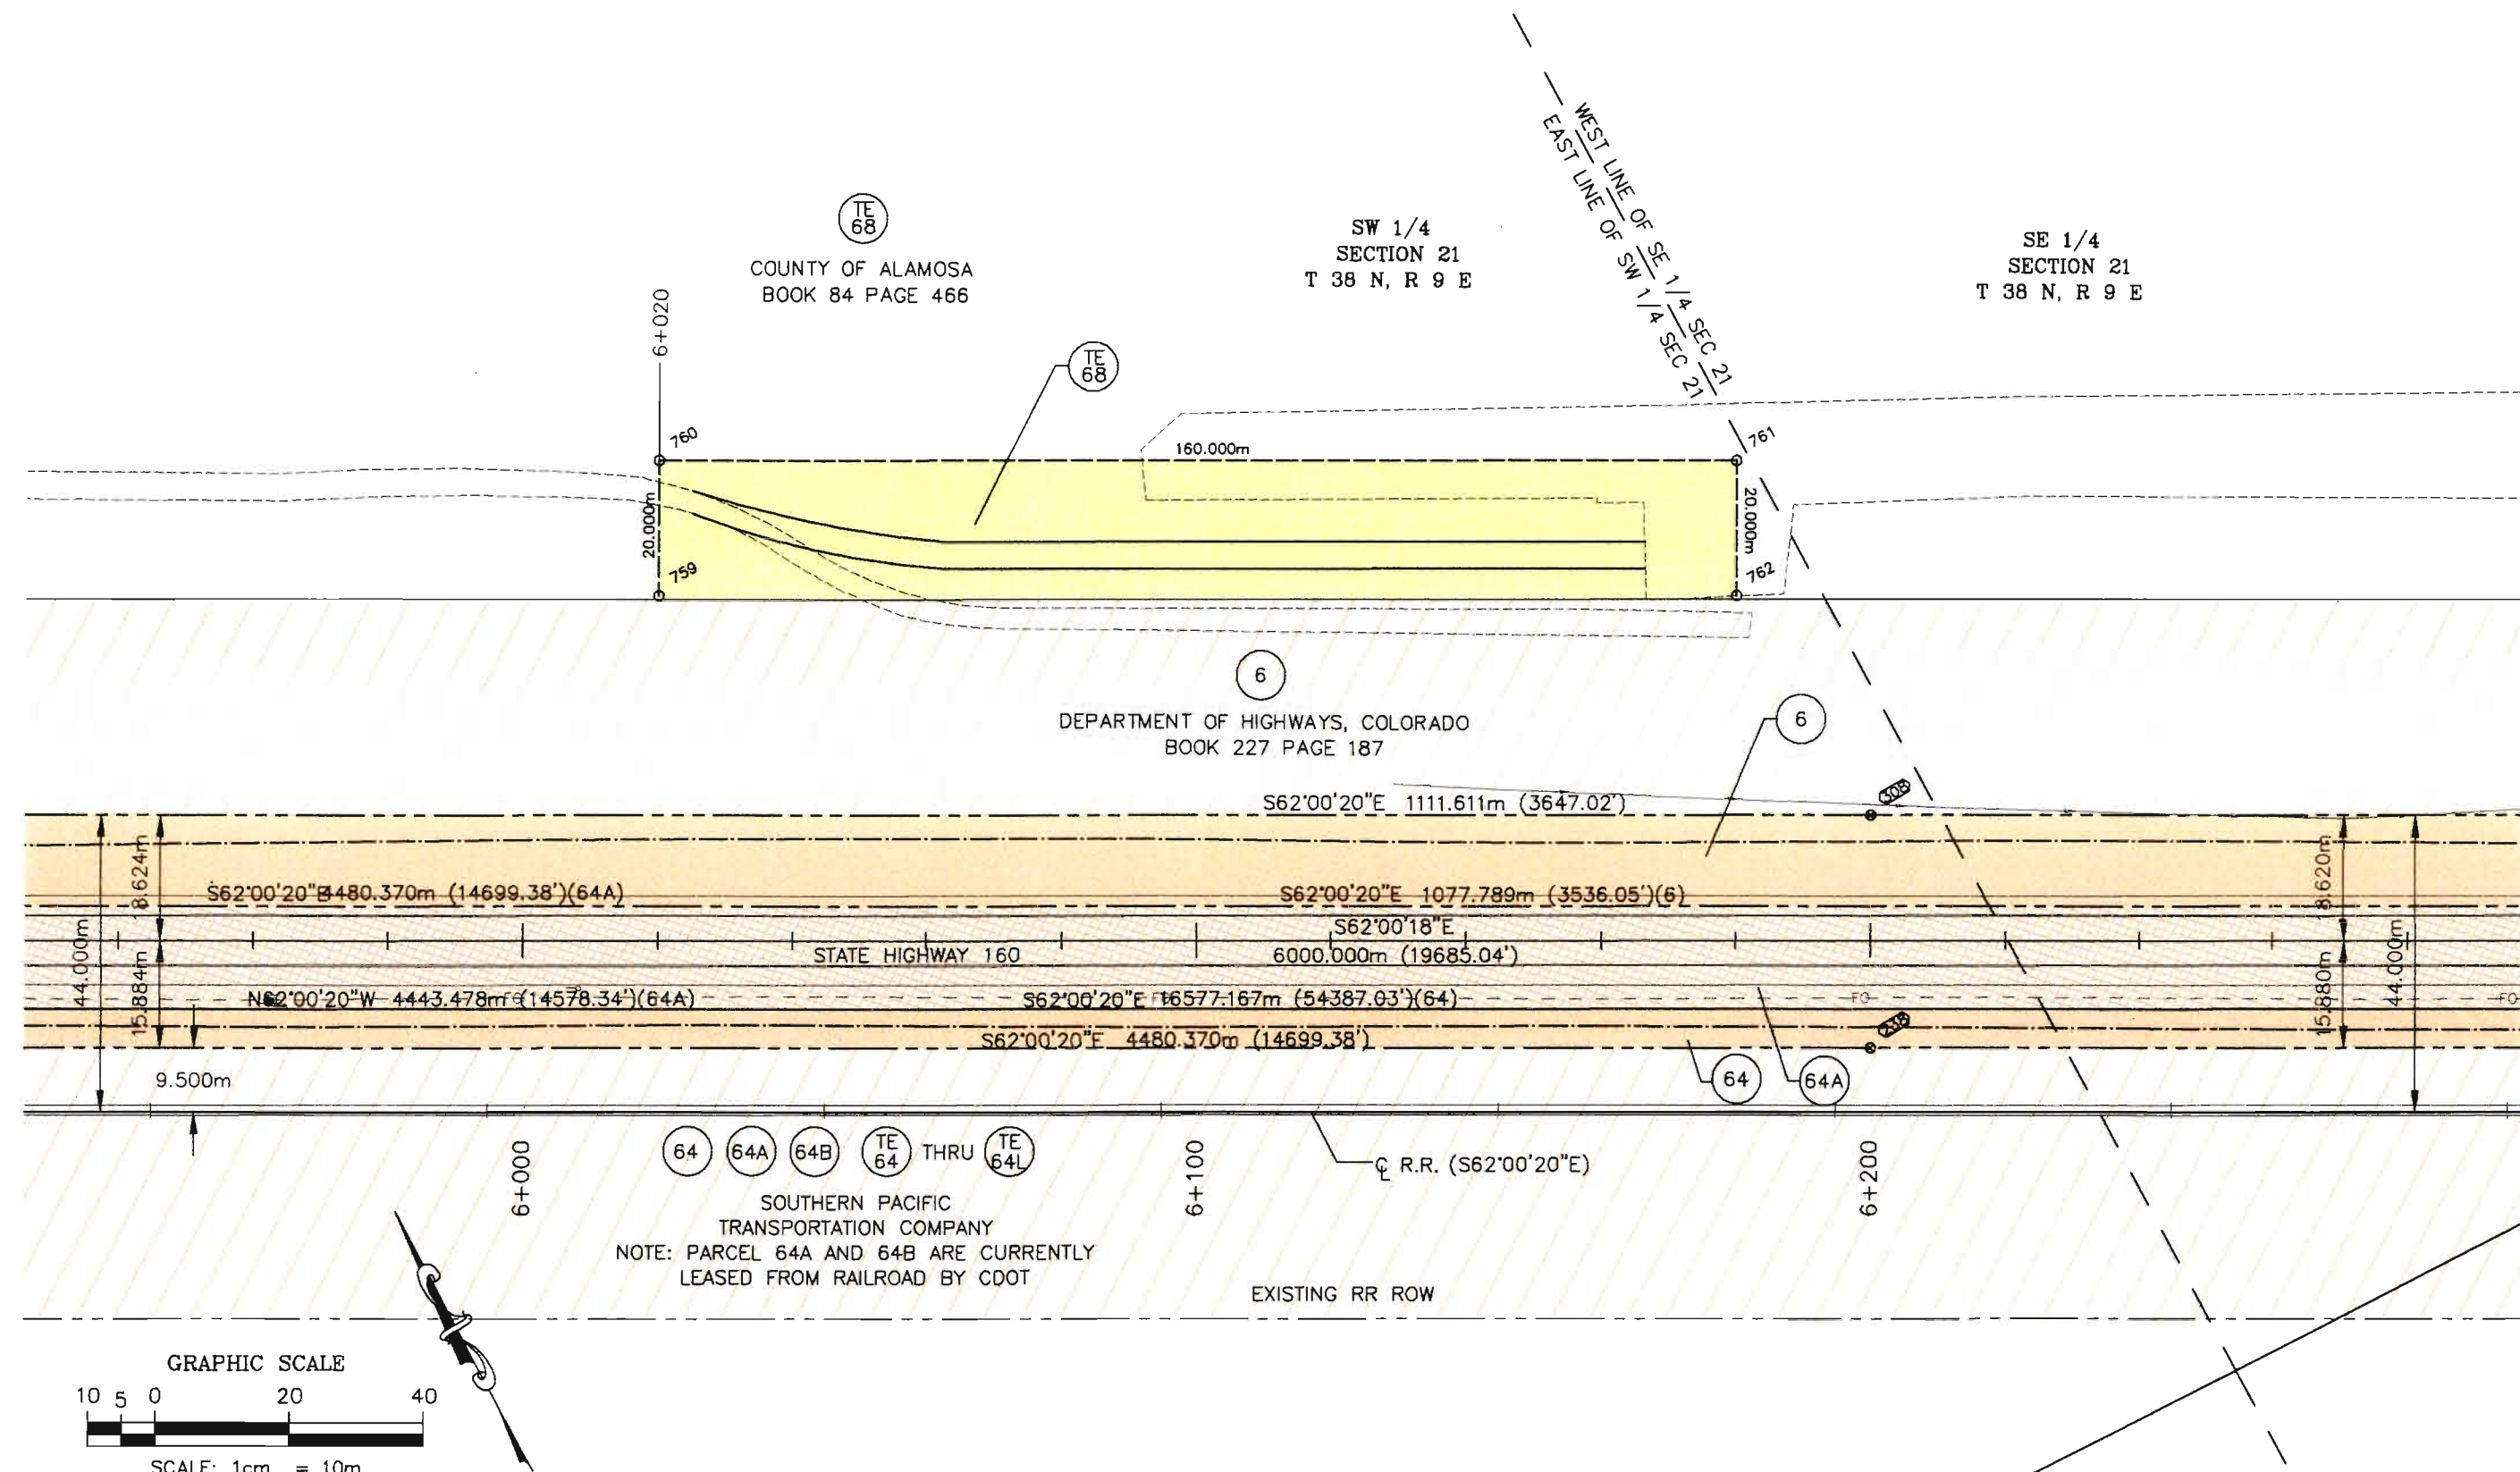

Computer File Information

Creation Date: 07/22/97 Initials: JRY
Last Modification Date: 12/24/97 Initials: JRY
Full Path: BEAST F:\JOBS\CDOT\5657-003\PHASE-ONE
Drawing File Name: P-1Rowplan3.DWG
Acad Ver. R14 Scale: 1:1000 Units: METRIC

Index of Revisions



Colorado Department of Transportation



Region 5

3803 North Main Avenue, Suite 300
Durango, Colorado 81301
Phone: 970-385-1400 FAX: 970-385-1410

As Constructed

No Revisions:

Revised:

Void:

RIGHT-OF-WAY PLAN SHEET

C. R. 6E TO CRAFT DR.

Designer:

Detailer: JRY

Sheet Subset: R.O.W.

Subset Sheets: 18 OF 46

Project No./Code

NH 1602-058

10578



Sheet Number: 22

SE 1/4
SECTION 21
T 38 N, R 9 E


NE 1/4
SECTION 28
T 38 N, R 9 E

BILL RUSH
BOOK 453 PAGE 328

DEPARTMENT OF HIGHWAYS, COLORADO
BOOK 227 PAGE 187

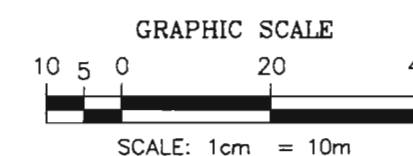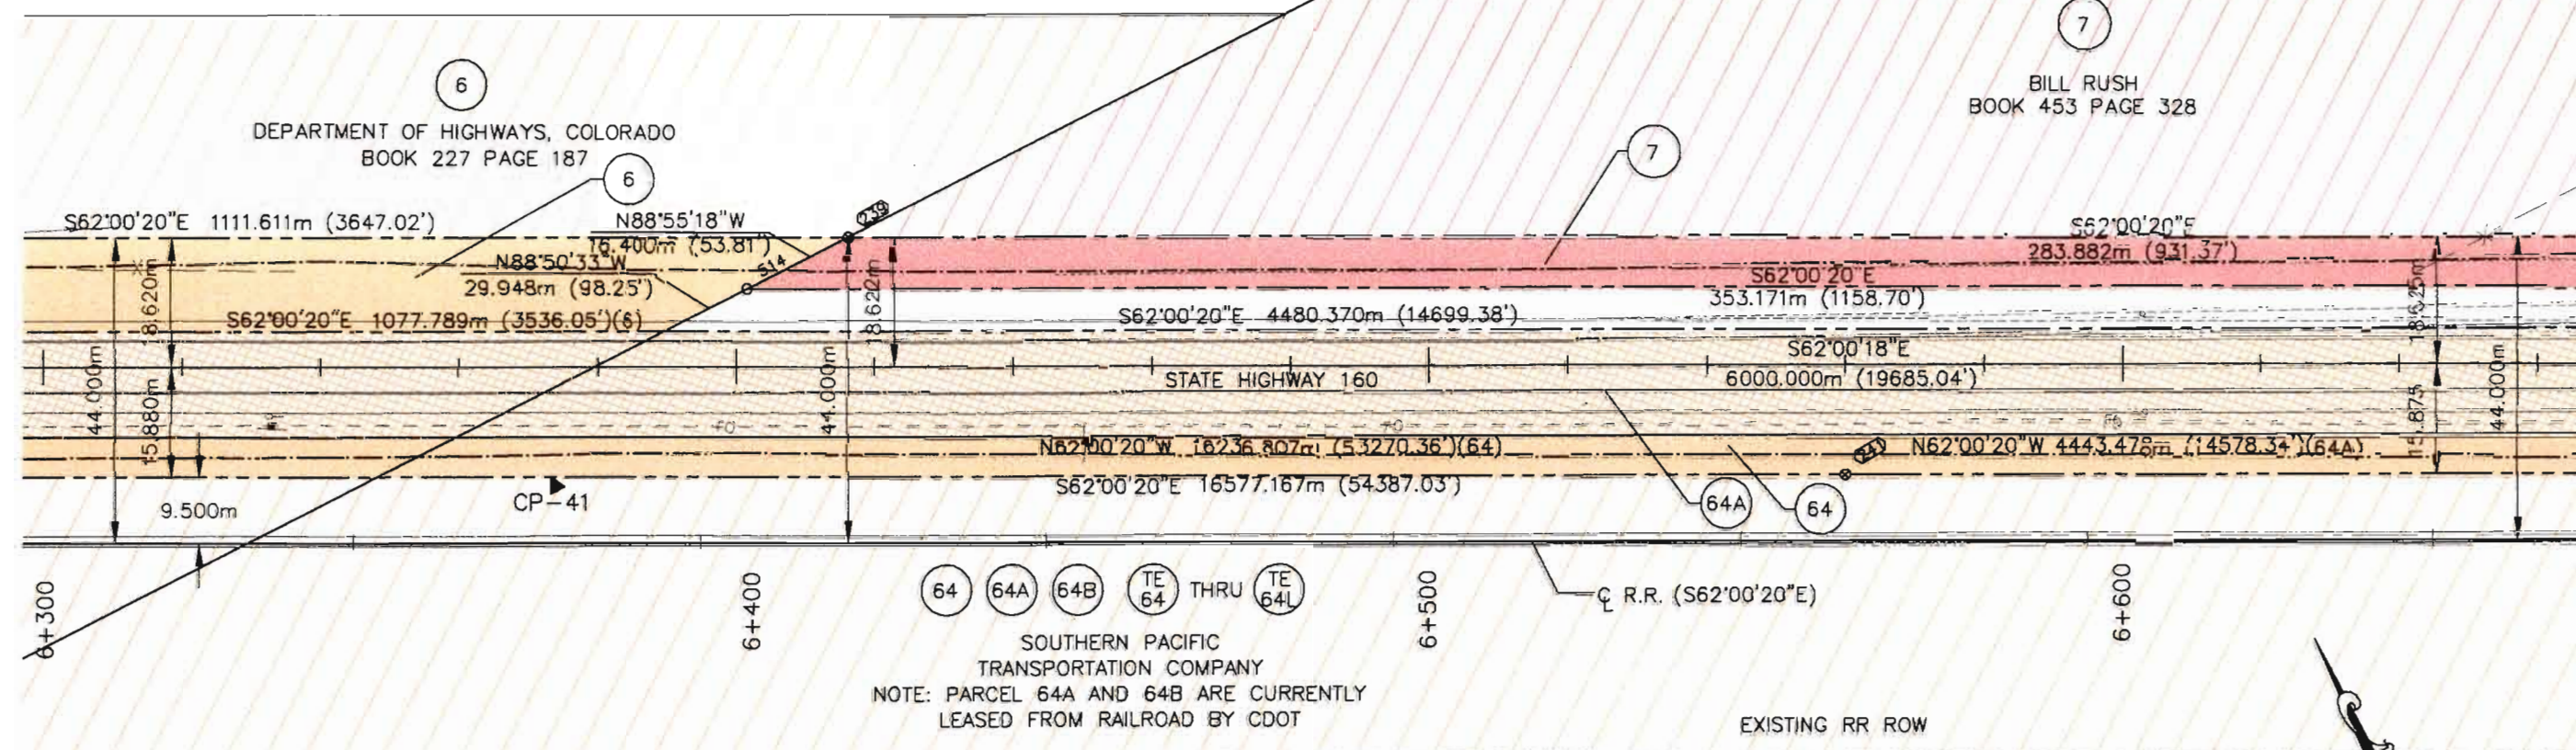

Computer File Information			Index of Revisions		Colorado Department of Transportation Region 5	As Constructed		RIGHT-OF-WAY PLAN SHEET C. R. 6E TO CRAFT DR.	Project No./Code	
Creation Date: 07/22/97	Initials: JRY					No Revisions:			NH 1602-058	
Last Modification Date: 12/24/97	Initials: JRY					Revised:		Designer:	10578	
Full Path: BEAST F:\JOBS\CDOT\5657-003\PHASE-ONE						Void:		Detailer: JRY		
Drawing File Name: P-1Rowplan3.DWG								Sheet Subset: R.O.W.	Subset Sheets: 19 OF 46	Sheet Number: 23
Acad Ver. R14	Scale: 1:1000	Units: METRIC								

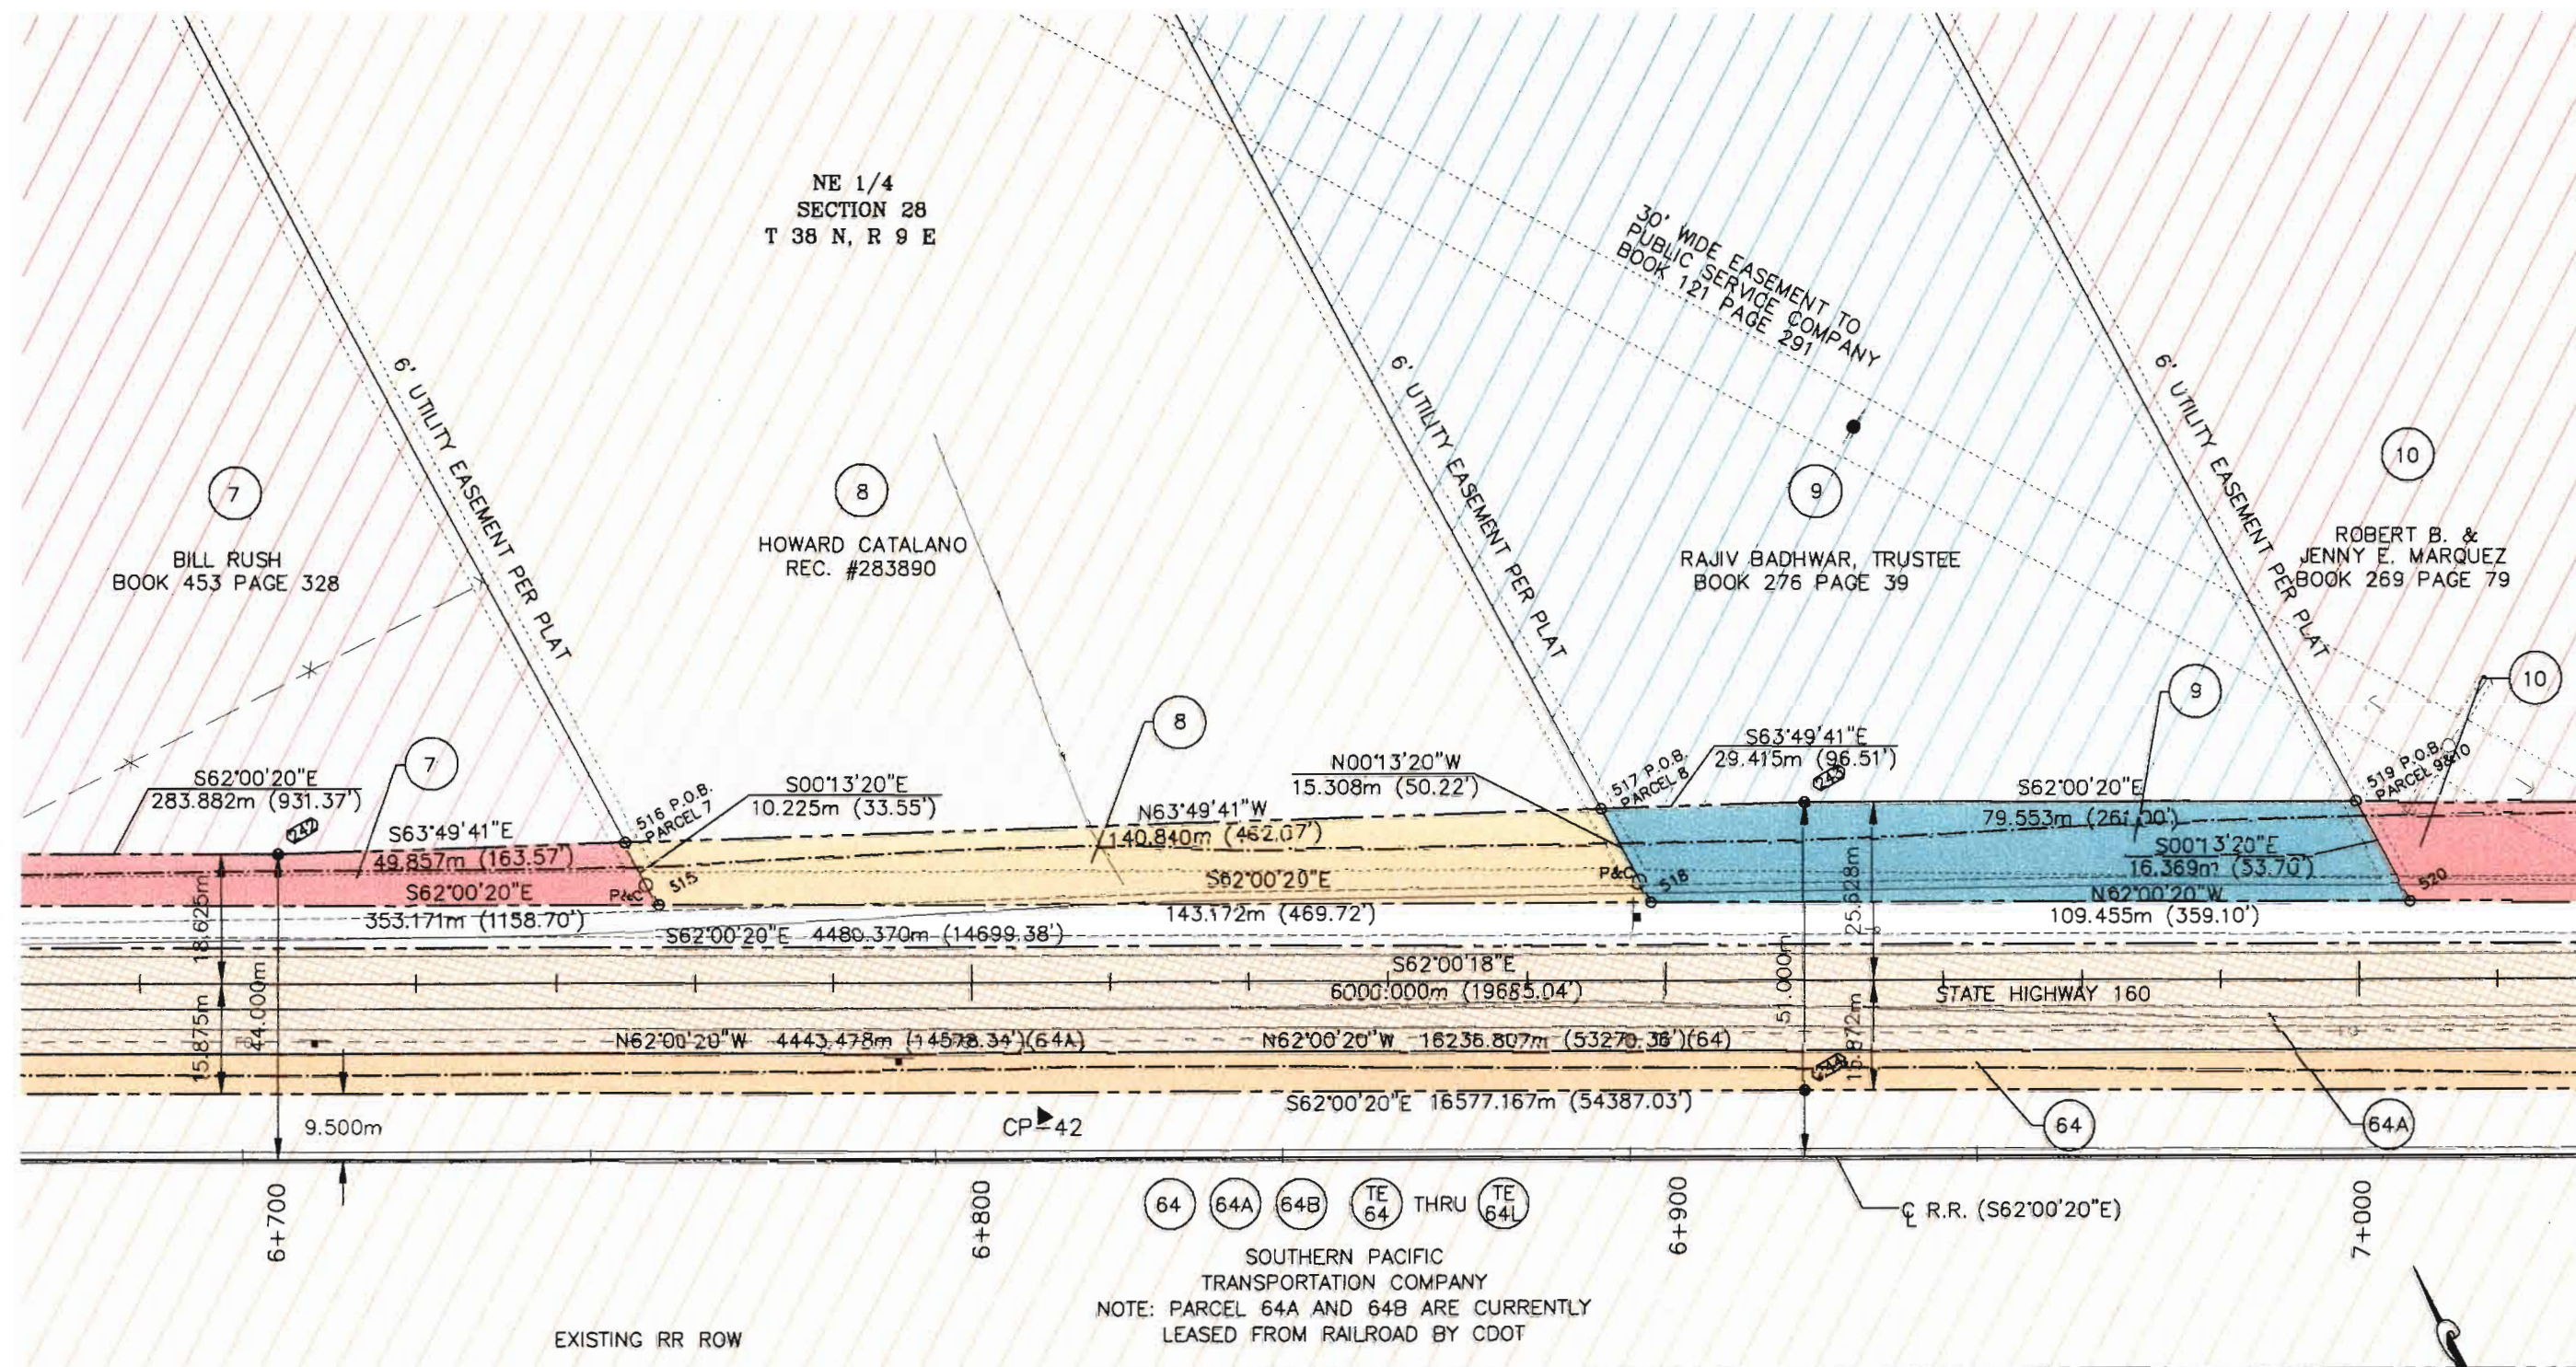

Computer File Information			
Creation Date: 07/22/97	Initials: JRY		
Last Modification Date: 12/24/97	Initials: JRY		
Full Path: BEAST F:\JOBS\CDOT\5657-003\PHASE-ONE			
Drawing File Name: P-1Rowplan3.DWG			
Acad Ver. R14	Scale: 1:1000	Units: METRIC	



Index of Revisions			

Colorado Department of Transportation	
	3803 North Main Avenue, Suite 300 Durango, Colorado 81301 Phone: 970-385-1400 FAX: 970-385-1410
Region 5	


As Constructed
No Revisions:
Revised:
Void:

RIGHT-OF-WAY PLAN SHEET	
C. R. 6E TO CRAFT DR.	
Designer:	
Detailer: JRY	
Sheet Subset: R.O.W.	Subset Sheets: 20 OF 46

Project No./Code
NH 1602-058
10578
Sheet Number: 24

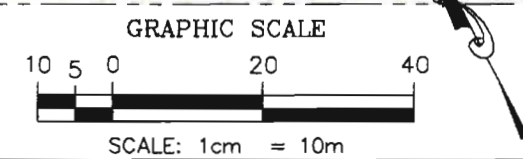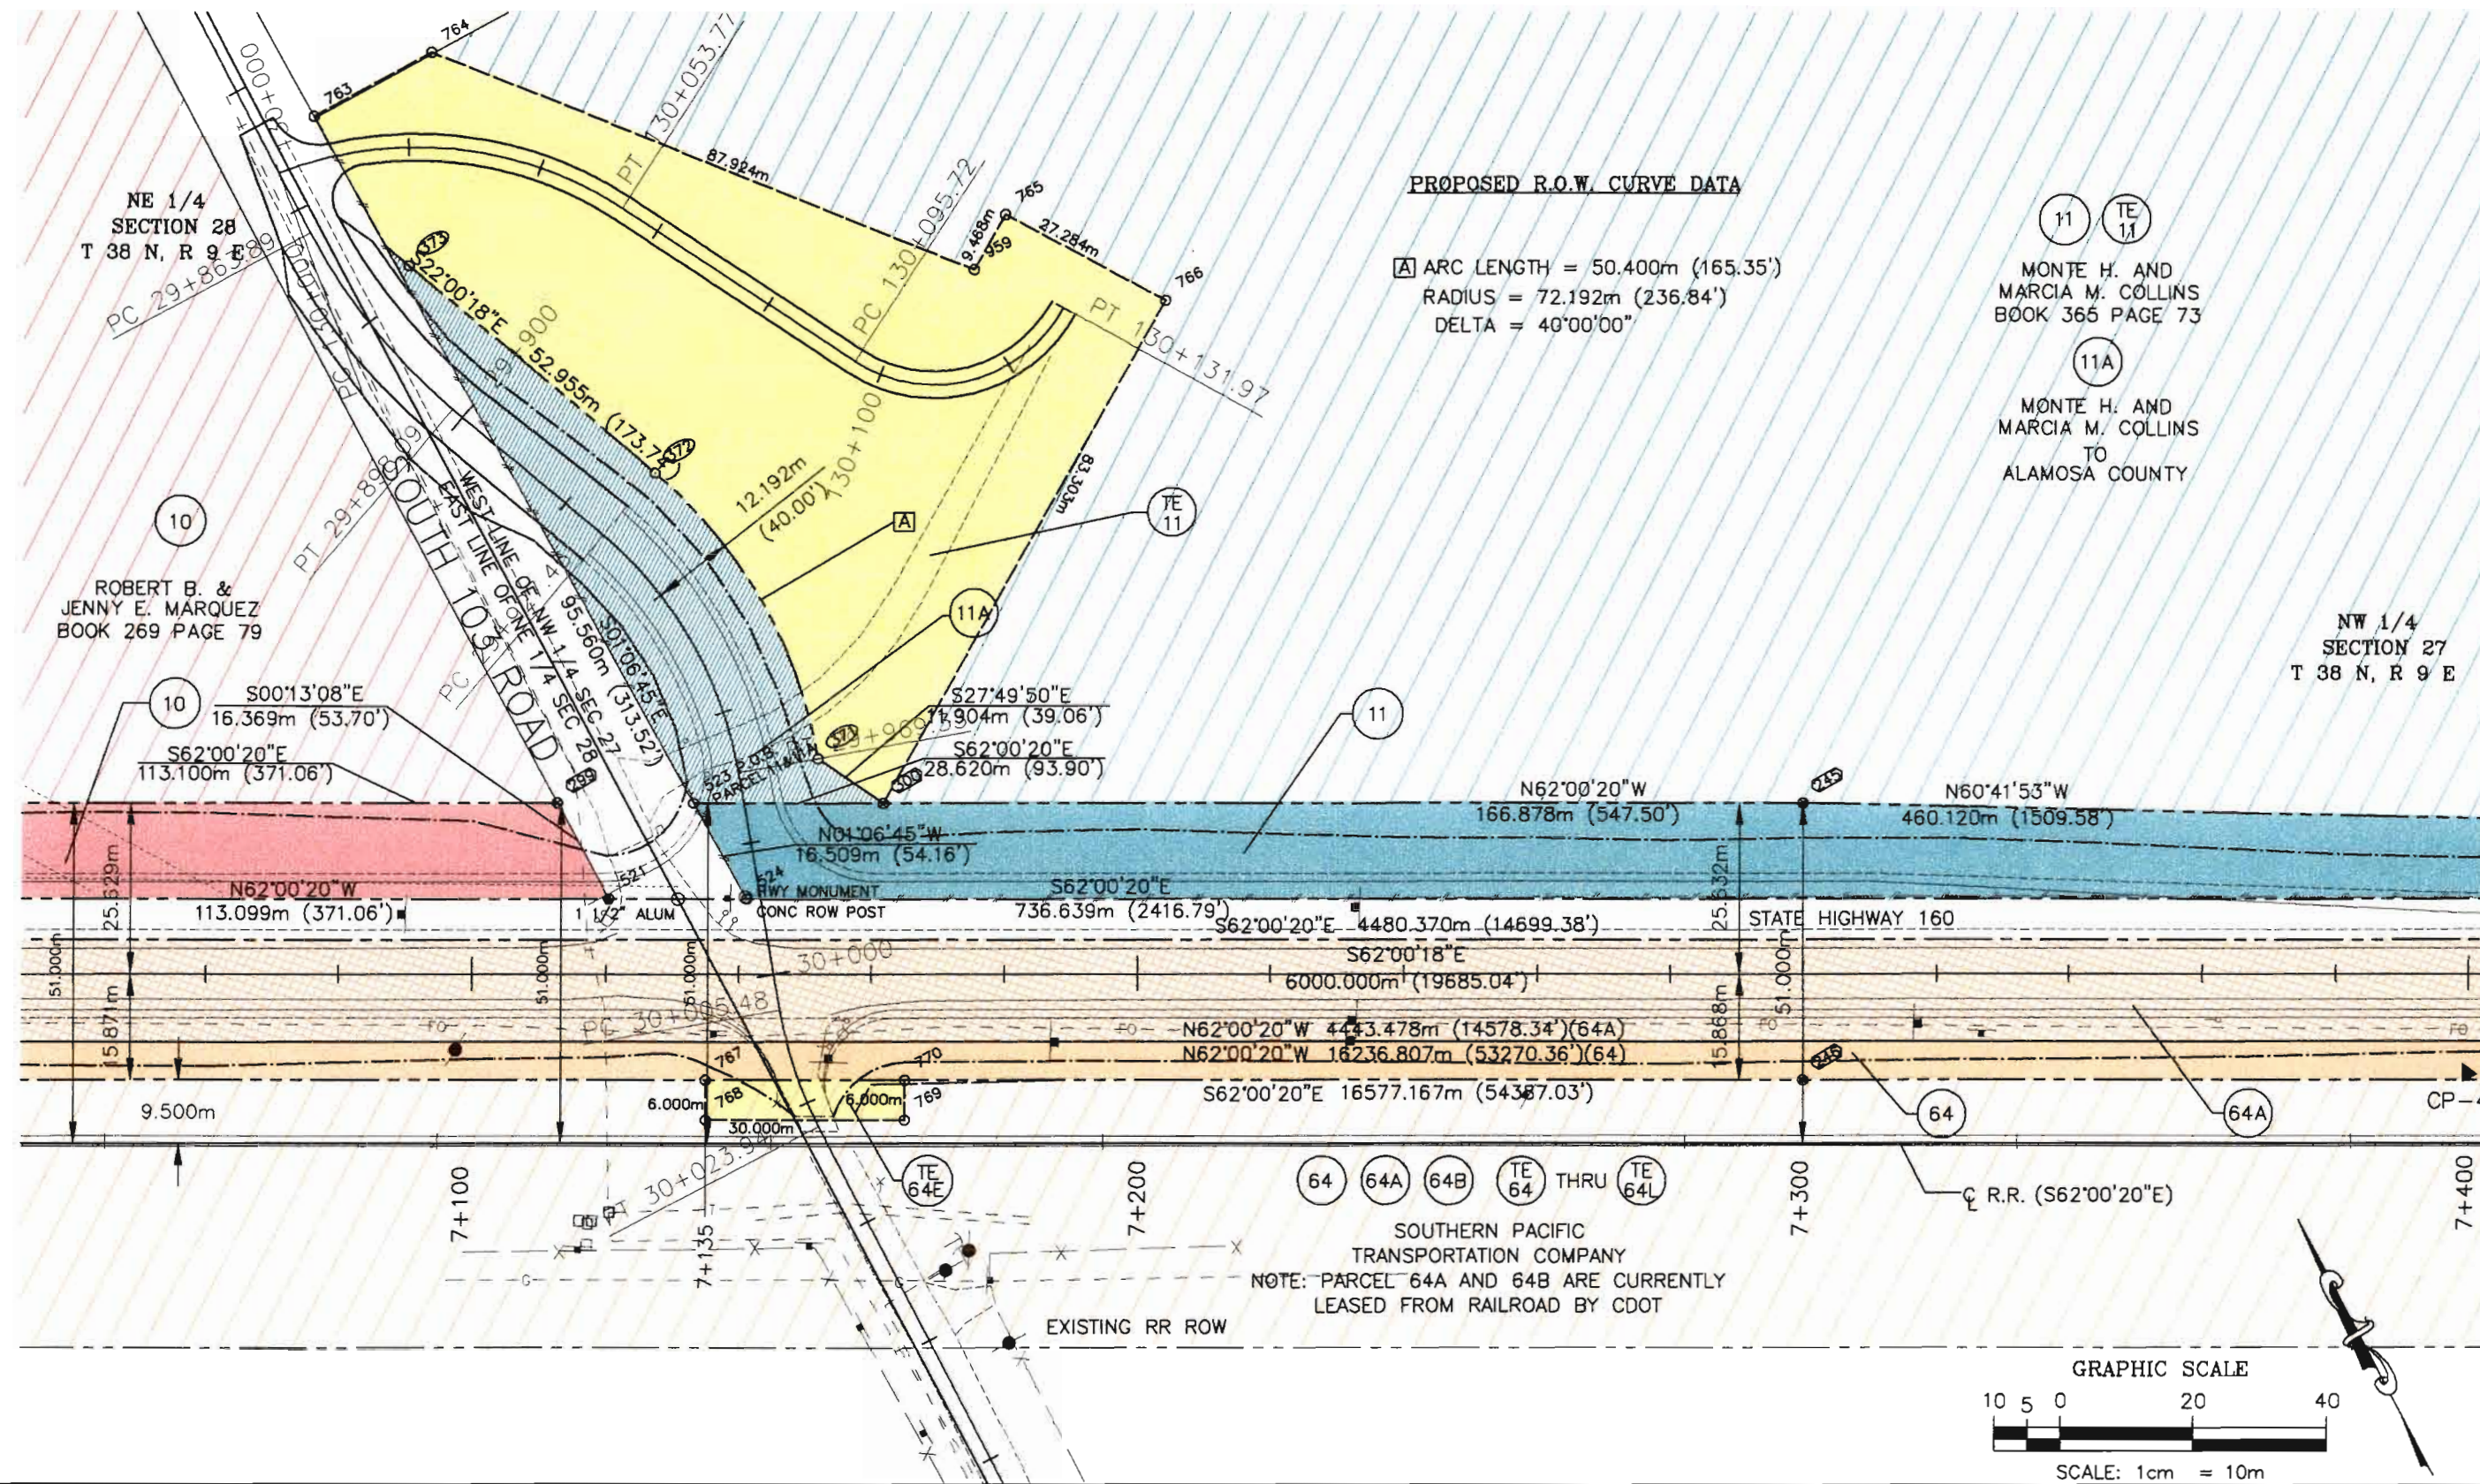

Computer File Information			Index of Revisions			Colorado Department of Transportation			As Constructed			RIGHT-OF-WAY PLAN SHEET			Project No./Code		
Creation Date: 07/22/97	Initials: JRY					 3803 North Main Avenue, Suite 300 Durango, Colorado 81301 Phone: 970-385-1400 FAX: 970-385-1410 Region 5			No Revisions:			C. R. 6E TO CRAFT DR.			NH 1602-058		
Last Modification Date: 12/24/97	Initials: JRY								Revised:			Designer:			10578		
Full Path: BEAST F:\JOBS\CDOT\5657-003\PHASE-ONE									Void:			Detailer: JRY					
Drawing File Name: P-1Rowplan3.DWG												Sheet Subset: R.O.W.			Subset Sheets: 21 OF 46		
Acad Ver. R14	Scale: 1:1000	Units: METRIC													Sheet Number: 25		

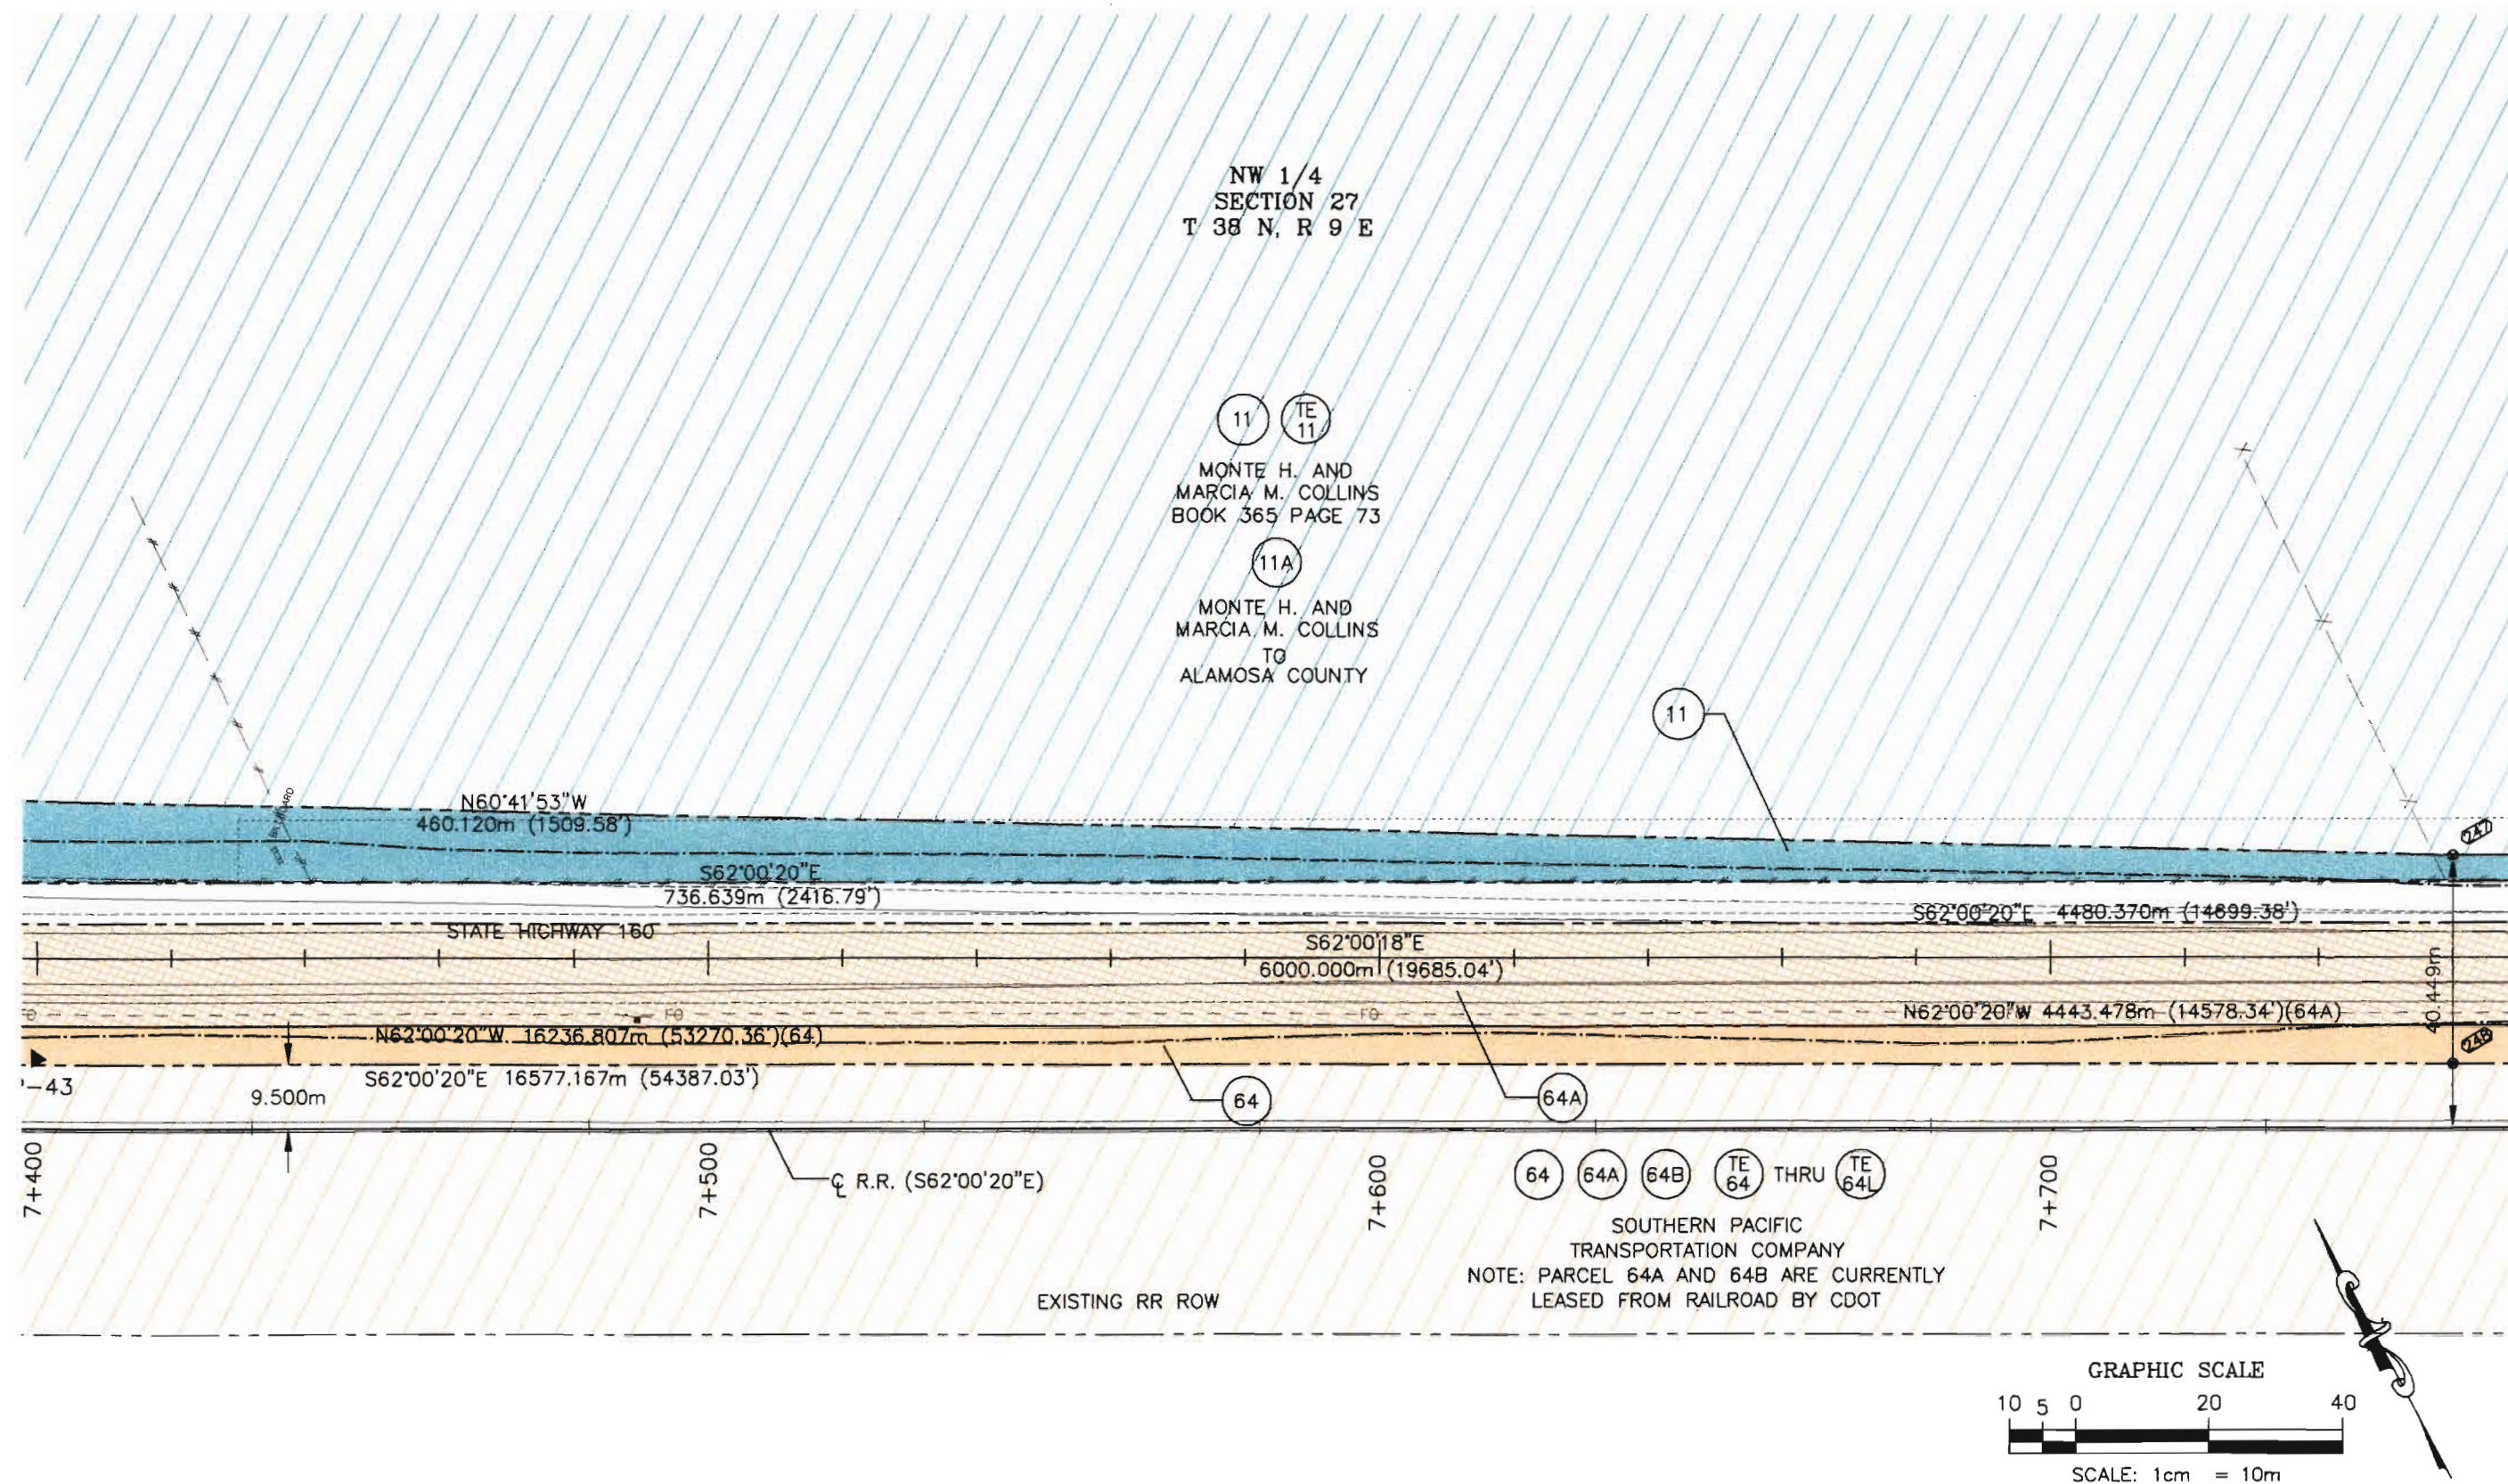


Computer File Information		
Creation Date: 07/22/97	Initials: JRY	
Last Modification Date: 12/24/97	Initials: JRY	
Full Path: BEAST F:\JOBS\CDOT\5657-003\PHASE-ONE		
Drawing File Name: P-1Rowplan3.DWG		
Acad Ver. R14	Scale: 1:1000	Units: METRIC


Index of Revisions		


Colorado Department of Transportation	
	3803 North Main Avenue, Suite 300 Durango, Colorado 81301 Phone: 970-385-1400 FAX: 970-385-1410
Region 5	

As Constructed		RIGHT-OF-WAY PLAN SHEET		Project No./Code	
No Revisions:		C. R. 6E TO CRAFT DR.		NH 1602-058	
Revised:		Designer:		10578	
Void:		Detailer: JRY		Sheet Number: 26	
		Sheet Subset: R.O.W.	Subset Sheets: 22 OF 46		

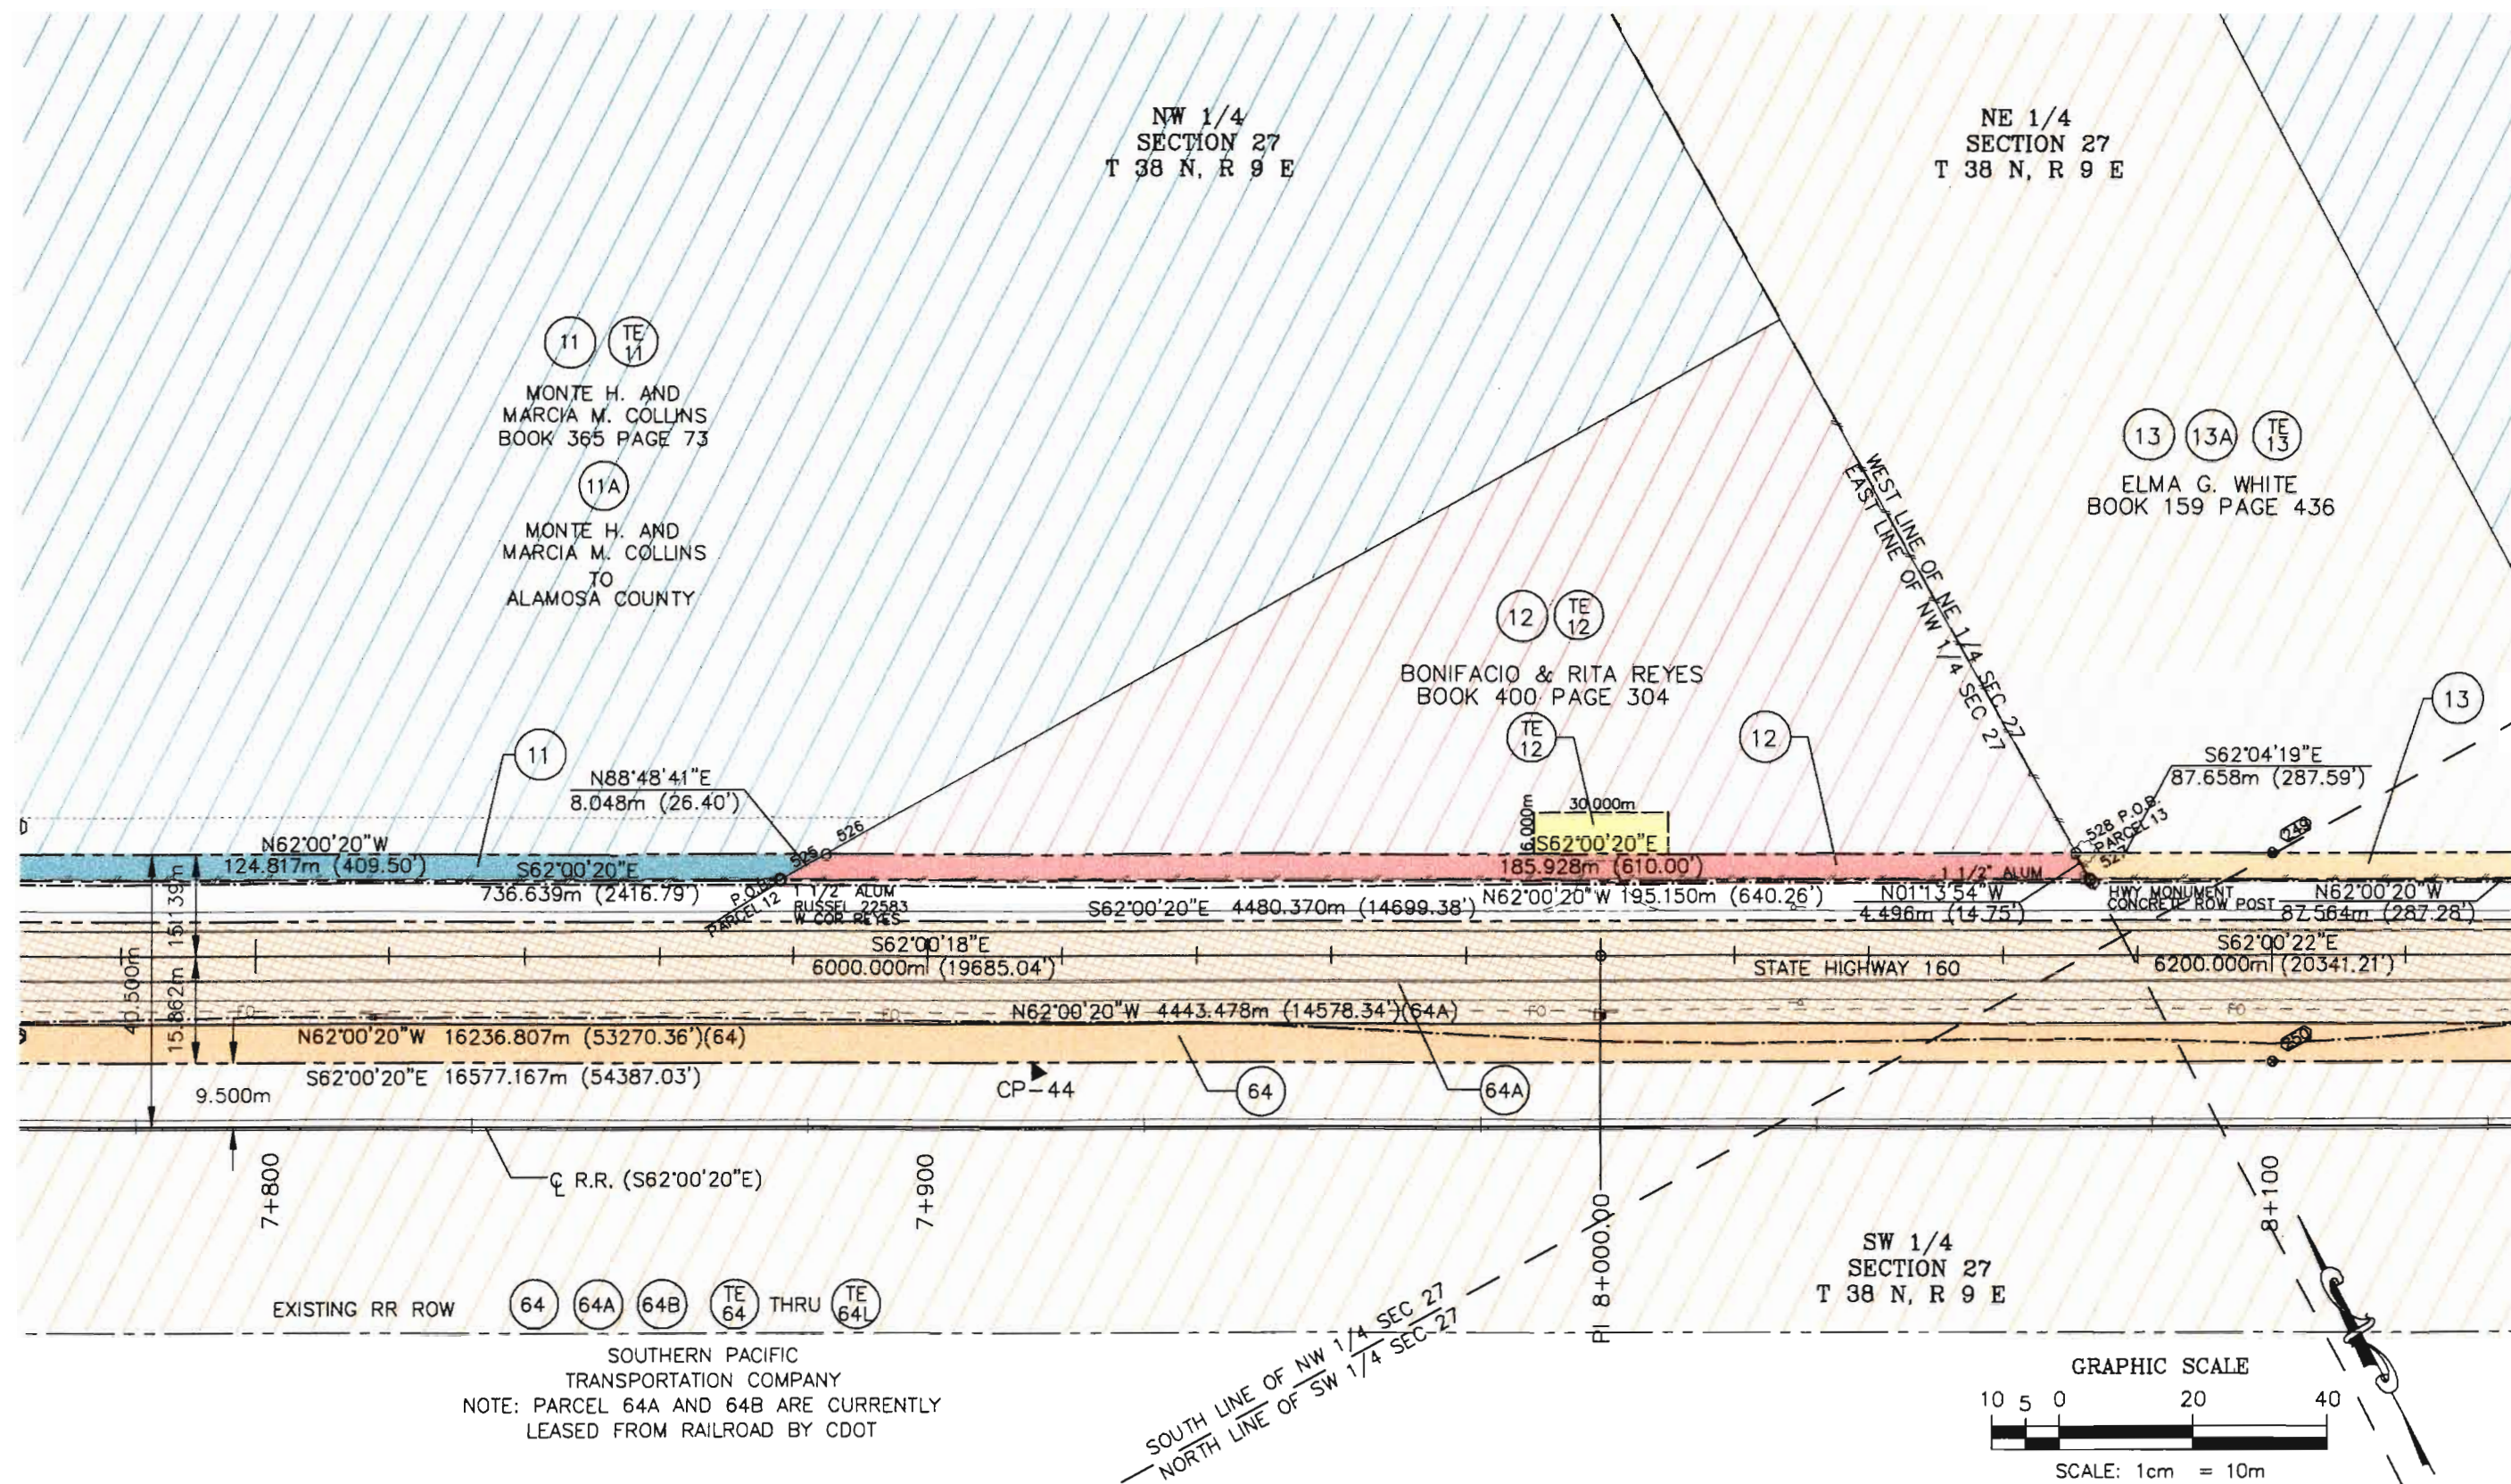


Computer File Information				Index of Revisions				Colorado Department of Transportation				As Constructed		RIGHT-OF-WAY PLAN SHEET				Project No./Code	
Creation Date: 07/22/97		Initials: JRY						 3803 North Main Avenue, Suite 300 Durango, Colorado 81301 Phone: 970-385-1400 FAX: 970-385-1410 Region 5	No Revisions:		C. R. 6E TO CRAFT DR.				NH 1602-058				
Last Modification Date: 12/24/97		Initials: JRY								Revised:		Designer:				10578			
Full Path: BEAST F:\JOBS\CDOT\5657-003\PHASE-ONE												Detailer: JRY							
Drawing File Name: P-1Rowplan3.DWG										Void:		Sheet Subset: R.O.W.		Subset Sheets: 23 OF 46		Sheet Number: 27			
Acad Ver. R14		Scale: 1:1000			Units: METRIC														

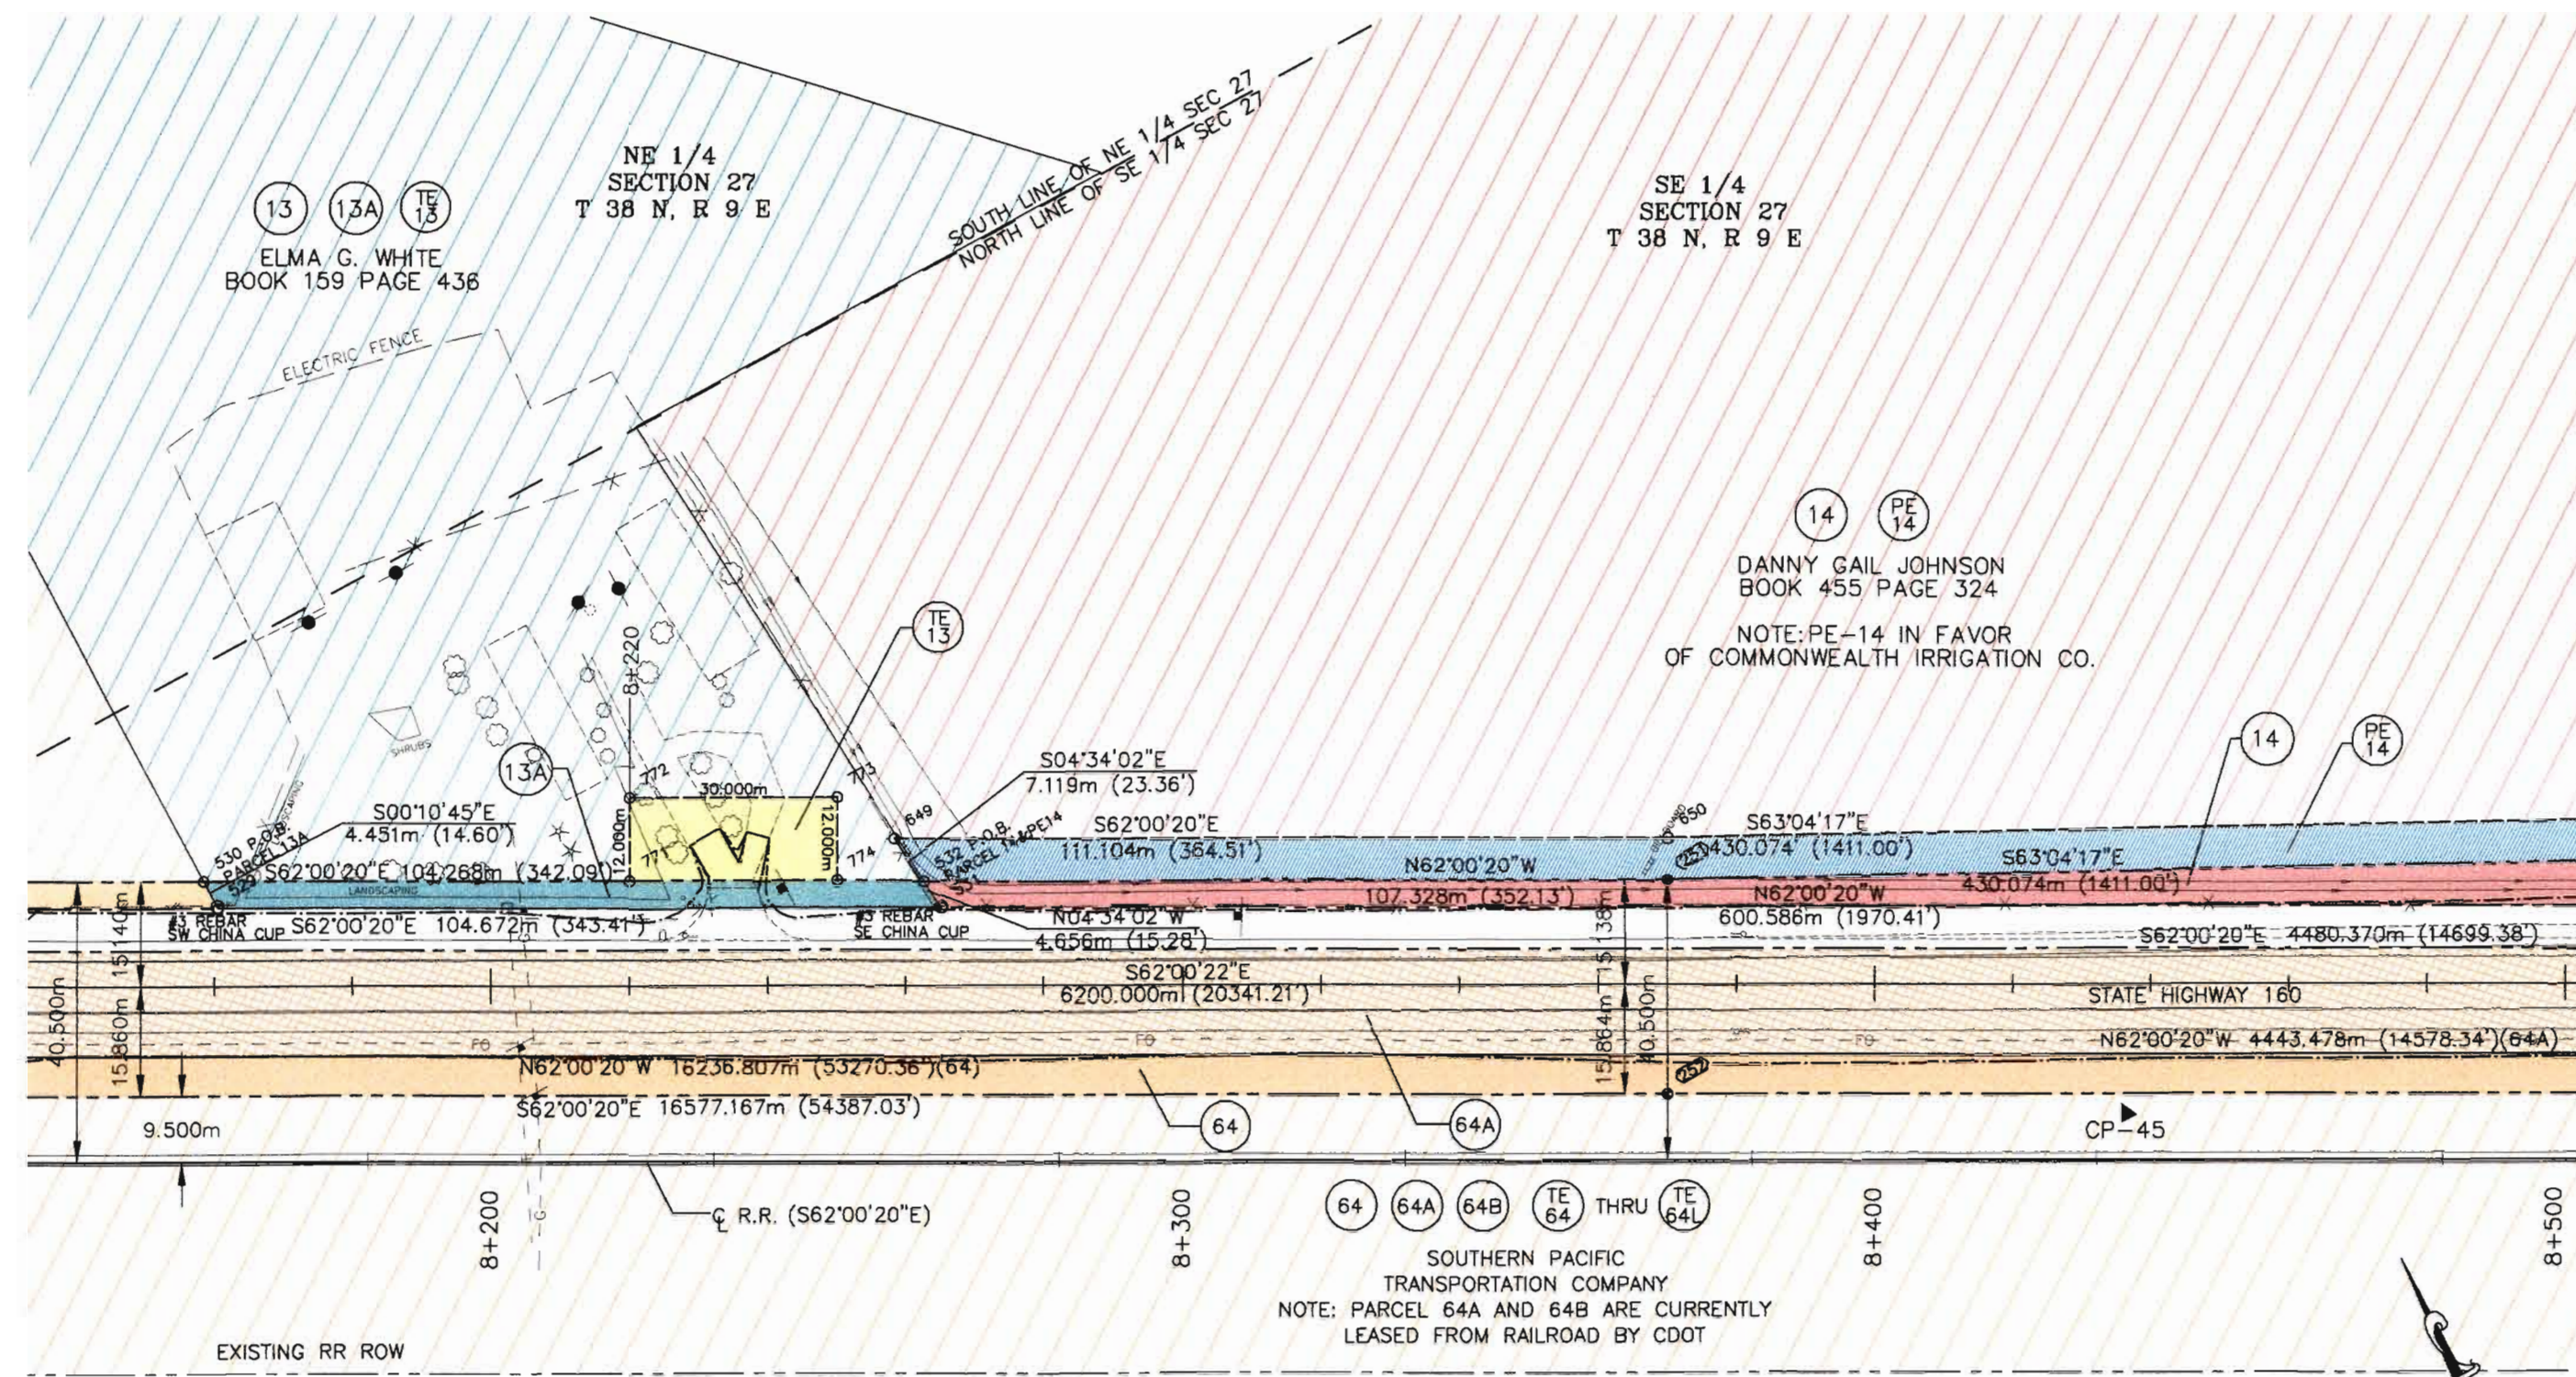

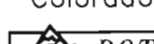
Computer File Information				Index of Revisions				Colorado Department of Transportation				As Constructed		RIGHT-OF-WAY PLAN SHEET				Project No./Code		
Creation Date: 07/22/97		Initials: JRY		☐				 3803 North Main Avenue, Suite 300 Durango, Colorado 81301 Phone: 970-385-1400 FAX: 970-385-1410	Region 5				No Revisions:		C. R. 6E TO CRAFT DR.				NH 1602-058	
Last Modification Date: 12/24/97		Initials: JRY		☐									Revised:		Designer:				10578	
Full Path: BEAST F:\JOBS\CDOT\5657-003\PHASE-ONE				☐									Detailer: JRY							
Drawing File Name: P-1Rowplan3.DWG				☐									Void:		Sheet Subset: R.O.W.		Subset Sheets: 24 OF 46		Sheet Number: 28	
Acad Ver. R14		Scale: 1:1000		Units: METRIC		☐														

SE 1/4
SECTION 27
T 38 N, R 9 E


(14) (PE 14)
DANNY GAIL JOHNSON
BOOK 455 PAGE 324
NOTE: PE-14 IN FAVOR
OF COMMONWEALTH IRRIGATION CO.

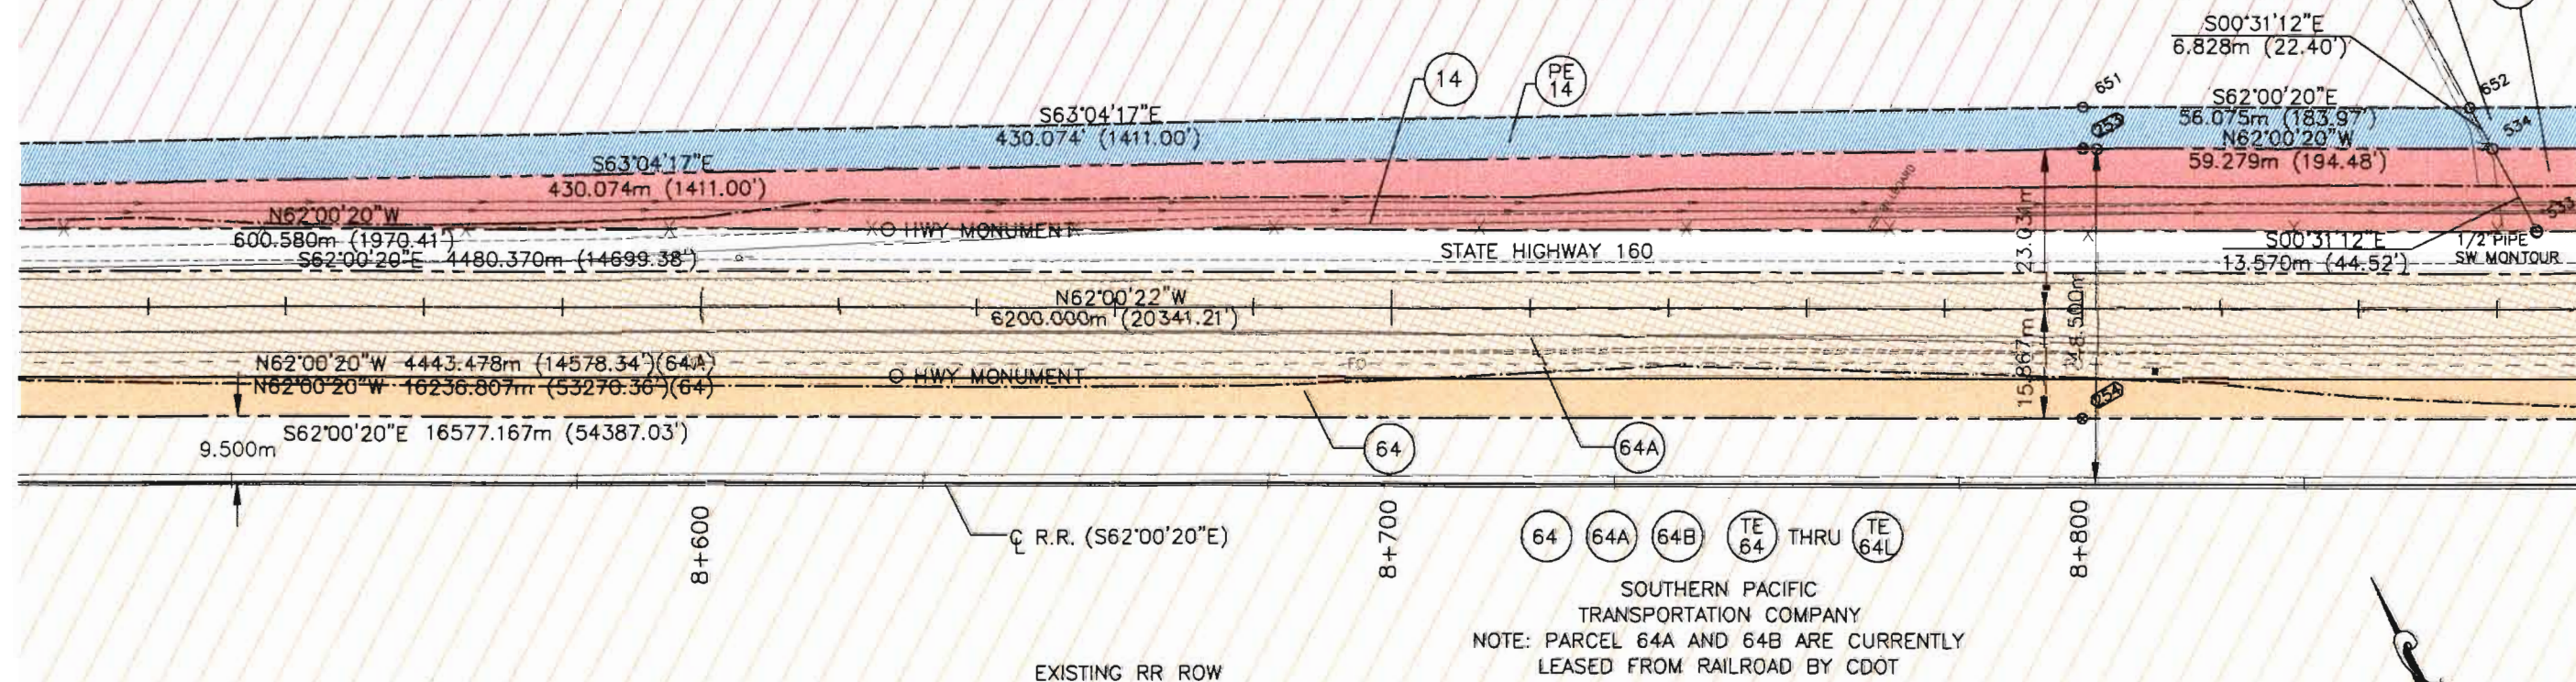


SOUTHERN PACIFIC
TRANSPORTATION COMPANY
NOTE: PARCEL 64A AND 64B ARE CURRENTLY
LEASED FROM RAILROAD BY CDOT

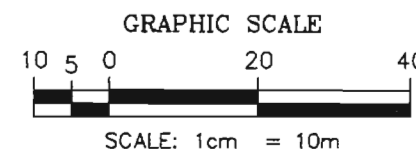



Computer File Information		Index of Revisions			Colorado Department of Transportation		As Constructed		RIGHT-OF-WAY PLAN SHEET		Project No./Code	
Creation Date: 07/22/97	Initials: JRY	(R2A)	4/20/98	PARCELS 15 & PE-15	EDC	 3803 North Main Avenue, Suite 300 Durango, Colorado 81301 Phone: 970-385-1400 FAX: 970-385-1410 Region 5	No Revisions:		C. R. 6E TO CRAFT DR.		NH 1602-058	
Last Modification Date: 12/24/97	Initials: JRY						Revised:		Designer:		10578	
Full Path: BEAST F:\JOBS\CDOT\5657-003\PHASE-ONE							Void:		Detailer: JRY		Sheet Number: 29	
Drawing File Name: P-1Rowplan3.DWG									Sheet Subset: R.O.W.	Subset Sheets: 25 OF 46		
Acad Ver. R14	Scale: 1:1000	Units: METRIC										

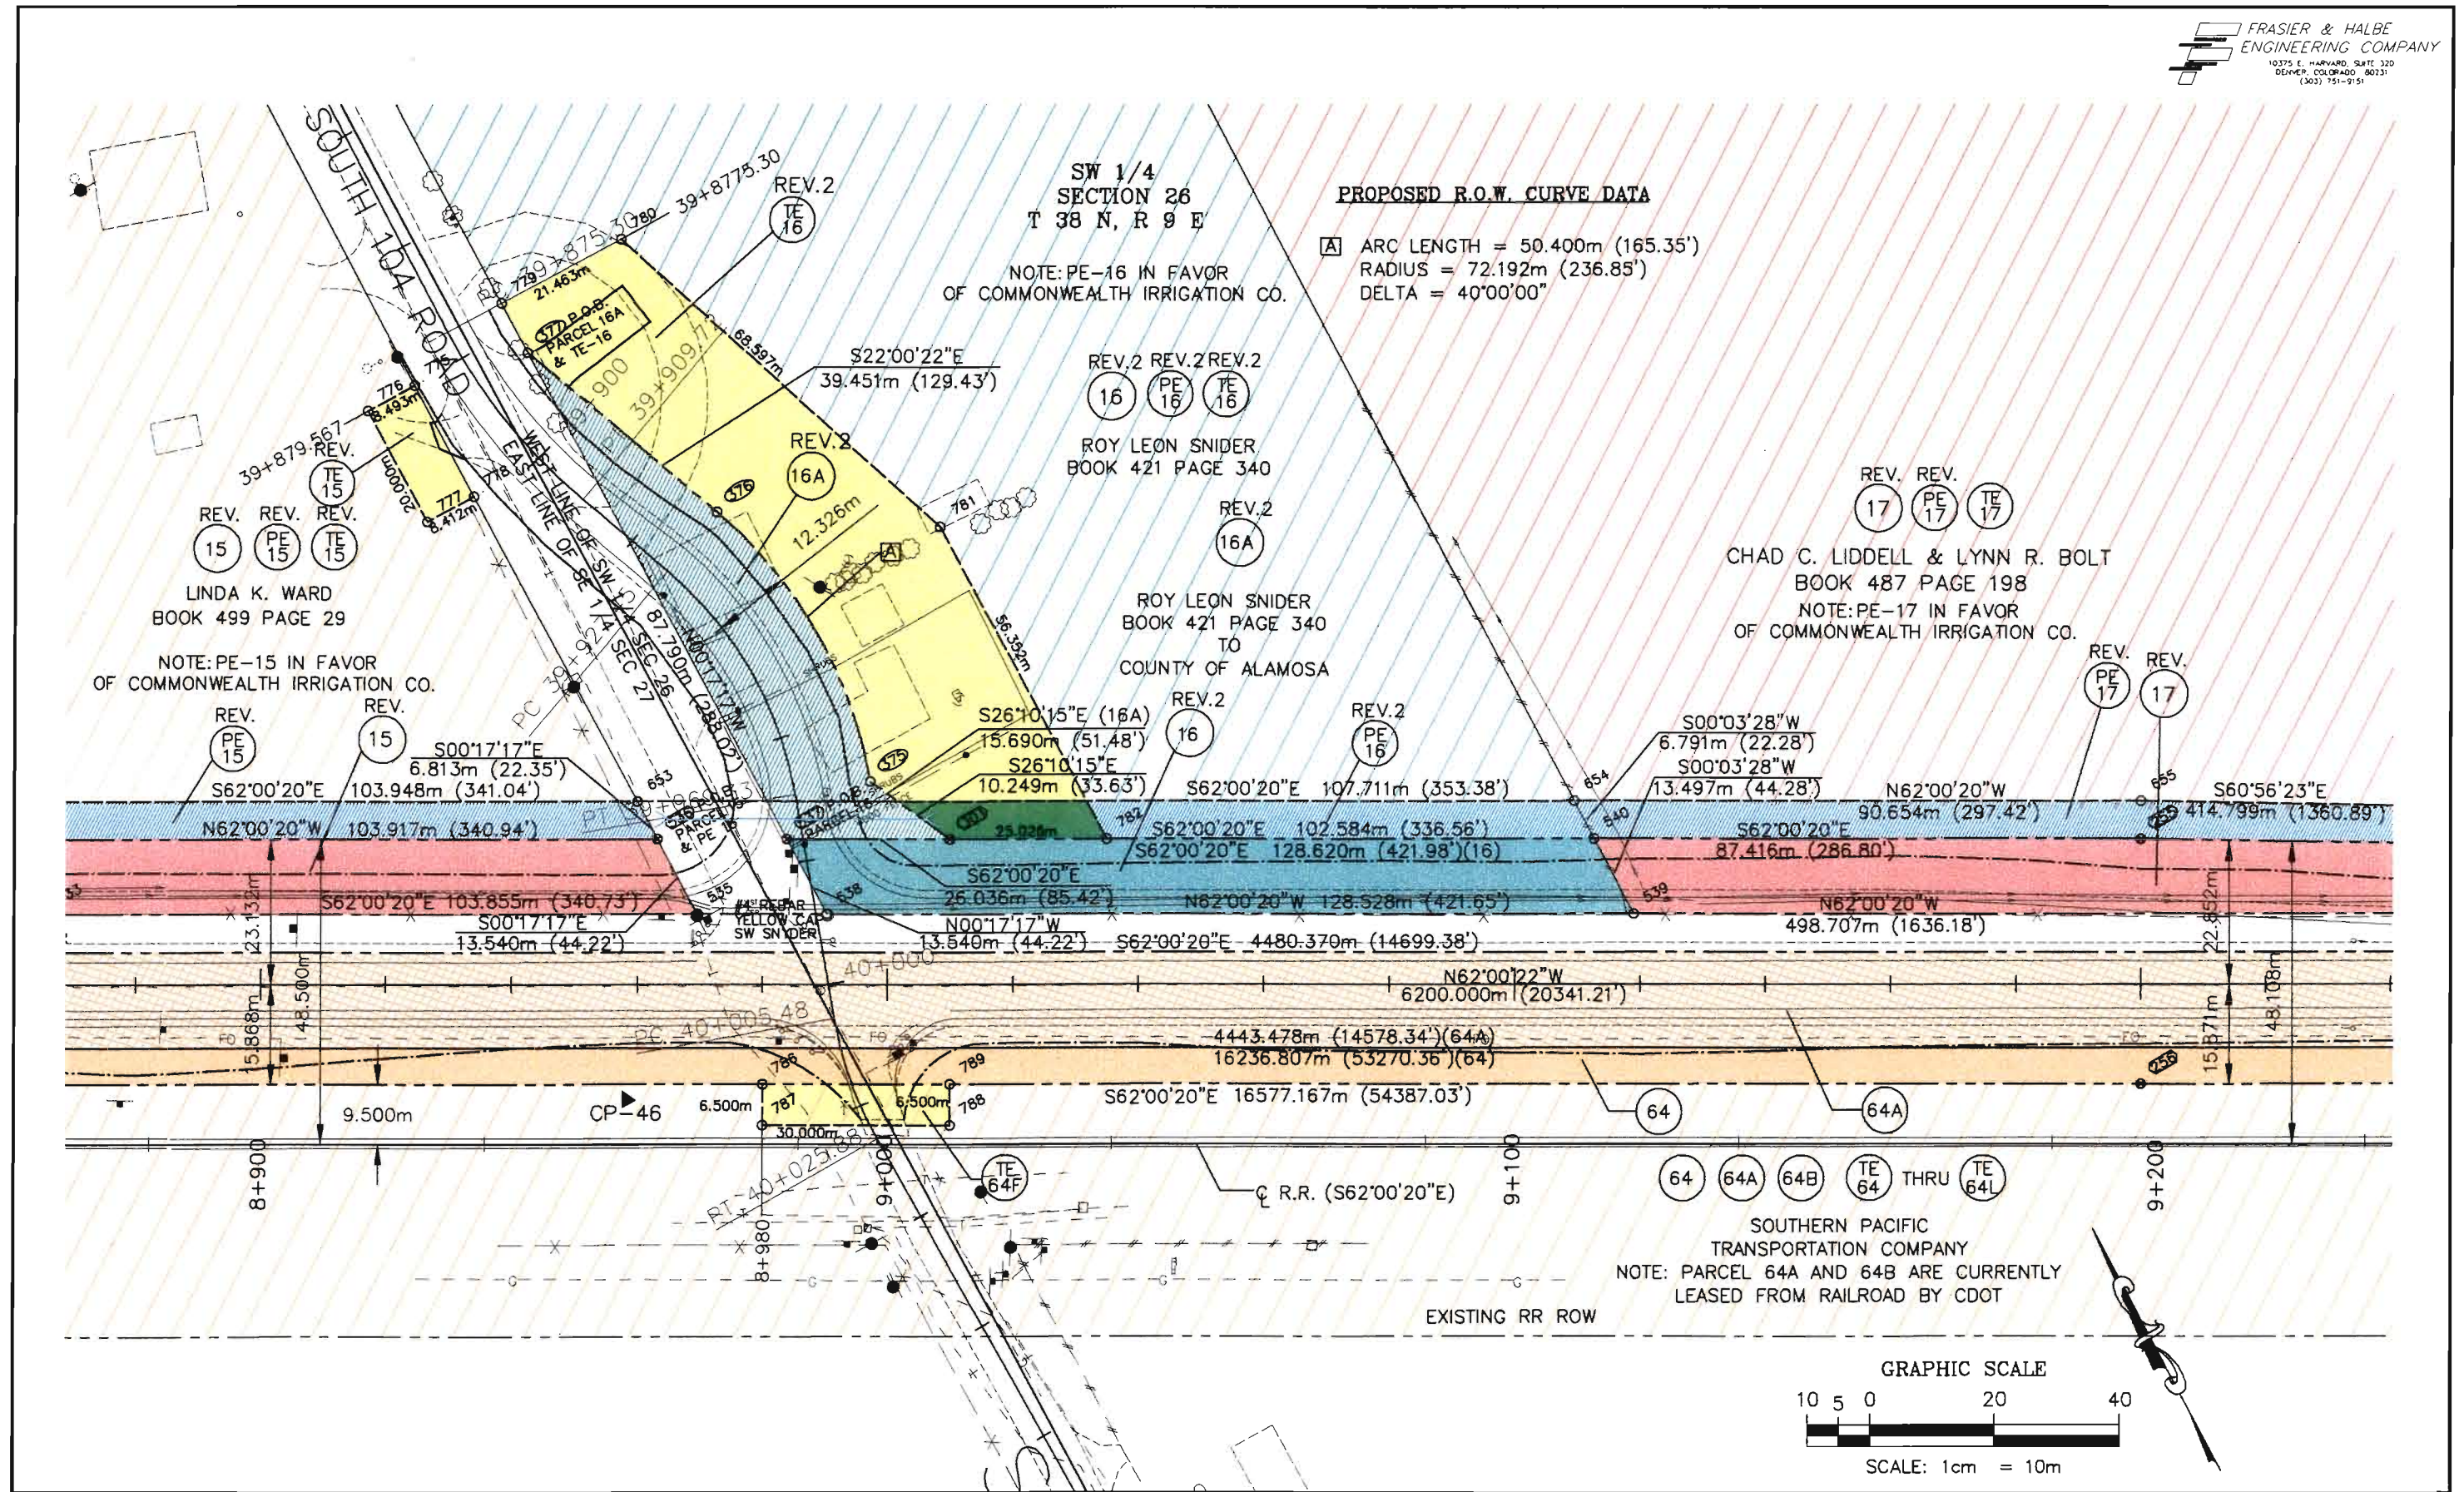

 Computer File Information		Index of Revisions		Colorado Department of Transportation		As Constructed		RIGHT-OF-WAY PLAN SHEET		Project No./Code	
Creation Date: 07/22/97 Initials: JRY		☐ R1	12/1/97	PARCEL 16, 16A, PE-16	EDC	No Revisions:		C. R. 6E TO CRAFT DR.		NH 1602-058	
Last Modification Date: 12/24/97 Initials: JRY		☐		TE-16		 3803 North Main Avenue, Suite 300 Durango, Colorado 81301 Phone: 970-385-1400 FAX: 970-385-1410		Designer:		10578	
Full Path: BEAST F:\JOBS\CDOT\5657-003\PHASE-ONE		☐ R2A	4/20/98	15 & 16-ALL PARCELS,	EDC			Detailer: JRY			
Drawing File Name: P-1Rowplan3.DWG		☐		17, PE-17		Void:		Sheet Subset: R.O.W.		Subset Sheets: 26 OF 46	
Acad Ver. R14 Scale: 1:1000 Units: METRIC		☐				Region 5				Sheet Number: 30	

SW 1/4
SECTION 26
T 38 N, R 9 E

REV. 17 REV. PE 17 TE 17
CHAD C. LIDDELL & LYNN R. BOLT
BOOK 487 PAGE 198
NOTE: PE-17 IN FAVOR
OF COMMONWEALTH IRRIGATION CO.

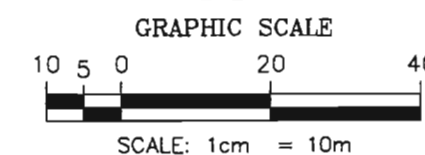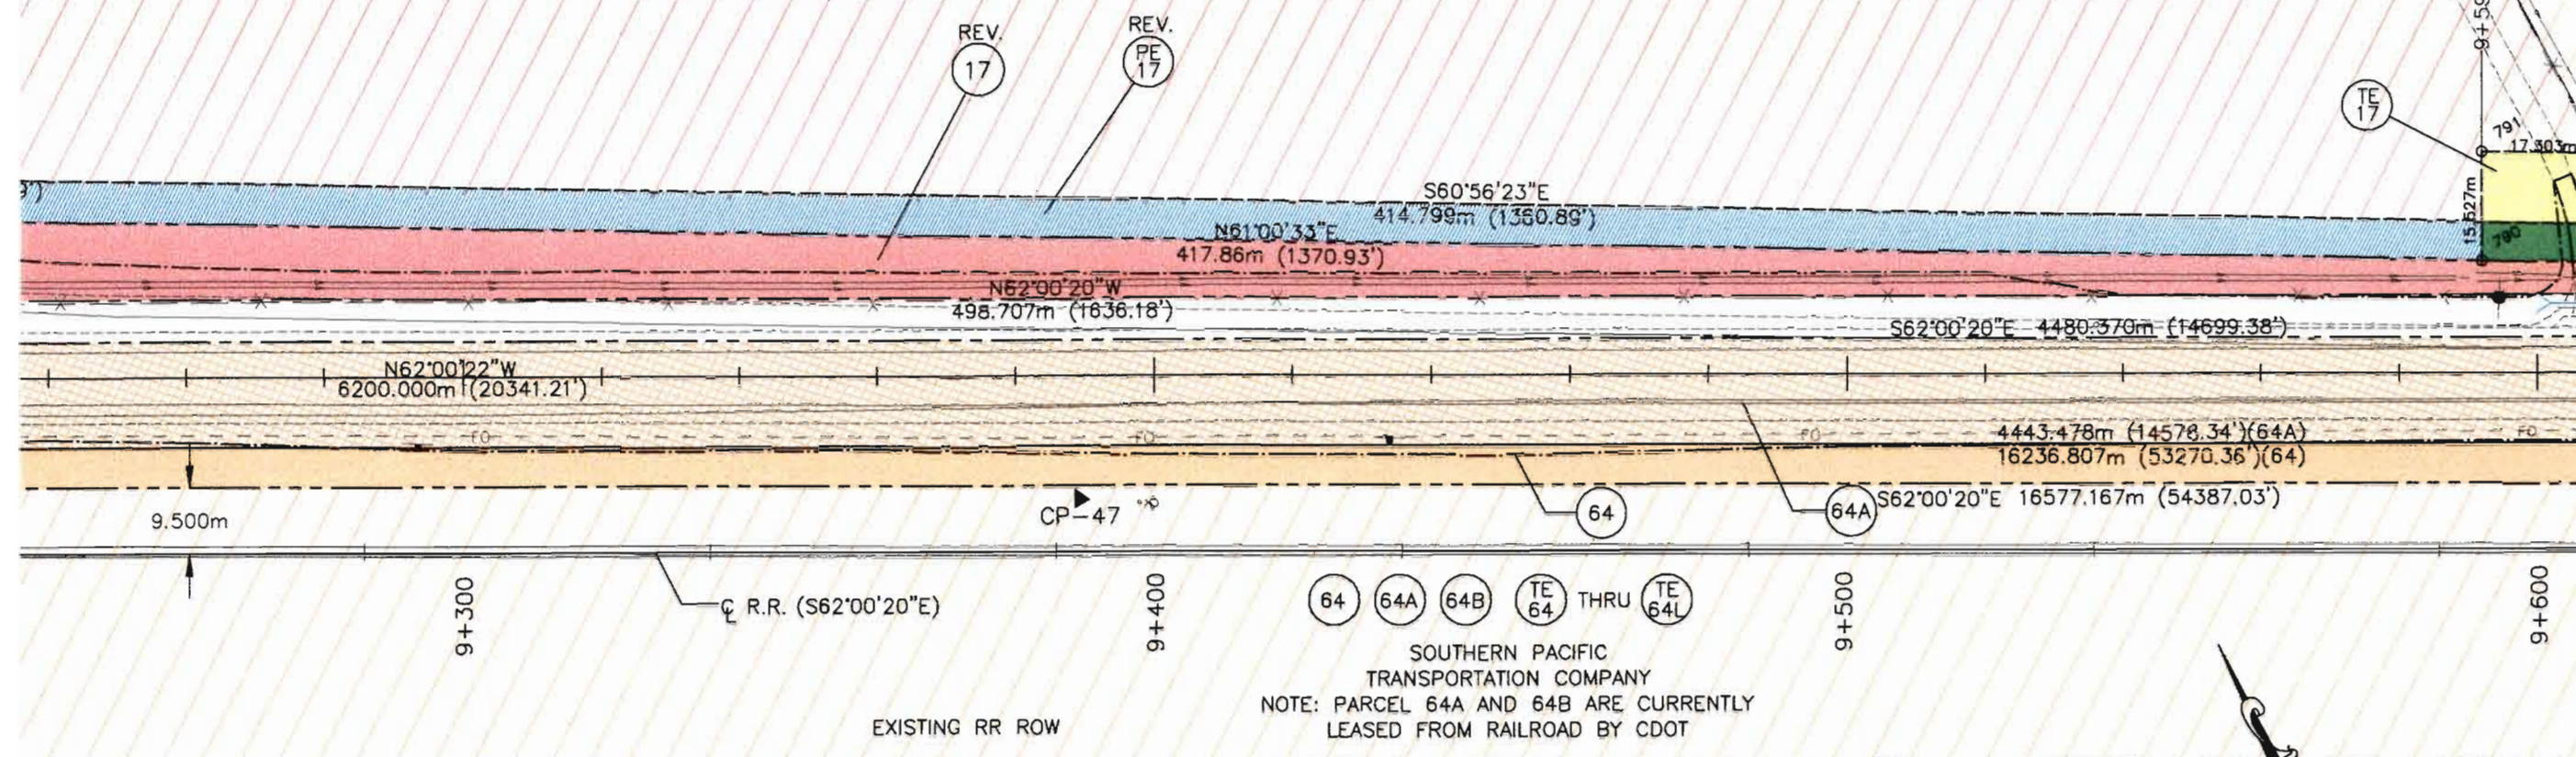


Computer File Information		Index of Revisions			As Constructed		RIGHT-OF-WAY PLAN SHEET		Project No./Code	
Creation Date: 07/22/97	Initials: JRY	(R2A)	4/20/98	PARCELS 17 & PE-17	EDC	No Revisions:	C. R. 6E TO CRAFT DR.			NH 1602-058
Last Modification Date: 12/24/97	Initials: JRY						Revised:	Designer:		10578
Full Path: BEAST F:\JOBS\CDOT\5657-003\PHASE-ONE								Detailer: JRY		
Drawing File Name: P-1Rowplan3.DWG							Void:	Sheet Subset: R.O.W.	Subset Sheets: 27 OF 46	Sheet Number: 31
Acad Ver. R14	Scale: 1:1000	Units: METRIC								




Colorado Department of Transportation
Region 5

3803 North Main Avenue, Suite 300
Durango, Colorado 81301
Phone: 970-385-1400 FAX: 970-385-1410

Colorado Department of Transportation
3803 North Main Avenue, Suite 300
Durango, Colorado 81301
Phone: 970-385-1400 FAX: 970-385-1410
Region 5

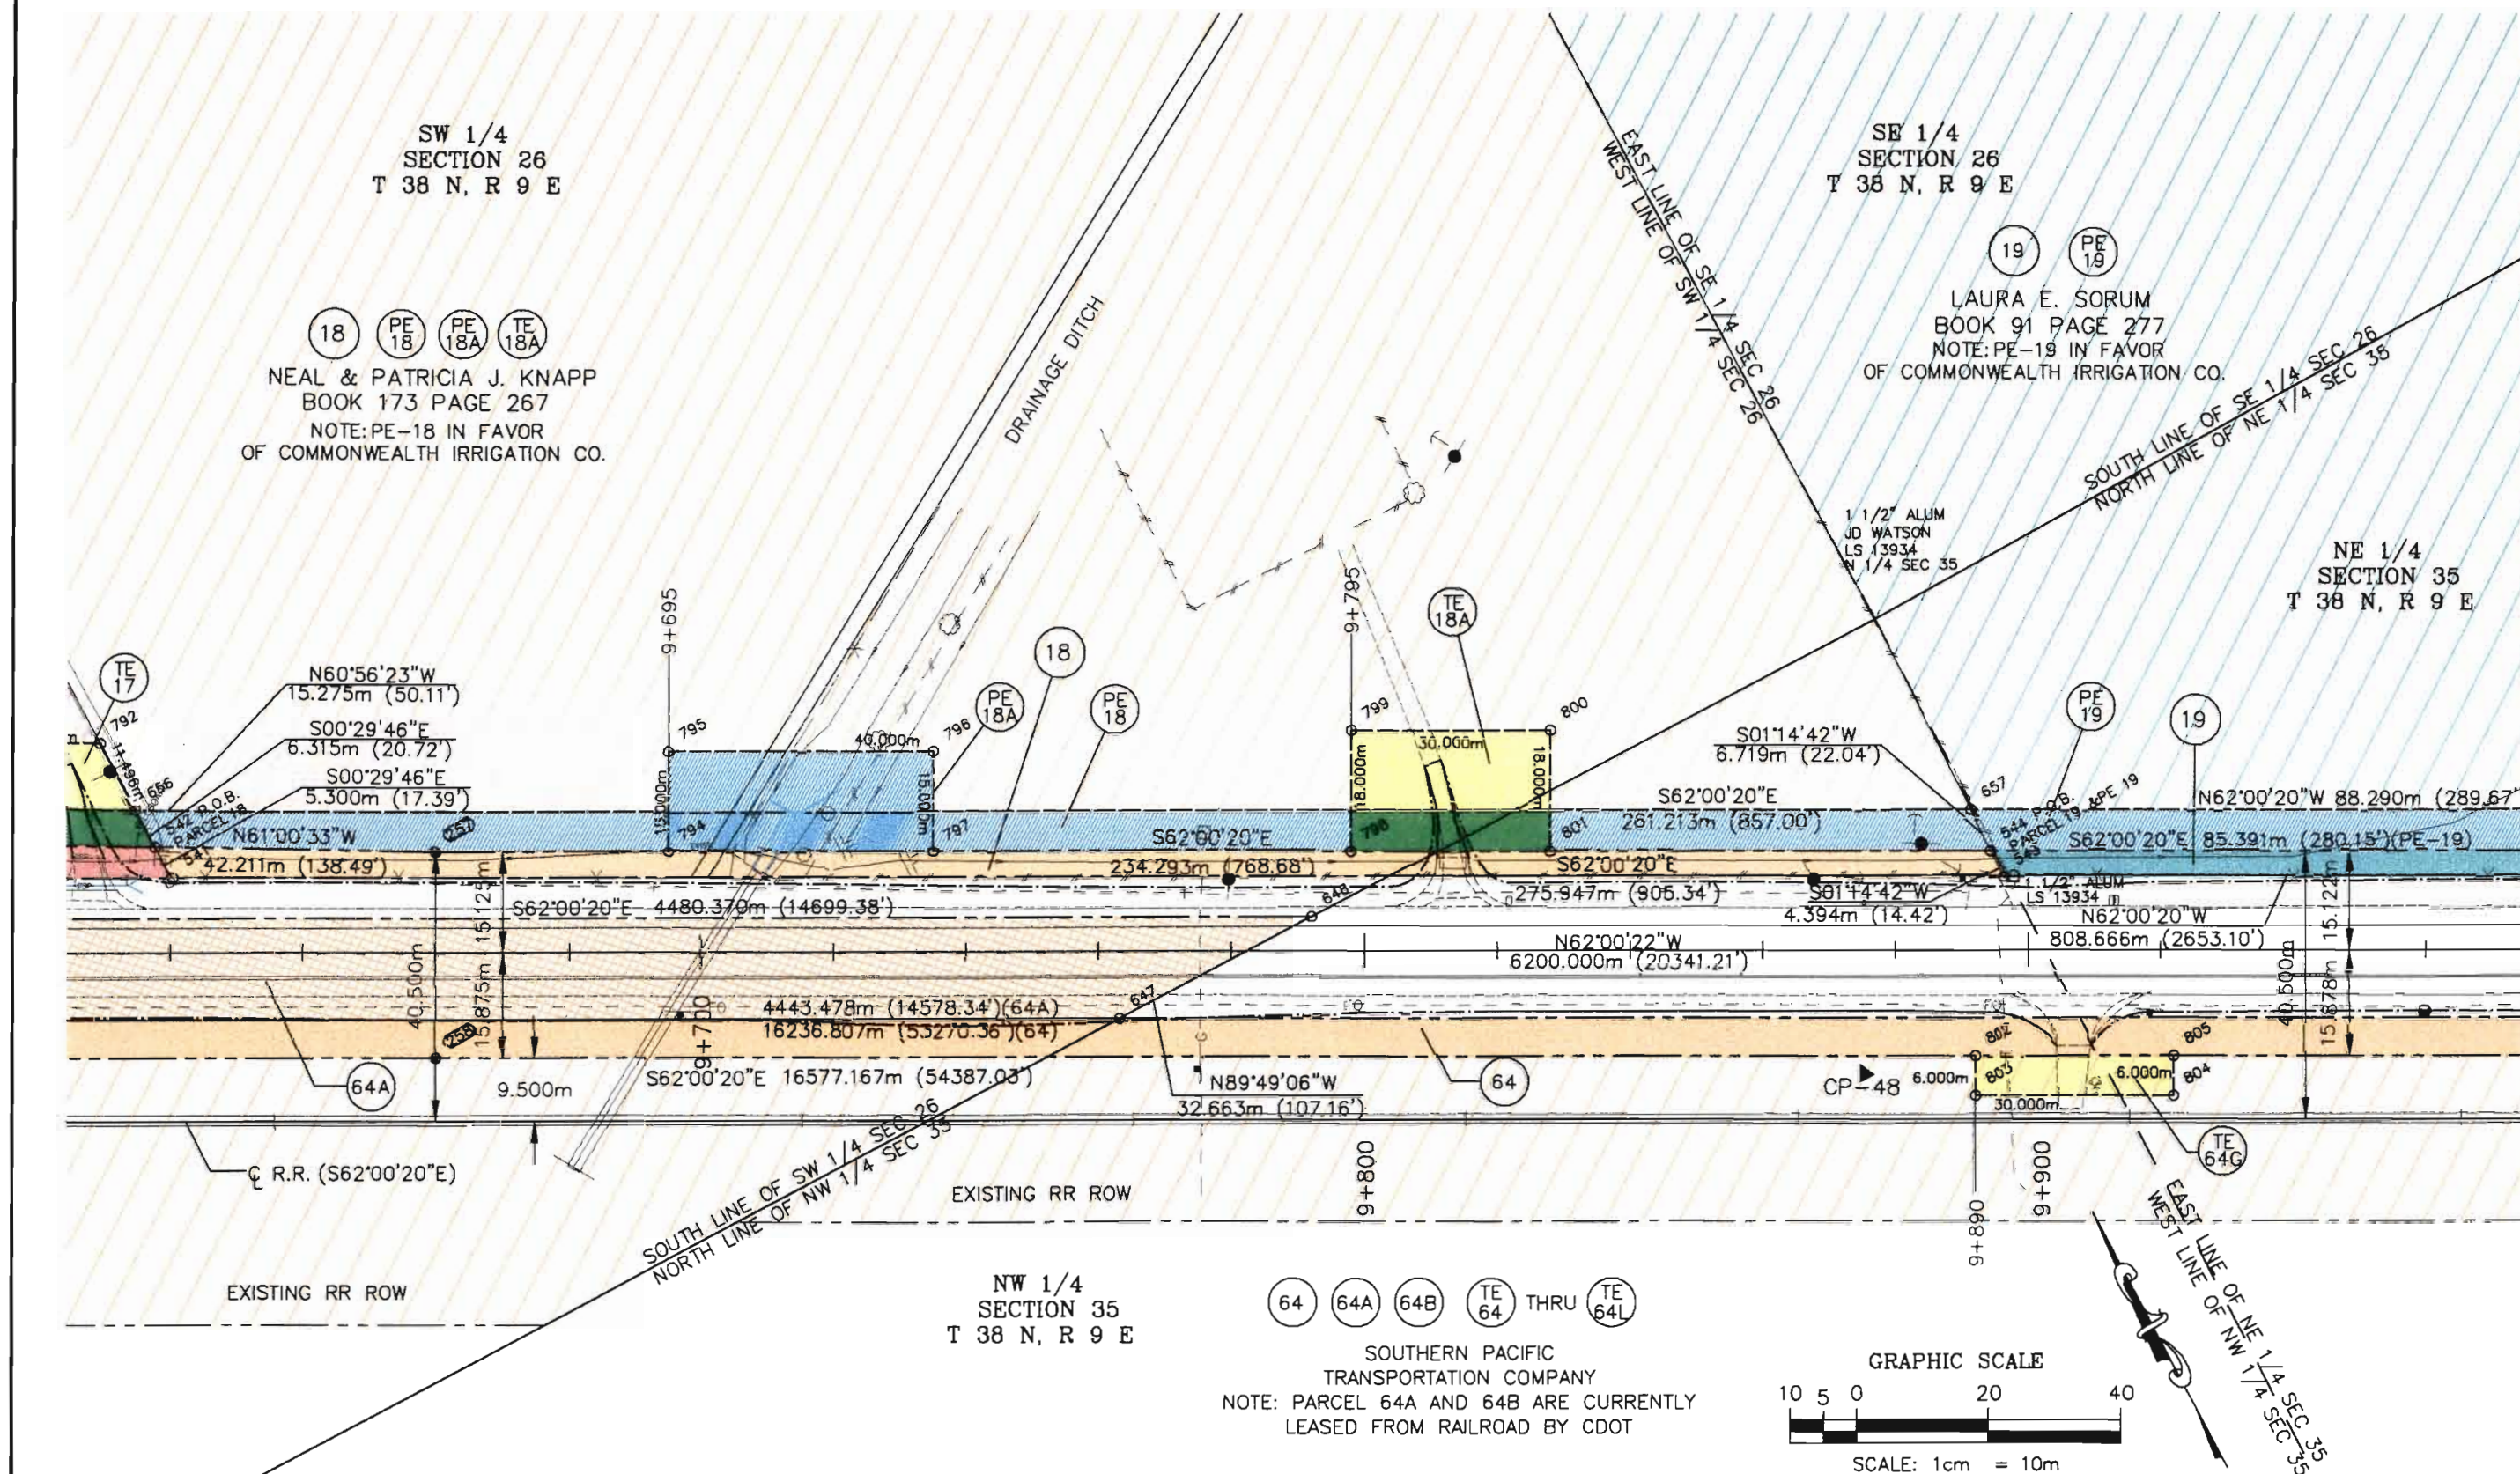

Computer File Information		Index of Revisions			Colorado Department of Transportation		As Constructed		RIGHT-OF-WAY PLAN SHEET		Project No./Code	
Creation Date: 07/22/97	Initials: JRY	(R2A)	4/20/98	PARCEL PE-18A	EDC	 3803 North Main Avenue, Suite 300 Durango, Colorado 81301 Phone: 970-385-1400 FAX: 970-385-1410 Region 5	No Revisions:		C. R. 6E TO CRAFT DR.		NH 1602-058	
Last Modification Date: 12/24/97	Initials: JRY						Revised:		Designer:		10578	
Full Path: BEAST F:\JOBS\CDOT\5657-003\PHASE-ONE							Void:		Detailer: JRY		Sheet Number: 32	
Drawing File Name: P-1Rowplan3.DWG									Sheet Subset: R.O.W.	Subset Sheets: 28 OF 46		
Acad Ver. R14	Scale: 1:1000	Units: METRIC										

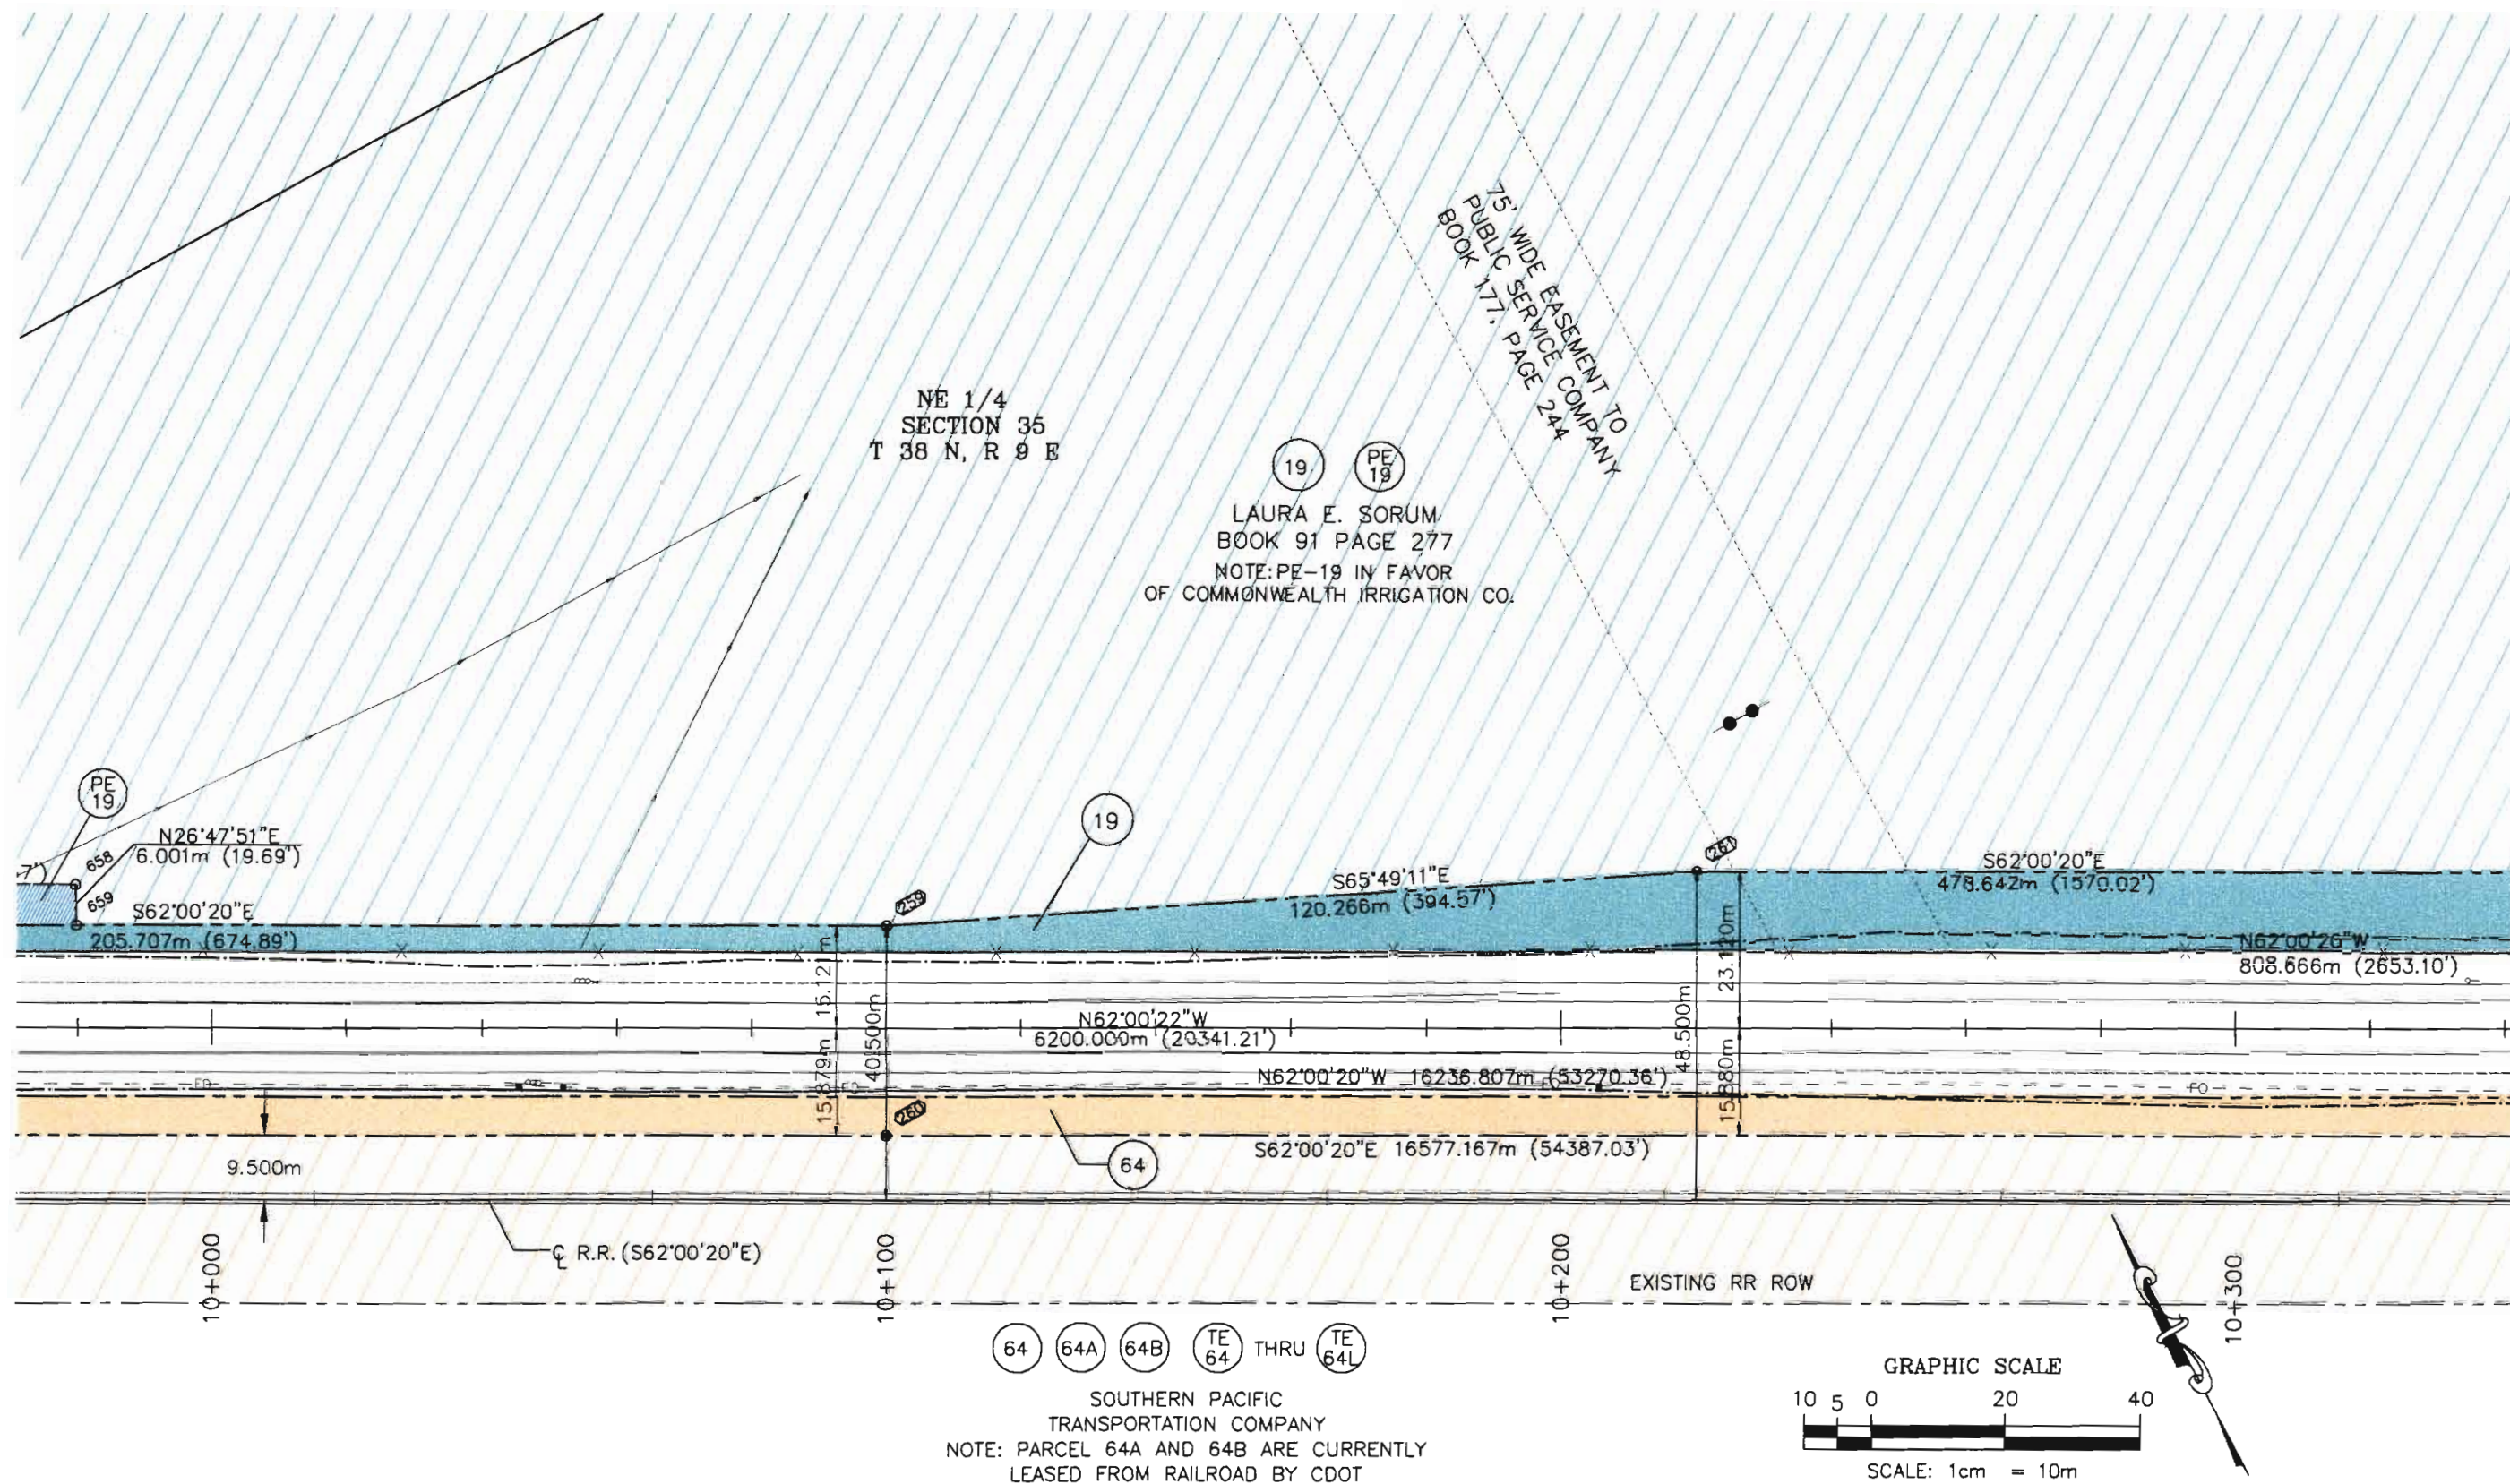


Computer File Information			Index of Revisions		Colorado Department of Transportation DOT DEPARTMENT OF TRANSPORTATION Region 5 3803 North Main Avenue, Suite 300 Durango, Colorado 81301 Phone: 970-385-1400 FAX: 970-385-1410	As Constructed		RIGHT-OF-WAY PLAN SHEET		Project No./Code	
Creation Date: 07/22/97 Initials: JRY						No Revisions:		C. R. 6E TO CRAFT DR.		NH 1602-058	
Last Modification Date: 12/24/97 Initials: JRY						Revised:		Designer:		10578	
Full Path: BEAST F:\JOBS\CDOT\5657-003\PHASE-ONE						Void:		Detailer: JRY			
Drawing File Name: P-1Rowplan3.DWG								Sheet Subset: R.O.W.		Subset Sheets: 29 OF 46	
Acad Ver. R14 Scale: 1:1000 Units: METRIC								Sheet Number: 33			


NE 1/4
SECTION 35
T 38 N, R 9 E

19 PE
19

LAURA E. SORUM
BOOK 91 PAGE 277
NOTE: PE-19 IN FAVOR OF
COMMONWEALTH IRRIGATION CO.

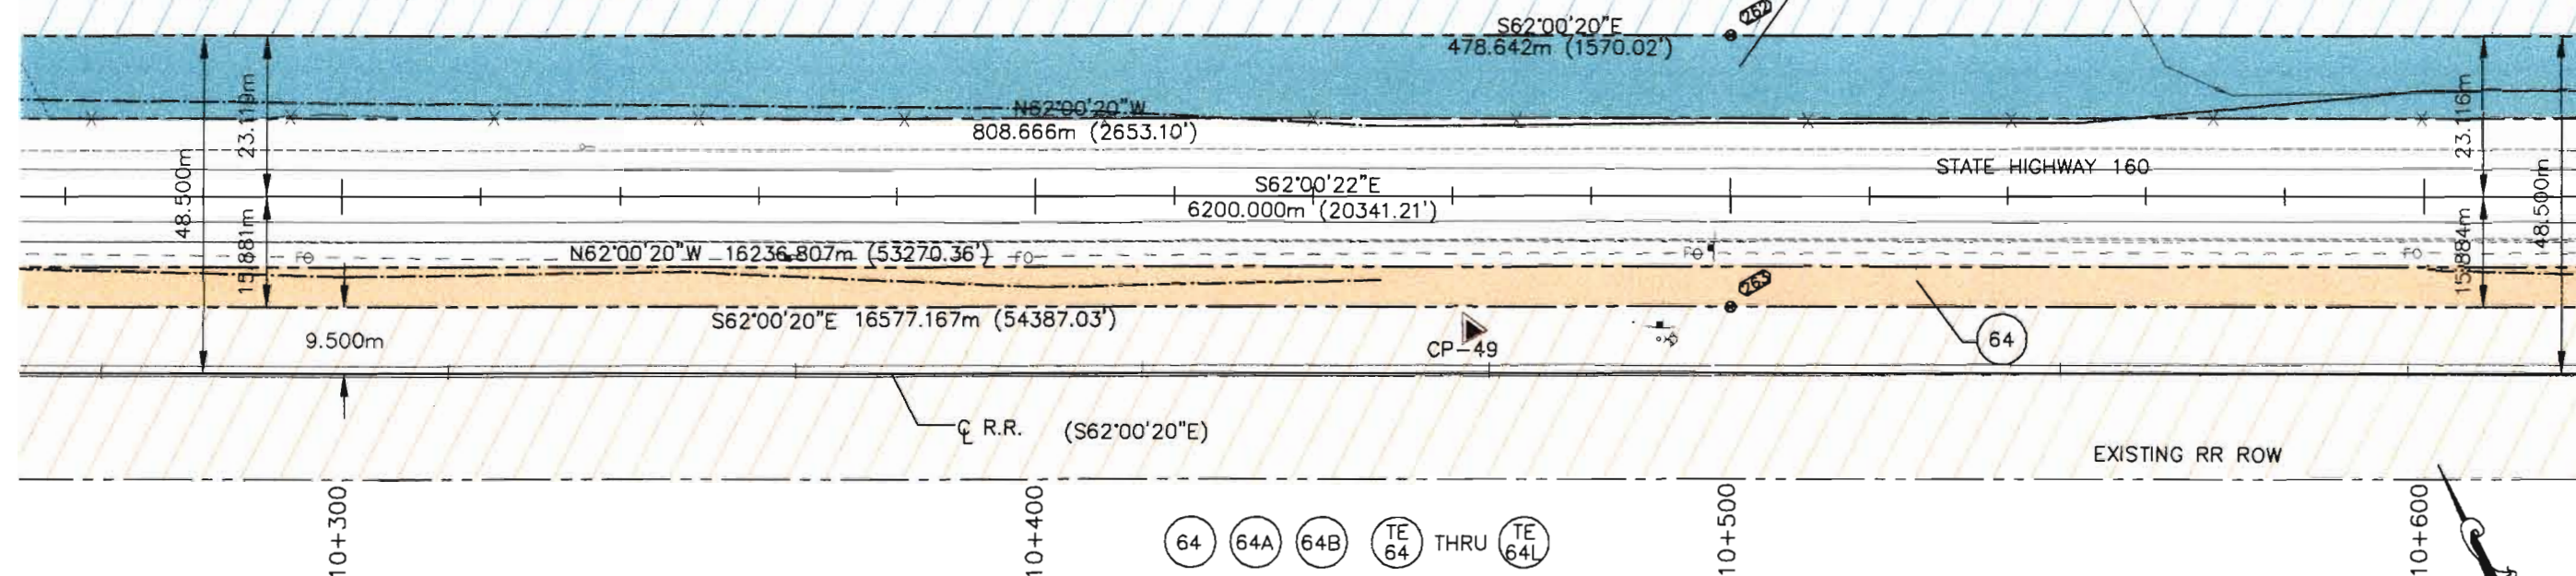

64 64A 64B TE 64 THRU TE 64L
SOUTHERN PACIFIC
TRANSPORTATION COMPANY
NOTE: PARCEL 64A AND 64B ARE CURRENTLY
LEASED FROM RAILROAD BY CDOT

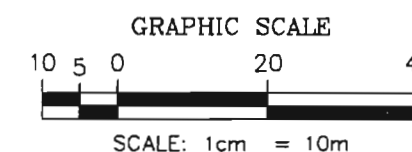

Computer File Information

Creation Date: 07/22/97 Initials: JRY
Lost Modification Date: 12/24/97 Initials: JRY
Full Path: BEAST F:\JOBS\CDOT\5657-003\PHASE-ONE
Drawing File Name: P-1ROW_PLAN2.DWG
Acad Ver. R14 Scale: 1:1000 Units: METRIC

Index of Revisions

00
00
00
00

Colorado Department of Transportation



Region 5

3803 North Main Avenue, Suite 300
Durango, Colorado 81301
Phone: 970-385-1400 FAX: 970-385-1410

As Constructed

No Revisions:

Revised:

Void:

RIGHT-OF-WAY PLAN SHEET

C. R. 6E TO CRAFT DR.

Designer:

Detailer: JRY

Sheet Subset: ROW


Subset Sheets: 30 of 46

Project No./Code


NH 1602-058

10578

Sheet Number: 34

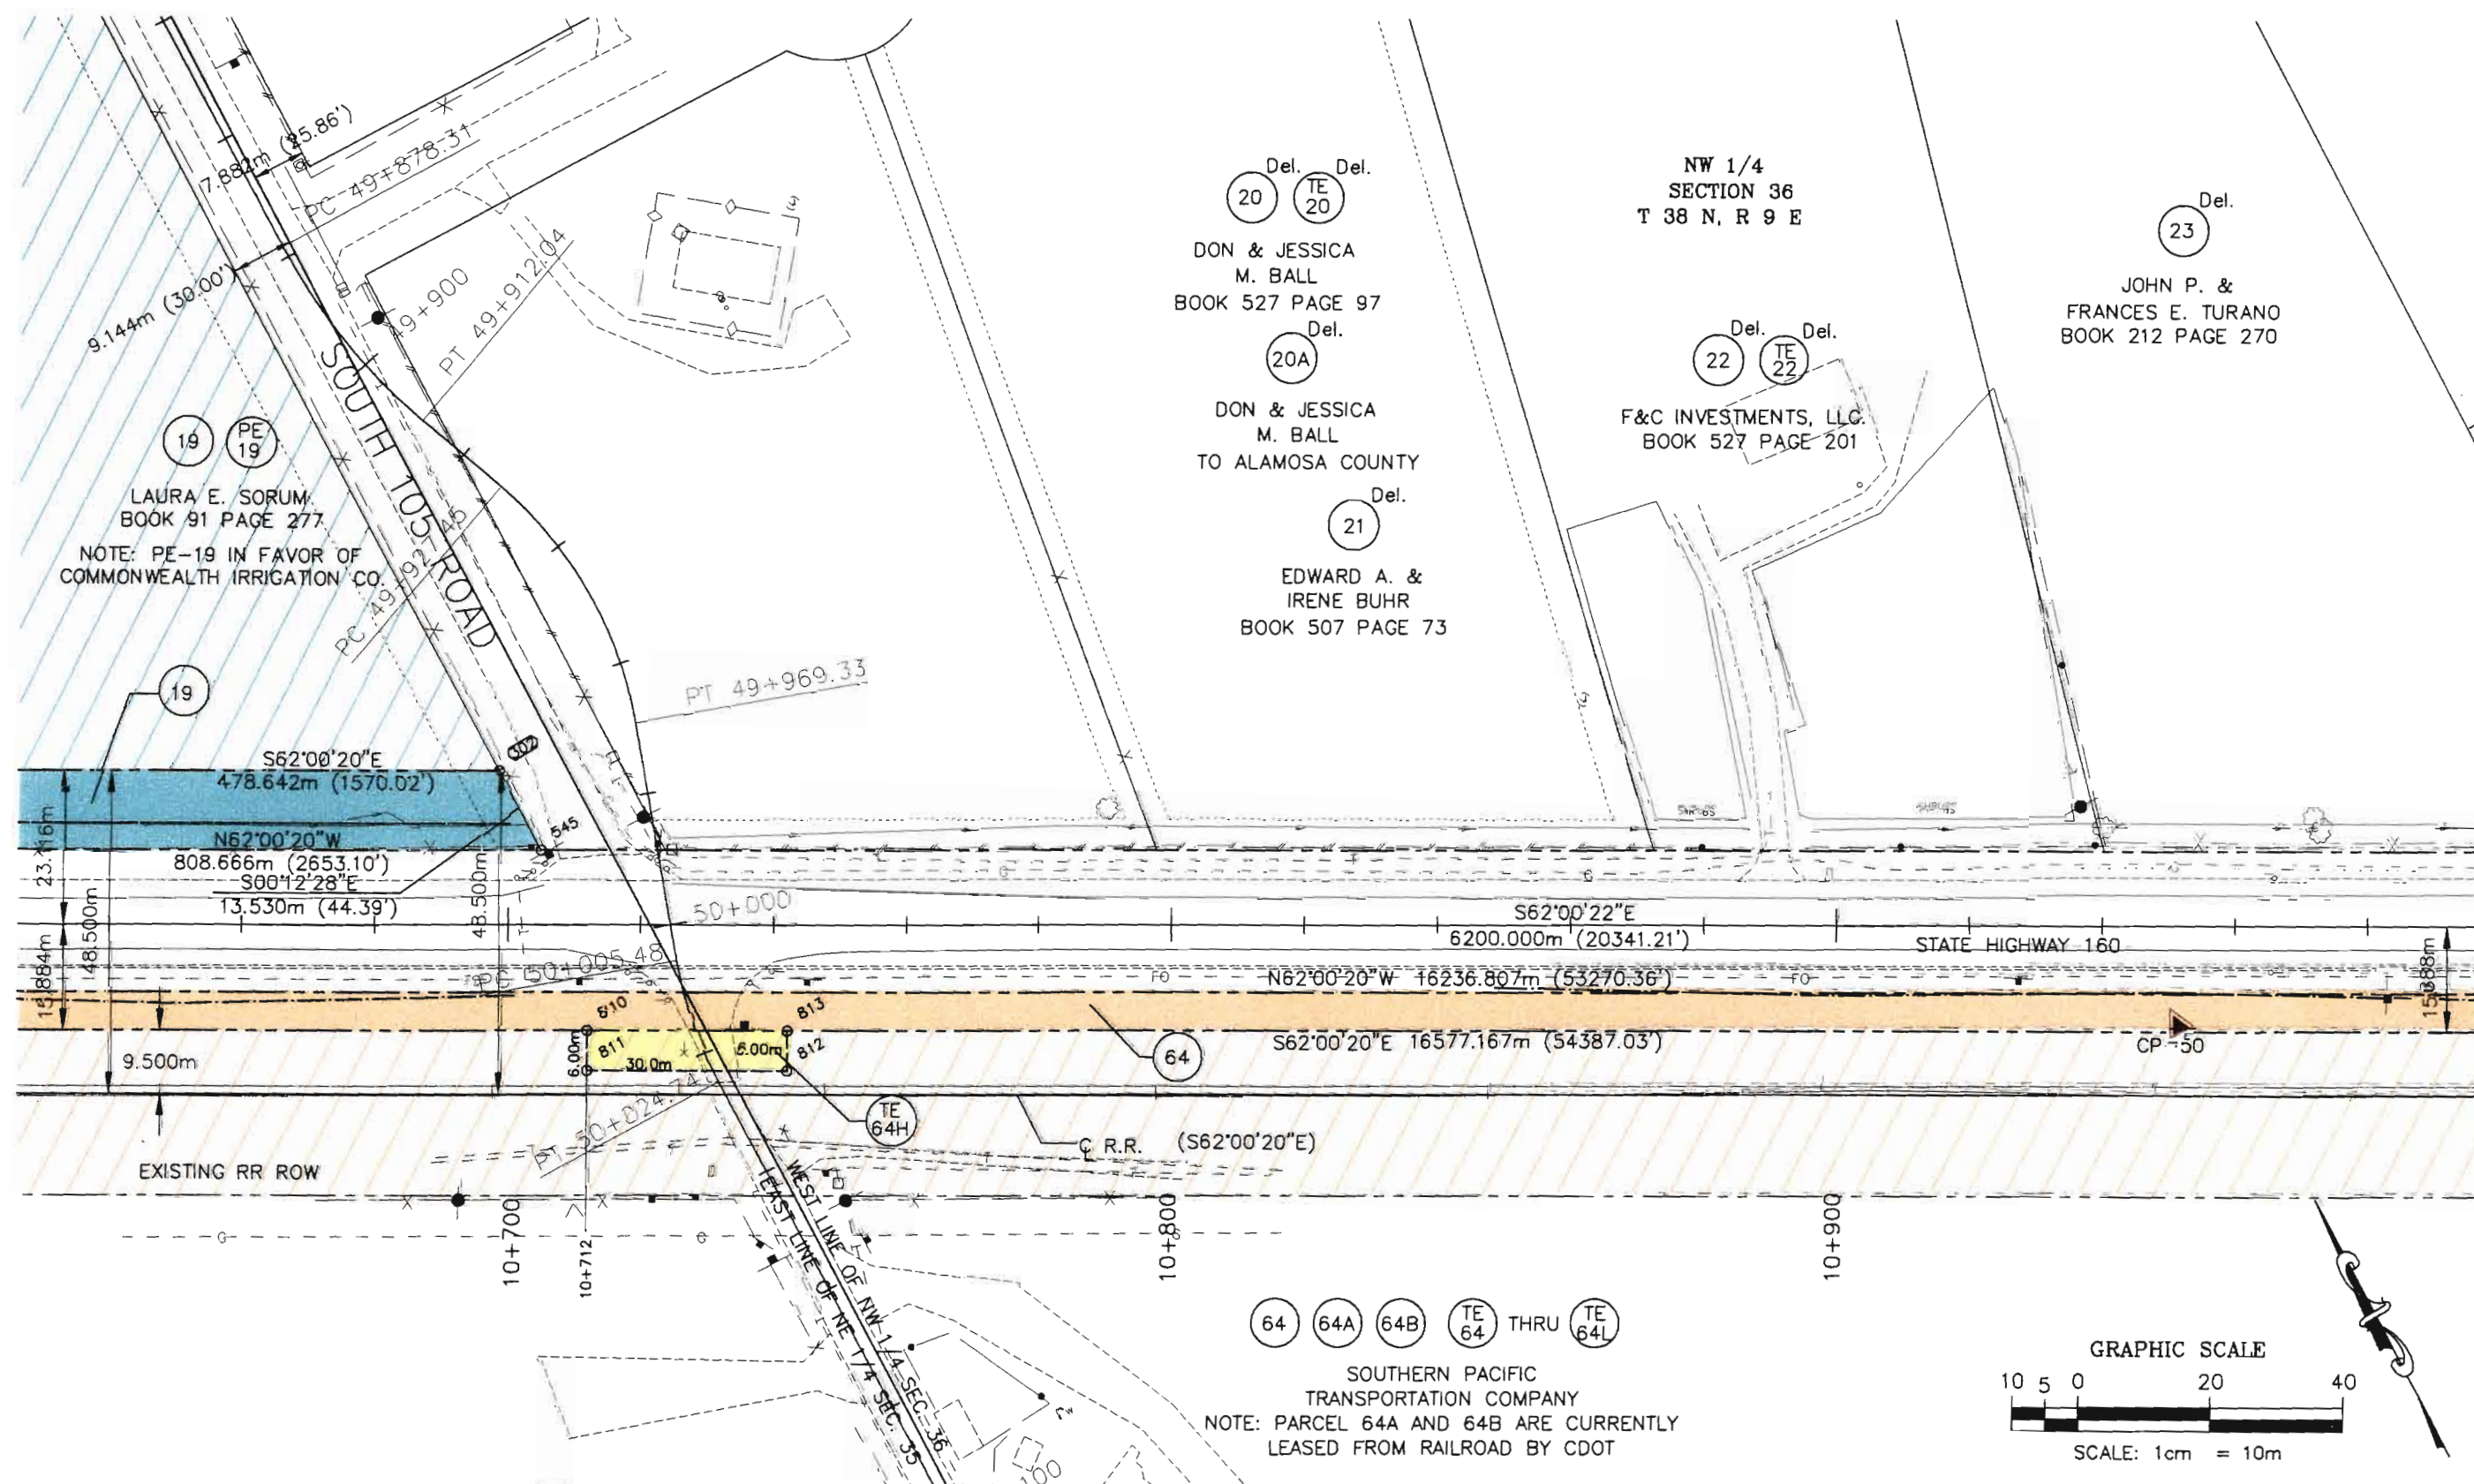

Computer File Information		Index of Revisions		Colorado Department of Transportation		As Constructed		RIGHT-OF-WAY PLAN SHEET		Project No./Code	
Creation Date: 07/22/97	Initials: JRY	(R2B) 5/11/98	DELETED PARCELS #20-23 et al.	EDC	 3803 North Main Avenue, Suite 300 Durango, Colorado 81301 Phone: 970-385-1400 FAX: 970-385-1410 Region 5	No Revisions:		C. R. 6E TO CRAFT DR.		NH 1602-058	
Last Modification Date: 12/24/97	Initials: JRY					Revised:		Designer:		10578	
Full Path: BEAST F:\JOBS\CDOT\5657-003\PHASE-ONE						Void:		Detailer: JRY		Sheet Number: 35	
Drawing File Name: P-1ROW_PLAN2.DWG								Sheet Subset: ROW	Subset Sheets: 31 of 46		
Scale: 1:1000	Units: METRIC										

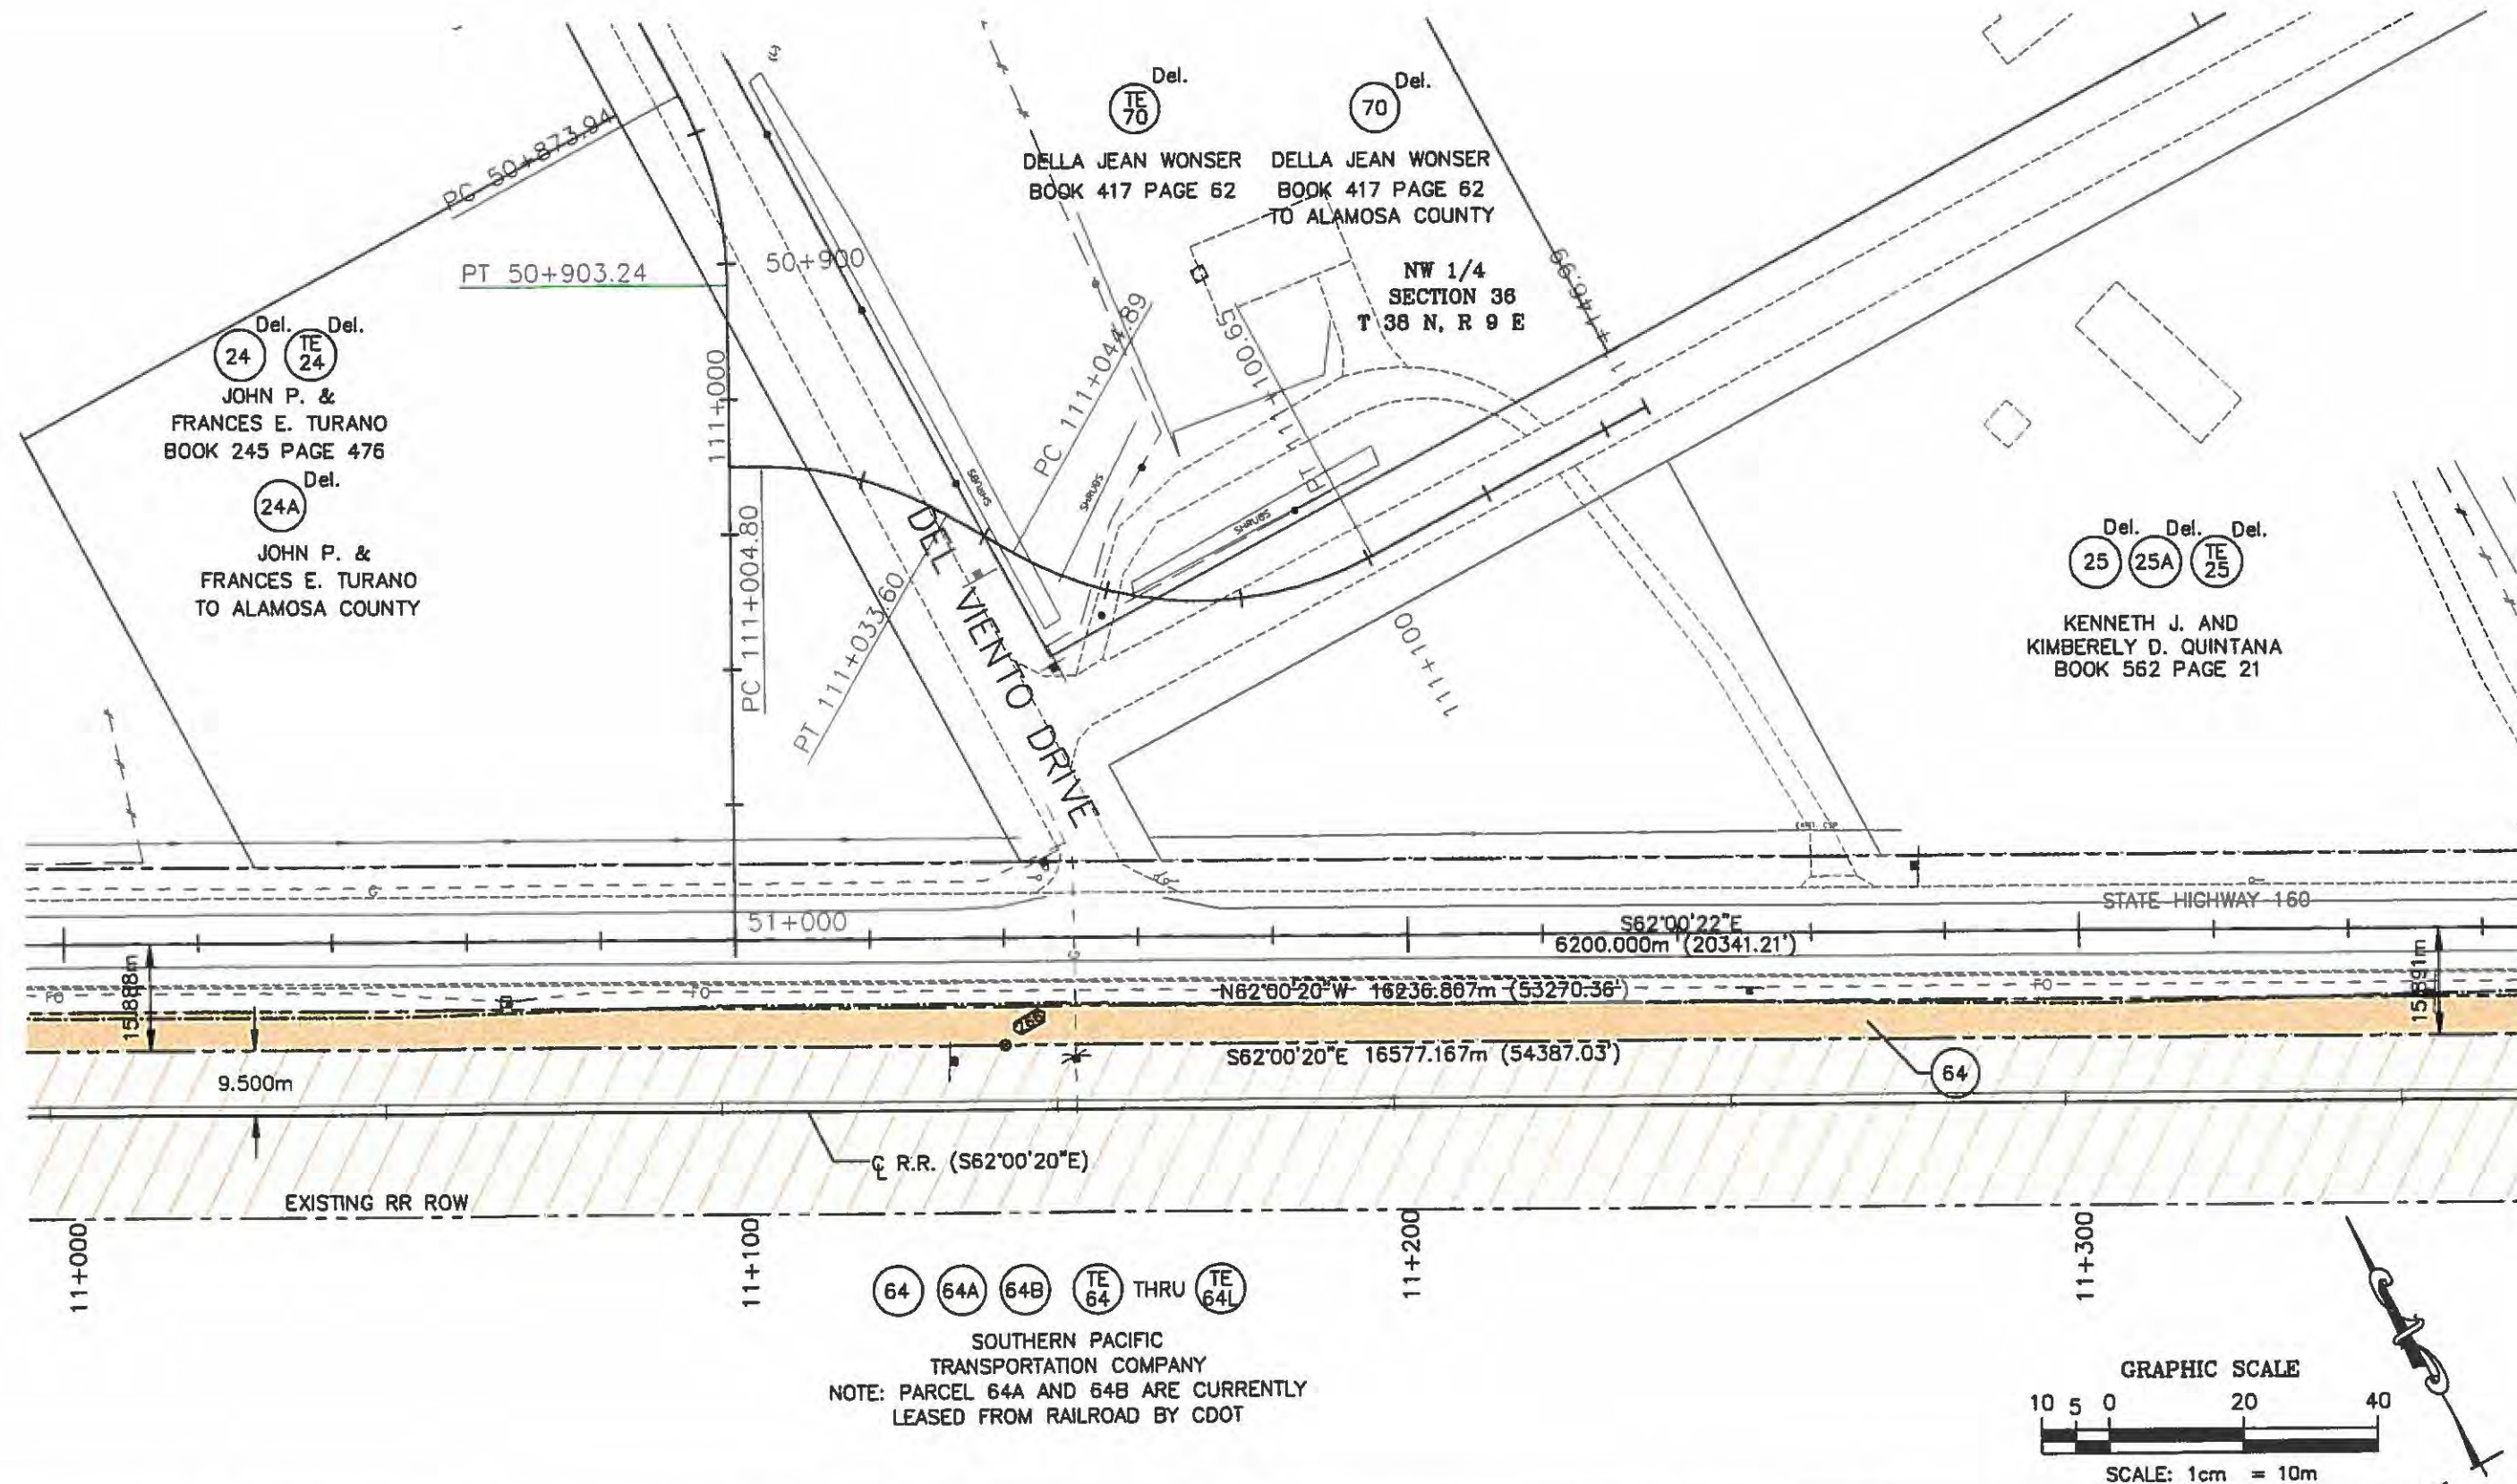

Computer File Information		Index of Revisions		Colorado Department of Transportation		As Constructed		RIGHT-OF-WAY PLAN SHEET		Project No./Code	
Creation Date: 07/22/97	Initials: JRY	5/11/98	DELETED PARCELS #24-25, & 70 et al.	EDC	 3803 North Main Avenue, Suite 300 Durango, Colorado 81301 Phone: 970-385-1400 FAX: 970-385-1410 Region 5	No Revisions:		C. R. 6E TO CRAFT DR.		NH 1602-058	
Last Modification Date: 12/24/97	Initials: JRY					Revised:		Designer:		10578	
Full Path: BEAST F:\JOBS\CDOT\5657-003\PHASE-ONE						Void:		Detailer: JRY		Sheet Number: 36	
Drawing File Name: P-1ROW_PLAN2.DWG								Sheet Subst: ROW		Subset Sheets: 32 of 46	
Acad Ver. R14	Scale: 1:1000	Units: METRIC									

SE 1/4
SECTION 36
T 38 N, R 9 E

Del. Del. Del.
30 30A TE 30


A&J SOLAR AND ADOBE
CONSTRUCTION, INC.
BOOK 558 PAGE 267

Del.
31

A&J SOLAR AND ADOBE
CONSTRUCTION, INC.
BOOK 558 PAGE 267

Del. Del.
32 TE 32

RALPH H. OUTCALT
BOOK 243 PAGE 230

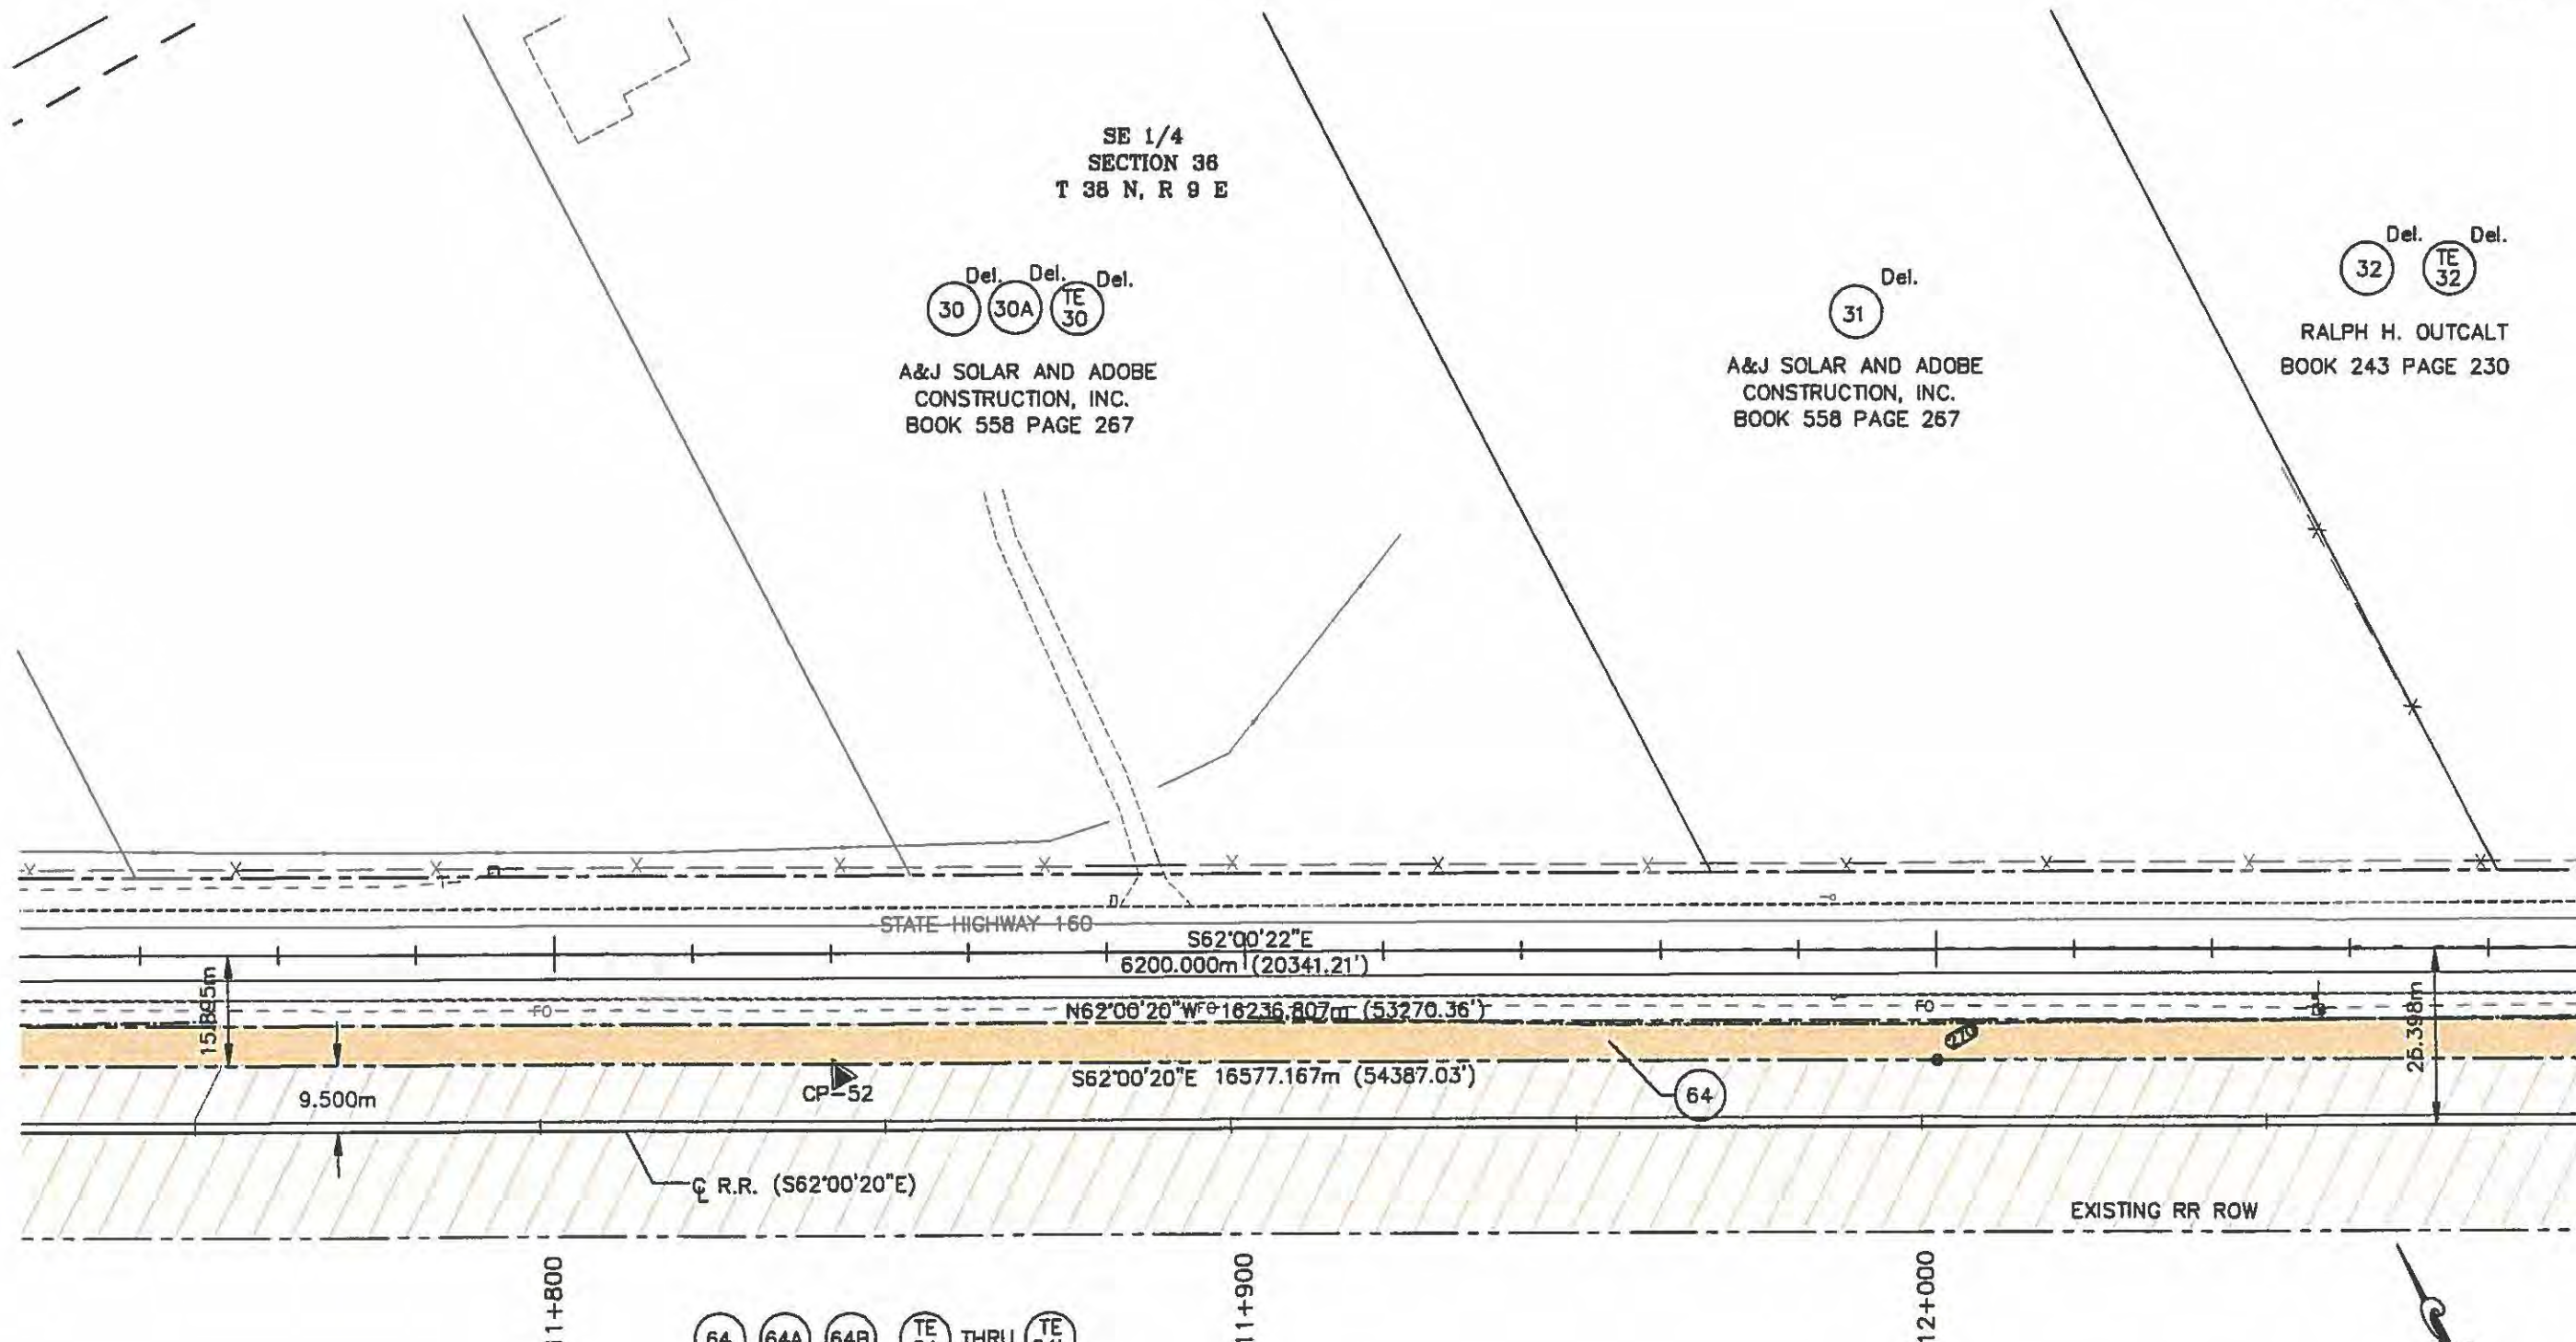


Computer File Information				Index of Revisions				Colorado Department of Transportation				As Constructed		RIGHT-OF-WAY PLAN SHEET				Project No./Code	
Creation Date: 07/22/97		Initials: JRY		R2B	5/11/98		DELETED PARCELS #30-32 et al.		EDC		 3803 North Main Avenue, Suite 300 Durango, Colorado 81301 Phone: 970-385-1400 FAX: 970-385-1410 Region 5	No Revisions:		C. R. 6E TO CRAFT DR.				NH 1602-058	
Last Modification Date: 12/24/97		Initials: JRY										Revised:		Designer:		10578			
Full Path: BEAST F:\JOBS\CDOT\5657-003\PHASE-ONE														Detailer: JRY					
Drawing File Name: P-1ROW_PLAN2.DWG																			
Acad Ver. R14		Scale: 1:1000												Sheet Subset: ROW		Subset Sheets: 34 of 46		Sheet Number: 38	
Units: METRIC																			

SE 1/4
SECTION 36
T 38 N, R 9 E


Del. Del.
32 TE 32
RALPH H. OUTCALT
BOOK 243 PAGE 230

Del.
33
DEAN WAYNE NESTER
BOOK 204 PAGE 194


Del.
34
ALAMOS WEST, INC.
BOOK 541 PAGE 161

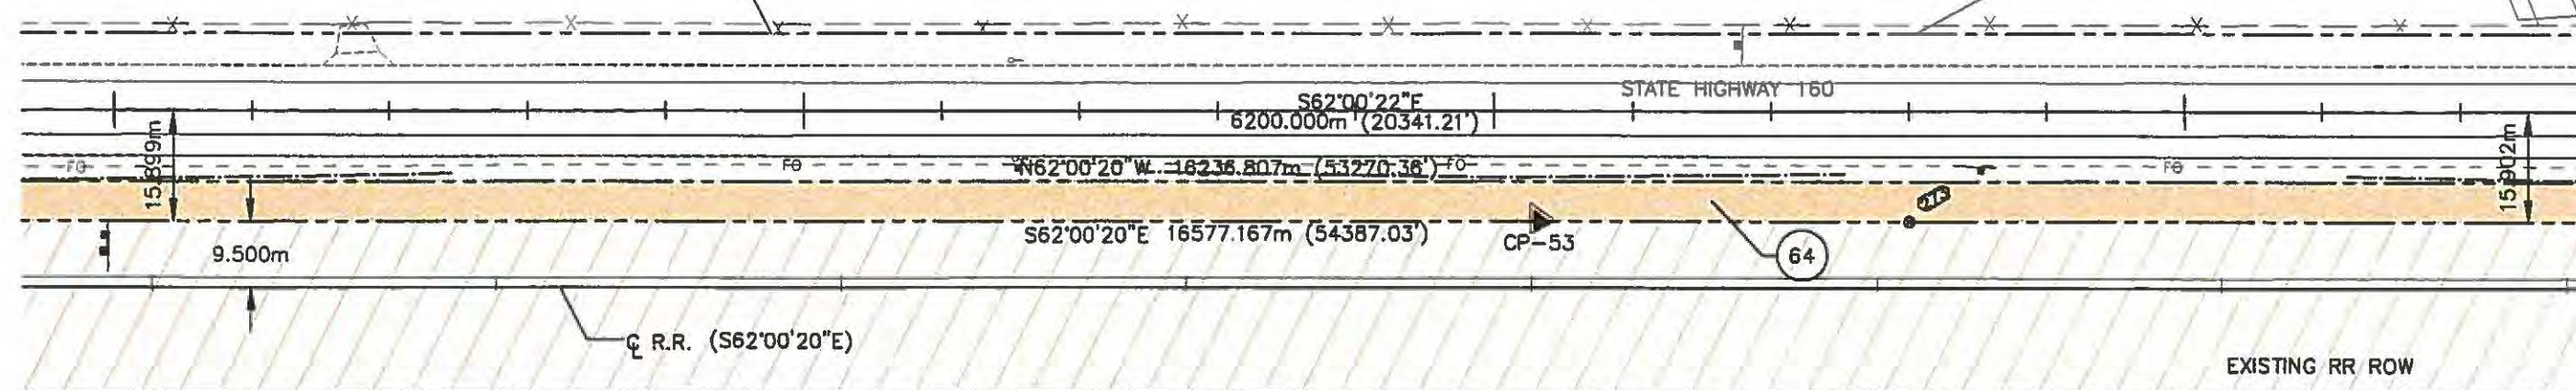


64 64A 64B TE 64 THRU TE 64L
SOUTHERN PACIFIC
TRANSPORTATION COMPANY
NOTE: PARCEL 64A AND 64B ARE CURRENTLY
LEASED FROM RAILROAD BY CDOT

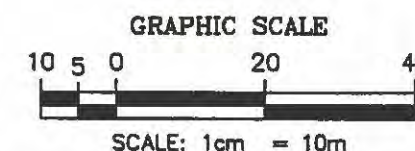


Computer File Information		Index of Revisions			Colorado Department of Transportation		As Constructed		RIGHT-OF-WAY PLAN SHEET		Project No./Code	
Creation Date: 07/22/97	Initials: JRY	(R2B)	5/11/98	DELETED PARCELS #32-34 et al.	EDC	 3803 North Main Avenue, Suite 300 Durango, Colorado 81301 Phone: 970-385-1400 FAX: 970-385-1410 Region 5	No Revisions:		C. R. 6E TO CRAFT DR.		NH 1602-058	
Last Modification Date: 12/24/97	Initials: JRY						Revised:		Designer:		10578	
Full Path: BEAST F:\JOBS\CDOT\5657-003\PHASE-ONE							Void:		Detailer: JRY			
Drawing File Name: P-1ROW_PLAN2.DWG									Sheet Subset: ROW	Subset Sheets: 35 of 46	Sheet Number: 39	
Acad Ver. R14	Scale: 1:1000	Units: METRIC										

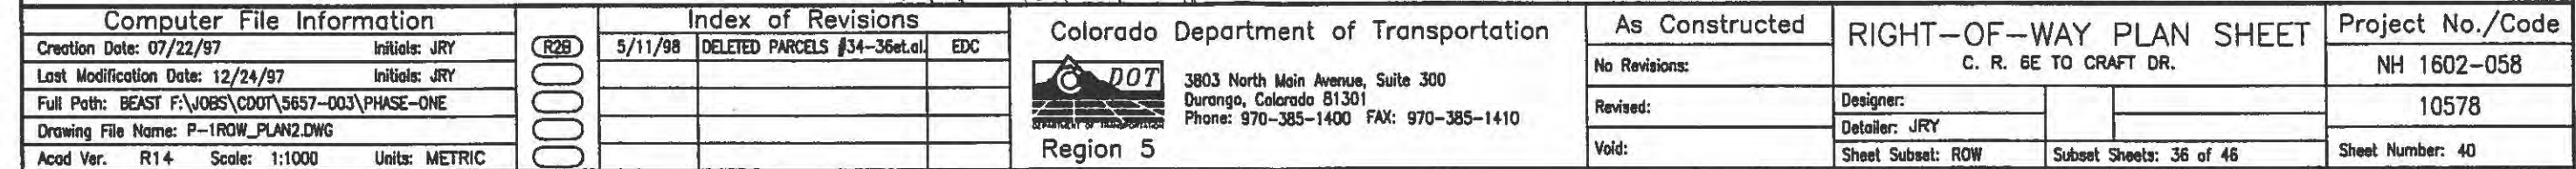


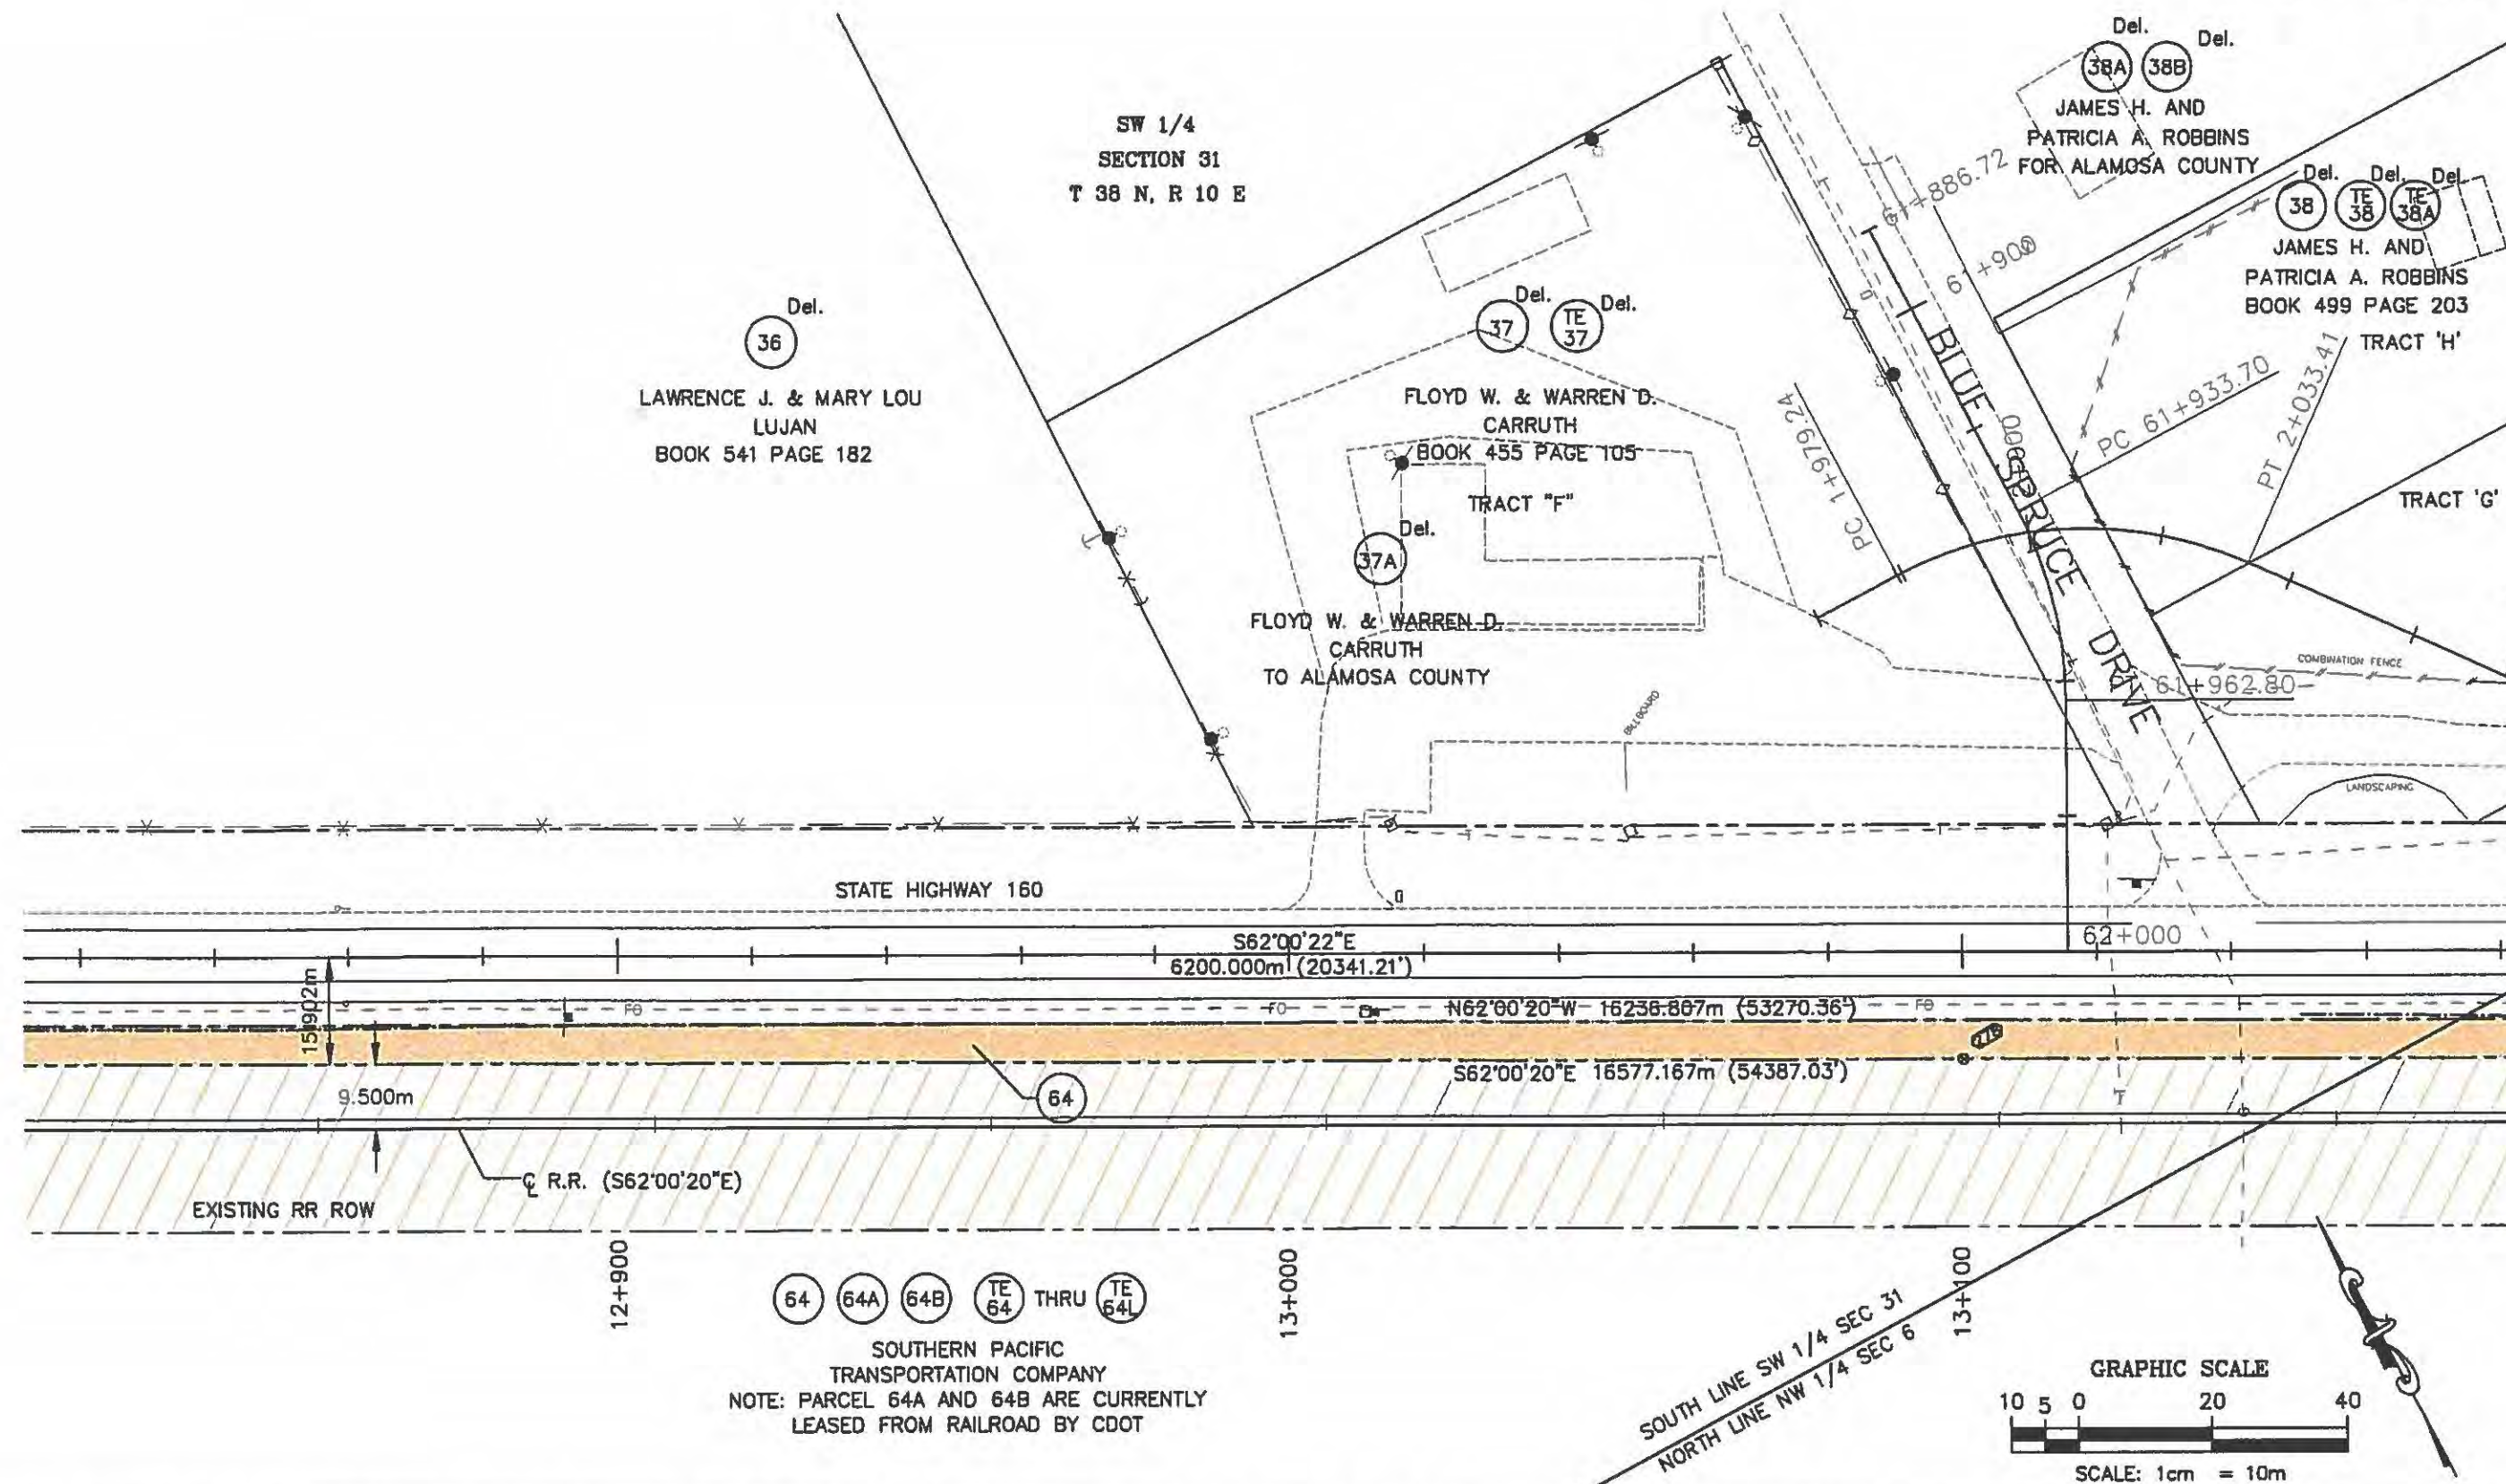

Computer File Information		Index of Revisions			Colorado Department of Transportation		As Constructed		RIGHT-OF-WAY PLAN SHEET		Project No./Code	
Creation Date: 07/22/97	Initials: JRY	(R28)	5/11/98	DELETED PARCELS #36-38et.al	EDC	 3803 North Main Avenue, Suite 300 Durango, Colorado 81301 Phone: 970-385-1400 FAX: 970-385-1410 Region 5	No Revisions:		C. R. 6E TO CRAFT DR.		NH 1602-058	
Last Modification Date: 12/24/97	Initials: JRY						Revised:		Designer:		10578	
Full Path: BEAST F:\JOBS\CDOT\5657-003\PHASE-ONE							Void:		Detailer: JRY		Sheet Number: 41	
Drawing File Name: P-1ROW_PLAN2.DWG									Sheet Subset: ROW	Subset Sheets: 37 of 46		
Acad Ver. R14	Scale: 1:1000	Units: METRIC										

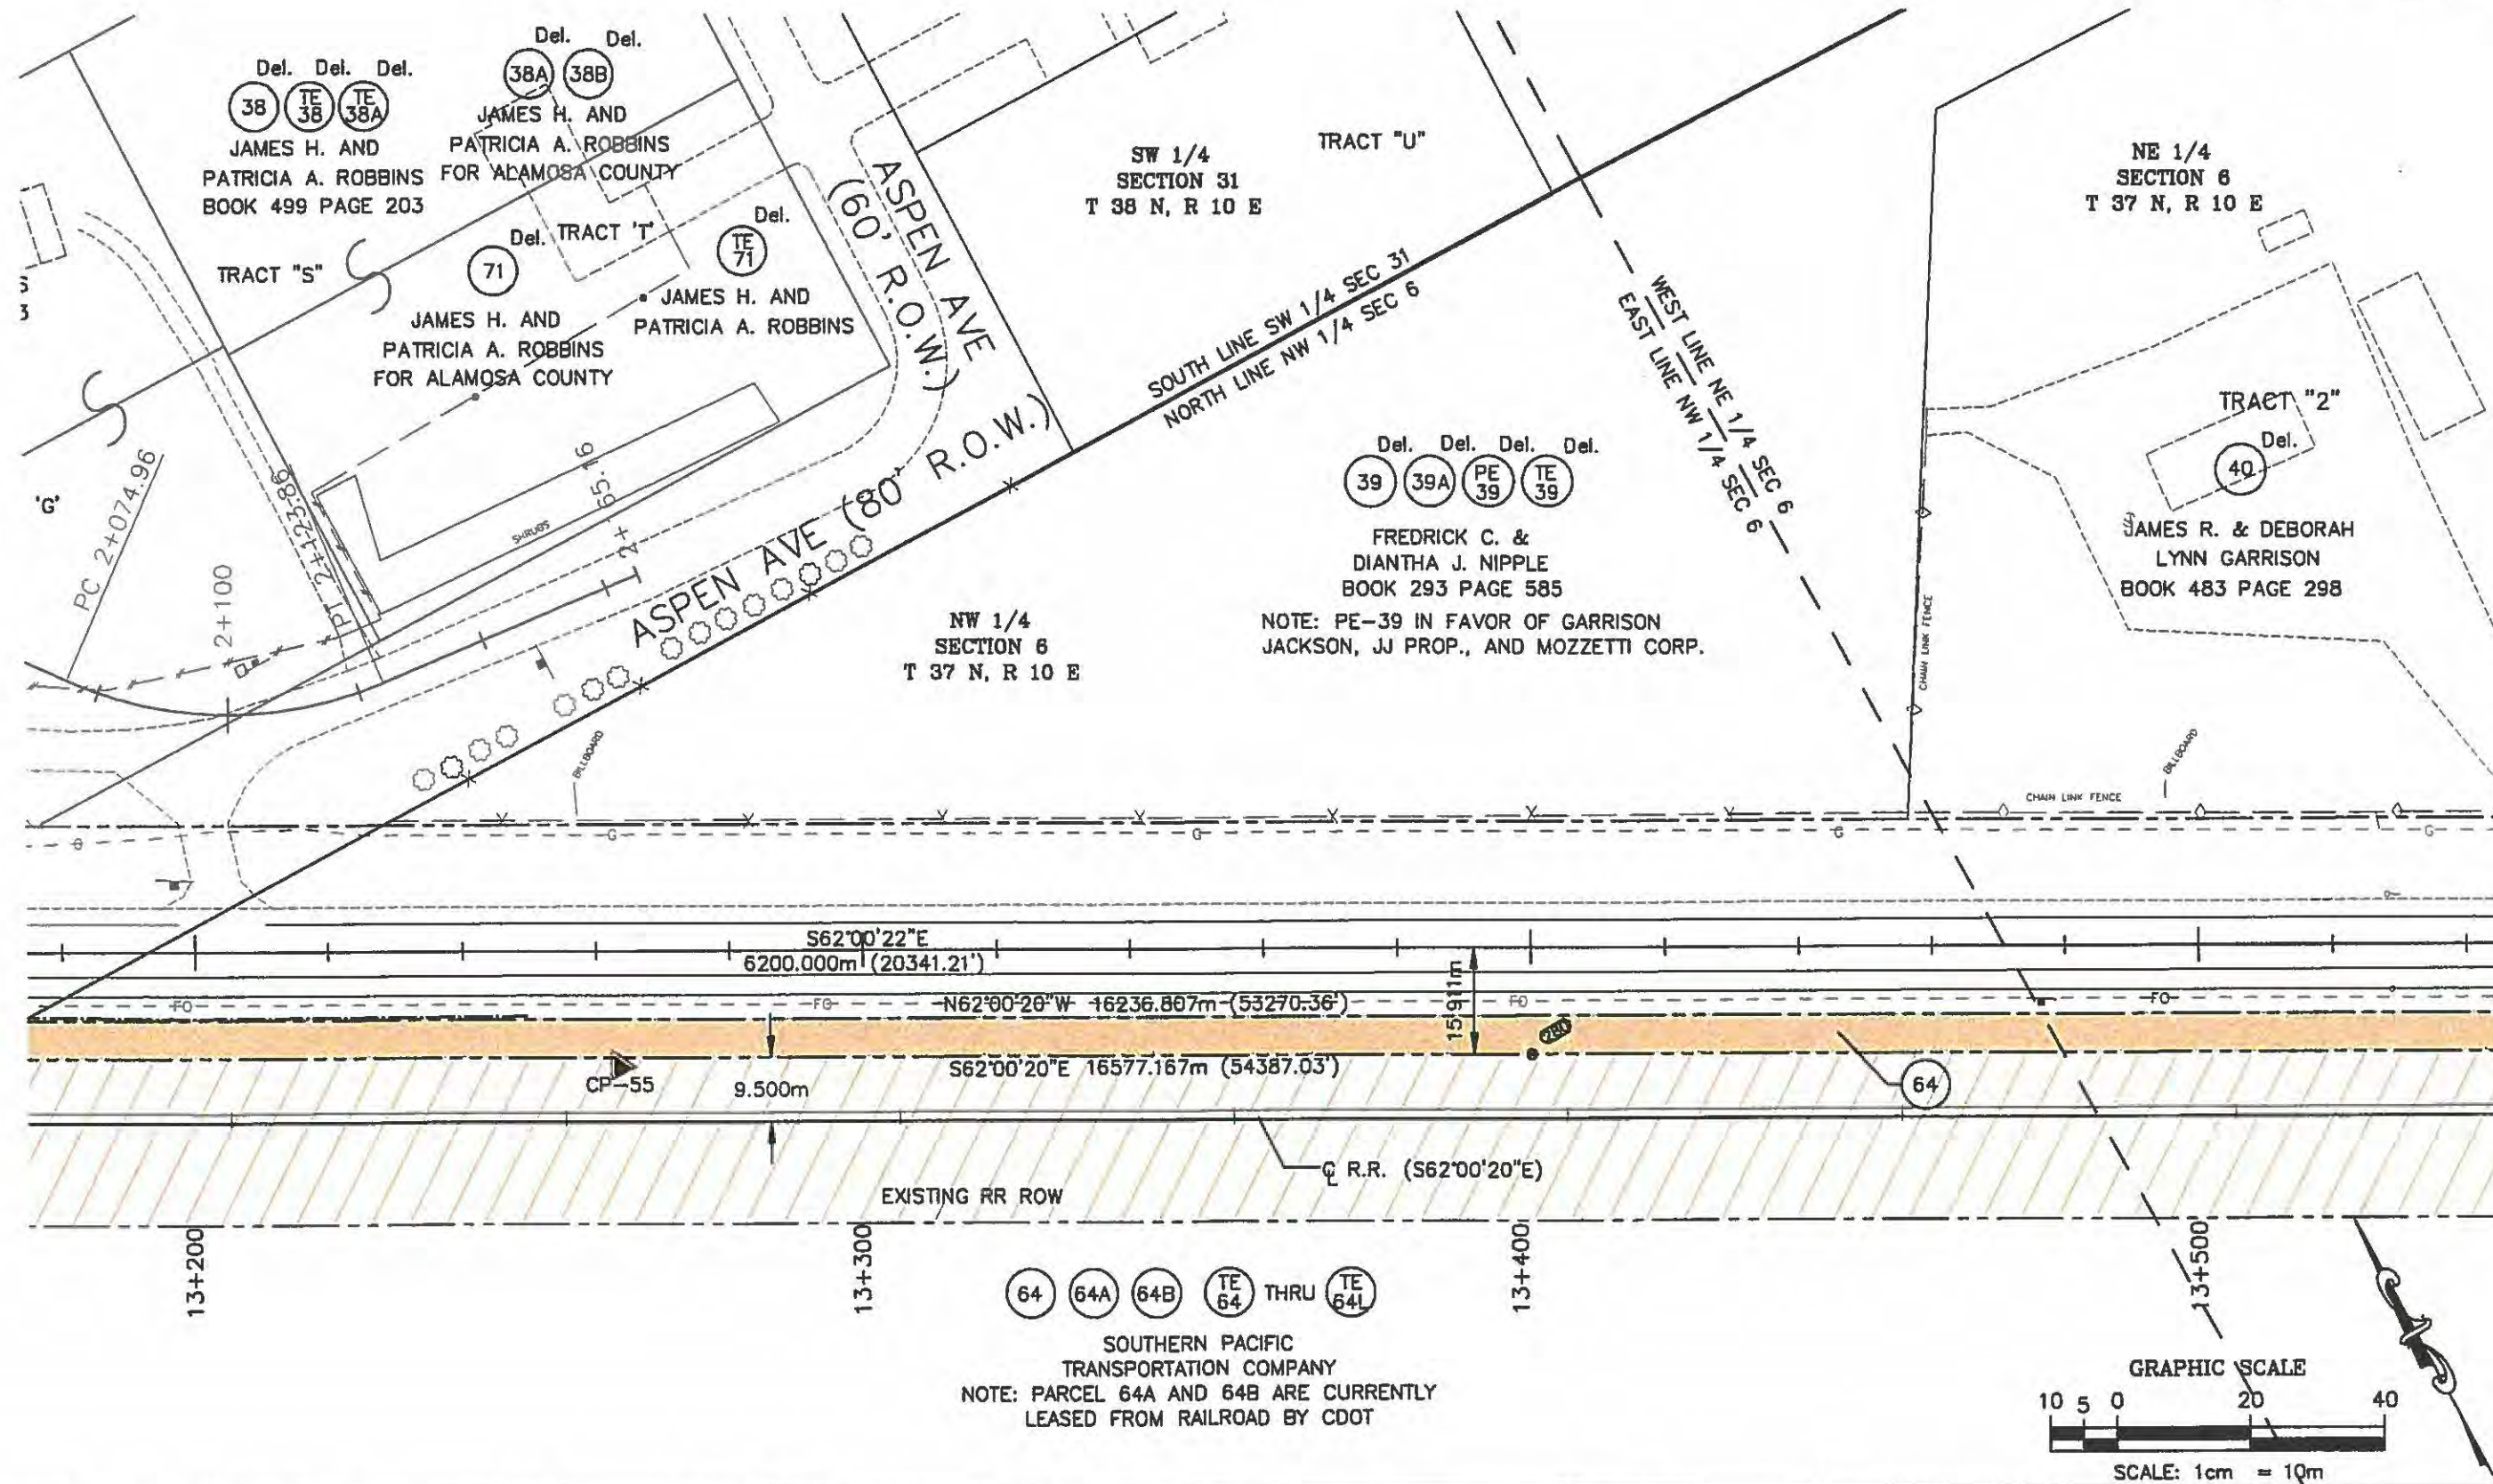

Computer File Information		Index of Revisions		Colorado Department of Transportation		As Constructed		RIGHT-OF-WAY PLAN SHEET		Project No./Code	
Creation Date: 07/22/97	Initials: JRY	(R2B)	5/11/98	DELETED PARCELS #38-40, & 71 et al.	EDC	No Revisions:		C. R. 6E TO CRAFT DR.		NH 1602-058	
Last Modification Date: 12/24/97	Initials: JRY					Revised:		Designer:		10578	
Full Path: BEAST F:\JOBS\CDOT\5657-003\PHASE-ONE						Void:		Detailer: JRY		Sheet Number: 42	
Drawing File Name: P-1ROW_PLAN2.DWG								Sheet Subset: ROW	Subset Sheets: 38 of 46		
Acad Ver. R14	Scale: 1:1000	Units: METRIC									

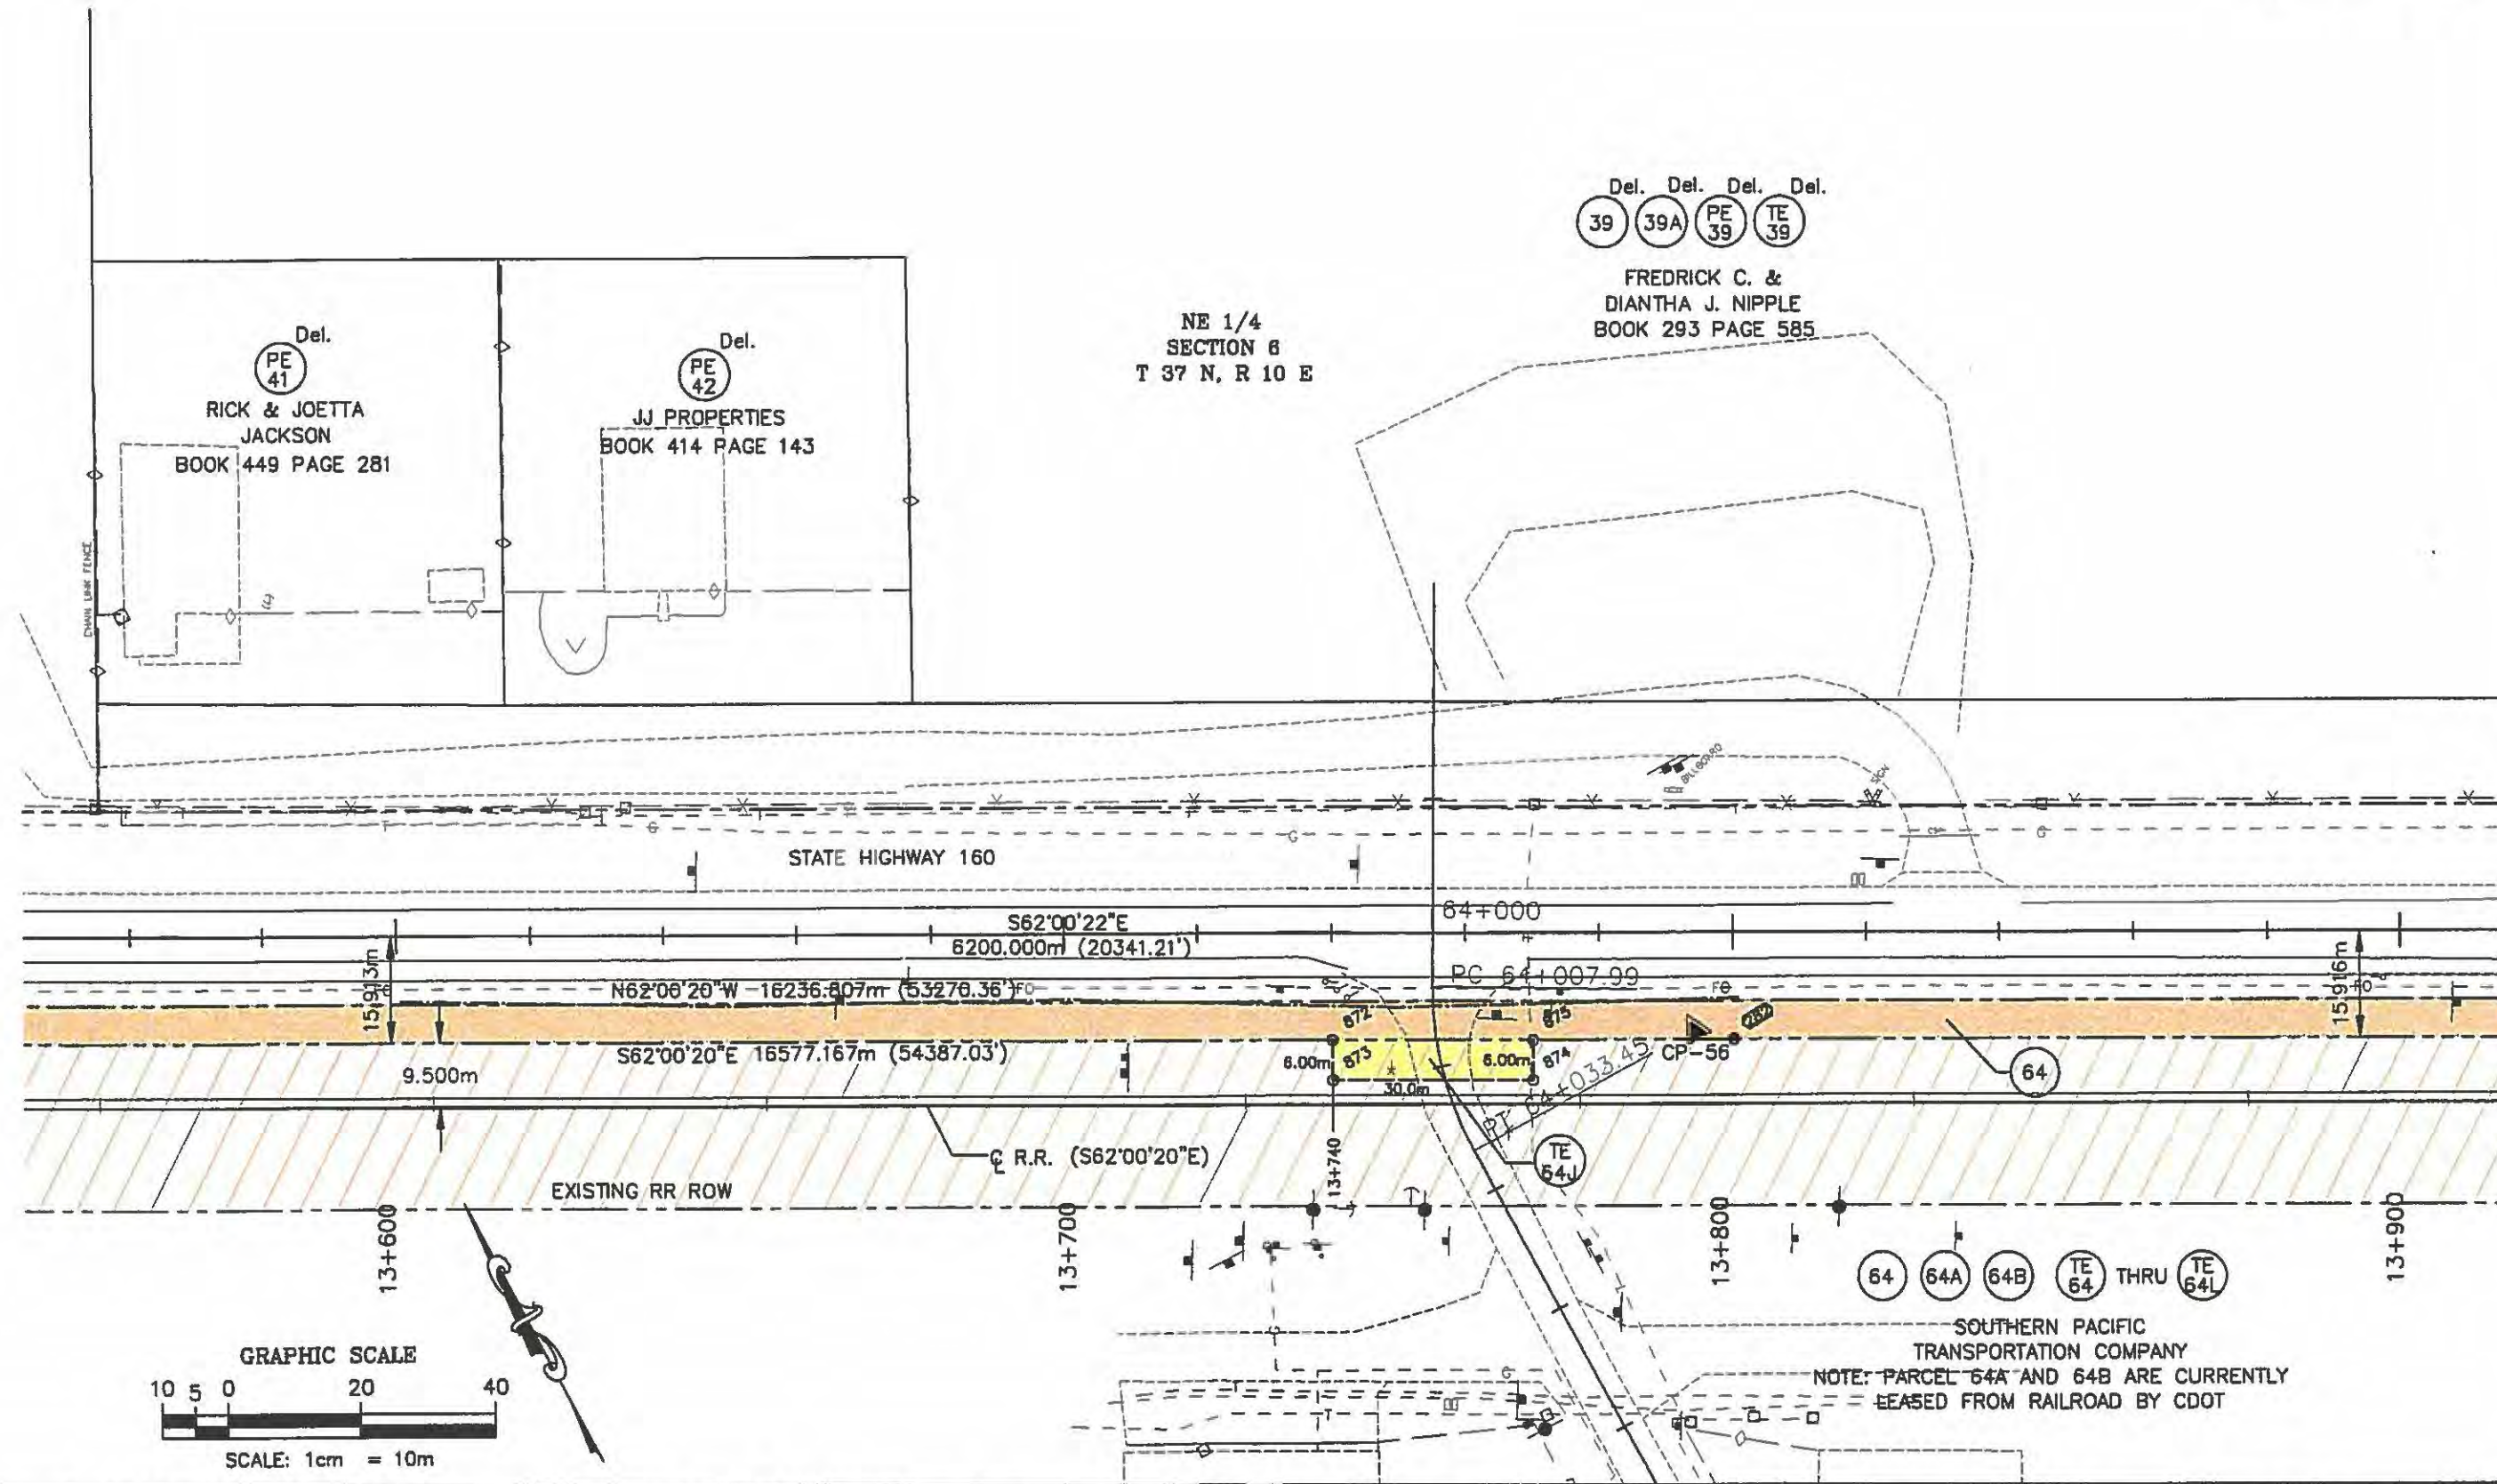

Computer File Information		Index of Revisions		Colorado Department of Transportation		As Constructed		RIGHT-OF-WAY PLAN SHEET		Project No./Code	
Creation Date: 07/22/97	Initials: JRY	R2B	5/11/98	DELETED PARCELS #39-42et.al.	EDC	 Department of Transportation Region 5 3803 North Main Avenue, Suite 300 Durango, Colorado 81301 Phone: 970-385-1400 FAX: 970-385-1410	No Revisions:	C. R. 6E TO CRAFT DR.		NH 1602-058	
Last Modification Date: 12/24/97	Initials: JRY						Revised:	Designer:		10578	
Full Path: BEAST F:\JOBS\CDOT\5657-003\PHASE-ONE								Detailer: JRY			
Drawing File Name: P-1ROW_PLAN2.DWG								Sheet Subset: ROW	Subset Sheets: 39 of 46	Sheet Number: 43	
Acad Ver. R14	Scale: 1:1000		Units: METRIC								


NE 1/4
SECTION 6
T 37 N, R 10 E

Del. Del. Del. Del.
39 39A PE 39 TE 39


FREDRICK C. &
DIANTHA J. NIPPLE
BOOK 293 PAGE 585

Del.
43


THE MOZZETTI CORP. DBA
COMFORT INN OF ALAMOSA
RECEPTION #281137

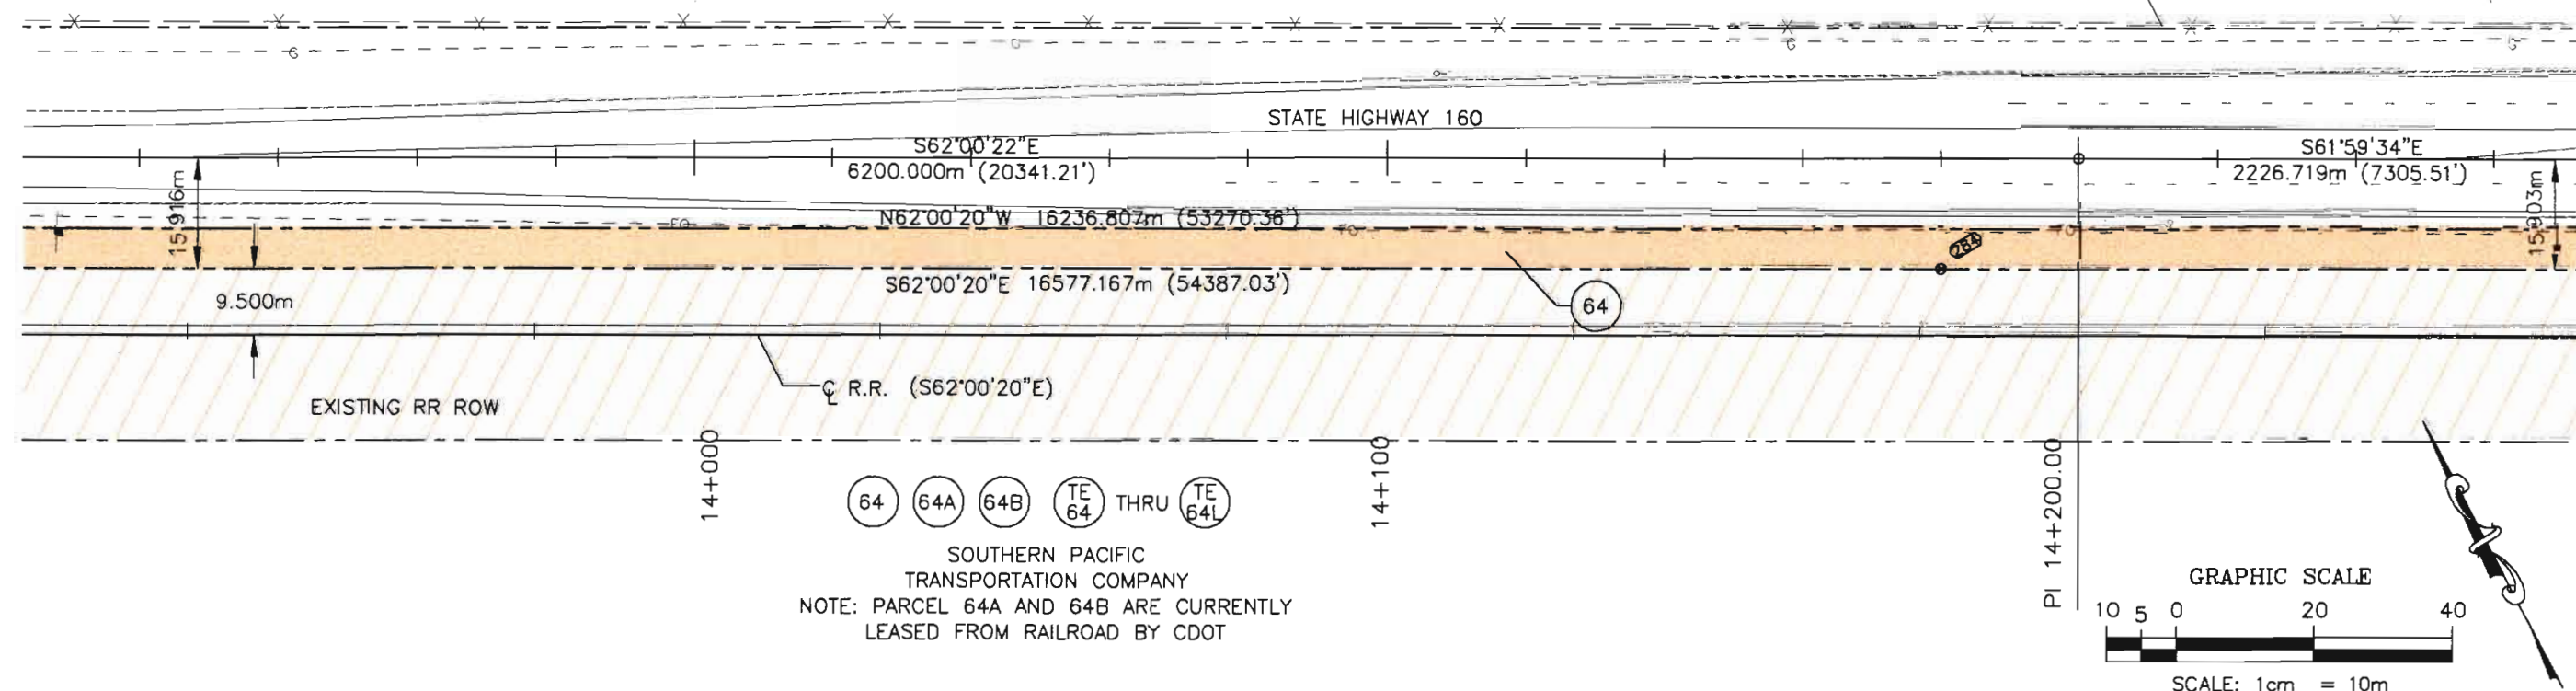

Computer File Information		Index of Revisions		Colorado Department of Transportation		As Constructed		RIGHT-OF-WAY PLAN SHEET		Project No./Code	
Creation Date: 07/22/97	Initials: JRY	(R2B)	5/11/98	DELETED PARCELS #39	EDC	No Revisions:		C. R. 6E TO CRAFT DR.		NH 1602-058	
Last Modification Date: 12/24/97	Initials: JRY			& 43et.al.		Revised:		Designer:		10578	
Full Path: BEAST F:\JOBS\CDOT\5657-003\PHASE-ONE						Void:		Detailer: JRY			
Drawing File Name: P-1ROW_PLAN2.DWG								Sheet Subset: ROW		Subset Sheets: 40 of 46	
Acad Ver. R14	Scale: 1:1000	Units: METRIC								Sheet Number: 44	

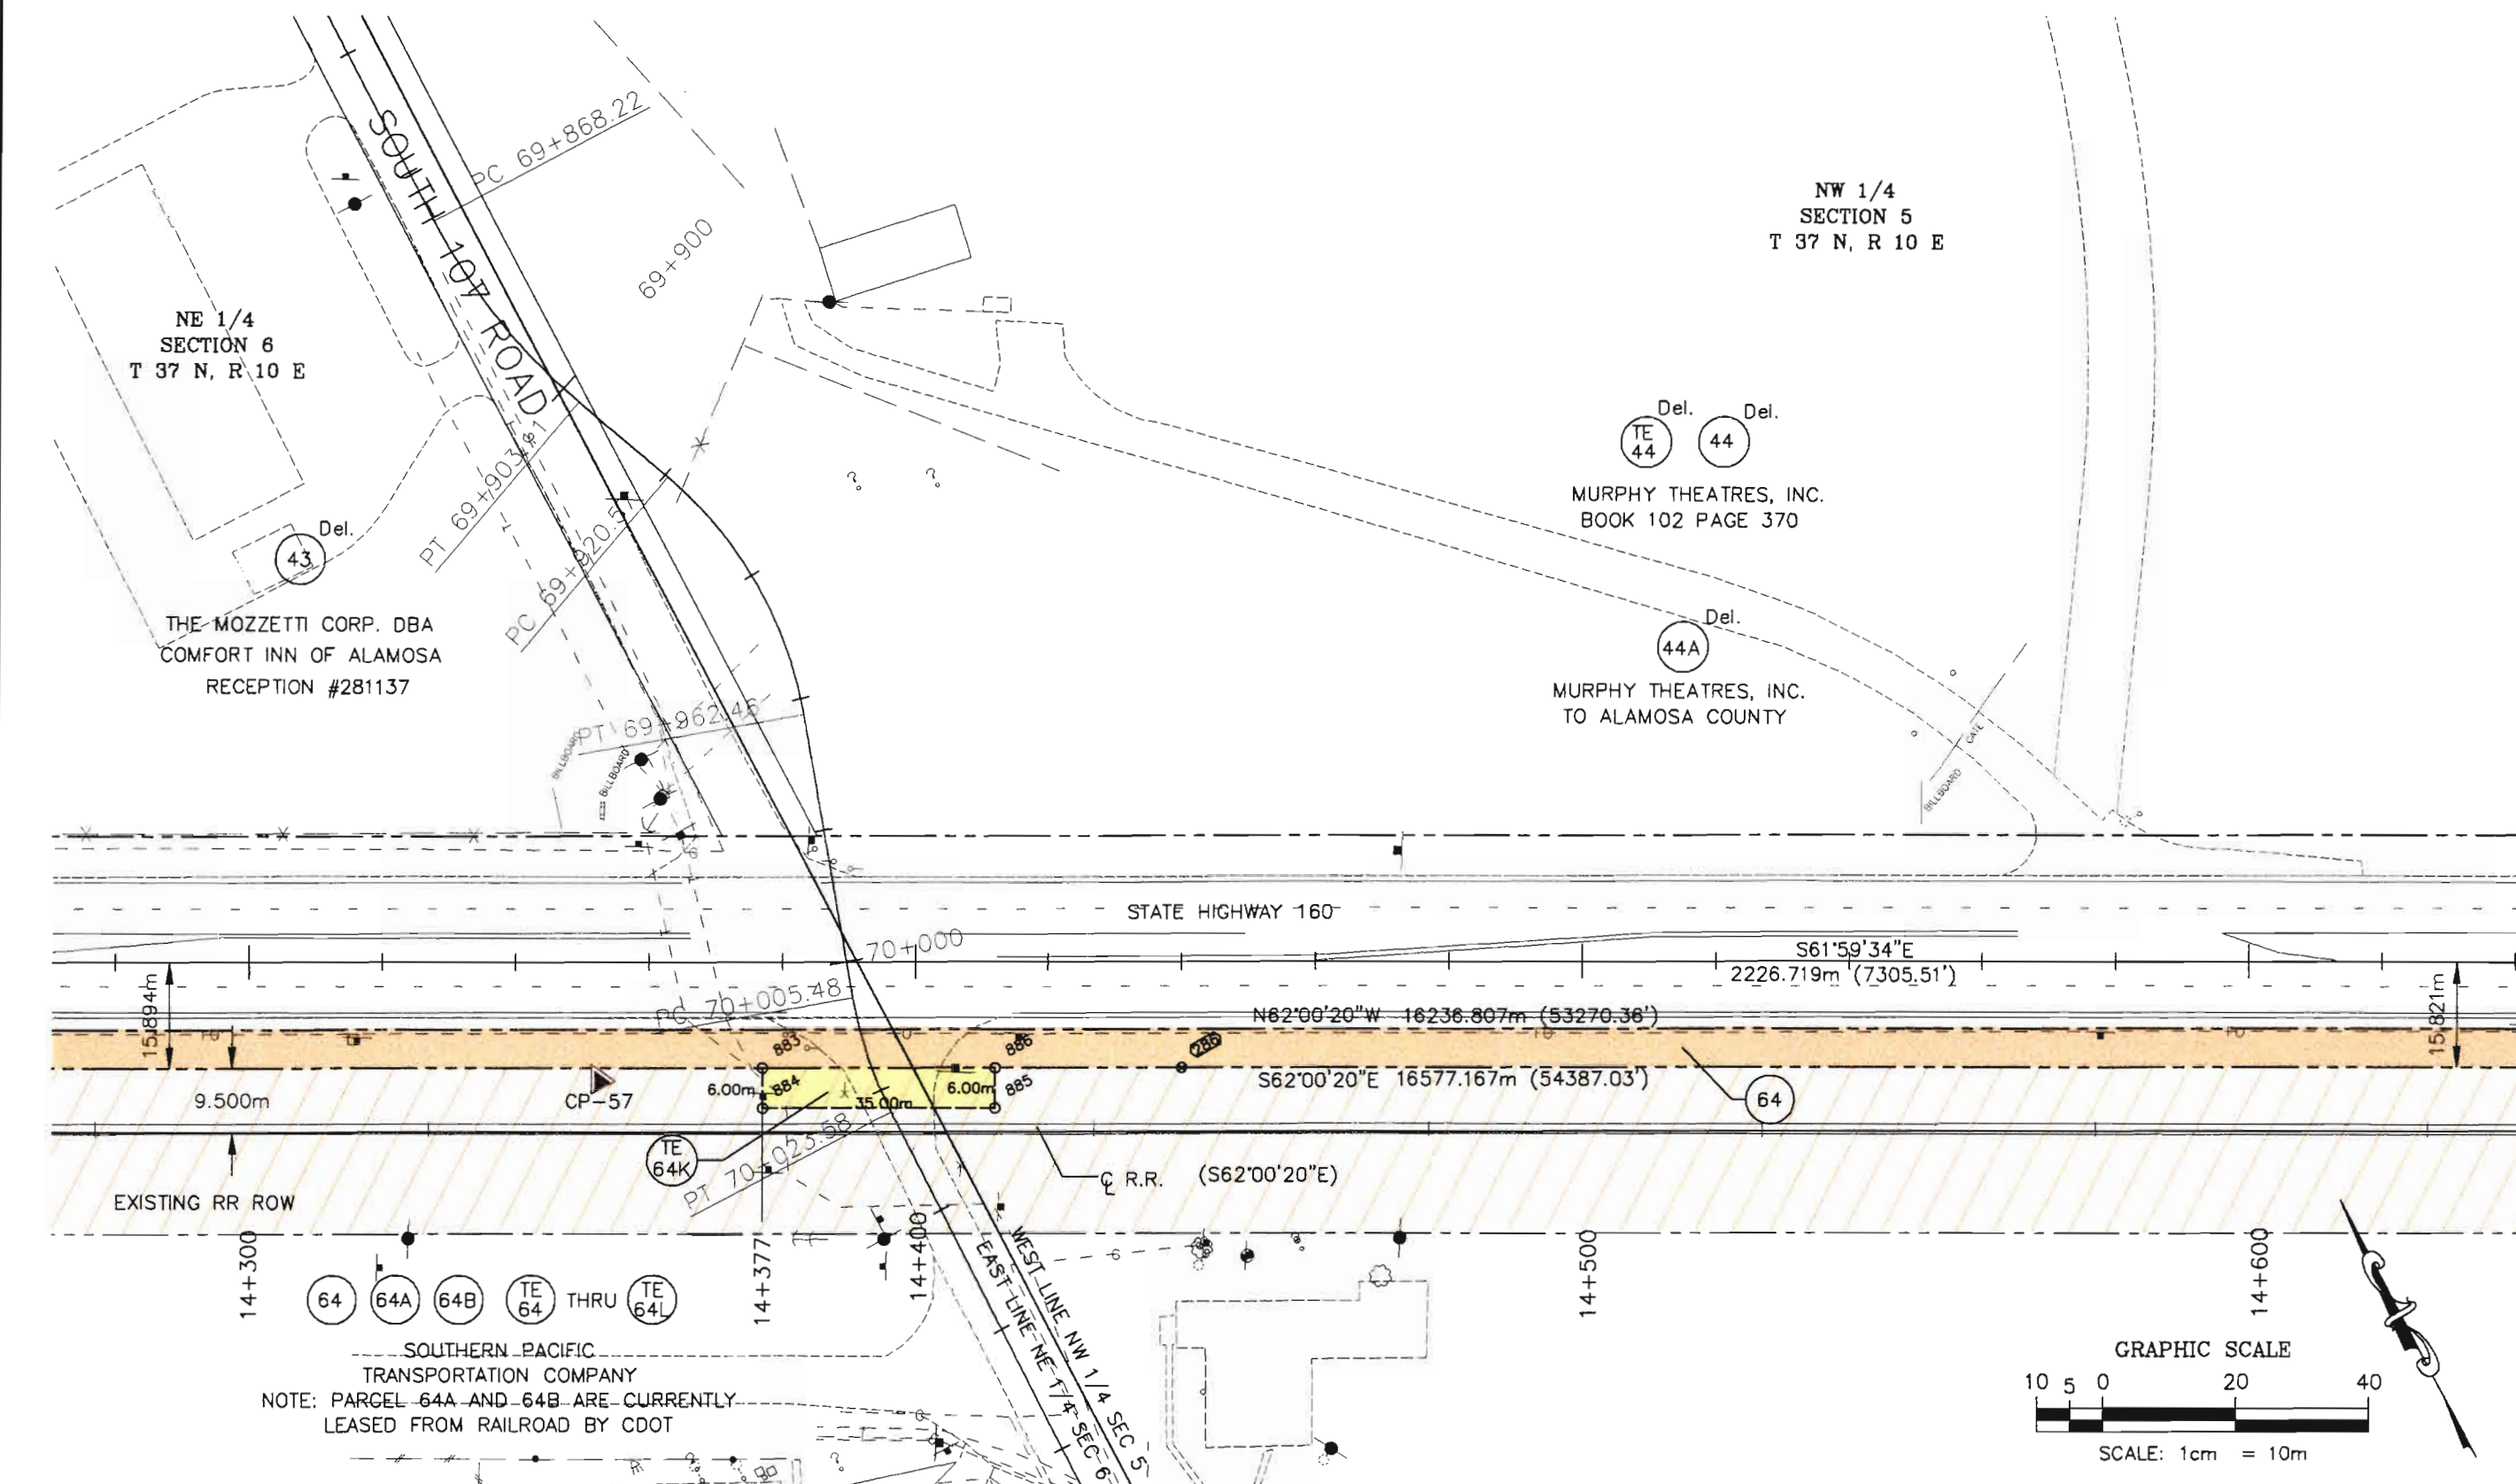

Computer File Information			Index of Revisions			As Constructed			RIGHT-OF-WAY PLAN SHEET			Project No./Code	
Creation Date: 07/22/97	Initials: JRY	(R2B)	5/11/98	DELETED PARCELS #43	EDC	No Revisions:			C. R. 6E TO CRAFT DR.			NH 1602-058	
Last Modification Date: 12/24/97	Initials: JRY			& 44et.al.		Revised:			Designer:			10578	
Full Path: BEAST F:\JOBS\CDOT\5657-003\PHASE-ONE						Void:			Detailer: JRY				
Drawing File Name: P-1ROW_PLAN2.DWG									Sheet Subset: ROW			Subset Sheets: 41 of 46	
Acad Ver. R14	Scale: 1:1000	Units: METRIC										Sheet Number: 45	

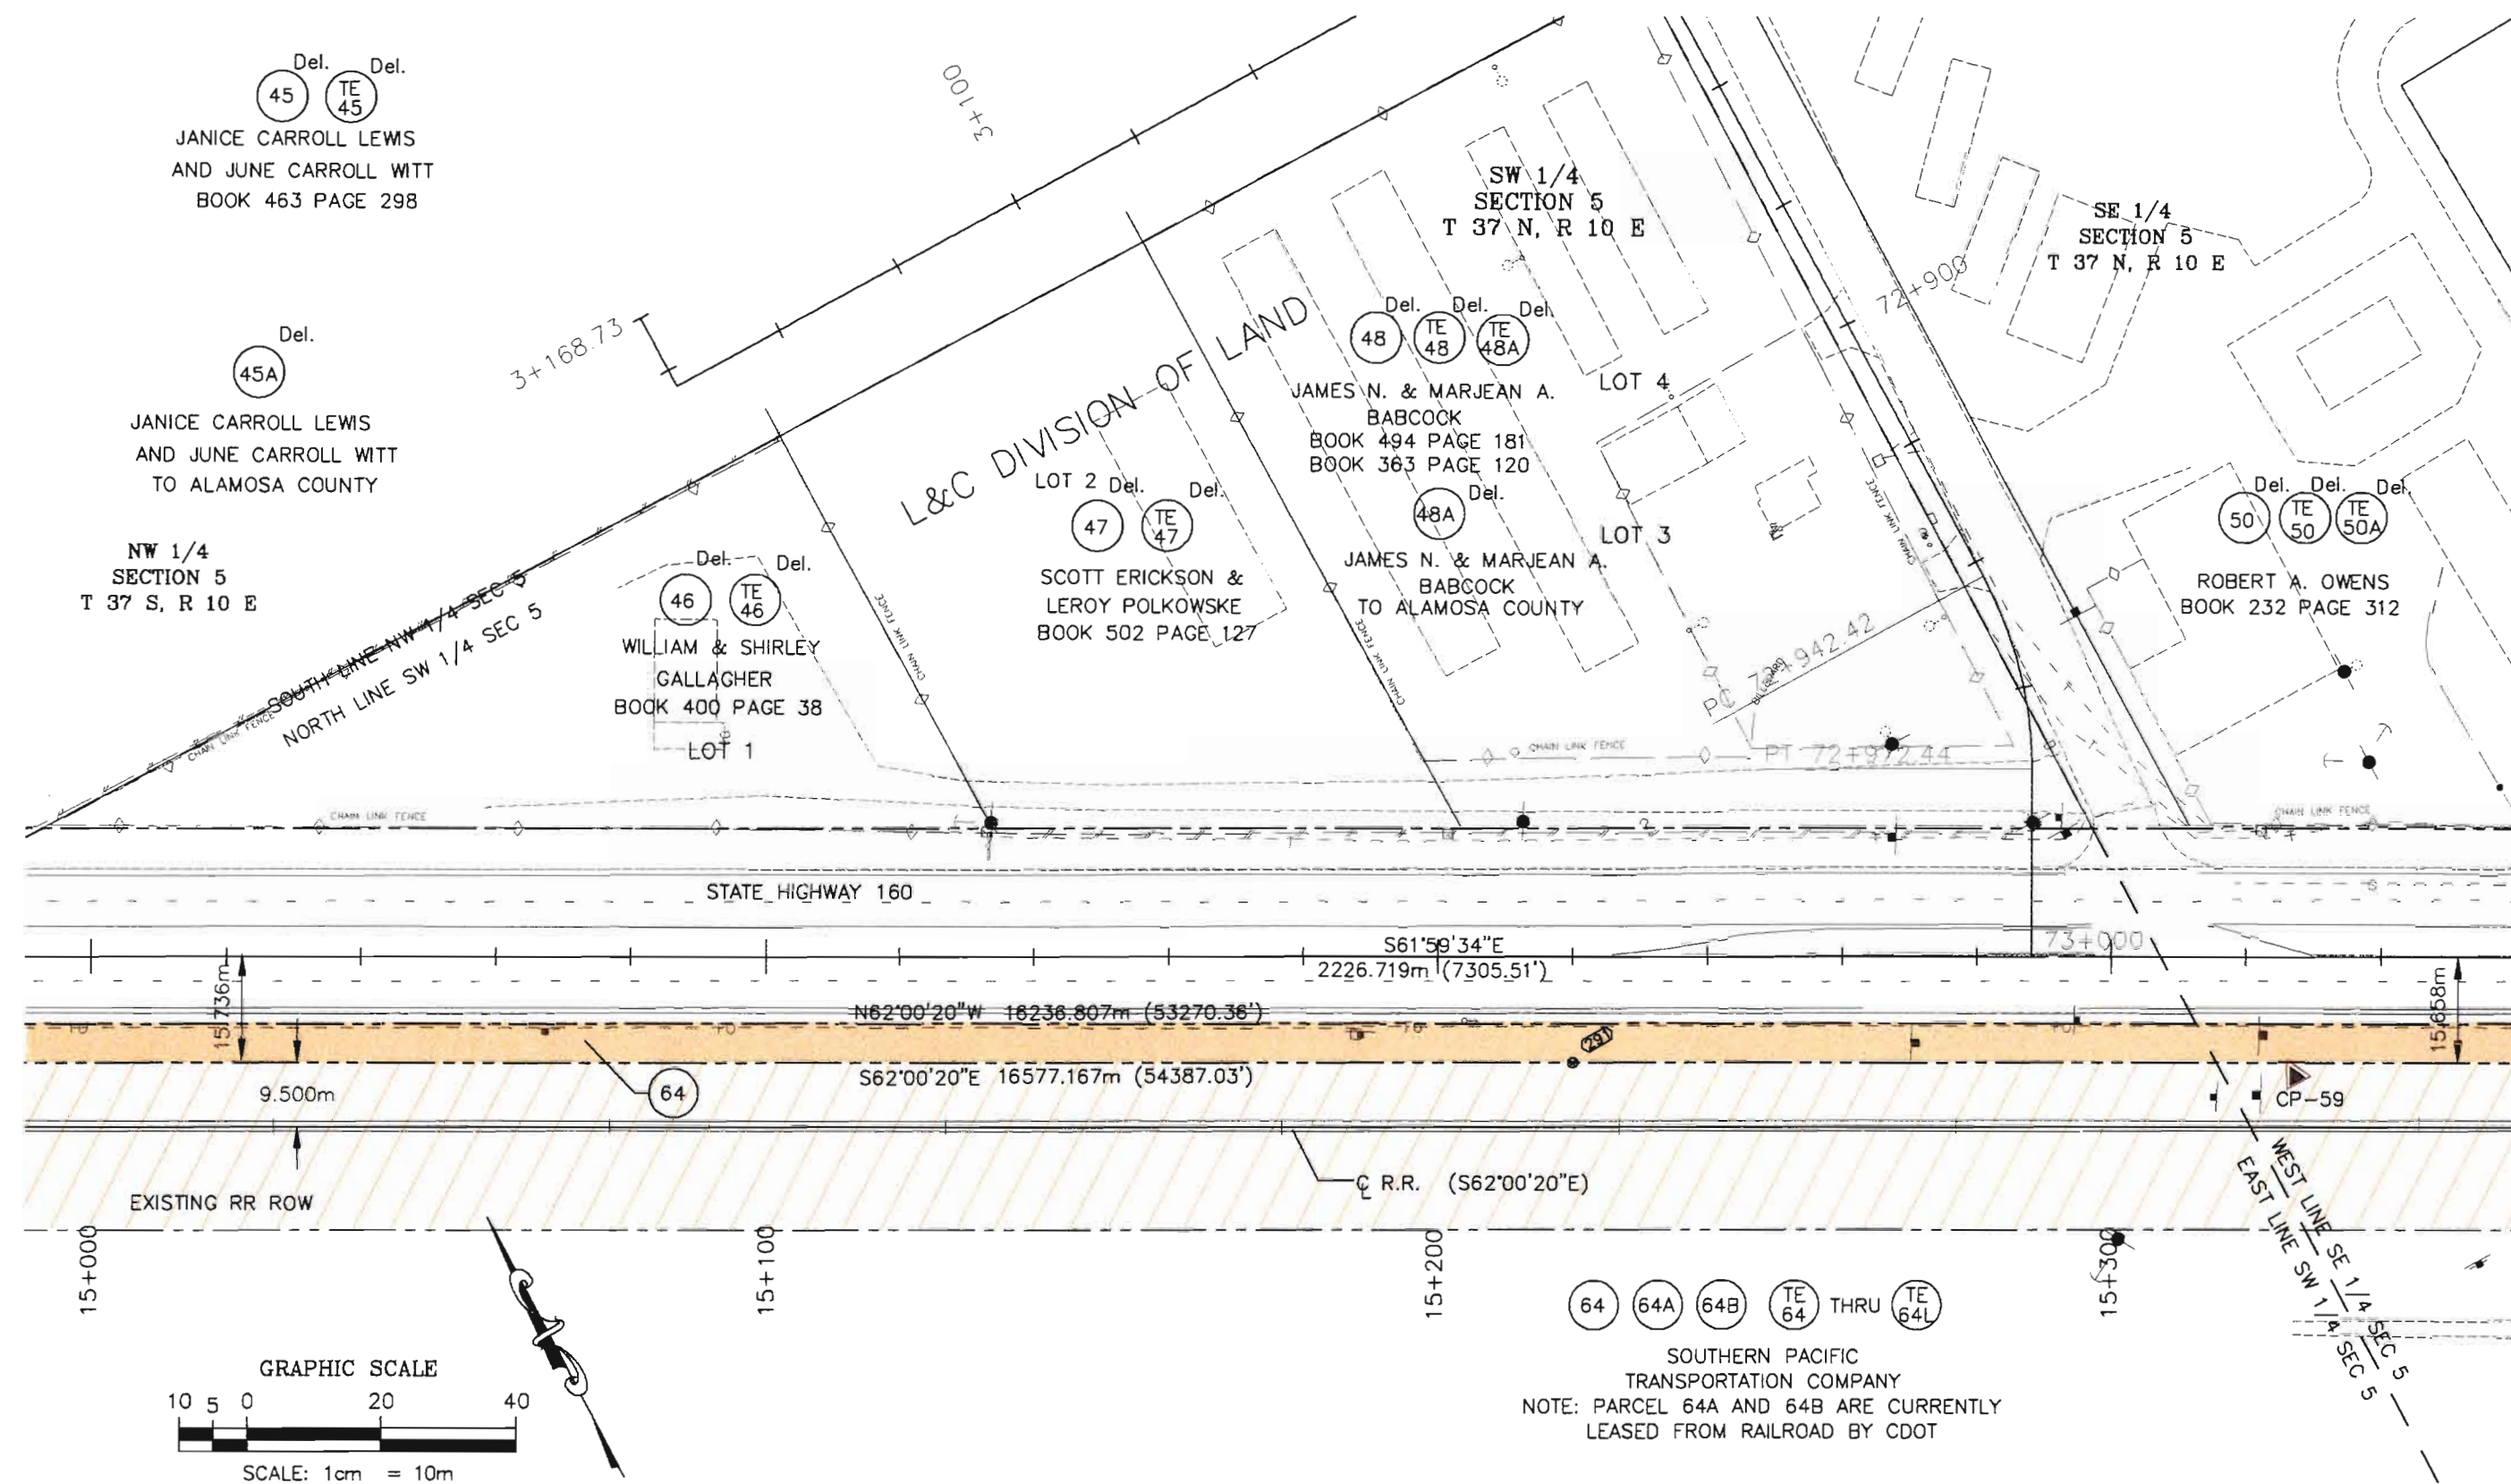



Computer File Information				Index of Revisions			Colorado Department of Transportation		As Constructed		RIGHT-OF-WAY PLAN SHEET			Project No./Code			
Creation Date: 07/22/97		Initials: JRY		(R2B)	5/11/98		DELETED PARCELS #45-50et.al.		EDC		No Revisions:		C. R. 6E TO CRAFT DR.			NH 1602-058	
Last Modification Date: 12/24/97		Initials: JRY									Revised:		Designer:		10578		
Full Path: BEAST F:\JOBS\CDOT\5657-003\PHASE-ONE													Detailer: JRY				
Drawing File Name: P-1ROW_PLAN2.DWG													Sheet Subset: ROW		Subset Sheets: 43 of 46		
Acad Ver. R14		Scale: 1:1000			Units: METRIC										Sheet Number: 47		




3803 North Main Avenue, Suite 300
Durango, Colorado 81301
Phone: 970-385-1400 FAX: 970-385-1410

 
Region 5

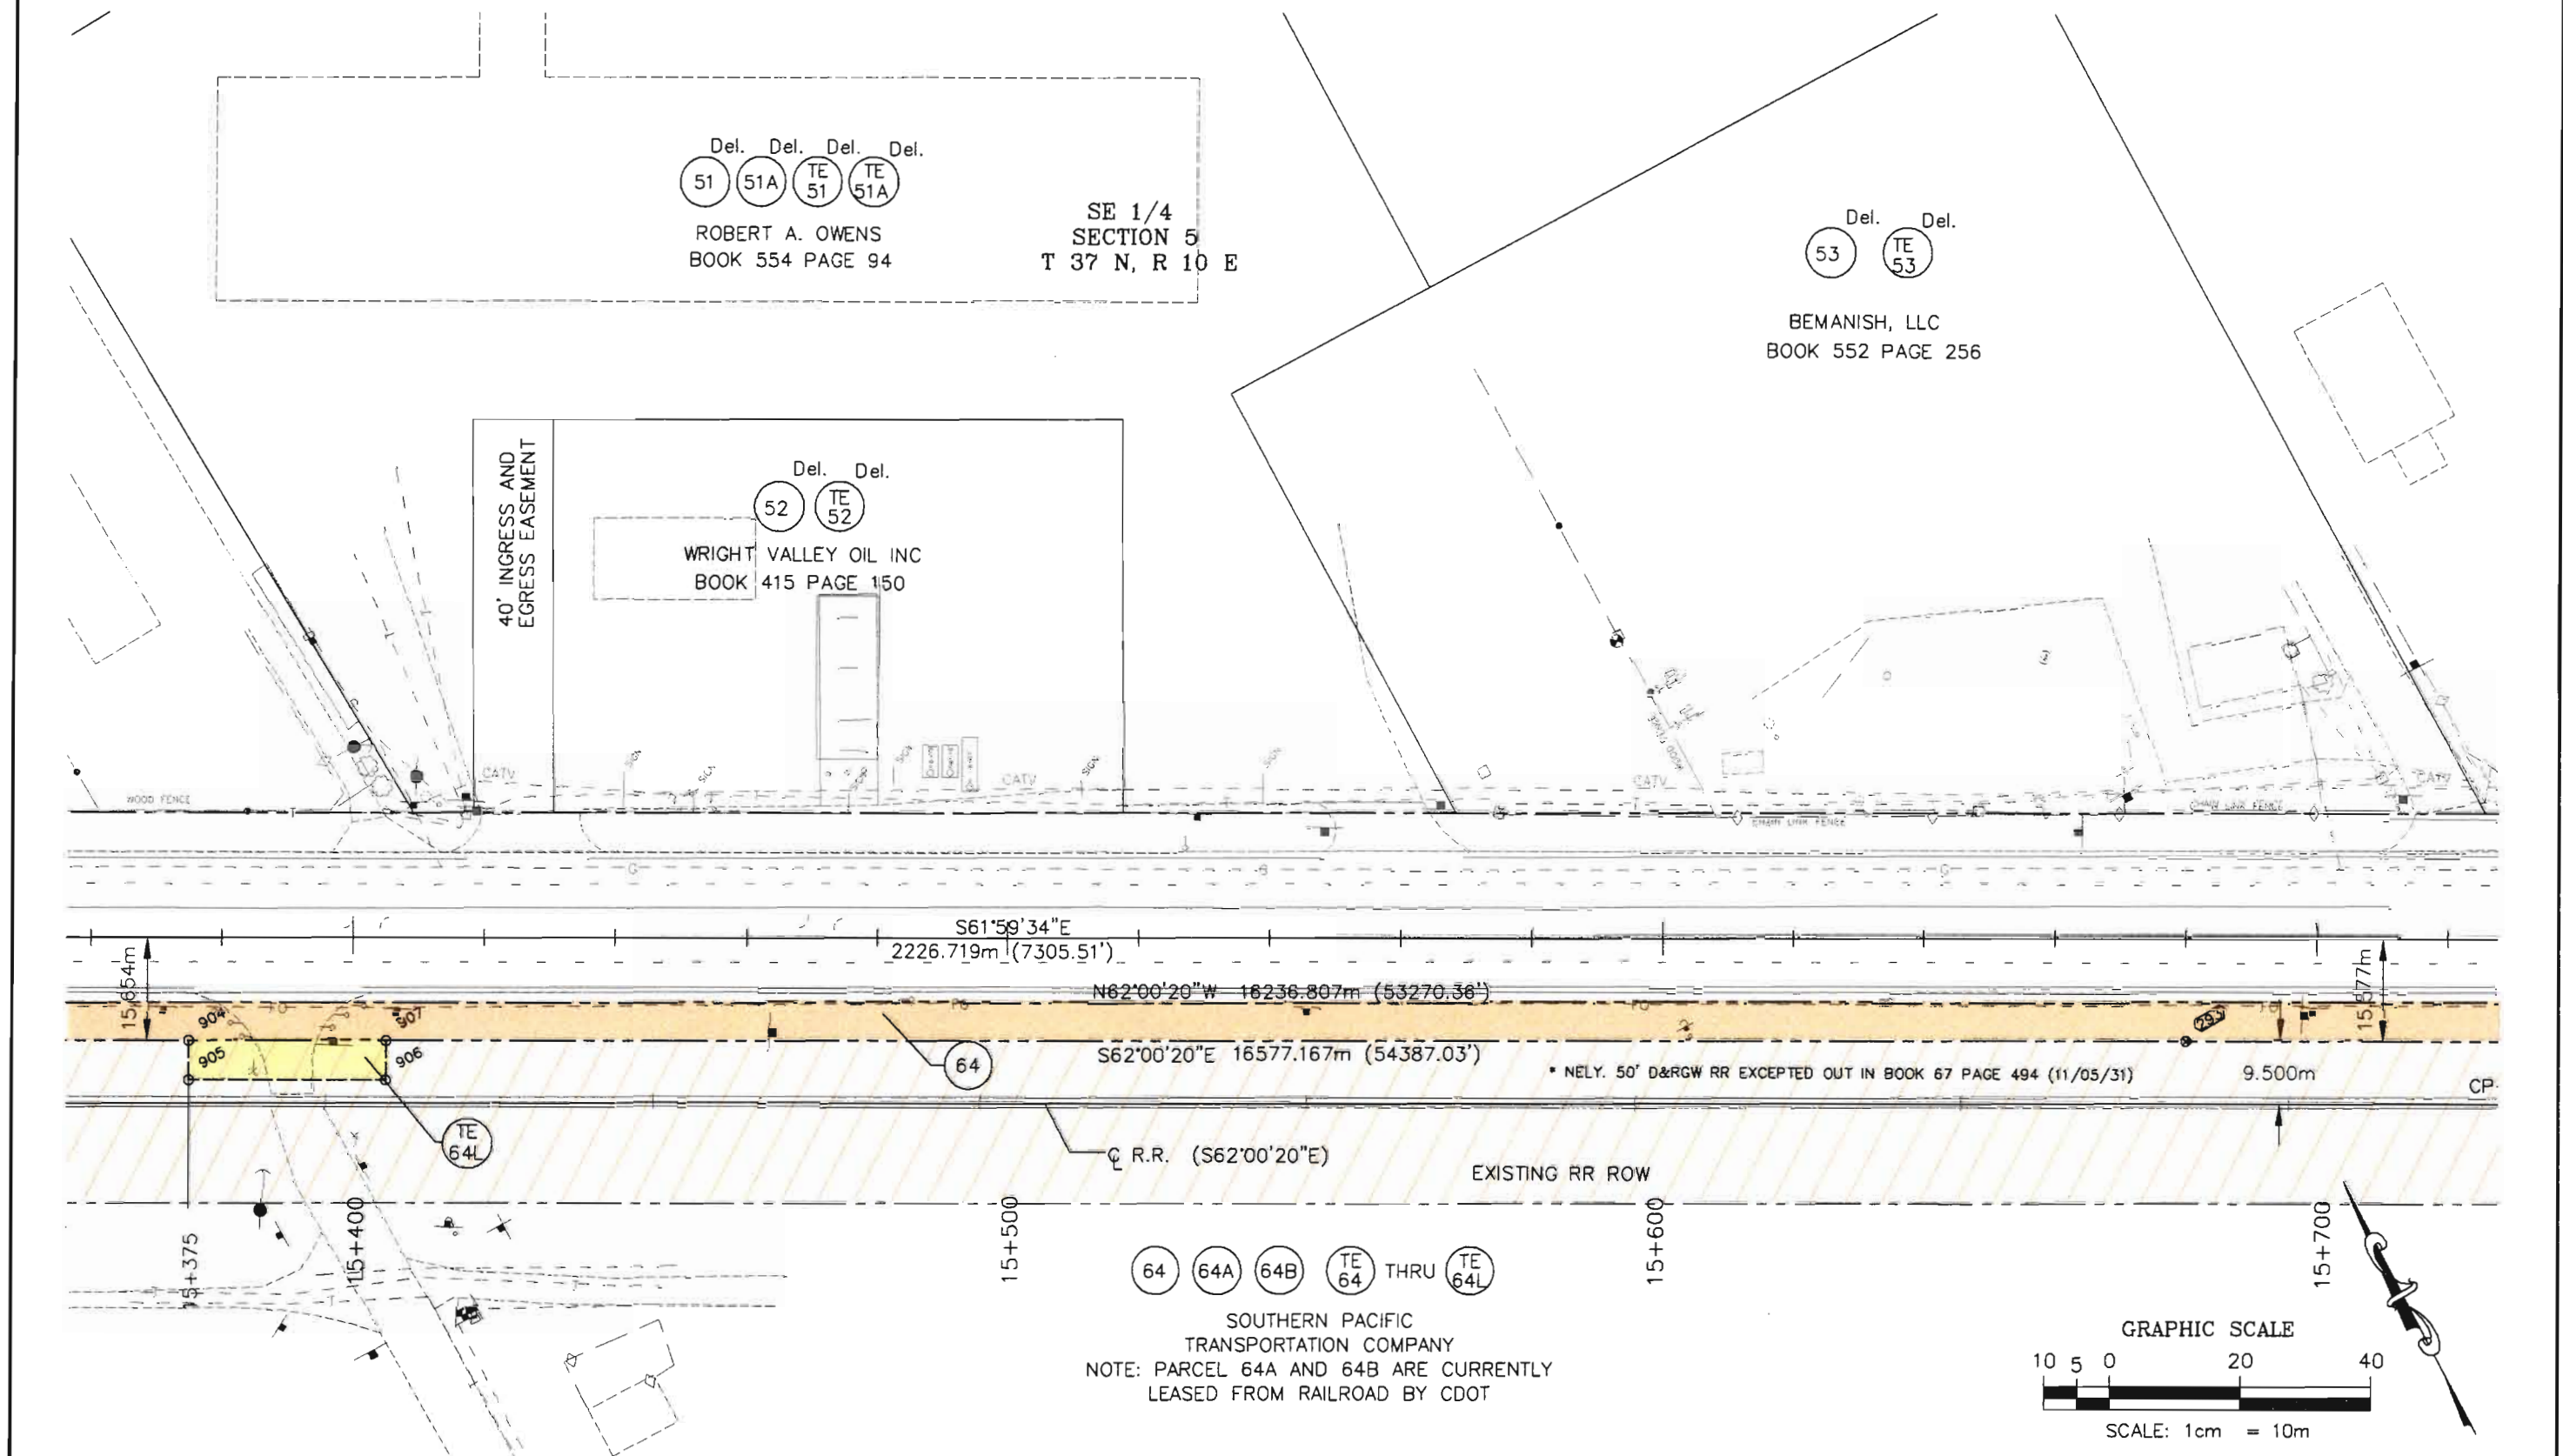

Computer File Information				Index of Revisions				Colorado Department of Transportation		As Constructed		RIGHT-OF-WAY PLAN SHEET		Project No./Code		
Creation Date: 07/22/97		Initials: JRY		☐ (R2B)	5/11/98	DELETED PARCELS #50-53et.al.		EDC	 3803 North Main Avenue, Suite 300 Durango, Colorado 81301 Phone: 970-385-1400 FAX: 970-385-1410 Region 5	No Revisions:		C. R. 6E TO CRAFT DR.		NH 1602-058		
Last Modification Date: 12/24/97		Initials: JRY		☐				Revised:		Designer:			10578			
Full Path: BEAST F:\JOBS\CDOT\5657-003\PHASE-ONE				☐				Void:		Detailer: JRY						
Drawing File Name: P-1ROW_PLAN2.DWG				☐						Sheet Subset: ROW		Subset Sheets: 44 of 46		Sheet Number: 48		
Acad Ver. R14		Scale: 1:1000		Units: METRIC		☐										

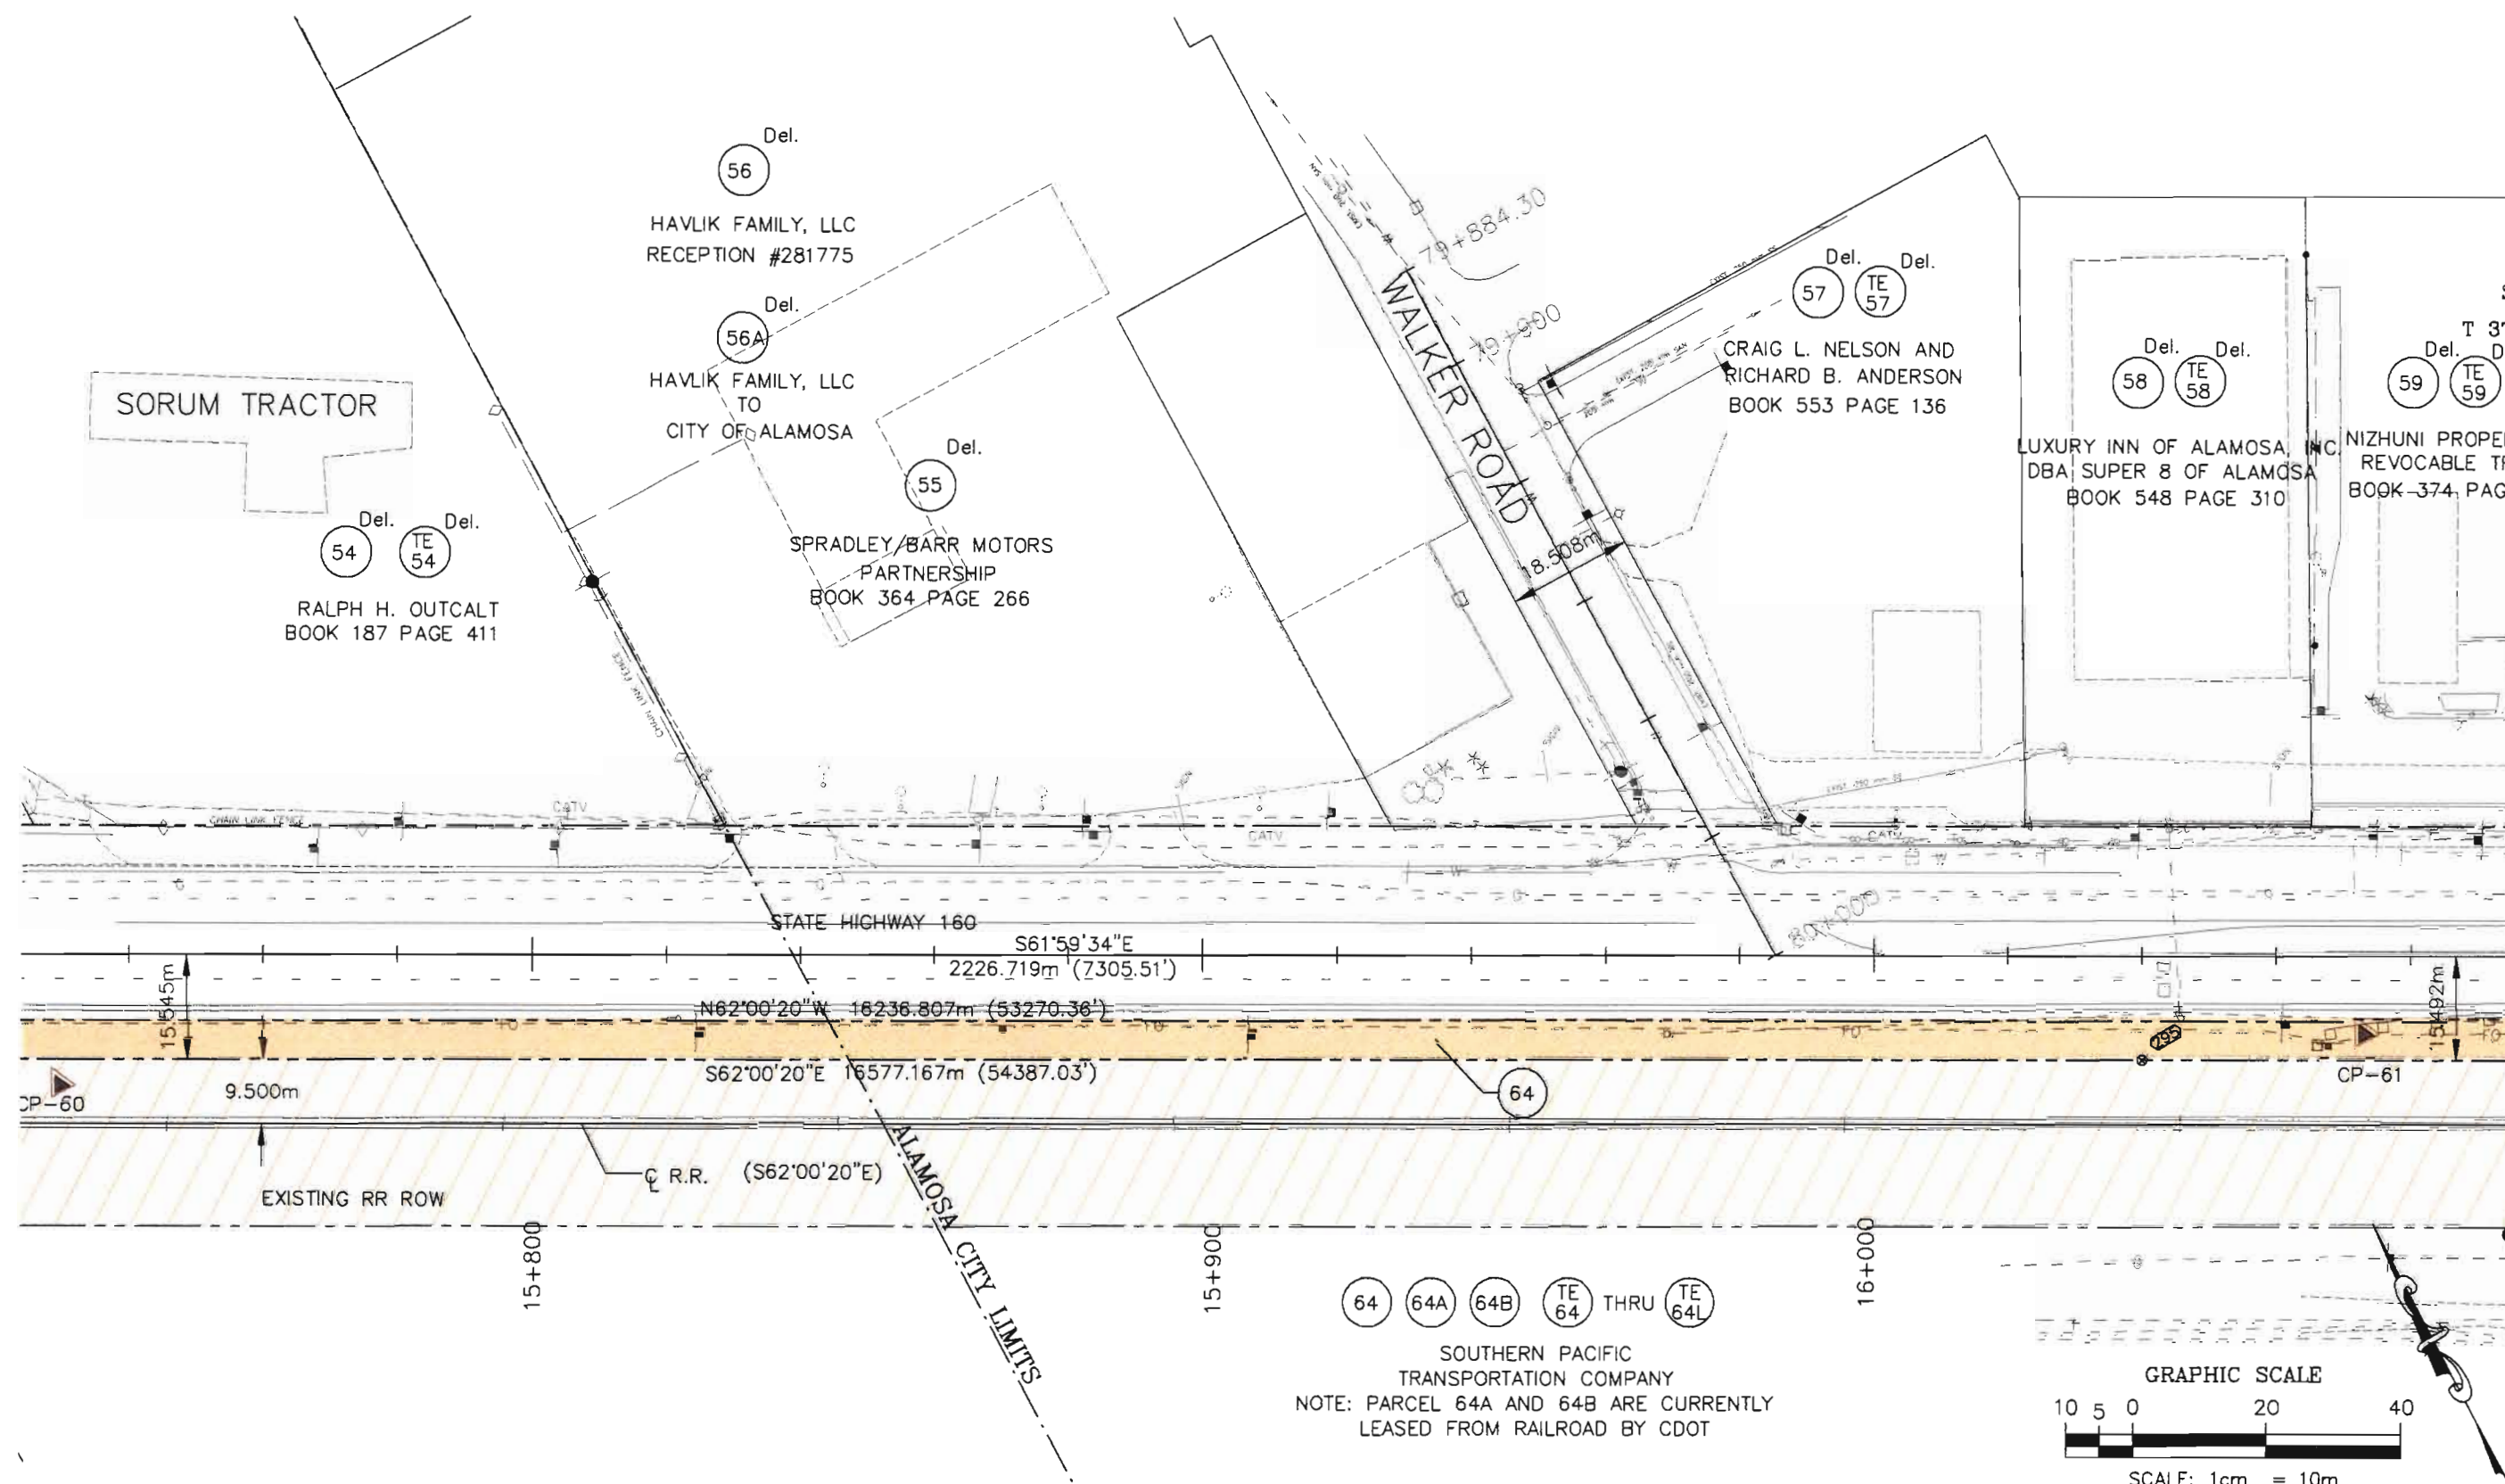


Computer File Information			Index of Revisions			Colorado Department of Transportation	As Constructed		RIGHT-OF-WAY PLAN SHEET C. R. 6E TO CRAFT DR.	Project No./Code	
Creation Date: 07/22/97	Initials: JRY		(R2B) 5/11/98	DELETED PARCELS #54-59et.al.	EDC		No Revisions:			NH 1602-058	
Last Modification Date: 12/24/97	Initials: JRY					 3803 North Main Avenue, Suite 300 Durango, Colorado 81301 Phone: 970-385-1400 FAX: 970-385-1410 Region 5	Revised:		Designer:	10578	
Full Path: BEAST F:\JOBS\CDOT\5657-003\PHASE-ONE							Void:		Detailer: JRY	Sheet Number: 49	
Drawing File Name: P-1ROW_PLAN2.DWG									Sheet Subset: ROW	Subset Sheets: 45 of 46	
Acad Ver. R14	Scale: 1:1000	Units: METRIC									

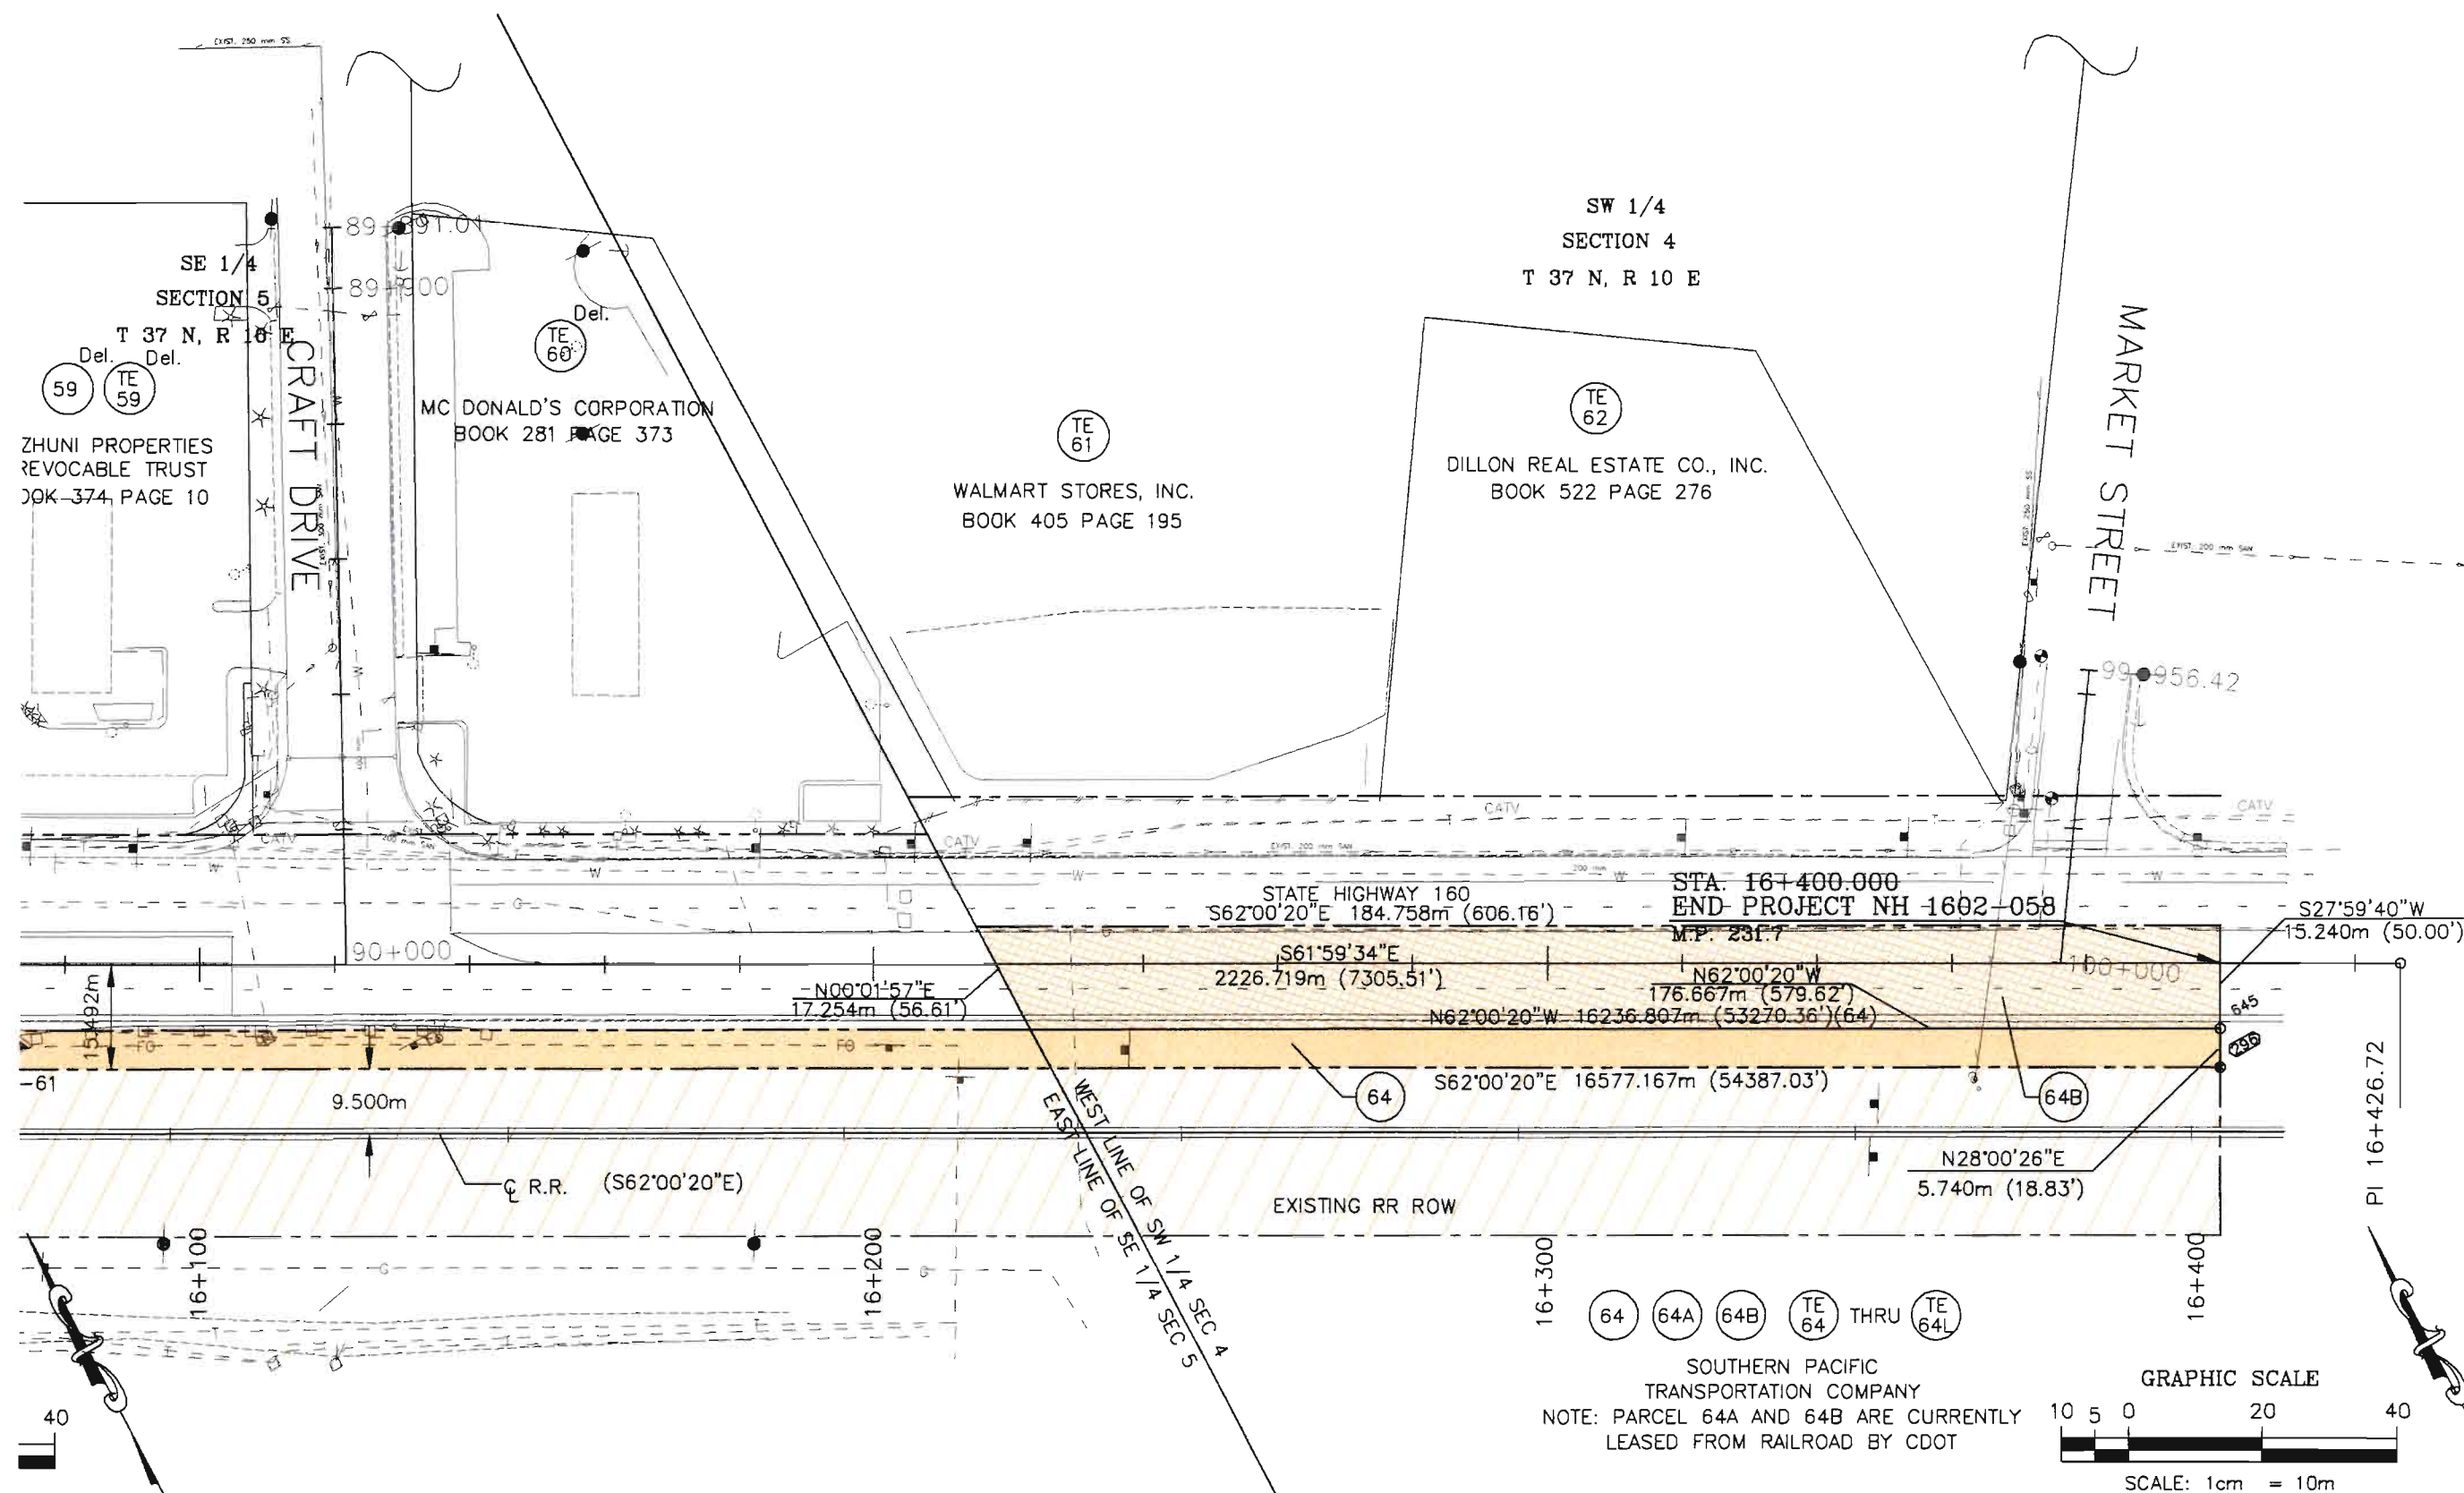

Computer File Information				Index of Revisions				As Constructed				RIGHT-OF-WAY PLAN SHEET				Project No./Code			
Creation Date: 07/22/97	Initials: JRY			5/11/98	DELETED PARCELS #59-62 et al.	EDC		No Revisions:				C. R. 6E TO CRAFT DR.				NH 1602-058			
Last Modification Date: 12/24/97	Initials: JRY							Revised:				Designer:				10578			
Full Path: BEAST F:\JOBS\CDOT\5657-003\PHASE-ONE								Void:				Detailer: JRY							
Drawing File Name: P-1ROW_PLAN2.DWG												Sheet Subset: ROW				Subset Sheets: 46 of 46			
Acad Ver. R14	Scale: 1:1000	Units: METRIC														Sheet Number: 50			

Colorado Department of Transportation
3803 North Main Avenue, Suite 300
Durango, Colorado 81301
Phone: 970-385-1400 FAX: 970-385-1410
Region 5

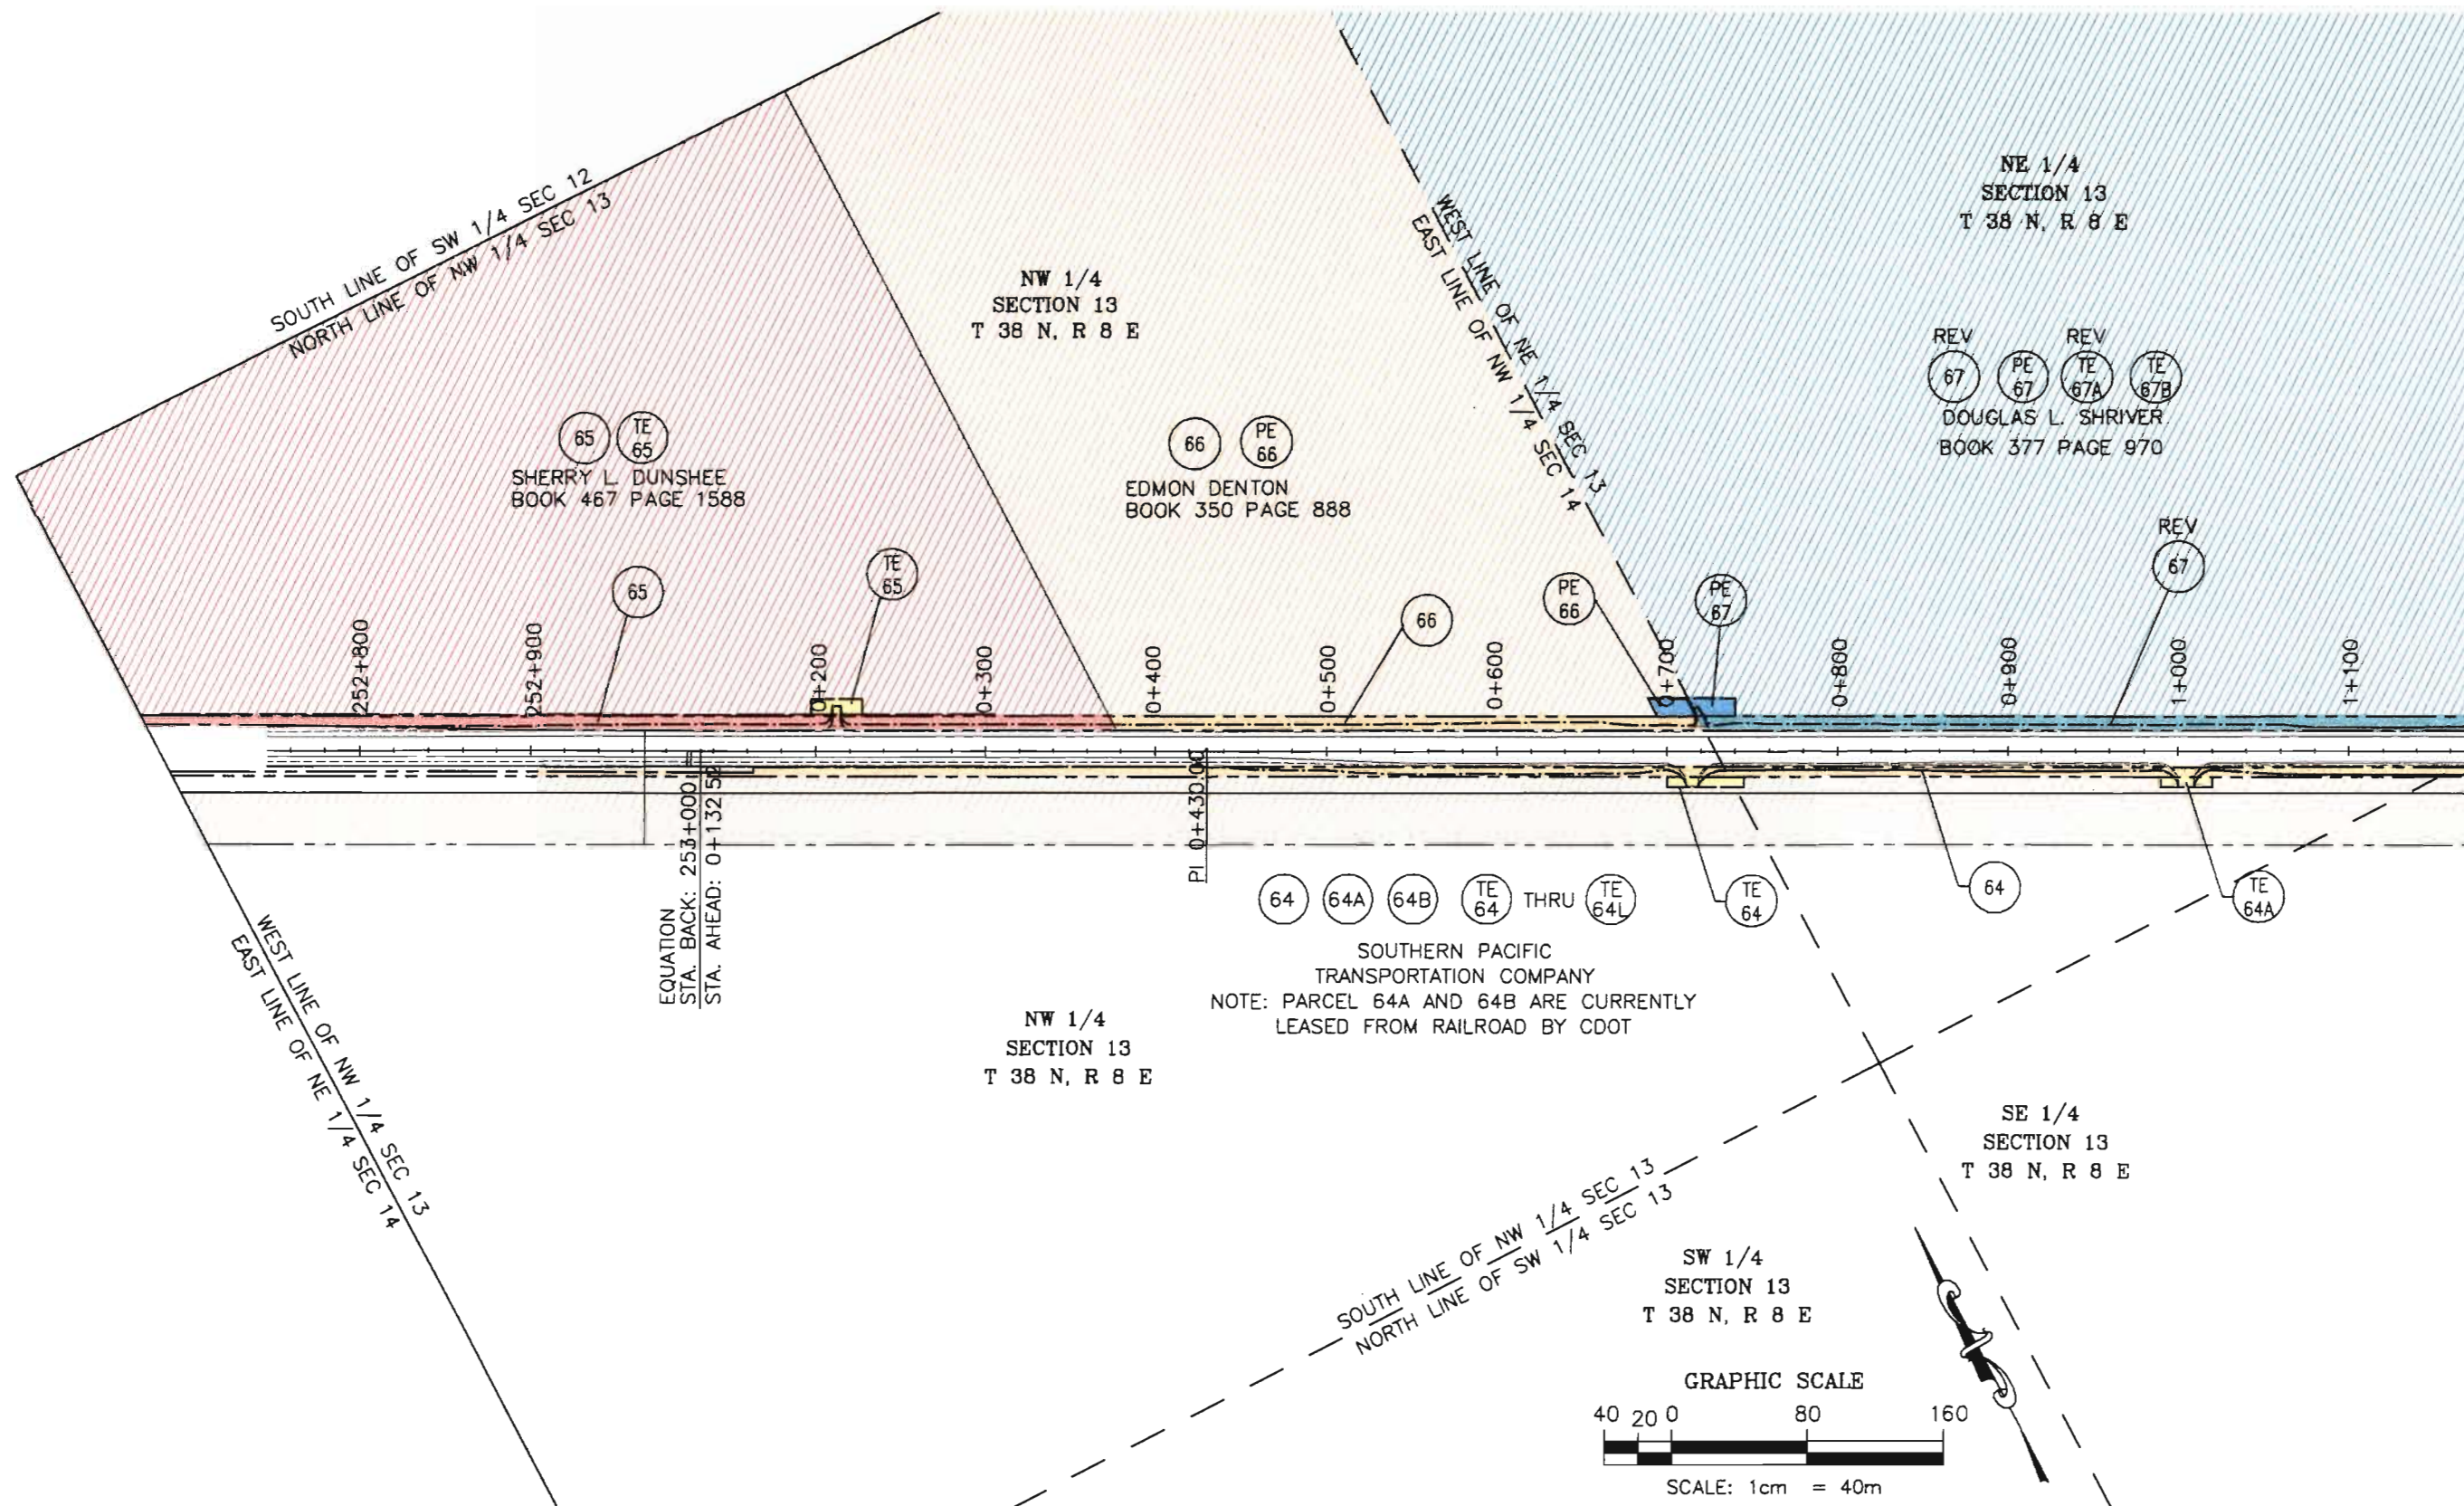


Computer File Information			Index of Revisions			As Constructed			OWNERSHIP PLAN			Project No./Code	
Creation Date: 10/24/97	Initials: JTO		R1	12/1/97	PARCELS 67, TE-67	EDC	No Revisions:		C. R. 6E TO CRAFT DR.			NH 1602-058	
Last Modification Date: 10/31/97	Initials: JTO		R2A	5/8/98	PARCELS PE-66, PE-67, TE-67AREV	EDC	Revised:		Designer:			10578	
Full Path: BEAST F:\JOBS\CDOT\5657-003\PHASE-ONE							Void:		Detailer: JTO			Sheet Number: 51	
Drawing File Name: P-10OWNER PLAN1.DWG									Sheet Subset: Ownership	Subset Sheets: 1 of 12			
Acad Ver. R14	Scale: 1:4000	Units: METRIC											

Colorado Department of Transportation



Region 5

3803 North Main Avenue, Suite 300
Durango, Colorado 81301
Phone: 970-385-1400 FAX: 970-385-1410

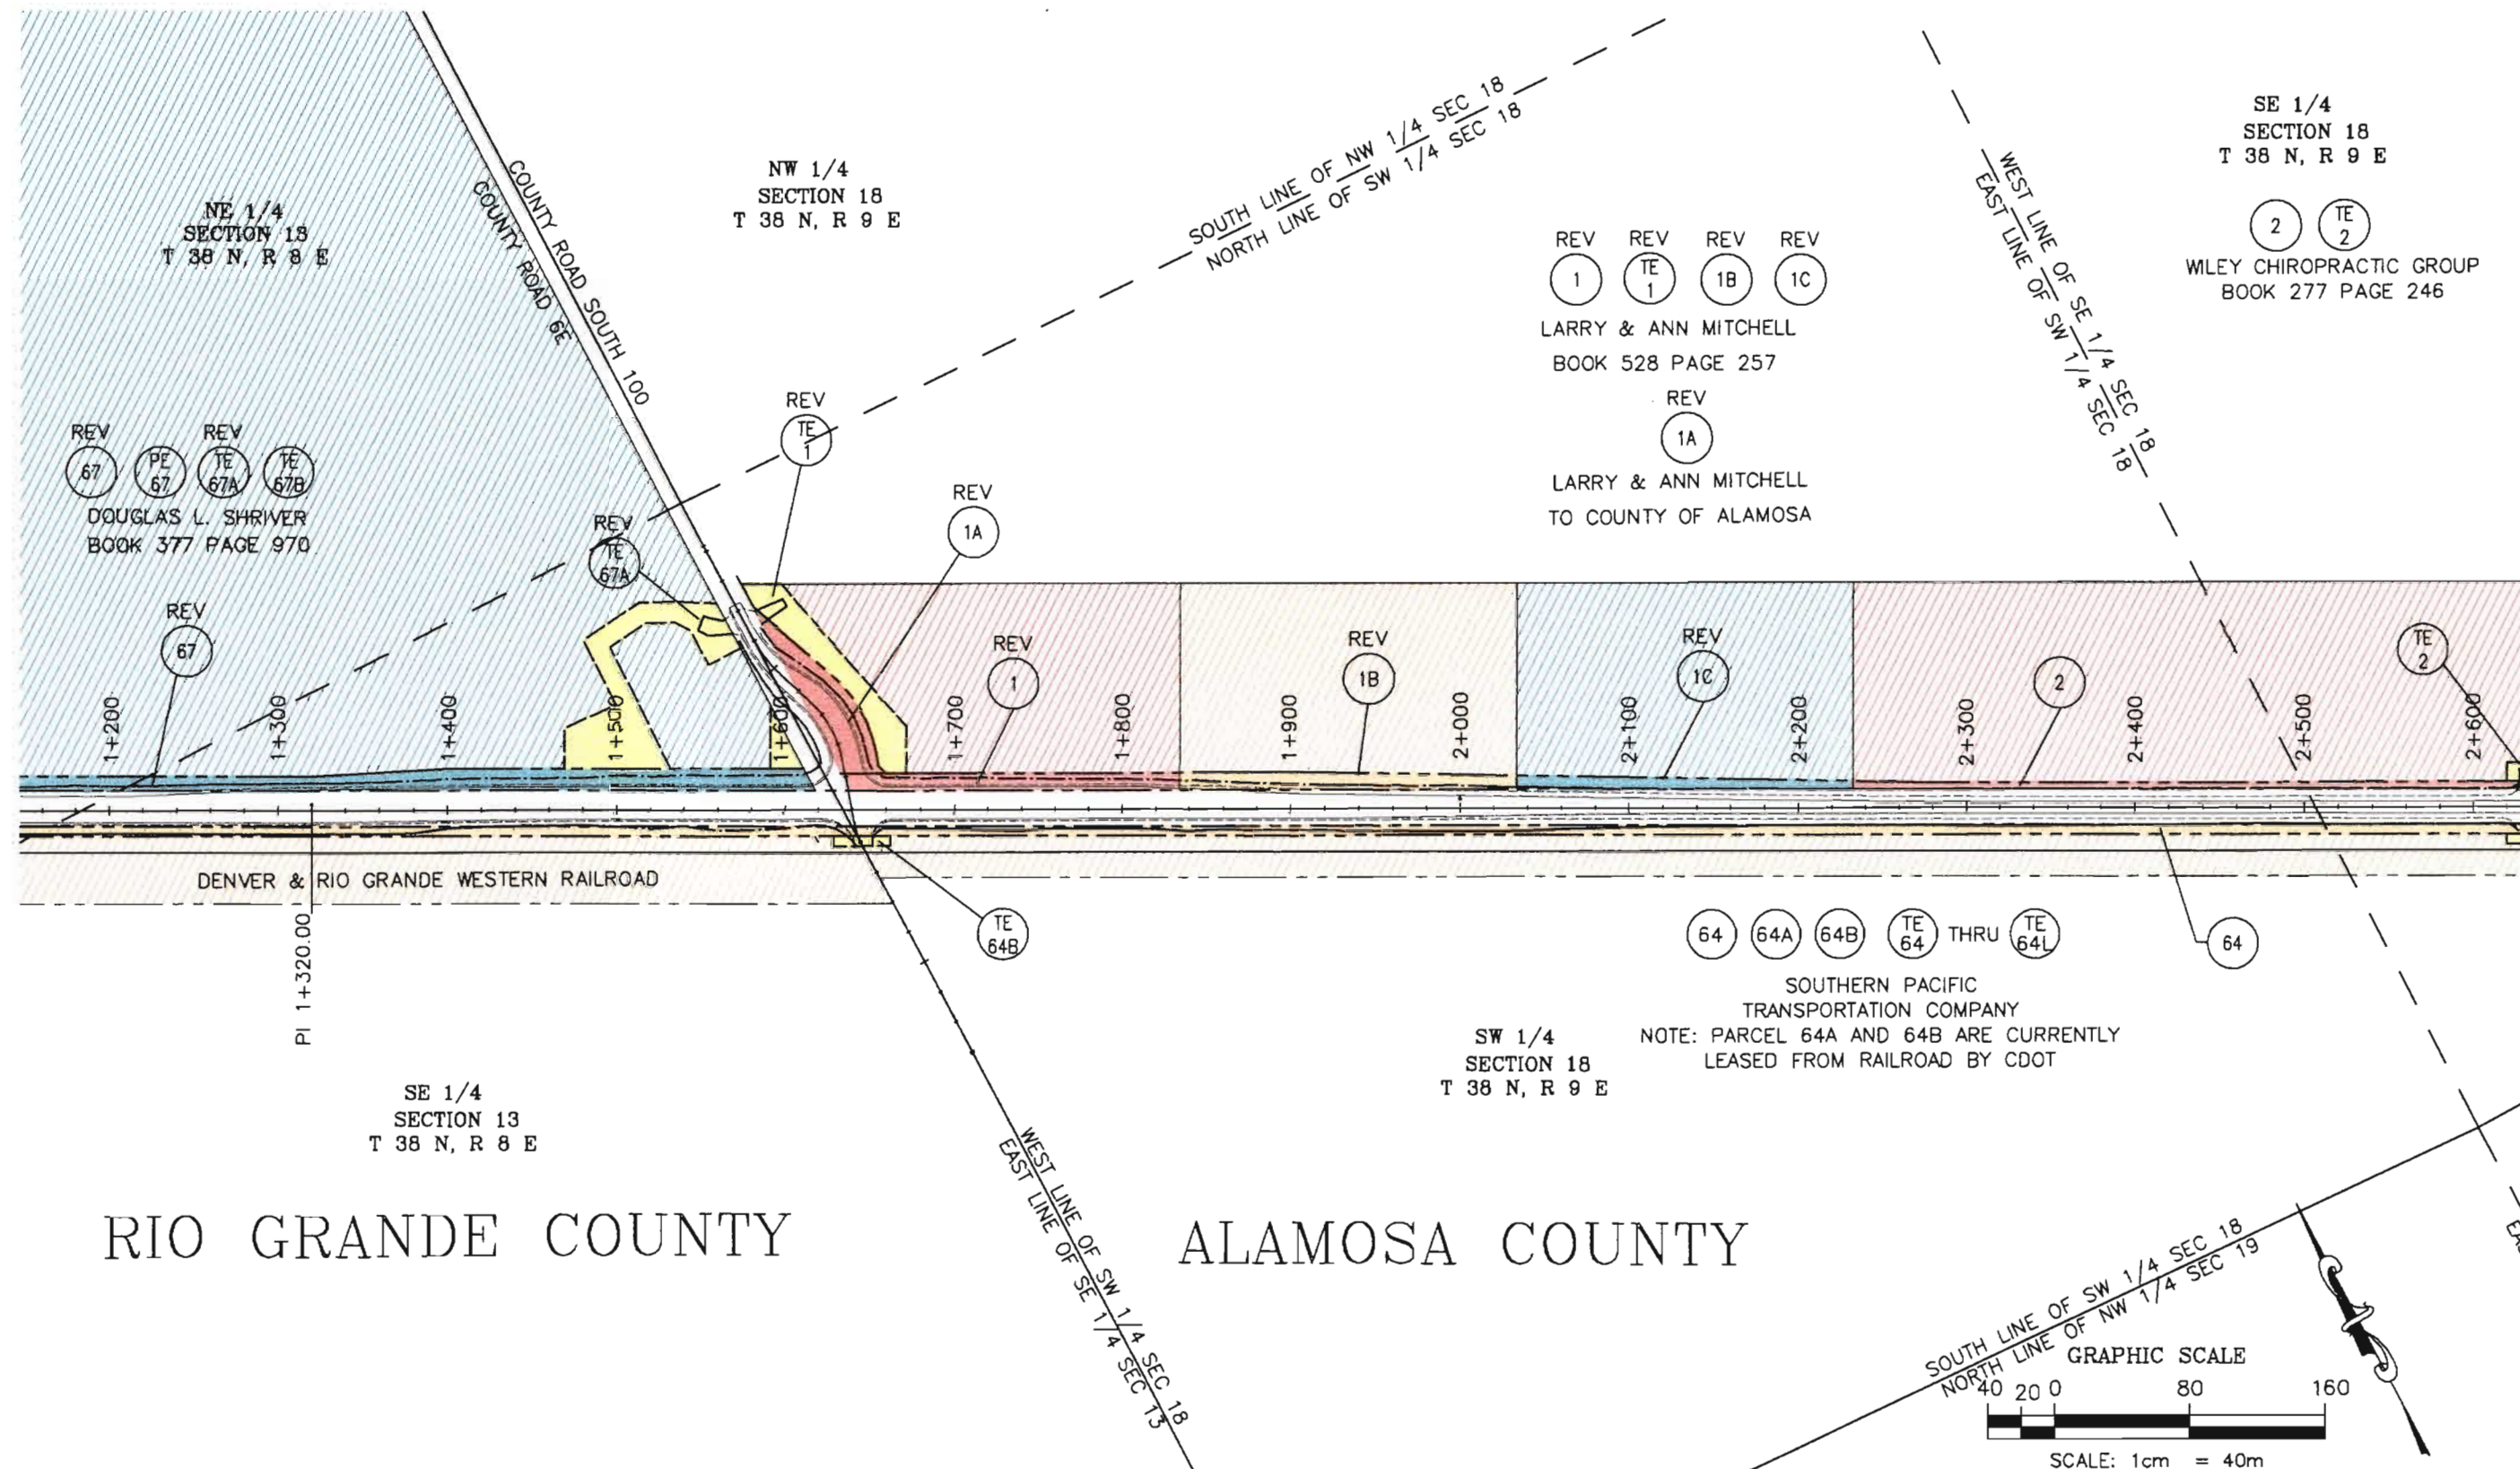


Computer File Information			Index of Revisions			As Constructed			OWNERSHIP PLAN			Project No./Code	
Creation Date: 10/24/97	Initials: JTO		(R1)	12/1/97	PARCEL 67, TE-67, 1, 1A,		No Revisions:		C. R. 6E TO CRAFT DR.			NH 1602-058	
Last Modification Date: 10/31/97	Initials: JTO		(R2A)	5/8/98	PARCEL PE-67, TE-67AREV,		Revised:		Designer:			10578	
Full Path: BEAST F:\JOBS\CDOT\5657-003\PHASE-ONE					TE-1REV		Void:		Detailer: JTO			Sheet Number: 52	
Drawing File Name: P-10OWNER PLAN1.DWG									Sheet Subset: Ownership			Subset Sheets: 2 of 12	
Acad Ver. R14	Scale: 1:4000	Units: METRIC											

Colorado Department of Transportation



Region 5

3803 North Main Avenue, Suite 300
Durango, Colorado 81301
Phone: 970-385-1400 FAX: 970-385-1410

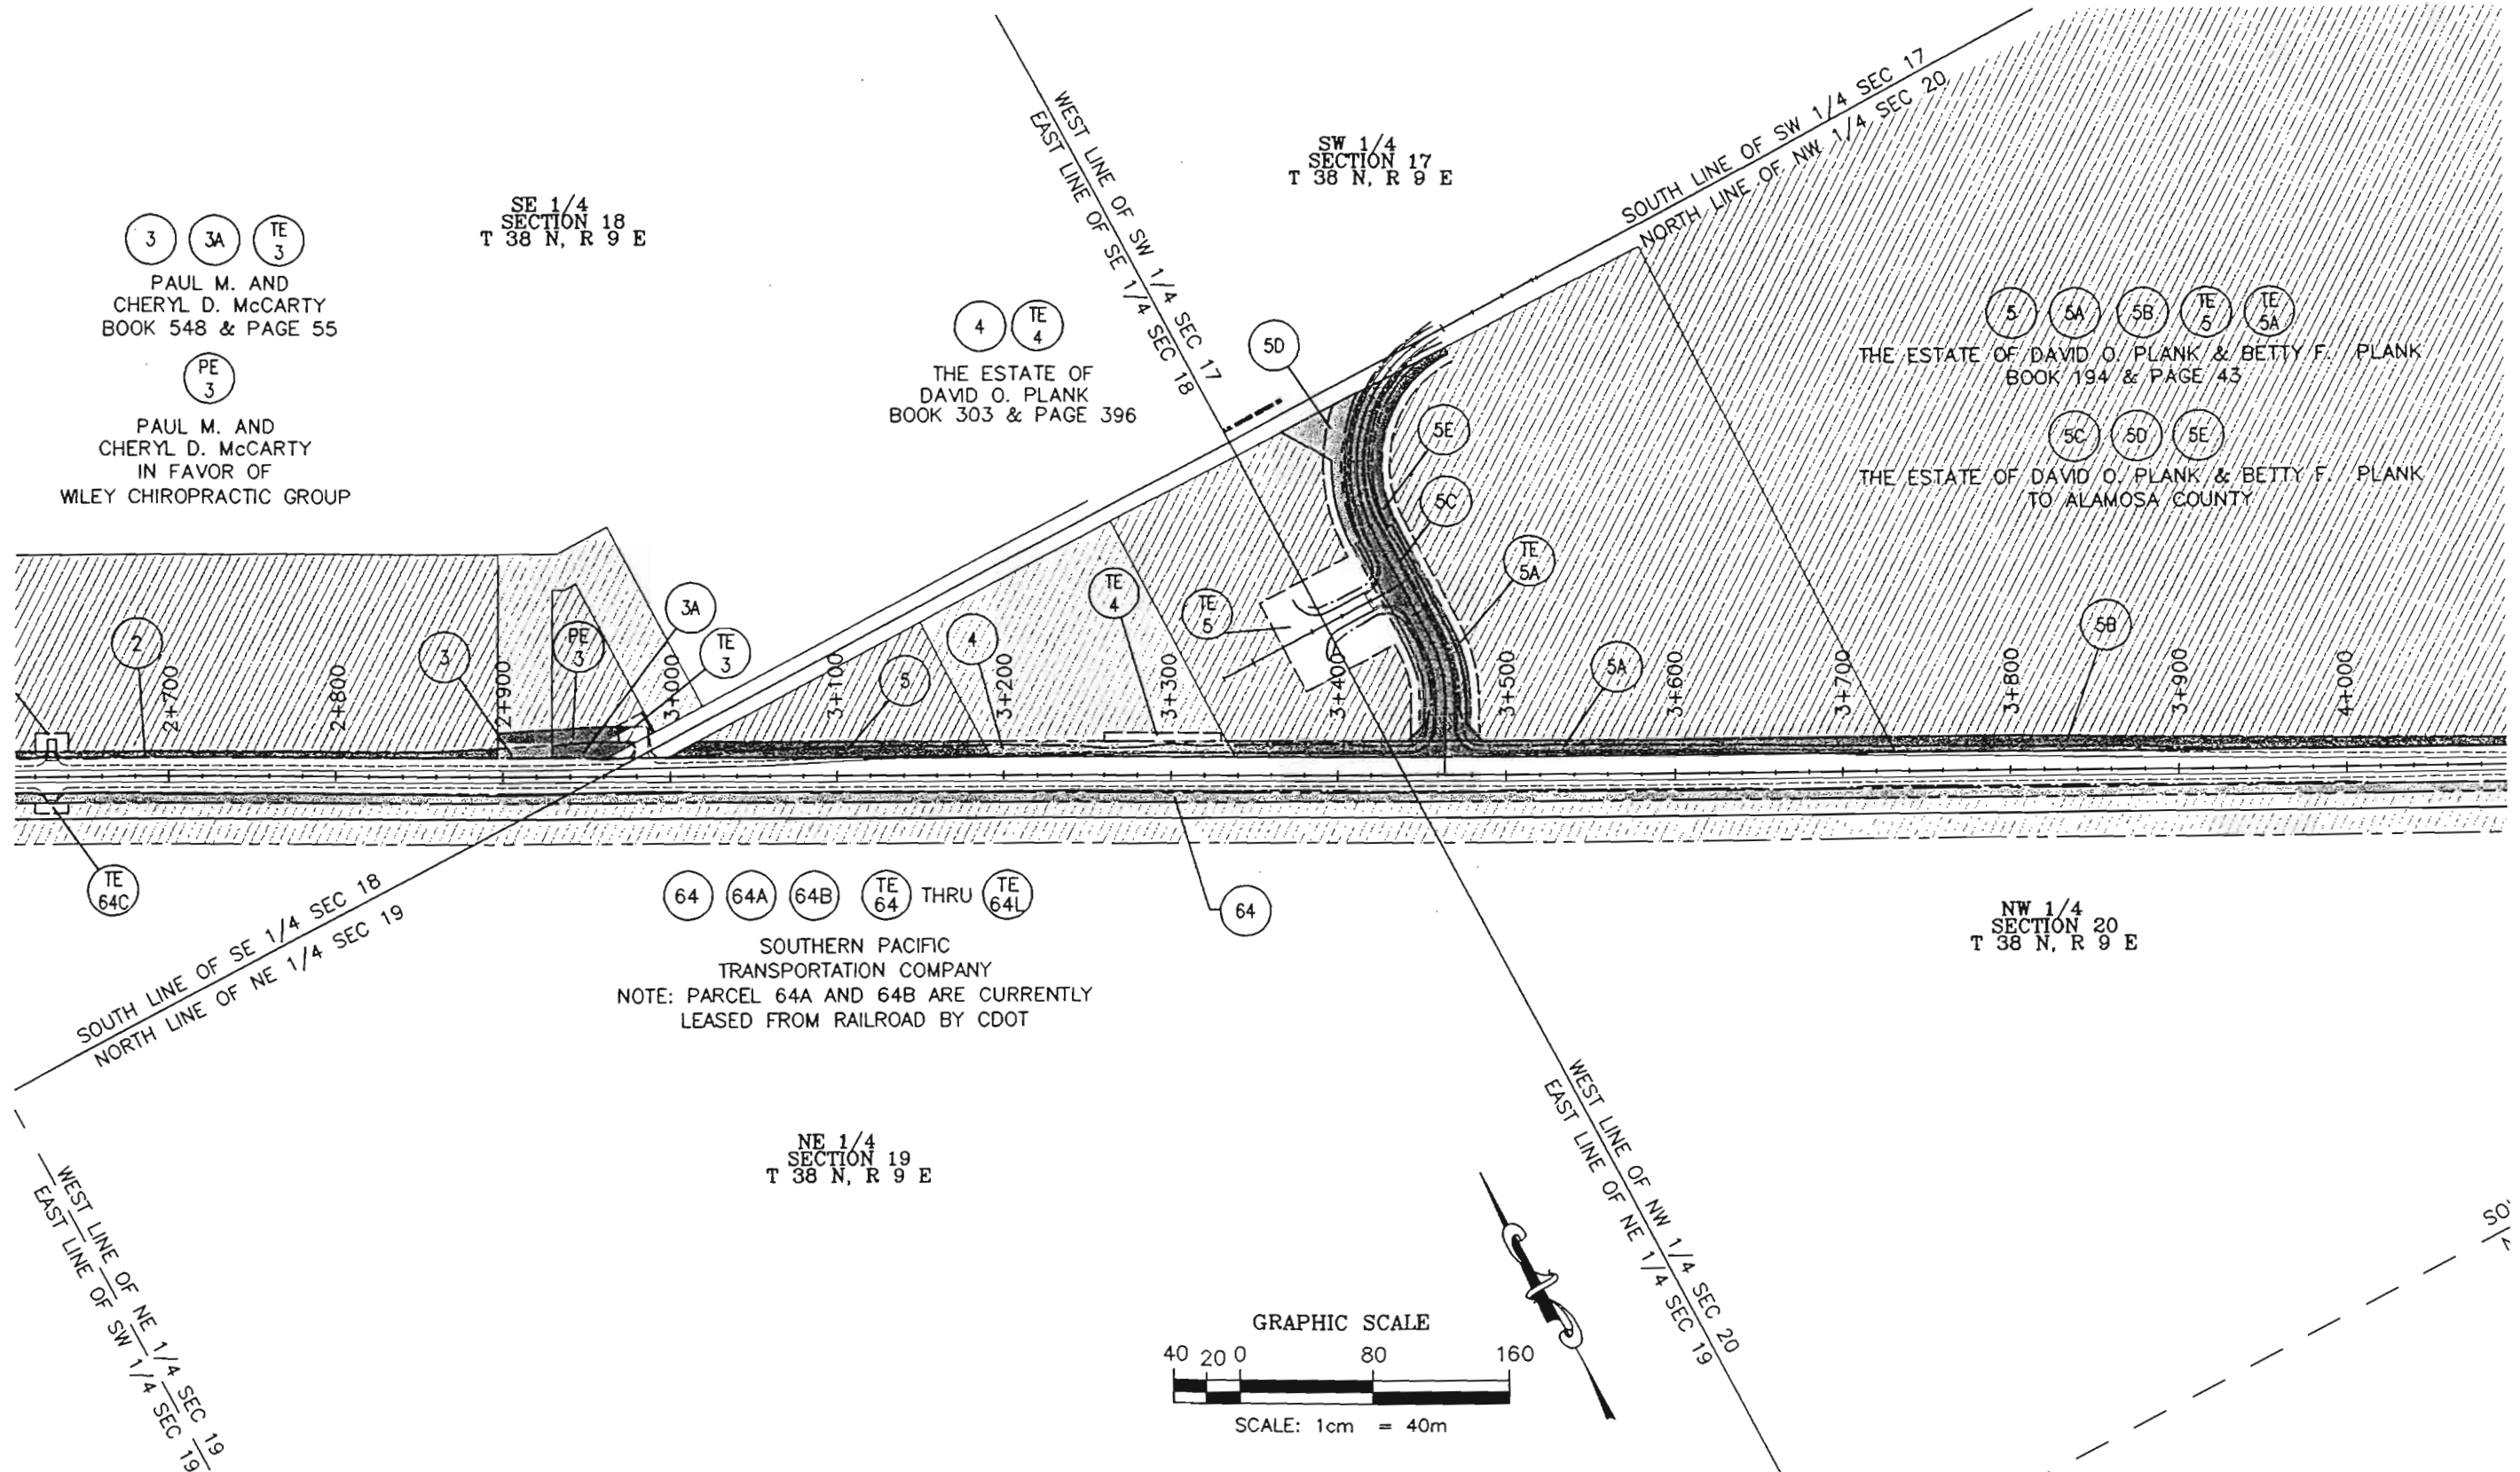

Computer File Information			Index of Revisions			As Constructed		OWNERSHIP PLAN		Project No./Code	
Creation Date: 10/24/97	Initials: JTO	☒	5/11/98	PARCEL PE-3	EDC	No Revisions:		C. R. 6E TO CRAFT DR.		NH 1602-058	
Last Modification Date: 03/01/2000	Initials: JHL	☐				Revised:		Designer:		10578	
Full Path: BEAST F:\JOBS\CDOT\5657-003\PHASE-ONE		☐				Void:		Detailer: JTO			
Drawing File Name: P-10OWNER PLAN1.DWG		☐						Sheet Subset: Ownership	Subset Sheets: 3 of 12	Sheet Number: 53	
Acad Ver. R14	Scale: 1:4000	Units: METRIC									



Colorado Department of Transportation
Region 5


3803 North Main Avenue, Suite 300
Durango, Colorado 81301
Phone: 970-385-1400 FAX: 970-385-1410


Colorado Department of Transportation

DOT

3803 North Main Avenue, Suite 300
Durango, Colorado 81301
Phone: 970-385-1400 FAX: 970-385-1410

Region 5

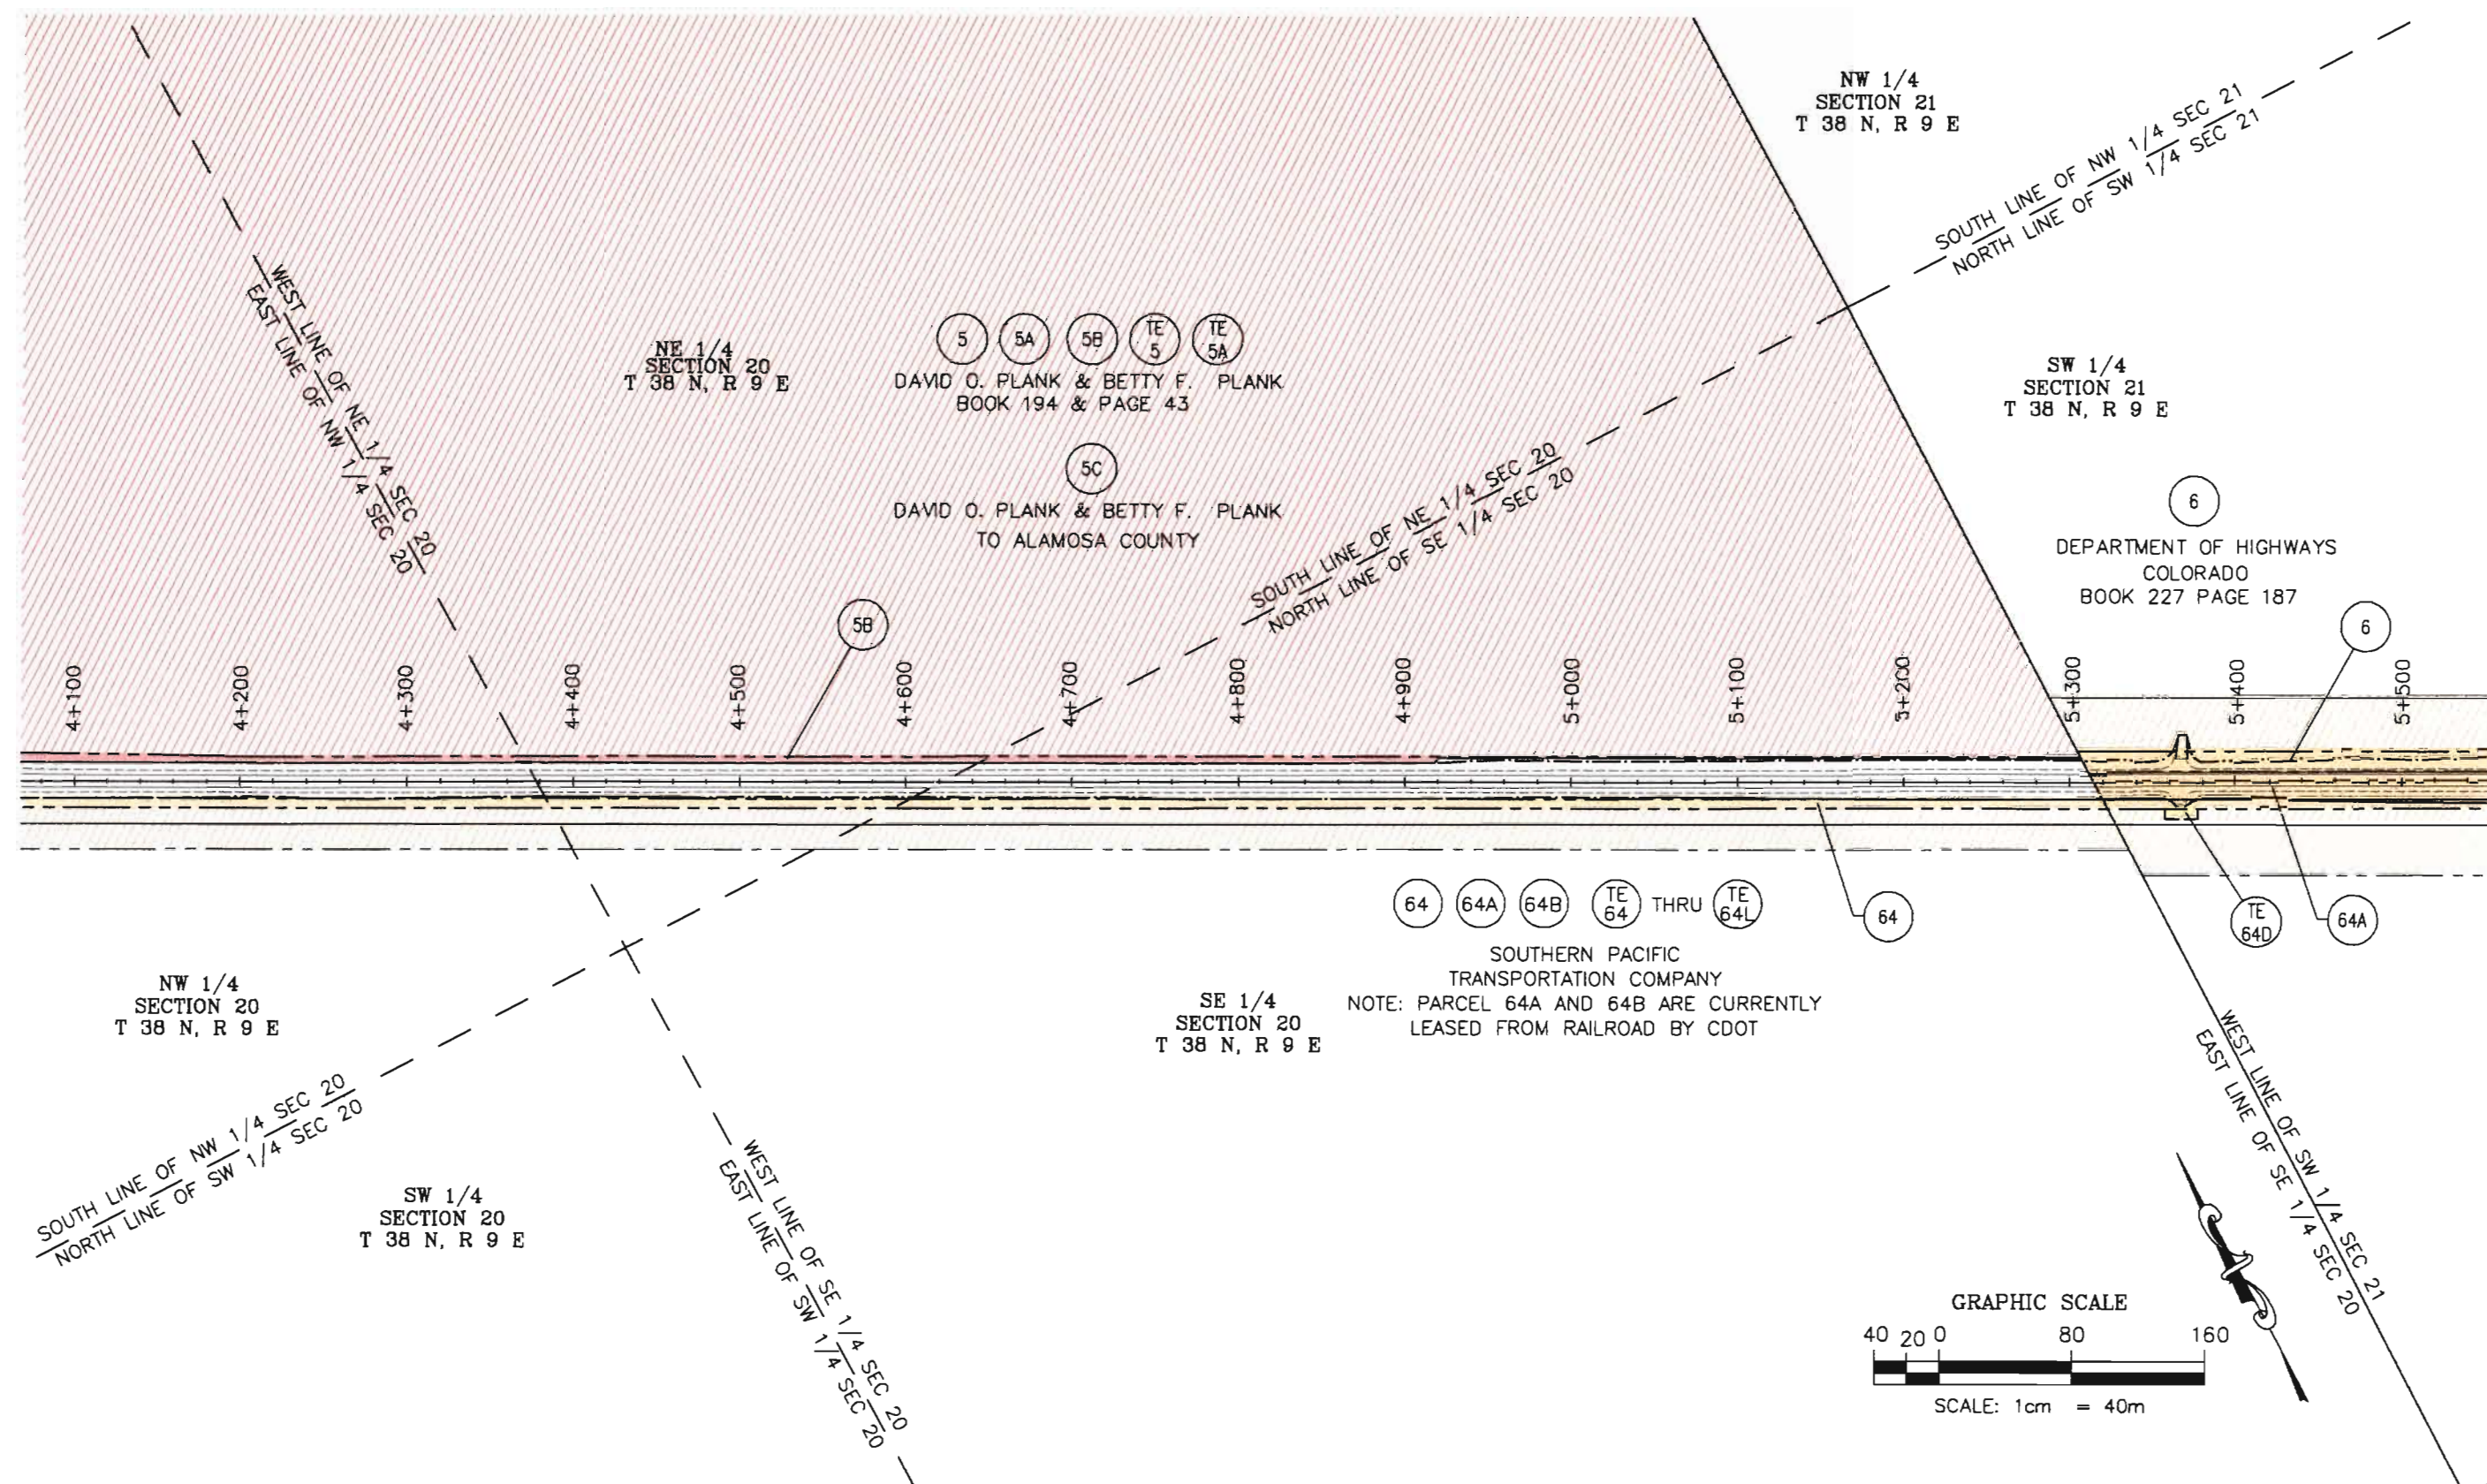

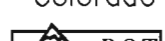Computer File Information			Index of Revisions			Colorado Department of Transportation			As Constructed		OWNERSHIP PLAN			Project No./Code	
Creation Date: 10/24/97		Initials: JTO	☐			 3803 North Main Avenue, Suite 300 Durango, Colorado 81301 Phone: 970-385-1400 FAX: 970-385-1410 Region 5	No Revisions:		C. R. 6E TO CRAFT DR.					NH 1602-058	
Last Modification Date: 10/31/97		Initials: JTO	☐				Revised:							Designer:	
Full Path: BEAST F:\JOBS\CDOT\5657-003\PHASE-ONE			☐				Void:		Detailer: JTO						
Drawing File Name: P-10OWNER PLAN1.DWG			☐						Sheet Subset: Ownership		Subset Sheets: 4 of 12		Sheet Number: 54		
Acad Ver. R14		Scale: 1:4000	Units: METRIC	☐											

SW 1/4
SECTION 21
T 38 N, R 9 E

TE 68
COUNTY OF ALAMOSA
BOOK 84 PAGE 466

SE 1/4
SECTION 21
T 38 N, R 9 E

9
RAJIV BADHWAR, TRUSTEE
BOOK 276 PAGE 39

8
HOWARD CATALANO
REC. NO. 283890


7
BILL RUSH
BOOK 453 PAGE 328

6
DEPARTMENT OF HIGHWAYS
COLORADO
BOOK 227 PAGE 187

64 64A 64B TE 64 THRU TE 64L
SOUTHERN PACIFIC
TRANSPORTATION COMPANY
NOTE: PARCEL 64A AND 64B ARE CURRENTLY
LEASED FROM RAILROAD BY CDOT

NE 1/4
SECTION 28
T 38 N, R 9 E

NW 1/4
SECTION 28
T 38 N, R 9 E

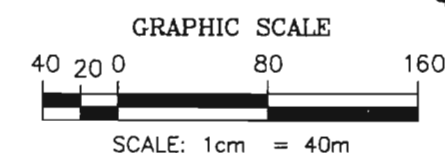

Computer File Information

Creation Date: 10/24/97 Initials: JTO
Last Modification Date: 10/31/97 Initials: JTO
Full Path: BEAST F:\JOBS\CDOT\5657-003\PHASE-ONE
Drawing File Name: P-1OWNER PLAN1.DWG
Acad Ver. R14 Scale: 1:4000 Units: METRIC

Index of Revisions

☐
☐
Colorado Department of Transportation



Region 5

3803 North Main Avenue, Suite 300
Durango, Colorado 81301
Phone: 970-385-1400 FAX: 970-385-1410

As Constructed

No Revisions:

Revised:

Void:

OWNERSHIP PLAN

C. R. 6E TO CRAFT DR.

Designer:

Detailer: JTO

Sheet Subset: Ownership

Subset Sheets: 5 of 12

Project No./Code

NH 1602-058

10578

Sheet Number: 55

NE 1/4
SECTION 27
T 38 N, R 9 E

(13) (13A) (TE 13)
ELMA G. WHITE
BOOK 159 PAGE 436

(14) (PE 14)
DANNY GAIL JOHNSON
BOOK 455 PAGE 324
NOTE: PE-14 IN FAVOR OF
COMMONWEALTH IRRIGATION CO.

(10)
ROBERT B. &
JENNY E. MARQUEZ
BOOK 269 PAGE 79

(11) (TE 11)
MONTE H. AND MARCIA M. COLLINS
BOOK 365 PAGE 73

(12) (TE 12)
BONIFACIO & RITA REYES
BOOK 400 PAGE 304


(11A)
MONTE H. AND MARCIA M. COLLINS
TO ALAMOSA COUNTY

(64) (64A) (64B) (TE 64) THRU (TE 64L)
SOUTHERN PACIFIC
TRANSPORTATION COMPANY
NOTE: PARCEL 64A AND 64B ARE CURRENTLY
LEASED FROM RAILROAD BY CDOT


NE 1/4
SECTION 28
T 38 N, R 9 E


SW 1/4
SECTION 27
T 38 N, R 9 E


SE 1/4
SECTION 27
T 38 N, R 9 E

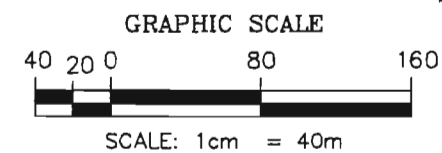


Computer File Information			Index of Revisions			Colorado Department of Transportation		As Constructed		OWNERSHIP PLAN		Project No./Code	
Creation Date: 10/24/97		Initials: JTO	(R2A)	5/8/98	PARCEL TE-12	EDC	 3803 North Main Avenue, Suite 300 Durango, Colorado 81301 Phone: 970-385-1400 FAX: 970-385-1410 Region 5	No Revisions:		C. R. 6E TO CRAFT DR.		NH 1602-058	
Last Modification Date: 10/31/97		Initials: JTO				Revised:		Designer:			10578		
Full Path: BEAST F:\JOBS\CDOT\5657-003\PHASE-ONE						Void:		Detailer: JTO			Sheet Number: 56		
Drawing File Name: P-10OWNER PLAN1.DWG						Sheet Subset: Ownership		Subset Sheets: 6 of 12					
Acad Ver. R14	Scale: 1:4000	Units: METRIC											

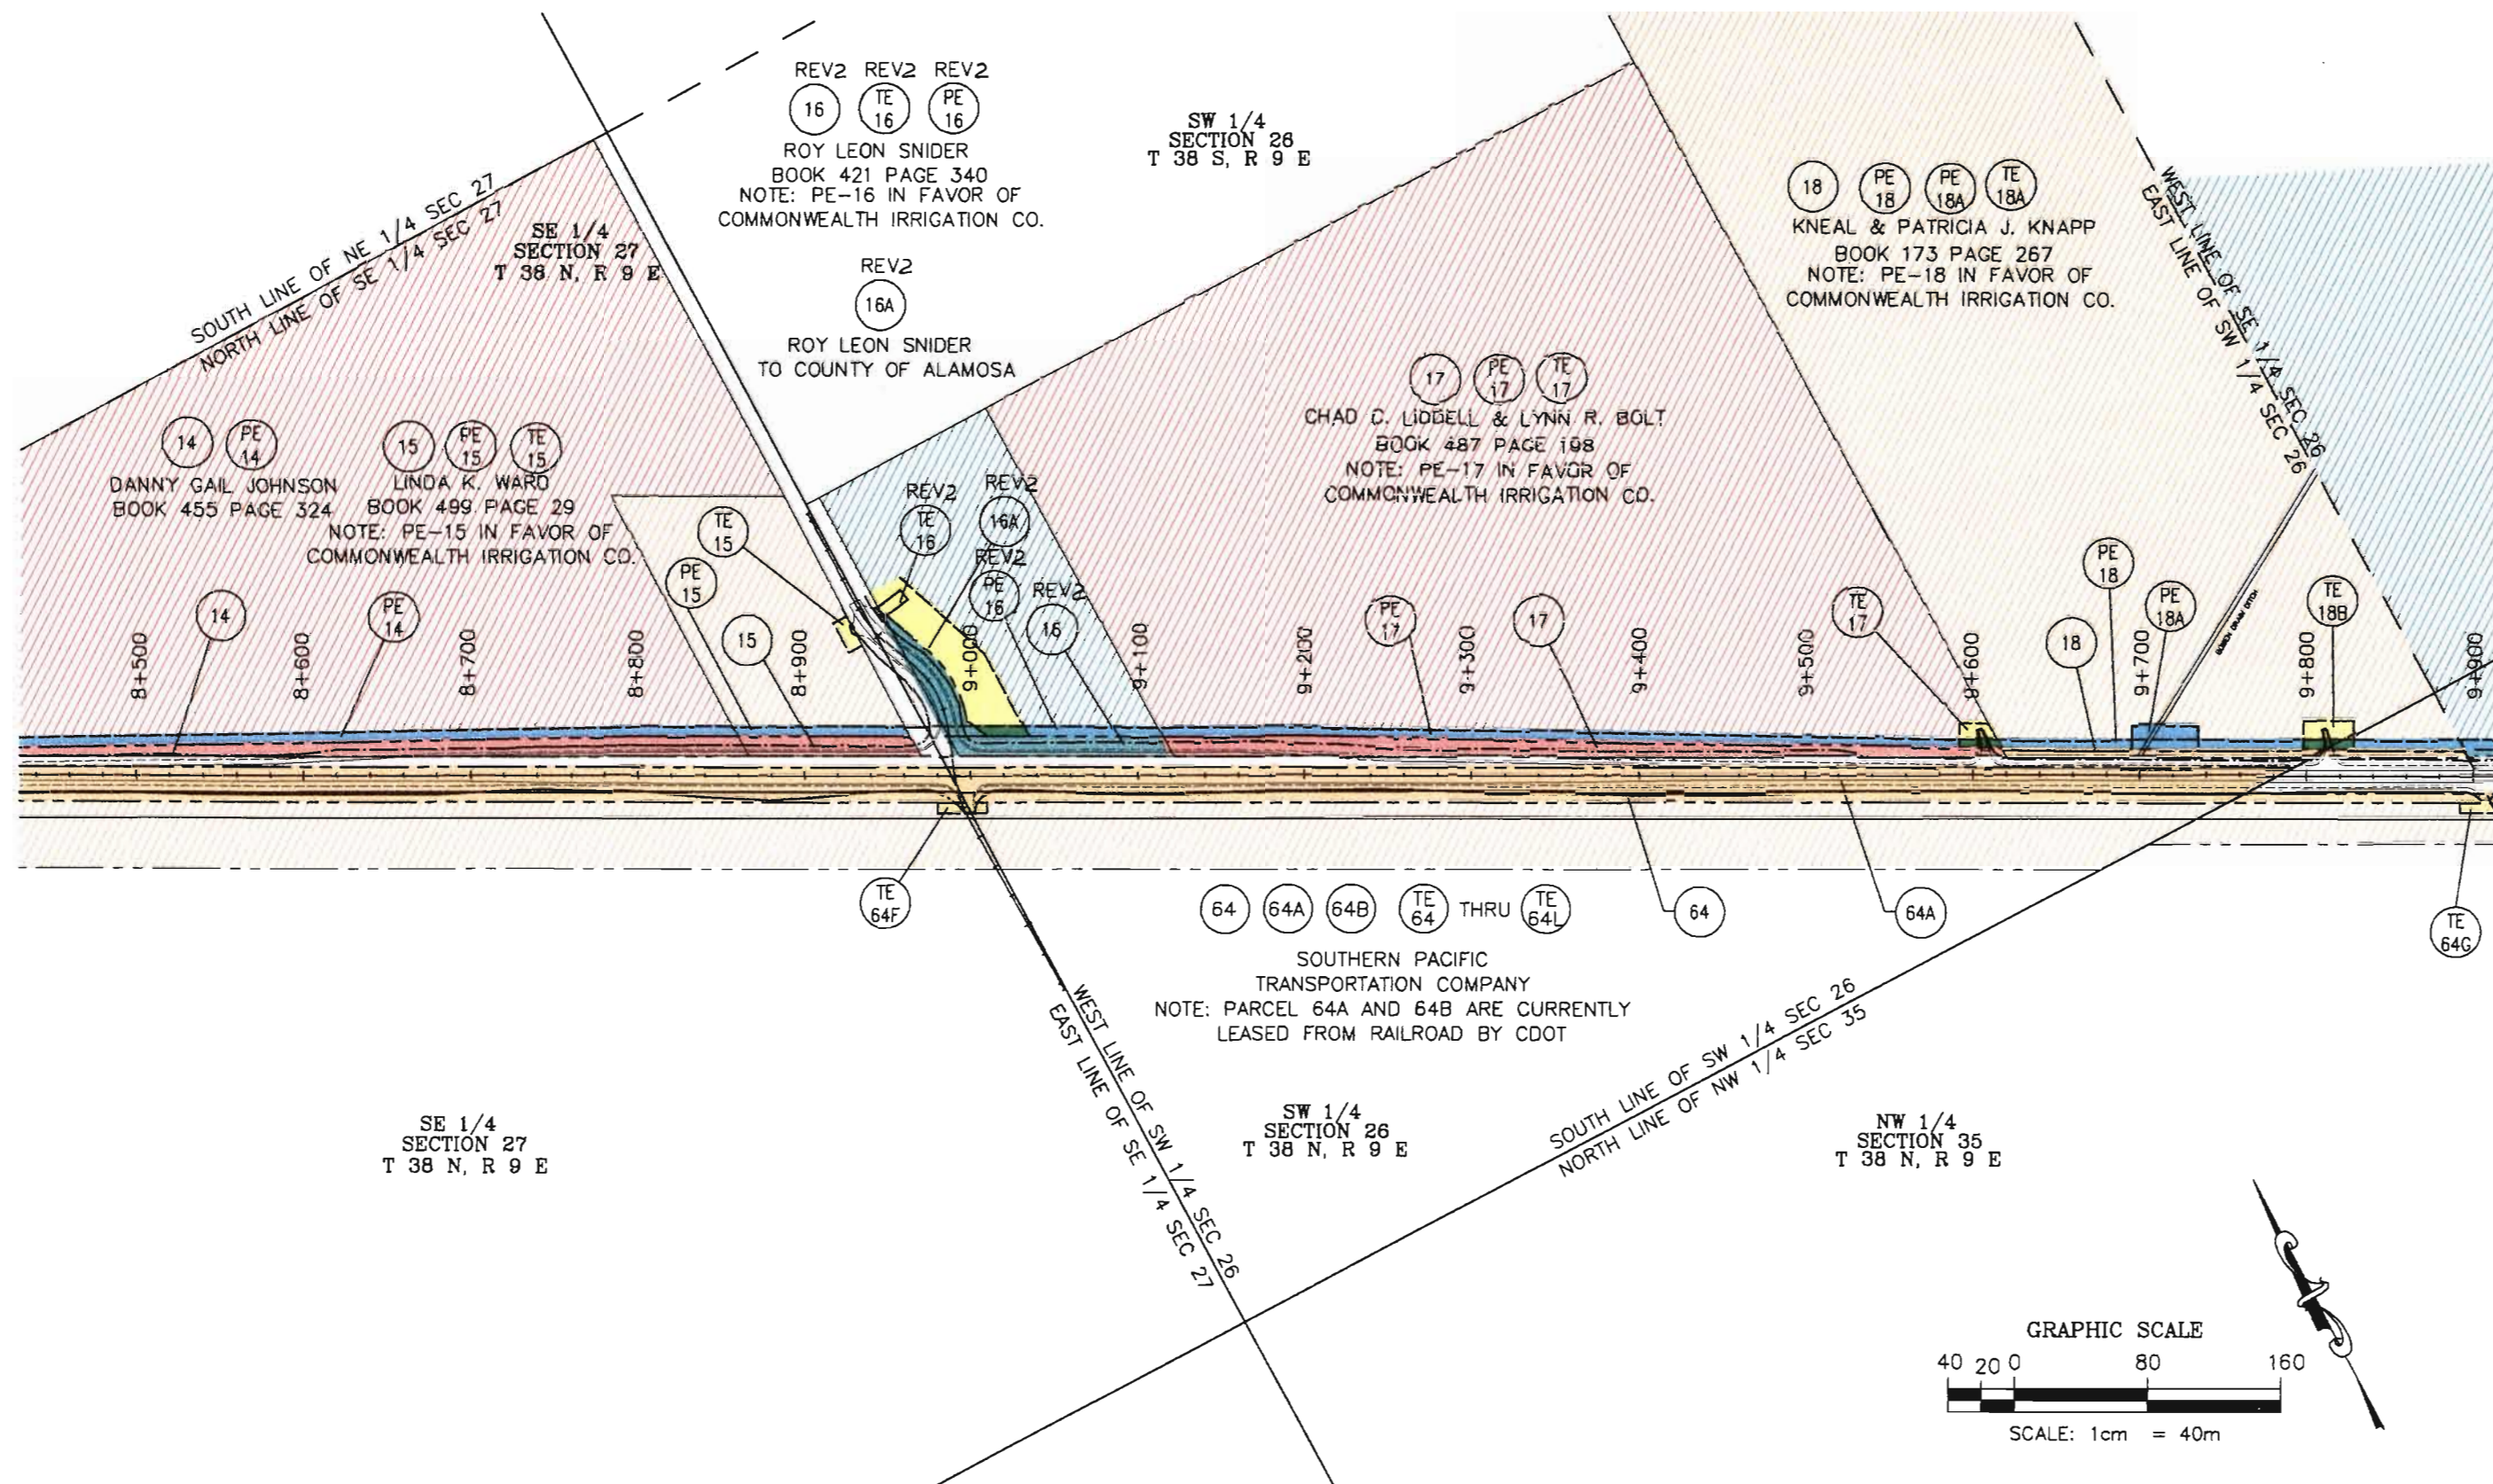

 Computer File Information		Index of Revisions			Colorado Department of Transportation  3803 North Main Avenue, Suite 300 Durango, Colorado 81301 Phone: 970-385-1400 FAX: 970-385-1410 Region 5	As Constructed	OWNERSHIP PLAN		Project No./Code		
Creation Date: 10/24/97	Initials: JTO	(R1)	12/1/97	PARCEL 16, 16A, PE-16,		EDC	No Revisions:	C. R. 6E TO CRAFT DR.		NH 1602-058	
Last Modification Date: 10/31/97	Initials: JTO			TE-16			Revised:	Designer:			10578
Full Path: BEAST F:\JOBS\CDOT\5657-003\PHASE-ONE		(R2A)	5/8/98	PARCEL 15-16et.al.,17, PE-17		EDC		Detailer: JTO			
Drawing File Name: P-10OWNER PLAN1.DWG							Void:	Sheet Subset: Ownership		Subset Sheets: 7 of 12	
Acad Ver. R14	Scale: 1:4000	Units: METRIC						Sheet Number: 57			

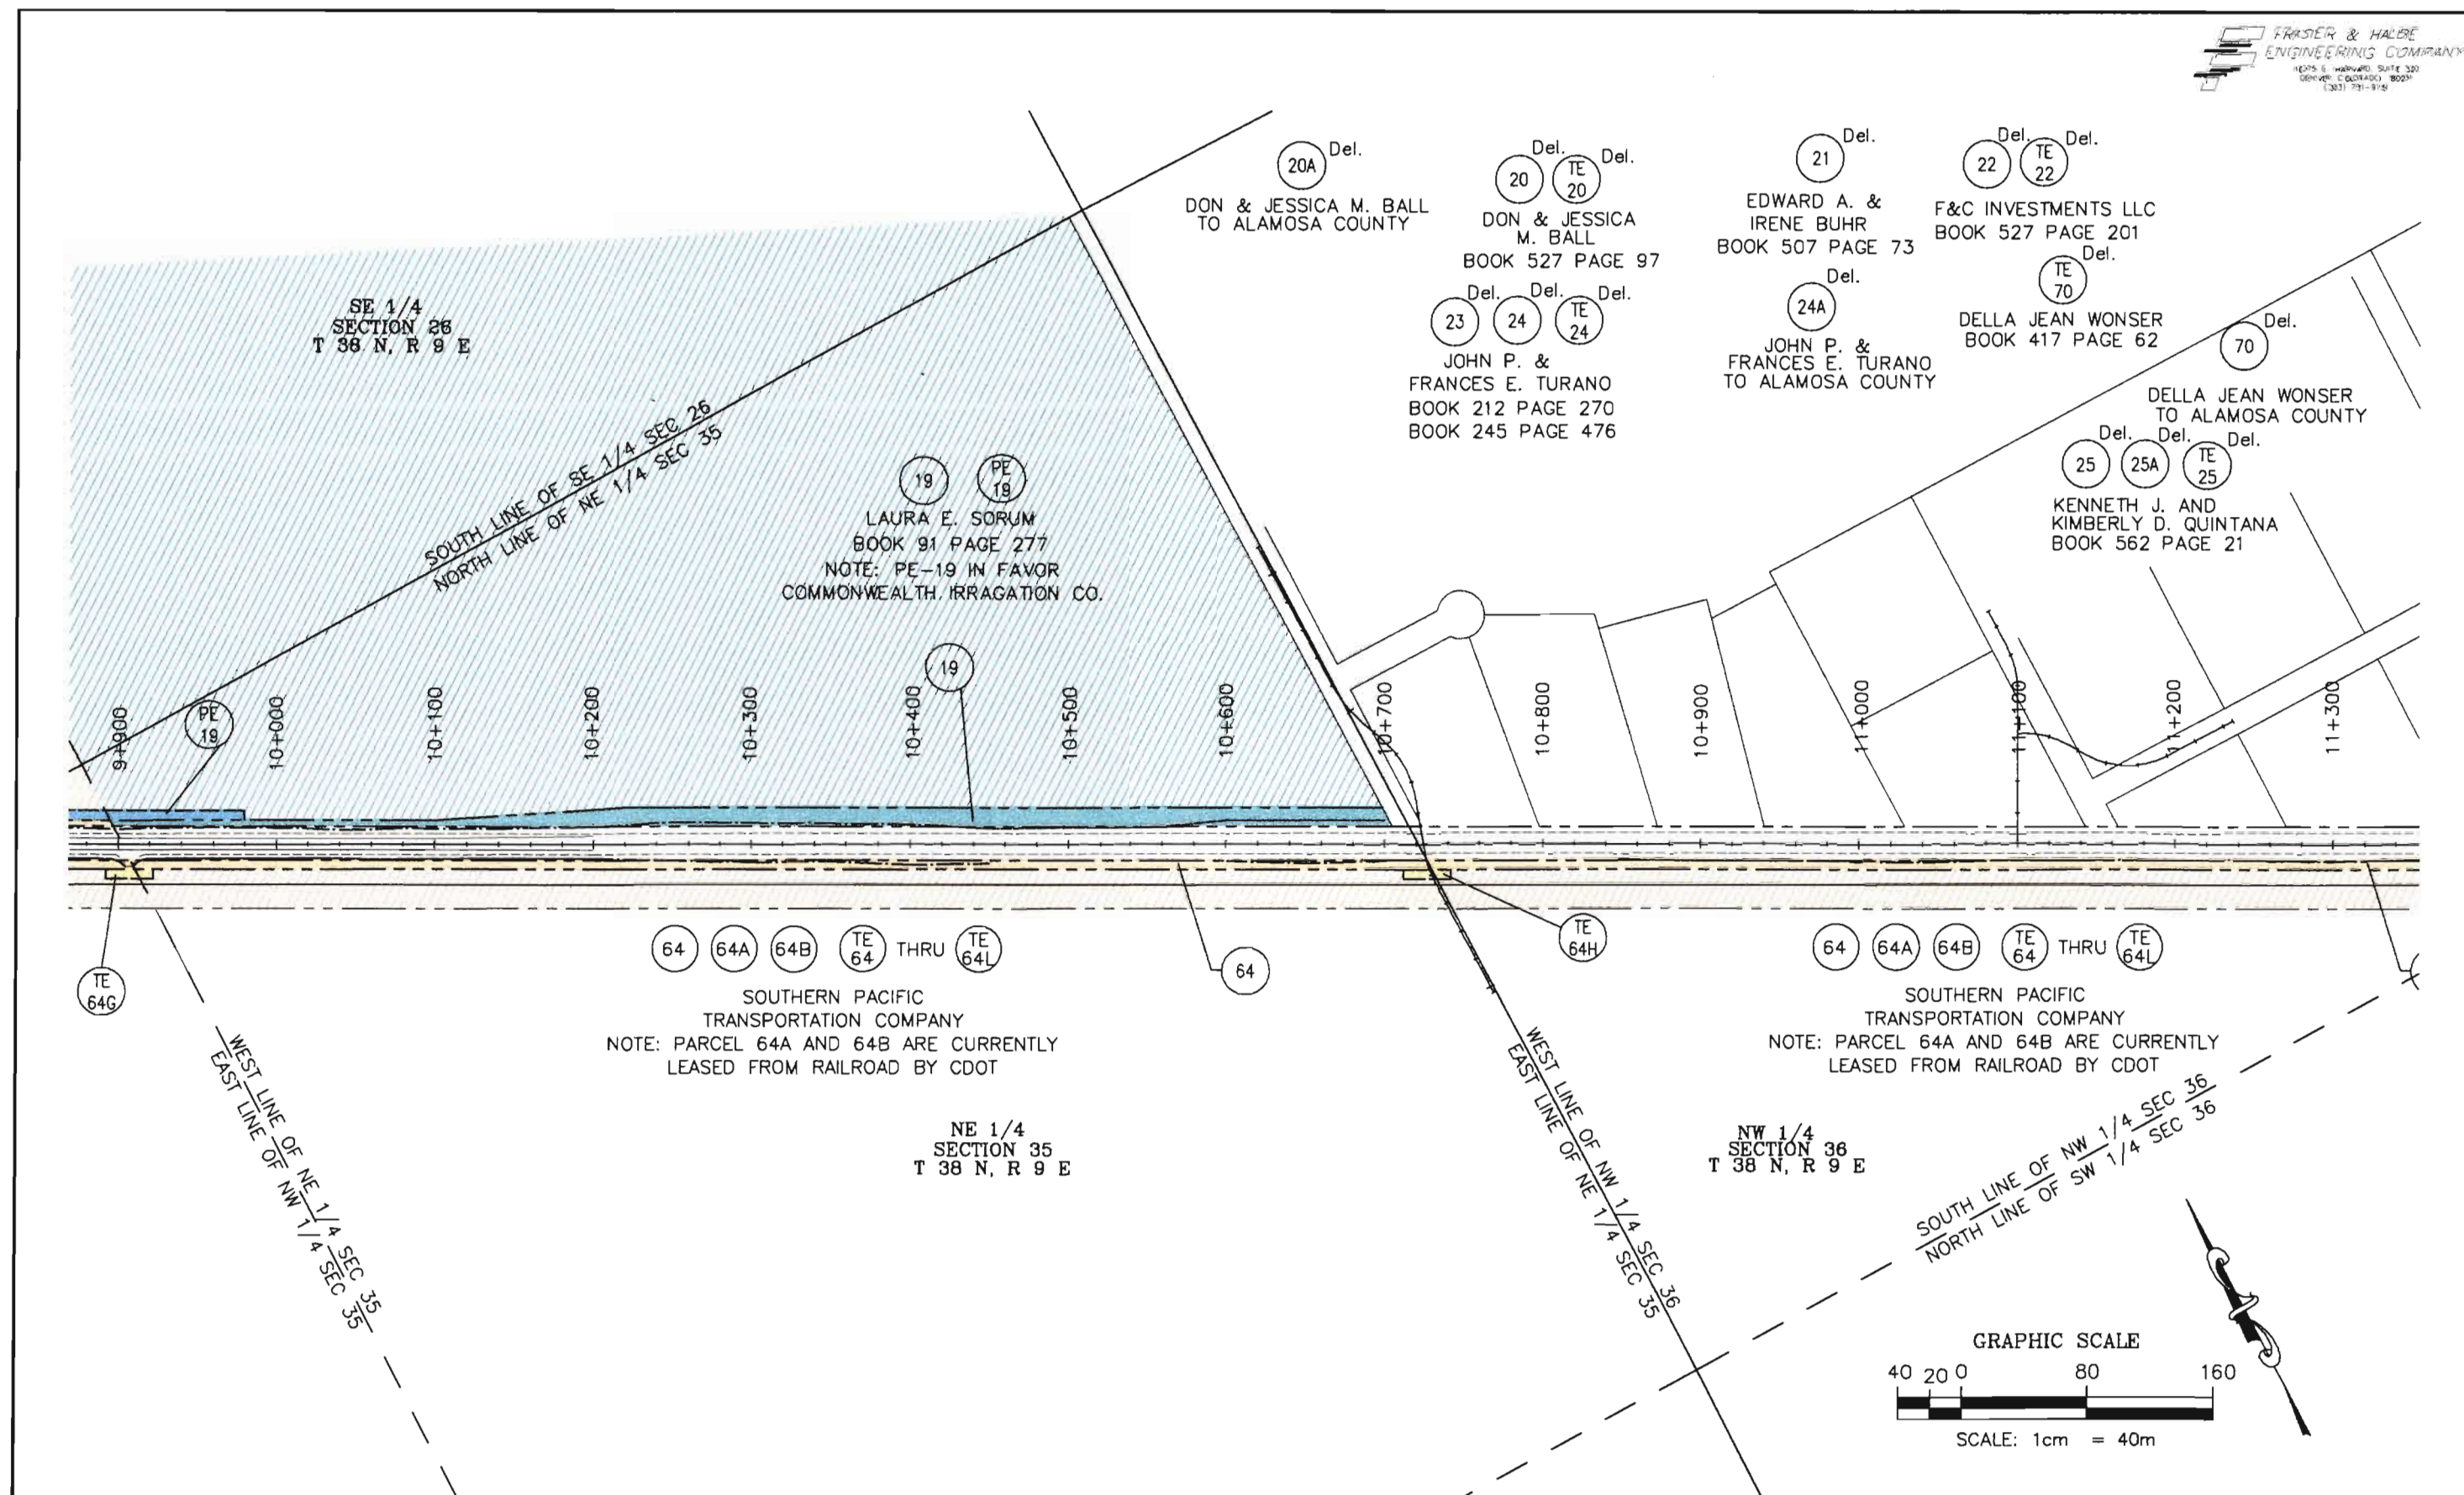


Computer File Information		Index of Revisions			Colorado Department of Transportation		As Constructed		OWNERSHIP PLAN		Project No./Code	
Creation Date: 10/24/97	Initials: JTO	(R2B)	4/6/98	DELETED PARCELS #53-62et.al	EDC	 3803 North Main Avenue, Suite 300 Durango, Colorado 81301 Phone: 970-385-1400 FAX: 970-385-1410 Region 5	No Revisions:		C. R. 6E TO CRAFT DR.		NH 1602-058	
Last Modification Date: 10/31/97	Initials: JTO						Revised:		Designer:		10578	
Full Path: BEAST F:\JOBS\CDOT\5657-003\PHASE-ONE							Void:		Detailer: JTO			
Drawing File Name: P-10OWNER PLAN1.DWG									Sheet Subset: Ownership	Subset Sheets: 8 of 12	Sheet Number: 58	
Acad Ver. R14	Scale: 1:4000	Units: METRIC										

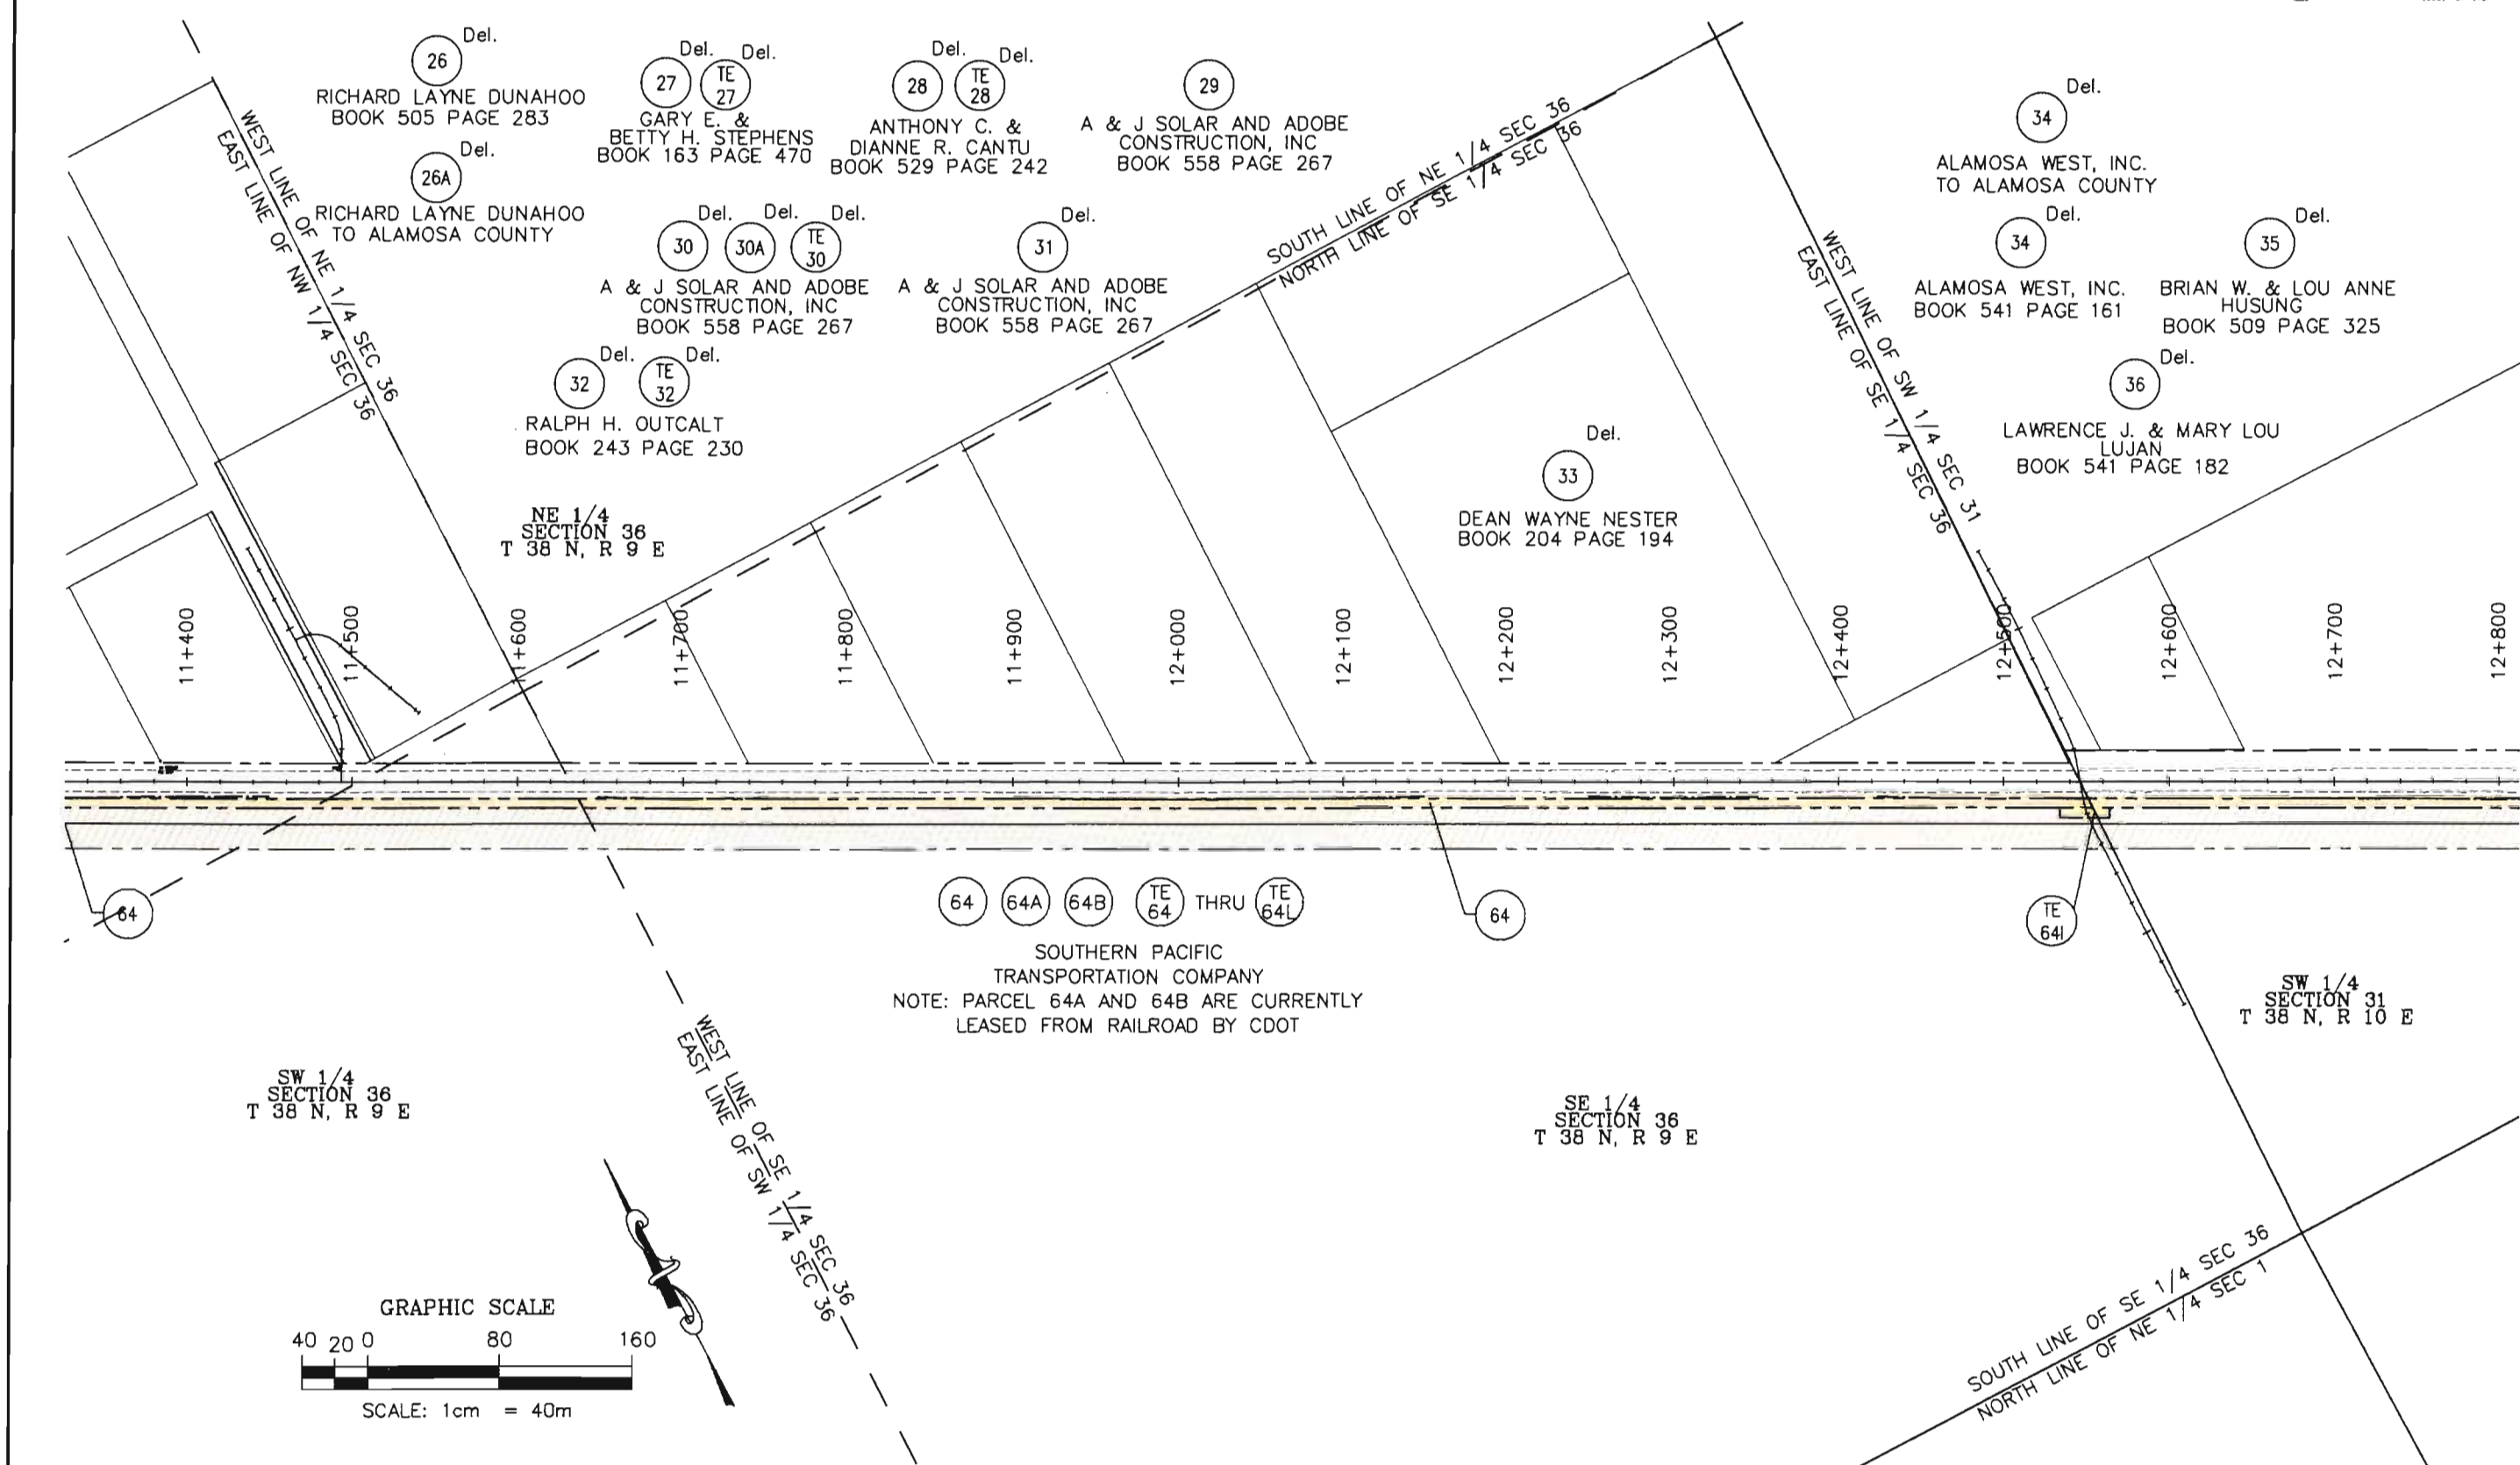


Computer File Information		Index of Revisions			Colorado Department of Transportation		As Constructed		OWNERSHIP PLAN		Project No./Code
Creation Date: 10/24/97	Initials: JTO	(R2B)	4/6/98	DELETED PARCELS #53-62 et al.	EDC		No Revisions:		C. R. 6E TO CRAFT DR.		NH 1602-058
Last Modification Date: 10/31/97	Initials: JTO						Revised:		Designer:		10578
Full Path: BEAST F:\JOBS\CDOT\5657-003\PHASE-ONE									Detailer: JTO		
Drawing File Name: P-1OWNER PLAN1.DWG									Sheet Subset: Ownership		Subset Sheets: 9 of 12
Acad Ver. R14	Scale: 1:4000	Units: METRIC									Sheet Number: 59

3803 North Main Avenue, Suite 300
Durango, Colorado 81301
Phone: 970-385-1400 FAX: 970-385-1410


Region 5

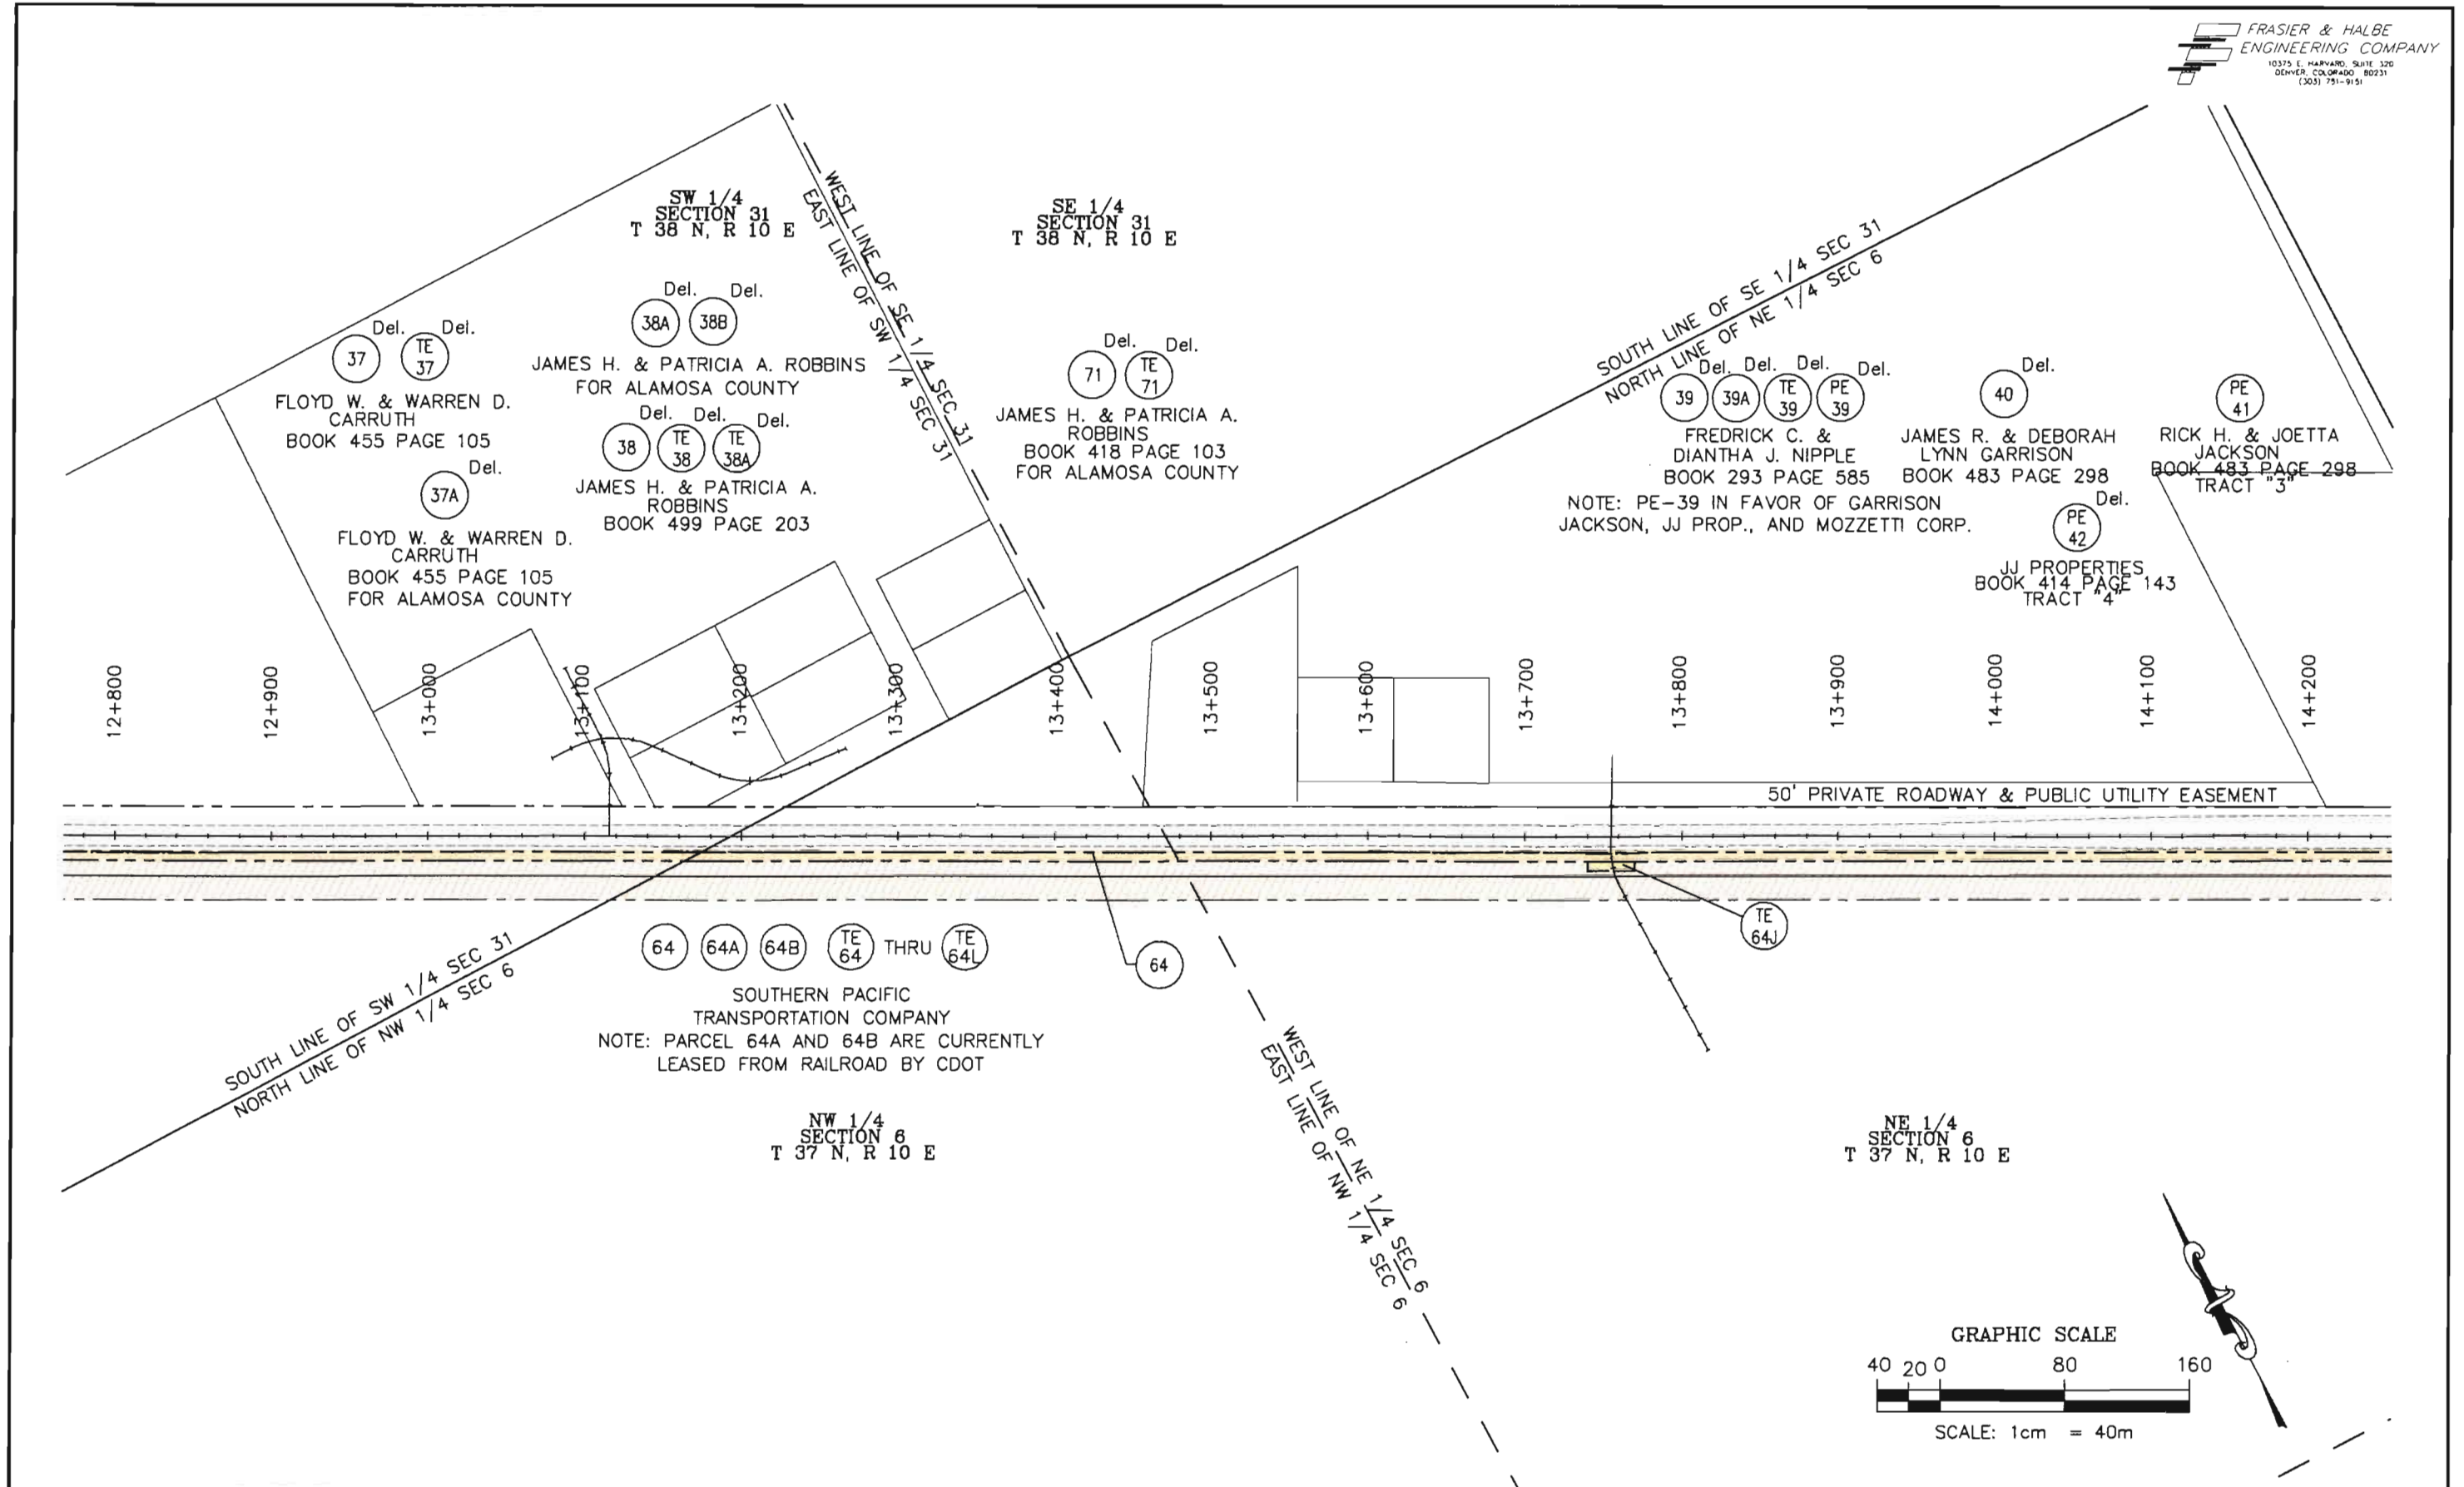

Computer File Information		Index of Revisions		Colorado Department of Transportation		As Constructed		OWNERSHIP PLAN		Project No./Code	
Creation Date: 10/24/97	Initials: JTO	☒ (R2B)	4/6/98	DELETED PARCELS #53-62et.al	EDC	No Revisions:		C. R. 6E TO CRAFT DR.		NH 1602-058	
Last Modification Date: 10/31/97	Initials: JTO	☐				Revised:		Designer:		10578	
Full Path: BEAST F:\JOBS\CDOT\5657-003\PHASE-ONE		☐				Void:		Detailer: JTO			
Drawing File Name: P-10OWNER PLAN1.DWG		☐						Sheet Subset: Ownership	Subset Sheets: 10 of 12		Sheet Number: 60
Acad Ver. R14	Scale: 1:4000	Units: METRIC									

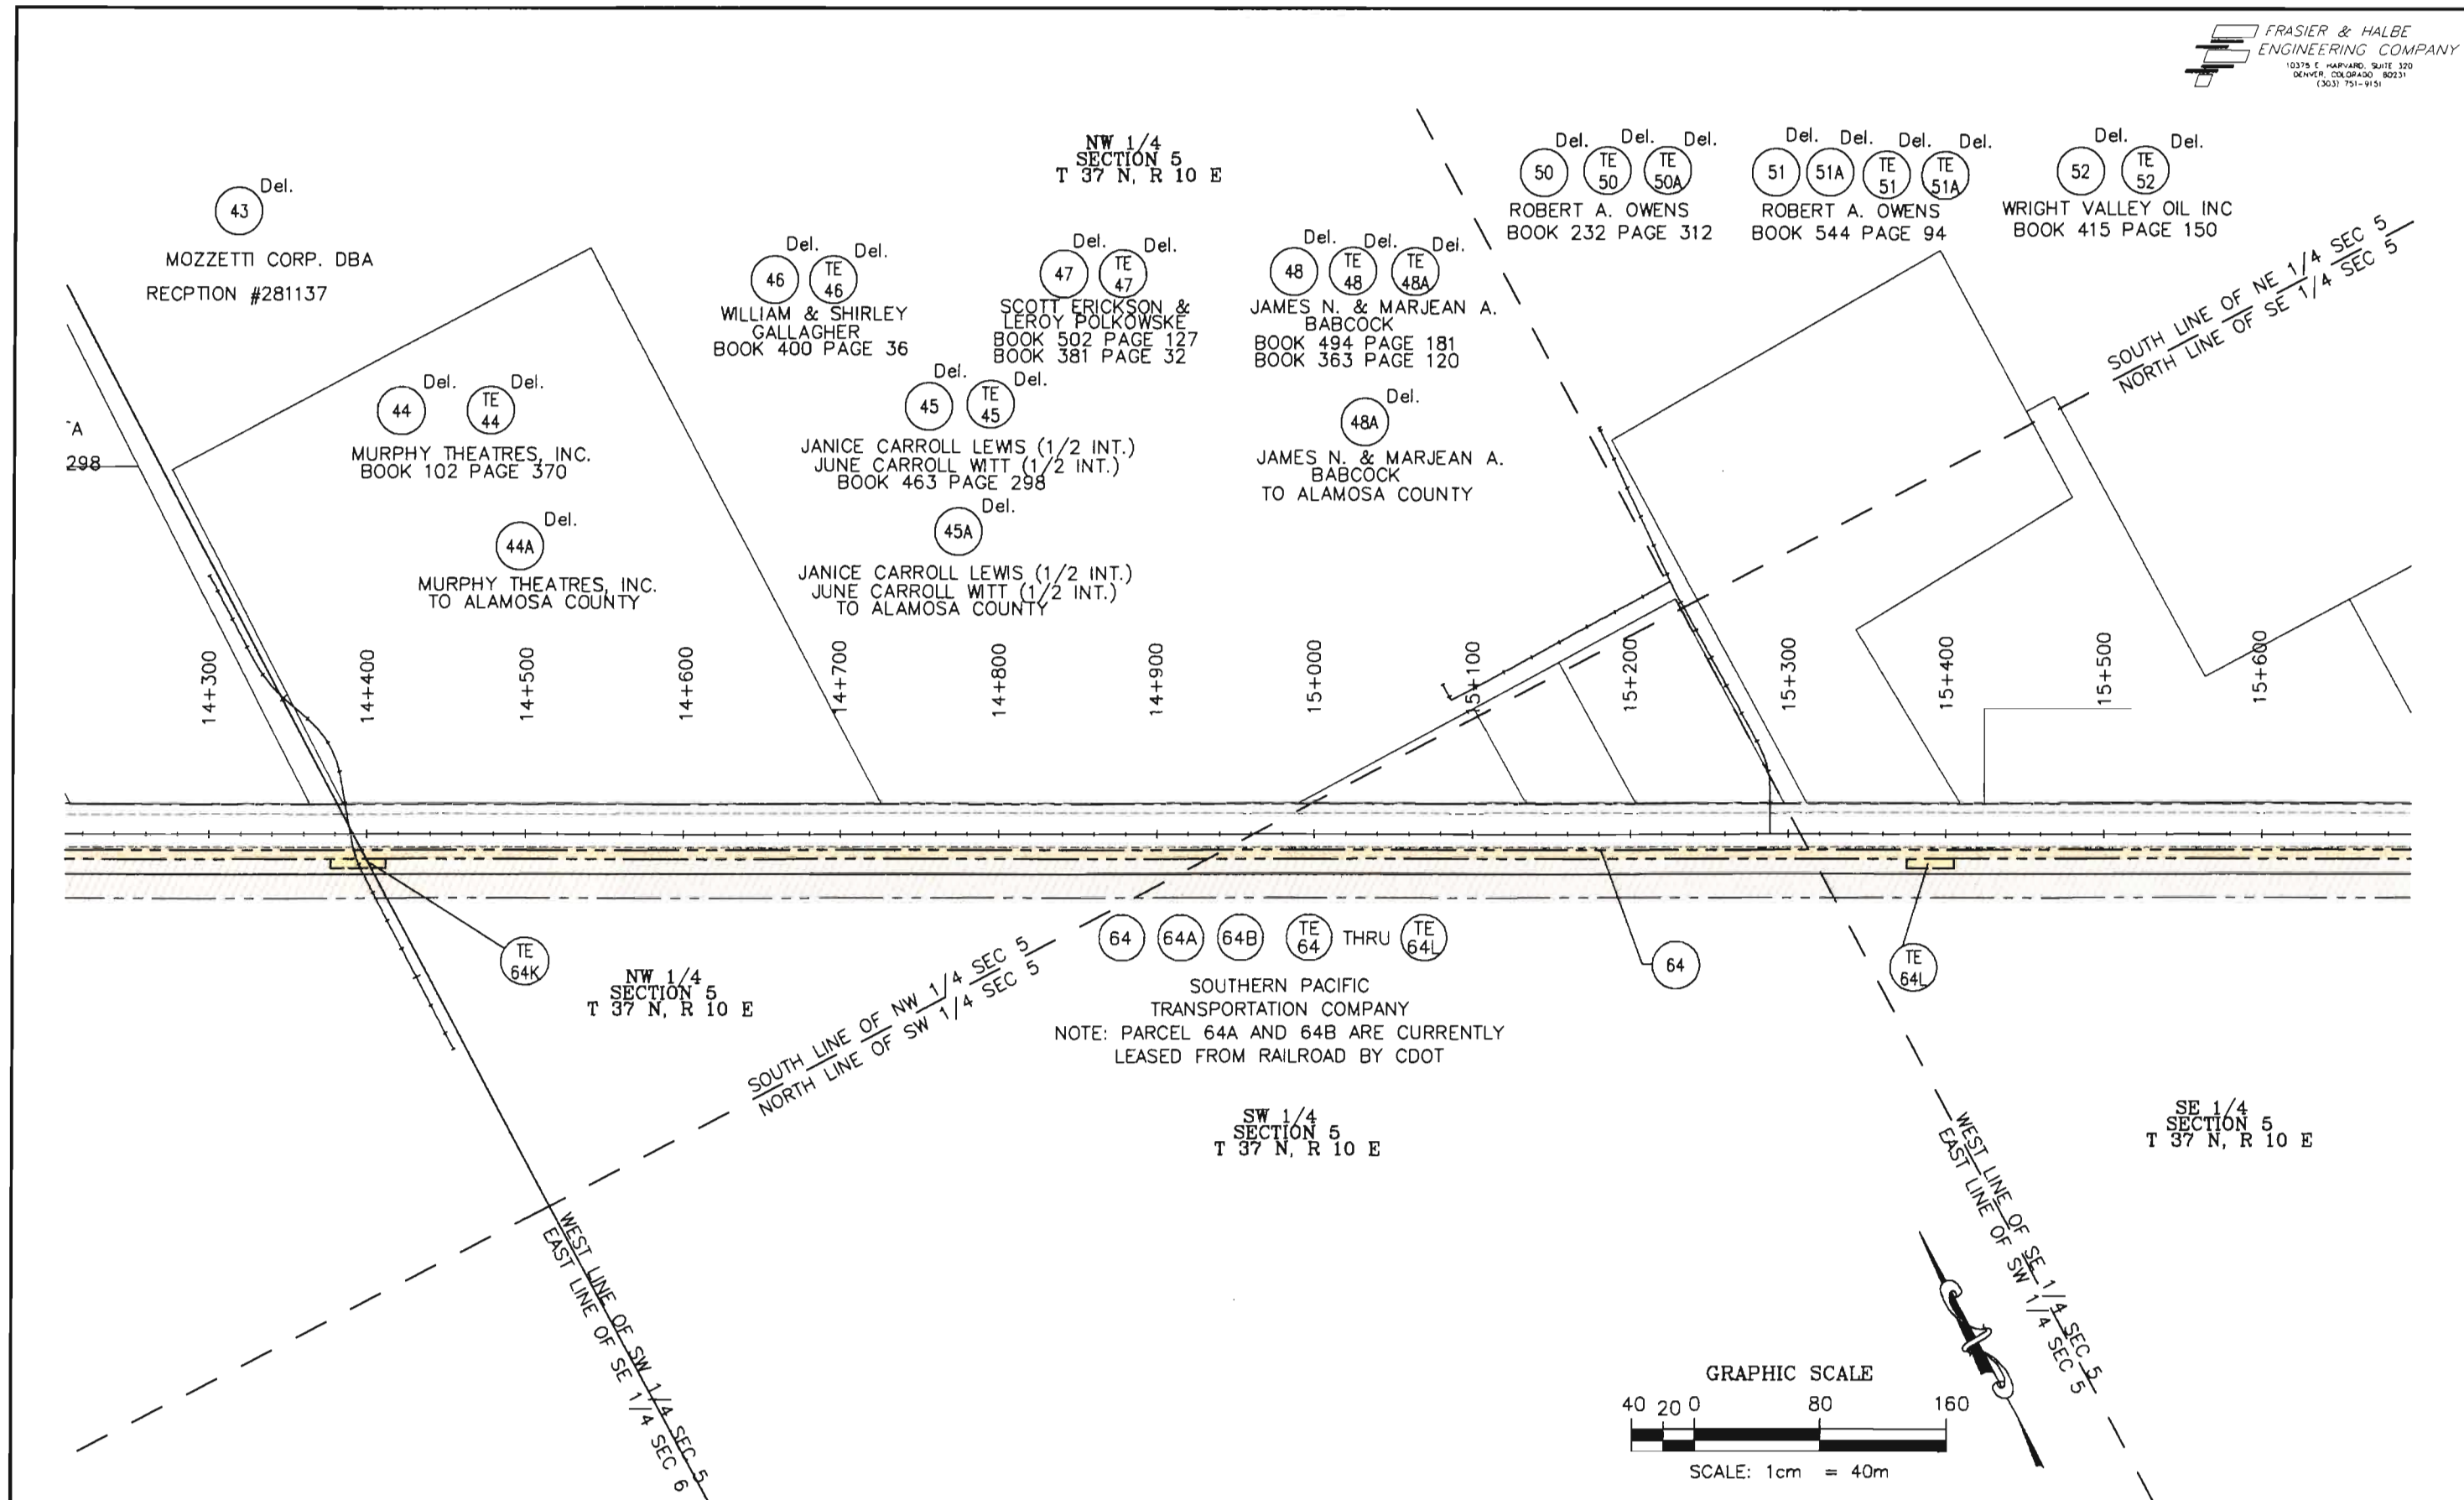

Computer File Information		Index of Revisions		Colorado Department of Transportation		As Constructed		OWNERSHIP PLAN		Project No./Code	
Creation Date: 10/24/97 Initials: JTO		☒ R2B	4/6/98	DELETED PARCELS #53-62et.al	EDC	No Revisions:		C. R. 6E TO CRAFT DR.		NH 1602-058	
Last Modification Date: 10/31/97 Initials: JTO		☐				Revised:		Designer:		10578	
Full Path: BEAST F:\JOBS\CDOT\5657-003\PHASE-ONE		☐				Void:		Detailer: JTO			
Drawing File Name: P-1OWNER PLAN1.DWG		☐						Sheet Subset: Ownership		Subset Sheets: 11 of 12	
Acad Ver. R14 Scale: 1:4000 Units: METRIC		☐								Sheet Number: 61	

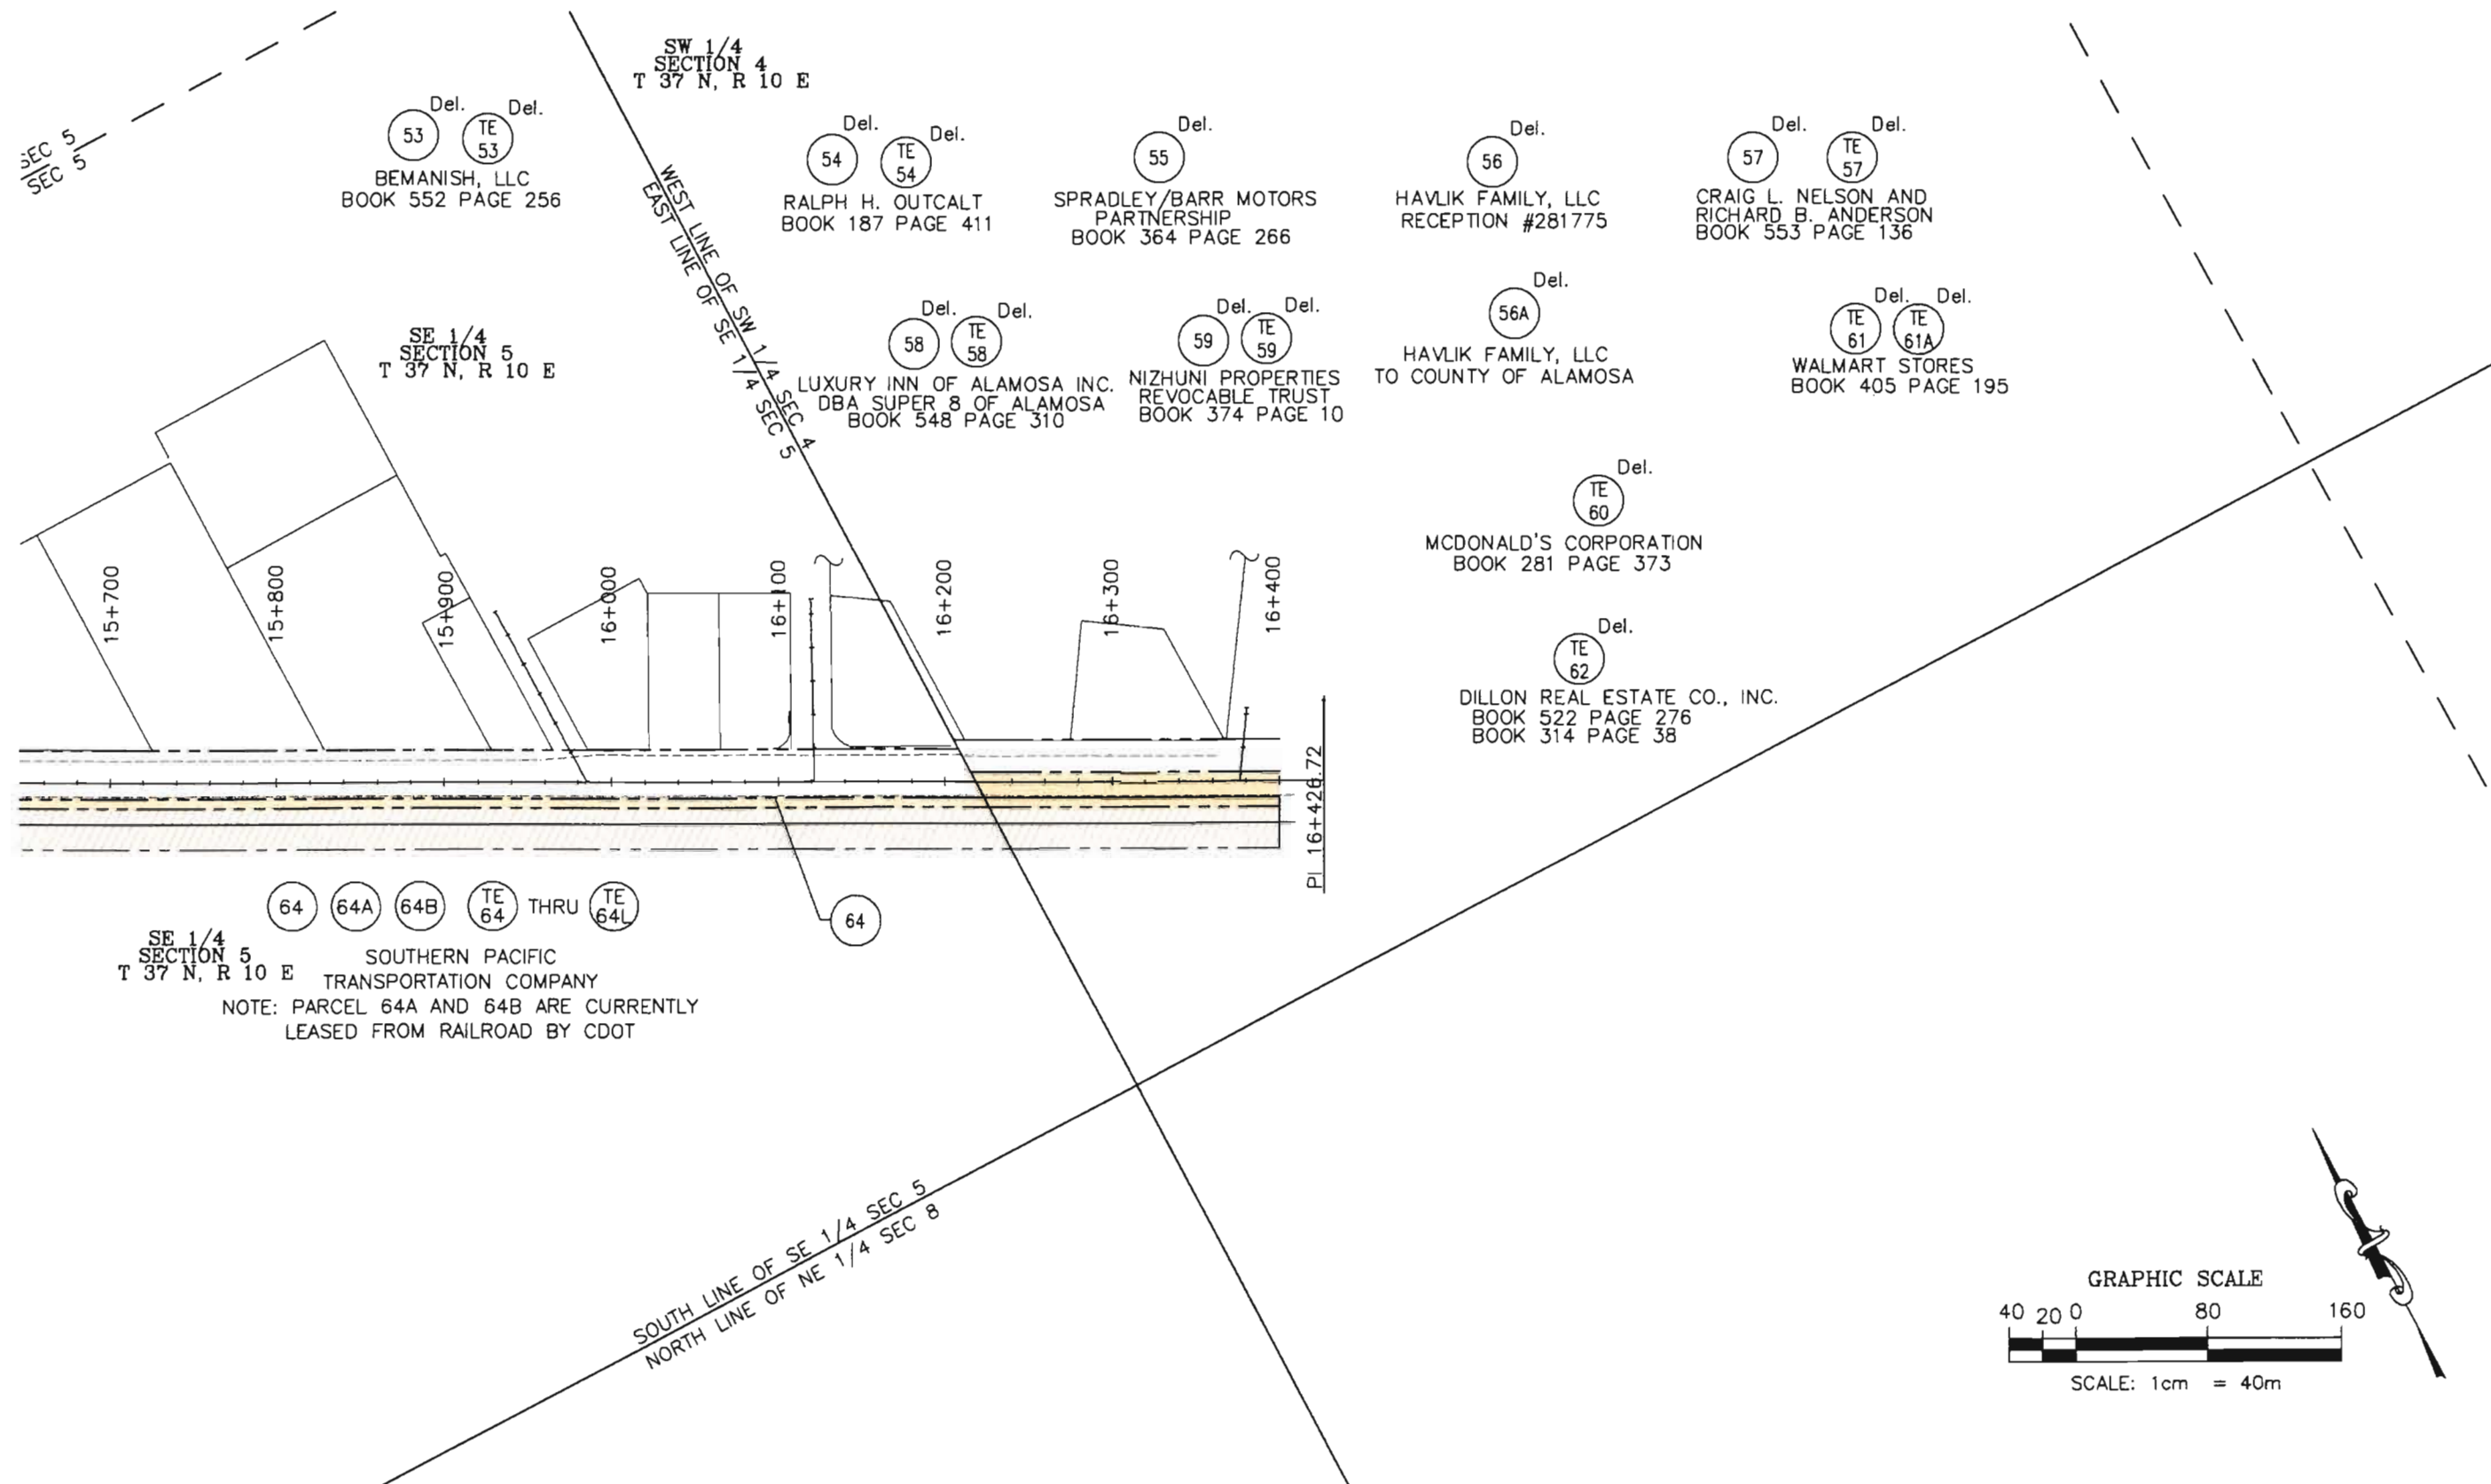

Computer File Information			Index of Revisions			As Constructed			OWNERSHIP PLAN			Project No./Code		
Creation Date: 10/24/97	Initials: JTO	(R2B)	4/6/98	DELETED PARCELS #53-62et.al	EDC	No Revisions:			C. R. 6E TO CRAFT DR.			NH 1602-058		
Last Modification Date: 10/31/97	Initials: JTO					Revised:			Designer:			10578		
Full Path: BEAST F:\JOBS\CDOT\5657-003\PHASE-ONE						Void:			Detailer: JTO			Sheet Number: 62		
Drawing File Name: P-10OWNER PLAN1.DWG									Sheet Subset: Ownership	Subset Sheets: 12 of 12				
Acad Ver. R14	Scale: 1:4000	Units: METRIC												

Colorado Department of Transportation



Region 5

3803 North Main Avenue, Suite 300
Durango, Colorado 81301
Phone: 970-385-1400 FAX: 970-385-1410