


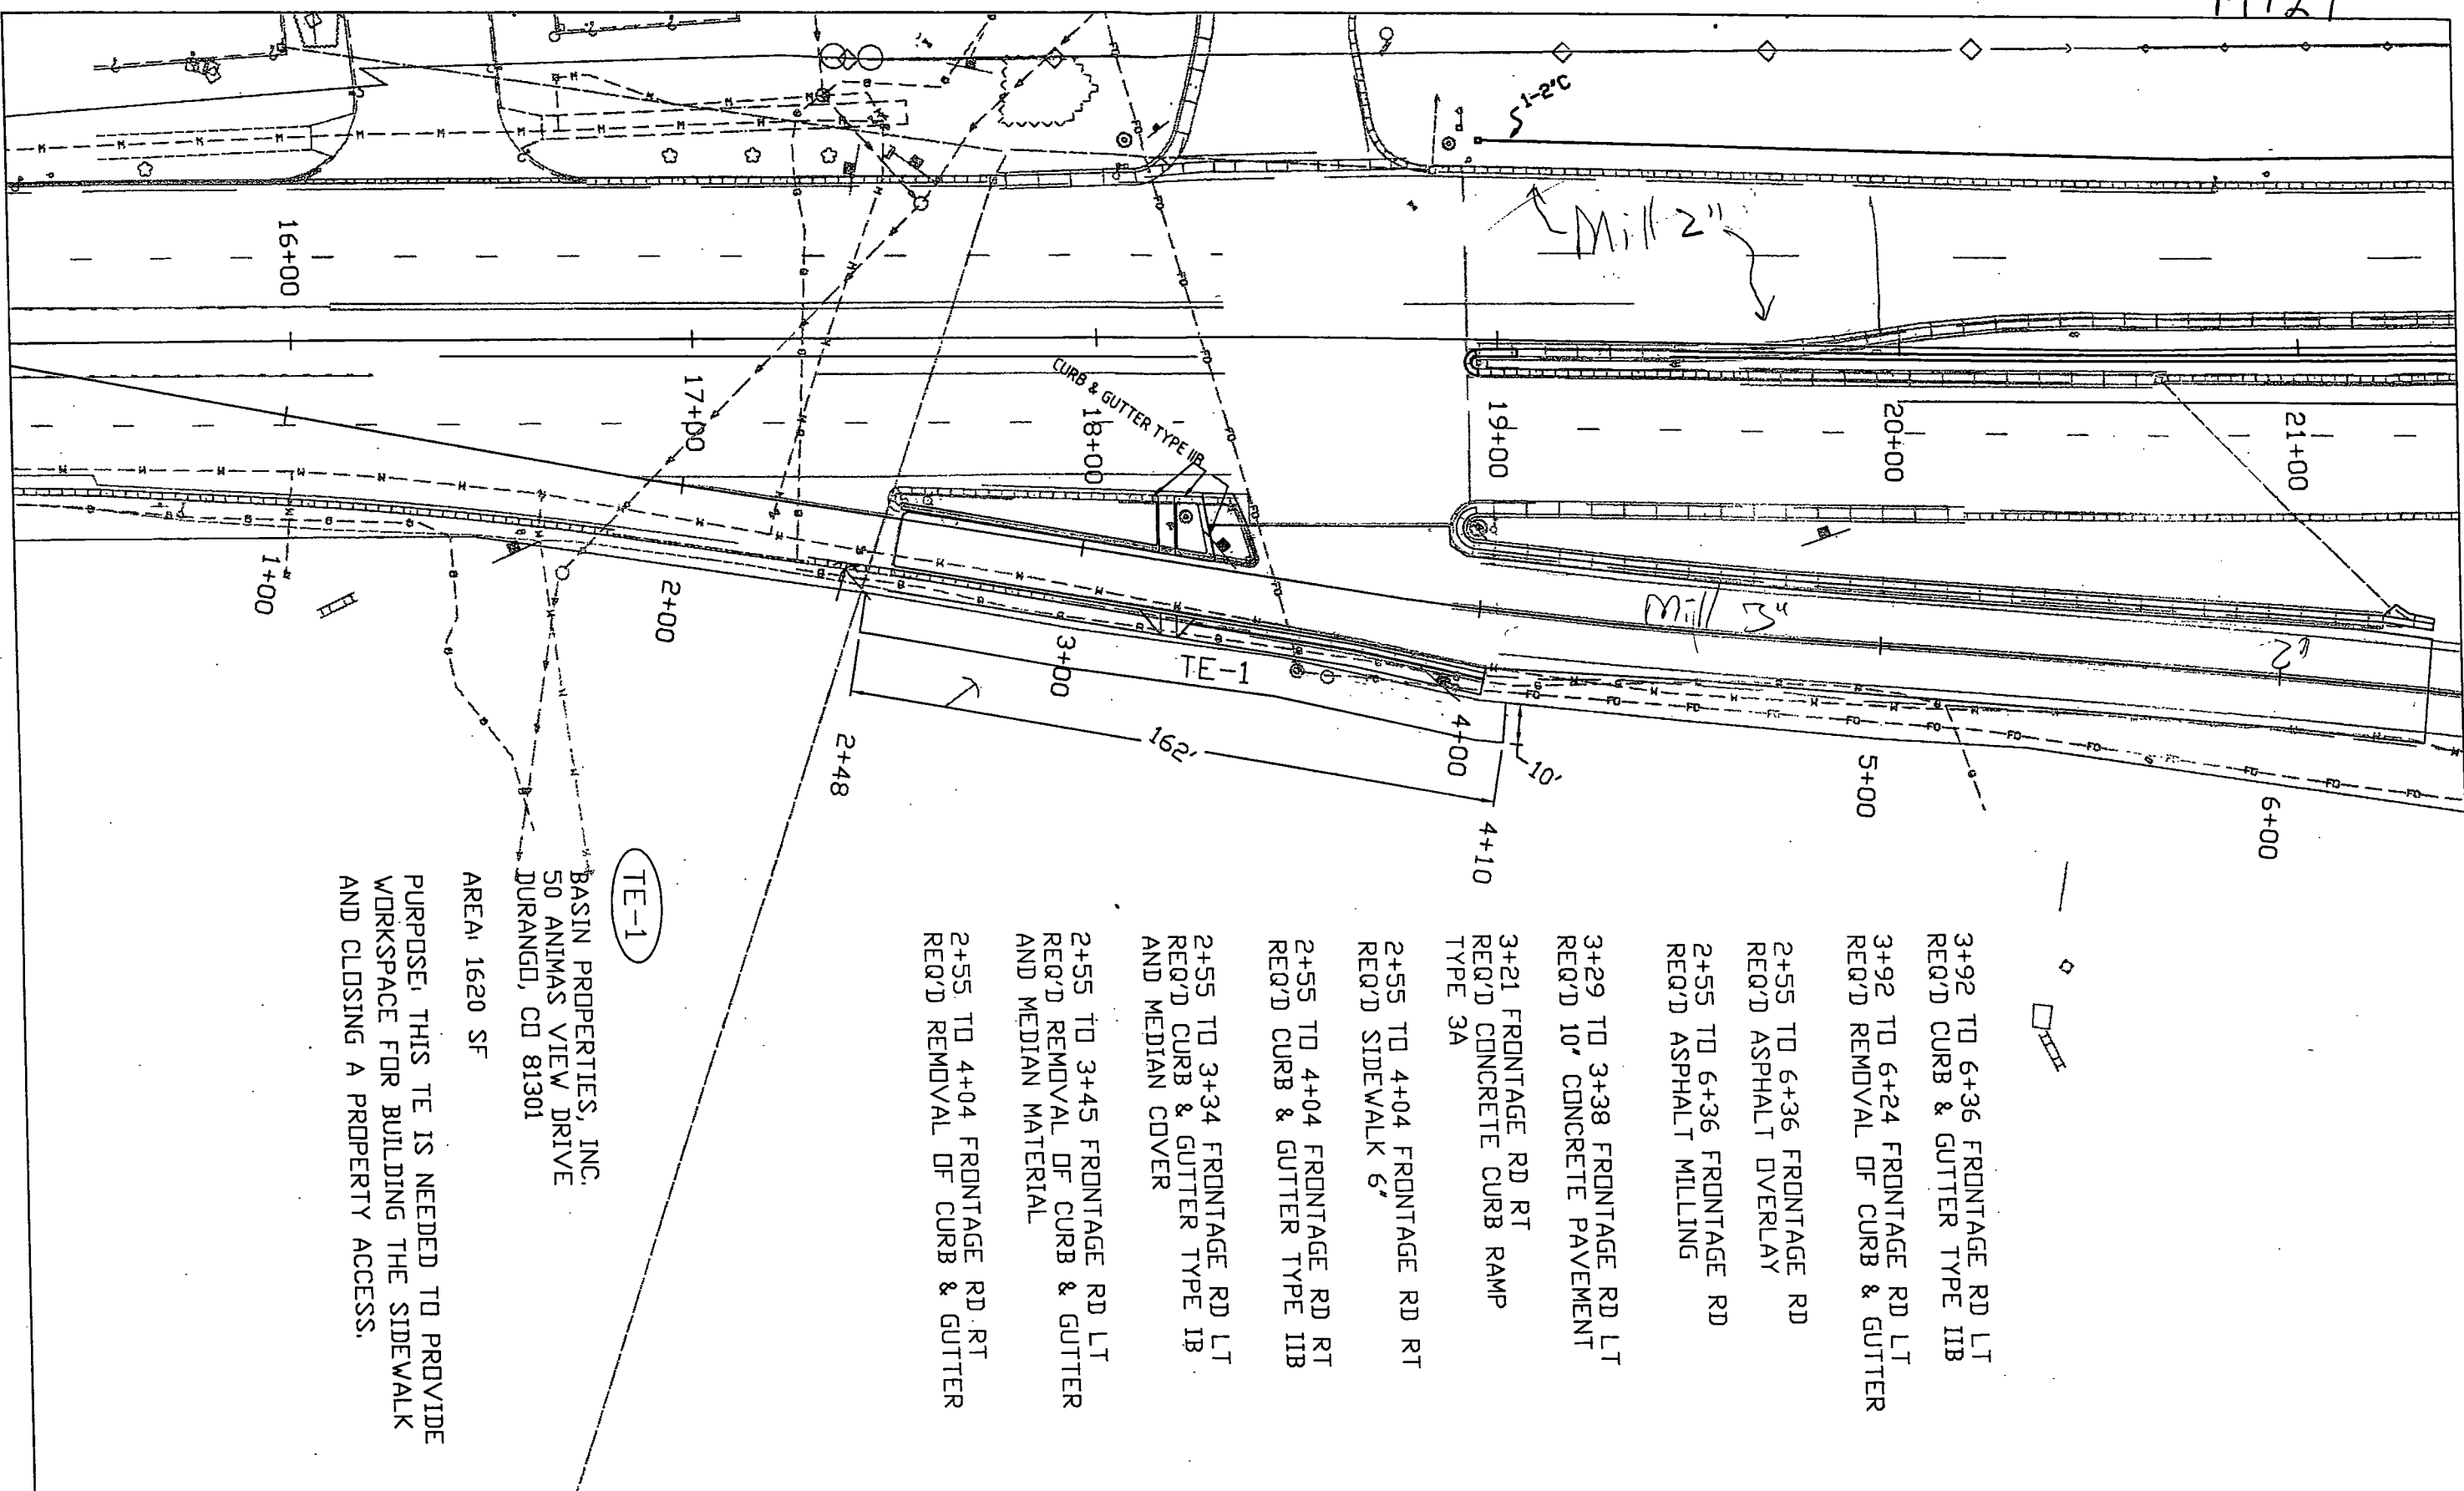

TE-1
BASIN PROPERTIES, INC.
50 ANIMAS VIEW DRIVE
DURANGO, CO 81301
AREA: 1620 SF
PURPOSE: THIS TE IS NEEDED TO PROVIDE
WORKSPACE FOR BUILDING THE SIDEWALK
AND CLOSING A PROPERTY ACCESS.

- 3+92 TO 6+36 FRONTAGE RD LT
REQ'D CURB & GUTTER TYPE IIB
- 3+92 TO 6+24 FRONTAGE RD LT
REQ'D REMOVAL OF CURB & GUTTER
- 2+55 TO 6+36 FRONTAGE RD
REQ'D ASPHALT OVERLAY
- 2+55 TO 6+36 FRONTAGE RD
REQ'D ASPHALT MILLING
- 3+29 TO 3+38 FRONTAGE RD LT
REQ'D 10" CONCRETE PAVEMENT
- 3+21 FRONTAGE RD RT
REQ'D CONCRETE CURB RAMP
TYPE 3A
- 2+55 TO 4+04 FRONTAGE RD RT
REQ'D SIDEWALK 6"
- 2+55 TO 4+04 FRONTAGE RD RT
REQ'D CURB & GUTTER TYPE IIB
- 2+55 TO 3+34 FRONTAGE RD LT
REQ'D CURB & GUTTER TYPE IB
AND MEDIAN COVER
- 2+55 TO 3+45 FRONTAGE RD LT
REQ'D REMOVAL OF CURB & GUTTER
AND MEDIAN MATERIAL
- 2+55 TO 4+04 FRONTAGE RD RT
REQ'D REMOVAL OF CURB & GUTTER

Computer File Information				Sheet Revisions				As Constructed				FRONTAGE ROAD PLAN		Project No./Code	
Creation Date:	01/15/05	Initials:	DP					No Revisions:				Designer:	dp	NH 5502-046	
Last Modification Date:	2/24/05	Initials:	DP					Revised:				Detailer:	dp	14924	
Full Path:	\PICKREND\Animas View Dr							Void:				Sheet Subset:		Sheet Number	
Drawing File Name:	PLANS.DWG													11	
Acad Ver. 2004	Scale: 1" = 40'	Units:	English												

Colorado Department of Transportation



3803 North Main Ave.
Suite 100
Durango, CO 81301
Phone: (970) 385-8360 FAX: (970) 385-8361

Region 5

MDM