

|                        |       |                        |              |               |
|------------------------|-------|------------------------|--------------|---------------|
| FED. ROAD<br>DIST. NO. | STATE | U.S. HWY.<br>PROJ. NO. | SHEET<br>NO. | DATE<br>THREE |
| 3                      | COLO  | N.H. 15-D              | 1            |               |

REV. 2-1-35 REL

(SHEET No. 1- TITLE SHEET

- |   |                                            |                                   |         |
|---|--------------------------------------------|-----------------------------------|---------|
| " | "                                          | 7- STANDARD SUPERELEVATION SHEET  | M-1-A   |
| " | "                                          | 8- " FENCE & MARKERS(WOOD POSTS)  | M-24-F  |
| " | "                                          | 9- " CULVERT HEADWALLS            | M-102-E |
| " | "                                          | 10- " C.M.P SIPHON                | M-123-A |
| " | "                                          | 11- " WIRE CABLE GUARD FENCE      | M- 20-G |
| " | "                                          | 12- SPECIAL 5'0 BARBED WIRE FENCE | M- 27-A |
| " | 13 TO 20- PLAN & PROFILE SHEETS- MAIN ROAD |                                   |         |
| " | No.21-                                     | " " " " WILLOW CR. APPROACH       |         |
| " | " 22-                                      | " " " " GRAND LAKE CONN.          |         |
| " | 23 TO 81- CROSS SECTIONS - MAIN ROAD       |                                   |         |
| " | 82 TO 85-                                  | " " " " WILLOW CR. APPROACH       |         |
| " | 86 TO 91-                                  | " " " " GRAND LAKE CONN.          |         |

CONST. DIV. NO. 1  
N.R.H. 151-D (1935)

CONST. DIV.#2.

- [ SHEET NO.1 - TITLE SHEET

- " " 2- SUMMARY SHEET  
" 4 to 6- BRIDGE DETAILS  
" NO. 16- PLAN & PROFILE SHEET


CENTER LINE OF SURVEY \_\_\_\_\_  
RIGHT OF WAY LINE \_\_\_\_\_  
TOWNSHIP LINE - - - - -  
SECTION LINE \_\_\_\_\_  
ONE QUARTER SECTION LINE \_\_\_\_\_  
RAILROADS +-----+-----+-----+-----+-----+-----+  
BARBED WIRE FENCE x-----x-----x-----x-----x-----x  
WIRE CABLE GUARD FENCE .-----.-----.-----.-----.-----.  
POLE LINES       ♦             ♦             ♦

ON PLAN, 1 IN. = 100 FT.

ON PROFILE (1 IN. = 100 FT. HORIZONTAL)

ON PROFILE (1 IN. - 10 FT. VERTICAL

GRADE LINE ON PROFILE IS SHOWN AS GRADE OF FINISHED ROAD  
GROSS LENGTH OF PROJECT } 25,045.3FT. = 4.782 MI.  
NET LENGTH OF PROJECT }

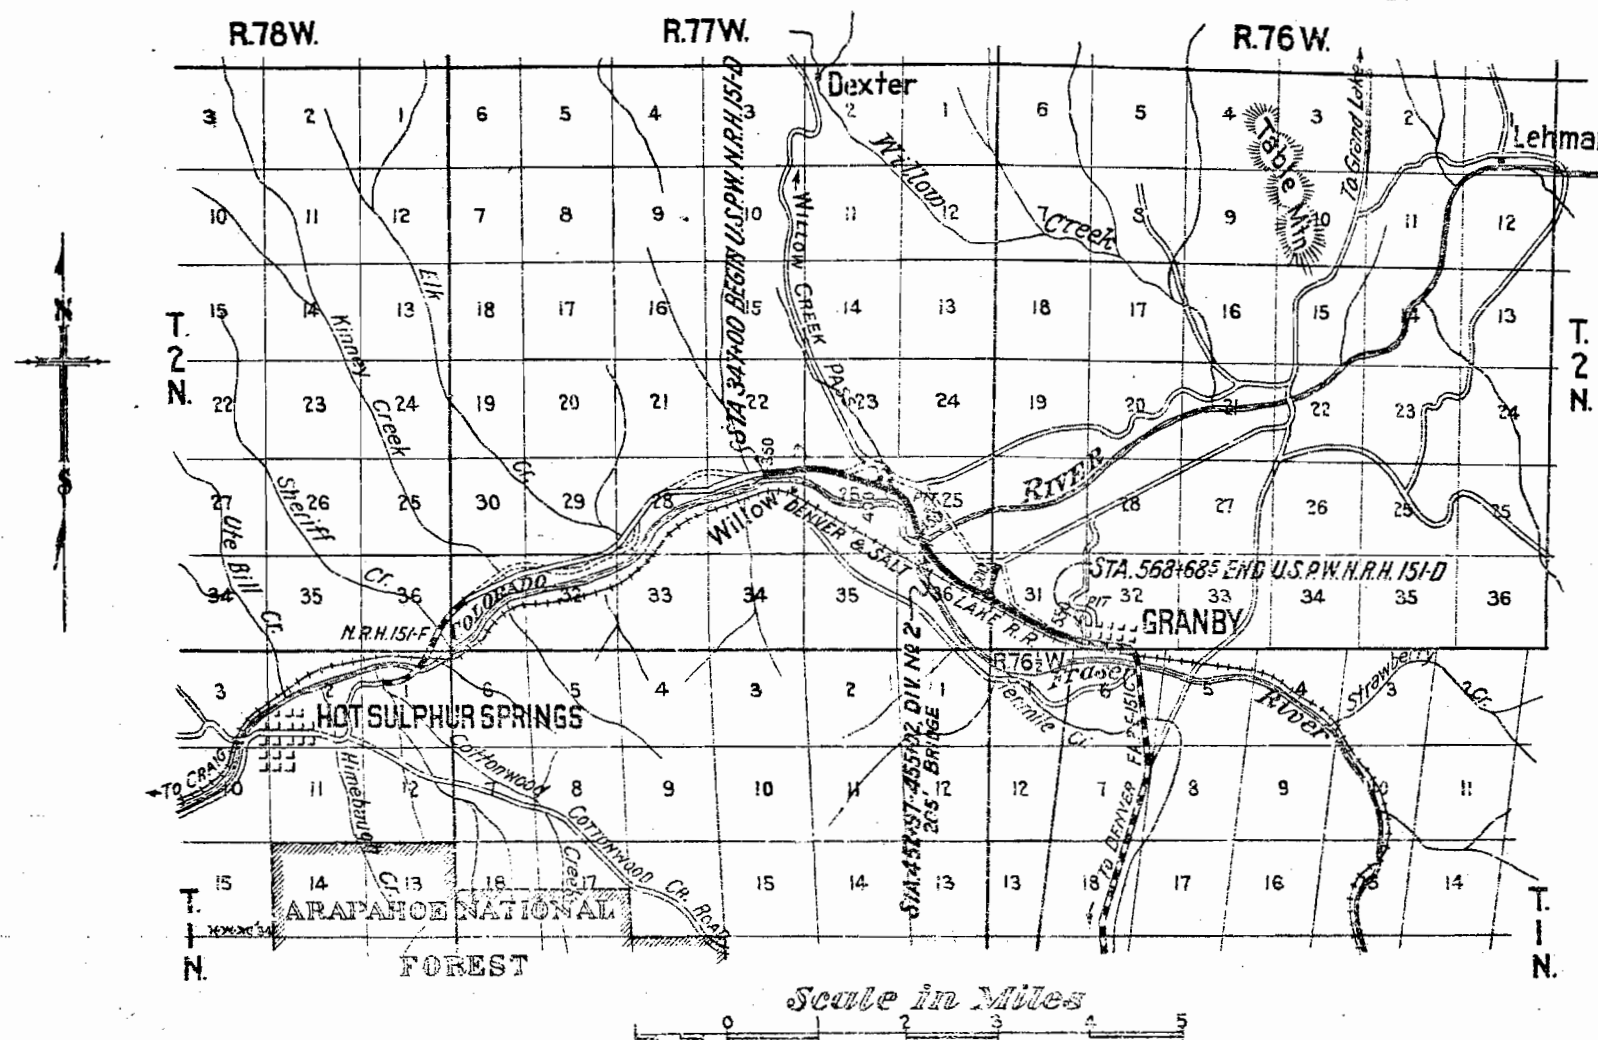

~ NOTE ~

*It is recommended that bidders on this Project go over the plan details with one of the following field representatives of this Department, -*  
*H. L. Jenness, Division Engineer, located at Glenwood Springs.*  
*Robt. Greisiger, Resident " " " Hor. Sulphur Springs.*

RECOMMENDED FOR APPROVAL 12/27/34

*J. J. J. J.*  
ASSISTANT ENGINEER

APPROVED  
*Chas. D. Wail*  
.....  
S. C. HIGHWAY EN. INTER.

RECOMMENDED FOR APPROVAL

1996, 1997, 1998, 2677, 26

DIST. ENG. BUREAU PUBLIC ROADS

RECOMMENDED FOR APPROVAL.

Copyright © 2005 John Wiley & Sons, Inc.


APPROVED

| FED. ROAD DIST. NO. | STATE | U.S. HWY. PROJ. NO. | SHEET NO. | TOTAL SHEETS |
|---------------------|-------|---------------------|-----------|--------------|
| 3                   | COLO. | NRH 151 01935       | 2         |              |

Rev. 1-23-35 HSK  
Rev. 2-2-35 R.L.  
Rev. as Const. 1-23-36 A.W.T.

# TYPICAL CROSS SECTION OF IMPROVEMENT AND SUMMARY OF QUANTITIES

## TYPICAL CROSS SECTIONS

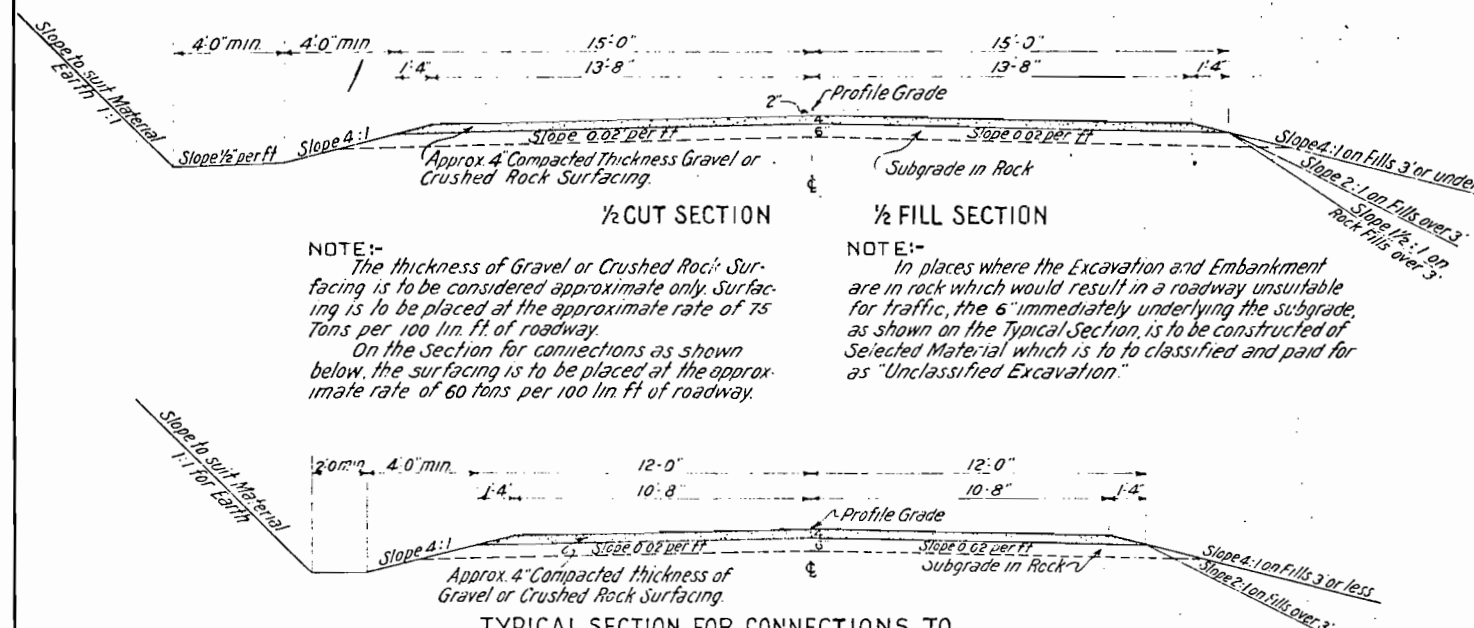

## SUMMARY OF APPROXIMATE QUANTITIES

| NO. | ITEM                              | UNIT       | ROADWAY-CONST. DIV. NO. 1 |           |             |             | BRIDGE STA. 452+  |   | TOTALS    |
|-----|-----------------------------------|------------|---------------------------|-----------|-------------|-------------|-------------------|---|-----------|
|     |                                   |            | MAIN                      | GL. CONN. | W.C. CONN.  | Feasibility | CONST. DIV. NO. 2 |   |           |
| 10a | Clearing & Grubbing Entire Proj.  | Lump Sum   | .                         | .         | .           | .           | .                 | . | .         |
| 10b | " " " Grand Lk. Conn.             | "          | .                         | .         | .           | .           | .                 | . | .         |
| 10c | " " " Willow Cr. "                | "          | .                         | .         | .           | .           | .                 | . | .         |
| 11a | Removing 3 structures             | "          | .                         | .         | .           | .           | .                 | . | .         |
| 11b | Remove and replace tele. line     | "          | .                         | .         | .           | .           | .                 | . | .         |
| 11c | Remove structure                  | "          | .                         | .         | .           | .           | .                 | . | .         |
| 12a | Removing fence                    | Lin. Ft.   | 1,600                     | 128.0     |             |             |                   |   | 3,490     |
| 13c | Unclassified Excavation           | Cu. Yd.    | 133,750.6                 | 23,305.9  | 3,697.26540 |             |                   |   | 160,753.7 |
| 13y | Cut slope treatment               | Mi.        | 3.276                     | 2.254     | 0.257       |             |                   |   | 3.789     |
| 14a | Dry Rock Excavation (Str.)        | Cu. Yd.    | -11.6                     |           |             |             |                   |   | 4.6       |
| 14b | " Comm.                           | "          | 494.7                     | 60.2      |             |             | 56.7              |   | 611.6     |
| 14c | Wet Rock                          | "          |                           |           |             |             |                   |   |           |
| 14d | " Comm.                           | "          | 301.4                     | 26.5      |             |             | 1142.6            |   | 1,470.5   |
| 18a | Sta. Yd. Overhaul                 | Sta. Yd.   | 723,471.5                 | 83,489.8  |             |             |                   |   | 906,961.3 |
| 18b | Yd. Ml. Overhaul                  | Yd. Ml.    | 7179.6                    | 1,081.1   |             |             |                   |   | 8,260.7   |
| 30x | Gravel or Crushed Rock Surf.      | Tons       | 16733.87                  | 1,938.27  | 31,866.7584 |             |                   |   | 34,838.9  |
| 42a | Untreated Bridge Timber           | M. Ft. 3M. |                           |           |             |             | 0.3               |   | 0.3       |
| 46a | Class "A" Concrete                | Cu. Yd.    |                           | 6.35      |             |             | 522               |   | 528.25    |
| 46b | " "B" Concrete                    | "          | 59.36                     | 7         |             |             | 72.5              |   | 139.86    |
| 47  | Reinforcing steel                 | Lbs.       |                           | 320.      |             |             | 62,840            |   | 63,160    |
| 48  | Structural                        | "          |                           |           |             |             | 290,700           |   | 290,700   |
| 53a | 15" Corr. Metal Culv. Pipe        | Lin. Ft.   | 156                       | 42        |             |             |                   |   | 198       |
| 53c | 24" " " " " "                     | "          | 1,194                     | 46        |             |             |                   |   | 1,240     |
| 53d | 30" " " " " "                     | "          | 330                       | 52        |             |             |                   |   | 382       |
| 53e | 36" " " " " "                     | "          | 290                       |           |             |             |                   |   | 290       |
| 53b | 18" " " " " "                     | "          |                           | 112       |             |             |                   |   | 112       |
| 53c | Connector band 140" 2839          | Each       | 1                         |           |             |             |                   |   | 1         |
| 56c | 24" Perforated Met. pipe Underdr. | Lin. Ft.   | 82                        |           |             |             |                   |   | 82        |
| 13d | Spec. Ditch Exc. - W. O. 156      | Cu. Yd.    | 59.70                     |           |             |             |                   |   | 59.70     |
| 72  | Wire Cable Guard Fence (Wd. P.)   | Lin. Ft.   | 4,350                     |           |             |             |                   |   | 4,350     |
| 75a | Galv. Barbed wire fence           | "          | 1,014                     | 1,108     |             |             |                   |   | 2,122     |
| 75s | Spec. 5'-0" " " "                 | "          | 11,294                    | 3,340     |             |             |                   |   | 14,634    |
| 75t | Spec. gates in B.W. "             | Each       | 6                         |           |             |             |                   |   | 6         |
| 78  | Project Marker                    | "          | 1                         |           |             |             |                   |   | 1         |
| 79  | Right of Way Markers              | "          | 34                        | 7         | 4           |             |                   |   | 45        |
| 85e | Trash guards for 36" siphon       | "          |                           | 2         |             |             |                   |   | 2         |
| 96e | 36" Corr. Metal Siphon pipe       | Lin. Ft.   |                           | 42        |             |             |                   |   | 42        |
| 81  | Bronze name plate                 | Each       |                           |           |             |             | 1                 |   | 1         |
| 89  | Drain pipe                        | "          |                           |           |             |             | 24                |   | 24        |
| 95x | Driveway gates                    | "          | 1                         |           |             |             |                   |   | 1         |
| 95f | Spec. " " " " "                   | "          | 1                         |           |             |             |                   |   | 1         |
| 55  | Rem. & Rep. 4C.M.P. NO. 2839      | L. Sum     | .                         | .         | .           | .           | .                 | . | .         |

## GENERAL NOTES

This Project is to be constructed in conformity with the Standard Specifications of the Colorado State Highway Department, adopted January 1, 1930.

All quantities on preliminary plans are to be considered approximate only.

All curves are to be super-elevated and widened as provided for by the Standard Superelevation Sheet.

All Roadway excavations required to construct this Project are to be obtained as indicated on the plans. Quantities involved beyond the limits of the ditch as shown on the Typical Section, either noted on Profile as "Borrow", or on List of Structures as "Embankment", are to be classified and paid for as "Unclassified Excavation".

These quantities are to be staked as part of the original excavation at locations indicated on the plans. Slope stakes, beyond the limits of the Typical Section as shown, are subject to change by the Engineer to fit Embankment requirements actually met in construction.

The entire Project is to be cleared for the full width of the Right of Way, and the cost thereof is to be included in the lump sum price for Clearing and Grubbing the entire Project. Approximate locations and character of Clearing & Grubbing required are indicated by notes on the plans.

All poles encroaching on the construction are to be moved by the owners.

At all places on the project where the new work lies along the present traveled road, the Contractor shall, at his own expense, prosecute construction in such a manner that traffic may readily pass over the road. The Contractor shall also maintain in safe condition and at his own expense, all temporary approaches to and crossings of intersecting highways.

Except as limited by the Special Provisions, power equipment may be used on this Project.


## R.O.W. MARKERS

| STATION          | LEFT | RIGHT |
|------------------|------|-------|
| 347+00           | 1    | 1     |
| 358+00           | 1    |       |
| 366+00           | 2    |       |
| 369+43.1         | 1    | 1     |
| 388+00           |      | 2     |
| 396+38           | 1    |       |
| 396+73.4         |      | 2     |
| 400+02.9         | 1    |       |
| 403+12           | 1    |       |
| 409+75           | 1    |       |
| 412+15.7         | 1    |       |
| 424+24           | 1    | 1     |
| 433+61.3         | 1    |       |
| 449+00           | 2    |       |
| 458+43.6         | 1    | 1     |
| 475+25.0         |      | 2     |
| 507+17.8         | 1    |       |
| 511+35.4         | 1    | 1     |
| 515+72           | 1    |       |
| 538+50           | 1    |       |
| 540+50           | 1    | 1     |
| 562+82.8         | 1    | 1     |
| GRAND LAKE CONN. |      |       |
| 512+00           | 1    |       |
| 523+00           |      | 2     |
| 530+00           |      | 2     |
| 532+65           | 1    |       |
| 533+00           | 1    |       |
| WILLOW CR. CONN. |      |       |
| 7+00             | 1    | 1     |
| 7+78.7           | 1    | 1     |
| TOTALS           | 23   | 22    |

## FENCING AND GATE REQUIREMENTS

| STATIONS              | SIDE | REMOVE FENCE LIN. FT. | BUILD B.W. FENCE LIN. FT. | B.W. GATES EACH | DRWAY GATES EACH | BUILD SPEC FENCE |
|-----------------------|------|-----------------------|---------------------------|-----------------|------------------|------------------|
| 347+00 to 349+00      | L.   | 530                   | 306                       |                 |                  |                  |
| 348+25                | L.   |                       |                           |                 |                  |                  |
| 399+40                | R    |                       | 708                       |                 |                  |                  |
| 392+50 to 399+40      | R    |                       |                           |                 |                  | 62               |
| 433+00                | X    | 150                   |                           |                 |                  |                  |
| 433+50 to 453+00      | RAL  |                       |                           |                 |                  | 3931             |
| 445+00                | X    | 150                   |                           |                 |                  |                  |
| 455+00 to 507+18      | RAL  |                       |                           |                 |                  | 7301             |
| 458+00                | RAL  |                       |                           | 2               |                  |                  |
| 461+30                | R    |                       |                           | 1               |                  |                  |
| 463+90                | L    |                       |                           | 1               |                  |                  |
| 482+00                | X    | 120                   |                           |                 |                  |                  |
| 490+50                | L    |                       |                           | 1               |                  |                  |
| 528+00 to 533+00      | R    | 650                   |                           |                 |                  |                  |
| 431+00                | L    |                       |                           |                 |                  |                  |
| MAIN HWY TOTALS       |      | 1600                  | 1014                      | 6               | 2                | 11,294           |
| GRAND LAKE CONNECTION |      |                       |                           |                 |                  |                  |
| 507+18 to 532+50      | L.   |                       |                           |                 |                  | 2477             |
| 511+00 to 532+50      | L.   | 1880                  | 1108                      |                 |                  |                  |
| 523+00 to 533+00      | L    |                       |                           |                 |                  | 863              |
| 514+50 to 523+00      | R    |                       |                           |                 |                  |                  |
| GR LAKE TOTALS        |      | 1880                  | 1108                      | -               | -                | 3340             |

★ Special 5'-0" Barbed wire fence with metal posts as per details on Sheet No. 12

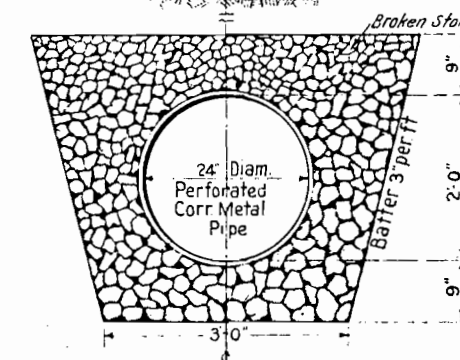



NOTE - Fencing and Right-of-Way Markers  
required are tabulated on Sheet No. 2



N.E. 4 SEC. 27

Sec 26

T. 2N., R. 77W. of 6th PM.

N.W. 4 SEC. 26

U.S.P.W.H.  
NRH-15-D 14  
(1935)  
Rev. as Const. 1-24-35 A.J.T.

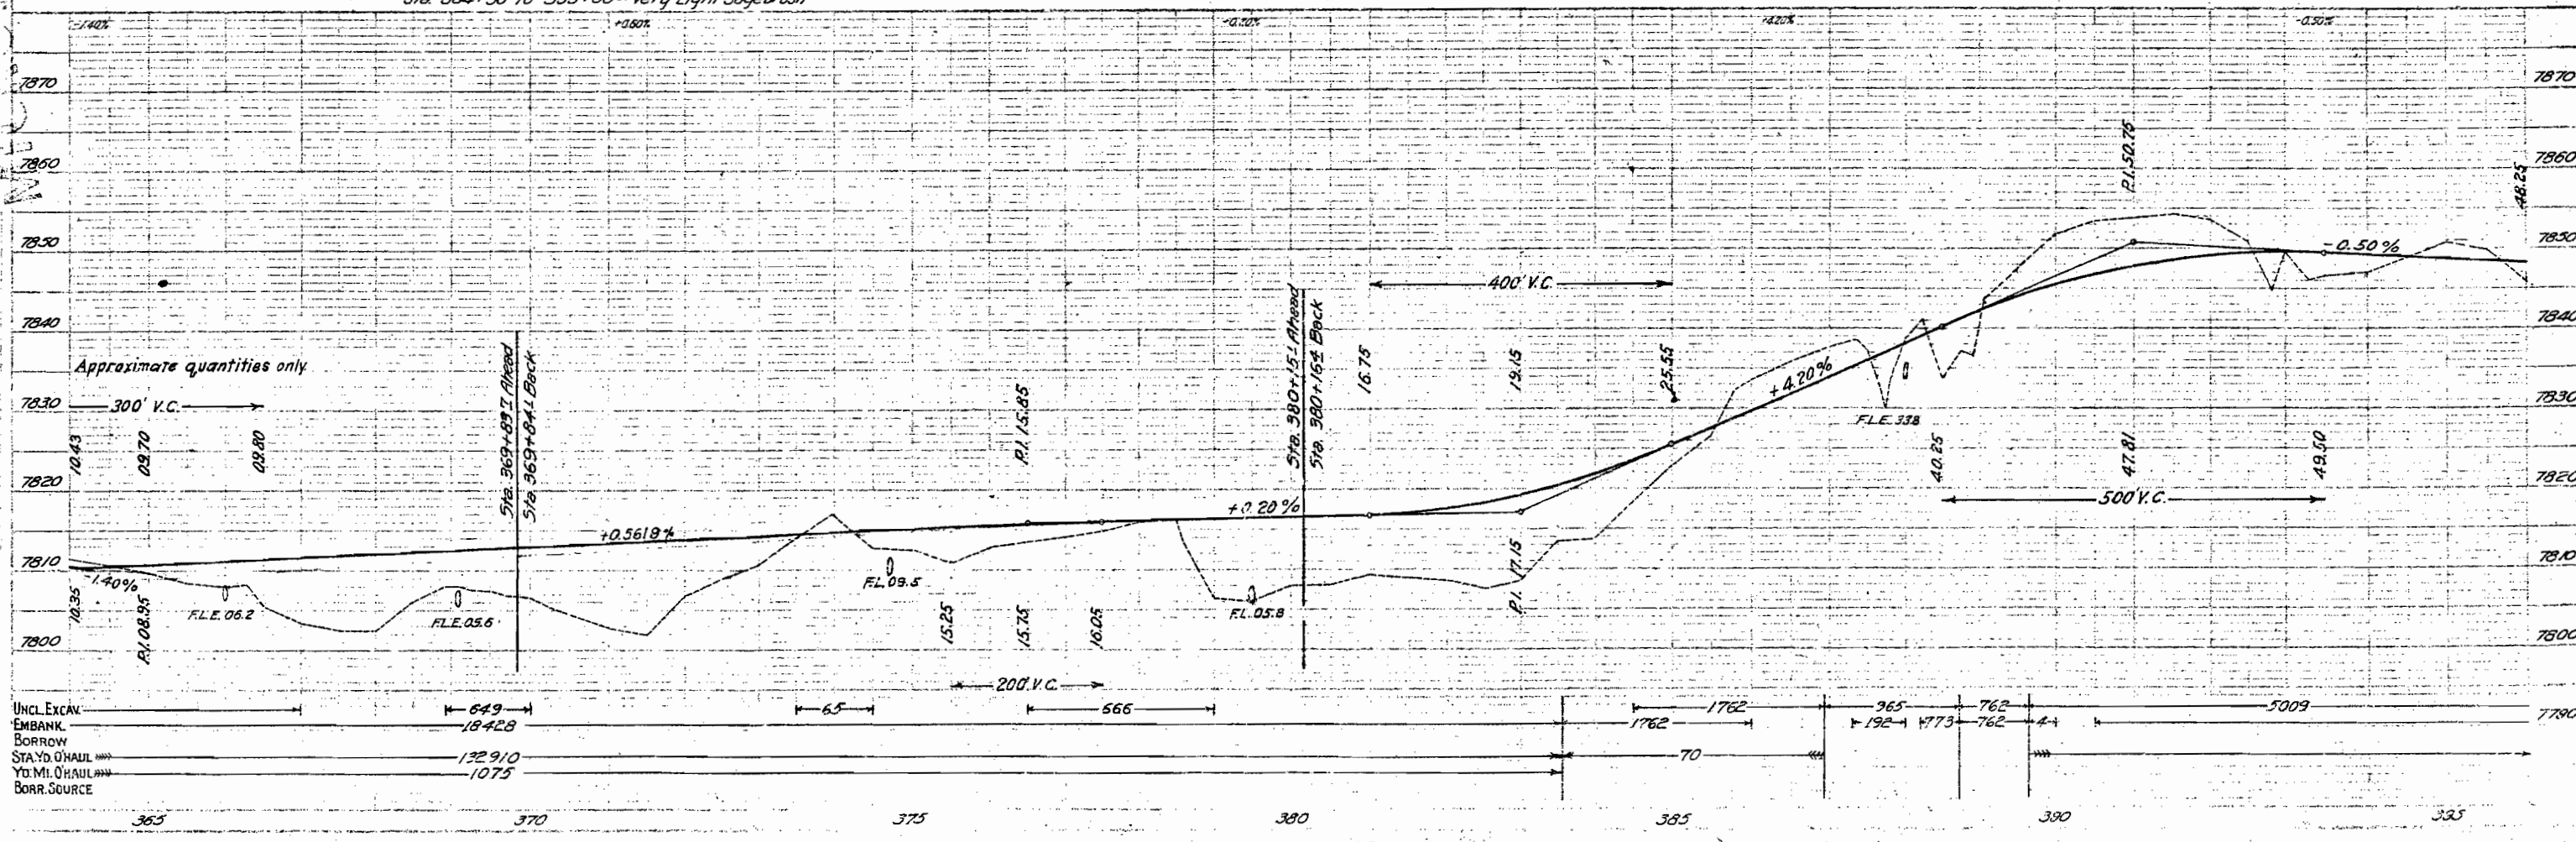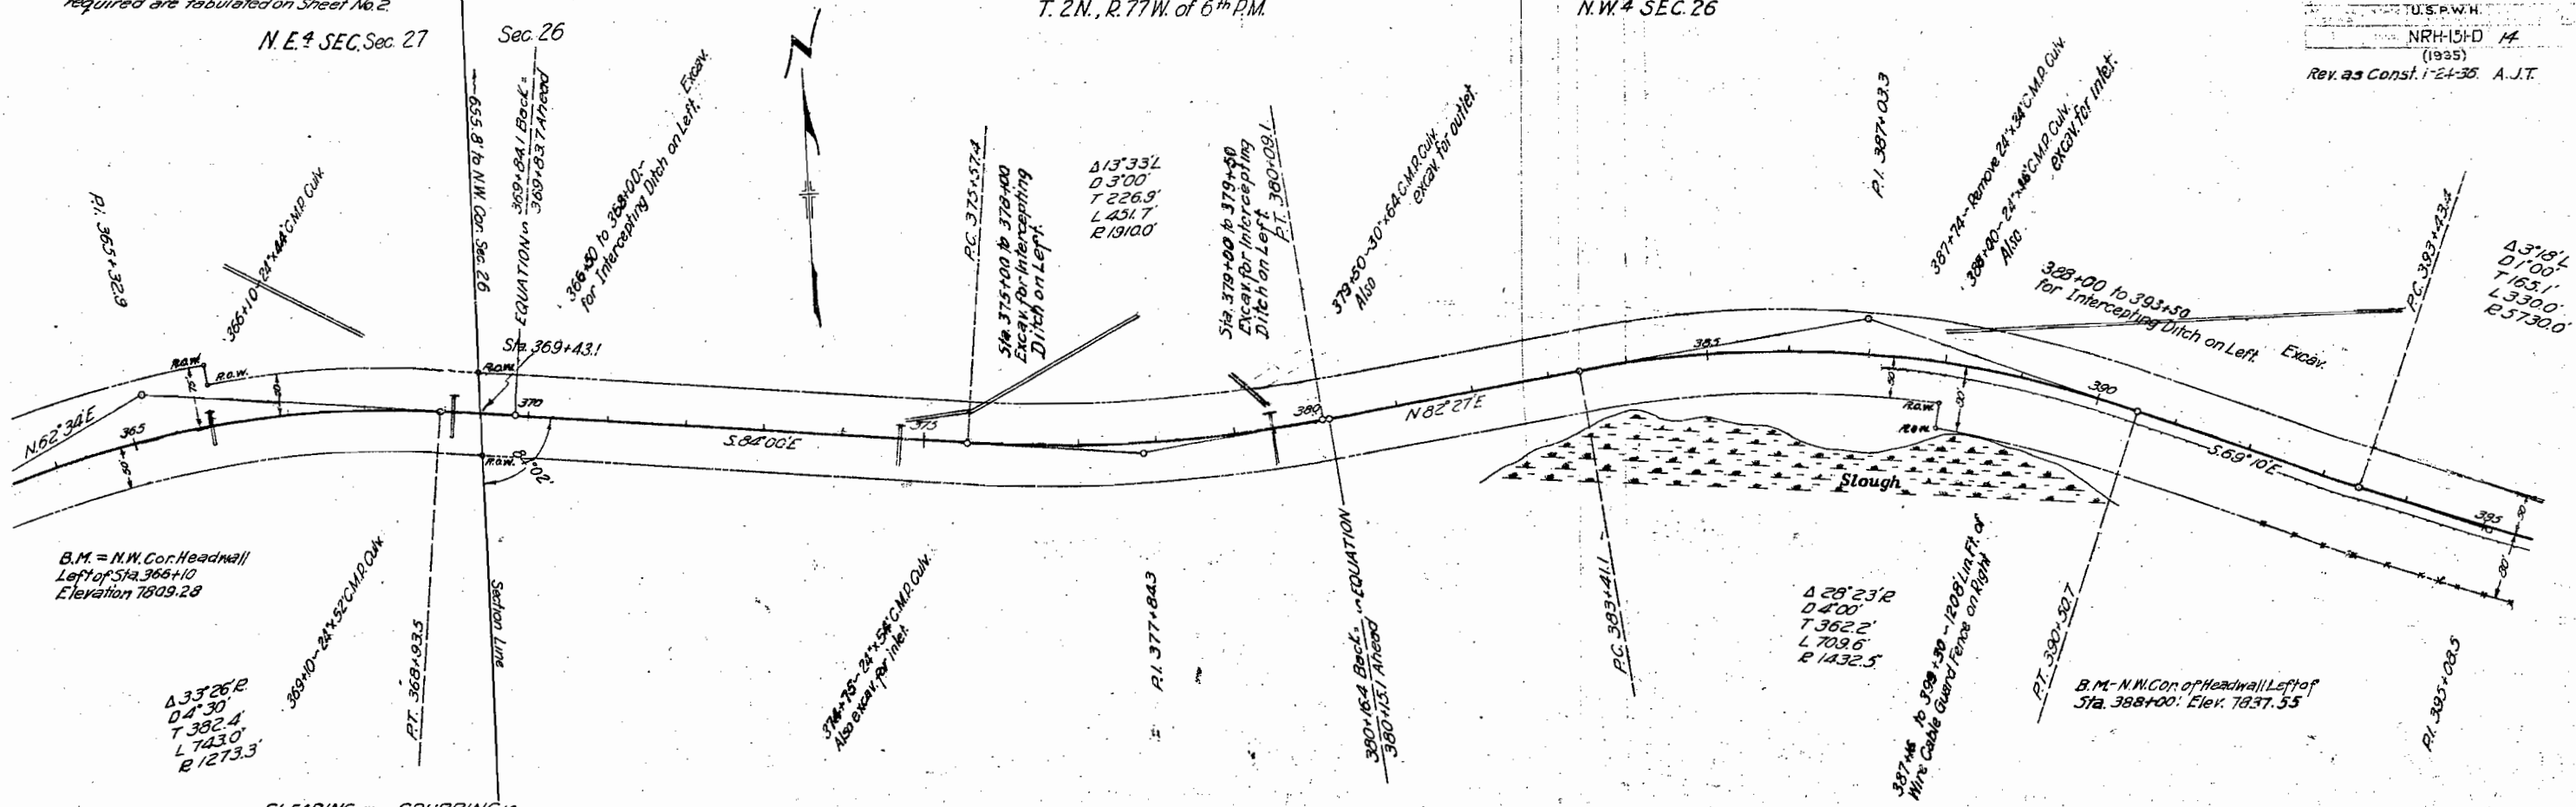

100


1. *Chlorophyll a* and *Chlorophyll b* were determined by the method of Lichtenthaler and Sponholz (1980). The total chlorophyll content was determined by the method of Arar and Cook (1987). The carotenoid content was determined by the method of Lichtenthaler and Sponholz (1980). The total carotenoid content was determined by the method of Arar and Cook (1987). The total protein content was determined by the method of Lowry et al. (1951). The total lipid content was determined by the method of Bligh and Dyer (1959). The total carbohydrate content was determined by the method of Dubois and Gilles (1950). The total nucleic acid content was determined by the method of Burton (1956). The total ash content was determined by the method of AOAC (1990). The total fiber content was determined by the method of AOAC (1990). The total organic acid content was determined by the method of AOAC (1990). The total alkaloid content was determined by the method of AOAC (1990). The total saponin content was determined by the method of AOAC (1990). The total tannin content was determined by the method of AOAC (1990). The total flavonoid content was determined by the method of AOAC (1990). The total phenolic content was determined by the method of AOAC (1990). The total terpenoid content was determined by the method of AOAC (1990). The total steroid content was determined by the method of AOAC (1990). The total glycoside content was determined by the method of AOAC (1990). The total alkaloid content was determined by the method of AOAC (1990). The total saponin content was determined by the method of AOAC (1990). The total tannin content was determined by the method of AOAC (1990). The total flavonoid content was determined by the method of AOAC (1990). The total phenolic content was determined by the method of AOAC (1990). The total terpenoid content was determined by the method of AOAC (1990). The total steroid content was determined by the method of AOAC (1990). The total glycoside content was determined by the method of AOAC (1990).

exten

616.7  
77°55'P  
5°23'N

195-11-10

~~SECRET~~

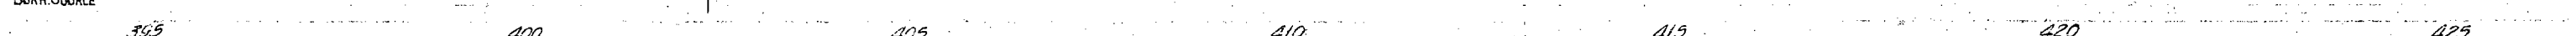

7820

429

NOTE: Fencing and Right-of-Way Markers required are tabulated on Sheet No. 2


N.W. 4 SEC. 25

T. 2N, R. 77W. of 6th PM.

U.S.R.W.

NRH-151-D. 16

Rev. 1-23-35 HSK  
" 2-1-35 R.L.  
Rev. as Const. 1-27-36 A.J.T.

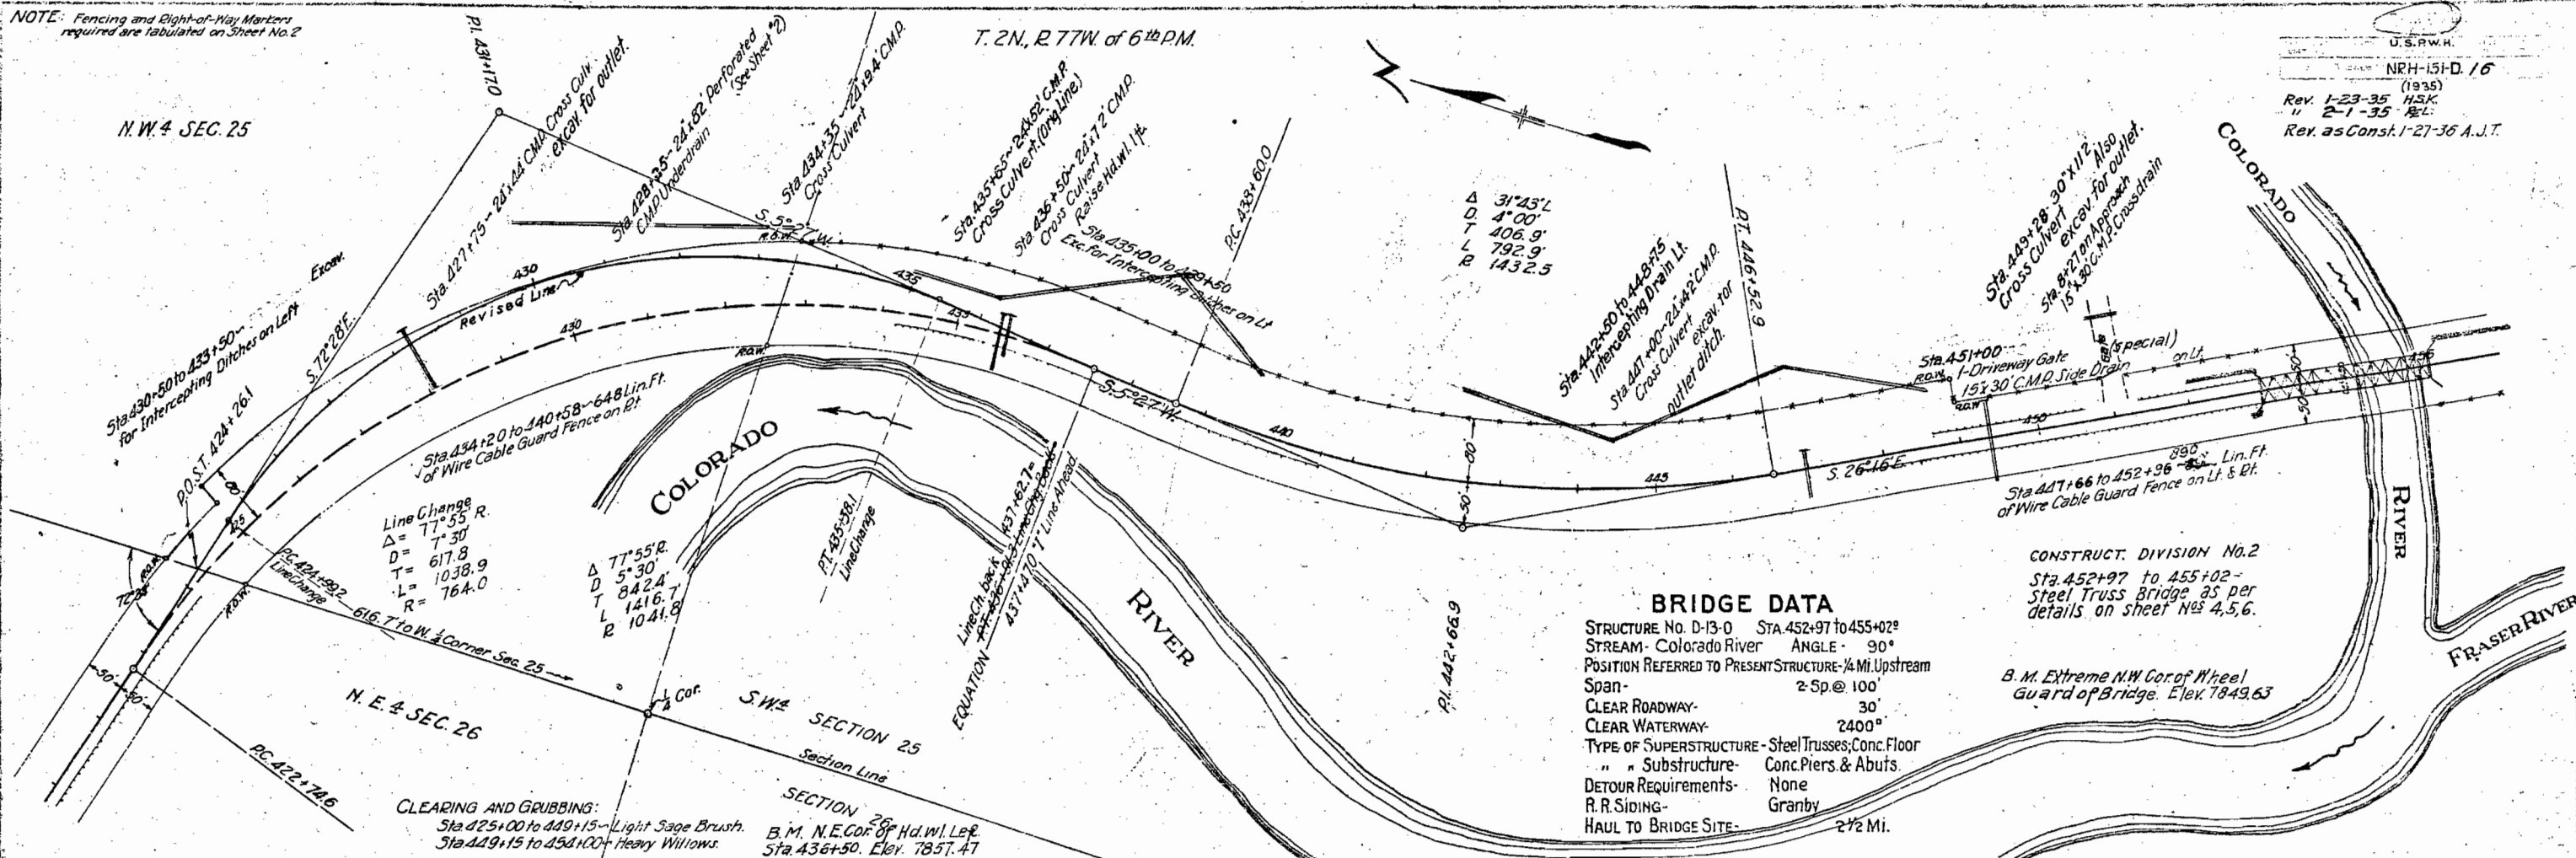

### BRIDGE DATA

STRUCTURE No. D-13-0 STA. 452+97 to 455+02  
 STREAM - Colorado River ANGLE -  $90^\circ$   
 POSITION REFERRED TO PRESENT STRUCTURE -  $\frac{1}{4}$  Mi. Upstream  
 Span - 2 Sp. @ 100'  
 CLEAR ROADWAY - 30'  
 CLEAR WATERWAY - 2400'  
 TYPE OF SUPERSTRUCTURE - Steel Trusses; Conc. Floor  
 " " Substructure - Conc. Piers & Abuts.  
 DETOUR REQUIREMENTS - None  
 R.R. SIDING - Granby  
 HAUL TO BRIDGE SITE -  $2\frac{1}{2}$  Mi.


CONSTRUCT. DIVISION No. 2  
 Sta. 452+97 to 455+02 -  
 Steel Truss Bridge as per  
 details on sheet Nos. 4, 5, 6.

B.M. Extreme N.W. Cor. of Wheel  
 Guard of Bridge. Elev. 7849.63

### STREAM DATA

DRAINAGE AREA IN SQUARE MI. 425  
 ELEVATIONS:-  
 Maximum High Water - 7839.5  
 Normal Stage - 7835.5 Stream Bed - 7832.0  
 Drift - Trees and Brush  
 Scour -  
 NEARBY BRIDGES ON SAME STREAM  
 Location - D-13-D -  $\frac{1}{4}$  Mi. Down Stream  
 Waterway -  
 Record During Flood -

Approximate quantities only.

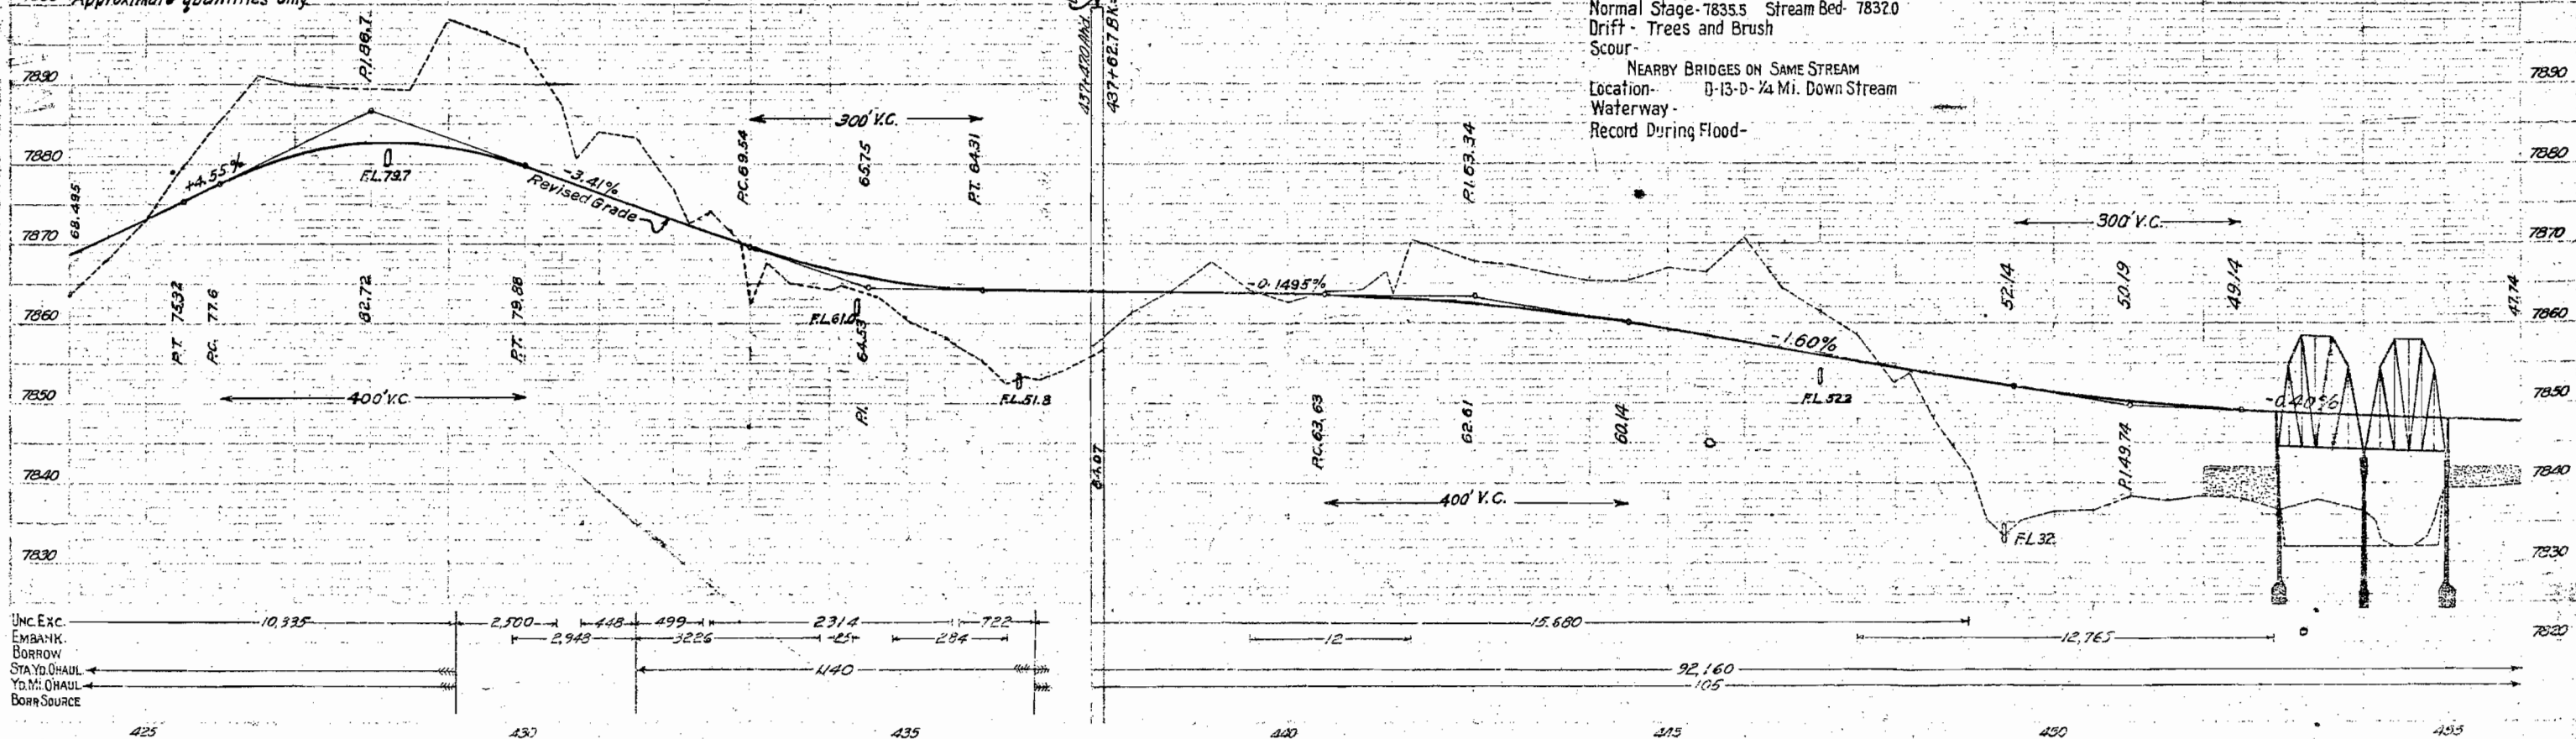

NOTE: Fencing and Right of Way Markers required are tabulated on Sheet No. 2

T. 2N., R. 77W. of 6th PM.



| FED. ROAD DIST. NO. | STATE | U.S. R.W.H. PROJ. NO. | SHEET NO. | TOTAL SHEETS |
|---------------------|-------|-----------------------|-----------|--------------|
| 2                   | COLO. | NRH-151-D (1935)      | 17        |              |

Rev. as Const. 1-27-35. A.L.T.

N.E. 1/4 SEC. 36


| PLAN     | DATE | BY | NO. |
|----------|------|----|-----|
| SURVEYED |      |    |     |
| PLOTTED  |      |    |     |
| CHECKED  |      |    |     |
| NOTED    |      |    |     |
| REVIEWED |      |    |     |

| PROFILE  | DATE | BY | NO. |
|----------|------|----|-----|
| SURVEYED |      |    |     |
| PLOTTED  |      |    |     |
| CHECKED  |      |    |     |
| NOTED    |      |    |     |
| REVIEWED |      |    |     |

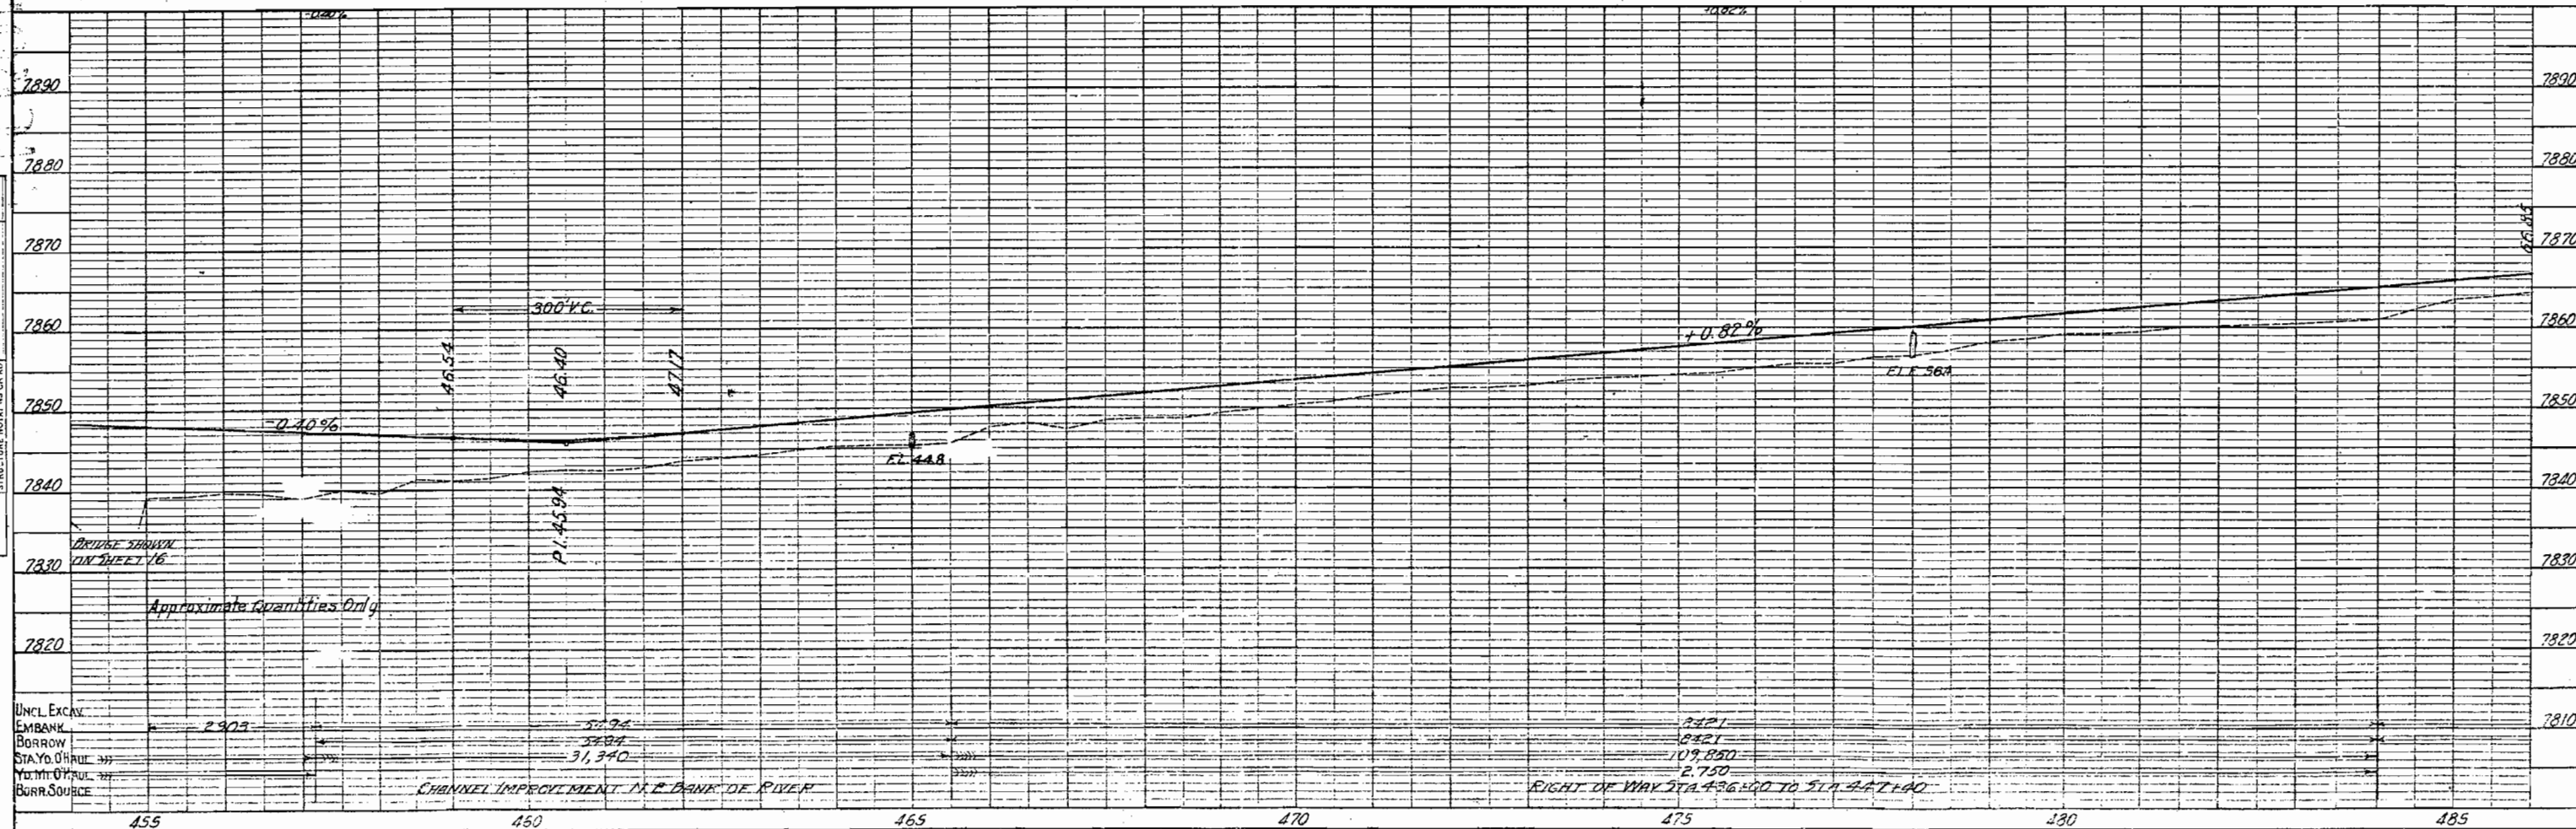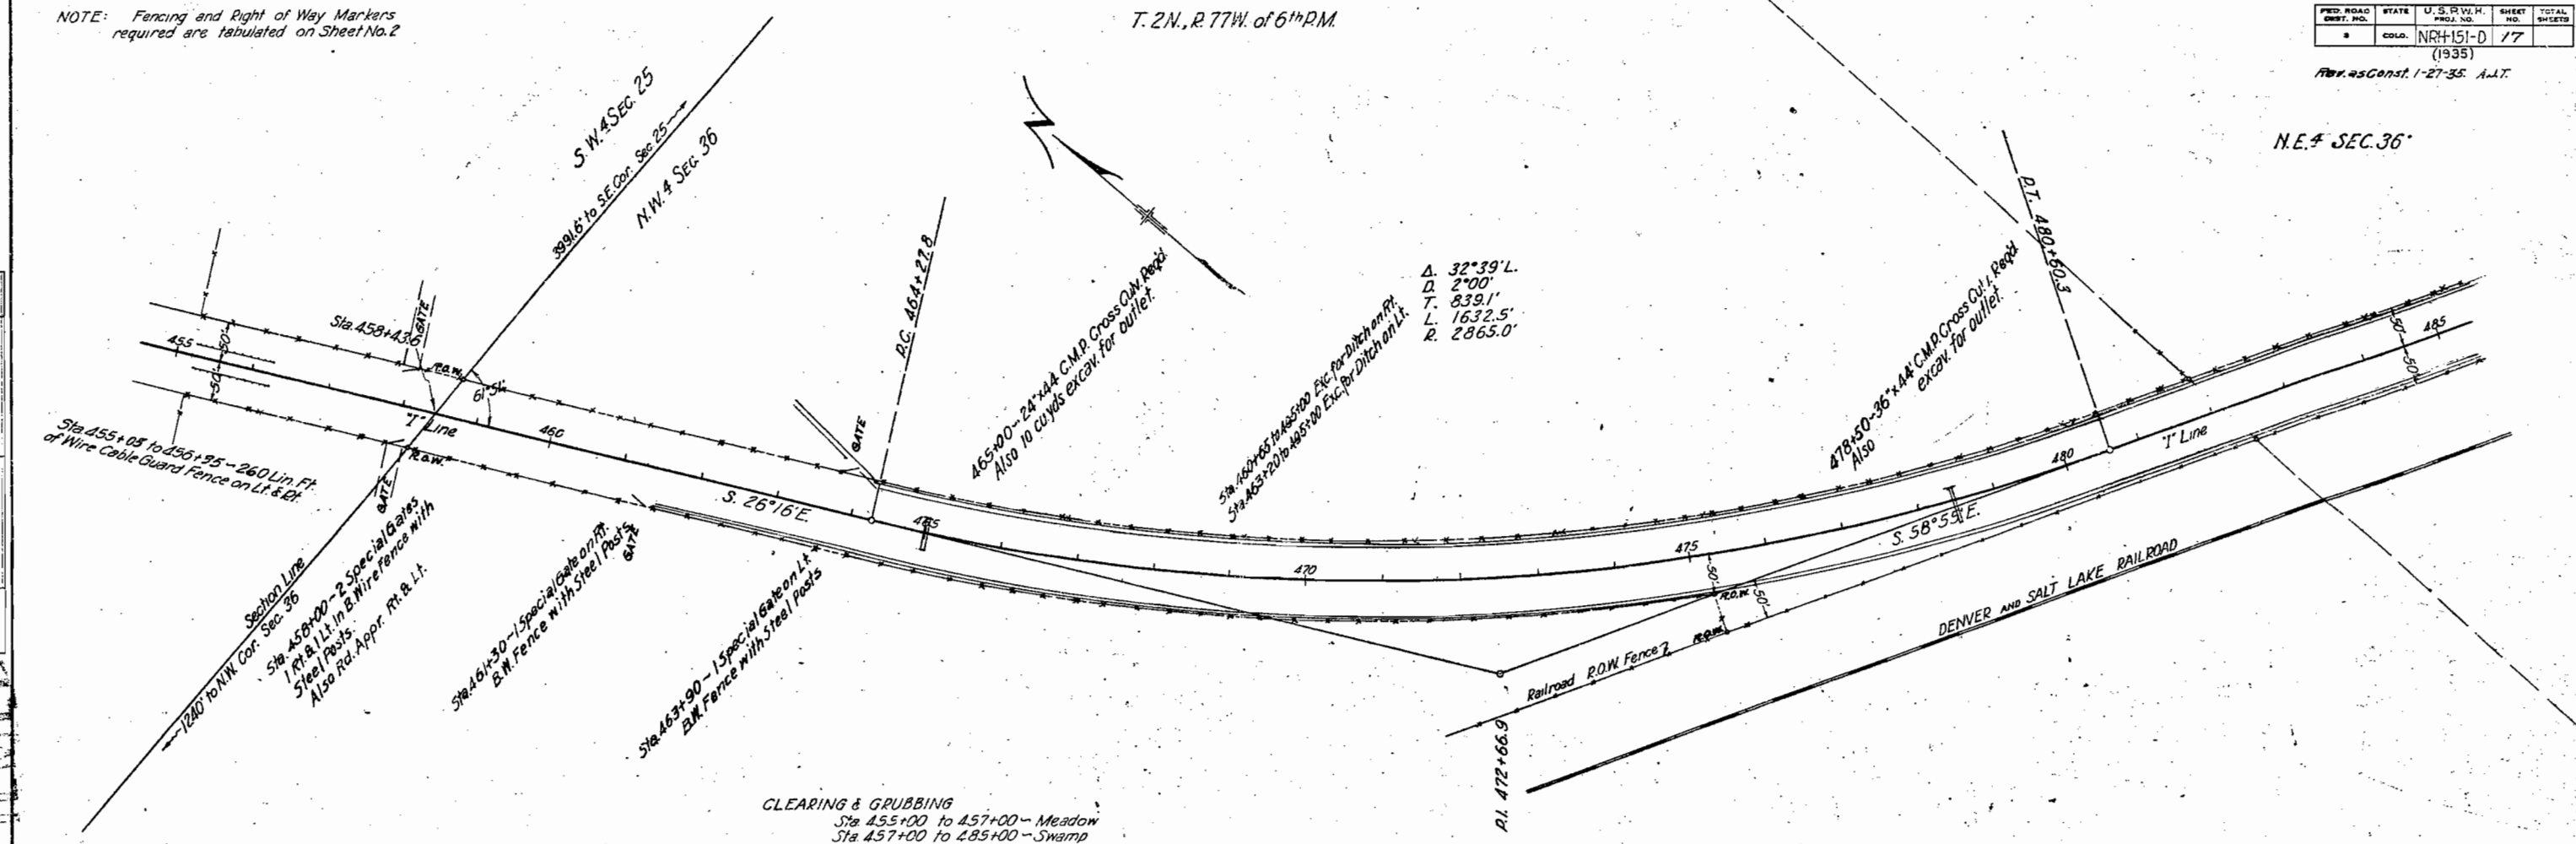

[illegible]

CONFIRMED

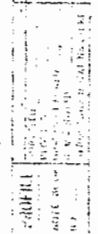


### CLEARING AND GRUBBING

Sta. 485+00 to

Sta. 488+50 to 497+685 ~ Meadow  
Sta. 497+685 to 502+065 ~ Meadow on left - Barrow Pit on right


Sta 503+96.5 to 511+60.4 ~ Meadow  
Sta 511+60.4 to 515+00 ~ Scattered Willows

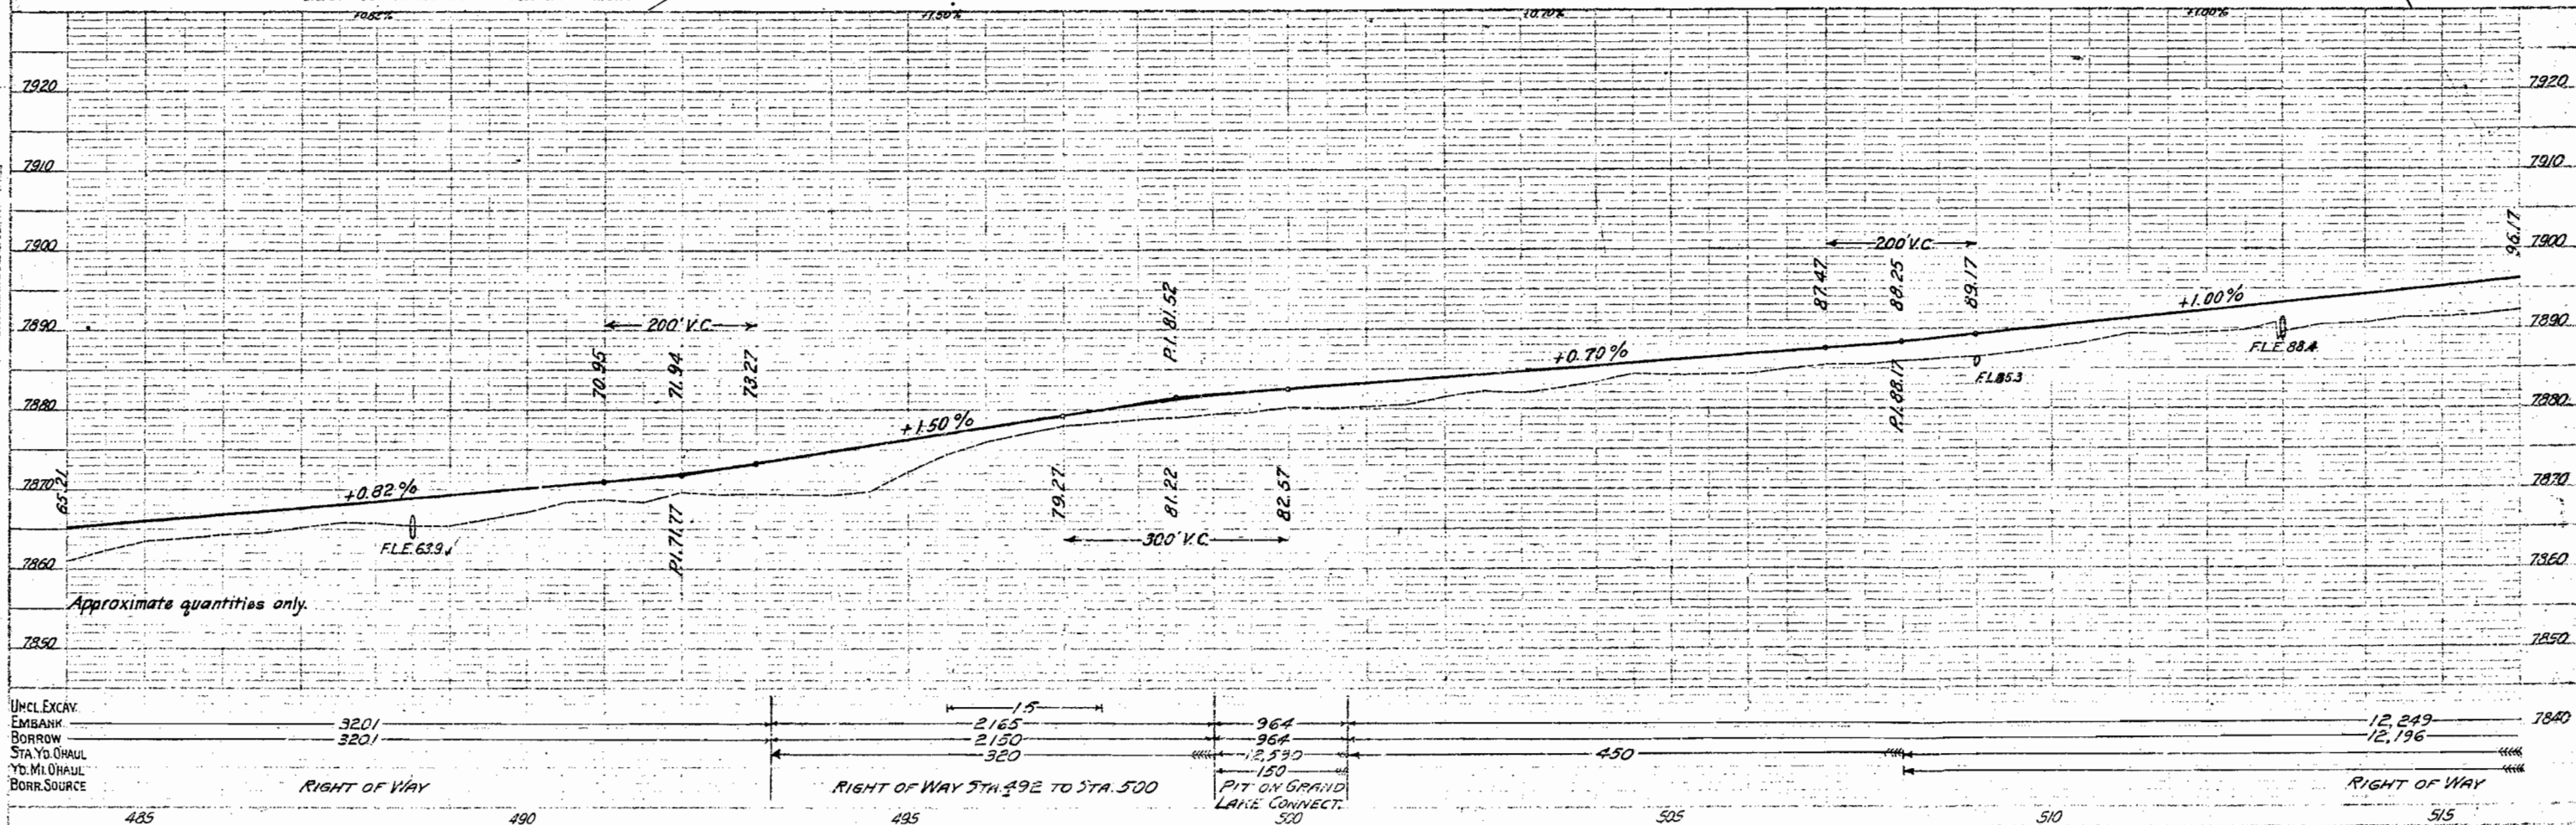


NOTE:- Fencing and Right of Way Markers required are tabulated on Sheet No. 2.

S.W. 4 Sec. 31, T. 2 N., R. 76 W. of 6th P.M.

U.S.P.W.H.  
PROJ. NO.  
NRH-151-D 19  
(1935)  
Rev. as Const. 1-28-36 A.J.T.


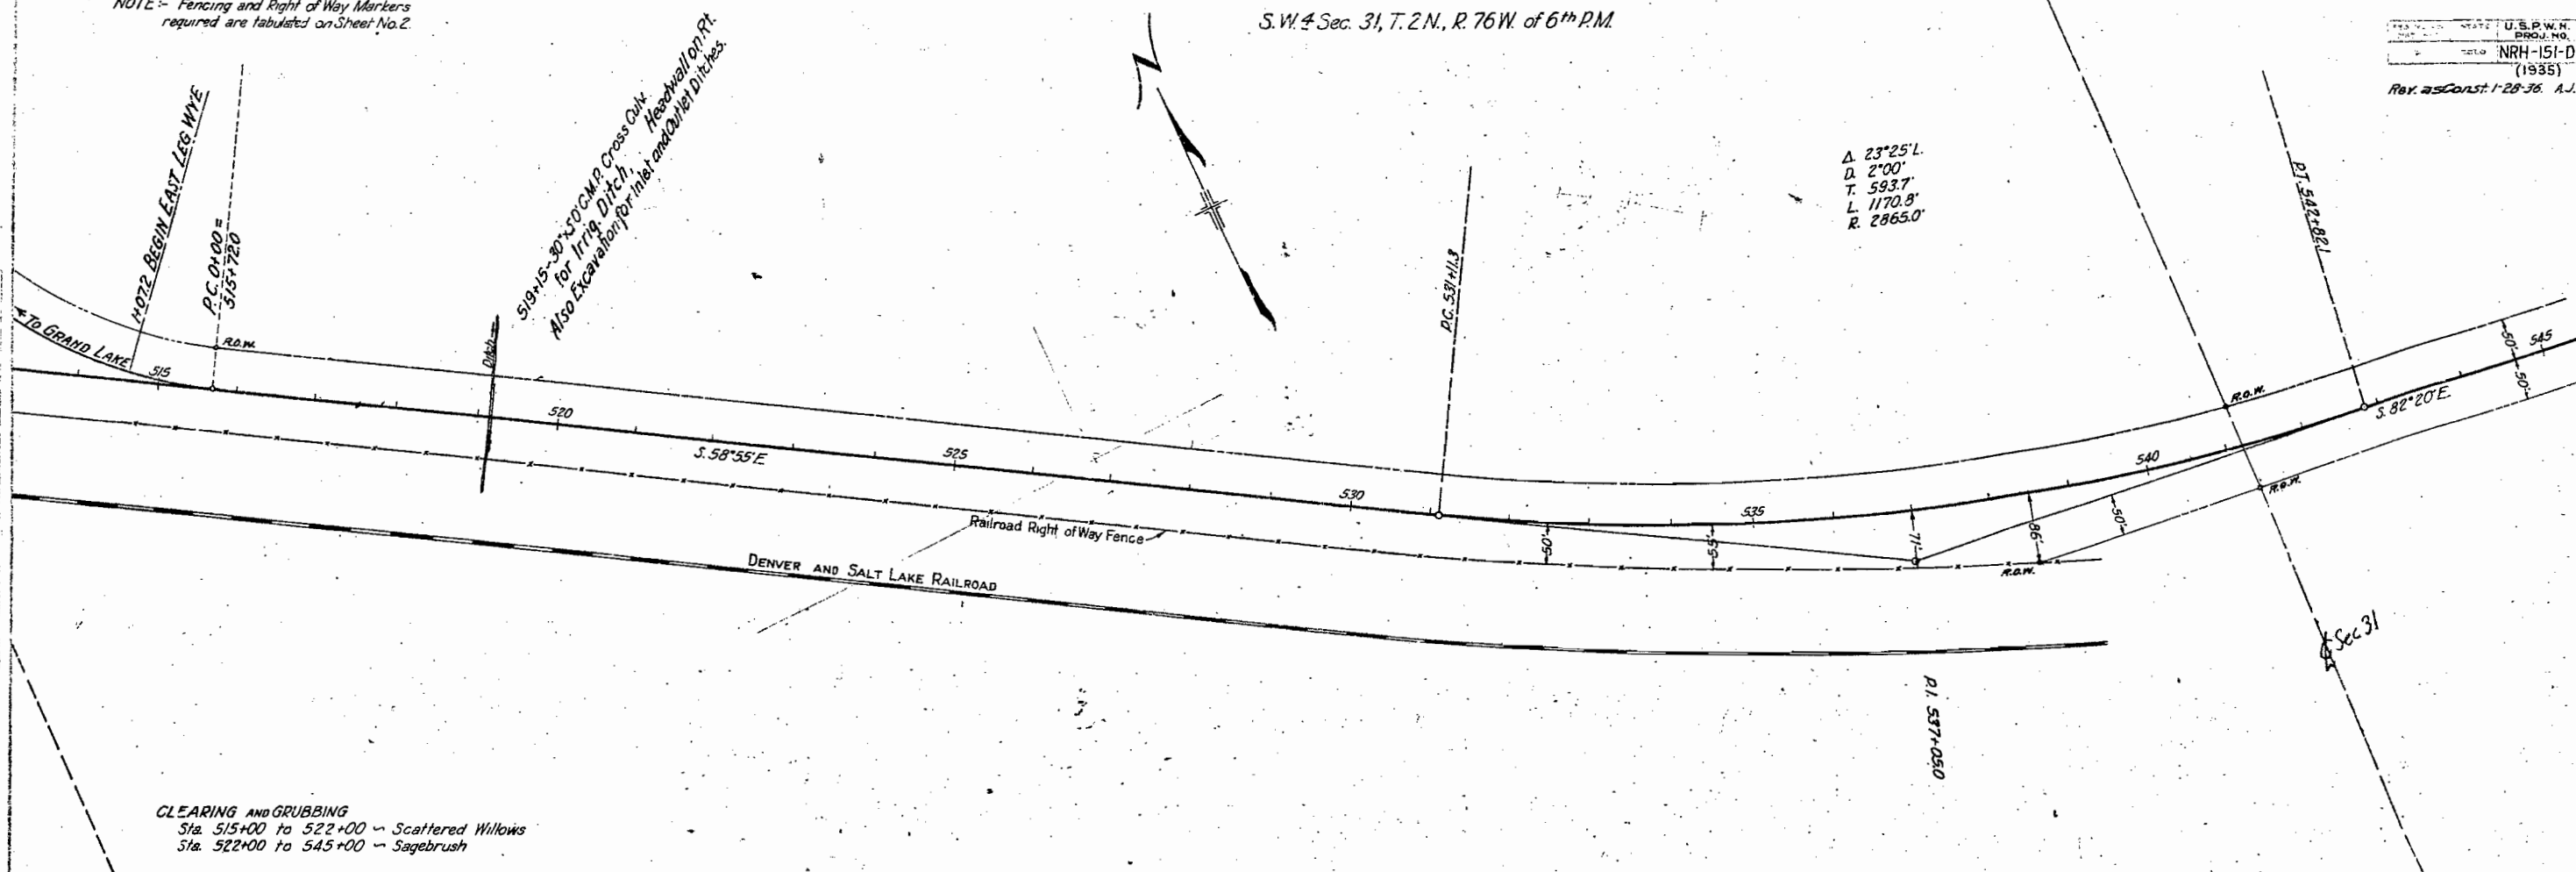


CLEARING AND GRUBBING  
Sta. 515+00 to 522+00 ~ Scattered Willows  
Sta. 522+00 to 545+00 ~ Sagebrush

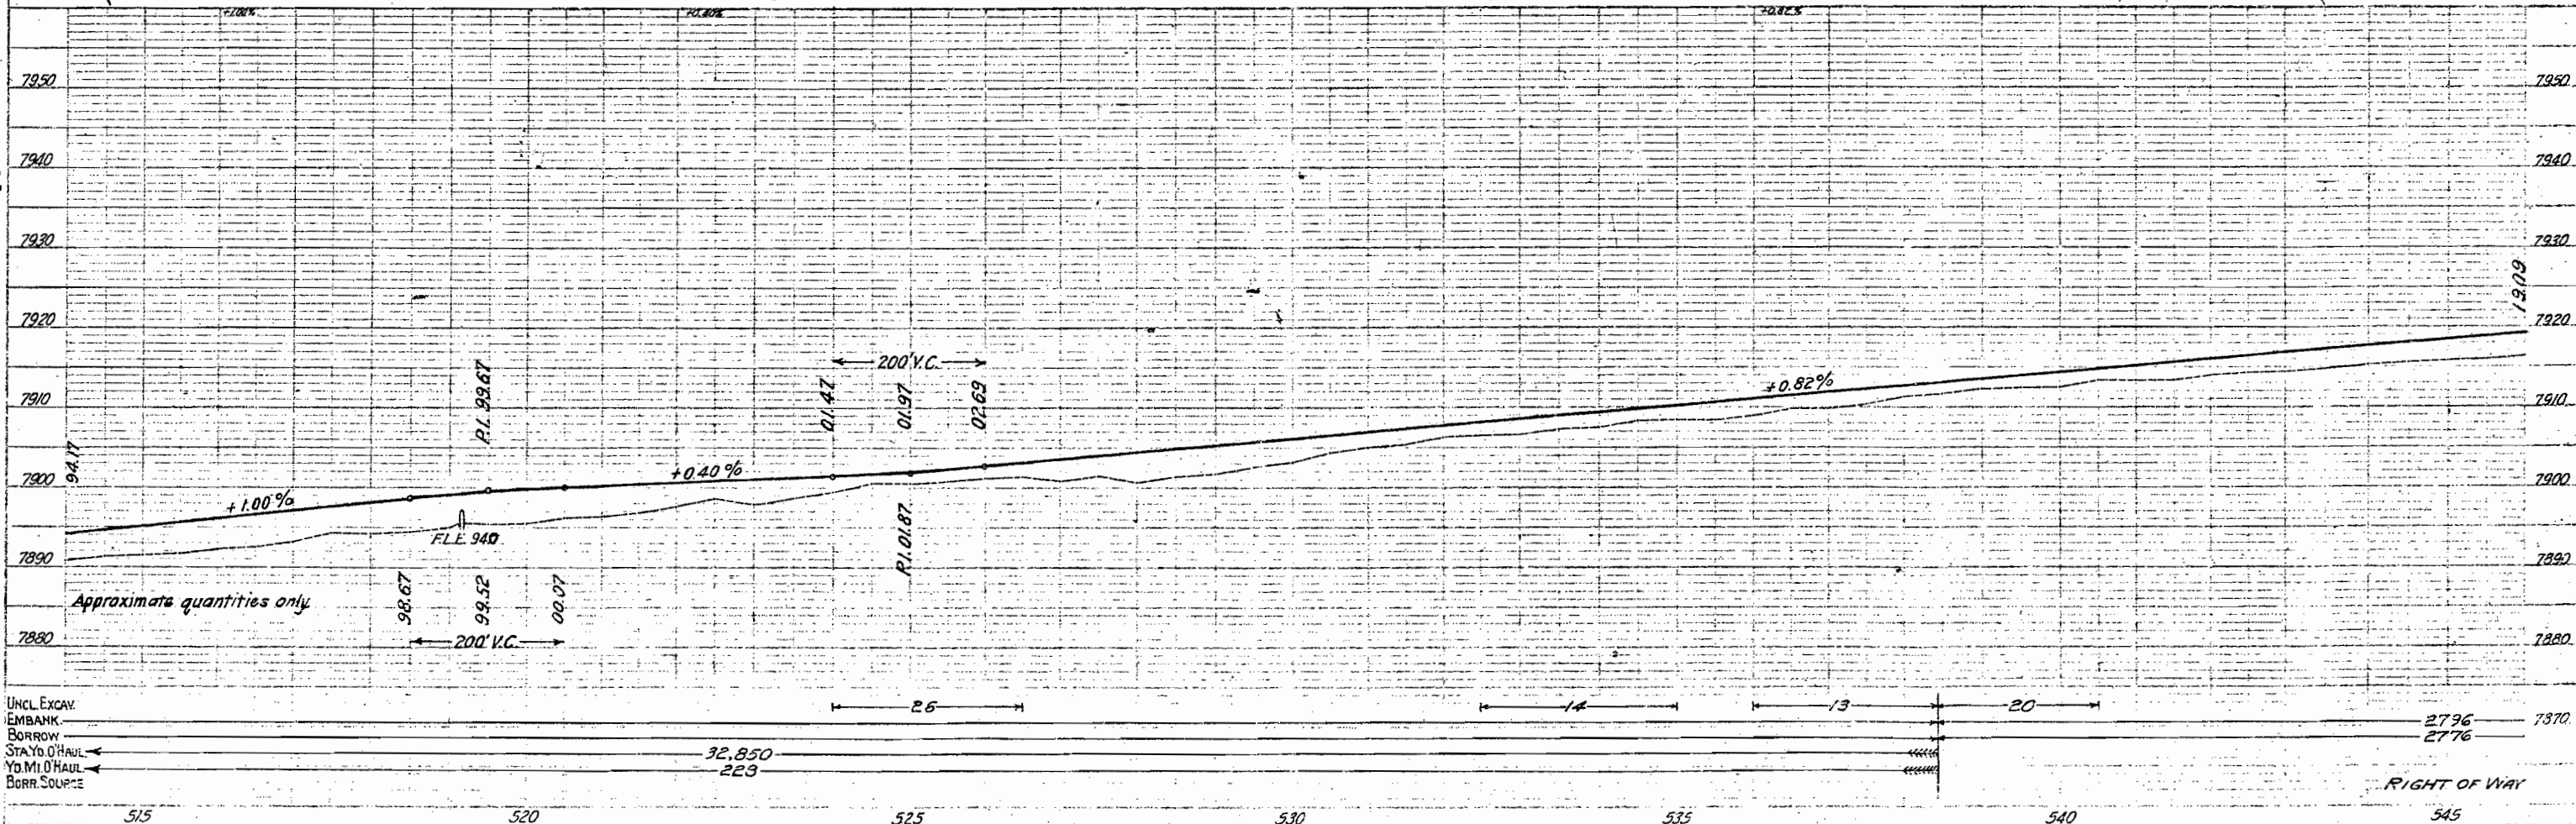



Sec. 31, T. 2N., R. 76W. of 6<sup>th</sup> P.M.

# GRANBY

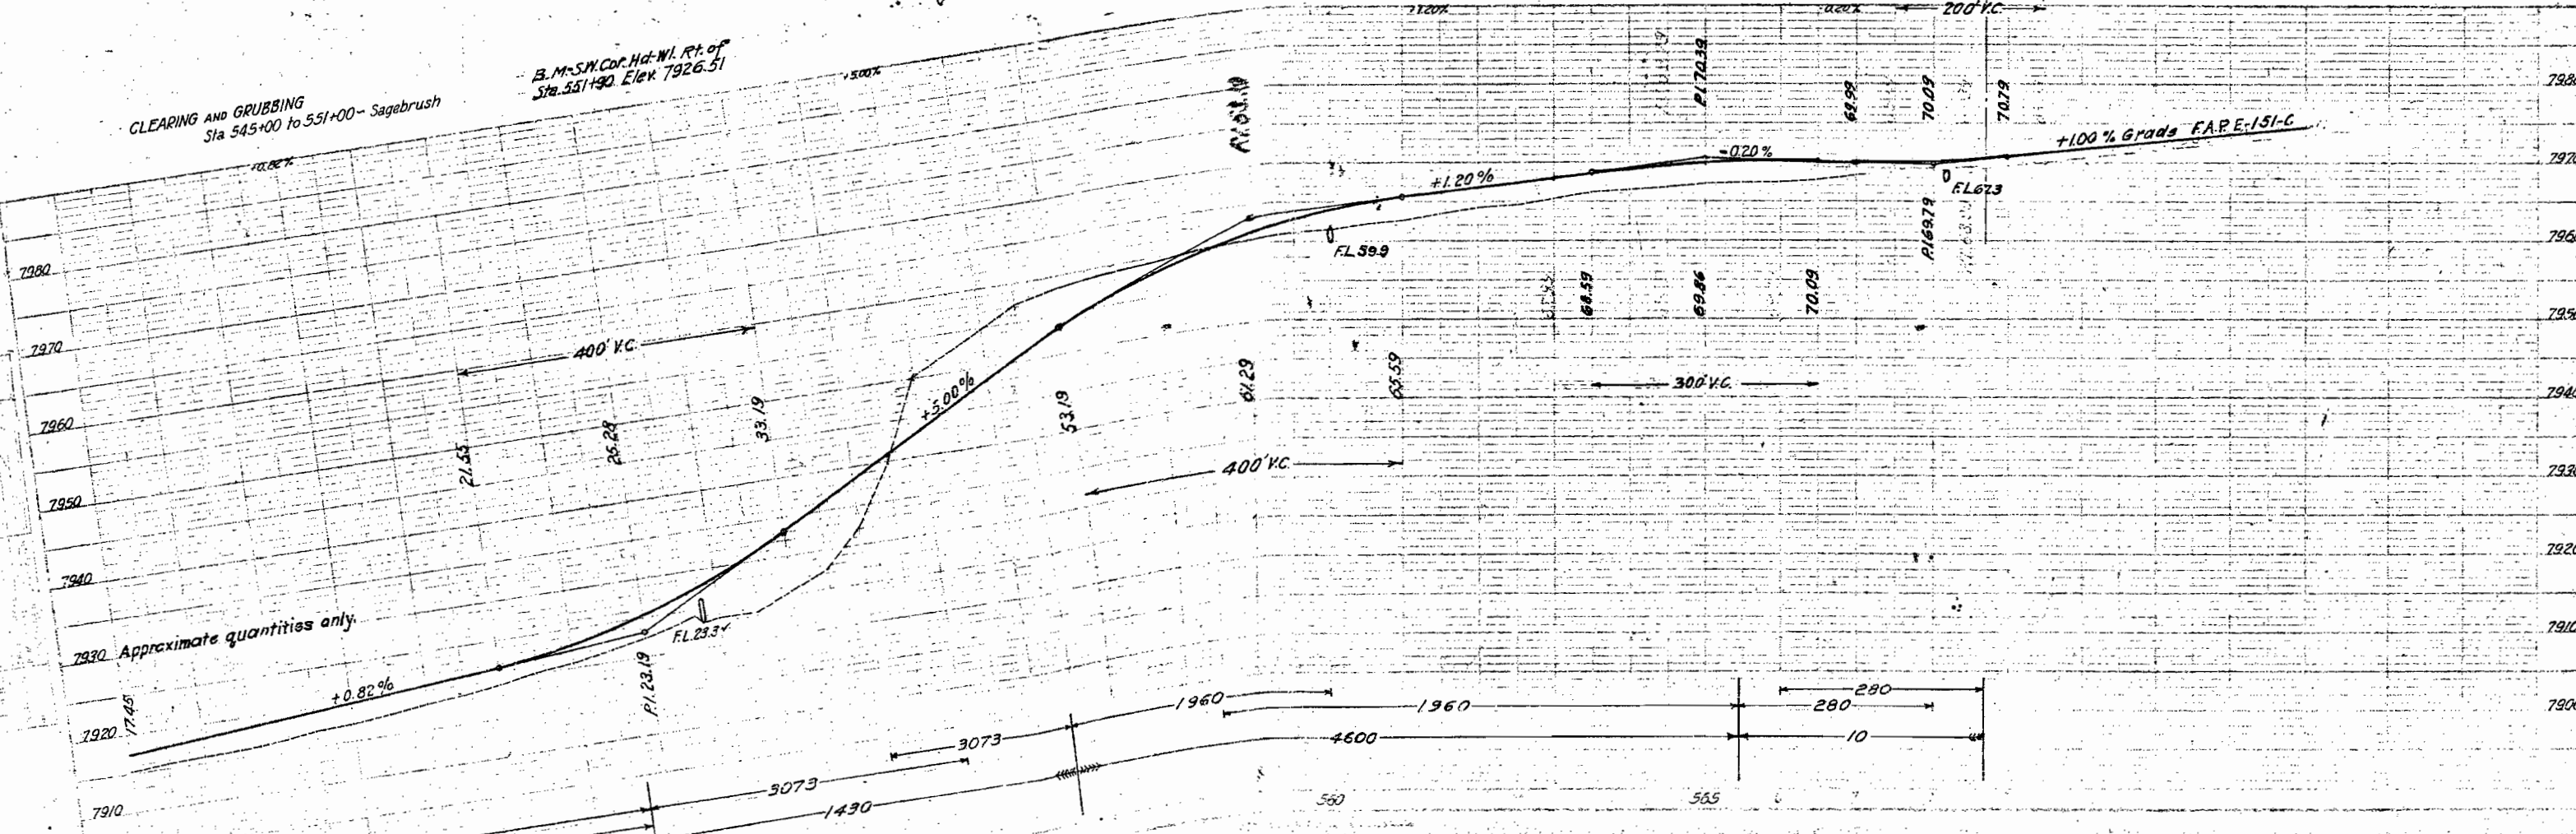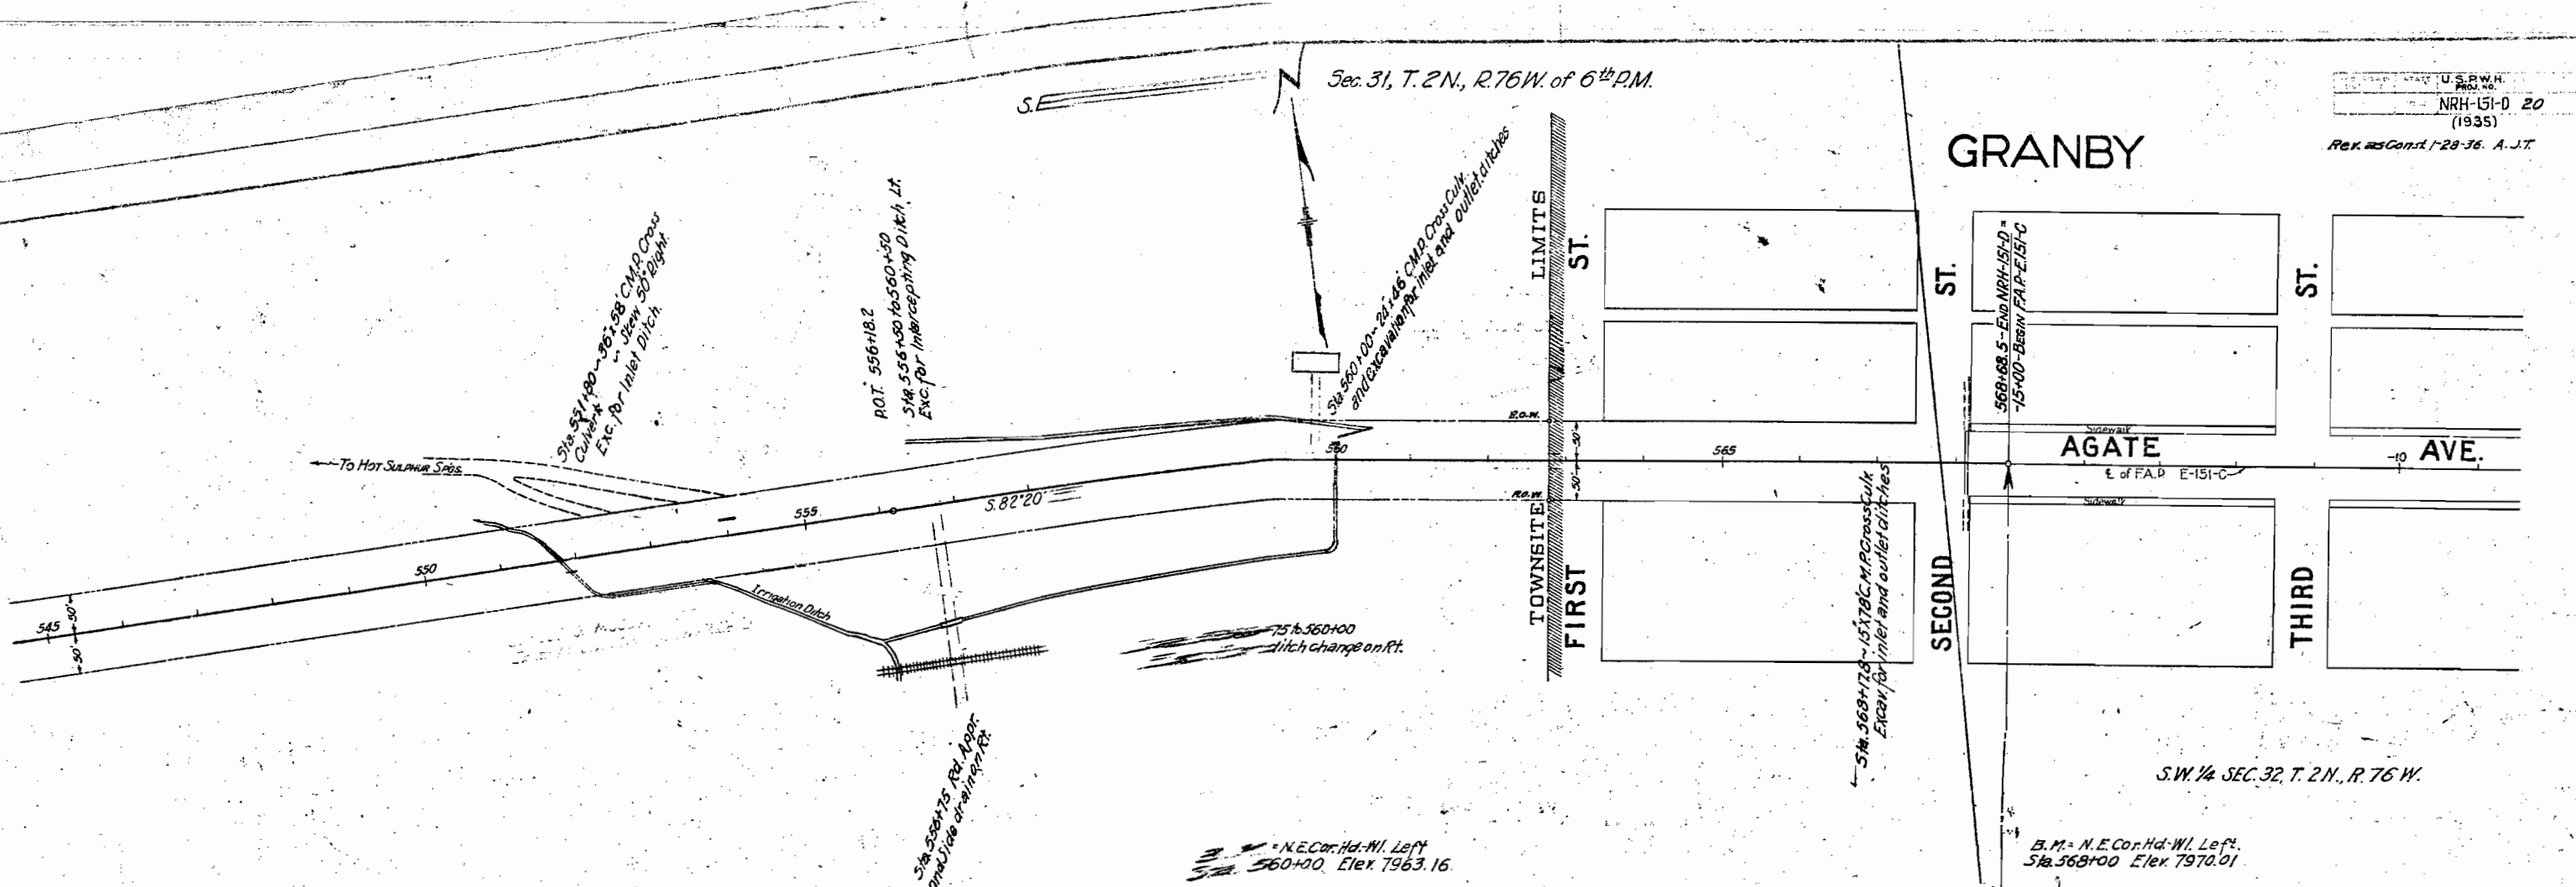

## MICROFILMED

Rev.as Const. 1-28-36. A. J. T.

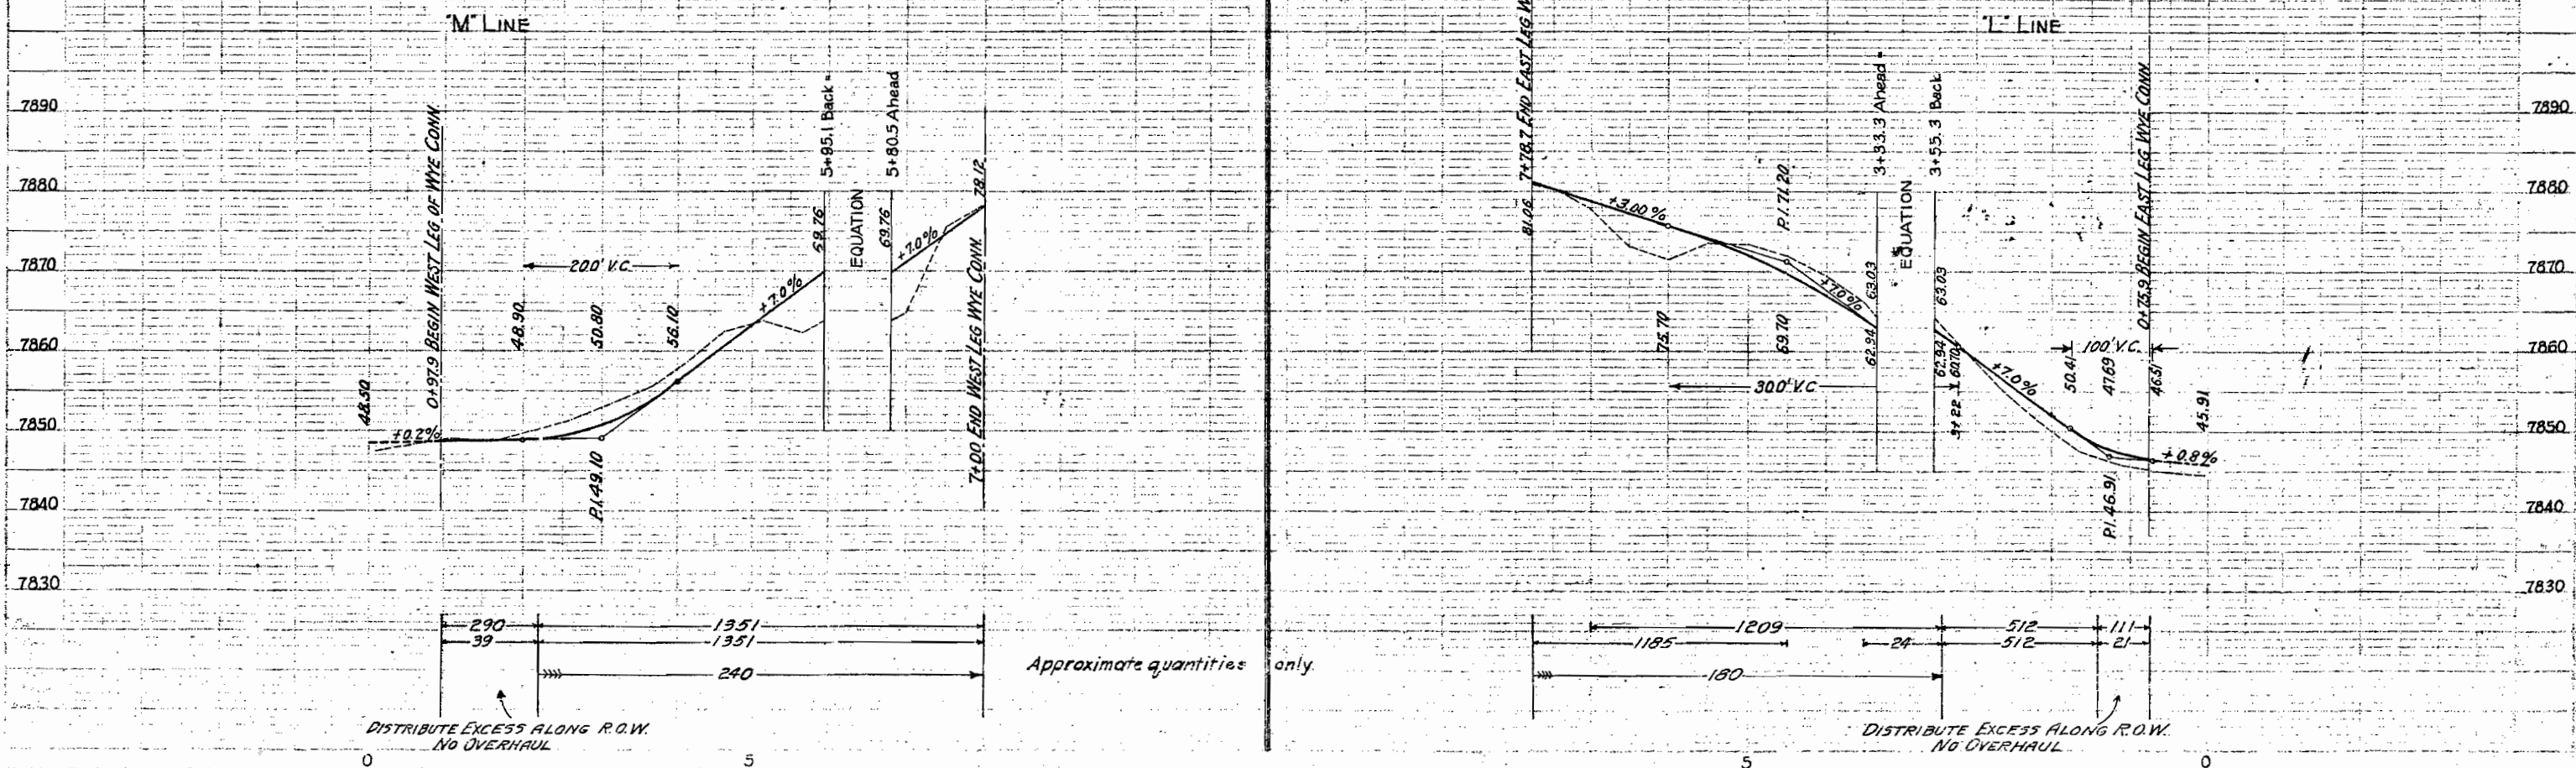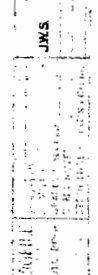

NOTE: Fencing and Right-of-Way Markers  
Required are tabulated on Sheet No. 2

T.2N.-R.77W. of the 6<sup>th</sup> PM.

T.2N.-R.76W. of the 6<sup>th</sup> PM.

GRAND LAKE CONNECTION

U.S.P.W.H.

NRH-151-D 22

(1935)

Rev 25 Const. 1-28-36. A.J.T.

S.E.4 SEC. 36

S.W.4 SEC. 31

PI. 511+45.4

D. 63 L.R.R.

507+97.8 BEGIN GRAND LAKE CONN.

Δ 106.200'  
D. 106.200'  
L. 106.200'  
P. 518.9

Range Line  
N. 1° 05' E.

ROT 518+92.6

Section 36  
N.E.4

Section 31  
N.W.4

PI. 523+98.7  
523+50 to 523+98.7  
C.M.P. Siphon  
Excavation for inlet & outlet  
H=0.0

V Sta 529+74 - remove C.M.P. Cross Culv.  
Sta 530+00 - 18' x 38' C.M.P.  
Cross Culvert


Sta 533+00 - END OF CONNECTION  
Improved Grand Lake Road

State Hwy. No. 16 to Grand Lake


Approximate quantities only

UNCL EXCAV  
EMBANK  
BORROW  
STAYD. HAUL  
YD. MI. HAUL  
BORR. SOURCE

PROFILE OF WEST LEG OF Y-ROAD CONNECTION WITH GRAND LAKE ROAD

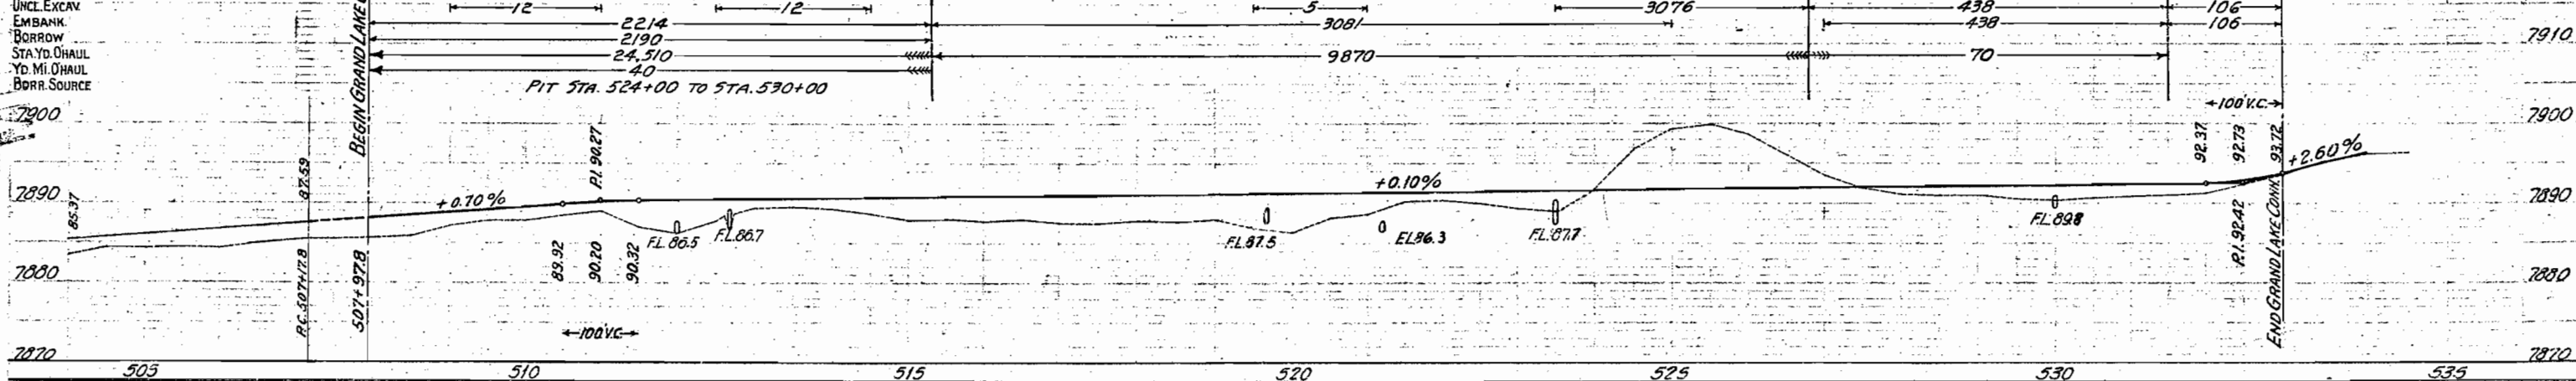

PROFILE OF EAST LEG OF Y-ROAD CONNECTION WITH GRAND LAKE ROAD

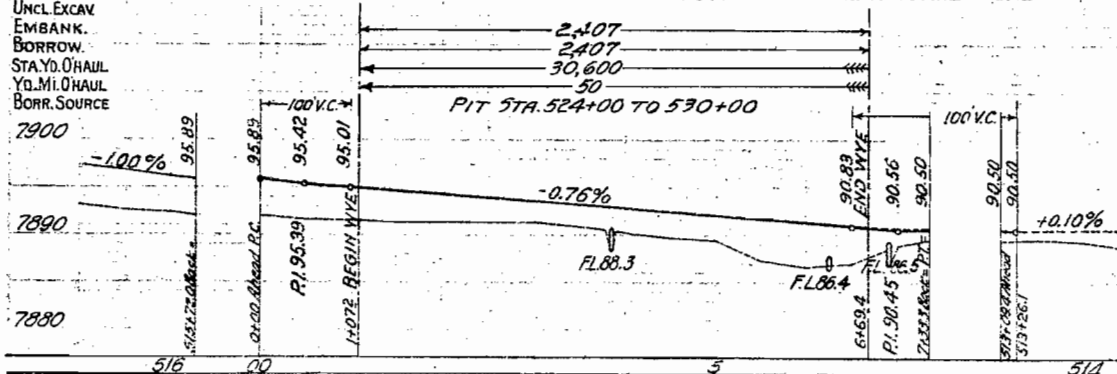



W. N. W. BLAYNEY

Conveys all of the land situated within the Right-of-way of the highway; said R. O. W. extends 50.0 feet on each side of the Centerline of the Highway, except where otherwise noted. Said Highway is located in the NE 1/4 of Sec. 36, T.2 N., R.77 W. of the 6th P.M., more particularly described as follows:

Beginning at Centerline Station 458+43.6, a point on the north line of Sec. 36, whence the R.O.W. of Sec. 36 bears N 88°07'W for 1200.0 feet; thence along said Sec. line, N 88°07'W, for 56.7 feet, to the west R.O.W. line of the Highway; thence along said R. O. W. line, S 26°16'E, for 811.0 feet; thence on a curve to the left, with a radius of 2915.0 feet, for 1120.4 feet; thence S 31°05'W for 80.0 feet to the north R. O. W. line of the D.A.S.L.R.R.; thence along said railroad R. O. W. line, S 58°55'E, for 1245.9 feet; thence N 31°05'E for 51.0 feet; thence S 58°55'E for 275.3 feet, to the E-W 1/2 line of Sec. 36; thence along said 1/2 line, S 27°52'E, for 22.9 feet, to the north R. O. W. line of the Highway; thence along said R. O. W. line, N 68°55'W, for 2070.5 feet; thence on a curve to the right, with a radius of 8515.0 feet, for 1204.0 feet; thence N 26°16'W for 357.4 feet, to the north line of Sec. 36; thence along said Section line, N 88°07'W, for 56.7 feet to the point of beginning.

Said Right-of-way contains 9.600 acres of meadow land to be acquired.

MINNIE H. BLAYNEY

Conveys all of the land situated within the Right-of-way of the Highway; said R. O. W. extends 50.0 feet on each side of the Centerline of the Highway, except where otherwise noted. Said Highway is located in the SE 1/4 of Sec. 36, T.2 N., R.77 W. of the 6th P.M., more particularly described as follows:

Beginning at Centerline Station 511+60.4, a point on the east line of Sec. 36, which is also the Range line between R.76 W. and R.77 W., whence the east 1/2 corner of Sec. 36 bears N 1°05'W for 846.8 feet; thence along said Section line, S 1°05'W for 57.7 feet, to the North R. O. W. line of the D.A.S.L.R.R.; thence along said R. O. W. line, N 58°55'W, for 792.8 feet; thence N 31°05'E for 51.0 feet; thence S 58°55'W for 352.7 feet, to the E-W 1/2 line of Sec. 36; thence along said 1/2 line, S 87°56'E for 99.9 feet, to the north R. O. W. line of the Highway; thence along said R. O. W. line, S 58°55'E, for 587.0 feet; thence on a curve to the left, with a radius of 266.3 feet, for 408.4 feet, to the east line of Range 77 W.; thence along said Range line, S 1°05'W, for 361.4 feet, to the point of beginning.

Said R. O. W. contains 2.904 acres of meadow land, all of which is to be acquired.


W. N. W. BLAYNEY

Conveys all of the land situated within the Right-of-way of the Highway; said R. O. W. extends for 50.0 feet on each side of the Centerline of the Highway, except where otherwise noted. Said Highway is located in the NE 1/4 of Sec. 31, T.2 N., R.76 W. of the 6th P.M., more particularly described as follows:

Beginning at Centerline Station 514+41.0 of the Grand Lake Road Approach, a point on the E-W 1/2 line of Sec. 31, whence the W 1/2 corner of Sec. 31 bears N 89°48'W for 115.8 feet; thence along said Section line, N 89°48'W, for 51.6 feet, to the west R. O. W. line of the Highway; thence along said R. O. W. line, N 14°28'E, for 703.7 feet; thence on a curve to the right, with a radius of 1003.0 feet, for 389.9 feet; thence N 36°39'W for 717.5 feet; thence S 44°21'E for 100.0 feet to the east R. O. W. line of the Highway; thence along said R. O. W. line, S 36°39'W for 300.0 feet; thence S 63°21'E for 100.0 feet; thence S 36°39'W for 417.5 feet; thence on a curve to the left, with a radius of 605.0 feet, for 163.8 feet; thence N 64°18'W for 100.0 feet; thence S 26°42'W, and on a curve to the left with a radius of 905.0 feet, for 178.2 feet; thence S 14°25'W for 758.3 feet to the E-W 1/2 line of Sec. 31; thence along said 1/2 line, N 89°48'W, for 51.6 feet, to the point of beginning.

Said Right-of-way contains 5.613 acres of uncultivated land of which 1.253 acres are contained in the Right-of-way of the present Highway, leaving 4.360 acres to be acquired.

COLORADO STATE HIGHWAY DEPARTMENT  
USPW-NR-151-D  
RIGHT-OF-WAY MAP No 2

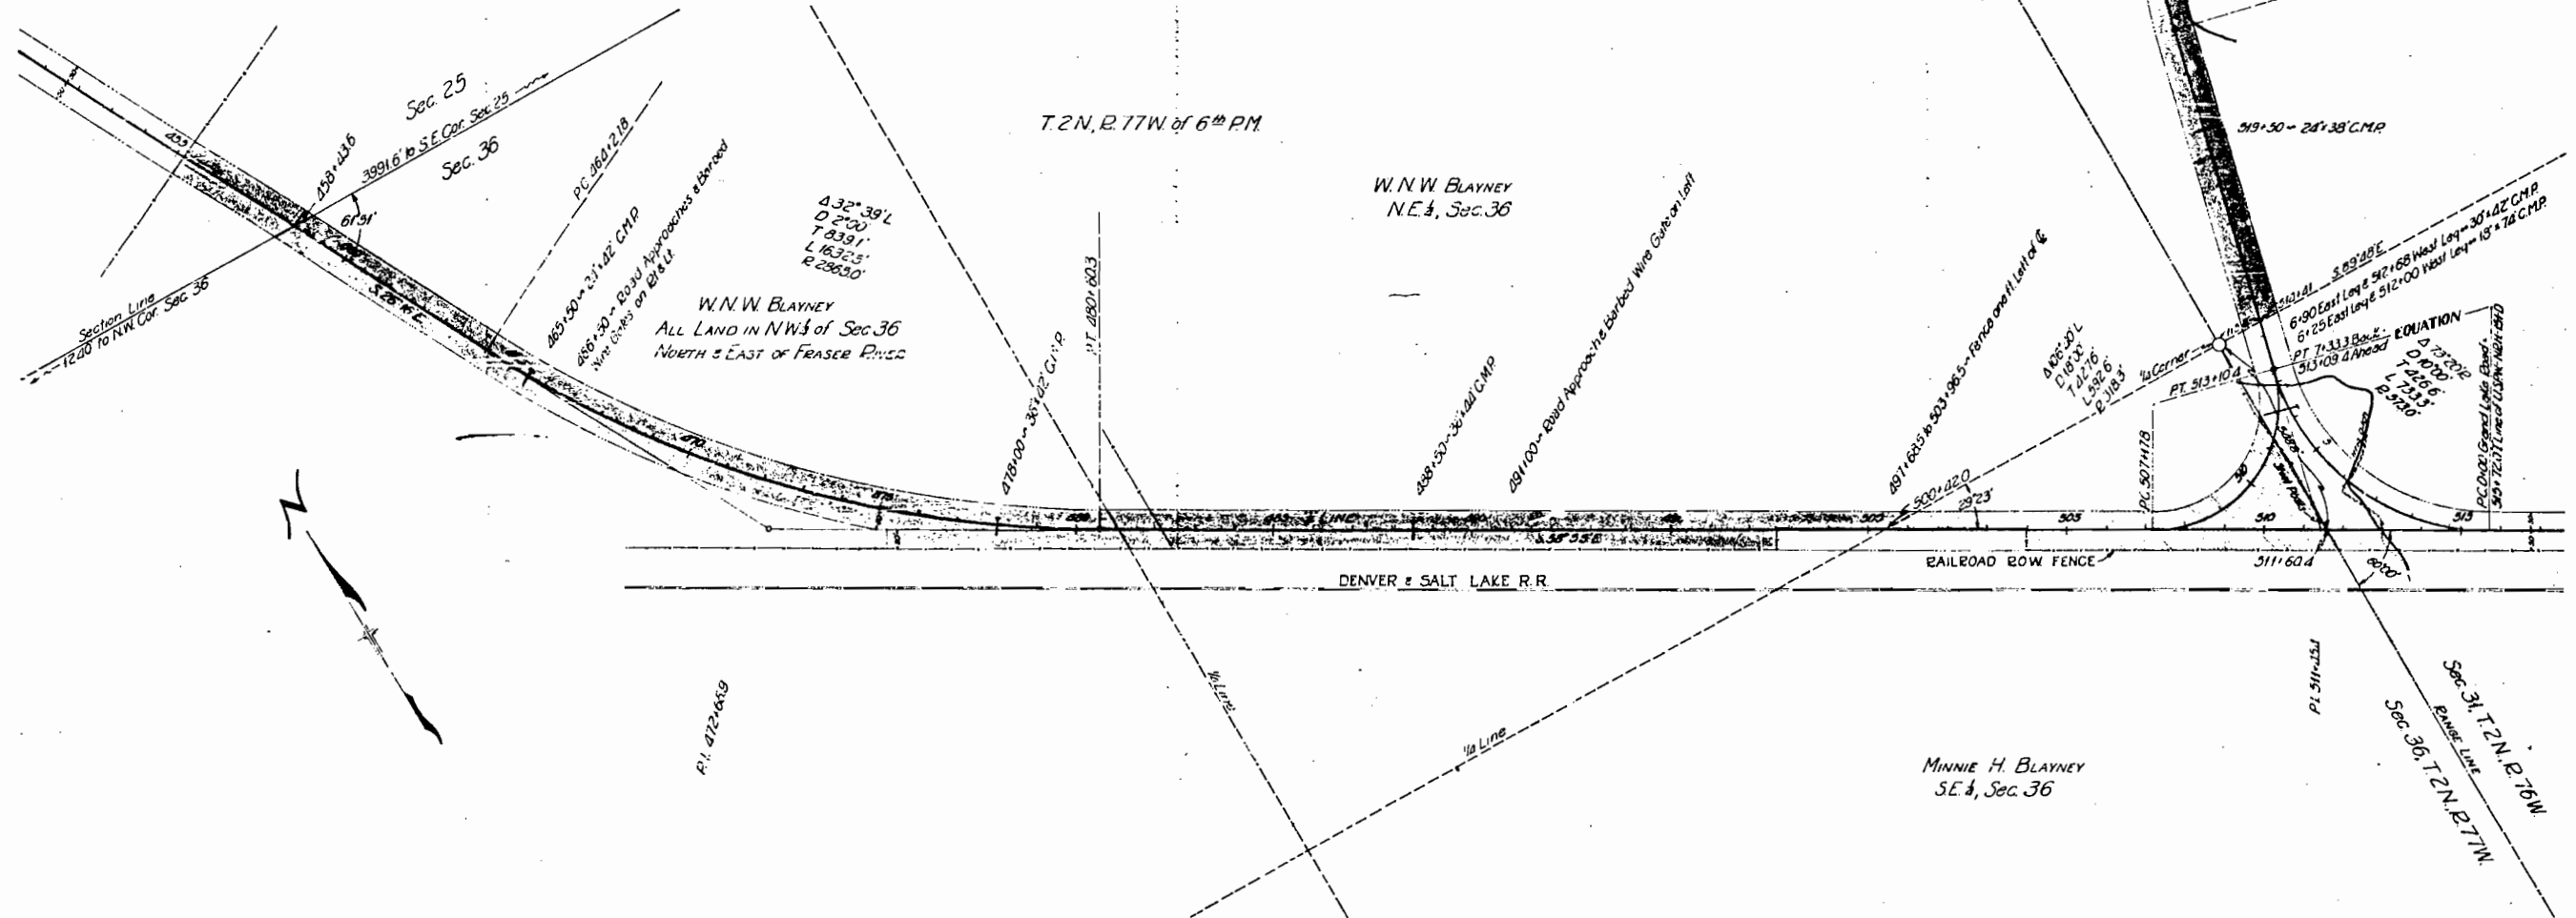


U. S. LAND  
W $\frac{1}{2}$  of NW $\frac{1}{4}$  Sec 25


Beginning at P.O.S.T. 424+88.1, a point on the West line of Sec. 25, thence the N. & 7/8 E. corner of Sec. 25 bears S.0°06'W., for 416.7 feet; thence along said Section line, S.0°06'W., for 68.2 feet to the east R. O. s. line of the Highway; thence along said R. O. s. line, S.68°27'W., and on a curve to the right, with a radius of 991.8 feet, for 740.5 feet to the E-W & 1/2 line of Section 25; thence along said E-W & 1/2 line, S.89°04'W. for 137.2 feet to the east R. O. W. line of the Highway; thence along said R. O. W. line, N.17°19'W. and on a curve to the left, with a radius of 1121.8 feet, for 827.4 feet; thence S.29°56'W. for 30.0 feet; thence S.60°04'W. and on a curve to the left, with a radius of 1021.8 feet, along said E-W & 1/2 line, to the intersection of Sec. 25; thence along said Section line, S.0°06'W. for 43.1 feet to the point of beginning.

W. N. W. BLAYNEY

Beginning at Centerline Station 458+43.6, a point on the south line of Sec. 28 whence the SW corner of Sec. 25 bears N.86°07'W. for 1240.0 feet; thence along said Section line, N.86°07'W. for 56.7 feet to the west R. O. W. line of the Highway; thence along said R. O. W. line, S.26°16'W. for 1163.9 feet; thence on a curve to the right, with a radius of 1482.5 feet, for 820.6 feet; thence on a curve to the left, with a radius of 991.8 feet, for 434.9 feet; thence along said R. O. W. line, S.89°54'W. for 137.2 feet to the east R. O. W. line of the highway; thence along said R. O. W. line, S.17°19'W. and on a curve to the right, with a radius of 1121.8 feet, for 445.5 feet; thence S.6°27'W. for 113.0 feet; thence on a curve to the left, with a radius of 1552.5 feet, for 748.6 feet; thence S.28°16'W. for 347.1 feet; thence S.63°05'W. for 322.2 feet; thence S.87°00'W. for 870.2 feet to the south line of Sec. 28; thence along said Section line, N.86°07'W., for 56.7 feet, to the point of beginning.

→ thence N 5°27'E for 113.0 feet:

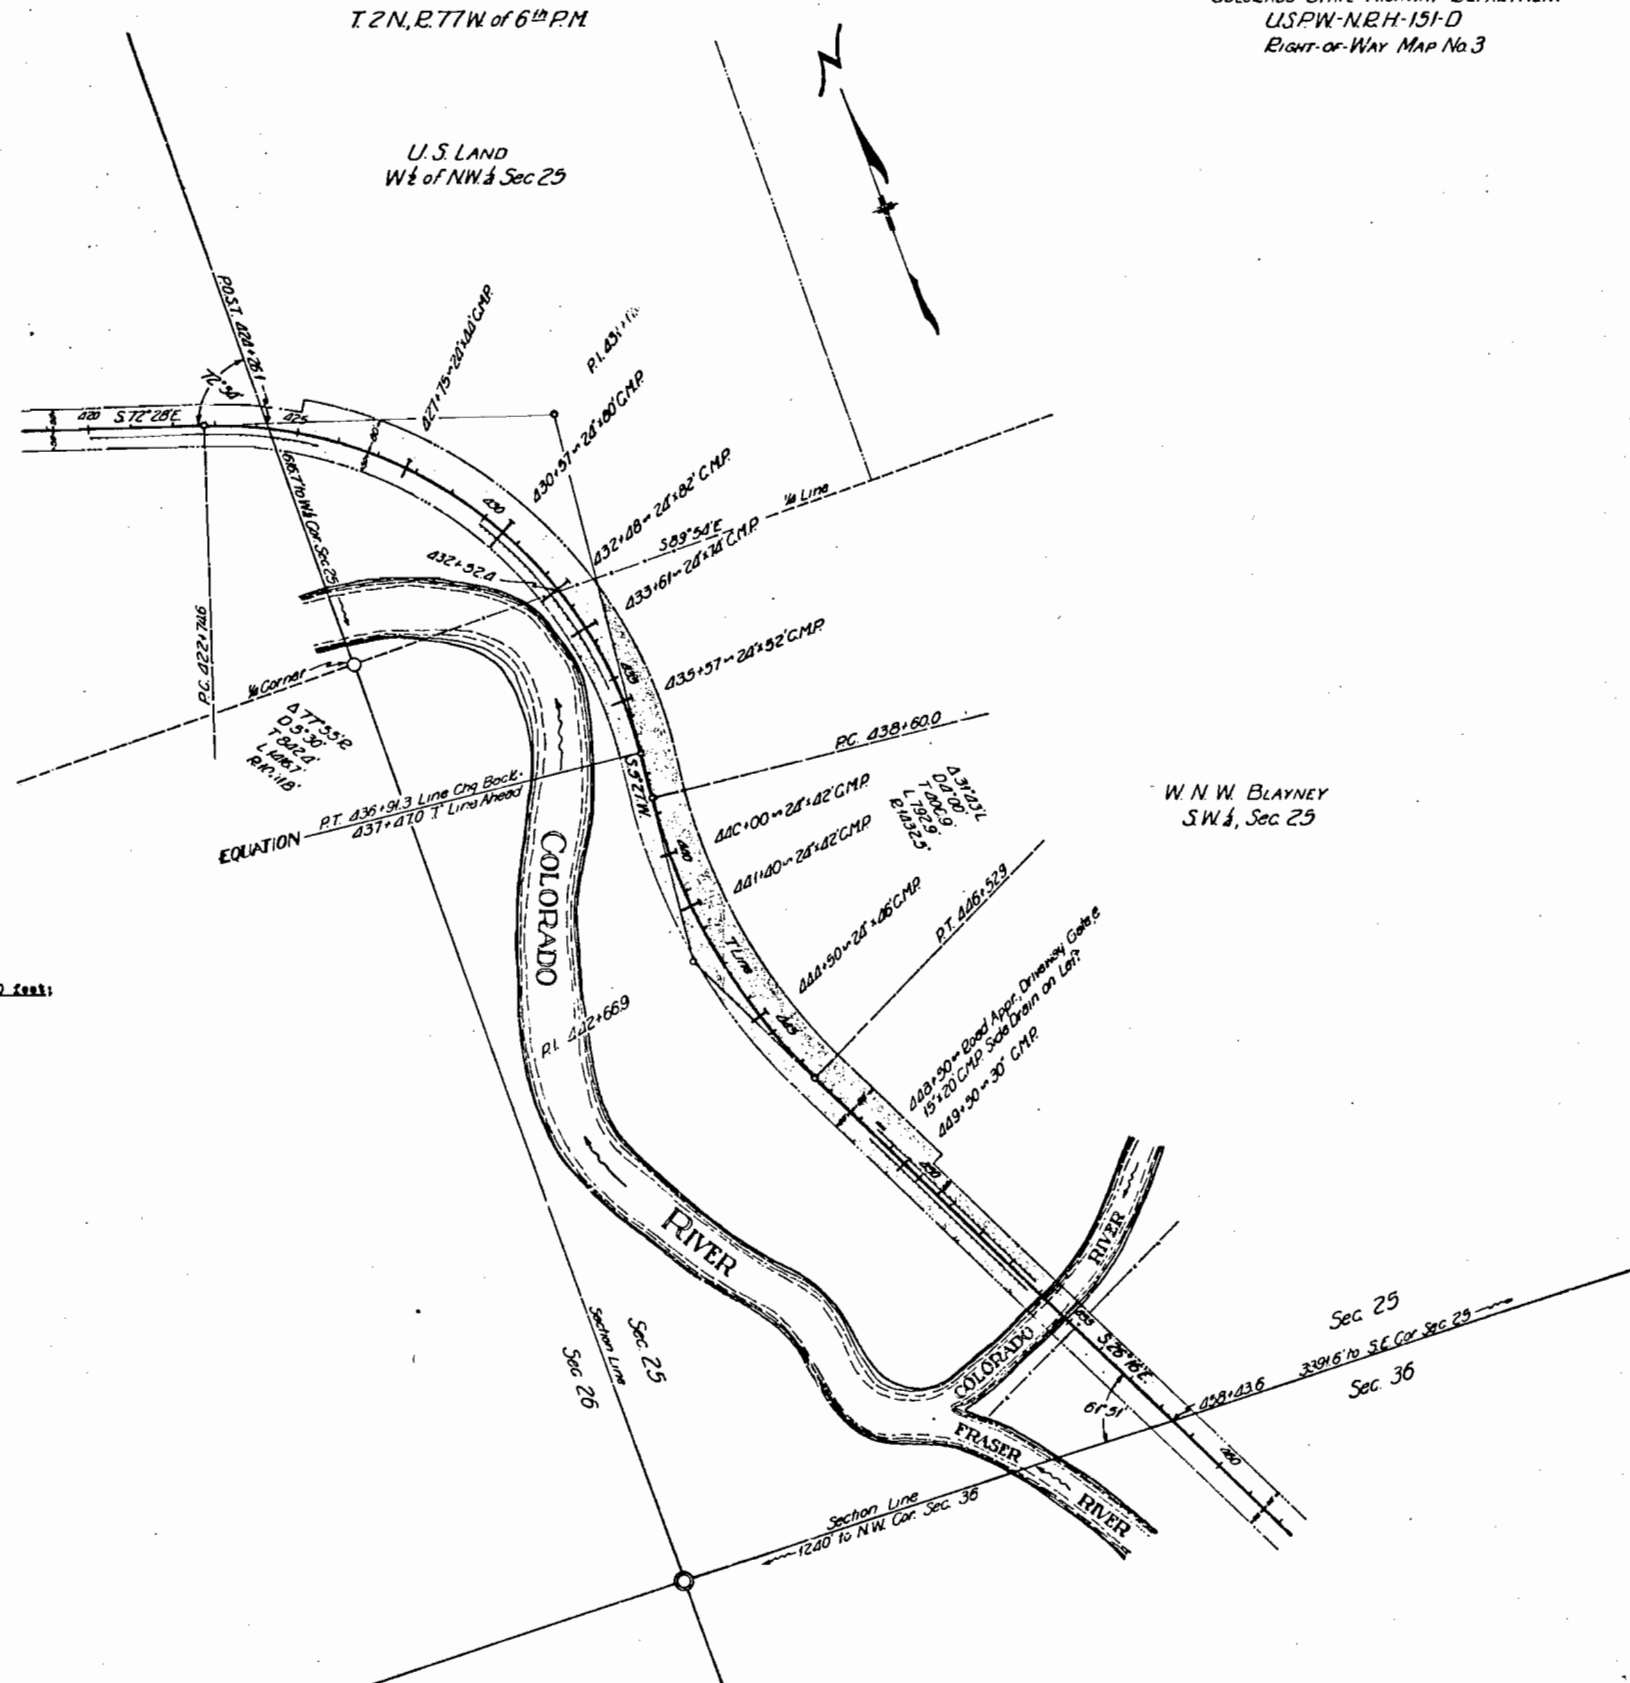

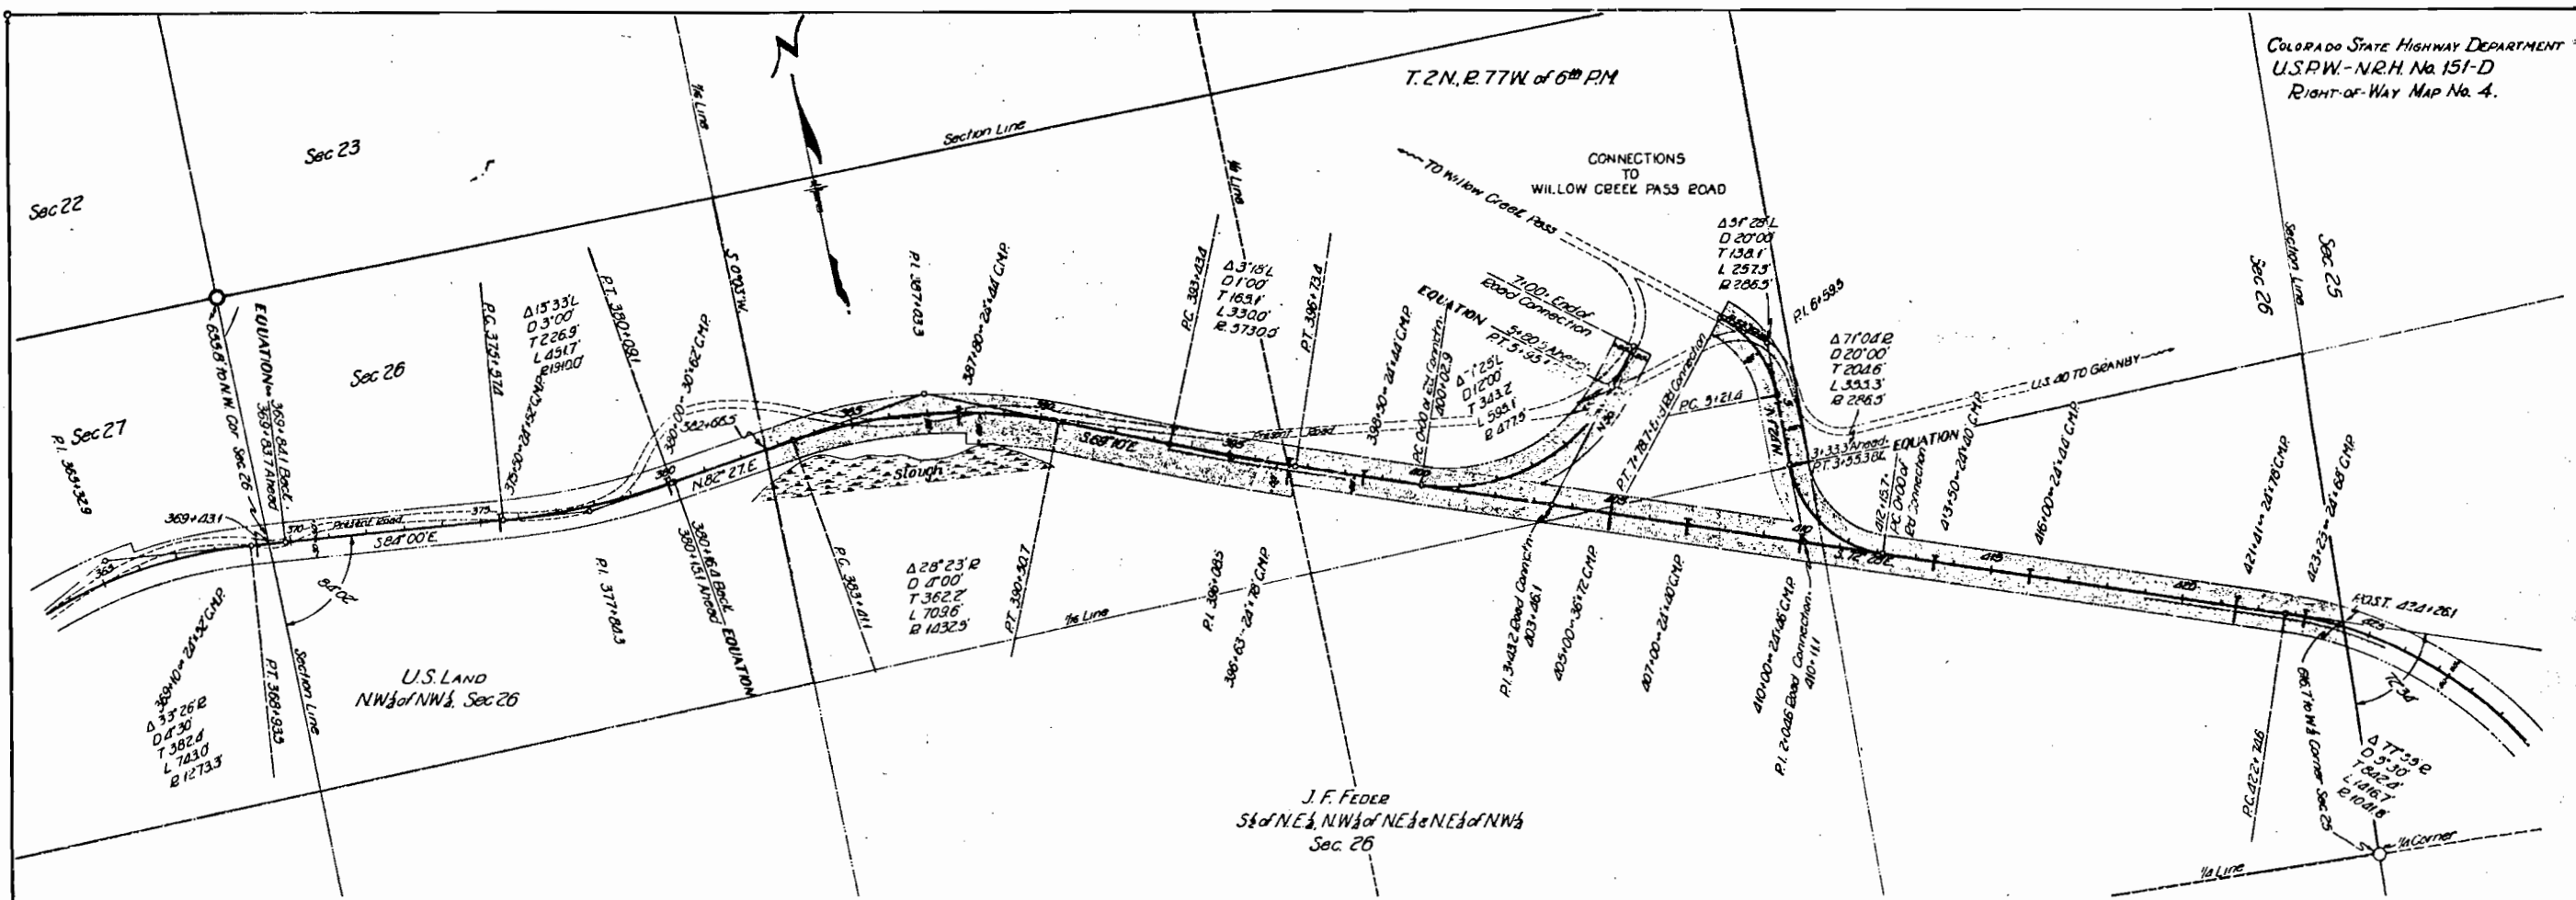

U. S. LAND

Conveys all of the land situated within the Right-of-way of the Highway; said R.O.W. extends 50.0 feet on each side of the Centerline of the Highway. Said Highway is located in the NW<sup>1</sup> of NE<sup>1</sup> of Sec. 26, T.2 N., R.77 W of the 6th P.M., more particularly described as follows:

Beginning at Centerline Station 369+43.1, a point on the west boundary line of Sec. 26, whence the NW corner of Sec. 26 bears N 0°02' E for 655.8 feet; thence along said Section line S 0°02' W for 50.3 feet to the south R.O.W. line of the Highway; thence along said R.O.W. line, S 84°00' E for 509.4 feet; thence on a curve to the left, with a radius of 1960.0 feet, for 463.8 feet; thence S 82°27' E for 252.0 feet; thence N 0°03' E for 100.8 feet to the north R.O.W. line of the Highway; thence along said R.O.W. line S 82°27' W for 265.4 feet; thence on a curve to the right, with a radius of 1860.0 feet, for 438.2 feet; thence N 84°00' W for 620.0 feet to the west boundary of Sec. 26; thence along said Section line S 0°02' W for 50.3 feet to the point of beginning.

Said R.O.W. contains 3.042 acres, of which 1.621 acres are contained in the R.O.W. of the present road, leaving 1.421 acres of uncultivated land to be acquired.

J. F. FEDER  
S of NE<sup>1</sup>, NW<sup>1</sup> of NE<sup>1</sup> of NW<sup>1</sup>  
Sec. 26

J. F. FEDER

Conveys all of the land situated within the Right-of-way of the Highway; said R.O.W. extends 50.0 feet on each side of the Centerline of the Highway, except where otherwise noted. Said Highway is located in the SE<sup>1</sup> of NE<sup>1</sup>, the NW<sup>1</sup> of NE<sup>1</sup>, and the NW<sup>1</sup> of NE<sup>1</sup> of Sec. 26, T.2 N., R.77 W of the 6th P.M., and is more particularly described as follows:

Beginning at P.O.S.T. 424+26.1, a point on the S line of Sec. 26, whence the NE<sup>1</sup> corner of Sec. 26 bears S 0°06' W for 616.7 feet; thence along said Section line S 0°06' W for 68.2 feet, to the south R.O.W. line of the Highway; thence along said R.O.W. line N 62°27' W and on a curve to the left, with a radius of 991.5 feet, for 173.3 feet; thence N 72°28' W for 2601.2 feet; thence N 17°33' E for 30.0 feet; thence N 72°28' W and on a curve to the right, with a radius of 5610.0 feet, for 334.6 feet; thence N 1°10' W for 292.7 feet; thence on a curve to the left, with a radius of 1352.5 feet, for 236.7 feet; thence N 10°48' E for 30.0 feet; thence N 79°12' W and on a curve to the left, with a radius of 1382.5 feet, for 442.9 feet; thence S 82°27' W for 81.3 feet to the N 1/4 line of Sec. 26; thence along said 1/4 line N 0°03' E for 100.8 feet to the north R.O.W. line of the Highway; thence along said R.O.W. line N 82°27' W for 47.9 feet; thence on a curve to the right, with a radius of 1482.5 feet, for 77.4 feet; thence S 69°10' E for 292.7 feet; thence on a curve to the left, with a radius of 3680.0 feet, for 327.1 feet; thence S 72°28' E for 329.5 feet; thence on a curve to the left, with a radius of 427.5 feet, for 552.8 feet; thence N 36°07' E for 119.5 feet; thence S 58°53' E for 100.0 feet; thence S 36°07' W for 119.5 feet; thence on a curve to the right, with a radius of 527.5 feet, for 328.5 feet; thence S 72°28' E for 661.3 feet; thence N 27°23' W and on a curve to the right, with a radius of 336.5 feet, for 152.6 feet; thence N 1°24' W for 166.1 feet; thence on a curve to the left, with a radius of 236.5 feet, for 212.4 feet; thence N 37°00' E for 100.0 feet; thence S 52°52' E and on a curve to the right, with a radius of 326.5 feet, for 302.2 feet; thence S 1°24' E for 166.1 feet; thence on a curve to the left, with a radius of 236.5 feet, for 236.5 feet; thence S 72°28' E for 1058.9 feet; thence on a curve to the right, with a radius of 1091.3 feet, for 139.5 feet, to the east boundary of Sec. 26; thence along said Section line S 0°04' W for 43.1 feet, to the point of beginning.

Said Right-of-Way contains 12.804 acres, of which 2.284 acres are contained in the Right-of-way of the present road, leaving 10.520 acres of uncultivated land to be acquired.

Sec. 28 T.2N R.77W of 6<sup>th</sup> P.M.

ADELINE T. SHERIFF

Conveys all of the land situated within the Right-of-Way of the Highway; said Right-of-Way is located in the SW<sup>1</sup>/<sub>4</sub> of NW<sup>1</sup>/<sub>4</sub> of Sec. 28, T.2N, R.77W, of the 6<sup>th</sup> P.M. Said Right-of-Way extends 50.0 feet on each side of the Centerline of the Highway, and is more particularly described as follows:


Beginning at Centerline Station 255+25.4, a point on the West line of Sec. 28, whence the Corner common to Sections 28, 29, 32, and 33 bears S. 1°55' W. for 520.0 feet; thence along said Section Line, N. 1°55' E., for 65.7 feet, to the east Right-of-Way Line of the Highway; thence from a bearing of N. 50°35' E., along said R.O.W. Line, on a curve to the left, with a radius of 1382.5 feet, for 298.9 feet; thence N. 36°12' E. for 1971.5 feet; thence S. 51°48' W. for 20.0 feet; thence N. 48°12' E. for 745.6 feet; thence on a curve to the right, with a radius of 1502.5 feet, for 728.5 feet; thence S. 23°37' E. for 20.0 feet; thence from a tangent bearing N. 66°25' E., on a curve to the right, with a radius of 1482.5 feet, for 164.0 feet, to the North-South Line of Sec. 28; thence S. 0°09' E. along said Line, for 108.1 feet, to the South R.O.W. Line of the Highway; thence along said R.O.W. Line, and from a tangent bearing S. 72°06' W., on a curve to the left, with a radius of 1382.5 feet, for 411.4 feet; thence S. 35°37' E. for 10.0 feet; thence from a tangent bearing S. 54°23' W., on a curve to the left, with a radius of 1372.5 feet, for 287.4 feet; thence N. 47°37' W. for 10.0 feet; thence from a tangent bearing S. 42°23' E., on a curve to the left, with a radius of 1382.5 feet, for 100.7 feet; thence S. 36°12' E. for 217.1 feet; thence on a curve to the right, with a radius of 1482.5 feet, for 406.2 feet, to the West line of Sec. 28; thence N. 1°55' E. along said Section Line, for 64.0 feet, to the point of beginning.

Said Right-of-Way contains 9.739 acres, of which 1.581 acres are within the Right-of-Way of the present road, leaving a remainder of 8.158 acres, of which 4.437 acres are meadow land and 3.721 acres are sage brush land, all of which is to be acquired.

Conveys all the land situated within the Right-of-Way of the highway; said highway is located in the SW<sup>1</sup>/<sub>4</sub> of NW<sup>1</sup>/<sub>4</sub> of Sec. 28, T.2N, R.77W, of the 6<sup>th</sup> P.M.; said Right-of-Way extends 50.0 feet on each side of the Centerline of the Highway except where otherwise noted, more particularly described as follows:

Beginning at Centerline Station 319+96.0, a point on the East Boundary Line of Sec. 28, whence the NE Corner of Sec. 28 bears S. 0°17' E. for 1885.0 feet; thence along said Section Line, S. 0°17' E., for 50.0 feet, to the South Right-of-Way Line of the Highway; thence along said R.O.W. Line, S. 89°54' W. for 945.7 feet; thence S. 0°06' E. for 10.0 feet; thence S. 89°54' W. for 900.0 feet; thence N. 0°06' E. for 10.0 feet; thence S. 89°54' W. for 261.9 feet; thence on a curve to the left, with a radius of 1382.5 feet, for 448.7 feet; to the North-South Line of Sec. 28; thence along said Line, N. 0°09' E., for 105.1 feet, to the North R.O.W. Line of the Highway; thence along said R.O.W. Line, N. 72°06' E. and on a curve to the right, with a radius of 1482.5 feet, for 444.6 feet; thence N. 89°54' E. for 2108.2 feet, to the East Boundary Line of Sec. 28; thence along said Section Line, S. 0°17' W. for 50.0 feet, to the point of beginning.

Said Right-of-Way contains 6.069 acres, of which 2.370 acres are contained in the Right-of-Way of the present road, leaving a remainder of 3.699 acres of land to be acquired, of which 2.000 acres are meadow land and 1.699 acres are sage brush land.

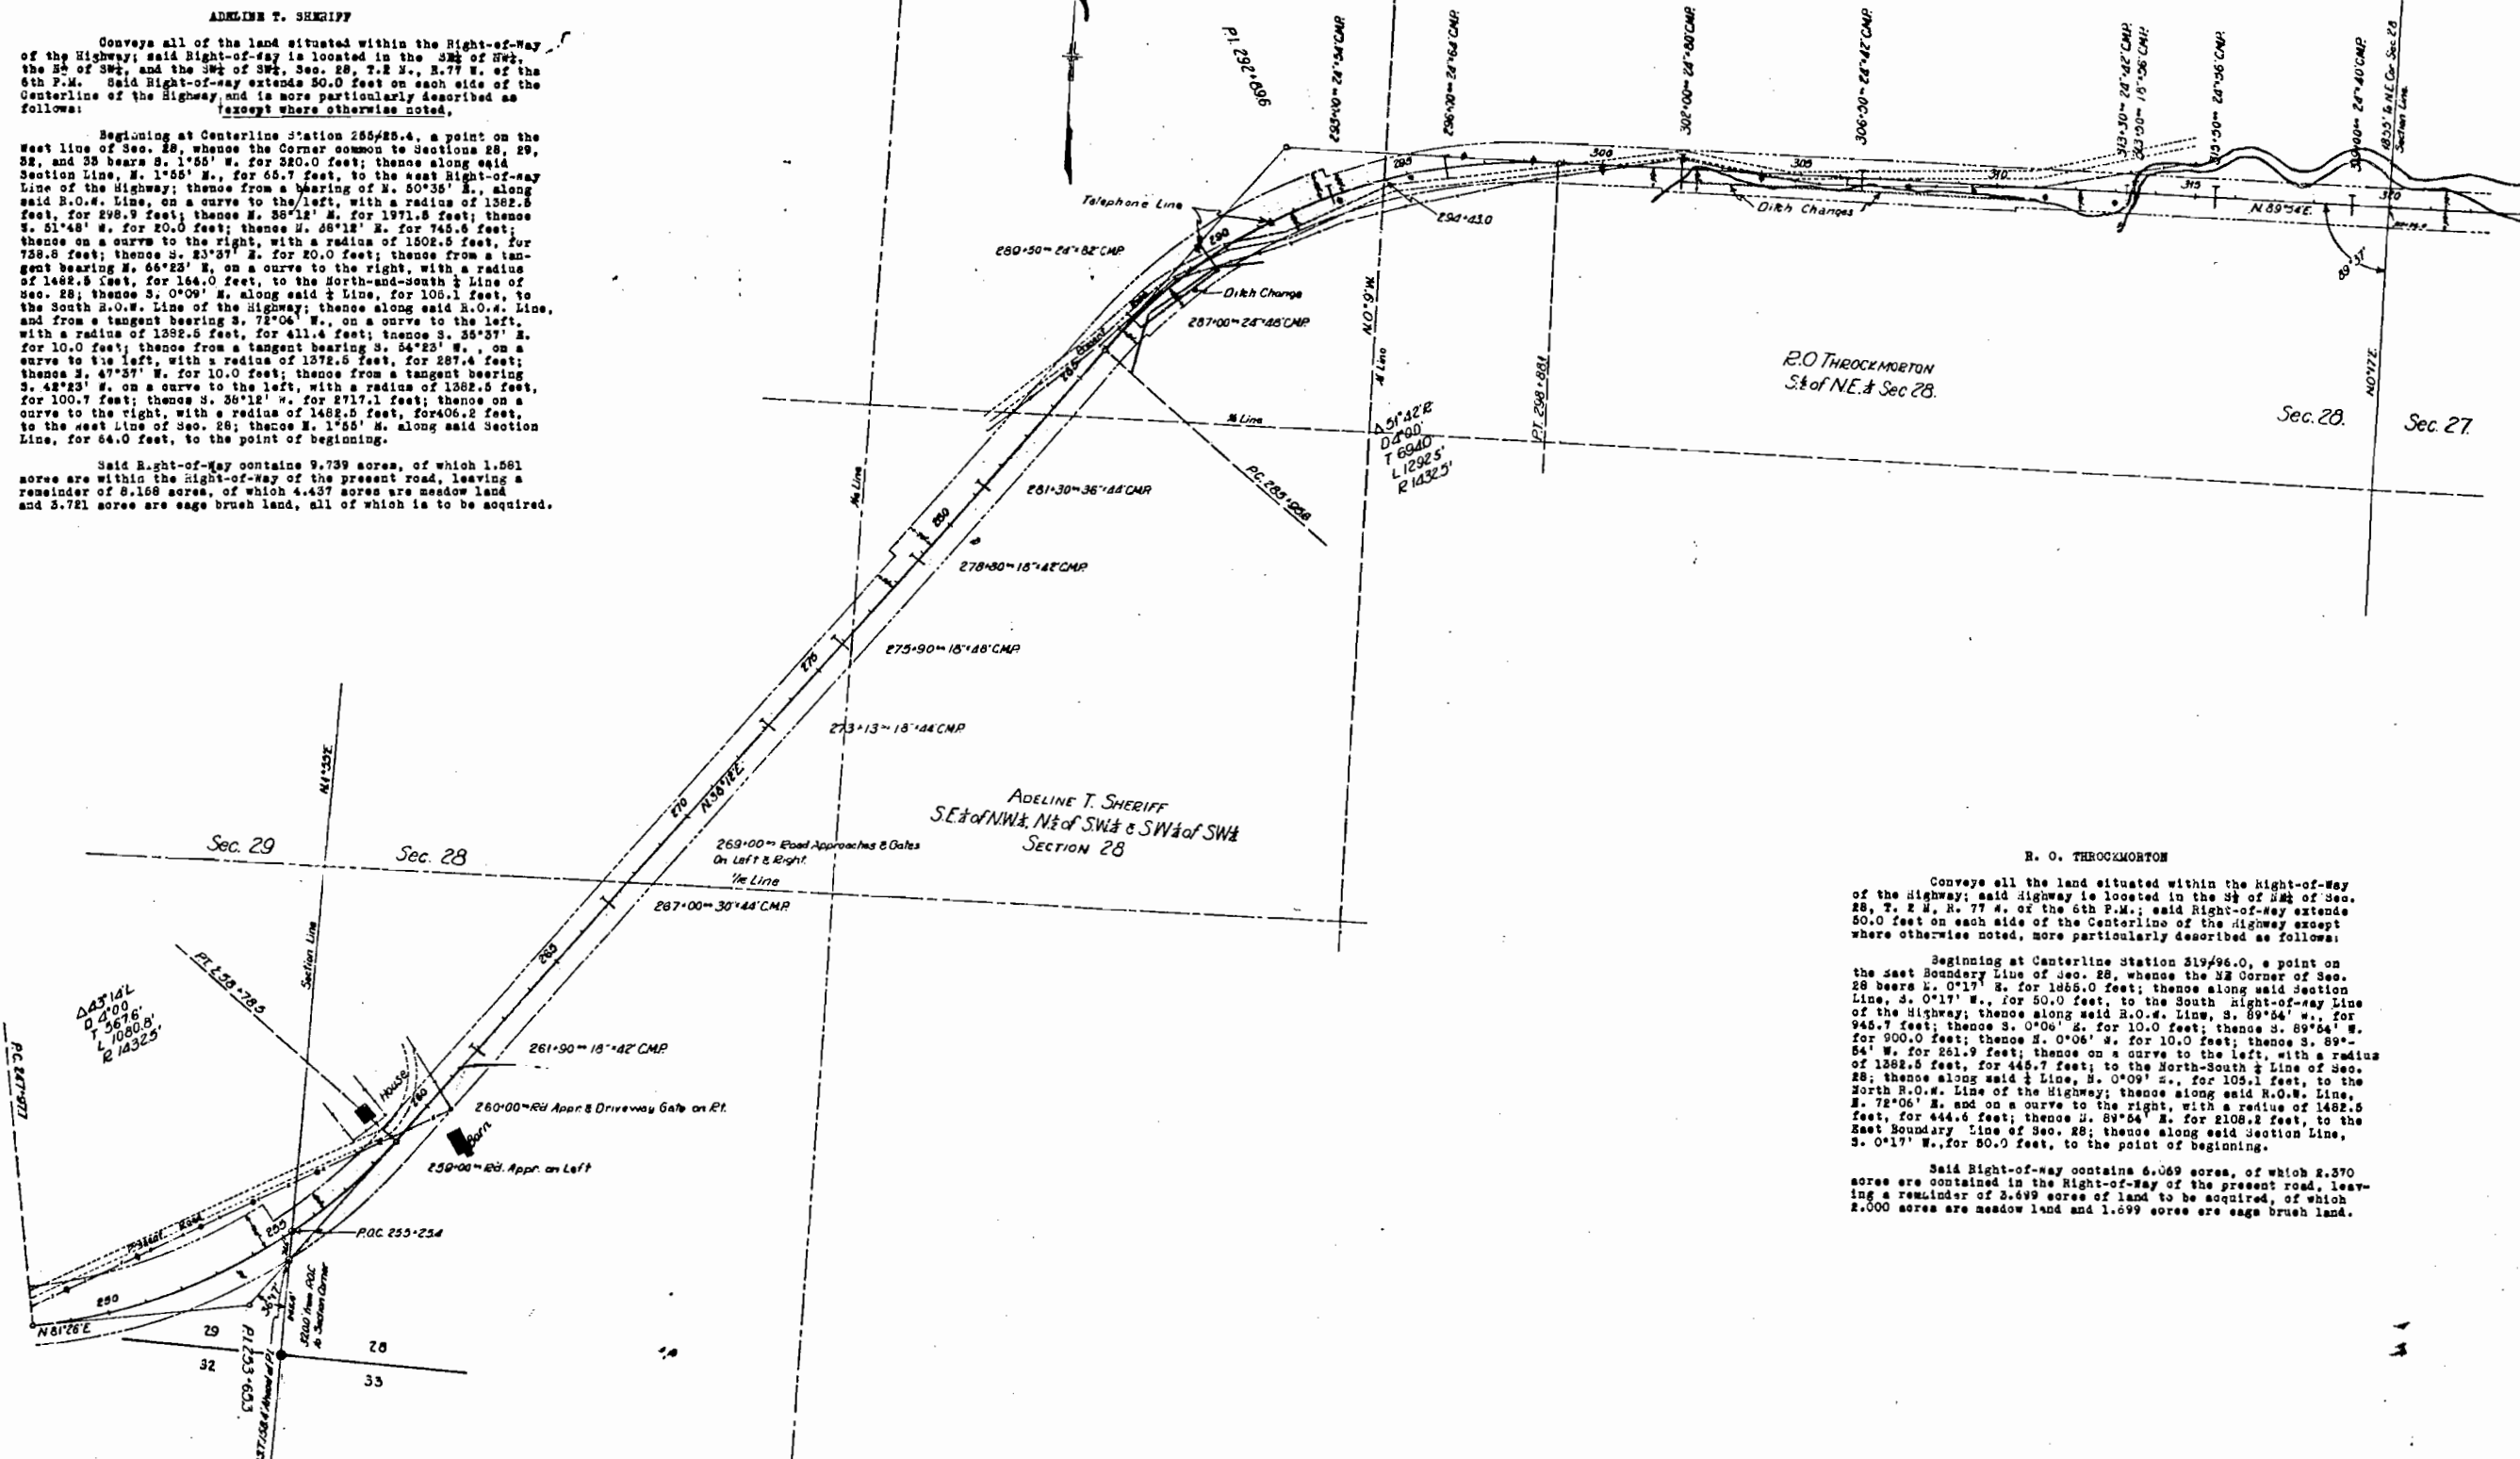



COLORADO STATE HIGHWAY DEPARTMENT  
USPW NRH 151-D  
RIGHT OF WAY MAP NO 7  
Map Revised May, 1935 CTZ.  
Descriptions Apr. June 35 WCC



Conveys all of the land situated within the Right-of-way of the Highway; said Highway is located in the S<sup>1</sup>/<sub>2</sub> of S<sup>1</sup>/<sub>2</sub> of Sec. 29, T. 2 N., R. 77 W. of the 6th P.M. Said Right-of-way extends 50.0 feet on the south and 100.0 feet on the north of the Centerline of the Highway, and is more particularly described as follows:

[except where otherwise noted]

Beginning at Centerline Station 856+55.4, a point on the West Line of Sec. 29; thence to the S. Corner of Sec. 29 bears S. 1°-55' W. for 380.0 feet; thence along said Line S. 88° 00' E. for 65.7 feet to the North Right-of-way Line of the Highway; thence along said R.O.W. Line, from a tangent bearing S. 50°35' E., on a curve to the right, with a radius of 1382.5 feet, for 66.4 feet; thence S. 36°40' W. for 30.0 feet; thence from a tangent bearing S. 53°50' E., on a curve to the right, with a radius of 1335.5 feet, for 653.3 feet; thence S. 81°30' E. for 113.0 feet; thence S. 8°34' E. for 50.0 feet, to the South Line of Sec. 29; thence along said Section Line S. 87°35' E. for 476.8 feet, to the South R.O.W. Line of the Highway; thence along said R.O.W. Line, from a tangent bearing N. 76°04' E., on a curve to the left with a radius of 1482.5 feet, for 547.6 feet, to the East Line of Sec. 29; thence along said Section Line S. 1°55' E. for 66.0 feet, to the point of beginning.

Said Right-of-way contains 2.889 acres, of which 0.565 acres are contained in the Right-of-way of the present road, the remainder of 2.304 acres of uncultivated land to be acquired.

Conveys all of the land situated within the Right-of-Way of the Highway; said Highway is located in the West and the East of N.E. of Sec. 32, T. 2 S., R. 77 W. of the 6th P.M. Said Right-of-Way extends 66.0 feet on each side of the Centerline of the Highway, more particularly described as follows:

Beginning at P.O.S.T. 201/85.6, a point on the West Line of Sec. 32, thence the N. W. corner of Sec. 32 bearing S. 0°17' E. for 889.0 feet, thence the N. 0°17' E. along said Section Line for 51.6 feet, to the North Right-of-Way Line of the Highway; thence along said R.O.W. Line, from a tangent bearing N. 73°00' E. on a curve to the right, with a radius of 2915.0 feet, for 439.4 feet; thence N. 81°26' E. for 3806.9 feet, to the North Line of Sec. 32; thence S. 87°35' E. along said Section Line for 262.4 feet, to Station #47/51.7, and continuing S. 87°35' E. for 214.4 feet, to the South R.O.W. Line of the Highway; thence along said R.O.W. Line, from a tangent bearing S. 75°04' E., on a curve to the right, with a radius of 1452.5 feet, for 165.7 feet; thence S. 81°26' E. for 325.7 feet, to Station #48/51.7, with a Radius of 2613.0 feet, for 444.9 feet, to the West Line of Sec. 32; thence along said Section Line N. 0°17' E. for 52.6 feet, to Centerline Station 201/85.6; thence continuing N. 0°17' E. for 0.6 feet, to P.O.S.T. 201/85.6, the point of beginning.

Said Right-of-Way contains 10.319 acres, of which 3.977 acres are contained in the Right-of-way of the present road, the remainder of 6.342 acres of uncultivated land to be acquired.

# COLORADO DEPARTMENT OF HIGHWAYS

## RIGHT OF WAY MAP


IN

THE S.W. 1/4, N.W. 1/4 Section 25


T. 2N., R. 77 W., 6th P.M.

ROAD AS CONSTRUCTED

SCALE 1"=100'

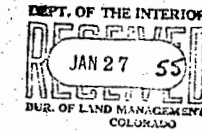

SERIAL NO C-010134

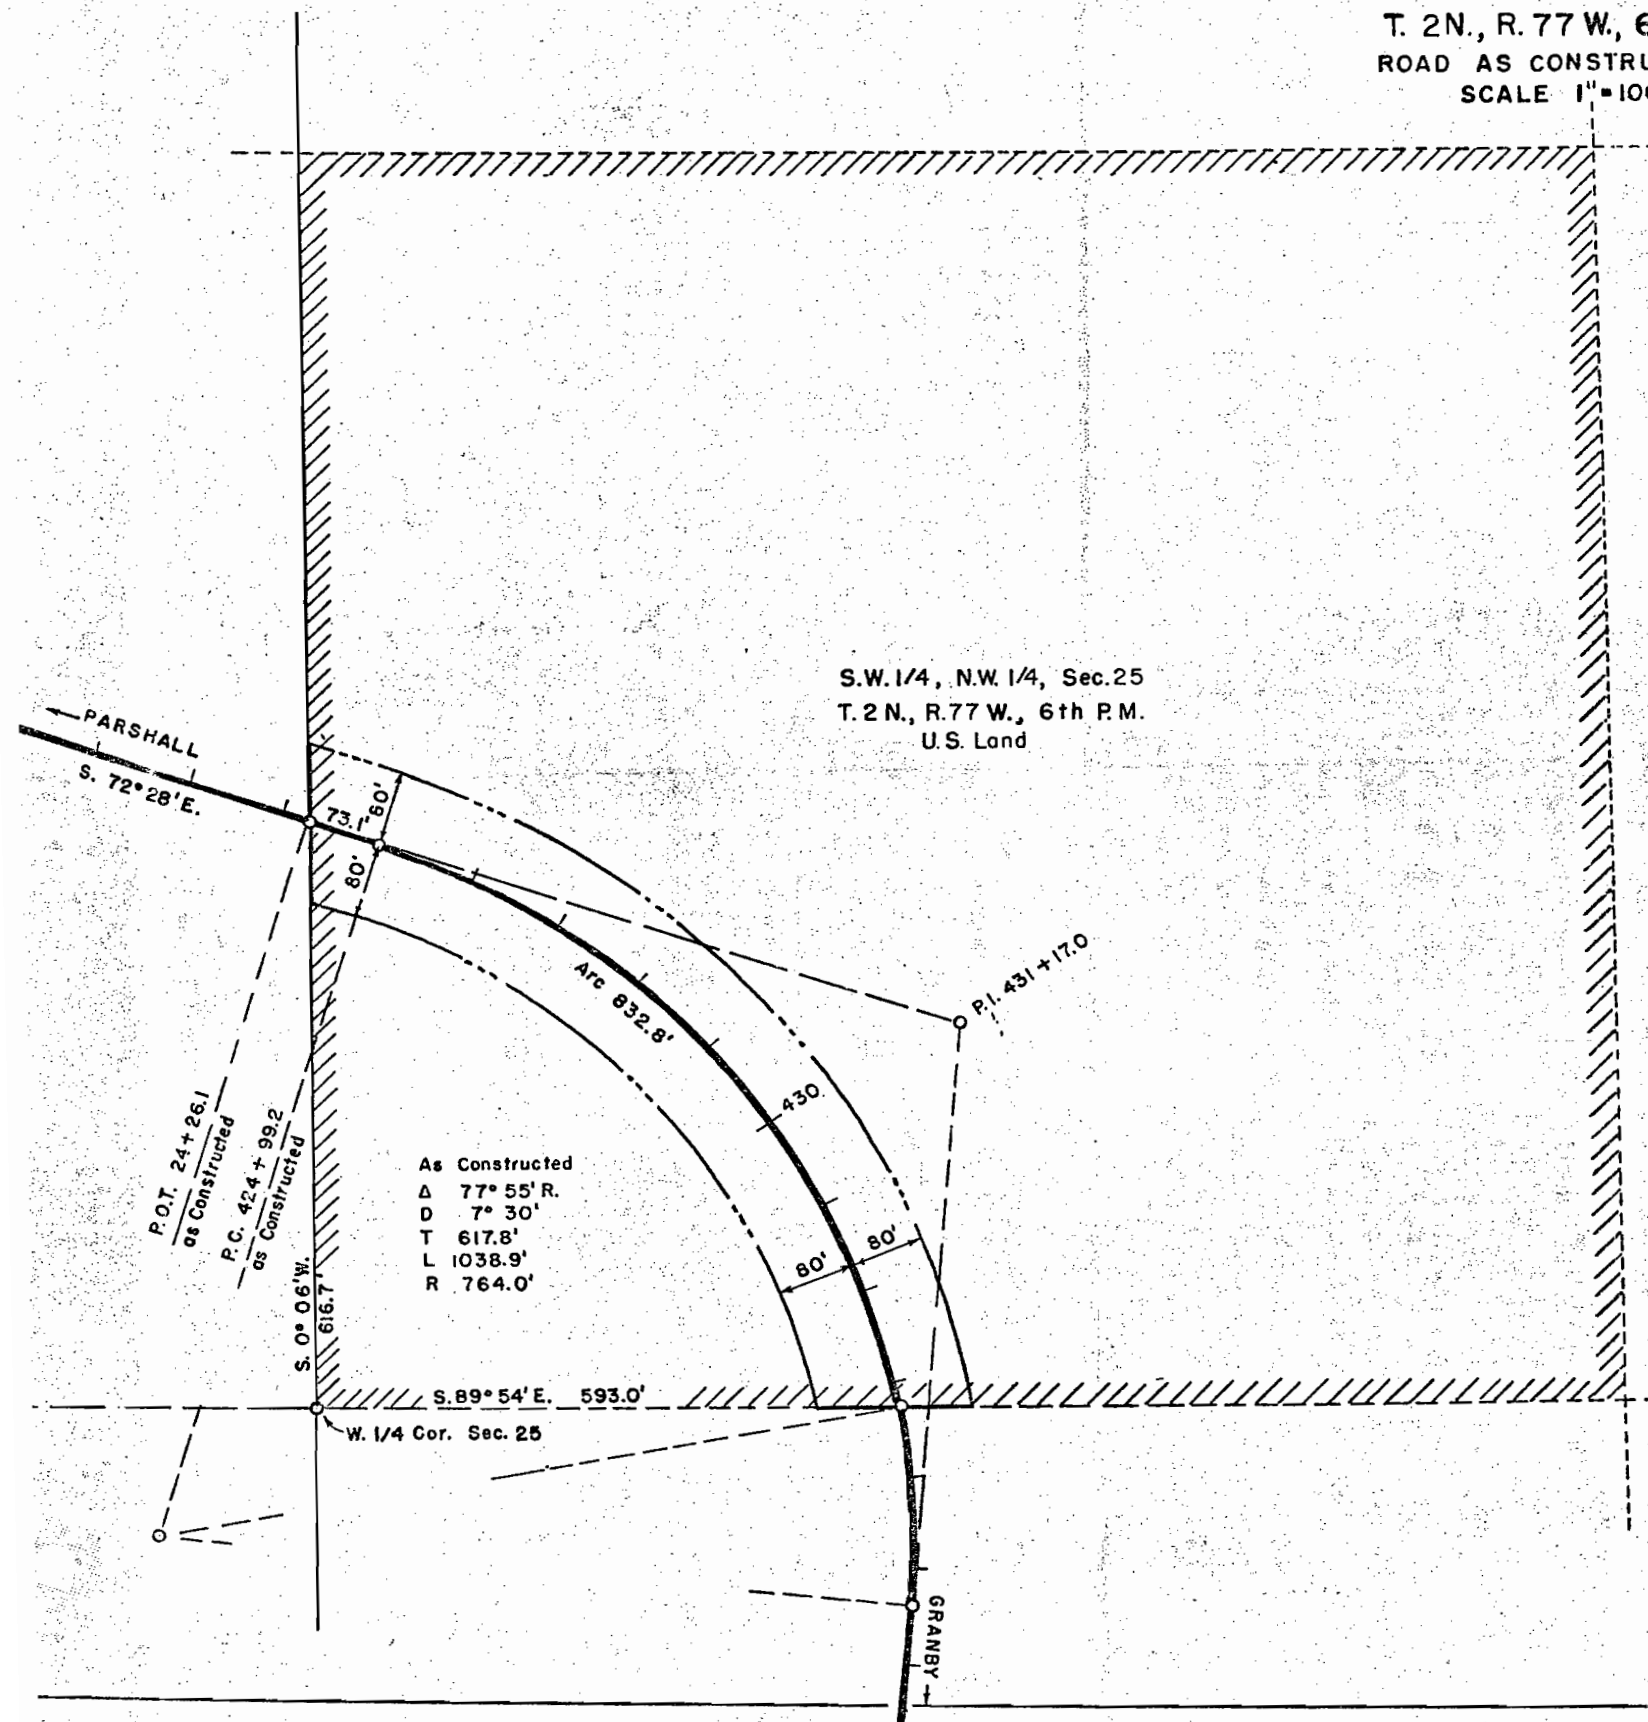

I, George H. Woodhall, Manager Bureau of Land Management, Denver, Colorado, hereby certify that the land shown cross-hatched hereon is unpatented or unappropriated.


*George H. Woodhall*  
Manager, Denver, Colorado

### CERTIFICATE OF CHIEF ENGINEER COLORADO DEPARTMENT OF HIGHWAYS

I, Mark U. Watrous, of Denver, Colorado, hereby certify that this map was made from notes taken during an actual survey made by the Resident Engineer in 1935, which work to the best of my knowledge and belief is accurately represented by this map.

Denver, Colorado

*Mark U. Watrous*  
Chief Engineer

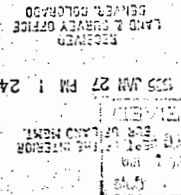

FILE WITH NRH. 151D