


INDEX OF SHEETS

SHEET NO.	Title Page
2	Typical Section and Summary of Quantities
3	Details of Culvert Extension Sta. 1471
4	Standard Conc. Box Culverts M-104-D
5	" Headwalls for C.P. Culverts M-102-E
6	" Fences & Marker Posts M-24-F
7	" Super-elevation Sheet M-1-A
8	Plan and Profile
9-28	Cross Sections


COLORADO STATE HIGHWAY DEPARTMENT

PLAN AND PROFILE OF PROPOSED U. S. P. W. HIGHWAY PROJECT NO. N.R.H. 29 (1935) STATE HIGHWAY NO. 8 JEFFERSON COUNTY

CONVENTIONAL SIGNS

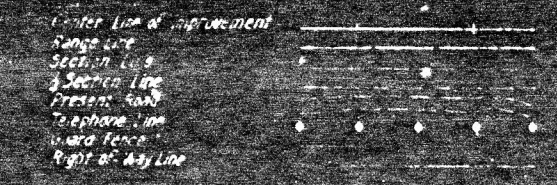

SCALES
ON PLAN. 1 IN. = 100 FT.
ON PROFILE 1 IN. = 100 FT. HORIZONTAL
1 IN. = 10 FT. VERTICAL
GRADE LINE ON PROFILE IS SHOWN AS GRADE OF FINISHED ROAD
GROSS LENGTH OF PROJECT 23072 FT. = 0.437 MI.
NET LENGTH OF PROJECT

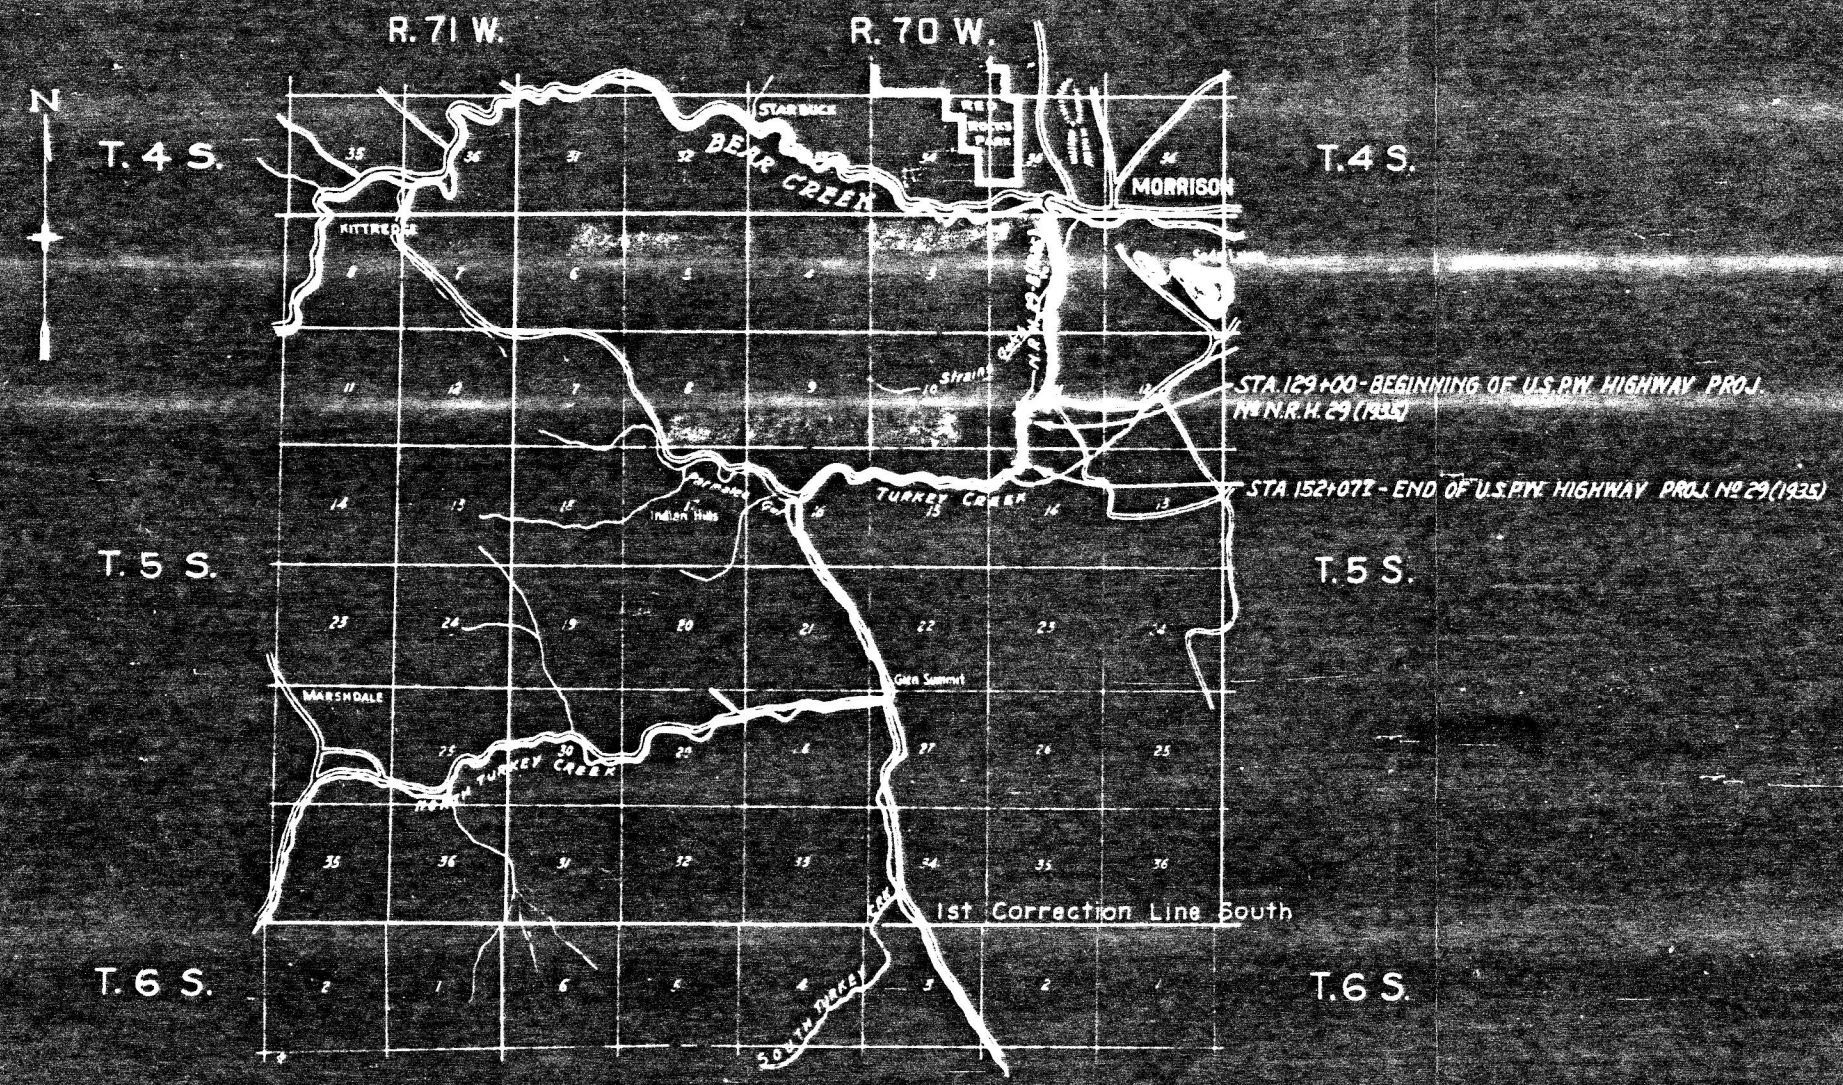



SCALE 1 INCH = 1 MILE

RECOMMENDED FOR APPROVAL 5/8/34
James H. ...
ASS. STANT ENGINEER
APPROVED
Charles ...
STATE HIGHWAY ENGINEER
RECOMMENDED FOR APPROVAL
DIST. ENG. BUREAU PUBLIC ROADS
RECOMMENDED FOR APPROVAL
CHIEF ENG. BUREAU PUBLIC ROADS
APPROVED
DIRECTOR BUREAU PUBLIC ROADS

N R H 29
N R H 21-A
R-11 # T-54

TEST D. NO. DIST. NO.	TA. NO.	U.S. MAP SHEET NO.	U.S. MAP SHEET NO.	LOCAL SHEETS
	51	NRN 25(N3E)	8	

Revised as constructed 4-30-34. N.W.

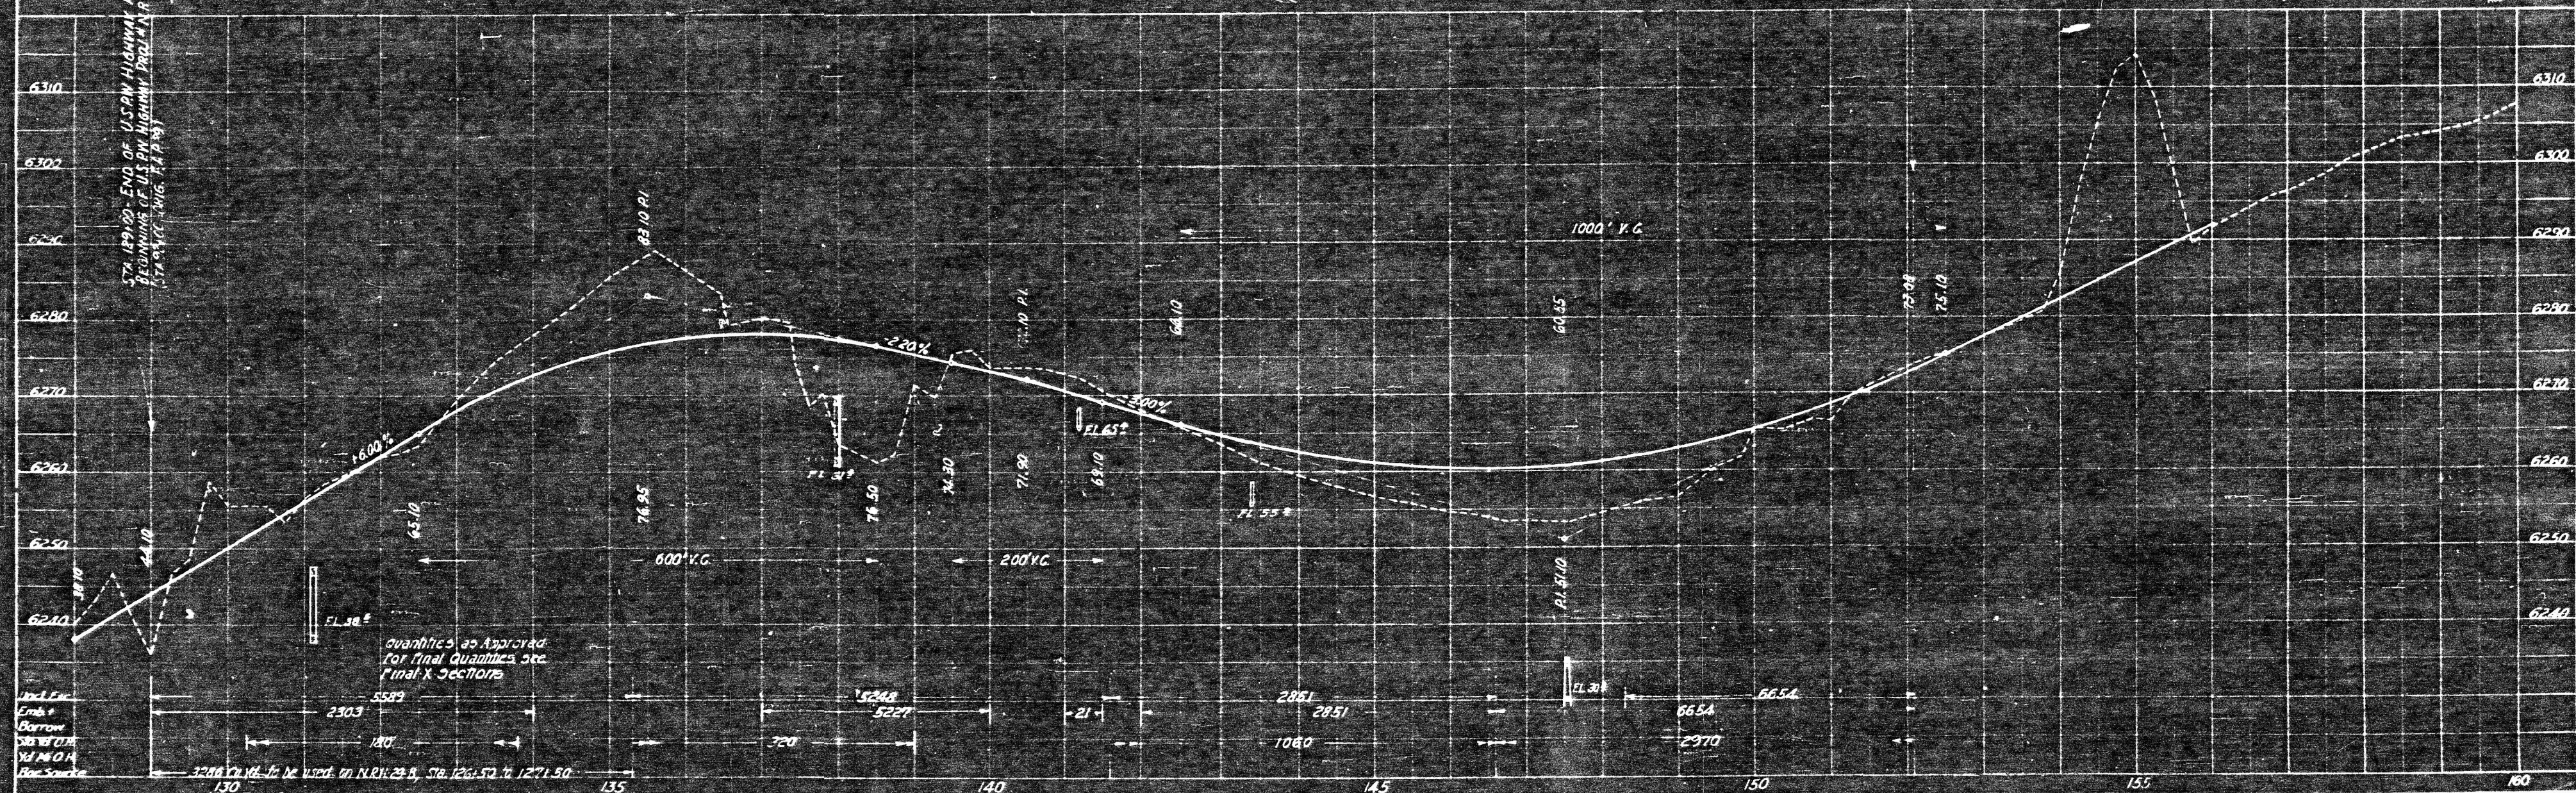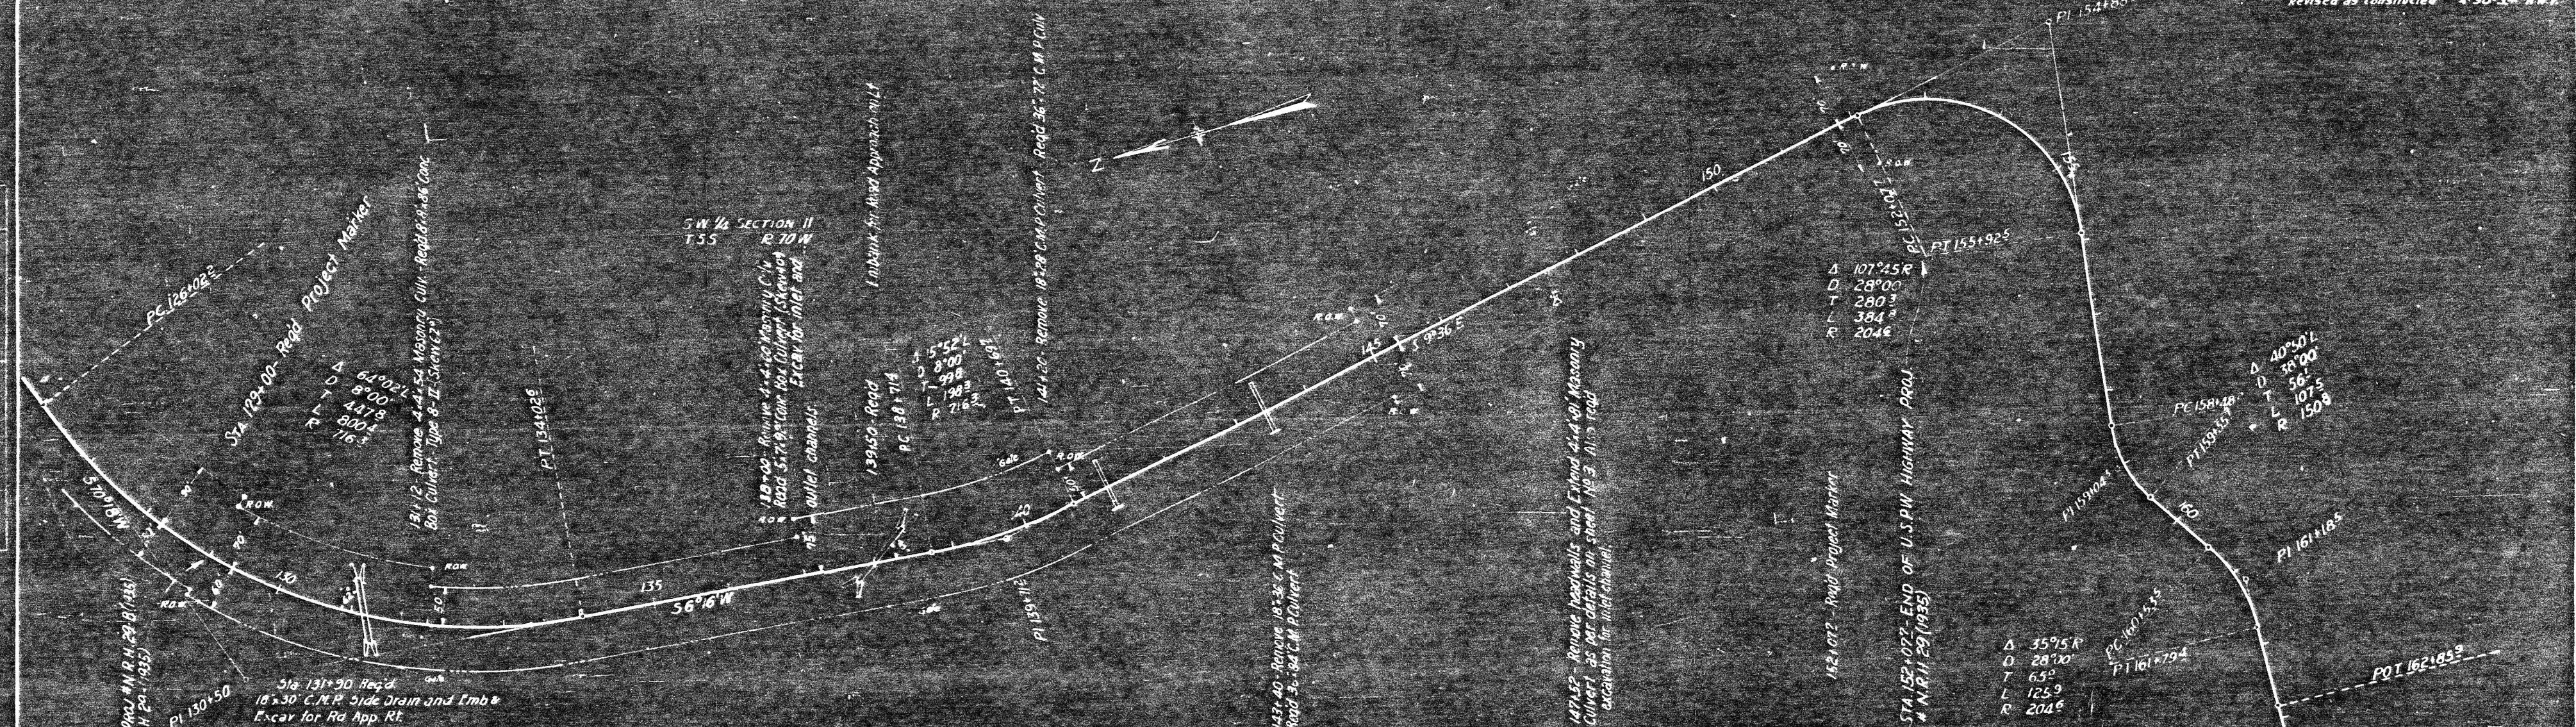

PLAN	DATE
DESIGNED BY	
CHECKED BY	
APPROVED BY	
DATE	

PROFILE	DATE
DESIGNED BY	
CHECKED BY	
APPROVED BY	
DATE	



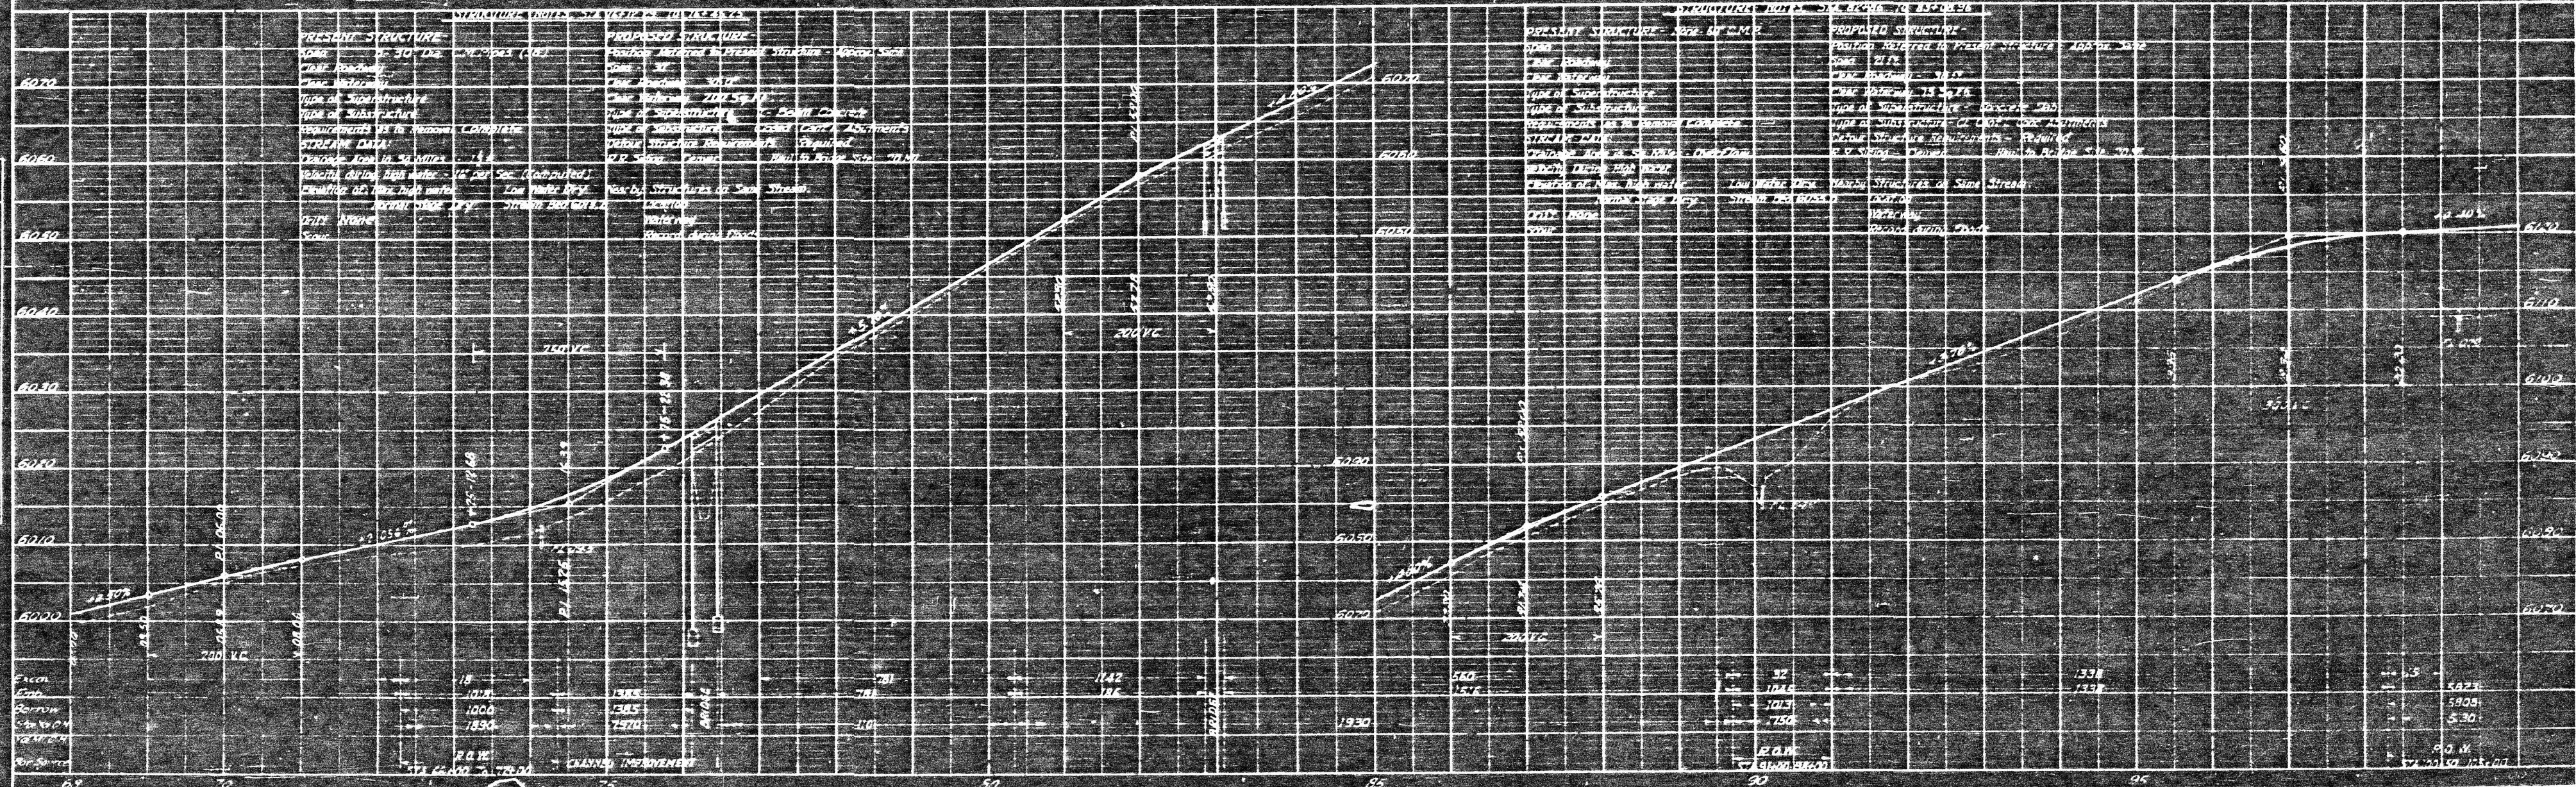


PLATE 1 - PLAN PROFILE OF FREE STATIONS
REUTEL & EDWARDS CO. NEW YORK

PLAN	DATE	BY	CHECKED
1	10/1/50	J. H. H.	J. H. H.
2	10/1/50	J. H. H.	J. H. H.
3	10/1/50	J. H. H.	J. H. H.
4	10/1/50	J. H. H.	J. H. H.
5	10/1/50	J. H. H.	J. H. H.
6	10/1/50	J. H. H.	J. H. H.
7	10/1/50	J. H. H.	J. H. H.
8	10/1/50	J. H. H.	J. H. H.
9	10/1/50	J. H. H.	J. H. H.
10	10/1/50	J. H. H.	J. H. H.

PROFILE	DATE	BY	CHECKED
1	10/1/50	J. H. H.	J. H. H.
2	10/1/50	J. H. H.	J. H. H.
3	10/1/50	J. H. H.	J. H. H.
4	10/1/50	J. H. H.	J. H. H.
5	10/1/50	J. H. H.	J. H. H.
6	10/1/50	J. H. H.	J. H. H.
7	10/1/50	J. H. H.	J. H. H.
8	10/1/50	J. H. H.	J. H. H.
9	10/1/50	J. H. H.	J. H. H.
10	10/1/50	J. H. H.	J. H. H.

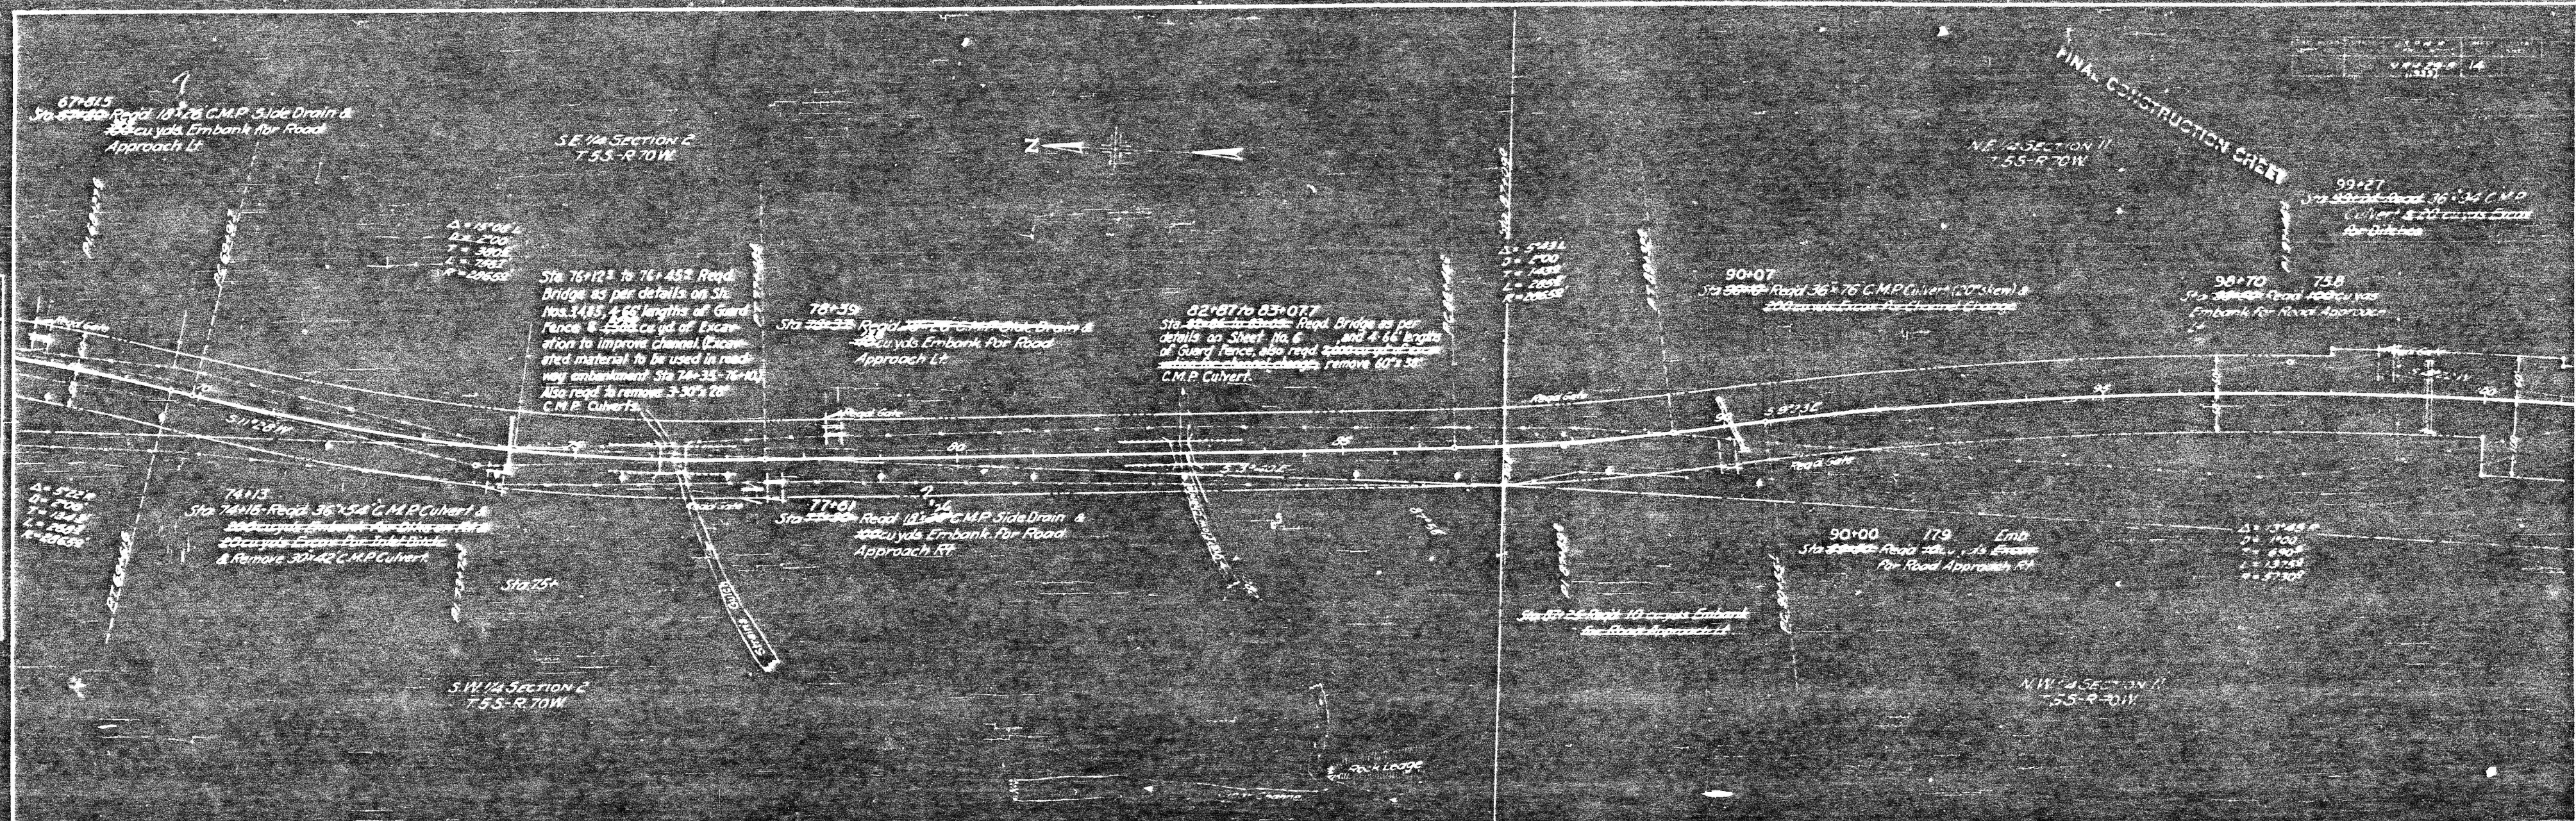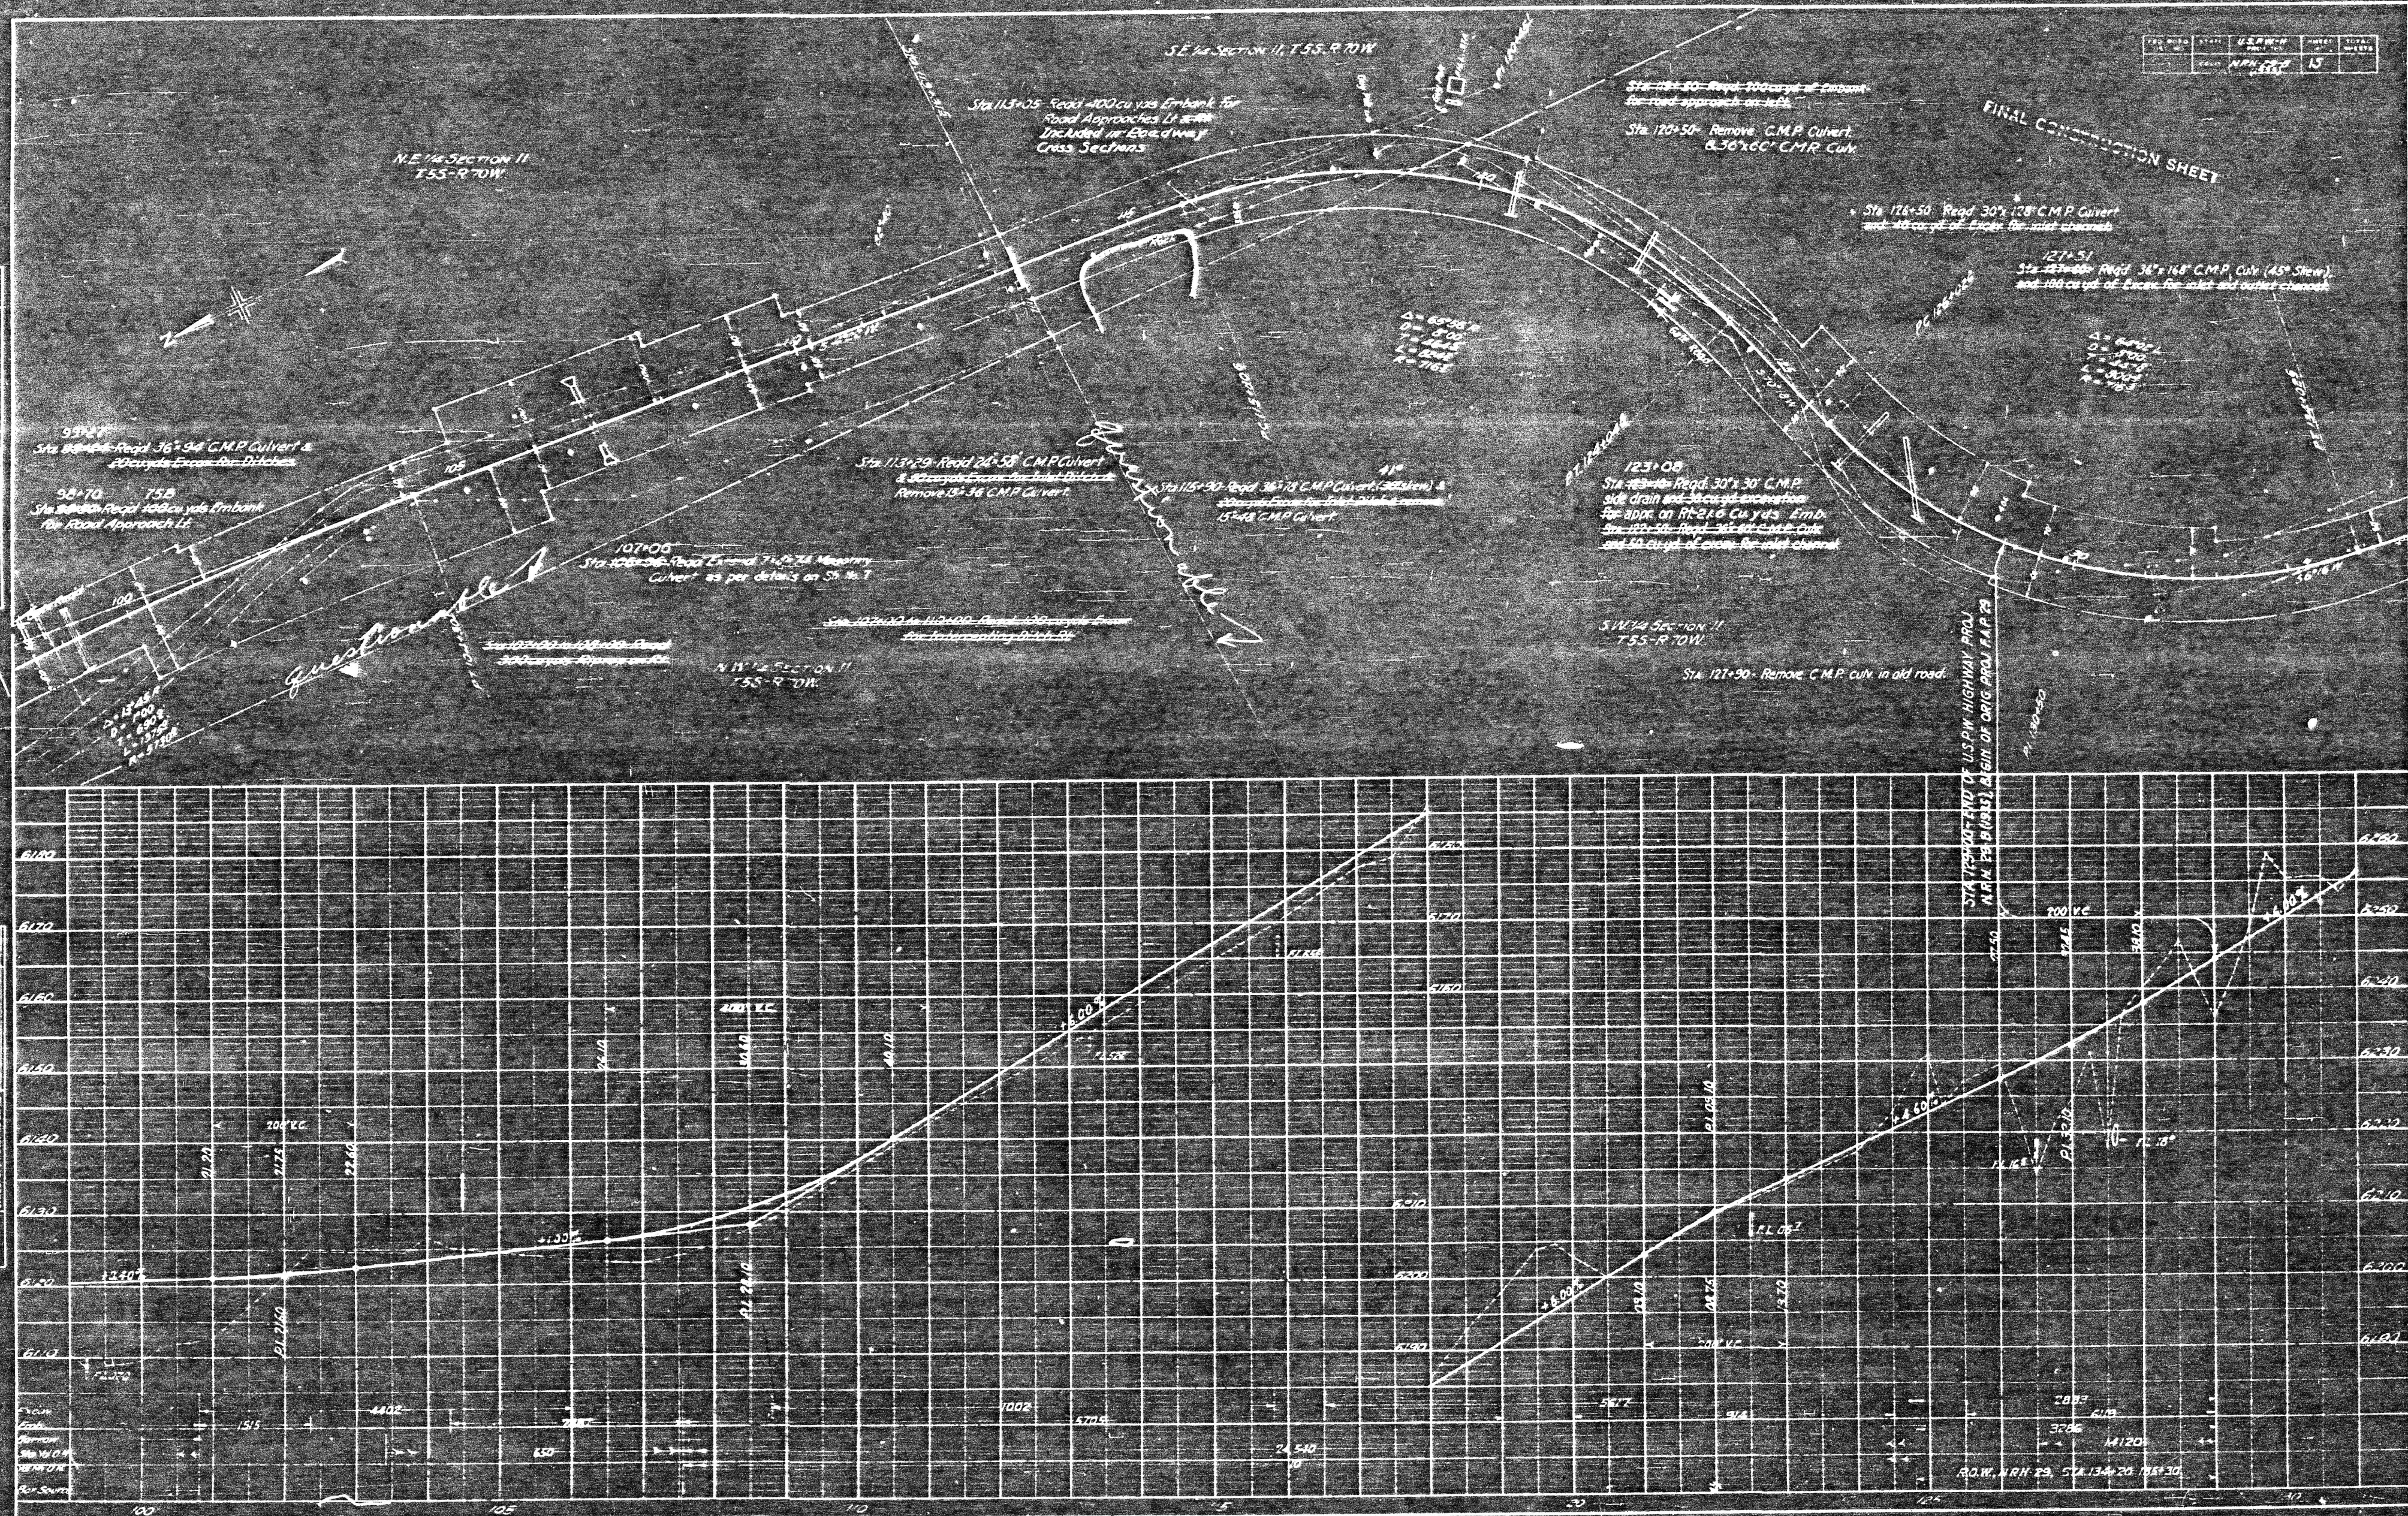

COLORADO STATE HIGHWAY DEPARTMENT

INDEX OF SHEETS


SHEET NO.	Title Page
2	Typical Section and Summary of Quantities
3	Details of Culvert Extension Sta 147+
4	Standard Conc. Box Culverts M-104-D
5	Headwalls for C.M.P. Culverts M-102-E
6	Fences & Marker Posts M-24-F
7	Superelevation Sheet M-1-A
8	Plan and Profile
9-26	Cross Sections

PLAN AND PROFILE OF PROPOSED U. S. P. W. HIGHWAY PROJECT NO. N.R.H. 29 (1935) STATE HIGHWAY NO. 8 JEFFERSON COUNTY

CONVENTIONAL SIGNS



SCALES
ON PLAN, 1 IN. = 100 FT.
ON PROFILE 1 IN. = 100 FT. HORIZONTAL
1 IN. = 10 FT. VERTICAL
GRADE LINE ON PROFILE IS SHOWN AS GRADE OF FINISHED ROAD
GROSS LENGTH OF PROJECT } 23072 FT. = 0.437 MI.
NET LENGTH OF PROJECT }

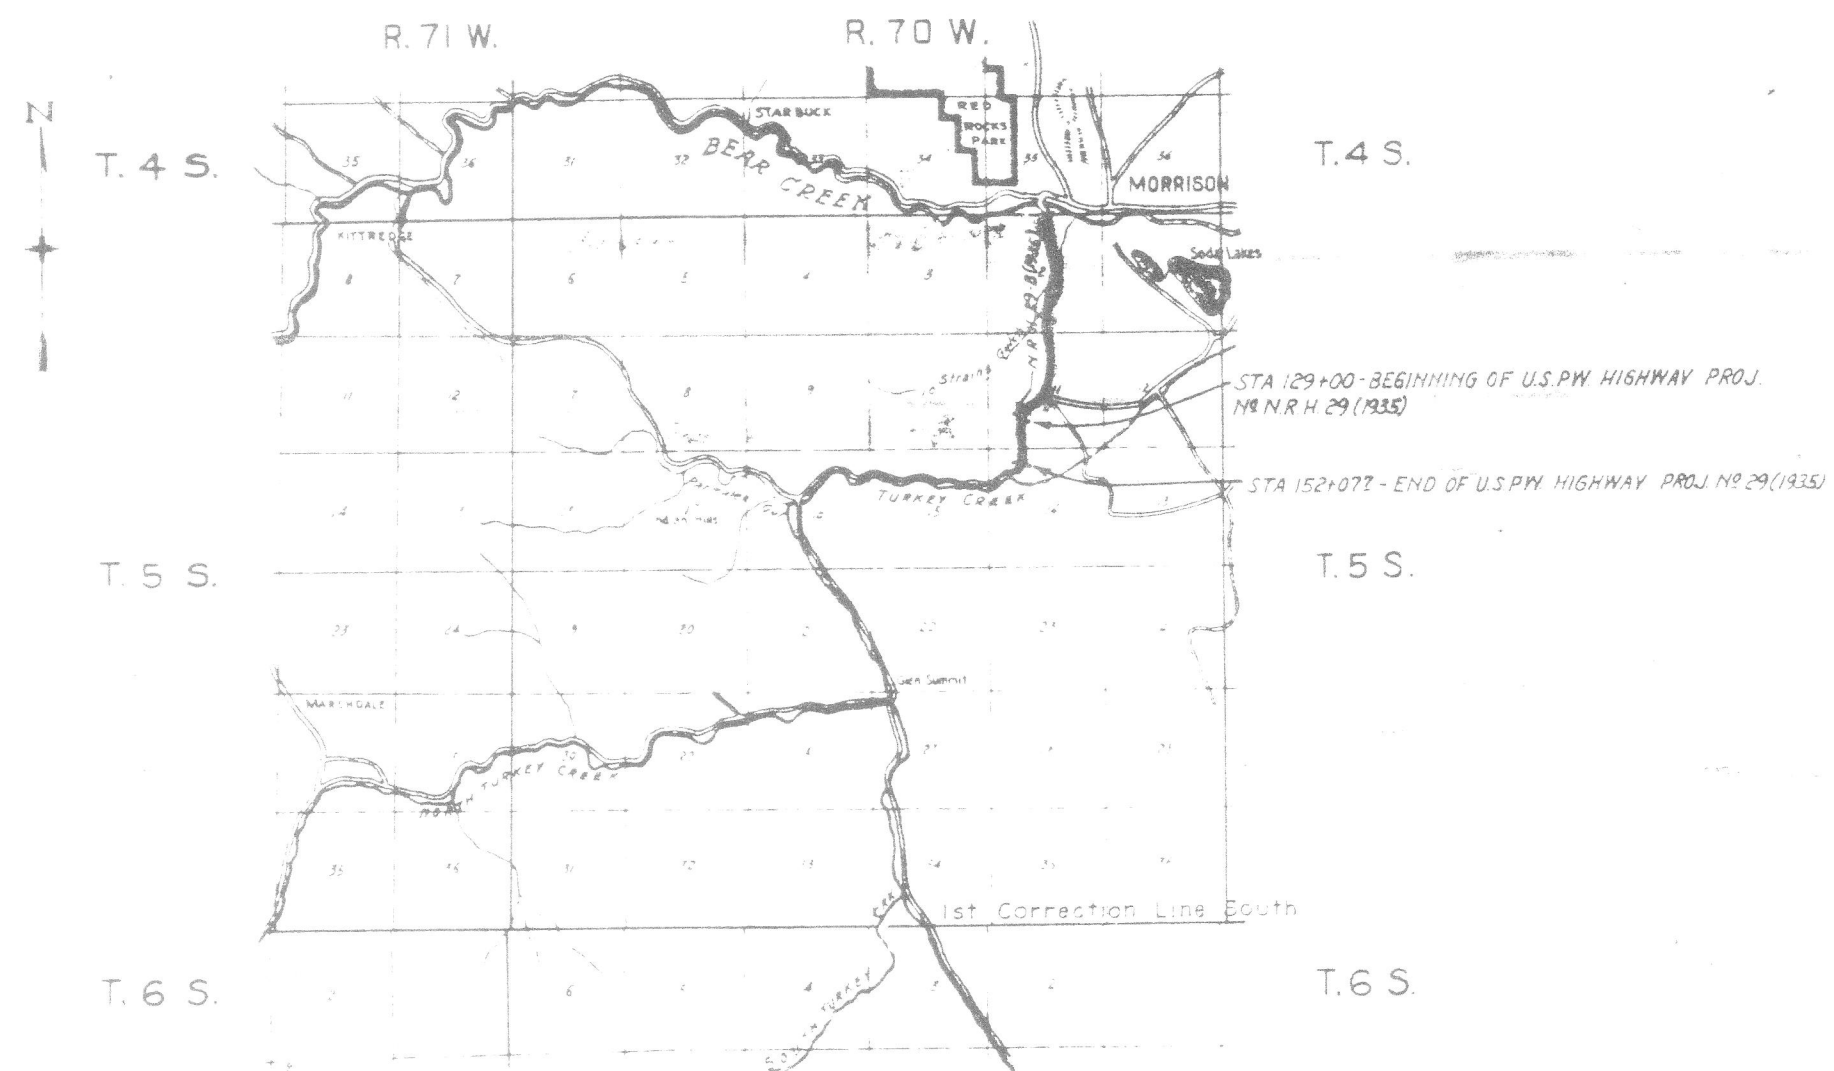

SCALE 1 INCH = 1 MILE


N R H 29
N R H 29-B
Roll # T-54

BY EXAMINER'S APPROVAL 8/8/34
DeMallory
ASSISTANT ENGINEER
APPROVED
Chas. D. ...
STATE HIGHWAY ENGINEER
RECOMMENDED FOR APPROVAL
DIST. ENG. BUREAU PUBLIC ROADS
RECOMMENDED FOR APPROVAL
CHIEF ENG. BUREAU PUBLIC ROADS
APPROVED
DIRECTOR, STATE HIGHWAY DEPARTMENT

DOWN HAWKWAY	ABLY TOTAL
NRH 29 (1035)	8

revised as constructed 4 30-34 NM

FILE NUMBER (ALL-SEC)	FILE #	U.S. DEPARTMENT OF JUSTICE	SECTION	TOTAL COPIES
	44-38861	NRH 29 (1935)	1	

 


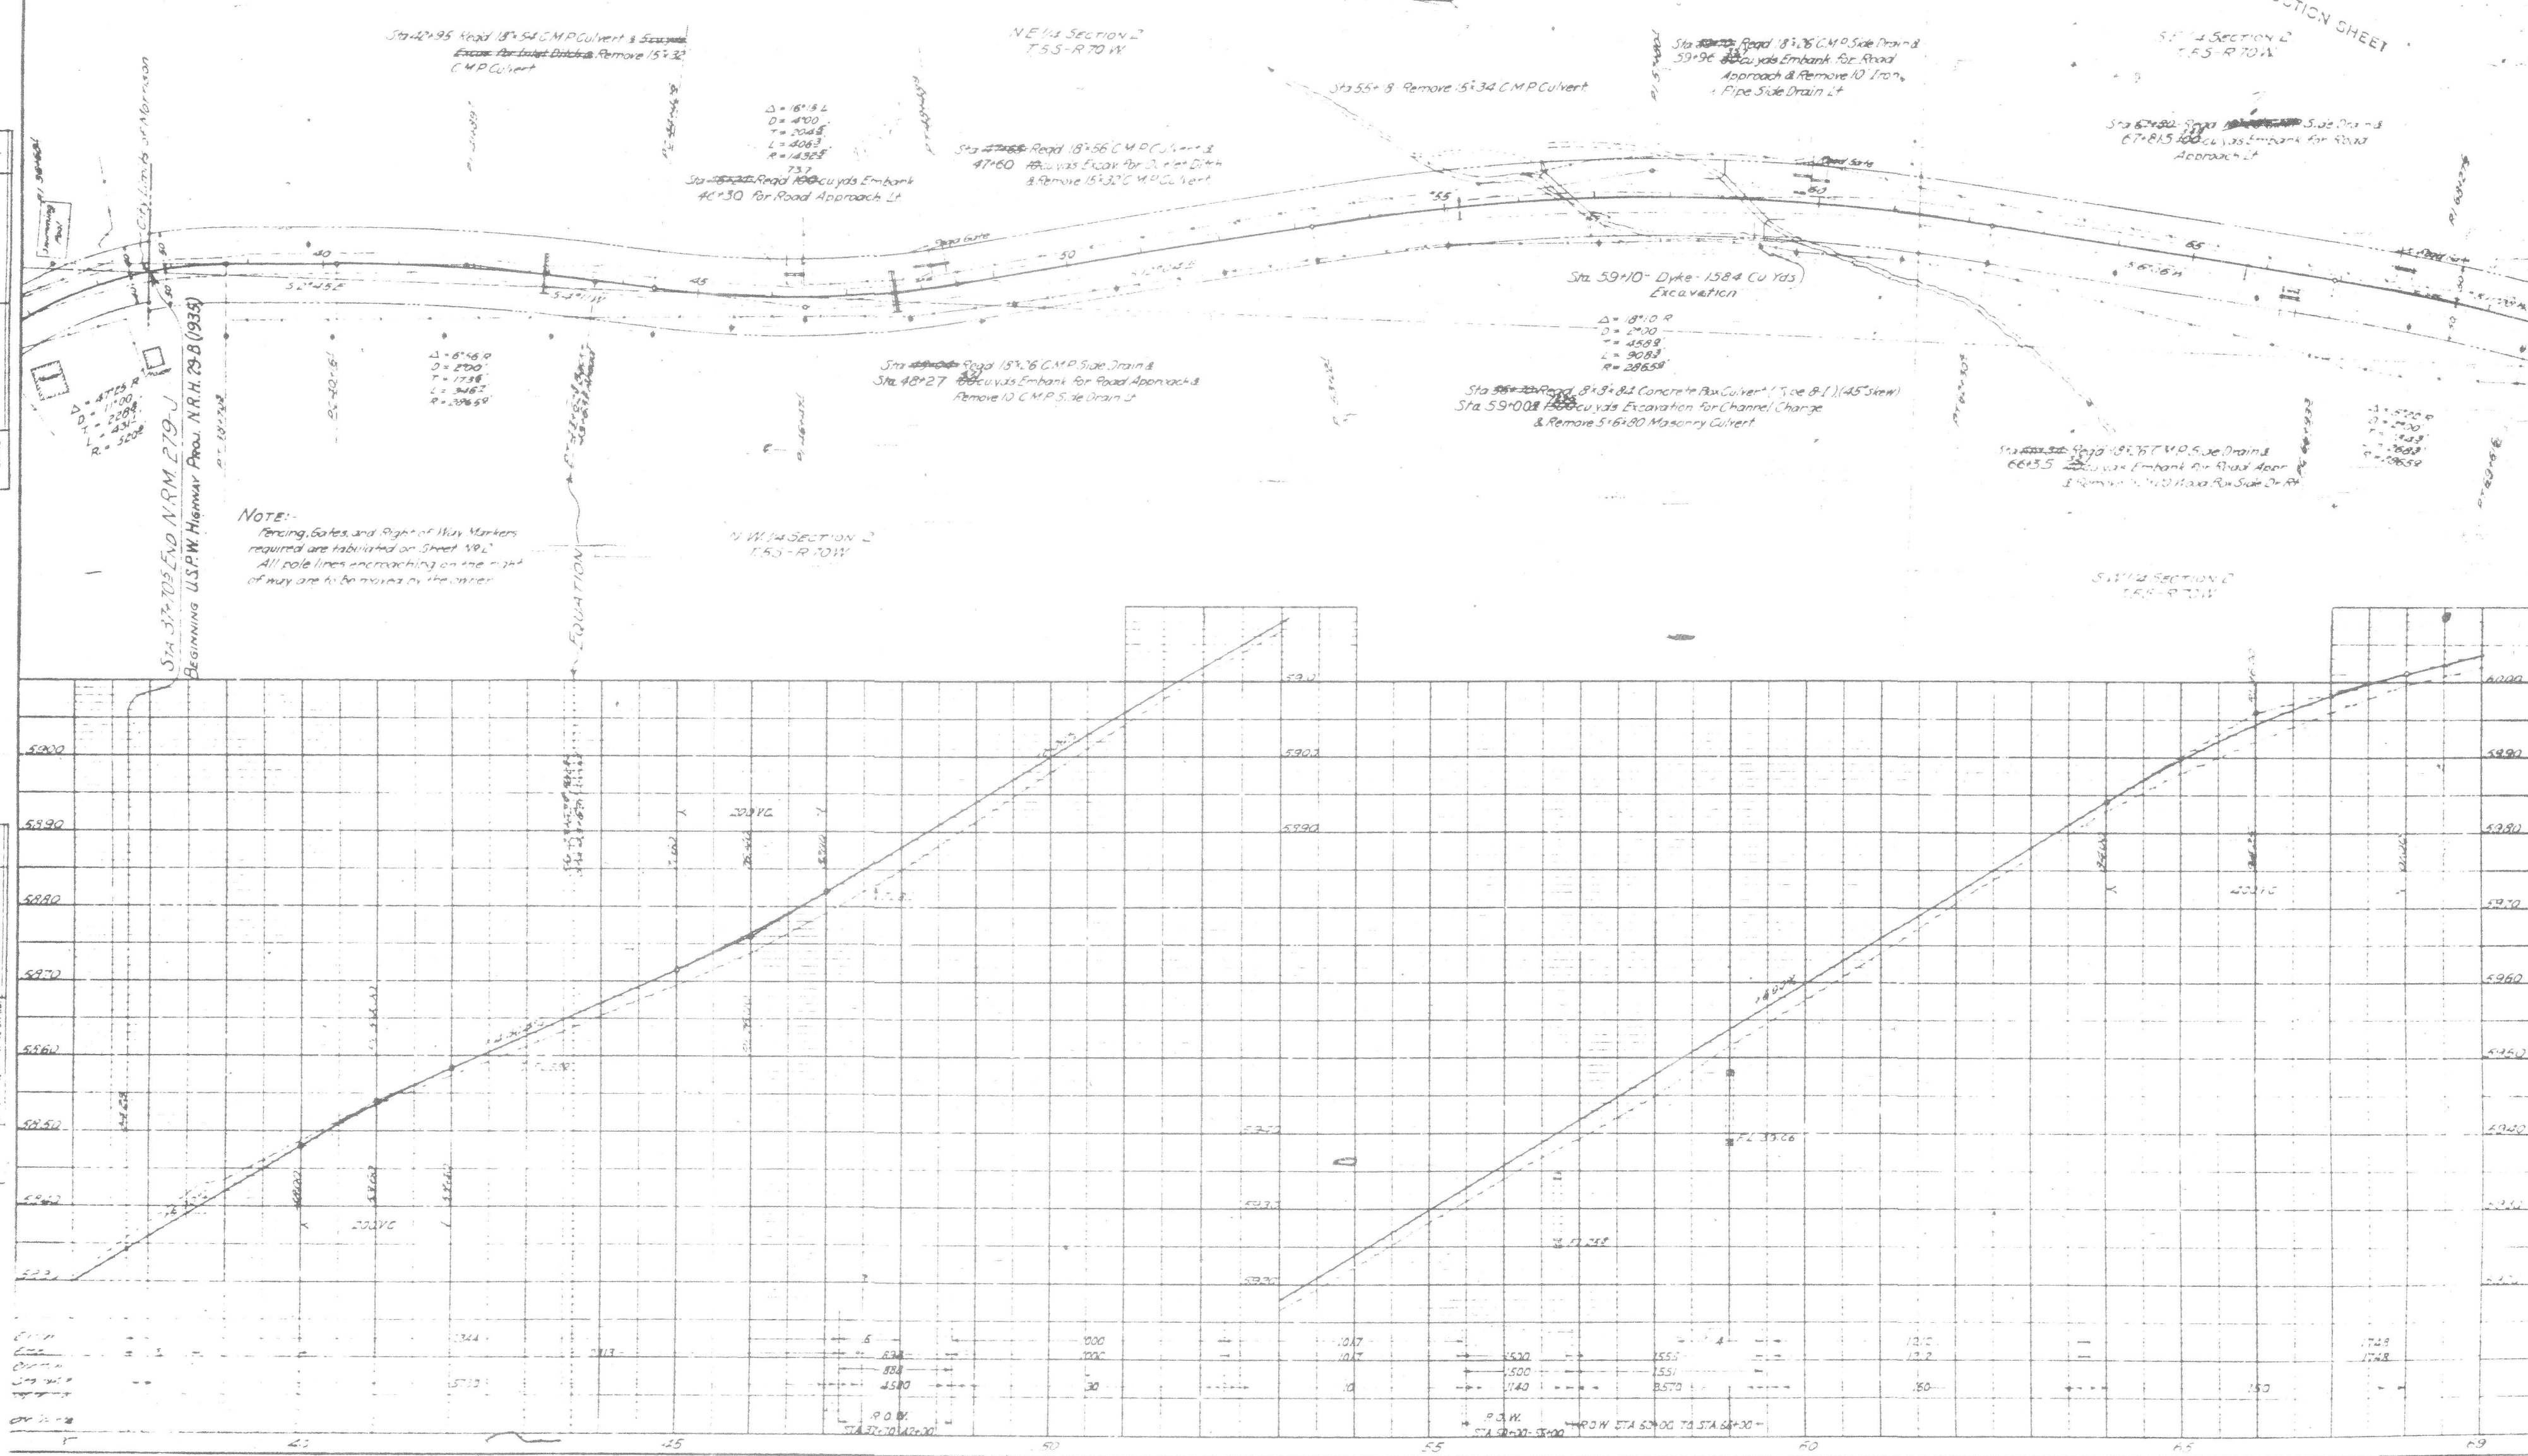


PLATE 1. PLAN-PROFILE OF R.R. E. STAMEN
ALONG A RIVER OF THE

DATE	BY	PROFILE
		SURVEYED
		PLOTTED
		NOTE BOOK
		NO
		GRACES CHECKED
		B M'S NOTED
		STRUCTURE NOTED
		NS CH RD

DATE	BY	PROFILE	SURVEIL
		NOTE BOOK	PLOTTED
		NO	GAMES CHECKED
			B M NOTED
			STRUCTURE ADJAST NS CH AD

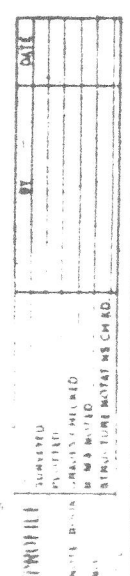