

STATE DEPARTMENT OF HIGHWAYS
DIVISION OF HIGHWAYS—STATE OF COLORADO

PLAN AND PROFILE OF ~~PROPOSED~~
FEDERAL AID PROJECT NO. RF034-1(16)
STATE HIGHWAY NO. 34
WELD COUNTY

UTILITIES, ROW, & PE
OBLIGATED UNDER RF034-1(16)
(E) 4-14-76, G.A.M.-REVISE DATE

FEDERAL ROAD REGION NO.	DIVISION	PROJECT NO.	SHEET NO.
VII	COLORADO	RF 034-1(16)	1

AS CONSTRUCTED
NO REVISIONS ☐ REVISED ☒ 7-7-77 void

INDEX OF SHEETS


1	TITLE PAGE, SKETCH MAP AND TABULATION OF LENGTH AND DESIGN DATA
2 - 2A	TYPICAL SECTIONS AND GENERAL NOTES
3 - 5	SUMMARY OF APPROXIMATE QUANTITIES
6	SUMMARY OF EARTHWORK QUANTITIES, EMBANKMENT PROTECTORS AND DETAIL OF INLET (SPECIAL)
7	FENCING REQUIREMENTS AND TABULATION OF DELINEATORS
8	BASE COURSE AND SURFACE COURSE PLAN AND SUBBASE PLAN
9 - 10	PIT SKETCHES
11 - 12	STRUCTURE QUANTITIES
13	INLET TYPE C (SPECIAL FOR THIS PROJECT)
14	DETAILS OF INTERCHANGE AND LIGHTING, STA. 308+
15	DETAILS OF INTERSECTION AND LIGHTING, STA. 333+
16 - 33	DETAILS OF BRIDGE, STA. 313+
34 - 36	ALIGNMENT AND PLAN SHEETS
37 - 40	PROFILE SHEETS
41 - 56	SIGNING PLANS
57 - 67	Cross Section Sheets - Below Ditch
68 - 74	Cross Section Sheets - Above Ditch
75 - 76	STANDARD SYMBOLS
M-100-A	APPROACH ROADS, FLARING, CUT SLOPE TREATMENT, BRIDGE + CREST WIDENING
M-203-B	DITCH TYPES
M-203-C	SUPERELEVATION OF CURVES - DIVIDED HIGHWAYS
M-203-S0	EXCAVATION AND BACKFILL FOR STRUCTURES
M-206-AB	LETTERS AND FIGURES FOR STRUCTURE NUMBERS
M-500-A	CONCRETE AND METAL END SECTIONS
M-603-CA	REINFORCED CONCRETE PIPE
M-603-RC	STEPS FOR MANHOLES AND INLETS
M-604-D	GUARD RAIL, TYPE 5, BOX BEAM MEDIAN
M-606-B	BARRIER - STEEL
M-607-A	WIRE FENCE AND GATES
M-609-A	CURBS AND GUTTERS
M-612-A	MARKER POSTS AND BENCH MARKS
M-613-AA	HIGHWAY LIGHTING
M-614-TB	TRAFFIC SIGNING FOR HIGHWAY CONSTRUCTION

AS CONSTRUCTED PLANS
RETURN TO DIST. 4 DESIGN

5-11-73	Added Quantities
12-11-72	
7-23-68	
3-24-75	(3 SHEETS)
3-28-75	
8-21-75	
8-29-72	
7-23-68	
11-6-74	(3 SHEETS)
10-15-75	(2 SHEETS)
1-19-76	
6-30-71	
9-16-70	
11-22-71	(3 SHEETS)
10-26-72	(2 SHEETS)
3-11-69	
3-11-69	(3 SHEETS)
1-9-76	
4-10-73	
1-14-71	
9-5-69	(2 SHEETS)
12-4-74	

TABULATION OF LENGTH & DESIGN DATA

STATION	ROADWAY	
	LIN. FT.	MILES
302 + 00 BEGIN RF034-1(16) - 302 + 00 END RF034-1(16)	1,100.0	
313 + 00 END RF034-1(16)		
TOTAL	1,100.0	
SUMMARY		LIN. FT.
TOTAL (NET AND GROSS LENGTH)		1,100.0
DESIGN DATA		
MAXIMUM DEGREE OF CURVE		NONE
MAXIMUM GRADE		0.6702 %
MINIMUM S.S.D. - HORIZONTAL		> 900 FT.
MINIMUM S.S.D. - VERTICAL		> 1300 FT.
MAXIMUM DESIGN SPEED		70 M.P.H.
1996 DESIGN TRAFFIC VOLUME		{ 5,050 A.D.T. 610 D.H.V.

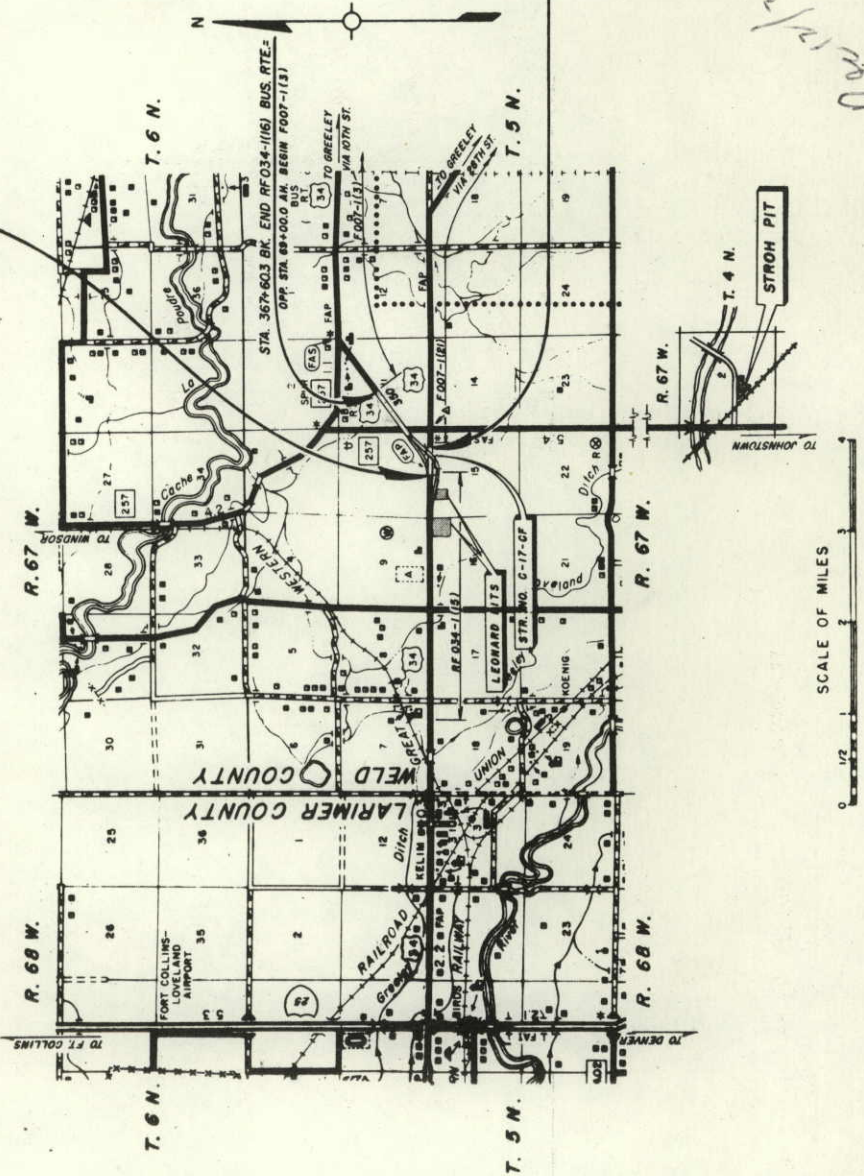

STA. 313+00 END RF034-1(16)


APPROVED
E.N. Hane
CHIEF ENGINEER
3/15/76
DATE

DEPARTMENT OF TRANSPORTATION
FEDERAL HIGHWAY ADMINISTRATION
APPROVED
DATE
DIVISION ADMINISTRATOR

AS CONSTRUCTED INFORMATION
CONTRACTOR Mountain Aggregates Inc
Resident Engineer L.G. Dunan
PROJECT STARTED May 24, 1976
PROJECT COMPLETED July 7, 1977
AS CONSTRUCTED PLANS APPROVED
DATE 10/14/77
TITLE

TYPICAL CROSS SECTIONS

STA. 302+ TO STA. 313+ — 34 BY-PASS ROUTE
 STA. 324+ TO STA. 348+ — 34 BUSINESS ROUTE

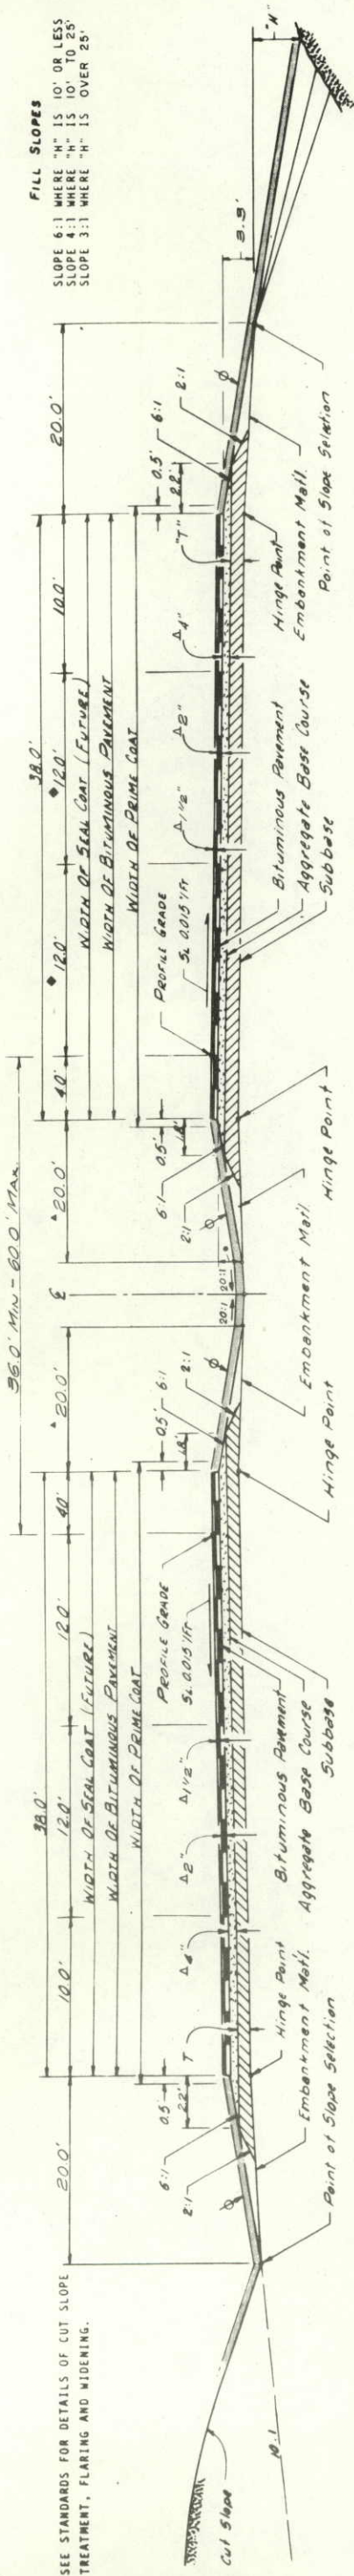

EXCAVATION BELOW 6:1 SLOPE AND/OR 10:1 SLOPE WILL NOT BE PERMITTED.

THE CONTRACTOR WILL BE REQUIRED TO PLACE TOPSOIL TO THIS LINE AFTER COMPLETION OF PAVING OPERATION.


THE DEPTH AND WIDTH OF THE SIDE DITCH SHALL BE VARIED WHERE NECESSARY IN ORDER TO PROVIDE PROPER DRAINAGE.

A 14' FROM STA. 324+55 TO 348+00 BUSINESS ROUTE (#23')

APPROXIMATE THICKNESS

BREAK POINTS ON SLOPES AND IN BOTTOMS OF DITCHES SHALL BE ROUNDED ON CONSTRUCTION FOR A PLEASING APPEARANCE.

STA. 324+ TO 348+ BUSINESS ROUTE (WESTBOUND LANE)

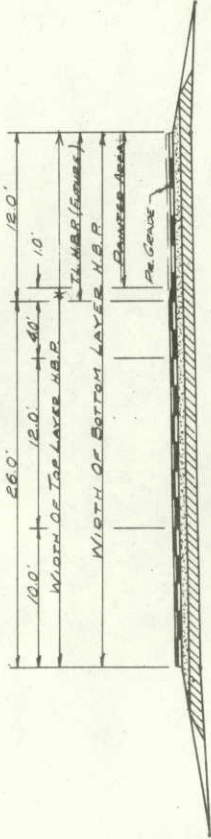

TRANSITION FROM STA. 316+ TO 323+ W.B. BUS. RTE.

MATERIAL SHALL BE PLACED IN SEPARATE COURSES AT THE FOLLOWING APPROXIMATE RATES PER 100 LIN. FT. OF ROADWAY

BITUMINOUS PAVEMENT TOP LAYER . . . 70 TONS (GRADING EX)

BITUMINOUS PAVEMENT BOTTOM LAYER . . . 93 TONS (GRADING E)

AGGREGATE BASE COURSE . . . 178 TONS

THE RATES SHOWN HAVE BEEN DETERMINED FROM INFORMATION AVAILABLE AT THE TIME OF DESIGN. RATES SHOULD BE ADJUSTED DURING CONSTRUCTION TO OBTAIN THE REQUIRED APPROXIMATE THICKNESS.

TRANSITION FROM 24' TO 12.0', STA. 340+ TO 346+

GENERAL NOTES

FOR PRELIMINARY PLAN QUANTITIES OF BITUMINOUS MATERIALS THE FOLLOWING RATES OF APPLICATION WERE USED:

PRIME COAT MC-70 @ 0.30 GALS. PER SQ. YD.

TACK COAT CSS-1 @ 0.10 GALS. OF MIXTURE PER SQ. YD. (DILUTED 1:1)

RATES OF APPLICATION SHALL BE AS DETERMINED BY THE ENGINEER AT THE TIME OF APPLICATION.

DEPTH OF MOISTURE-DENSITY CONTROL FOR THIS PROJECT SHALL BE AS FOLLOWS:

FULL DEPTH OF ALL EMBANKMENTS

BASES OF CUTS AND FILLS 6 INCHES

EXCAVATION REQUIRED FOR COMPACTION OF BASES OF CUTS AND FILLS WILL BE CONSIDERED AS SUBSIDIARY TO THAT OPERATION AND WILL NOT BE PAID FOR SEPARATELY.

THE MINIMUM THICKNESS OF TOPSOIL SHALL BE 4 INCHES. APPROXIMATELY 1/2" OF TOPSOIL WAS OBTAINED WITHIN ROADWAY LIMITS AND STOCKPILED WITHIN ROW

EARTH SLOPES SHALL BE DISCED OR ROUGHENED BY OTHER APPROVED METHODS FOR MULCHING OR EROSION PROTECTION.

3392.5 HOURS OF FLAGGING FOR CONTROLLING TRAFFIC WILL BE REQUIRED FOR THIS PROJECT.

SEEDING RECOMMENDATIONS:

COMMON NAME	BOTANICAL NAME	%Purity	%germ.	PLS/LBS/ACRE
INTERMEDIATE WHEATGRASS	AGROPYRON INTERMEDIUM	90	85	5
ALL WHEATGRASS	AGROPYRON ELONGATUM	94	90	6
SWITCHGRASS	PAICICUM VIRGATUM	90	80	4
BLUESMITH	AMODENUM SCLOPARIUS	90	80	2
RANGER ALFALFA	MEDICAGO SATIVA	95	90	2
MULCHING:	1-1/2 TONS/ACRE NATIVE HAY			27

FERTILIZER:

PROVIDING: 50 LBS/ACRE AVAILABLE NITROGEN

IN THE FORM OF: 100 LBS/ACRE SUPERPHOSPHATE

18% AVAILABLE NITROGEN (18-0-0)

45% SUPERPHOSPHATE (0-45-0)


TOTALING: 500 LBS/ACRE COMMERCIAL FERTILIZER

TYPICAL CROSS SECTIONS

(2 - LANE SECTION)

BUSINESS ROUTE

STA. 343+ TO STA. 367 +

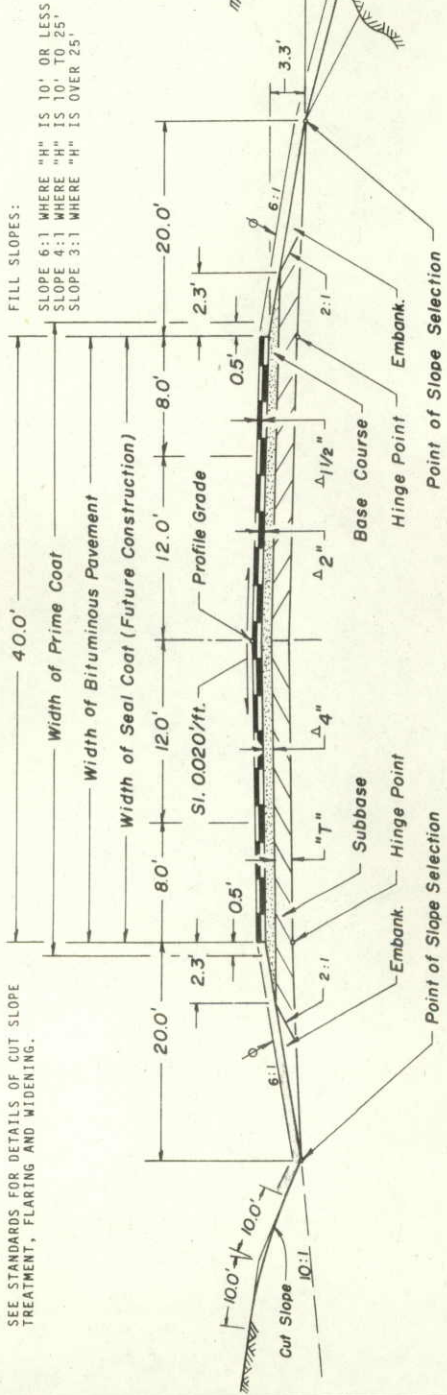

Δ APPROXIMATE THICKNESS

THE DEPTH AND WIDTH OF THE SIDE DITCH SHALL BE VARIED WHERE NECESSARY IN ORDER TO PROVIDE PROPER DRAINAGE.

EXCAVATION BELOW 6:1 SLOPE AND/OR 10:1 SLOPE WILL NOT BE PERMITTED.

BREAK POINTS ON SLOPES AND IN BOTTOMS OF DITCHES SHALL BE ROUNDED ON CONSTRUCTION FOR A PLEASING APPEARANCE.

MATERIAL SHALL BE PLACED IN SEPARATE COURSES AT THE FOLLOWING APPROXIMATE RATES PER 100 LIN. FT. OF ROADWAY:

BITUMINOUS PAVEMENT	TOP LAYER	37 TONS (Grading EX)
	BOTTOM LAYER	49 TONS (Grading E)
BASE COURSE		94 TONS

THE RATES SHOWN HAVE BEEN DETERMINED FROM INFORMATION AVAILABLE AT THE TIME OF DESIGN. RATES SHOULD BE ADJUSTED DURING CONSTRUCTION TO OBTAIN THE REQUIRED APPROXIMATE THICKNESS.


THE CONTRACTOR WILL BE REQUIRED TO PLACE TOPSOIL TO THIS LINE AFTER COMPLETION OF PAVING OPERATION.

• TRANSITION FROM 4-LANE TO 2-LANE SECTION, STA. 348+ TO 365+ BUS. RTE.

(4 - LANE SECTIONS)

WEST BOUND BUSINESS ROUTE

STA. 302+ TO STA. 323 +

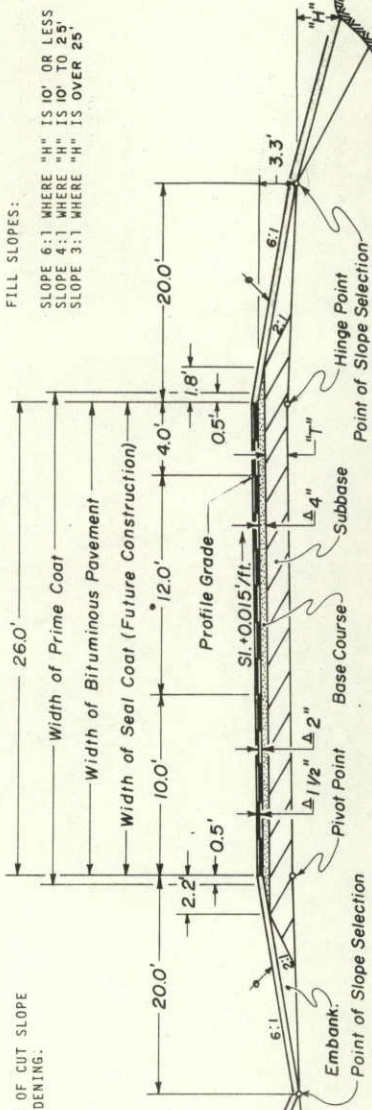


MATERIAL SHALL BE PLACED IN SEPARATE COURSES AT THE FOLLOWING APPROXIMATE RATES PER 100 LIN. FT. OF ROADWAY:

BITUMINOUS PAVEMENT	TOP LAYER	24 TONS (Grading EX)
	BOTTOM LAYER	22 TONS (Grading E)
BASE COURSE		63 TONS

THE RATES SHOWN HAVE BEEN DETERMINED FROM INFORMATION AVAILABLE AT THE TIME OF DESIGN. RATES SHOULD BE ADJUSTED DURING CONSTRUCTION TO OBTAIN THE REQUIRED APPROXIMATE THICKNESS.

EAST BOUND BUSINESS ROUTE

STA. 287+ TO STA. 326 +

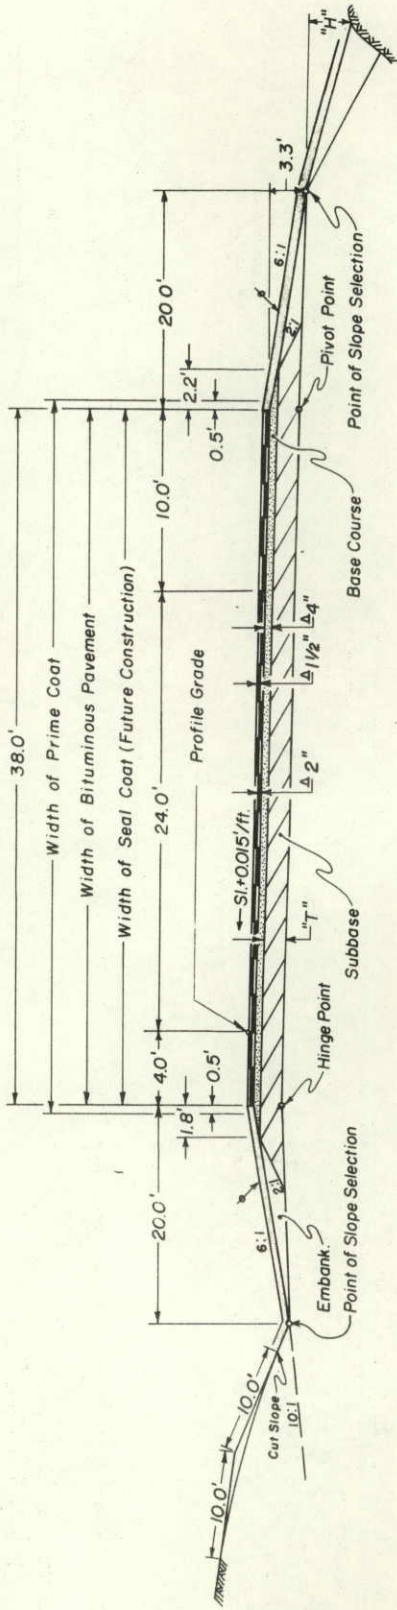

Δ Approximate Thickness

THE DEPTH AND WIDTH OF THE SIDE DITCH SHALL BE VARIED WHERE NECESSARY IN ORDER TO PROVIDE PROPER DRAINAGE.

THE CONTRACTOR WILL BE REQUIRED TO PLACE TOPSOIL TO THIS LINE AFTER COMPLETION OF PAVING OPERATION.

MATERIAL SHALL BE PLACED IN SEPARATE COURSES AT THE FOLLOWING APPROXIMATE RATES PER 100 LIN. FT. OF ROADWAY:

BITUMINOUS PAVEMENT	TOP LAYER	35 TONS (Grading EX)
	BOTTOM LAYER	47 TONS (Grading E)
BASE COURSE		89 TONS

THE RATES SHOWN HAVE BEEN DETERMINED FROM INFORMATION AVAILABLE AT THE TIME OF DESIGN. RATES SHOULD BE ADJUSTED DURING CONSTRUCTION TO OBTAIN THE REQUIRED APPROXIMATE THICKNESS.

FEDERAL ROAD DISTRICT NO.	DIVISION	PROJ. NO.	SHEET NO.	TOTAL SHEETS
VIII	COLORADO	RF 034-1(16)	24	
NO REVISIONS				
AS CONSTRUCTED				
REVISED 7-7-77 VOID				

FINAL
SUMMARY OF APPROXIMATE QUANTITIES

INDEX		CONTRACT ITEM NO.	CONTRACT ITEM	UNIT	ROADWAY Plan	Final	Diff	STRUCTURE NO. C-17-FA Plan	Final	Diff	PROJECT TOTALS Plan	Final	Diff	SHEET NO.	TOTAL SHEETS
BOOK	PAGE														
		202	REMOVAL OF STRUCTURE	EACH	4	4	-				4	4	-		
		202	REMOVAL OF GROUND SIGN	EACH	24	26	+2				24	26	+2		305
		202	REMOVAL OF SIGN PANEL	EACH	1	1	-				1	1	-		305
		202	REMOVAL OF FENCE	LIN. FT.	3,600	3,586	-14				3,600	3,586	-14		305
		203	UNCLASSIFIED EXCAVATION	CUBIC YARD	231,000						231,000	223,447	-7,553		547 75
		203	BORROW	CUBIC YARD	111,000	113,749	+2,749				111,000	113,749	+2,749		547 75
		203	STRIPPING	CUBIC YARD	64,700						64,700	11,600	-53,100		547 75
		203	COMPACTION (AASHTO T 99)	CUBIC YARD	267,000						267,000	298,930	+31,930		547 75
		204	HAUL	YARD MILE	144,100						144,100	142,724	-1,376		305
		204	HAUL	TON MILE	389,000	440,529	+51,529				389,000	440,529	+51,529		Form 724
		206	STRUCTURE EXCAVATION	CUBIC YARD	220	309.4	+89.4	510	353	-167	730	662.4	-67.6		305
		206	STRUCTURE BACKFILL (CLASS 2)	CUBIC YARD	255	302.5	+47.5	455	455	-	710	757.5	+47.5		305
		207	TOPSOIL (HAUL)	CUBIC YARD	18,100	16,860	-1,240				18,100	16,860	-1,240		82 9 17 2
		209	WETTING	M. GAL.	11,760	7,370.9	-4,389.1				11,760	7,370.9	-4,389.1		Form 7
		210	RESET MAILBOX STRUCTURE	EACH	1	1	-				1	1	-		547 12
		210	RESET GROUND SIGN	EACH	31	29	-2				31	29	-2		305
		210	RESET ILLUMINATED GROUND SIGN	EACH	2	2	-				2	2	-		305
		210	RESET FENCE	LIN. FT.	1200	1,036	-164				1200	1,036	-164		305
		212	SEEDING (NATIVE)	Lb.	720	1215.5	+495.5				720	1215.5	+495.5		305
		212	FERTILIZER	Lb.	16,000	17,540	+1,540				16,000	17,540	+1,540		305
		212	SOIL PREPARATION (NATIVE)	ACRE	32	53	+21				32	53	+21		305
		213	MULCHING	TON	51	79.20	+28.2				51	79.2	+28.2		305
		304	AGGREGATE BASE COURSE (CLASS 1)	TON	57,600	58,804.36	+1,204.36				57,600	58,804.36	+1,204.36		Form 87
		304	AGGREGATE BASE COURSE (CLASS 6)	TON	16,500	20,493.75	+3,993.75				16,500	20,493.75	+3,993.75		Form 87
		403	HOT BITUMINOUS PAVEMENT (GRADING E)(HAUL & ASPHALT)	TON	8,600	9,679.55	+1,079.55				8,600	9,679.55	+1,079.55		Form 87
		403	HOT BITUMINOUS PAVEMENT (GRADING EX)(HAUL & ASPHALT)	TON	6,221	7,834.35	+1,613.35				6,400	8,029.50	+1,629.5		Form 87
		411	EMULSIFIED ASPHALT (CSS-1)	GALLON	27,900	1,760	-26,140				27,900	1,760	-26,140		Form 87
		411	LIQUID ASPHALTIC MATERIAL (MC-70)	GALLON	24,100	16,635	-7,465				24,100	16,635	-7,465		Form 87
		502	DRILLING HOLE TO FACILITATE PILE DRIVING	LIN. FT.				600	600	-	600	600	-		Form 87
		502	STEEL PILING (HP 10x42)	LIN. FT.				820	758.8	-61.2	820	758.8	-61.2		Form 87
		507	STEEL PILE CUTOFF	LIN. FT.	3	2.2	-0.8				3	2.2	-0.8		Form 87
		507	CONCRETE SLOPE AND DITCH PAVING (REINFORCED)	CUBIC YARD							0	13.9	+13.9		Form 87
		507	CONCRETE SLOPE AND DITCH PAVING (REINFORCED) (COLORED)	CUBIC YARD				210	181.7	-28.3	210	181.7	-28.3		Form 87

RED 4-14-76, C.K.M., Added FIA08

FINAL

SUMMARY OF APPROXIMATE QUANTITIES

AS CONSTRUCTED
NO REVISIONS
REVISED 7-7-77
VOID

FEDERAL ROAD DISTRICT NO. XIII
DIVISION COLORADO
PROJ. NO. RF 034 - 1 (16)
SHEET NO. 5
TOTAL SHEETS

INDEX		CONTRACT ITEM NO.	CONTRACT ITEM	UNIT				ROADWAY Plan	Final	Diff.	STRUCTURE NO. G-17-FA Plan	Final	Diff.	PROJECT TOTALS Plan	Final	Diff.	Ref
BOOK	PAGE																
		613	LUMINAIRE MERCURY VAPOR (37,000 LUMEN)	EACH				7	7	—				7	7	—	305
		613	LUMINAIRE MERCURY VAPOR (TINTED)(37,000 LUMEN)	EACH				1	1	—				1	1	—	305
		613	LIGHT STANDARD ALUMINUM (40 FOOT)	EACH				8	8	—				8	8	—	305
		613	CONCRETE FOUNDATION PAD	EACH				8	8	—				8	8	—	305
		614	FLAGGING	HOURL				7000	3329.5	-3670.5				7000	3329.5	-3670.5	Form 7
		614	SIGN PANEL (CLASS I)	SQUARE FOOT				47	47					47	47		305
		614	SIGN PANEL (CLASS II)	SQUARE FOOT				495	495					495	495		305
		614	SIGN PANEL (CLASS III)	SQUARE FOOT				729	729					729	729		305
		614	TIMBER SIGN POST 4x4 INCH	LIN. FT.				139	139					139	139		305
		614	TIMBER SIGN POST 6x6 INCH	LIN. FT.				635	635					635	635		305
		614	STEEL SIGN POST (W 10x21)	LIN. FT.				39	39	—				39	39	—	305
		614	CONCRETE FOOTING (TYPE 5)	EACH				2	2	—				2	2	—	305
		614	MODIFICATION OF TIMBER SIGN POST	EACH				13	13	—				13	13	—	305
		614	SIGN BRIDGE STRUCTURE (95 TO LESS THAN 100 FOOT FRAME)	EACH				1	1	—				1	1	—	305
		614 618	FLASHING YELLOW BEACON PRESTRESSING STEEL WIRE OR STRAND	EACH LB.				2	2	—		78,026	—	2	2	—	305 SMT 16
		620	FIELD LABORATORY	EACH				1	1	—				1	1	—	305
		620 626	SANITARY FACILITY MOBILIZATION	EACH LUMP SUM				1 PRORATED	1	—		PRORATED		1 ●	1 ●	—	305
			FORCE ACCOUNT														
			FIA01 RESET TEMPORARY LIGHTING	LUMP SUM				●	●					●	●		
			FIA02 ON THE JOB TRAINEE	EACH				2	2					2	2		
			FIA03 MINOR CONTRACT REVISIONS CMO 0801	LUMP SUM				●	●					●	●		
			FIA04 RELOCATE WATER LINE	LUMP SUM				●						●			
			FIA05 FURNISH POWER TO SIGNS AT VARIOUS LOCATIONS (WORK BY FORTREE VALLEY REA FORCES)	LUMP SUM				●						●			
			FIA08 FURNISH AND INSTALL GROUND FAULT INTERRUPTER AND DISCONNECT CMO 3232 Additional Grading Due to Grade Change	LUMP SUM				● ●	●					● ●	●		
			STATE FORCES														
			FIA06 STRIPING ENTIRE PROJECT (Non-Federal Aid)	LUMP SUM				●	●					●	●		
			FIA07 TEMPORARY SIGNING AND STRIPING (Non-Federal Aid)	LUMP SUM				●	●					●	●		


FINAL

TABULATION OF EMBANKMENT PROTECTORS

STATION	SIDE	CURB TYPE 6 (SECTION M)		INLET SPECIAL (5 FOOT)		BITUMINOUS SLOPE AND DITCH PAVING		CORRUGATED STEEL PIPE 12"		STRUCTURE EXCAVATION	
		LIN.	FT.	Plan	Final	Plan	Final	LIN.	FT.	Plan	Final
BUSINESS (E.B.)											
311+15	Lt	50	45	1	1	1.5	1.5	78	86	1	1
315+25	Lt	50	55	1	1	1.5	1.5	62	62	1	1
PROJECT TOTAL		100	100	2	2	3	3	140	148	2	2


REF. FORM 305 FORM 305 FORM 305 FORM 305 FORM 305 FORM 305

DETAIL OF INLET

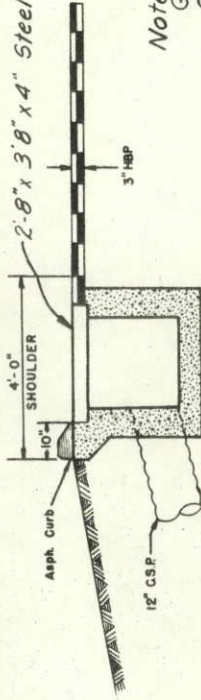


Note:
Grating to be galvanized steel capable
of supporting H-20 Loading with
approx. 75% open area. Grating
to be fabricated as per manufactures
recommendations. Grating shall have
1/4" thick end bands. Interior stringers
are to be 3/16" thick and are to be placed
parallel to the short side of the box.


CROSS SECTION

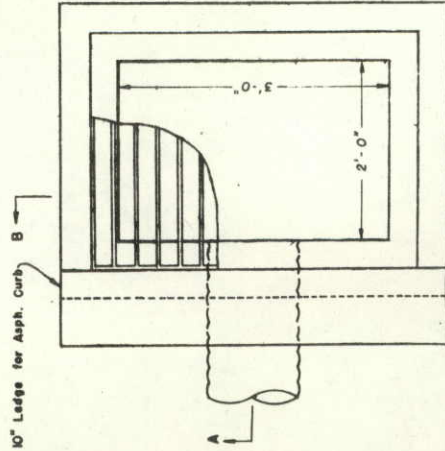

TOP VIEW

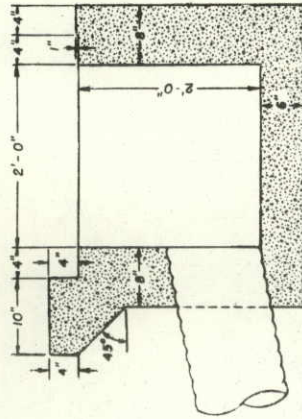

SECTION A-A

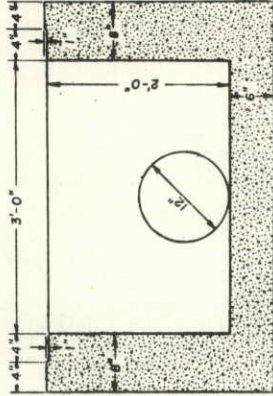

SECTION B-B

FINAL

SUMMARY OF EARTHWORK QUANTITIES

INDEX	ITEM	PROJECT TOTALS	
		Plan	Final
Sheet 75	UNCLASSIFIED EXCAVATION	Cu. Yd.	Cu. Yd.
9 50	Roadway (From Cross Section & Electronic Computer) Structure Quantities as Embankment (in Xsects)	194,363	201,067
	Structure Quantities as Excavation (in Xsects)	400	66
	Structure Quantities as Ditch (in Xsects)	300	
	Estimate for Cut Slope Treatment (in Xsects)	18,100	16,860
	Excavation for Shoulder Areas	14,110	
	Excavation to Replace Topsoil	2,140	
	Excavation for Grade Change, Bypass CMO# 3232		5,454
	TOTAL FOR PAY QUANTITY	230,213	223,447
9 50	STRIPPING		
	Remove Overburden	41,100	11,600
	Replace Overburden	23,600	11,600
	TOTAL FOR PAY QUANTITY	64,700	23,200
Sheet 57-67	BORROW		
	For Roadway Embankment	87,804	
	For Embankment To Replace Topsoil	22,300	
	TOTAL FOR PAY QUANTITY	110,104	113,749
Sheet 75	EMBANKMENTS (AASHTO T 99)		
	(MOISTURE AND DENSITY CONTROL)		
	Embankment (Net)	209,015	248,910
	Base of Cut and Fills	27,320	33,094
	Structure Quantities as Embankment (Net)*	1,170	66
	Embankment To Replace Topsoil (Net)	18,100	16,860
	Shoulder Areas (Net)	10,450	
	* Included in Roadway X- Sects.		
	TOTAL FOR PAY QUANTITY	266,055	298,930
9 50	HAUL		
	From Mass Diagram	118,738	
	Estimate for Shoulder Areas	10,550	
	Estimate for Replacing Topsoil	14,757	
	TOTAL FOR PAY QUANTITY	144,045	
	ROADWAY QUANTITIES BALANCE		
	(For Information Only)		
	Excavation	194,363	
	Borrow	87,804	
	TOTAL	282,167	
	EMBANKMENT NET		
	Roadway from Cross Sections	209,015	
	TOTAL	209,015	
	EMBANKMENT x FACTOR		
	(Roadway - Electronic Computer)	282,167	
	TOTAL	282,167	

NOTE: Approximately 17,020 Cu. Yds. of Unclassified Excavation:
To be Obtained Within R.O.W. Rt. of Sta. 266± to 269± and
287± to 291±

AS CONSTRUCTED

NO REVISIONS REVISED 7-7-72 VOID

PROJ. NO.

RF 034 - 1(16)

DIVISION

COLORADO

FEDERAL ROAD
REGION NO.

VIII

SHEET

NO.

TOTAL

SHEETS

6

AS CONSTRUCTED

NO REVISIONS

REVISED

7-7-77

VOID

FEDERAL ROAD DISTRICT NO.
VIII

DIVISION
COLORADO

PROJ. NO.
RF 034 - (116)

SHEET NO.
7

TOTAL SHEETS

FINAL
TABULATION OF DELINEATORS

STATION TO STATION	SIDE	SPACING	TYPE I		TYPE II	
			EACH		EACH	
			Plan	Final	Plan	Final
E.B. BUSINESS	Rt.	2° Curve	2			
	Lt. & Rt.	Tangent	4	37		
	Lt. & Rt.	Tangent	4			
	Lt. & Rt.	5° Curve	14			
	Lt. & Rt.	Tangent	4			
BUSINESS W.B. & E.B.	Rt.	2° Curve	2			
	Rt.	Tangent	2			
	Lt.	Acceleration Lane		28	7	13
	Rt.	Lt. Turn Lane	11			
W.B. BUSINESS	Lt.	14° Curve			2	
	Rt.	Deceleration Lane			4	
	Rt.	Curve			4	
	Lt. & Rt.	Islands	9	7		
	Rt.	Acceleration Lane			8	
BY - PASS	Lt.	Lt. Turn Lane	14	18	5	17
	Lt.	Deceleration Lane				
	Lt. & Rt.	Crossover	8			
	Lt.	2'45" Curve	12			
W.B. BUSINESS	Lt.	Tangent	2	36		16
	Lt.					
BY - PASS	Lt. & Rt.	Crossover	8	13		4
	Lt. & Rt.					
PROJECT TOTALS			96	139	30	61

FINAL
FENCING REQUIREMENTS

STATION TO STATION	SIDE	REMOVE FENCE		RESET FENCE		BUILD FENCE		FENCE		GATES	
		Plan	Final	Plan	Final	Barbed	Linear	Barbed	Wire	Barbed	Wire
BY - PASS	Rt.	2010	2016								
	Rt.	950	939								
	Lt.			1120	1036						
E.B. BUSINESS	Rt.						3100		3018		
BUSINESS W.B. & E.B.	Lt.						1100				
	Lt.						2150				
	Lt.						600				
	Rt.						2450				0
W.B. BUSINESS	Rt.						770				
	Lt.						2090		11,801		
	Rt.										
S.H. 257	Rt.	210	212								
	Lt.	420	419								
	Lt.						980				
	Rt.						1040				
BY - PASS	Lt.						800				
	Rt.										
PROJECT TOTALS		3590	3586	1120	1036		15080		14,819	2	2
										1	0

Note: ²⁴ It is Estimated that ¹⁸ End Posts and ¹⁸ Corner and Line Brace Posts ~~will be~~ Required. ¹⁸ For Information Only

FINAL
BASE COURSE AND SURFACE COURSE PLAN

AS CONSTRUCTED
NO REVISIONS
REVISED 7-7-77
VOID

FEDERAL ROAD
REGION NO. VIII
DIVISION COLORADO
PROJ. NO. RF 034 - 1(16)
SHEET NO. 8
TOTAL
SHEETS

STATION TO STATION	SOURCE	QUANTITY - TONS						HAUL - TON MILE	
		BASE COURSE		SURFACE COURSE - HOT BITUMINOUS PAVEMENT		BASE COURSE		BASE COURSE	
		AGGR. BASE COURSE, CL. 6	BOTTOM LAYER, GRADING E	TOP LAYER, GRADING EX	AGGR. BASE COURSE, CL. 6	AGGR. BASE COURSE, CL. 6	AGGR. BASE COURSE, CL. 6	AGGR. BASE COURSE, CL. 6	
E.B. BUSINESS 287+ to 311+46.4 314+93.8 to 326+75.1 Bk. Decel Lane Accel Lane		Plan	Final	Plan	Final	Plan	Final	Plan	Final
		2177	1150	856	1717.85	13407	31696		
		1051	555	413		5539			
		225	120	90		1341			
		200	110	82		1214			
W.B. BUSINESS 309+00 to 323+75.4 Bk. 302+00 to 309+00 Accel Lane Transition		930	472	354		4867			
		441	224	168	588.10	2275			
		171	80	60		912	7092		
		92	51			488			
BUSINESS W.B. & E.B. 324+54.6 Ah to 333+60.3 333+60.3 to 340+79.7 340+79.7 to 348+00 348+00 to 352+50 Lt. 352+50 to 355+40 Lt. 355+40 to 367+60.3 Transition	H.B.P. UNDESIGNATED A.B.C. STROH PIT	1612	842	572		8176			
		1281	669	478		6472			
		1088	562	425		5646			
		400	209	142		2121			
		91	46	35		489			
		1147	598	452	3098.95	6347	58268		
		80	44	33		420			
		231	117	88		1234			
		297	129			1533			
		1067	584	438		5320			
BY - PASS 302+00 to 313+00 Approach to Project		1958	1023	770		9991			
		1902	973	730	2624.6	9223	13697		
PROJECT TOTALS		16,441	8,558	6,186	8,029.50	87,015	110,753		

STABILIZATION BASED ON :
18k EDLA = 67
Regional Factor = 1.5
Serviceability Index = 2.5
STRENGTH COEFFICIENTS:
H.B.P. (Rt = 100) = 0.44
A.B.C. (Class 6(R = 82)) = 0.12
A.B.C. (Class 1(R = 78)) = 0.12

FINAL
SUBBASE PLAN

STATION TO STATION	SOURCE	THICKNESS INCHES	AGGREGATE		BASE	COURSE		
			CLASS	I		HAUL - TON MILE		
						TONS	Plan	Final
BUSINESS (E.B.)			Plan	Final	Plan	Final		
287+00 to 294+00		12	2100		12,585			
294+00 to 311+46.4		9 12	3929		24,459			
314+93.8 to 323+00		9 12	1814	17,062.80	9559	101,406		
323+00 to 326+75.1 Bk.		12	1125		5844			
Est. for Irregularities			897		5245			
BUSINESS (W.B.)								
302+00 to 309+00		12	1540		7945			
309+00 to 323+75.4 Bk.		12	3246		16,985			
Accel Lane		12	360	9,012.20	1955	51,320		
Transition		12	277		1496			
Est. for Irregularities			542		2838			
BUSINESS W.B. & E.B.	STROH PIT							
324+54.6 Ah. to 333+60.3		12	5434		27,562			
333+60.3 to 340+79.7		12	6478		32,743			
340+79.7 to 348+00		9 12	3746		19,446			
348+00 to 352+50 Lt.		9 12	1013		5371			
352+50 to 355+40		9	345		1854			
355+40 to 367+60.3		12	3856	20,451.55	21265	105,018		
Intersection, Sta. 333 + With Accel & Decel Lanes			3201		15961			
Transition								
Crossover Sta. 348+			180		932			
Est. for Irregularities			590		3152			
BY - PASS			2484		12,829			
302+00 to 313+00		12	6600		33,676			
Approach to Project			6453	12,217.81	31292	72,032		
Est. for Irregularities			1305		6497			
PROJECT TOTALS			57,515	58,804.36	301,491	329,176		

AS CONSTRUCTED		FEDERAL ROAD DISTRICT NO.		DIVISION		PROJ. NO.		SHEET NO.		TOTAL SHEETS	
NO REVISIONS		REVISED 7-7-77		VOID		COLORADO		RF 034 - 1(16)		9	

STROH PIT
NOT USED - CMO 3230

LOCATION: A portion of S.W. $\frac{1}{4}$, and W. $\frac{1}{2}$, NW. $\frac{1}{4}$, SE. $\frac{1}{4}$, Sec. 2, T.4 N., R. 67 W.

OWNER: Elmer Stroh and Helen D. Stroh


QUANTITY AVAILABLE: 70,000 Cu. Yd.

PROPOSED USE: Aggregate Base Course Class 6, Subbase Class 1


HAUL DISTANCE: 4.7 Mi. to Sta. 328+75.1

OVERBURDEN: 17,500 Cu. Yd.

STRIPPING: 3500 Cu. Yd. Remove
3500 Cu. Yd. Replace

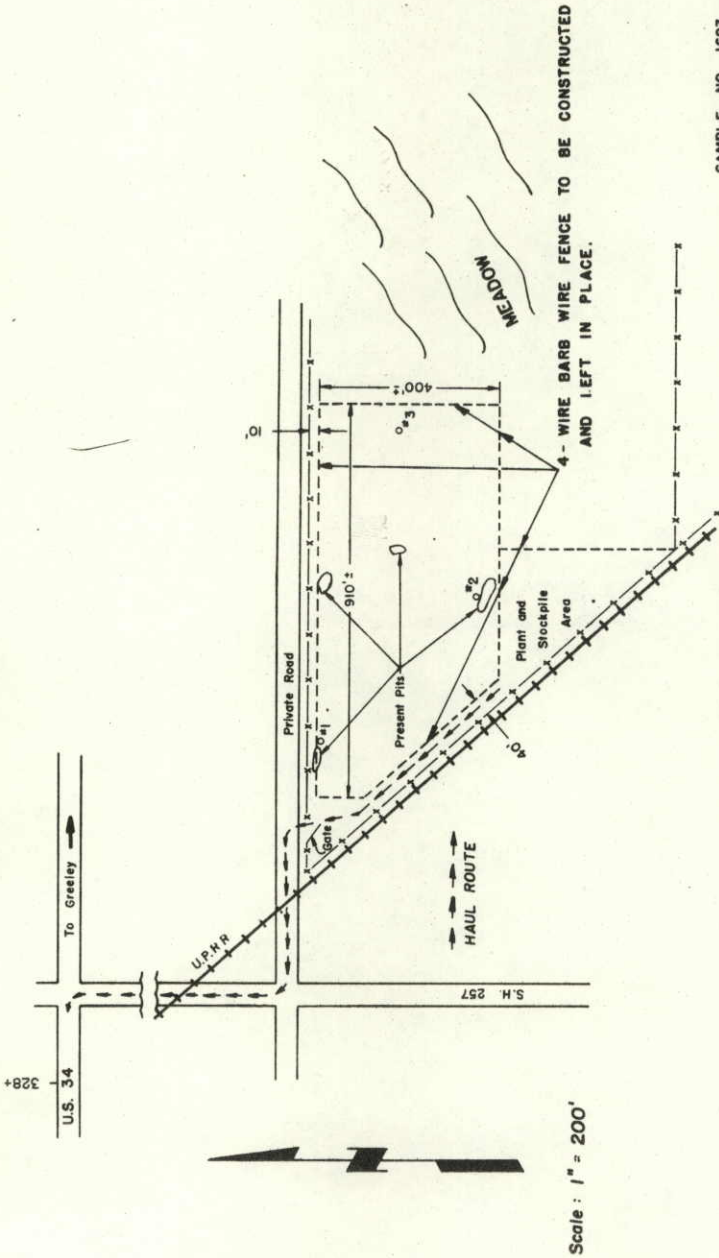

SAMPLE NO. 1693
DATE: NOVEMBER 19, 1973
WATER TABLE: AVERAGE

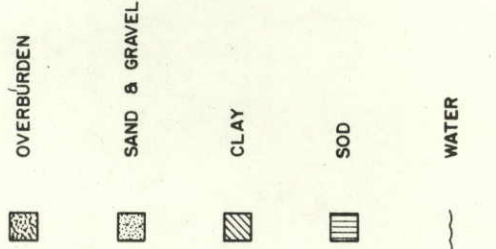


NOTE:

CONTRACTOR WILL BE PROHIBITED
FROM WORKING THE PIT BETWEEN
THE HOURS OF 10 P.M. AND
6 A.M.


NOTE:

The Contractor's Attention Is Directed
To The Fact That Some Areas Of
This Pit Contain Plastic Fine Sand
And Filler. These Areas Of Plastic
Material Should Be Avoided During
The Production Of Aggregate Base
Course - Class 6.

AS CONSTRUCTED		FEDERAL ROAD REGION NO.	DIVISION	PROJ. NO.	SHEET NO.	TOTAL SHEETS
NO REVISIONS	REVISED 7-7-77 VOID	VIII	COLORADO	RF 034-1(16)	10	

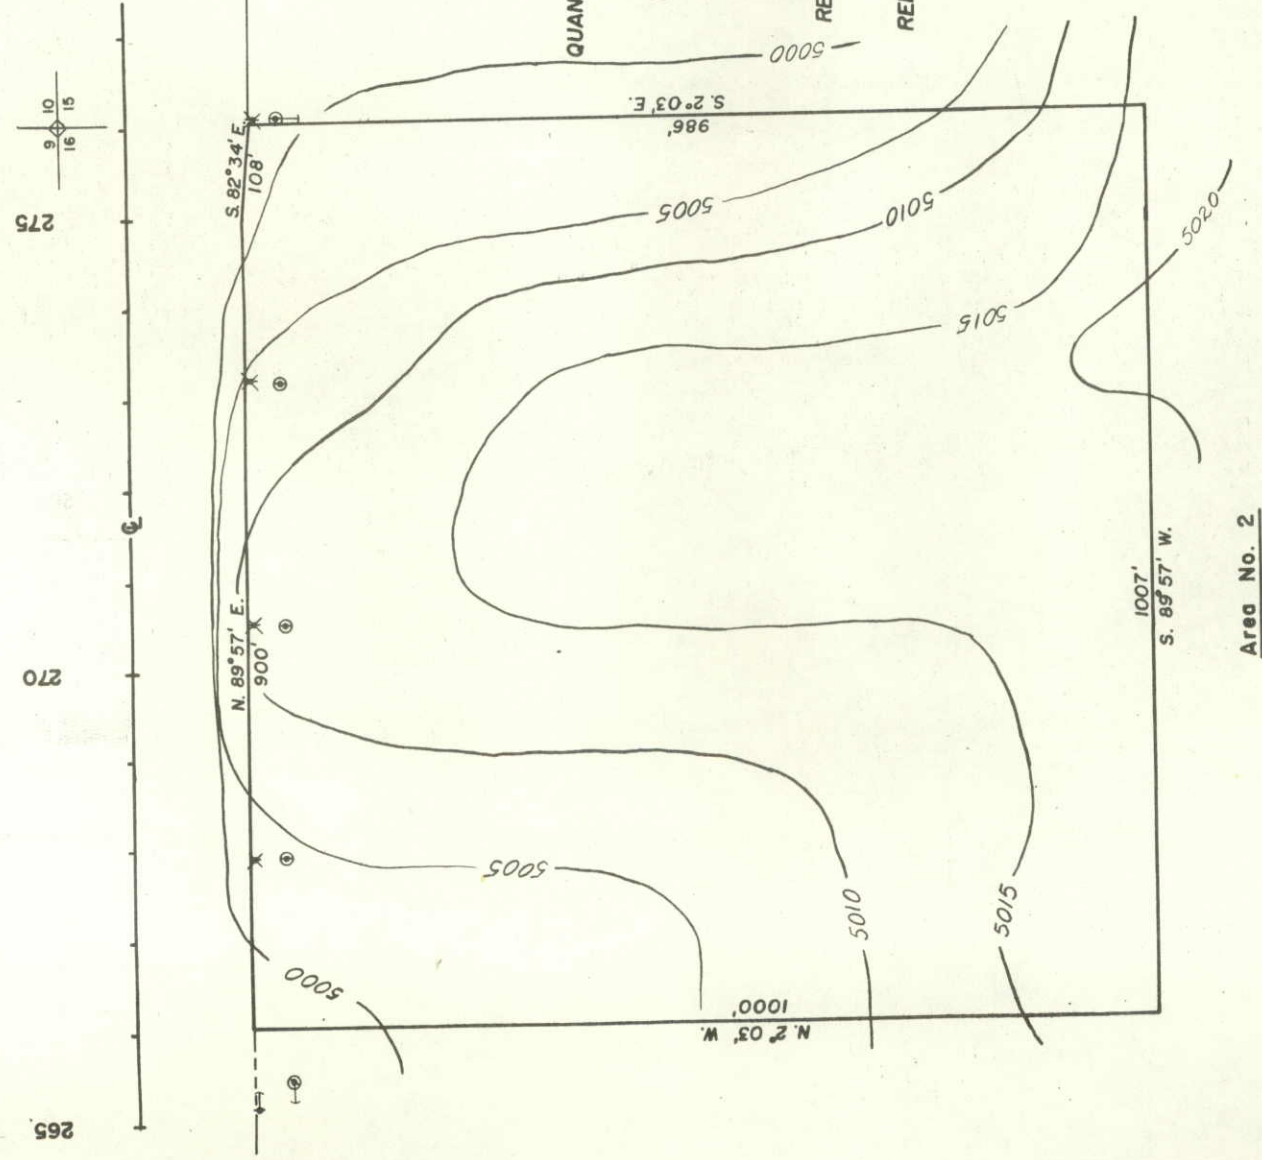

Note :
Area No. 1 is to be used first.

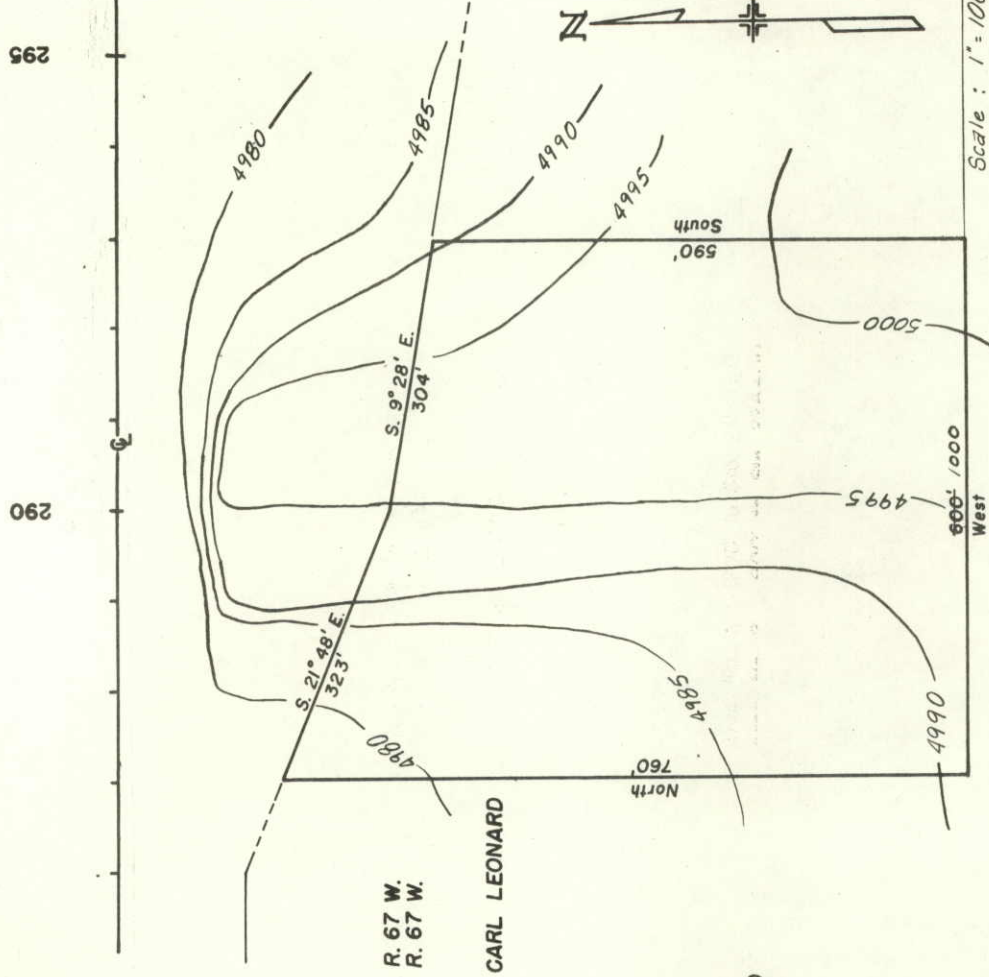

SAMPLE NO. 1690
DATE: SEPTEMBER 12, 1975
80' TO WATER

Area No. 1, NW. $\frac{1}{4}$, Sec. 15, T. 5 N., R. 67 W.
Area No. 2, NE. $\frac{1}{4}$, Sec. 16, T. 5 N., R. 67 W.

DONALD E. & OLIVE M. LEONARD, CARL LEONARD

Area No. 1,	81,000	Cu. Yd.
Area No. 2,	249,000	Cu. Yd.

PROPOSED	USE:	BORROW

HAUL DISTANCE:

Area No. 1,	700' to Sta. 293+00
Area No. 2,	900' to Sta. 276+00

REMOVE TOPSOIL:	Area No. 1,	10,100	Cu. Yd.
	Area No. 2,	10,000	Cu. Yd.

REPLACE TOPSOIL:			
	Area	No. 1,	10,100
	Area	No. 2,	10,000
			Cu. Yd.
			Cu. Yd.

THE STATE DEPARTMENT OF HIGHWAYS DIVISION OF HIGHWAYS-STATE OF COLORADO DDH FORM NO. 126 (MYLAR) REV. MARCH, 1975										FINAL										STRUCTURE QUANTITIES										AS CONSTRUCTED		NO REVISIONS		REVISED		VOID		PROJECT NO.		DIVISION		SHEET NO.	
INDEX		LOCATION		UNCLASSIFIED EXCAVATION		STRUCTURE EXCAVATION		STRUCTURE BACKFILL		REMOVAL OF STRUCTURE		AGGREGATE COURSE SURFACING (CLASS. E.) (GRADING E.)		HOT BITUMINOUS PAVEMENT		INLET TYPE C		REINFORCED CONCRETE PIPE LINEAR FEET		CONCRETE SLOPE & DITCH PAVING		REINFORCED CONCRETE END SECTION		MISCELLANEOUS																			
BOOK	PAGE	SHEET		EXCAV.	EMB.	DITCH	CUBIC YARD	CL. 2	CUBIC YARD	EACH	TON	TON	TON	TON	EACH	5 FT.	15 FT.	24"	36"	FT	CUBIC YARD	EACH	24"	36"																			
E.B. & W.B. BUSINESS ROUTE																																											
5	21		332+50			15	55	29																																			
5	24		333+				54	31																																			
5	26		333+ Lt.																																								
5	31		348+																																								
5	34		350+00				54	73.5																																			
5	37		361+50				56	77																																			
5	40		365+80				16	37																																			
5	43		367+03					27																																			
5	46		297+ (S.H. 257)																																								
5	48		Entire Project																																								
PROJECT TOTALS				400	770	30	3074	3025		4	297	129				1'	1'																										

Δ Included In Surfacing Plan • Actual "H" = 3'-6" ° Actual "H" = 12'-0"

1 - Reset Mailbox Structure

440 Lin. Ft. Curb Type 6 (Section M)

NO REVISIONS 7-7-77

ALL DIMENSIONS IN INCHES UNLESS NOTED OTHERWISE




STANDARD M-604-B-A

(JUNE 1, 1967)

(SPECIAL FOR THIS PROJECT ONLY)



FEDERAL ROAD DISTRICT NO.	DIVISION	PROJ. NO.	SHEET NO.	TOTAL SHEETS
VIII	COLORADO	RF 034 - 1(16)	13	

REVISIONS	REVISIONS
(R-1) 9-13-67	Grate Detail & Quantities
(R-2) 12-18-67	Connect to skewed culvert, General Note
(R-3) 7-19-68	Note B, Dept. Name
(R-4) 4-15-71	Conc. in G. Note and table. Re-do grate welds.
(R-5) 5-24-71	Lower fastener bolt so top is flush w. conc.
(R-6) 4-3-74	"H" to flow line in table. WWF in Gen'l. N.
(R-7) 11-19-74	Grate Install. Dimensions. Quantities.
(R-8) 7-3-75	Added alt. WWF.

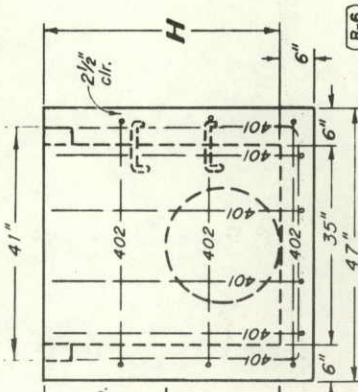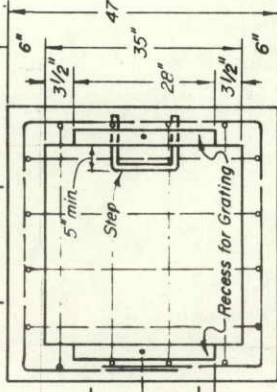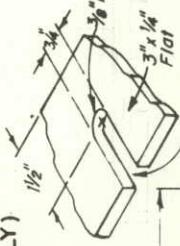

BAR LIST FOR H₂6' AND BENDING DIAGRAM

MARK	NO. REQ'D	HGT. "U"	LENGTH
401	2	2'-3"	7'-11"
401	6	2'-7"	8'-7"
402	3		15'-0"

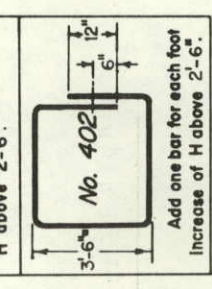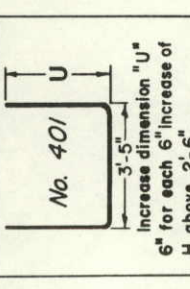

QUANTITIES FOR ONE INLET


H	CONCRETE (CU. YDS.)	REIN. STEEL (LBS.)	NO. STEPS
2'-6"	0.9	75	0
3'-0"	1.0	80	0
3'-6"	1.2	96	0
4'-0"	1.3	101	1
4'-6"	1.4	116	2
5'-0"	1.5	122	2
5'-6"	1.7	137	2
6'-0"	1.8	142	3
6'-6"	1.9	158	3
7'-0"	2.0	163	3
7'-6"	2.2	179	4
8'-0"	2.3	184	4
8'-6"	2.4	199	4
9'-0"	2.5	205	5
9'-6"	2.7	220	5
10'-6"	3.0	235	6
12'-0"	3.4	267	7

* Note: Includes Volume occupied by pipes. (R-3)

GENERAL NOTES

- All work shall be done in accordance with the Standard Specifications applicable to the project.
- All concrete shall be Class A, B or D.
- For detail of Inlet Step, see M-Standard "Steps for Manholes and Inlets".
- All reinforcing bars shall be deformed, of intermediate grade, and shall be lagged with the station number and bar designation.
- All edge distances not marked "clear" are to ϵ of bar.
- Concrete slope and ditch paving shall conform to Section 507.
- Reinforcement for concrete slope paving shall be WWF 4 x 4 - W1.4 x W1.4 or WWF 6 x 6 - W2.1 x W2.1.
- Grating shall conform to Section 604.
- Inlet grating shall be galvanized as described for Frames, Grates, Covers and Steps in Section 712.
- Steps or ladder will be required when Inlet "H" exceeds 3'-6".


NO. PIECES	DESCRIPTION	LENGTH	WEIGHT (LBS.)
4	5/8 x 7/7 Beam	40'	7.70
2	3/4 x 1/4 Flat	26'-3/8"	2.98
2	3" x 1/4 Flat	26'-3/8"	2.55
			TOTAL 12.8 lbs.

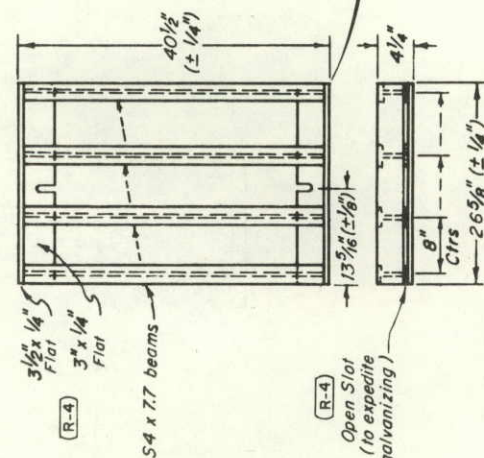


DETAIL OF GRATING

DEPARTMENT OF HIGHWAYS
STATE OF COLORADO
DIVISION OF HIGHWAYS
INLET, TYPE C


Designed by D. B. R.
Approved by J. R. B.
Made by J. R. B.
Checked by R. S. M.
Date: JUNE 1, 1967

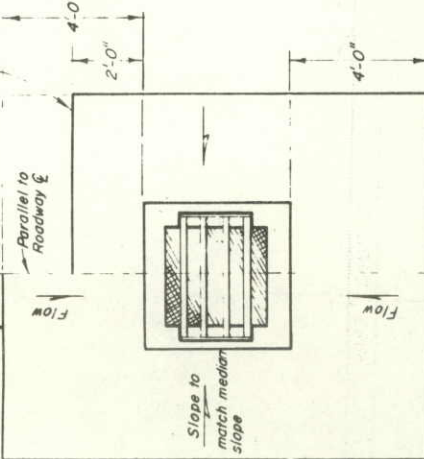



LAYOUT OF INLET IN MEDIAN DITCH

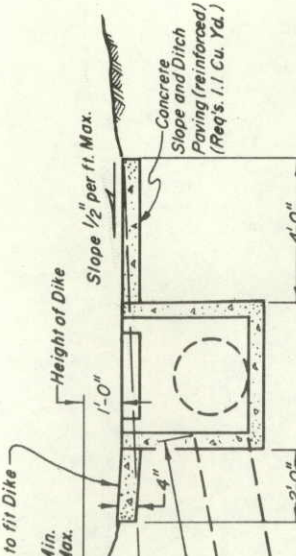


SECTION B-B INLET FOR USE IN MEDIAN ON GRADE (FLOW FROM ONE DIRECTION)

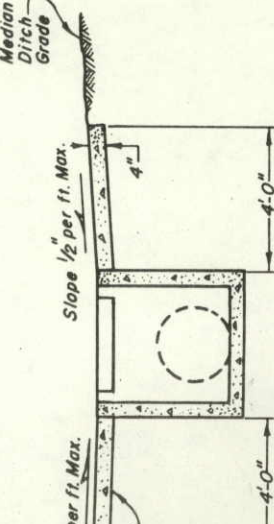

SECTION A-A INLET FOR USE IN MEDIAN AT BOTTOM OF VERTICAL CURVE

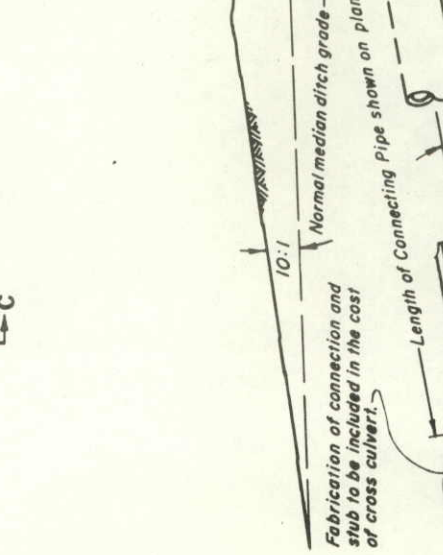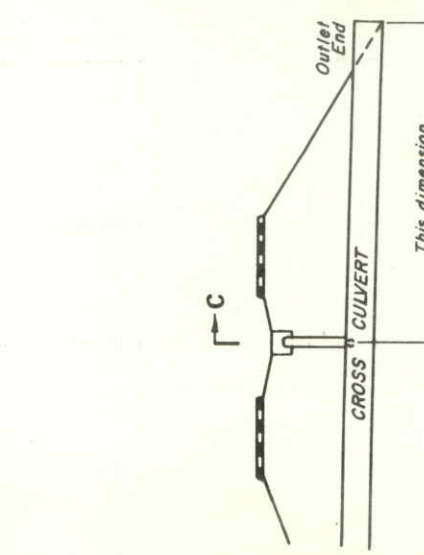

SECTION C-C DETAIL SHOWING MEDIAN INLET CONNECTED TO A CROSS CULVERT

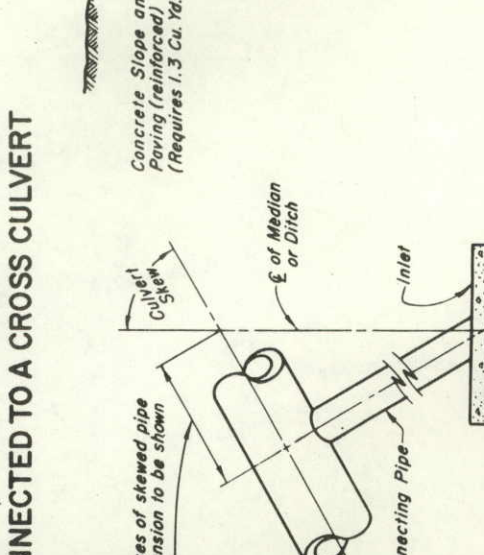


DETAIL SHOWING MEDIAN INLET CONNECTED TO A SKEWED CROSS CULVERT

NO REVISIONS	AS CONSTRUCTED	REVISED	7-7-77	VOID
--------------	----------------	---------	--------	------

DETAILS OF INTERCHANGE

STA. 308+

FEDERAL ROAD DISTRICT NO.	DIVISION	PROJ. NO.	SHEET NO.	TOTAL SHEETS
VIII	COLORADO	RF034-1 (16)	14	

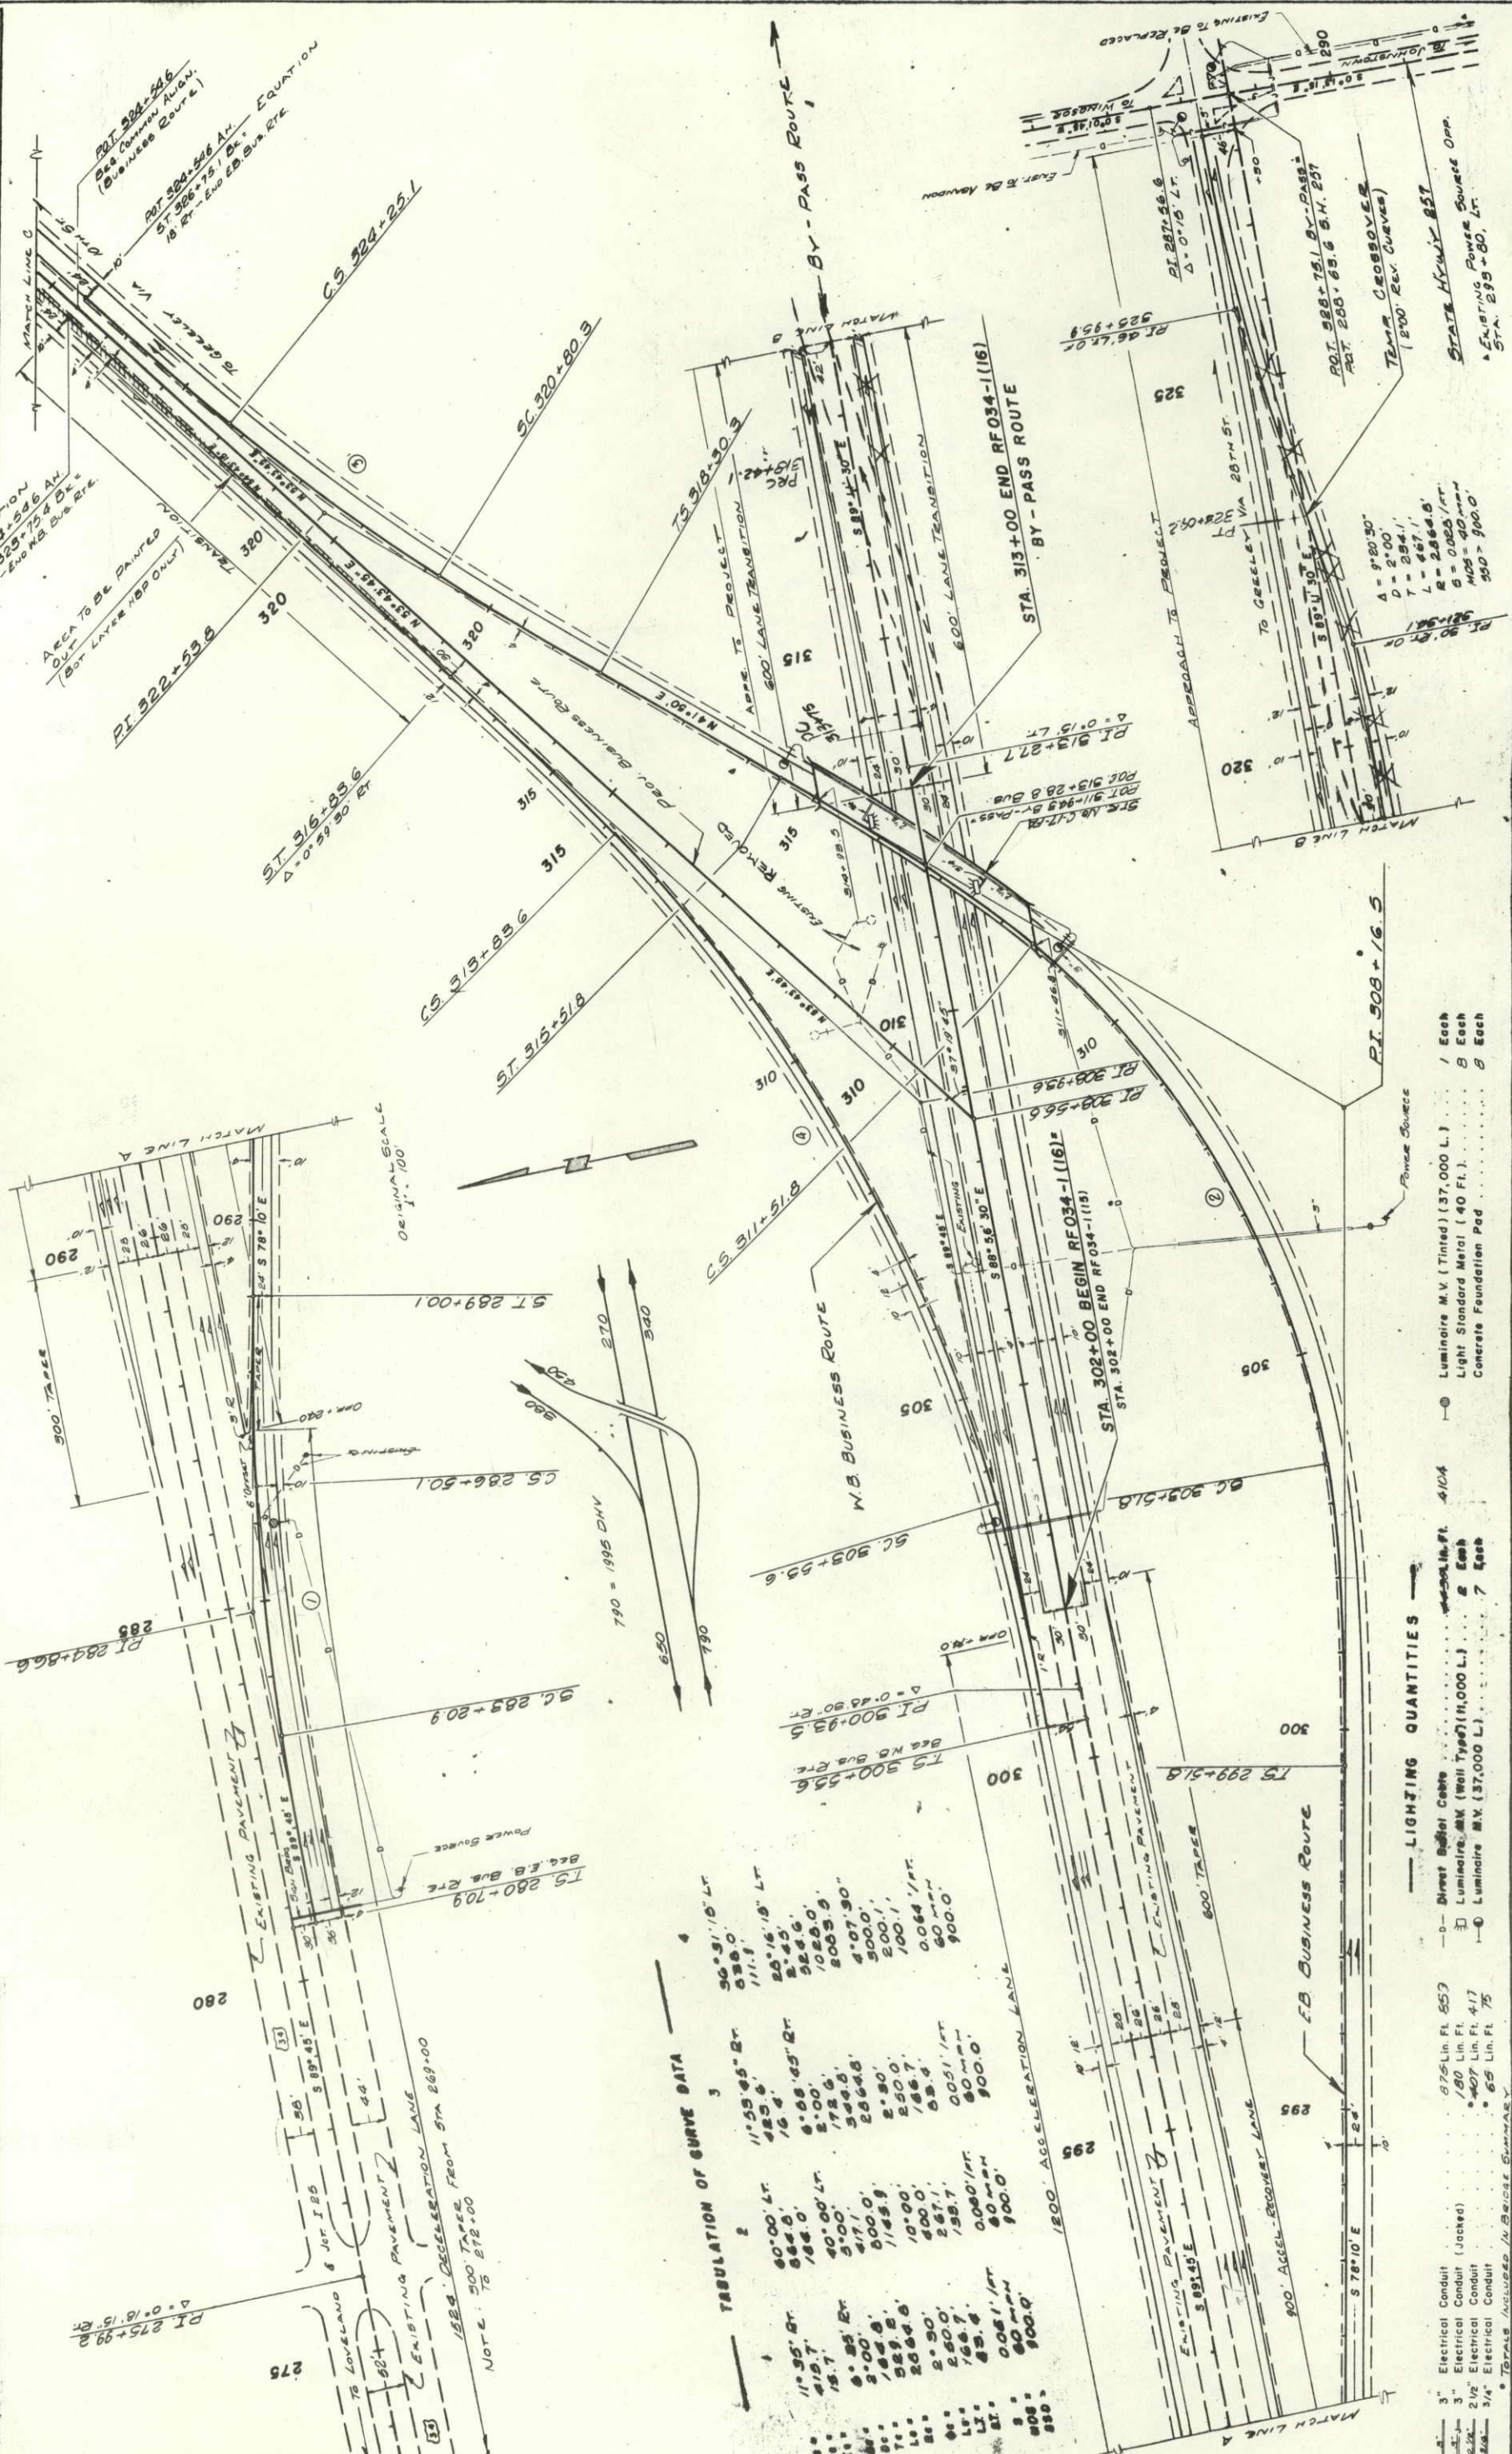

TABULATION OF CURVE DATA									
1		2		3		4		5	
11° 35' 27"	418.7	40° 00' 27"	164.0	11° 55' 45" 27"	425.4	16° 4	164.4	11° 55' 45" 27"	425.4
15.7	9.85 27"	5° 00'	172.6	5° 00'	172.6	5° 00'	172.6	5° 00'	172.6
2° 00'	184.8	41° 1	344.8	2° 00'	184.8	2° 00'	184.8	2° 00'	184.8
5° 00'	184.8	5° 00'	184.8	5° 00'	184.8	5° 00'	184.8	5° 00'	184.8
10° 00'	184.8	10° 00'	184.8	10° 00'	184.8	10° 00'	184.8	10° 00'	184.8
15° 00'	184.8	15° 00'	184.8	15° 00'	184.8	15° 00'	184.8	15° 00'	184.8
510° 00'	184.8	510° 00'	184.8	510° 00'	184.8	510° 00'	184.8	510° 00'	184.8
515° 00'	184.8	515° 00'	184.8	51					


LIGHTING QUANTITIES

ITEM	QU
------	----

NO REVISIONS	AS CONSTRUCTED
	REVISED 7-7-77
	VOID

DETAILS OF INTERSECTION $\diamond$ STA. 333+

FEDERAL ROAD DISTRICT NO.	DIVISION	PROJ. NO.	SHEET NO.	TOTAL SHEETS
VIII	COLORADO	RF034-1(16)	15	

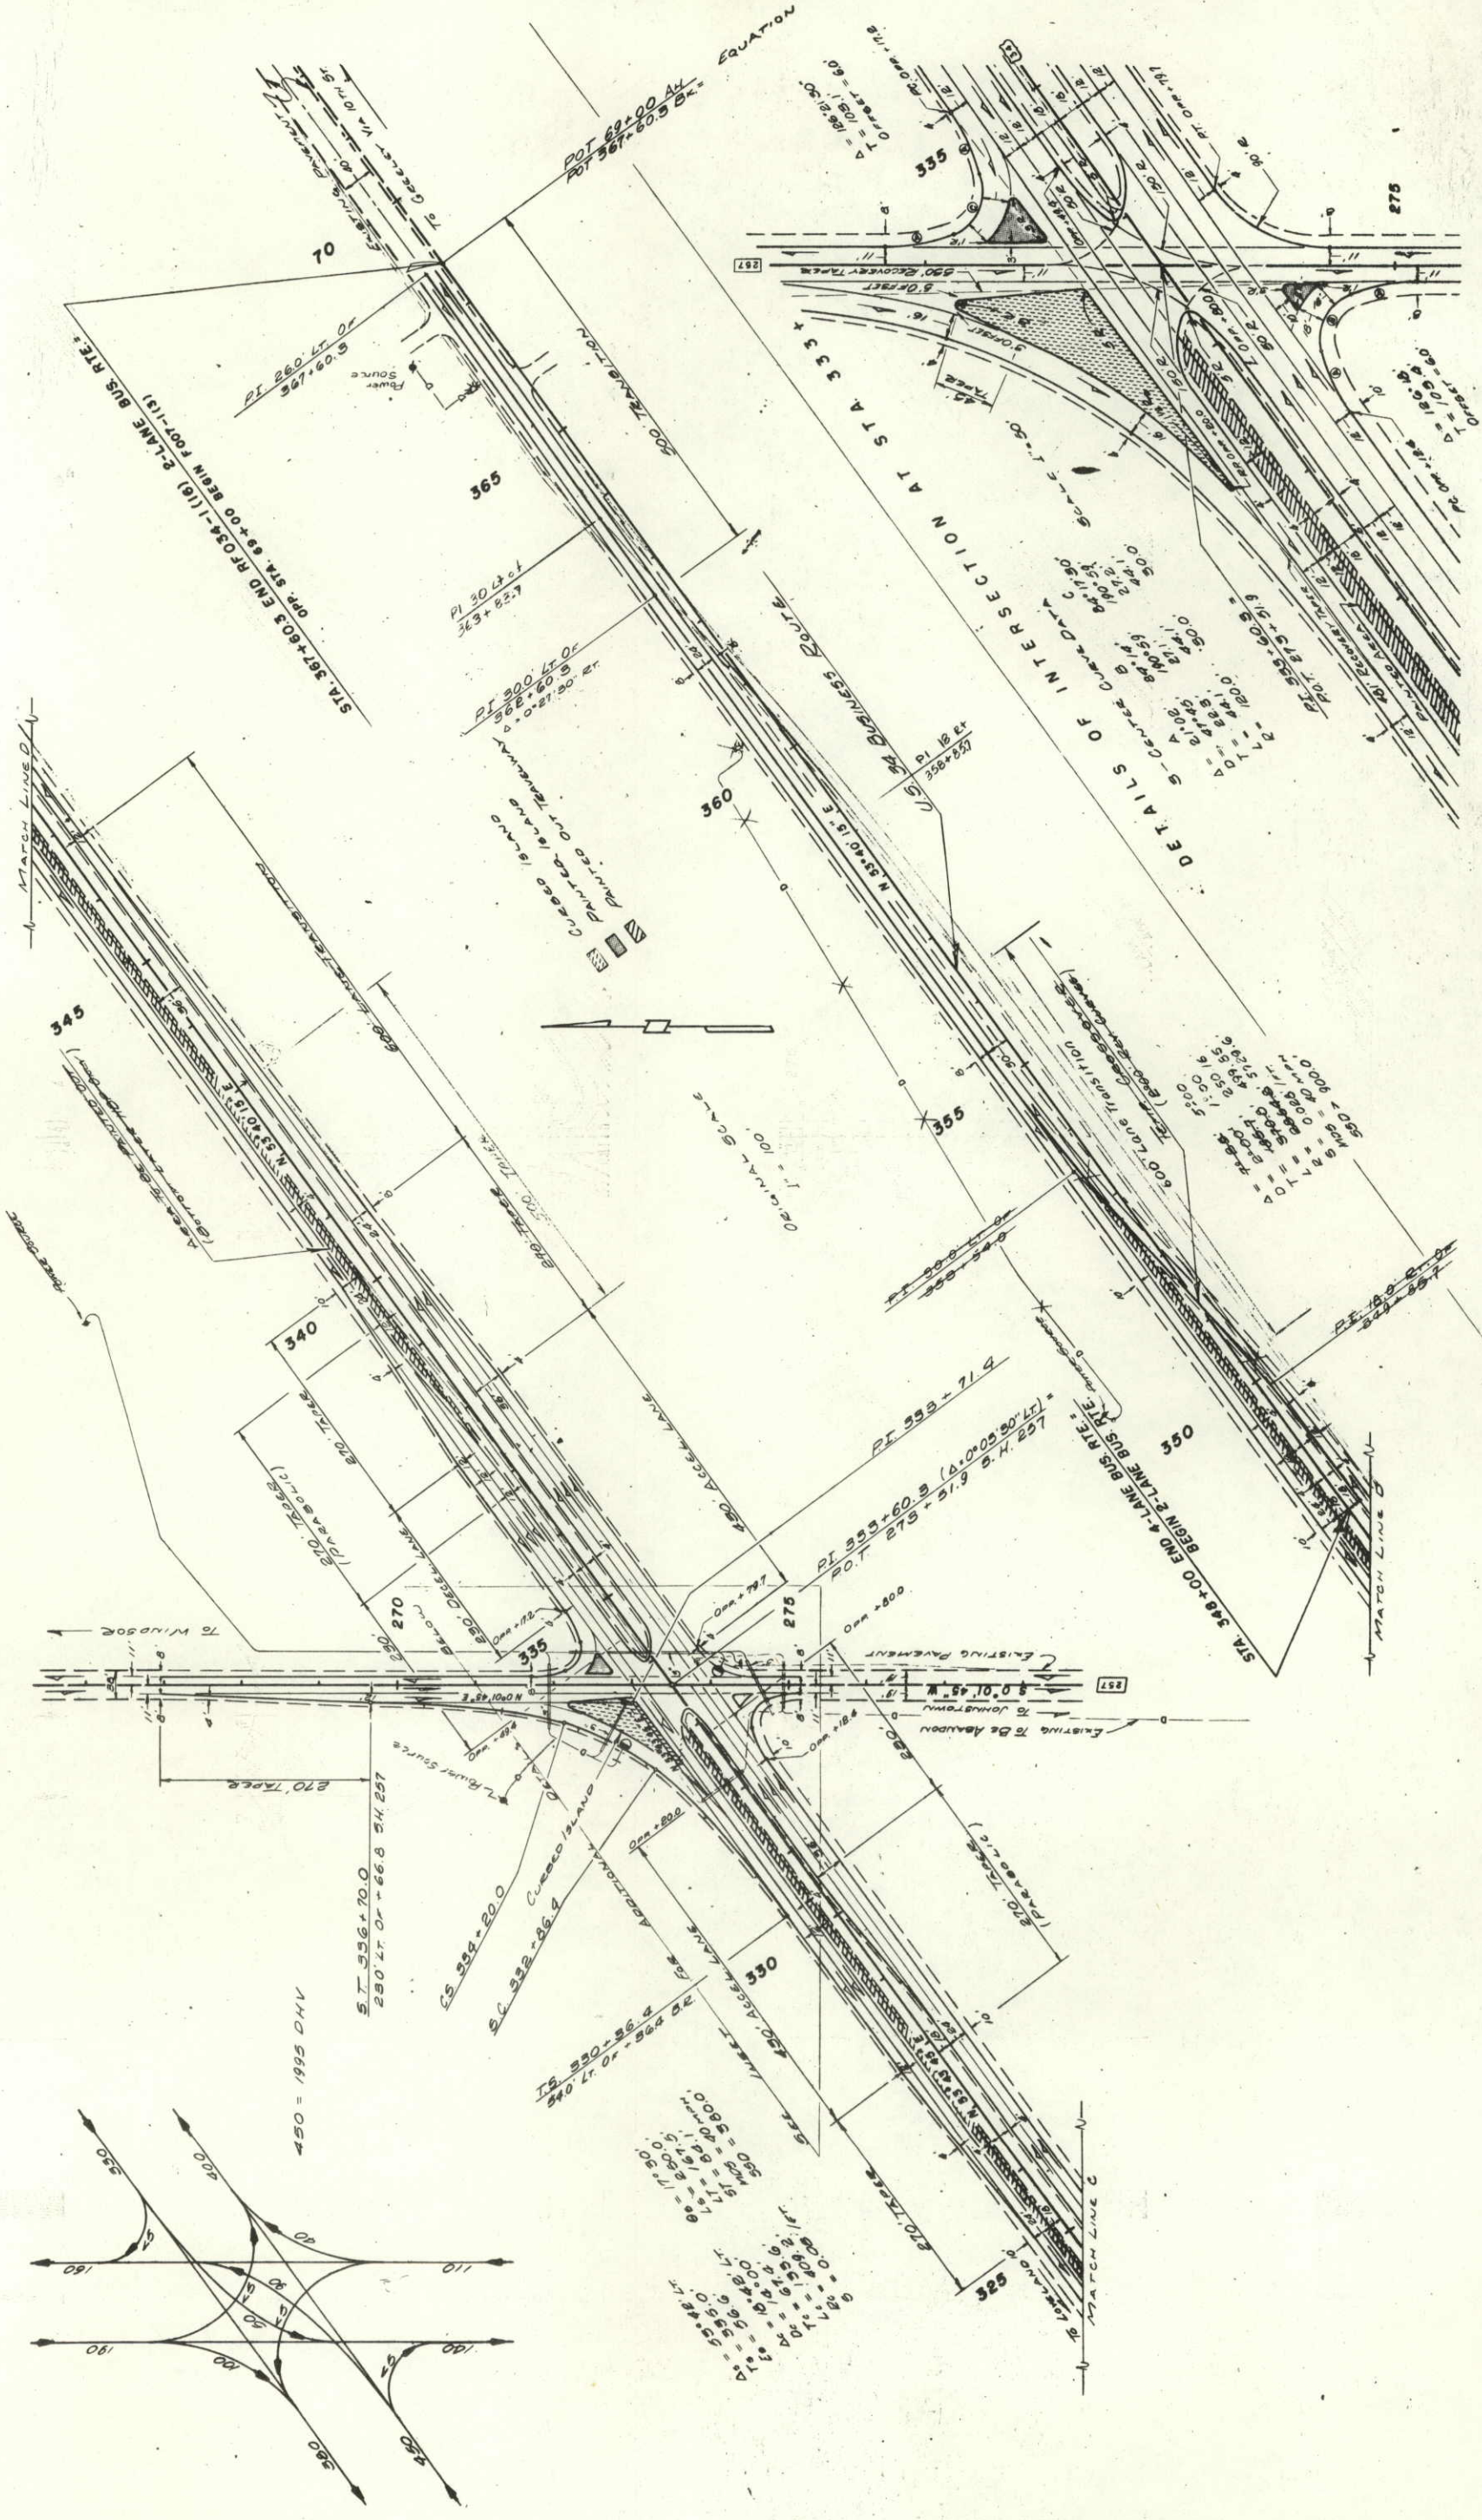

GENERAL NOTES

ALL WORK SHALL BE DONE ACCORDING TO THE STANDARD SPECIFICATIONS OF THE DIVISION OF HIGHWAYS, STATE OF COLORADO, APPLICABLE TO THE PROJECT.

ALL CONCRETE SURFACES MARKED WITH THE SYMBOL ∇ AS SHOWN ON DRAWING NO. B-8.9, 10, 11 SHALL RECEIVE A CLASS 5 SURFACE FINISH.

ALL CONCRETE CHAMFERS SHALL BE 3/4" UNLESS OTHERWISE NOTED.

EXPANSION JOINT MATERIAL SHALL MEET A.A.S.H.T.O. SPECIFICATION M-213-65. IT SHALL NOT BE PAID FOR SEPARATELY BUT WILL BE INCLUDED IN THE WORK.

SOUNDINGS AND DEPTH OF FOOTINGS ARE IN ACCORDANCE WITH THE BEST AVAILABLE DATA. WHEN DIFFERENT CONDITIONS ARE ENCOUNTERED, THE BRIDGE ENGINEER WILL INSPECT AND DETERMINE IF REDESIGN IS NECESSARY.

WHEN EXCAVATING FOR FOOTINGS, THE FINAL SIX INCHES IN DEPTH SHALL BE DONE BY HAND LABOR METHODS.

FOOTINGS IN ROCK SHALL NOT BE FORNED BUT SHALL BE PLACED AGAINST UNDISTURBED ROCK.

FOR DETAILS OF STRUCTURE EXCAVATION AND STRUCTURE BACKFILL, SEE STANDARD M-206-AA.

ALL STRUCTURAL STEEL NOT OTHERWISE NOTED SHALL BE A.A.S.H.T.O. SPECIFICATION M-183(ASTM A-36).

ALL STRUCTURAL STEEL NOT OTHERWISE NOTED SHALL BE PAINTED IN ACCORDANCE WITH SECTION 509 FOR () PAINT.

ALL BOLTS SHALL BE 3/4" DIAMETER, HIGH STRENGTH, UNLESS OTHERWISE NOTED.

NO WELDING OF ANY KIND SHALL BE PERMITTED ON THE FLANGES OF STEEL GIRDERS UNLESS SPECIFICALLY CALLED FOR ON THE PLANS.

THE FOLLOWING TABLE SHOWS THE MINIMUM LAP FOR COMMON BAR SIZES.

BAR SIZE	NUMBER	4"	5	6	7	8	9	10	11
SPLICE LENGTH	1'-0"	1'-2"	1'-8"	2'-3"	3'-0"	3'-10"	4'-10"	6'-0"	

GRADE 60 REINFORCING STEEL REQUIRED FOR #5 BARS AND LARGER

GRADE 40 OR GRADE 60 MAY BE FURNISHED FOR #4 BARS.

E. F. = EACH FACE
N. F. = NEAR FACE
F. F. = FAR FACE



LOCATION OF CONSTRUCTION JOINTS SHALL BE APPROVED BY THE ENGINEER.

EMBANKMENT MUST BE IN PLACE BEFORE STRUCTURAL EXCAVATION IS MADE.

LOADING DATA

LIVELOAD: A.A.S.H.T.O. HS-20-44 OR INTERSTATE ALTERNATE
DEADLOAD: ASSUMES 25 LBS. PER SQ. FT. FOR BITUMINOUS PAVEMENT

DESIGN DATA

A.A.S.H.T.O. 1973 UNIT STRESSES, EXCEPT AS NOTED

REINFORCED CONCRETE: #5 BARS & LARGER, $f_s = 24,000$ PSI
EXCEPT #4, $f_s = 20,000$ PSI IN TRANSVERSE
#4 BARS, $f_s = 20,000$ PSI
 $f_c = 1,200$ PSI $n = 10$

STRUCTURAL STEEL: A.A.S.H.T.O. M183(ASTM A-36) $f_s = 20,000$ PSI
A.A.S.H.T.O. M223(ASTM A-572) $f_s = 27,000$ PSI

BRIDGE STANDARD -0-

AS CONSTRUCTED

NO REVISIONS

REVISED 7-7-77 VOID

FEDERAL ROAD DISTRICT NO.	DIVISION	PROJECT NO.	SHEET NO.	TOTAL SHEETS
VIII	COLORADO	RF034-1(16)	16	
REVISIONS				

FINAL SUMMARY OF QUANTITIES

DESCRIPTION	UNIT	STRUCTURE NO. C-17-FA				4	TOTAL	Ref.
		SUPER-STRUCTURE	ABUT. 1	PIER 2	ABUT. 3	RETAINING WALLS		
206 STRUCTURE EXCAVATION	CUYD.		97	193	43	1670	543	305
206 STRUCTURE BACKFILL (CLASS 2)	CUYD.		123	104	93			305
403 HOT BITUMINOUS PAVEMENT (GRADING EX)	TON	179				179	179	305-Form 87
502 STEEL PILING (HP10X42)	LIN.FT.		1213		3375		4588	305
502 STEEL PILE CUTOFF	LIN.FT.		159		159		318	305
502 DRILLING HOLE TO FACILITATE PILE DRIVING	LIN.FT.		320		280		600	305
507 CONCRETE SLOPE & DITCH PAVING (REINF. COLORED)	CUYD.		9686		8884		18570	305
509 STRUCTURAL STEEL (GALVANIZED)	Lb.	26596				26596	26596	305
515 WATERPROOFING (MEMBRANE)	SQ.YD.	1635				1635	1635	305
518 BRIDGE COMPRESSION JOINT SEALER	LIN.FT.					24	24	305
601 CONCRETE CLASS A (BRIDGE)	CUYD.		298	1366	176		184	305
601 CONCRETE CLASS S (BRIDGE)	CUYD.	1193.1	62.0		54.9		1310	305
602 REINFORCING STEEL	Lb.	198507	9095	27028	7544	242174	245230	305
613 2 1/2" INCH ELECTRICAL CONDUIT	LIN.FT.	407417				407417	407417	305
613 3/4" INCH ELECTRICAL CONDUIT	LIN.FT.	6575				6575	6575	305
618 PRESTRESSING STEEL WIRE OR STRAND	Lb.	78026				78026	78026	305
626 MOBILIZATION	LS							

THIS ITEM INCLUDES FURNISHING, PLACING IN THE CONCRETE, AND POST-TENSIONING THE PRESTRESSING STEEL. THE CONTRACTOR SHALL FURNISH ALL STRESSING EQUIPMENT AND ACCESSORIES REQUIRED FOR INSTALLATION AND STRESSING OPERATIONS. WEIGHT SHALL NOT BE REMEASURED, BUT SHALL BE THE QUANTITY SHOWN.

BRIDGE DESCRIPTION

OVER U.S. 34 (BYPASS)
2 SPANS (180'-0", 163'-0")
POST-TENSIONED CONCRETE BOX GIRDER BRIDGE
29°13' 30" SKEW
42'-0" ROADWAY CURB TO CURB
1'-3" CURBS, BRIDGE RAIL TYPE 5



Approved
P. C. Vavarek, Jr.
Bridge Engineer Date 9/5/76

DIVISION OF HIGHWAYS


GENERAL INFORMATION
SUMMARY OF QUANTITIES

Station 311+46.80S TO 314+93.44E
Near Greeley Sec. 10, T. 5 N. R. 67 W
Designer M. McMullen
Detailer A. Takigiku
Drawing Number B 1 of 18 Drawings

(11-1-74)


Business Route
 $\Delta_s = 60^\circ 00'$ Lt.
 $\Delta_c = 5^\circ 00'$
 $T_c = 417.1'$
 $L_c = 800'$
 $R_c = 1145.9'$
 $S = 0.080 \frac{1}{in}$

$\Delta_s = 10^\circ 00'$ Lt.
 $\Delta_c = 400.0'$
 $L_c = 267.1'$
 $T_c = 133.7'$
 $S.S.D. > 500'$
 $M.D.S. = 60 \text{ MPH}$

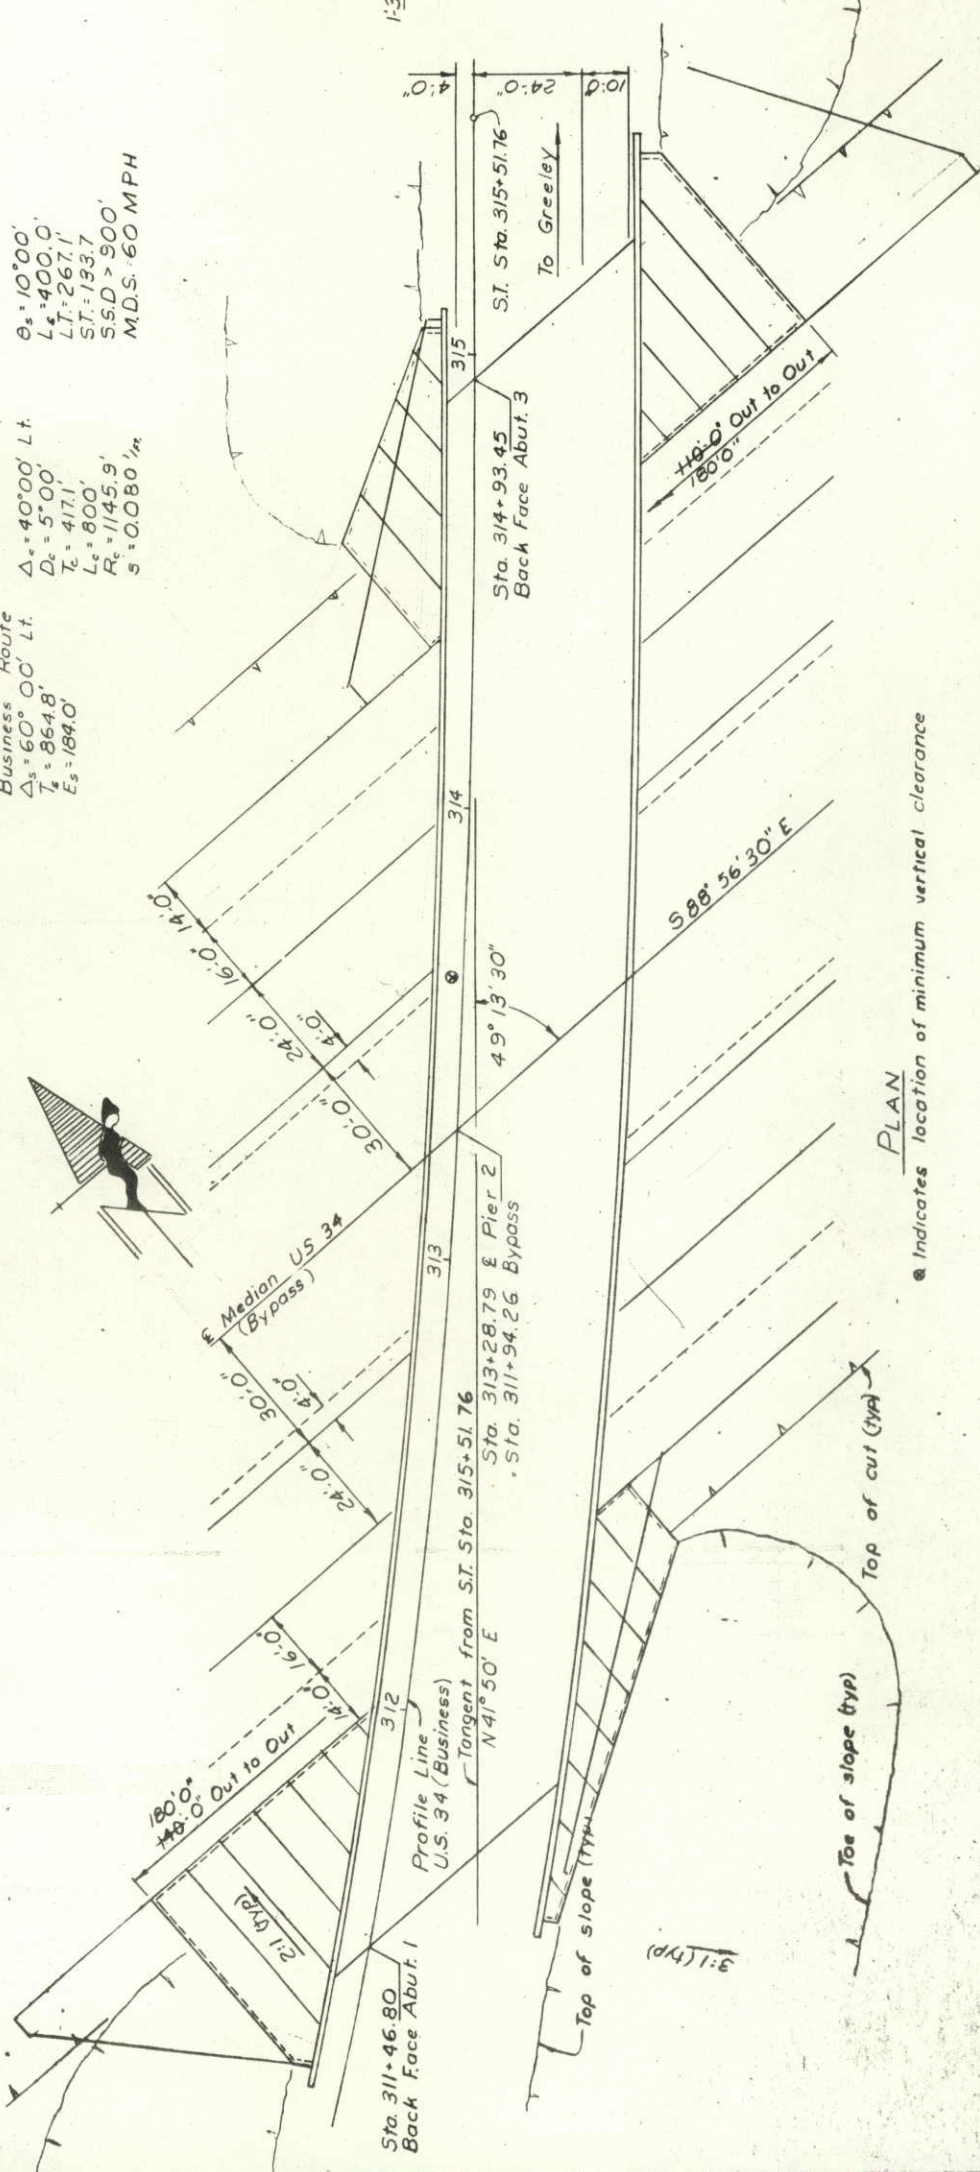


PLAN
Indicates location of minimum vertical clearance

TYPICAL SECTION

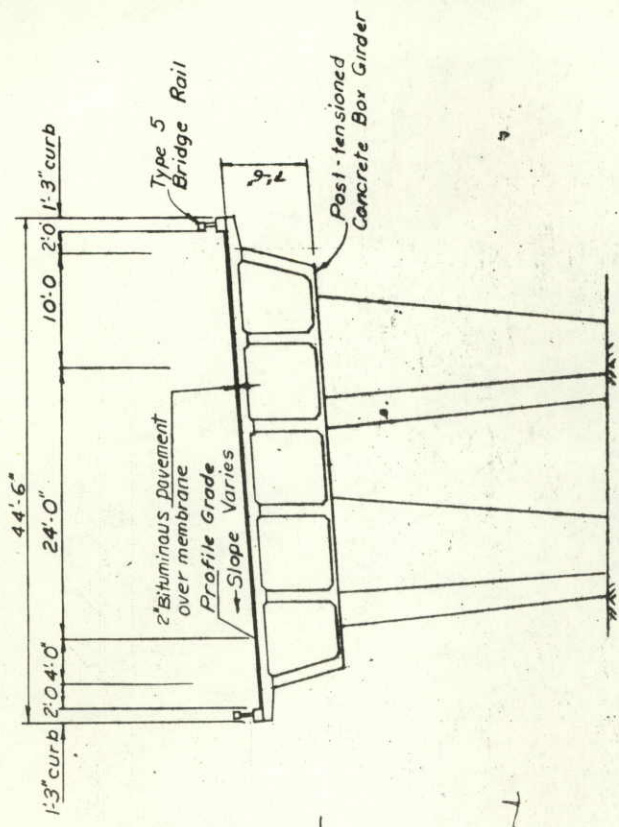

TYPICAL SECTION

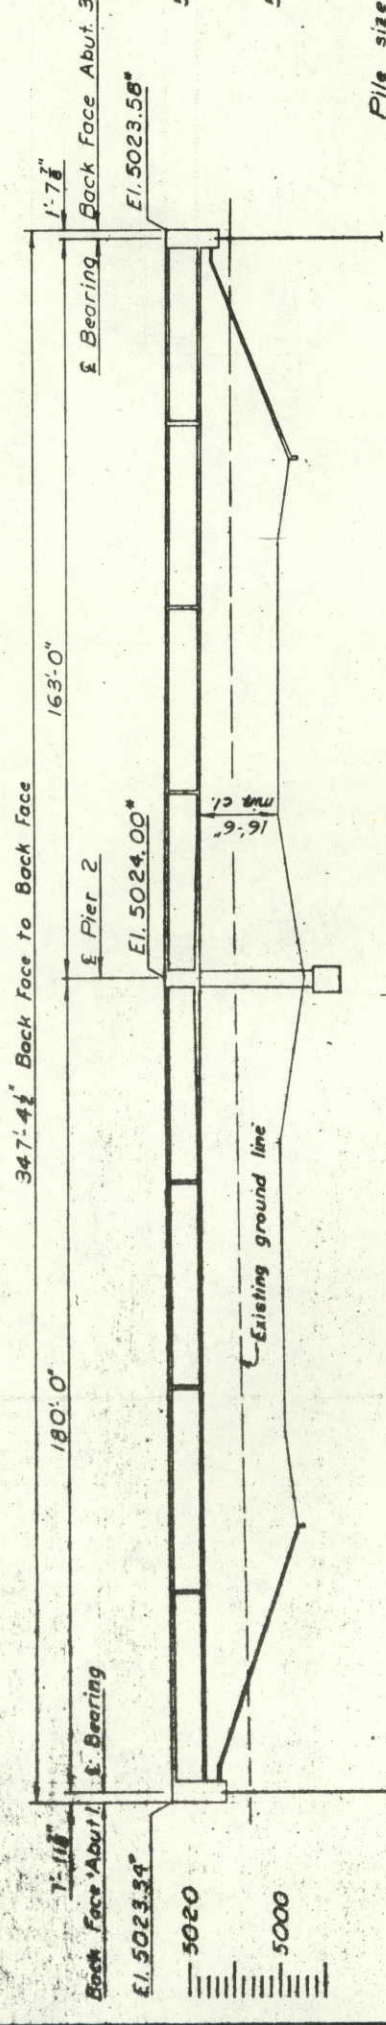

SECTION
(Taken at Profile Line)
* Finished roadway elevation

Pile size Location Est. tip elev.
HP10x42 Abut. 1 4992
HP10x42 Abut. 3 4993
All piles are end bearing

Note: See Sheet #22 for pile tip elevations

DIVISION OF HIGHWAYS

GENERAL LAYOUT

Designer	F. Lundberg	Structure	C-17-FA
Detailer	E. Hadley	Numbers	
Drawing Number	B 2	of	18
Drawings			

Revision Dates (Preliminary Stage Only)

DESIGNED BY	DATE	CHECKED BY	QUANTITIES BY	CHECKED BY
MLM	12-75	RAI	1-76	RAI
RAI	1-76	RAI	2-76	RAI
RAI	2-76	RAI	2-76	RAI

2/ 20 PT.= 2	NORTH OUT CL WEB 1 PROFILE CL WEB 2 CL WEB 3 CL WEB 4 CL WEB 5 CL WEB 6 SOUTH OUT TANGENT	314+38.190 5023.5260 314+41.529 5023.8779 314+45.090 5023.8351 314+48.633 5023.8664 314+52.033 5023.9270 314+55.163 5024.0063 314+58.163 5024.0663 314+62.642 5024.5350 314+66.556 5024.7757 314+70.414 5024.9944 314+74.597 5025.0890 314+78.597 5025.9598
3/ 20 PT.= 2	NORTH OUT CL WEB 1 PROFILE CL WEB 2 CL WEB 3 CL RD MY CL WEB 4 CL WEB 5 CL WEB 6 SOUTH OUT TANGENT	313+46.391 5023.5370 313+49.705 5023.6822 313+53.240 5023.8321 313+56.758 5023.9764 313+60.747 5024.2479 313+64.218 5024.3752 313+67.675 5024.4350 313+71.075 5024.7239 313+74.368 5024.9290 313+77.534 5025.0173 313+80.810 5023.9180
4/ 20 PT.= 2	NORTH OUT CL WEB 1 PROFILE CL WEB 2 CL WEB 3 CL WEB 4 CL WEB 5 CL WEB 6 SOUTH OUT TANGENT	313+54.590 5023.5455 313+57.880 5023.6840 313+61.390 5023.8268 313+64.827 5024.0214 313+68.277 5024.3418 313+71.714 5024.4566 313+75.147 5024.6698 313+78.547 5024.8613 313+81.941 5024.9432 313+85.441 5024.9432 313+88.841 5023.9161
5/ 20 PT.= 2	NORTH OUT CL WEB 1 PROFILE CL WEB 2 CL WEB 3 CL RD MY CL WEB 4 CL WEB 5 CL WEB 6 SOUTH OUT TANGENT	313+62.786 5023.5517 313+66.054 5023.6835 313+69.540 5023.8192 313+73.011 5023.9492 313+76.491 5024.1926 313+80.000 5024.3060 313+83.541 5024.4139 313+87.080 5024.6133 313+90.554 5024.7688 313+94.080 5024.8668 313+97.514 5023.8937
6/ 20 PT.= 2	NORTH OUT CL WEB 1 PROFILE CL WEB 2 CL WEB 3 CL RD MY CL WEB 4 CL WEB 5 CL WEB 6 SOUTH OUT TANGENT	313+70.980 5023.5554 313+74.226 5023.6805 313+77.690 5023.8211 313+81.140 5024.0214 313+84.580 5024.1615 313+88.000 5024.2679 313+91.409 5024.3689 313+94.807 5024.4689 313+98.286 5024.5685 314+01.714 5024.6685 314+05.140 5024.7688 314+08.514 5023.8709
7/ 20 PT.= 2	NORTH OUT CL WEB 1 PROFILE CL WEB 2 CL WEB 3 CL RD MY CL WEB 4 CL WEB 5 CL WEB 6 SOUTH OUT TANGENT	313+79.172 5023.5568 313+82.398 5023.6752 313+85.840 5023.7967 313+89.269 5023.9126 313+92.690 5024.0280 313+96.090 5024.1280 313+99.482 5024.2274 314+02.862 5024.3215 314+06.291 5024.4236 314+09.680 5024.5236 314+13.080 5024.6236 314+16.480 5023.8474
8/ 20 PT.= 2	NORTH OUT CL WEB 1 PROFILE CL WEB 2 CL WEB 3 CL RD MY CL WEB 4 CL WEB 5 CL WEB 6 SOUTH OUT TANGENT	313+87.362 5023.5557 313+90.568 5023.6675 313+93.990 5023.7819 313+97.400 5023.8908 314+00.841 5024.0061 314+04.291 5024.1161 314+07.720 5024.2217 314+11.140 5024.3274 314+14.560 5024.4336 314+17.980 5024.5396 314+21.400 5024.6456 314+24.820 5024.7513
9/ 20 PT.= 2	NORTH OUT CL WEB 1 PROFILE CL WEB 2 CL WEB 3 CL RD MY CL WEB 4 CL WEB 5 CL WEB 6 SOUTH OUT TANGENT	313+95.550 5023.5523 313+98.737 5023.6574 314+02.140 5023.7647 314+05.531 5023.8666 314+08.940 5024.0539 314+12.350 5024.1350 314+15.760 5024.2397 314+19.170 5024.3447 314+22.580 5024.4497 314+25.990 5024.5547 314+29.400 5024.6597 314+32.810 5023.7977
10/ 20 PT.= 2	NORTH OUT CL WEB 1 PROFILE CL WEB 2 CL WEB 3 CL RD MY CL WEB 4 CL WEB 5 CL WEB 6 SOUTH OUT TANGENT	314+3.735 5023.5465 314+6.905 5023.6452 314+10.264 5023.7447 314+13.614 5023.8440 314+16.964 5024.0134 314+20.314 5024.0920 314+23.664 5024.1652 314+27.014 5024.2387 314+30.364 5024.3122 314+33.714 5024.3857 314+37.064 5024.4592 314+40.414 5024.5327 314+43.764 5023.7713

CL ABUT 3

NORTH OUT CL WEB 1 PROFILE CL WEB 2 CL WEB 3 CL WEB 4 CL WEB 5 CL WEB 6 SOUTH OUT TANGENT	314+11.916 5023.5383 314+15.072 5023.6301 314+18.440 5023.7233 314+21.791 5023.8165 314+25.145 5023.9104 314+28.496 5024.0043 314+31.814 5024.0421 314+35.135 5024.1084 314+38.452 5024.1752 314+41.752 5024.2251 314+45.072 5024.2704 314+48.338 5024.3204 314+51.602 5024.3582 314+54.866 5023.7436
--	--

HF ABUT 3

NORTH OUT CL WEB 1 PROFILE CL WEB 2 CL RD MY CL WEB 4 CL WEB 5 CL WEB 6 SOUTH OUT TANGENT	314+20.100 5023.5277 314+23.238 5023.6129 314+26.590 5023.6990 314+29.933 5023.7794 314+33.285 5023.8642 314+36.591 5023.9252 314+39.907 5023.9898 314+43.216 5024.0492 314+46.510 5024.1084 314+49.810 5024.1672 314+53.110 5024.2260 314+56.410 5024.2848 314+59.710 5024.3436 314+63.010 5023.7146
--	--

END N.WING A3

NORTH OUT	315+3-153 5023.2848
-----------	---------------------

END N.R.W. A3

NORTH OUT	315+13.159 5023.2389
-----------	----------------------

END S.WING A3

SOUTH OUT	315+41.632 5023.1790
-----------	----------------------

END S.R.W. A3

SOUTH OUT	315+51.628 5023.0304
-----------	----------------------

FEDERAL ROAD REGION NO.	DIVISION	PROJ. NO.	SHEET NO.	TOTAL SHEETS
VIII	COLORADO	RF034-1(16)	20	

REVISIONS				

AS CONSTRUCTED

NO REVISIONS 7-77 REVISED VOID

DIVISION OF HIGHWAYS


ELEVATIONS

Designer M. McMullen	Structure Numbers	C-17-FA
Detailer A. Takigiku	S of	Drawings

Revision Dates

(Primary Stage Only)

NO REVISIONS	27-77	REVISED	VOID	AS CONSTRUCTED	FEDERAL ROAD REGION NO.	DIVISION	PROJ. NO.	SHEET NO.	TOTAL SHEETS
					VIII	COLORADO	RF 034-1(16)	21	
REVISIONS									

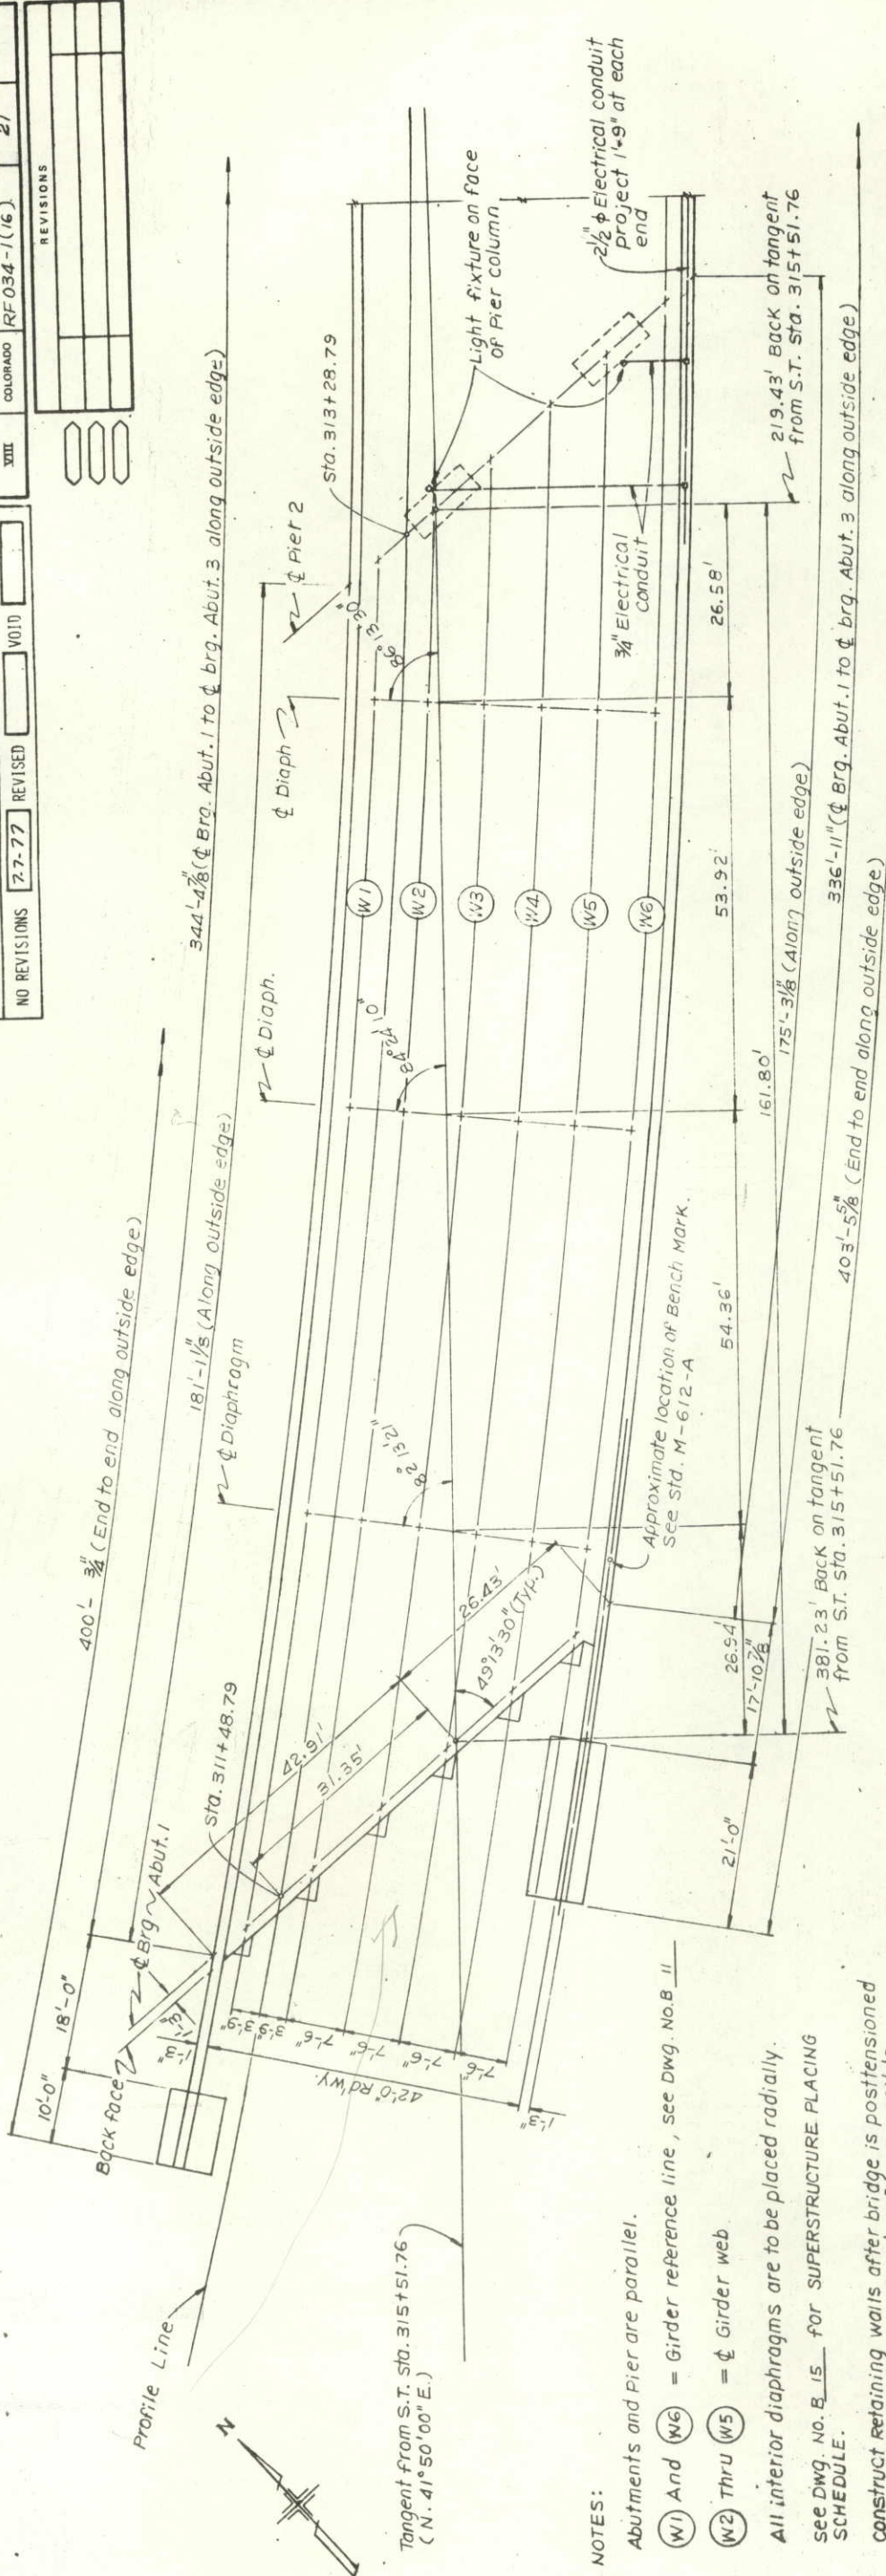

NOTES:

Abutments and Pier are parallel.

(W1) And (W6) = Girder reference line, see Dwg. No. B. 11


(W2) Thru (W5) = ϕ Girder web

All interior diaphragms are to be placed radially.

See Dwg. No. B. 15 for SUPERSTRUCTURE PLACING SCHEDULE.

Construct retaining walls after bridge is positioned and after wings are backfilled as far as possible.

CONSTRUCTION LAYOUT


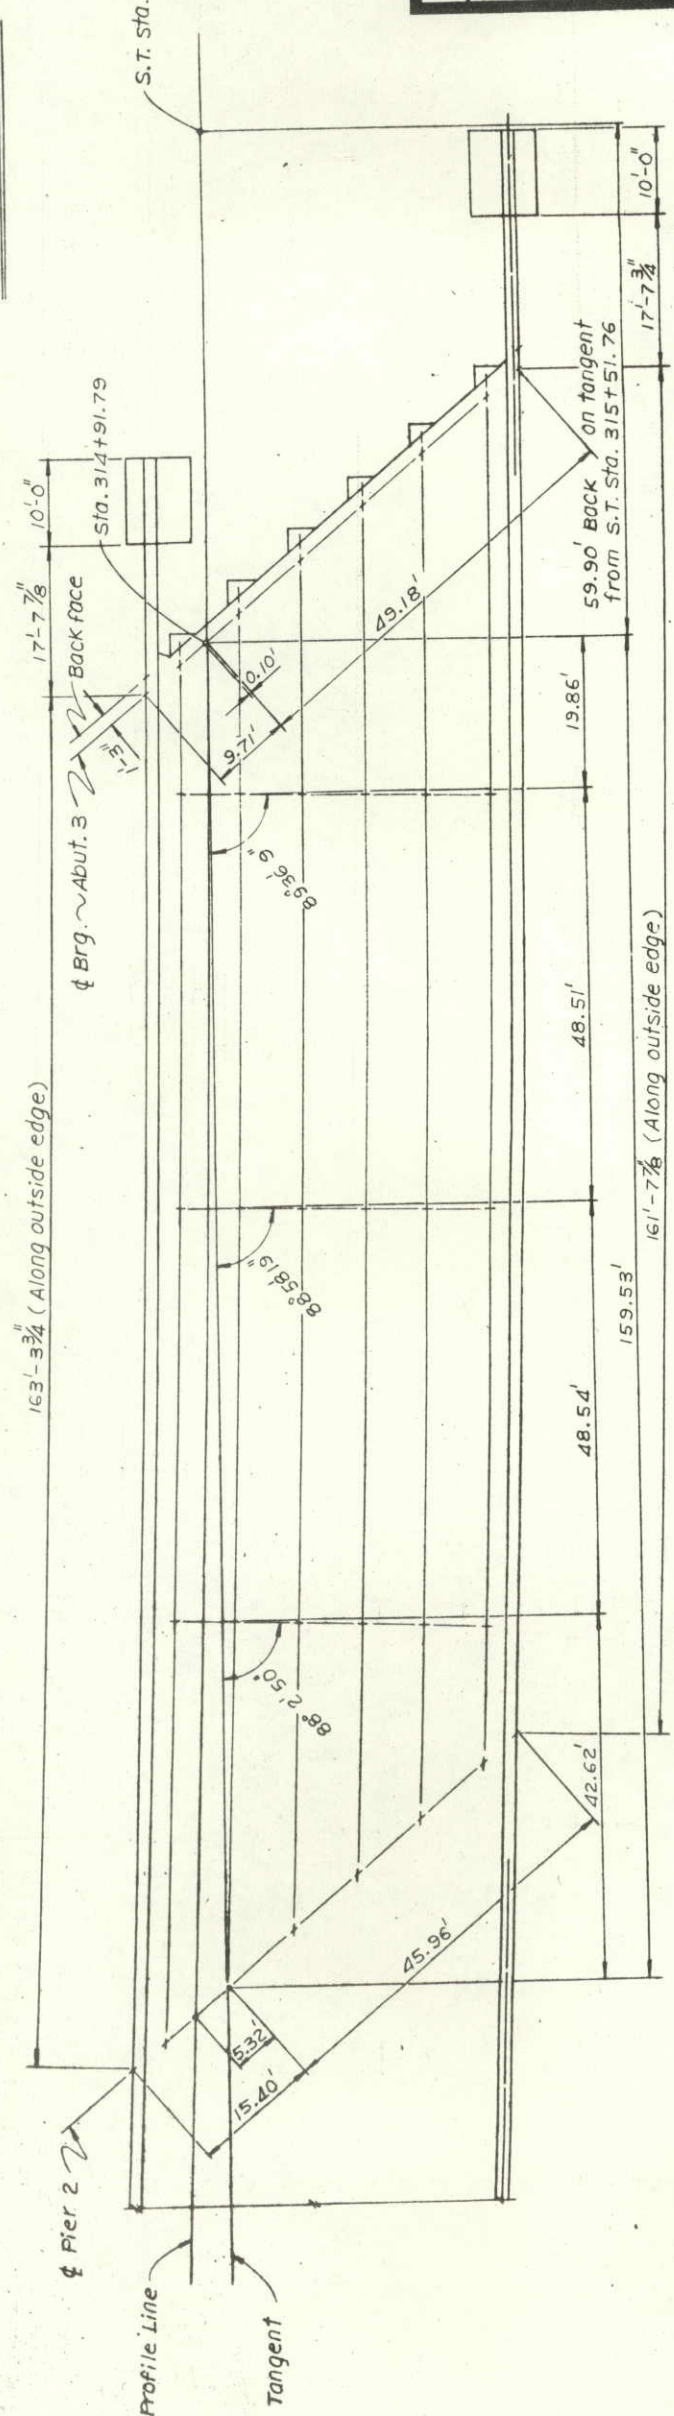


DIVISION OF HIGHWAYS			
CONSTRUCTION LAYOUT			
Designer	M. McMullen	Structure	C-17-FA
Detailer	A. Takigiku	Numbers	
Drawing Number	B 6	of	18
Drawings			
Revision Dates			
(Preliminary Stage Only)			

AS CONSTRUCTED	NO REVISIONS	REVISED	7-7-77	VOID
----------------	--------------	---------	--------	------

FEDERAL ROAD DISTRICT NO.	DIVISION	PROJECT NO.	SHEET NO.	TOTAL SHEETS
XIII	COLORADO	RF 034-1(16)	22	

REVISIONS	DATE	BY
HPH Piling note	4-14-78	

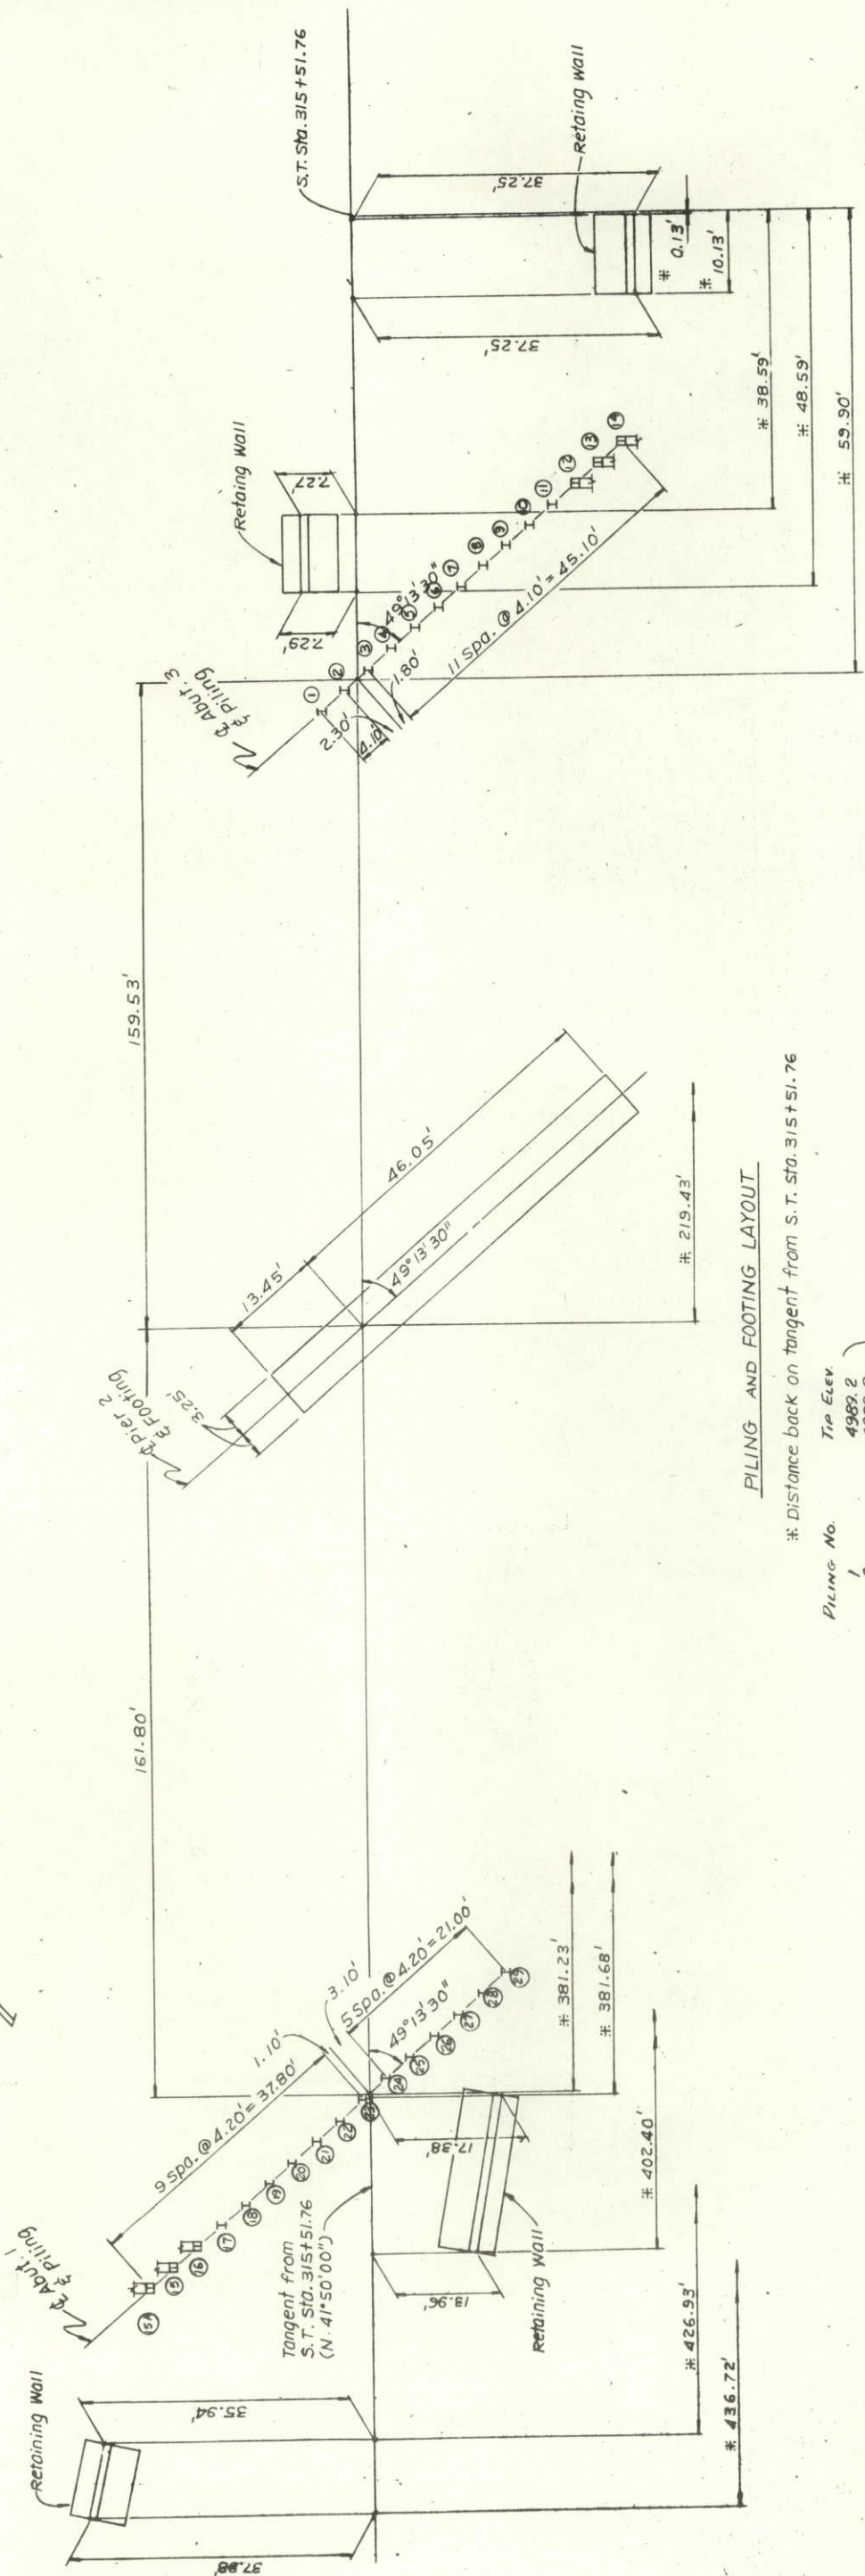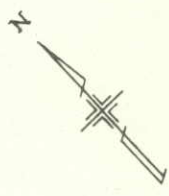

PILING AND FOOTING LAYOUT

Distance back on tangent from S.T. Sta. 315+51.76

Piling No.	Top Elev.
1	4989.2
2	4989.2
3	4989.2
4	4989.5
5	4989.2
6	4989.2
7	4989.2
8	4989.2
9	4989.2
10	4989.2
11	4989.2
12	4989.2
13	4989.2
14	4989.2
15A	4986.9
15	4986.7
16	4986.2
17	4986.1
18	4986.3
19	4987.7
20	4987.8
21	4987.9
22	4987.6
23	4987.3
24	4988.4
25	4988.6
26	4988.5
27	4989.3
28	4989.5
29	4988.9

NOTES:

- (R-1) All piles are HP 10x42, placed in 16" dia. drilled holes 20' deep. Fill holes with bentonite slurry after piling is driven. The web of piling shall be perpendicular to the tangent.
- H Denote piling is placed vertically.
- EH Denote piling is battered 3:12 away from Tangent.
- Max. pile load { Abut. 1 = 51.8 Tons
Abut. 3 = 51.0 Tons
- Max. footing pressure for pier 2 = 5.6 Tons/sq. Ft.
- All dimensions shown are at the bottom of concrete.

DIVISION OF HIGHWAYS	
PILING AND FOOTING LAYOUT	
Designer M. MC HULLEN	Structure Numbers C-17-FA
Detailer A. TAKIGIKU	of 18 Drawings
Drawing Number B 7	

Revision Dates	(Preliminary Stage Only)
----------------	--------------------------


DESIGNED BY	DATE	CHECKED BY
MLM	12-75	FHH
QUANTITIES BY	DATE	CHECKED BY
RRA	1-76	KDH
DETAILS BY	DATE	CHECKED BY
RA	1-76	KDH

NOTES:[illegible]


DIVISION OF HIGHWAYS

ABUTMENT DETAILS


Designer M. McMULLEN	Structure	C-17 - FA
Detailer A. TAKIGIKU	Numbers	
Drawing Number B	3	of 18 Drawings

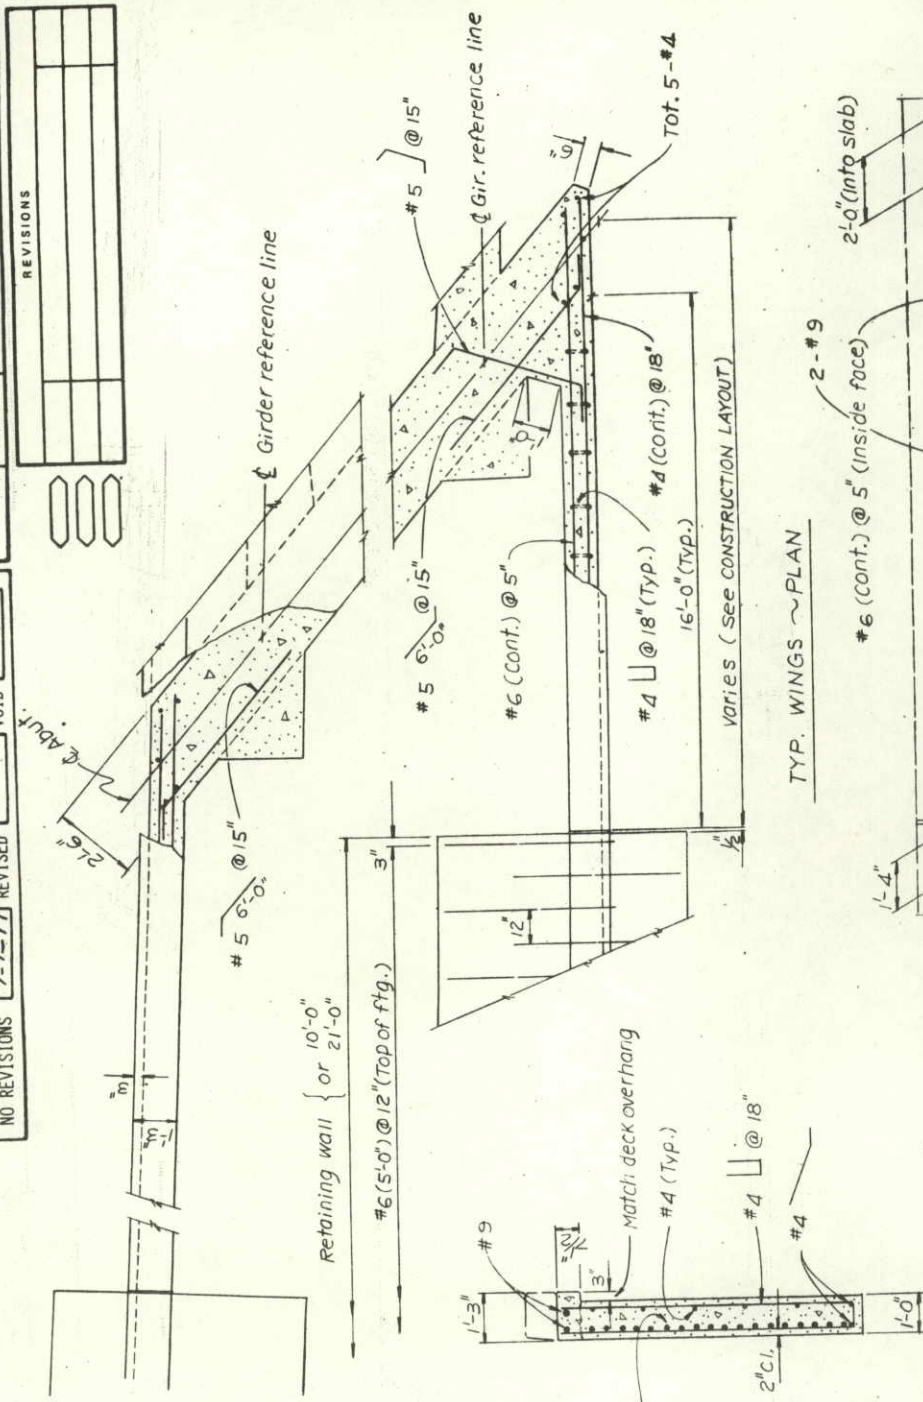

TYP. SECTION THRU WINGWALL

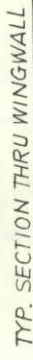

#6

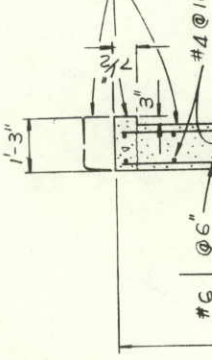

TYP SECTION THRU RETAINING WALL

1	2	3	100
---	---	---	---	---	---	---	---	---	----	----	-----

TYP. SECTION THRU RETAINING

4'-0"

7'-0"

20 - #11 (10'-0") Dowels
19 Equal Spa.


3'-0" (3'-8" Dia.) @ 12"

#4

2'Cl.

#5 (typ.)

Tot. 18 - #11 (in circle)

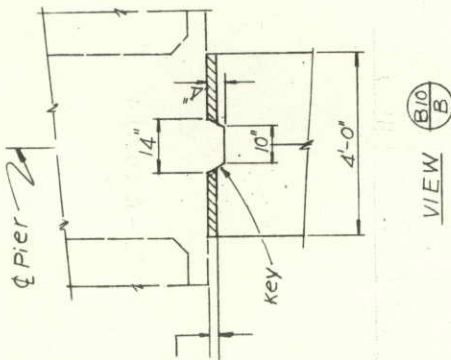

VIEW

$\frac{3}{4} \phi$ Electrical conduit

Approx. location of 4"x4" Junction Box
opposite side on other end.
Lights to be 15'-0" above rdwy. surface

at. 12-#5

t. 18-#11 (From fig.)

99
21

99
21

12-#11 L

Diagram of a horizontal beam with a pin support at the left end and a roller support at the right end. The beam is divided into two equal segments of 15'-0" each by a central point.

4'0"

5'-0"

5'-5"

5'-7"

(Tot. 6-#11.

✓ Tot. 20-#11

21
①

121-0"

50'-0" End to end

59'-6" End to end

HALF PIER $\sim$ ELEVATION

TYP. SECTION NEAR TOP OF COL.

→ ϕ column

TYP. SECTION NEAR BOTTOM OF COL.



TYP. SECTION THRU FOOTING

DIVISION OF HIGHWAYS

PIER 2 DETAILS

Designer M. McMULLEN	Structure Numbers	C-17-FA
Detailer A. TAKI/GIKU Drawing Number B 10 of 18 Drawings		
Preliminary Stage Only		

AS CONSTRUCTED	
NO REVISIONS	7-7-77
REVISED	VOID

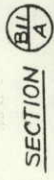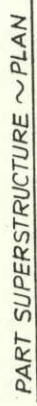

DIVISION OF HIGHWAYS

SUPERSTRUCTURE DETAILS

Designer M. McMULLEN	Structure	C-17-FA
Detailer A. TAKIGIKU	Numbers	
Drawing Number B 11		18 Drawings

TYP. SECTION THRU DIAPH

TYP. SECTION THRU SUPERSTRUCTURE
(section showing radially)

Revision Date:


(Preliminary Stage Only)

1990-1991 10-11 11-12 12-13 542-543


FEDERAL ROAD REGION NO.	DIVISION	PROJ. NO.	SHEET NO.	TOTAL SHEETS
VIII	COLORADO	RF034-1(16)	27	

NO REVISIONS	7-7-77	REVISED	VOID
--------------	--------	---------	------

REVISIONS				

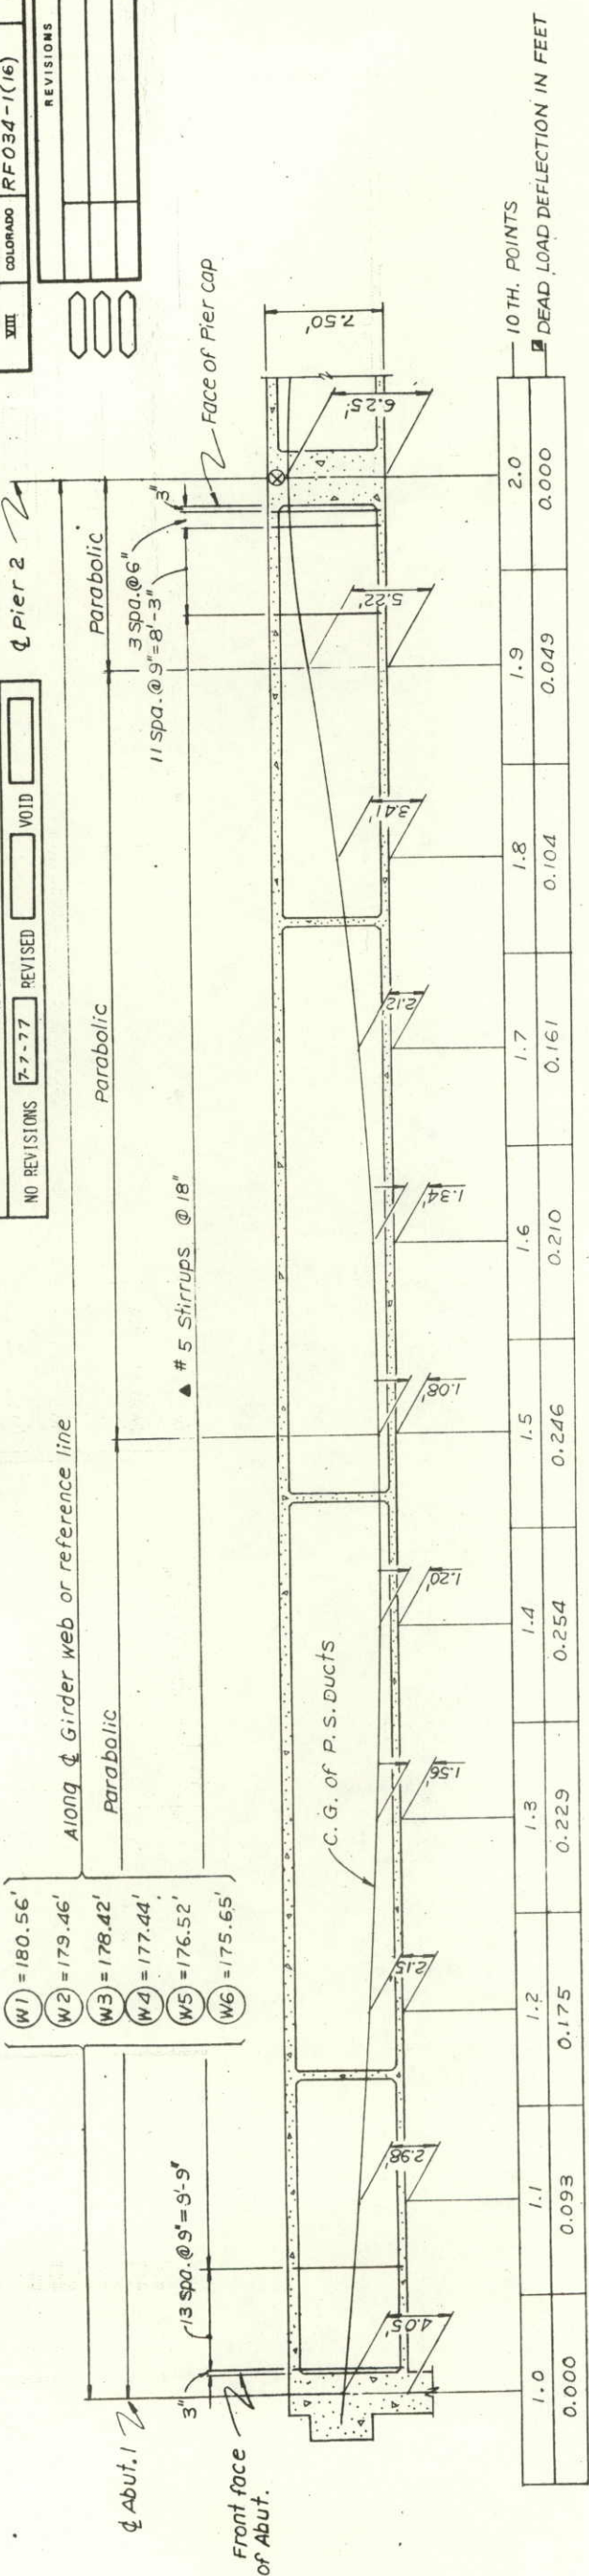

DATE	12-75	CHECKED BY	FHH
DATE	1-76	CHECKED BY	KDH
DATE	2-76	CHECKED BY	KDH
DATE	2-76	CHECKED BY	KDH

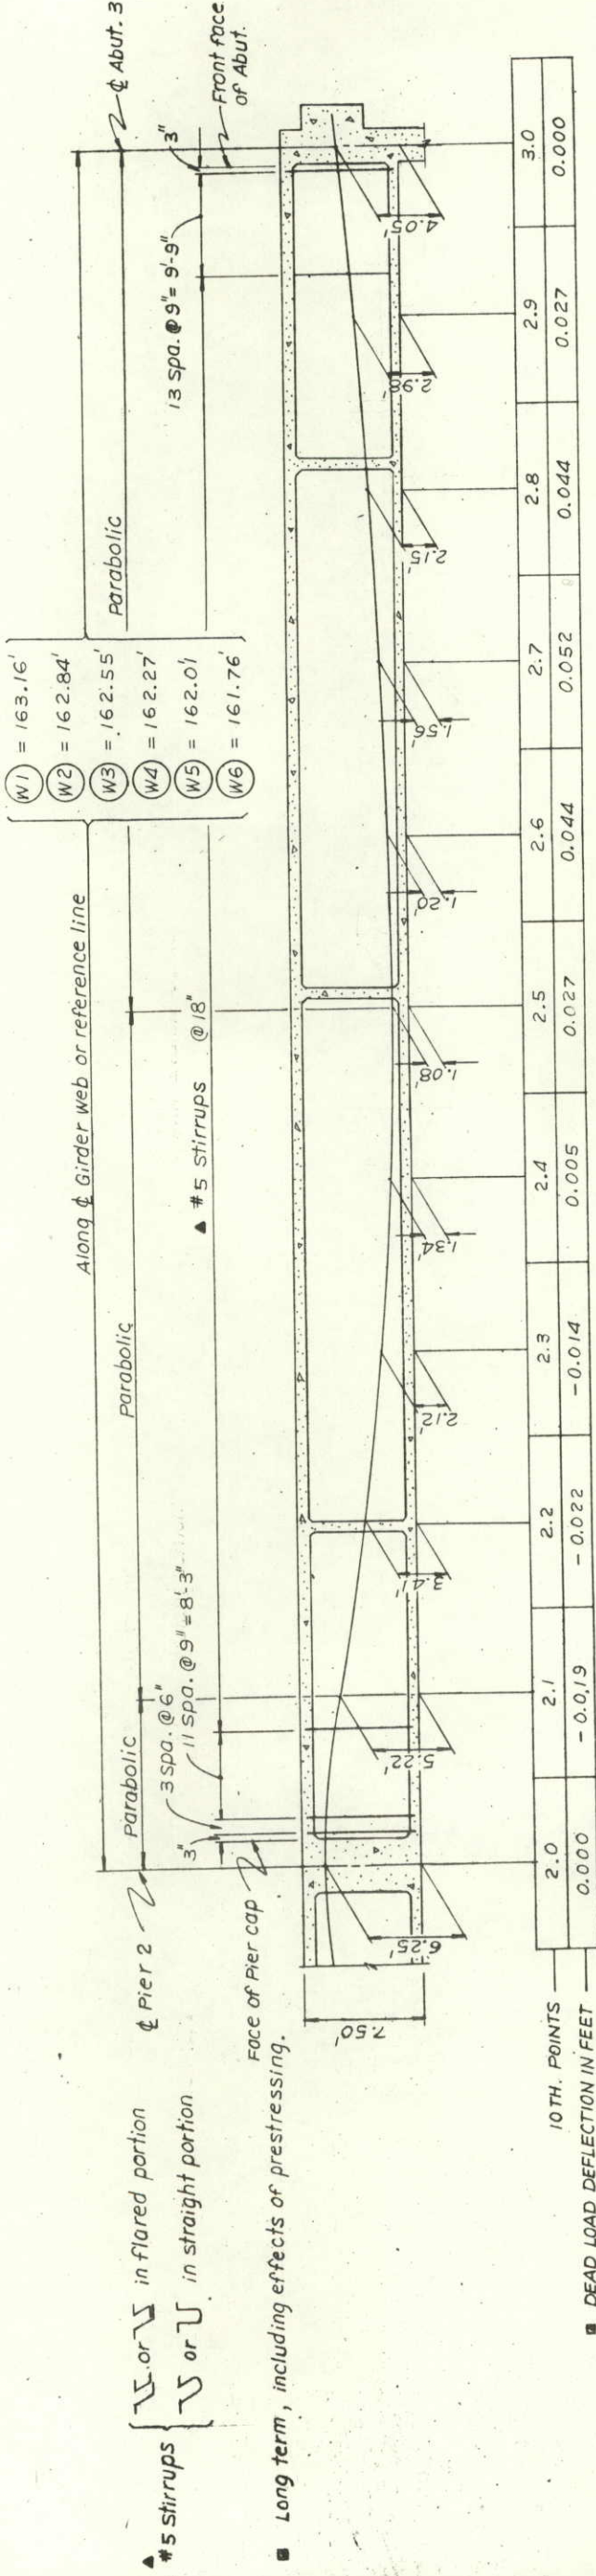

STRESSING NOTES:

JACKING FORCE (P_{JACK}) = 13393 KIPS total at jacking ends, As = $\frac{P_{JACK}}{0.75f'_s}$

CONCRETE: $f'_c = 5000$ psi at 28 days.
 $f'_c = 4000$ psi at time of stressing

- GENERAL:
- Design is based on $\mu = 0.25$ and $K = 0.0002$
P_{JACK} specified at the jacking ends include friction losses and provisions for an additional 32 ksi loss in stress.
 - Tendon to be jacked to 0.75 f's and anchored at an equivalent anchor set = $\frac{5}{8}$ "
 - contractor to submit elongation and jacking calculations based on $\mu \alpha + KL = 0.1125$ (at pier) and initial stress at & Pier 2 = 0.8875 times jacking stress.
 - ⊗ indicates point of minimum prestressing for two end stressing.

TENSIONING STEEL:

At the contractors option the tensioning force may vary $\pm 5\%$ from the theoretical force per girder provided the total force is obtained and is distributed symmetrically about the & of the typical section.
One end stressing is permissible, if approximately 1/2 of the tendons ($\pm 10\%$) are stressed from each end.

TYP. GIRDER WEB ~ ELEVATION

DIVISION OF HIGHWAYS

SUPERSTRUCTURE DETAILS


Designer	M. McMULLEN	Structure	C-17-FA
Detailer	A. TAKIGIKU	Numbers	
Drawing Number	B 12	of	18
		Drawings	

Revision Dates (Preliminary Stage Only)


DESIGNED BY	DATE	CHECKED BY	DATE
KLH 2-76	12-75	KLH 2-76	12-75
KLH 2-76	1-76	KLH 2-76	1-76
KLH 2-76	1-76	KLH 2-76	1-76

AS CONSTRUCTED	VOID
NO REVISIONS	7-7-77
REVISED	

FEDERAL ROAD DISTRICT NO.	PROJ. NO.	SHEET NO.	TOTAL SHEETS
XIII	RF034-1 (16)	28	
DIVISION			
COLORADO			
REVISIONS			

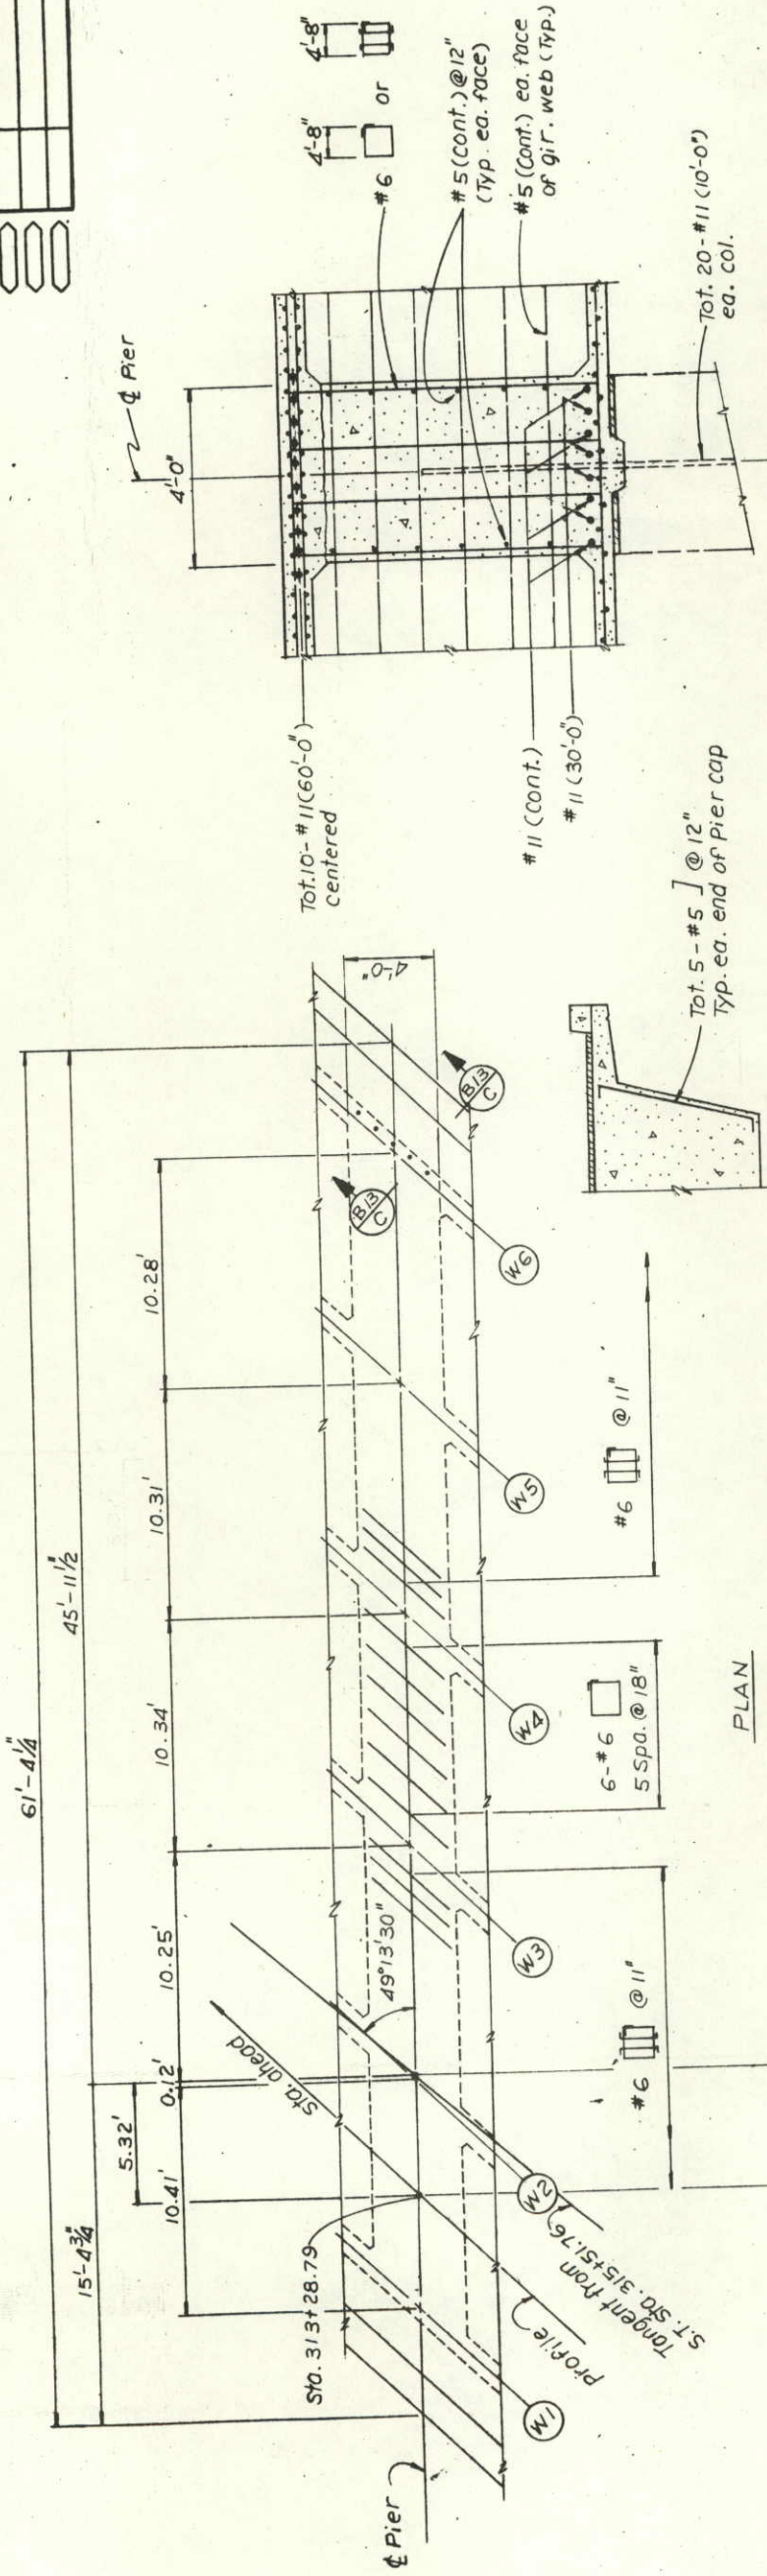

SECT. B/C

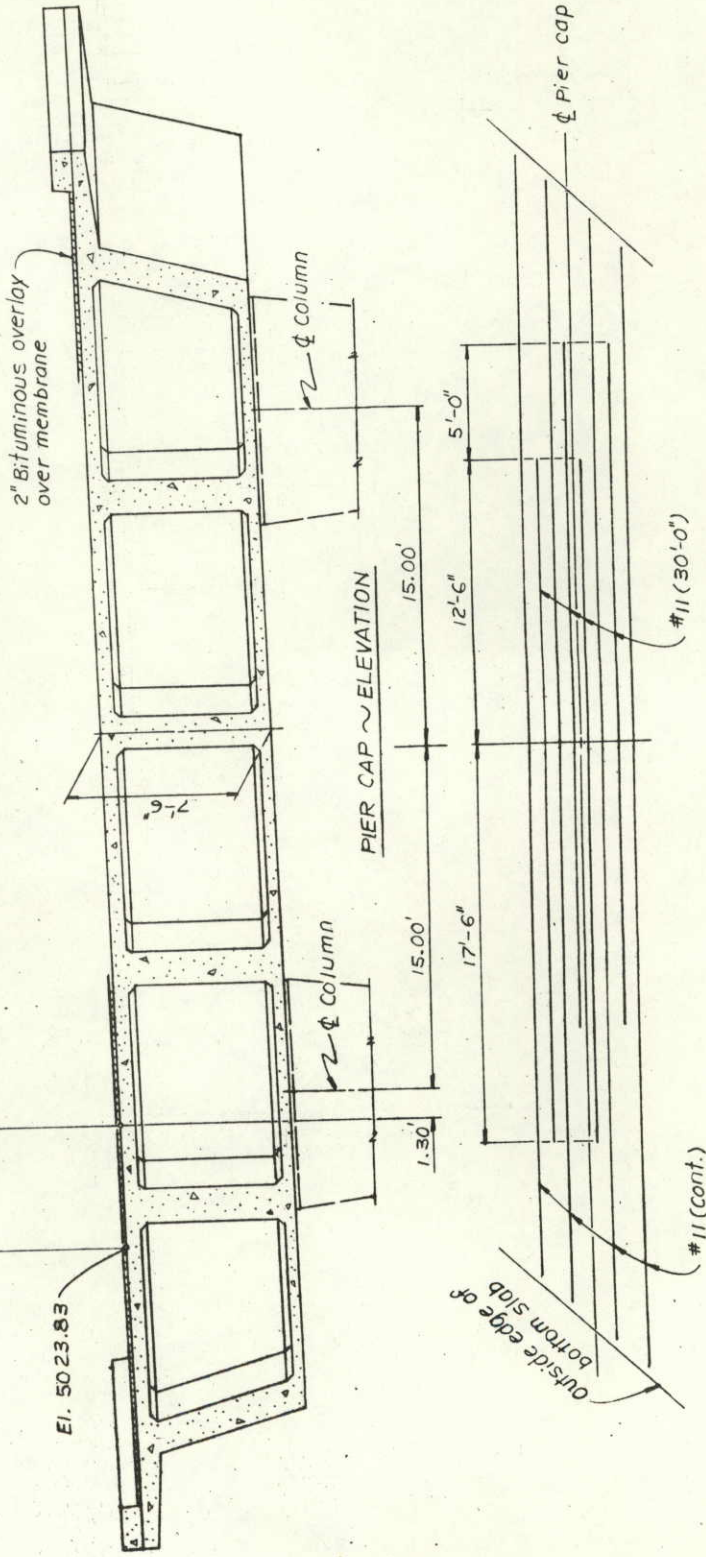

DETAIL OF #11 BARS IN BOTTOM SLAB

TYP. SECTION THRU PIER CAP

DIVISION OF HIGHWAYS

SUPERSTRUCTURE DETAILS


Designer	M. McMullen	Structure Numbers	C-17-FA
Detailer	A. Takigiku	Drawings	18
Drawing Number	B 13	of	18

Revision Dates (Preliminary Stage Only)

NO REVISIONS	AS CONSTRUCTED	REVISED	VOID
--------------	----------------	---------	------


DESIGN NO.	DIVISION	PROJ. NO.	SHEET NO.	TOTAL SHEETS
VIII	COLORADO	RF034-1(16)	29	

REVISIONS	

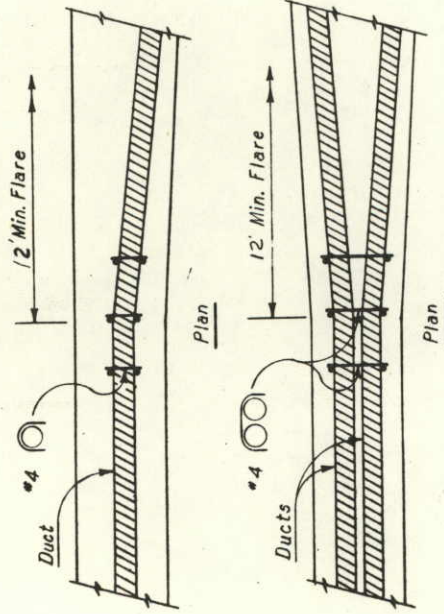

Provide #4 ties for each pair of ducts, or single duct, tie to six stirrups at beginning of duct flare.


ADDITIONAL REINFORCEMENT AT FLARE OF DUCTS

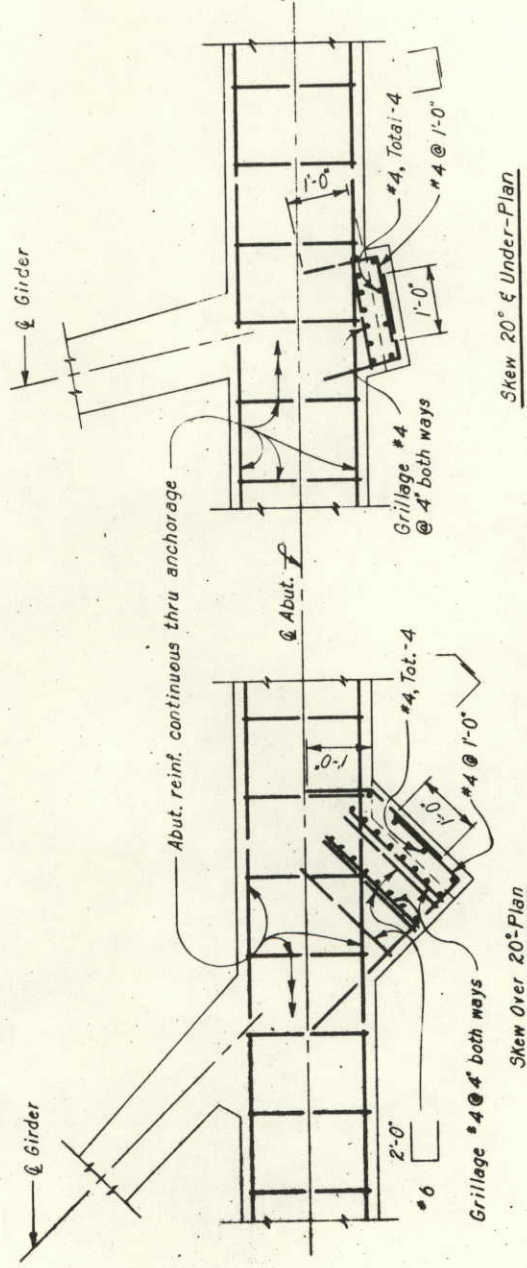

Skew 20° & Under - Plan


Skew Over 20° - Plan

BEARING SEAT FOR PRESTRESSED ANCHORAGE AT ABUTMENTS

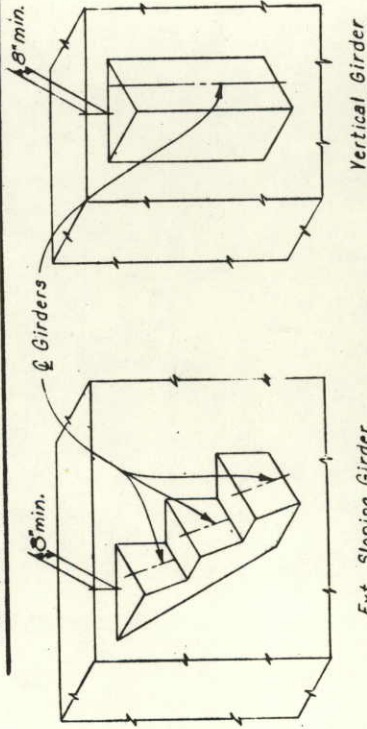


TYPICAL BEARING SEAT ILLUSTRATIONS

Details may be modified to suit specific anchorage.

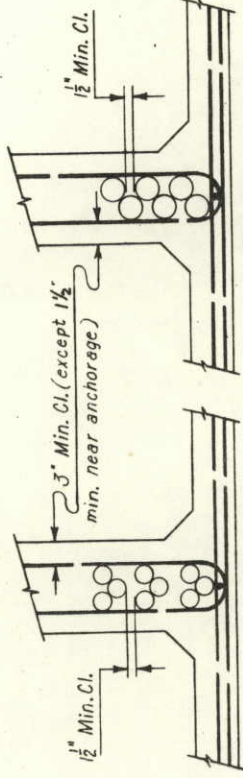

Ducts 3" O.D. & Less
Ducts Over 3" O.D.
& Less Than 4" O.D.

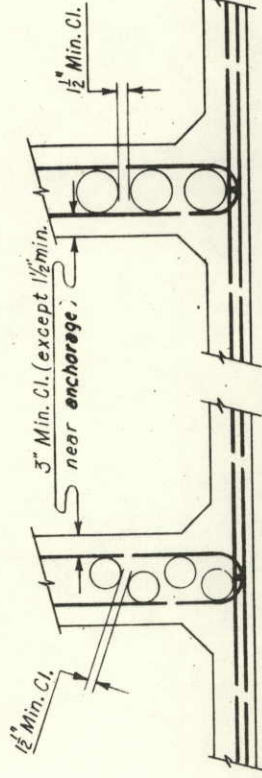

Ducts 4" to 4 1/2" O.D.
Ducts Over 4 1/2" O.D.

CLEARANCE REQUIREMENTS FOR DUCTS

1. DUCT PATTERNS SHOWN ARE FOR A 12" WIDE GIRDER STEM. FOR OTHER WIDTHS THE MINIMUM CLEARANCES MUST BE MAINTAINED.
2. GIRDER STIRRUPS MUST BE BENT TO FIT THE DUCT SIZE USED, OR STIRRUPS MAY BE USED.
3. APPROVAL OF THE ENGINEER IS REQUIRED FOR DEVIATIONS.

NOTES:
1. RECESS FOR ANCHORAGE TO BE FILLED WITH CONCRETE TO PROVIDE A MINIMUM OF 1 1/2" COVER.
2. EDGE DISTANCE OF BEARING PLATES SHALL BE 1 1/2" MINIMUM.

DISTRIBUTION OF PRESTRESSING FORCE:
VARY AT THE CONTRACTOR'S OPTION THE PRESTRESSING FORCE MAY VARY 5% FROM THE THEORETICAL FORCE PER GIRDER PROVIDED THE TOTAL FORCE IS OBTAINED AND IS DISTRIBUTED SYM. ABOUT THE CENTERLINE OF THE TYPICAL SECTION.

STRESSING SEQUENCE:
1. MORE THAN 1/2 OF THE PRESTRESSING FORCE IN ANY GIRDER MAY BE APPLIED BEFORE AN EQUAL FORCE IS STRESSED IN THE ADJACENT GIRDERS. AT NO TIME DURING THE STRESSING OPERATIONS WILL MORE THAN 1/6 OF THE TOTAL PRESTRESSING FORCE BE APPLIED ECCENTRICALLY ABOUT THE CENTERLINE OF THE STRUCTURE.

2. GIRDER STEM SHALL BE FLARED NEAR ANCHORAGE TO PROVIDE A MINIMUM OF 1 1/2" CONCRETE COVERING THE DUCTS, FLARE MAY BE ON ONE SIDE OF GIRDER ONLY.
3. BAR REINFORCEMENT INTERFERING WITH THE PRESTRESSING TENDON ALIGNMENT SHALL BE ADJUSTED, AS APPROVED BY THE ENGINEER.

DIVISION OF HIGHWAYS

CAST IN PLACE PRESTRESSED GIRDER DETAILS

Designer	M. McMillen	Structure Numbers	C-17-FA
Detailer	R.L. Kilpatrick	Number	14
Drawing Number	B	of	18
		Drawings	


(12-1-74)

NO REVISIONS	7-7-77	AS CONSTRUCTED	VOID
		REVISED	

BRIDGE STANDARD


-71-

FEDERAL ROAD DISTRICT NO.	DIVISION	PROJ. NO.	SHEET NO.	TOTAL SHEETS
VIII	COLORADO	RF034-1(16)	30	
REVISIONS				

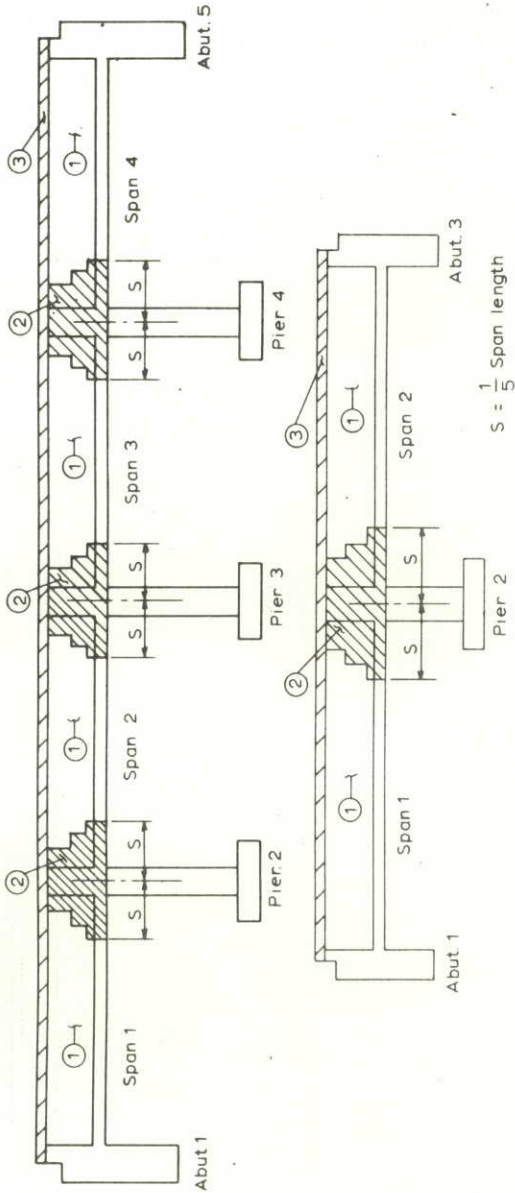


BOX GIRDER SUPERSTRUCTURE PLACING SCHEDULE

Note: Numbers ① and ② indicate sequence of placing bottom slab and girder web concrete when each section constitutes a separate pour. Any combination of ① and ② sections may be placed in one continuous pour. Top slab concrete ③ shall be placed separately from ① and ②. ③ may be placed continuously or in parts, as approved by the Engineer, providing no transverse construction joints fall within the ② areas. Any deviation from the above must be approved by the Engineer.

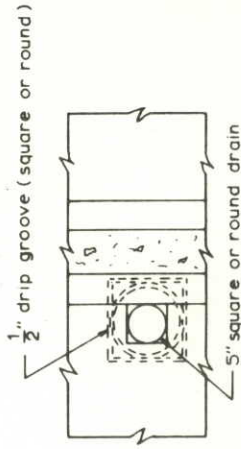


PLAN

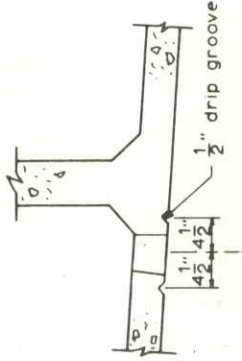

ELEVATION


BOTTOM SLAB DRAIN DETAIL

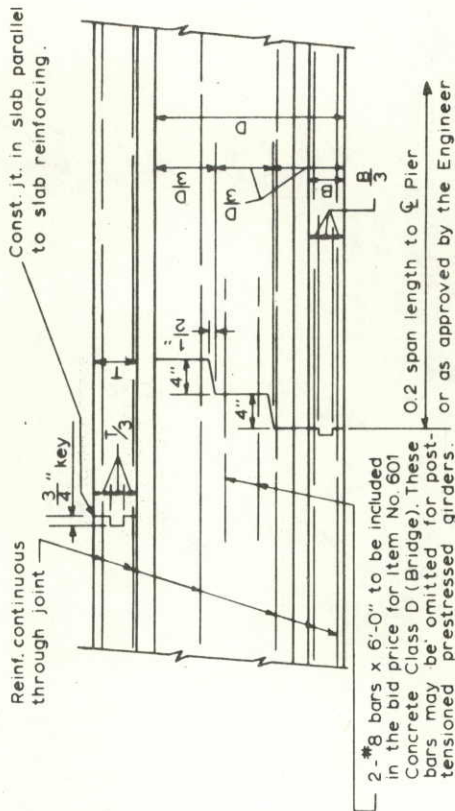

TRANSVERSE GIRDER CONSTRUCTION JOINT

T = Top slab thickness
B = Bottom slab thickness

INTERMEDIATE DIAPHRAGM SECTION

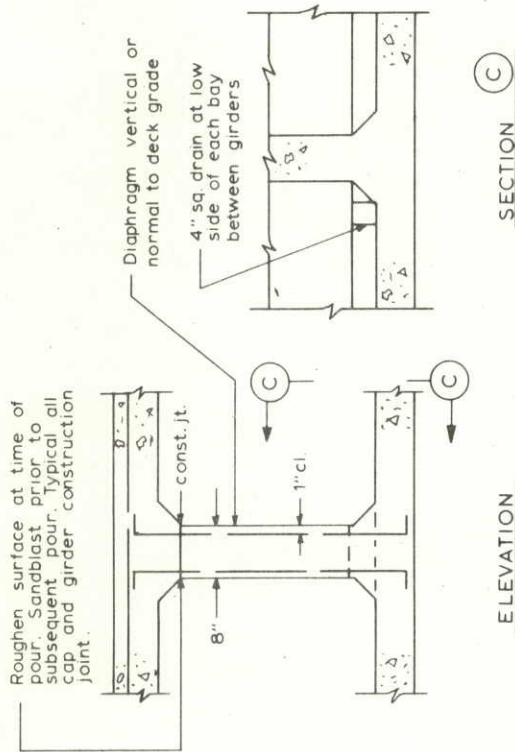

DIVISION OF HIGHWAYS

BOX GIRDER DETAILS

Designer: M. McMullen	Draftsman: A. Takigiku
Structure Number: C-17-FA	
DWG. No. B 15	Of 18

(7-1-74)

Revision Dates

(Preliminary Stage Only)


NO REVISIONS	7 77	REVISED	VOID
--------------	------	---------	------

BRIDGE STANDARD -11-


FEDERAL ROAD DISTRICT NO.	DIVISION	PROJ. NO.	SHEET NO.	TOTAL SHEETS
VIII	COLORADO	RF034-1(16)	31	

REVISIONS	


8'-0" Max. Post Spc.

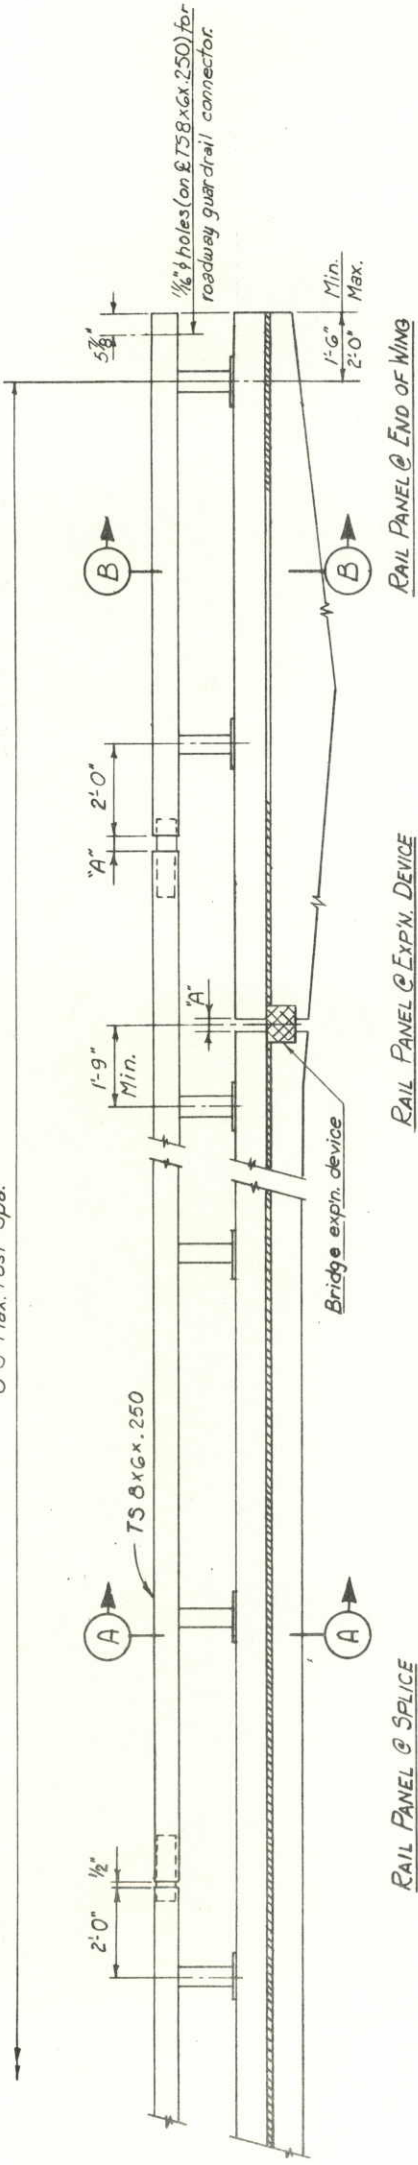


ELEVATION BRIDGE RAIL

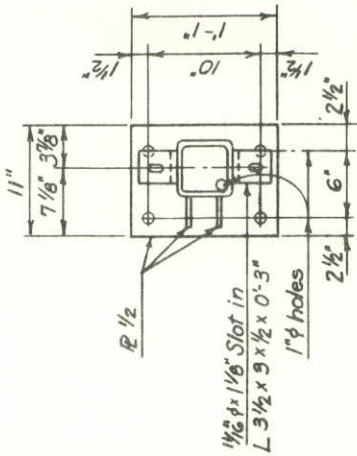

PLAN

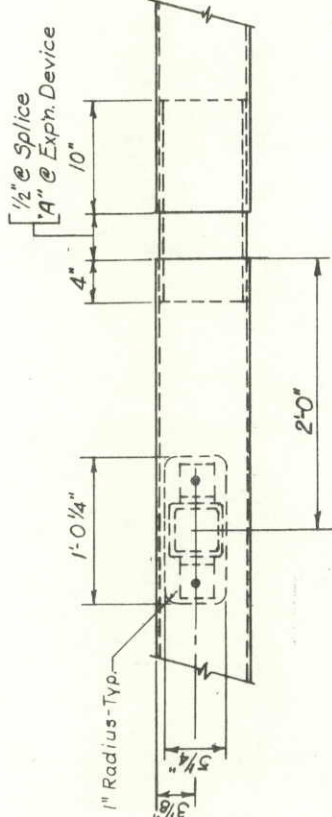


PLAN

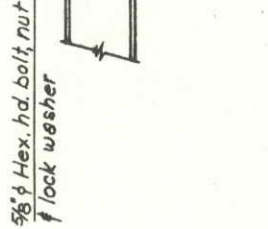


ELEVATION

POST CONNECTION

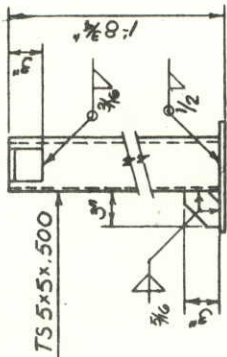


ELEVATION


POST DETAIL

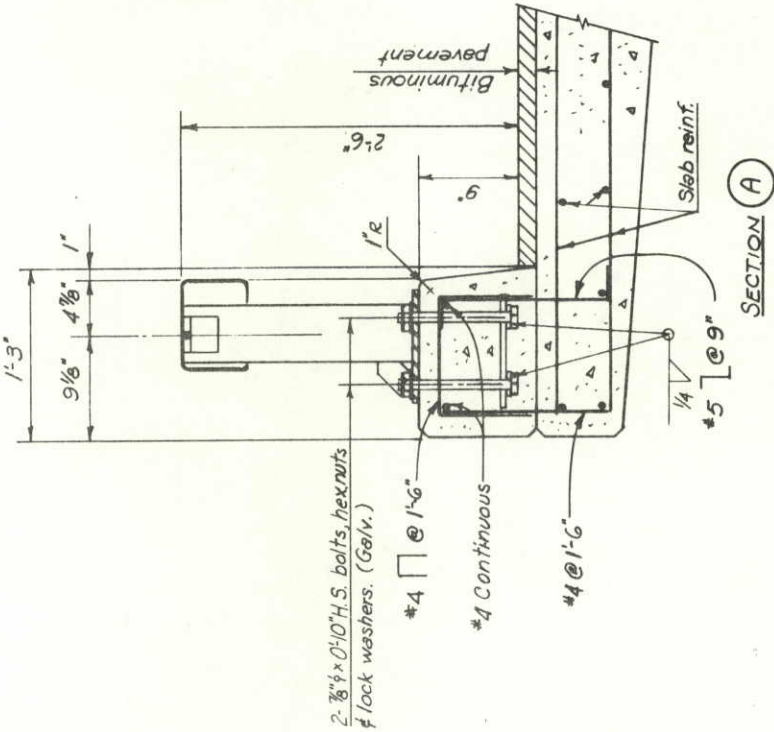

SECTION A

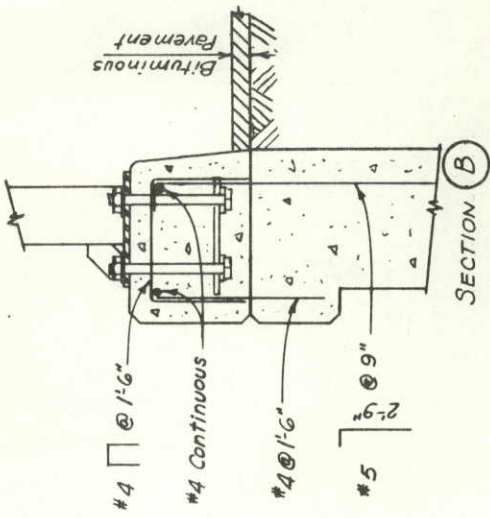

SECTION B

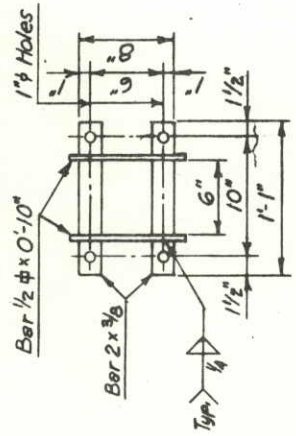

ANCHOR DETAIL

DIVISION OF HIGHWAYS

BRIDGE RAIL TYPE 5

Designer	S. CHOWDHURY	Structure Number	C-17-FA
Detailer	J.R. FURBER	Number	
Drawing Number	B	of	18
Drawings			

(12-17-75)

NO REVISIONS	AS CONSTRUCTED	REVISED	VOID

BRIDGE STANDARD -50-

FEDERAL ROAD DISTRICT NO.	DIVISION	PROJ. NO.	SHEET NO.	TOTAL SHEETS
VIII	COLORADO	RF034-1(16)	32	

REVISIONS	

NOTES

SLOPE PAVING SHALL BE POURED IN 5'-FT. TRANSVERSE SECTIONS WITH A TOOLED CONSTRUCTION JOINT AT EACH SECTION. WIRE FABRIC SHALL BE 2" FROM THE END OF JOINTS AND SHALL LAP 8" AT SPLICES.

WHERE SLOPE OR BERM PAVING BUTTS AGAINST STRUCTURAL CONCRETE, SEPARATE WITH 1" EXPANSION JOINT MATERIAL.

EXPANSION JOINT MATERIAL AND WELDED WIRE FABRIC SHALL NOT BE PAID FOR SEPARATELY BUT SHALL BE INCLUDED IN THE WORK.

PANELS MARKED THUS "A" ARE TO RECEIVE AN EXPOSED AGGREGATE FINISH. AFTER THE CONCRETE IS SET, THE SURFACE SHALL BE SPRAYED WITH AN APPROVED RETARDER. THE AMOUNT OF RETARDER SPRAYED ON THE SURFACE SHALL BE AS RECOMMENDED BY THE MANUFACTURER.


IN ALL CASES, THE EXPOSED AGGREGATE FINISH SHALL BE STARTED ON THE FIRST PANEL FACING ON-COMING TRAFFIC.

THE CONCRETE SHALL THEN BE ALLOWED TO SET. SETTING TIME SHALL BE DETERMINED BY THE ENGINEER. AFTER SETTING THE PRESCRIBED TIME THE SURFACE SHALL BE BROOMED AND WASHED WITH WATER TO EXPOSE THE AGGREGATE.

THE EXPOSED AGGREGATE FINISH SHALL THEN BE SPRAYED WITH A CLEAR CURING COMPOUND.

COARSE AGGREGATE USED IN EXPOSED AGGREGATE PANELS SHALL BE EXPOSED PREDOMINANTLY OF STONE CONTRASTING IN COLOR TO THAT OF CONCRETE IN ADJACENT PANELS.

~~COARSE AGGREGATE SHALL MEET THE REQUIREMENTS OF AASHTO SPECIFICATION M-2.5 SIZE NUMBER 6.~~

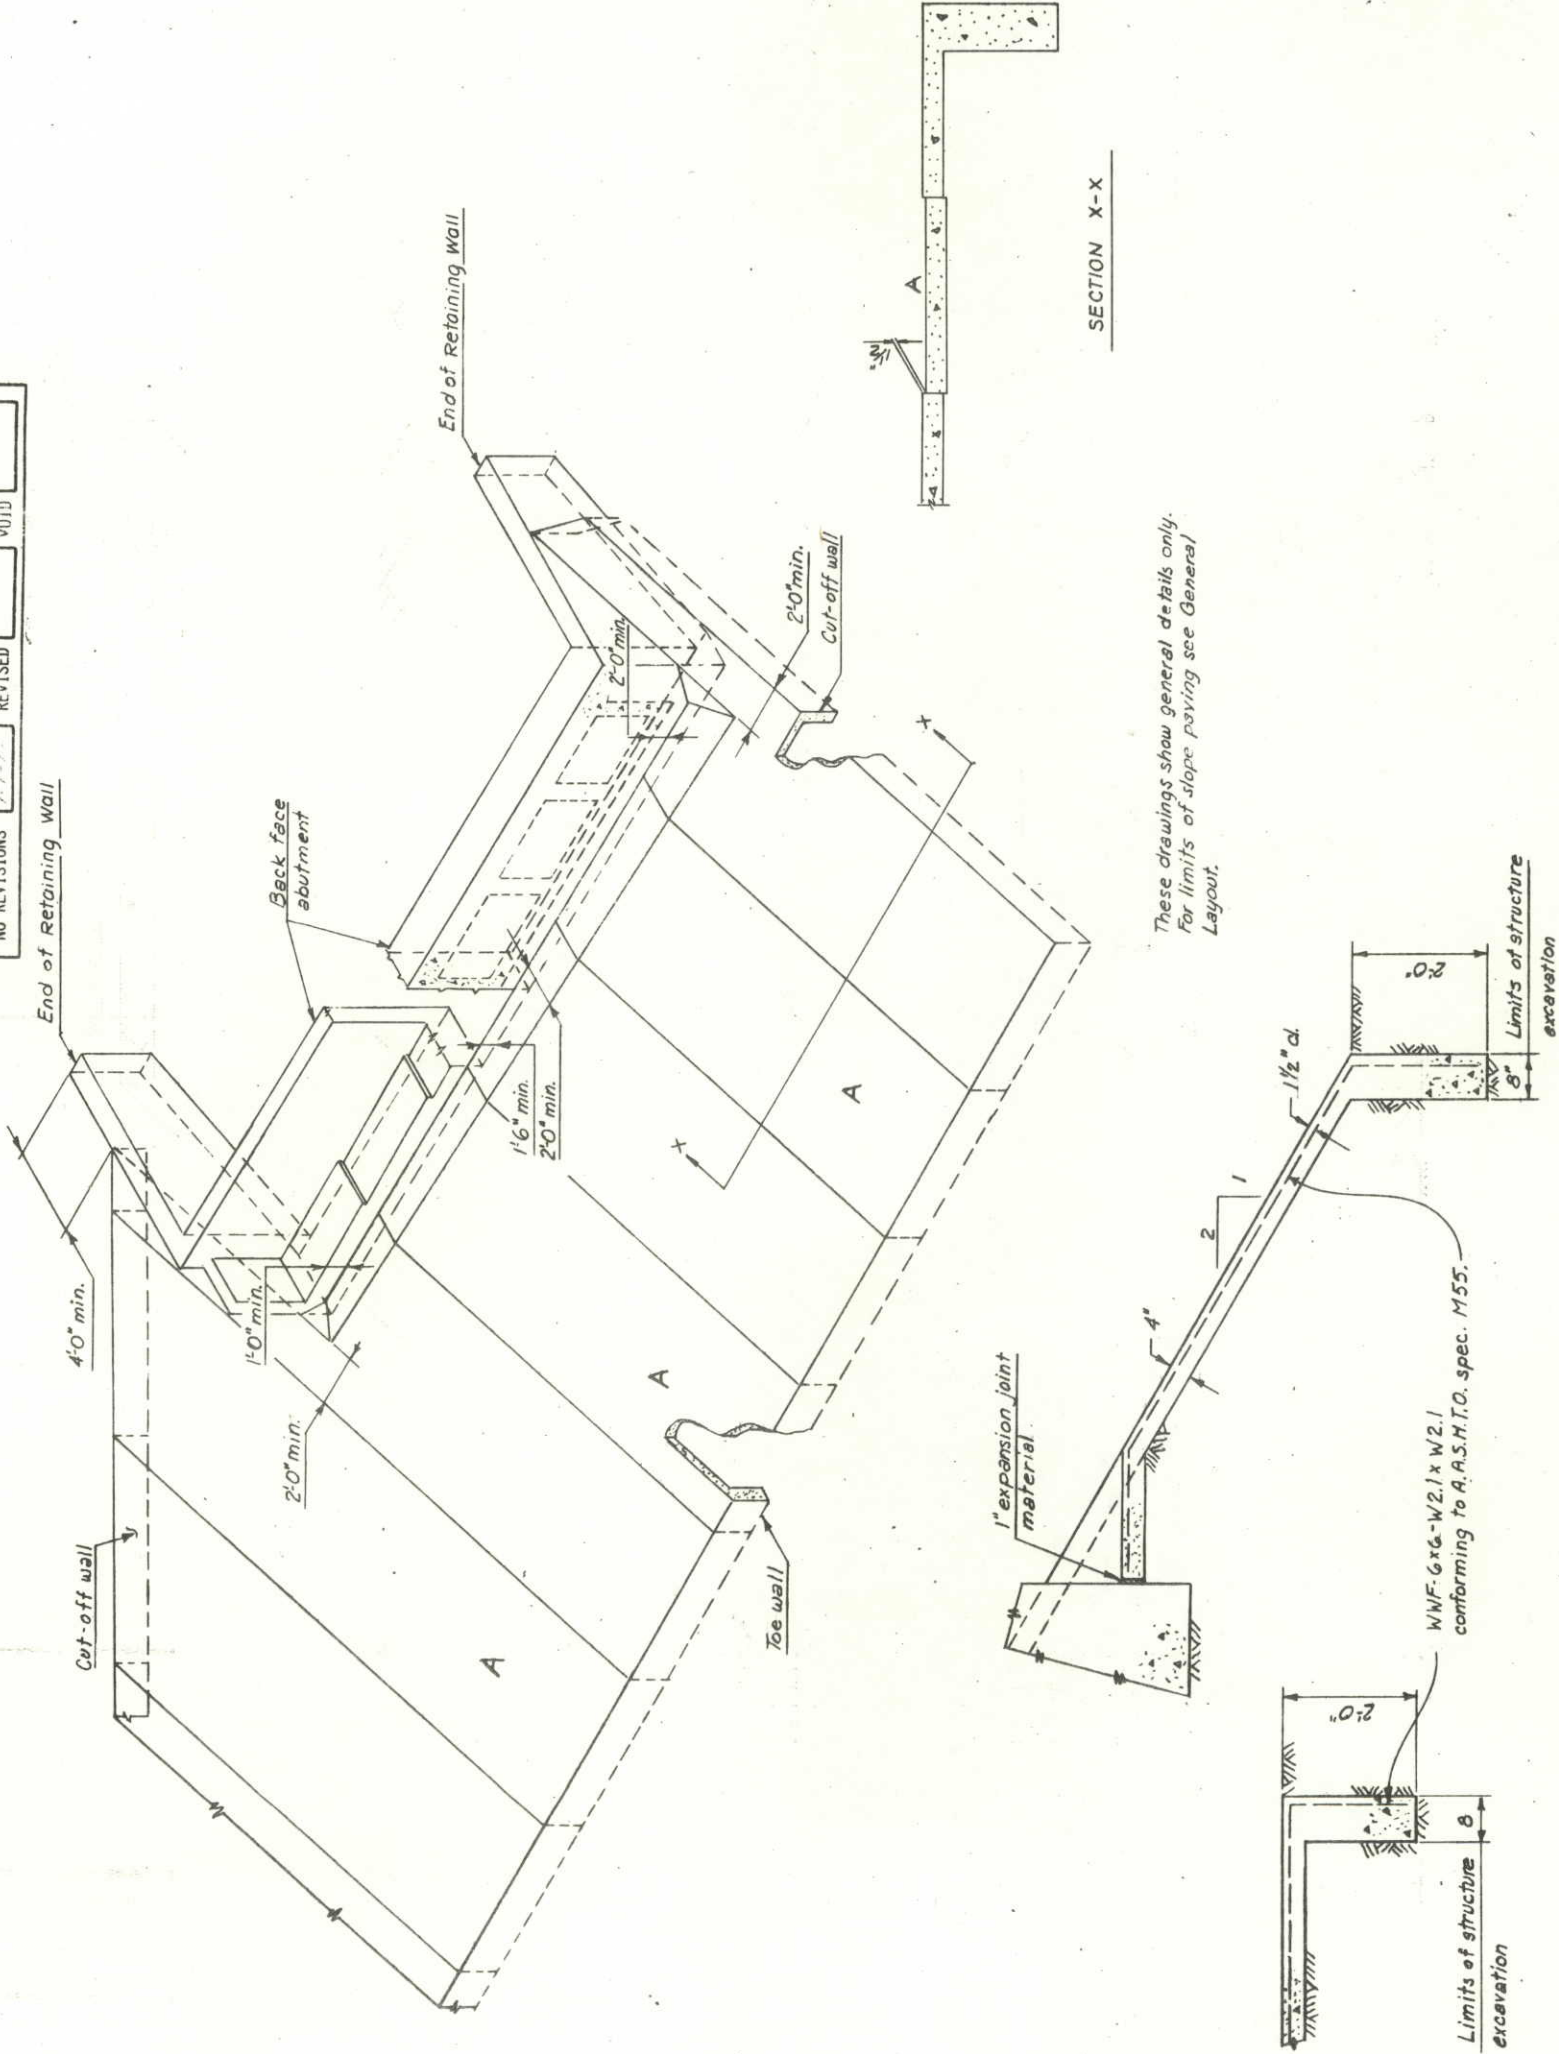

DIVISION OF HIGHWAYS

SLOPE PAVING DETAILS

Designer	M. McMullen	Structure	C-17-FA
Detailer	J.R. Ewert	Numbers	
Drawing Number	B 17	of	18
Drawings			

Revision Date

(Preliminary Stage Only)


(9-1-74)

NO REVISIONS	2-7-77	REVISED	VOID
--------------	--------	---------	------


AS CONSTRUCTED

FEDERAL ROAD DISTRICT NO.	DIVISION	PROJ. NO.	SHEET NO.	TOTAL SHEETS
VIII	COLORADO	RF034-1(16)	59	


REVISIONS	

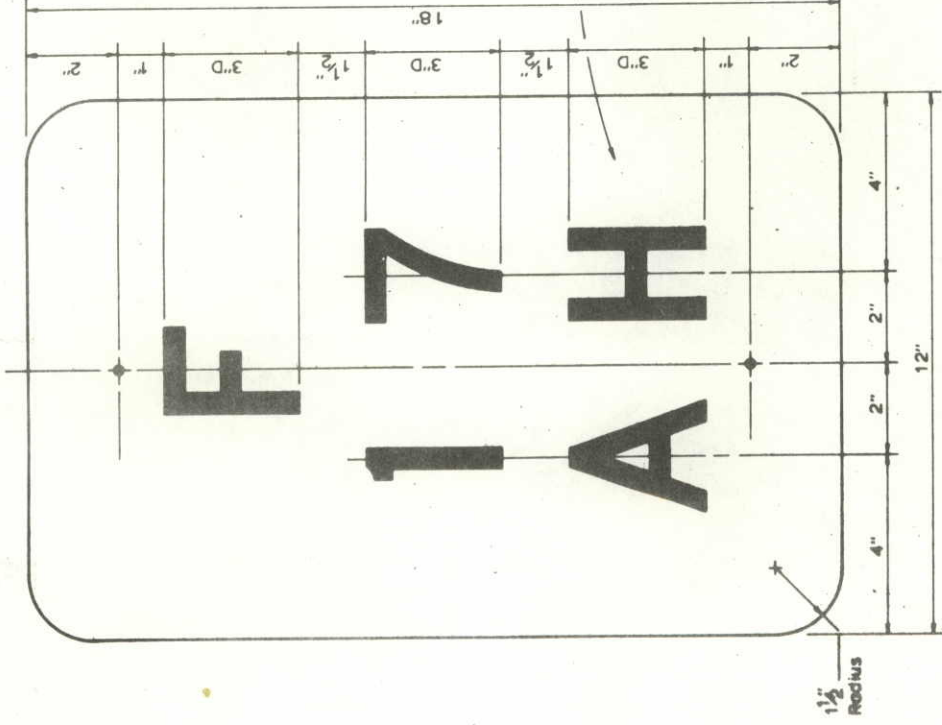

STRUCTURE IDENTIFICATION PANEL
(SAMPLE NUMBERS & LETTERS)

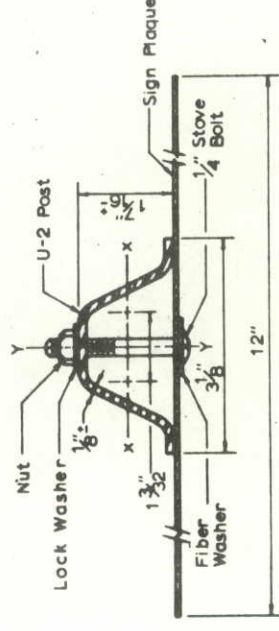


SECTION (A)

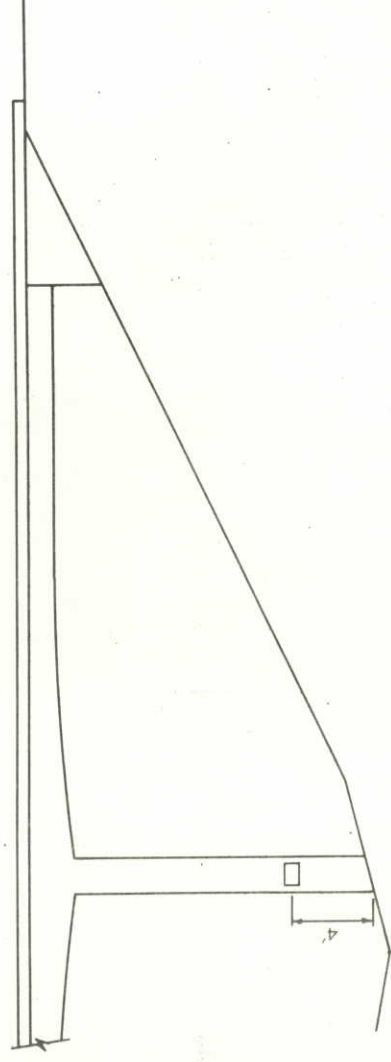


STRUCTURE NUMBER LOCATION
ON PIERS

Black letters and numbers on white background.

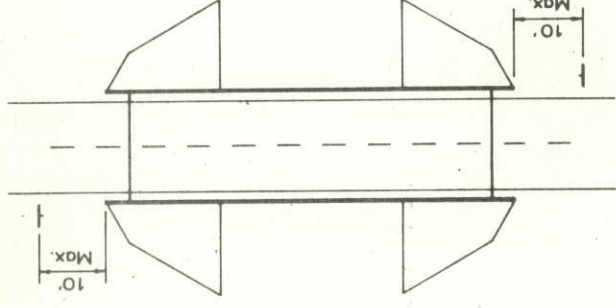

① STANDARD LOCATION DETAIL

U-2 POST IN GROUND

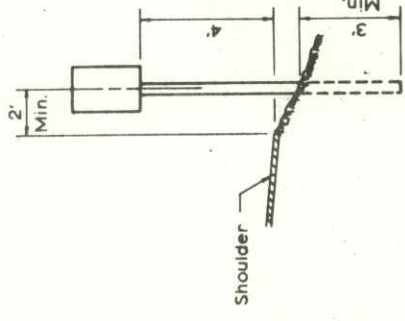


DIVISION OF HIGHWAYS

STRUCTURE NUMBER
STANDARD

Designer M. McMullen	Structure Numbers C-17-FA
Drafter B. L. L. L.	of 18
Drawing Number 8	Drawings

NO REVISIONS ☐ AS CONSTRUCTED ☐ REVISED ☐ 7-2-77 ☐ VOID ☐

FEDERAL ROAD REGION NO.	DIVISION	PROJ. NO.	SHEET NO.	TOTAL SHEETS
VIII	COLORADO	RF 034-1 (16)	34	

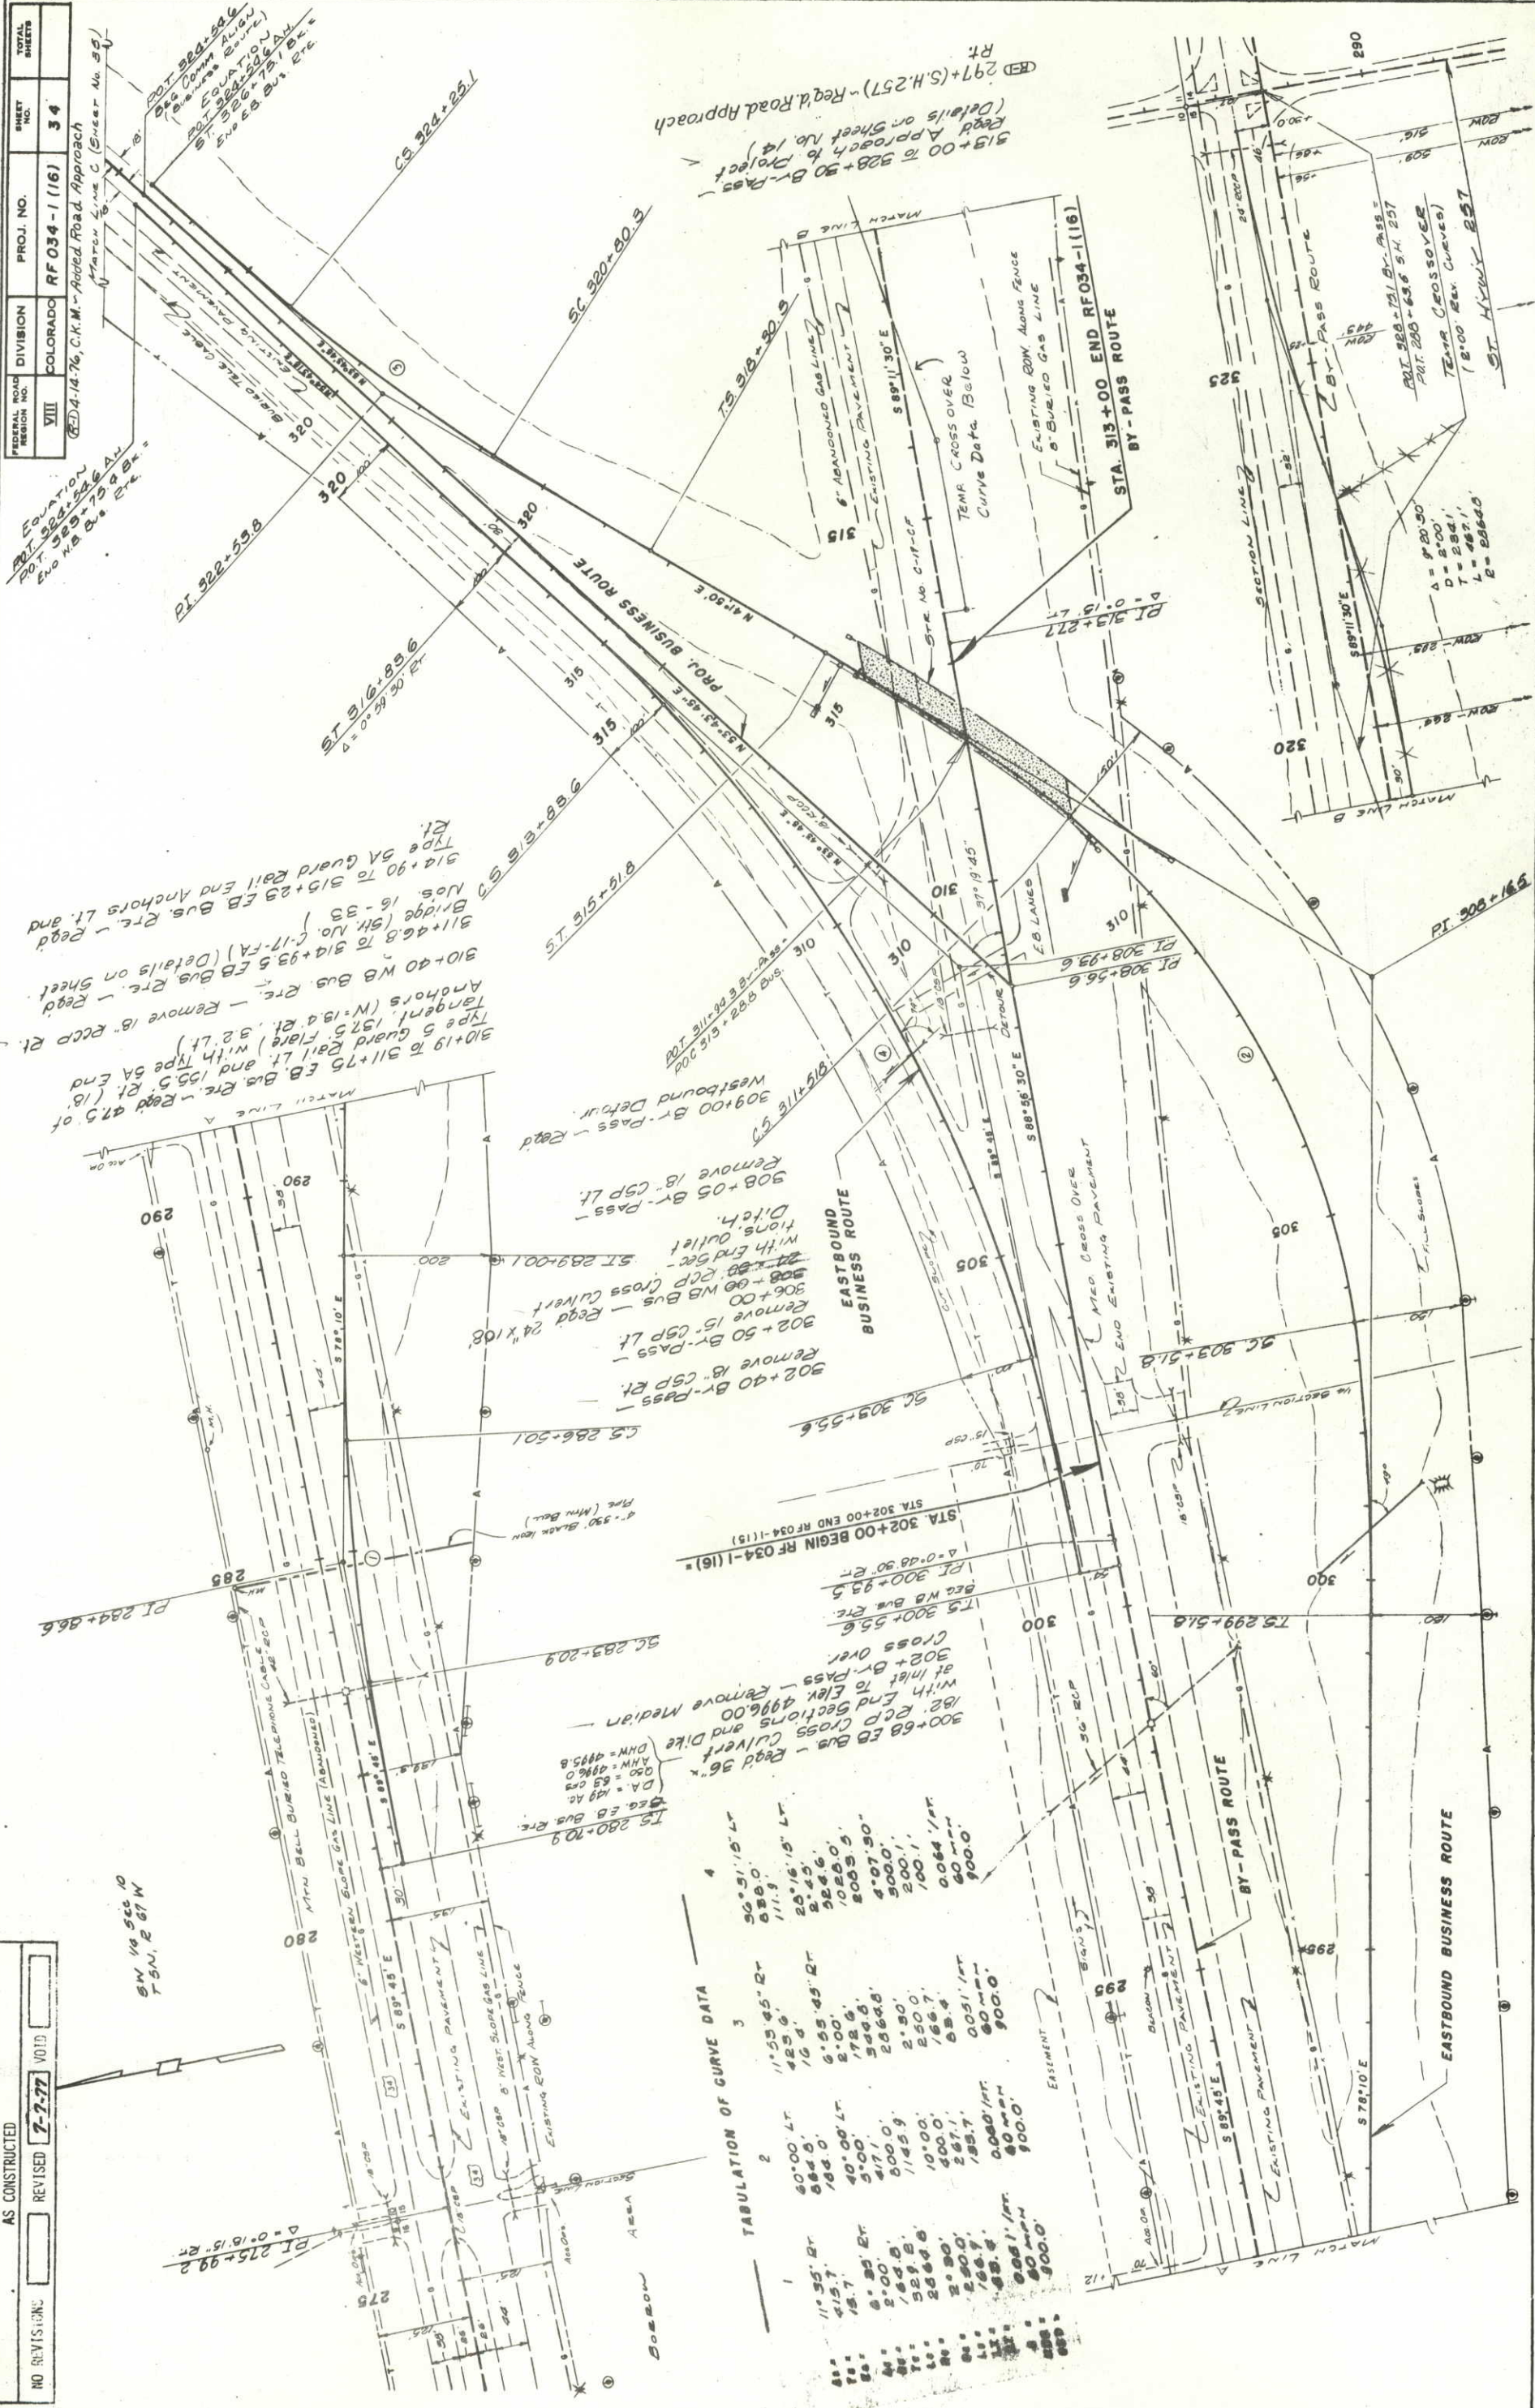

NO REVISIONS		REVISED	7-7-77	VOID	
--------------	--	---------	--------	------	--

