



COLORADO
Department of
Transportation

DOCUMENT SEPARATOR SHEET

REGION 5 – JUNE 2017 CONVERSION

To be placed at the beginning of each separator sheet.



r500001854

Description:

ROW Plans 11X17

Route # and Mile Points:

SH 666

Originating Office:

ROW/Survey

File Name:

FAP-RF666-2(4)_ROW(.PDF)

Box Location:

29 of 38

AS CONSTRUCTED

N O T

SCANNED

(PER TODD)

NOTE:
Preliminary Engineering, Right Of Way and
Utilities Obligated to Proj. No. F666-2(1).

AS CONSTRUCTED
REVISED DATE 10/16/74

STATE DEPARTMENT OF HIGHWAYS DIVISION OF HIGHWAYS—STATE OF COLORADO

FEDERAL ROAD REGION NO.	DIVISION	PROJECT NO	SHEET NO
XIII	COLORADO	RF 666-2(4)	1

(R-1) 10-10-73 C.K.M., Project No. has been revised to RF666-2(4).
Former Proj. No. was F666-2(4) and has not been revised on
any other sheets of these plans.

PLAN AND PROFILE OF ^{COMPLETED} PROPOSED FEDERAL AID PROJECT NO. RF666-2(4) STATE HIGHWAY NO. 666 MONTEZUMA COUNTY

SCALES OF ORIGINAL DRAWINGS

ON PLAN, 1 IN. = 50 FT.
ON PROFILE 1 IN. = 50 FT. HORIZONTAL
1 IN. = 10 FT. VERTICAL
GRADE LINE ON PROFILE IS SHOWN AS GRADE OF FINISHED ROAD


INDEX OF SHEETS

SHEET NO	1	SKETCH MAP, TITLE PAGE AND TABULATION OF LENGTH AND DESIGN DATA	
2 - 3		TYPICAL SECTIONS AND GENERAL NOTES	
4 - 6		SUMMARY OF APPROXIMATE QUANTITIES	
7		SUMMARY OF EARTHWORK QUANTITIES, TABULATION OF CURB CUTS AND FENCING REQUIREMENTS	
8		SUBBASE PLAN, SURFACE COURSE PLAN, TABULATIONS OF CURB & GUTTER AND DELINEATORS	
9		PIT SKETCHES	
10 - 11		STRUCTURE QUANTITIES	
12		DETAILS OF: IRRIGATION DITCH STA. 93+ TO 99+, DRY RUBBLE SLOPE & DITCH PAVING AT INLET, RIPRAP OUTLET DITCH AND RIPRAP AT INLET	
13 - 18		ALIGNMENT PLAN AND PROFILE	
19A - 20		STRUCTURE CROSS SECTIONS	
25-33		ROADWAY CROSS SECTIONS (REVISED)	
34-35		BORROW CROSS SECTIONS	
36-41		WEEKLY CROSS SECTIONS	
42-44		TOP SOIL CROSS SECTIONS	
M-100-A		STANDARD SYMBOLS	5-11-73
M-203-SC		SUPERELEVATION & WIDENING OF CURVES - CROWNED HIGHWAYS	10-22-71
M-203-SS		SUPERELEVATION OF CURVES - STREETS	2-8-72
M-203-B		APPROACH ROADS, FLARING, CUT SLOPE TREATMENT, BRIDGE & CREST WIDENING	12-11-72
M-203-C		DITCH TYPES	7-23-68
M-206-AA		EXCAVATION AND BACKFILL FOR STRUCTURES	(2 SHEETS) 2-16-72
M-603-CA		CONCRETE AND METAL END SECTIONS	6-25-71
M-603-M		METAL CULVERT PIPE - H-20 LOADING	2-11-71
M-604-D		STEPS FOR MANHOLES AND INLETS	7-23-68
M-604-R		CURB INLET, TYPE R	(2 SHEETS) 9-27-72
M-607-A		WIRE FENCES AND GATES	(2 SHEETS) 8-19-71
M-609-A		CURBS AND GUTTERS	5-7-71
M-614-TB		TRAFFIC SIGNING FOR HIGHWAY CONSTRUCTION	(3 SHEETS) 11-22-71
M-616-B		CSP SIPHON	4-9-71
S-612-51A		TYPICAL DELINEATOR INSTALLATIONS	(2 SHEETS) 10-26-72
S-614-40A		STANDARD CONSTRUCTION IDENTIFICATION SIGNS	(2 SHEETS) 4-13-73
S-614-52A		BARRICADES AND VERTICAL PANEL CHANNELIZING DEVICES	6-26-73

TABULATION OF LENGTH & DESIGN DATA

STATION	24 FT. ROADWAY	48 FT. ROADWAY
	LIN. FT.	LIN. FT.
83+28.2 8'6" IN RF666-2(4) = 83+28.2 END F. 666-2(3)		4,684.9
130+13.1 BK. = 130+00.0 AH EQUATION		400.0
134+00.0 END 48 FT. - BEGIN 24 FT. RDWY.	1,600.0	
150+00.0 END RF666-2(4) = 150+00.0 ON BF 022-1(12)		
TOTAL	1,600.0	5,084.9
SUMMARY	LIN. FT.	MILES
TOTAL - 24 FT. ROADWAY	1,600.0	0.303
TOTAL - 48 FT. ROADWAY	5,084.9	0.963
TOTAL (NET & GROSS LENGTH)	6,684.9	1.266
DESIGN DATA		
MAXIMUM DEGREE OF CURVE	2°30'	
MAXIMUM GRADE	4.8909%	
MINIMUM S.S.D. - HORIZONTAL	900 FT.	
MINIMUM S.S.D. - VERTICAL	480 FT.	
MAXIMUM DESIGN SPEED	60 MPH	


1993 DESIGN TRAFFIC VOLUME 3,900 A.D.T.
507 D.H.V.

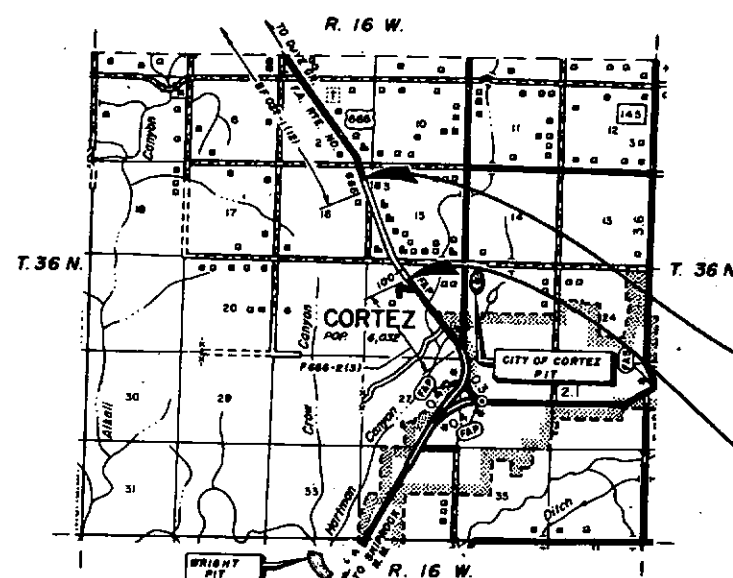

SCALE OF MILES
0 1/2 1 2 3

STA. 150+00.0 END RF666-2(4) =
STA. 150+00.0 ON BF 022-1(12)

STA. 83+28.2 BEGIN RF666-2(4) =
STA. 83+28.2 END F666-2(3)

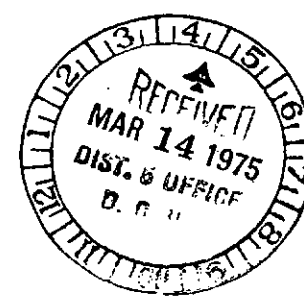

AS CONSTRUCTED INFORMATION

CONTRACTOR	NIELSON'S INC.
Project ENGINEER	J. Pat. Linn.
(Project or Resident)	
PROJECT STARTED	9-24-73
PROJECT COMPLETED	10-16-74
AS CONSTRUCTED PLANS APPROVED	
TITLE	Const. Eng. 1-4-75
DATE	

DIVISION OF HIGHWAYS

APPROVED: E. N. Linn 7/17/72
CHIEF ENGINEER DATE

DEPARTMENT OF TRANSPORTATION
FEDERAL HIGHWAY ADMINISTRATION

APPROVED: _____ DATE _____
DIVISION ENGINEER

