

STATE DEPARTMENT OF HIGHWAYS


DIVISION OF HIGHWAYS—STATE OF COLORADO

PLAN AND PROFILE OF PROPOSED

FEDERAL AID PROJECT NO. RS 0009(14)

STATE HIGHWAY NO. 9

PARK COUNTY

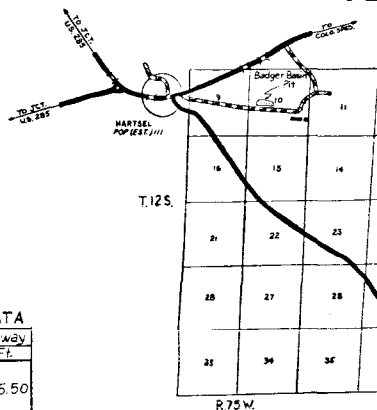


SCALES OF ORIGINAL DRAWINGS
 ON PLAN, 1 IN. = 100 FT.
 ON PROFILE, 1 IN. = 100 FT. HORIZONTAL
 1 IN. = 10 FT. VERTICAL
 GRADE LINE ON PROFILE IS SHOWN AS GRADE OF FINISHED ROAD

TABULATION OF LENGTH & DESIGN DATA

STATION	Roadway Lin. Ft.
1085+00 Begin Proj. RS 0009(14)	4,365.50
1128+65.50 Bk. = EQUATION	
1128+60.52 Ah.	3,183.59
1160+44.11 Bk. = EQUATION	
1160+47.20 Ah.	15,859.75
1319+06.95 Bk. = EQUATION	
1319+06.01 Ah.	93.99
1320+00 End Proj. RS 0009(14) = 1320+00 Begin Proj RS 0009(13)	
Total	23,502.83
SUMMARY	Lin. Ft. Miles
Roadway	23,502.83 4.451
Total (Net & Gross length)	23,502.83 4.451
DESIGN DATA	
Maximum Degree of Curve.....	5°30'
Maximum Grade.....	6.26%
Minimum S.S.D. — Horizontal.....	400'
Minimum S.S.D. — Vertical.....	320'
Maximum Design Speed.....	45 mph
1998 Design Traffic Volume (ADT..... 430 D.V..... 85)	

STA. 1320+00 BEGIN RS 0009(13)
 STA. 1320+00 END RS 0009(14)

STA. 1085+00
 BEGIN RS 0009(14)

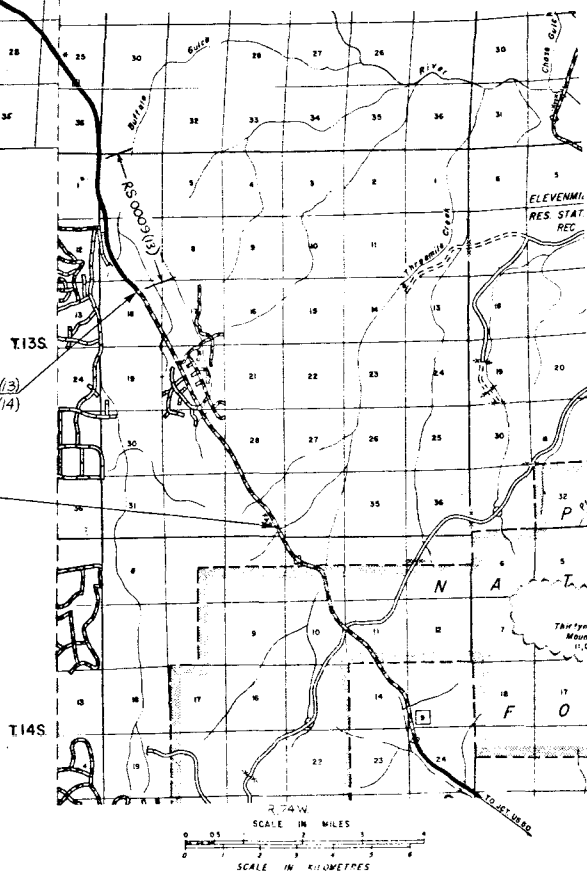

FEDERAL ROAD DISTRICT NO.	DIVISION	PROJECT NO.	SHEET NO.
12	COLORADO	RS 0009(14)	1

AS CONSTRUCTED	
NO REVISIONS	REVISED 7-31-79 VOID

INDEX OF SHEETS

- SHEET NO. 1 TITLE PAGE, SKETCH MAP, INDEX OF SHEETS AND TABULATION OF LENGTH AND DESIGN DATA
 2 TYPICAL SECTIONS AND GENERAL NOTES AND TABULATION OF WORK
 3 - 4 SUMMARY OF APPROPRIATE QUANTITIES
 5 STRUCTURE QUANTITIES
 6 CROSS CURVE AND SURFACING PLAN, SUMMARY OF EARTHWORK QUANTITIES, TABULATION OF EARTHWORK QUANTITIES, SUMMARY OF EARTHWORK QUANTITIES, SUMMARY OF EARTHWORK QUANTITIES, SUMMARY OF EARTHWORK QUANTITIES
 7 CROSS CURVE AND SURFACING PLAN, SUMMARY OF EARTHWORK QUANTITIES, SUMMARY OF EARTHWORK QUANTITIES, SUMMARY OF EARTHWORK QUANTITIES, SUMMARY OF EARTHWORK QUANTITIES
 8 - 15 ALIGN PLAN AND PROFILE

M STANDARDS

M-100-A	STANDARD SYMBOLS	5-11-73
M-203-B	APPROACH ROADS, FLARING, CUT SLOPE TREATMENT, BRIDGE + CREST WIDENING	12-11-72
M-203-C	DITCH TYPES	7-23-68
M-203-SC	SUPERELEVATION OF CURVES-CROWNED HIGHWAYS	1-06-77
M-205-AB	EXCAVATION AND BACKFILL FOR STRUCTURES	(3 SHEETS) 5-05-78
M-601-L	HEADWALL, INTERCEPTING HEADWALL AND CULVERT OUTLET PAVING	3-31-75
M-603-M	METAL CULVERT PIPE - H-20 LOADING	11-03-78

S STANDARDS

S-612-1A	TYPICAL DELINEATOR INSTALLATIONS	(4 SHEETS) 10-26-77
S-614-38A	TRAFFIC SIGNING FOR HIGHWAY CONSTRUCTION	(4 SHEETS) 5-08-70
S-614-52B	BARRELS, DRUMS, CONCRETE BARRIER (TEMP) AND VERTICAL PANELS	1-10-79

Work sheet NO. 1 Additional Uncl. Exc. (Bench Removal) 1411-1425+Rt

NO. 2 Slope Flattening 1221+1223+Lt
 WS 3-4 P. App. 1242+Rt

JUL 31 1979
INACTIVE

DIVISION OF HIGHWAYS

APPROVED

John M. Cox 1/7/79
 ASST. CHIEF ENGINEER DATE

AS CONSTRUCTED INFORMATION


CONTRACTOR	Flanagan Engineering
Resident ENGINEER	W. T. Hargett
(Project or Resident)	
PROJECT STARTED	March 16, 1979
PROJECT COMPLETED	July 31, 1979
AS CONSTRUCTED PLANS	Approved
DATE	8-16-79

AS CONSTRUCTED			
NO REVISIONS	REVISED	7-3-79	VOID

FEDERAL ROAD REGION NO.	DIVISION	PHOT. NO.	SHEET NO.	TOTAL SHEETS
VIII	COLORADO	RS 0039 (14)	2	16

TYPICAL SECTIONS


RECONDITIONING

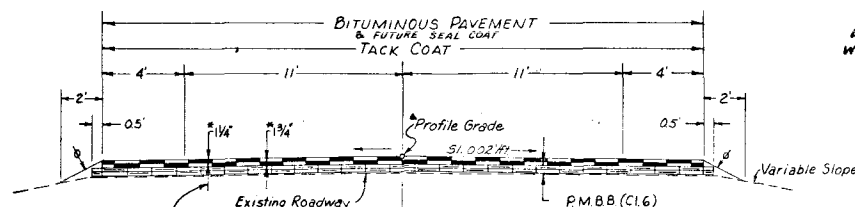

Note: 1 1/4" Top layer of H.B.P. to be future construction. Was Constructed

*Approximate Thickness
*Profile Grade shows the thickness of P.M.B.B. and H.B.P. above the existing road.
*P.M.B.B. Rates per 100
3" 56 tons
3 1/4" 63 tons
4" 63 tons

GRADING

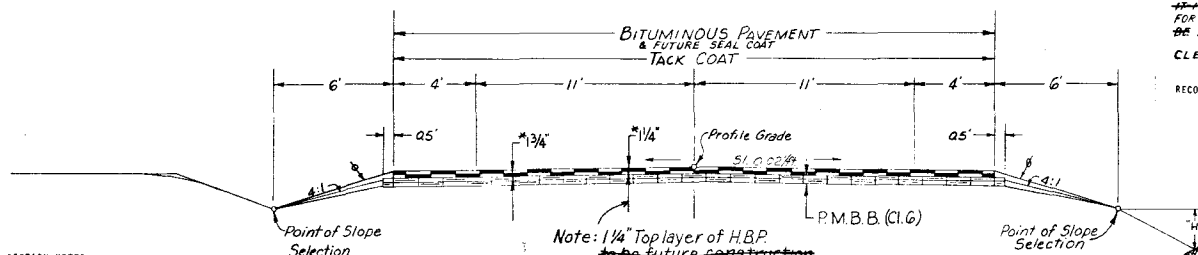

Note: 1 1/4" Top layer of H.B.P. to be future construction. Was Constructed

TYPICAL SECTION NOTES

THE DEPTH AND WIDTH OF THE SIDE DITCH SHALL BE VARIED WHERE NECESSARY IN ORDER TO PROVIDE PROPER DRAINAGE.

MATERIAL SHALL BE PLACED IN SEPARATE COURSES AT THE FOLLOWING APPROXIMATE RATES PER 100 LIN. FT. OF ROADWAY:

BITUMINOUS PAVEMENT TOP LAYER 23 TONS
PLANT MIX BITUMINOUS BASE 32 TONS
THE RATES SHOWN HAVE BEEN DETERMINED FROM INFORMATION AVAILABLE AT THE TIME OF DESIGN. RATES SHALL BE ADJUSTED DURING CONSTRUCTION TO OBTAIN THE REQUIRED APPROXIMATE THICKNESS.

THE CONTRACTOR SHALL BE REQUIRED TO PLACE SUITABLE MATERIAL TO THIS LINE AFTER COMPLETION OF PAVING OPERATION. THIS SHALL NOT BE PAID FOR SEPARATELY, BUT INCLUDED IN THE WORK.

FILL SLOPES:

SLOPE 4:1 WHERE "H" IS 4' OR LESS
SLOPE 3:1 WHERE "H" IS 4' TO 15'
SLOPE 2:1 WHERE "H" IS OVER 15'

IN SPECIAL CASES, SLOPE MAY BE STEEPENED.

BREAK POINTS ON SLOPES AND IN BOTTOMS OF DITCHES SHALL BE ROUNDED ON CONSTRUCTION FOR A PLEASING APPEARANCE.

GENERAL NOTES

FOR PRELIMINARY PLAN QUANTITIES OF BITUMINOUS MATERIALS AND COVER COAT MATERIALS, THE FOLLOWING RATES OF APPLICATION WERE USED:

TACK COAT DILUTED EMUL. ASPH. (CSS-1H) 8.0-1 GALS. PER SQ. YD.

DILUTED EMULSIFIED ASPHALT FOR TACK COAT SHALL CONSIST OF 1 PART EMULSIFIED ASPHALT AND 1 PART/S WATER.

RATES OF APPLICATION SHALL BE DETERMINED BY THE ENGINEER AT THE TIME OF APPLICATION.

DILUTED EMULSIFIED ASPHALT WAS USED AS A DUST PALLIATIVE WHERE REQUIRED AND SHALL CONSIST OF A DILUTION OF EMULSIFIED ASPHALT AND WATER, THE PORTIONS OF WHICH SHALL BE 9 PARTS WATER AND 1 PART EMULSIFIED ASPHALT, BASED ON VOLUME MEASUREMENT. LOCATIONS WHERE REQUIRED.

THE FOLLOWING SHALL BE FURNISHED WITH EACH BITUMINOUS PAYER.

A SKI TYPE DEVICE AT LEAST 30 FEET IN LENGTH AND A SHORT SKI OR SHOE.

ANY LAYER OF BITUMINOUS PAVEMENT THAT IS TO BE A SUCCEEDING LAYER PLACED THEREON SHALL BE COMPLETED FULL WIDTH BEFORE SUCCEEDING LAYER IS PLACED.

ROAD APPROACHES WHICH REQUIRE BITUMINOUS PAVEMENT A 3" THICKNESS OF PMBB AND A 2" THICKNESS OF PAVEMENT SHALL BE PLACED AS FOLLOWS:

COUNTY ROAD APPROACHES SHALL BE PAVED 50 FT. OUT FROM EDGE OF SHOULDER OR TO THE RIGHT OF WAY LINE WHICHEVER IS LESS. OTHER APPROACHES SHALL BE PAVED 4 FT. OUT FROM EDGE OF SHOULDERS.

DEPTH OF MOISTURE-DENSITY CONTROL FOR THIS PROJECT SHALL BE AS FOLLOWS:

FULL DEPTH OF ALL EMBANKMENTS.

BASES OF CUTS AND FILLS .5 FOOT.

EXCAVATION REQUIRED FOR COMPACTION OF BASES OF CUTS AND FILLS SHALL BE PAID FOR SEPARATELY.

2052 HOURS OF FLAGGING FOR CONTROLLING TRAFFIC SHALL BE REQUIRED FOR THIS PROJECT.

2 HOURS OF BLADING WITH A MOTOR GRADER IN THE 125 TO 200 FLYWHEEL HORSEPOWER RANGE SHALL BE REQUIRED FOR THIS PROJECT.

GUARD POSTS, DELINEATORS, SIGNS AND SNOW FENCE SHALL BE PROVIDED BY STATE FORCES.

FLEXIBLE CONDUITS ON THIS PROJECT WITH HELICAL CORRUGATIONS, JOINED BY DIMPLED CONNECTING BANDS, SHALL USE A SEALING COMPOUND OR GASKET WITH THE CONNECTING BAND.

IT IS ESTIMATED THAT 3.1 MILES OF RECONDITIONING SHALL BE REQUIRED FOR THIS PROJECT. THE TYPE OF COMPACTION FOR RECONDITIONING SHALL BE AS AASHTO T99.

CLEARING AND GRUBBING TO BE SUBSIDIARY TO COST OF PROJECT.

RECONDITIONED ROADWAY SHALL BE SUPERELEVATED IN ACCORDANCE WITH STANDARD M-203-SC

TABULATION OF WORK

STATION TO STATION	GRADING	RECONDITIONING
	LIN. FT.	LIN. FT.
1085+00 to 1096+50		1,150
1096+50 to 1110+50	1,400	
1110+50 to 1123+00		1,250
1123+00 to 1150+00	2,705	
1150+00 to 1161+00		1,097
1161+00 to 1172+00	1,100	
1172+00 to 1231+00		5,900
1231+00 to 1251+00	2,000	
1251+00 to 1320+00		6,901
TOTALS	7,205	16,298

SUMMARY OF APPROXIMATE QUANTITIES

R-1 changed
Quantity-3.0 M
2.8.79

AS CONSTRUCTED

NO REVISIONS

REVISED 7-31-79

VOID

FEDERAL ROAD
DISTRICT NO.

DIVISION

PROJ. NO.

SHEET
NO.TOTAL
SHEETS

VIII

COLORADO

RS 0009 (12)

3

16

INDEX			CONTRACT ITEM NO.	CONTRACT ITEM	UNIT																																																																																																																																																																																																																																																																																																																																																																																																																																																																																																																																																																																																															</
-------	--	--	----------------------	---------------	------	--	--	----

R-7

AS CONSTRUCTED			FEDERAL ROAD REGION NO.	DIVISION	PROJ. NO.	SHEET NO.	TOTAL SHEETS
NO REVISIONS	REVISED	VOID	VIII	COLORADO	RS 0009 (14)	4	16

INDEX			CONTRACT ITEM NO.	CONTRACT ITEM	UNIT													PROJECT TOTALS	Project FINAL Quantities	% Plan
BOOK	PAGE	SHEET																		
7	16		506	Riprap	Cu. Yd.													21	20	95
7	17		603	18 Inch Corrugated Steel Pipe	Lin. Ft.													26	26	100
7	18		603	24 Inch Corrugated Steel Pipe	Lin. Ft.													314	282	90
7	19		603	36 Inch Corrugated Steel Pipe	Lin. Ft.													84	84	100
9		6	612	Delineator (Type I)	Each													164	162	99
		6	614	Flagging	Hour													1,200	2,052	171
		6	614	Construction Traffic Sign (Panel Size A)	Each													3	4	133
		6	614	Construction Traffic Sign (Panel Size B)	Each													10	11	110
7	24		614	Vertical Panel	Each													50	50	100
7	25		620	Field Office	Each													1	1	100
7	26		620	Field Laboratory	Each													1	1	100
7	27		620	Sanitary Facility	Each													1	1	100
7	28		626	Mobilization	Lump Sum													1	1	100
				<u>FORCE ACCOUNT</u>																
		F/A01		Minor Contract Revisions	F.A.													1		
				<u>STATE FORCES (FED.AID)</u>																
6	79	F/A02		Signing & Striping	F.A.													1	1	100

STRUCTURE QUANTITIES

AS CONSTRUCTED		7" CULVERT ROAD REG. OR M.L.	DIVISION	PROJECT NO.	SHEET NO.
NO REVISIONS	REVISED <u>7-31-79</u>	VOID	VIII	COLORADO	RS 0009 (14)
					5

INDEX			LOCATION	UNCLASSIFIED EXCAVATION			STRUCTURE EXCAVATION	STRUCTURE BACKFILL	REMOVAL OF STRUCTURE	RM.B.B. SURFACING	HOT BITUMINOUS PAVEMENT	RIPRAP	CONCRETE	REINFORCING STEEL	CULVERT PIPE			OVER CULV.	SLOPE AND DITCH PAVING	END SECTION	MISCELLANEOUS		
L304	PAGE	SHEET		CUBIC YARD			CUBIC YARD	CUBIC YARD	EACH	CLASS 5	INCHES	CUBIC YARD	CUBIC YARD	CL. A	LB.	LINEAR FEET							
				EXCAV.	EMB.	DITCH										CORRUGATED	METAL PIPE						
																	18"					24"	36"
7			1100+82				8	8	8	0	1		3	3.10				22 1/2	40	7			
			1111+75			10	6	0	6	0								18	0	4			
			1113+65								11	8											
			1128+30				6	6	7	7	4	0						22 1/2	38	6			
			1140+08			5	3	3	4	4								18	18	5			
			1151+35				2	2	4	4								18	18				
			1153+55								3	2											
			1155+35				8	8	7	7	1	1		3	2.37			18	18	4			
			1187+61		95		7	7	6	6				3	3.05			18	28	2			
			1196+55				4	4	7	7	1	1						18	30	3			
			1198+60								3	2											
			1198+75								3	2											
			1209+16				6	6	5	5	0	1		3	1.77			20	20	3			
			1216+81				5	5	3	3				3	2.70			12	12	2			
			1223+20				5	5	3	3				3	2.96			12	12	2			
			1227+00								3	2											
			1240+37				8	8	9	9				3	3.00			24	40	5			
			1242+00								3	2											
			1255+65				8	8	9	9		3	2		26	26				1			
			1256+20								3	2											
			1271+16		70		4	2	5	3								24	8	1			
			1289+54		45		4	0	8	0								24	0	1			
7			1304+25	250	10		17	17	19	19	2	2							84	84	3		
PROJECT TOTALS				366	35		98	89	104	94	5	6	32	22	21	19	95	26	26	314	282	84	84

* Quantity carried to slope flattening tabulation
18" Thick - 9" Stone size

P-1 Added tabulation, deleted note -
J.D.M. 2-8-79

FEDERAL ROAD REGION NO.	DIVISION	PROJ. NO.	SHEET NO.	TOTAL SHEETS
VIII	COLORADO	FS 0009(14)	6	16
AS CONSTRUCTED				
NO REVISIONS ☐ REVISED ☒ 7-31-79 VOID ☐				

BASE COURSE AND SURFACING PLAN

STATION TO STATION	* PLANT MIX BITUMINOUS BASE (CLASS 6)			* HOT BITUMINOUS PAVEMENT (GRADING E)			
	THICKNESS	TONS USED	HAUL - TON MILE	TONS USED		HAUL - TON MILE	
				BOTTOM LAYER	* TOP LAYER	BOTTOM LAYER	* TOP LAYER
1085+00 - 1320+00				7,521	5,906	996.8	69,416
1085+00 - 1160+00	3"	4202	56,409				
1160+00 - 1170+00	3 3/4"	648	8,182				
1170+00 - 1250+00	3"	4480	50,495				
1250+00 - 1260+00	3 3/4"	650	7,099				
1260+00 - 1270+00	3"	560	6,010				
1270+00 - 1290+00	3 1/4"	1460	17,343				
1290+00 - 1300+00	3"	560	5,692				
1300+00 - 1310+00	3 1/4"	630	6,483				
1310+00 - 1320+00	3"	561	5,989				
ESTIMATED FOR CORR. IN REG.		4,397	16,696				
FROM STR. QUANTITIES		3.2		22			
TOTALS		15,401	123,253	182,138	146,948	7,543	59,406

STABILIZATION BASED ON THE FOLLOWING:

18" EDLA 9
REGIONAL FACTOR 2.5
SERVICEABILITY INDEX 2.0

STRENGTH COEFFICIENTS:

PLANT MIX BITUMINOUS BASE (CLASS 6) 0.34
HOT BITUMINOUS PAVEMENT (GRADING E) 0.44
W.S.N. 0.90-2.80
"R" VALUE 5-82

* Source - Badger Basin Pit

* Future Construction
CMD # 6037

WETTING QUANTITIES

Wetting	77 GAL
Embankment	493
Base Cuts & RMs	261
Roadway Flaring	600
Total	591


Project

TABULATION OF DELINEATORS

STATION TO STATION	SIDE	SPACING	TYPE I DELINEATOR	BOOK 7 Page 20 Sheet 1
1085+00 - 1102+63.68	RELT.	300'	12	12
1102+63.68 - 1111+75.10	RELT.	103'	12	12
1111+75.10 - 1320+00	RELT.	300'	140	138
TOTAL			164	162

SCHEDULE OF
CONSTRUCTION TRAFFIC SIGNS

SIGN CODE OR LEGEND	DIMENSIONS	PANEL SIZE			QUANTITY REQUIRED
		A	B	C	
XW 20-1	48" x 48"		X		4
SG 20-1	60" x 36"		X		2
SG 20-2	60" x 24"		X		2
XW 20-7	48" x 48"		X		23
* 60" Prepared/ To/Stop	36" x 36"	X			2
XW 8-3	36" x 36"	X			1
Vertical Panel					50

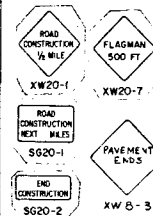

SUMMARY OF EARTHWORK QUANTITIES

UNCLASSIFIED EXCAVATION

ROADWAY (FROM CROSS SECTIONS)

STRUCTURE QUANTITIES AS DITCH
EST. FOR CUT SLOPE TREATMENT

TOTAL

COMPACTION (AASHTO T99)

EMBANKMENT (NET)

BASE OF CUTS AND FILLS

TOTAL

HAUL

FROM MASS DIAGRAM
FOR FLATTENING SLOPES

TOTAL

ROADWAY QUANTITIES BALANCE (FOR INFORMATION ONLY)

EXCAVATION

UNCLASSIFIED (TOTAL)

EMBANKMENT NET

ROADWAY (FROM CROSS SECTIONS)

EMBANKMENT x FACTOR (1.2)

ROADWAY (FROM CROSS SECTIONS)

EXCESS EXCAVATION

TOTAL

* EXCESS EXCAVATION TO BE DISPOSED OF AS:
FLATTENING OF FILL SLOPES (TOTAL)

P-1

* TABULATION OF SLOPE FLATTENING

STATION TO STATION	SIDE	CUBIC YARDS	YARD MILE HAUL
1085+50 - 1092+50	RT	208	501
1113+50 - 1115+50	RT	206	207
1135+00 - 1141+00	RT	490	315
1150+00 - 1161+00	RT	1206	269
1193+50 - 1197+50	LT & RT	642	338
1206+50 - 1212+50	LT & RT	1134	816
1215+50 - 1217+50	RT	228	210
1221+50 - 1231+00	RT	988	1067
1268+50 - 1273+50	RT	527	222
STR. EMB. (EST.)	LT & RT	366	242
TOTALS		6,037	3,987

Note: Compaction will not be required for slope flattening.

FINAL SURVEY	PROJECT NO.	DATE
BY	BY	BY
BY	BY	BY

ORIGINAL SURVEY	PROJECT NO.	DATE
BY	BY	BY
BY	BY	BY

Excavation		Embankment	
Cu. Yds.	Area	Area	Cu. Yds.
Summary of Earthwork Quantities			
22428	Unclassified Excavation		5,161
6 51	Excavation (Computer)		21,553
work sheet #1	Excavation (Computer)		6,241
	Excavation (Computer)		59
	Excavation (Computer)		22,155
	Excavation (Computer)		
3	Excavation (Computer)		2,266
work sheet #34	Excavation (Computer)		1,116
6 52	Excavation (Computer)		5,223
6 53	Excavation (Computer)		2,715
6 54	Excavation (Computer)		12,432
	Excavation (Computer)		2,164
	Excavation (Computer)		2,164
	Excavation (Computer)		12,766
Posting Division Summary			
(Information Only)			
	Unclassified Excavation		11,164
	Embankment (Vol.)		12,766
	Embankment (Computer)		2,164
	Excavation (Computer)		2,164
	Total		12,766
	Excavation (Computer)		2,266


Excavation		Embankment	
Cu. Yds.	Area	Area	Cu. Yds.
TABLE OF SLOPE PERTAINING			
Station to Station	Slope	Cu. Yd.	Area
1156700 - 1156725	1:1	157	157
1156725 - 1156750	1:1 1/2	256	256
1156750 - 1156775	1:1 1/2	256	256
1156775 - 1156800	1:1	74	74
1156800 - 1156825	1:1	200	130
1156825 - 1156850	1:1	31	36
1156850 - 1156875	1:1	267	30
Total		1,130	2,134

FED. ROAD REGION	DIVISION	PROJ. NO.	SHEET NO.	TOTAL SHEETS
1	100	100	100	100

FEDERAL ROAD DISTRICT NO.	DIVISION	PROJ. NO.	SHEET NO.	TOTAL SHEETS
VIII	COLORADO	RS 0009(14)	7	16
AS CONSTRUCTED				
NO REVISIONS ☐ REVISED ☒ 7-31-79 VOID ☐				

LOG OF PIT

Sample No. 1323

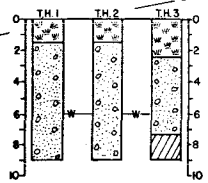

LEGEND

- Overburden
- Sand & Gravel
- Clay with rock
- W=Water (dug)


BADGER BASIN PIT

OWNER: BADGER BASIN GRAZING ASSOC.
HARTSEL, COLORADO
LOCATION: Part of the W1/2 Sec.10, T.12 S., R. 75 W., 6th P.M.
USE: Aggregate Base Course, Bituminous Base Course, and Hot Bituminous Pavement
QUANTITY AVAILABLE: 62,500 Cu. Yds. ¹²⁸⁵
STRIPPING: Removal and Stockpile Overburden 1,500 Cu.Yds.
PIT AREA: 23.09 Acres
HAUL DISTANCE: 9.69 Mi. to Sta. 1320+00
ADJACENT OWNERS: BADGER BASIN GRAZING ASSOC. ONLY
Contractor ^{restricted} will restrict his operations to within the pit limits and haul road.

Seeding and restoration of the pit area will be done at the completion of the next project.

TIE: SW Cor. Sec. 15 Bears
S. 5° 12' 24" W. 7214.15 Ft. (Calc.)

TIE: SE Cor. Sec. 15 Bears
S. 20° 35' 59" E. 7269.97' (Calc.)

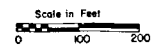

Approximate Contours
Original
Graded (Future Construction)
(This Construction)

FEDERAL ROAD ADMINISTRATION	DIVISION	PROJECT NO.	SHEET NO.	TOTAL SHEETS
WEST	COLORADO	RS 0009 (14)	8	16
AS CONSTRUCTED				
NO REVISIONS		REVISED	7-31-79	VOID

P.L1091+ Proj.
 $\Delta = 3^{\circ} 08' \text{ Li.}$
 $D = 0^{\circ} 30'$
 $T = 313.41'$
 $L = 626.67'$
 $R = 11459.16'$
 $S.S.D. > 900'$
 $e = \text{N.C.}$
 $M.D.S. = 50 \text{ MPH.}$

Surv.
 $\Delta = 16^{\circ} 45' 45''$ Lt.
 $D = 1^{\circ} 30'$
 $T = 562.77'$
 $L = 1117.50'$
 $R = 3819.72'$ *ap*

P.I. 1099+ Proj.
 $\Delta = 3^{\circ} 38'$ Lt.
 $D = 0^{\circ} 45'$
 $T = 242.30'$
 $L = 484.44'$
 $R = 7639.44'$
 $e = RC$
 $T.L. = 150'$
 $M.Q.S. = 50 \text{ mph}$
 $S.S.D. = 800'$

P.L. 1104+ Proj.
 $\Delta = 14^{\circ} 56' 15''$ Lt.
 $D = 5^{\circ} 30'$
 $T = 136.57'$
 $L = 271.59'$
 $R = 1041.74'$
 $e = 0.074\%$
 $TL = 175'$
 M.D.S. = 50 mph
 S.S.D. = 400'

P.L1109+ Proj.
 $\Delta = 21^{\circ}44'30''$ Rt.
 $D = 5^{\circ}30'$
 $T = 200.06'$
 $L = 395.30'$
 $R = 1041.74'$
 $e = 0.074\%$
 $T.L. = 175'$
 $M.D.S. = 50$ mph
 $S.S.D. = 320'$



P.L. 1109+62.78
(Surv.)

1110

P.L. 1109+79.86
(Pro.)

N 37° 33' W (Surv.)

<u>Surv.</u>	<u>p.c. 1107</u>	$\Delta = 13^{\circ}48' \text{ Rt.}$
$\theta_s = 4^{\circ}30'$	<u>S.C. 1108 +</u>	$\Delta_c = 4^{\circ}48'$
$L_s = 300'$	<u>(Surv.)</u>	$D_c = 3^{\circ}00'$
$LI = 200.06'$		$T_s = 381.33'$
$SI = 100.06'$		$L_c = 160.00'$
		$R_c = 1909.86'$

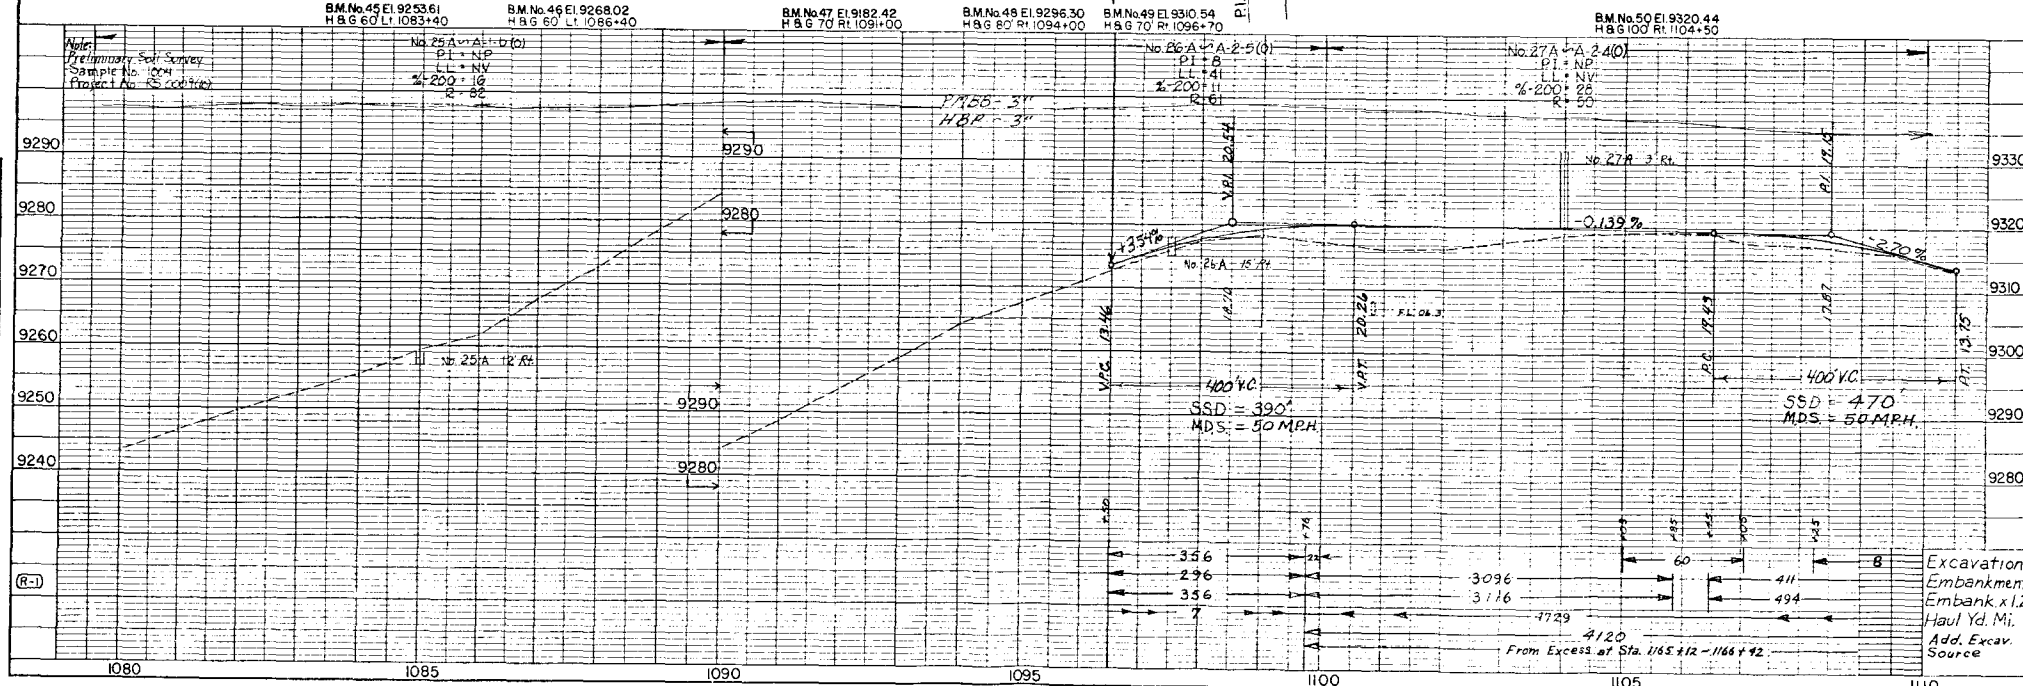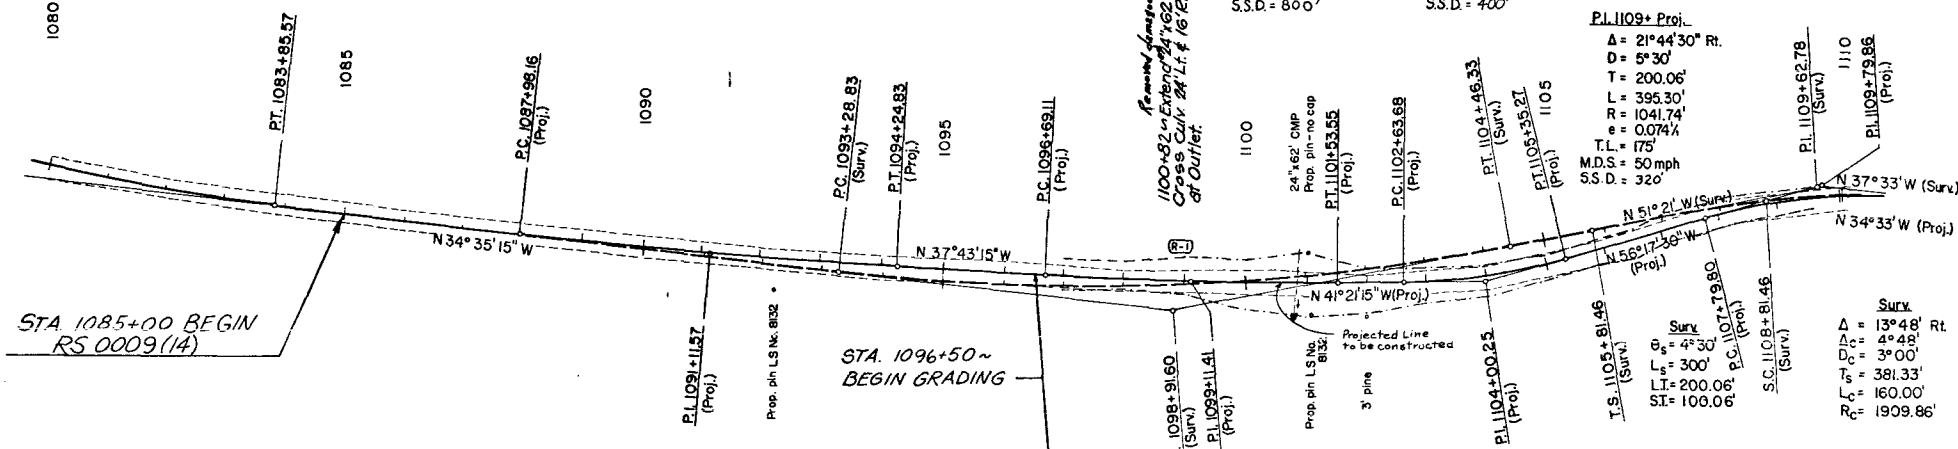

Plan View Data:

- Segment 1 (STA. 1110+50 ~ END GRADING):**
 - Curve Data: $\Delta = 6^\circ 45' 45''$ Lt, $D = 145'$, $T = 193.44'$, $L = 386.43'$, $R = 3274.05'$, $SSD = 560'$, $e = .034\%$, $MDS = 50$ MPH.
 - Stationing: $PL\ 1119+39.03$, $P.C.\ 1120+60.52$, $PT\ 1121+32.02$.
- Segment 2 (STA. 1123+00 ~ BEGIN GRADING):**
 - Curve Data: $\Delta = 5^\circ 45' 45''$ Rt, $D = 3^\circ 30'$, $T = 226.61'$, $L = 450.36'$, $R = 6370.2'$, $e = 0.058\%$, $T.L. = 150'$, $MDS = 50$ mph, $SSD = 430'$.
 - Stationing: $PL\ 1124+61.99$, $P.C.\ 1128+60.82$, $PT\ 1137+34.92$.

Profile View Data:


- Vertical Curve 1:**
 - Grade: $+3.20\%$
 - Stationing: $P.C.\ 1122+81.76$, $P.T.\ 1127+32.11$
 - SSD = 350', MDS = 50 MPH
- Vertical Curve 2:**
 - Grade: 0.64%
 - Stationing: $P.C.\ 1137+34.92$, $P.T.\ 1146+00.00$
 - SSD = 505', MDS = 50 MPH
- Final Grade:** -3.00%

Notes:

- 1135+00 to 1146+00 Profile Grade to be 0.5' above existing grade.
- Excavation, Embankment, Embank x 1.2, Haul Yd M, Add. Excc. Source

PLAN	NOTES
1. ALL DIMENSIONS ARE IN FEET AND DECIMALS THEREOF.	
2. ALL CURVES ARE TO BE CONSTRUCTED AS SHOWN.	
3. ALL GRADES ARE TO BE CONSTRUCTED AS SHOWN.	
4. ALL ELEVATIONS ARE TO BE CONSTRUCTED AS SHOWN.	
5. ALL DISTANCES ARE TO BE CONSTRUCTED AS SHOWN.	
6. ALL GRADES ARE TO BE CONSTRUCTED AS SHOWN.	
7. ALL ELEVATIONS ARE TO BE CONSTRUCTED AS SHOWN.	
8. ALL DISTANCES ARE TO BE CONSTRUCTED AS SHOWN.	
9. ALL GRADES ARE TO BE CONSTRUCTED AS SHOWN.	
10. ALL ELEVATIONS ARE TO BE CONSTRUCTED AS SHOWN.	


PROFILE	NOTES
1. ALL DIMENSIONS ARE IN FEET AND DECIMALS THEREOF.	
2. ALL CURVES ARE TO BE CONSTRUCTED AS SHOWN.	
3. ALL GRADES ARE TO BE CONSTRUCTED AS SHOWN.	
4. ALL ELEVATIONS ARE TO BE CONSTRUCTED AS SHOWN.	
5. ALL DISTANCES ARE TO BE CONSTRUCTED AS SHOWN.	
6. ALL GRADES ARE TO BE CONSTRUCTED AS SHOWN.	
7. ALL ELEVATIONS ARE TO BE CONSTRUCTED AS SHOWN.	
8. ALL DISTANCES ARE TO BE CONSTRUCTED AS SHOWN.	
9. ALL GRADES ARE TO BE CONSTRUCTED AS SHOWN.	
10. ALL ELEVATIONS ARE TO BE CONSTRUCTED AS SHOWN.	

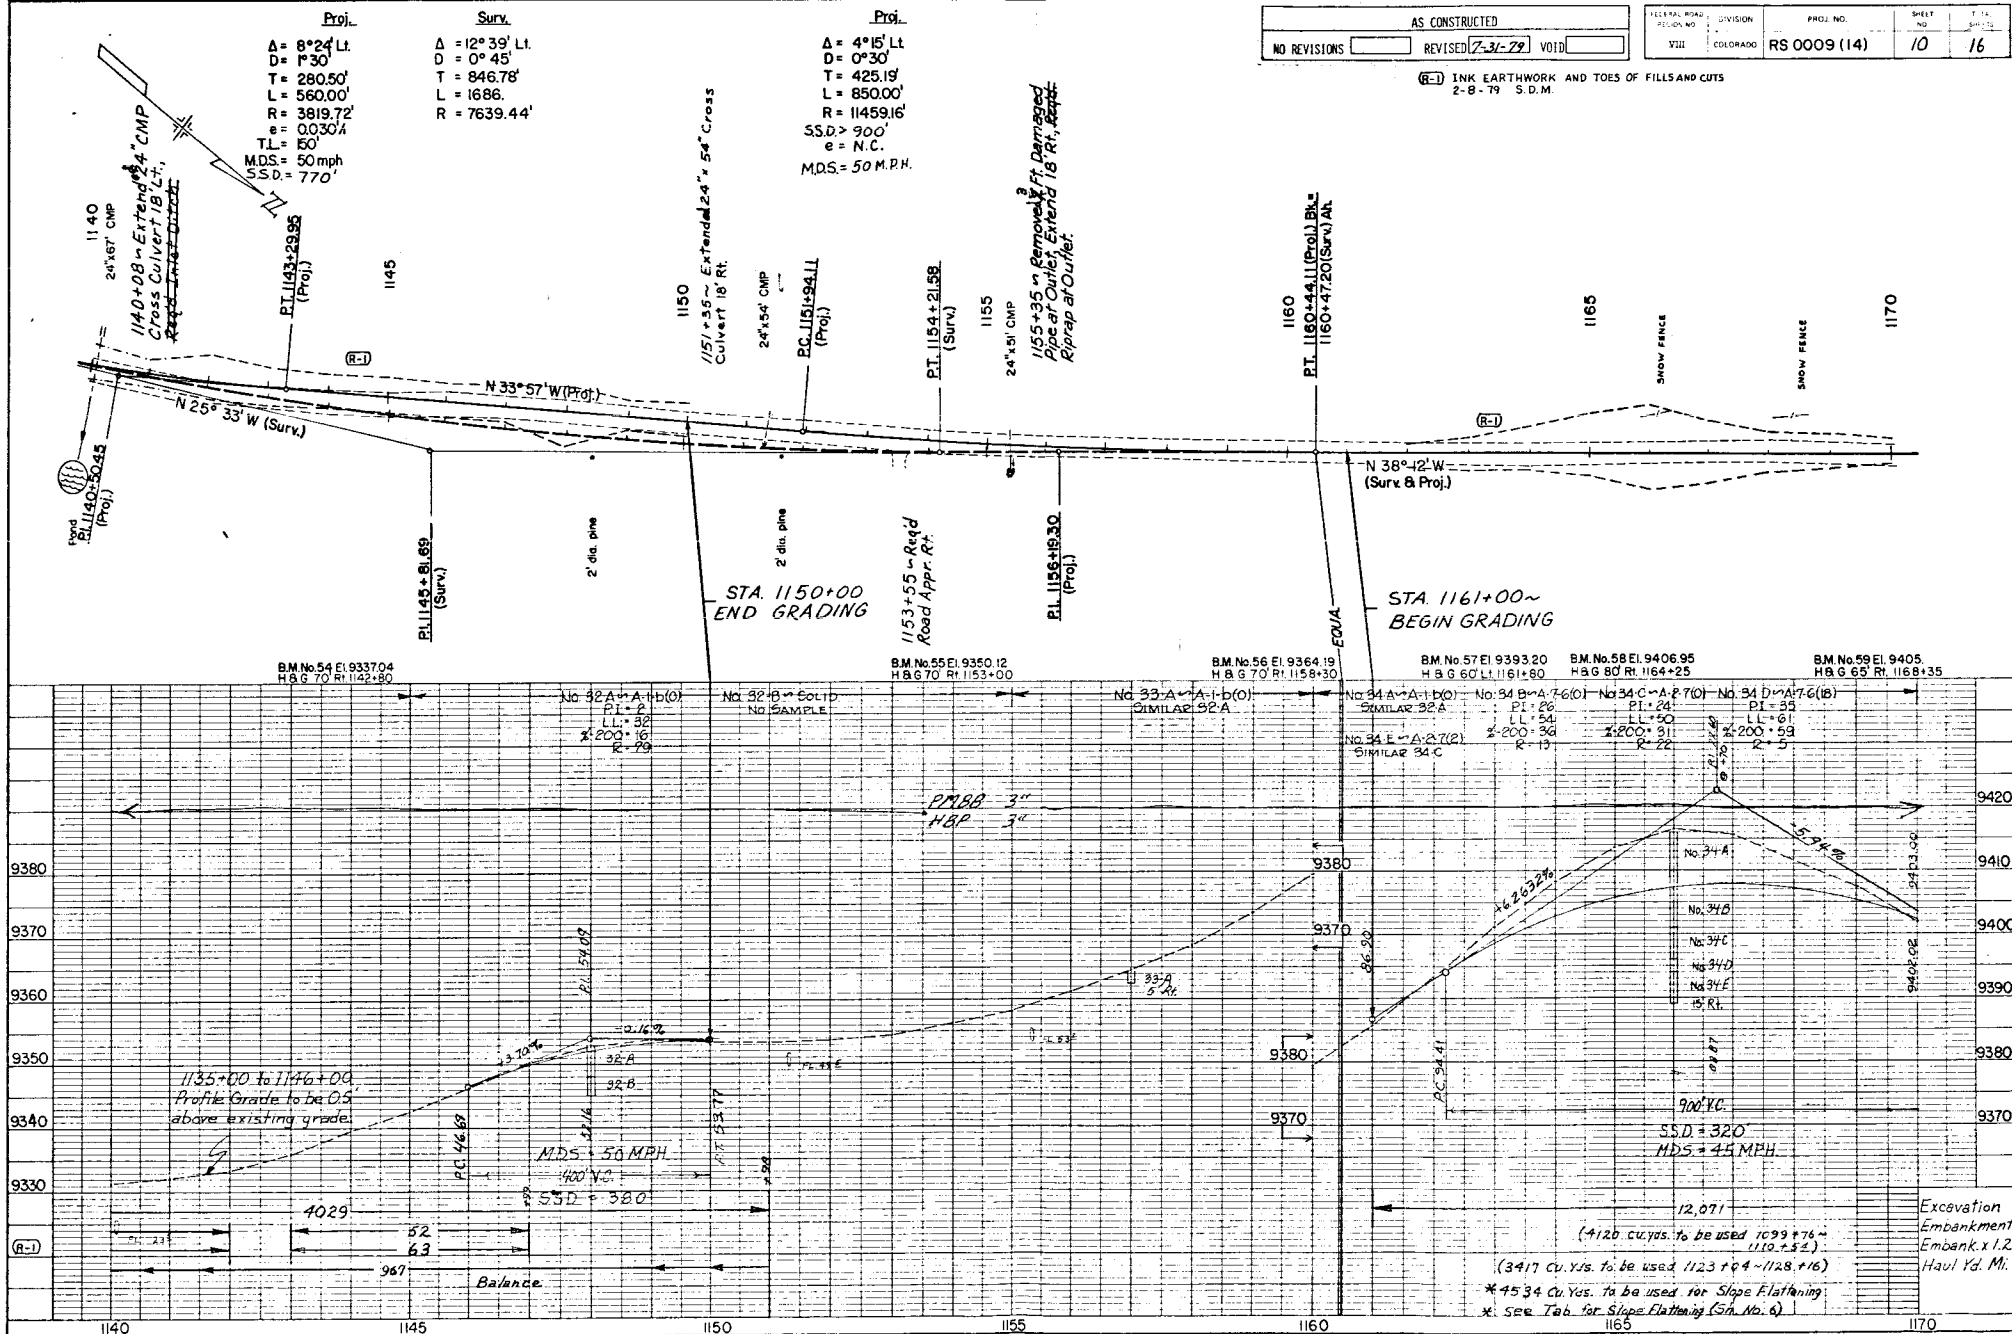

Excavation
Embankment
Embank. x 1.2
Haul Yd. Mi.

PLAN	REVISED	BY	DATE
	NOTES		
NOTE BOOK	ALUMINUM SHEETS		
14	IN. OR MAY OBTAIN		

PROFILE	ST	DATE
SURVEYED		
PLATTED		
GRADED CHECKED		
S. 45.1 MOFFS		
ADJUSTABLE INSULATIONS CHECKED		

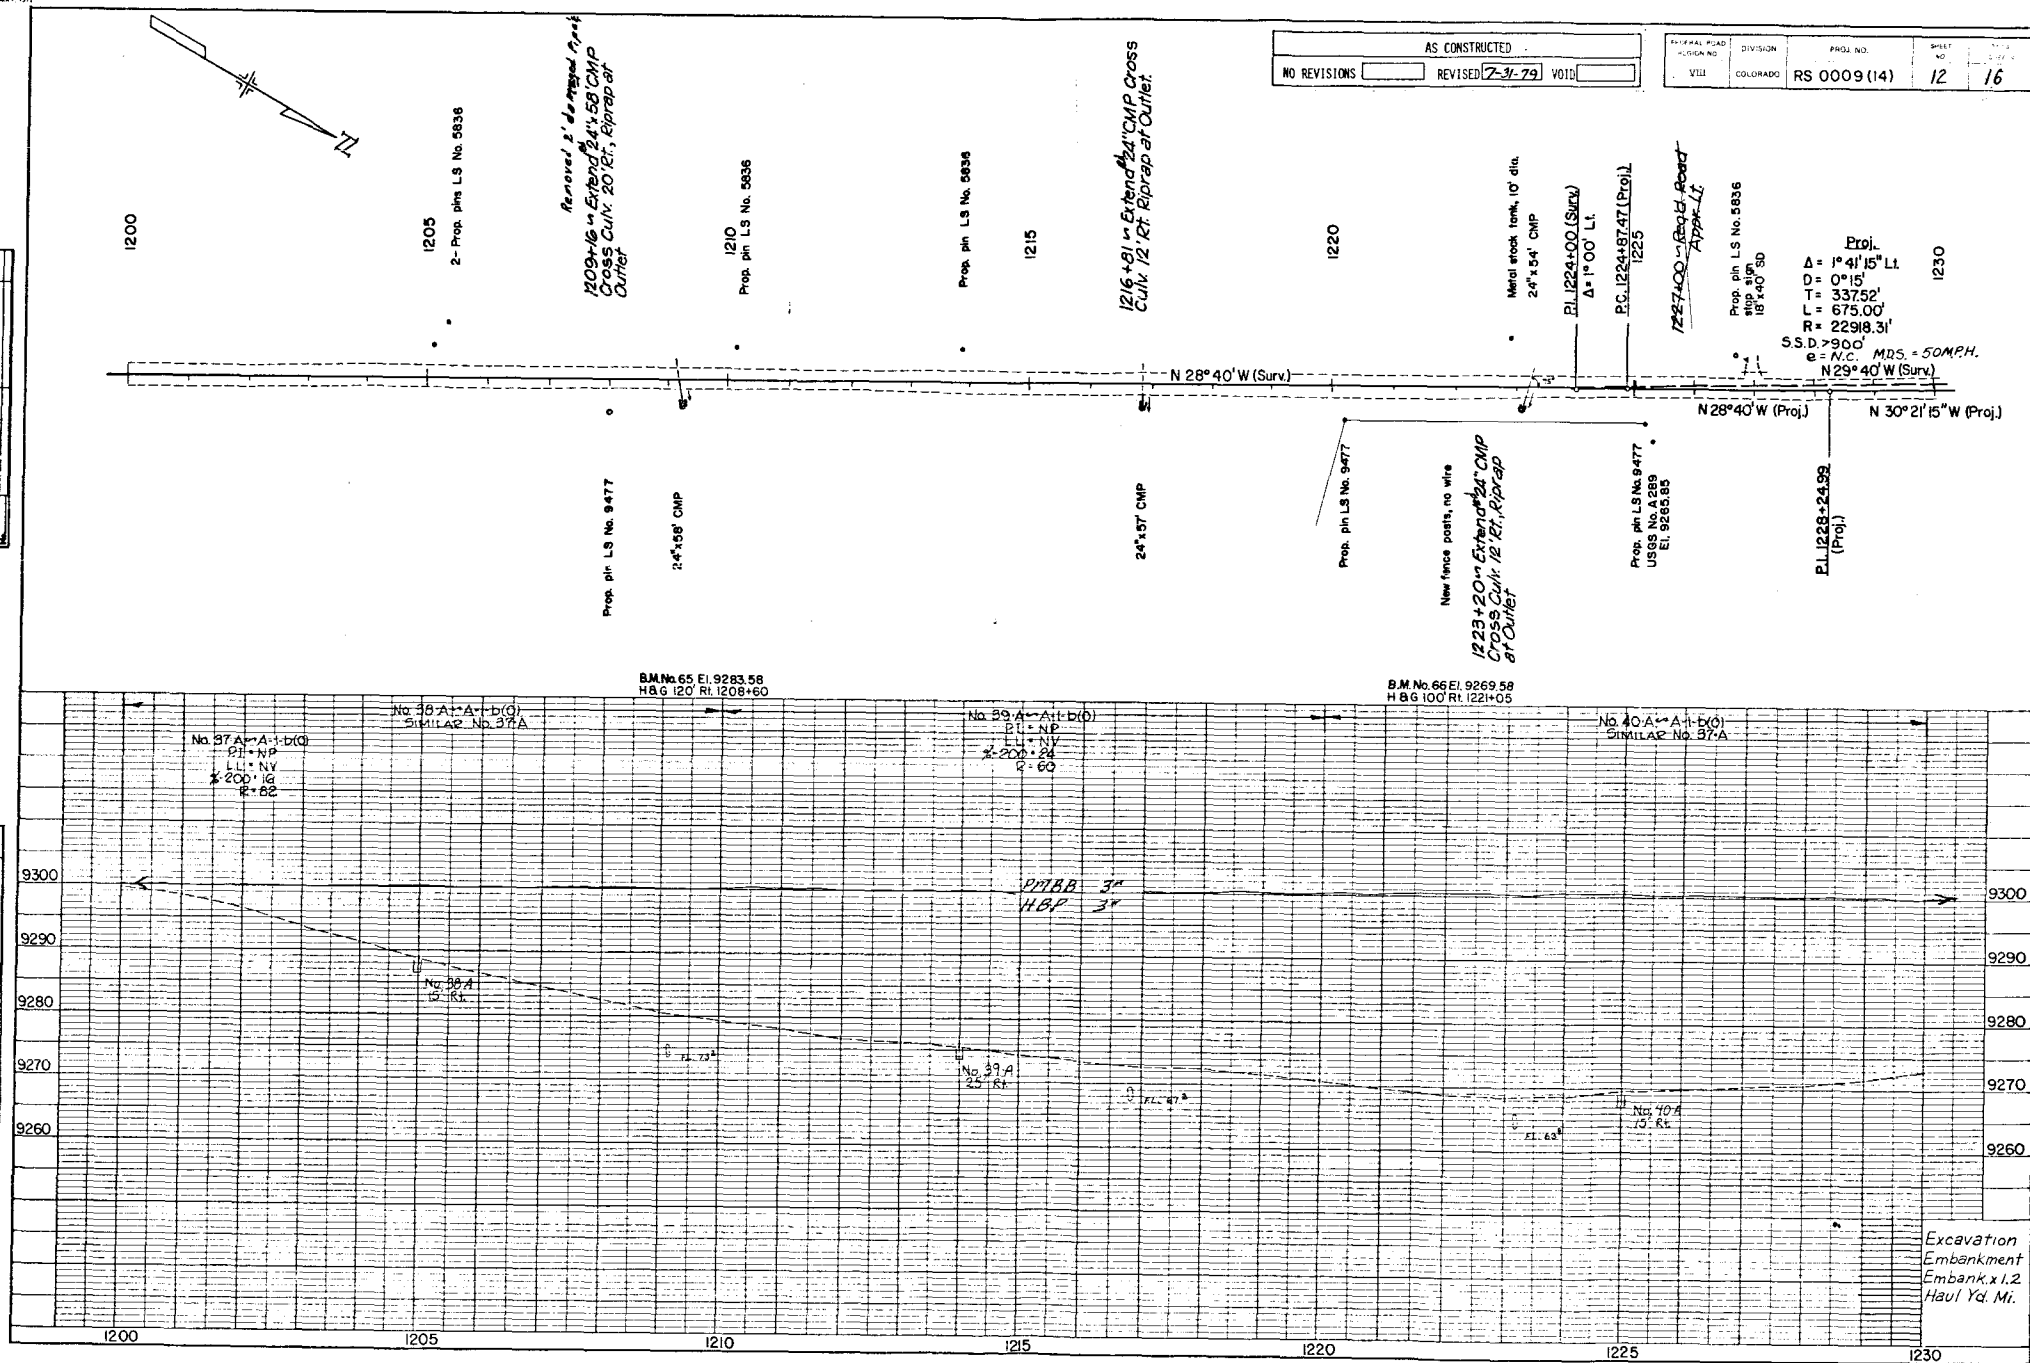


(R-1) INK EARTHWORK AND TOES OF CUTS AND FILLS
1-8-79 S.D.M.

AS CONSTRUCTED
NO REVISIONS ☐ REVISED 7-31-79 VOID ☐


FEEDBACK ROAD
DIVISION
PROJ. NO. RS 0009 (14)
SHEET 13 16

PLAN	DATE	BY	CHKD
DESIGNED			
DRAWN			
CHECKED			
IN CHARGE			

PROFILE	DATE	BY	CHKD
DESIGNED			
DRAWN			
CHECKED			
IN CHARGE			

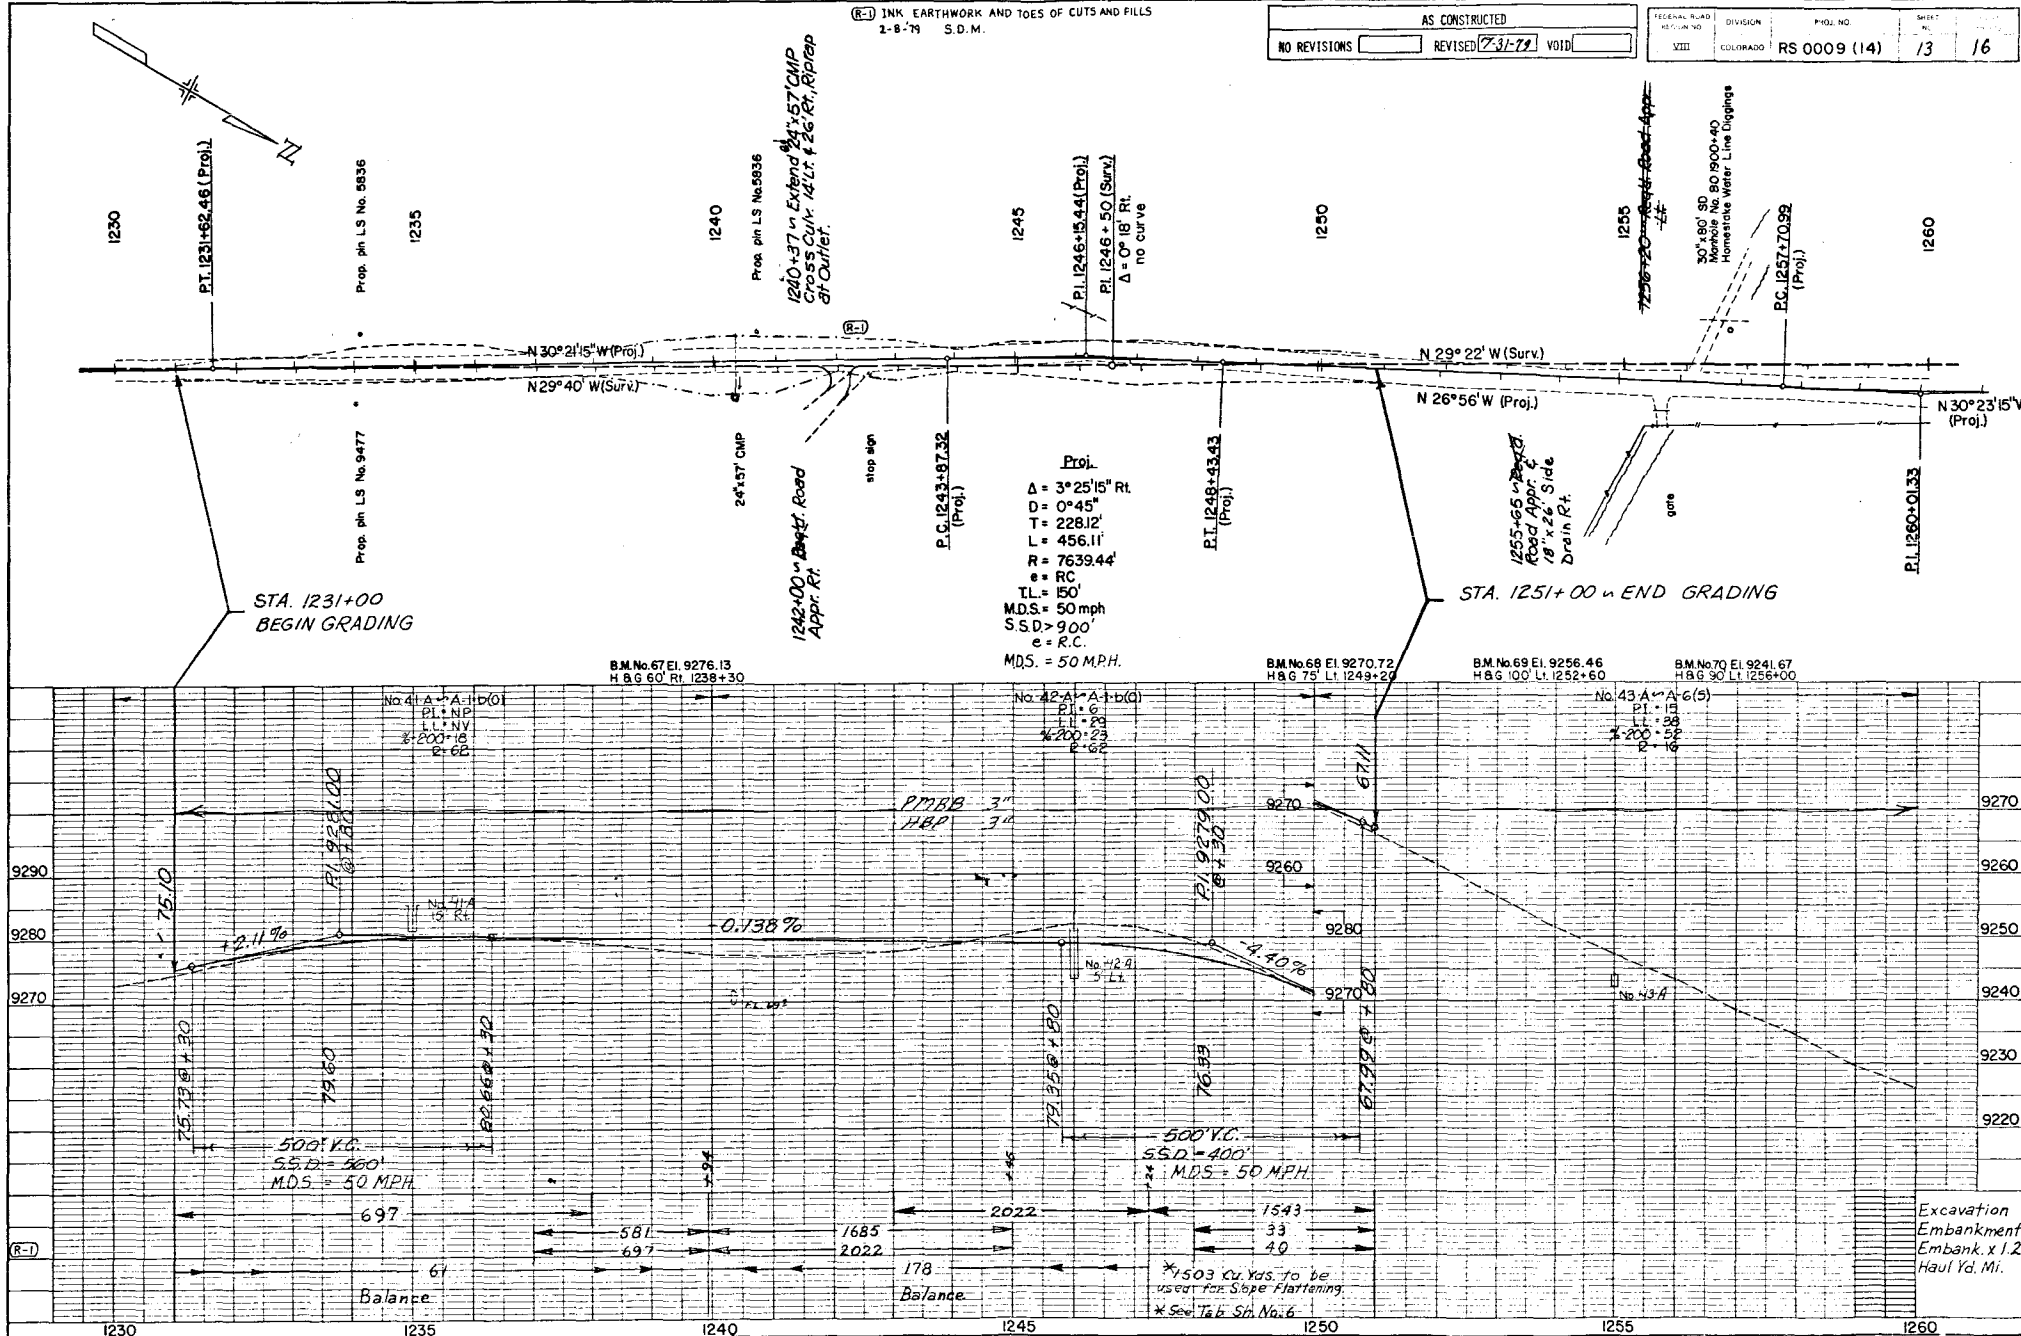

PROFILE NAME BOOK No.	SUPPLIER	BY	DATE
	PLATTER		
	GRASSIE CHESTER		
	A. M. Y. MOTOR		
	STRUCTURE INDIATIONS KNOWLEDGE		

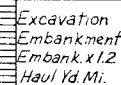

PLAN	DATE
NOTES	
BY	
CHECKED	
APPROVED	

PROFILE	DATE
NOTES	
BY	
CHECKED	
APPROVED	

AS CONSTRUCTED		
NO REVISION	REVISED 7-31-79	VOID



PROJECT NO.	15	16
DIVISION	VIII	
STATE	COLORADO	
PROJECT NAME	RS 0009 (14)	

Surv.
 $\Delta = 16^{\circ}11' \text{ Lt.}$
 $D = 0^{\circ}45'$
 $T = 1086.10'$
 $L = 2157.77'$
 $R = 7639.44'$

Proj.
 $\Delta = 12^{\circ}33'15'' \text{ Lt.}$
 $D = 1^{\circ}30'$
 $T = 420.15'$
 $L = 836.94'$
 $R = 3819.72'$
 $S.S.D. = 900'$
 $e = 0.30\%$
 $M.D.S. = 50 \text{ MPH.}$

DA = 0.10 Sa Mi.
 DESIGN $Q_{25} = 30 \text{ cfs}$
 AHW = 9108.2
 DHW = 9106.2
 Q₁₀₀ = 60 cfs
 HW = 9108.2

Proj.
 $\Delta = 3^{\circ}13'45'' \text{ Lt.}$
 $D = 0^{\circ}15'$
 $T = 646.01'$
 $L = 1291.67'$
 $R = 22918.31'$
 $S.S.D. = 900'$
 $e = N.C.$
 $M.D.S. = 50 \text{ MPH.}$

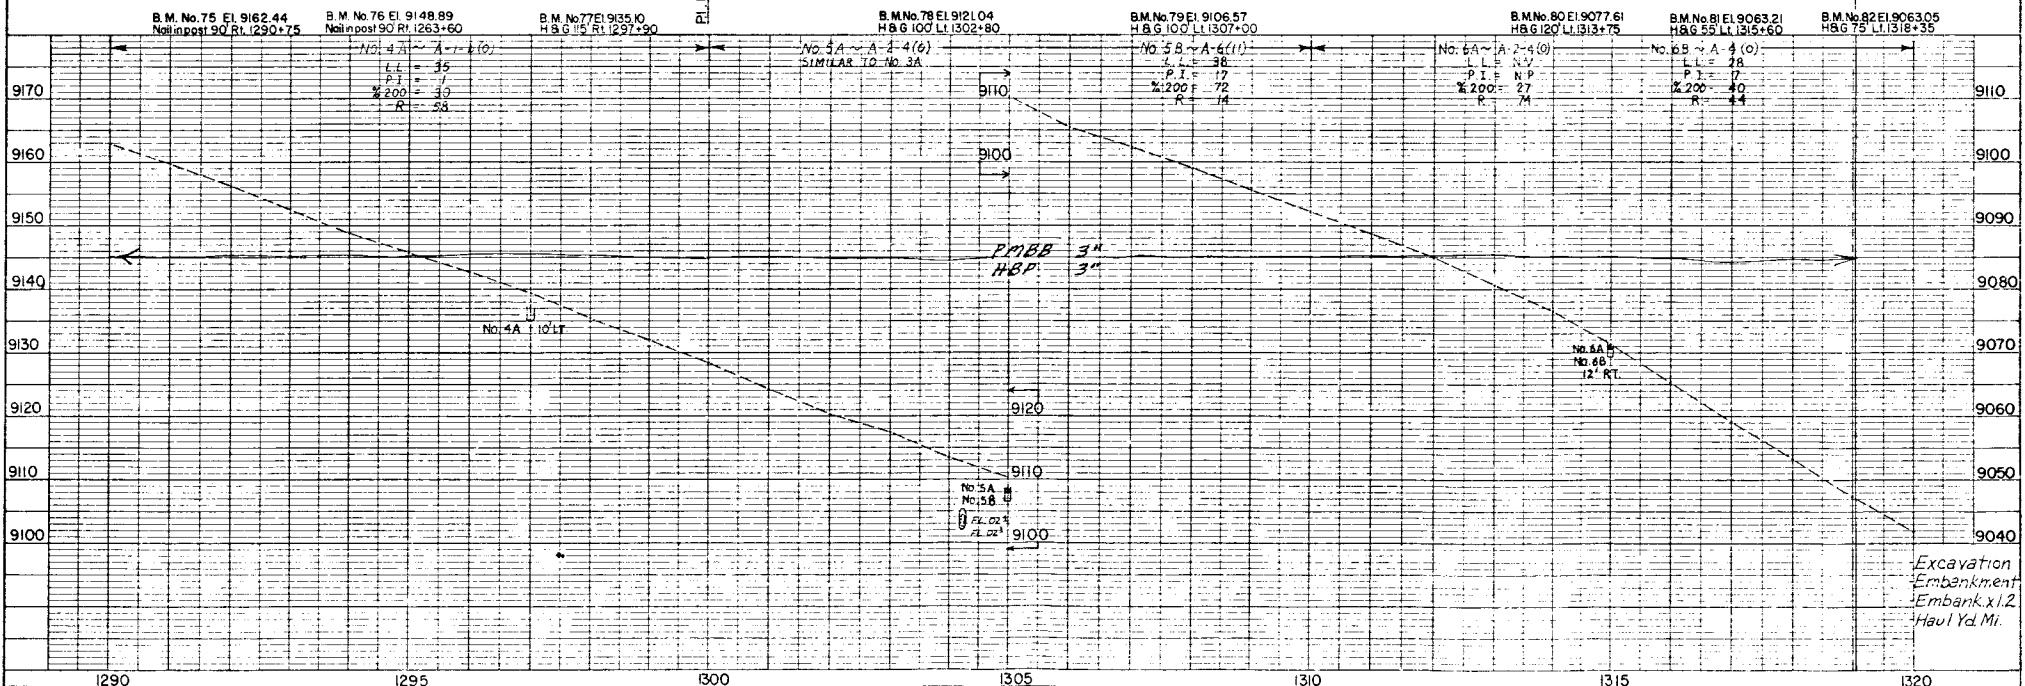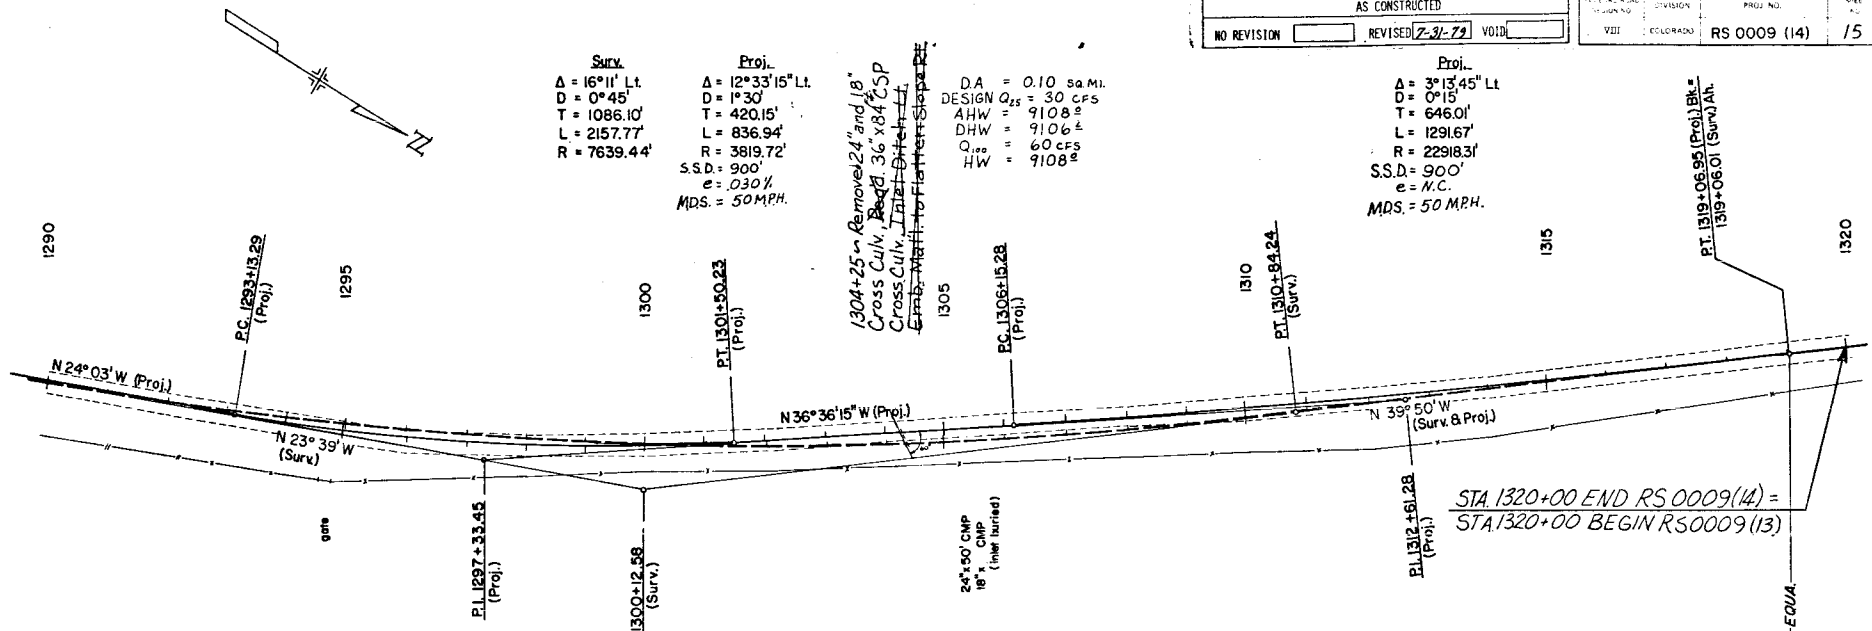

Excavation
 Embankment
 Embank x 1.2
 Haul Yd. Mi.

STANDARD M-100-A

(MAY 11, 1973)

FEDERAL ROAD REGION NO.	DIVISION	PROJ. NO.	SHEET NO.	TOTAL SHEETS
VI	COLORADO			

REVISIONS	


GENERAL NOTES

THESE SYMBOLS ARE INTENDED TO EXPLAIN THE VARIOUS TOPOGRAPHIC FEATURES INVOLVED ON THE ROADWAY PLAN SHEETS WHICH ARE PREPARED AT SCALES OF 1" = 50 FEET OR 1" = 100 FEET. NOTES ARE ADDED WHERE NECESSARY TO CLARIFY THE SYMBOL. IF THESE SYMBOLS ARE NOT APPROPRIATE FOR USE WITH OTHER SCALES, A LEGEND IS PROVIDED IN THE PLANS TO EXPLAIN THE SYMBOLS THAT ARE USED.


GLARE RAIL, CURB & GUTTER, ETC., ARE REPRESENTED BY A SYMBOL WITH TYPE GIVEN BY NOTE. SEE THE APPROPRIATE DIVISION M-STANDARD FOR EXPLANATION OF THE VARIOUS TYPES.

EXISTING BUILDINGS AND OTHER MAN MADE TOPOGRAPHICAL FEATURES NOT SYMBOLIZED HERE ARE SHOWN BY DASHED LINES WITH EXPLANATORY NOTES AS NECESSARY. NEW FEATURES TO BE CONSTRUCTED ARE SHOWN BY SOLID LINES.



TYPICAL LOG OF PIT

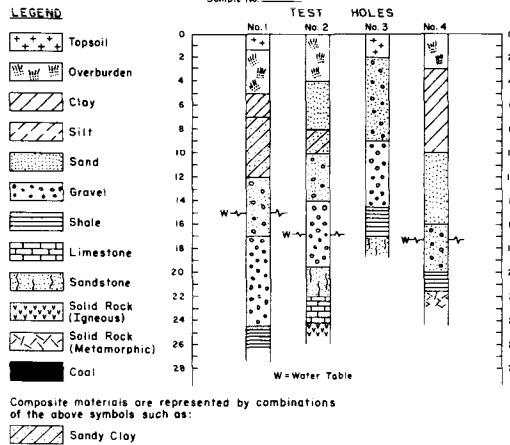






TYPICAL HORIZONTAL CURVE

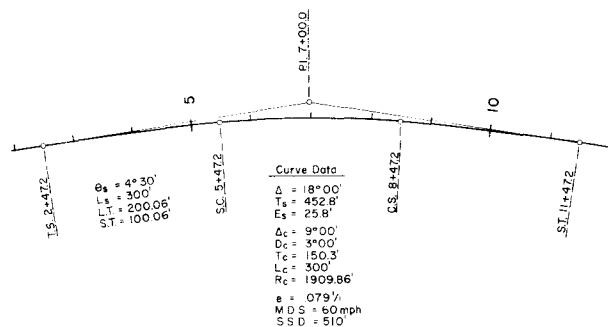

TYPICAL VERTICAL CURVE

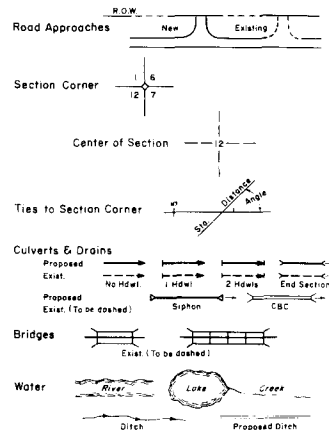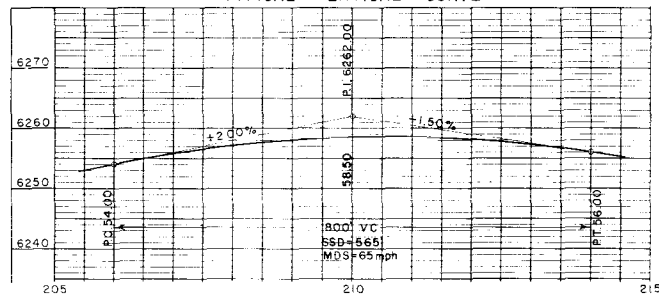

NORTH ARROWS

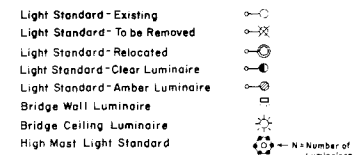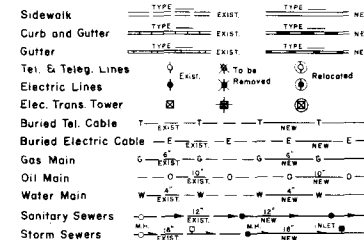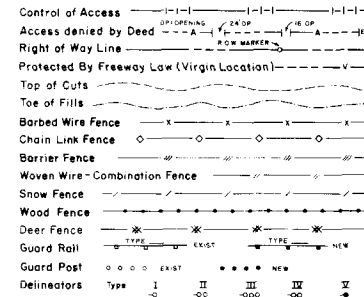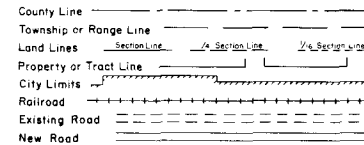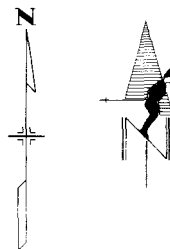

DEPARTMENT OF HIGHWAYS
STATE OF COLORADO
DIVISION OF HIGHWAYS

STANDARD SYMBOLS

Designed by RLM Approved by Staff Design Eng.
 Made by HPS
 Checked by DWD Date: May 11, 1973

STANDARD SIDE APPROACH ROADS, FLARING, CUT SLOPE TREATMENT & WIDENING AT BRIDGES AND AT CREST OF GRADES

STANDARD M-203-B

(JULY 1, 1965)

FED. ROAD DIST. NO.	DIVISION	PROJECT NO.	SHEET NO.
9	COLO.		


GENERAL DETAILS FOR FLARING OF EARTH CUTS, CUT SLOPE TREATMENT & WIDENING AT BRIDGES

TYPICAL PLANS FOR SIDE APPROACH ROADS AND EMERGENCY MEDIAN CROSS OVERS

Where practical Side Drains are to be placed in line with the roadway ditches.

50' Radii to be used on all intersecting roads except private approaches. Radii may be varied to suit field conditions.

REVISIONS	
NO.	DESCRIPTION
(R-1)	2-6-68 Median Cross Over
(R-2)	7-30-68 Dept. Name
(R-3)	4-1-69 Widening for Guard Rail
(R-4)	4-27-70 Cut Slope and Note
(R-5)	12-1-72 Cut Slope to Dimension

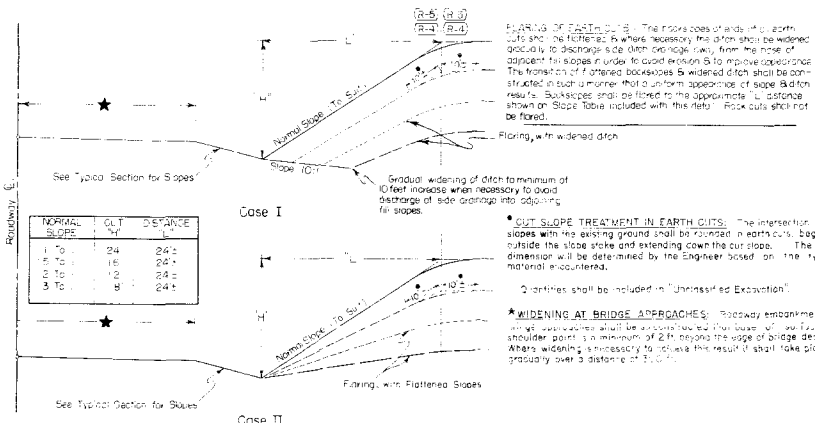

FLARING OF EARTH CUTS: The topsides of earth cuts shall be flared where necessary. The flaring shall be done so as to discharge side ditch drainage away from the nose of adjacent slopes in order to avoid erosion. To improve appearance the formation of flattened backslopes by widening ditches shall be constructed in such a manner that a uniform appearance of slope is obtained. Backslopes shall be flared to the approximate "L" distance shown on Slope Table included with this sheet. Road cuts shall not be flared.

Flaring with widened ditch

Gradual widening of ditch to minimum of 10 feet maximum when necessary to avoid drainage of side drainage into adjoining slopes.


CUT SLOPE TREATMENT IN EARTH CUTS: The intersection of cut slopes with the existing ground shall be rounded in earth cuts, beginning outside the slope stake and extending down the cut slope. The exact dimension will be determined by the Engineer based on the type of material encountered.

Quarterlines shall be included in "Unfinished Excavation".

WIDENING AT BRIDGE APPROACHES: Maximum embankment at bridge approaches shall be exposed below the lower of the existing shoulder points is a minimum of 2 ft. beyond the edge of bridge deck. Where widening is necessary to achieve this result it shall take place gradually over a distance of 100 ft.

WIDENING FOR RETAINING CURB: (Only where Guard Rail is required). See appropriate Minimum for Guard Rail.



PLAN OF FLARING IN EARTH CUTS

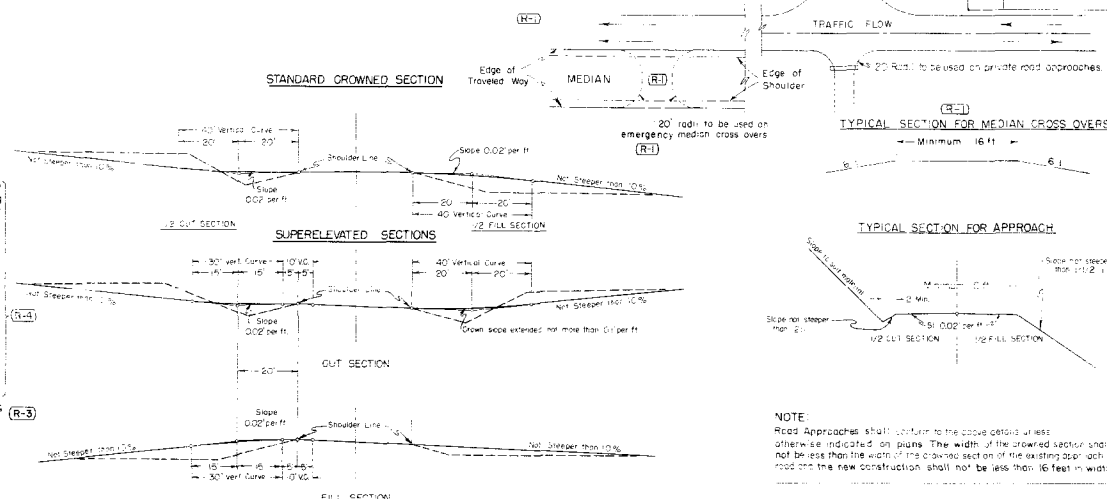

NOTE: Road Approaches shall conform to the above details unless otherwise indicated on plans. The width of the crowned section shall not be less than the width of the existing section of the existing approach road. The new construction shall not be less than 16 feet in width.

DETAILS FOR DITCH & WIDENED SHOULDERS AT CREST OF GRADES

(TO BE USED ONLY WHERE SIGHT DISTANCE AT CREST OF GRADE IS 600 FT OR LESS)

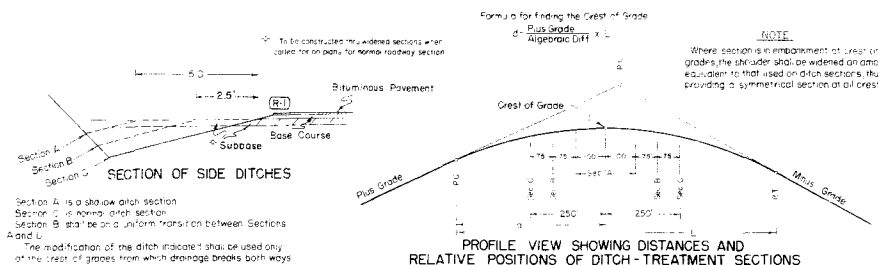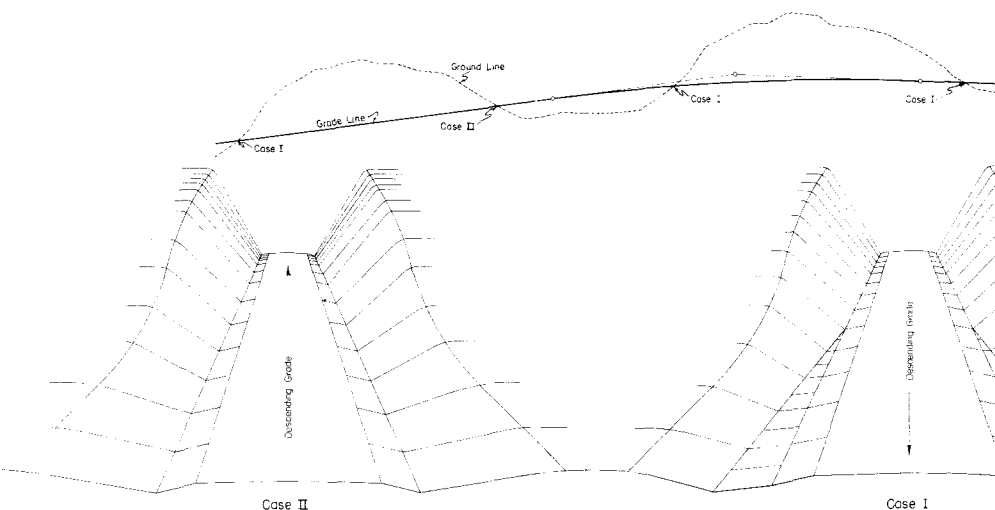

GENERAL NOTES

All work shall be done in accordance with the Standard Specifications applicable to the Project.

The maximum depth to the Project shall be 30 in. Surfaced with a 4 in. thickness of Aggregate Base Course extending approximately to the Right of Way Line. Estimated tonnage and class of material required for this operation are shown in the Aggregate Base Course Plan.

The maximum grades shown are to be limiting grades for all road approaches. Modifications of grades will be permitted where adherence to the grades as shown would cause damage to property or create other unsatisfactory conditions. Grades flatter than the maximum shown are to be used wherever feasible.

DEPARTMENT OF HIGHWAYS
STATE OF COLORADO
DIVISION OF HIGHWAYS

APPROACH ROADS,
FLARING, CUT SLOPE TREATMENT,
BRIDGE & CREST WIDENING

Designed by J. J. M. A. S. 3-4
Made by J. J. M. A. S. 3-4
Checked by C. R. S. 3-4
Approved by J. J. M. A. S. 3-4
Staff Design Eng. 3-4
Date: 3-4-65


STANDARD TYPES *of* DITCHES *and* CONSTRUCTION METHODS

STANDARD M-203-C
(JULY 1, 1965)

FED. ROAD RES. NO.	DIVISION	PROJECT NO.	SHEET NO.
9.	COLO.		

DETAILS *for* CONTOUR INTERCEPTING DITCHES

Typical Section for Contour Intercepting Ditches

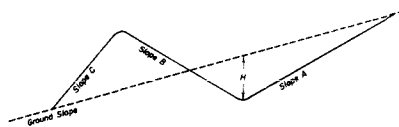

PURPOSE & USE OF THE TABLE

The primary purpose of the information for Contour and Intercepting Ditches shown on this sheet is to serve as a guide in construction and to readily arrive at yardages of excavation involved. Foremost consideration in constructing these ditches is given first to the natural ground line slope confronted in construction, thence to the other values shown on the Typical Section. By properly arriving at the combination of values shown on the Typical Section and in the Table for a specified condition, the number of cubic yards of excavation per 100 in. ft. of ditch may be read under the appropriate column for this item.

Typical Construction Layouts


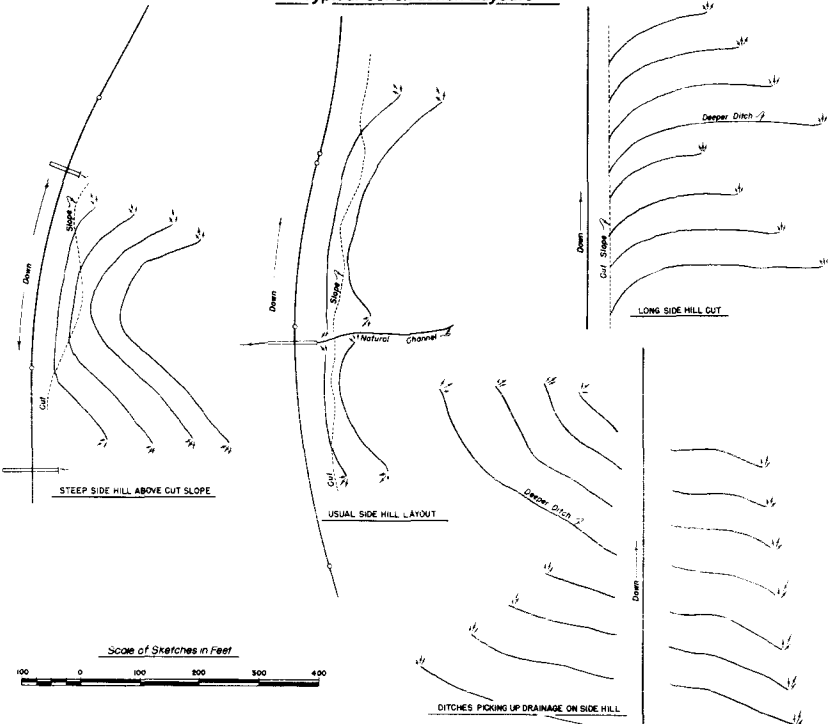


Table of Slopes and Yardages


▲ SLOPES				H	Cubic Yards per 100 in. ft. of Ditch
Ground	A	B	C		
5:1 Or Flatter	2:1	4:1	2:1	15"	16
				18"	23
				21"	32
				15"	15
				18"	22
	1-1/2:1	4:1	1-1/2:1	21"	30
				15"	14
				18"	27
				15"	13
				18"	19
4:1	2:1	4:1	2:1	21"	25
				15"	12
				18"	18
				21"	25
				15"	12
	1-1/2:1	3:1	1-1/2:1	18"	17
				21"	23
				15"	10
				18"	14
				21"	19
3:1	2:1	3:1	2:1	15"	17
				18"	24
				21"	32
				15"	15
				18"	22
	1-1/2:1	4:1	1-1/2:1	21"	30
				15"	15
				18"	21
				21"	29
				15"	13
2:1	1:1	2:1	1:1	18"	16
				21"	25
				15"	12
				18"	17
				21"	23
	1-1/2:1	3:1	1-1/2:1	15"	11
				18"	16
				21"	21
				15"	10
				18"	14
1-1/2:1	1:1	1-1/2:1	1:1	21"	20
				15"	9
				18"	13
				21"	17
				15"	8
	1-1/2:1	2:1	1-1/2:1	18"	12
				21"	16
				15"	11
				18"	15
				21"	21

▲ Slopes are approximate and may be varied to suit conditions encountered during construction.

TYPICAL SECTIONS *for* DRAINAGE, IRRIGATION DITCHES *and* CHANNEL CHANGES

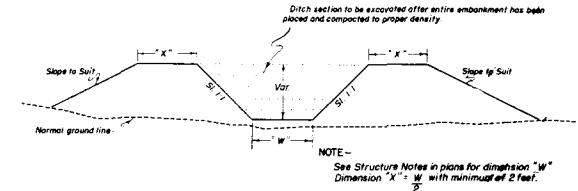

For Embankment Sections (Generally for use in Irrigation Ditches & Channel Changes)

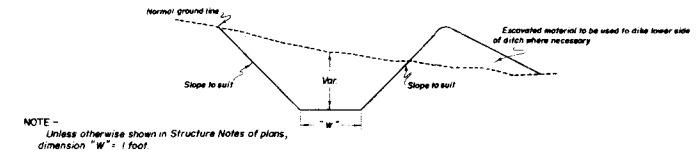

For Cut Sections

REVISIONS			
NO.	DATE	DEPT. NAME	BY
7-23-68			

GENERAL NOTES

All work shall be done in accordance with the Standard Specifications applicable to the Project.

All ditches are to be constructed to lines and grades as staked by the Engineer using the ditch section shown on plans or as ordered by the Engineer.

CONTOUR INTERCEPTING DITCHES - Ditches are to be laid out along the ground contour on a grade of not over 1% (Type of soil shall govern the grade). Lines of ditches are to be lined up so that concentration of flow from a higher contour ditch into one of lower contour ditches, as far as possible avoided. The use of a deeper ditch is recommended where this condition is encountered.

The following horizontal spacing of ditches is recommended:
4% to 6% Approximately 70' Centers
6% to 10% Approximately 60' Centers
10% to 15% Approximately 55' Centers
15% to 20% Approximately 50' Centers

Where ditch checks are required the intervening ditch between one set of ditch checks shall not exceed a grade of 1.0%. Details of checks will be shown on plans when required.

DEPARTMENT OF HIGHWAYS
STATE OF COLORADO
DIVISION OF HIGHWAYS

DITCH TYPES

Designed by G.W. Made by G.W. Checked by G.W. Approved by G.W. Draft Design Engr. Date: July 1, 1965


STANDARD M-206-AB

(MARCH 4, 1976)
(SHEET 1 OF 3)


FEDERAL ROAD DISTRICT NO.	DIVISION	PROJ. NO.	SHEET NO.	TOTAL SHEETS
VII	COLORADO			

REVISIONS				
(R-1)	3-26-76	Gen. Note, footing in rock		T.A.L.
(R-2)	4-16-76	Limit of Str. Excav. in Box Culv. detail		T.A.L.
(R-3)	5-8-76	Backfill for wingwall		T.A.L.

SIPHON OR CONDUIT IN TRENCH

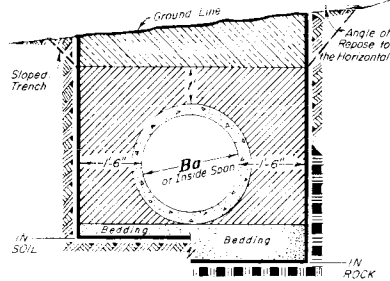


CIRCULAR CONDUIT

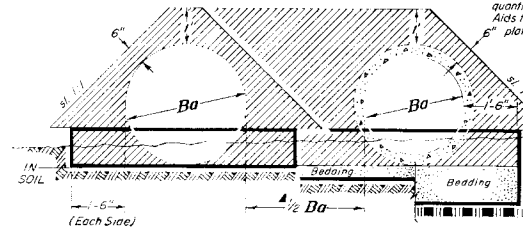


NOTE: For additional Culvert installation details and for Backfill quantities, see M Standards (Design Aids for metal, concrete, structural 6\"/>


ELLIPTICAL OR ARCH CONDUIT

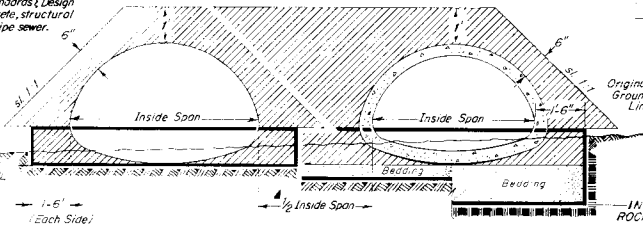

CAST IN PLACE CONDUIT

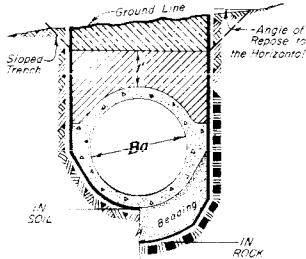


TRENCH FOR PIPE UNDERDRAIN

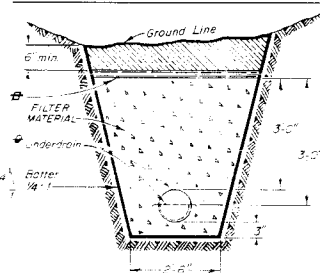


When 2 or more conduits are laid side by side they shall be placed so that the adjacent pipes will be $\frac{1}{2}$ Inside Diameter or $\frac{1}{2}$ Inside Span or 3 feet apart (including wall thickness) whichever is less. Minimum spacing shall be not less than one foot between outside walls of pipe or End Section.


CONDUIT WITH END SECTIONS

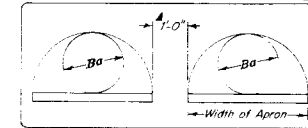


RETAINING WALL IN CUT & IN PARTIAL CUT

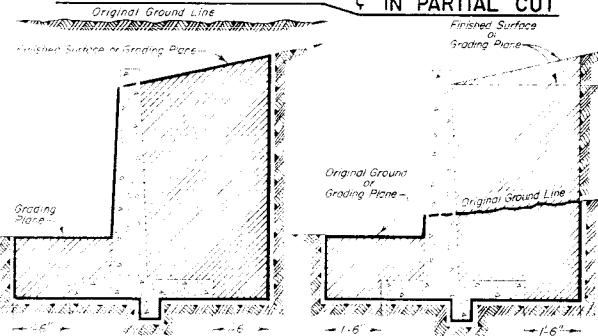

HEAD WALL

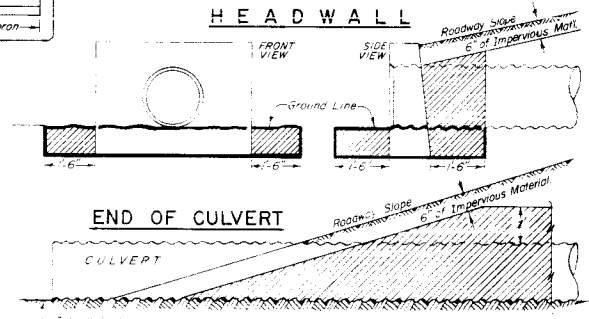

END OF CULVERT

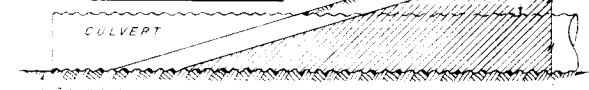

GENERAL NOTES (R-1)

- All work shall be done in accordance with the Standard Specifications applicable to the project.
- * Where the roadway cross section is in FILL, excavation for box culverts shall be done as follows:
1. Embankment shall be built up to one foot above the bottom of the box culvert.
 2. The trench shall then be excavated to accommodate construction of the box culvert. Excavation and Backfill patterns different from those indicated on these sheets will be shown elsewhere on the Plans.
- Excavation for structure installation shall be classified as "Structure Excavation" unless otherwise shown on the Plans.
- Structure footings which are located in rock shall be poured out to undisturbed rock without forming.

**DEPARTMENT OF HIGHWAYS
STATE OF COLORADO
DIVISION OF HIGHWAYS**

**EXCAVATION & BACKFILL
FOR STRUCTURES**

Designed by: M.P.H.
Made by: J.B.B.
Checked by: G.L.S.

Approved by: B.L. Lamm
Staff Design Engineer
Date: March 4, 1976


STANDARD M-206-AB

(MARCH 4, 1976)
(SHEET 2)


FEDERAL ROAD REGION NO.	DIVISION	PROJ. NO.	SHEET NO.	TOTAL SHEETS
VIII	COLORADO			

REVISIONS:				
(R-1)	3-26-76	Revision date only.		T.A.L.
(R-2)	4-16-76	" " "		T.A.L.
(R-3)	5-8-76	" " "		T.A.L.

STRUCTURE EXCAVATION MEASUREMENT FOR PIPE CULVERTS

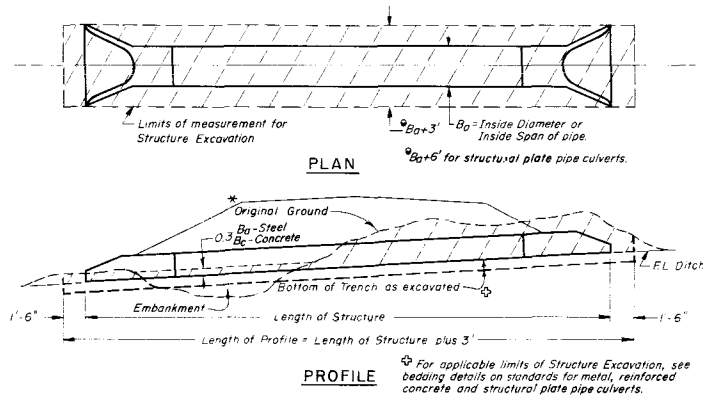

STRUCTURE EXCAVATION MEASUREMENT FOR CONCRETE BOX CULVERTS

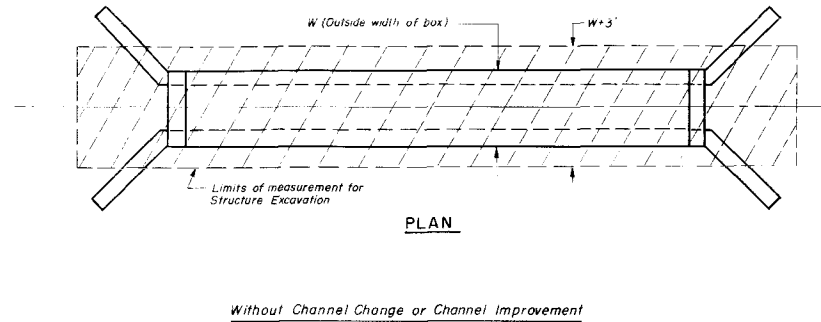

GENERAL NOTES (Continued)



TRENCH INSTALLATION:

Trenches over 5 feet in depth shall be either shored or the trench walls shall be sloped to the angle of repose. If sloped, the bottom of the slope shall be a minimum of 1 foot above the top of the pipe.

Shoring will be required when the bottom of the slope is more than 3 feet above the bottom of the trench. Shoring shall extend a minimum of one foot above the bottom of the slope.

Timber sheeting or shoring may be cut off 1 foot above the top of the pipe after backfilling is complete.

STRUCTURE EXCAVATION MEASUREMENT FOR DIVERSION OR DIVISION BOXES

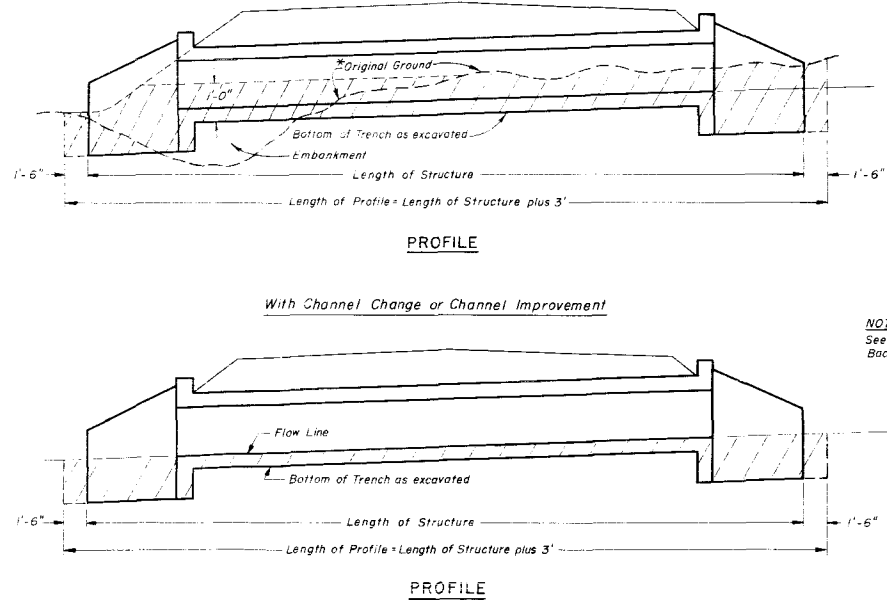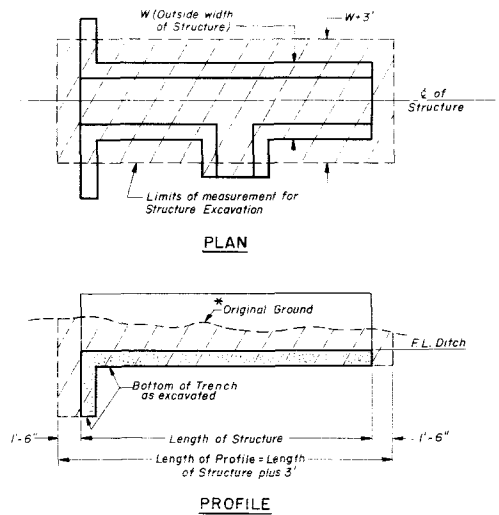

NOTE:
See Sheet 1 for General Notes and Backfilling Details

DEPARTMENT OF HIGHWAYS
STATE OF COLORADO
DIVISION OF HIGHWAYS
EXCAVATION AND
BACKFILL
FOR STRUCTURES

Designed by M.R.H. Approved by H.P.B.
Made by H.P.B. Staff Design Eng.
Checked by Date: March 4, 1976


STANDARD M-206-AB

(MARCH 4, 1976)
(SHEET 3)



FEDERAL ROAD DISTRICT NO.	DIVISION	PROJ. NO.	SHEET NO.	TOTAL SHEETS
VIII	COLORADO			

REVISIONS			
NO.	DATE	REVISION	BY
H-1	3-26-76	Revision date only	T.A.L.
R-2	4-16-76	" " "	T.A.L.
H-3	5-8-76	" " "	T.A.L.



IN FILL

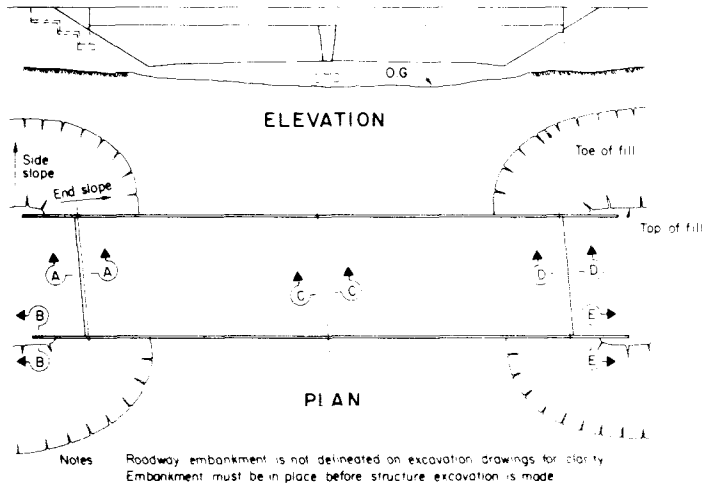


EXCAVATION --- BACKFILL

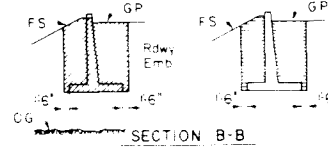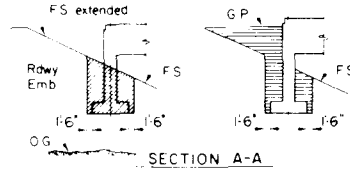


EXCAVATION --- BACKFILL

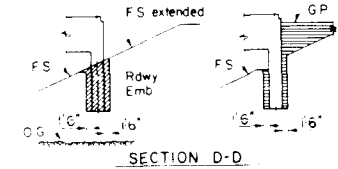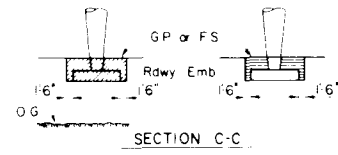




EXCAVATION --- BACKFILL

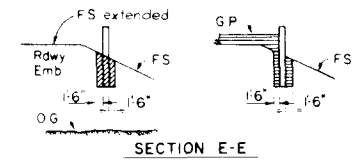



IN CUT

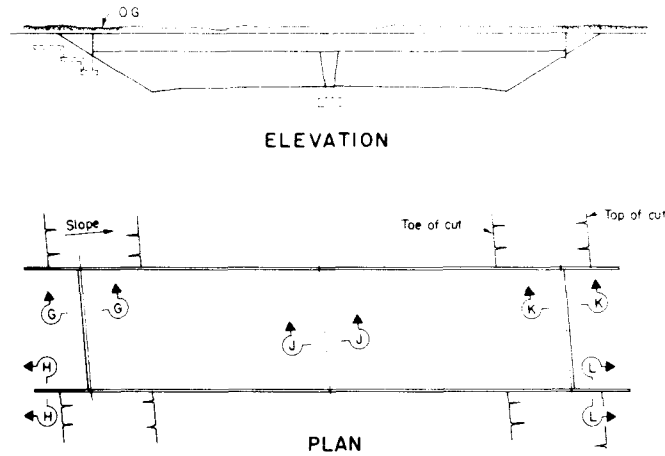

EXCAVATION --- BACKFILL

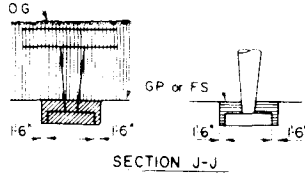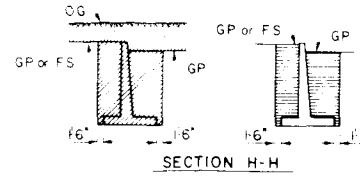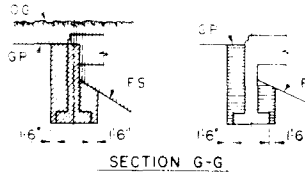

EXCAVATION --- BACKFILL

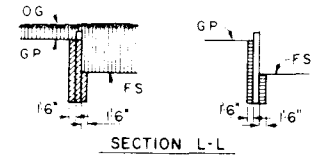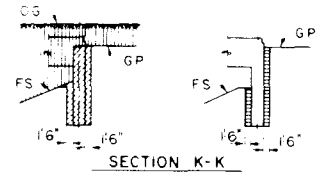

ABBREVIATIONS

- OG: Original Ground
- FS: Planned Finished Surface
- GP: Planned Grading Plane

LEGEND

- Structure Excavation
- Structure Backfill
- Roadway Excavation

Note: If no roadway excavation is involved at bridge, structure excavation is measured from original ground.

DEPARTMENT OF HIGHWAYS
STATE OF COLORADO
DIVISION OF HIGHWAYS

**EXCAVATION & BACKFILL
FOR STRUCTURES
(BRIDGE)**


Designed by: M.R.H. Accepted by: A.L. Thomas
Made by: J.R.B. Staff Design Engineer
Checked by: O.L.S. Date: March 4, 1976

STANDARD M-60I-L

(JANUARY 8, 1969)

FEDERAL ROAD DISTRICT	PROJ. NO.	SHEET NO.	TOTAL SHEETS
VIII	COLORADO		


REVISIONS			
(R-1)	4-15-71	Concrete in Gen. Note. Grate weights.	M.R.H.
(R-2)	5-24-71	Lower fastener bolt so top is flush w conc.	M.R.H.
(R-3)	4-30-73	Change WWF & steel designations.	M.R.H.
(R-4)	3-31-75	Revise Grate Installation.	M.R.H.

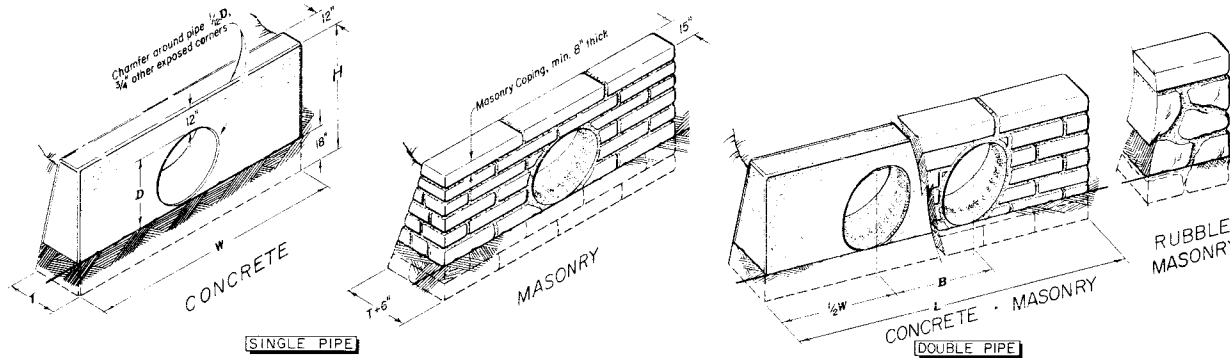

SINGLE PIPE

HEADWALL INSTALLATIONS

DOUBLE PIPE

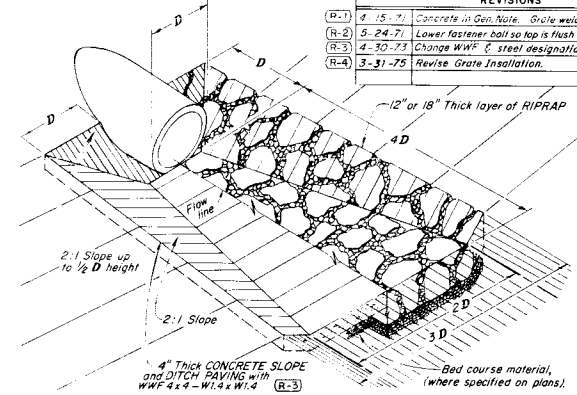

CULVERT OUTLET PAVING

QUANTITIES FOR ONE CONCRETE HEADWALL

		DIAMETER (AND EQUIVALENT DIAMETER) Inches				(S = Span)				(R = Rise)					
		18		24		30		36		42		48			
TYPE	MAT'L	SGL	DBL	SGL	DBL	SGL	DBL	SGL	DBL	SGL	DBL	SGL	DBL	SGL	DBL
C	RCP	1.0	1.3	1.5	2.0	2.0	2.7	2.8	3.6	3.6	4.6	4.6	6.0		
	CSP	1.1	1.4	1.6	2.1	2.2	3.0	3.0	4.0	3.9	5.3	5.0	6.8		
A	RCP	0.9	1.2	1.3	1.8	1.7	2.3	2.3	3.1	2.9	3.9	3.7	4.4		
	CSP	0.9	1.3	1.4	1.9	1.8	2.4	2.4	3.4	3.2	4.4	3.4	5.0		
		S	R	S	R	S	R	S	R	S	R	S	R		
		22	13	29	18	36	22	43	27	50	31	58	36		

QUANTITIES FOR ONE MASONRY HEADWALL



		DIAMETER (AND EQUIVALENT DIAMETER) Inches				(S = Span)				(R = Rise)					
		18		24		30		36		42		48			
TYPE	MAT'L	SGL	DBL	SGL	DBL	SGL	DBL	SGL	DBL	SGL	DBL	SGL	DBL	SGL	DBL
C	RCP	1.3	1.7	1.9	2.5	2.6	3.4	3.5	4.5	4.4	6.1	5.6	7.2		
	CSP	1.4	1.8	2.0	2.7	2.8	3.7	3.8	5.0	4.8	6.8	6.1	8.2		
A	RCP	1.4	1.9	2.1	2.8	2.9	3.9	3.9	5.3	5.0	7.2	6.4	8.8		
	CSP	1.4	1.9	2.1	2.9	3.0	4.1	4.0	5.5	5.2	7.6	6.6	9.2		
		S	R	S	R	S	R	S	R	S	R	S	R		
		22	13	29	18	36	22	43	27	50	31	58	36		

CONCRETE FOR INTERCEPTING HEADWALL

		18		24		30		36		42		48	
TYPE	MAT'L	SGL	DBL	SGL	DBL	SGL	DBL	SGL	DBL	SGL	DBL	SGL	DBL
C	RCP	1.6	2.1	2.2	2.9	2.9	3.8	3.8	5.0	4.8	6.8	6.1	8.2
	CSP	1.7	2.2	2.3	3.0	3.0	4.1	4.0	5.5	5.2	7.6	6.6	9.2

PAVING FOR CULVERT OUTLET


		18		24		30		36		42		48	
THICK-MATERIAL		SGL	DBL	SGL	DBL	SGL	DBL	SGL	DBL	SGL	DBL	SGL	DBL
4" CONCRETE		0.4	0.8	1.2	1.7	2.4	3.1						
12" RIPRAP		1.3	2.3	3.6	5.2	7.1	9.3						
18" RIPRAP		2.0	3.5	5.4	7.8	10.7	13.9						

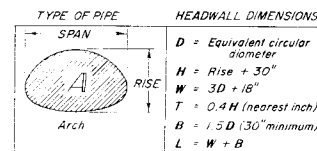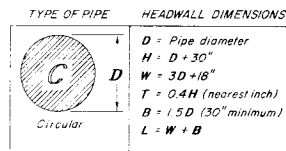

NOTE: Volume occupied by pipe has been deducted.




INTERCEPTING HEADWALL DIMENSIONS

SYMBOL	FORMULA	DIMENSION IN INCHES											
D	Pipe Dia.	18	24	30	36	42	48						
E	$D + 25.5$	43.5	49.5	55.5	61.5	67.5	73.5						
F	$D + 16.5$	34.5	40.5	46.5	52.5	58.5	64.5						
G	$(D + 5)$	6.5	7.0	7.5	8.0	8.5	9.0						
J	$D + 26$	31.0	38.0	45.0	52.0	59.0	66.0						

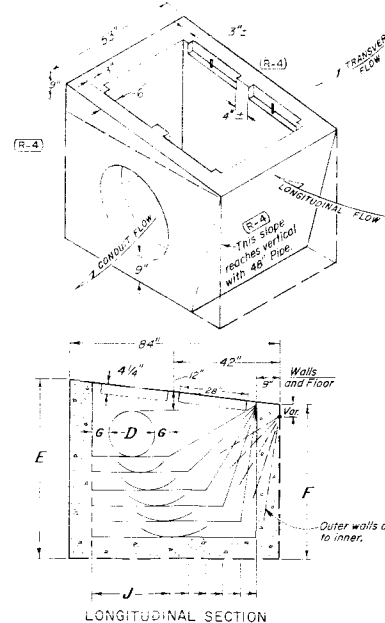

GENERAL NOTES (R-1)

- All work shall be done in accordance with the Standard Specifications applicable to the project.
- For size and location of culverts, see plans.
- All concrete shall be Class A, B or D.
- All exposed concrete surfaces shall receive Class I finish.
- Futings in rock shall be poured out to rock and not formed.
- Inlet Grating shall be galvanized as described for Frames, Grates, Covers and Steps in Section 712.

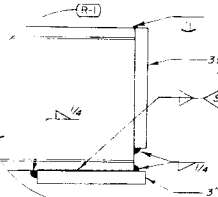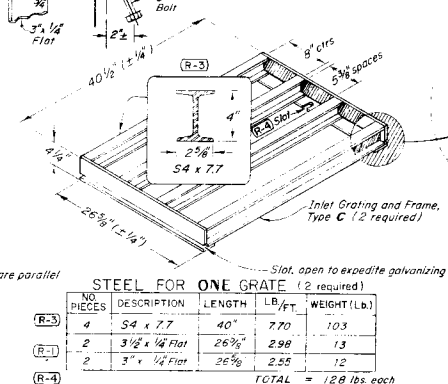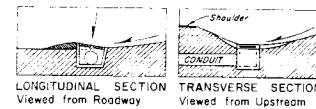

DEPARTMENT OF HIGHWAYS STATE OF COLORADO DIVISION OF HIGHWAYS HEADWALL, INTERCEPTING HEADWALL AND CULVERT OUTLET PAVING

Designed by M.R.H. Approved by J.R.B.
Made by J.R.B. Staff Design Engineer
Checked by R.S.M. Date January 8, 1969

INTERCEPTING HEADWALL AND GRATE

STANDARD M-603-MA

(JANUARY 11, 1974)

FILL HEIGHT & THICKNESS TABLES FOR METAL CULVERT PIPE

TABLE I CORRUGATED STEEL PIPE

22 1/2-inch by 1/2-inch Corrugations
Riveted, Welded or Helical Fabrication

Pipe Diameter (inches)	Minimum Cover, Top of Pipe to Top of Subgrade (inches)	Maximum Fill Heights above Top of Pipe in Feet				
		Minimum Thickness Required (Decimal inches)				
		0.064	0.079	0.109	0.138	0.168
12	12	64	91	—	—	—
15	12	67	73	—	—	—
18	12	56	61	—	—	—
24	12	42	46	59	—	—
30	12	34	36	47	—	—
36	12	28	30	39	41	—
42	12	31	43	46 (67)	48 (70)	50 (73)
48	12	27	37	45 (58)	46 (61)	47 (64)
54	12	—	33	43 (52)	44 (54)	45 (57)
60	12	—	—	43 (47)	43 (49)	44 (51)
66	12	—	—	42	43	43 (47)
72	12	—	—	—	41	43
78	12	—	—	—	—	39
84	12	—	—	—	—	35


Values for elongated pipe are shown in parentheses.

TABLE II CORRUGATED STEEL PIPE ARCH


22 1/2-inch by 1/2-inch Corrugations
Riveted, Welded or Helical Fabrication

Pipe Dimensions Span x Rise (inches)	Equiv. Diameter (inches)	Min. Corner Radius (inches)	Minimum Cover, Top of Pipe to Top of Subgrade for 2 Tons per sq. ft. (inches)	Minimum Thickness Required (Decimal inches)	Maximum Fill Heights above Top of Pipe in Feet	
					Corner Bearing Pressure in Tons per Square Foot	
					2 Tons	3 Tons
17 x 13	15	3	18	0.064	13	15+
21 x 15	18	3	18	0.064	12	15+
24 x 18	21	3	18	0.064	10	15+
28 x 20	24	3	18	0.064	10	15
35 x 24	30	3	18	0.064	9	14
42 x 29	36	3 1/2	18	0.064	9	13
49 x 33	42	4	18	0.079	8	12
57 x 38	48	5	18	0.109	8	12
64 x 43	54	6	18	0.109	8	12
71 x 47	60	7	18	0.138	8	12
77 x 52	66	8	18	0.168	8	12
83 x 57	72	9	18	0.168	9	13

METAL CULVERT WITH END SECTIONS

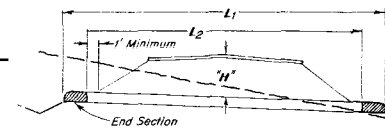


METAL CULVERT WITHOUT END SECTIONS

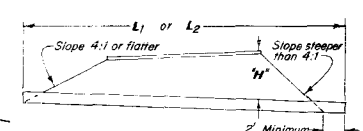

"H" = Maximum height of fill over top of Culvert, including pavement.
L1 = Length of Culvert to be measured when placed in accordance with Section 617.
L2 = Length of pipe to be measured when placed in accordance with Section 603.
Length of extension, when placed in accordance with Section 617, shall be the actual number of feet of new culvert required.

INSTALLATION OF METAL CULVERT PIPE

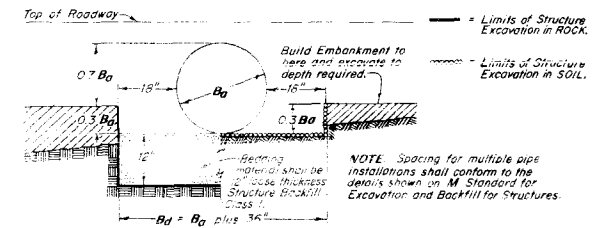

GENERAL NOTES

- All work shall be done in accordance with the Standard Specifications applicable to the project.
- The tables on this sheet show minimum thickness for structural requirements only. They are intended for use only where corrosive and/or abrasive conditions are negligible. Heavier metal and/or protective coatings shall be used where site investigations indicate corrosive and/or abrasive conditions.
- Pipe arch with equal periphery and with span and rise dimensions approximately equal to those required by plans will be permitted.
- During construction, adequate cover shall be provided to protect the structure from damage.
- Pipe shall be placed with longitudinal seams of the sides or quarter points but not along top of vertical axis.
- When a culvert is to be extended with pipe of different material, the connection shall conform to the details on plans or be approved.
- Structural plate pipes of equal or larger diameter, conforming to Section 510 of the Standard Specifications, may be substituted for the pipes shown on this sheet at no additional cost to the State.
- Variations from corner radii shown will be acceptable provided the pipe is of sufficient strength to support its designated fill height.
- The minimum depth of fill excluding pavement over corrugated metal pipe culvert shall be as stated by the Engineer, but shall not be less than shown in the Fill Height Tables.
- Extensions for CSP Arch Culvert shall match the corrugations and the span & rise dimensions of the culvert shown on plans.
- Backfill and compaction shall be in accordance with Section 206.
- TRENCH INSTALLATION
Installation and Maximum Fill Heights shall conform to the M Standard for "Pipe Sewer in Trench."

TABLE III CORRUGATED STEEL PIPE

3-inch by 1-inch Corrugations
Riveted, Welded, Helical or Bolted Fabrication

Pipe Diameter (inches)	Minimum Cover, Top of Pipe to Top of Subgrade (inches)	Maximum Fill Heights above Top of Pipe in Feet				
		Minimum Thickness Required (Decimal inches)				
		0.064	0.079	0.109	0.138	0.168
36	12	48	60	78 (88)	89 (106)	101 (118)
42	12	41	51	64 (76)	71 (91)	79 (101)
48	12	36	45	57 (66)	61 (80)	66 (88)
54	12	32	40	52 (59)	55 (71)	59 (79)
60	12	29	36	49 (53)	51 (64)	54 (71)
66	12	26	33	47	49 (58)	51 (64)
72	12	24	30	44	47 (53)	49 (59)
78	12	22	28	41	46 (49)	47 (54)
84	12	21	26	38	45	46 (51)
90	12	19	24	35	43	45
96	12	18	22	33	40	44
102	24	17	21	31	38	42
108	24	—	20	30	35	39
114	24	—	19	28	34	37
120	24	—	—	27	32	35

* Fill heights greater than 90" shall be used only after thorough investigation of foundation material.

TABLE IV CORRUGATED STEEL PIPE ARCH

3-inch by 1-inch Corrugations
Riveted, Welded or Helical Fabrication

Pipe Dimensions Span x Rise (inches)	Equiv. Diameter (inches)	Min. Corner Radius (inches)	Minimum Cover, Top of Pipe to Top of Subgrade for 2 Tons per sq. ft. (inches)	Minimum Thickness Required (Decimal inches)	Maximum Fill Heights above Top of Pipe in Feet	
					Corner Bearing Pressure in Tons per Square Foot	
					2 Tons	3 Tons
40 x 31	36	6	18	0.064	12	15+
46 x 36	42	6	18	0.064	12	15+
53 x 41	48	7	18	0.064	12	15+
59 x 46	54	8	18	0.064	12	15+
66 x 51	60	9	18	0.064	12	15+
73 x 56	66	12	18	0.064	15+	—
81 x 59	72	14	18	0.079	14	—
87 x 63	78	14	18	0.079	14	15+
95 x 67	84	16	18	0.109	13	—
103 x 71	90	16	24	0.109	12	15+
112 x 75	96	18	24	0.109	11	15+
117 x 79	102	18	24	0.109	10	15
128 x 83	108	18	24	0.138	9	14

(R-2)

TABLE V CORRUGATED ALUMINUM PIPE

22 1/2-inch by 1/2-inch Corrugations
Riveted, Helical or Spot Welded Fabrication

Pipe Diameter (inches)	Minimum Cover, Top of Pipe to Top of Subgrade (inches)	Maximum Fill Heights above Top of Pipe in Feet				
		Minimum Thickness Required (Decimal inches)				
		0.060	0.075	0.105	0.135	0.075
12	12	45	45	78	81	26
18	12	30	30	52	54	18
24	12	22	22	39	41	14
30	12	18	18	31	32	11
36	12	15	15	26	27	9
42	12	—	26	43	44	—
48	12	—	—	40	41	—
54	12	—	—	35	37	—
60	12	—	—	—	33	—
66	12	—	—	—	30	—
72	12	—	—	—	29	—

TABLE VI CORRUGATED ALUMINUM PIPE ARCH

22 1/2-inch by 1/2-inch Corrugations
Riveted, Welded or Helical Fabrication

Pipe Dimensions Span x Rise (inches)	Equiv. Diameter (inches)	Corner Radius (inches)	Minimum Cover, Top of Pipe to Top of Subgrade for 2 Tons per sq. ft. (inches)	Minimum Thickness Required (Decimal inches)	Maximum Fill Heights above Top of Pipe in Feet	
					Corner Bearing Pressure in Tons per Square Foot	
					2 Tons	3 Tons
18 x 11	15	4	18	0.060	15	—
22 x 13	18	4	18	0.060	14	—
25 x 16	21	4	18	0.060	12	15+
29 x 18	24	4 1/2	18	0.060	10	15+
36 x 22	30	5	18	0.060	9	14
43 x 27	36	6 1/2	18	0.075	9	13
50 x 31	42	6	18	0.105	8	12
58 x 36	48	7	18	0.135	8	12
65 x 40	54	8	18	0.135	8	12
72 x 44	60	9	18	0.164	8	12

* In the absence of a Bearing Pressure Report use fill heights listed under "2 Tons". Where bearing pressures exceeding 2 tons per square foot are required for given fill heights, the foundation material shall be investigated to determine its bearing capacity.

DEPARTMENT OF HIGHWAYS
STATE OF COLORADO
DIVISION OF HIGHWAYS

METAL CULVERT PIPE
H-20 LOADING

Designed by M.R.H. Approved by J.R.B. Staff Design Engineer
Checked by G.L.S. Date: January 11, 1974

STANDARD S-612-1A

(SHEET 1 OF 4 SHEETS)

OCTOBER 28, 1977

FEDERAL ROAD REGION NO.	DIVISION	PROJ. NO.	SHEET NO.	TOTAL SHEETS
III	COLORADO			
REVISIONS				

SPACING FOR DELINEATOR POSTS ON HORIZONTAL CURVES					
'D' DEGREE OF CURVE	'R' RADIUS (FEET)	*-O- SPACING ON CURVE (FEET)	* SPACING IN ADVANCE OF AND BEYOND CURVE (FEET)		
			FIRST SPACE	SECOND SPACE	THIRD SPACE
0° 30'	14600	300	300	300	300
1° 00'	57300	226	300	300	300
1° 30'	38200	184	300	300	300
2° 00'	28850	139	300	300	300
2° 30'	22920	142	284	300	300
3° 00'	19100	129	259	300	300
3° 30'	16371	120	239	300	300
4° 00'	14325	112	223	300	300
4° 30'	12733	105	210	300	300
5° 00'	11460	99	199	298	300
5° 30'	10418	94	189	283	300
6° 00'	9550	90	181	271	300
6° 30'	8815	87	173	260	300
7° 00'	8186	83	166	250	300
7° 30'	7640	80	160	240	300
8° 00'	7163	77	155	232	300
8° 30'	6741	75	150	225	300
9° 00'	6367	73	145	218	300
9° 30'	6032	71	141	212	300
10° 00'	5730	69	137	206	300
10° 30'	5457	67	134	200	300
11° 00'	5209	65	130	195	300
11° 30'	4983	64	127	191	300
12° 00'	4775	62	124	186	300
15° 00'	3820	55	109	164	300
18° 00'	3183	49	96	147	235
21° 00'	2729	45	90	134	269
25° 00'	2292	40	80	120	241
30° 00'	1910	36	71	107	214
40° 00'	1432	29	58	87	174
50° 00'	1146	24	48	72	145
60° 00'	955	20	40	61	121

* ON CONVENTIONAL ROADWAYS OMIT THE THIRD SPACE AND DOUBLE THE SPACING ON THE CURVE AND IN ADVANCE OF AND BEYOND THE CURVE (300 MAX)

$R = \frac{5730}{D}$


• SPACING FOR CURVES NOT SHOWN MAY BE COMPUTED FROM THE FORMULA: $S = 3 \sqrt{R - 50}$

SPACING IN ADVANCE OF AND BEYOND CURVE IS: FIRST SPACE = 2S; SECOND SPACE = 3S; AND THIRD SPACE = 6S. SPACES SHOULD NOT BE LESS THAN 20 FEET NOR MORE THAN 300 FEET.


GENERAL NOTES

- All work shall be done in accordance with the Standard Specifications applicable to the Project.
- See the Tabulation of Quantities included in the Plans for the numbers and locations of delineators required.
- The color of delineators shall, in all cases, conform to the color of Edge Lines stipulated in the latest edition of the Manual on Uniform Traffic Control Devices and the Colorado Supplement thereto, except:
 - Red delineators.
 - Type III delineators (Yellow Hazard Marker)
- The color of delineator posts and all special mounting brackets shall be Interstate Green.
- Type I (Crystal) delineators are optional for all conventional roadways.
- Type I (Crystal) delineators shall be installed on the right side of expressway roadways (Except Note No. 9).
- Type I (Yellow) delineators are optional on the left side of expressway roadways. They may be placed in the median or attached to median barriers.
- Red delineators may be installed on the reverse side of any delineator and/or a separate post on one-way roadways or ramps where investigation shows a need for wrong-way movement protection.
- Delineation shall be optional on sections of roadway between interchanges where fixed-source lighting is in operation.
- Interchange ramps shall be delineated on the right side, the left side, or both sides with Type I (Crystal or Yellow) delineators of the appropriate color as illustrated on sheet number 3.
- Frontage road delineators are not to be installed where they might be misleading to mainline traffic.
- Spacing of delineators for tunnels and snow sheds shall be as directed by the Engineer.
- Normal spacing will be 528 feet for tangent sections and a 200 foot minimum will apply to a "lost space". (Maximum spacing is also 528 feet.) At all other locations, such as A B D lanes, Ramps, Width Transitions and Turn Lanes a "lost space" should not be less than 50% of the spacing shown for that location.
- Type II delineators shall be installed at 100 foot spaces on all acceleration lanes, deceleration lanes, and lane transitions involving pavement width changes.
- Type I delineators shall be installed at 100 foot spaces on interchange ramp tangent sections and by the spacing table on ramp curves. Spacing "in advance of and beyond curve" does not apply to ramp curves.
- For spacing on a curve that follows a tangent section with spaces shorter than those shown in the curve table, modify the table so that the curve spacing is no greater than the tangent spacing.
- Where guard rail intrudes into the space between the pavement edge and the line of delineators, place the delineators immediately above or behind the rail face.
- When normal spacing fails on an intersecting roadway, driveway, etc. the delineator may be moved either direction a distance not exceeding one-quarter of the normal spacing.
- The angular placement for all delineators should be by the "traffic orienting" method: aim the face of the delineator at the centerline of the nearest lane of approaching traffic at a point 300 feet away (as directed by the Engineer for special or hazardous locations and curves having a degree of curvature greater than 6°).
- Where practicable the approach ends of islands and medians should be delineated.

TYPICAL DELINEATOR PLACEMENT

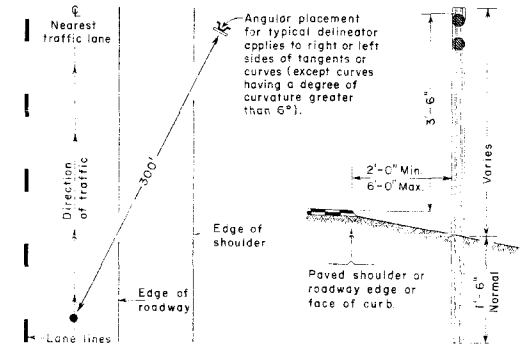

TYPICAL U-2 DELINEATOR POST

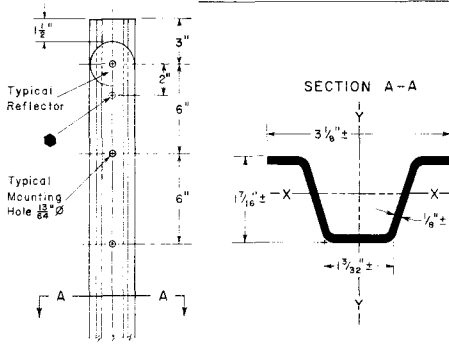

POST NOTES

Steel posts shall be hot-rolled steel or re-rolled rail steel.

Posts are to weigh 2 lbs./ft. with a mill tolerance of minus 3 1/2 % of the weight of any one post being allowed.


Alternate post is acceptable if section modulus is at least 0.200 in.³ about the X-X axis and at least 0.250 in.³ about the Y-Y axis.

Posts shall be set in drilled or excavated holes, placed plumb and firmly tamped in place, or may be driven plumb.

A minimum of 3 holes of 1 3/16" diameter, spaced as shown, are required for all delineator posts.

- An additional hole is required when the Adjustable Reflector Bracket is used.

TYPICAL DELINEATOR FABRICATION DETAILS

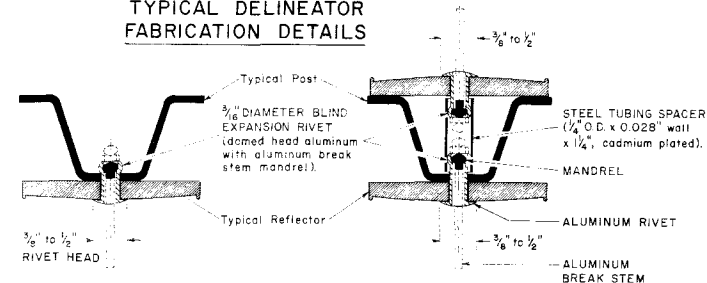

DEPARTMENT OF HIGHWAYS
 STATE OF COLORADO
 DIVISION OF HIGHWAYS
 TYPICAL
 DELINEATOR
 INSTALLATIONS

Designed by F. B. Approved by Staff Traffic Engineer
 Made by F. B. Staff Traffic Engineer
 Checked by J. S. Date OCT 28, 1977

STANDARD S-612-1A

(SHEET 2 OF 4 SHEETS)
OCTOBER 28, 1977

FEDERAL ROAD REGION NO.	DIVISION	PROJ. NO.	SHEET NO.	TOTAL SHEETS
XII	COLORADO			

REVISIONS

NO.	DESCRIPTION


TYPICAL INSTALLATION FOR TANGENT SECTION AND CURVES

NOTE

δ IS THE DISTANCE LEFT OVER AFTER CURVE SPACING AND IS TO BE PRORATED AMONG ALL CURVE SPACINGS SO THAT THE LAST DELINEATOR FALLS AT THE END OF THE CURVE.


CONVENTIONAL ROADWAY

DELINEATORS ARE NOT REQUIRED BUT ARE OPTIONAL.

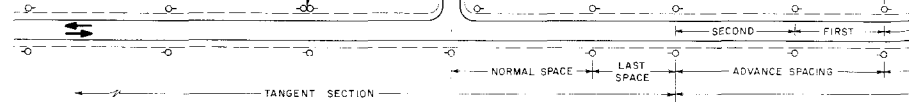


EXPRESSWAY ROADWAYS

DELINEATORS ARE REQUIRED.

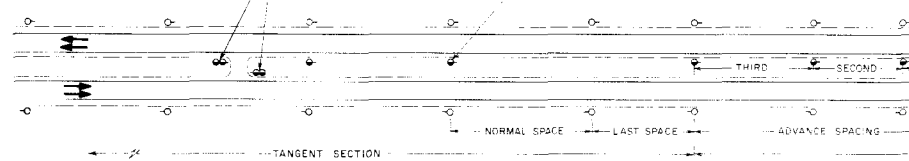


TYPICAL INSTALLATION FOR LANE TRANSITION

WIDTH REDUCTION ON LEFT SIDE

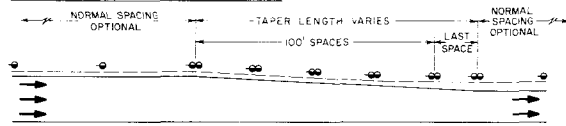


WIDTH REDUCTION ON RIGHT SIDE

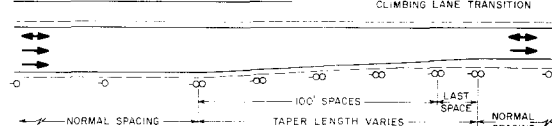


NOTE: THIS DELINEATOR TREATMENT IS ALSO REQUIRED FOR PAVEMENT WIDTH INCREASE.

TYPICAL INSTALLATION FOR BRIDGE APPROACHES

CONVENTIONAL ROADWAY

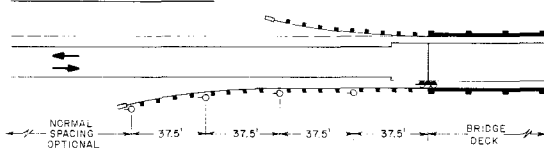


EXPRESSWAY ROADWAY

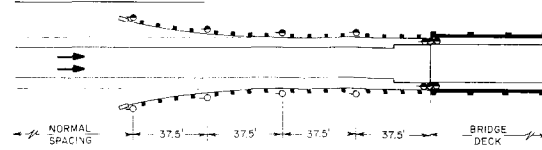

TYPICAL INSTALLATION FOR MINOR INTERSECTION

* = NORMAL SPACING IF THIS ROADWAY IS DELINEATED.

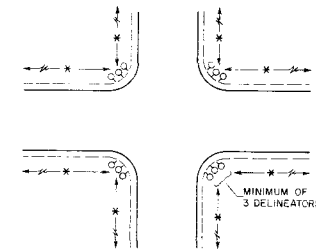

BRIDGE NOTES

WHERE CURB TO CURB WIDTH OF BRIDGE IS EQUAL TO OR GREATER THAN ROADWAY WIDTH PLUS USABLE SHOULDER WIDTH, USE THE TYPE III DELINEATOR HAZARD MARKER ONLY AND OMIT ALL THE TYPE I DELINEATORS.

FOR GUARD RAIL INSTALLATIONS WHERE APPROACH END IS NOT FLARED, PLACE A TYPE III DELINEATOR HAZARD MARKER IMMEDIATELY IN ADVANCE OF APPROACH END.

ALL TYPE I DELINEATORS ARE TO BE MOUNTED ABOVE OR IMMEDIATELY BEHIND GUARD RAIL AND ARE NOT A CONSTANT DISTANCE FROM THE ROADWAY.

DELINEATOR SYMBOLS

- TYPE I (CRYSTAL)
- TYPE I (YELLOW)
- TYPE I (RED)
- TYPE II (2 CRYSTAL)
- TYPE II (2 YELLOW)
- TYPE II (CRYSTAL-CRYSTAL, BACK-TO-BACK)
- TYPE II (YELLOW-YELLOW, BACK-TO-BACK)
- TYPE II (CRYSTAL-RED, BACK-TO-BACK)
- TYPE II (YELLOW-RED, BACK-TO-BACK)
- TYPE III (3 YELLOW, HAZARD MARKER)
- TYPE III (2 CRYSTAL-RED, BACK-TO-BACK)
- TYPE III (2 YELLOW-RED, BACK-TO-BACK)

DEPARTMENT OF HIGHWAYS
STATE OF COLORADO
DIVISION OF HIGHWAYS
TYPICAL
DELINEATOR
INSTALLATIONS


Designed By: J. B. Approved By: J. B. Made By: J. B. Checked By: J. B. Date: OCT 28, 1977

(SHEET 3 OF 4 SHEETS)

OCTOBER 28, 1977


FEDERAL ROAD REGION NO.	DIVISION	PROJ. NO.	SHEET NO.	TOTAL SHEETS
VIII	COLORADO			

TYPICAL INSTALLATION FOR INTERCHANGES

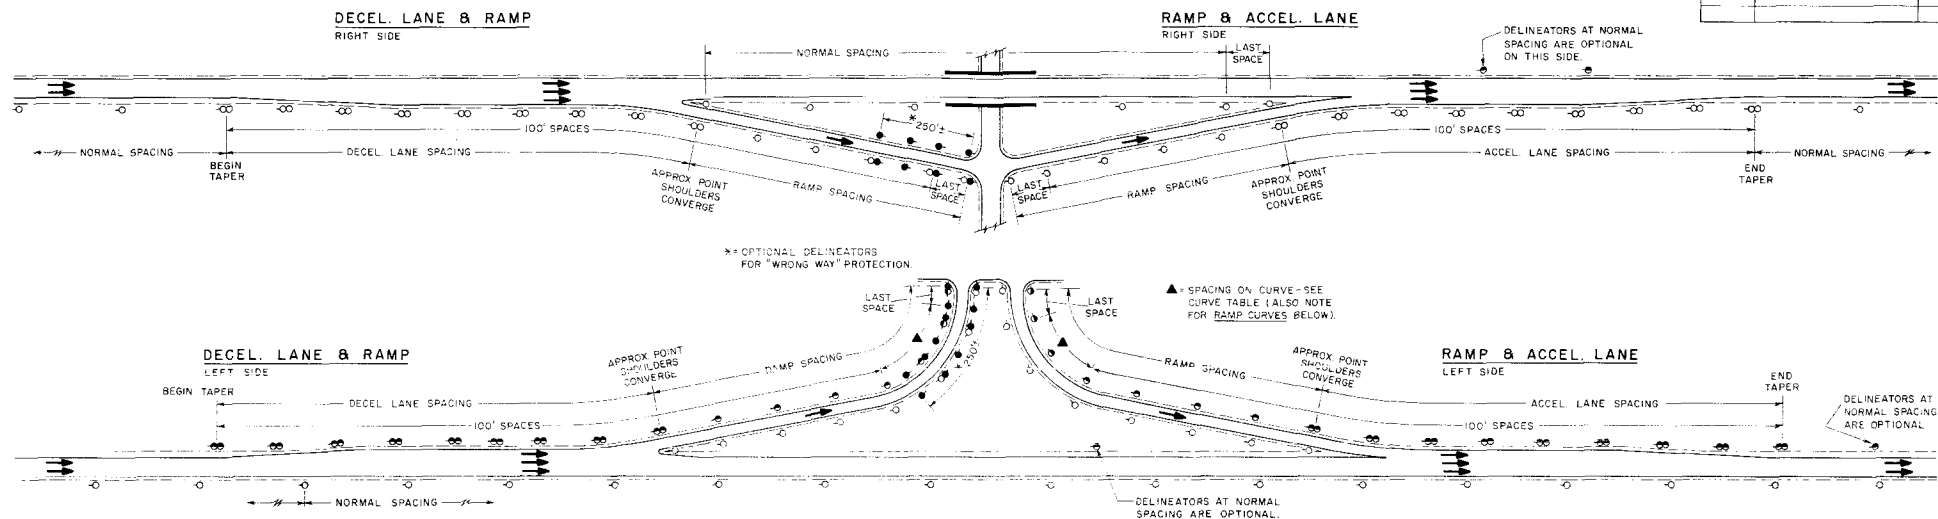[illegible]


TYPICAL INSTALLATION FOR RAMP CURVES

NOTE:
"SPACING IN ADVANCE OF AND BEYOND CURVE"
(1st, 2nd & 3rd Spaces) AS SHOWN IN THE SPACING
TABLE SHALL NOT APPLY TO RAMP CURVES.

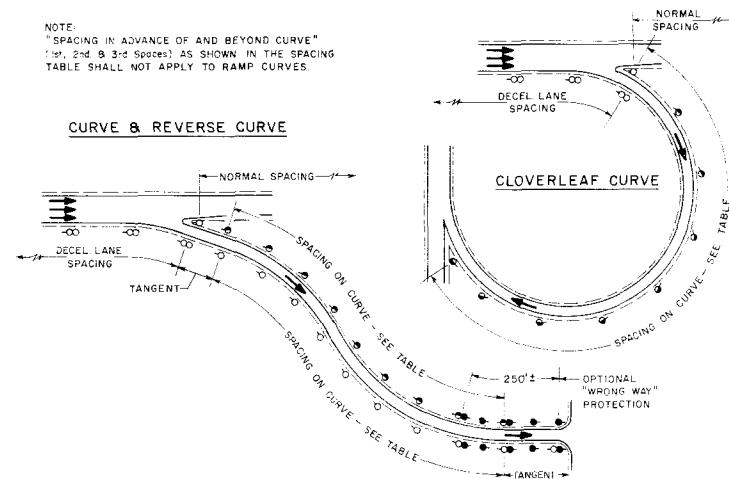

TYPICAL INSTALLATION FOR INTERSECTIONS

WITH ACCEL. & DECEL. LANES

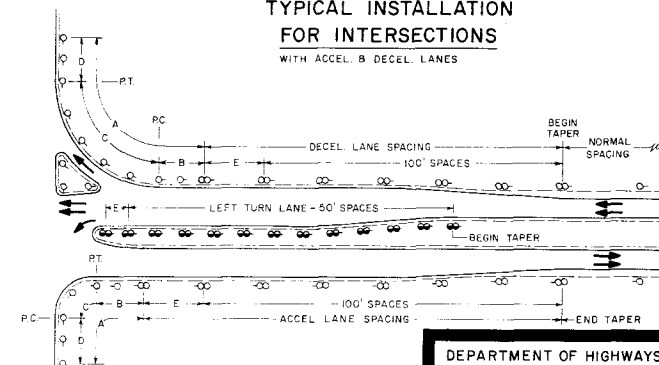

LEGEND:

- A = SEE CURVE SPACING TABLE
- B = ADVANCE SPACES (FIRST & SECOND)
- C = SPACING ON CURVE
- D = BEYOND SPACES (FIRST & SECOND)
- E = LAST SPACE

NOTE:
DELINEATORS MAY BE INSTALLED IF
NECESSARY FOR "WRONG WAY" PROTECTION.
SEE OTHER TYPICAL INSTALLATIONS.

DEPARTMENT OF HIGHWAYS
STATE OF COLORADO
DIVISION OF HIGHWAYS

TYPICAL DELINEATOR INSTALLATIONS

Designed By:	F. J. B.	Approved By:	<i>[Signature]</i>
Made By:	F. J. B.	Staff Traffic Engineer	
Checked By:	J. D. S.	Date:	OCT 26 1977

STANDARD S-612-1A


(SHEET 4 OF 4 SHEETS)

OCTOBER 28, 1977


FEDERAL ROAD REGION NO.	DIVISION	PROJ. NO.	SHEET NO.	TOTAL SHEETS
VII	COLORADO			
REVISIONS				

TYPICAL INSTALLATION FOR GUARD RAIL

CONCRETE BARRIER

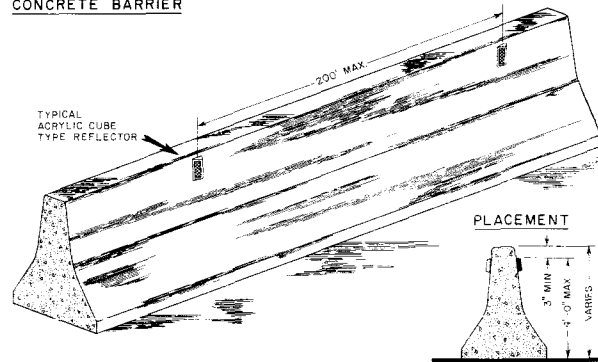


BOX BEAM BARRIER

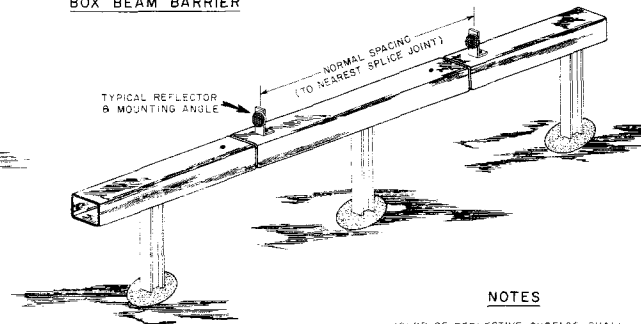


NOTES

1. COLOR OF REFLECTIVE SURFACE SHALL MATCH COLOR OF ADJACENT EDGE LINE.
2. REFLECTOR AND MOUNTING ANGLE ARE TO BE "TRAFFIC ORIENTED".
3. UNLESS OTHERWISE NOTED IN THE PLANS OR DIRECTED BY THE ENGINEER, NORMAL TANGENT AND CURVE SPACING APPLIES TO THE REFLECTOR & MOUNTING ANGLE AND 200' MAXIMUM TANGENT & CURVE SPACING APPLIES TO THE ACRYLIC CUBE REFLECTOR.
4. MOUNTING ANGLES SHALL BE FABRICATED FROM EITHER GALVANIZED STEEL NOT LESS THAN 16 GAGE, OR ALUMINUM NOT LESS THAN 0.025 INCH.


TYPICAL ADJUSTABLE REFLECTOR BRACKET

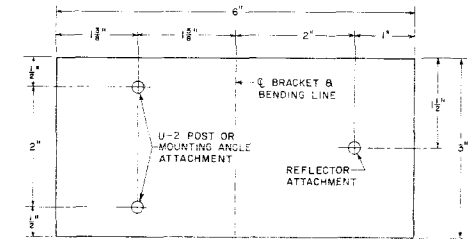

BRACKET & U-2 POST

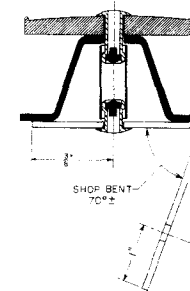


BRACKET & MOUNTING ANGLE

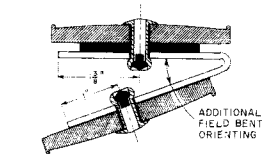


NOTES

- REFLECTOR BRACKETS SHALL BE FABRICATED FROM EITHER GALVANIZED STEEL NOT LESS THAN 16 GAGE, OR ALUMINUM NOT LESS THAN 0.025 INCH. ALL HOLES ARE 1/8" DIAMETER.
- SHOP BEND BRACKET APPROX. 70° AS SHOWN AND FIELD BEND AS NECESSARY TO TRAFFIC ORIENT. AFTER INSTALLING AND TRAFFIC ORIENTING THE BRACKET THE REFLECTOR CAN BE ATTACHED. U-2 POSTS REQUIRE AN ADDITIONAL 1/8" HOLE 2" BELOW THE TOP HOLE PROVIDED IN THE POST.
- THE ADJUSTABLE REFLECTOR BRACKET IS TO BE USED TO "TRAFFIC ORIENT" BACK-TO-BACK DELINEATORS USED ON CURVES.


TYPICAL MOUNTING ANGLE

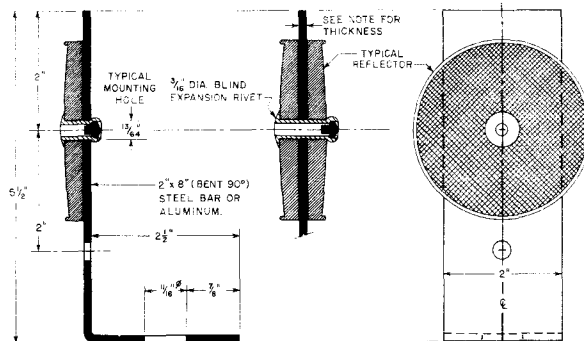

TYPICAL ACRYLIC CUBE TYPE REFLECTOR

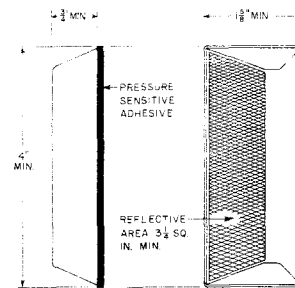

BOX BEAM BARRIER ATTACHMENT

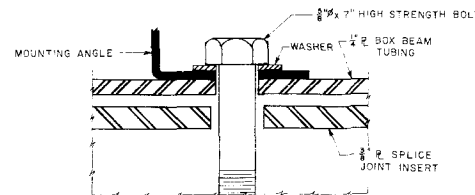

DEPARTMENT OF HIGHWAYS
STATE OF COLORADO
DIVISION OF HIGHWAYS
TYPICAL
DELINEATOR
INSTALLATIONS

Designed By: F. J. B. Approved By: *[Signature]*
Made By: S. J. B. Checked By: S. J. B.
Date: OCT 28, 1977

NOTE: See sheet No. 4 for typical Construction Traffic Sign and Channelizing Device requirements for each Case.


STANDARD S-614-39A

SHEET 1 OF 4 SHEETS
MAY 17, 1977

REVISIONS		
NO.	REVISION	DATE
1	Rev. Date Only	J.D.S.


LEGEND	
	Type 3 Barricade
	Type 1 or 2 Barricade
	Concrete Barrier (Temporary)
	Flagman
	Vertical Panel Channelizing Device
	Traffic Cone
	Drum Channelizing Device

CASE I

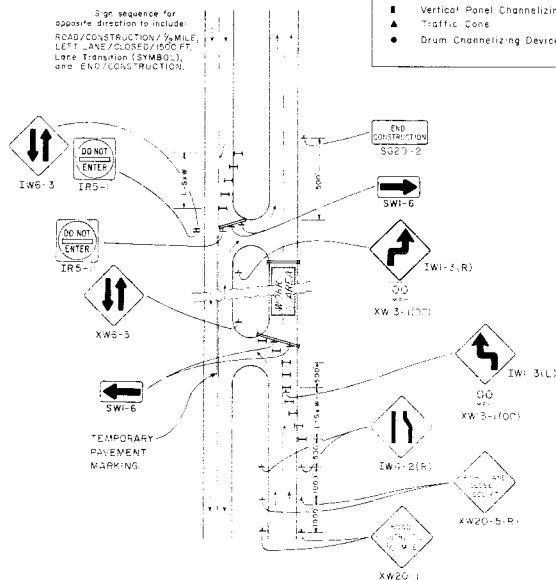


TYPICAL APPLICATION
CLOSURE OF ONE ROADWAY,
4-LANE DIVIDED HIGHWAY

CASE II

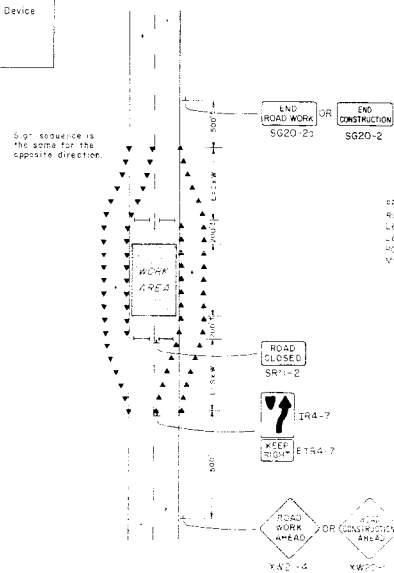


TYPICAL APPLICATION
ROAD CLOSURE, USE OF
ADJACENT SHOULDERS

CASE III

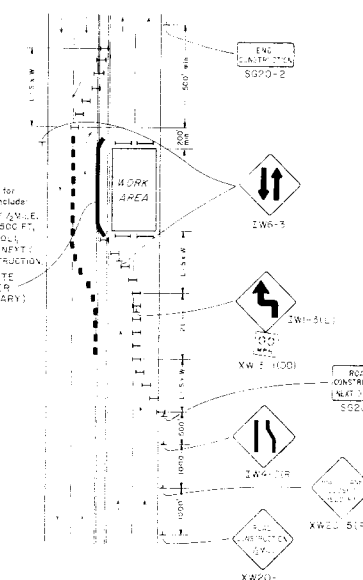


TYPICAL APPLICATION
CLOSURE OF HALF OF 4-LANE
HIGHWAY, NOT PHYSICALLY DIVIDED

CASE IV

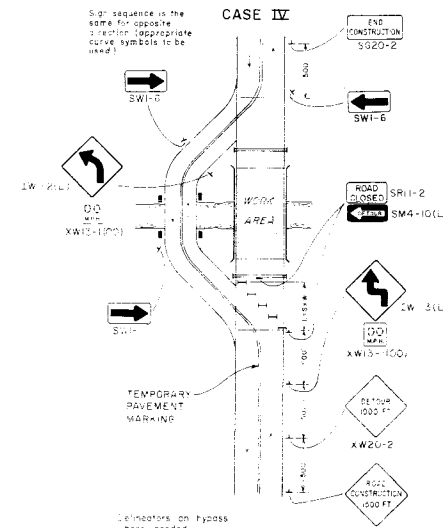


TYPICAL APPLICATION
ROAD CLOSURE, BYPASS
DETOUR PROVIDED

CASE V

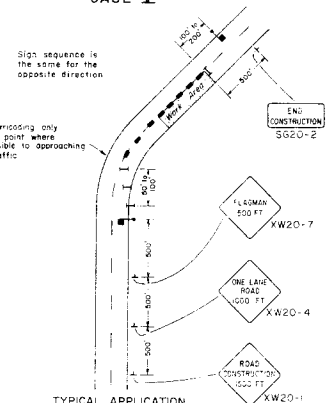

TYPICAL APPLICATION
LANE CLOSURE, 2-LANE
HIGHWAY, AT CURVE

CASE VI

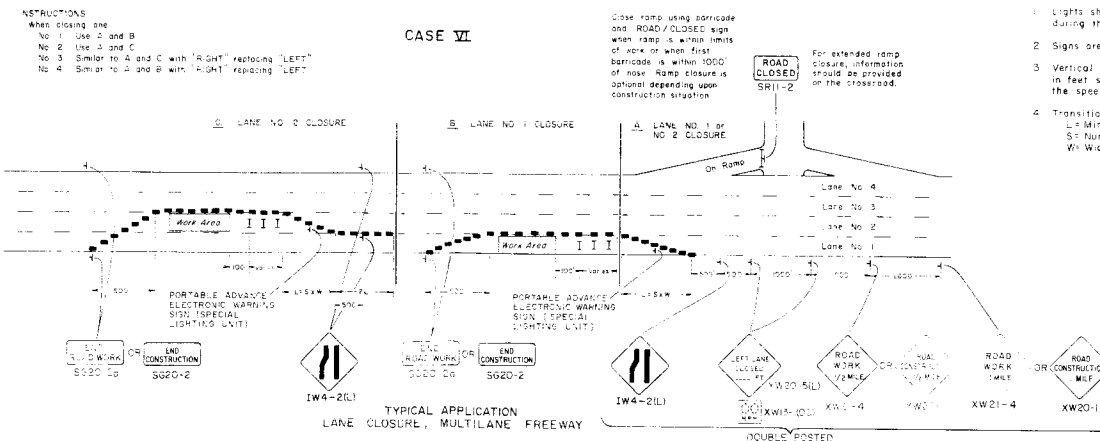

TYPICAL APPLICATION
LANE CLOSURE, MULTILANE
FREEWAY

NOTES

1. Lights shall be used to mark flagman stations during the hours of darkness.
2. Signs are shown for one direction of travel only.
3. Vertical Panel, Traffic Cone, and Drum spacing in feet shall equal the numerical value of the speed limit (eg. 45mph = 45ft spacing).
4. Transition Taper: L = SW
L = Minimum length of taper.
S = Numerical value of speed limit or 85 percentile speed
W = Width of offset

DEPARTMENT OF HIGHWAYS
STATE OF COLORADO
DIVISION OF HIGHWAYS
TRAFFIC SIGNING
FOR HIGHWAY
CONSTRUCTION

Designed by J.V.V.
Made by J.C.M.
Checked by J.D.S.
Approved by J.D.S.
Date: May 17, 1977

STANDARD S-614-39A


SHEET 2 OF 4 SHEETS
MAY 17, 1977

Form No. 101	REV. 1-60	HEET 1	700
Part		Net	143.75
XIII	Net Weight		

REVISIONS		
REV	5-B-78 Rev. Date Only	V.C.S.


Typical Signing Where Traffic Is Prohibited Along Construction

(Advance signing not shown, see sheet No.1 for typical applications)

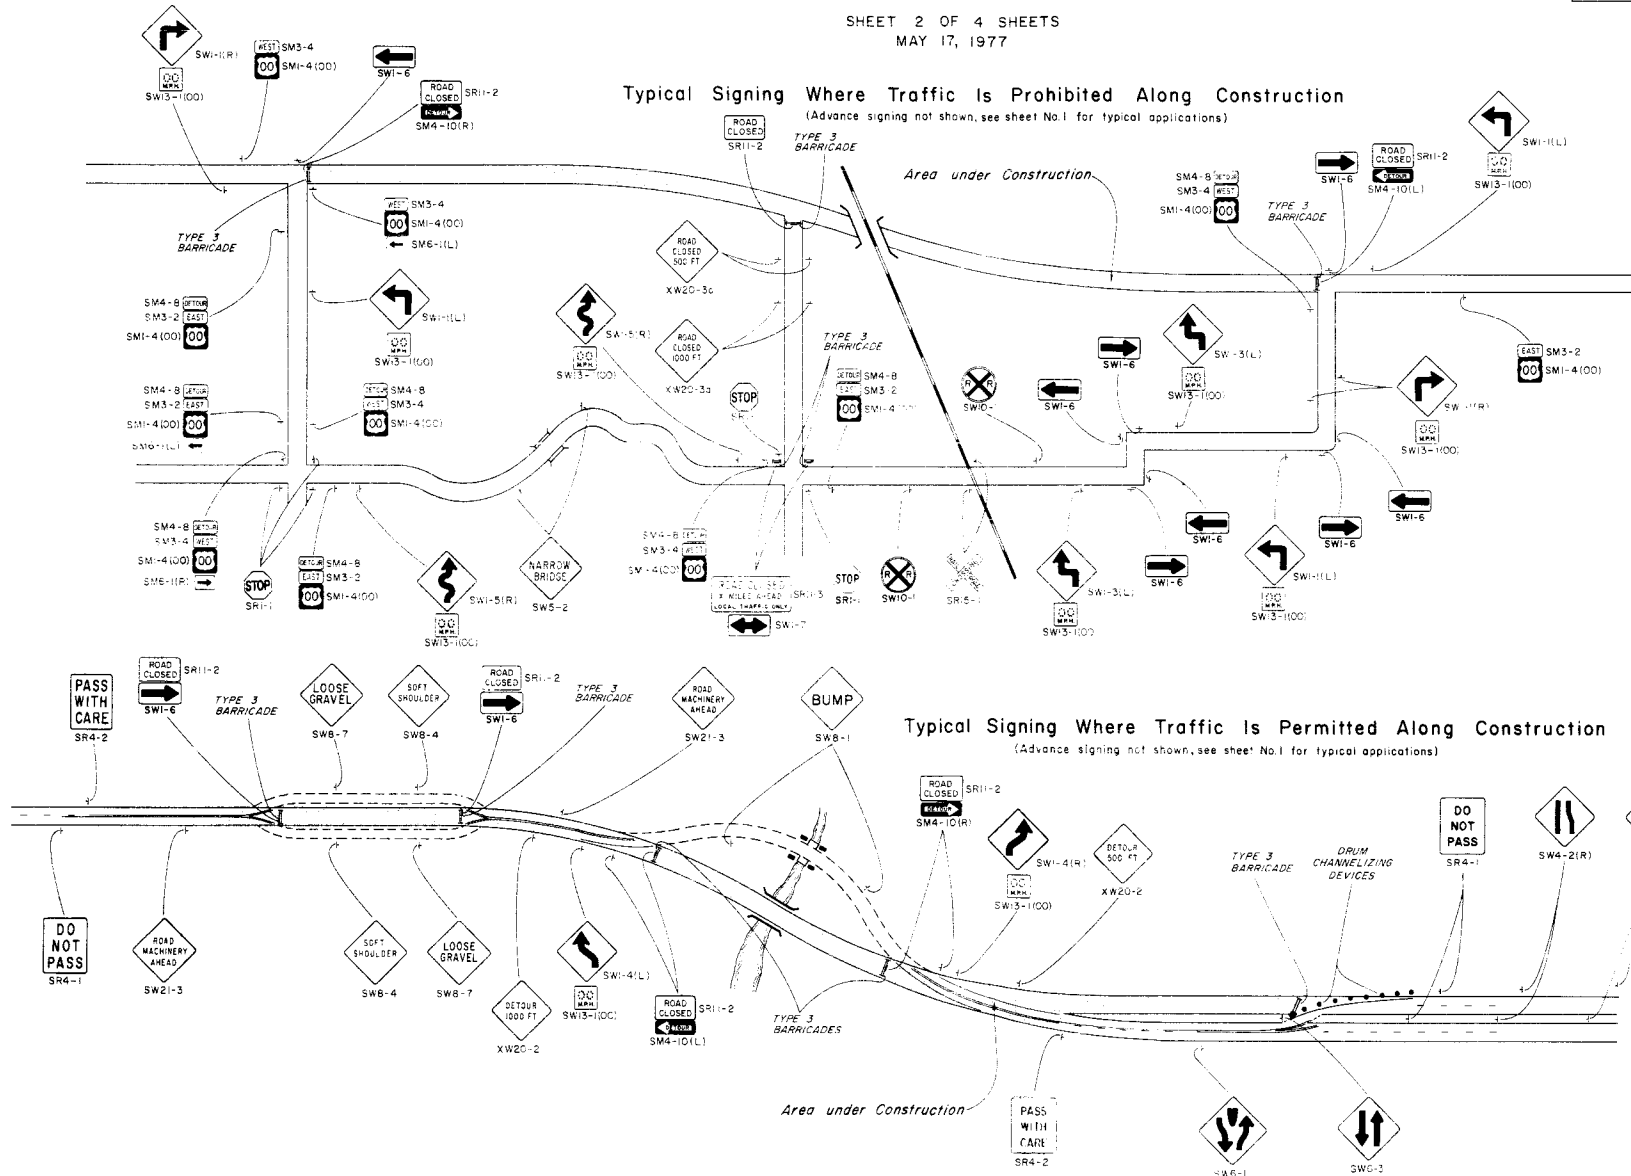

Typical Signing Where Traffic Is Permitted Along Construction

(Advance signing not shown, see sheet No.1 for typical applications)

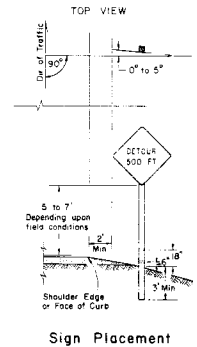

DEPARTMENT OF HIGHWAYS
STATE OF COLORADO
DIVISION OF HIGHWAYS
TRAFFIC SIGNING
FOR HIGHWAY
CONSTRUCTION

Designed By	FUB	Approved By	<i>W. E. Tucker</i>
Made By	JLM		Staff Traffic Engineer
Checked By	JDS	Date:	May 17, 1977


STANDARD S-614-39A

FEDERAL ROAD REGION NO.	DIVISION	PROJ. NO.	SHEET NO.	TOTAL SHEETS
VIII	COLORADO			

REVISIONS		
REV.	Rev. Date Only	J.D.S.
5-8-78		































REGULATORY SIGNS

See Note No. 9

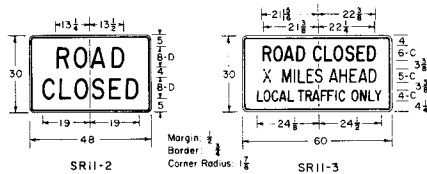

WARNING SIGNS

See Note No. 10

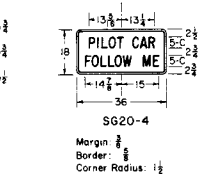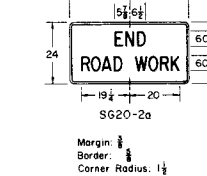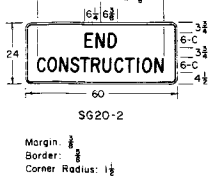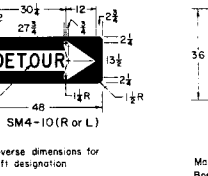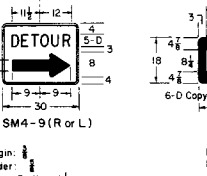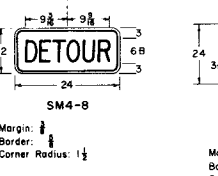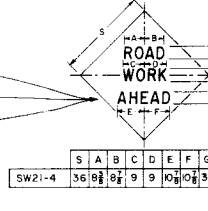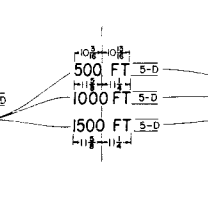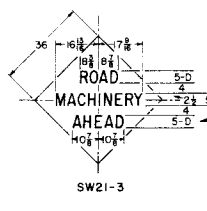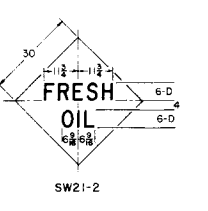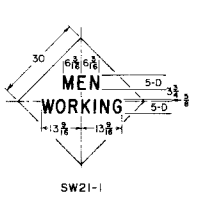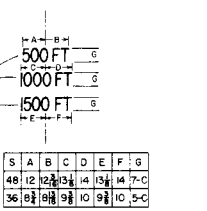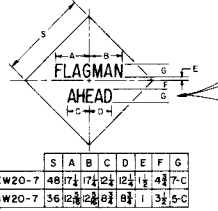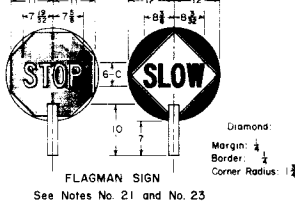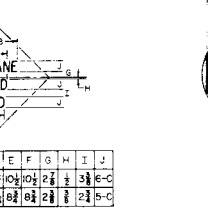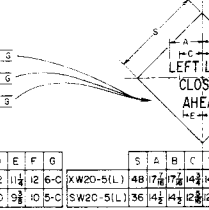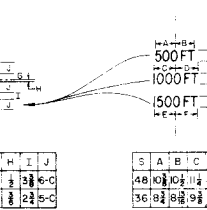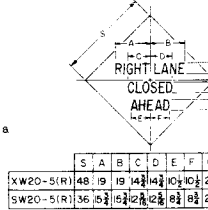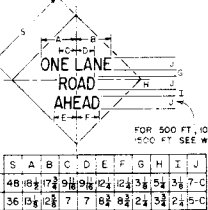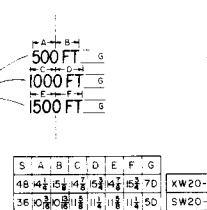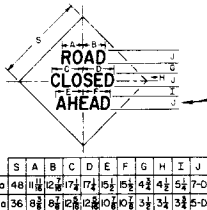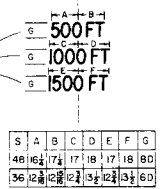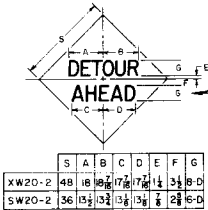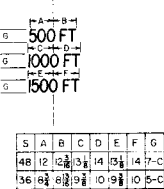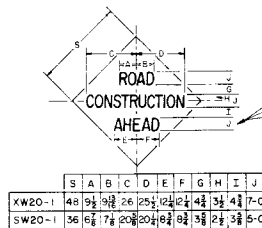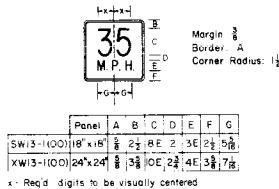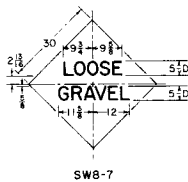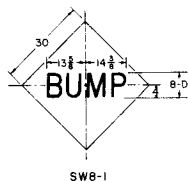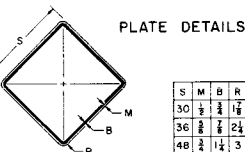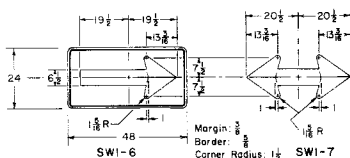

DEPARTMENT OF HIGHWAYS
STATE OF COLORADO
DIVISION OF HIGHWAYS

TRAFFIC SIGNING FOR HIGHWAY CONSTRUCTION

Designed By: J.E.M.
Made By: J.E.M.
Checked By: J.D.S.

Approved By: J.E.M.
Staff Traffic Engineer
Date: May 17, 1977

STANDARD S-614-39A

SHEET 4 OF 4 SHEETS
MAY 17, 1977

PROJECT	PRJ. NO.	SHEET NO.	TOTAL SHEETS
VII	5-8-76	7	7

REVISIONS		
(R-1)	5-8-76	Rev. Note No. 7

GENERAL NOTES

- All work shall be done in accordance with the "Standard Specifications" applicable to the Project and the "Manual on Uniform Traffic Control Devices for Streets and Highways" (adopted by the Federal Highway Administration) and the related "Colorado Supplement".
- Where traffic is maintained through or over any part of the Project the Contractor will be required to mark all hazards within the limits of the Project (including connecting roads) with well-maintained Barricades, Warning, Regulatory, and Guide signs. All barricades and signs shall be moved, added to, changed or removed as required during the progress of construction and removed entirely when the Project is completed.
- Where traffic must be diverted from the Project by road closure, the Detour will be marked by the Division except that the Contractor shall provide, erect and maintain Barricades (when required) at the ends of the Project, ends of the Detour and connecting roads. All U.S. or State Route Markers required for the Project will be furnished and installed by the Division. The location and positioning of Barricades, Warning and Regulatory signs shall be as recommended by the Engineer.
- Work on the Project shall not be started until all required signs are in place and approved by the Engineer. Where speed limit reduction appears necessary such speed limit reduction shall be requested from the Engineer by the Contractor. Advisory Speed plates may be used in conjunction with Warning Signs (SW13-1) for use with 30" Diamond signs and XW13-1 for use with 36" and 48" Diamond signs, where the safe speed is lower than the imposed Regulatory speed limit.
- All Barricades and Signs shall be placed for best visibility and legibility, maintained in good condition, and kept clean and free of dirt at all times. Contractor's and Engineer's vehicles and equipment must be parked so that barricades and signs are visible to approaching traffic at all times.
- Where two identical signs are used for dual posting they are to be staggered on the two sides of the roadway for a minimum distance of 75' to avoid a tunneling effect.
- Examples for signing Projects, as illustrated on Sheets 1 and 2, are typical of signs required and are subject to alteration to fit actual conditions encountered in the field. In all cases Warning signs are to be placed well in advance of the hazard, the distance depending on topography and existing approach speeds.
- Desirable sizes for signs are shown on Sheets 1 and 2 of this Standard. Larger or smaller signs shall be used where warranted. Detailed dimensions for signs normally used in connection with construction are shown on Sheet 3 of this Standard. For information on standard roadway signs not detailed on this Standard see the "Manual on Uniform Traffic Control Devices for Streets and Highways" (adopted by the Federal Highway Administration) and the related "Colorado Supplement". Detailed layouts for these signs will be furnished in the plans or on request.
- Signs with the prefix "R" in the sign code are Regulatory signs, and as such they impose legal restrictions on drivers and shall only be used as authorized by the Engineer.
- Signs with the prefix "W" in the sign code are Warning signs, and are used to alert traffic to existing or potentially hazardous conditions.
- Signs with the prefix "G", "O" or "M" in the sign code are Guide signs. Those with the prefix "O" or "G" convey general information and those with the prefix "M" are used to mark the traffic route.
- All Warning and Regulatory signs shall be posted on both sides of the roadway on divided highways. Dual posting is required where warranted on two-lane, two-way highways.
- Guide sign SG20-1 shall be placed to mark the beginning of all Projects more than 2 miles in extent, where traffic is maintained through the project. It shall be placed singly and near the beginning of construction. Guide sign SG20-2 shall be placed to mark the end of the Project. It shall be placed singly and may be placed opposite barricade if desirable.
- Inapplicable pavement markings that could be confusing to motorists shall be removed by a method approved by the Engineer. Temporary markings shall be used as necessary to define vehicle paths. Refer to the appropriate Division Standard (Typical Pavement Markings) for marking details. Adhesive pavement marking tape and raised pavement markers may be used with the approval of the Engineer.
- Lanterns and Torches: Lanterns shall be used only in low speed urban areas and Open-Flame Torches shall not be used under any circumstances.
- Barricades, Flashing Beacons and Flashers: refer to appropriate Division Standard for details.
- Traffic Cones shall be orange, at least 18" in height, and not weighted to an extent that would be hazardous to traffic. They shall not be used during the hours of darkness.
- If closure is for extended period, including nighttime operations, barricade warning lights and temporary pavement markings are to be installed through-out the construction zone and inapplicable pavement markings are to be removed.
- Sign panels furnished by the Contractor for use only during construction may be fabricated from plywood, aluminum, steel or other suitable material but shall be stable and durable enough to meet other requirements of this Standard.
- All signs shall be reflectorized unless otherwise specified on plans. All reflective sheeting shall be non-exposed lens type.
- When Flags are used in lieu of the Flagman Sign, they shall be a minimum of 24"x24", made of a good grade of bright red material, and fastened securely to a staff of approximately 3 feet in length. The free edge should be weighted to insure that the flag will hang vertically, even in heavy winds.
- All material shall be sound and durable. Barricades, signs, symbols and lettering shall be of good workmanship. Uneven lettering will not be accepted.
- Flagman Sign: The background of the STOP face shall be reflectorized red with white reflectorized letters and border. The background of the SLOW face shall be reflectorized orange with black letters and border.
- Painting for all wood surfaces shall conform with the "Standard Specifications".
- Alternate methods of processing signs or the substitution of symbols or other reflecting elements for painted symbols will be permitted only after approval by the Division.
- Posts for regulatory, warning and guide signs shall conform with the "Standard Specifications" for Timber Sign Posts.
- Diamond warning signs shall have a standard size of 48"x48". Where speeds and volumes are relatively low, a minimum size of 36"x36" may be used for Construction Approach Warning Signs, provided that a minimum letter size of 5" can be accommodated on this size with the appropriate legend.

TYPICAL CONSTRUCTION TRAFFIC SIGN AND CHANNELIZING DEVICE REQUIREMENTS

CASE	Construction Traffic Signs Each			Channelizing Devices per 100'			
	Panel Size ▲			Barricades	Cones	Vertical Panels	Drums
I	A	B	C	*	2	3	2
II	6	4	*	*	2	3	2
III	4	9	*	*	2	3	2
IV	16	8	*	*	2	3	2
V	0	6	*	*	2	3	2
VI	6	11-13	*	*	2	3	2


* As directed by the Engineer

▲ PANEL SIZE	A	9.01 to 9.00 sq. ft. including Type 1 and Type 2 Barricades
	B	9.01 to 16.00 sq. ft.
	C	16.01 sq. ft. and over

DEPARTMENT OF HIGHWAYS
STATE OF COLORADO
DIVISION OF HIGHWAYS
TRAFFIC SIGNING
FOR HIGHWAY
CONSTRUCTION


Designed By F. J. B. Approved By *[Signature]*
Made By F. J. B. Staff Traffic Engineer
Checked By J. D. S. Date May 17, 1977

TYPICAL TYPE 1 BARRICADE

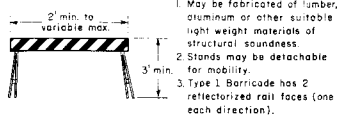


1. May be fabricated of lumber, aluminum or other suitable light weight materials of structural soundness.
2. Stands may be detachable for mobility.
3. Type 1 Barricade has 2 reflectorized rail faces (one each direction).

TYPICAL TYPE 2 BARRICADE

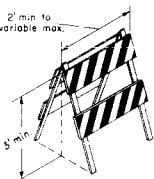

1. May be fabricated of lumber, aluminum or other suitable light weight materials of structural soundness.
2. Type 2 Barricade has 4 reflectorized rail faces (two each direction).


TYPICAL TYPE 3 BARRICADES (Timber)

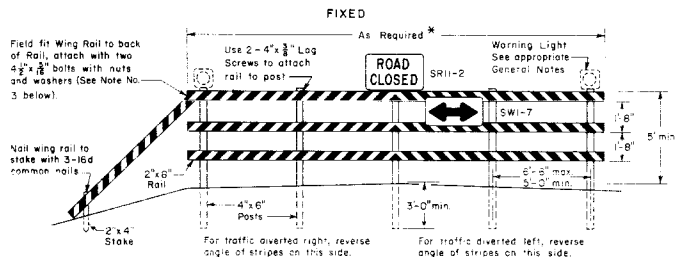

RAIL LENGTH TABLE *		
TYPE 3 BARRICADE	LENGTH	
FIXED	MOVABLE	
F - A	M - A	8' - 14'
F - B	M - B	15' - 24'
F - C	M - C	25' - 35'
F - D	M - D	> 35'

Type 3 Barricades have 3 reflectorized rail faces if facing traffic in one direction and 6 if facing traffic in two directions.


2. When fixed barricades are designated on the plans, the portion of the posts below the ground line shall be dipped 1" not less than 1/2" in the portion of the post above the ground line shall be pointed in accordance with the appropriate General Note.
3. Detachable extension wing rails for bypassing of construction equipment are permitted, when necessary, on Fixed or Movable Type 3 Barricades. The length shall be adequate to close the borrow pit and/or shoulder as required.

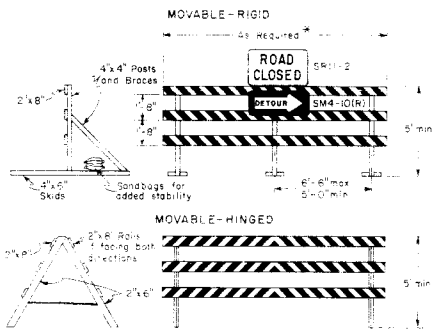


TYPICAL BARRICADE CHARACTERISTICS

	BARRICADE DESIGNATIONS		
	TYPE 1	TYPE 2	TYPE 3
Rail Width	8" min. - 12" max.	8" min. - 12" max.	6" min. - 12" max.
Rail Length	2' min. to variable max.	2' min. to variable max.	As required, See Table *
Height	3' min.	3' min.	3' min.
Stripes	See Detail of Barricade Striping and appropriate General Notes.		
Use	Temporary	Temporary	Temporary or Permanent

RAIL STRIPING DETAIL

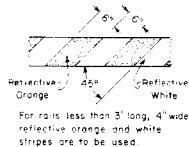

TYPICAL CONCRETE BARRIER (TEMPORARY)

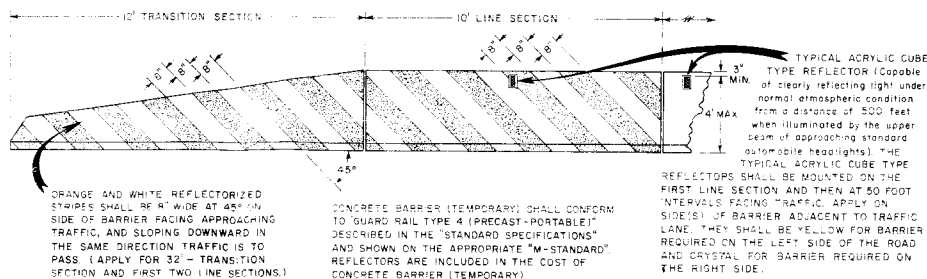

STANDARD S-614-52B

JANUARY 10, 1979

GENERAL NOTES


1. All work shall be done in accordance with the Standard Specifications applicable to the Project.
2. All signs, sign materials, beacons and barricade warning lights shall conform to the standards set forth in the latest edition of the Manual on Uniform Traffic Control Devices for Streets and Highways and the Colorado Supplement thereto.
3. The various types, combinations and applications of signs and beacons for barricades required for each project shall be:
 - a. governed by field conditions.
 - b. as shown in appropriate typical illustrations or specified or detailed in the plans.
 - c. when called for by, and subject to approval by the Engineer.
4. Alternate materials or other reflective elements on signs or barricades will be permitted only after approval of such material by the Division in writing.
5. All painting shall conform with:
 - a. the applicable Subsections of 506 and 614 of the Standard Specifications.
 - b. all skids, braces, rails and posts shall be painted with 2 coats of "Exterior White Paint".
 - c. the backsides of rails and vertical panel channelizing devices facing and direction of traffic only shall be painted with "Exterior White Paint".
6. All striped surfaces, except on concrete, shall conform with:
 - a. the entire area of orange and white stripes shall be reflectorized.
 - b. all reflective surfaces shall be "Smooth Surface Type Reflective Sheeting".
 - c. horizontal rails, wing rails and vertical panel channelizing devices shall have orange and white stripes on the face side(s) sloping downward at a 45° angle toward the side(s) to which traffic is to pass or turn.
 - d. permanent barricades shall be reflectorized red and white stripes. They may be used at locations to mark the end of a road, street or highway where there is no crossroad or outlet.
7. For all wooden barricade components:
 - a. nominal lumber dimensions are satisfactory.
8. All screws, bolts, nuts and washers shall be galvanized or cadmium plated.
9. Stability of barricades and channelizing devices shall conform with:
 - a. skids (bases) of movable barricades shall be weighted with sandbags only where necessary to provide stability.
 - b. no movable or portable device shall be weighted by any method or material to the extent that would make them hazardous to motorists.
10. Flashing beacons or warning lights used with barricades, drums and vertical panels shall conform with:
 - a. use flashing warning lights when devices are used singly and steady burn lights when they are used in a series for channelization.
 - b. they shall be positioned above the top rail of barricades or on top of drums and vertical panels.

FEDERAL ROAD REGION NO.	DIVISION	PROJ. NO.	SHEET NO.	TOTAL SHEETS
VIII	COLORADO			

REVISIONS


NO.	DESCRIPTION

TYPICAL DRUM

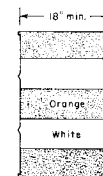


1. Drums shall never be placed in the roadway without appropriate advance warning signs.
2. There shall be at least two orange and two white horizontal, circumferential, reflective stripes on each drum.

TYPICAL VERTICAL PANEL

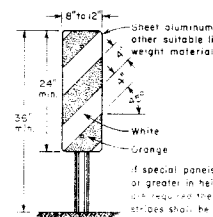

- For permanent installation only:
1. Steel posts shall be hot-rolled steel or re-rolled rail steel.
 2. Posts are to weigh 2 lbs./ft. with a mill tolerance of minus .3g./ft. at the weight of dry ore post being weighed.
 3. Reflectorized Yellow shall replace Orange and Black shall replace White.
 4. Panel shall conform to "Class I Signs".

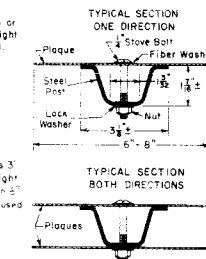

DEPARTMENT OF HIGHWAYS STATE OF COLORADO DIVISION OF HIGHWAYS BARRICADES, DRUMS, CONCRETE BARRIER (TEMP) & VERTICAL PANELS

Designed By: F.J.B.
Made By: F.J.B.
Checked By: J.D.S.
Approved By: J.D.S.
Staff Traffic Engineer
Safety Projects Engineer
Date: January 10, 1979