


AS CONSTRUCTED

NO REVISION ☐ REVISED ☐ VOID ☐



AS INSTRUCTED			FILE NO.	DIVISION	PROJECT NO.	SHEET NO.
NO REVISIONS	REVISED	VOID			RS 0059 (NR)	29

5-B-76, T.E.P., ADD. EARTHWORK BREAKOUT

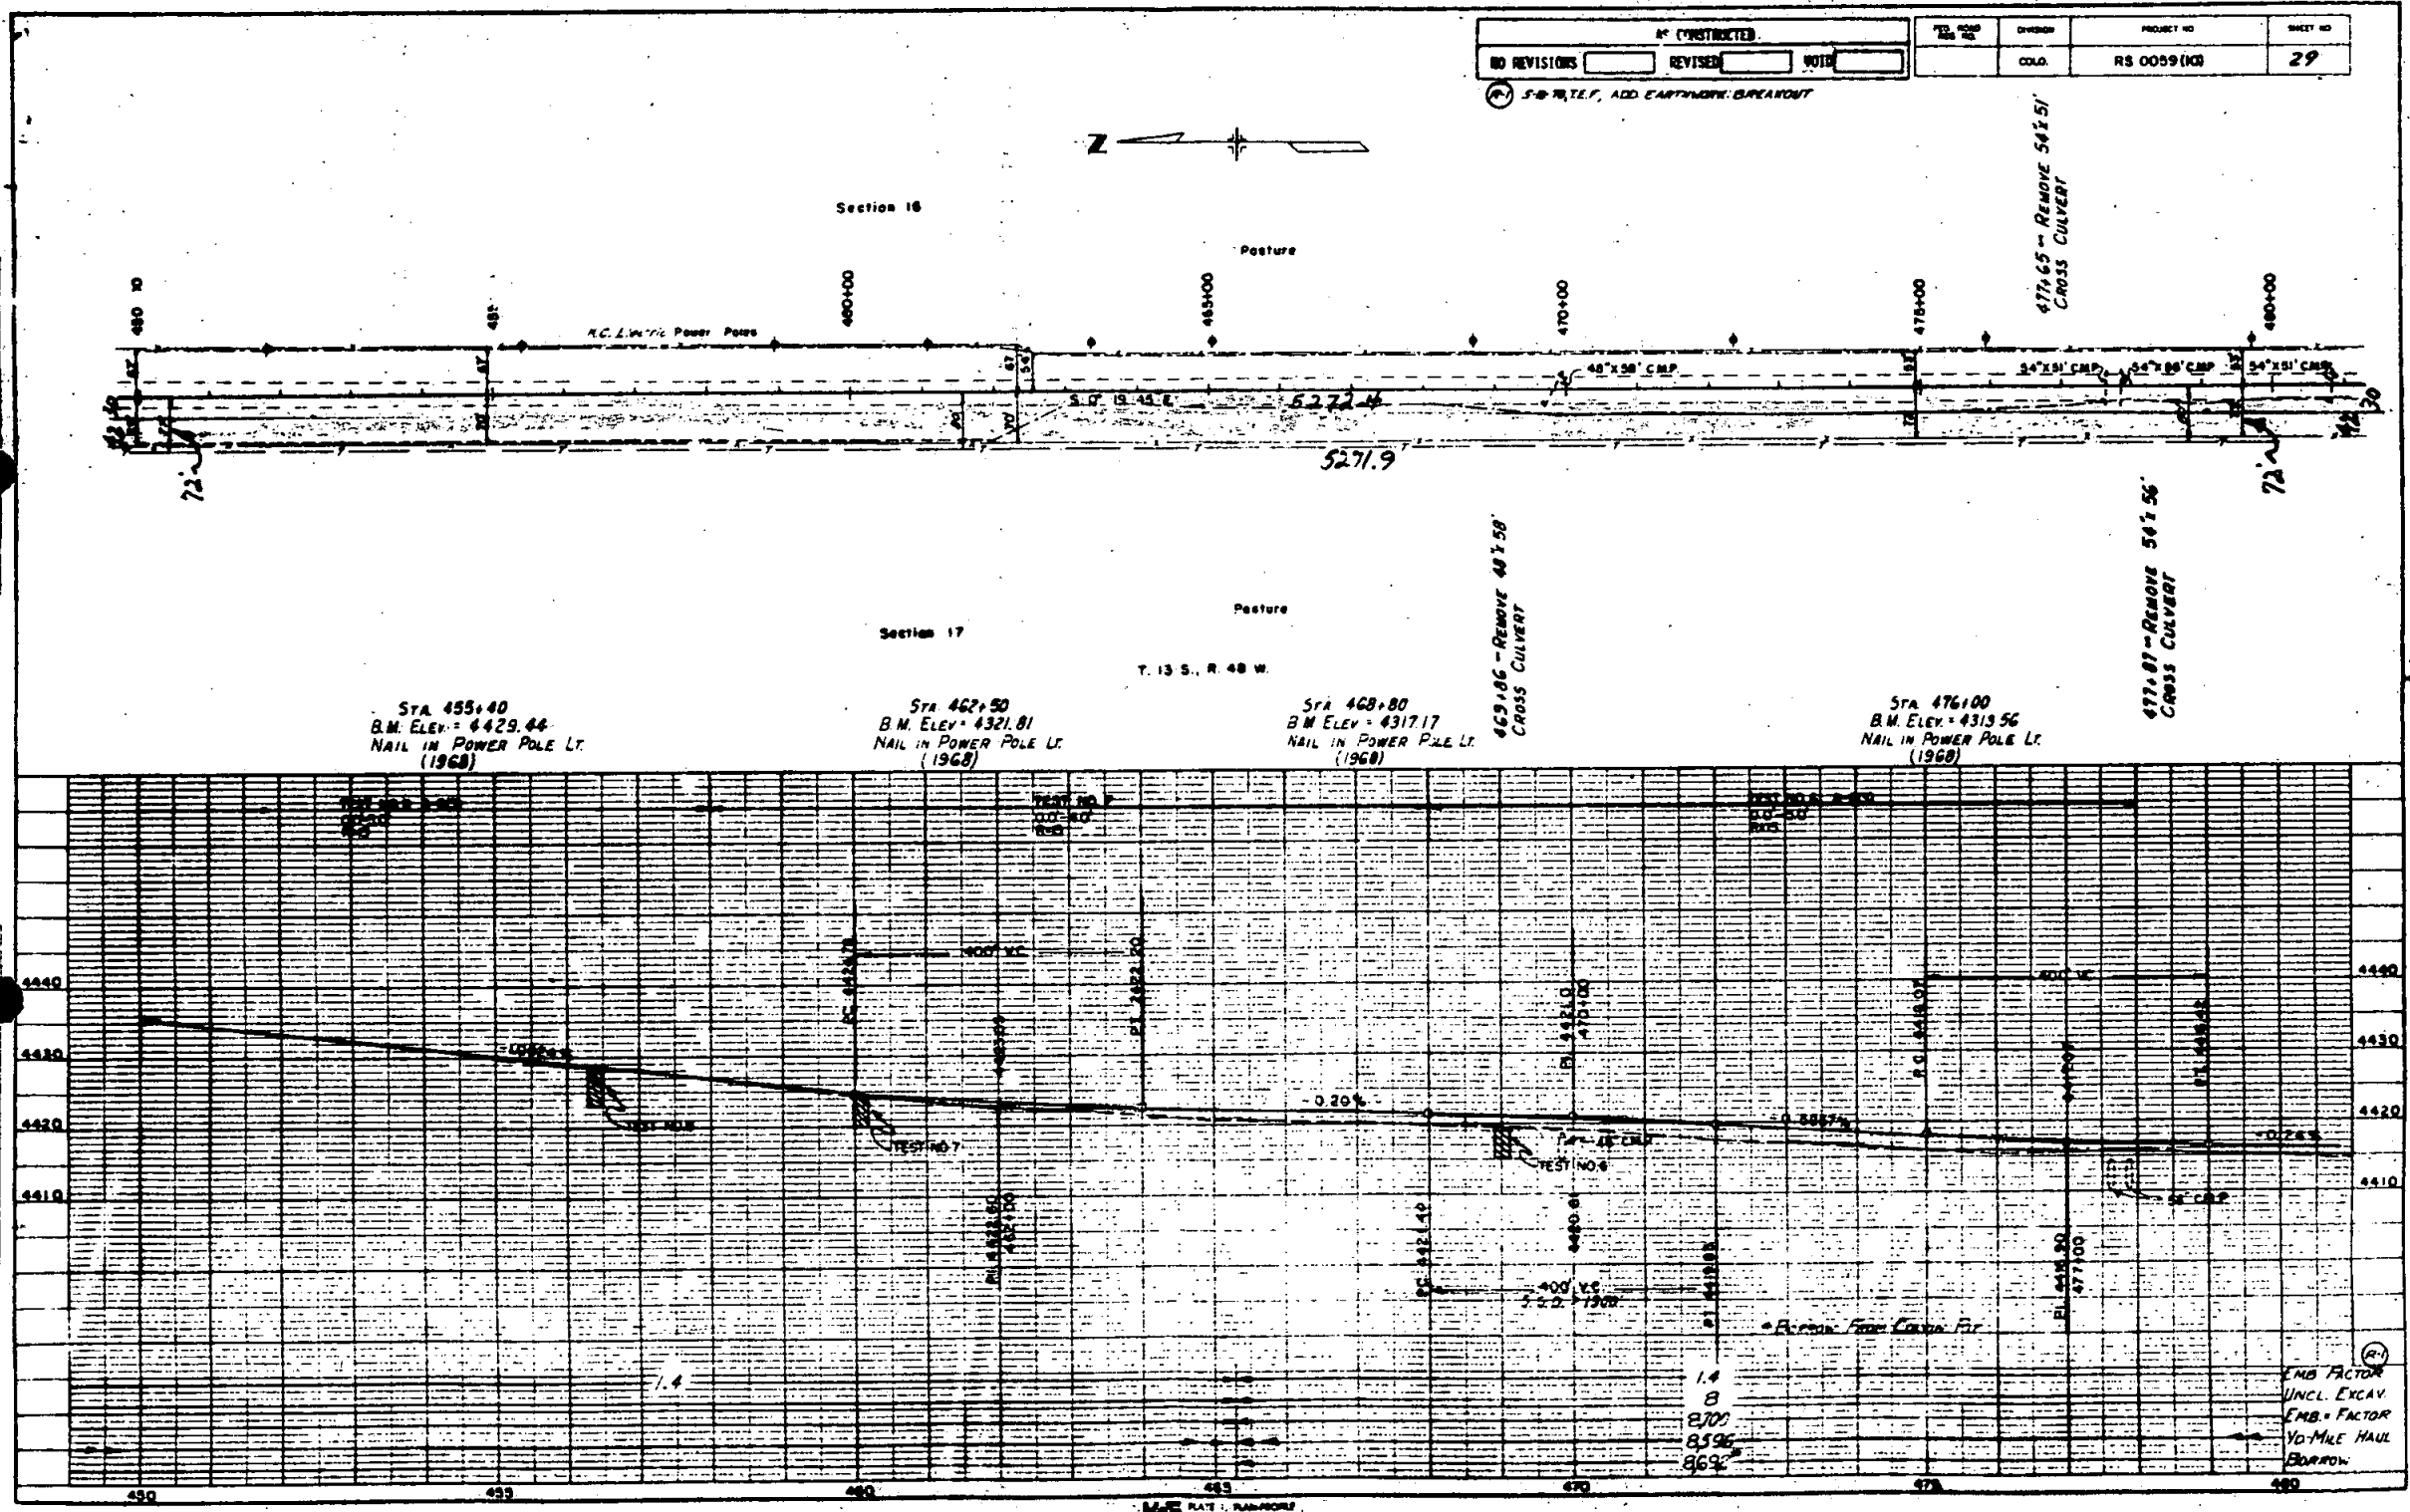

PLAN
SECTION
DETAIL
ASSEMBLY
GENERAL NOTES


PROFILE
SECTION
DETAIL
ASSEMBLY
GENERAL NOTES

END FACTOR
UNCL. EXCAV.
EMB. FACTOR
1/2 MILE HAUL
BORROW

FILE NO.	DIVISION	PROJECT NO.	SHEET NO.
VBI	COLO.	RS 0059(10)	30

AS CONSTRUCTED		
NO REVISIONS	REVISED	VOID

(R-1) S-40, T-4, ADD EARTHWORK BREAKOUT, CHANGED S.S.D.

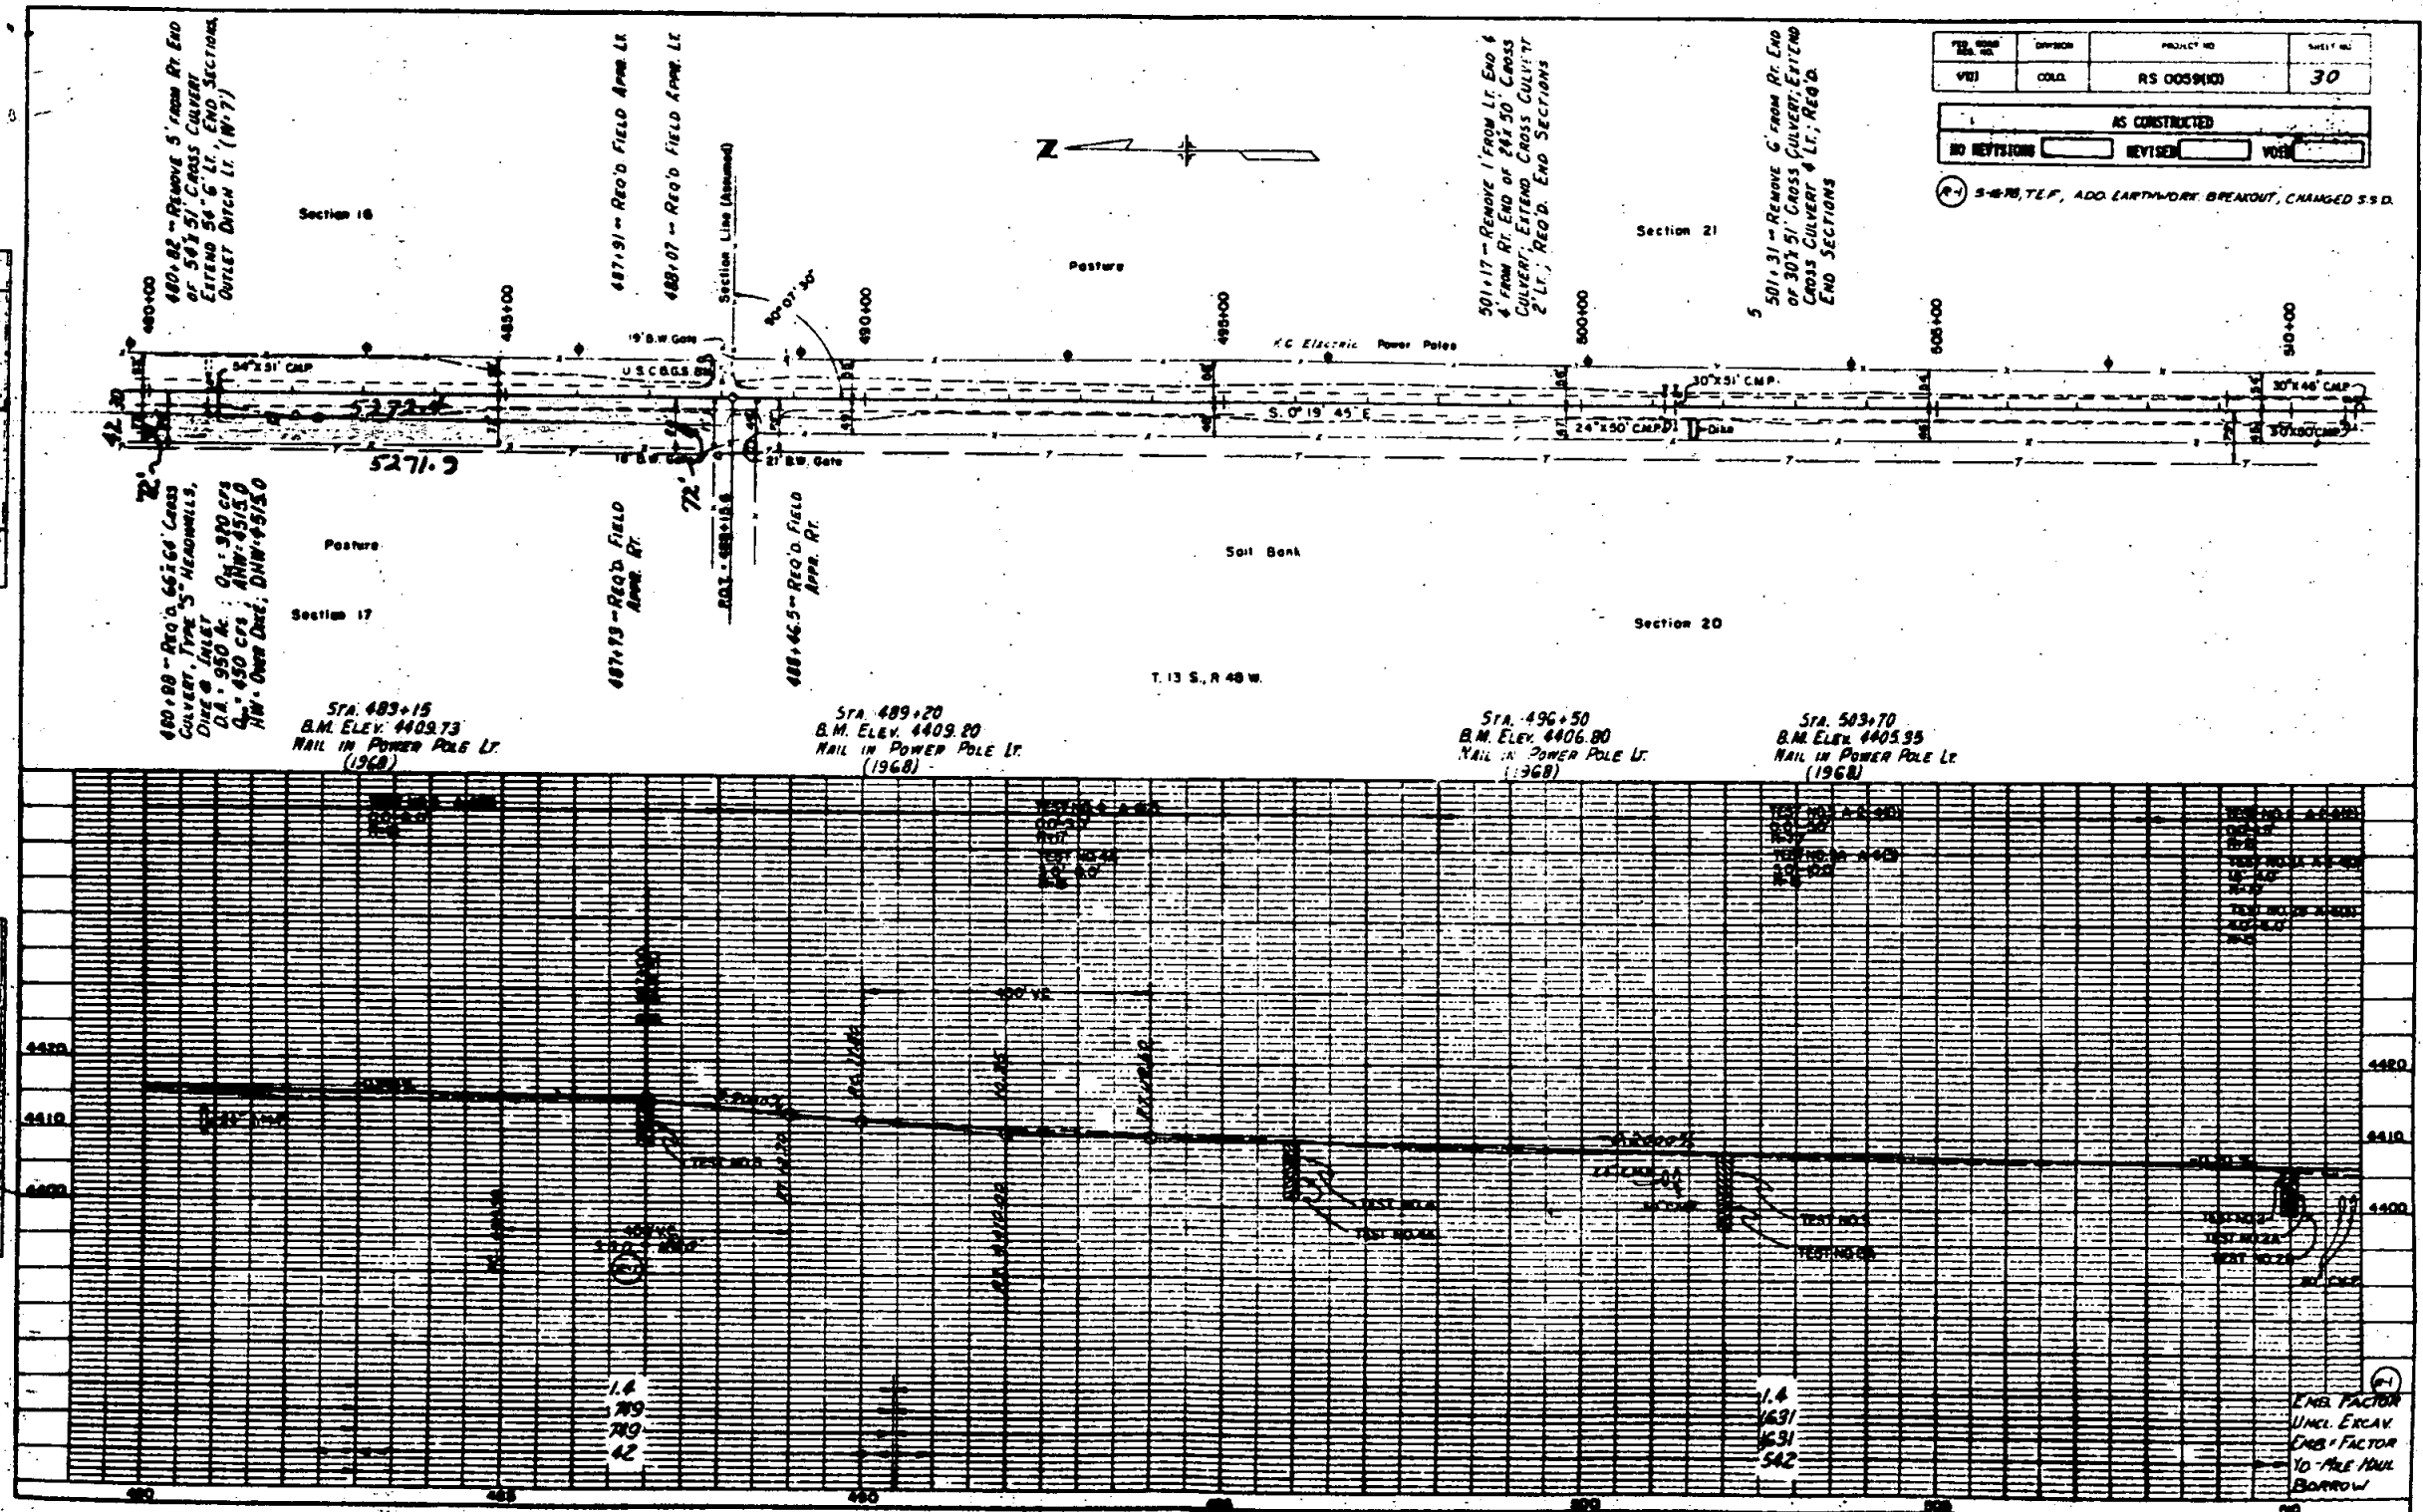

1.4
 1631
 1631
 542
 LNER FACTOR
 UNCL. EXCAV.
 CMB. FACTOR
 10' FILL HAIL
 BORROW