


STATE DEPARTMENT OF HIGHWAYS

DIVISION OF HIGHWAYS—STATE OF COLORADO

FEDERAL ROAD REGION NO.	DIVISION	PROJECT NO.	SHEET NO.
9	COLORADO	RS 0089(5)	1

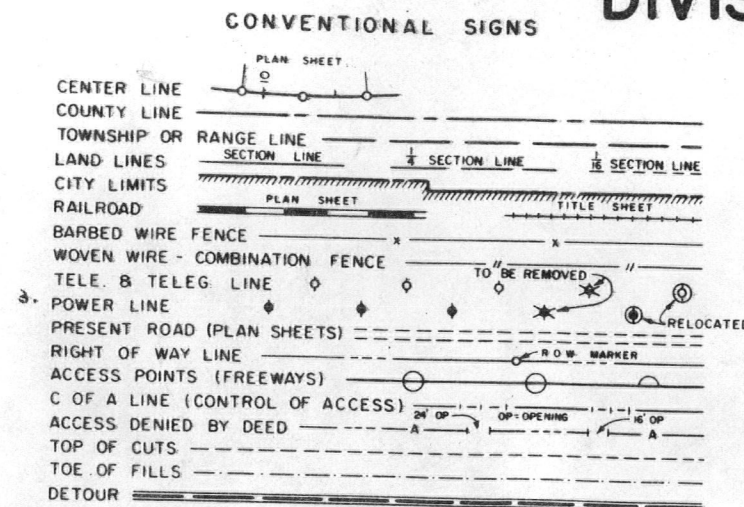

PLAN AND PROFILE OF PROPOSED COMPLETED FEDERAL AID PROJECT NO. RS 0089(5) STATE HIGHWAY NO. 89 PROWERS AND BACA COUNTIES

SCALES OF ORIGINAL DRAWINGS


ON PLAN, 1 IN. = 100 FT.
ON PROFILE 1 IN. = 100 FT. HORIZONTAL
1 IN. = 10 FT. VERTICAL

GRADE LINE ON PROFILE IS SHOWN AS GRADE OF FINISHED ROAD

STA. 1285+00 BEGIN RS 0089(5)=
STA. 1285+00 END S 0089(4)

TABULATION OF LENGTH AND DESIGN DATA

STATION	ROADWAY	
	PROWERS LIN. FT.	BACA LIN. FT.
1285+00.0 ~ BEGIN RS 0089(5) = 1285+00.0 ~ END S 0089(4)		
1348+85.5 ~ BEGIN BRIDGE STR. NO. N-28-B	6,385.5	
1349+14.1 ~ END BRIDGE	286	
1459+47.5 ~ BEGIN BRIDGE STR. NO. N-28-A	11,033.4	
1460+15.5 ~ END BRIDGE	68.0	
1497+71.0 ~ PROWERS-BACA CO. LINE	3,755.5	5,641.0
1554+12.0 ~ BEGIN BRIDGE STR. NO. N-28-C		29.0
1554+41.0 ~ END BRIDGE		159.0
1556+00.0 ~ END RS 0089(5)		
TOTALS	21,271.0	5,829.0
SUMMARY:	LIN. FT.	MILES
ROADWAY-PROWERS COUNTY	21,271.0	4.029
ROADWAY-BACA COUNTY	5,829.0	1.104
TOTAL ROADWAY (NET & GROSS LENGTH)	27,100.0	5.133
DESIGN DATA:		
MAXIMUM DEGREE OF CURVE	TANGENT	
MAXIMUM GRADE	4.26 %	
MINIMUM S.S.D.-HORIZONTAL	> 900'	
MINIMUM S.S.D.-VERTICAL	375'	
MAXIMUM DESIGN SPEED	50 M.P.H.	
1991 DESIGN TRAFFIC VOLUME	{ADT 250 DHY 30	

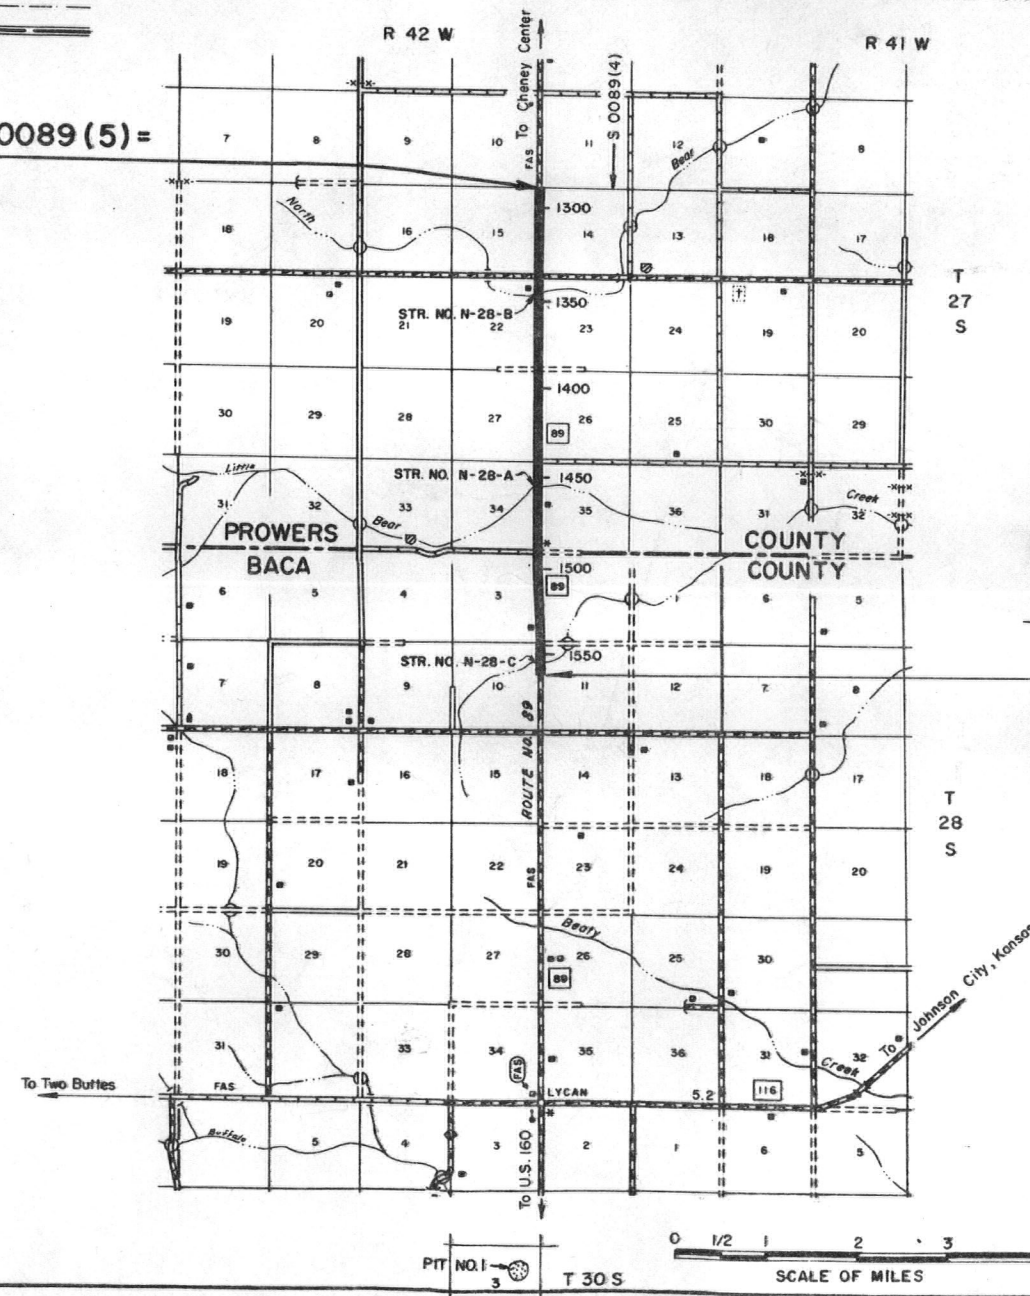

INDEX OF SHEETS

SHEET NO.	DESCRIPTION
1	SKETCH MAP, TITLE PAGE AND TABULATION OF LENGTH AND DESIGN DATA.
2	TYPICAL SECTION AND GENERAL NOTES.
3	SUMMARY OF APPROXIMATE QUANTITIES.
4	STRUCTURE QUANTITIES.
5	SURFACING PLAN, SUMMARY OF EARTHWORK QUANTITIES AND GUARD RAIL.
6	PIT SKETCH.
7	GUARD RAIL (TYPE 3A) CONNECTION TO EXISTING STRUCTURE NO. N-28-B STA. 1348+.
8	GUARD RAIL (TYPE 3A) CONNECTION TO EXISTING STRUCTURE NO. N-28-A STA. 1459+.
9	GUARD RAIL (TYPE 3A) CONNECTION TO EXISTING STRUCTURE NO. N-28-C STA. 1554+.
10-19	ALIGNMENT, PLAN AND PROFILE.
20-26	CROSS SECTIONS.

M-203-B	APPROACH ROADS, FLARING, CUT SLOPE TREATMENT, BRIDGE AND CREST WIDENING.	4-27-70
M-203-C	DITCH TYPES.	7-23-68
M-206-AA	EXCAVATION AND BACKFILL FOR STRUCTURES. (2 SHEETS)	3-1-71
M-603-M	METAL CULVERT PIPE - H-20 LOADING	2-11-71
M-603-RC	REINFORCED CONCRETE PIPE	3-1-71
M-606-AB	GUARD RAIL, TYPE 3. (3 SHEETS)	6-25-71
M-614-A	TIMBER BARRICADES.	4-23-69
M-614-IC	STANDARD CONSTRUCTION IDENTIFICATION SIGNS. (2 SHEETS)	9-25-70
M-614-TB	TRAFFIC SIGNING FOR HIGHWAY CONSTRUCTION. (3 SHEETS)	12-24-68
S-614-29B	TYPICAL PAVEMENT MARKINGS. (2 SHEETS)	8-18-71 4-11-72

"As Constructed No Revisions"
Sheet 8, 10-19

PROJECT STARTED - DECEMBER 1, 1971
PROJECT COMPLETED - JULY 7, 1972
CONTRACTOR - ROCKY MTN. PAVING INC.
RESIDENT ENGINEER - L.D. MULLER

SEE SPECIAL PROVISIONS FOR
NOTICE TO BIDDERS

DIVISION OF HIGHWAYS

APPROVED: *L. D. Muller* 10-13-71
CHIEF ENGINEER DATE

DIVISION OF HIGHWAYS

APPROVED: *L. D. Muller* 8-18-72
DIST. CONST. ENGR DATE

DEPARTMENT OF TRANSPORTATION
FEDERAL HIGHWAY ADMINISTRATION


APPROVED: _____ DATE _____

DIVISION ENGINEER

FEDERAL ROAD REGION NO.	DIVISION	PROJ. NO.	SHEET NO.	TOTAL SHEETS
9	COLORADO	RS 0089(5)	2	26

TYPICAL SECTION

Note:
See standards for details of cut slope
treatment, flaring and widening.

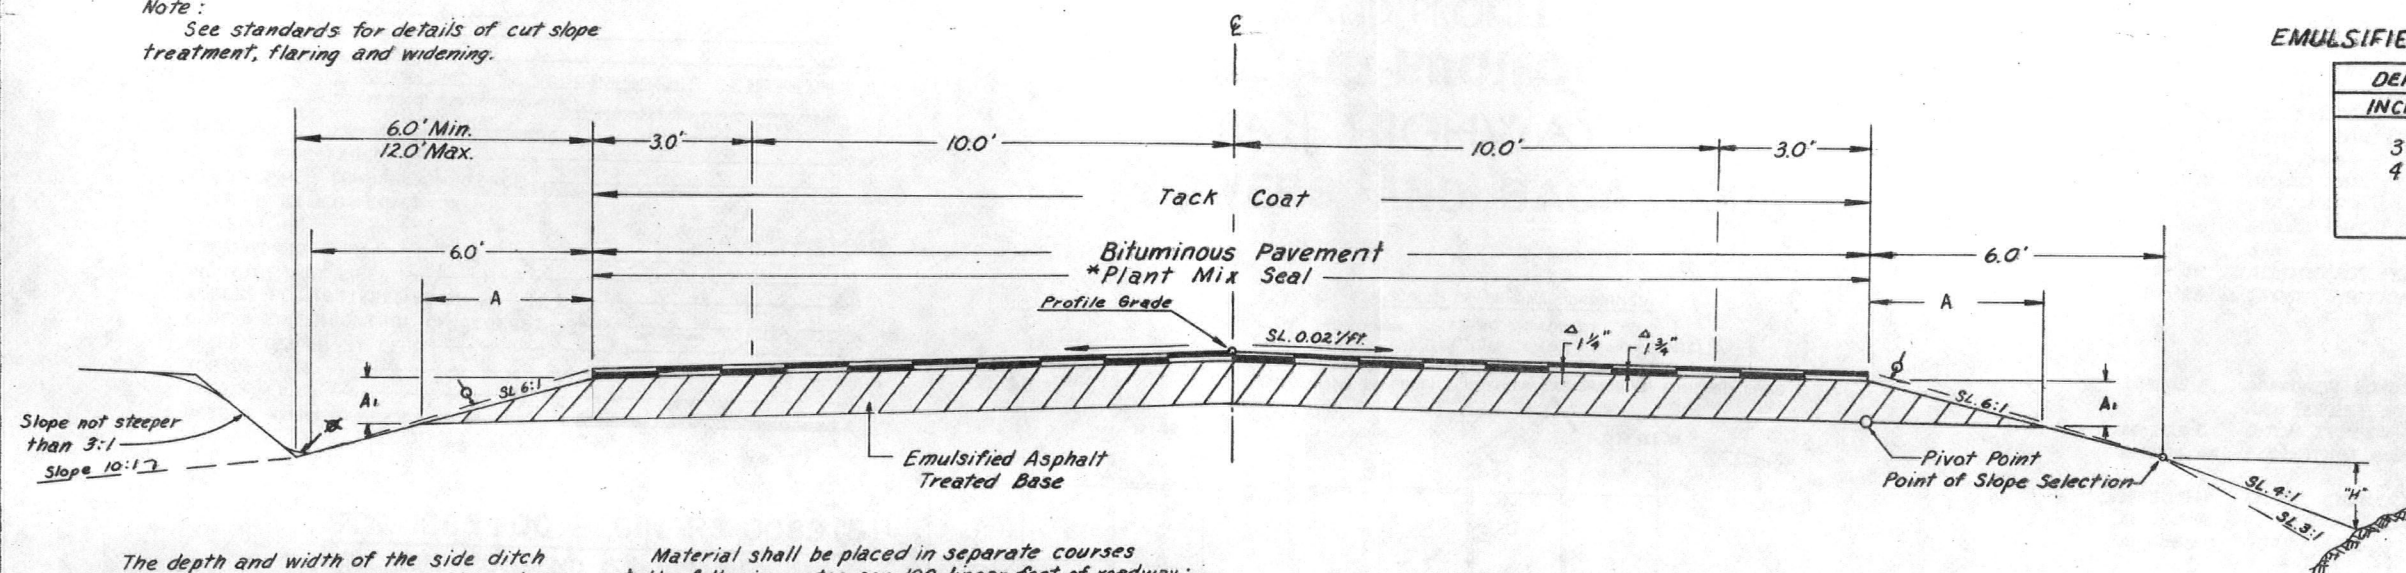

EMULSIFIED ASPHALT TREATED BASE

DEPTH INCHES	A FEET	A ₁ FEET
3	1.7	0.3
4	2.3	0.4

Fill Slopes

Slope 4:1 where "H" is 3' or less.
Slope 3:1 where "H" is over 3'.
In special cases, slope may be steepened.

The depth and width of the side ditch
shall be varied where necessary in order
to provide proper drainage.

Excavation below 6:1 slope and/or 10:1
slope will not be permitted.

Break points on slopes and in bottom
of ditches shall be rounded on construction
for a pleasing appearance.

Material shall be placed in separate courses
at the following rates per 100 linear feet of roadway:

Bituminous Pavement	Top Layer	19 tons
	Bottom Layer	26 tons
3" Emul. Asphalt Treated Base		47 tons
4" Emul. Asphalt Treated Base		63 tons

* Future Construction

Δ Approximate thickness

φ The Contractor will be required to place suitable material to this line
after completion of paving operation.

GENERAL NOTES

For preliminary plan quantities of Bituminous Materials the following
rates of application were used:

Tack Coat, Emul. Asph. @ 0.10 Gals. per Sq. Yd. (Diluted)

Rates of application shall be as determined by the Engineer at the time
of application.

Flexible conduits on this project with helical corrugations, joined
by dimpled connecting bands, shall use a sealing compound or gasket
with the connecting band.

The Type of Compaction for reconditioning shall be AASHTO T-99.

Depth of Moisture-Density control for Grading Sections shall be
as follows:

Bases of Cuts and Fills - 6 inches.
Full depth of all embankments.

Excavation required for compaction of bases of cuts and fills will be
considered as subsidiary to that operation and will not be paid for separately.

Plain water shall be used as a dust palliative where required.
Locations shall be as ordered.

Through areas of reconditioning, the road, including shoulders,
shall be scarified to a depth of 6 inches. Est. Quantity - 4.5 miles.

The Contractor shall conduct his operations so that a minimum of
existing vegetation, adjacent to the roadway, is destroyed.

Any layer of bituminous pavement that is to have a succeeding layer placed
thereon shall be completed full width before succeeding layer is placed.

Road approaches which require bituminous pavement shall be tacked
and a 3" thickness of bituminous pavement placed as follows:

Public approaches and entrances to buildings or residences shall be
tacked 50 ft. out from edge of shoulder or to the Right of Way line, whichever
is less. Field entrances shall be tacked 4 ft. out from edge of shoulder.

Approaches shall have Emulsified Asphalt Treated Base.

It is estimated that 20 hours Blading will be required.

Guard posts, signs and delineators will be removed by State Forces.

It is estimated that ²⁸⁴ 1900 Hours of Flagging for controlling traffic will
be required for this project.

Ski-type device 30 feet in length and short shoe shall be furnished with
the automatic control system of each bituminous paver.

It is estimated that ²⁸⁷ 225 gal. of Pavement Marking Paint will be required for this
project. This quantity includes the following:

White Paint	²³⁰ 179 gal.
Yellow Paint	⁵⁷ 52 gal.

The Engineer will establish all terminal points for no-passing zones on the project.

The Force Account item, "Cleaning Bridge Decks", shall include the removal of all dirt,
gravel, etc. from bridge floor prior to placement of pavement on bridges.

FEDERAL ROAD REGION NO.	DIVISION	PROJ. NO.	SHEET NO.	TOTAL SHEETS
9	COLORADO	RS 0089 (5)	3	26

STRUCTURE QUANTITIES

AS CONSTRUCTED
REVISED DATE 11/7/72

FEDERAL ROAD REGION NO.	DIVISION	PROJECT NO.	SHEET NO.
8	COLORADO	RS 0089 (5)	4

LOCATION	REMOVAL OF STRUCTURE	UNCLASSIFIED EXCAVATION			STRUCTURE EXCAVATION		STRUCTURE BACKFILL		E. A. T. B. (CLASS 7)		AGGREGATE BASE COURSE SURFACING		HOT BITUMINOUS PAVEMENT		CONCRETE		REINFORCING STEEL		INDEX			CULVERT PIPE LINEAR FEET							"H" OVER CULV. FT.	SLOPE AND DITCH PAVING CUBIC YARD	END SECTION			MISCELLANEOUS
		EXCAV.	EMB.	DITCH	CUBIC YARD	CUBIC YARD	CL. 2'	TON	TON	TON	CL. A	LB.	BOOK	PAGE	SHEET	18"	24"	30"	18"	24"	30"	18"	24"	30"	18"	24"	30"	EACH						
																EACH																		
1285 +00																		1	8													✓ 1 - Identification Sign (State Forces)		
1289 +25		4	15						27.15				*	2				1	10															
1301 +20		4	15		14	5			28.80				*	2				1	12		30					1								
1326 +50	1	8	30		17	12			45.50				*	4				1	14		30	30					1							
1339 +74		40	160						45.25				49.00					1	16															
1345 +75	1	4	15		1	3			27.50				9.10					1	18				10				1							
1347 +80		4	15						28.20				*	2				1	20															
1348 +99		72							45.50				*	4				1	21															
1366 +21		8	30		27	10			22									1	22		30					1								
1380 +75		4	15						21.00				20.35					1	24															
1384 +30		4	15						21.00				9.30					1	26															
1388 +31		4	15						25.00				21.35					1	28															
1392 +69		8	30						41.50				*	4				1	30															
1418 +77		4	15						13.65				*	2				1	32															
1444 +48	1	4	15		3	5			16.40				*	2				1	34		30					1								
1445 +15		20	80		3	5			16.45				10.90					1	35		30					1								
1468 +49	2	8	30		9	15			16.40				13.80					1	37			30				1								
1497 +59		3	15		14	5			14.60				*	2				1	39		30					1								
Sub-Total (Prowers Co.)	5	203	510		88	60			133.90				133.80								210	94	10											
1497 +80		3	15		21	7			14.60				*	2				1	40															
1538 +20		3	15						13.50				8					1	42		40					1								
1550 +53		392							28.00				*	4				1	44															
1554 +26		150							22									1	46															
1555 +73		4	15						14.35				*	2				1	48															
1556 +00									*	40			*	6				1	52															
1556 +00																		1	50													✓ 1 - Identification Sign (State Forces)		
Sub-Total (Baca Co.)		402	45		21	7			70.45				13.65								40													
Project Totals	5	605	555		109	67			504.35				147.45								250	94	10											

* Included in Roadway Quantities

NOT CONSTRUCTED
REVISED JUL 1972

FEDERAL ROAD REGION NO.	DIVISION	PROJ. NO.	SHEET NO.	TOTAL SHEETS
9	COLORADO	RS 0089 (5)	5	26

SURFACING PLAN

STATION	SOURCE	QUANTITY - TONS								HAUL - TON MILE							
		EMULSIFIED ASPHALT TREATED BASE				HOT BITUMINOUS PAVEMENT				EMULSIFIED ASPH. TREATED BASE				HOT BITUMINOUS PAVEMENT			
		THICKNESS				GR. F				CL. 7				GR. F			
		CL. 7	FINAL	CL. 7	FINAL	GR. F	FINAL	GR. F	FINAL	CL. 7	FINAL	CL. 7	FINAL	GR. F	FINAL	GR. F	FINAL
1285+00 to 1348+85		4	4,023	4,012.70	1,660	1,982.70	1,213	1,137.30	62,777	62,630	25,903	30,946	18,928	17,751			
1348+85 to 1349+14.5 BRIDGE						7.00	6	6.00				105	90	90			
1349+14.5 to 1459+47.5		4	6,951	7,014.90	2,869	2,839.85	2,096	1,830.35	96,963	97,878	40,021	39,624	29,238	25,539			
1459+47.5 to 1460+15 BRIDGE						32.45	13	11.00				419	168	142			
1460+15 to 1470+00		4	621	788.20	256	236.75	187	162.90	7,948	10,091	3,276	3,031	2,393	2,085			
1470+00 to 1497+71		3	1,302	2,250.70	720	732.65	526	501.95	16,201	28,013	8,959	9,119	6,545	6,247			
ESTIMATED FOR: CORRECTING IRREGULARITIES	NO. 1		1,290	*					18,393	*							
WIDENING FOR GUARD RAIL			40	*				33	*	570	*			468	*		
FROM STRUCTURE QUANTITIES			363	433.90				130	133.80	5,176	6,345			1,845	1,931		
SUB TOTAL (PROWERS CO.) =			14,590	14,500.40	5,505	5,831.40	4,204	3,783.30	208,028	204,957	78,159	83,244	59,675	53,785			
1497+71 to 1510+00	PIT	3	578	684.10	320	345.00	234	181.65	6,973	8,255	3,861	4,163	2,823	2,192			
1510+00 to 1554+12		4	2,780	2,654.95	1,147	1,155.00	838	859.40	32,053	30,621	13,225	13,327	9,662	9,912			
1554+12 to 1554+41 BRIDGE						4.00	6	6.00				44	67	67			
1554+41 to 1556+00	MUNDALL	4	100	174.65	42	25.35	30	41.55	1,109	1,938	466	281	333	461			
ESTIMATED FOR: CORRECTING IRREGULARITIES			346	*					4,014	*							
WIDENING FOR GUARD RAIL			20	*				17	*	217	*			185	*		
FROM STRUCTURE QUANTITIES			95	70.45				22	13.65	1,031	804			240	156		
SUB TOTAL (BACA CO.) =			3,919	3,584.15	1,509	1,529.85	1,147	1,102.25	45,397	41,618	17,552	17,815	13,310	12,788			
PROJECT TOTALS =			18,509	18,084.55	7,014	7,361.25	5,351	4,885.55	253,425	246,575	95,711	101,059	72,985	66,573			

* Included in Roadway Quantities

STABILIZATION FOR THIS PROJECT IS BASED ON THE FOLLOWING:

1. E.D.L.A. 18K 6
2. REGIONAL FACTOR 1.25
3. SERVICEABILITY INDEX 2.0
4. HOT BIT. PAVEMENT 0.25 (Rt + 80)
5. EMUL. ASPH. TREAT. BASE 0.23 (Rt + 92)

GUARD RAIL

STATION TO STATION	SIDE	GUARD RAIL		STATION TO STATION	SIDE	GUARD RAIL	
		TYPE 3				TYPE 3	
		LIN. FT.				LIN. FT.	
Prowers Co.				Baca Co.			
1347+33.25 ^ø to 1348+83.25*	Rt.	150 [✓]		1552+60.0 ^ø to 1554+10.0*	Rt.	150 [✓]	
1349+16.75 ^ø to 1349+91.75 ^ø	Rt.	75 [✓]		1554+43.0* to 1555+18.0 ^ø	Rt.	75 [✓]	
1348+08.25 ^ø to 1348+83.25*	Lt.	75 [✓]		1553+35.0 ^ø to 1554+10.0*	Rt. Lt.	75 [✓]	
1349+16.75* to 1350+66.75 ^ø	Lt.	150 [✓]		1554+43.0* to 1555+68.0 ^ø	Rt. Lt.	125 [✓]	
1458+56.5 ^ø to 1459+31.5*	Lt.	75 [✓]					
1460+06.5* to 1461+56.5 ^ø	Lt.	150 [✓]					
1458+06.5 ^ø to 1459+56.5*	Rt.	150 [✓]					
1460+31.5* to 1461+06.5 ^ø	Rt.	75 [✓]					
Sub Total Prowers Co.		900 [✓]		Sub Total Baca Co.		425 [✓]	
				Total		1,325 [✓]	

* Attach to Bridge Guard Rail.
Type I Anchor 12 Required.

Note: See sheet Nos. 7, 8 and 9 for Guard Rail Type 3A Requirements.

SUMMARY OF EARTHWORK QUANTITIES

INDEX			PROWERS	BACA	PROJECT					
BOOK	PAGE	SHEET	CO.	CO.	TOTALS					
			Cu. Yd.	Cu. Yd.	Cu. Yd.					
Plans Plans Plans	20-25 4 4	UNCLASSIFIED EXCAVATION								
			Roadway (From Cross Sections)	3,440	2,822	72	0	3,512	2,822	
			Structure Quantities as Embankment	0	0	0	0	0	0	
			Structure Quantities as Excavation	131	203	160	402	291	605	
			TOTAL	3,571	3,025	232	402	3,803	3,427	
To be made from Structure Quantities Excavation and Excess Excavation from Roadway.										
COMPACTION (AASHTO T99)										
Plans Plans Plans	20-25 11 4	Embankment (Net) Base of Cuts and Fills Structure Quantities as Embankment (Net)	2,189	1,869			2,189	1,869		
			1,829	1,629	167	167	1,796	1,796		
			510	510	45	45	555	555		
			TOTAL	4,328	4,008	212	212	4,540	4,220	
			HAUL	Yd. Mi.	Yd. Mi.	Yd. Mi.				
Mass Diagram	1 6	Estimated for Profile Quantities Estimated for Road Approaches	1,200	1,052			1,200	1,052		
			1,100	1,026	100	39	1,200	1,065		
			TOTAL	2,300	2,078	100	39	2,400	2,117	
			ROADWAY QUANTITIES BALANCE (For Information Only)			Cu. Yd.	Cu. Yd.	Cu. Yd.		
			EXCAVATION							
Unclassified			3,440	72			3,512			
* Excess Excavation			-522	-72			-594			
TOTAL			2,918	0			2,918			
EXCAVATION X FACTOR										
Unclassified			2,580	54			2,634			
* Excess Excavation			-391	-54			-445			
TOTAL			2,189	0			2,189			
EMBANKMENT										
Roadway from Cross Sections			2,189				2,189			
TOTAL			2,189				2,189			
* To be used for Road Approaches or Shoulder Widening as directed.										

DOH FORM # 266 - Quantity Book

FEDERAL ROAD REGION NO.	DIVISION	PROJ. NO.	SHEET NO.	TOTAL SHEETS
9	COLORADO	RS 0089 (5)	6	26

LOG OF PIT

Sample No 5015

TEST NO.	DEPTH IN FEET	DESCRIPTION OF MATERIAL
4	0.0 - 3.3	SILT: SANDY, CLAYEY
4A	3.3 - 11.5+	SAND: WELL-GRADED, PEBBLY
6	0.0 - 1.4	SILT: SANDY, CLAYEY
6A	1.4 - 11.3+	SAND: WELL-GRADED, PEBBLY
7	0.0 - 3.4	SILT: SANDY, CLAYEY
7A	3.4 - 11.0+	SAND: WELL-GRADED, PEBBLY
10	0.0 - 5.3	SILT: SANDY, CLAYEY
10A	5.3 - +	CLAYSTONE: LIGHT GRAY, HARD
11	0.0 - 1.3	SILT: SANDY, CLAYEY
11A	1.3 - 6.3	SAND: WELL-GRADED, PEBBLY
11B	6.3 - +	SILTSTONE: SANDY, SOFT
12	0.0 - 1.6	SILT: SANDY, CLAYEY
12A	1.6 - 5.3	SAND: WELL-GRADED, PEBBLY
12B	5.3 - +	SILTSTONE: SANDY, SOFT
13	0.0 - 3.0	SILT: SANDY, CLAYEY
13A	3.0 - 10.0+	SAND: WELL-GRADED, PEBBLY
14	0.0 - 4.7	SILT: SANDY, CLAYEY
14A	4.7 - 11.0+	SAND: WELL-GRADED, PEBBLY
15	0.0 - 4.6	SILT: SANDY, CLAYEY
15A	4.6 - 6.3+	SAND: WELL-GRADED, PEBBLY
20	0.0 - 1.0	SILT: SANDY, CLAYEY, TRACE OF GRAVEL
20A	1.0 - 2.4	SAND: MEDIUM, WITH GRAVEL
20B	2.4 - 12.0	SAND: WELL-GRADED, GRAVELLY
21	0.0 - 1.3	SILT: SANDY, CLAYEY, TRACE OF GRAVEL
21A	1.3 - 6.6	SAND: MEDIUM TO COARSE, GRAVELLY
21B	6.6 - 12.5+	SAND: WELL-GRADED, CLEAN
22	0.0 - 2.0	SILT: SANDY, CLAYEY, TRACE OF GRAVEL
22A	2.0 - 12.4+	SAND: MEDIUM TO COARSE, WITH FINE GRAVEL
23	0.0 - 0.5	SILT: SANDY, CLAYEY, GRAVELLY
23A	0.5 - 12.0+	SAND: WELL-GRADED, TRACE OF FINE GRAVEL
24	0.0 - 0.5	SILT: SANDY, CLAYEY, GRAVELLY
24A	0.5 - 6.0	SAND: WITH TRACE OF GRAVEL
24B	6.0 - +	SANDSTONE: HARD
25	0.0 - 1.5	SILT: SANDY, CLAYEY, TRACE OF GRAVEL
25A	1.5 - 8.0	SAND: WELL-GRADED, TRACE OF FINE GRAVEL
25B	8.0 - +	SANDSTONE: WITH CLAYSTONE, SOFT TO HARD
26	0.0 - 1.0	SILT: SIMILAR TO TEST NO. 20
26A	1.0 - 4.5	SAND: SIMILAR TO TEST NO. 22A
26B	4.5 - +	SANDSTONE
27	0.0 - 1.3	SILT: SIMILAR TO TEST NO. 20
27A	1.3 - 7.0	SAND: WITH CLAY
27B	7.0 - +	SANDSTONE
28	0.0 - 1.0	SILT: SIMILAR TO TEST NO. 20
28A	1.0 - 6.0	SILT: SIMILAR TO TEST NO. 21
28B	6.0 - 8.2	SAND: CLAYEY
28C	8.2 - +	SAND: FINE
29	0.0 - 1.0	SILT: SANDY, CLAYEY
29A	1.0 - 2.0	SAND: SILTY
29B	2.0 - 12.5+	SAND: MEDIUM TO COARSE, GRAVELLY
30	0.0 - 1.3	SILT: SANDY, CLAYEY
30A	1.3 - 5.0	SILT: CLAYEY, WHITE
30B	5.0 - 6.3	SAND: FINE, SLIGHTLY CLAYEY
30C	6.3 - 7.4	SAND: MEDIUM TO COARSE, CLEAN
30D	7.4 - 12.0+	SAND: MEDIUM TO COARSE, TRACE OF GRAVEL AND SAND CLAY BALLS
31	0.0 - 0.5	SILT: SIMILAR TO TEST NO. 20
31A	0.5 - 4.0	SAND: GRAVELLY
31B	4.0 - 9.5+	SAND: MEDIUM TO COARSE, CLEAN
32	0.0 - 1.0	SILT: SIMILAR TO TEST NO. 21
32A	1.0 - 5.0	SAND: GRAVELLY, CLAYEY
32B	5.0 - 11.0+	SAND: WELL-GRADED, CLAYEY
33	0.0 - 1.2	SILT: SIMILAR TO TEST NO. 30
33A	1.2 - 4.0	SILT: SIMILAR TO TEST NO. 30A
33B	4.0 - 8.4	SAND: WITH TRACE OF GRAVEL, CLAYEY
33C	8.4 - +	CLAYSTONE: GRAY
34	0.0 - 1.0	SILT: SIMILAR TO TEST NO. 30
34A	1.0 - 7.0+	SILT: SIMILAR TO TEST NO. 30A
35	0.0 - 0.6	SILT: SIMILAR TO TEST NO. 20
35A	0.6 - 2.7	SAND: CLAYEY, GRAVELLY
35B	2.7 - 9.0	SAND: MEDIUM TO COARSE, GRAVELLY
35C	9.0 - +	GRAVEL, SANDSTONE & CLAY
36	0.0 - 0.6	SILT: SIMILAR TO TEST NO. 20
36A	0.6 - 9.5	SAND: MEDIUM TO COARSE, TRACE OF GRAVEL, CLAYEY
36B	9.5 - +	SANDSTONE: WITH CLAY, SOFT
37	0.0 - 0.7	SILT: SIMILAR TO TEST NO. 30
37A	0.7 - 2.3	SILT: SIMILAR TO TEST NO. 30A
37B	2.3 - 4.0	SAND: SIMILAR TO TEST NO. 36A
37C	4.0 - 9.4	SAND: WITH CLAY
37D	9.4 - +	SANDSTONE: CLAYEY
38	0.0 - 2.0	SILT: SIMILAR TO TEST NO. 30
38A	2.0 - 3.5	SAND: SILTY
38B	3.5 - 9.0	SAND: SIMILAR TO TEST NO. 36A
38C	9.0 - +	SANDSTONE & CLAY
39	0.0 - 0.8	SILT: SIMILAR TO TEST NO. 20
39A	0.8 - 3.5	SAND: SIMILAR TO TEST NO. 36A
39B	3.5 - +	SANDSTONE: CLAYEY

Sample No. 1036

PIT NO. 1

Owner: Felix & Mamie Mundell, Walsh, Colorado

Location: Part of the Northeast 1/4 Sec. 3, T. 30 S., R. 42 W.

Use: Aggregate for Emulsified Asphalt Treated Base and Hot Bituminous Pavement

Quantity Available: 94,000 Cu. Yds.


Stripping: ~~5,000 Cu. Yds.~~ Remove Overburden 4,081 Cu. Yds.
~~5,000 Cu. Yds.~~ Replace Overburden 4,081 Cu. Yds.

Haul Distance: 11.08 Miles to Sta. 1556 +00

Haul distance was checked by odometer and found to be correct.

LEGEND

--- Outline Pit Area
--- Worked Out Pit
O Test Hole
Scale in Feet
200 0 200 400





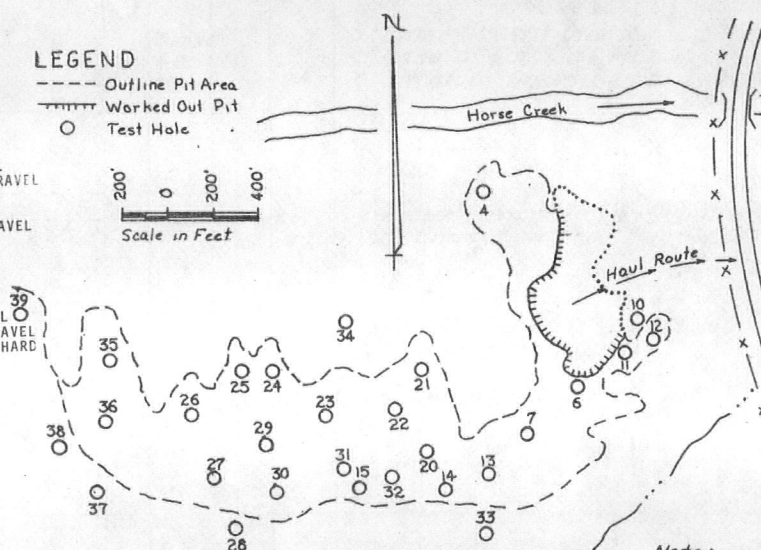


Note: Depth of water table unknown.
Sample No. 5015
Date: 9-5-68 #2-5-71
Sample No. 1036
Date: 6-15-71


Note: This pit previously used on Project Nos. S 0160(3); RS 0116(3); S 0002(29); S 0160(4).

FEDERAL ROAD REGION NO.	DISTRICT	PROJ. NO.	SHEET NO.	TOTAL SHEETS
8	COLORADO	RS 0089 (5)	7	26

REVISIONS		

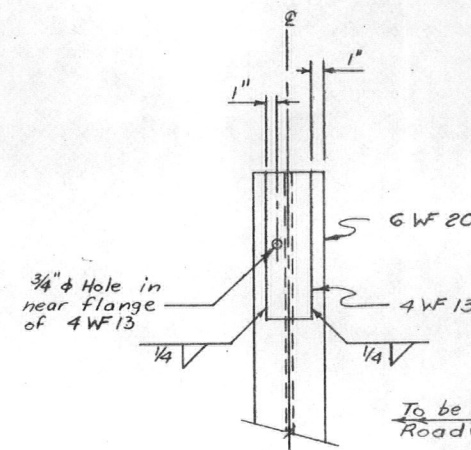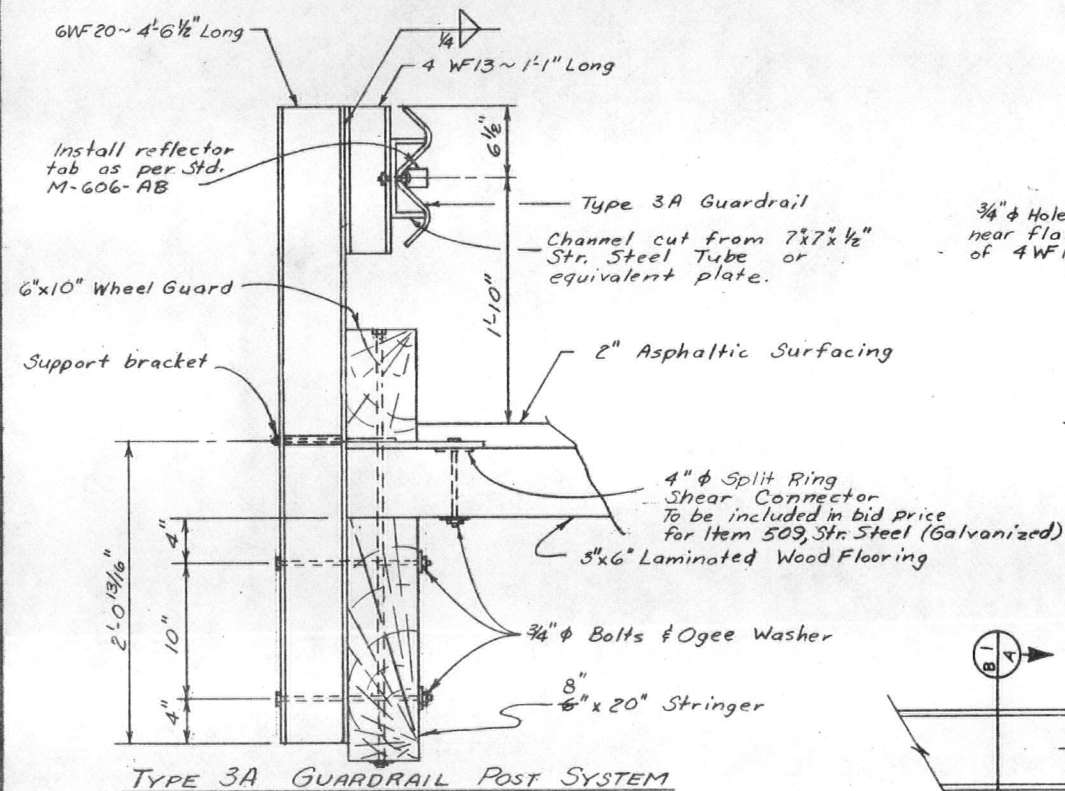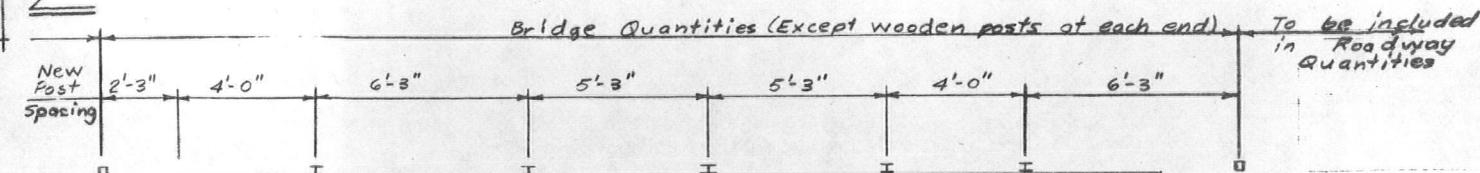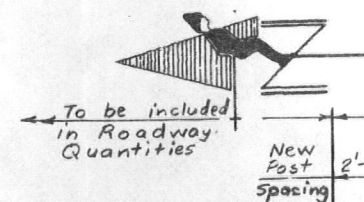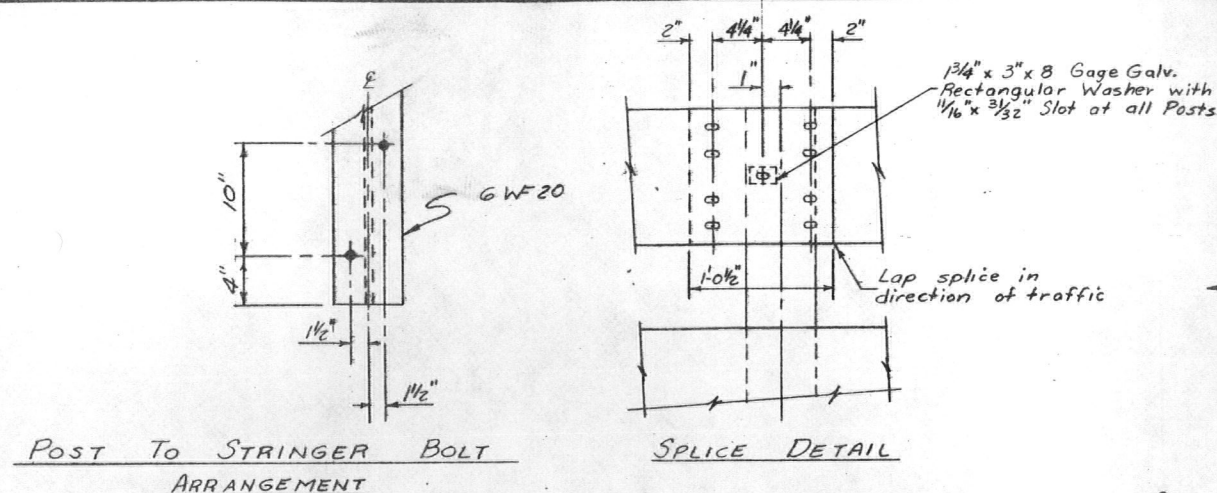


POST LOCATION OF 4WF13

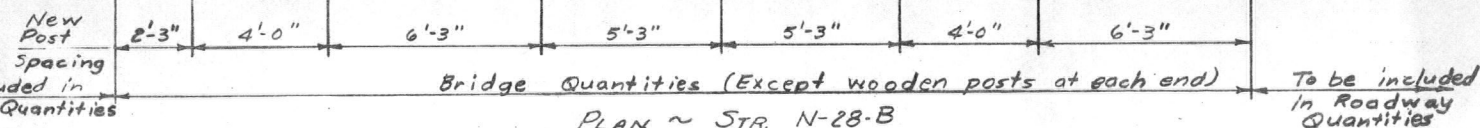


Item	Description	Unit	Str. N-28-B	
			Super-structure	Totals
202	Removal of Portions of Present Str.	Ea.	1	1
509	Structural Steel (Galvanized)	Lb.	3025	3025
606	Guard Rail Type 3A	Lin. Ft.	67	67
			75	75

Included in Roadway Quantities.

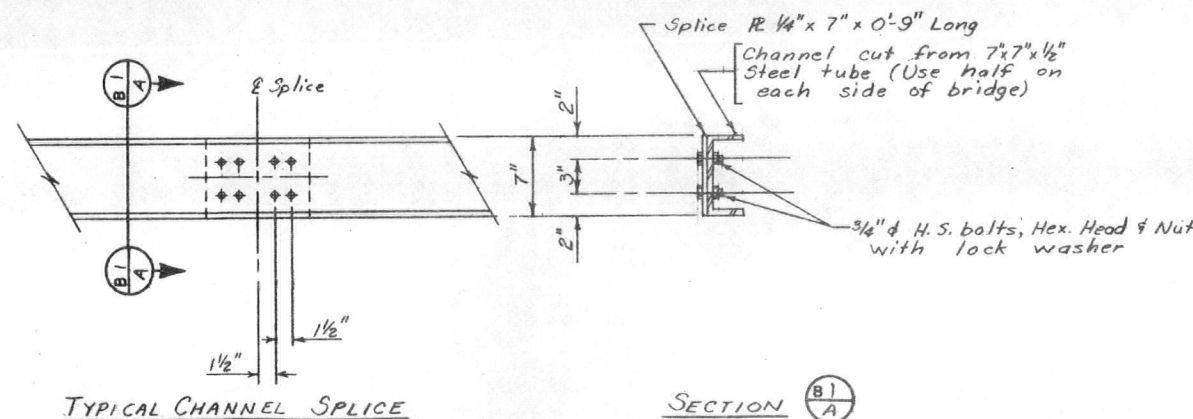

General Notes
 For additional details of guard rail and its installation not shown on these sheets see Std. M-606-AB.

All posts and steel elements shall be galvanized after fabrication.
 Field drilling of holes in existing timber stringers and laminated wood flooring to be included in the bid price of Item 509.

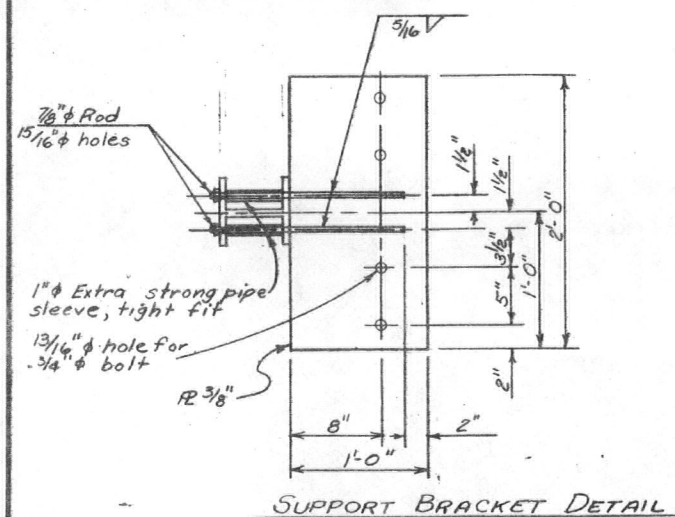

SUPPORT BRACKET DETAIL


DIVISION OF HIGHWAYS

GUARD RAIL (TYPE 3A) CONNECTION TO EXISTING STRUCTURE

Approved: Schwartz RE Bridge Engineer Date: Sept. 20, 1971	Designer: H. Henson Structure Numbers N-28-B DWG. No. 8 / of 3
---	---

FEDERAL ROAD REGION NO.	DISTRICT	PROJ. NO.	SHEET NO.	TOTAL SHEETS
9	COLORADO	RS 0089(5)	8	


REVISIONS	

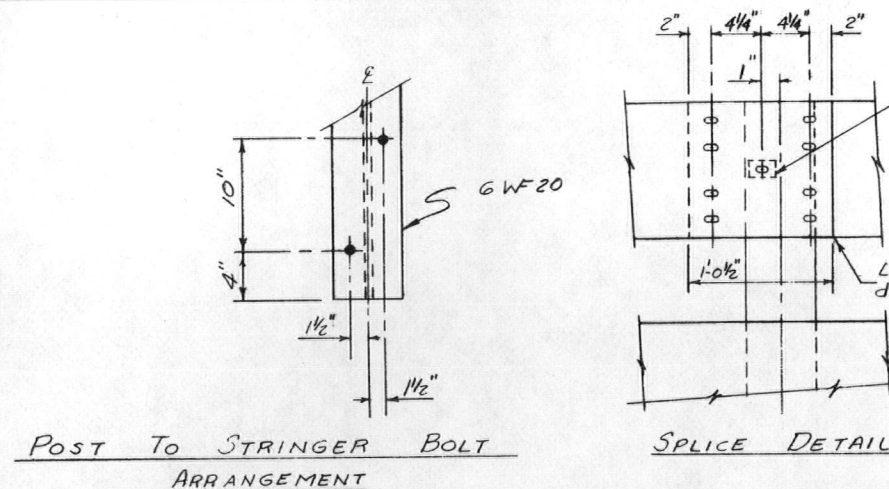

To be included in Roadway Quantities

Bridge Quantities (Except wooden posts at each end)


To be included in Roadway Quantities

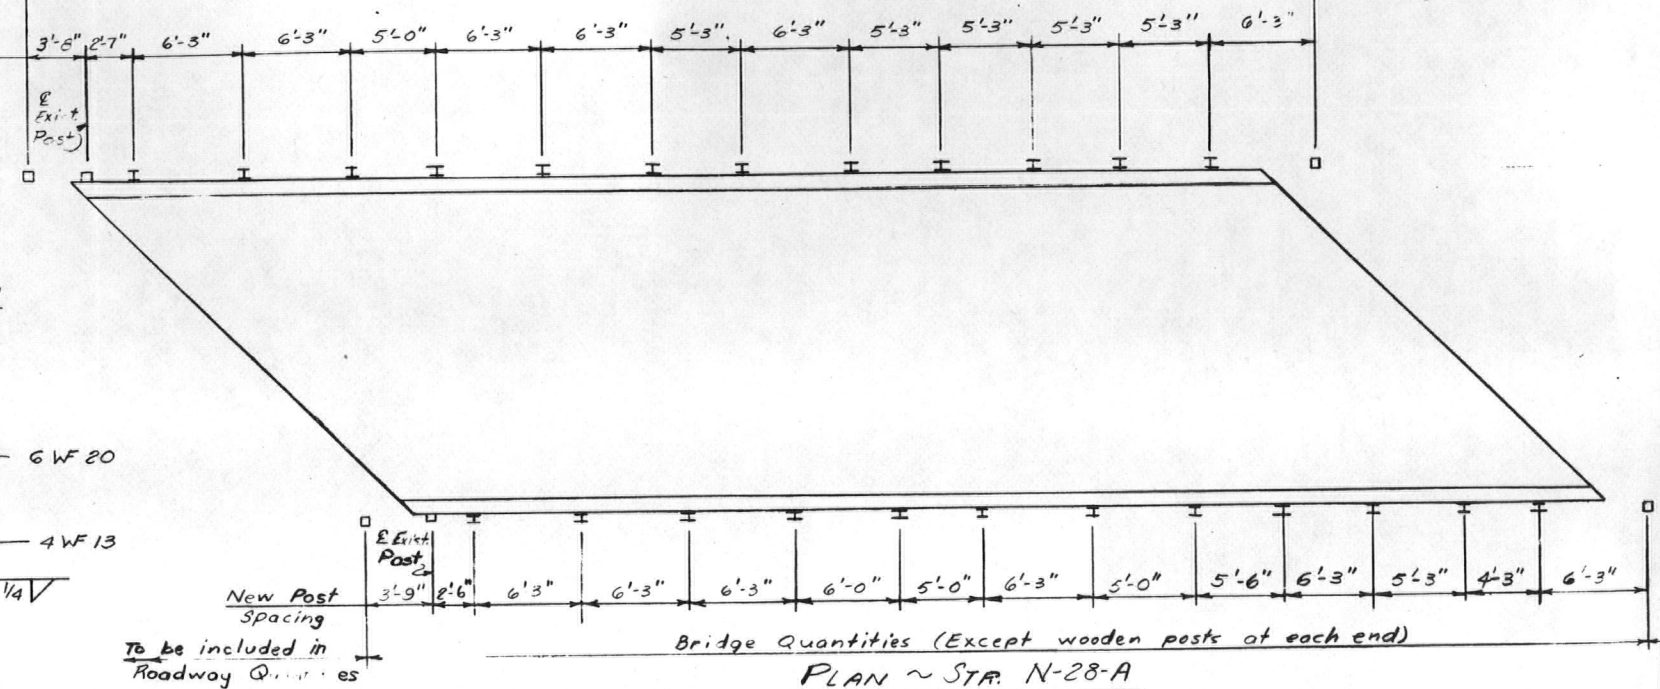


To be included in Roadway Quantities

Bridge Quantities (Except wooden posts at each end)

To be included in Roadway Quantities


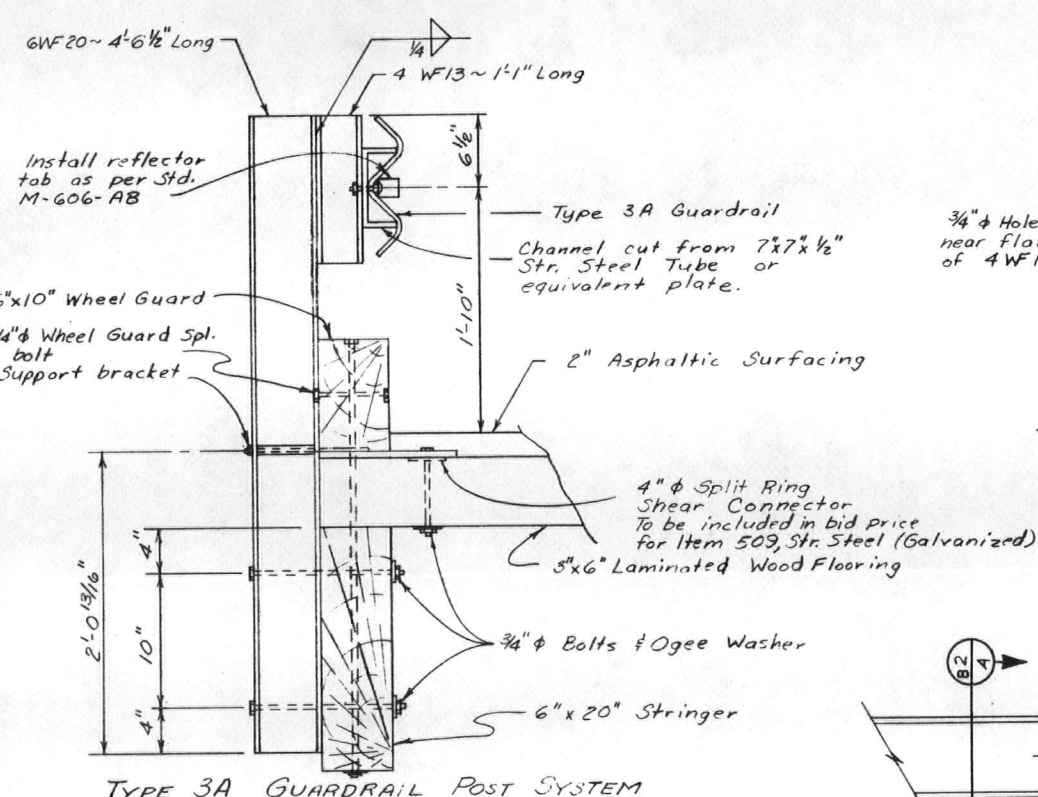


POST LOCATION OF 4WF13

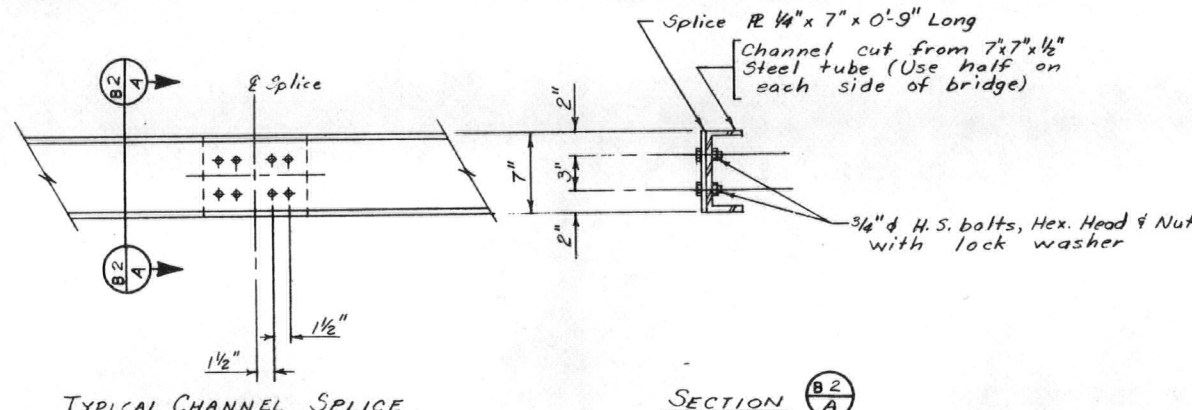

Item	Description	Unit	Str. N-28-A	Totals
202	Removal of Portions of Present Str.	Ea.	1	1
509	Structural Steel (Galvanized)	Lb.	7060	7060
606	Guard Rail Type 3A	Lin. Ft.	150	150

Included in Roadway Quantities.

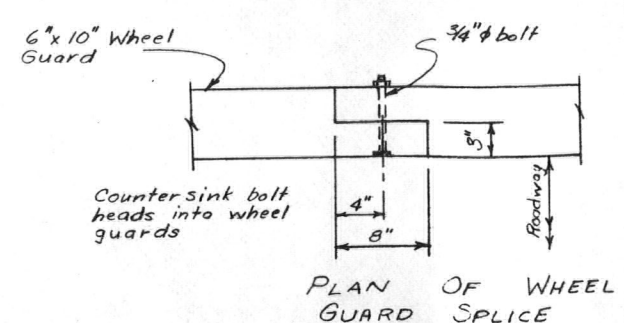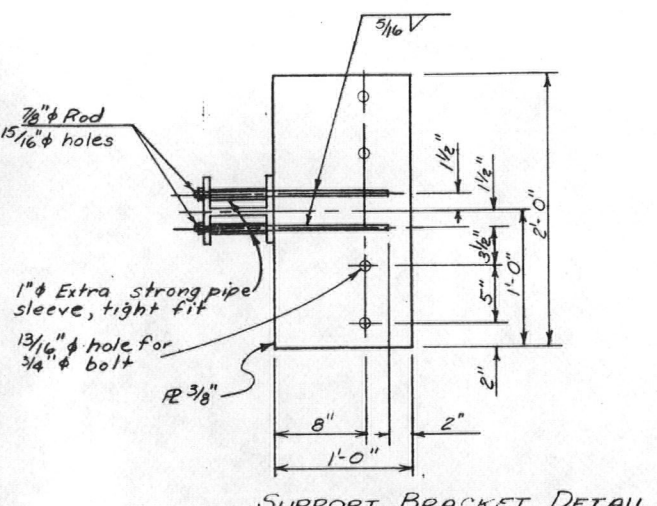

General Notes
For additional details of guard rail and its installation not shown on these sheets see Std. M-606-AB.
2-3/4 x 16 H.S. Bolts with Hex. H. and Hex. Nut required at each stringer splice where post is removed.
All posts and steel elements shall be galvanized after fabrication.
Field drilling of holes in existing timber stringers and laminated flooring to be included in the bid price of Item 509.

DIVISION OF HIGHWAYS


GUARD RAIL (TYPE 3A) CONNECTION TO EXISTING STRUCTURE

Approved: P. L. W. R. P.E. Bridge Engineer Date: Sept. 20, 1971	Designer: H. Henson Structure Numbers N-28-A	Detailer: D. Blaker DWG. No. 8 2 OF 3
--	--	--



FEDERAL ROAD DISTRICT	PROJ. NO.	SHEET NO.	TOTAL SHEETS
9 COLORADO	RS 0089 (5)	9	26

REVISIONS	

POST TO STRINGER BOLT
ARRANGEMENT

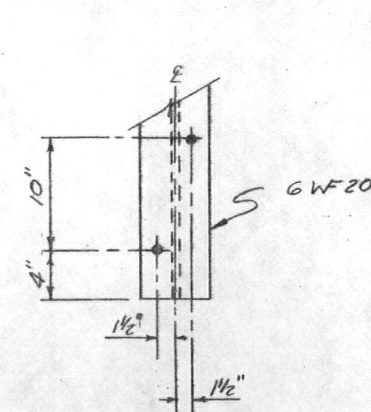

SPLICE DETAIL

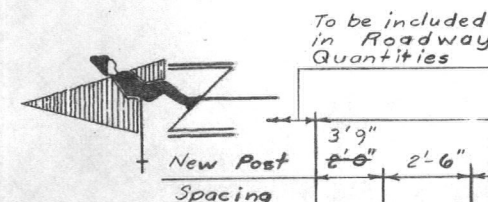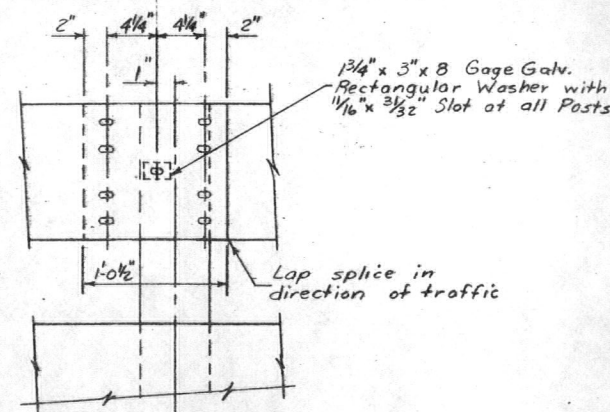

Bridge Quantities (Except wooden posts at each end)


To be included in Roadway Quantities

New Post Spacing
To be included in Roadway Quantities

Bridge Quantities (Except wooden posts at each end)



To be included in Roadway Quantities

PLAN ~ STR. N-28-C

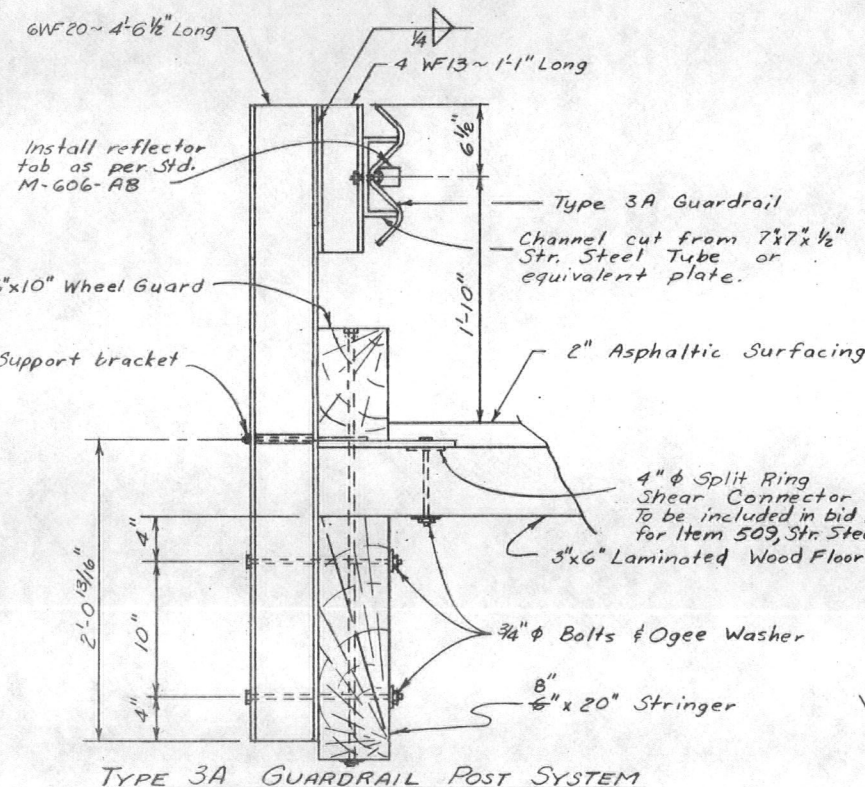

TYPE 3A GUARDRAIL POST SYSTEM

POST LOCATION OF 4WF13

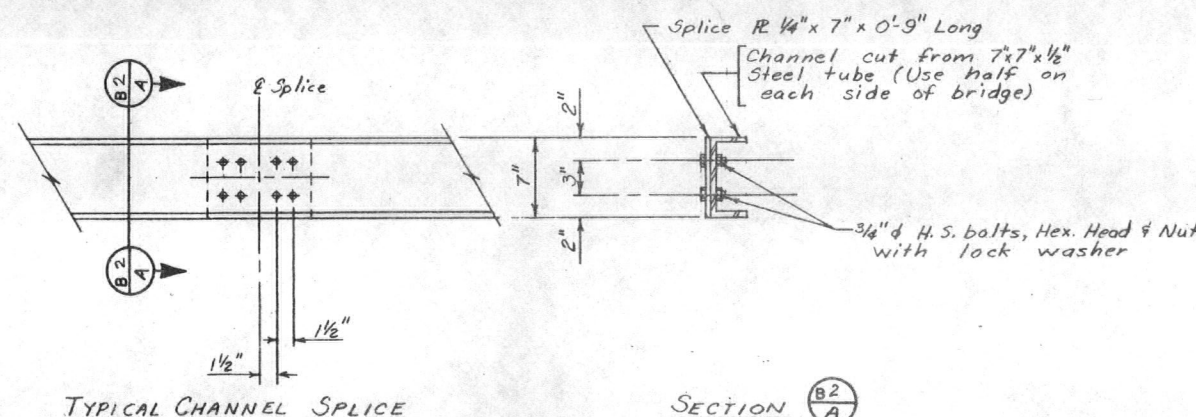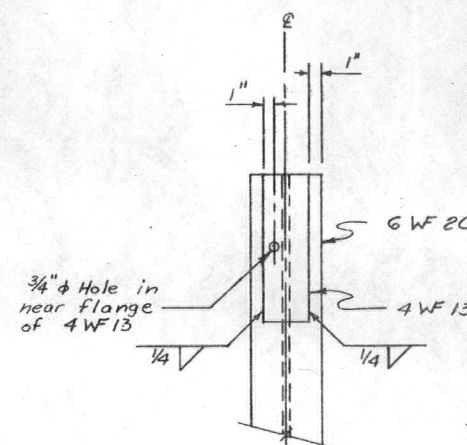

TYPICAL CHANNEL SPLICE


SECTION B2 A

General Notes
For additional details of guard rail and its installation not shown on these sheets see Std. M-606-AB.

All posts and steel elements shall be galvanized after fabrication. Field drilling of holes in existing timber stringers and laminated wood flooring to be included in the bid price of Item 509.

Item	Description	Unit	Str. N-28-C	
			Super-structure	Totals
202	Removal of Portions of Present Str.	Ea.	1	1
509	Structural Steel (Galvanized)	Lb.	3320	3320
606	Guard Rail Type 3A	Lin. Ft.	66	66
			75	75

Included in Roadway Quantities.

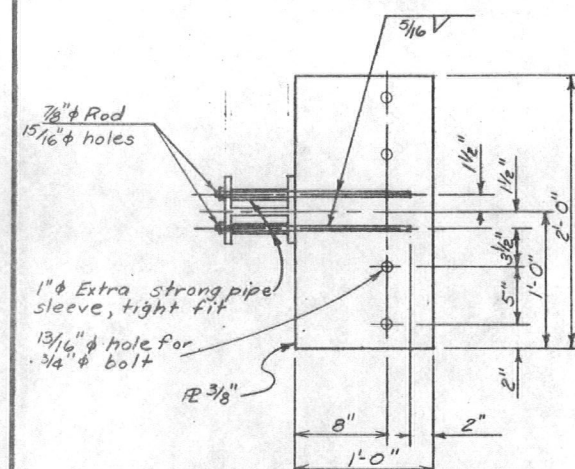

SUPPORT BRACKET DETAIL

DIVISION OF HIGHWAYS

GUARD RAIL (TYPE 3A) CONNECTION TO EXISTING STRUCTURE

Approved:
R. H. Henson, P.E.
Bridge Engineer
Date: Sept 20, 1971

Designer: H. Henson
Detailer: D. Blacker
Structure Numbers: N-28-C
DWG. No. B 3 OF 3

FEDERAL ROAD DISTRICT NO.	DIVISION	PROJ. NO.	SHEET NO.	TOTAL SHEETS
5	COLORADO	RS 0089(5)	10	

PLAN

DATE: _____ BY: _____

NOTED: _____

NOTE BOOK: _____

NO. 31

NO. 32

PROFILE


DATE: _____ BY: _____

NOTED: _____

NOTE BOOK: _____

NO. 31


NO. 32

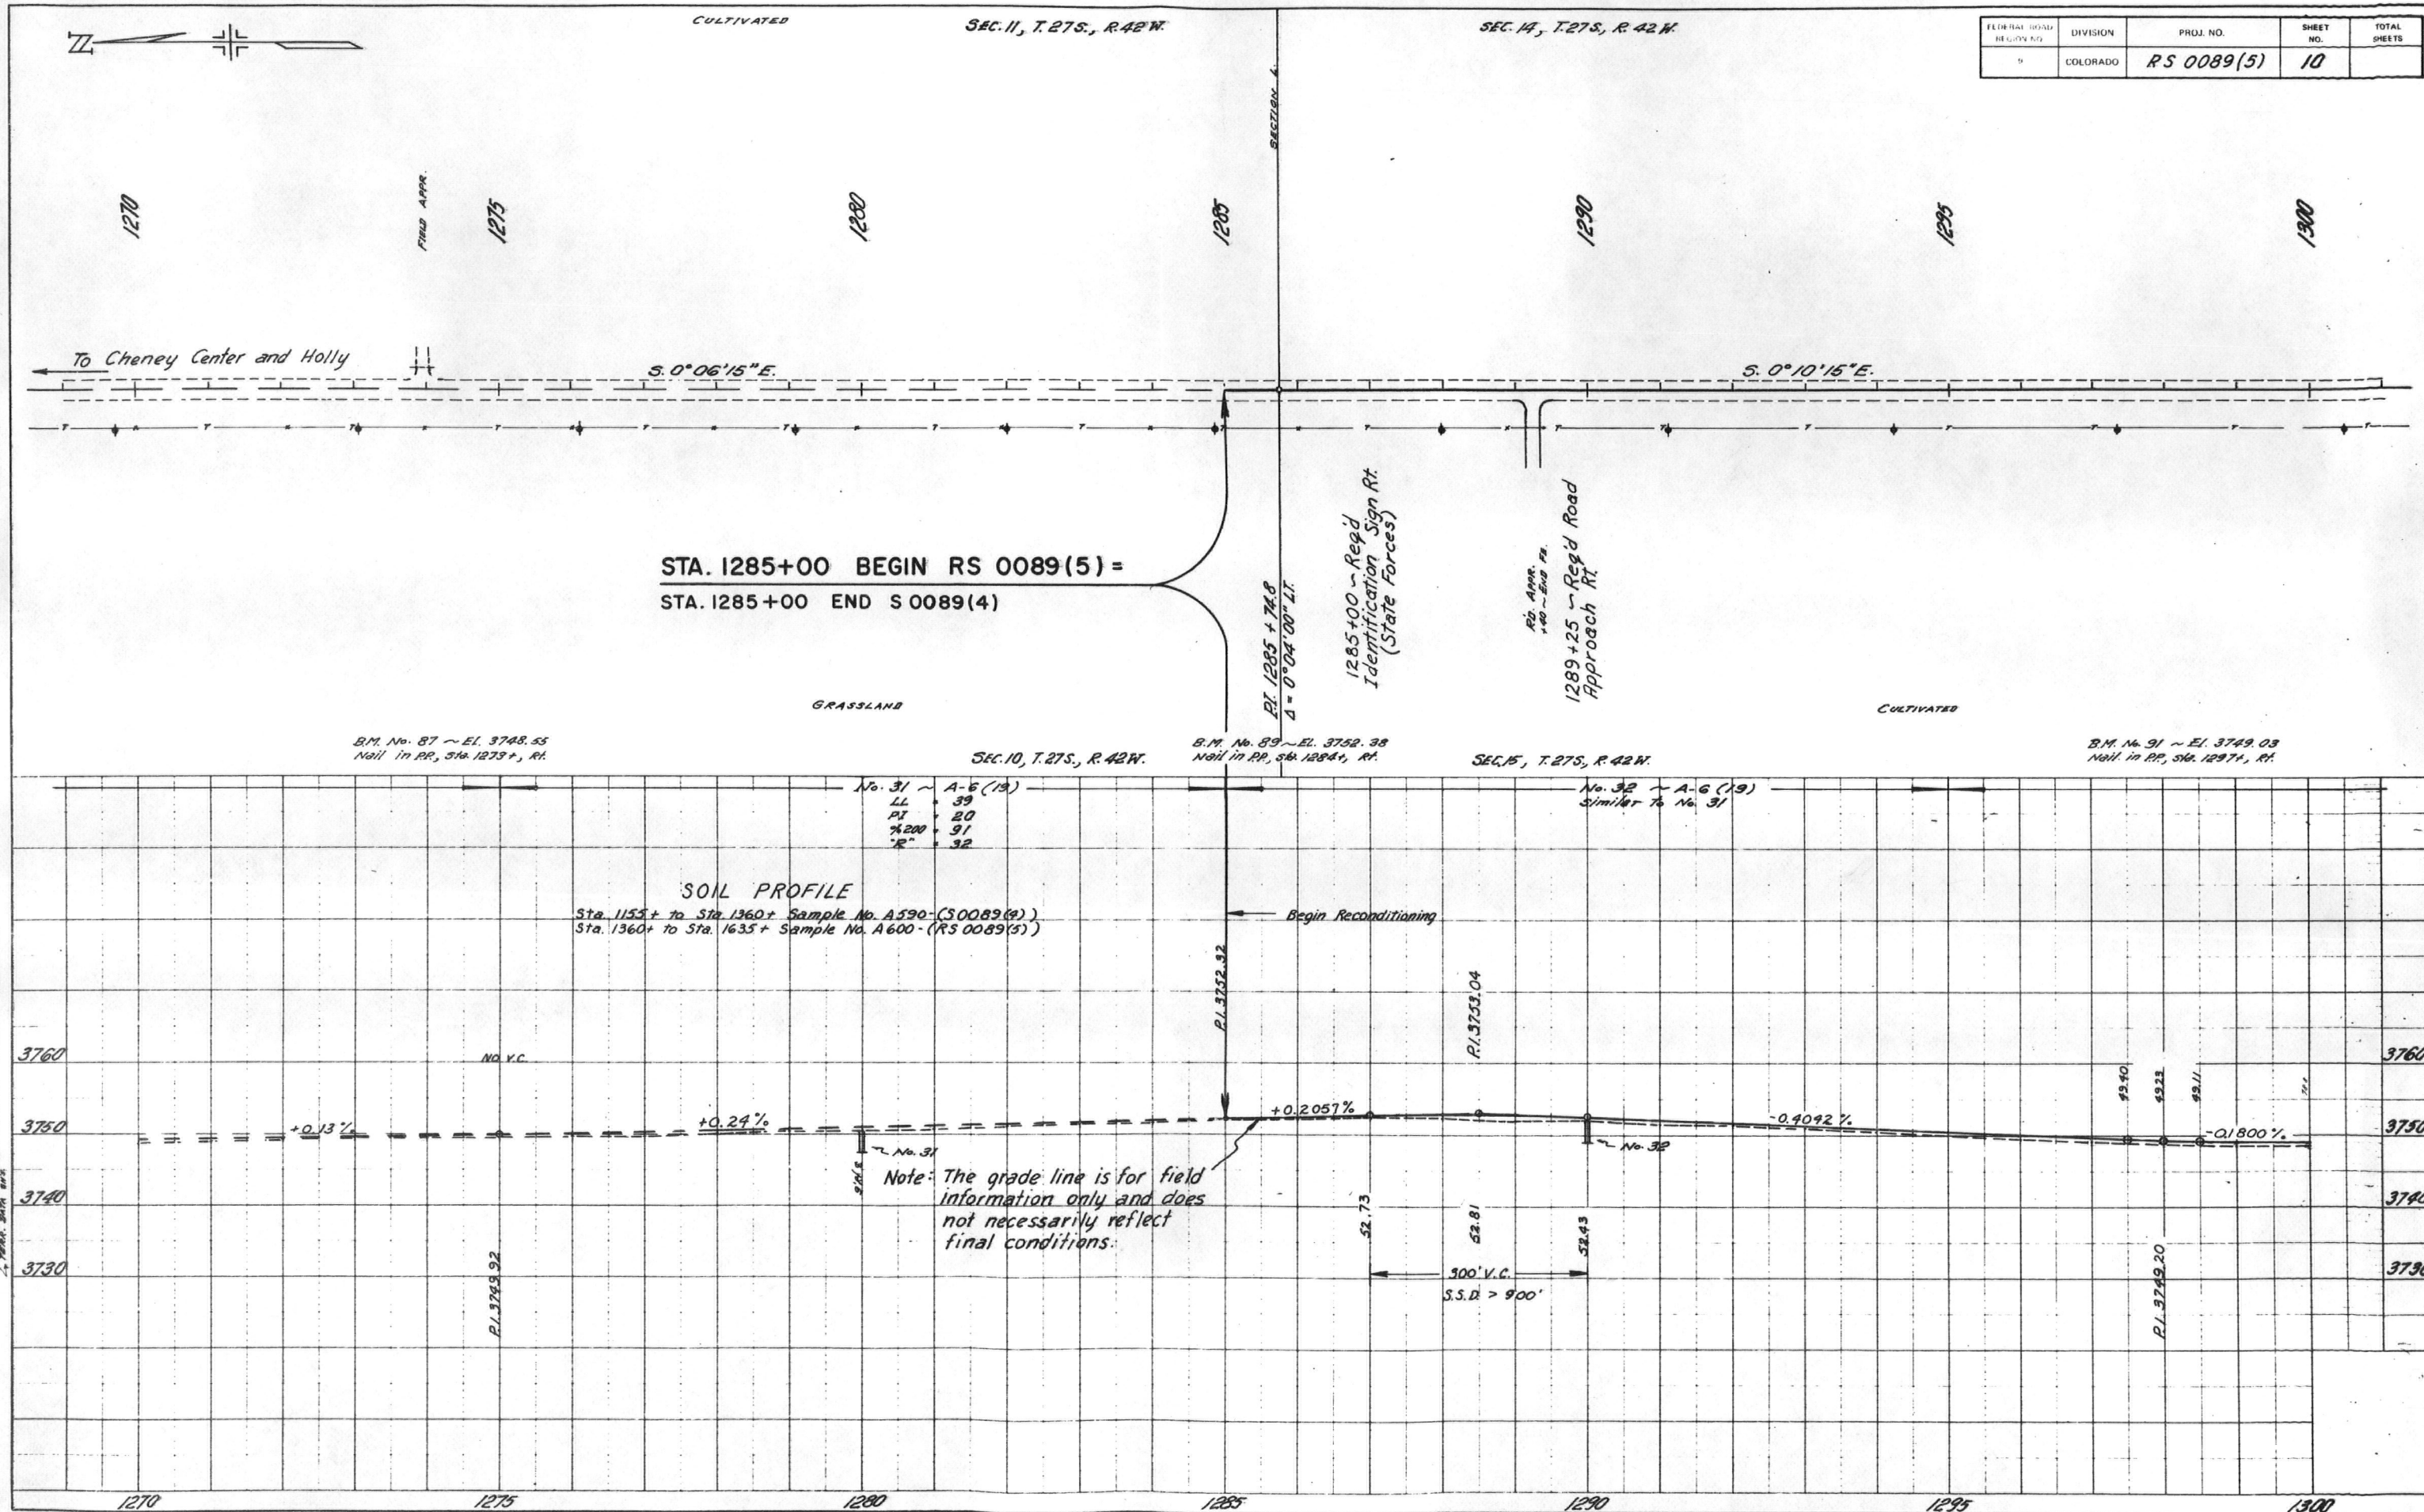

FEDERAL ROAD REGION NO.	DIVISION	PROJ. NO.	SHEET NO.	TOTAL SHEETS
9	COLORADO	RS 0089(5)	11	

PLAN	BY	DATE
SURVIVED		
PLOTTED		
ALIGNMENT CHECKED		
RT. OF WAY CHECKED		


PROFILE	SURVEYED.....	BY.....	DATE.....
	PLOTTED.....		
	GRADES CHECKED.....		
	B. M.'s NOTED.....		
NOTE BOOK			

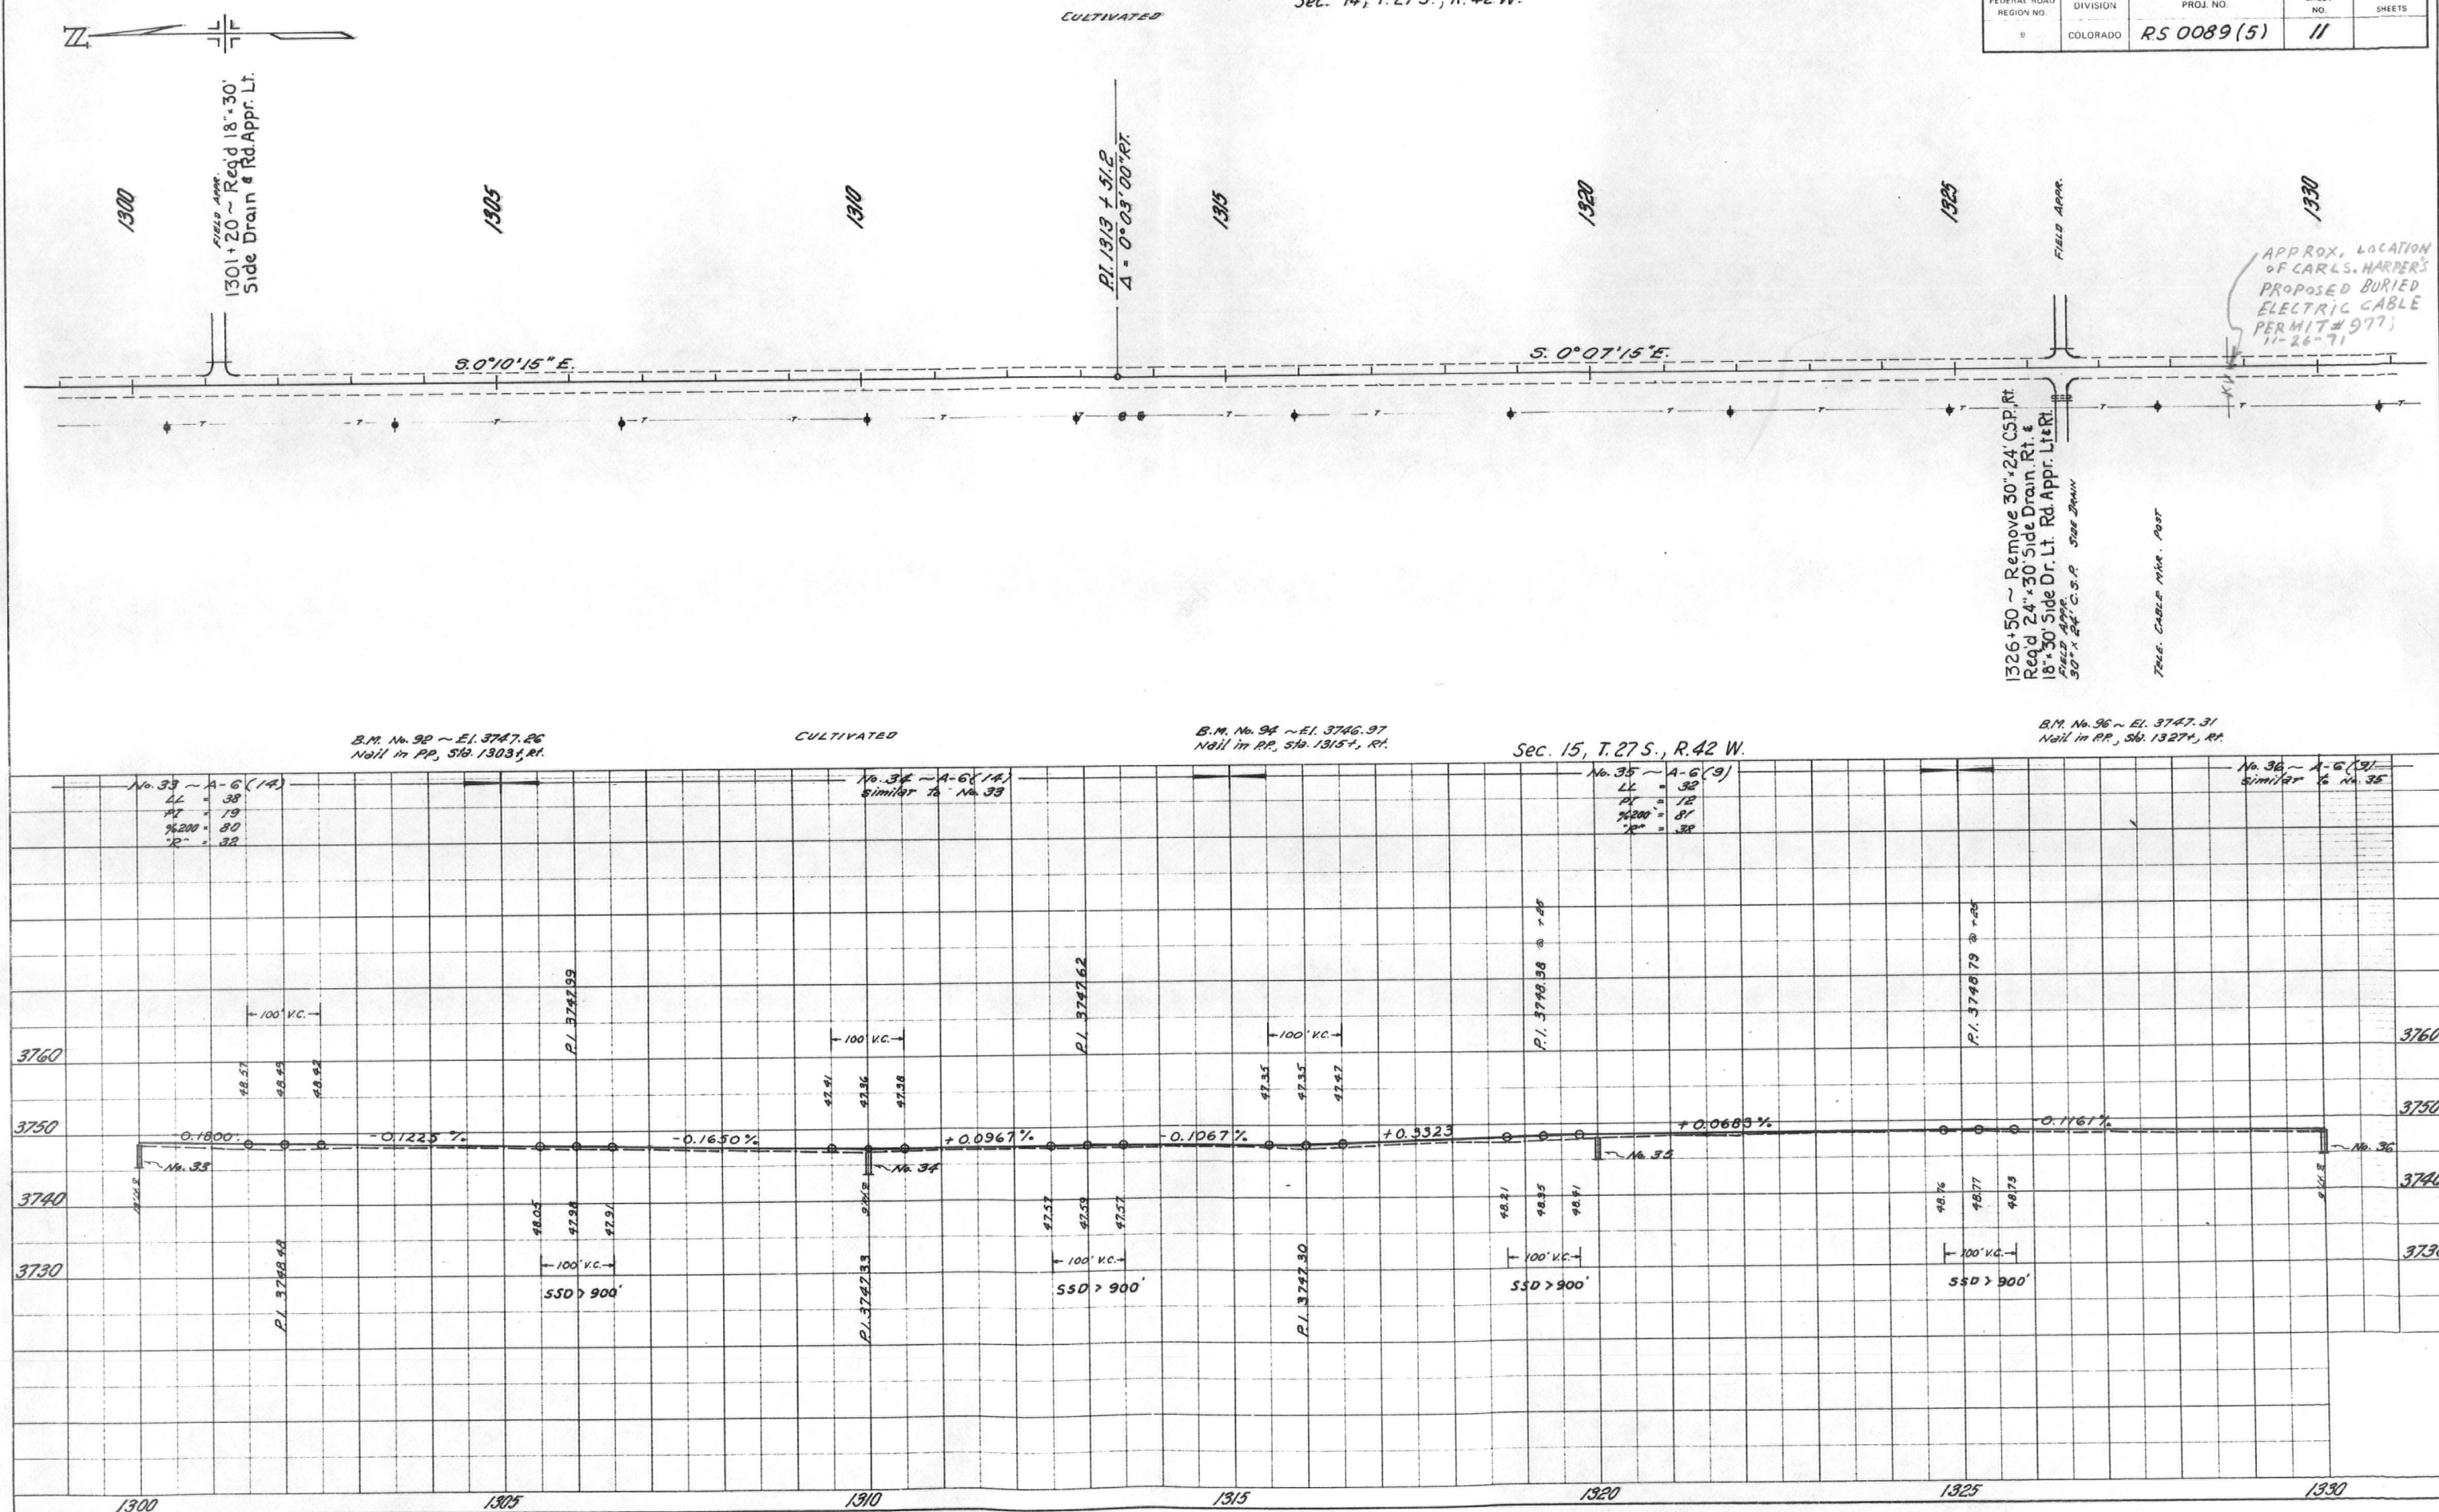

DATE	BY	CH
8-2-58	W. S. D.	W. S. D.
PLAN		
NOTE BOOK		
NO. 3458		
37578		

DATE	BY	CH
PROFILE		
NOTE BOOK		
NO. 3458		
37578		

FEDERAL ROAD REGION NO.	DIVISION	PROJ. NO.	SHEET NO.	TOTAL SHEETS
9	COLORADO	RS 0089 (5)	12	

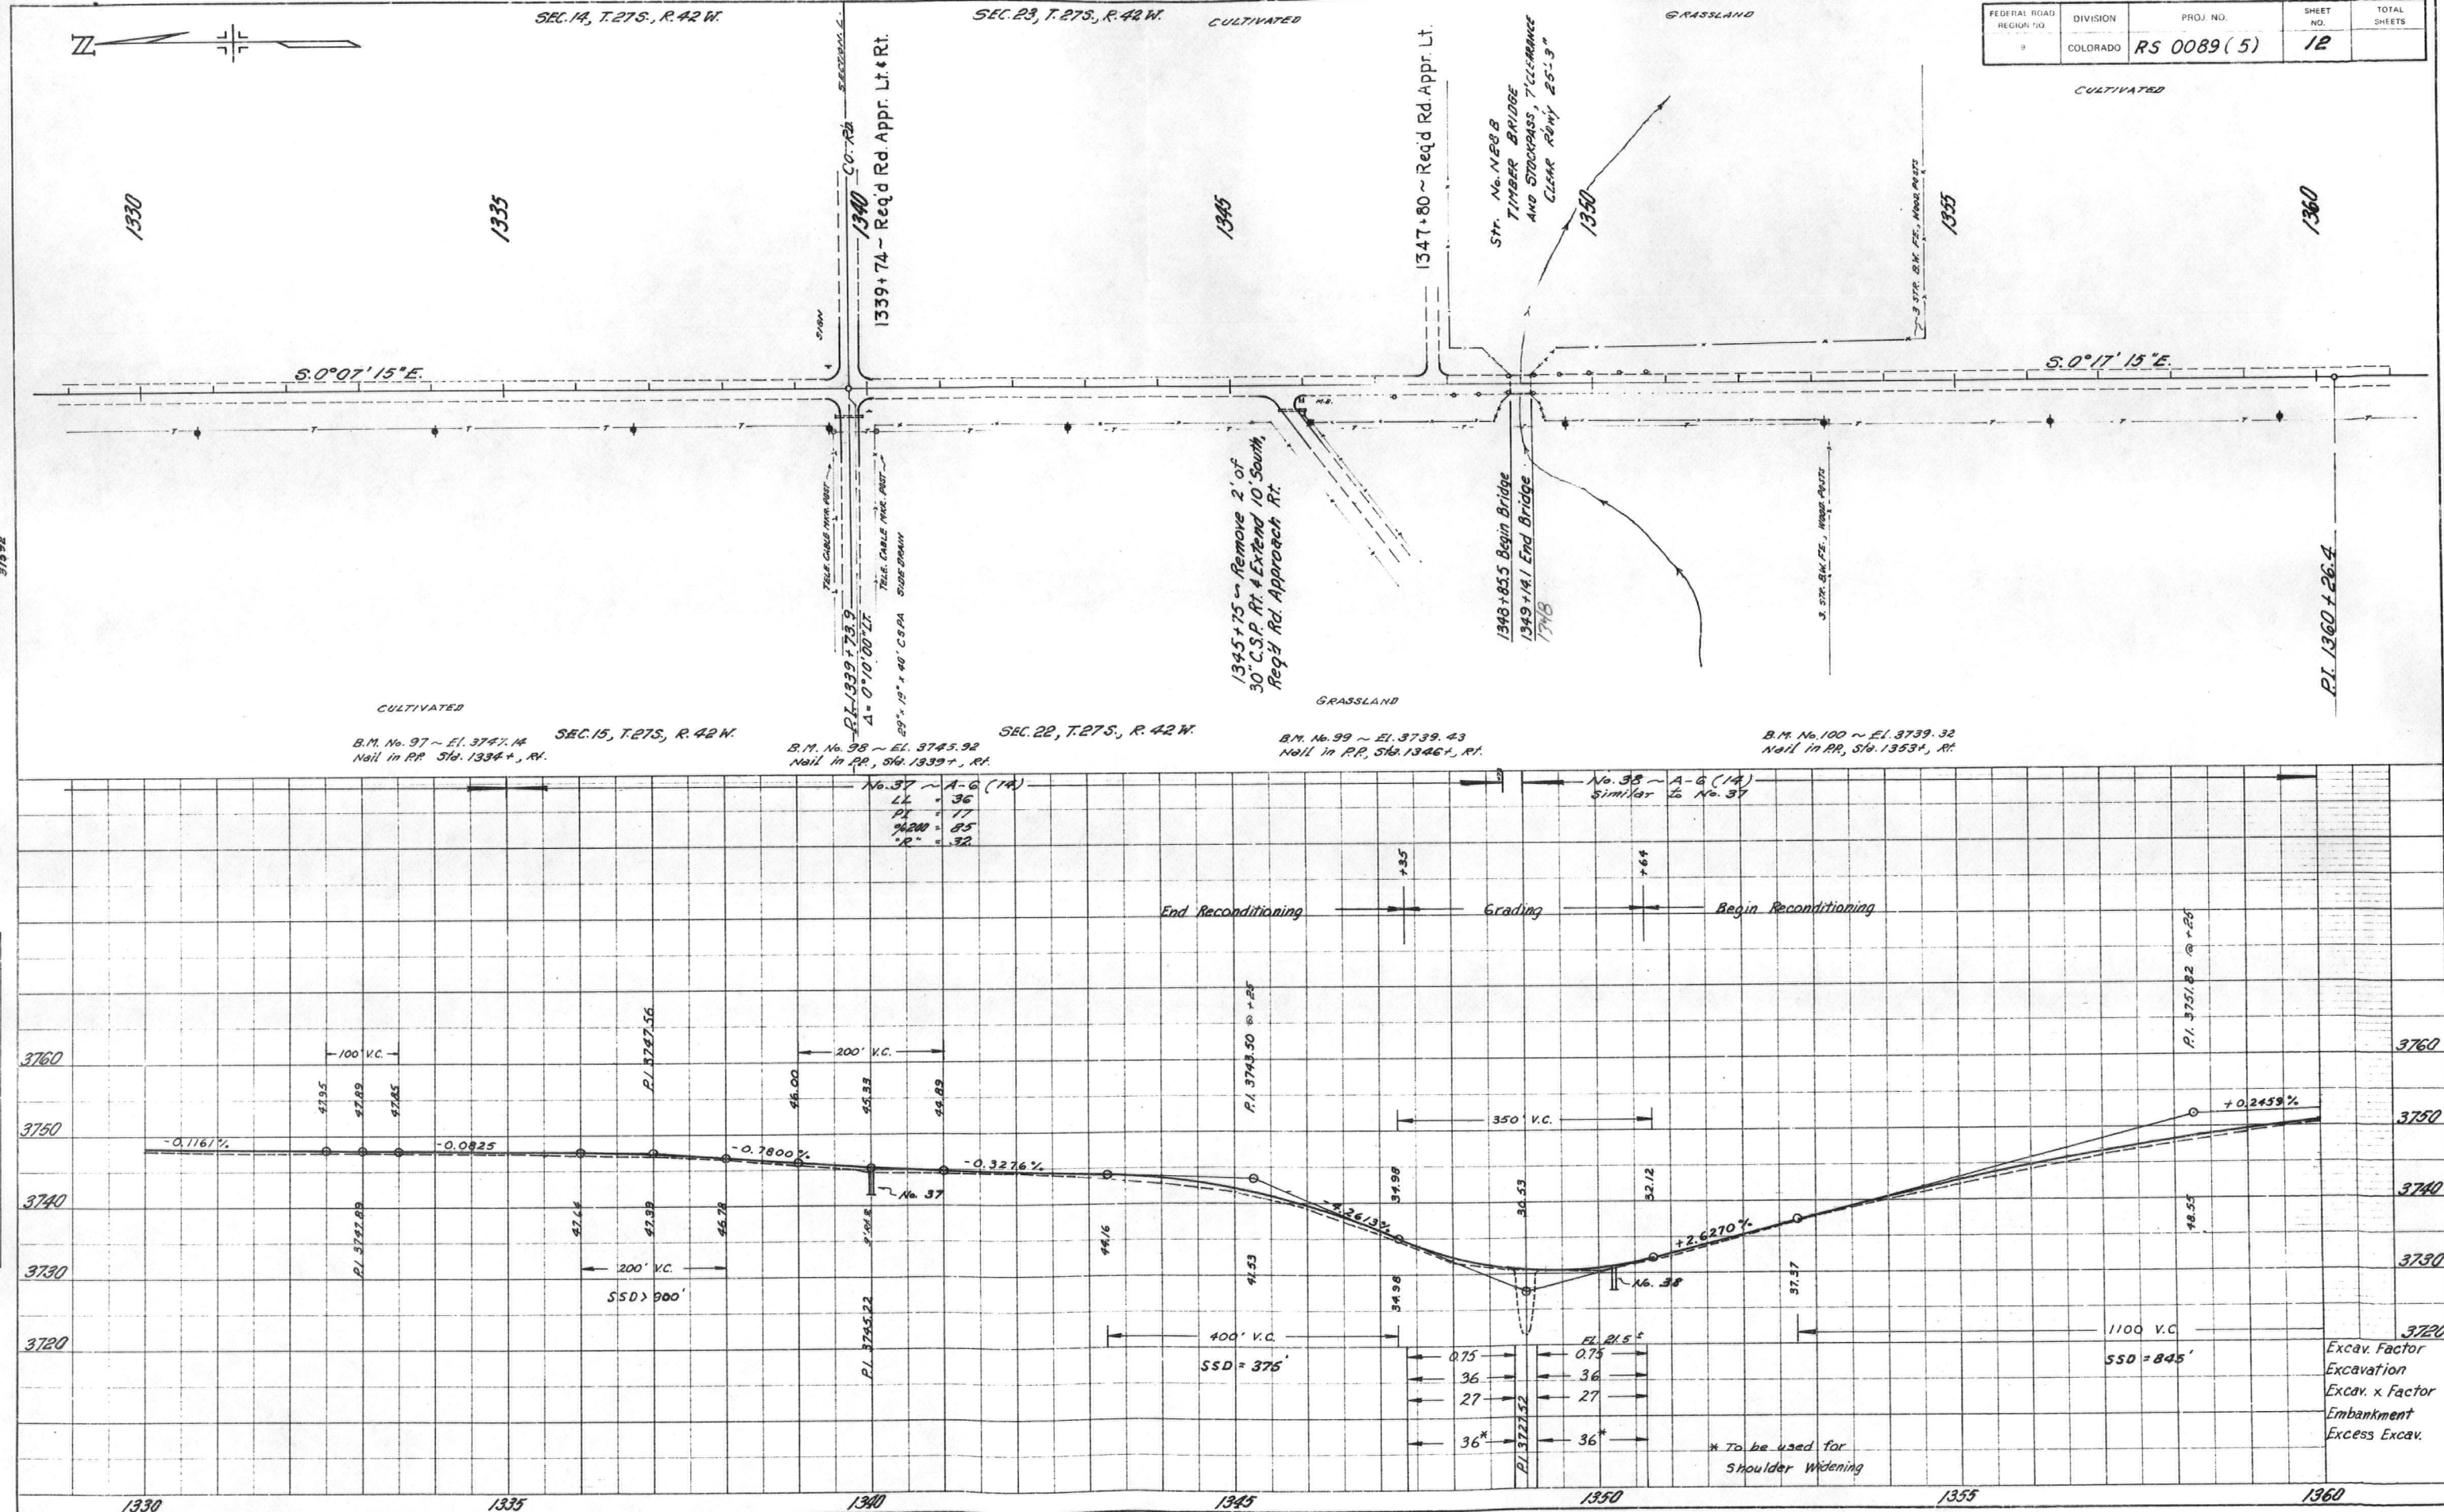


Excav. Factor
Excavation
Excav. x Factor
Embankment
Excess Excav.

Sec. 23, T.27 S., R. 42 W.

FEDERAL ROAD REGION NO.	DIVISION	PROJ. NO.	SHEET NO.	TOTAL SHEETS
9	COLORADO	RS 0089 (5)	13	

DATE	BY
PLAN	
NOTE BOOK	
ALIGNED CHECKED	
BY	
DATE	
No. 31592	

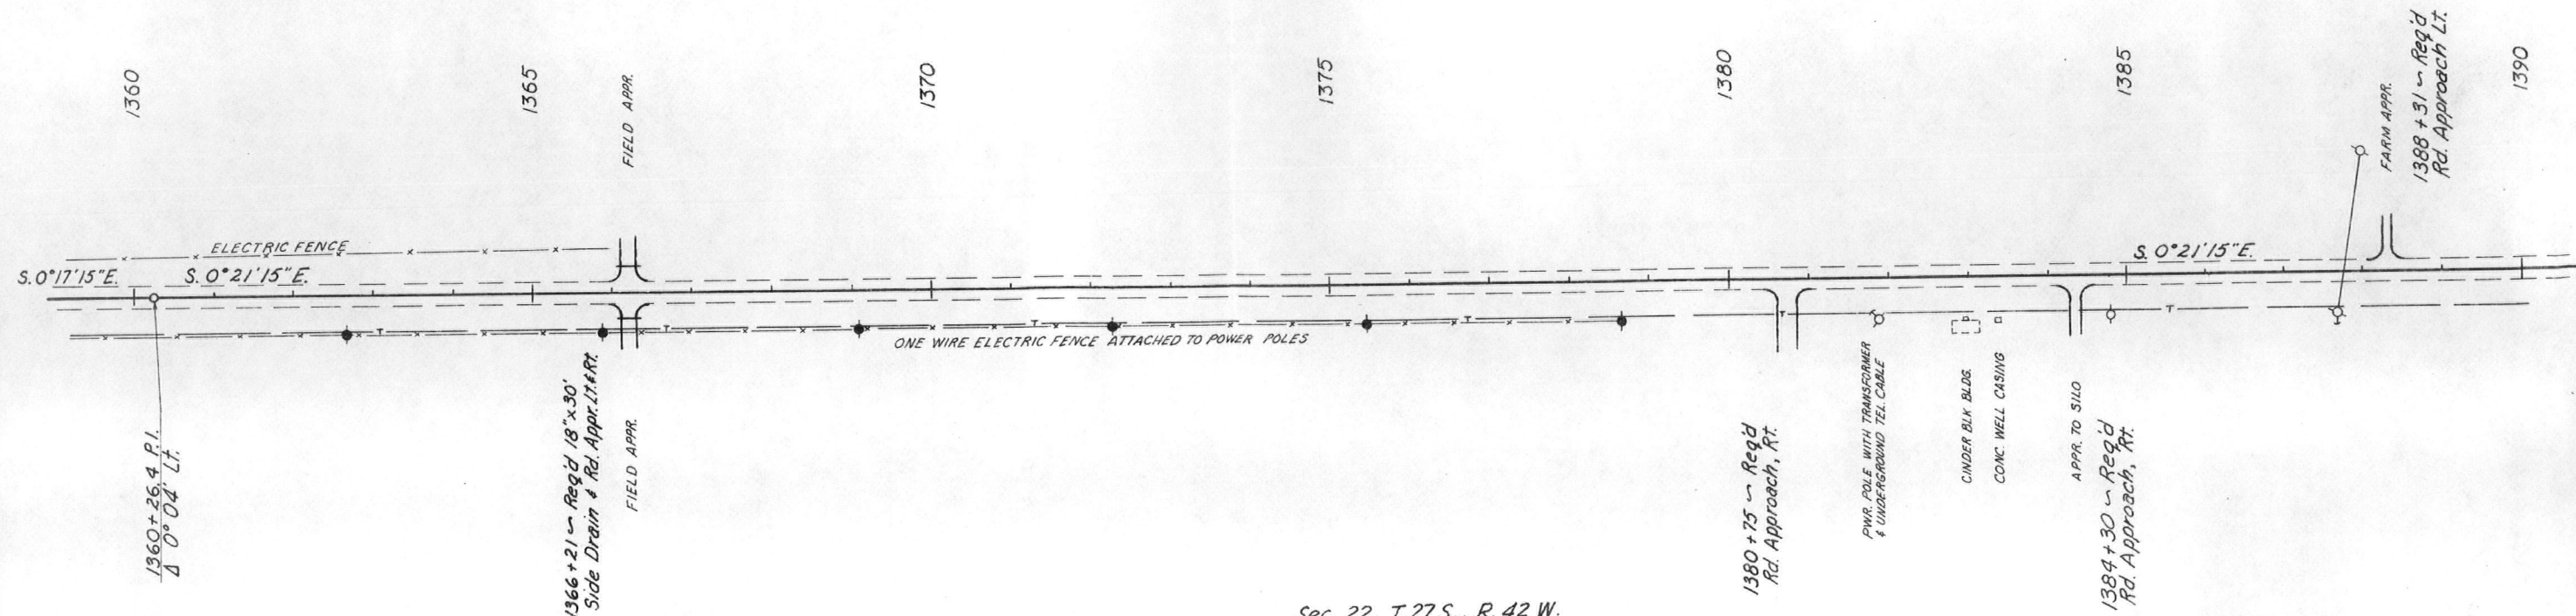

Sec. 22, T.27 S., R. 42 W.

B.M. No. 101 ~ El. 3749.11
Nail in R.P., Sta. 1360+, Rt.


B.M. No. 102 ~ El. 3752.06
Nail in R.P., Sta. 1366+, Rt.

B.M. No. 103 ~ El. 3753.63
Nail in R.P., Sta. 1372+, Rt.

B.M. No. 104 ~ El. 3755.72
Nail in R.P., Sta. 1378+, Rt.

B.M. No. 105 ~ El. 3758.06
Nail in R.P., Sta. 1384+, Rt.

DATE	BY
PROFILE	
NOTE BOOK	
ALIGNED CHECKED	
BY	
DATE	
No. 31592	

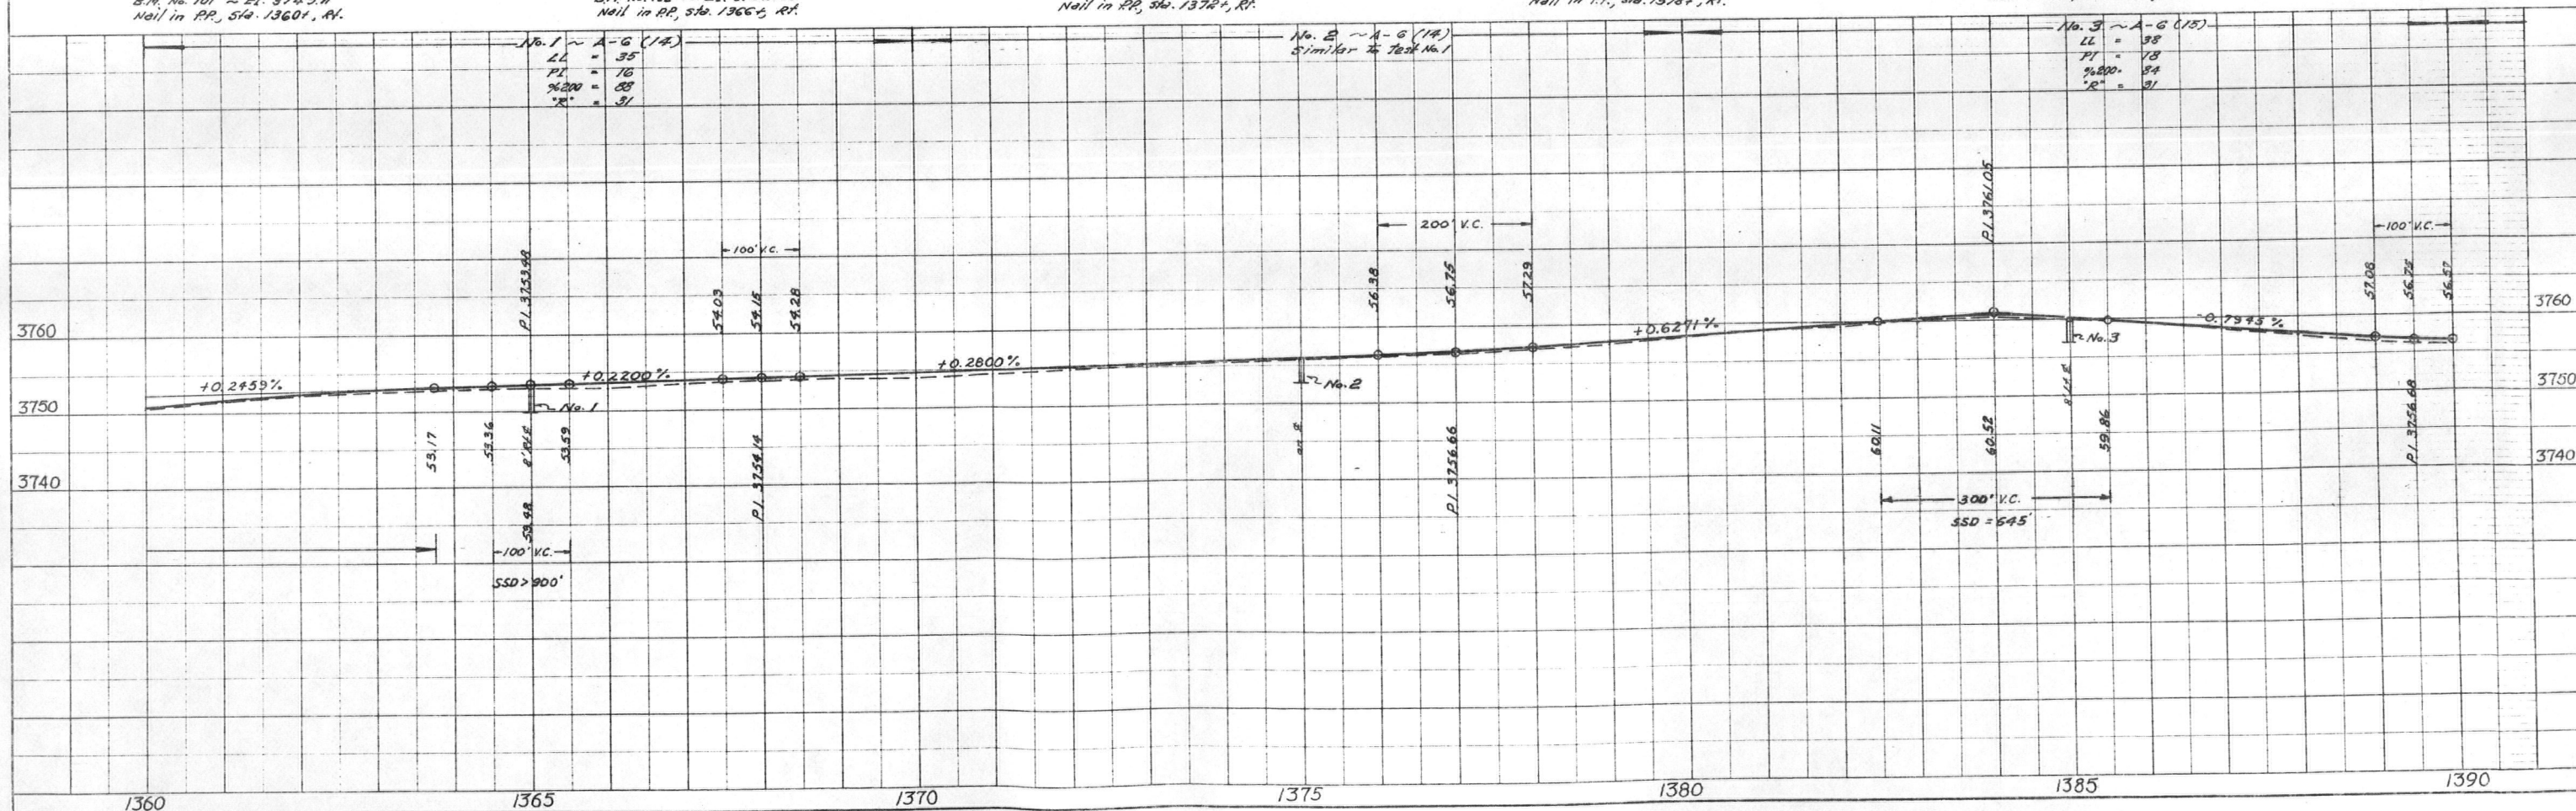


Sec. 26, T. 27 S., R. 42 W.

FEDERAL ROAD REGION NO.	DIVISION	PROJ. NO.	SHEET NO.	TOTAL SHEETS
9	COLORADO	RS 0089 (5)	14	

Sec. 23, T. 27 S., R. 42 W.

PLAN	DATE
NOTE BOOK	BY
No. 21292	

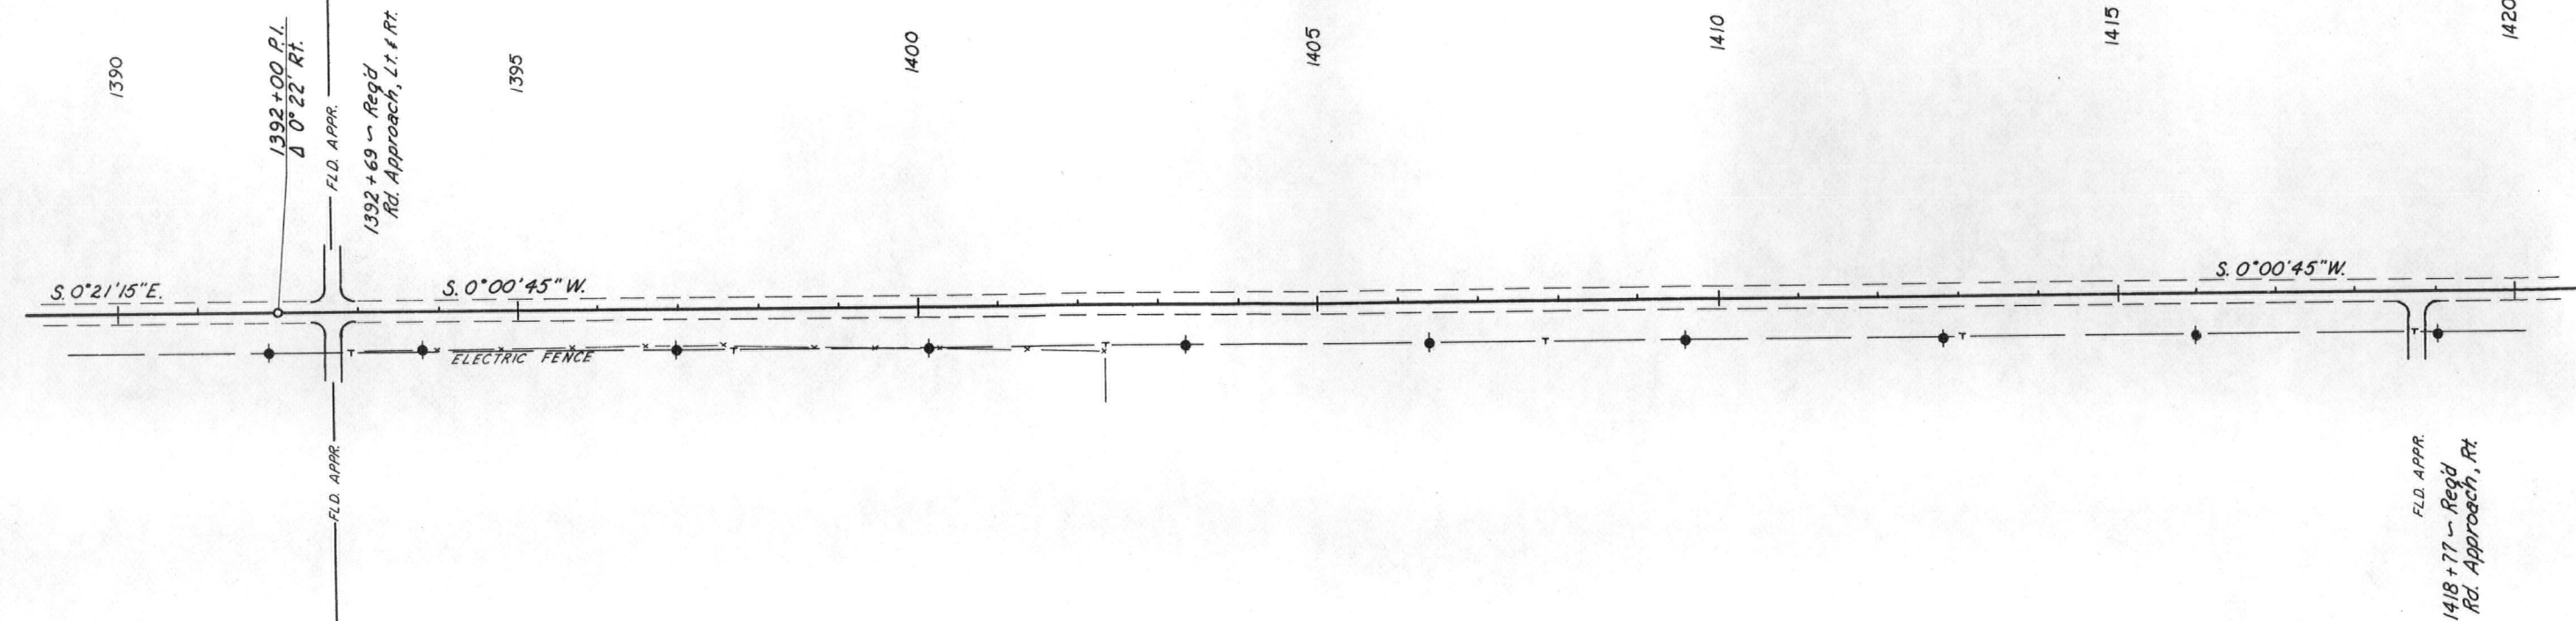

Sec. 22, T. 27 S., R. 42 W.

B.M. No. 106 ~ El. 3754.44
Nail in RR, Sta. 1390+, Rt.

B.M. No. 107 ~ El. 3753.83
Nail in RR, Sta. 1396+, Rt.


Sec. 27, T. 27 S., R. 42 W.

B.M. No. 108 ~ El. 3753.83
Nail in RR, Sta. 1402+, Rt.

B.M. No. 109 ~ El. 3754.26
Nail in RR, Sta. 1403+, Rt.

B.M. No. 110 ~ El. 3754.83
Nail in RR, Sta. 1415+, Rt.


PROFILE	DATE
NOTE BOOK	BY
No. 21292	

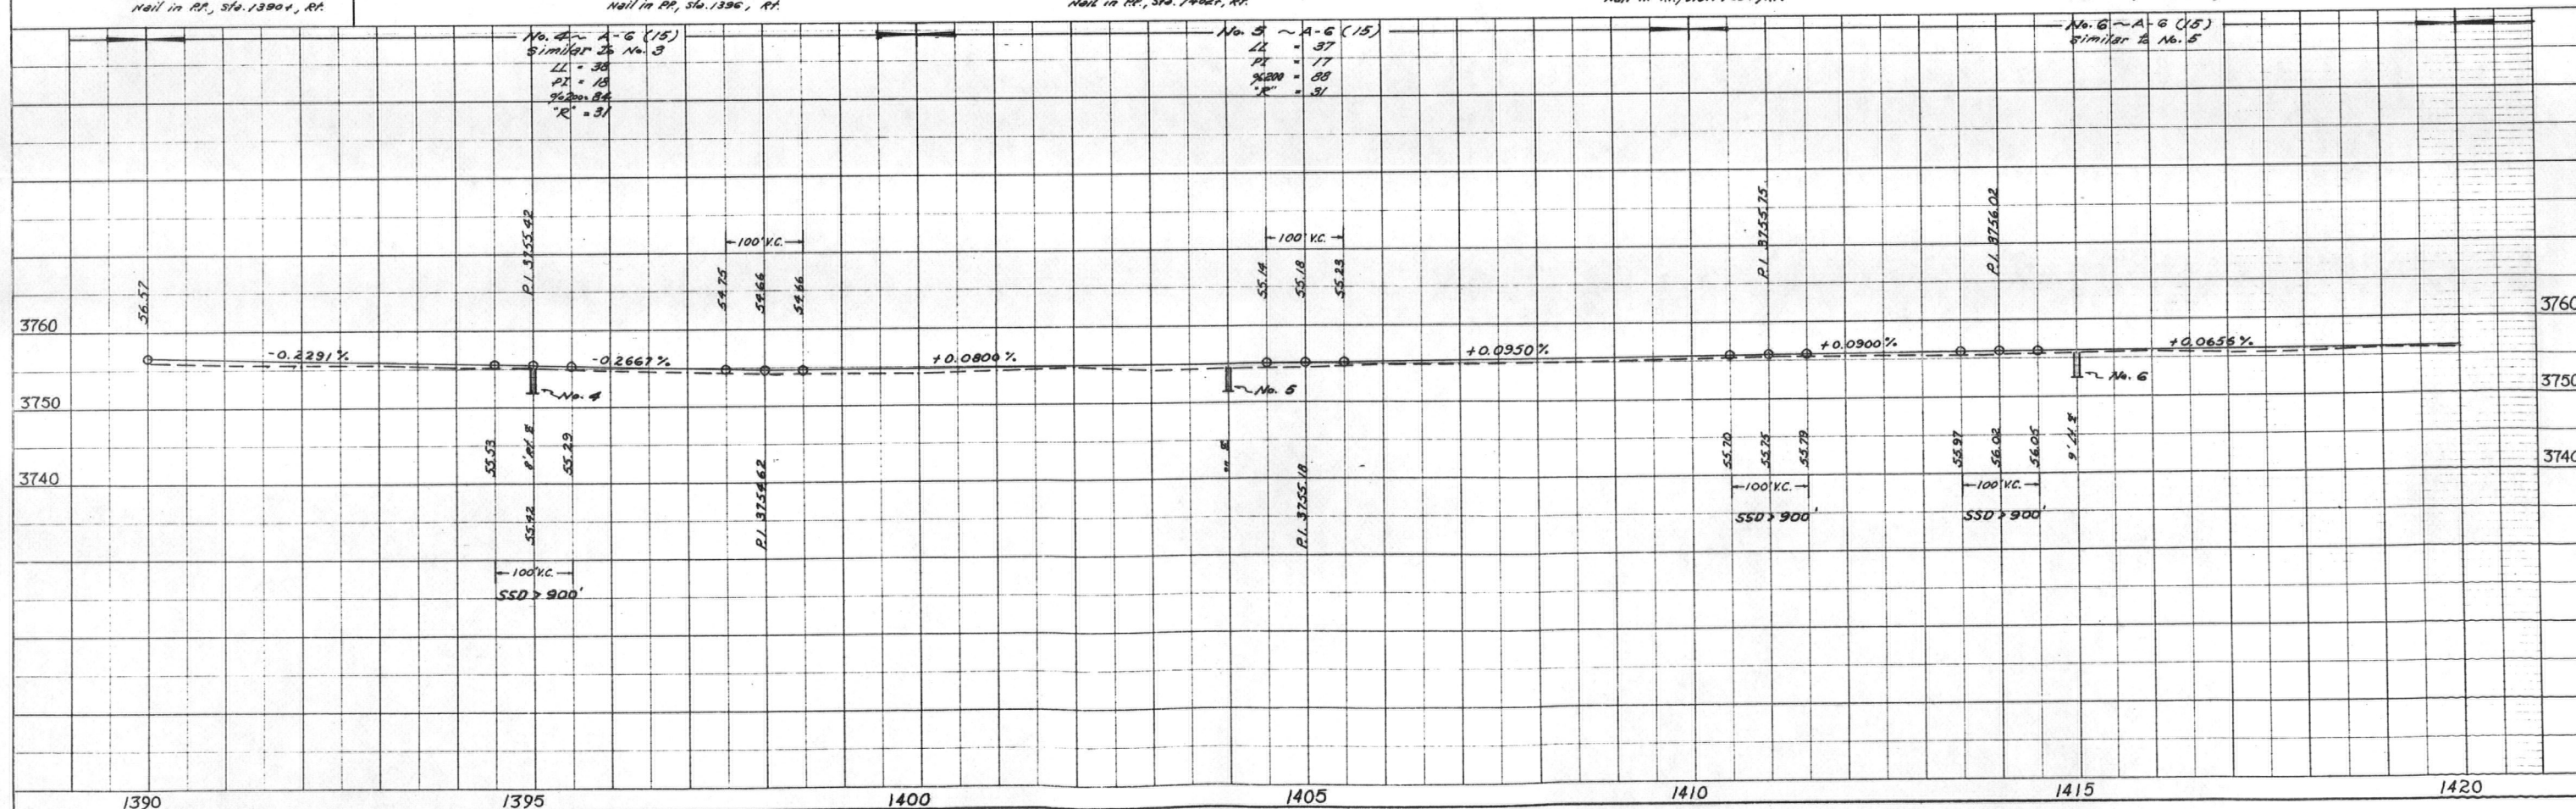

Sec. 26, T. 27 S., R. 42 W.

FEDERAL ROAD REGION NO.	DIVISION	PROJ. NO.	SHEET NO.	TOTAL SHEETS
8	COLORADO	RS 0089(5)	15	

Sec. 35, T. 27 S., R. 42 W.

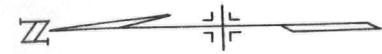

1420

1425

1430

1435

1440

1445

1450

S. 0°00'45" W.

P.I. 1437+00
Δ 0°08' L.

ELECTRIC FENCE

UNDERGROUND CABLE CROSSES HWY.
PWR. LINE CROSSES HWY. (CL 24')

1445+15 ~ Reg'd 18" x 30"
Side Drain, Road
Approach, Lt.

S. 0°07'15" E.

1444+48 ~ Remove
24" x 30" C.S.P. Rt. Reg'd
18" x 30" Side Drain & Rd.
Appr. Rt.
F.I.D. APPR.
24" x 30" C.M.P.
14.8 ON 50 GAL. DRAIN

Sec. 27, T. 27 S., R. 42 W.

B.M. No. 111 ~ El. 3754.60
Nail in PP, Sta. 1421+, Rt.

B.M. No. 112 ~ El. 3752.17
Nail in PP, Sta. 1428+, Rt.

B.M. No. 113 ~ El. 3748.97
Nail in PP, Sta. 1434+, Rt.

B.M. No. 114 ~ El. 3744.01
Nail in PP, Sta. 1439+, Rt.


B.M. No. 115 ~ El. 3736.12
Nail in PP, Sta. 1446+, Rt.

Sec. 34, T. 27 S., R. 42 W.

No. 7 ~ A-G (15)
LL = 36
PI = 17
SSD = 90
VR = 31

No. 8 ~ A-G (15)
Similar to No. 7

No. 9 ~ A-G (14)
LL = 36
PI = 16
SSD = 87
VR = 31

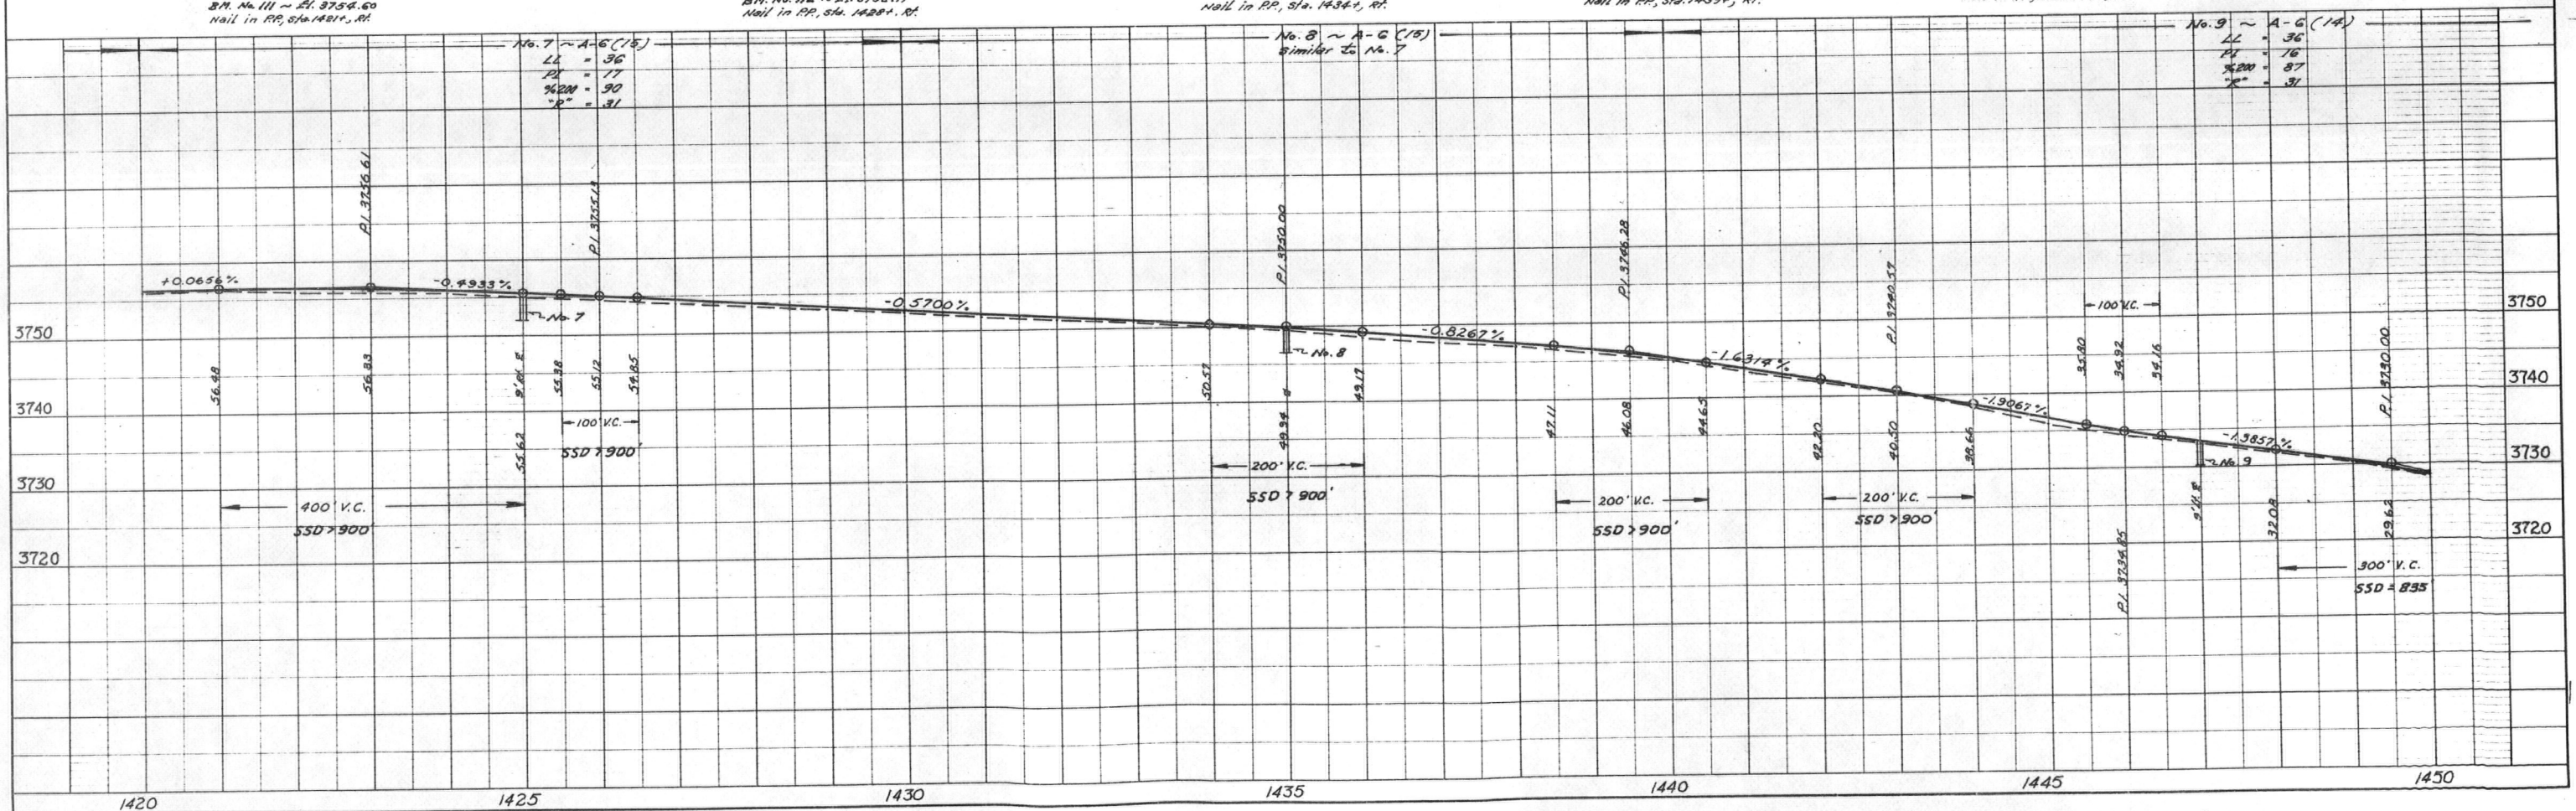


PLAN	DATE
BY	
NOTED	
NOTE BOOK	
ALIGNED	
ET. OF WAY	
NO. 3/592	

PROFILE	DATE
BY	
NOTED	
NOTE BOOK	
GRADES	
ET. OF WAY	
NO. 3/592	

Sec. 35, T. 27 S., R. 42 W.

FEDERAL ROAD REGION NO.	DIVISION	PROJ. NO.	SHEET NO.	TOTAL SHEETS
8	COLORADO	RS 0089(5)	16	

PLAN	DATE
NO. 2792	

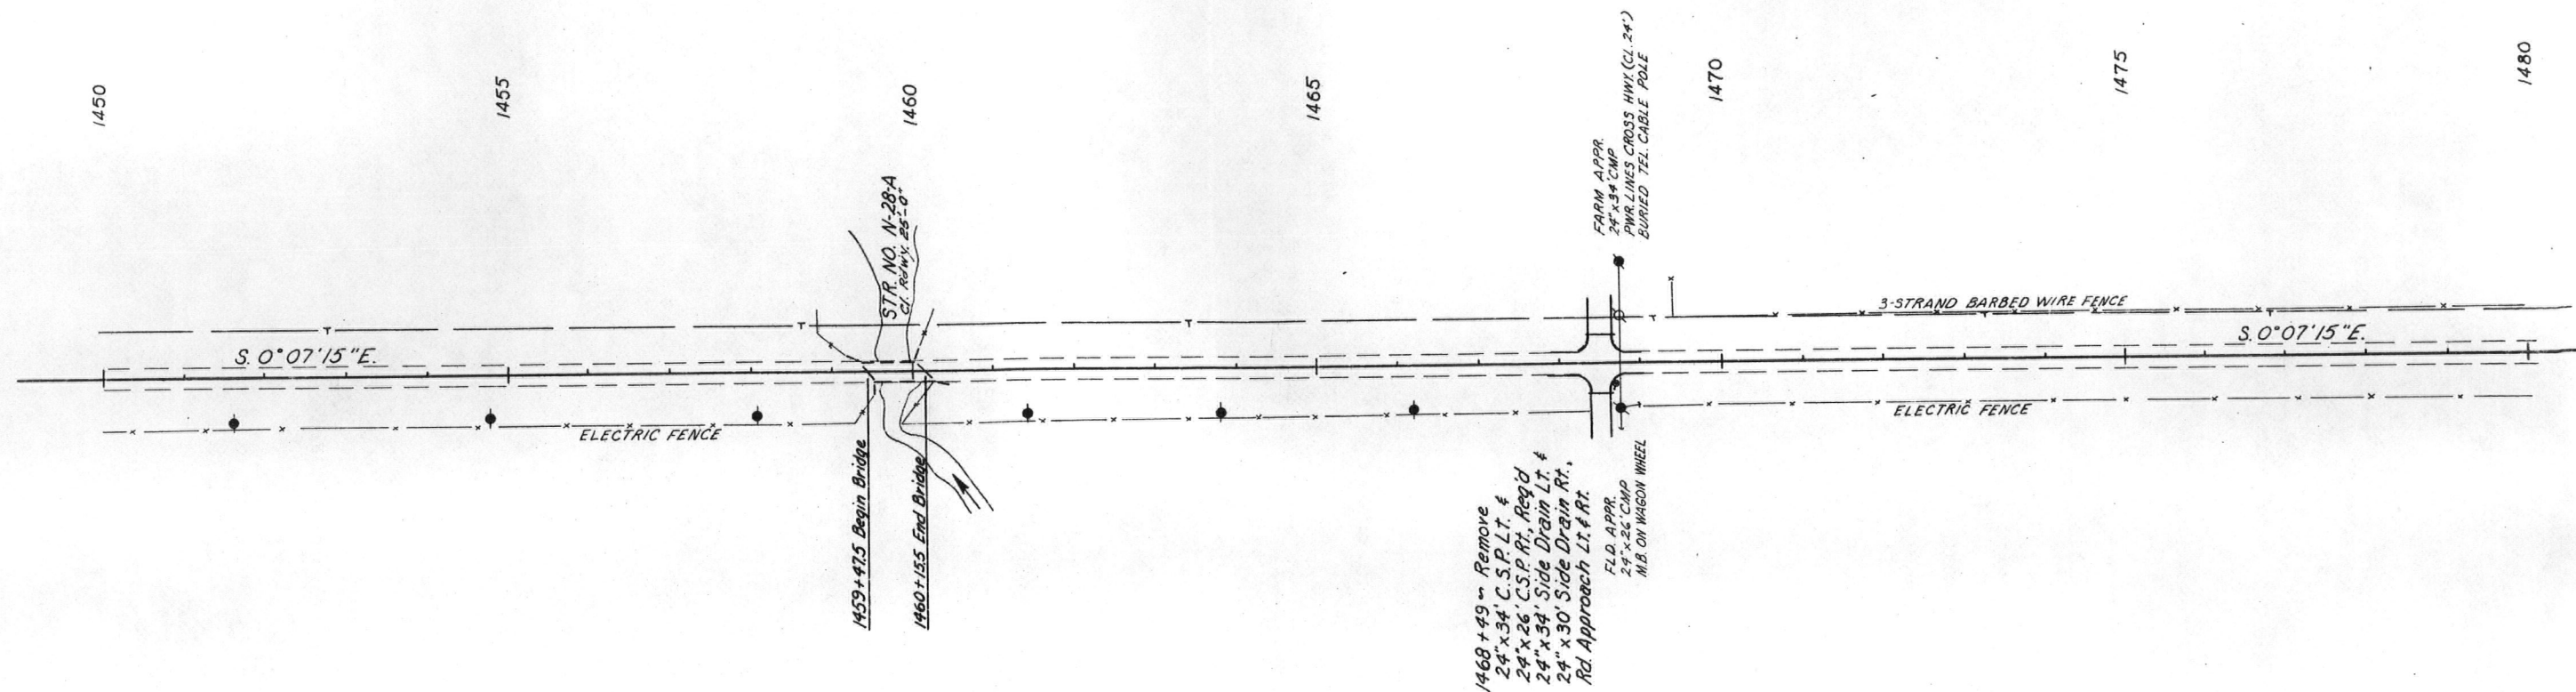

Sec. 34, T. 27 S., R. 42 W.


B.M. No. 116 ~ El. 3713.35
Nail in RR, Sta. 1434+, Rt.

B.M. No. 117 ~ El. 3708.68
Nail in RR, Sta. 1461+, Rt.

B.M. No. 118 ~ El. 3716.15
Nail in RR, Sta. 1468+, Rt.

B.M. No. 119 ~ El. 3721.55
H. & G. in Fence, Sta. 1476+, Lt.

PROFILE	DATE
NO. 2792	

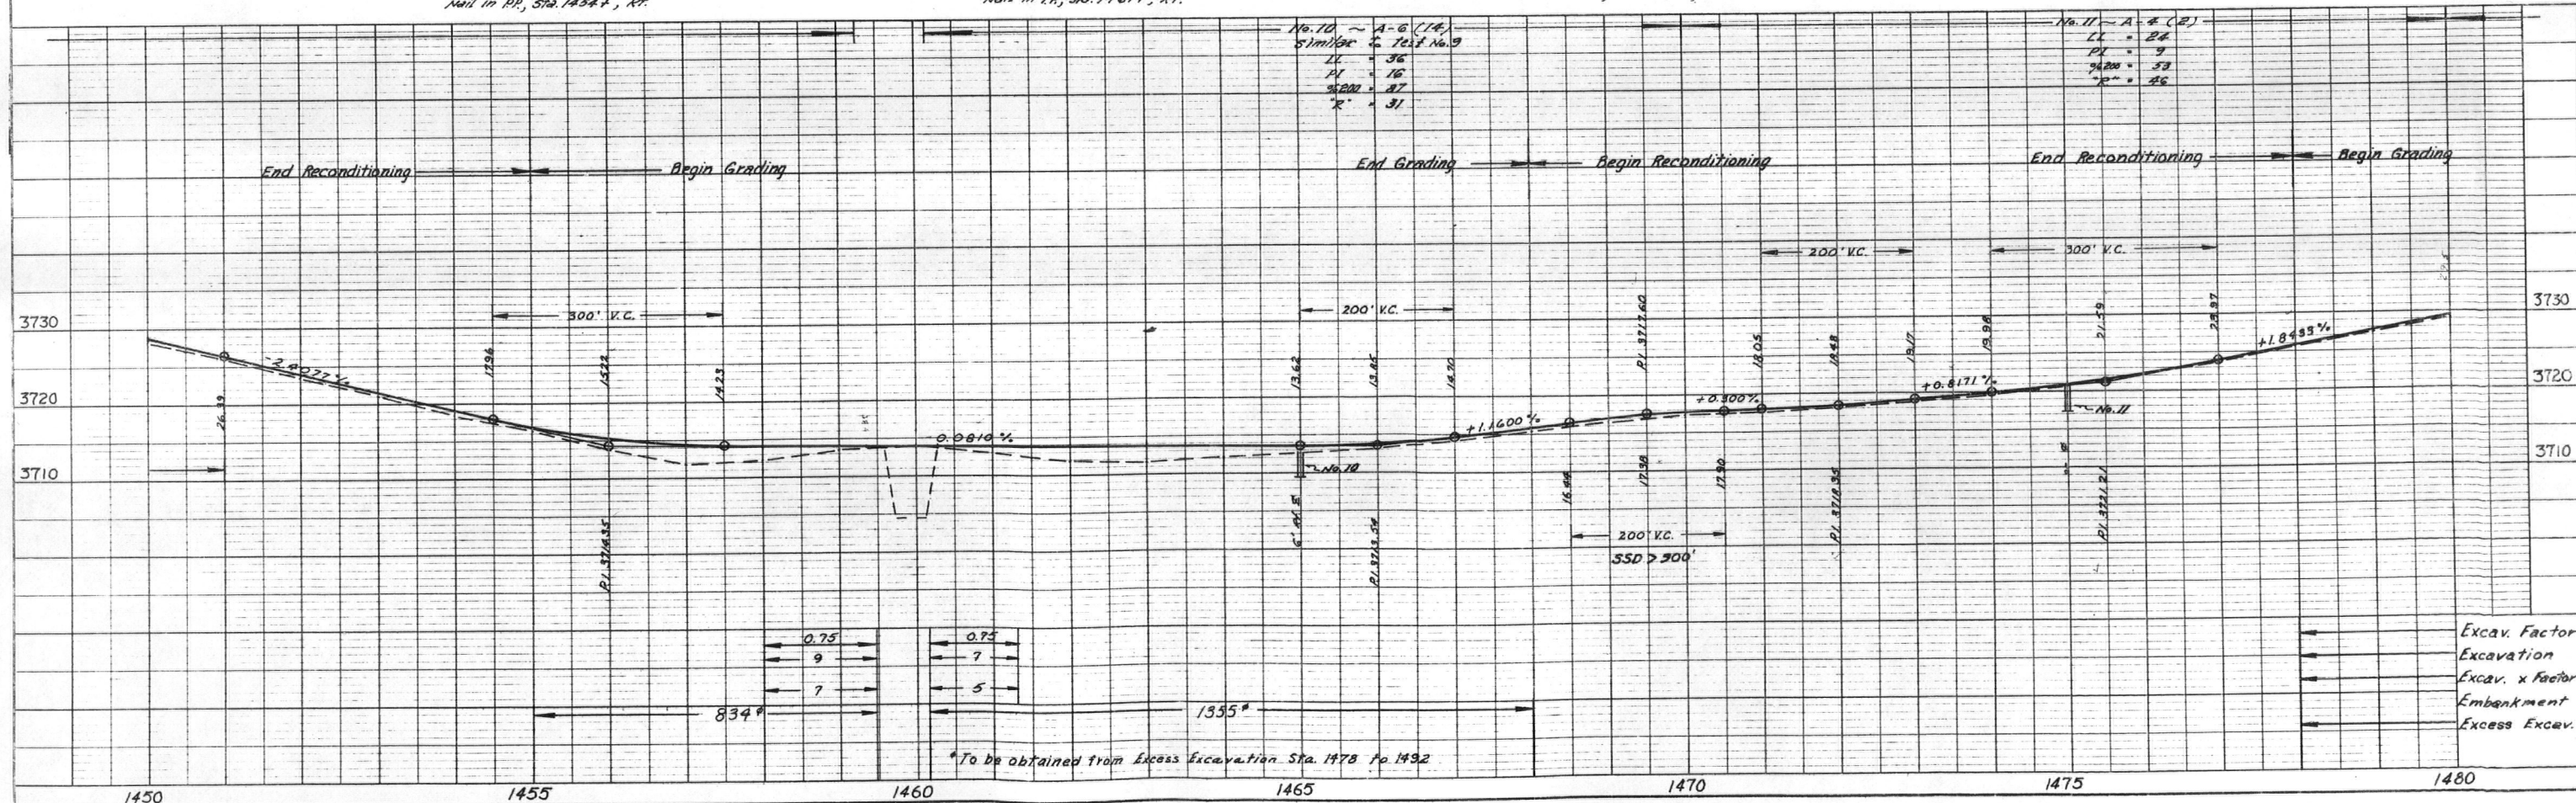

*To be obtained from Excess Excavation Sta. 1478 to 1492


Sec. 35, T. 27 S., R. 42 W.

Sec. 2, T. 28 S., R. 42 W.

FEDERAL ROAD REGION NO.	DIVISION	PROJ. NO.	SHEET NO.	TOTAL SHEETS
1	COLORADO	RS 0089 (5)	17	

PLAN	DATE
NOTE BOOK	BY
No. 2192	



PROFILE	DATE
NOTE BOOK	BY
No. 2192	

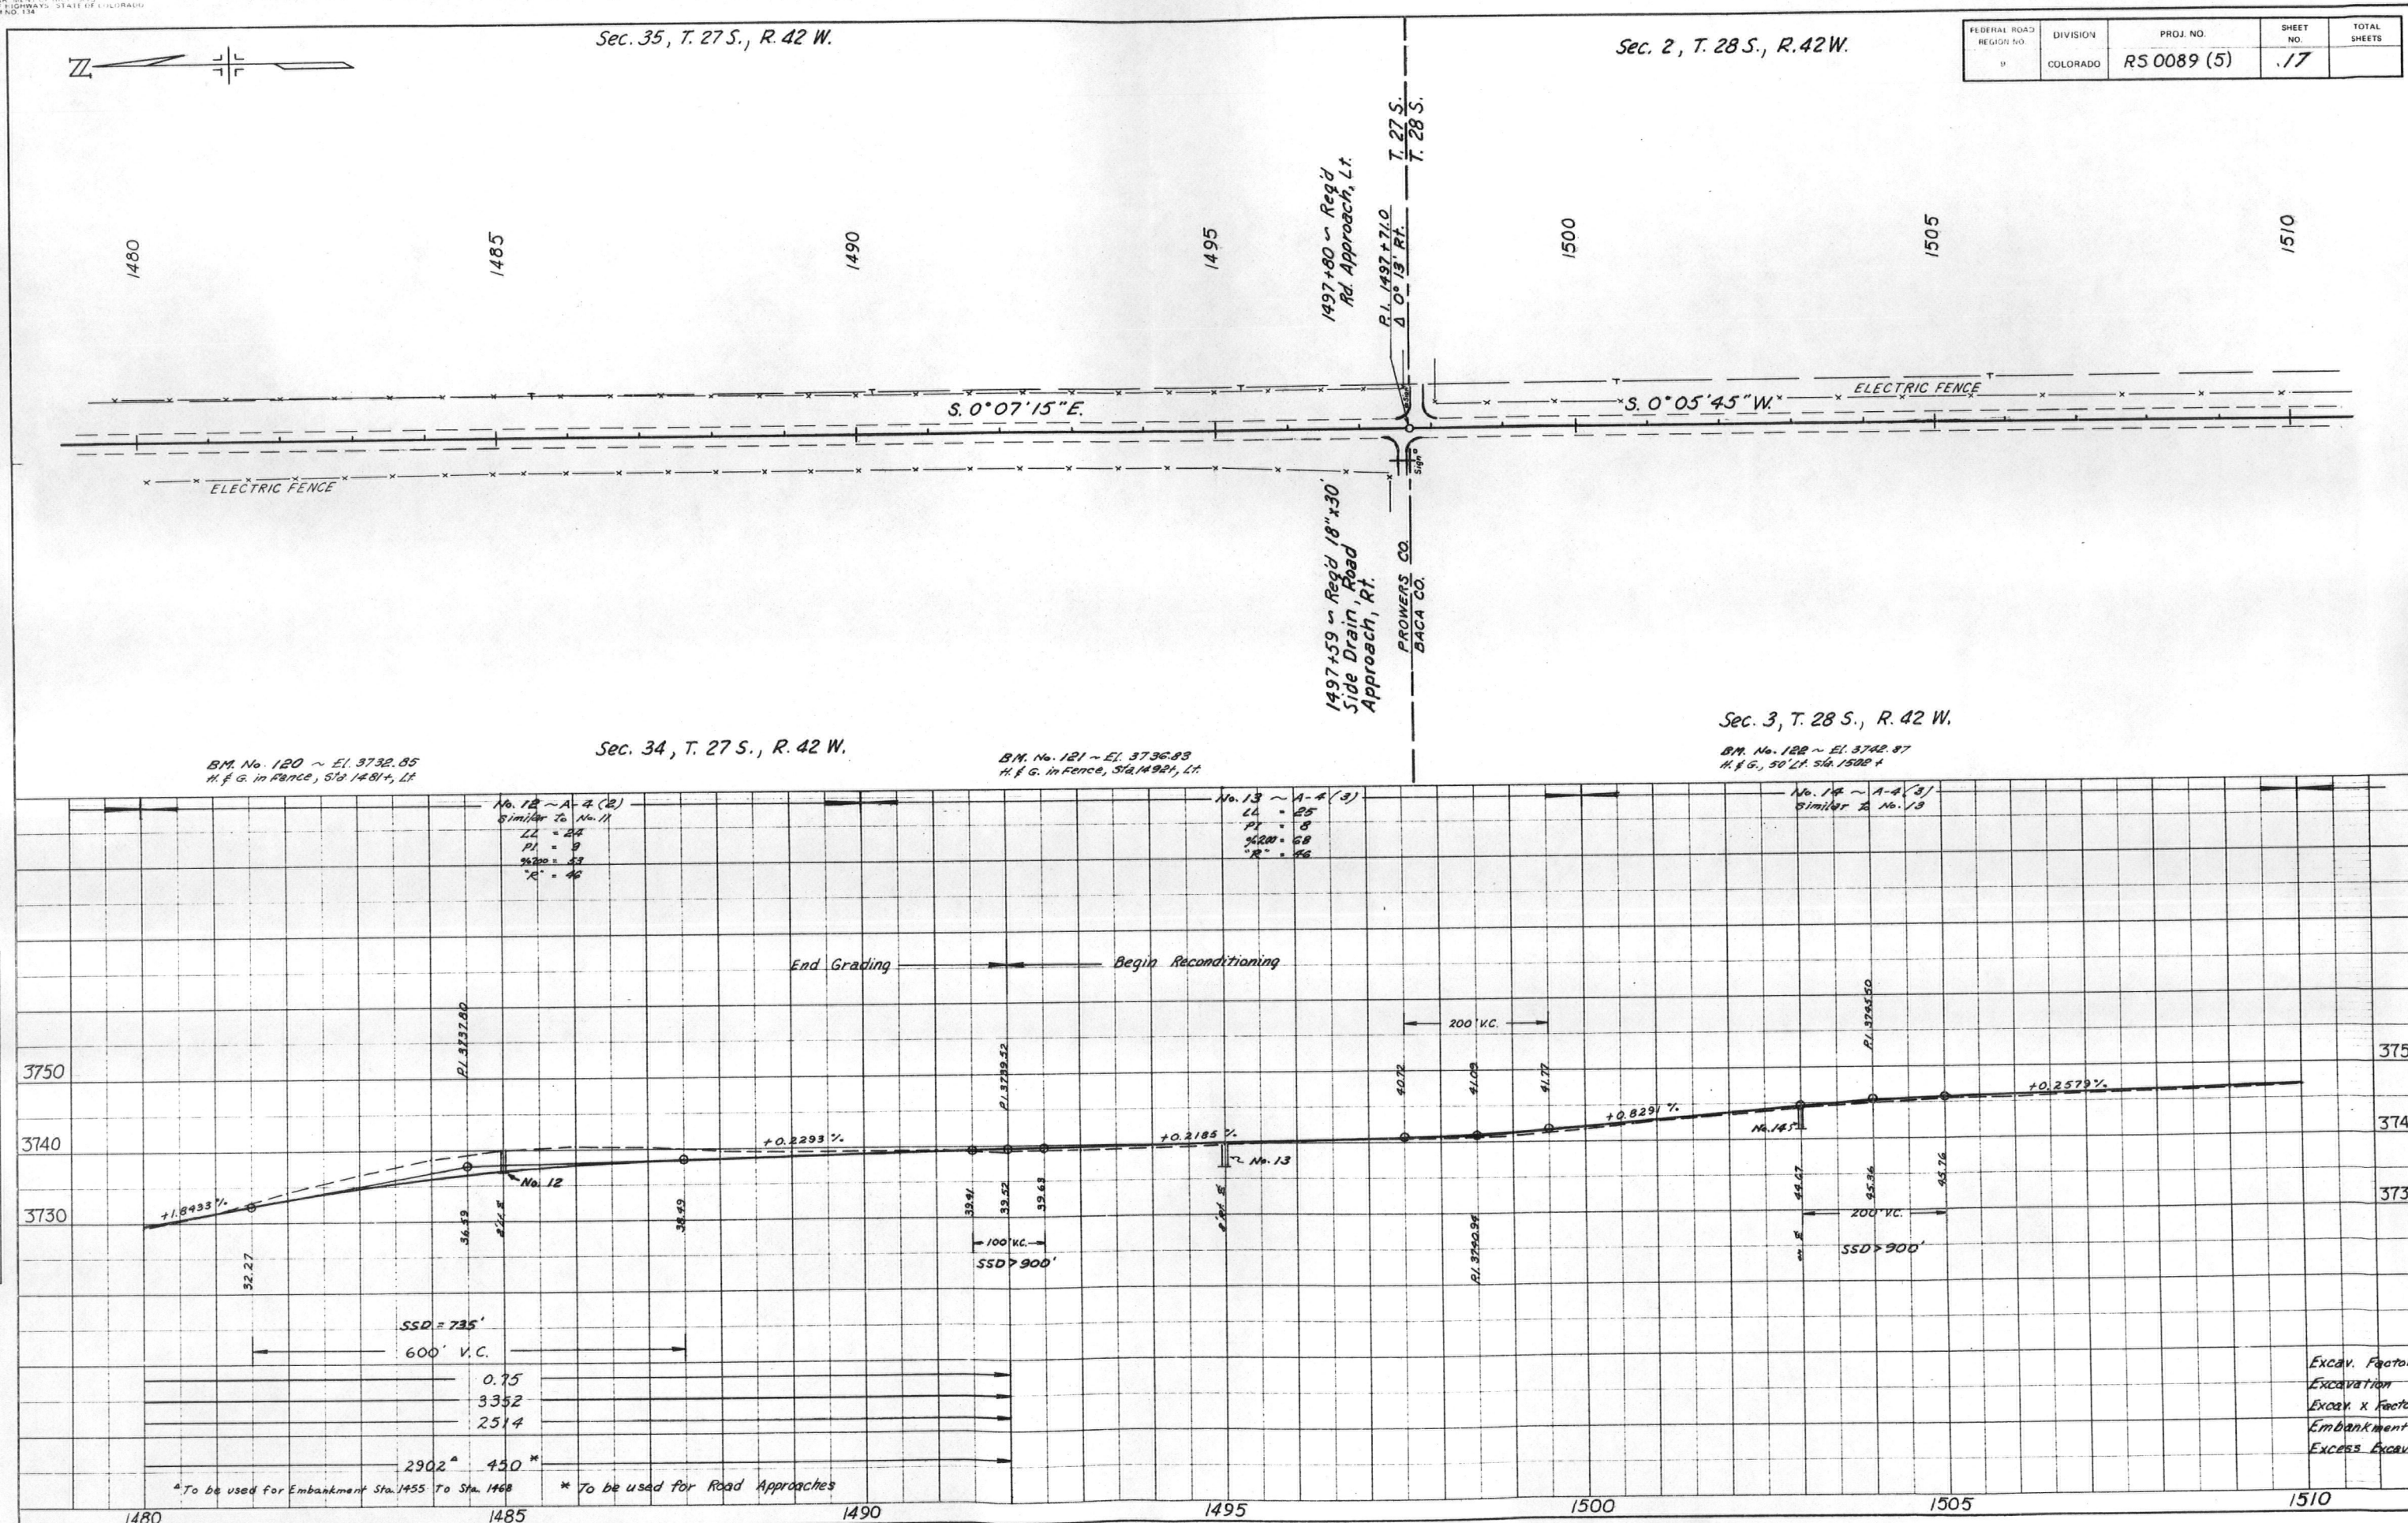

Sec. 2, T. 28 S., R. 42 W.

FEDERAL ROAD REGION NO.	DIVISION	PROJ. NO.	SHEET NO.	TOTAL SHEETS
9	COLORADO	R5 0089 (5)	18	

PLAN	DATE
NO. 1552	

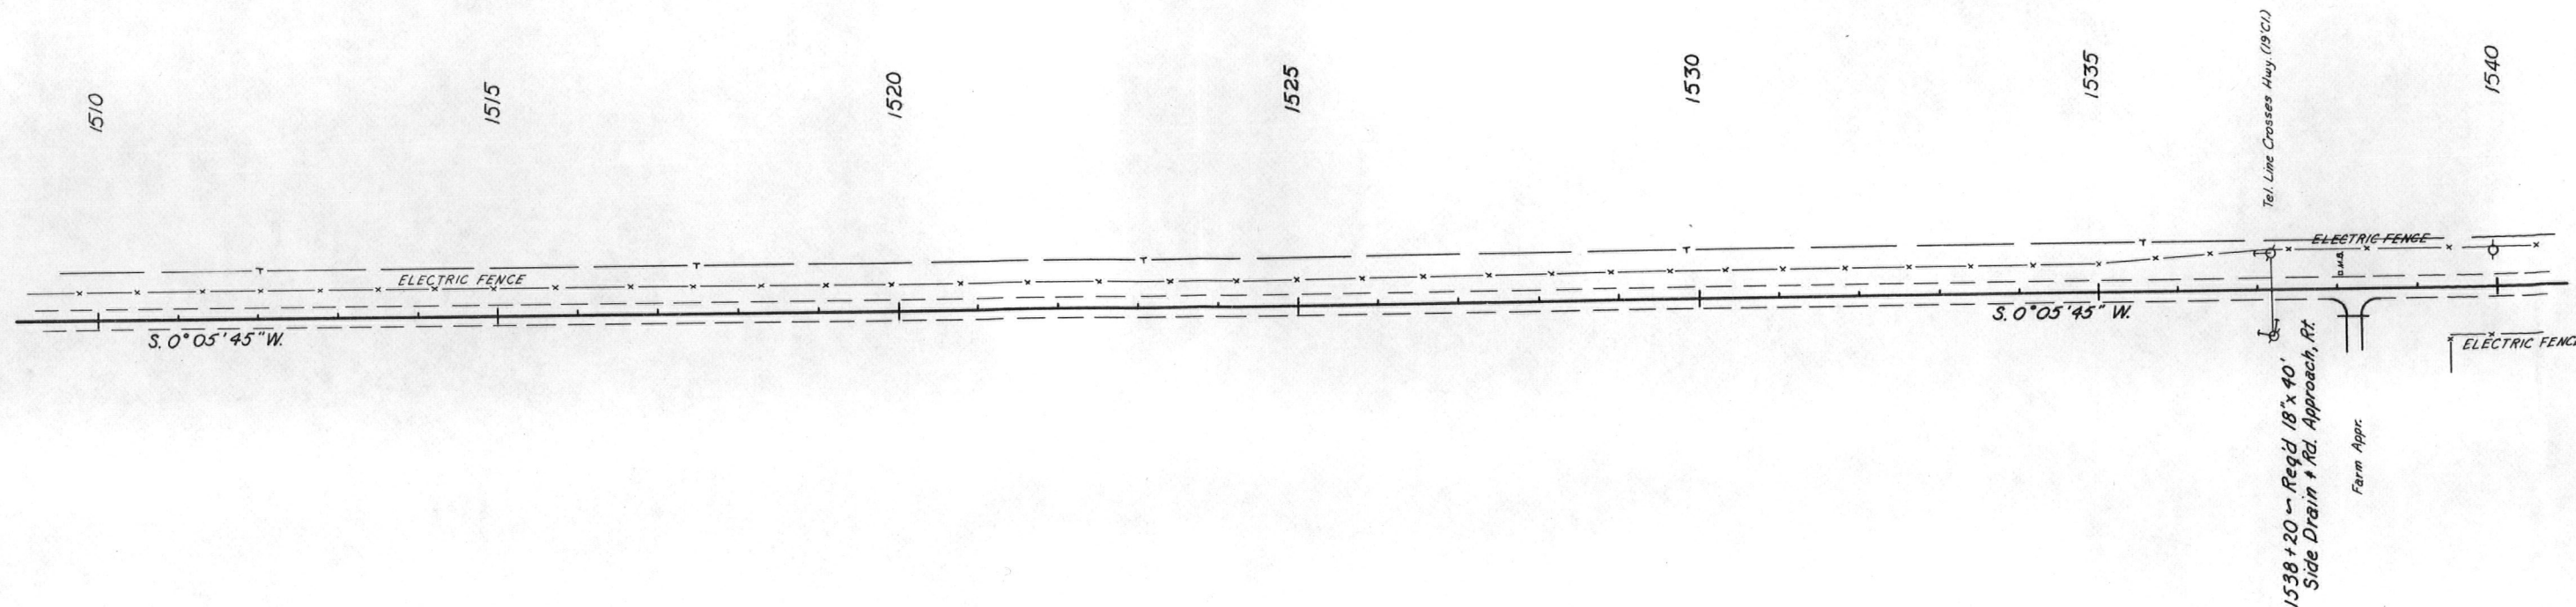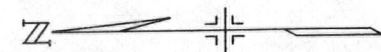

PROFILE	DATE
NO. 1552	

Sec. 3, T. 28 S., R. 42 W.


B.M. No. 123 ~ EL. 3745.25
H. & G., 50' L., Sta. 1511+


B.M. No. 124 ~ EL. 3745.99
H. & G., 50' L., Sta. 1513+

B.M. No. 125 ~ EL. 3743.73
H. & G., 50' L., Sta. 1527+

B.M. No. 126 ~ EL. 3743.34
H. & G., 50' L., Sta. 1534+

B.M. No. 127 ~ EL. 3742.95
Nail in Tel. P., 1539+, Lt.

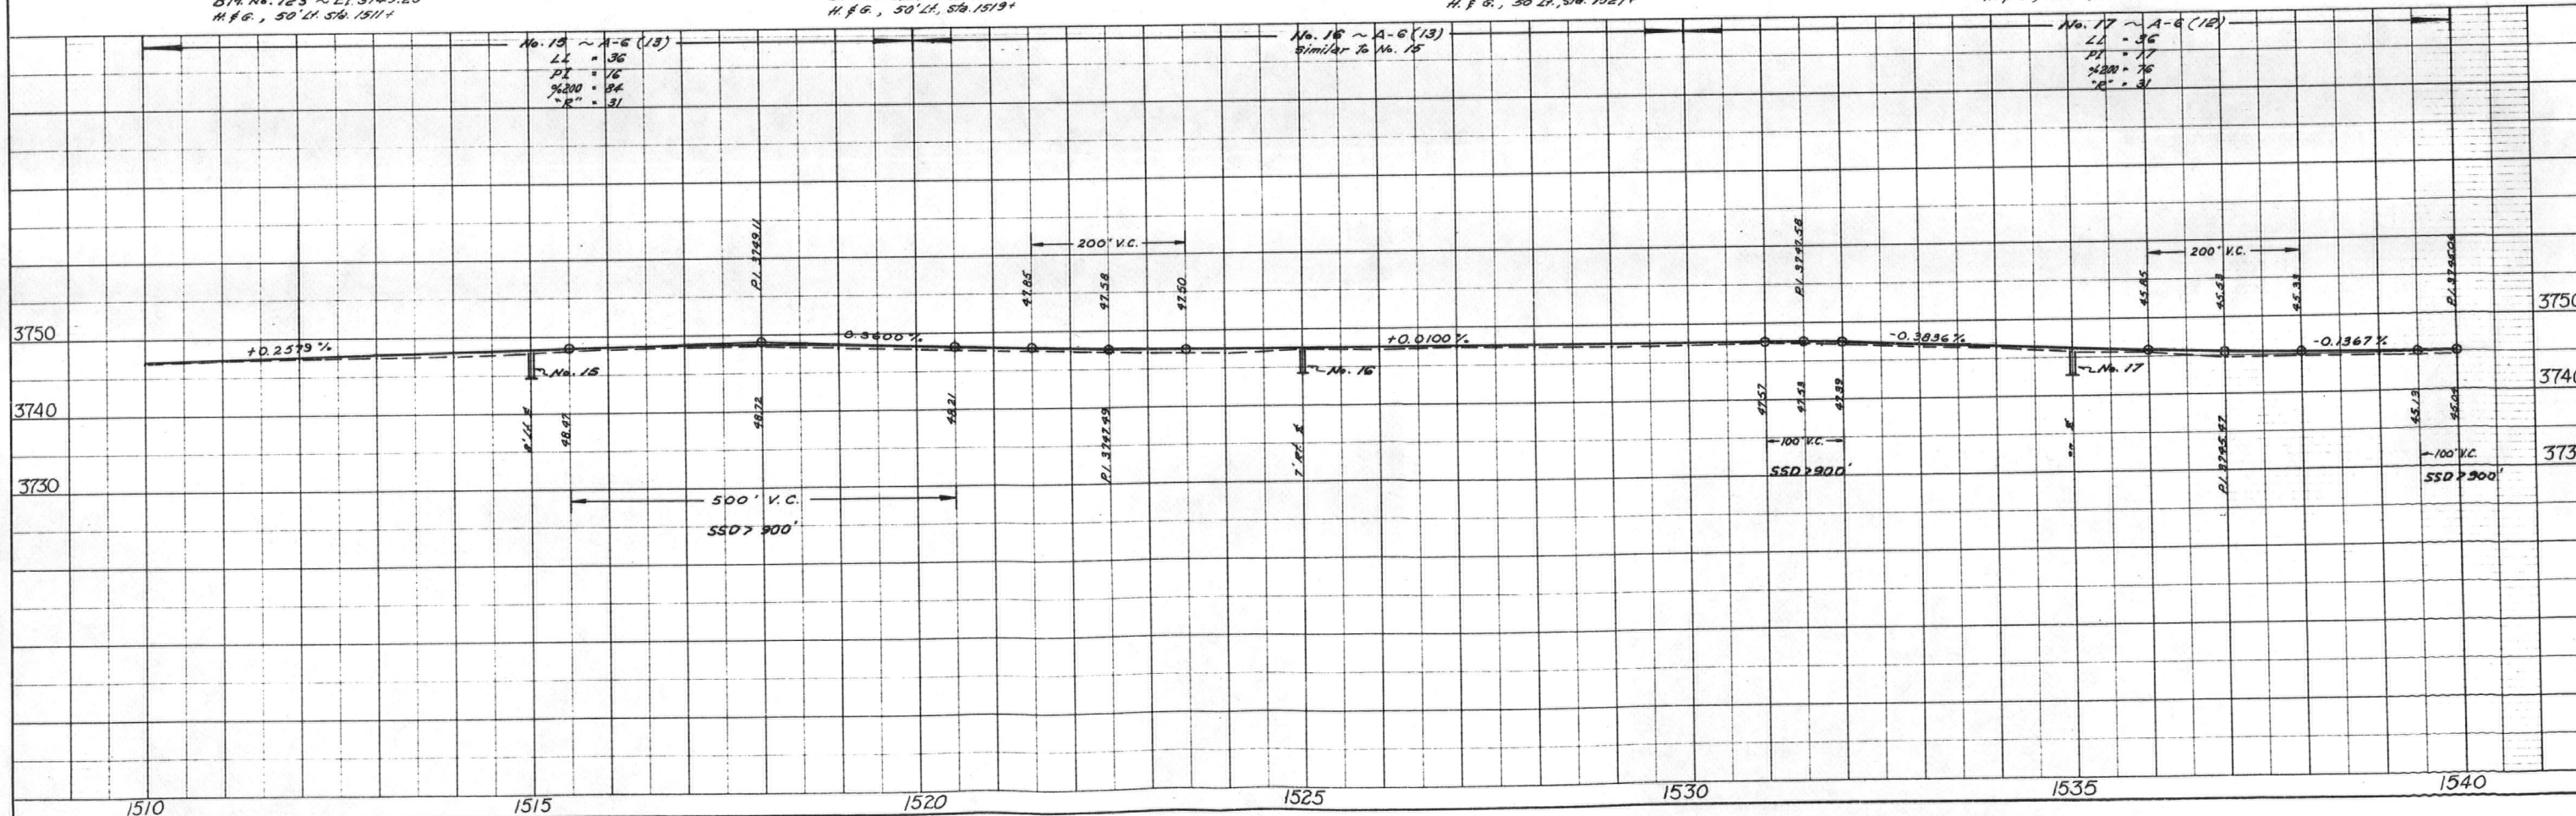

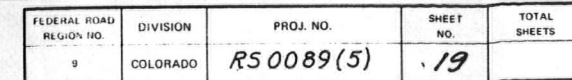


STANDARD SIDE APPROACH ROADS, FLARING, CUT SLOPE TREATMENT & WIDENING AT BRIDGES AND AT CREST OF GRADES


STANDARD M-203-B
(JULY 1, 1965)

FED. ROAD REG. NO.	DIVISION	PROJECT NO.	SHEET NO.
9	COLO.		

GENERAL DETAILS FOR FLARING OF EARTH CUTS, CUT SLOPE TREATMENT & WIDENING AT BRIDGES

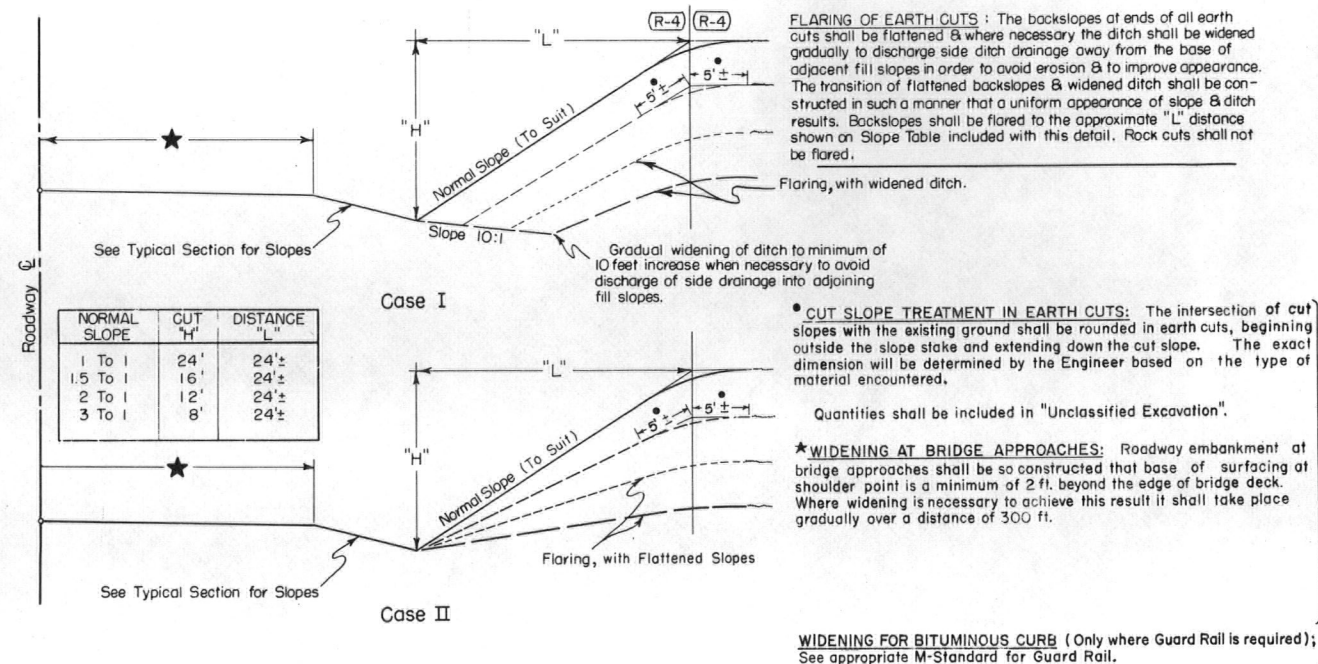


PLAN OF FLARING IN EARTH CUTS

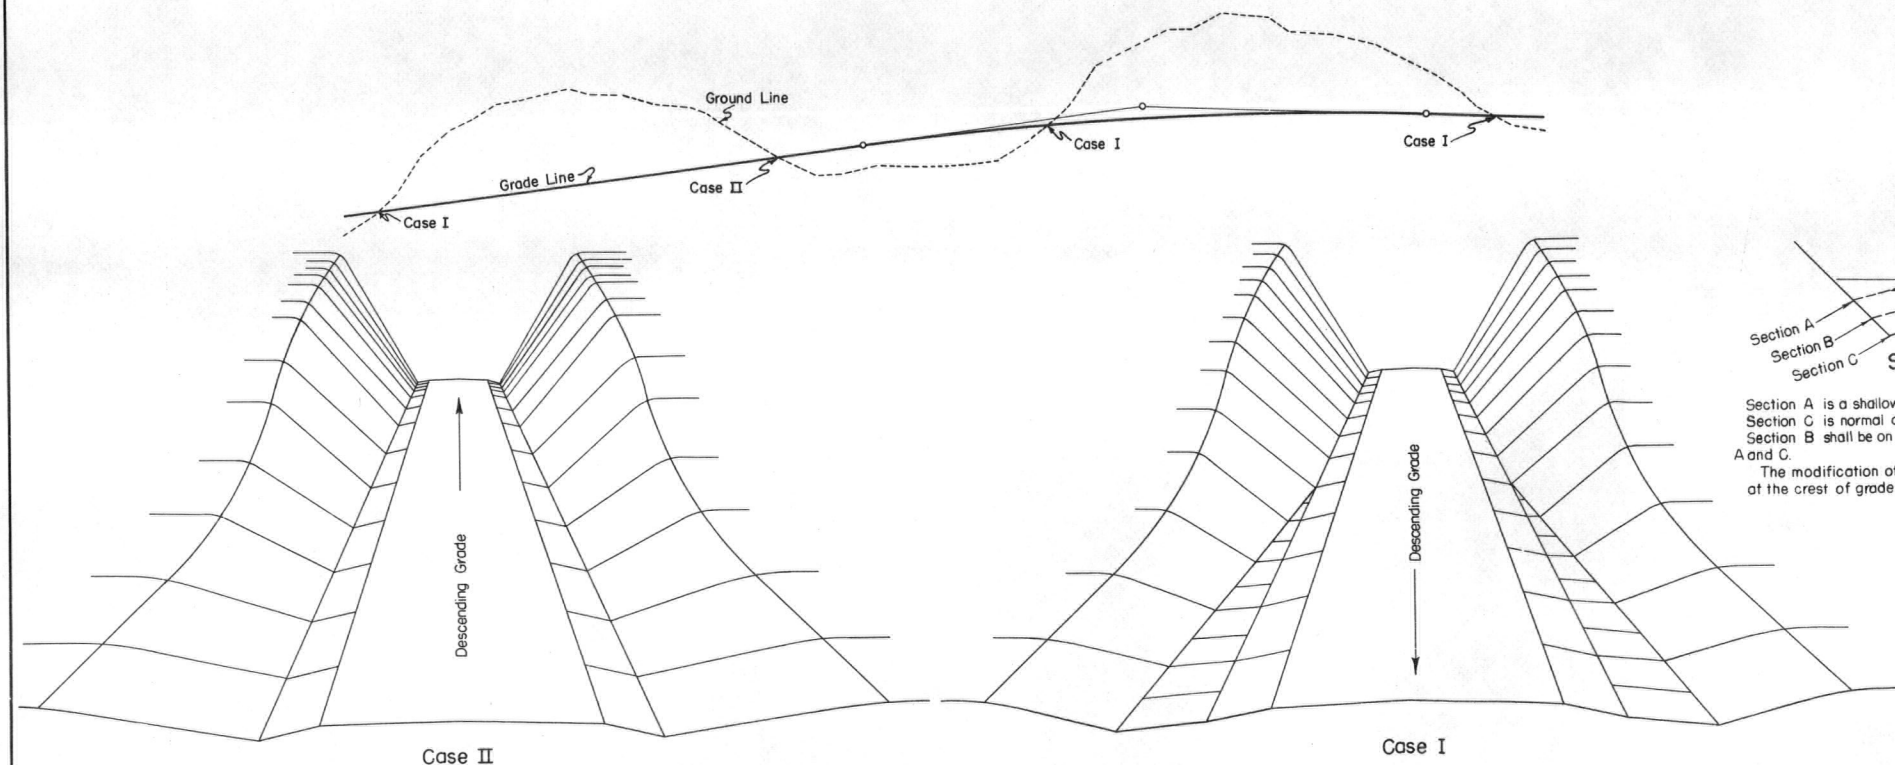


TYPICAL PLANS FOR SIDE APPROACH ROADS AND EMERGENCY MEDIAN CROSS OVERS

Where practical Side Drains are to be placed in line with the roadway ditches.

50' Radii to be used on all intersecting roads except private approaches. Radii may be varied to suit field conditions.

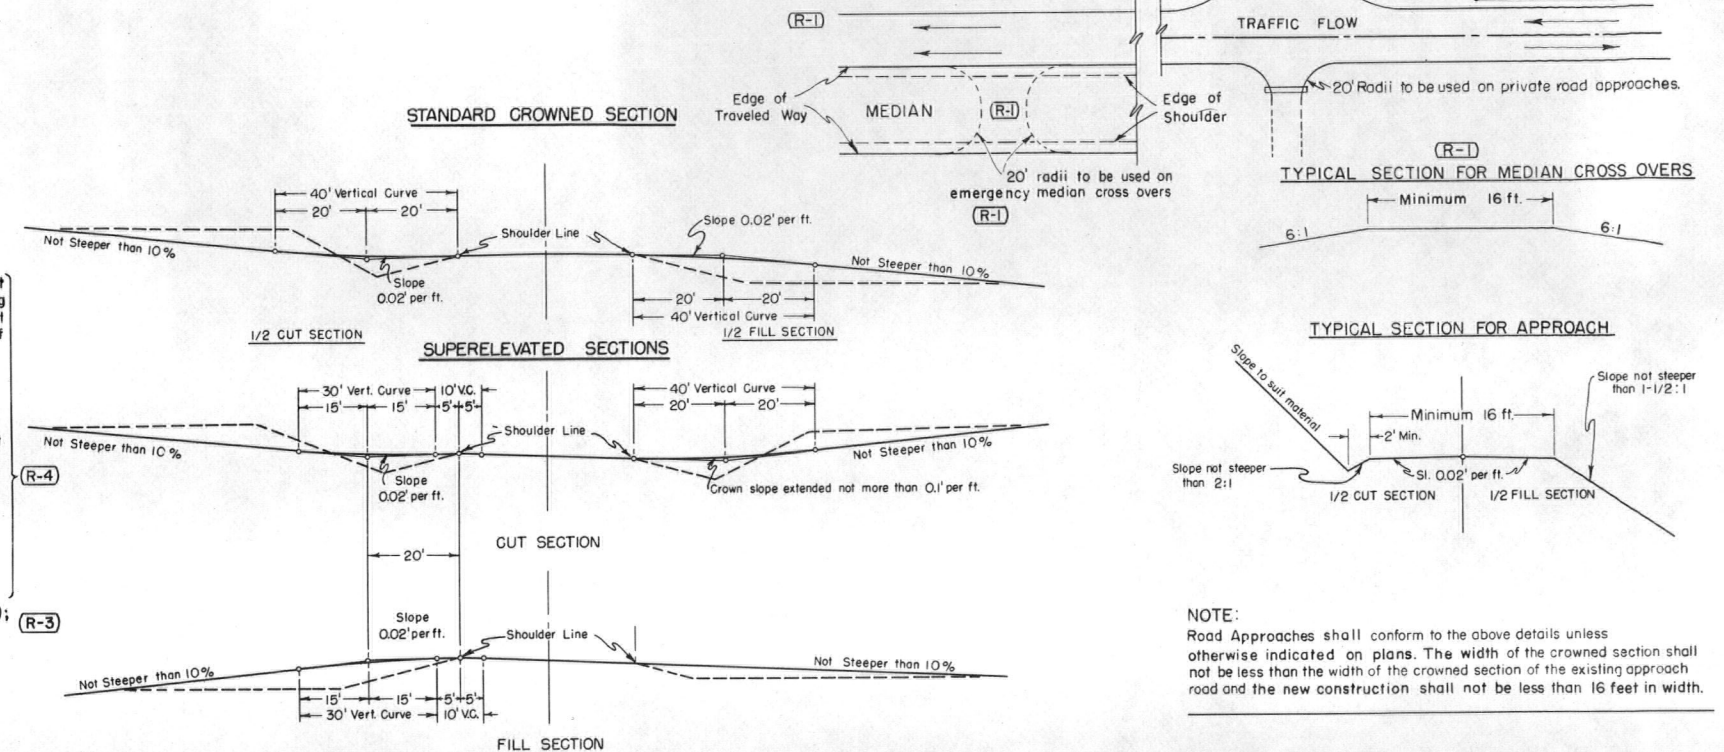

DETAILS FOR DITCH & WIDENED SHOULDERS AT CREST OF GRADES (TO BE USED ONLY WHERE SIGHT DISTANCE AT CREST OF GRADE IS 600 FT OR LESS)

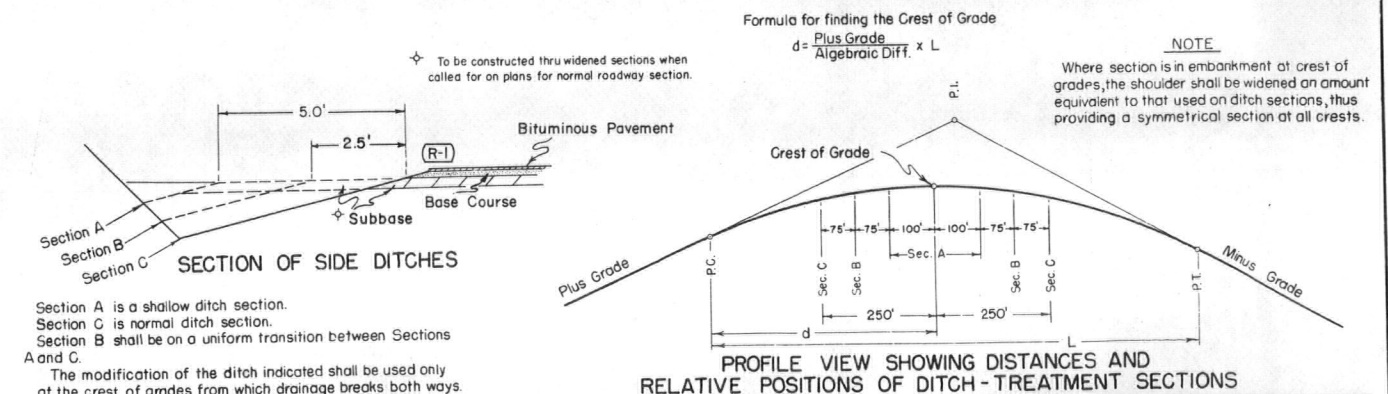

GENERAL NOTES

- All work shall be done in accordance with the Standard Specifications applicable to the Project.
- All side approach roads to the Project shall be Gravel Surfaced with a 4 inch thickness of Aggregate Base Course extending approximately to the Right of Way Line. Estimated tonnage and class of material required for this operation are shown in the Aggregate Base Course Plan.
- The maximum grades shown are to be the limiting grades for all road approaches. Modifications of grades will be permitted where adherence to the grades as shown would cause damage to property or create other unsatisfactory conditions. Grades flatter than the maximum shown are to be used wherever feasible.

DEPARTMENT OF HIGHWAYS
STATE OF COLORADO
DIVISION OF HIGHWAYS
APPROACH ROADS,
FLARING, CUT SLOPE TREATMENT,
BRIDGE & CREST WIDENING

Designed by A.Z.
Made by SJM & ABH
Checked by CRS
Approved by [Signature]
Staff Design Engr.
Date: 3-14-1965


STANDARD TYPES *of* DITCHES *and* CONSTRUCTION METHODS

STANDARD M-203-C
(JULY 1, 1965).

FED. ROAD RE. NO.	DIVISION	PROJECT NO.
9.	COLO.	

DETAILS *for* CONTOUR INTERCEPTING DITCHES

Typical Section for Contour Intercepting Ditches

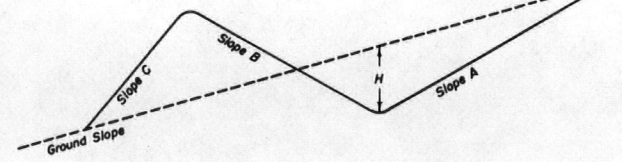

PURPOSE & USE OF THE TABLE

The primary purpose of the information for Contour and Intercepting Ditches shown on this sheet is to serve as a guide in construction and to readily arrive at yardages of excavation involved.
Foremost consideration in constructing these ditches is given first to the natural ground line slope confronted in construction, thence to the other values shown on the Typical Section.
By properly arriving at the combination of values shown on the Typical Section and in the Table for a specified condition, the number of cubic yards of excavation per 100 lin. ft. of ditch may be read under the appropriate column for this item.

Typical Construction Layouts


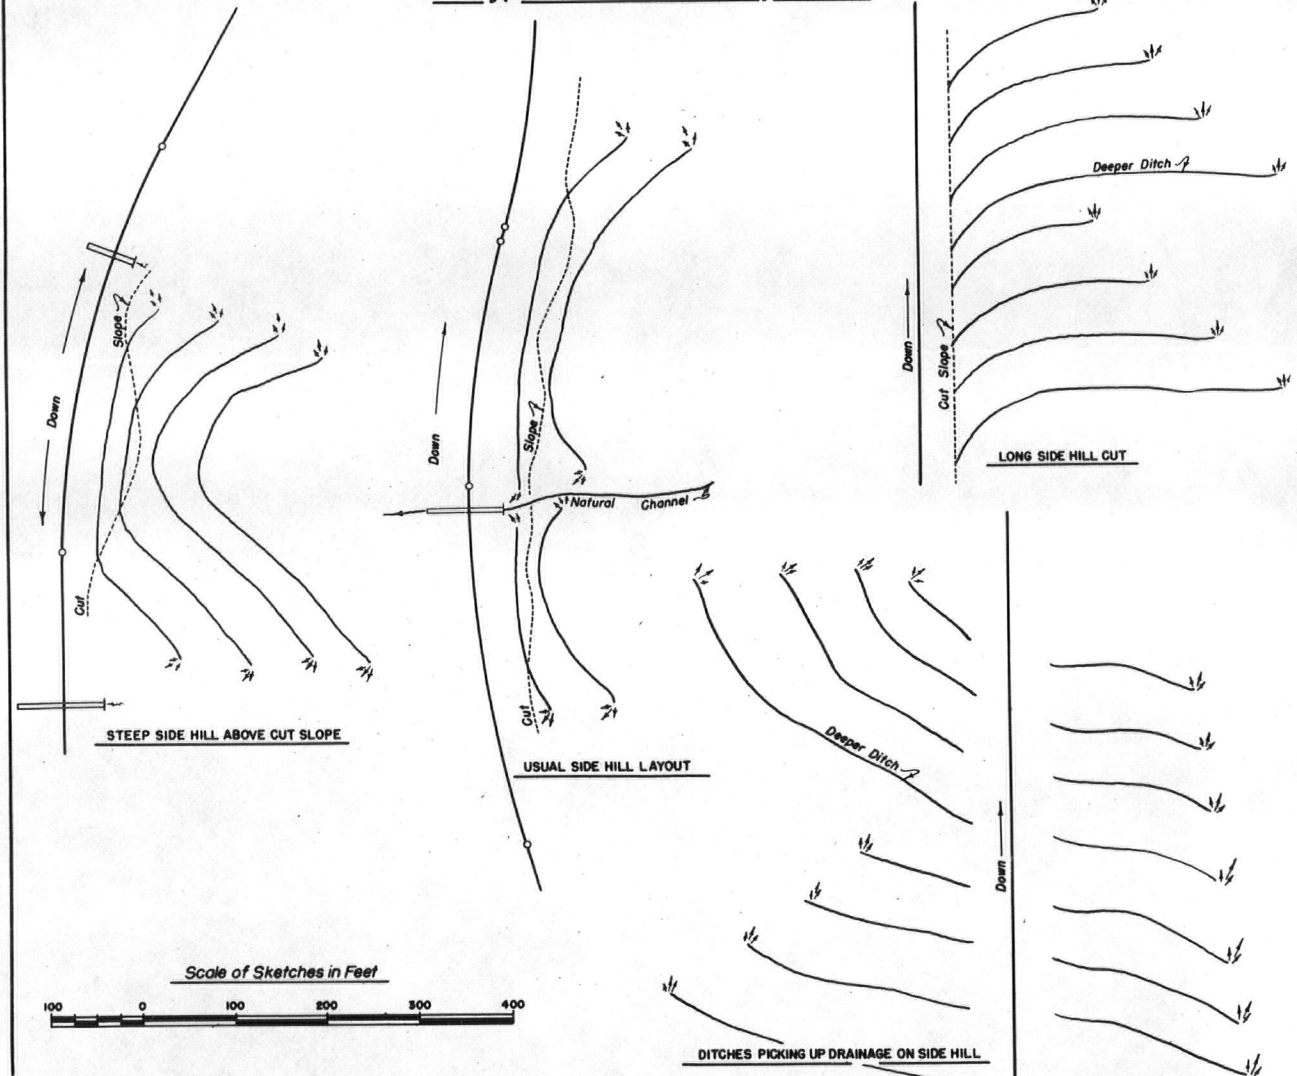


Table of Slopes and Yardages


SLOPES				H	Cubic Yards per 100 lin. ft. of Ditch
Ground	A	B	C		
5:1 Or Flatter	2:1	4:1	2:1	15"	16
				18"	23
				21"	32
				15"	15
				18"	22
		2:1	1-1/2:1	21"	30
				15"	14
				18"	20
				21"	27
				15"	13
	1-1/2:1	4:1	1-1/2:1	18"	19
				21"	25
				15"	12
				18"	18
				21"	25
4:1	2:1	4:1	2:1	15"	12
				18"	17
				21"	23
				15"	10
				18"	15
	1-1/2:1	4:1	1-1/2:1	21"	20
				15"	10
				18"	14
				21"	19
				15"	17
	2:1	4:1	2:1	18"	25
				21"	34
				15"	17
				18"	24
				21"	32
3:1	2:1	3:1	2:1	15"	15
				18"	22
				21"	30
				15"	15
				18"	21
	1-1/2:1	4:1	1-1/2:1	21"	29
				15"	13
				18"	18
				21"	25
				15"	12
	2:1	3:1	2:1	18"	17
				21"	23
				15"	11
				18"	16
				21"	21
2:1	1-1/2:1	2:1	1-1/2:1	15"	10
				18"	14
				21"	20
				15"	22
				18"	31
	1:1	2:1	1:1	21"	43
				15"	21
				18"	30
				21"	41
				15"	20
1-1/2:1	1:1	1-1/2:1	1:1	18"	29
				21"	40
				15"	13
				18"	19
				21"	26
	1-1/2:1	1-1/2:1	1-1/2:1	15"	12
				18"	17
				21"	24
				15"	12
				18"	17
1:1	1:1	1:1	1:1	21"	39
				15"	9
				18"	13
				21"	17
				15"	8
	1-1/2:1	1-1/2:1	1-1/2:1	18"	12
				21"	16
				15"	11
				18"	16
				21"	21

▲ Slopes are approximate and may be varied to suit conditions encountered during construction.

TYPICAL SECTIONS *for* DRAINAGE, IRRIGATION DITCHES *and* CHANNEL CHANGES

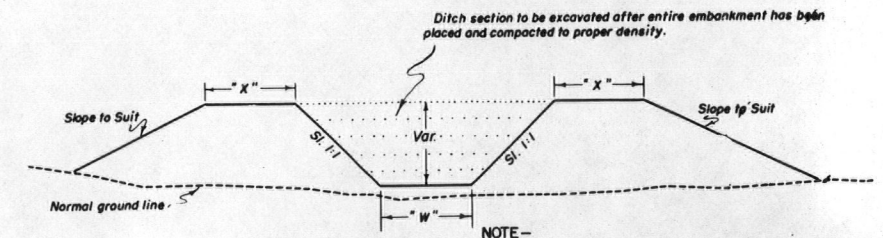

For Embankment Sections (Generally for use in Irrigation Ditches & Channel Changes)

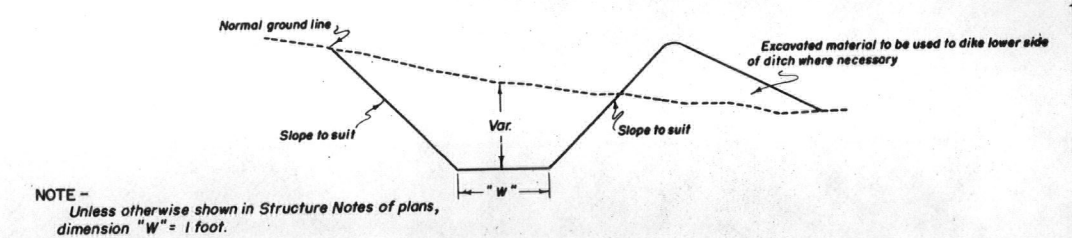

For Cut Sections

GENERAL NOTES

All work shall be done in accordance with the Standard Specifications applicable to the Project.

All ditches are to be constructed to lines and grades as staked by the Engineer using the ditch section shown on plans or as ordered by the Engineer.

CONTOUR INTERCEPTING DITCHES: Ditches are to be laid out along the ground contour on a grade of not over 1% (Type of soil shall govern the grade).

Ends of ditches are to be lined up so that concentration of flow from a higher contour ditch into one of lower contour is, as far as possible avoided. The use of a deeper ditch is recommended where this condition is encountered.

The following horizontal spacing of ditches is recommended:

4% to 6%	Approximately 70' Centers
8% to 10%	Approximately 60' Centers
20% to 4:1 Slope	Approximately 55' Centers
30% to 1-1/2:1 Slope	Approximately 50' Centers

Where ditch checks are required the intervening ditch between one set of ditch checks shall not exceed a grade of 1.0%. Details of checks will be shown on plans when required.


REVISIONS			
(R-1)	7-23-68	Dept. Name	M.R.H.

DEPARTMENT OF HIGHWAYS
STATE OF COLORADO
DIVISION OF HIGHWAYS

DITCH TYPES


Designed by C.E.M. Approved by *[Signature]*
Made by C.E.M. Staff Design Engr.
Checked by Date: July 1, 1965

CONCRETE BOX CULVERTS & WINGWALLS

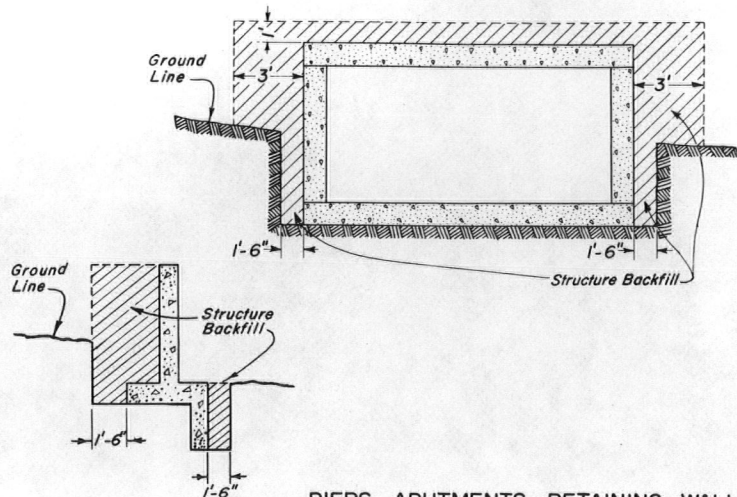


PIERS, ABUTMENTS, RETAINING WALLS ETC.

All material that is to be compacted shall be placed in horizontal layers not more than 6" inches in depth and compacted before the next layer is placed. For Arches, Rigid Frames and Box Culverts the fill shall be brought up uniformly on both sides of the center of structure to avoid stresses in the structure caused by unsymmetrical loading.

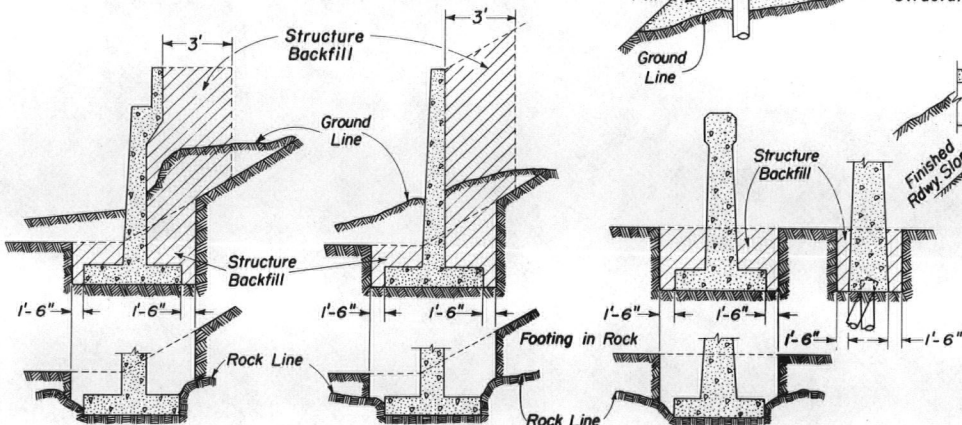

Note:
"E" = Limits of Structure Excavation


CAST IN PLACE CONDUIT

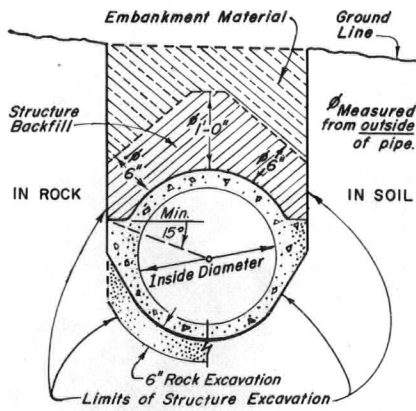


STANDARD M-206-AA

(MARCH 1, 1971)
(SHEET 1 OF 2)


CIRCULAR CONDUIT

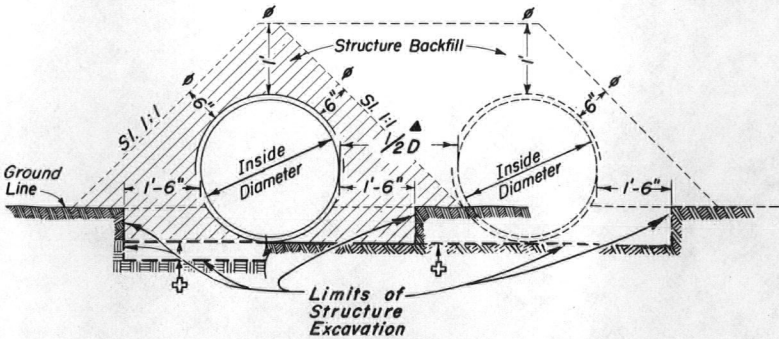

ELLIPTICAL OR ARCH CONDUIT

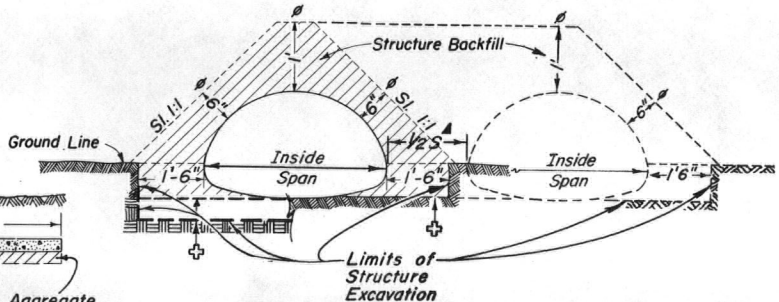

SIPHONS OR CONDUIT IN TRENCH

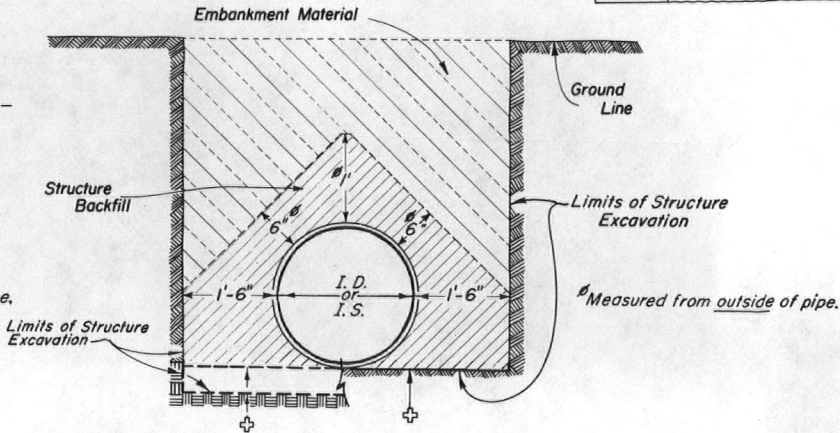


- NOTES:
- ▲ When two or more conduits are laid side by side they shall be spaced so that the adjacent pipes will be $\frac{1}{2}$ I.D., $\frac{1}{2}$ I.S. or 3 feet apart (including wall thickness), whichever is less. Minimum spacing shall be not less than 1 foot between outside walls of pipe. For additional culvert installation details see M Standards for metal, concrete, or structural plate pipe culverts.
 - ✦ Bottom of trench as excavated. For applicable limits of Structure Excavation, see bedding details on standards for culverts.


GENERAL NOTES

- All work shall be done according to the Standard Specifications applicable to the Project.
- Where the roadway cross section is in fill, excavation for concrete footings (except those in rock or those on piles) and for box culverts shall be done according to the following:
- Embankment shall be built up and compacted to a point one foot above the bottom of the box or one foot above the bottom of the footing. The trench shall then be excavated to accommodate construction of the box or footing.
- Excavation and backfill patterns different from those indicated on these sheets will be shown elsewhere on the plans.
- Excavation for structure installation shall be classified as "Structure Excavation" unless otherwise shown on plans.


DROP INLETS, DIVISION BOXES, INTERCEPTING HEADWALLS, ETC.

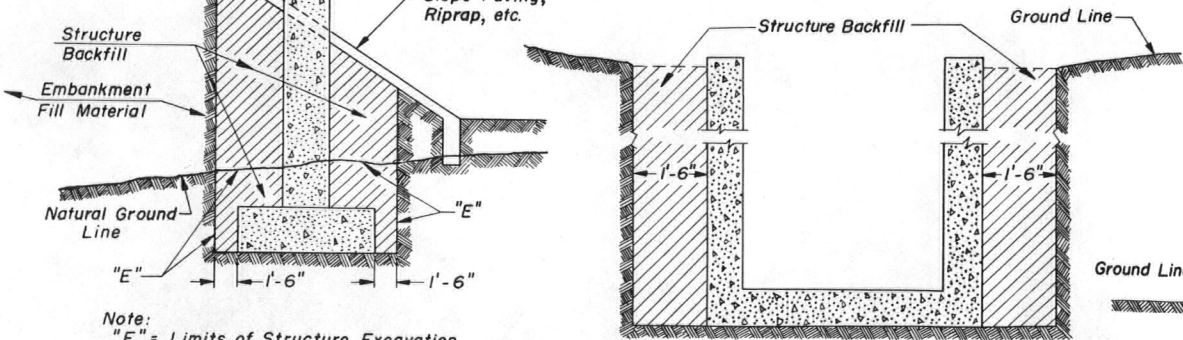

HEADWALLS AND END OF CULVERTS

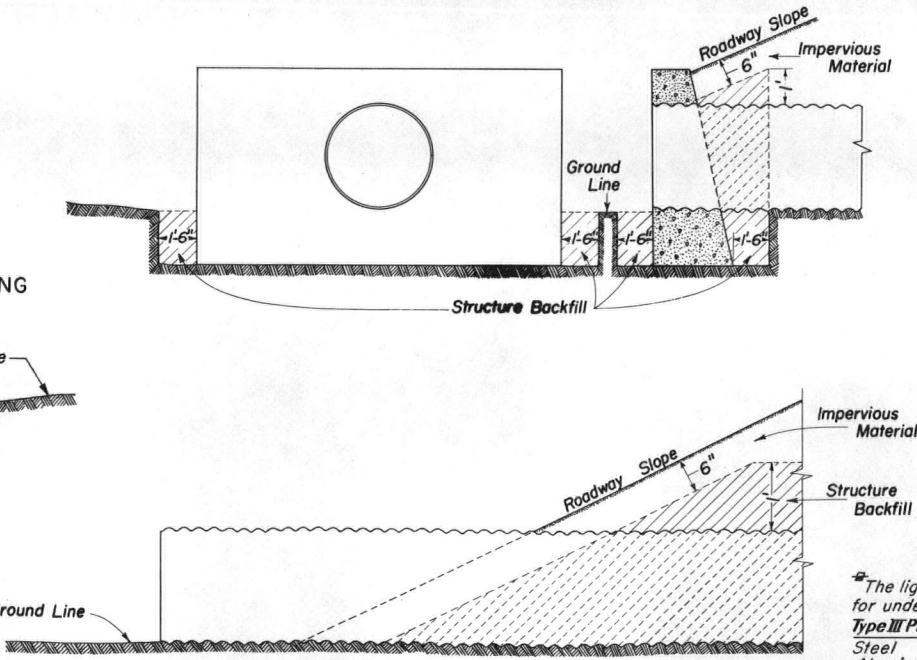

TRENCH FOR PIPE UNDERDRAIN

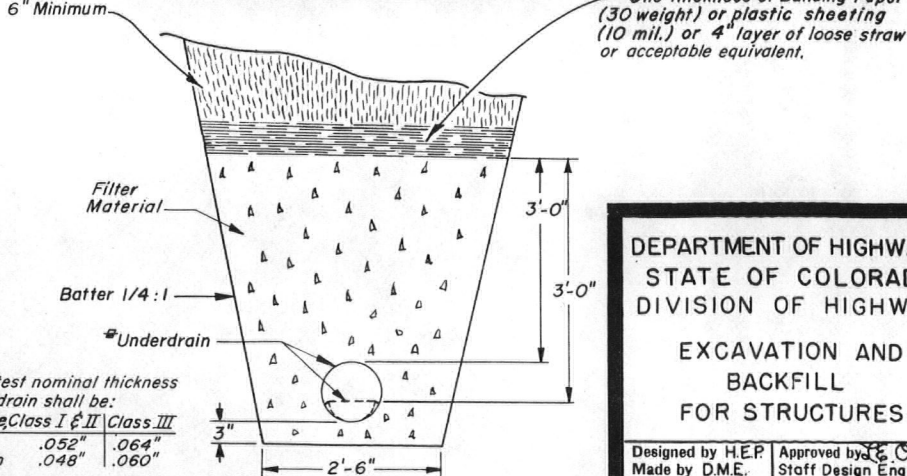

The lightest nominal thickness for underdrain shall be:

Type III Pipe Class I & II Class III		
Steel	.052"	.064"
Aluminum	.048"	.060"

DEPARTMENT OF HIGHWAYS
STATE OF COLORADO
DIVISION OF HIGHWAYS

EXCAVATION AND
BACKFILL
FOR STRUCTURES

Designed by H.E.P. Approved by E. Olson
Made by D.M.E. Staff Design Engr.
Checked by L.E.O. Date: March 1, 1971


STANDARD M-206-AA

(MARCH 1, 1971)
(SHEET 2)


FEDERAL ROAD REGION NO.	DIVISION	PROJ. NO.	SHEET NO.	TOTAL SHEETS
9	COLORADO			

REVISIONS:	



STRUCTURE EXCAVATION MEASUREMENT FOR PIPE CULVERTS

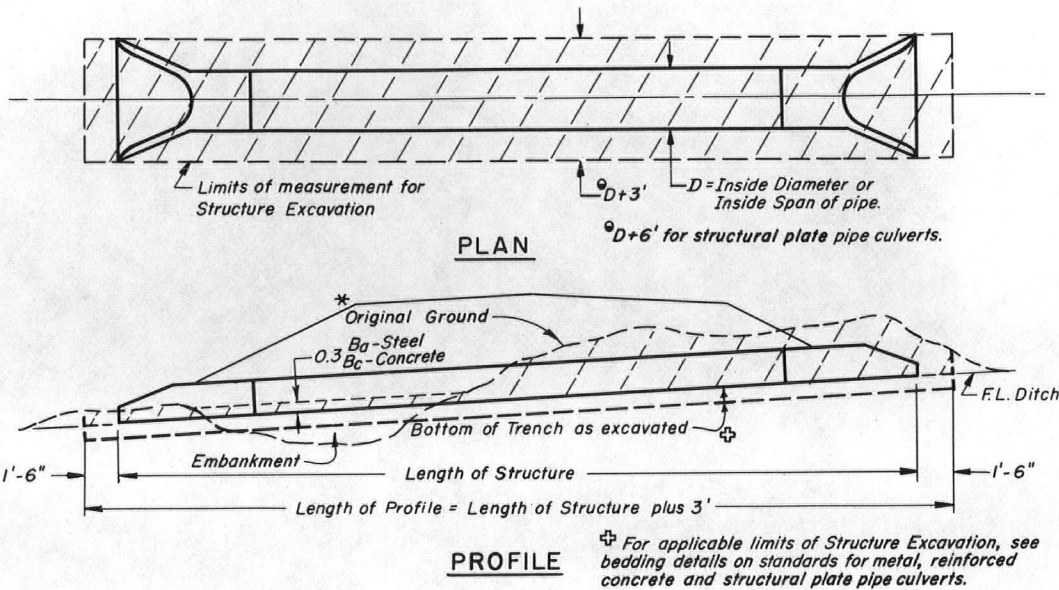

STRUCTURE EXCAVATION MEASUREMENT FOR CONCRETE BOX CULVERTS

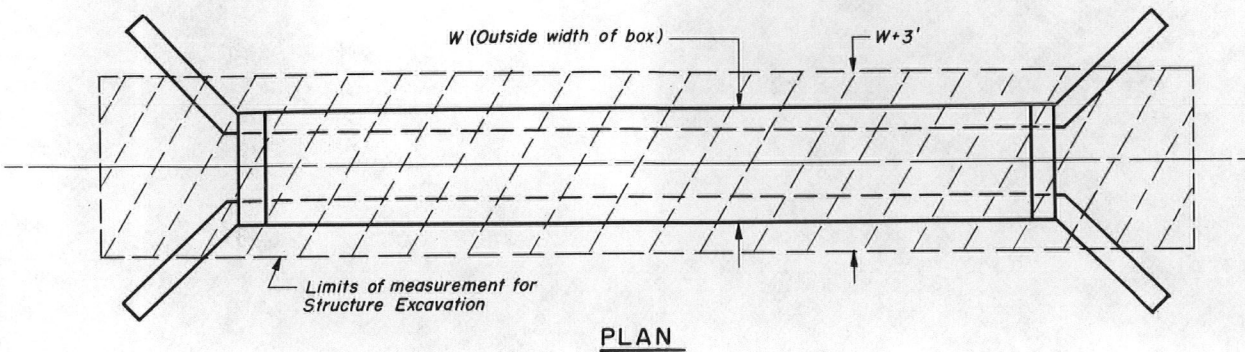

STRUCTURE EXCAVATION MEASUREMENT FOR DIVERSION OR DIVISION BOXES

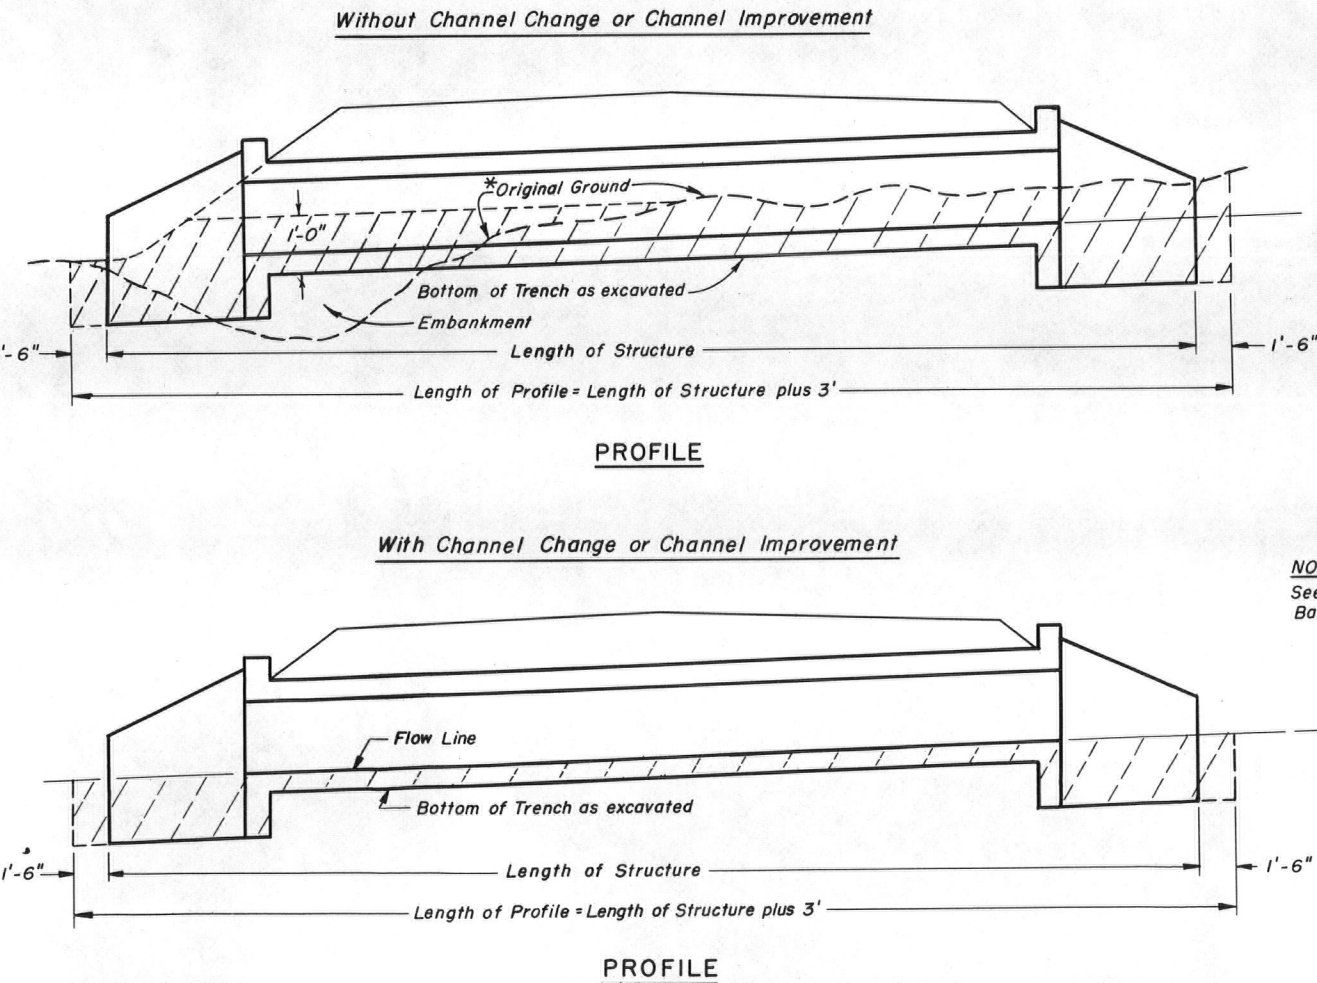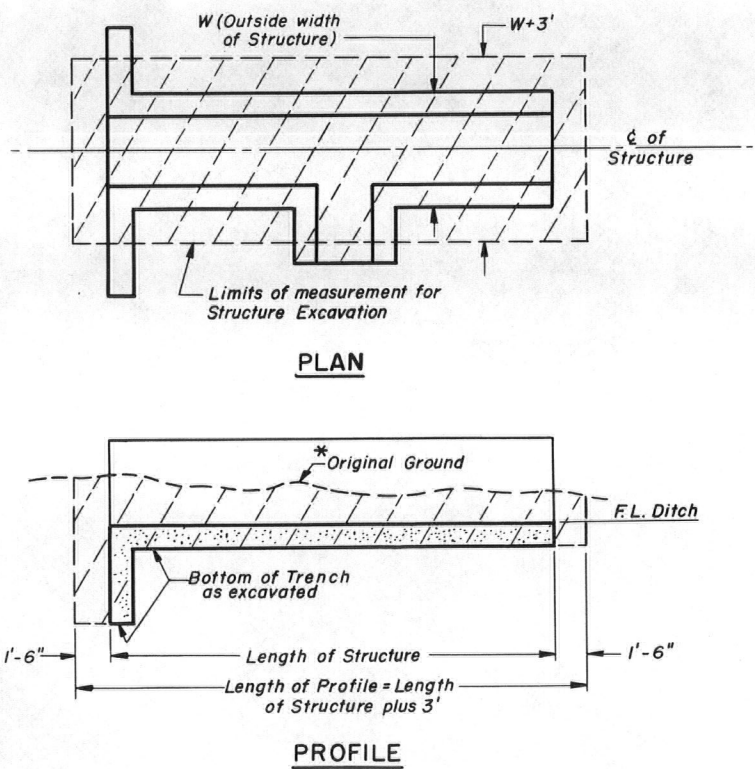

NOTE:
See Sheet 1 for General Notes and Backfilling Details.

* Along C of Structure
Areas to be used for Structure Excavation computations.

DEPARTMENT OF HIGHWAYS
STATE OF COLORADO
DIVISION OF HIGHWAYS
EXCAVATION AND
BACKFILL
FOR STRUCTURES

Designed by: M.R.H. Approved by: H.P.B.
Made by: H.P.B. Staff Design Engr.
Checked by: Date: March 1, 1971

STANDARD M-603-RC

(MARCH 20, 1967)


FEDERAL ROAD REGION NO.	DIVISION	PROJ. NO.	SHEET NO.	TOTAL SHEETS
9	COLORADO			

REVISIONS			
(R-1)	4-19-68	Added Arch and Elliptical Pipe. Gen. Notes.	M.R.H.
(R-2)	7-23-68	Dept. Name.	M.R.H.
(R-3)	3-1-71	GN's for B bed and NRCP. Cl. 2 bed matl.	M.R.H.

(R-1)


NOTE: B_c is the outside dimension for diameter, span or rise.

PIPE INSTALLATION
(WITH 0.7 PROJECTION RATIO)

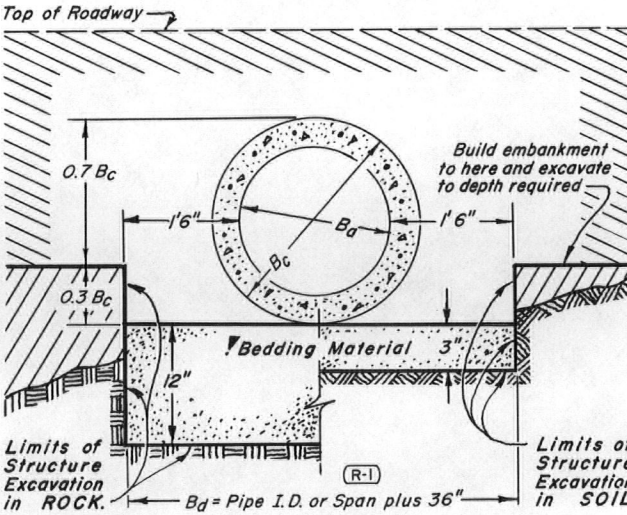

IMPERFECT TRENCH PIPE INSTALLATION
(WITH 0.7 PROJECTION RATIO)

Complete embankment to here, then excavate and fill as shown.

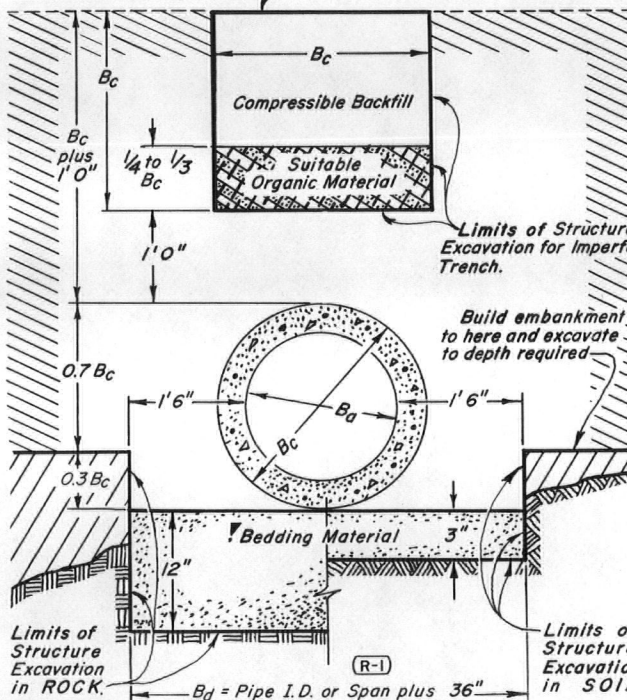

Bedding Material for SOIL shall be 3" loose thickness Structure Backfill Class 2. (R-3)
Bedding Material for ROCK shall be 12" loose thickness Structure Backfill Class 1.


DIMENSIONS FOR REINFORCED CONCRETE PIPE
(For Information Only)

CIRCULAR				ARCH				VERTICAL ELLIPTICAL (VE)				HORIZONTAL ELLIPTICAL (HE)			
PIPE SIZE- B_o (In. I.D.)	Wall Thickness (Inches)	0.3 B_c (Outside Dia.) (Feet)	ϕ Span (Inches)	ϕ Rise (Inches)	Wall Thickness (Inches)	0.3 Outside Rise (Feet)		Span (Inches)	Rise (Inches)	Wall Thickness (Inches)	0.3 Outside Rise (Feet)	Span (Inches)	Rise (Inches)	Wall Thickness (Inches)	0.3 Outside Rise (Feet)
12	2	0.40	18	11	2-1/4	0.39						23	14	2-3/4	0.49
15	2-1/4	0.49	22	13	2-1/2	0.45									
18	2-1/2	0.58													
21	2-3/4	0.66	25	16	2-3/4	0.54						30	19	3-1/4	0.66
24	3	0.75	29	18	3	0.60						34	22	3-1/2	0.73
27	3-1/4	0.84													
30	3-1/2	0.92	36	22	3-1/2	0.73						38	24	3-3/4	0.79
33	3-3/4	1.01										42	27	3-3/4	0.86
36	4	1.10	43	27	4	0.88	29	45	4-1/2	1.35		45	29	4-1/2	0.95
39	4-1/2	1.28	50	31	4-1/2	1.00	32	49	4-3/4	1.46		49	32	4-3/4	1.04
42	5	1.45	58	36	5	1.15	34	53	5	1.58		53	34	5	1.10
48							38	60	5-1/2	1.78		60	38	5-1/2	1.23
54	5-1/2	1.62	65	40	5-1/2	1.28	43	68	6	2.00		68	43	6	1.38
60	6	1.80	72	44	6	1.40	48	76	6-1/2	2.23		76	48	6-1/2	1.53
66	6-1/2	1.97					53	83	7	2.43		83	53	7	1.68
72	7	2.15	88	54	7	1.70	58	91	7-1/2	2.65		91	58	7-1/2	1.83
78	7-1/2	2.32					63	98	8	2.85		98	63	8	1.98
84	8	2.50	102	62	8	1.95	68	106	8-1/2	3.08		106	68	8-1/2	2.13
90	8-1/2	2.68	115	72	8-1/2	2.23	72	113	9	3.28		113	72	9	2.25
96	9	2.85	122	77	9	2.38	77	121	9-1/2	3.50		121	77	9-1/2	2.40
102	9-1/2	3.02					82	128	9-3/4	3.69		128	82	9-3/4	2.54
108	10	3.20	138	87	10	2.68	87	136	10	3.90		136	87	10	2.68


Also equivalent round dimension for Arch and Elliptical pipe.

Sizes shown are for identification purposes only. Actual sizes shall conform to those listed in Fig. 1 of ASTM Spec. C 506.

CONCRETE CULVERT WITH END SECTIONS

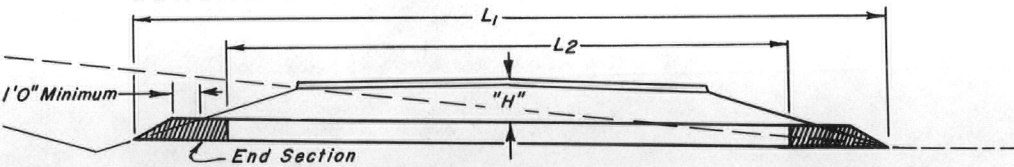

CONCRETE CULVERT WITHOUT END SECTIONS

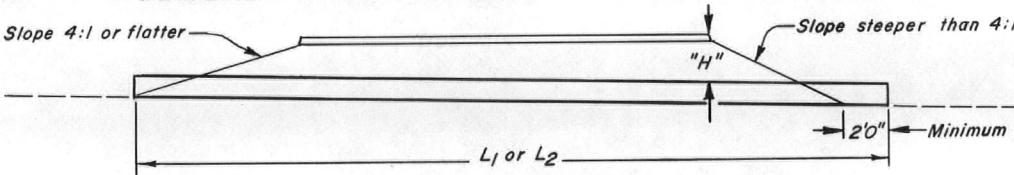

"H" = Maximum height of fill over top of Culvert, including pavement.
 L_1 = Length of Culvert to be measured when placed in accordance with Section 617.
 L_2 = Length of Pipe to be measured when placed in accordance with Section 603.

(R-1) Length of extension, when placed in accordance with Section 617, shall be the actual number of feet of new culvert required.

HEIGHTS OF FILL OVER REINFORCED CONCRETE PIPE
— ALL SIZES —

TYPE OF PIPE	HEIGHT OF FILL OVER TOP OF PIPE IN FEET CLASS OF PIPE (0.01" Crack D-Load)					
	Class II Class VE II	Class III Class VE III	Class IV Class HE IV	Class V Class VE V	Class VI Class VE VI	
	1000 D	1350 D	2000 D	3000 D	4000 D	
PIPE INSTALLATION WITH 0.7 PROJECTION RATIO						
CIRCULAR	Min. to 18	Min. to 25	25+ to 37	37+ to 45		
ARCH	Min. to 18	Min. to 25	25+ to 37			
VERTICAL ELLIPTICAL	Min. to 18	Min. to 25	25+ to 37	37+ to 45	45+ to 62	
HORIZONTAL ELLIPTICAL	Min. to 18	Min. to 25	25+ to 37			
PIPE INSTALLATION WITH IMPERFECT TRENCH						
ALL TYPES	up to 35	up to 48	48+ to 75	75+ to 96		

(R-3)

GENERAL NOTES

All work shall be done in accordance with the Standard Specifications applicable to the project.
Minimum cover excluding pavement shall be 1 foot.
Fill heights greater than maximum allowed in the Heights of Fill Table on this sheet will require special design of structure.
Pipe design is based on safety factor of 1.33 on ultimate strength.
The heights of fill over top of pipe are based on unit weight of soil at 120 lbs. per cubic foot.
Pipe Class is determined from .01 inch crack D-load.
Bedding is Class B (Modified) with Settlement Ratio $R_{sd} = 0.0$ (Yielding Bed).

Changes in design factors will require compensating change in pipe design.
Minimum wall thickness dimensions are based on AASHTO Designation M 170 (Wall B) for Circular Pipe, AASHTO Designation M 206 for Arch Pipe and AASHTO Designation M 207 for Elliptical Pipe.
Spacing for multiple pipe installations shall conform to the details shown on M Standard for Excavation and Backfill for Structures.
When a culvert is to be extended with pipe of different material, the connection shall conform to the detail on plans or be approved.

NONREINFORCED CONCRETE PIPE
Nonreinforced Concrete Pipe is required to meet the same D-Load to produce the ultimate load under the three-edge-bearing method as specified for Reinforced Concrete Pipe in accordance with AASHTO M-170. Wall thickness of pipe may be increased as required to meet D-Load requirement.

All requirements for Reinforced Concrete Pipe, except those referring to reinforcement shall apply to Nonreinforced Concrete Pipe.

DEPARTMENT OF HIGHWAYS
STATE OF COLORADO
DIVISION OF HIGHWAYS

REINFORCED CONCRETE
PIPE

Designed by M.R.H. Approved by J.R.B. Staff Design Eng'r.
Made by J.R.B. Checked by R.S.M. Date: 4-19-68

STANDARD M-606-AB
(MARCH 1, 1968)
(SHEET 1 OF 3)


FEDERAL ROAD REGION NO.	DIVISION	PROJ. NO.	SHEET NO.	TOTAL SHEETS
9	COLORADO			

REVISIONS			
(R-1)	7-10-68	Add typical post & obstr.	M.R.H.
(R-2)	4-1-69	Widening. Bevel. Gen. notes.	M.R.H.
(R-3)	2-18-70	Pay length. Blocks. Gen. Notes.	M.R.H.
(R-4)	11-25-70	Timber, Hole and Gen. Notes.	M.R.H.
(R-5)	6-15-71	Timber table, post spacing G.N.S.	M.R.H.
(R-6)	6-25-71	Shoulder treatment detail.	M.R.H.


TABLE OF OFFSETS
FOR 75' PARABOLIC FLARES

x	W=4'	W=5'	W=10'	W=12'	W=14'	W=16'
12'-6"	0.11	0.14	0.28	0.33	0.39	0.44
25'-0"	0.44	0.55	1.11	1.33	1.56	1.78
37'-6"	1.00	1.25	2.50	3.00	3.50	4.00
50'-0"	1.78	2.22	4.44	5.33	6.23	7.11
62'-6"	2.78	3.48	6.95	8.34	9.73	11.11
75'-0"	4.00	5.00	10.00	12.00	14.00	16.00


LEGEND
W = Full parabolic offset.
L = Length of parabolic transition.
X = Longitudinal dist. from beginning of flare.
Y = Offset = $W \cdot \frac{X^2}{L^2}$

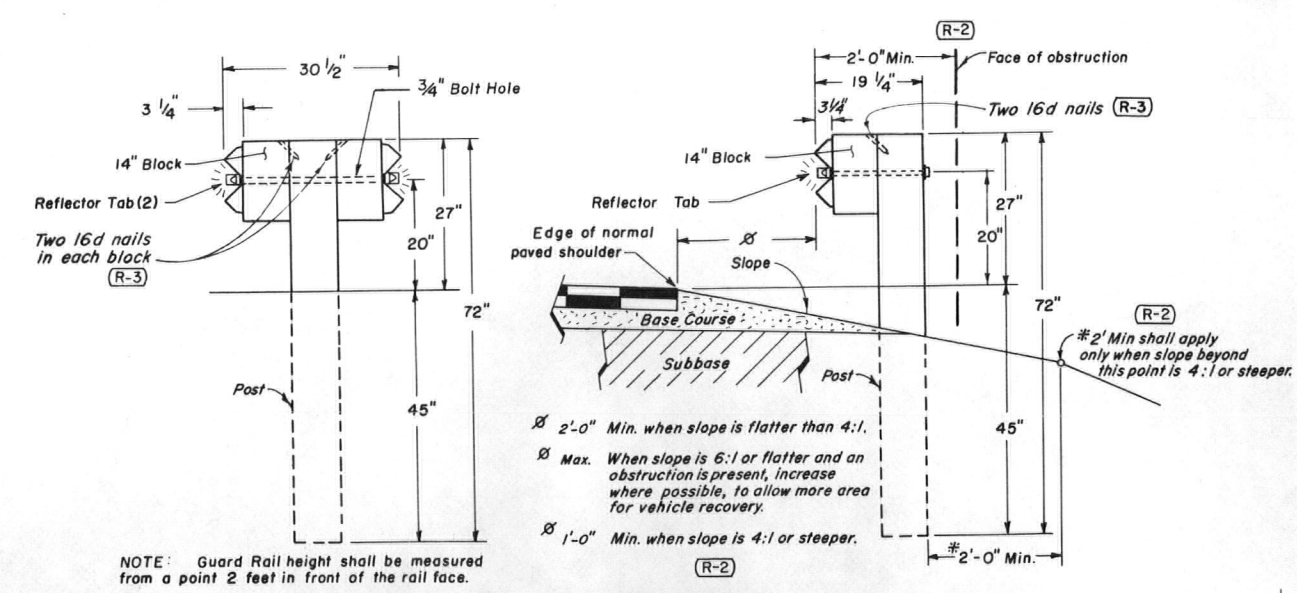

TYPICAL POST INSTALLATIONS
(See Table for Post & Block Cross Section)

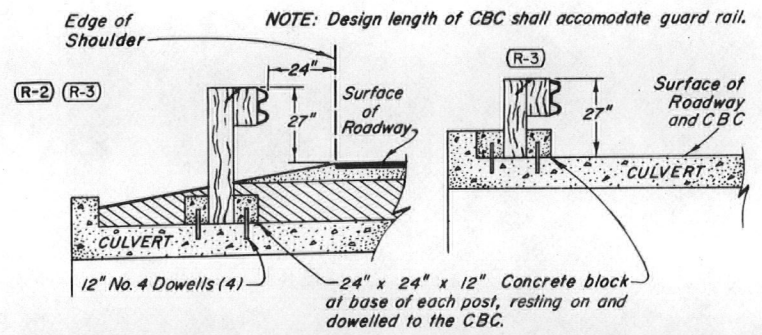


GUARD RAIL ACROSS CONCRETE BOX CULVERT

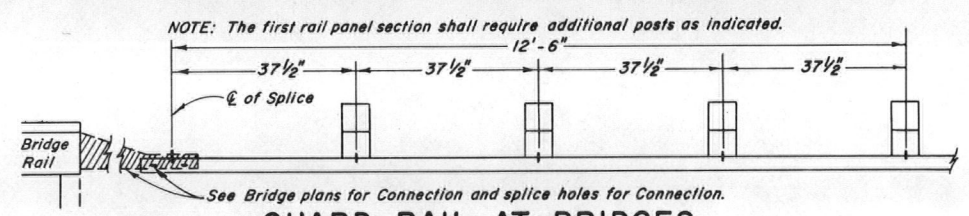

STANDARD M-606-AB


(MARCH 1, 1968)
(SHEET 2)

FEDERAL ROAD REGION NO.	DIVISION	PROJ. NO.	SHEET NO.	TOTAL SHEETS
9	COLORADO			
REVISIONS				
(R-1)	7-10-68	Add end anchorage	M.R.H.	
(R-2)	4-1-69	Bridge exit guard rail note	M.R.H.	
(R-3)	2-18-70	Pay length	M.R.H.	
(R-4)	11-25-70	Timber dimension.	M.R.H.	
(R-5)	6-15-71	Lengthen bridge approach g.r. in 60'+ med.	M.R.H.	
(R-6)	6-25-71	Revision date only.	M.R.H.	

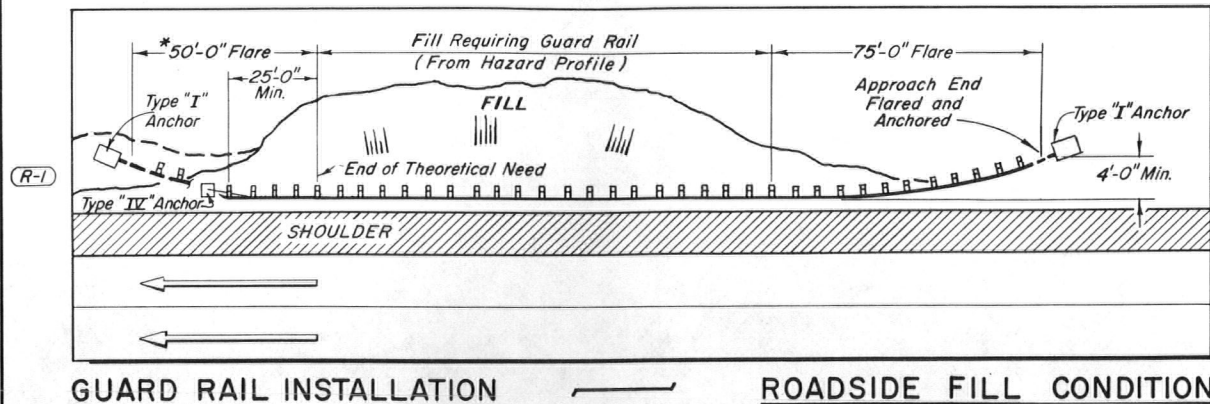


GUARD RAIL INSTALLATION ————— ROADSIDE FILL CONDITION

NOTES:
* 2-Lane Highways — The exit end of Guard Rail shall extend 50 feet past the end of theoretical need and shall be flared and anchored.

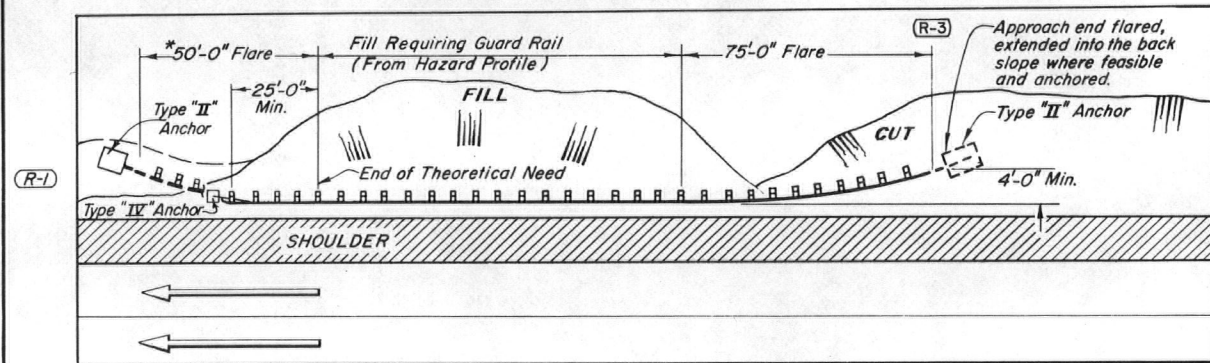

GUARD RAIL INSTALLATION ————— ROADSIDE CUT TO FILL CONDITION

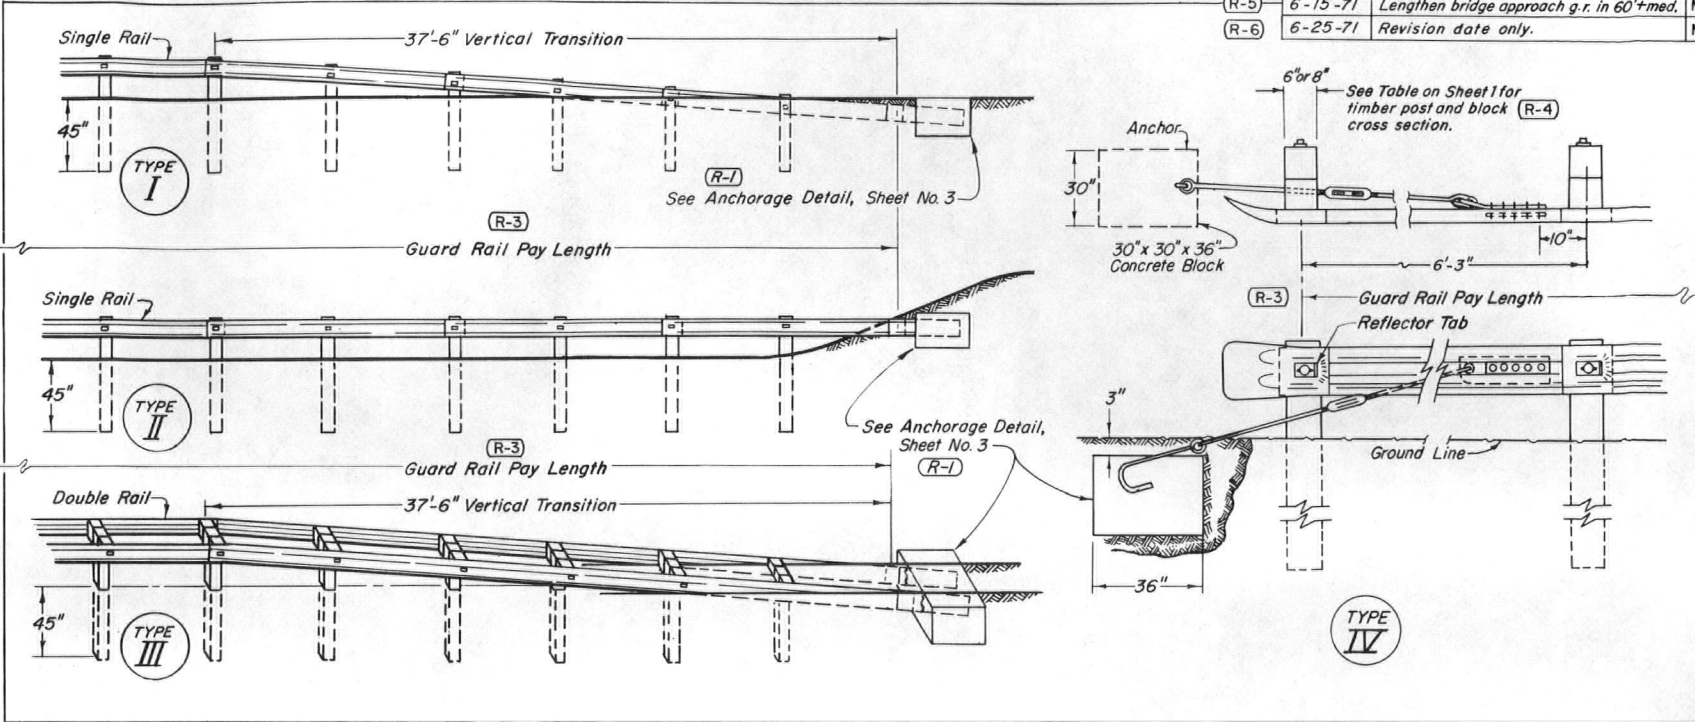

TYPICAL END ANCHORAGE

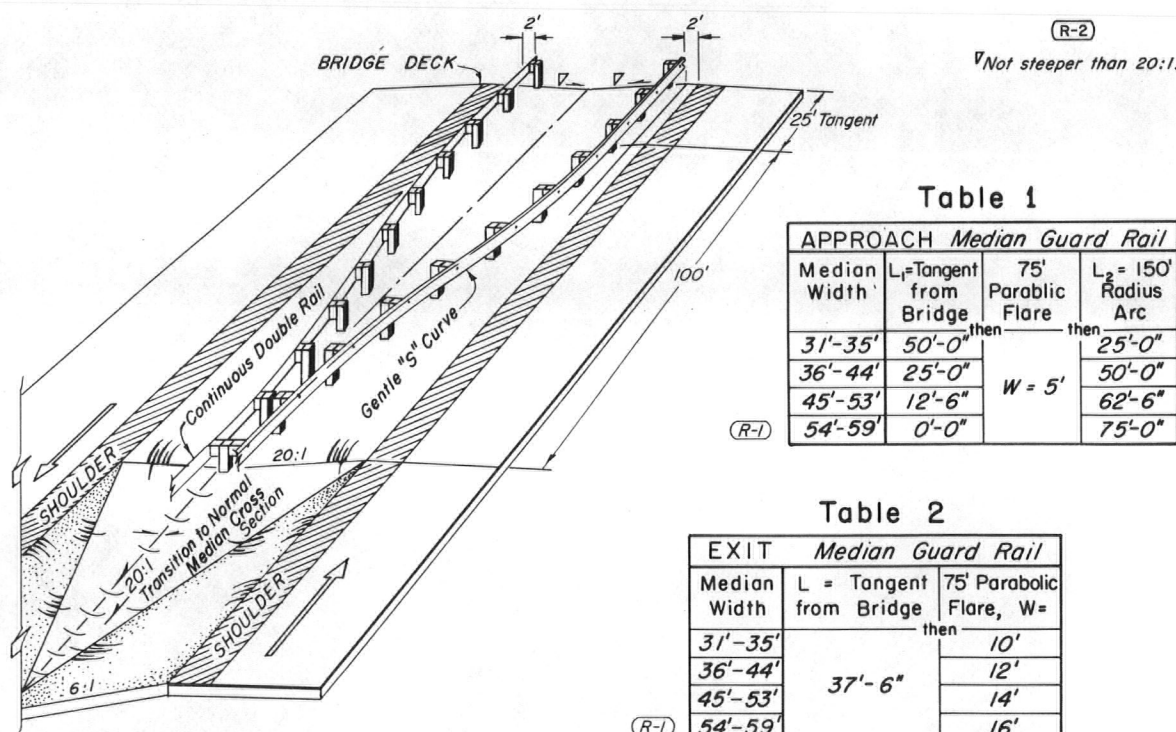


Table 1
APPROACH Median Guard Rail

Median Width	L = Tangent from Bridge	75' Parabolic Flare	L ₂ = 150' Radius Arc
31'-35'	50'-0"	then	25'-0"
36'-44'	25'-0"	then	50'-0"
45'-53'	12'-6"	then	62'-6"
54'-59'	0'-0"	then	75'-0"


W = 5'

Table 2
EXIT Median Guard Rail


Median Width	L = Tangent from Bridge	75' Parabolic Flare, W =
31'-35'	37'-6"	10'
36'-44'	37'-6"	12'
45'-53'	37'-6"	14'
54'-59'	37'-6"	16'

21' to 30' MEDIAN

GUARD RAIL AT BRIDGE APPROACH

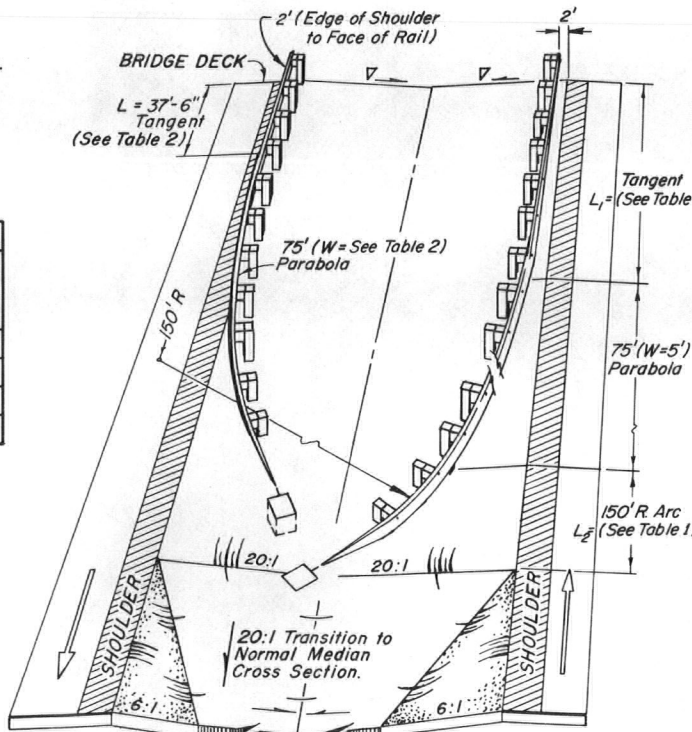

31' to 59' MEDIAN

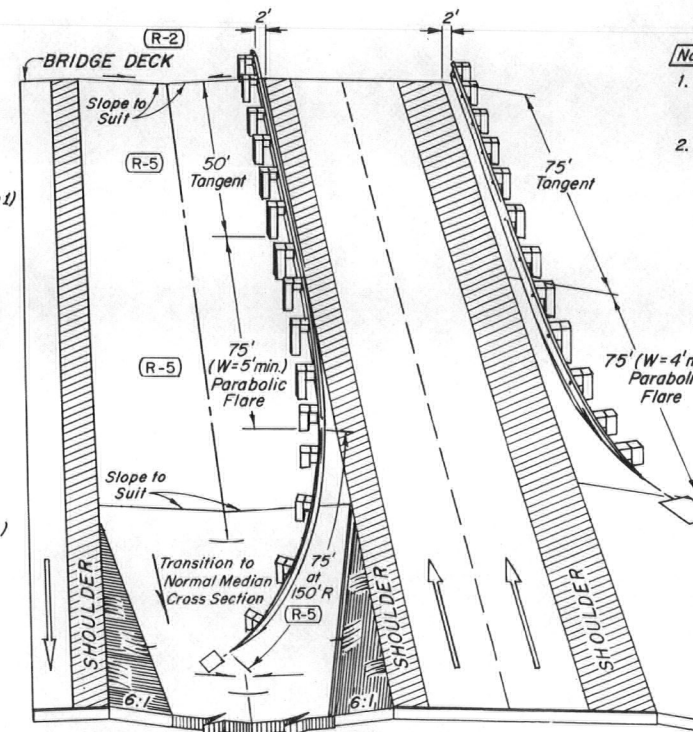

MEDIAN 60' AND OVER

- Note: EXIT FROM BRIDGES:
- Guard rail for OUTSIDE shoulders at exit end of bridges on divided highways to be determined from hazard profile.
 - Guard rail for INSIDE shoulders at exit end of bridges on divided highways with medians 60' and over to be determined from hazard profile.

DEPARTMENT OF HIGHWAYS
STATE OF COLORADO
DIVISION OF HIGHWAYS

**GUARD RAIL
TYPE 3**

Designed by M.R.H. Approved by J.R.B.
Made by J.R.B. Staff Design Engineer
Checked by R.S.M. Date: March 1, 1968

STANDARD M-614-A

(JULY 1, 1965)

FEDERAL ROAD REGION NO.	DISTRICT	PROJECT NO.	SHEET NO.
9	COLORADO		


REVISIONS			
(R-1)	11-15-68	Rev. Dept. Name & Code Nos.	JLS
(R-2)	4-23-69	Rev. Code No. & Notes	JLS

GENERAL NOTES


1. All work shall be done in accordance with the Standard Specifications applicable to the Project.
- (R-2) 2. All signs and sign materials shall conform to the standards set forth in the "Manual on Uniform Traffic Control Devices for All Classes of Streets and Highways" published by the Division of Highways and this standard.
3. The various types and combinations of approved Signs and Beacons for Barricades required for each project shall be governed by field conditions and subject to approval by the Engineer. All traffic controls shall be placed for best visibility and legibility and maintained in good condition at all times. Oversigning is to be avoided.
- (R-2) 4. Painting shall conform with Subsection 508.08 of the Standard Specifications. All skids, braces, planking and wings on all barricades shall be painted with 2 coats of "Exterior Black Paint" on all sides before adding reflective strips. Reflective strips shall be "cut from smooth surface yellow reflective sheeting" of a type approved by the Division.
5. Each barricade rail shall be striped on the face side only with reflective yellow strips slanting downward at a 45° angle toward the side to which traffic is to turn or pass. See "DETAIL OF RAIL AND WING STRIPING."
6. When barricades are designated on plans the portion of the posts below ground line shall be painted either be dipped in or painted with hot creosote oil. The portion of the post above ground line shall be painted with 2 coats of "Exterior Black Paint."
7. All skids, braces, and posts shall be nailed together with No. 20d nails. All screws, bolts, nuts, and washers shall be galvanized or cadmium plated. Skids (bases) of movable barricades shall be weighted where necessary to provide stability.
- (R-2) 8. All timber shall be Standard Grade or better, S4S, Douglas Fir or Larch, as described in the 1965 Standard Grading Rules published by the Western Wood Products Association, and shall conform to paragraph 123c for the rails and paragraphs 122c and 125c for the posts.
9. Detachable extension wings for bypassing of construction equipment are permitted. "W" is variable, length shall be adequate to provide closing of borrow pit and/or shoulder as required.
- (R-2) 10. Alternate materials or other reflective elements on Traffic signs or Barricades will be permitted only after approval of such material by the Division in writing.
11. A Flashing Beacon for use on Barricades is a section of a standard traffic signal head or a similar-type device having a yellow lens in the face, which is illuminated by intermittent flashes. Where commercial power is not available, the beacon may be adapted to operate from storage batteries. Each signal unit lens shall have a visible diameter of not less than 8 inches. Each unit complete shall be of such design as to render the lens when illuminated clearly visible to traffic facing the signal at all distances up to 1000 feet under all atmospheric conditions except dense fog. The color of the yellow lens for caution shall be in accordance with Technical Report No. 1 of the Institute of Traffic Engineers. All beacon flashers shall be equipped with filters for suppression of radio interference. The illuminating element in a flashing yellow beacon shall be flashed at a rate of not less than 50 times nor more than 60 times per minute. The illuminated period of each flash shall be not less than half and not more than two-thirds of the total cycle. The use of Flashing Beacons will be governed by field conditions. Flashing Beacons when warranted generally should be operated continuously throughout the 24 hours of the day. Warrant for Flashing Beacons may be found in Sec. 3G of the "Manual on Uniform Traffic Control Devices for Streets and Highways" published by the U.S. Department of Commerce, Bureau of Public Roads, June, 1961 (or latest revision).
12. Flashers are portable, power-operated, lens-directed, enclosed lights, illuminated by rapid intermittent flashes of short duration. Flashers may be used in connection with barricades when approved by the Engineer. An array of random flashers which tends to obscure rather than delineate the traveled way will not be permitted. The use of flashers on a job will be governed by Sec. 5D of the "Manual on Uniform Traffic Control Devices for Streets and Highways" published by the U.S. Department of Commerce, Bureau of Public Roads, June, 1961 (or latest revision). The color of the light emitted by a flasher shall be yellow.
13. Flashing Beacons and Flashers, when used, shall be positioned above the top rail of the barricades to produce the most effective results.
14. Barricades used as "Traffic Controls for Highway Construction" are not to be paid for separately.
15. Barricades will be paid for separately when designated on plans as bid items.
16. For additional general information on control of traffic through work areas refer to the "Manual on Uniform Traffic Control Devices for Streets and Highway", Part V, published by the U.S. Department of Commerce, Bureau of Public Roads, June, 1961 (or latest revision).

CLASS I BARRICADES
(3 RAILS)

MOVABLE





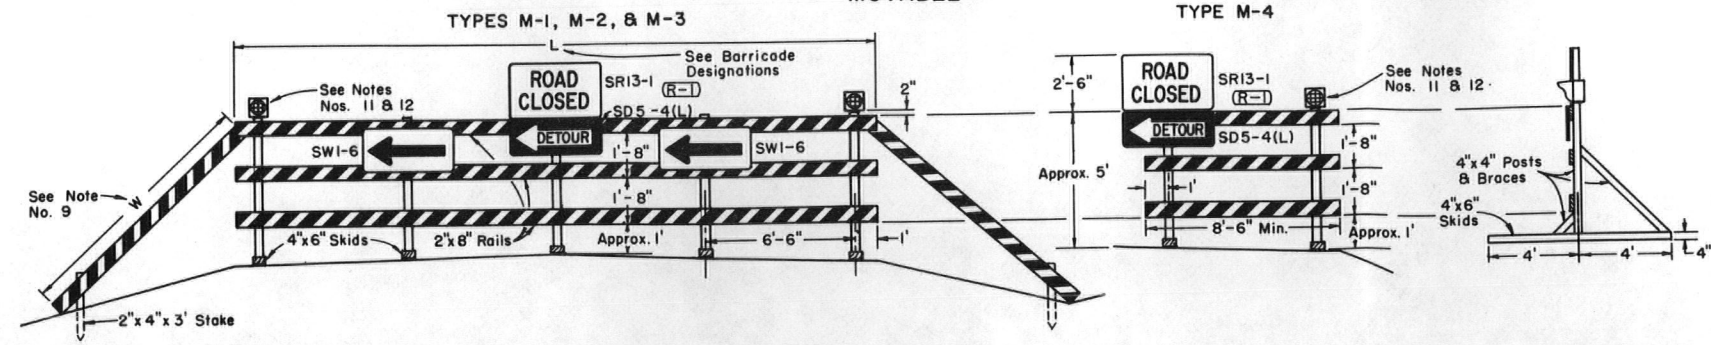


FIXED

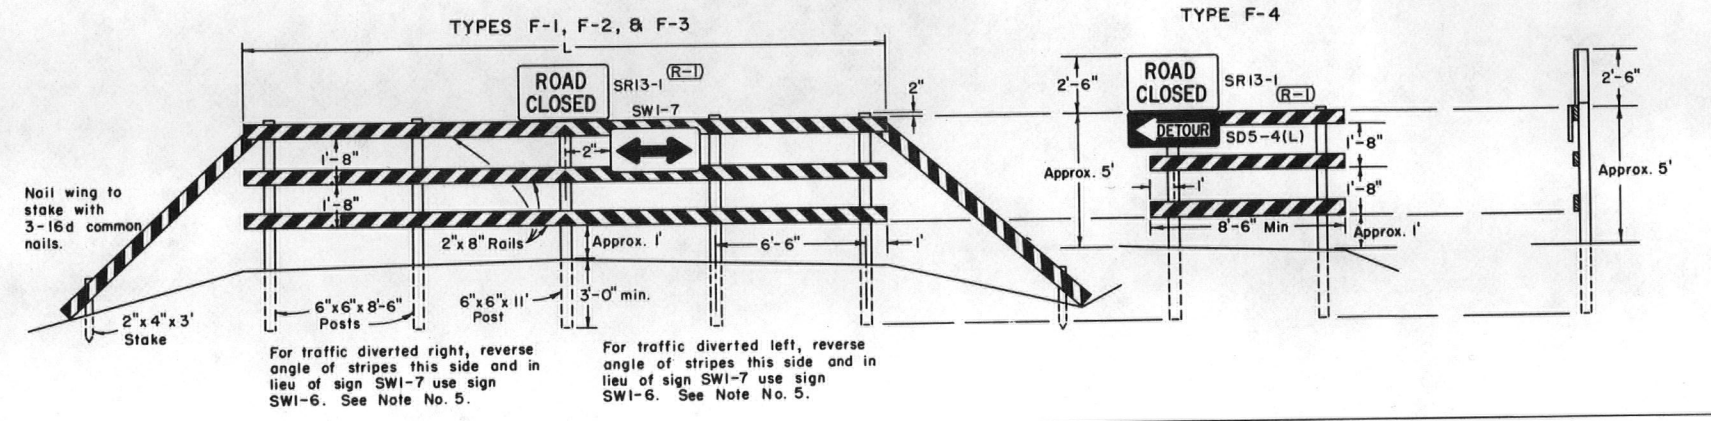

CLASS II BARRICADE
(1 RAIL)

FIXED
TYPE F-6

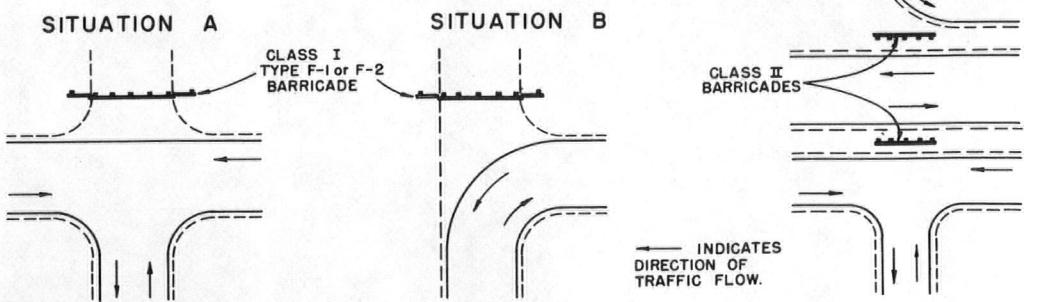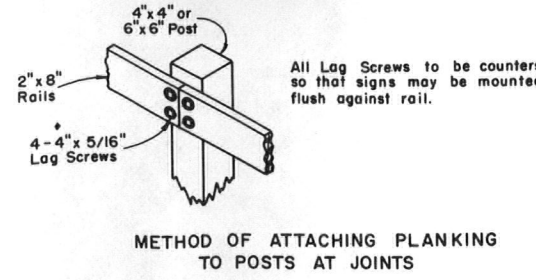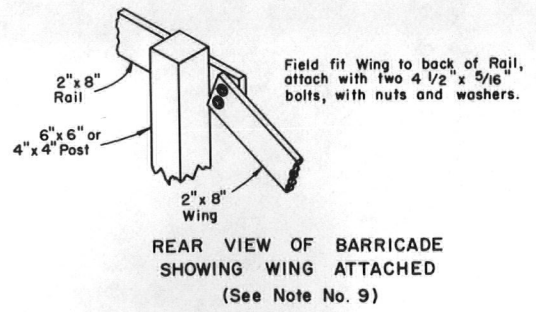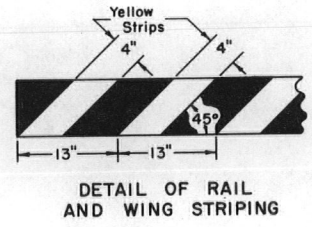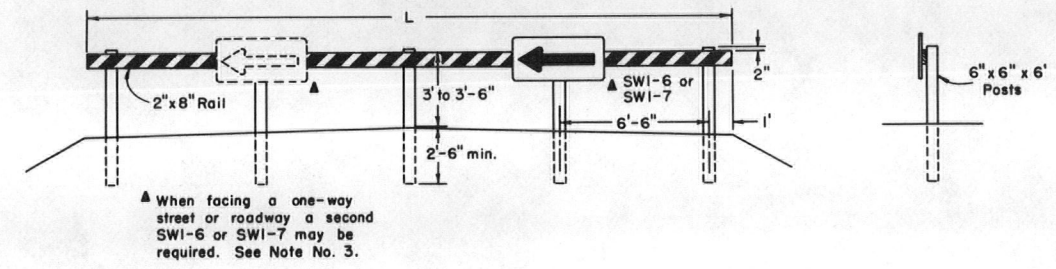

BARRICADE DESIGNATIONS						
Class	Type	Roadway Width	L	Description		
(R-1)	I	M-1	F-1	26'-34'	28'	Barricade complete with SR13-1 sign and SW1-6 or SW1-7 signs as required.
(R-2)	I	M-2	F-2	35'-44'	41'	Barricade complete with SR13-1 sign and SW1-6 or SW1-7 signs as required.
(R-1)	I	M-3	F-3	Variable	28'	Barricade (without extension wings) complete with SR13-1 sign and SW1-6 or SW1-7 signs as required.
	I	M-4	F-4	Variable	Variable 8'-6" min.	Wing Barricade (signs only as appropriate).
	II	-	F-6	Variable	28'	Barricade complete with appropriate signs.

DEPARTMENT OF HIGHWAYS
STATE OF COLORADO
DIVISION OF HIGHWAYS

TIMBER
BARRICADES

Designed By: D.R.W.
Made By: JLS
Checked By: J.B.


Approved By:
Date: JULY 1, 1965

STANDARD M-614-IC


JULY 5, 1968
(SHEET 1 OF 2 SHEETS)

FEDERAL ROAD REGION NO.	DISTRICT	PROJ. NO.	SHEET NO.	TOTAL SHEETS
9	COLORADO			

REVISIONS			
(R-1)	7-26-68	Rev. Legend and Notes	G.W.F.
(R-2)	5-20-69	Rev. Lateral Placement	J. J. B.
(R-3)	9-25-70	Rev. Legend	J. J. B.

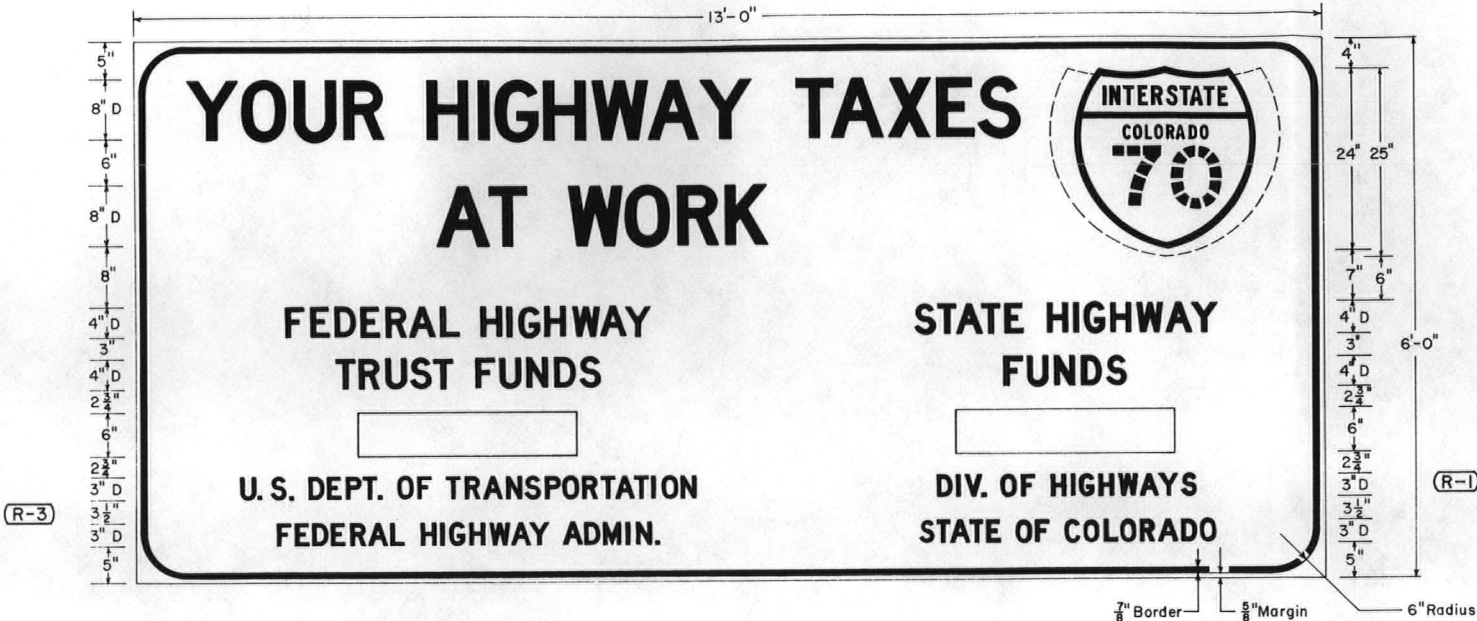


ALTERNATE LEGEND
4" D FEDERAL FUNDS

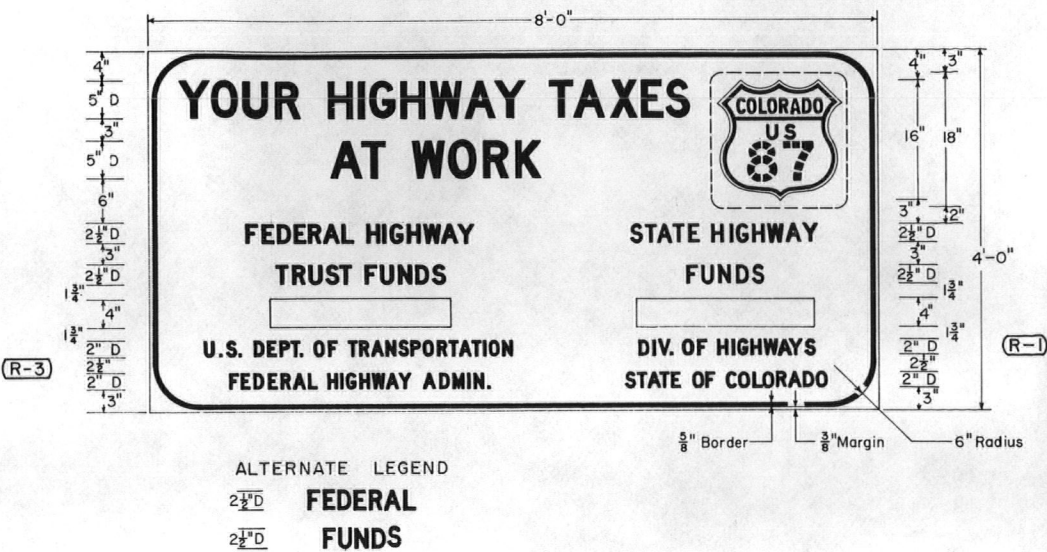


ALTERNATE LEGEND
2 1/2" D FEDERAL FUNDS

FABRICATION DETAILS

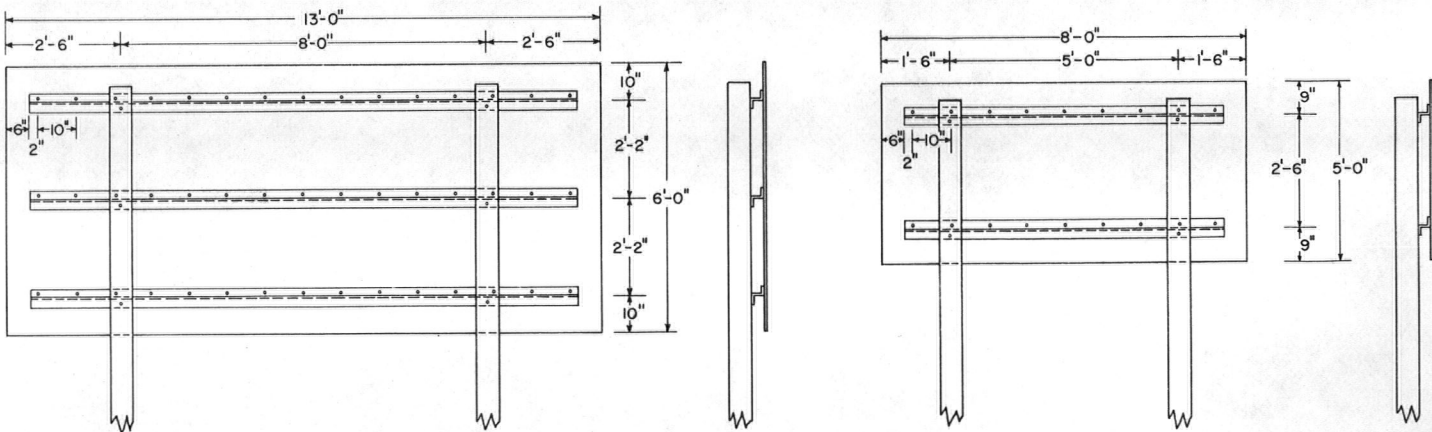


"AMOUNT OF FUNDS" PLAQUE DETAILS

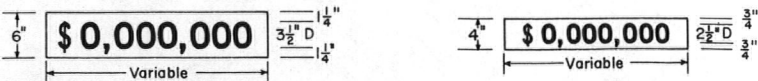

GENERAL NOTES

1. These signs shall be furnished and installed by state forces.
2. All work shall be done in accordance with Standard Specifications applicable to the Project.
3. Signs are to be placed facing traffic approaching the Project. They shall be installed at a location where they will not obscure or detract from the effectiveness of other official signs.
4. The lateral placement may be reduced to a minimum of 2 ft. outside of the shoulder edge where necessary to fit field conditions.
5. When these signs are used on Beautification Projects, the words "HIGHWAY" and "TRUST" in lines 3 and 4 shall be deleted and the words "FEDERAL" and "FUNDS" shall be used in accordance with the spacing as shown under "Alternate Legend".
6. Sign panel shall be fabricated with 3/4" plywood.
7. Route Marker plaques and "Amount of Funds" plaques shall be sheet aluminum 0.080" min. thickness.
8. Signs shall have a screen processed black legend and border on a plain white background. "Amount of Funds" plaques shall have a screen processed black legend on a plain white background.
9. Route Marker plaques shall be plain as indicated on the applicable standards.
10. Backing zeos shall be 3" x 2 3/4" x 1/4". Steel zeos shall weigh 6.7 lbs. per ft. and aluminum zeos shall be of 6061-T6 alloy weighing 2.33 lbs. per ft.
11. Posts shall be 6" x 6", S4S timber, painted white.
12. Each timber post shall be provided with two 2" diameter holes through the neutral axis, one at 6" and one at 18" above the ground level. The inside portion of each 2" diameter hole shall be painted white.
13. Panels shall be fastened to backing zeos with 1/4" thrust head lockbolt fasteners.
14. Backing zeos shall be fastened to posts with 3/8" machine bolts.
15. Route Marker plaques and "Amount of Funds" plaques shall be fastened to the sign panels with 5/8" #9 round head wood screws.
16. Exposed lockbolt fastener heads and wood screw heads on the face of the sign shall be dipped or painted to match the surrounding color.
17. The underground portion of each timber post shall be treated with creosote.
18. Where a third governmental agency is shown as participating, its official name should be included centrally in lines 6, 7, and 8.
19. It will not be necessary to change DEPT. to DIV. on any existing signs.

INSTALLATION DETAIL

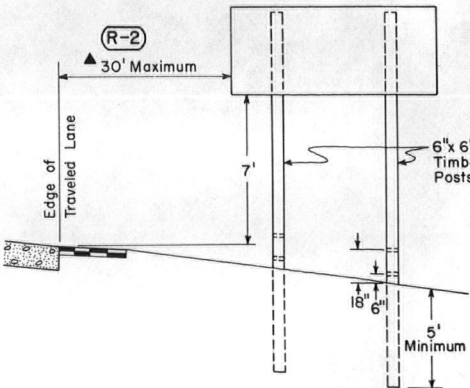

DEPARTMENT OF HIGHWAYS
STATE OF COLORADO
DIVISION OF HIGHWAYS
STANDARD
CONSTRUCTION
IDENTIFICATION
SIGNS


Designed By: J.L.S. Approved By: J.L.S.
Made By: F.J.B. Traffic Engineer
Checked By: G.W.F. Date: July 5, 1968

STANDARD M-614-IC

JULY 5, 1968
(SHEET 2 OF 2 SHEETS)

FEDERAL ROAD REGION NO.	DISTRICT	PROJ. NO.	SHEET NO.	TOTAL SHEETS
9	COLORADO			

REVISIONS			
R-1	7-26-68	Rev. Legend	G.W.F.
R-2	5-20-69	Rev. Lateral Placement	J.J.B.
R-3	9-25-70	Rev. Legend	J.J.B.

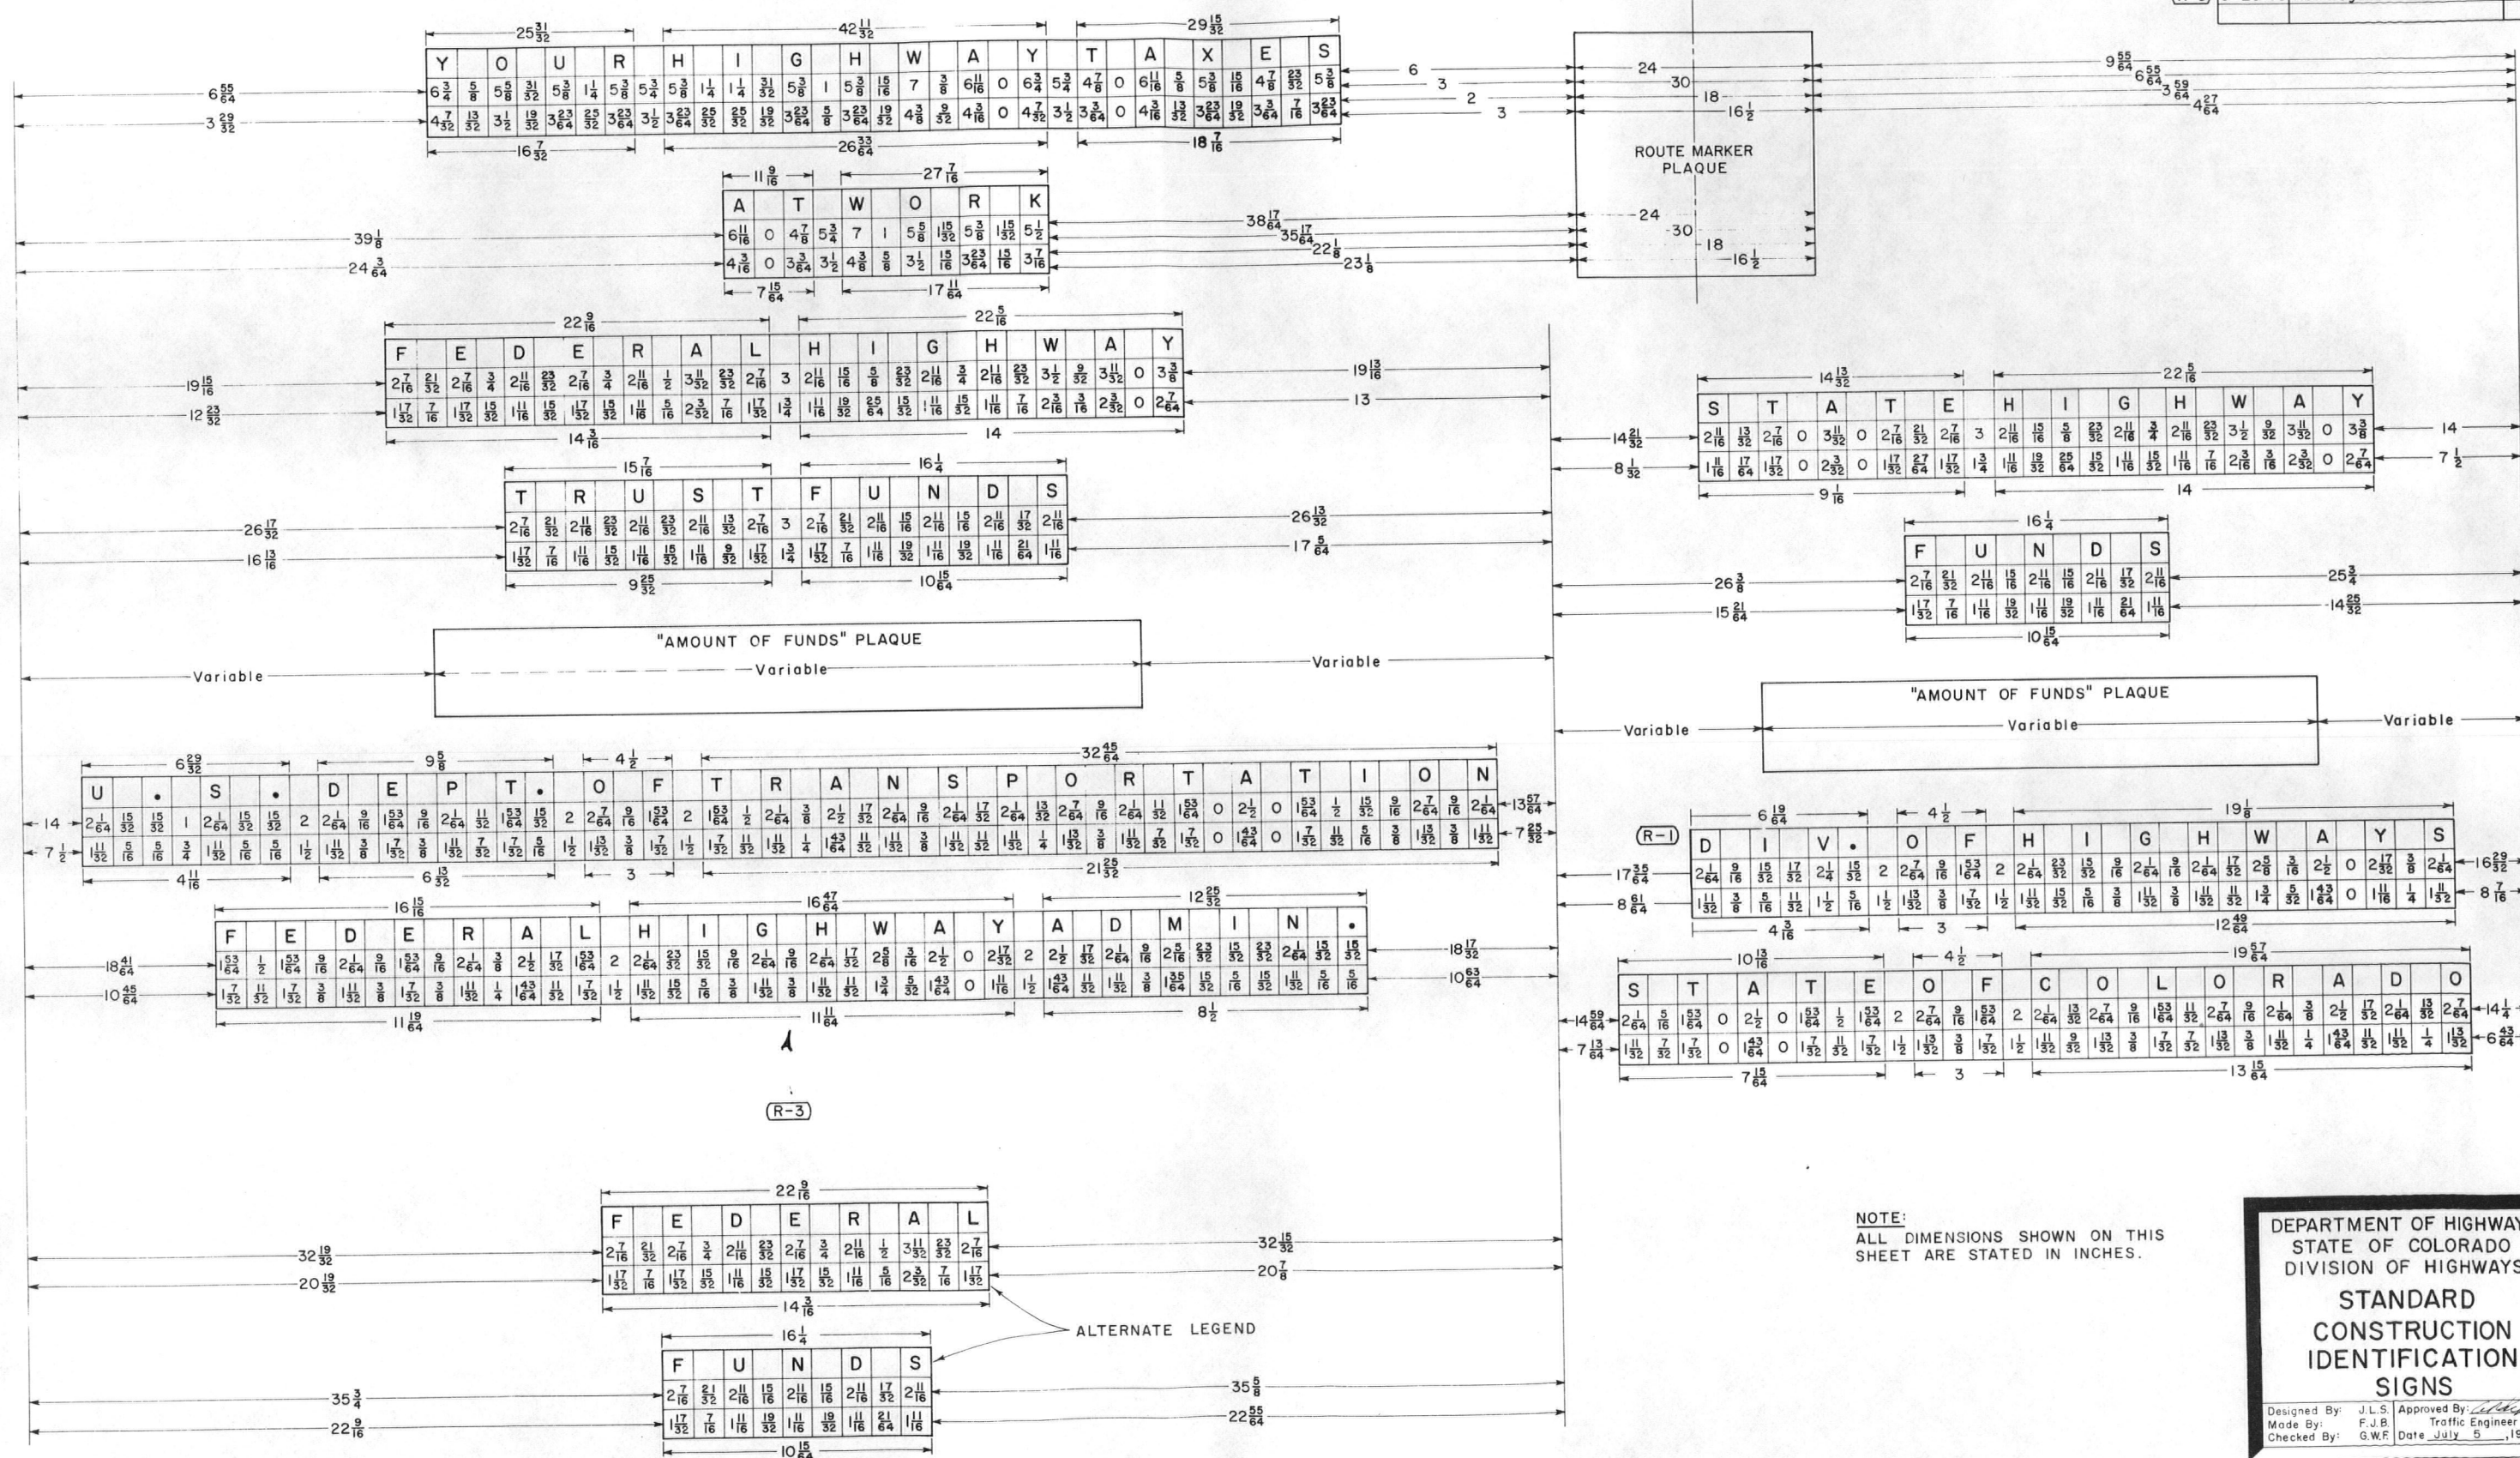

NOTE:
ALL DIMENSIONS SHOWN ON THIS
SHEET ARE STATED IN INCHES.


DEPARTMENT OF HIGHWAYS
STATE OF COLORADO
DIVISION OF HIGHWAYS

**STANDARD
CONSTRUCTION
IDENTIFICATION
SIGNS**

Designed By: J.L.S. Approved By: *[Signature]*
Made By: F.J.B. Traffic Engineer
Checked By: G.W.F. Date July 5, 1968

(JULY 1, 1965)

NOTE:
See Sheet 2 for detailed drawings of signs.
See Sheet 3 for General Notes applicable to
Sheets 1 and 2.

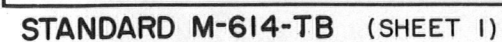

STANDARD M-614-TB

(SHEET 2 OF 3 SHEETS)

(JULY 1, 1965)






WARNING SIGNS

See Note No. 10

FEDERAL ROAD REGION NO.	DIVISION	PROJECT NO.	SHEET NO.
9	COLORADO		
REVISIONS			
(R-1)	7-12-67		M.R.H.
(R-2)	7-8-68	Rev. Code No. & Dept. Name	G.W.F.
(R-3)	12-24-68	Added Notes	J.L.S.

REGULATORY SIGNS




See Note No. 9

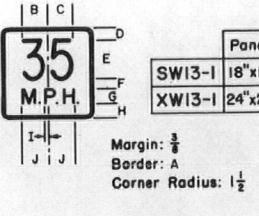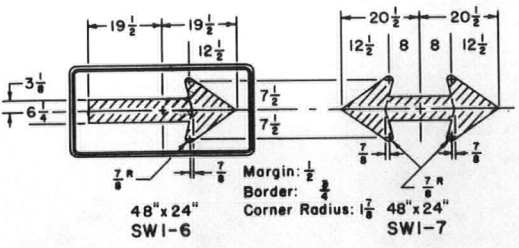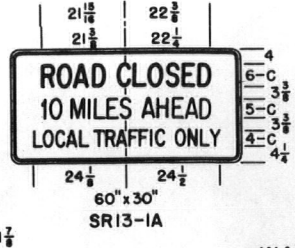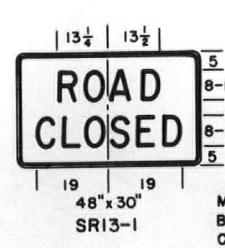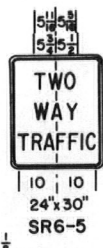

Panel	A	B	C	D	E	F	G	H	I	J
SW13-1	18" x 18"	3/8"	5/8"	5/8"	2 1/2"	8-C	2	3-E	2 3/4"	5 3/8"
XW13-1	24" x 24"	5/8"	6 3/8"	3 1/2"	10-C	2 1/2"	4-E	4	15 1/8"	6 7/8"


WARNING SIGNS

See Note No. 10

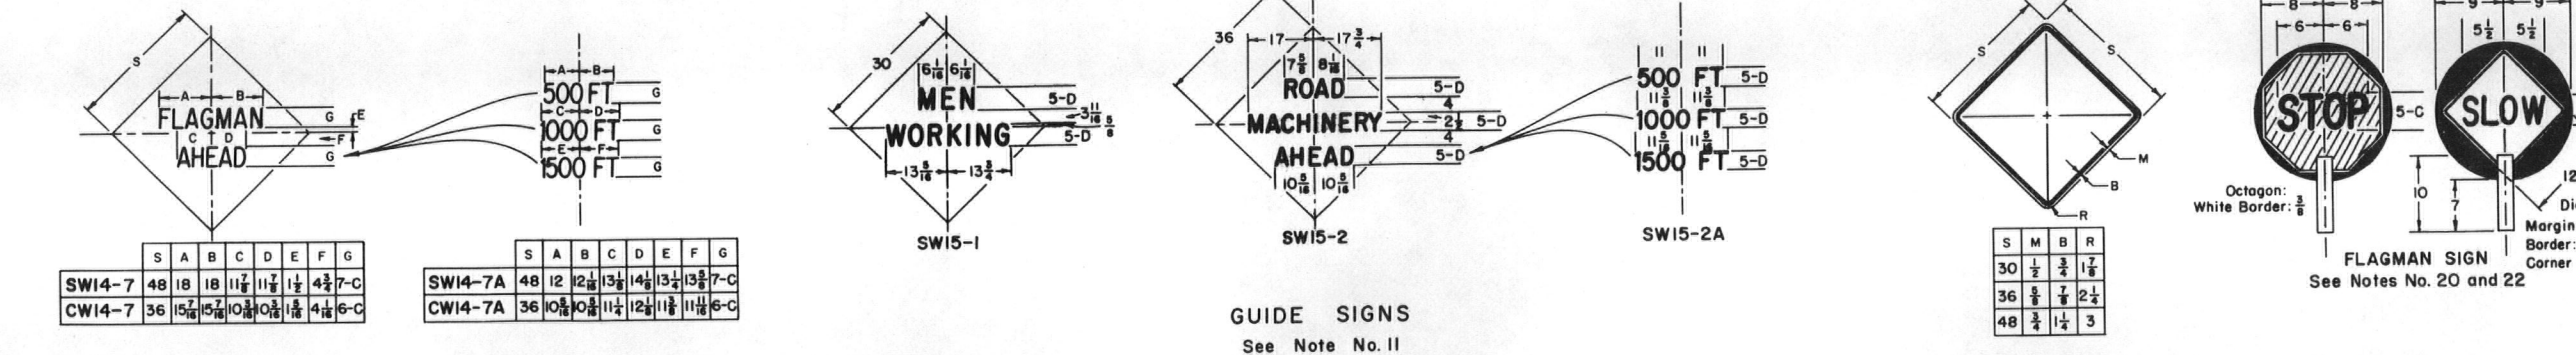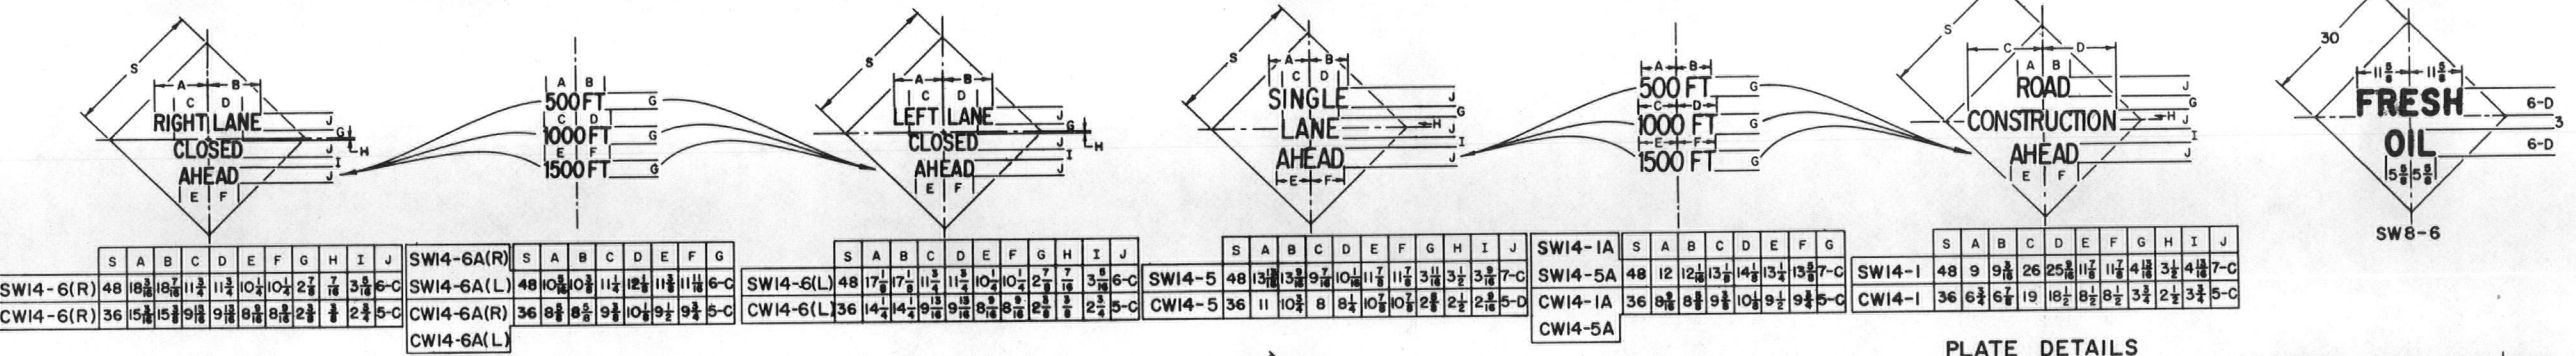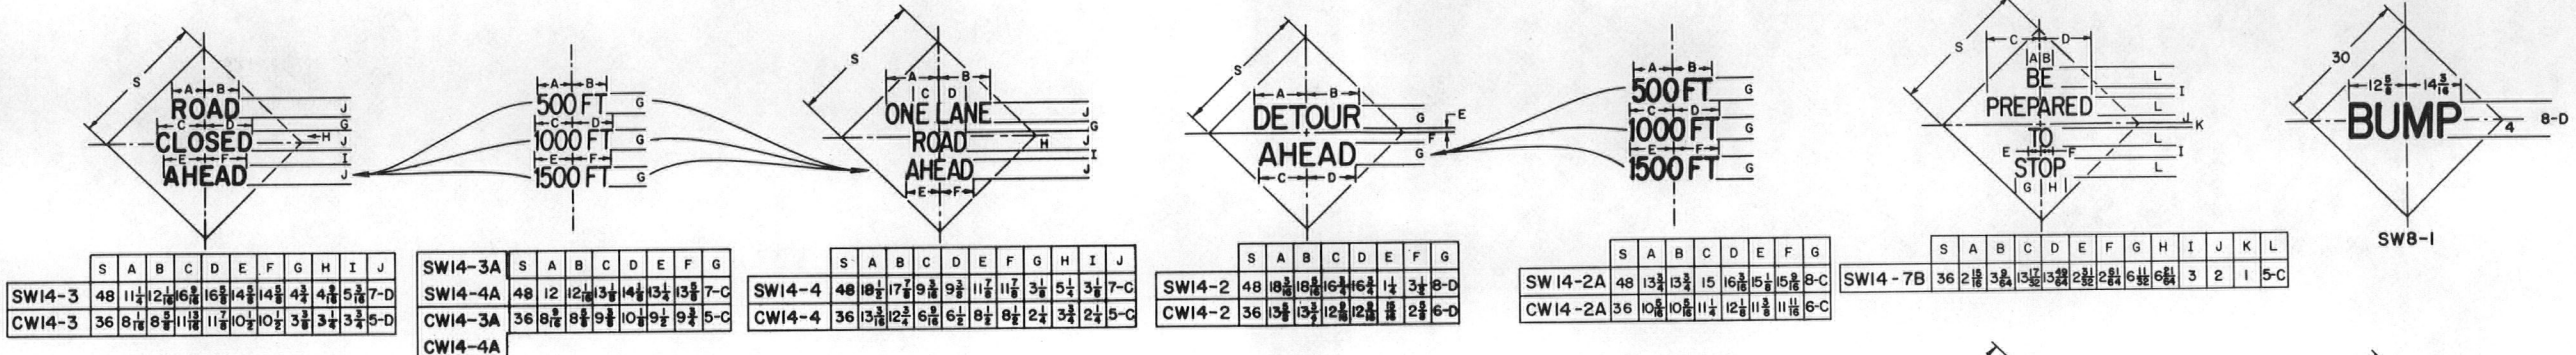

GUIDE SIGNS

See Note No. 11

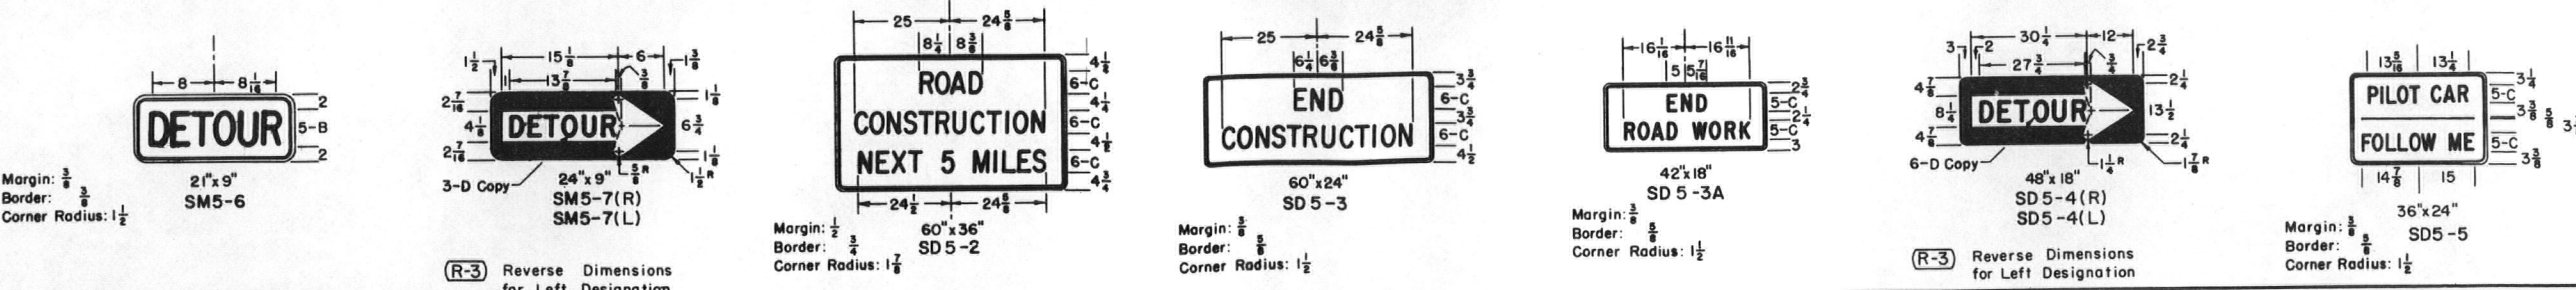

NOTES:
SEE SHEET 1 FOR TYPICAL SIGNING AND SIGN PLACEMENT.
SEE SHEET 3 FOR GENERAL NOTES APPLICABLE TO SHEETS 1 AND 2.
ALL DIMENSIONS THAT ARE NOT LABELED ARE IN INCHES.

DEPARTMENT OF HIGHWAYS
STATE OF COLORADO
DIVISION OF HIGHWAYS
TRAFFIC SIGNING FOR HIGHWAY CONSTRUCTION
Designed By: D.R.W.
Made By: H.B.D.
Checked By: J.B.
Approved By: [Signature]
Traffic Engineer
Date: AUGUST 9, 1965

STANDARD M-614-TB
(SHEET 3 OF 3 SHEETS)
(JULY 1, 1965)

FEDERAL ROAD REGION NO.	DIVISION	PROJECT NO.	SHEET NO.
9	COLORADO		

REVISIONS			
(R-1)	7-12-67	Added Note 23	G.W.F.
(R-2)	7-8-68	Rev. Note 23 & Dept. Name -	
		Deleted Note	G.W.F.
(R-3)	12-24-68	Rev. Note No. 18	J.L.S.

GENERAL NOTES

1. All work shall be done in accordance with: (a) the Standard Specifications applicable to the Project, and (b) the "Manual on Uniform Traffic Control Devices for all Classes of Streets and Highways" published by the Department of Highways.

2. Where traffic is maintained through or over any part of the Project the Contractor will be required to mark all hazards within the limits of the Project (including connecting roads) with well-maintained Barricades, Warning, and Guide Signs. All Barricades and Signs shall be moved, added to, changed or removed as required during the progress of construction and removed entirely when the Project is completed.

3. Where traffic is prohibited from the Project the Detour will be marked by the Department except that the Contractor shall provide, erect and maintain Barricades, complete, (when required) at the ends of the Project, ends of the Detour and connecting roads. All U. S. or State Route Markers required for the Project will be furnished and installed by the Department. The location and positioning of Warning Signs, Barricades, and Regulatory Signs shall be as recommended by the appropriate District Engineering Forces of the Department.

4. Work on the Project shall not be started until all required signs are in place and approved by the Engineer. Where speed control appears necessary such speed control shall be requested from the Engineer by the Contractor. Control of speed through a construction zone may be achieved by Advisory Speed plates in conjunction with Warning Signs (SW13-1 for use with 30" Warning Signs and XW13-1 for use with 36" and 48" Warning Signs). The Advisory Speed plate is to be posted only at those locations where the safe speed is lower than the imposed Regulatory speed limit.

5. All Signs and Barricades shall be placed for best visibility and legibility, maintained in good condition and kept clean and free of dirt at all times. Contractor's and Engineer's vehicles and equipment must be parked so that signs and barricades are visible to approaching traffic at all times.

6. Where two identical signs are used for dual posting they are to be staggered on the two sides of the roadway for a minimum distance of 75' to avoid a tunneling effect.

7. Examples for marking Projects, as shown on Sheet 1, are typical of signs required and are subject to alteration to fit actual conditions encountered in the field. Locations for control devices are to be staked by the Engineer. In all cases Warning signs are to be placed well in advance of the hazard, the distance depending on topography and existing approach speeds. Additional markings and any special signs required for the guidance and protection of traffic will be placed as required on the Project at the Contractor's expense.

8. Desirable sizes for signs are shown on Sheet 1 of this Standard. Larger or smaller signs shall be used where warranted. Detailed dimensions for signs normally used in connection with construction are shown on Sheet 2 of this Standard. For information on standard roadway signs not detailed on this Standard see the "Manual on Uniform Traffic Control Devices for all Classes of Streets and Highways" published by the Department of Highways.

9. Signs with the prefix "R" in the sign code are Regulatory signs and as such impose legal compulsions or restrictions on drivers and should only be used as authorized by the Engineer.

10. Signs with the prefix "W" in the sign code are Warning signs and are used to alert traffic to existing or potentially hazardous conditions.

11. Signs with the prefix "D" or "M" in the sign code are Guide signs. Those with the prefix "D" convey general information and those with the prefix "M" are used for marking the traffic route.

12. All signs shall be reflectorized unless otherwise specified on plans. Regulatory and Guide signs (unless otherwise specified) shall have a screen processed black legend and border on a white flexible reflective sheeting, non-exposed lens background. The back side of Regulatory and Guide signs shall be painted with two coats of "Exterior Sign White Paint." Warning signs shall have a screen processed black legend and border on a highway yellow flexible reflective sheeting, non-exposed lens background. The back side of Warning signs shall be painted with two coats of "Federal Yellow Synthetic Sign Enamel."

13. Painting for wood surfaces shall conform with Section 508 of the Standard Specifications.

14. Posts for regulatory, warning, and guide signs will normally be 4" x 4" or 6" x 6" and shall conform to the Standard Specifications for Untreated Timber-S4S. Timber shall conform to Construction grade Paragraph 123B or 125B of Standard No. 15 Grading & Dressing Rules for West Coast Douglas Fir (1956) or Dense Structural 58 and LL Structural 58 Paragraph 284 or 285 of 1956 Grading Rules for Southern Pine. Posts shall be painted with one coat of "White Wood Primer" and one coat of "Outside White Paint."
15. Sign panels furnished by the Contractor for use only during construction may be fabricated from plywood, aluminum, steel or other suitable material but shall be stable and durable enough to meet other requirements of this Standard.

16. All material shall be sound and durable. Barricades, signs, symbols, and lettering shall be of good workmanship. Uneven lettering will not be accepted.

17. Alternate methods of processing signs or the substitution of symbols or other reflecting elements for painted symbols will be permitted only after approval by the Department.

(R-3) 18. Lanterns and Torches - Lanterns, with red globes, shall be used only in low speed urban areas. Open-flame torches shall not be used under any circumstances.

19. Barricades, Flashing Beacons and Flashers - Refer to appropriate "M" Standard (Timber Barricades) for details.

20. Flagman Sign - This sign shall have a black painted background on both sides to form a contrast for the octagonal Stop sign and the diamond Warning sign. The "STOP" sign shall be fabricated by reverse screen process using transparent red paint on smooth surface silver reflective sheeting. The "SLOW" side of the Flagman Sign shall be black process paint on smooth surface yellow reflective sheeting. Handle to be grooved on one side to indicate reading of sign to Flagman.


21. Sign "A": This is the first advance warning sign and shall be placed 1,500 feet ahead of Barricade or project terminal. Postings are required on both sides of the roadway on divided highways. Dual posting is required where warranted on two-lane, two-way highways.
Sign "B": This is the second advance warning sign and shall be placed 1,000 feet ahead of barricade or project terminal. Postings are required on both sides of the roadway on divided highways and singly on two-lane, two-way highways.
Sign "C": This is the third advance warning sign in cases where barricades are used and shall be placed 500 to 750 feet ahead of barricade or potentially hazardous condition. Postings are required on both sides of the roadway on divided highways and singly on two-lane, two-way highways.
Sign "D": SD5-2 - This sign shall be placed to mark the beginning of a Project of more than 2 miles in extent, where traffic is maintained through the project. It shall be placed singly and near the beginning of construction.
Sign "E": SD5-3 - This sign shall be placed to mark the end of the Project. It shall be placed singly and may be placed opposite barricade if desirable.
Sign "F": Construction identification signs shall be furnished and installed by the Department on all Federal-Aid and Forest Highway Projects where actual construction is in progress and visible to highway users. These signs should be located so as not to obscure or detract from the effectiveness of other official signs. Where two or more projects are contiguous the appropriate data may be included in one set of signs. Refer to appropriate "M" Standard (Identification Signs) for sign details.
Signs A through F shall be furnished, installed and maintained by the Department.

22. When Flags are used in lieu of the Flagman Sign, they shall be a minimum of 18"x18", made of a good grade of bright red material, and fastened securely to a staff of approximately 3 foot length. The free edge should be weighted to insure that the flag will hang vertically, even in heavy winds.

(R-1) 23. Each 6"x6" timber sign post shall be provided with two 2" diameter holes through the neutral axis normal to the roadway, one hole at 6" and one hole at 18" above the ground level. The 4"x4" timber posts shall not be provided with any type of break-away device. The inside portion of each 2" diameter hole shall be painted white. The underground portion of each timber post shall be treated with creosote.
- (R-2)
- (R-2)

DEPARTMENT OF HIGHWAYS
STATE OF COLORADO
DIVISION OF HIGHWAYS
TRAFFIC SIGNING
FOR HIGHWAY
CONSTRUCTION

Designed By: D.R.W.
Made By: J.L.S.
Checked By: J.B.

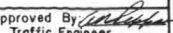
Approved By: 
Traffic Engineer
Date: AUGUST 9, 1965

STANDARD S-614-29B


(SHEET 1 OF 2 SHEETS)

AUGUST 18, 1971

TYPICAL ENTRANCE AND EXIT RAMP MARKINGS

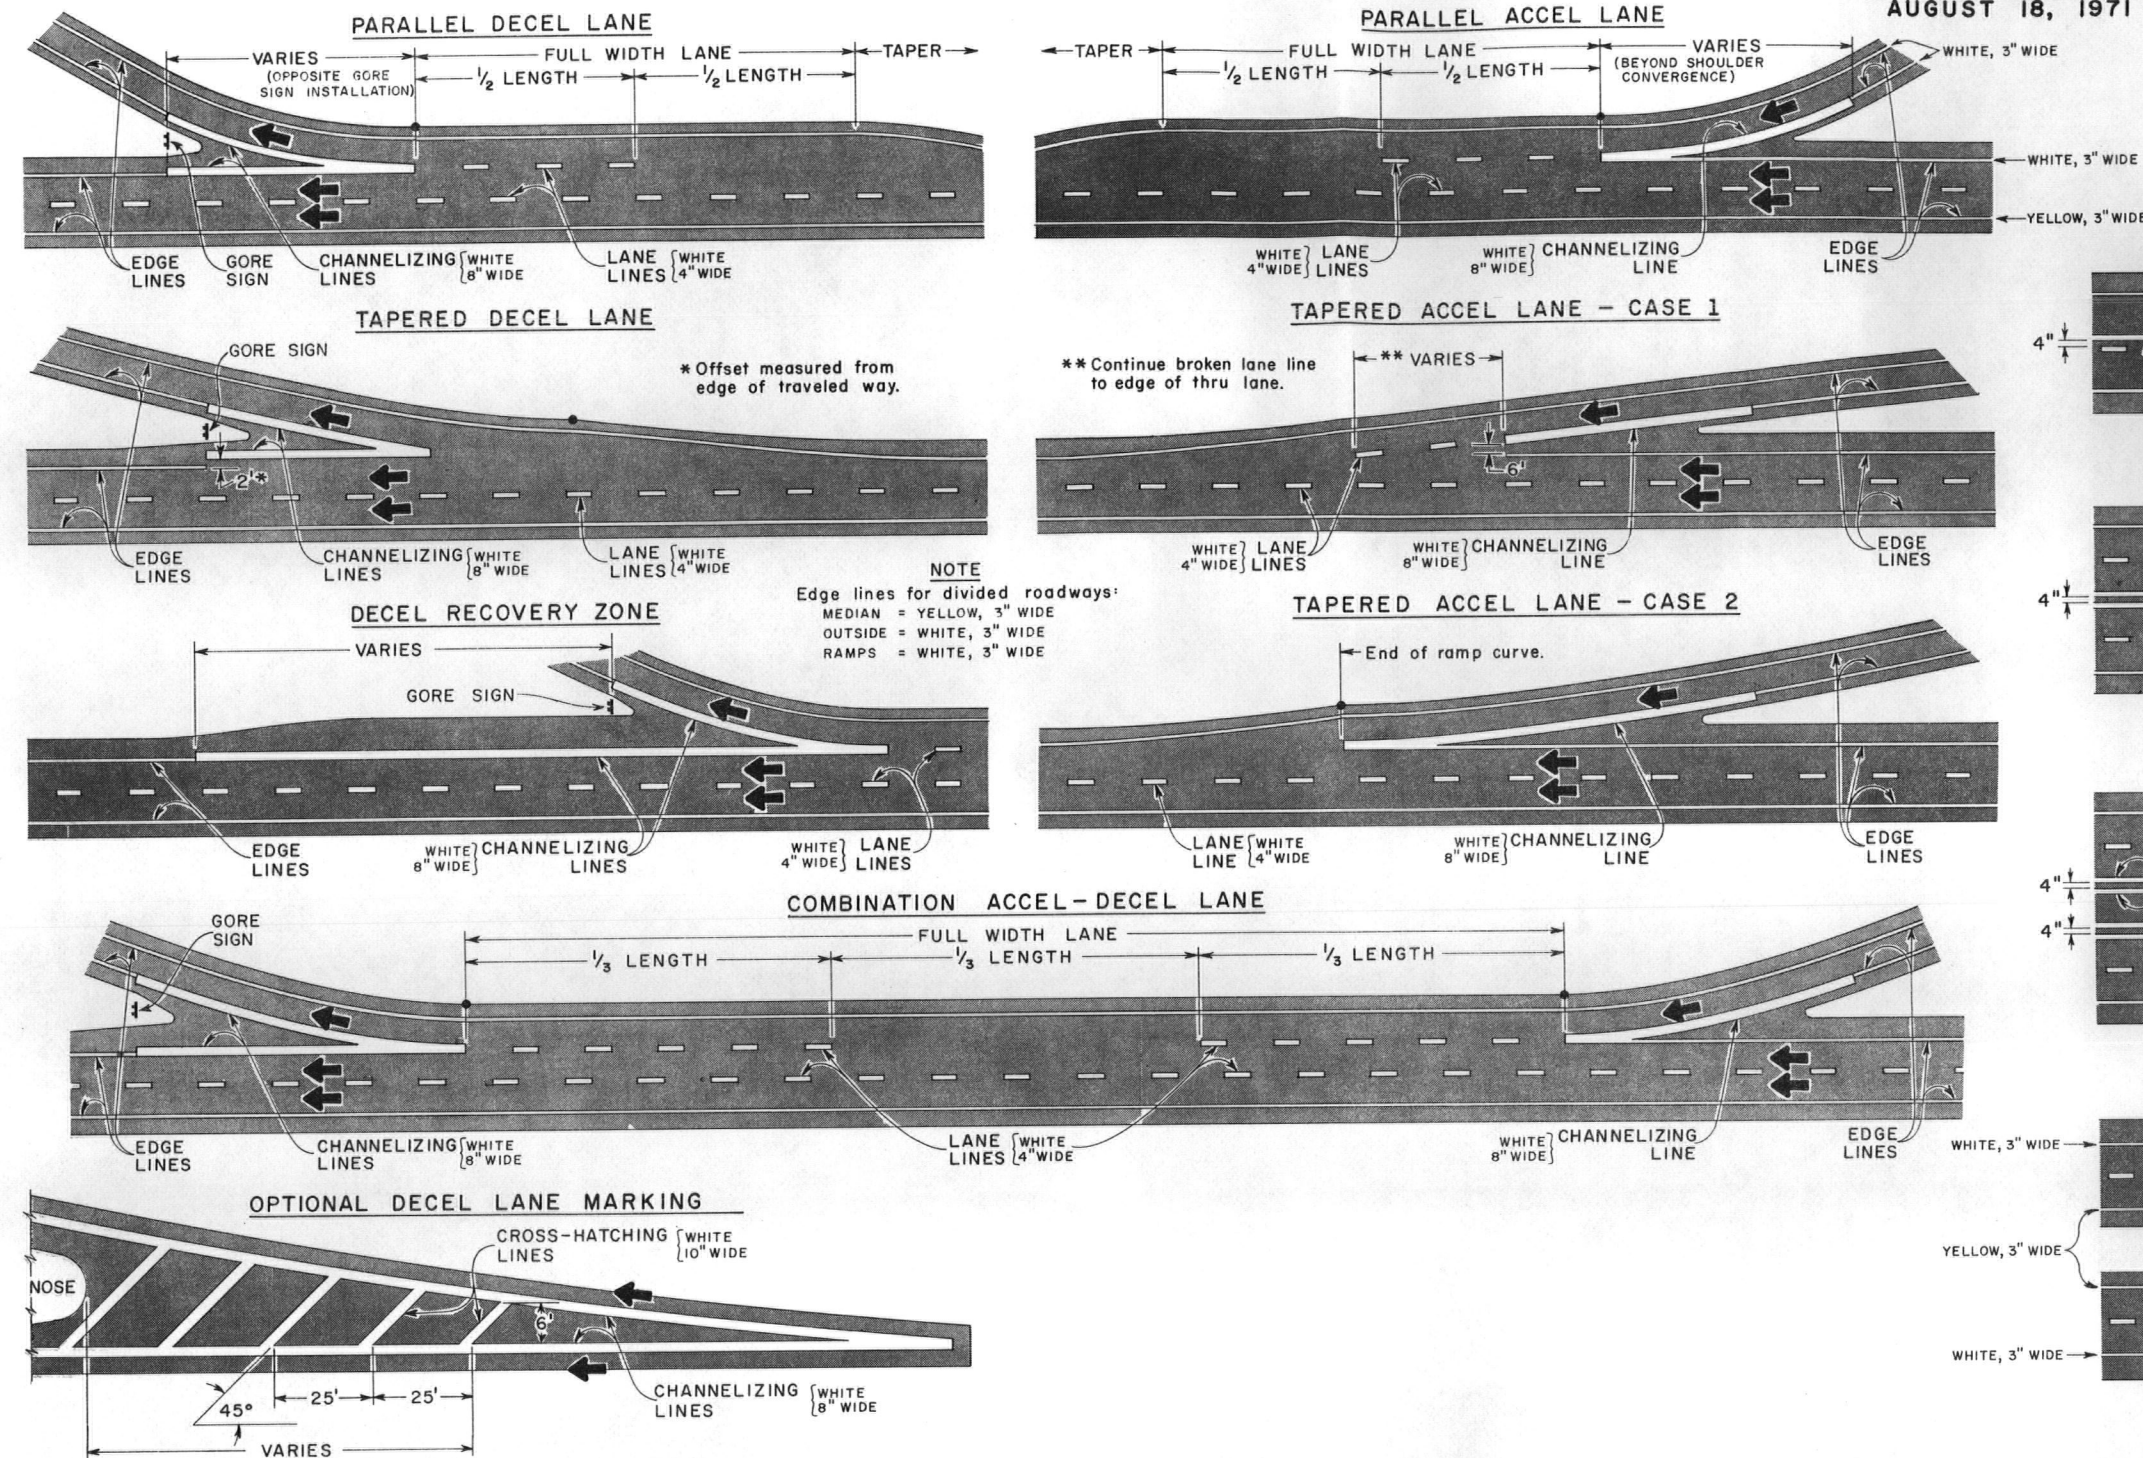

TYPICAL ROADWAY MARKINGS

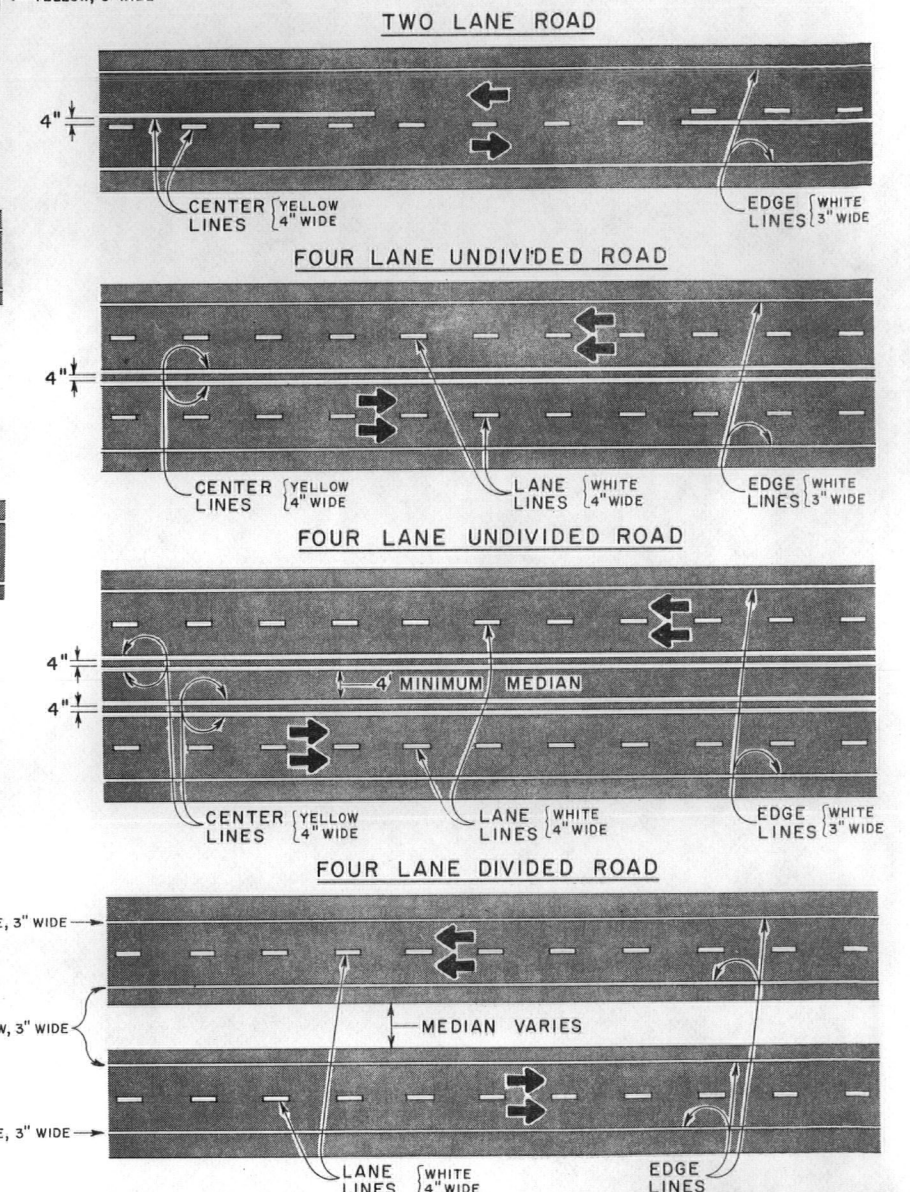

GENERAL NOTES

ALL WORK SHALL BE DONE IN ACCORDANCE WITH THE STANDARD SPECIFICATIONS APPLICABLE TO THE PROJECT.

CENTER LINES

1. Broken yellow, 4 inches wide - 15 foot segments with 25 foot gaps.
2. Solid yellow, 4 inches wide.

These lines separate adjacent-opposite direction traffic lanes. Double lines shall be spaced 4 inches apart.

LANE LINES

1. Broken white, 4 inches wide - 15 foot segments with 25 foot gaps.
2. Solid white, 4 inches wide.

These lines separate adjacent-same direction traffic lanes. A solid line may be used to discourage lane changing.

EDGE LINES

1. Parallel - Solid white or yellow, 3 inches wide.
2. Diagonal - Solid white, 10 inches wide, spaced at intervals of 20 feet minimum to 100 feet maximum.

Yellow edge lines shall be used only for the left edge of freeway or expressway mainline roadways separated by other than a painted median. Edge lines are not continued through intersections and are not broken for driveways. Care must be taken to avoid edge line appearing as lane line along roadways with wide shoulders and / or closely spaced driveways.

CHANNELIZING LINES

Solid white, 8 inches wide. These lines are used with acceleration-deceleration lanes, pavement width transitions, and left-right turn slots or islands.

CROSS-HATCHING LINES

Solid white or yellow, 10 inches wide - 45 degree Diagonal, spaced at 25 foot intervals. These lines are optional and may be placed at locations indicated on the plans or determined by the Engineer. Yellow shall be used for painted median-undivided road only.

PARKING LINES

Solid white, 3 inches wide - diagonal or parallel as shown on the plans.

STOP LINES

Solid white, 24 inches wide - extend parallel to intersected roadway across all approach lanes or as indicated at locations on the plans. Locate at the desired stopping point, not more than 30 feet nor less than 4 feet from the nearest edge of the intersected traffic lane.

CROSSWALK LINES (see note on sheet 2)

DEPARTMENT OF HIGHWAYS
STATE OF COLORADO
DIVISION OF HIGHWAYS

TYPICAL PAVEMENT MARKINGS

Designed By: F.J.B. Approved By: *[Signature]*
Made By: F.J.B. Traffic Engineer
Checked By: J.J.S. Date: August 18, 1971

STANDARD S-614-29 B


(SHEET 2 OF 2 SHEETS)

AUGUST 18, 1971

FEDERAL ROAD REGION NO.	DIVISION	PROJ. NO.	SHEET NO.	TOTAL SHEETS
9	COLORADO			


REVISIONS	

TYPICAL PAVEMENT WIDTH TRANSITION MARKINGS

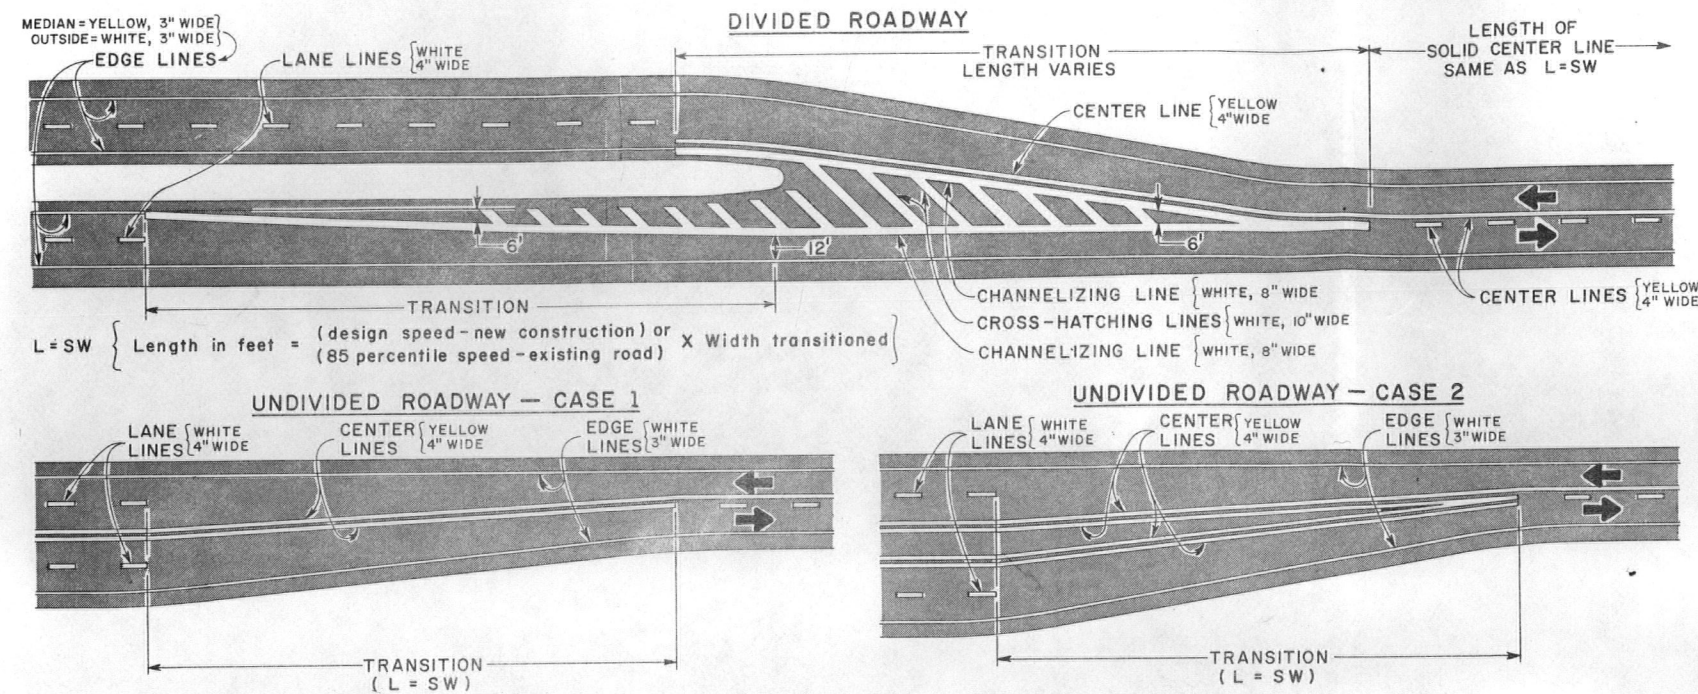


TYPICAL PAVEMENT EDGE MARKINGS

NOTE: Δ = SHOULDER WIDTH

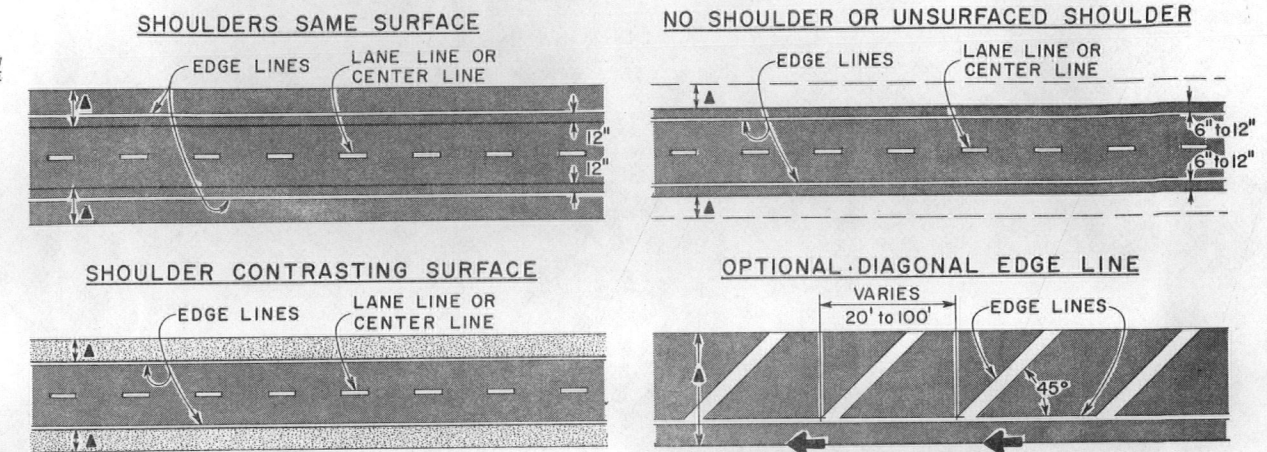


TYPICAL INTERSECTION MARKINGS

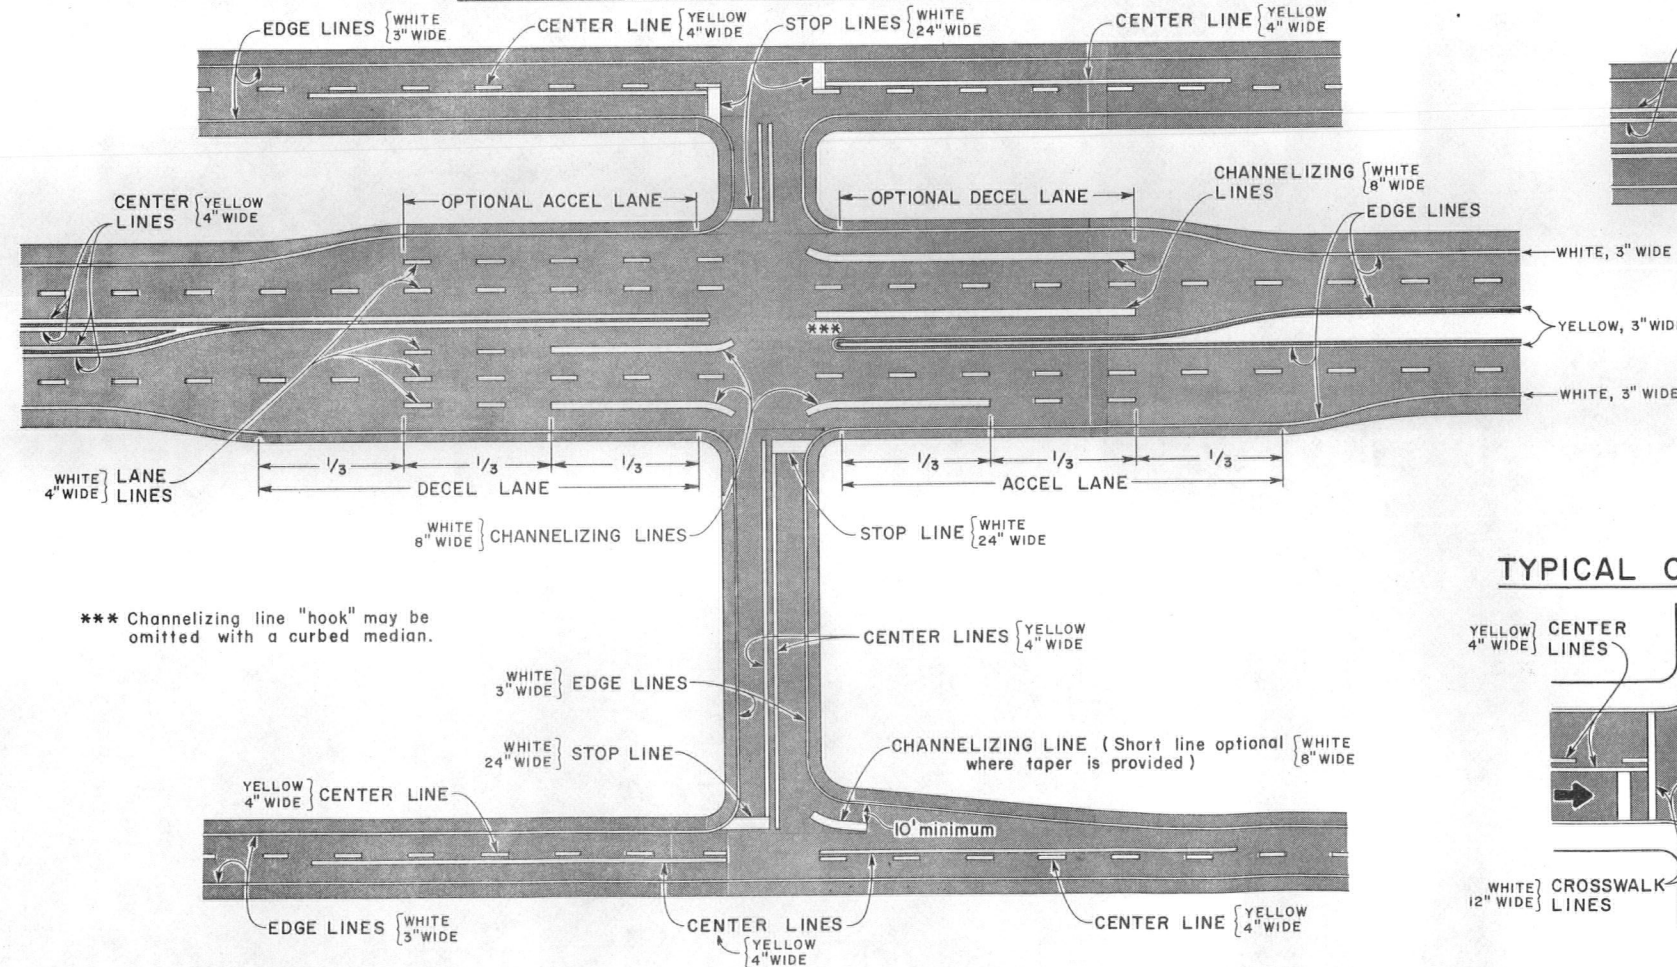


*** Channelizing line "hook" may be omitted with a curbed median.

TYPICAL ISLAND MARKINGS

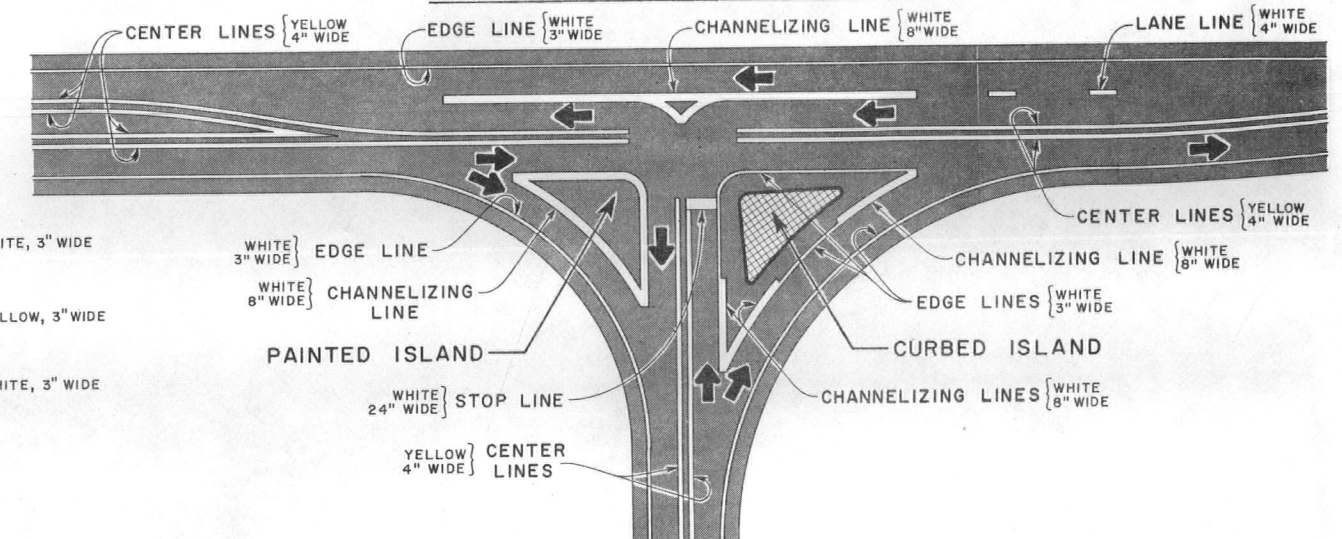

TYPICAL CROSSWALK MARKINGS

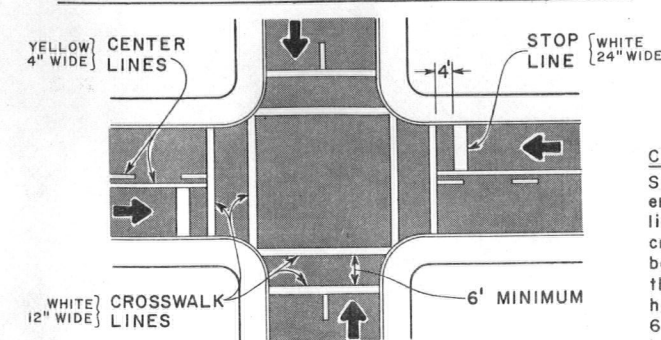

CROSSWALK LINE APPLICATION

Solid white, 12 inches wide - extend across entire width of pavement. If no advance stop line is provided, increase the width of the crosswalk lines to 24 inches. The distance between the lines is usually determined by the width of the sidewalks so connected, however, in no case shall this be less than 6 feet. Complicated and/or channelized intersections and mid-block crosswalks shall be as detailed in the plans or as directed by the Engineer.

DEPARTMENT OF HIGHWAYS
STATE OF COLORADO
DIVISION OF HIGHWAYS

TYPICAL PAVEMENT MARKINGS

Designed By: F.J.B. Approved By: *[Signature]*
Made By: F.J.B. Traffic Engineer
Checked By: J.J.S. Date: August 12, 1971