

AS CONSTRUCTED		FED. ROAD REGION	DIVISION	PROJ. NO.	SHEET NO.
NO REVISIONS	3-2-74	VI	COLO.	SHE C120-001	9


SE. 1/4 SEC. 15  
T. 2 S., R. 67 W.

SW. 1/4 SEC. 14  
T. 2 S., R. 67 W.

**CONTROL POINTS**

- ① CONTROL PNT # 1096101  
NORTHING 5500.0000  
EASTING 10400.0000  
ELEV. 5125.36  
2" ALUM. CAP
- ② CONTROL PNT # 1098105  
NORTHING 7075.9597  
EASTING 11878.5096  
ELEV. 5109.84  
2" ALUM. CAP
- ③ CONTROL PNT # 1097105  
NORTHING 6253.0256  
EASTING 11837.6761  
ELEV. 5126.97  
2" ALUM. CAP
- ④ CONTROL PNT # 1097107  
NORTHING 6163.2473  
EASTING 12426.3796  
ELEV. 5127.91  
2" ALUM. CAP
- ⑤ CONTROL PNT # 1096104  
NORTHING 5549.3665  
EASTING 11693.7323  
ELEV. 5130.93  
2" ALUM. CAP
- ⑥ CONTROL PNT # 1096108  
NORTHING 5543.2495  
EASTING 12972.7854  
ELEV. 5129.56  
2" ALUM. CAP
- ⑦ CONTROL PNT # SECTION CORNER  
NORTHING 5519.5877  
EASTING 11846.7838  
SW SECTION CORNER/SEC14,T2S,R67W

<b>SH 2</b>	<b>96TH</b>
STA. 6+25.60 N 4788.0005 E 11331.9678	STA. 113+71.89 N 5526.1906 E 11816.0531
STA. 15+68.97 N 5525.1822 E 11922.8355	STA. 117+76.00 N 5524.0792 E 12220.1422
STA. 25+17.43 N 6166.0450 E 12628.6227	

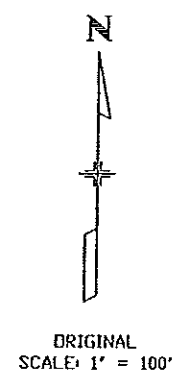

①  
X 1096101

⑤  
X 1096104

⑦  
SECTION CORNER

⑥  
X 1096108


96TH AVENUE

NW. 1/4 SEC. 23  
T. 2 S., R. 67 W.

NE. 1/4 SEC. 22  
T. 2 S., R. 67 W.

PROJECT CONTROL SHEET

AS CONSTRUCTED		DISTRICT	DIVISION	PROJ. NO.	SHEET NO.
NO REVISIONS	REVISED	VOID	VIIC	SHE C120-001	10
			COLO.		

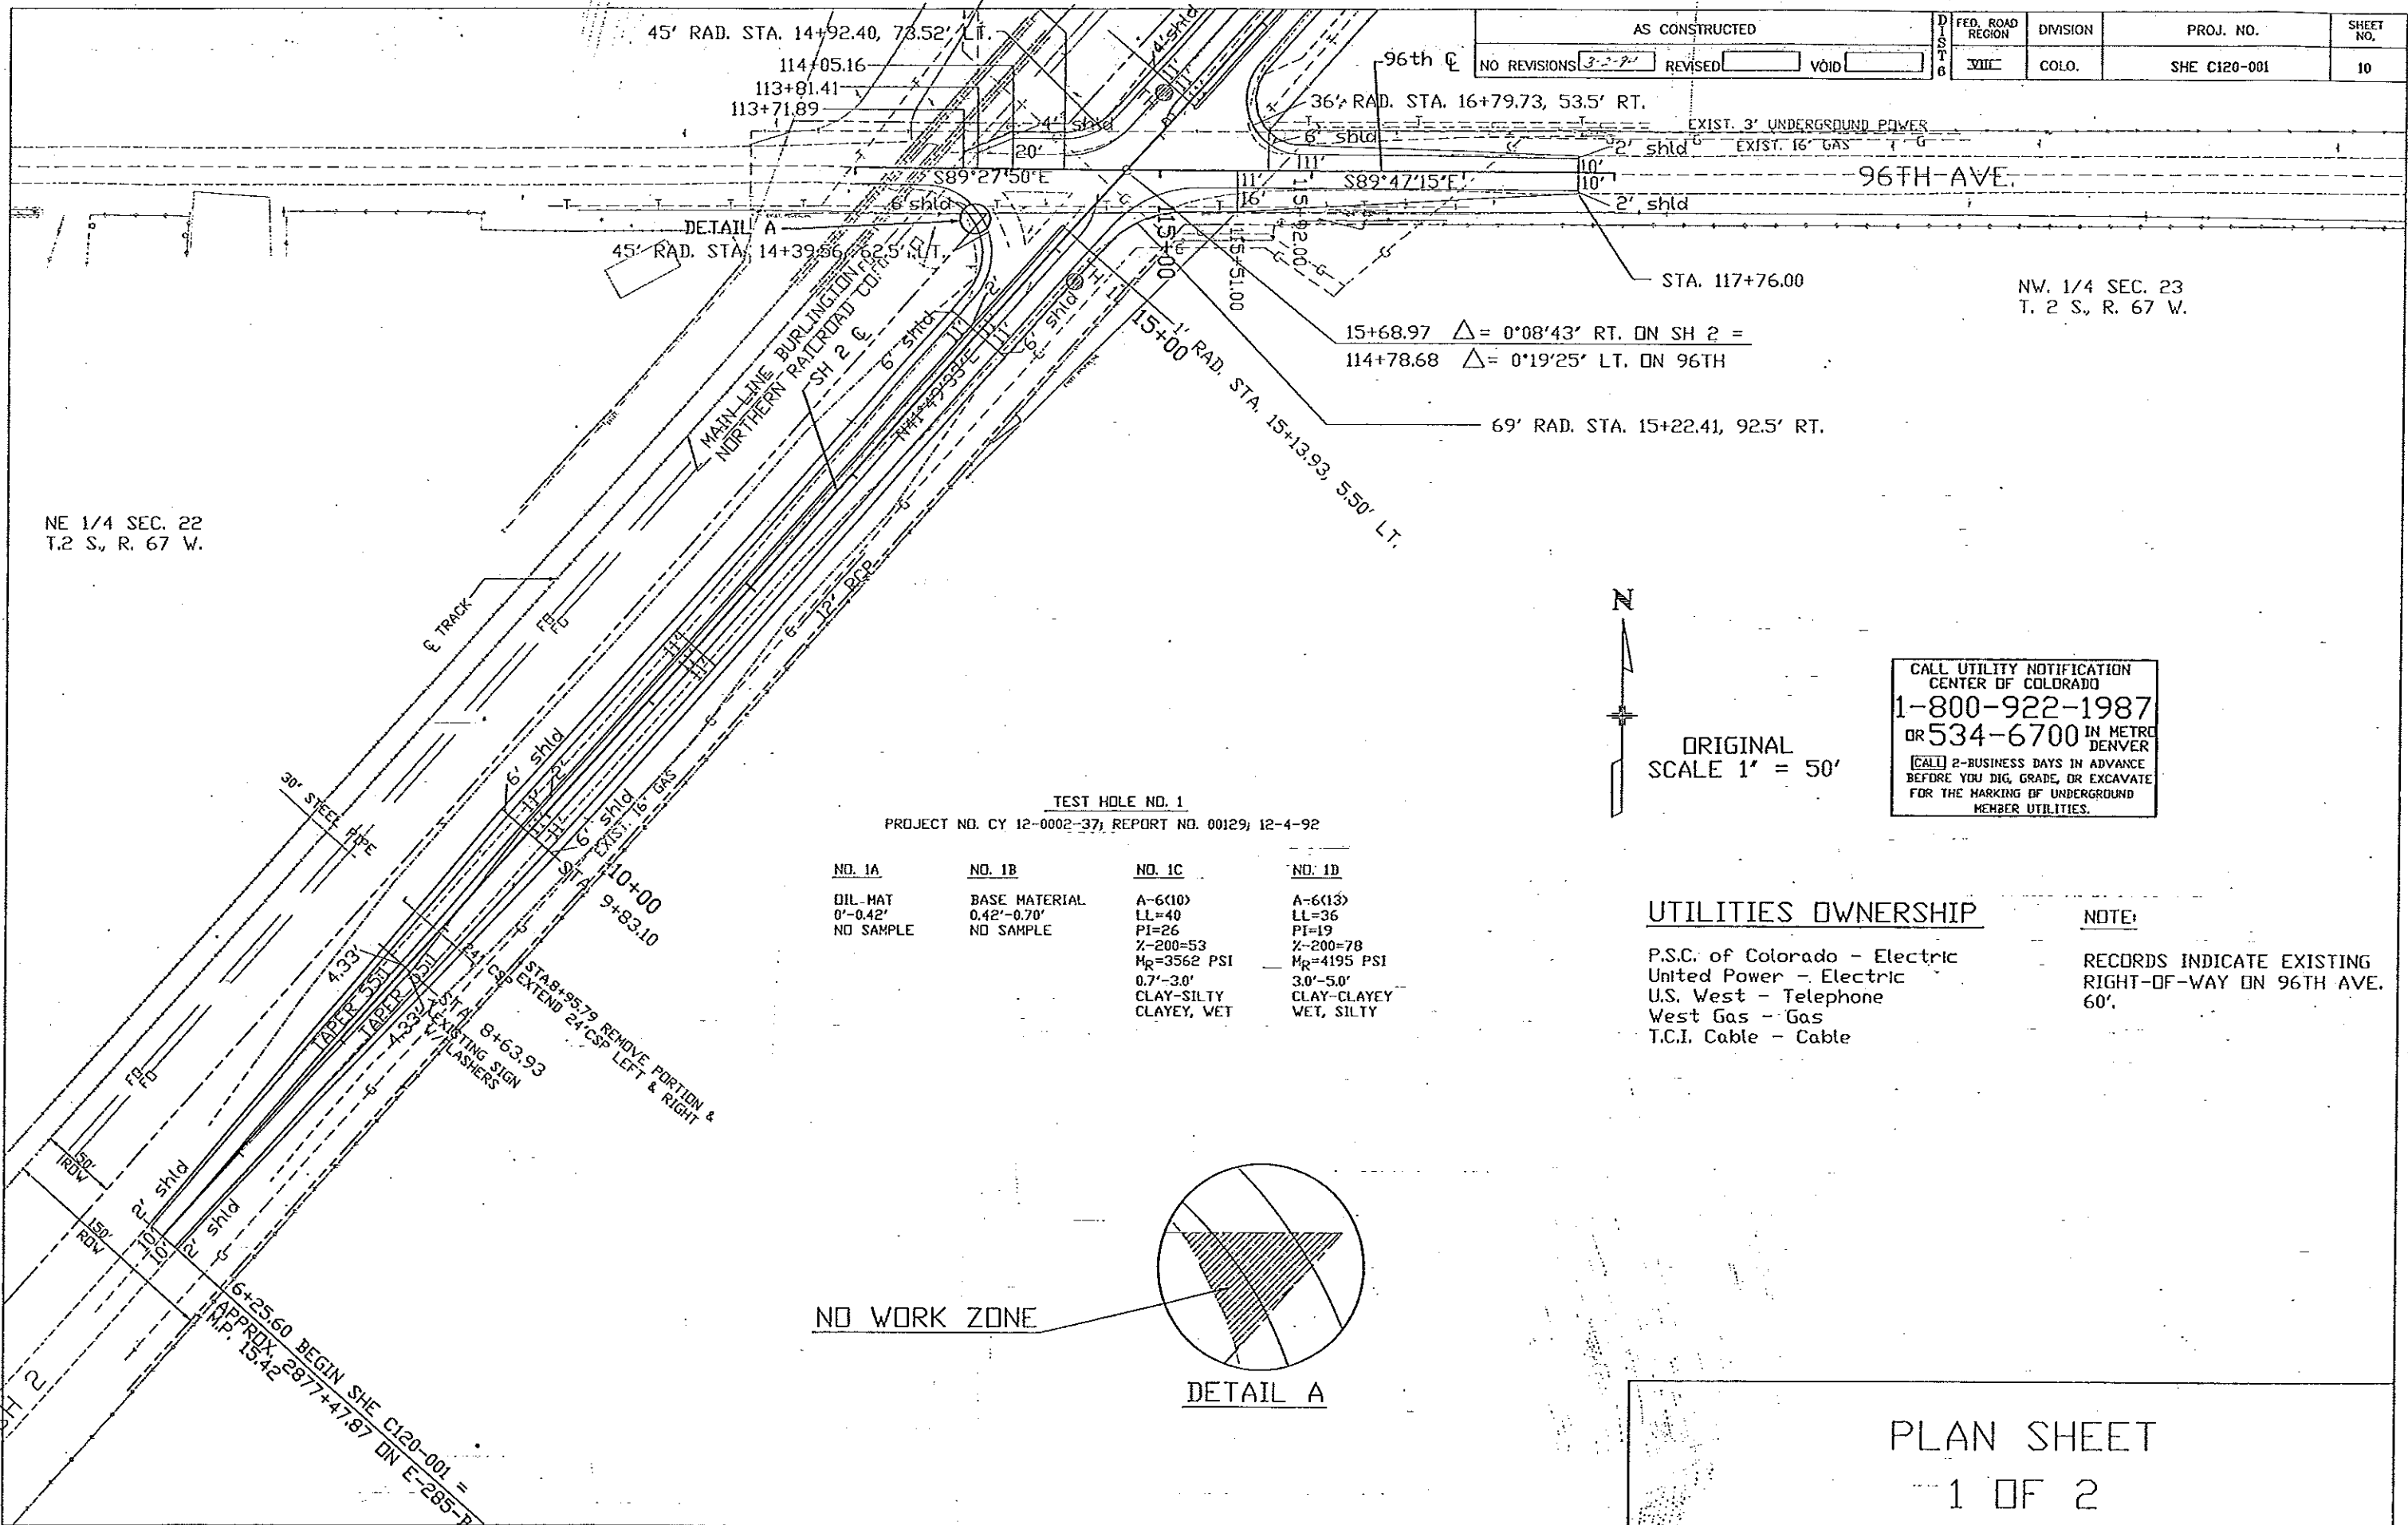


NE 1/4 SEC. 22  
T.2 S., R. 67 W.

NW 1/4 SEC. 23  
T. 2 S., R. 67 W.

15+68.97 Δ = 0°08'43" RT. ON SH 2 =  
114+78.68 Δ = 0°19'25" LT. ON 96TH

69' RAD. STA. 15+22.41, 92.5' RT.

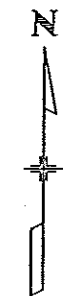

ORIGINAL  
SCALE 1" = 50'

CALL UTILITY NOTIFICATION  
CENTER OF COLORADO  
1-800-922-1987  
OR 534-6700 IN METRO  
DENVER  
CALL 2-BUSINESS DAYS IN ADVANCE  
BEFORE YOU DIG, GRADE, OR EXCAVATE  
FOR THE MARKING OF UNDERGROUND  
MEMBER UTILITIES.

TEST HOLE NO. 1  
PROJECT NO. CY 12-0002-37; REPORT NO. 00129; 12-4-92

NO. 1A	NO. 1B	NO. 1C	NO. 1D
DIL. MAT 0'-0.42' NO SAMPLE	BASE MATERIAL 0.42'-0.70' NO SAMPLE	A-6(10) LL=40 PI=26 %-200=53 M <sub>R</sub> =3562 PSI 0.7'-3.0' CLAY-SILTY CLAYEY, WET	A-6(13) LL=36 PI=19 %-200=78 M <sub>R</sub> =4195 PSI 3.0'-5.0' CLAY-CLAYEY WET, SILTY


UTILITIES OWNERSHIP

P.S.C. of Colorado - Electric  
United Power - Electric  
U.S. West - Telephone  
West Gas - Gas  
T.C.I. Cable - Cable

NOTE:

RECORDS INDICATE EXISTING  
RIGHT-OF-WAY ON 96TH AVE.  
60'.


NO WORK ZONE

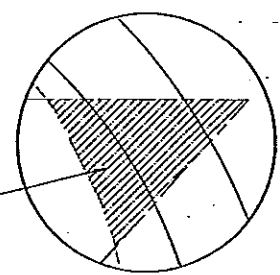

DETAIL A

PLAN SHEET  
1 OF 2

CALL UTILITY NOTIFICATION  
CENTER OF COLORADO  
1-800-922-1987  
OR 534-6700 IN METRO DENVER  
CALL 2-BUSINESS DAYS IN ADVANCE  
BEFORE YOU DIG, GRADE, OR EXCAVATE  
FOR THE MARKING OF UNDERGROUND  
MEMBER UTILITIES.

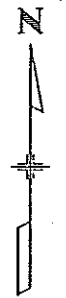


ORIGINAL  
SCALE 1" = 50'

25+17.43 END SHE C120-001 =  
APPROX. 2858+56.04 ON E-285-B  
M.P. 15.78


SW 1/4 SEC. 14  
T.2 S., R. 67 W.

SE 1/4 SEC. 15  
T.2 S., R. 67 W.

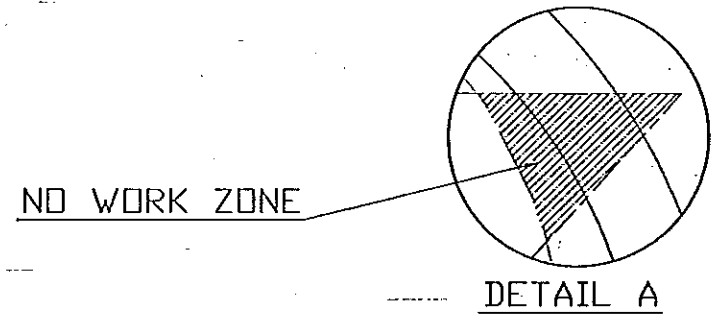

TEST HOLE NO. 2  
PROJECT NO. CY 12-0002-37, REPORT NO. 00129, 12-4-92

NO. 2A	NO. 2B	NO. 2C	NO. 2D
OIL MAT 0'-0.65' NO SAMPLE	BASE MATERIAL 0.65'-1.0' NO SAMPLE	A-6(10) CLAY-SILTY CLAYEY, WET 1.0'-2.0' NO SAMPLE	A-6(15) LL=37 PI=21 γ=200=80 M <sub>p</sub> =4478 PSI 2.0'-5.0' CLAY-CLAYEY, SANDY, SILTY, WET

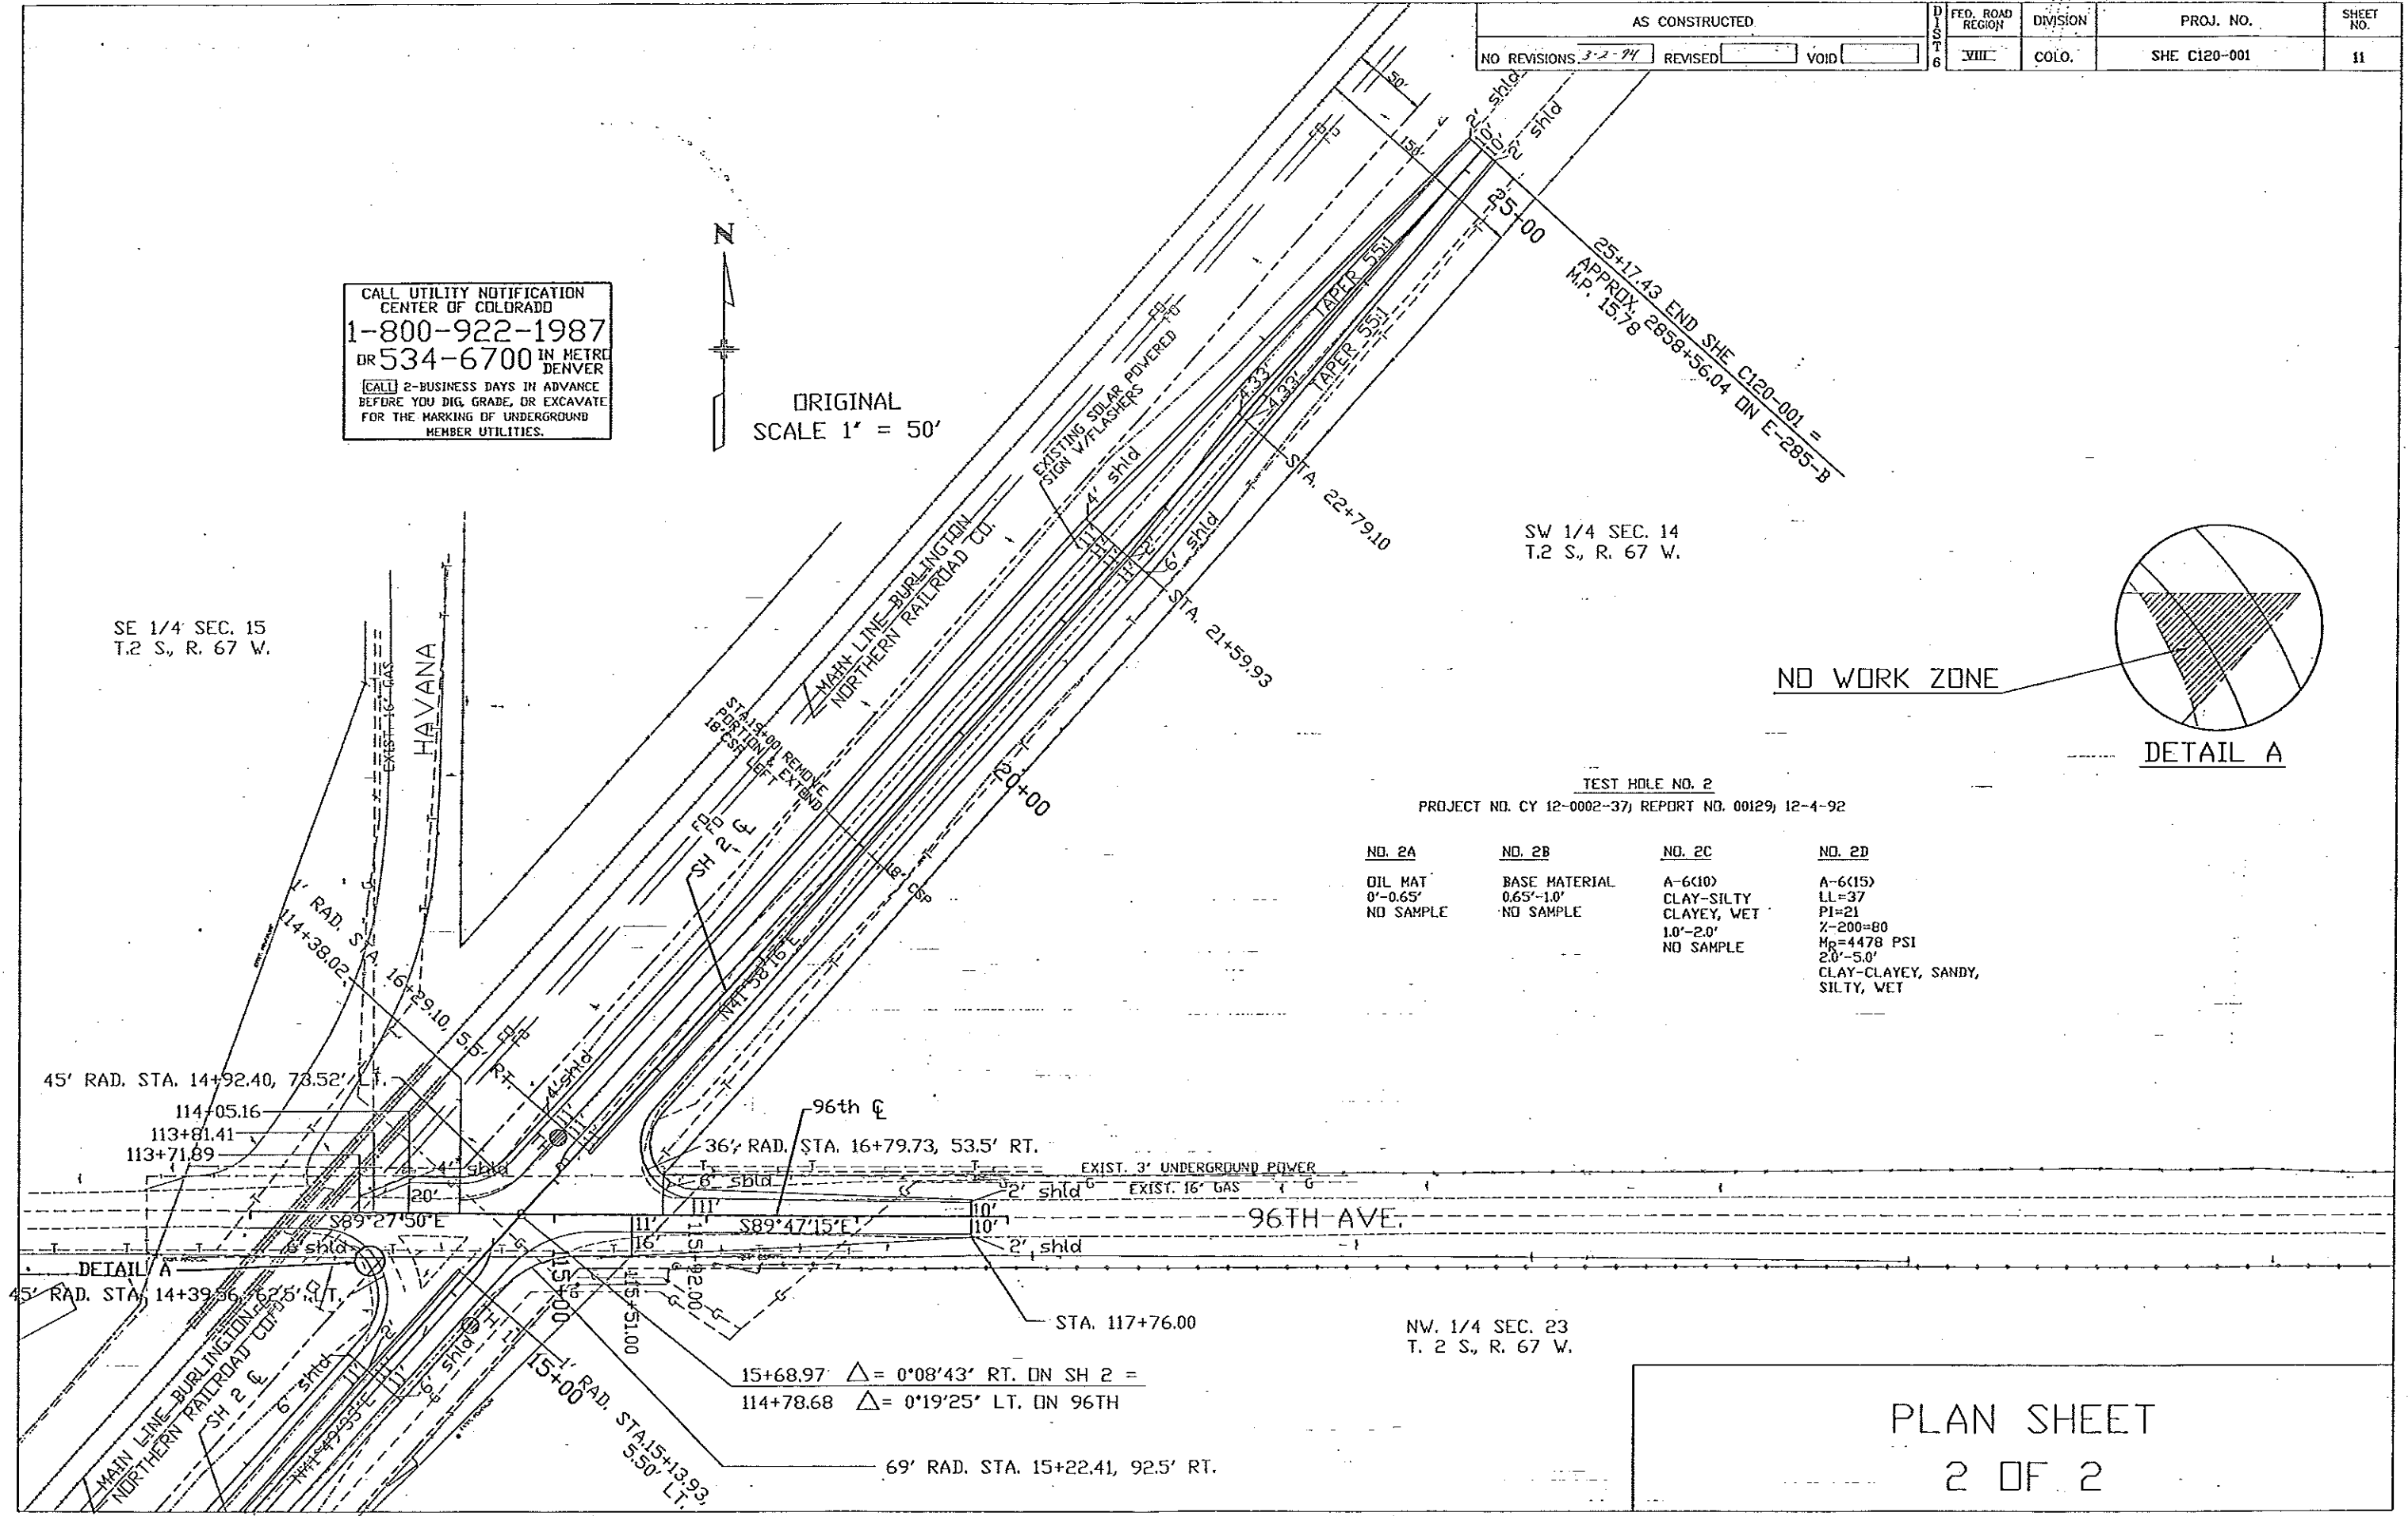

NW 1/4 SEC. 23  
T. 2 S., R. 67 W.

PLAN SHEET  
2 OF 2