

FED. ROAD DIST. NO.	STATE	SN FAP 210 C (I)	SHEET NO.	TOTAL SHEETS
3	COLO.		1	6

COLORADO STATE HIGHWAY DEPARTMENT

CONVENTIONAL SIGNS

CENTER LINE OF SURVEY	50
RIGHT OF WAY LINES	
COUNTY LINE	
SECTION LINES	
ONE QUARTER SECTION LINES	
QUARTER QUARTER SECTION LINES	
RAILROAD TRACKS	
BARED WIRE FENCE	
POLE LINES	
PUBLIC LAND BOUNDARY	

INDEX OF SHEETS

1. TITLE SHEET
2. TABULATION OF PROPERTIES
3. JUDD MILLER ESTATE.
MARIAN E. NOVINGER.
~~LENA F. COOPER~~ MARIAN E. NOVINGER.
~~GRANT BALES & R. G. CARLISLE~~ BERT ST. JOHN & J. D. SEVERSON.
~~BONITA VALLEY LAND CO.~~ BLUESTONE DITCH ASS'N.
4. HOME LOAN & INVESTMENT CO.
WESTCOLO CO.
A. J. CANFIELD.
~~I. C. ROBERTS~~ S. G. McMULLIN.
WESTCOLO CO. & ALL HEIRS OF Wm. MORLOCK
5. WESTCOLO CO.
ORVILLE A. KELLY.
ALL HEIRS OF Wm. MORLOCK.
6. PLAT OF PART T. 8 S. R. 97 W. 6th P. M.


PLAN AND PROFILE OF PROPOSED S.N. FEDERAL AID PROJECTS NO. } S.N. F.A.P. 210-C (I) STATE HIGHWAY NO. 4 }

MESA COUNTY

SCALE 3 OF ORIGINAL TRACINGS
ON PLAN, 1 IN. = 100 FT.
ON PROFILE 1 IN. = 100 FT. HORIZONTAL
1 IN. = 10 FT. VERTICAL
GRADE LINE ON PROFILE IS SHOWN AS GRADE OF FINISHED ROAD
GROSS LENGTH OF PROJECT S.N. F.A.P. 210-C (I) 8,243.4 FEET
NET LENGTH OF PROJECT 1.561 MILES

RIGHT OF WAY

INFORMATION OBTAINED FROM AVAILABLE COUNTY RECORDS
R. 98 W. R. 97 W. R. 96 W. T. 8 S.

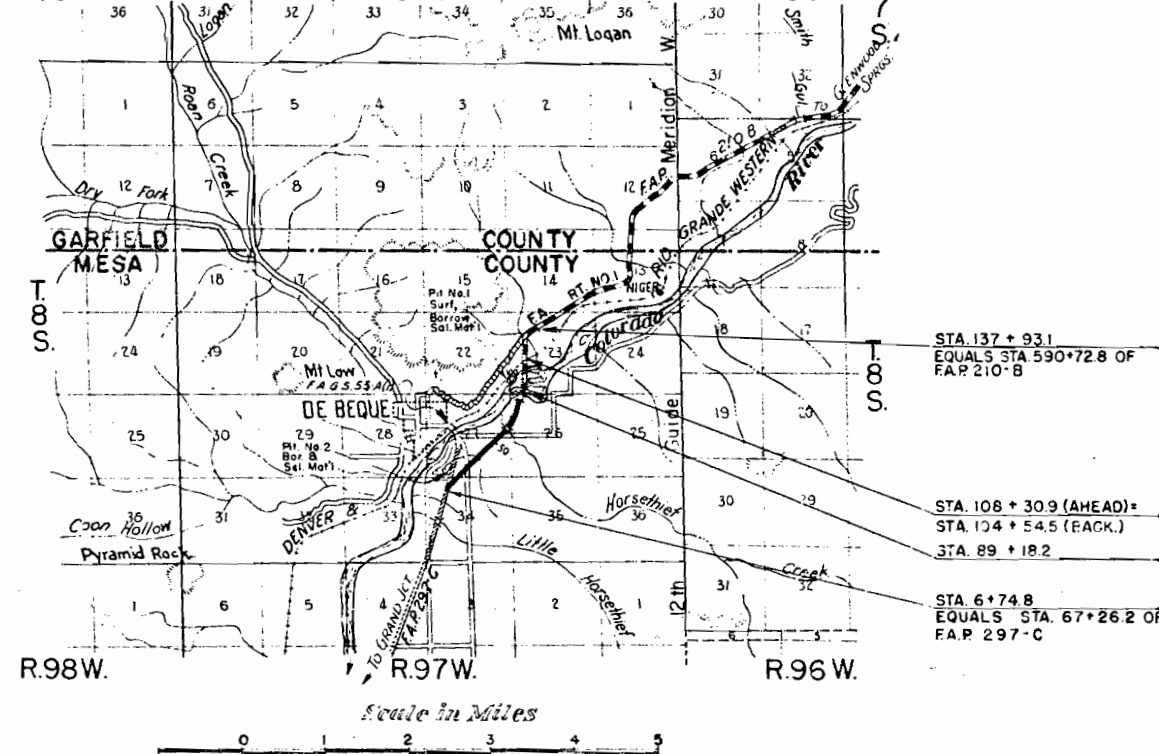

STA. 137 + 93.1
EQUALS STA. 590 + 72.8 OF
F.A.P. 210-B

STA. 108 + 30.9 (AHEAD) =
STA. 104 + 54.5 (BACK.)
STA. 89 + 18.2

STA. 6 + 74.8
EQUALS STA. 67 + 26.2 OF
F.A.P. 297-C

SN. F.A.G.H. 210-D (I)

SN. F.L.H.P. 6-A (I)

SN. F.A.P. 210-C (I)

FED. ROAD DIST. NO.	STATE	SN-FAP PROJ. NO.	SHEET NO.	TOTAL SHEETS
3	COLO.	210-C (II)	3	

Rev 5-24-44-CRS Summary.
Rev 7-28-44-J.A.C. Fencing Summary.

TIMBER GUARD POSTS

STATION	CENTERS	NO	
		LEFT	RIGHT
13 + 00 to 16 + 50	50'	8	
18 + 50 to 23 + 00	50'	10	
29 + 50 to 31 + 00	50'	4	4
35 + 00 to 36 + 00	50'	3	3
42 + 00	Culv	1	1
47 + 00	Culv	1	1
49 + 75 to 50 + 75	50'	3	3
52 + 75 to 53 + 75	50'	3	3
54 + 75 to 59 + 25	50'	10	
54 + 75 to 61 + 25	50'		14
61 + 51 to 61 + 62	Bridge	4	4
62 + 38 to 62 + 49	Bridge	4	4
62 + 99 to 63 + 49	50'	2	
62 + 99 to 84 + 49	50'		44
66 + 00 to 84 + 50	50'	38	
84 + 98 to 85 + 09	Bridge	4	4
TOTAL		180	

R.O.W. MARKERS

STATION	NO	
	LEFT	RIGHT
6 + 74.8		1
17 + 32		1
18 + 10	1	
18 + 22	1	
29 + 06	1	
30 + 00		1
56 + 69	1	
56 + 73		1
61 + 44 (385')		1
61 + 56		1
61 + 60	1	
61 + 78 (250')	1	
62 + 19 (315')		1
62 + 37		1
62 + 46	1	
62 + 66 (250')	1	
65 + 50		1
65 + 74		1
67 + 76	1	
68 + 44	1	
72 + 86.5	1	1
74 + 00		1
79 + 00	1	
TOTAL		24

FENCING REQUIREMENTS

STATIONS	SIDE	REMOVE FENCE	BUILD B. WIRE FENCE	BUILD B. WIRE GATES
		LIN. FT.	LIN. FT.	NO.
26 + 30	X	165		
29 + 90	X	150		
36 + 50	X	170		
47 + 00	X	55		
56 + 02	X	165		
66 + 15	X	225		
66 + 70	X	225		
67 + 25	X	350		
71 + 20	X	165		
81 + 55	X	110		
84 + 85	X	105		
56 + 80	X	165		
65 + 50	Lt			1 *
30 + 30 to 55 + 50	Lt		2520	
56 + 25 to 61 + 60	Lt		555 *	
62 + 45 to 67 + 00	Lt		465 *	
67 + 00 to 71 + 00	Lt		400	
71 + 00 to 81 + 40	Lt		1040 *	
29 + 35 to 56 + 70	Rt		2735	
57 + 45 to 61 + 60	Rt		435 *	
62 + 45 to 65 + 00	Rt		275 *	
65 + 00 to 71 + 00	Rt		600	
71 + 00 to 81 + 90	Rt		1090 *	
50 + 90	Lt			1
51 + 50	Rt			1
65 + 50	Rt			1
65 + 70	Rt			1
67 + 75	Rt			1
68 + 60	Lt			1
75 + 50	L & R			2 *
81 + 40 to 84 + 70	Lt		330	
81 + 90 to 85 + 00	Rt		310	
TOTAL Non F.A.			3860 *	3 *
TOTALS F.A.		2050	6895	6

*Non Participating in F.A.


SUMMARY OF APPROXIMATE QUANTITIES

ITEM NO	ITEM	UNIT	SN-FAP 210-C (II) STA 6 + 74.8 TO STA 89 + 18.2			
			ROADWAY	BRIDGES		PROJECT TOTALS
				STA 61 +	STA 85 +	
10a	Clearing and Grubbing Entire Project	Lump Sum	•			•
12a	Removing Fence	Lin. Ft	2,100			2,100
13c	Unclassified Excavation	Cu. Yd	70,000			70,000
13d	Unclassified Ditch Excavation	Cu. Yd	2,600			2,600
14a	Dry Rock Excavation (Str.)	Cu. Yd	60		10	70
14b	Dry Common Excavation (Str.)	Cu. Yd	510	170	200	1,080
14c	Wet Rock Excavation (Str.)	Cu. Yd	10		360	370
14d	Wet Common Excavation (Str.)	Cu. Yd	60	10	2,050	2,120
14e	Mechanical Tamping	Hour	380	50	500	930
15a	Rolling Embankments and Cuts	Hour	850			850
15b	Furnishing Roller	Roller Unit	4			4
15c	Wetting Embankments and Cuts	M. Gal.	1050			1050
18a	Station Yard Overhaul	Sta Yd	398,000			398,000
18b	Yard Mile Overhaul	Yd. Mile	9,400			9,400
26a	Gravel or Crushed Rock Surfacing	Ton	9,100			9,100
26c	Overhaul of Surfacing	Ton Mile	600			600
42a	Untreated Bridge Timber	M ft. b.m.		1.5	02	1.7
42b	Treated Bridge Timber	M ft. b.m.		34.0		34.0
43	Asphalt Plank Wearing Surface	Sq. Ft.		2,001		2,001
46a	Class "A" Concrete	Cu. Yd.	69		1,230	1,299
46b	Class "B" Concrete	Cu. Yd.	97			97
46c	Class "A" Concrete (Handrails)	Cu. Yd.			2	2
47	Reinforcing Steel	Lb.	6,600		134,900	141,500
48	Structural Steel	Lb.			745,600	745,600
52b	18" Reinf. Concrete Culvert Pipe (Std. Strength)	Lin. Ft.	668			668
52c	24" Reinf. Concrete Culvert Pipe (Std. Strength)	Lin. Ft.	492			492
52e	36" Reinf. Concrete Culvert Pipe (Std. Strength)	Lin. Ft.	188			188
52g	48" Reinf. Concrete Culvert Pipe (Std. Strength)	Lin. Ft.	120			120
60a	Treated Timber Piling	Lin. Ft		1,836		1,836
60e	Metal Pile Shoes	Each		66		66
64	Dry Rubble Slope and Ditch Paving (18" thick)	Sq. Yd.		68		68
76a	Barbed Wire Fence with Treated Wooden Posts	Lin. Ft.	6900			6900
76g	Barbed Wire Gates	Each	6			6
80b	Bronze Name Plates	Each			2	2
81a	Project Markers	Each	2			2
81b	Right of Way Markers	Each	24			24
89a	Drain Pipe (Concrete Floor) (3"x5'-0")	Each			24	24
89b	Drain Pipe (Timber Floor) (3"x2'-4")	Each		6		6
91	Pipe Railing (3" Diam.)	Lin. Ft.			806	806
92	Timber Guard Posts	Each	180			180
15z	Furnishing Flat Wheeled Roller	Lump Sum	•			•
15y	Rolling with Flat Wheeled Roller	Hour	100			100
	FORCE ACCOUNT Raise Power Lines, Sta 30+ and 56+69 (Work by Grand Valley Power Lines, Inc., Forces.)		•			•
	Right of Way, Entire Project	Lump Sum	•			•
76b	NON PARTICIPATING IN F.A. Barbed Wire Fence, Treated Wooden Posts	Lin. Ft.	3900			3900
76g	Barbed Wire Gates	Each	3			3


**T.8S. R.97W.
6th P.M.**

FED. ROAD DIST. NO.	STATE	PROJ. NO.	SHEET NO.	TOTAL SHEETS
3	COLO.	SN FAP 210-C(1)	3	6

PLAN	DATE
DESIGNED BY A. H. BULLOCK CHECKED BY A. H. BULLOCK NOTE BOOK NO. 100 REVISIONS 1. 10/1/40 2. 10/1/40 3. 10/1/40 4. 10/1/40 5. 10/1/40 6. 10/1/40 7. 10/1/40 8. 10/1/40 9. 10/1/40 10. 10/1/40	10/1/40

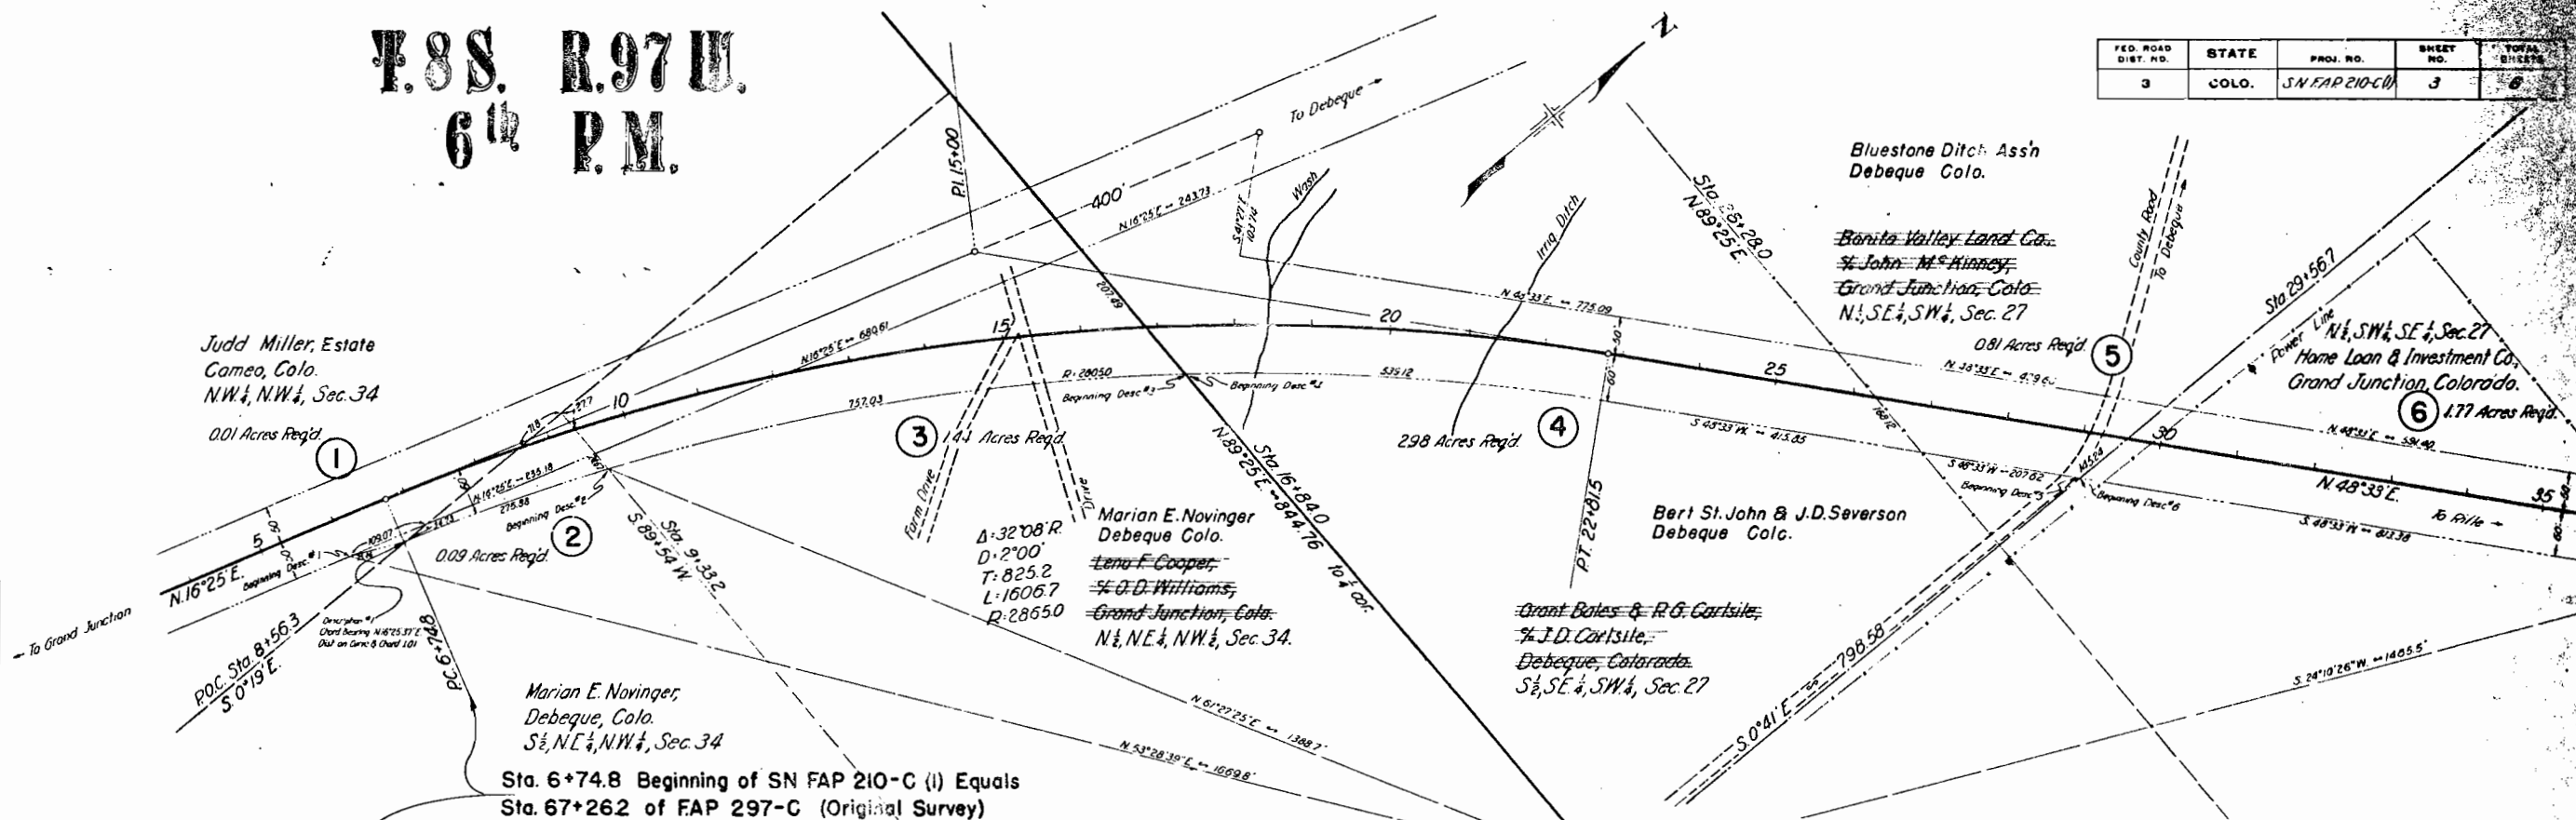


PROFILE	DATE
DESIGNED BY A. H. BULLOCK CHECKED BY A. H. BULLOCK NOTE BOOK NO. 100 REVISIONS 1. 10/1/40 2. 10/1/40 3. 10/1/40 4. 10/1/40 5. 10/1/40 6. 10/1/40 7. 10/1/40 8. 10/1/40 9. 10/1/40 10. 10/1/40	10/1/40

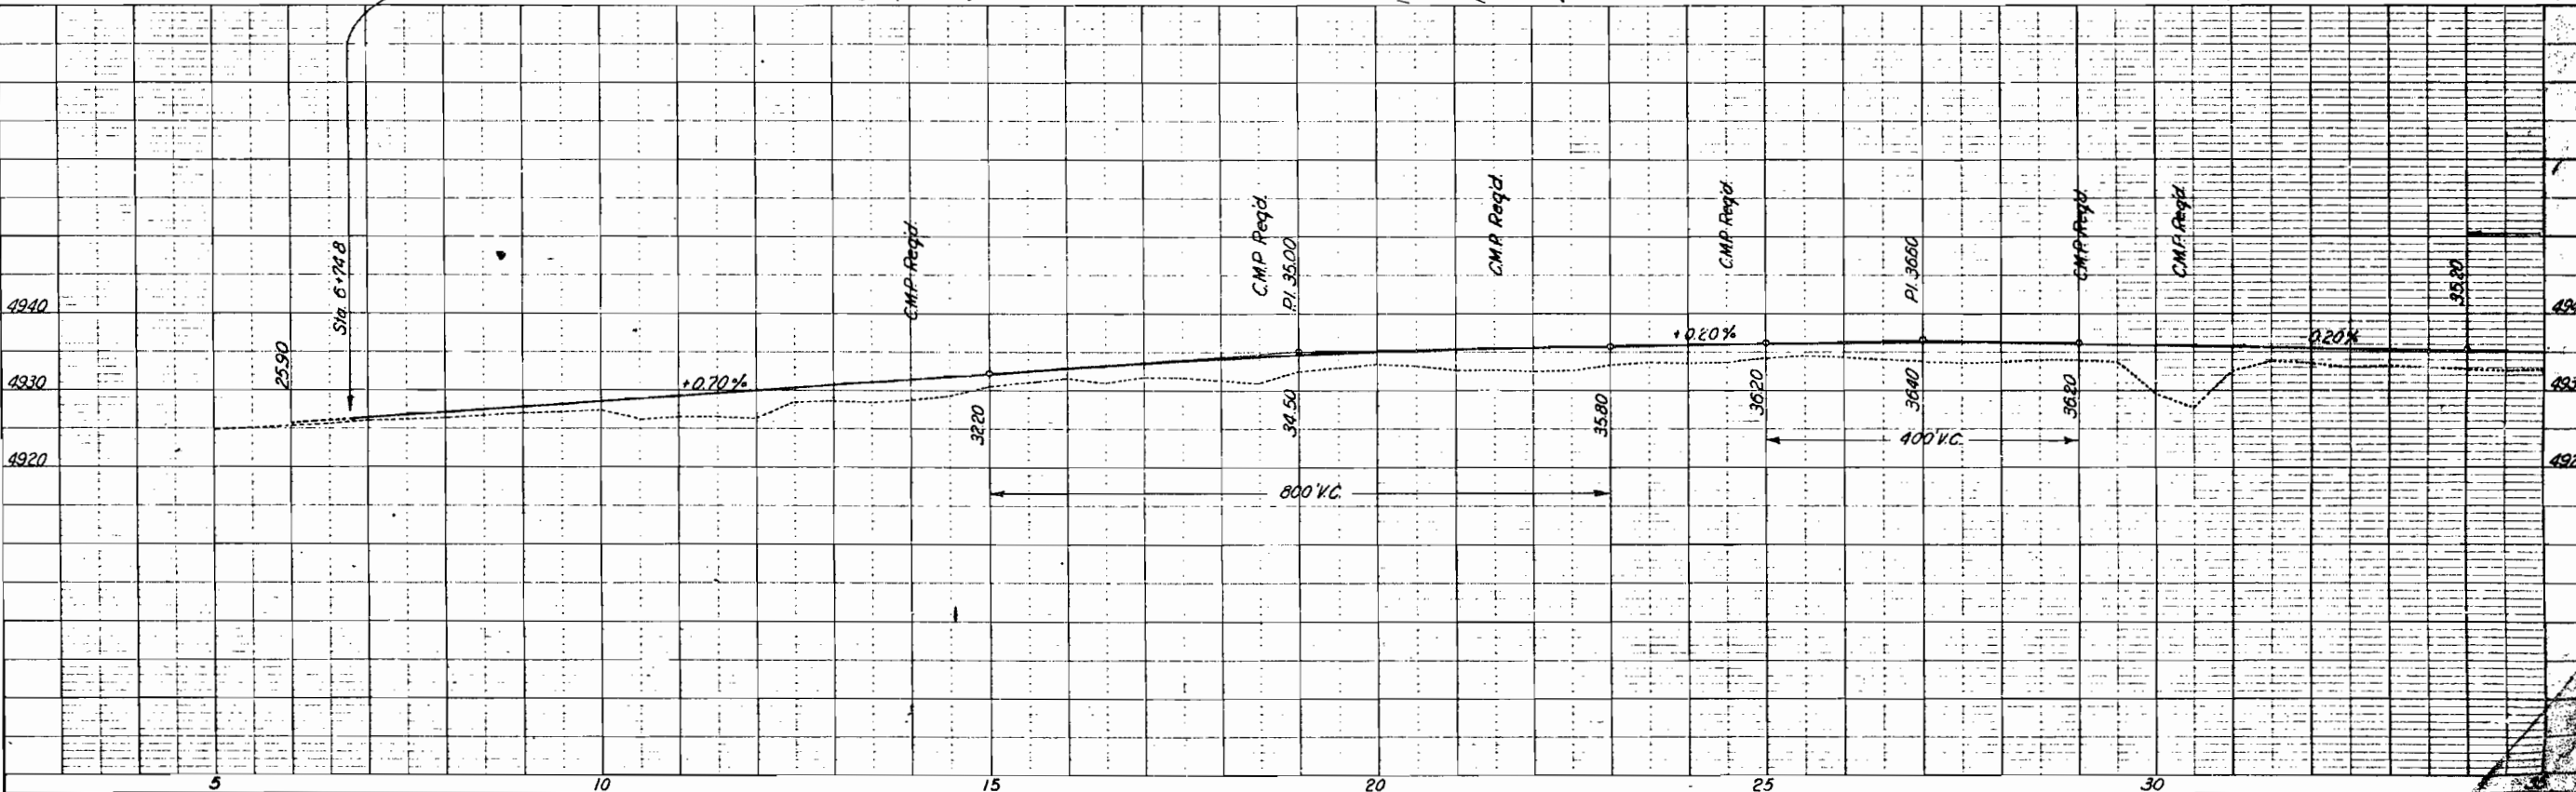


T.8S. R.97W.
6th P.M.

FED. ROAD DIST. NO.	STATE	PROJ. NO.	SHEET NO.	TOTAL SHEETS
3	COLO.	SN FAP 20-C (1)	4	8

PLAN	DATE
PL 100	12-24
PL 101	12-24
PL 102	12-24
PL 103	12-24
PL 104	12-24
PL 105	12-24
PL 106	12-24
PL 107	12-24
PL 108	12-24
PL 109	12-24
PL 110	12-24
PL 111	12-24
PL 112	12-24
PL 113	12-24
PL 114	12-24
PL 115	12-24
PL 116	12-24
PL 117	12-24
PL 118	12-24
PL 119	12-24
PL 120	12-24

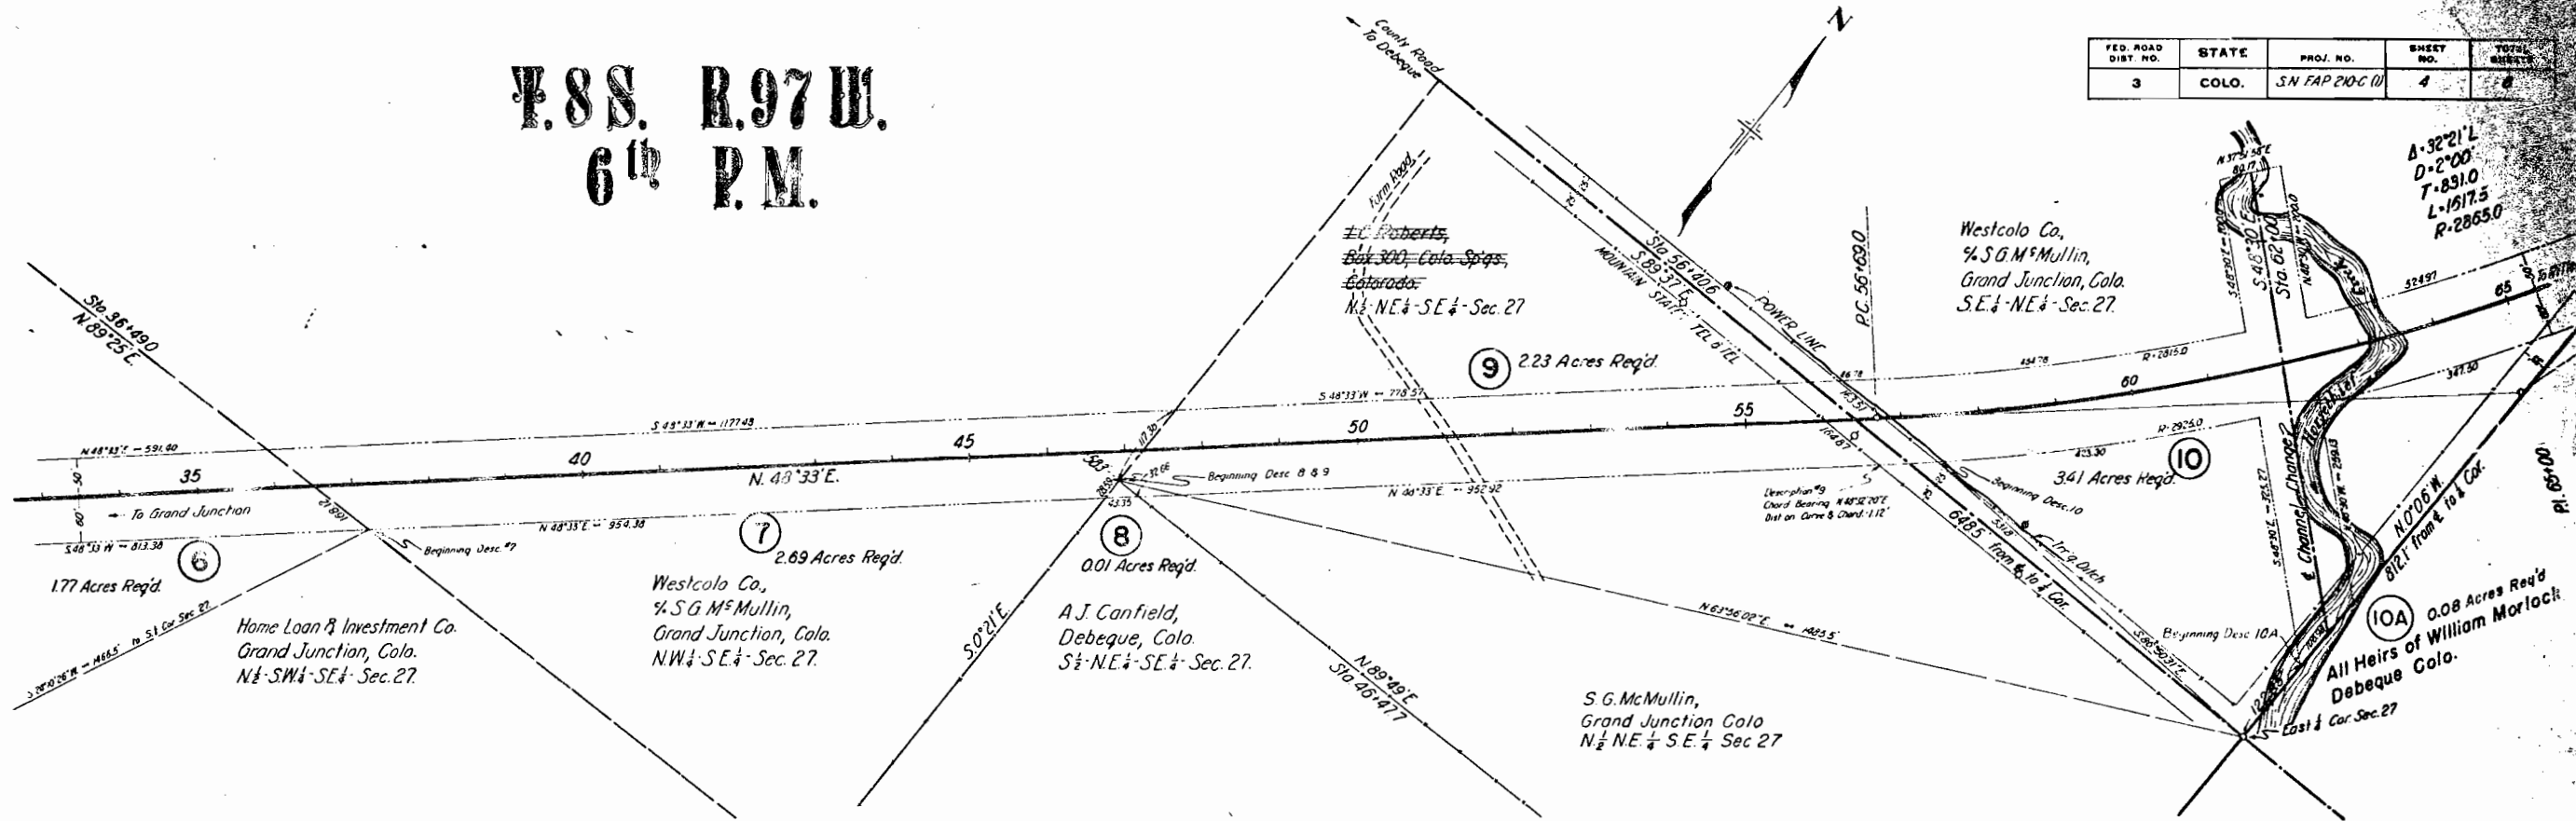

PROFILE	DATE
PL 100	12-24
PL 101	12-24
PL 102	12-24
PL 103	12-24
PL 104	12-24
PL 105	12-24
PL 106	12-24
PL 107	12-24
PL 108	12-24
PL 109	12-24
PL 110	12-24
PL 111	12-24
PL 112	12-24
PL 113	12-24
PL 114	12-24
PL 115	12-24
PL 116	12-24
PL 117	12-24
PL 118	12-24
PL 119	12-24
PL 120	12-24

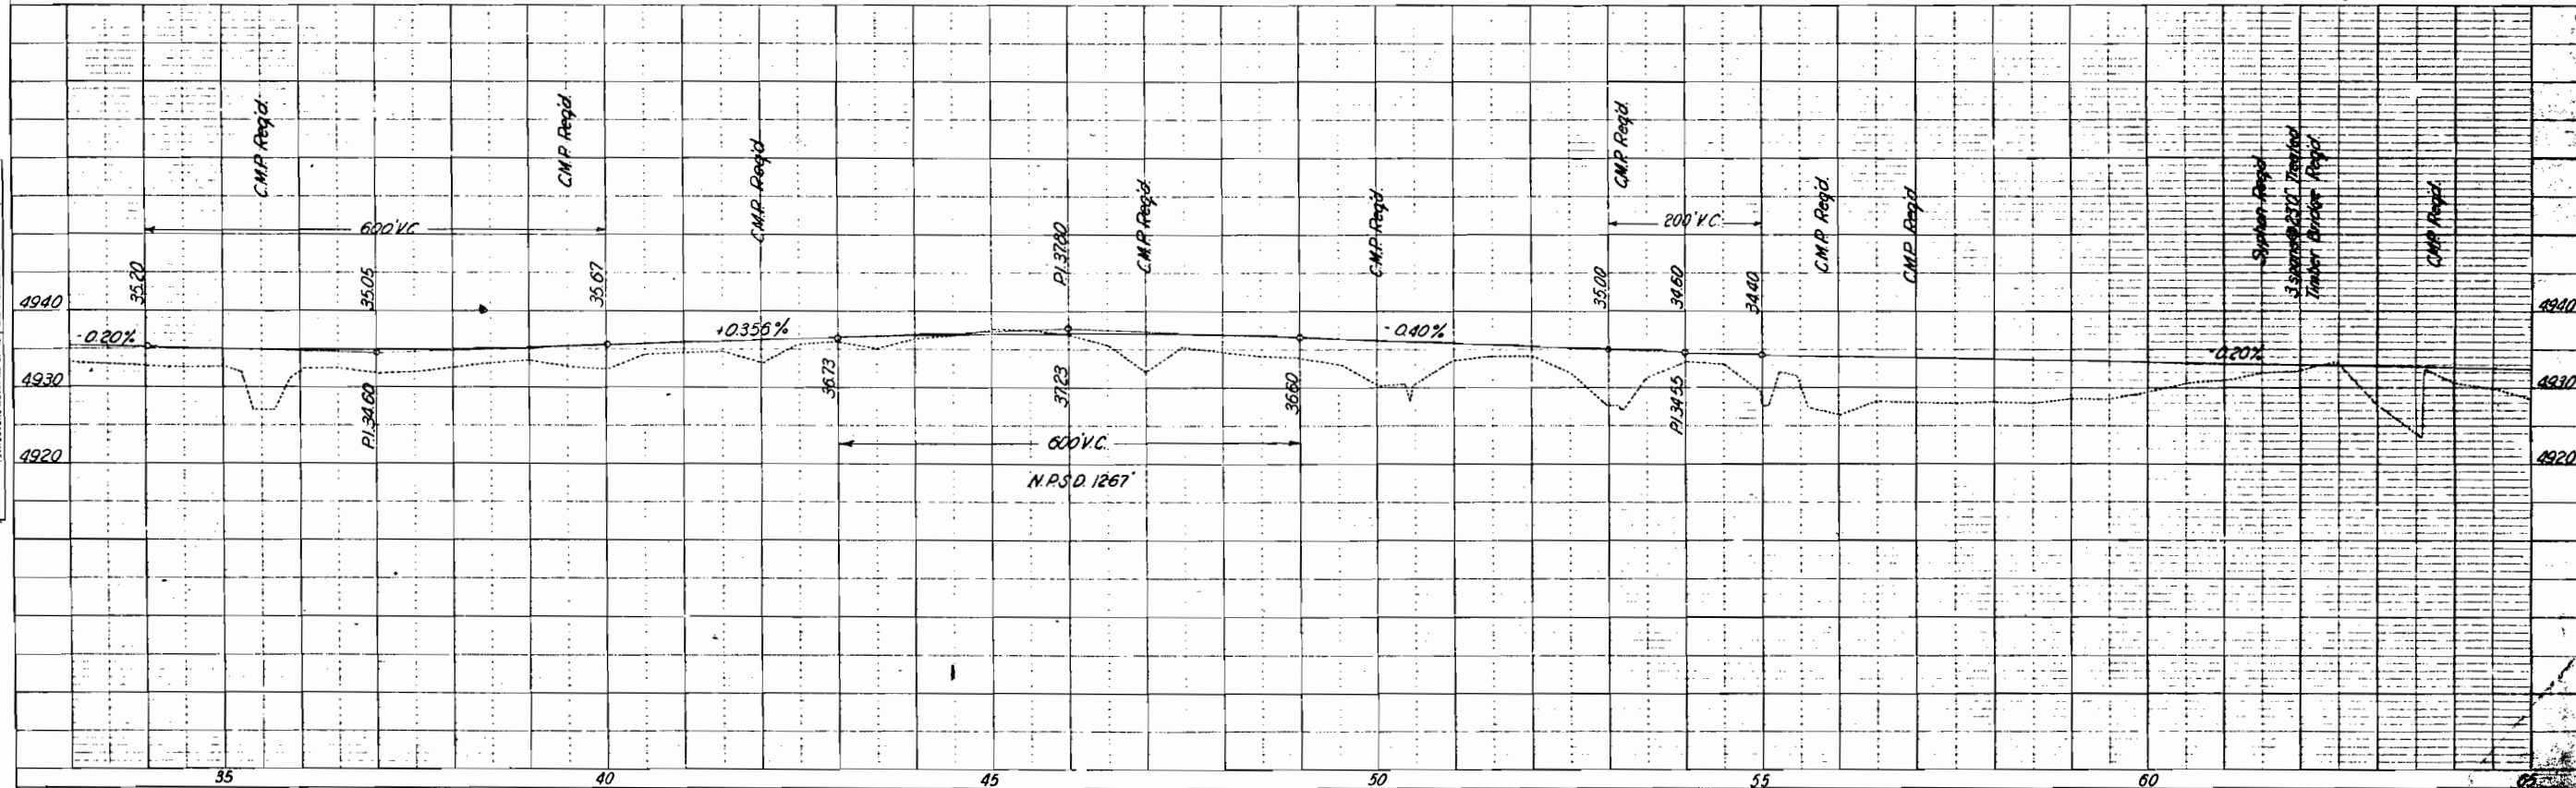


7.88. R.97 W.
6th P.M.


FED. ROAD DIST. NO.	STATE	PROJ. NO.	SHEET NO.	TOTAL SHEETS
3	COLO.	SN FAP 210 C (I)	5	6

Rev. sed 2-15-45 RPO ROW

PLAN	DATE
DESIGNED BY A. J. BULLARD, JR. CHECKED BY C. M. ANDERSON	12-11-44
NOTED BY C. M. ANDERSON	

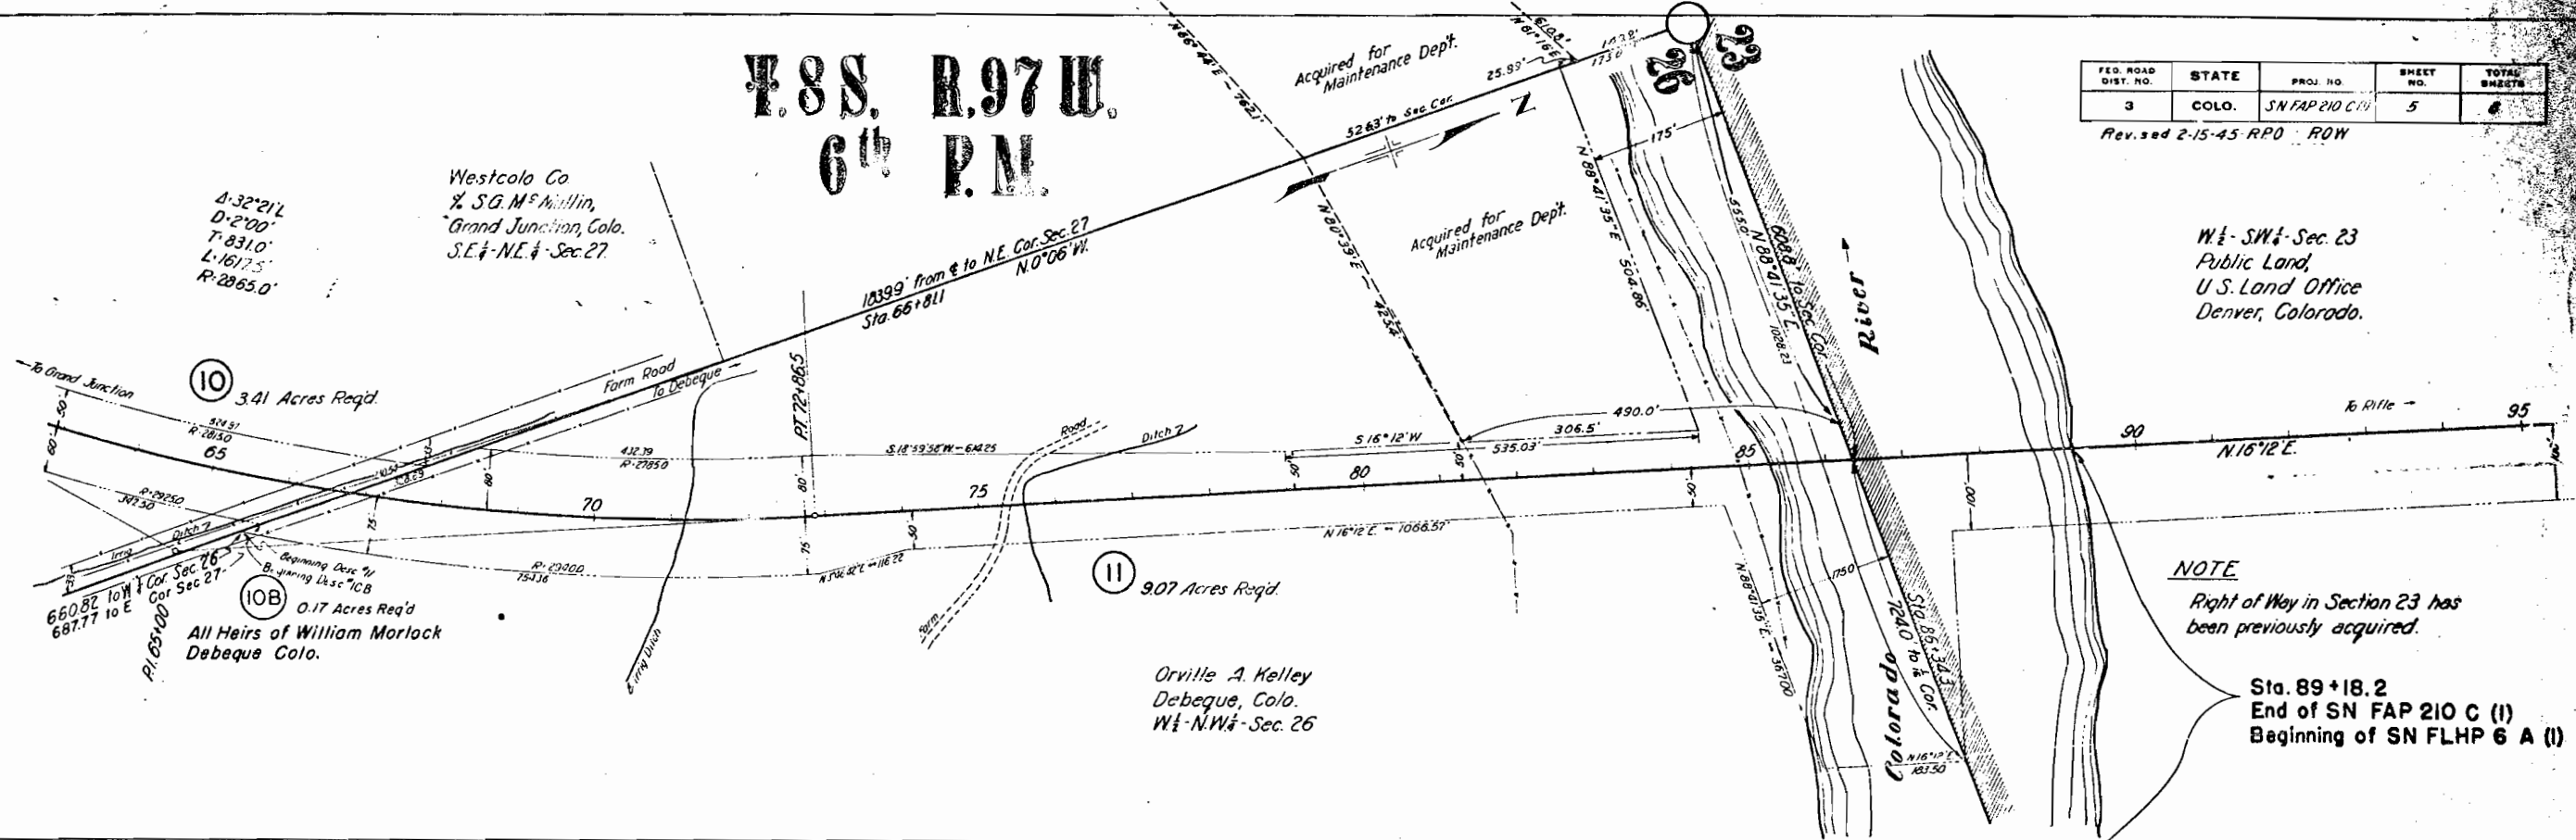


PROFILE	DATE
DESIGNED BY A. J. BULLARD, JR. CHECKED BY C. M. ANDERSON	12-11-44
NOTED BY C. M. ANDERSON	

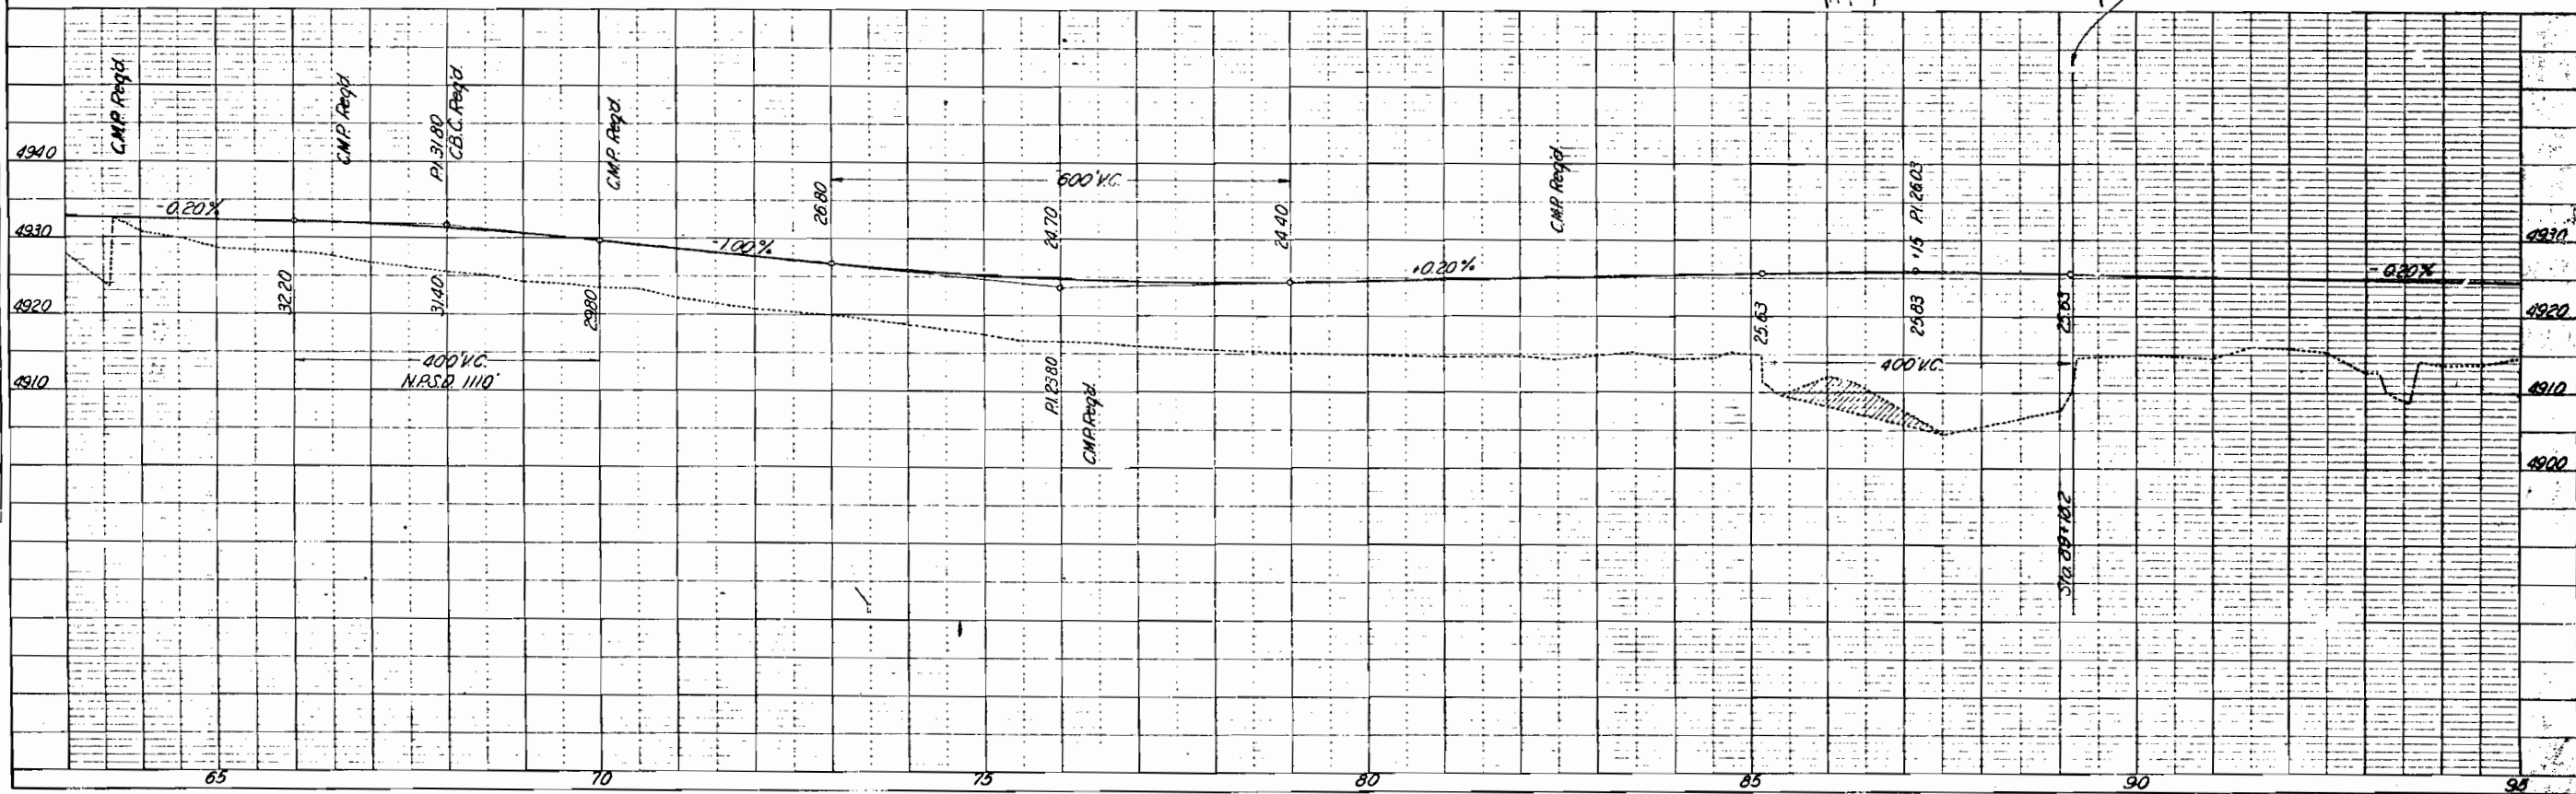

FED. ROAD DIST. NO.	STATE	S.N.F.A.D. PROJ. NO.	SHEET NO.	TOTAL SHEETS
3	COLO	210 C (1)	6	6

Revised 2-15-45 R.P.D. R.Q.W.

PLAT
OF PART OF
T.8S. R.97W. 6th P.M.
SHOWING CLAIMANTS WITH REGARD TO RIGHT OF
WAY FOR PROJECT S.N.F.A.P. 210 C (1)
SCALE 1 INCH = 800 FEET

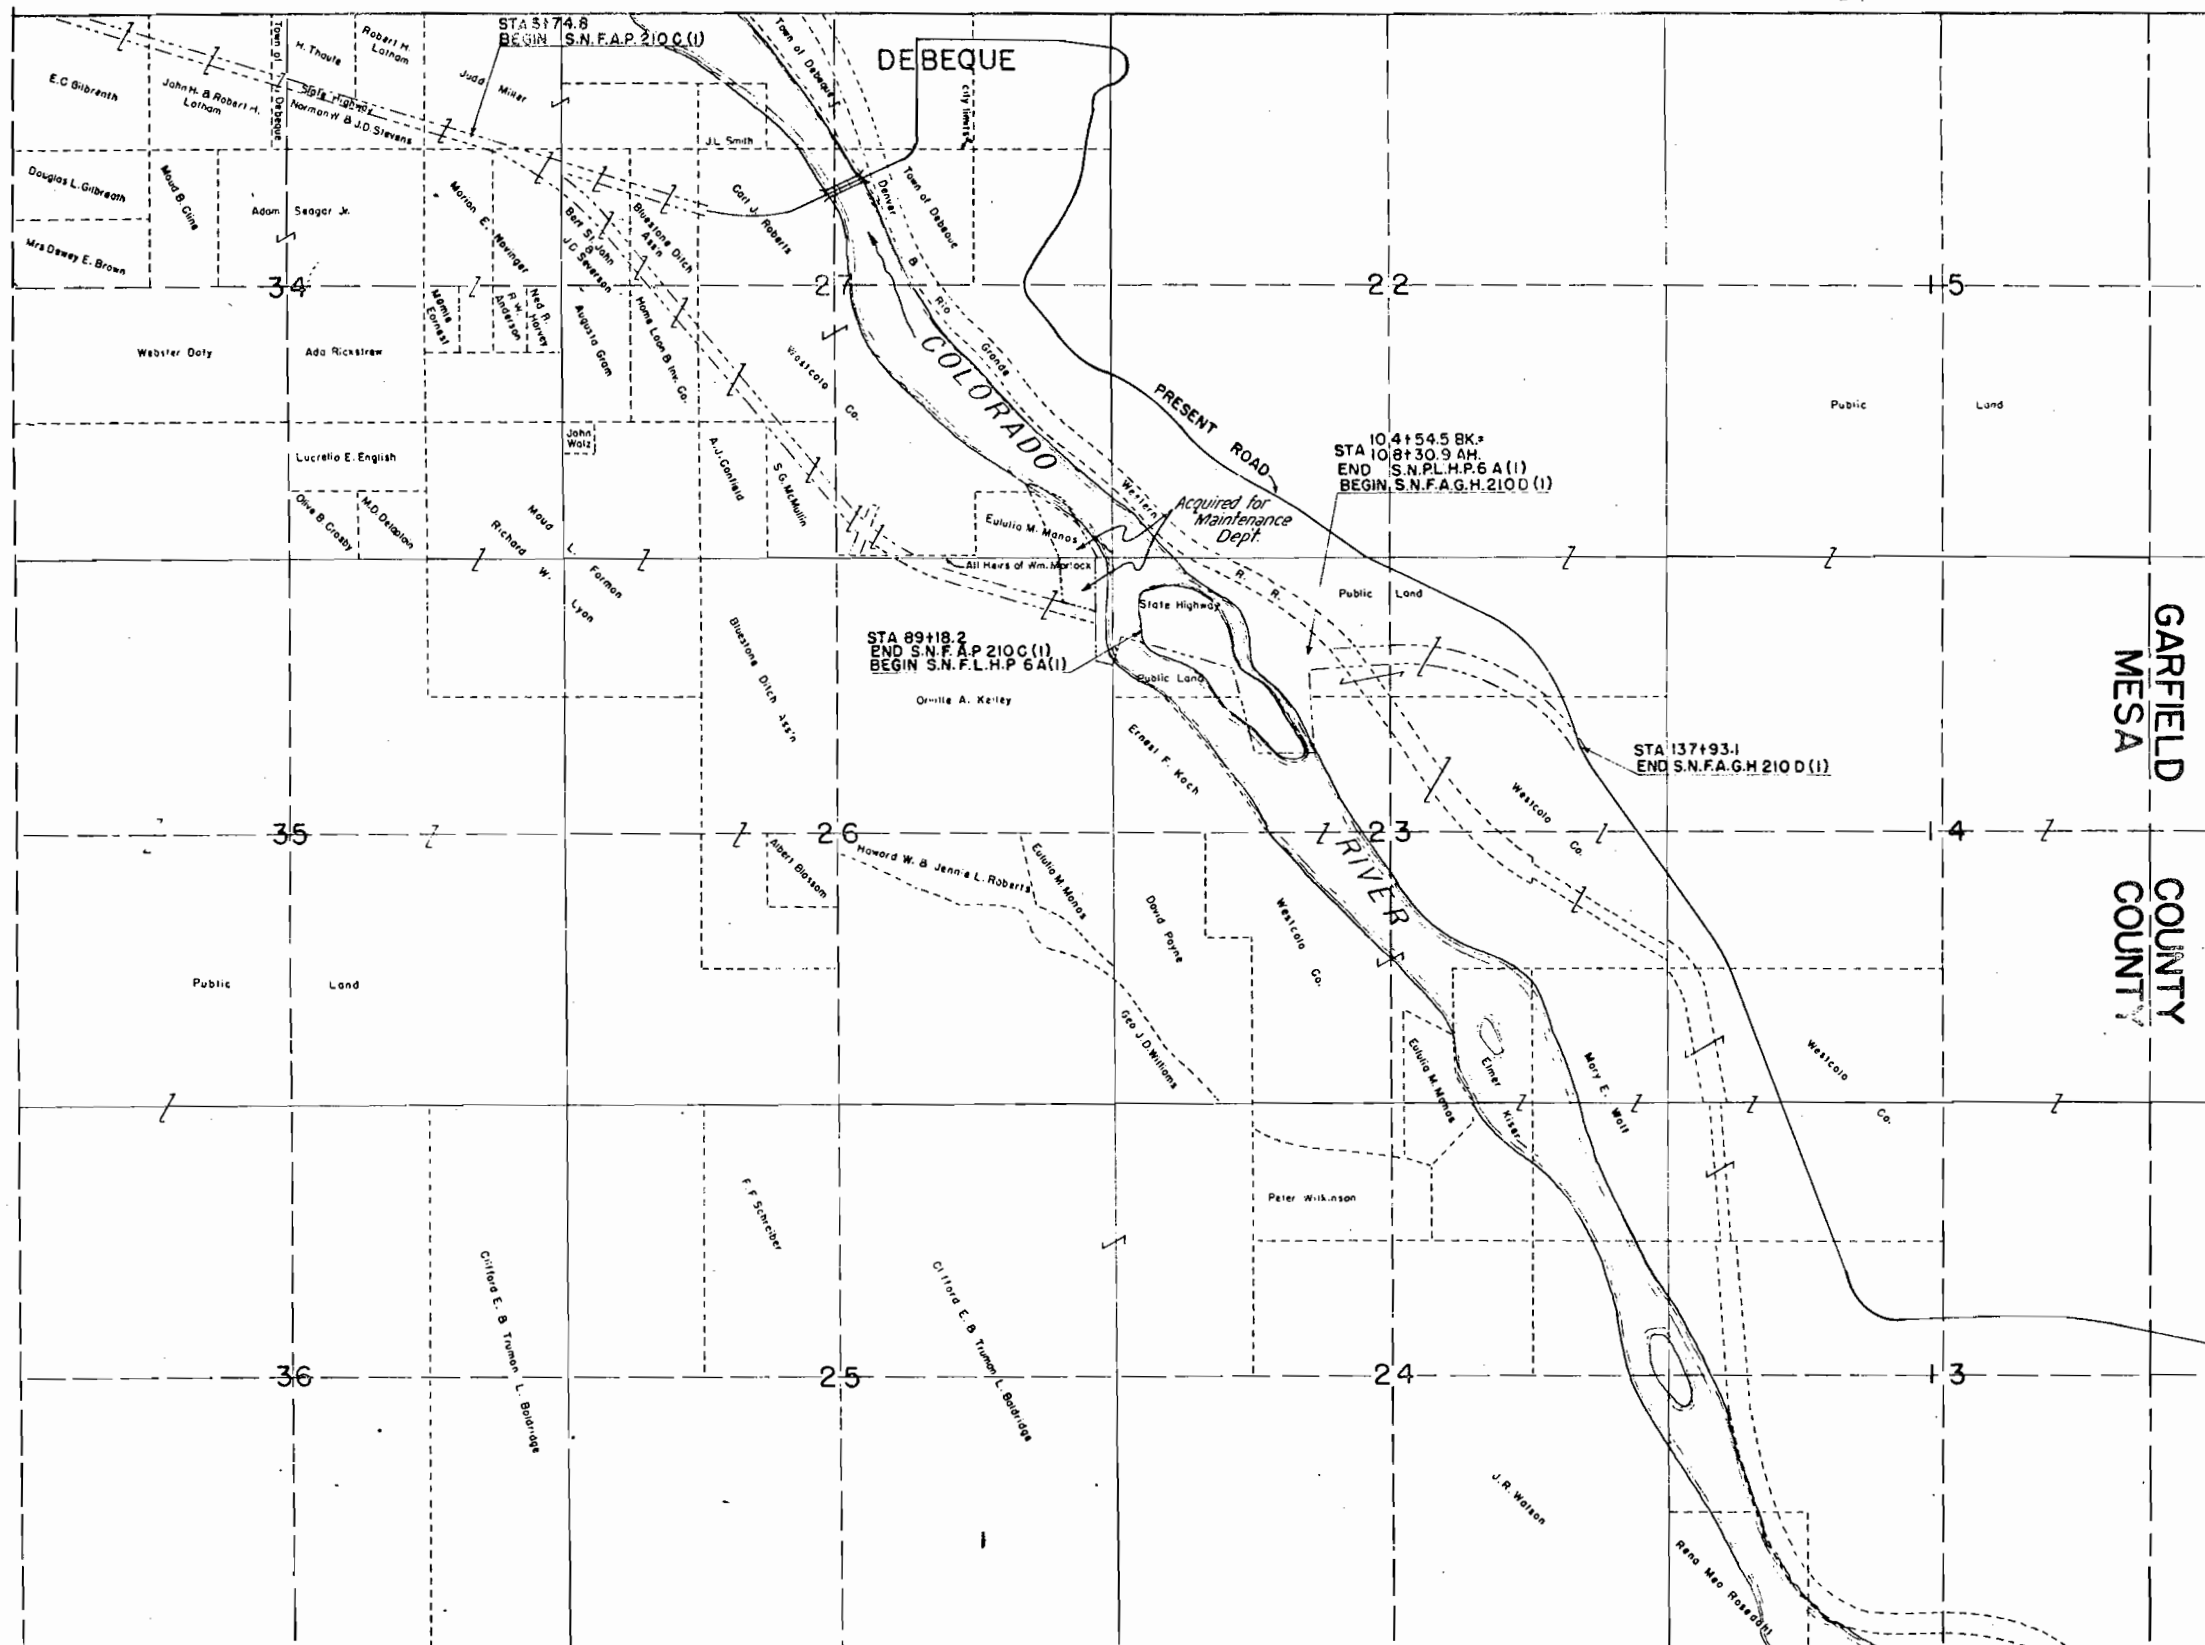

FED. ROAD DIST. NO.	STATE	S.N.-F.A.P. PROJ. NO.	SHEET NO.	TOTAL SHEETS
3	COLO.	210-C(II)	1	

REV. 5-24-44-E.P.

INDEX OF SHEETS

SHEET NO. 1	TITLE SHEET AND SKETCH MAP	
2	TYPICAL SECTION AND SURFACING PLAN	
3	SUMMARY OF QUANTITIES	
4	TABULATION OF STRUCTURES	
5	DETAILS OF BRIDGE, STA. 61+	
6-10	DETAILS OF BRIDGE, STA. 85+	
11	TYPICAL STANDARD NAME PLATE	M 6E
12	SPECIAL 6'x7' CONCRETE BOX CULVERT	M 101B (SPEC. REVISION)
13	STANDARD TIMBER GUARD POSTS	M 19B
14	STANDARD WIRE FENCES (TREATED WOODEN POSTS)	M 24G
15	STANDARD STRUCTURE NUMBER LETTERING	M 10A
16	STANDARD STRUCTURE YEAR NUMBER MARKING	M 14A
17	STANDARD METHODS FOR SUPERELEVATION AND WIDENING OF CURVES	M 1B
18	TYPICAL SIDE APPROACH ROADS-ROADWAY CONSTRUCTION TRAFFIC SIGNS	M 2B
19	STANDARD MARKER POST	M 7B
20	STANDARD CONTOUR-INTERCEPTING AND DRAINAGE DITCHES	M 107B
21-24	ALIGNMENT PLAN AND PROFILE	
25-56	ROADWAY CROSS SECTIONS	

11A STANDARD HEADWALLS FOR PIPE CULVERTS	M 102F
12A REINFORCED CONCRETE CULVERT PIPE	M 112D


COLORADO STATE HIGHWAY DEPARTMENT

PLAN AND PROFILE OF PROPOSED FEDERAL AID PROJECT NO. S.N.-F.A.P. 210-C(II) STATE HIGHWAY NO. 4 MESA COUNTY

SCALES OF ORIGINAL TRACINGS
ON PLAN, 1 IN. = 100 FT.
ON PROFILE 1 IN. = 100 FT. HORIZONTAL
1 IN. = 10 FT. VERTICAL
GRADE LINE ON PROFILE IS SHOWN AS GRADE OF FINISHED ROAD
GROSS LENGTH OF PROJECT 8,243.4 FT. = 1.561 MI.
NET LENGTH OF PROJECT

CONVENTIONAL SIGNS

CENTER LINE OF SURVEY	50
RIGHT OF WAY LINES	
COUNTY LINE	
TOWNSHIP OR RANGE LINES	
SECTION LINES	
ONE QUARTER SECTION LINES	
RAILROAD TRACKS	
BARBED WIRE FENCE	
POLE LINES	

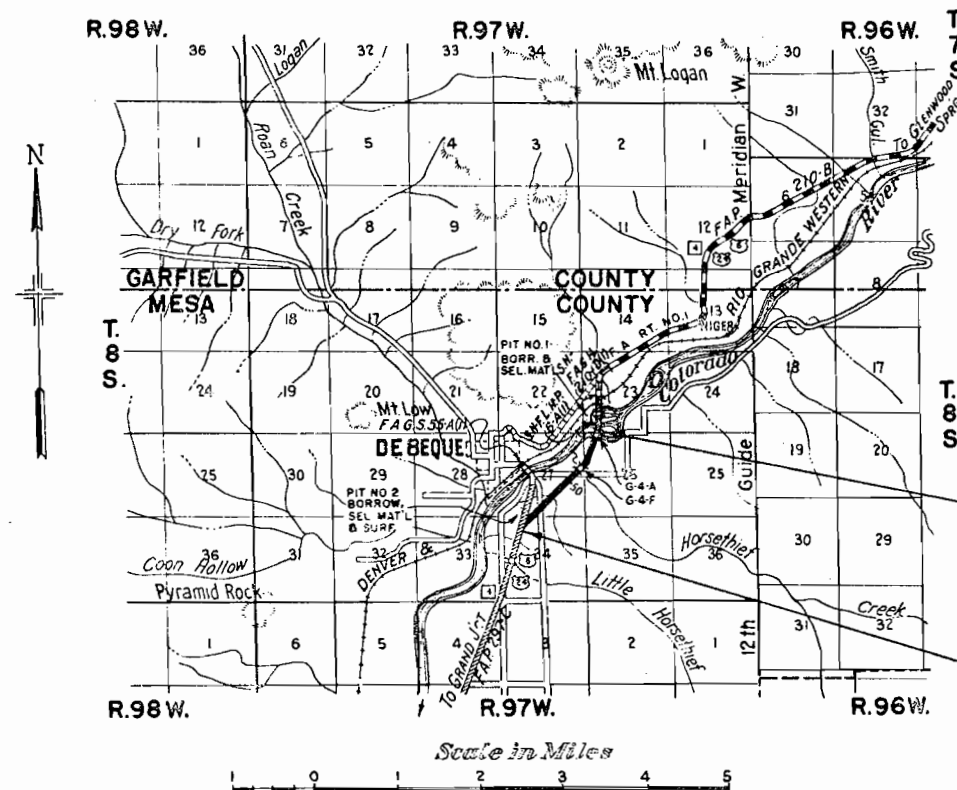

-NOTE-
It is recommended that bidders on this Project go over the plan details with one of the following field representatives of this Department.
J.R. Cheney, Division Engineer, at Grand Junction.
A.H. Batten, Resident Engineer, at Grand Junction

STA. 89+18.2
END OF S.N.-F.A.P. 210-C(II) -
BEGINNING OF S.N. F.L.H.P. 6-A(II)

STA. 6+748
BEGINNING OF S.N.-F.A.P. 210-C(II) -
STA. 67+26.2 OF F.A.P. 297-C

RECOMMENDED FOR APPROVAL
[Signature]
ASSISTANT ENGINEER DATE 12-22-41

APPROVED
[Signature]
STATE HIGHWAY ENGINEER DATE

RECOMMENDED FOR APPROVAL
DISTRICT ENGINEER
PUBLIC ROADS ADMINISTRATION
FEDERAL WORKS AGENCY

RECOMMENDED FOR APPROVAL
CHIEF WESTERN REGION
PUBLIC ROADS ADMINISTRATION
FEDERAL WORKS AGENCY

APPROVED
COMMISSIONER
PUBLIC ROADS ADMINISTRATION
FEDERAL WORKS AGENCY

Intercepting ditches shall be placed on light grades, (approx 1%) following the ground contour and where possible shall be so constructed that the direction of flow will be away from the Roadway, in order to spread runoff and thereby avoid erosion. This work shall be done in accordance with the methods shown on Standard Sheet No. M-107-B included in the plans. These ditches shall be constructed at locations indicated and as staked by the Engineer.


STATION	DESCRIPTION	REMOVE STRUCT.	UNCLASSIFIED EXCAVATION		STRUCTURAL EXCAVATION				MECH- ANICAL TAMP- ING HOURS	GRAVEL SURF. TONS	CONCRETE		REIN- FORCE STEEL LBS.	CONCRETE CULVERT PIPE				MISCELLANEOUS
			CU. YDS.		CU. YDS.						CU. YDS.			CU. YDS.				
			NO.	EXCAV.	EMB.	CU. YDS.	*							CL "A"	CL "B"	18"	24"	
6 + 74.3 7 + 00 to 55 + 60 9 + 14 + 00	Project Marker Intercepting Ditch, Rt Road Approach, Lt Cross Culvert. Inlet and Outlet			200	900	25			11	150	3.8		52				Project Marker	
15 + 25 17 + 18 + 30 18 + 50 21 + 55	Side Drain (No Hdwl's) and Road Approach, Rt. Road Approach, Lt. Remove 18" Muck and Backfill with Rock Cross Culvert. Inlet and Outlet Cross Culvert. Ditch Change, Rt and Lt			30 500 20	10	30 35			4 12 12	20 200			28	60 56				
24 + 50 29 + 20 30 + 30 35 + 50 39 + 50	Cross Culvert. Inlet and Outlet Road Approaches, Rt. and Lt. Cross Culvert. Inlet and Outlet Cross Culvert. Inlet and Outlet Cross Culvert. Inlet and Outlet			100	30	40			11	50	3.8		52					
42 + 00 47 + 00 50 + 00 51 + 15 53 + 15	Cross Culvert. Inlet and Outlet Cross Culvert. Inlet and Outlet Cross Culvert. Inlet and Outlet Road Approaches, Rt. and Lt. Cross Culvert. Inlet and Outlet				5 10 25	30 20 25			34 22 11		13.8 7.9 3.8		52	56	55			
55 + 75 56 + 50 56 + 95 56 + 84 61 + 50	Cross Culvert. Inlet and Outlet Road Approaches, Rt. and Lt. Side Drain, Rt. (No Hdwl's) Cross Culvert. Inlet and Outlet Cross Culvert. Ditch Change, Rt. and Lt.			50	10	20			25	30	7.9		64 68					
61 + 65 to 62 + 35.5 63 + 70 65 + 50 66 + 35	Tr. Timber Bridge, 3 spans @ 23' (Details on Sh. No. 5) Channel Change, Rt. & Lt. Cross Culvert. Inlet and Outlet Road Approaches, Rt. and Lt. Cross Culvert. Inlet and Outlet				10	20			40	100	13.8		65					
67 + 15 to 74 + 50 71 + 21 75 + 50 76 + 40	6' x 7' x 38" Concrete Box Culvert (Std. Mod. B) Inlet & Outlet Drain Ditches, Rt. and Lt. Cross Culvert. Ditch Change, Rt. and Lt. Road Approach, Rt. and Lt., Side Drain Rt. (No Hdwl's) Cross Culvert. Ditch Change, Rt. & Lt.				25 15	30 25			7 17 7		2.4 2.4		124 52	32				
77 + 00 to 85 + 00 82 + 50 83 + 117 to 89 + 18.2 89 + 18.2 90 + 55 + 59	Intercepting Ditch, Rt. Cross Culvert. Inlet and Outlet Steel Through Truss, 2 spans at 200' (Details on Sheets No. 6 to 10) Chan. Chg. Lt. & Rt. Project Marker Raise Power Line				130 10	15			15		3.8		72				Project Marker	
71 + 21	2-18" x 8' Culverts in drain ditch, Rt. and Lt. (No Hdwl's)				5				5				32					
TOTALS			10	1600	2575	630			374	610	68.6	96.1	6592	668	492	188	120	

* Structural Excavation is estimated to be 10 % Rock and 90 % Common, each of which is estimated to be 10 % Wet and 90% Dry
 * Included in profile quantities for payment

STANDARD P-117-BH-D

FED. ROAD DIST. NO.	STATE	SN. F.A.P.	SHEET NO.	TOTAL SHEETS
3	COLO.	210-C(1)	5	

Revised 6-14-40 W.M.D. Changed to 1940 Specifications.
REV 4141: W.B.S. Mechanical Tamping.

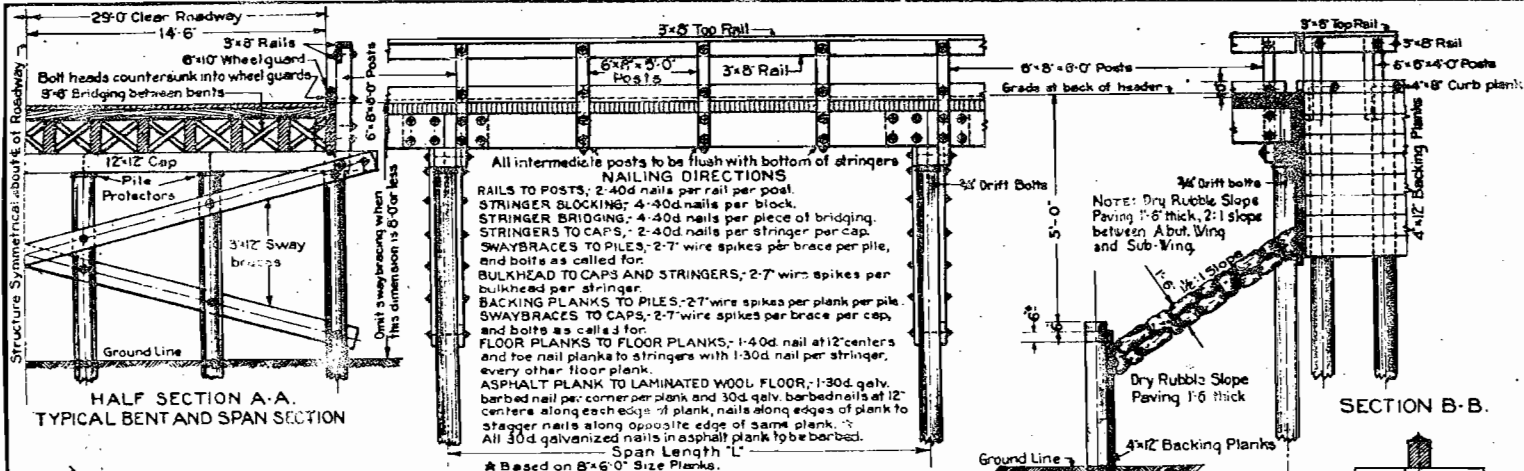

BOLTS AND WASHERS FOR ONE SPAN OF SUPERSTRUCTURE

LOCATION	SIZE	19'-0" SPAN	23'-0" SPAN	27'-0" SPAN
POSTS TO RAILS	3/8"	12.0	12.0	12.0
POSTS TO WHEEL GUARDS	3/4"	12.0	12.0	12.0
POSTS TO STRINGERS	3/4"	12.0	12.0	12.0
WHEEL GUARDS TO STRINGERS	3/4"	12.0	12.0	12.0
WASHERS: STD. C.I. O.G.	3/4"	12.0	12.0	12.0
TOTAL WEIGHT		146.0	147.0	147.0

BOLTS AND WASHERS FOR ONE ABUTMENT

LOCATION	ITEM	SIZE	NO.	LENGTH	WT. EACH	TOTAL WT.
POSTS TO RAILS	BOLTS	3/8"	2	10"	1.08 LBS.	2.16 LBS.
POSTS TO BULKHEAD TO CAP	BOLTS	3/4"	2	10"	1.08 LBS.	2.16 LBS.
POSTS TO STRINGERS	BOLTS	3/4"	2	10"	1.08 LBS.	2.16 LBS.
POSTS TO WHEEL GUARDS	BOLTS	3/4"	2	10"	1.08 LBS.	2.16 LBS.
WHEEL GUARDS TO STRINGERS	BOLTS	3/4"	2	10"	1.08 LBS.	2.16 LBS.
TIMBER HEADER TO STRINGERS	LAG SCREWS	5/8"	14	16"	1.36 LBS.	19.04 LBS.
WASHERS: STD. C.I. O.G.	WASHERS	3/4"	22	16"	0.75 LBS.	16.50 LBS.
CAPS TO PILES	DRIFT BOLTS	3/4"	7	24"	3.00 LBS.	21.00 LBS.
TOTAL WEIGHT						108.0 LBS.

BOLTS AND WASHERS FOR ONE BENT

LOCATION	ITEM	SIZE	NO.	LENGTH	WT. EACH	TOTAL WT.
POSTS TO RAILS	BOLTS	3/8"	2	10"	1.08 LBS.	2.16 LBS.
POSTS TO WHEEL GUARDS	BOLTS	3/4"	2	10"	1.08 LBS.	2.16 LBS.
POSTS TO CAPS WITHOUT SWAYS	BOLTS	3/8"	2	10"	1.08 LBS.	2.16 LBS.
WHEEL GUARDS TO STRINGERS	BOLTS	3/4"	2	10"	1.08 LBS.	2.16 LBS.
POSTS TO STRINGERS TO SPICES	BOLTS	3/4"	2	10"	1.08 LBS.	2.16 LBS.
POSTS TO CAP SWAYS	BOLTS	3/8"	2	10"	1.08 LBS.	2.16 LBS.
SWAYS TO CAPS	BOLTS	3/8"	2	10"	1.08 LBS.	2.16 LBS.
SWAYS TO PILES	BOLTS	3/8"	2	10"	1.08 LBS.	2.16 LBS.
WASHERS: STD. C.I. O.G.	WASHERS	3/4"	32	16"	0.75 LBS.	24.00 LBS.
WASHERS: STD. C.I. O.G. WITH SWAYS	WASHERS	3/4"	60	16"	0.75 LBS.	45.00 LBS.
CAPS TO PILES	DRIFT BOLTS	3/4"	6	24"	3.00 LBS.	18.00 LBS.
TOTAL WEIGHT WITHOUT SWAYS						115.0 LBS.
TOTAL WEIGHT WITH SWAYS						159.0 LBS.

NAILS

LOCATION	ITEM	19'-0" SPAN	23'-0" SPAN	27'-0" SPAN
ONE SPAN OF SUPERSTRUCTURE	30D. COMMON	25 LBS.	30 LBS.	35 LBS.
ONE ABUTMENT	30D. COMMON	165 LBS.	185 LBS.	225 LBS.
ONE WING	30D. COMMON	165 LBS.	185 LBS.	225 LBS.
ONE SUB-ABUTMENT	30D. COMMON	165 LBS.	185 LBS.	225 LBS.
ONE BENT	30D. COMMON	165 LBS.	185 LBS.	225 LBS.
TOTAL WEIGHT		90	450	613

SUMMARY FOR HARDWARE

LOCATION	UNIT	30D. COMMON	30D. GALV.	40D. COMMON	7 WIRE SPIKES
3 SPANS	AT	147 LBS. PER SPAN		441 LBS.	
2 ABUTMENTS	AT	108 LBS. PER ABUTMENT		216 LBS.	
4 WINGS	AT	50 LBS. PER WING		200 LBS.	
2 BENTS WITHOUT SWAYS	AT	115 LBS. PER BENT		230 LBS.	
2 BENTS WITH SWAYS	AT	159 LBS. PER BENT		318 LBS.	
TOTAL WEIGHT				1175 LBS.	

SUMMARY OF QUANTITIES

ITEM	QUANTITY	UNIT
ITEM 14a DRY ROCK	-	CU. YDS.
ITEM 14b DRY COMMON	162	CU. YDS.
ITEM 14c WET ROCK	-	CU. YDS.
ITEM 14d WET COMMON	10	CU. YDS.
ITEM 42a UNTREATED BRIDGE TIMBER		
3 SPANS	AT	312 BO. FT. EACH = 936 BO. FT.
2 ABUTMENTS	AT	48 BO. FT. EACH = 96 BO. FT.
4 WINGS	AT	64 BO. FT. EACH = 256 BO. FT.
2 BENTS	AT	48 BO. FT. EACH = 96 BO. FT.
TOTAL		1488 BO. FT.
ITEM 42b TREATED BRIDGE TIMBER		
3 SPANS	AT	8552 BO. FT. EACH = 25656 BO. FT.
2 ABUTMENTS	AT	1336 BO. FT. EACH = 2672 BO. FT.
4 WINGS	AT	232 BO. FT. EACH = 928 BO. FT.
2 SUB-ABUTMENTS	AT	1512 BO. FT. EACH = 3024 BO. FT.
2 BENTS	AT	846 BO. FT. EACH = 1692 BO. FT.
TOTAL		33928 BO. FT.
ITEM 43 ASPHALT PLANK WEARING SURFACE		
3 SPANS	AT	627 SQ. FT. EACH = 1881 SQ. FT.
2 ABUTMENTS	AT	210 LIN. FT. EACH = 420 LIN. FT.
4 WINGS	AT	96 LIN. FT. EACH = 384 LIN. FT.
2 SUB-ABUTMENTS	AT	336 LIN. FT. EACH = 672 LIN. FT.
2 BENTS	AT	180 LIN. FT. EACH = 360 LIN. FT.
TOTAL		1636 LIN. FT.
ITEM 60a METAL PILE SHOES		
(SEE DETAIL)		
ITEM 64 DRY RUBBLE SLOPE PAVING 1'-6" THICK		
ITEM 89b DRAIN PIPE		
2 PIECES 3" DIA. GALV. PIPE 2'-4" LONG WITH ONE 3" GALV. FLANGE ON EACH PIPE		
3 SPANS	AT	2 COMPLETE PER SPAN = 6 PIECES
ITEM 14e MECHANICAL TAMPING		
ABOUT 22 HRS. / ABOUT 194 = 21 HRS. (SUB-ABUT. & WINGS INCL.) TOTAL		43 HRS.

ONE SPAN OF SUPERSTRUCTURE

DESCRIPTION	SIZE	19'-0" SPAN	23'-0" SPAN	27'-0" SPAN
HANDRAILS 54S	3'-6"	12.0	12.0	12.0
HANDRAIL POSTS 54S	6'-8"	12.0	12.0	12.0
TOTAL UNTREATED TIMBER		260 BO. FT.	312 BO. FT.	364 BO. FT.

ONE ABUTMENT

DESCRIPTION	SIZE	19'-0" SPAN	23'-0" SPAN	27'-0" SPAN
HANDRAIL POSTS 54S	2 PCS.	6'-8"	6'-8"	6'-8"
TOTAL UNTREATED TIMBER		48 BO. FT.	48 BO. FT.	48 BO. FT.
TOTAL TREATED TIMBER		1356 BO. FT.	1636 BO. FT.	1920 BO. FT.
PILING - TREATED		7 PIECES AT 30 LIN. FT. EACH = 210 LIN. FT.		

ONE WING

DESCRIPTION	SIZE	19'-0" SPAN	23'-0" SPAN	27'-0" SPAN
HANDRAILS 54S	3'-6"	12.0	12.0	12.0
HANDRAIL POSTS 54S	6'-8"	12.0	12.0	12.0
TOTAL UNTREATED TIMBER		84 BO. FT.	84 BO. FT.	84 BO. FT.
TOTAL TREATED TIMBER		232 BO. FT.	232 BO. FT.	232 BO. FT.
PILING - TREATED		3 PIECES AT 32 LIN. FT. EACH = 96 LIN. FT.		

ONE SUB-ABUTMENT AND WINGS

DESCRIPTION	SIZE	19'-0" SPAN	23'-0" SPAN	27'-0" SPAN
HANDRAILS 54S	3'-6"	12.0	12.0	12.0
HANDRAIL POSTS 54S	6'-8"	12.0	12.0	12.0
TOTAL UNTREATED TIMBER		84 BO. FT.	84 BO. FT.	84 BO. FT.
TOTAL TREATED TIMBER		232 BO. FT.	232 BO. FT.	232 BO. FT.
PILING - TREATED		3 PIECES AT 32 LIN. FT. EACH = 96 LIN. FT.		

ONE BENT

DESCRIPTION	SIZE	19'-0" SPAN	23'-0" SPAN	27'-0" SPAN
HANDRAILS 54S	3'-6"	12.0	12.0	12.0
HANDRAIL POSTS 54S	6'-8"	12.0	12.0	12.0
TOTAL UNTREATED TIMBER		84 BO. FT.	84 BO. FT.	84 BO. FT.
TOTAL TREATED TIMBER		232 BO. FT.	232 BO. FT.	232 BO. FT.
PILING - TREATED		3 PIECES AT 32 LIN. FT. EACH = 96 LIN. FT.		

STRUCTURES REQUIRED

DESCRIPTION	SIZE	19'-0" SPAN	23'-0" SPAN	27'-0" SPAN
HANDRAILS 54S	3'-6"	12.0	12.0	12.0
HANDRAIL POSTS 54S	6'-8"	12.0	12.0	12.0
TOTAL UNTREATED TIMBER		84 BO. FT.	84 BO. FT.	84 BO. FT.
TOTAL TREATED TIMBER		232 BO. FT.	232 BO. FT.	232 BO. FT.
PILING - TREATED		3 PIECES AT 32 LIN. FT. EACH = 96 LIN. FT.		

LOADING DATA

DESCRIPTION	SIZE	19'-0" SPAN	23'-0" SPAN	27'-0" SPAN
HANDRAILS 54S	3'-6"	12.0	12.0	12.0
HANDRAIL POSTS 54S	6'-8"	12.0	12.0	12.0
TOTAL UNTREATED TIMBER		84 BO. FT.	84 BO. FT.	84 BO. FT.
TOTAL TREATED TIMBER		232 BO. FT.	232 BO. FT.	232 BO. FT.
PILING - TREATED		3 PIECES AT 32 LIN. FT. EACH = 96 LIN. FT.		

STRUCTURE NO. G-4-F

DESCRIPTION	SIZE	19'-0" SPAN	23'-0" SPAN	27'-0" SPAN
HANDRAILS 54S	3'-6"	12.0	12.0	12.0
HANDRAIL POSTS 54S	6'-8"	12.0	12.0	12.0
TOTAL UNTREATED TIMBER		84 BO. FT.	84 BO. FT.	84 BO. FT.
TOTAL TREATED TIMBER		232 BO. FT.	232 BO. FT.	232 BO. FT.
PILING - TREATED		3 PIECES AT 32 LIN. FT. EACH = 96 LIN. FT.		

REVISED DIMENSIONS, COLLISION RAIL 42-94 RCB Rev. Steel Wts. for Simp Str Shapes 1-B-42 H.C.C.
 CHANGED EXPANSION JOINTS 11-13 44 RCB
 CHANGED 1/2" BARS TO 3/8" BARS 5-24-44 G.R.B.
 CHANGED MEMBERS, 2" PARALLEL 23-AT 23-44 RCB





FED. ROAD DIST. NO.	STATE	SN. F.P.	SHEET NO.	TOTAL SHEETS
3	COLO.	210-C	7	

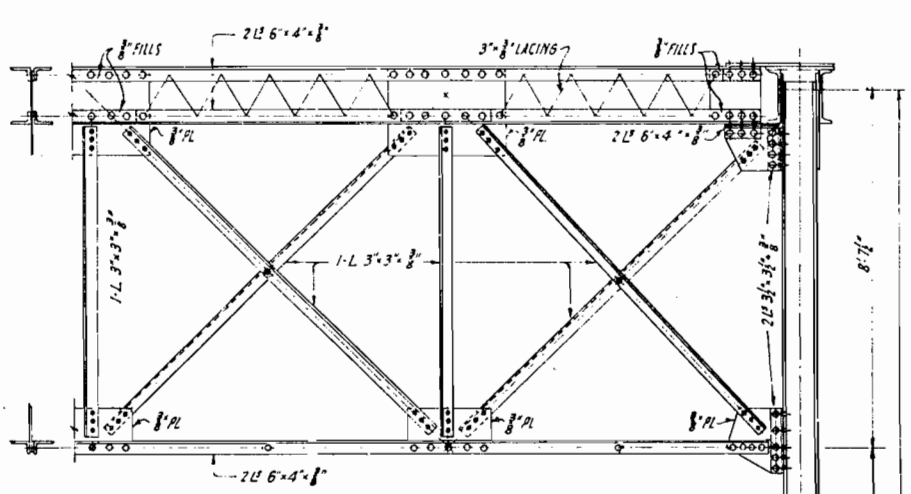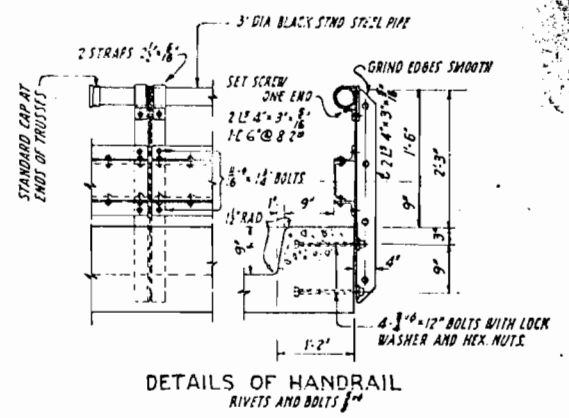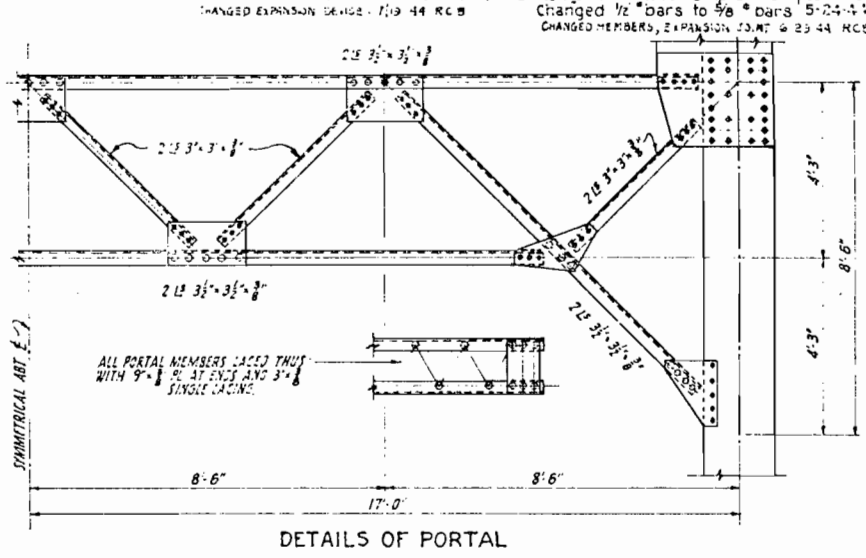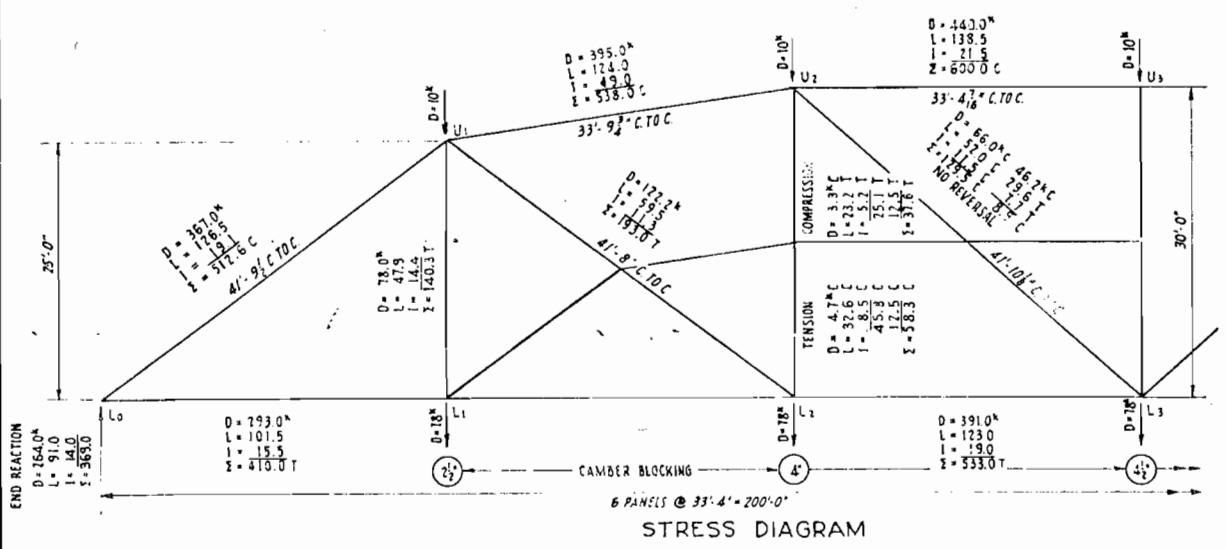

BAR LIST FOR ONE SPAN OF SUPERSTRUCTURE			
MARK	NO	SIZE	LENGTH
D1	210	3/8"	33'-0"
D2	42	3/8"	34'-0"
E1	138	5/8"	35'-0"
E2	932	5/8"	33'-2"

BENDING DIAGRAMS			
STRAIGHT			
SYMMETRICAL ABT. E			
RAD 27"			

BAR SUMMARY	
30,645 LIN. FT. OF 3/8" BARS @ 1043 LBS. PER LIN. FT. =	31,967 LBS.
PLUS 1% FOR OVERRUN =	323 LBS.
TOTAL =	32,290 LBS.

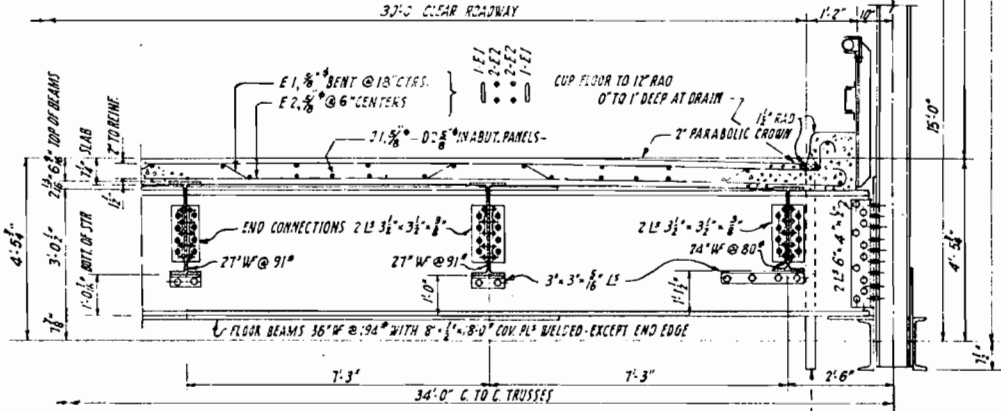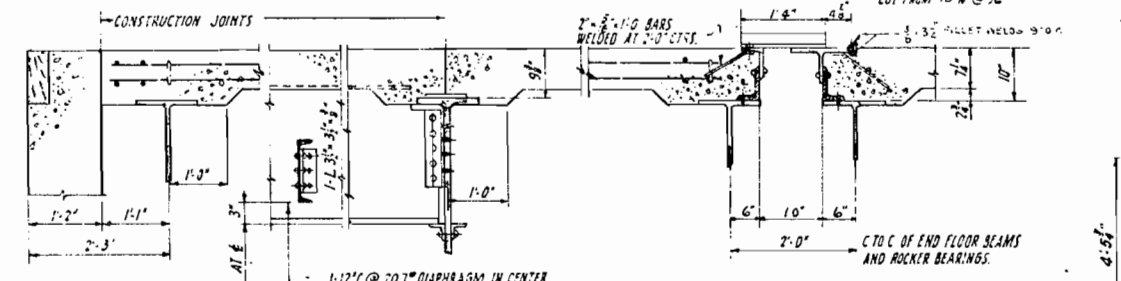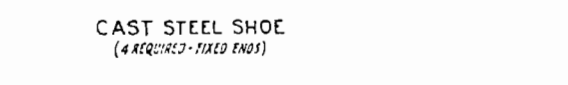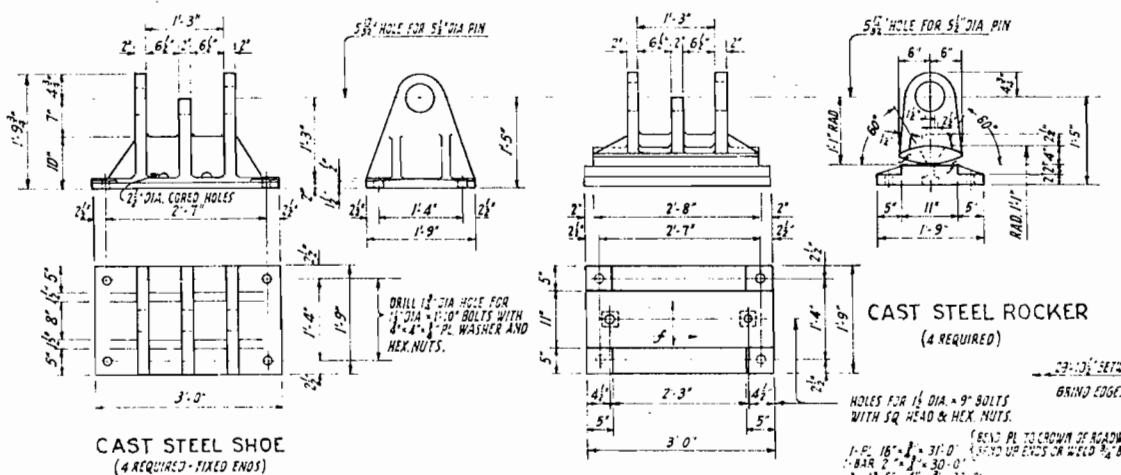

ESTIMATED QUANTITIES				
ITEM	DESCRIPTION	UNIT	ONE SPAN	SPANS
46 a	CLASS "A" CONCRETE	CUYD	188.5	
47	REINFORCING STEEL (INCLUDES 1% FOR OVERRUN)	LBS	32,290	
48	STRUCTURAL STEEL (INCLUDES 2% FOR OVERRUN)	LBS	372,500	
89 a	DRAIN PIPE (CONC. FLOOR) (FLANGE INCL)	EACH	12	
91	PIPE RAILING (BLACK STD STL 3" DIA @ 2575 LBS LIN. FT)	LIN. FT	403	

THIS INCLUDES 4,300 LBS FOR CAST STEEL SHOES

LOADING DATA:
 LIVE LOAD A.A.S.H.O. 1941 CLASS A, H-15;
 DEAD LOAD: ASSUMES 15 LBS. PER SQ. FT. ADDITIONAL WEARING SURFACE WHICH INCLUDES THE 1/2 INCH CONCRETE MONOLITHIC WEARING SURFACE SHOWN.

DESIGNING DATA:
 A.A.S.H.O. 1941, 16,000 LBS. = 833 LBS. = 11.2

REFERENCE DRAWINGS	
Sheet N° 6 Gen. Layout, Bar Lists	
Sheet N° 8 200' Truss Details & General Notes	
Sheet N° 9 Abutments 1 & 3	
Sheet N° 10 Pier # 2	

COLORADO STATE HIGHWAY DEPARTMENT
 2-200 FT. THRU TRUSSES
 30 FT. CLEAR ROADWAY
 PORTAL & FLOOR DETAILS


Across **COLORADO RIVER**
 Sta. 85+11.15 TO STA. 89+18.78
 Near **DE BEQUE** Sec. 15, T. 8 S., R. 97 W.

Designed by **W.H.** Approved by **G.D. Bailey**
 Made by **W.B.S.** Bridge Engineer
 Checked by **J.D.S.** Date: **Dec. 8, 1941.**

Designed By	W.H.	Date	
Checked By	W.B.S.		
Drawn By	W.B.S.		
Traced By	W.B.S.		
Checked By	W.B.S.		

REV 1-8-42. WGS R. 1005 & extension side 12' and out;
also Lower Chord C Section H.C.C.

FED. ROAD DIST. NO.	STATE	SN. F.A.P.	SHEET NO.	TOTAL SHEETS
3	COLO.	210-C	8	

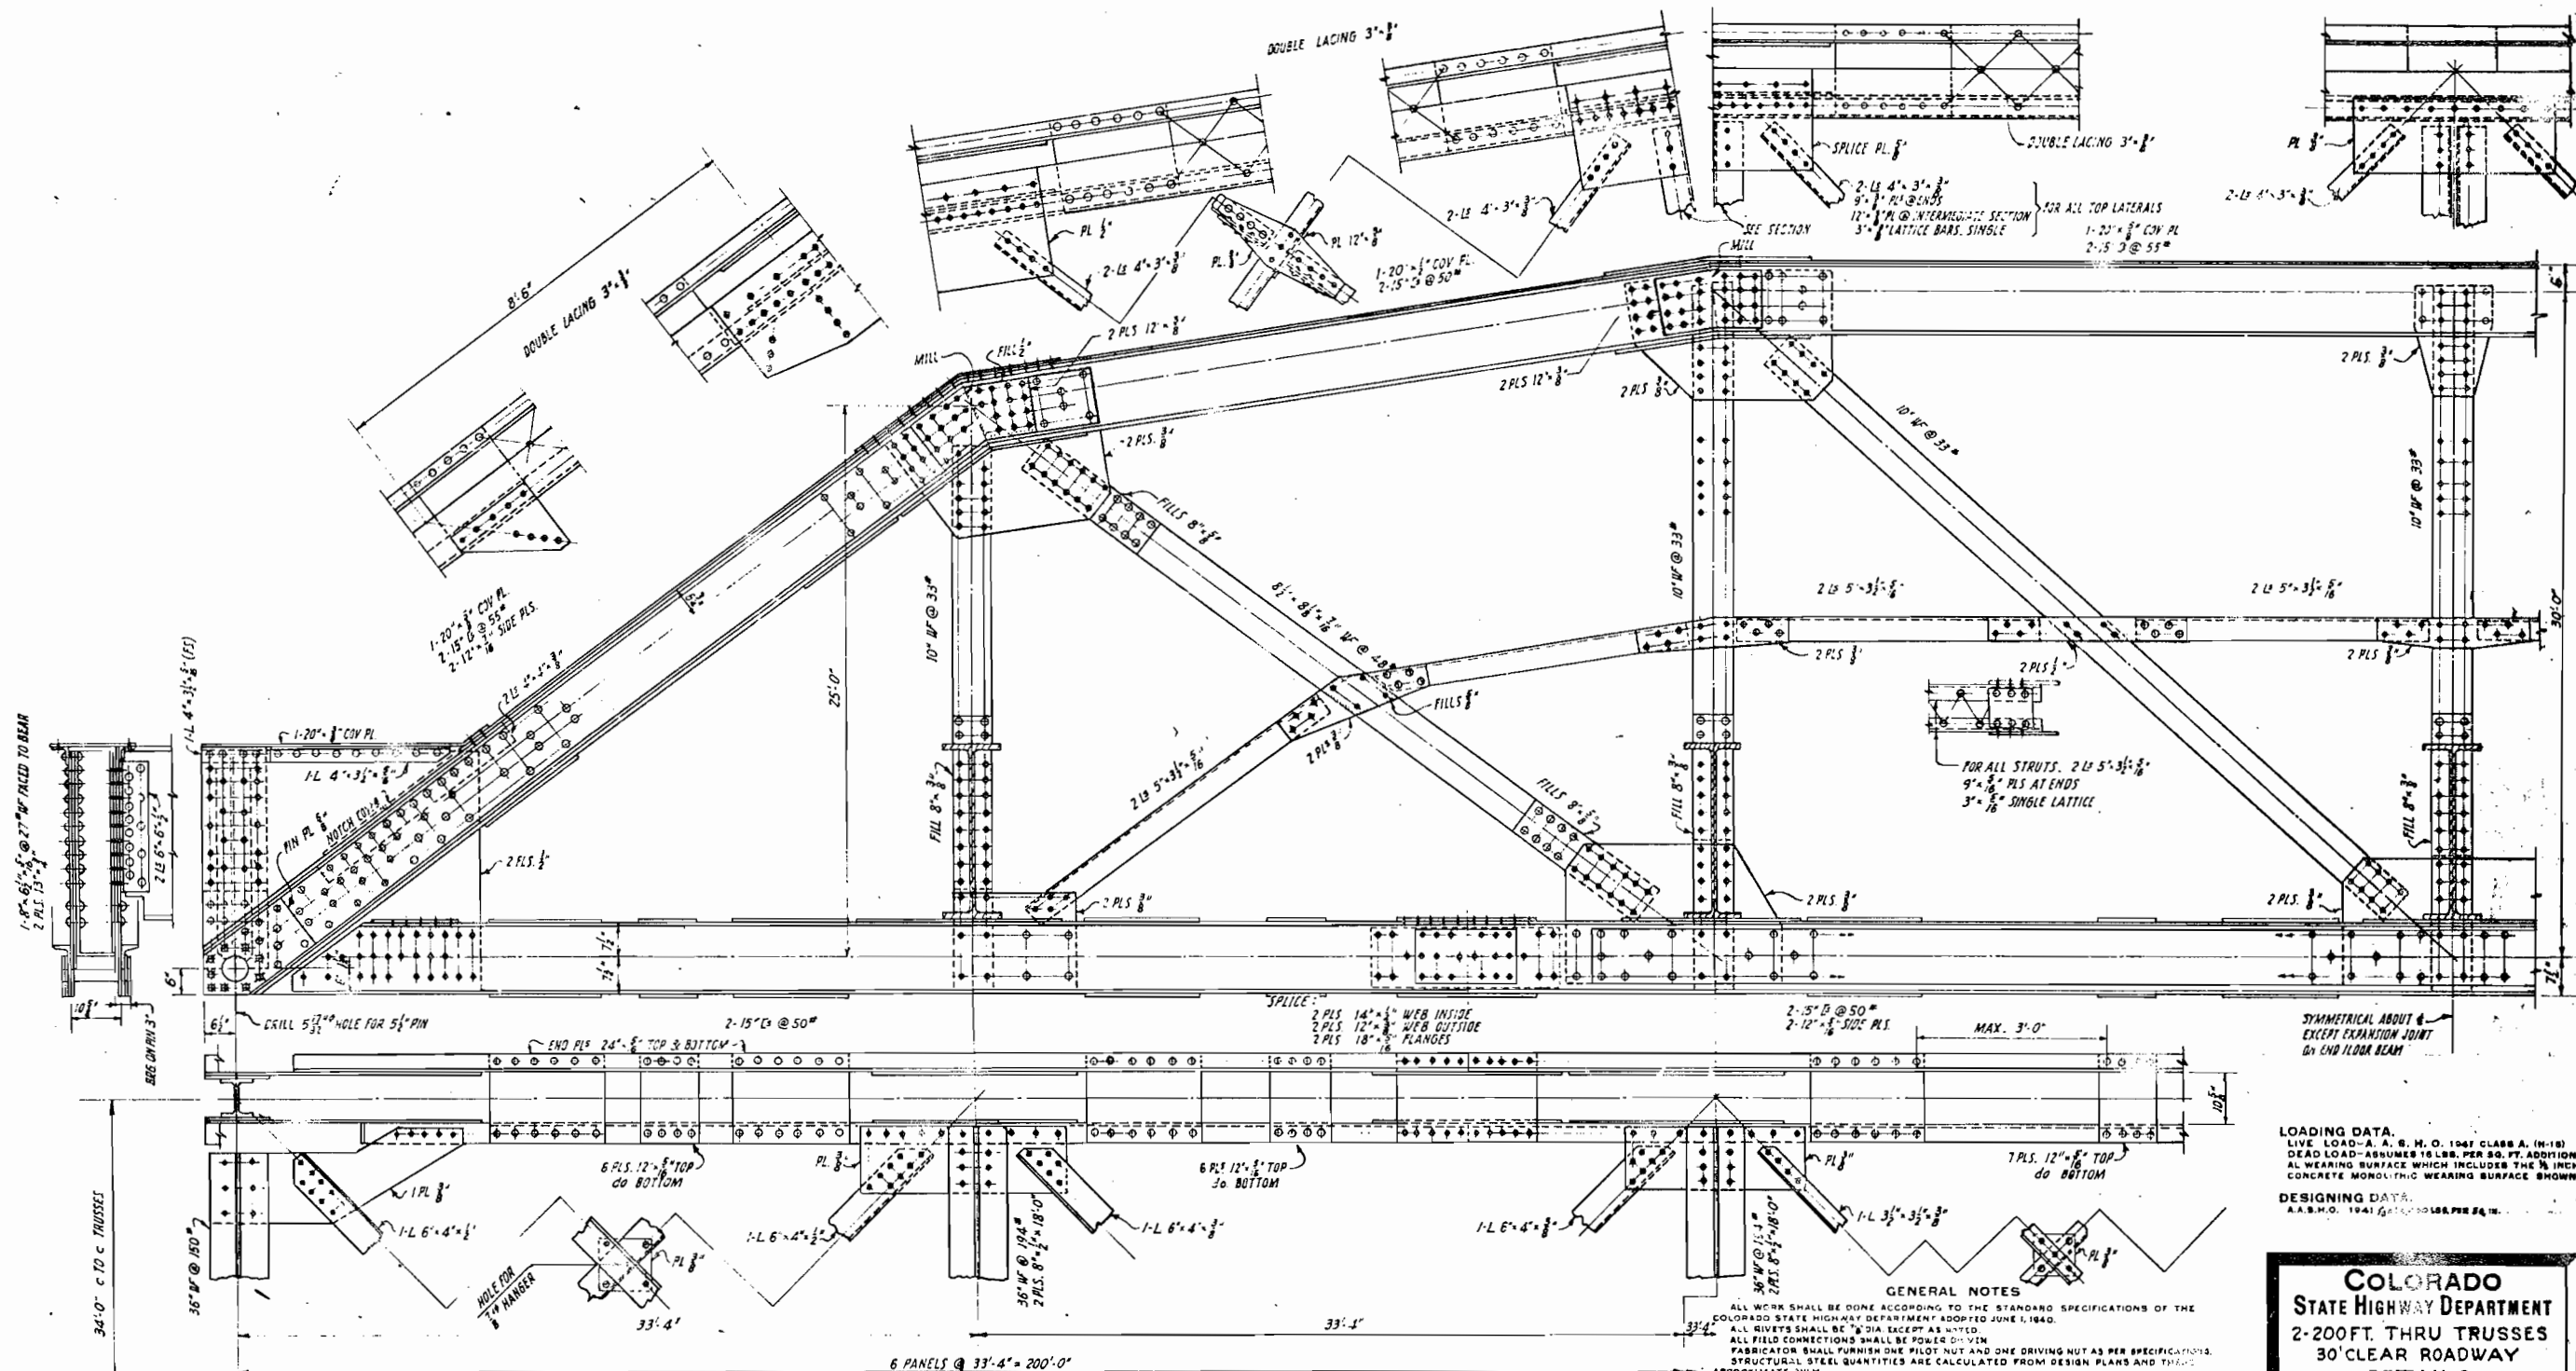

LOADING DATA.
LIVE LOAD-A. A. S. H. O. 1941 CLASS A. (H-18)
DEAD LOAD-ASSUMES 16 LBS. PER SQ. FT. ADDITION-
AL WEARING SURFACE WHICH INCLUDES THE 1/2 INCH
CONCRETE MONOLITHIC WEARING SURFACE SHOWN

DESIGNING DATA.
A.A.S.H.O. 1941 1/2 INCH MONOLITHIC WEARING SURFACE

COLORADO STATE HIGHWAY DEPARTMENT
2-200FT. THRU TRUSSES
30' CLEAR ROADWAY
DETAILS



Across COLORADO RIVER
Sta. 85+11.75 TO STA. 89+18.25
Near DE BEQUE Soc. 23/26 T. 8 S. R. 21 W.
Designed by W.M. Approved by P.D. Bailey
Made by W.M. Bridge Engineer
Checked by Date: Dec. 8th 1941.

REFERENCE DRAWINGS
Sheet No 6 Gen. Layout, Bar List
Sheet No 7 Truss Portal & Floor Details
Sheet No 9 Abutments 1 & 3
Sheet No 10 Pier #2






GENERAL NOTES (CONT.)
BOUNDINGS AND DEPTH OF FOOTINGS SHOWN ARE ACCORDING TO THE BEST AVAILABLE DATA. IF
ESSENTIALLY DIFFERENT CONDITIONS ARE ENCOUNTERED THE BRIDGE ENGINEER WILL INSPECT
AND DETERMINE IF REVISION IS NECESSARY.
ROADWAY FLOOR SLAB IS SHOWN INCLUDING 1/2 IN MONOLITHIC WEARING SURFACE.
A VERTICAL CONSTRUCTION JOINT IS REQUIRED TRANSVERSELY IN THE CONCRETE FLOOR
OVER EACH FLOOR BEAM.

GENERAL NOTES
ALL WORK SHALL BE DONE ACCORDING TO THE STANDARD SPECIFICATIONS OF THE
COLORADO STATE HIGHWAY DEPARTMENT ADOPTED JUNE 1, 1940.
ALL RIVETS SHALL BE 3/4" DIA. EXCEPT AS NOTED.
ALL FIELD CONNECTIONS SHALL BE POWER DRIVEN.
FABRICATOR SHALL TURNISH ONE PILOT NUT AND ONE DRIVING NUT AS PER SPECIFICATIONS.
STRUCTURAL STEEL QUANTITIES ARE CALCULATED FROM DESIGN PLANS AND THESE
APPROXIMATE ONLY.
ALL HOLES IN TOP AND BOTTOM CHORD SPICES SHALL BE SUB-PUNCHED 1/8" DIA. AND
REAMED.
ALL HOLES IN FLOOR BEAM AND STRINGER FIELD CONNECTIONS SHALL BE SUB-
PUNCHED AND REAMED TO AN IRON TEMPLATE.
FOR GENERAL NOTES ON CONCRETE AND DETAILS OF SUB-STRUCTURE SEE SHEET NO
ALL CONCRETE SHALL BE CLASS "A".
FORMS FOR CONCRETE SURFACES EXPOSED IN THE FINISHED WORK SHALL BE CONSTRUCTED
OF SHIP LAP OR TONGUE AND GROOVE LUMBER 3/4" UNLESS FACED WITH PANEL BOARD.
CONCRETE FLOOR, SLABS AND CURB SHALL BE POURED MONOLITHICALLY.
FOOTINGS IN ROCK SHALL BE POURED OUT TO THE ROCK AND NOT FORMED.
ALL REINFORCING BARS SHALL BE DEFORMED AND TAGGED WITH THE STATION NUMBER AND
LETTER DESIGNATION. MAIN BARS SHALL NOT BE SPICED.

FED. ROAD DIST. NO.	STATE	SN F.A.P.	SHEET NO.	TOTAL SHEETS
3	COLO.	210-C	9	

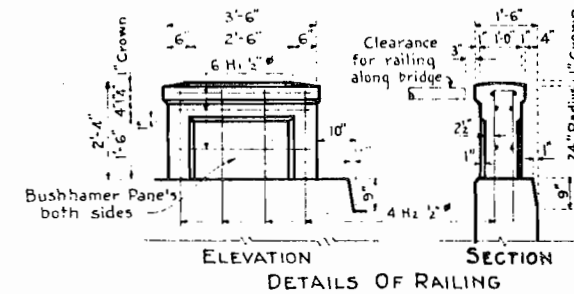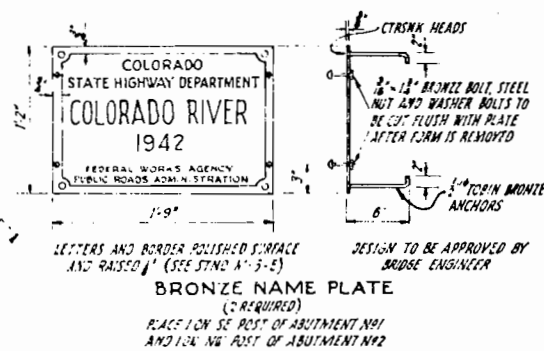

Designed By	WM	Date	9-26-41
Checked By	RMA		
Drawn By	WM		
Checked By	RMA		
Traced By	W.P.H.		10-31-41
Checked By	WM		11-7-41

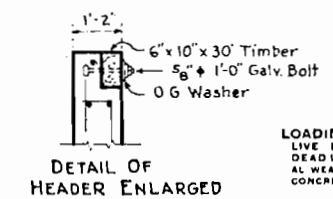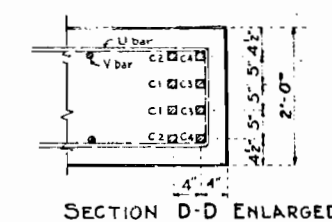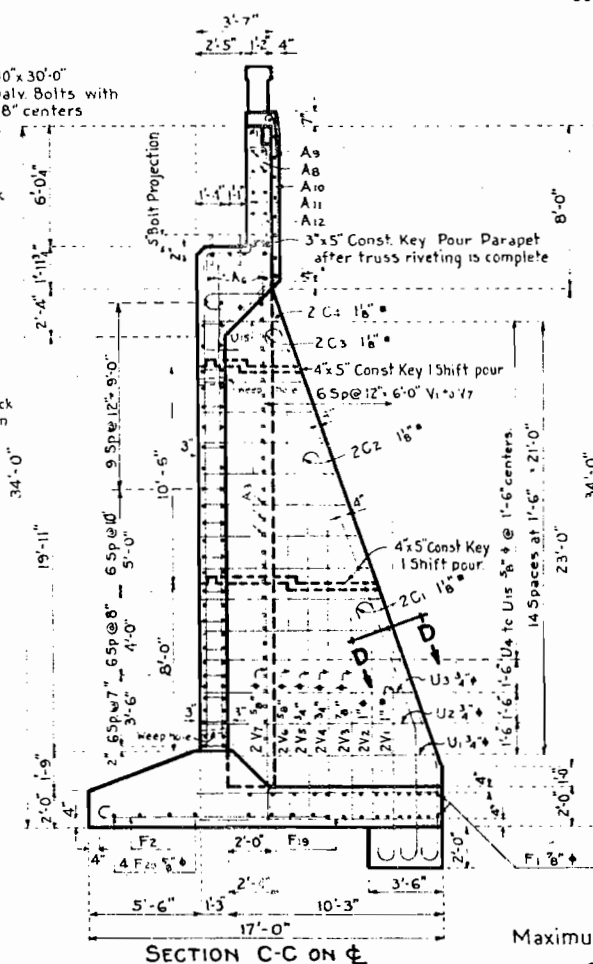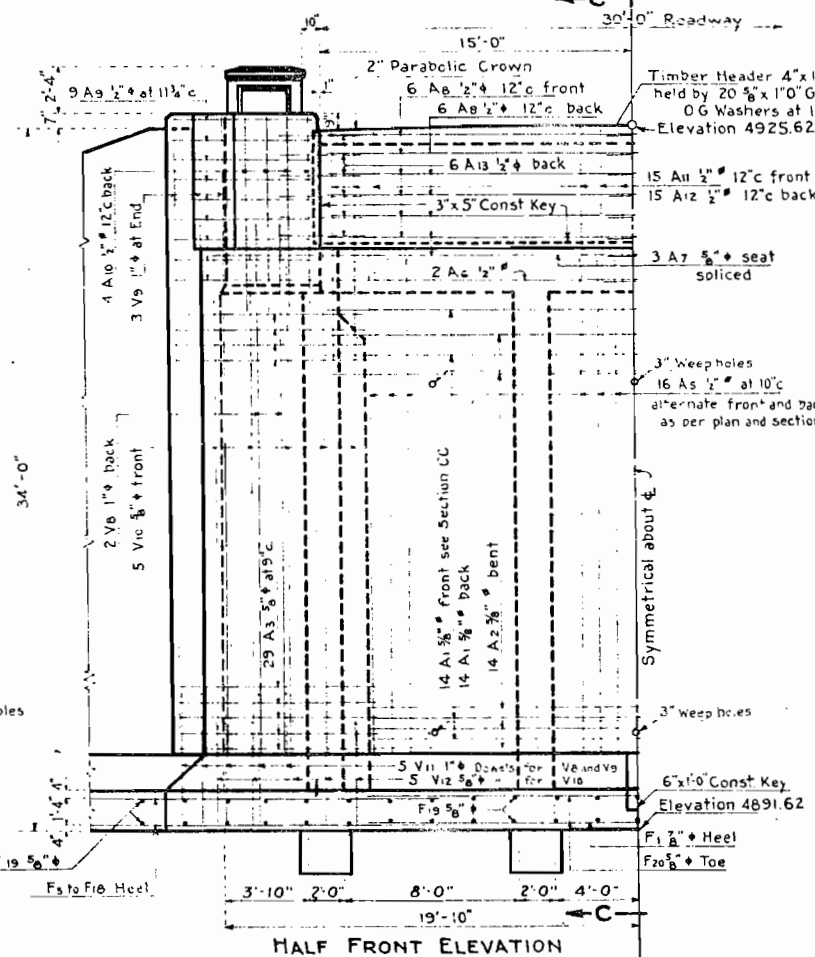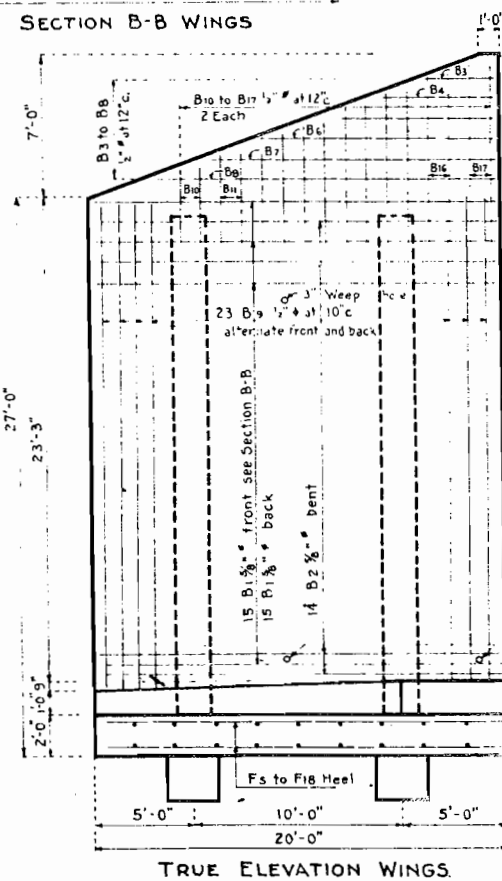

LOADING DATA.
LIVE LOAD A. A. S. H. O. 1941 CLASS A. (11-18)
DEAD LOAD-ASSUMES 18 LBS. PER SQ. FT. ADDITIONAL
WEARING SURFACE WHICH INCLUDES THE 1/2 INCH
CONCRETE MONOLITHIC WEARING SURFACE SHOWN.

DESIGNING DATA.
A.A.S.H.O. 1241
 $f_s = 16000 \text{ lb/in.}$ $f_c = 833 \text{ lb/in.}$ $n = 12$

REFERENCE DRAWINGS
Sheet No 6 Gen Layout, Bar Lists
Sheet No 7 Truss Portal &
Floor Details
Sheet No 8 200' Truss Details &
General Notes
Sheet No 10 Pier

COLORADO
STATE HIGHWAY DEPARTMENT
2-200'-0" THRU TRUSSES
DETAILS OF
ABUTMENTS 1 AND 3

Across **COLORADO RIVER**
Sta. **85+11.75 to 69+18.25**
Near **DeBeque** Sec. **23-26 T. 8S R. 27W.**

Designed by **W.M.**
Made by **W.P.M.**
Checked by _____
Approved by **Ed Bailey**
Bridge Engineer
Date: **Dec. 8th, 1941.**

Maximum toe pressure = 3½ Tons
STRUCTURE NO. **G-4-A**

NOTE The alignment, grade lines and drainage structures shown on plans are subject to adjustment by the Engineer in the field to meet construction requirements, after approval by the Denver Office of the Department.

Fencing is tabulated on sheet No.3


Right of Way Markers are tabulated on sheet No.3

Timber Guard Posts are tabulated on sheet No.3


PIT NO. 2
BORROW AND SELECTED MATERIAL
LOCATED IN SW 1/4 SW 1/4 SEC. 27 T. 8 S. R. 97 W.
800' LT. STA. 17+00

FED. ROAD DIST. NO.	STATE	SN-FED. AID PROJ. NO.	SHEET NO.	TOTAL SHEETS
3	COLO.	210-C(1)	21	

Revised 5-24-44 Structures C.W.

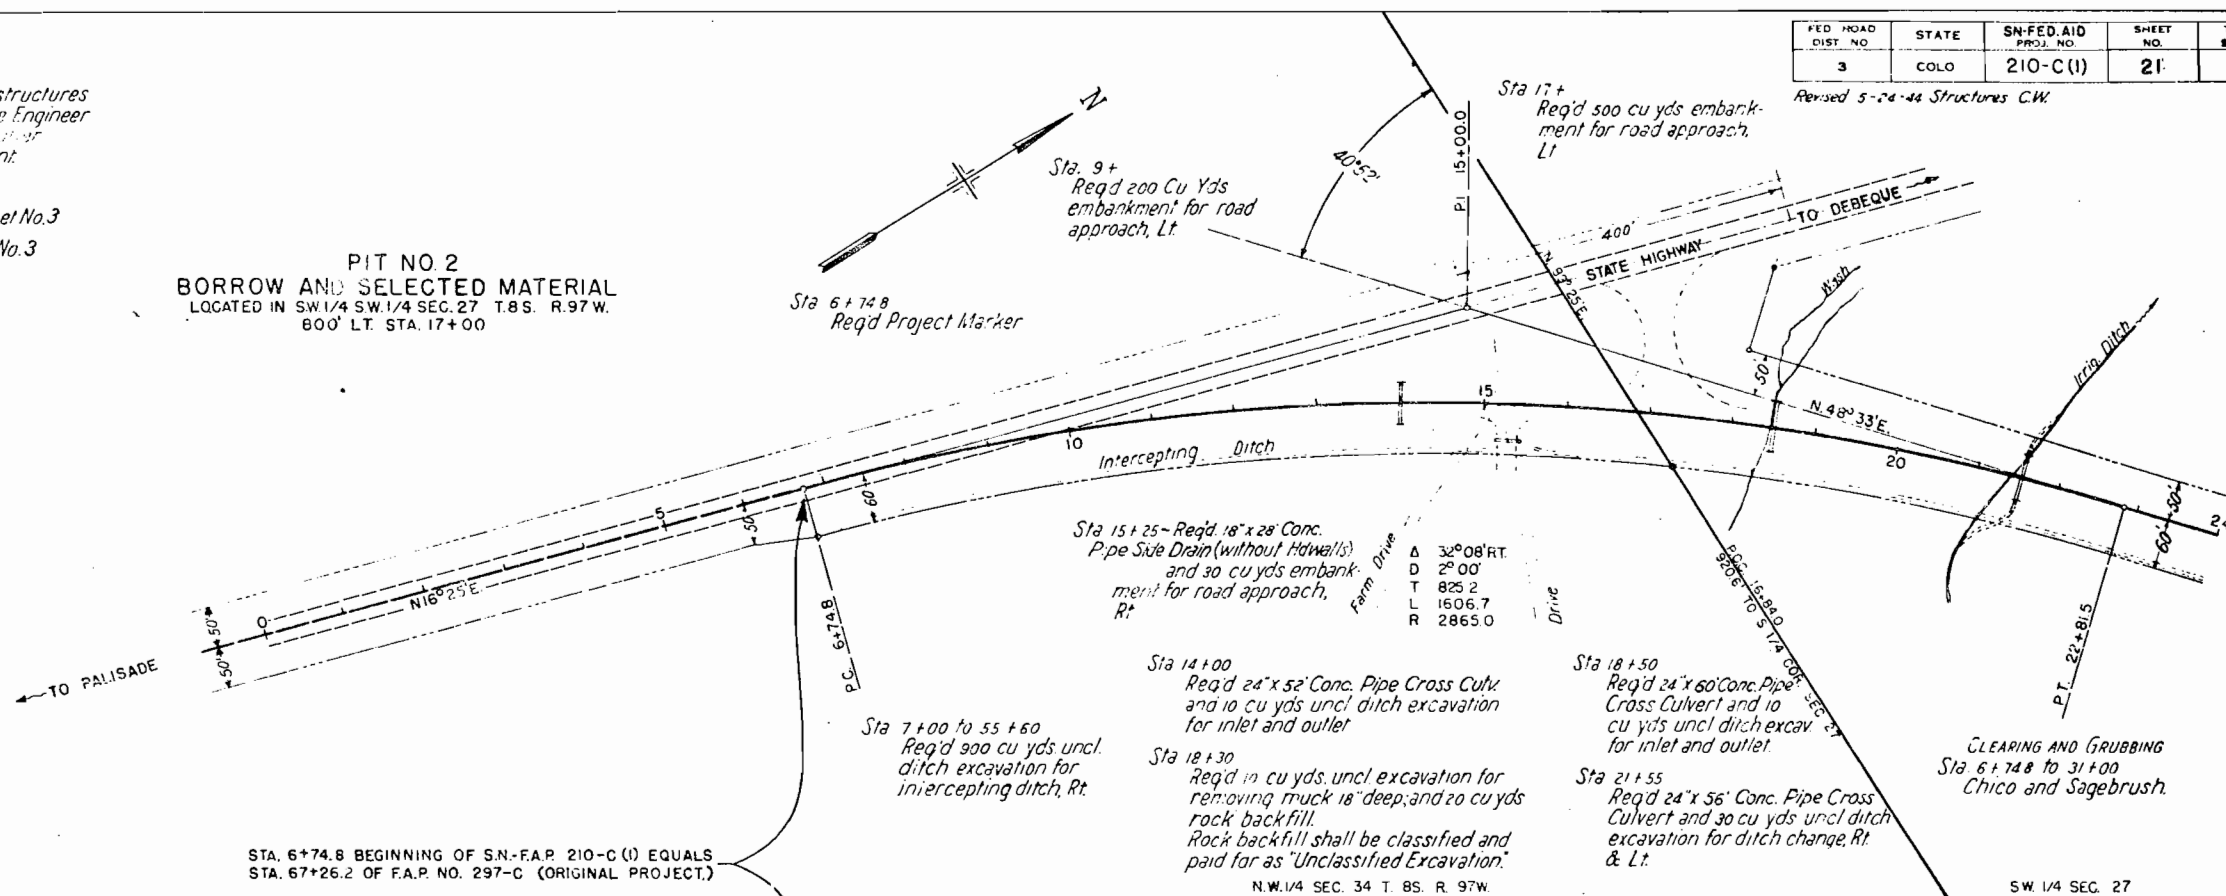

STA. 6+74.8 BEGINNING OF S.N.F.A.P. 210-C(1) EQUALS STA. 67+26.2 OF F.A.P. NO. 297-C (ORIGINAL PROJECT.)

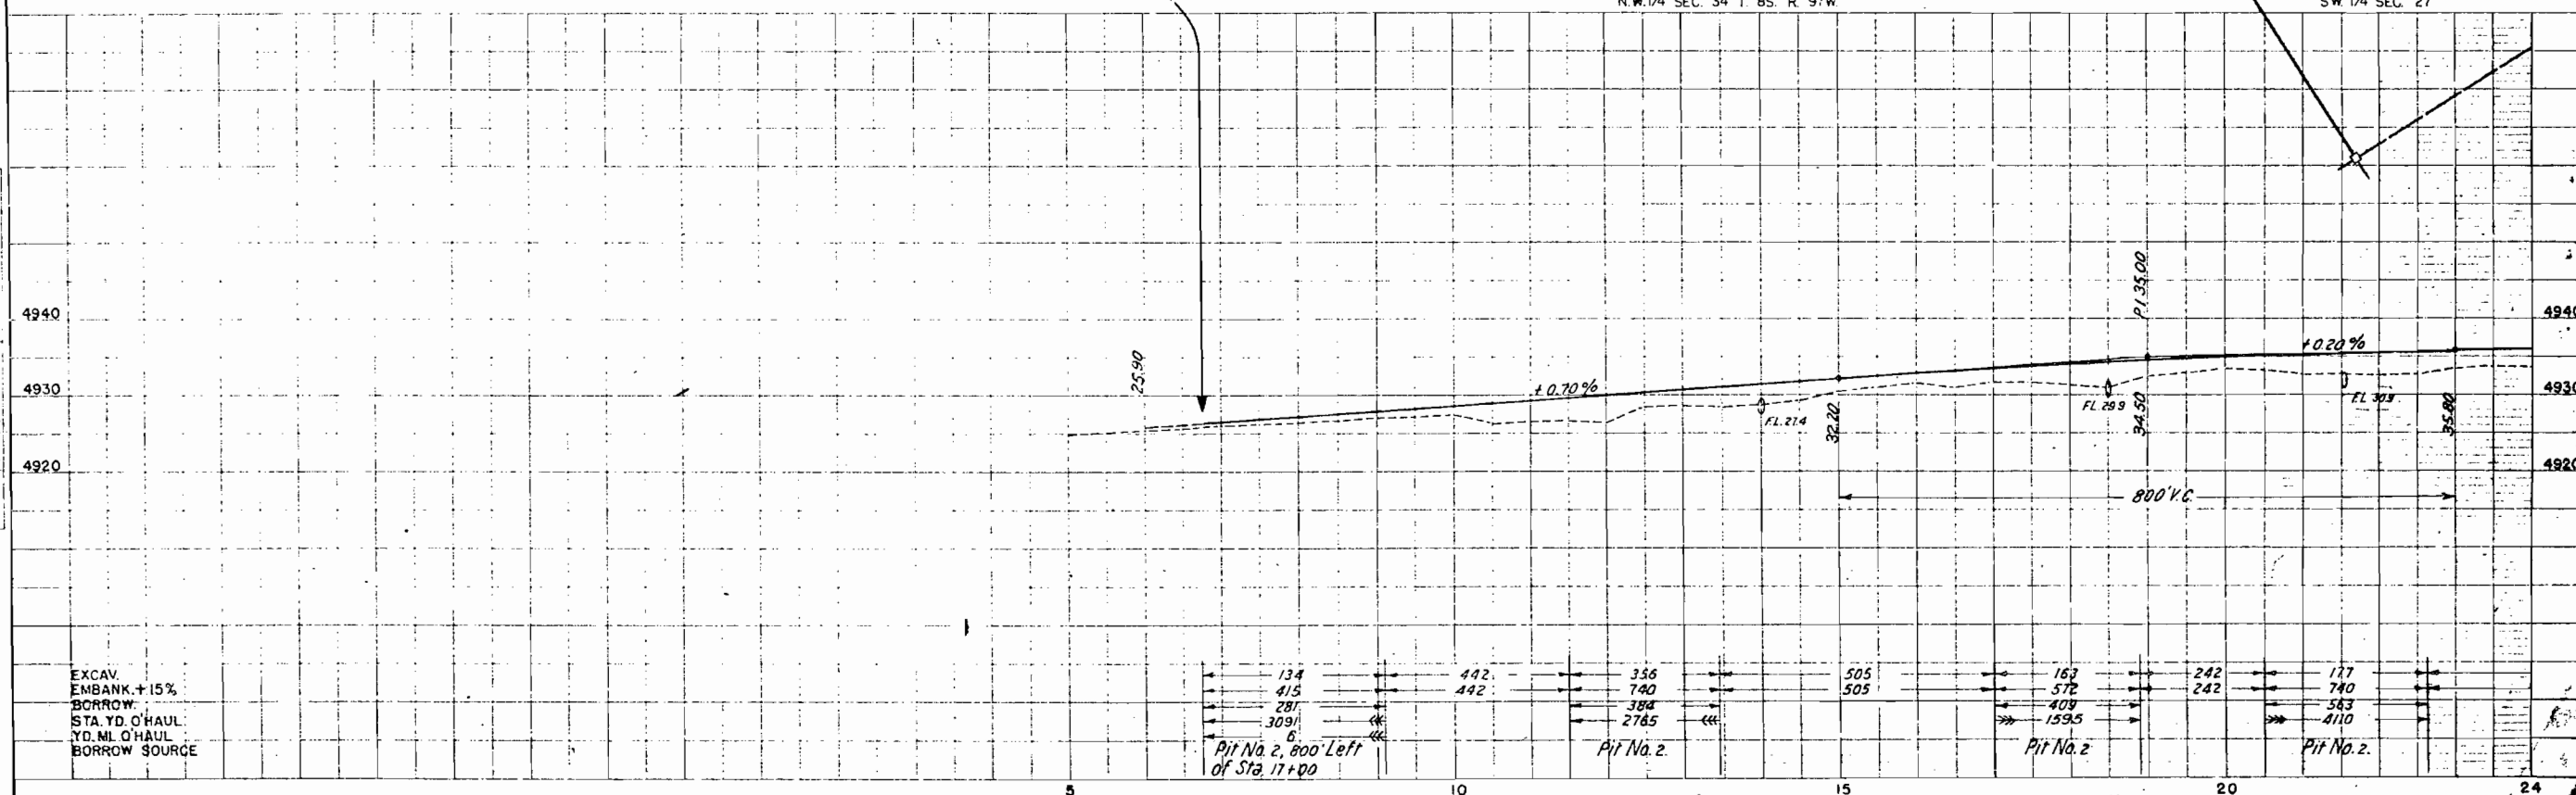

FED. ROAD DIST. NO.	STATE	SNFED. AID PROJ. NO.	SHEET NO.	TOTAL SHEETS
3	COLO.	210-C(1)	22	

Revised 5-24-44 Structures C.W.

FORCE ACCOUNT
Work by Grand Valley Rural Power Lines, Inc., forces
Sta. 30+ & 56+69
Raise Power Lines.

Sta 24+50
Req'd 24"x 52' Conc. Pipe Cross Culv
and 30 cu yds uncl ditch excavation
for inlet and outlet

Sta 29+20
Req'd 100 cu yds embankment
for road Approaches, Rt and Lt

Sta 42+00
Req'd 24" x 64' Conc. Pipe Cross Culv
and 25 cu yds uncl ditch excavation
for inlet and outlet

Sta 47+00
Req'd 36" x 68' Conc. Pipe Cross
Culvert and 40 cu yds uncl ditch
excavation for inlet and outlet

NOTE:
Borrow pits on Rt. and Lt. and
intercepting ditch on Rt. between Sta
24+50 and 29+00 shall be graded so
that drainage will be away from the
road approaches at Sta. 29+20

Sta 30+30
Req'd 48" x 55' Conc. Pipe Cross
Culvert and 5 cu yds uncl
ditch excavation for inlet
and outlet.

Sta 35+50
Req'd 36" x 56' Conc. Pipe Cross
Culvert and 10 cu yds uncl ditch
excavation for inlet and outlet.

Sta 39+50
Req'd 24" x 52' Conc. Pipe Cross Culv.
and 25 cu yds uncl ditch excavation
for inlet and outlet.


Sta 50+00
Req'd 24" x 52' Conc. Pipe Cross
Culvert and 10 cu yds uncl
ditch excavation for inlet
and outlet.

Sta 51+15
Req'd 50 cu yds embankment
for road approaches, Rt and Lt.

CLEARING AND GRUBBING
Sta 31+00 to 61+00
Chico and sagebrush.

SW 1/4 SEC. 27

SE 1/4 SEC. 27 T. 8S. R. 97W.

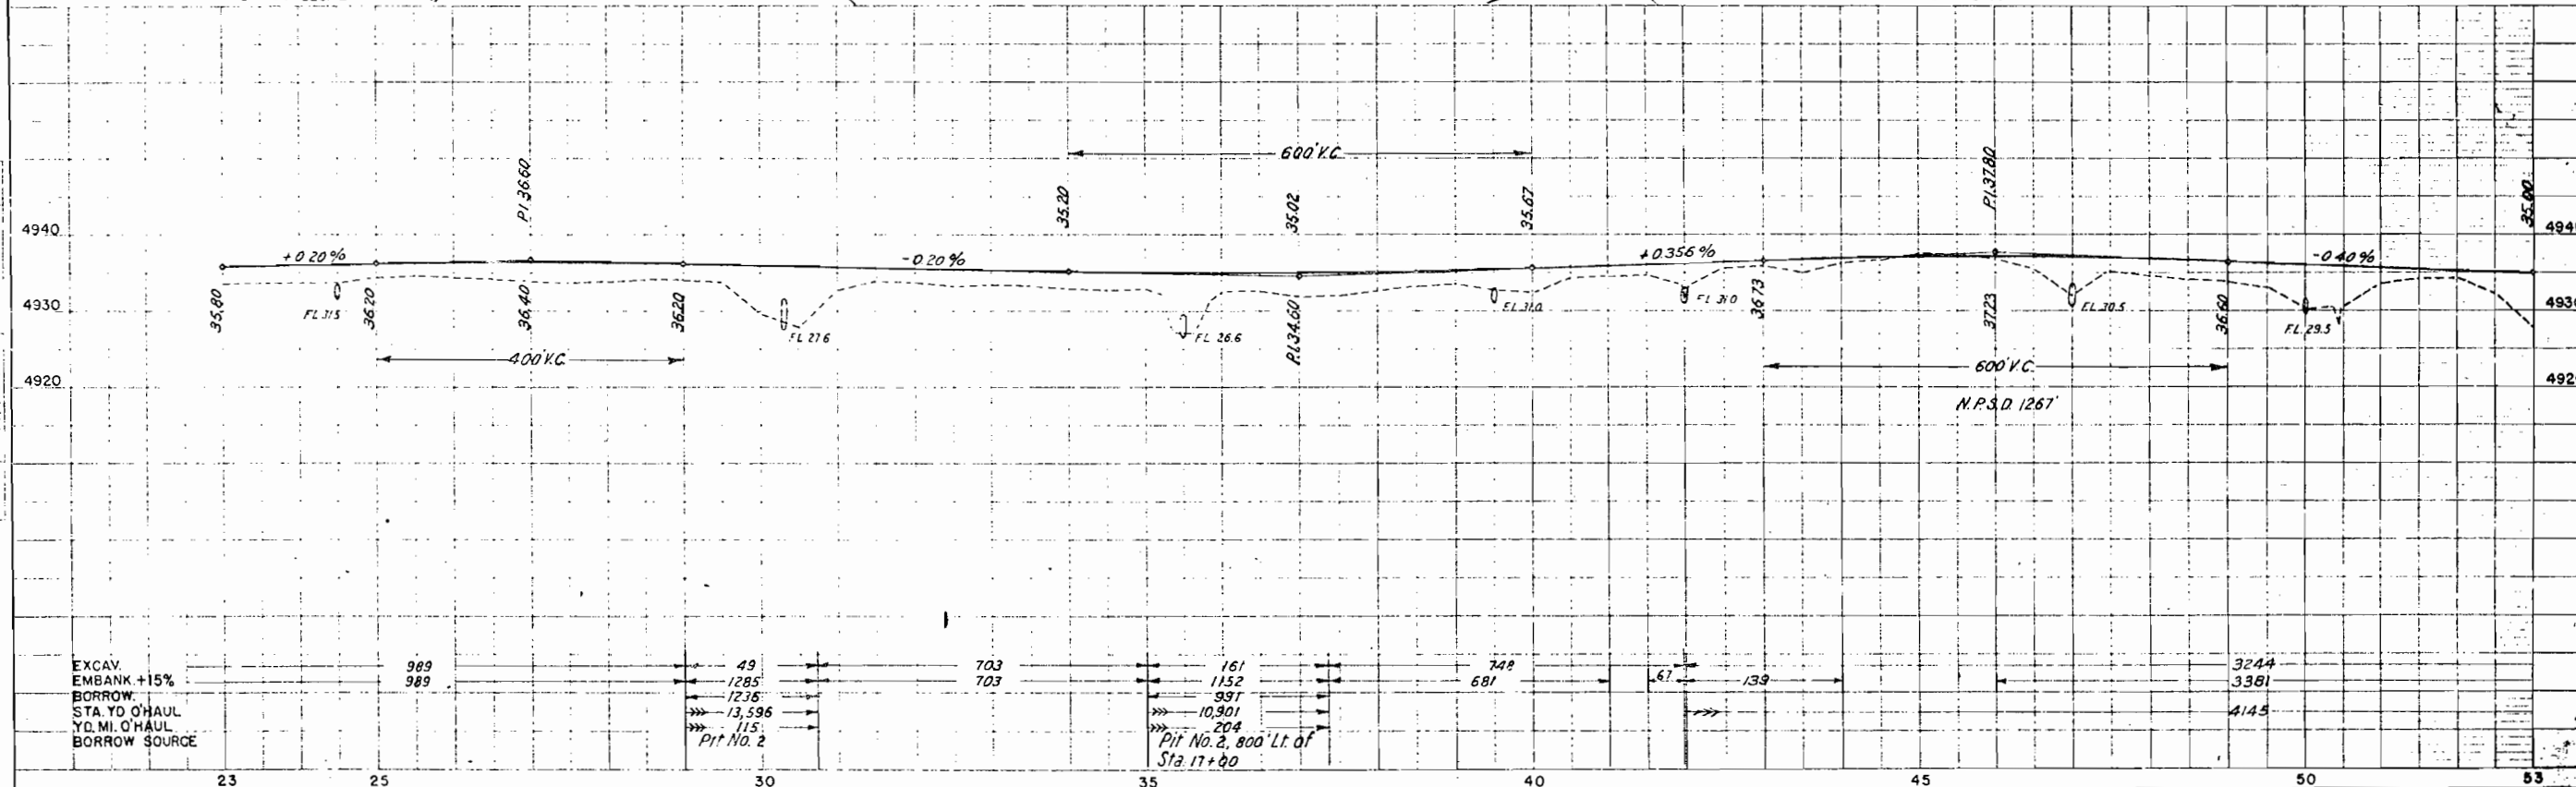

DATE	
PLAN	
NOTES	

PROFILE	
NOTES	

TYPICAL SECTION OF CHANNEL CHANGE

Sta 61+65 to 62+35.5

Req'd Treated Timber Bridge,
3 spans at 23' Details on sheet No 5
Req'd 3500 cu yds uncl excavation
for channel change, Lt and Rt
Excavated material to be used in
roadway embankment.

Sta 61+50

Req'd 18"x52" Conc. Pipe Cross Culv.

Sta 61+50

Req'd 15 cu yds uncl ditch excavation
for ditch change, Rt & Lt.

Sta 63+70

Req'd 18"x52" Conc. Pipe Cross Culv.
and 40 cu yds uncl ditch excavation
for inlet and outlet

Sta 65+50

Req'd 100 cu yds embankment for
road approaches, Rt and Lt

Sta 68+00

Req'd 6'x7'x58' Conc. Box Culv.
(Spec. Rev. Std. M-10-B) and 150 cu
yds uncl ditch excavation for inlet
& outlet

Sta 71+21

Req'd 18"x148" Conc. Pipe Cross Culv.
and 10 cu yds uncl ditch excavation
for ditch change, Rt & Lt

Sta 76+40

Req'd 18"x64" Conc. Pipe Cross
Culvert and 25 cu yds uncl
ditch excavation for ditch
change, Rt & Lt.

Sta 82+50

Req'd 24"x72" Conc. Pipe Cross
Culvert and 10 cu yds uncl
ditch excavation for inlet
and outlet.

Sta 75+50

Req'd 100 cu yds embankment
for road approaches, Rt & Lt
Req'd 18"x32" Conc. Pipe Side
Drain Rt. - No Hdwl's.

Sta 71+00 to 85+00

Req'd 130 cu yds uncl ditch
excavation for intercepting
ditch, Rt


CLEARING AND GRUBBING
Sta 61 to 71
Sagebrush and scattered
Cottonwoods.

SE 1/4 SEC 27

NW 1/4 SEC 26


Structure No. 6-G-F
Stream - Horseshoe Wash
Skew Angle - 90°
Present Structure - None
Span -
Clear Roadway -
Clear Waterway -
Type of Superstructure -
Type of Substructure -
Requirements as to removal -
Stream Data
Drainage Area in Sq. Mi. - 10
Velocity during high water -
Elevation of:
Maximum high water - 49300
Low water -
Normal stage -
Stream bed -
Drift - None
Scour - Silt up

Station - 61+65 to 62+35.5
County - Mesa
Position - referred to present structure -
Proposed Structure:
Span - 3 @ 23'
Clear Roadway - 29'
Clear Waterway - 460'
Type of Superstructure - Treated Timber Asphalt Plank
Type of Substructure - Treated Timber Piles
Detail Structure requirements - None
R.R. Siding - De Beque
Haul to bridge site - 1 Mile
Nearby structures on same stream -
Location - 500' Up Stream
Waterway - 12'x20' Timber Struct.
Record during floods -

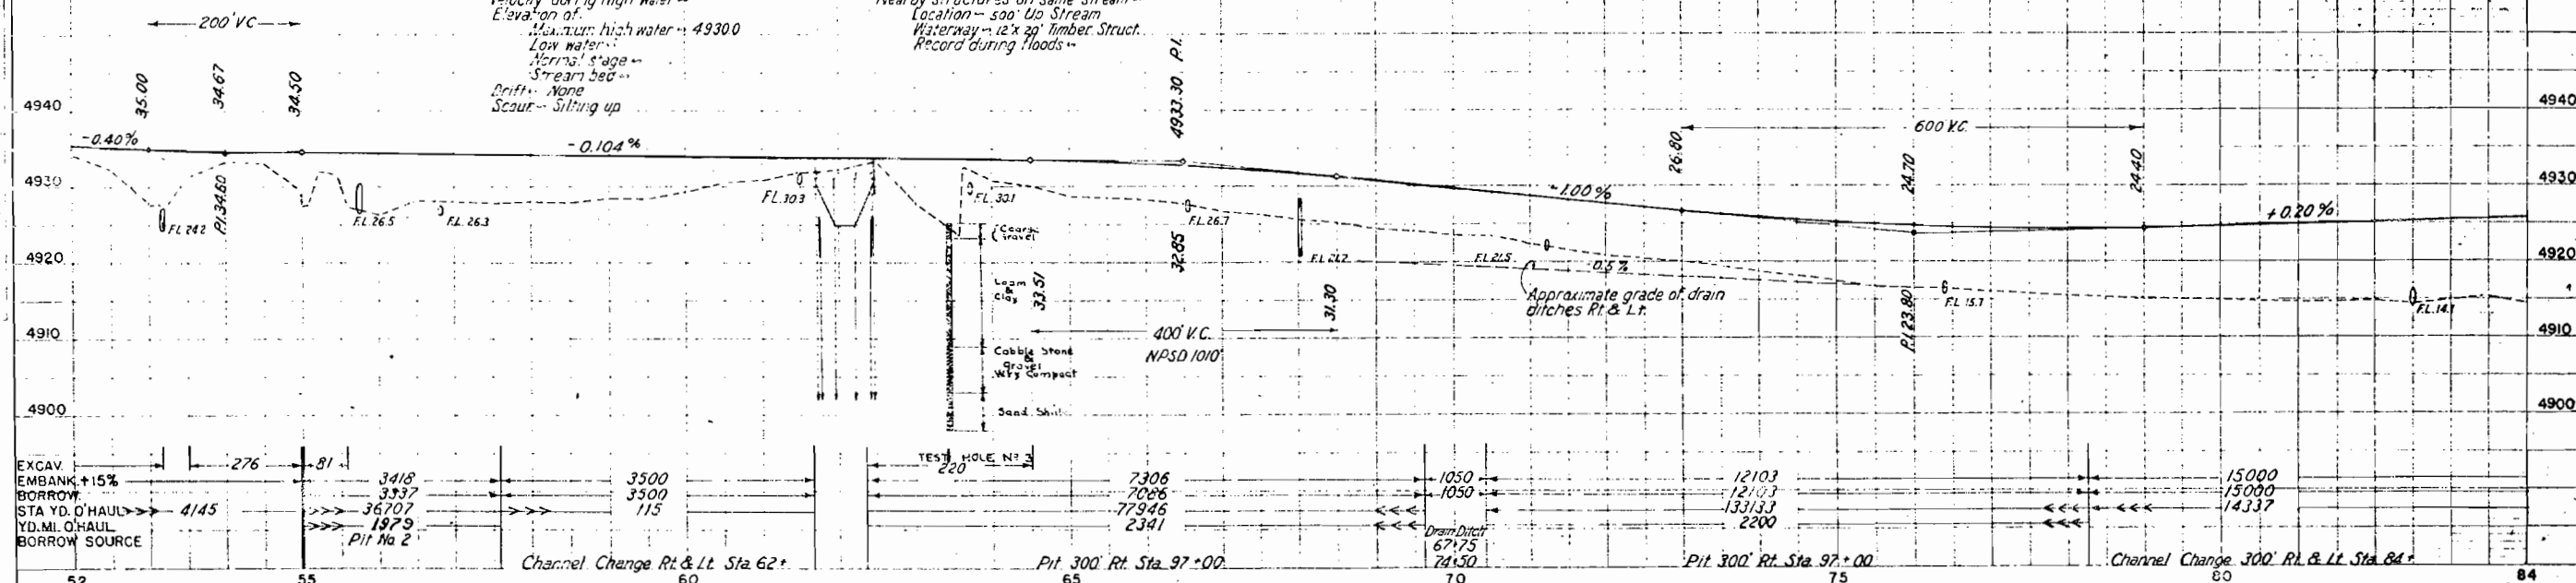

FED. ROAD DIST. NO.	STATE	S.N.-FED. AID PROJ. NO.	SHEET NO.	TOTAL SHEETS
3	COLO.	210-C(1)	24	

Rev. 5-24-44-A.Z. Earthwork

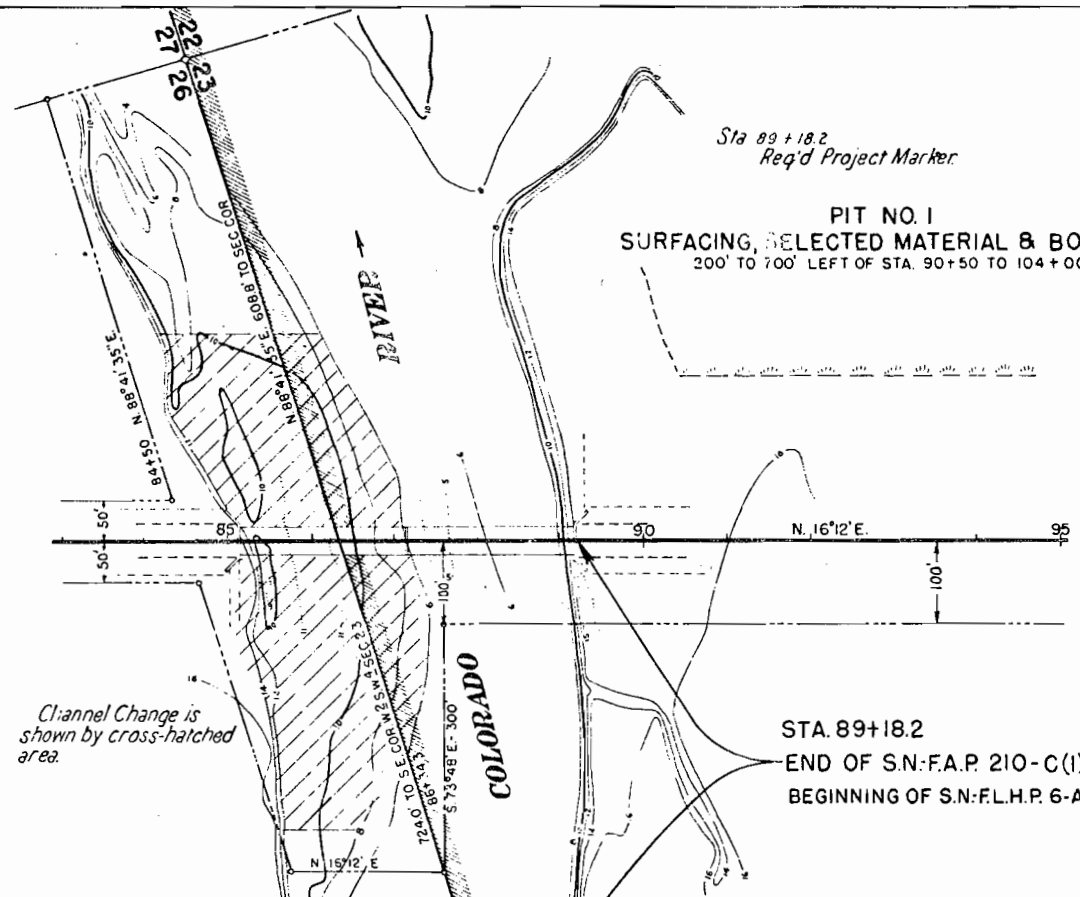

Sta 85+11.7 to 89+18.2
Req'd Steel Truss Bridge (2-200' spans)
as per details on Sheets No. 6 to 10.
Req'd 15,000 cu yds. uncl. excavation
for channel change, Lt. & Rt.

STA. 89+18.2
END OF S.N.-F.A.P. 210-C(1)
BEGINNING OF S.N.-F.L.H.P. 6-A(1)

BRIDGE DATA

STRUCTURE NO. 6-4-A

STREAM- Colorado River
SHEW ANGLE- 90°

PRESENT STRUCTURE
SPAN- 1 TT 238'-0" and 1-150'-0"
CLEAR ROADWAY- 15'-0"
CLEAR WATERWAY- 48'-0" 4' below chord
TYPE OF SUPERSTRUCT- Steel thru truss
TYPE OF SUBSTRUCT- Concrete Gravity
REQUIREMENTS FOR REMOVAL- None

STREAM DATA
DRAINAGE AREA IN SQ. MI.- 6685

ELEVATIONS
MAXIMUM HIGH WATER- 4917
NORMAL STAGE- 4904
DRIFT- Heavy
VELOCITY DURING HIGH WATER- 10 ft. sec. estimated
U.S.G. Survey indicate peak flow of 52,400 Sec. ft. at Palisade in 1921

LOW WATER-
STREAM BED- 4904
SCOUR- None


STATION 85+11.7 TO 89+18.2

COUNTY- Mesa
POSITION REFER. PRESENT STRUCT. 2 Miles Upstream


PROPOSED STRUCTURE
Z- 200'-0"
30'-0"
4130 to Elev. 4918.0
2- Steel T. Trusses
Conc. Counterfort
DECK STRUCT. REQ'D- None
HAUL TO BRIDGE SITE- 3 Mi.

NEARBY STRUCTURES ON SAME STREAM- See Struct. 6-4-B Overflow Bridge- 4N-PLN. 28-400
LOCATION-
WATERWAY-


R.R. S. DING De Beque

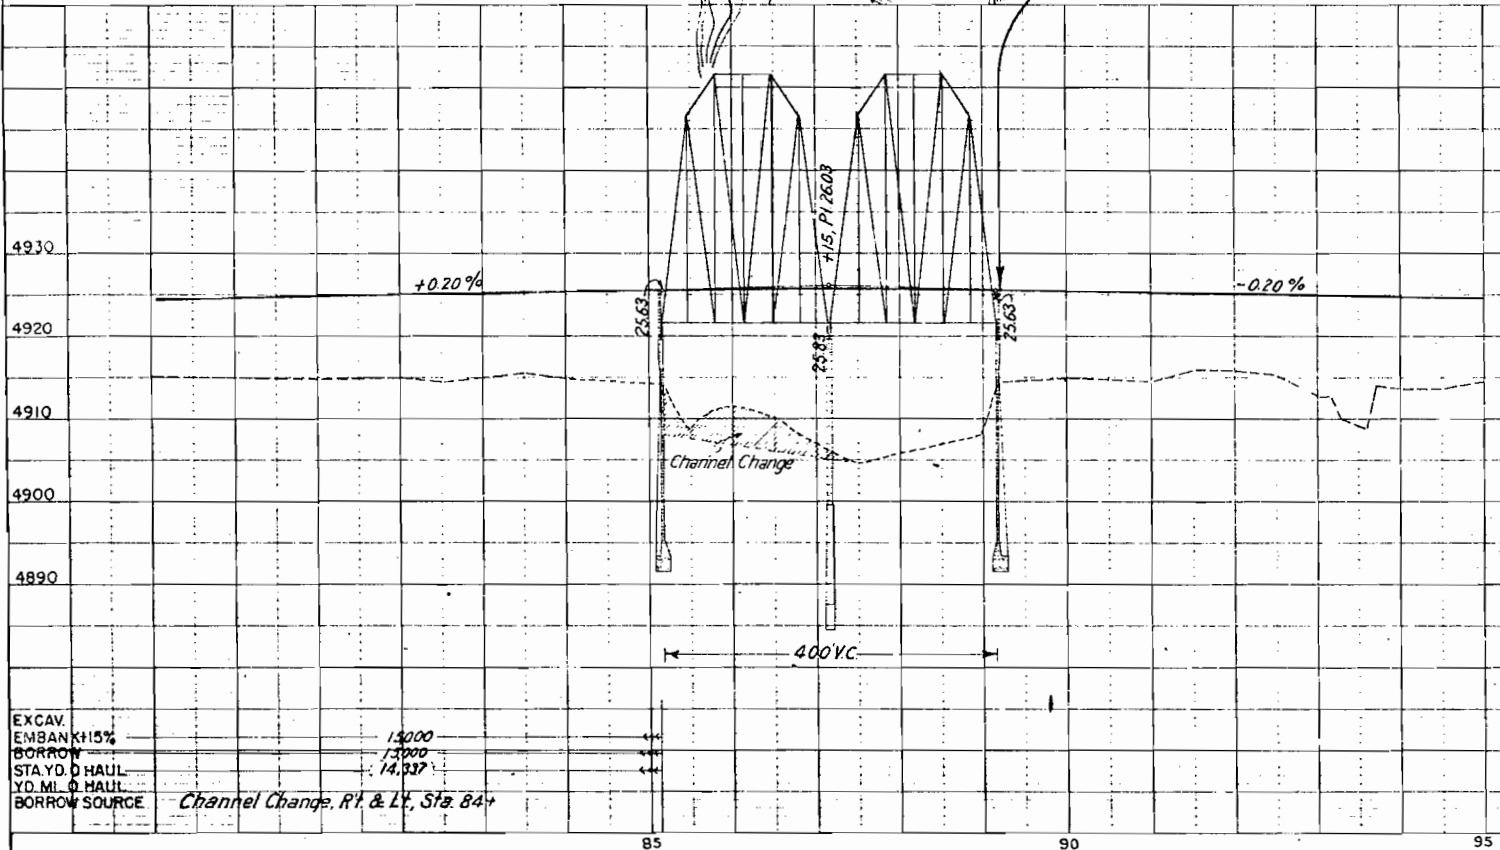


EXCAV. 1:5000
EMBANK. 1:5000
BORROW 1:5000
STA. YD. 0 HAUL 1:5000
YD. MI. 0 HAUL 1:5000
BORROW SOURCE Channel Change, Rt. & Lt., Sta. 84+

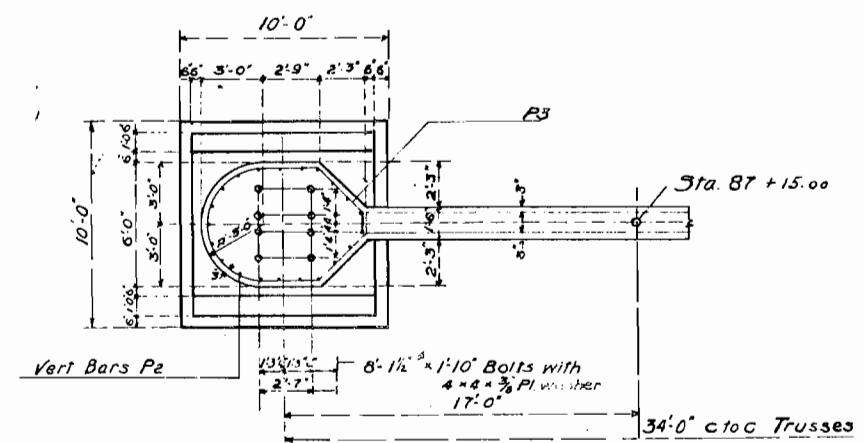

Half Plan

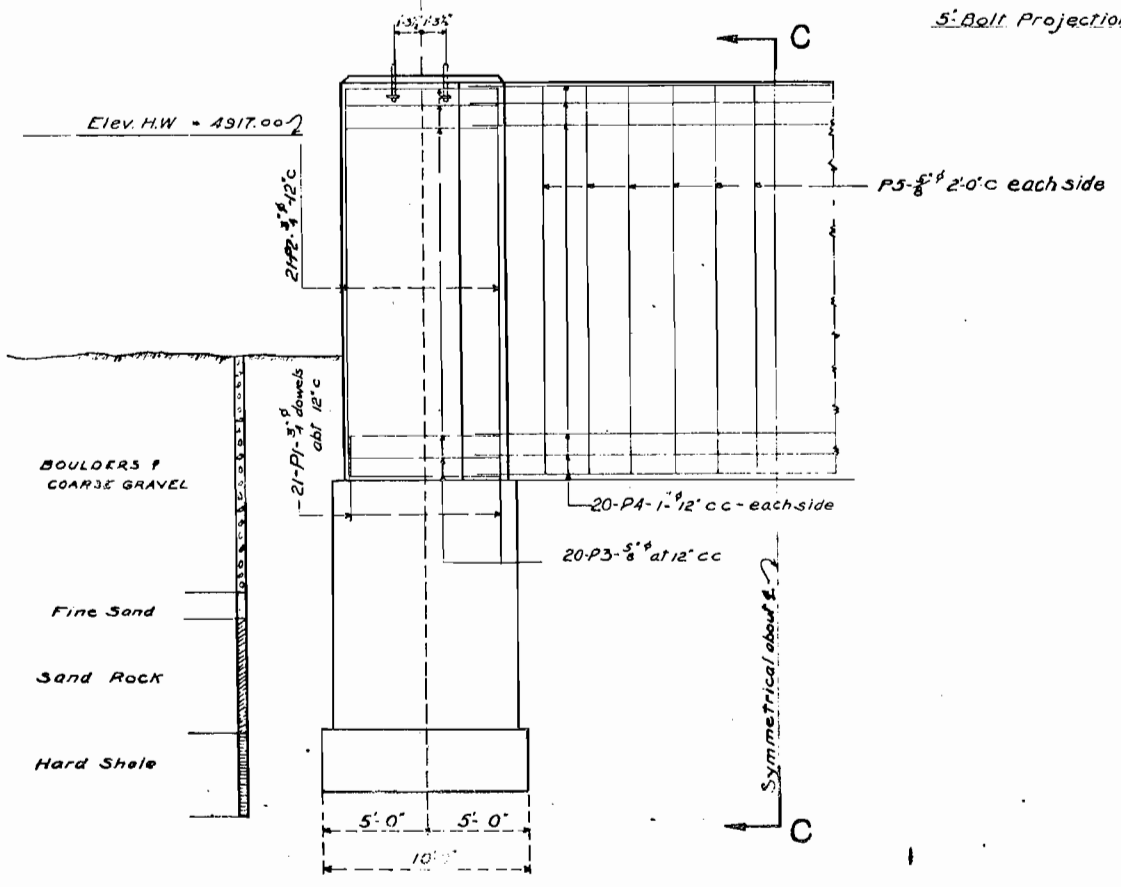

Half Elevation

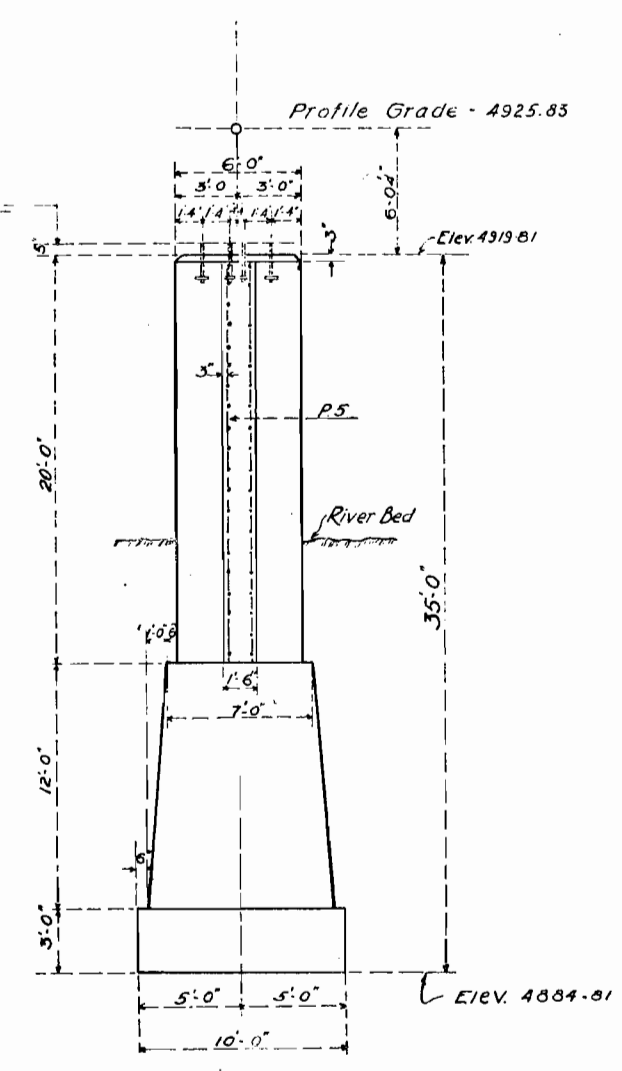

Section GC.

Pressure on footings = 5 Tons

Mark	Size	No. Reqd	Length	Type	Total Length	Diagram
P1	3/4"	42	5' 4"	Str	2268	Diagram of Pier No. 2 showing reinforcement layout.
P2	3/4"	42	19' 8"	Str	826	
P3	3/4"	40	21' 5"	I	857	
P4	1"	40	34' 0"	Str	1360	
P5	3/4"	24	19' 3"	Str	462	
P6	1"	40	34' 0"	Str	1360	
1360 Lin Ft. 1" @ 2610 Lbs per lin ft. = 3631 Lbs.						
1032 " 3/4" @ 1502 " " " = 1641 "						
1319 " 3/4" @ 1043 " " " = 1376 "						
Add 1% overrun						62
Total						6710

Item	Description	Unit	Quantity
14c	Wet Rock	Cu Yds	72
14d	Wet Common	"	170
46	Class A Concrete	Cu Yds	173
47	Reinforcement	Lbs.	6710
48	Structural Steel	Lbs.	260

Sheet No. 6	Gen. Layout, Bar Lists
Sheet No. 7	Truss Portal & Floor Details
Sheet No. 8	200' Truss Details & Gen. Notes
Sheet No. 9	Abutments 1 & 3

COLORADO
STATE HIGHWAY DEPARTMENT
2-200'0" Thru Trusses
Details, Pier #2
OVER COLORADO RIVER

Across Sta. 85+11.3 to 89+14.26
Near DeBeque Sec. 12 T. 4 S. R. 1 W.


Designed by W.M. Approved by *[Signature]*
Made by *[Signature]* Bridge Engineer
Checked by *[Signature]* Date: Dec. 6, 1941

STRUCTURE NO. G-4-A


STANDARD M-101-B SPECIAL REVISION Revised 9-24-40: Corrected bar list. Added note 5.
8-13-41 Revised to 1941 A.A.S.H.O. Specs.
(Temp. Steel) added notes for Minimum depth and tamping. L.M.R.

Revised Size and Number of Bars, 3-25-44, ADM, S.J.B.

PROJ. ROAD DIST. NO.	STATE	PROJECT	SHEET	TOTAL SHEETS
3	COLO.	S.N. FAP 210 C(11)	12	

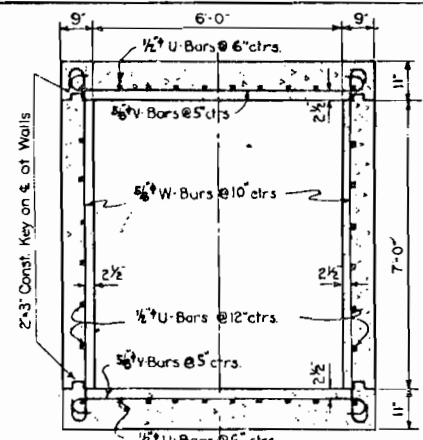

TYPICAL SECTION THRU BOX

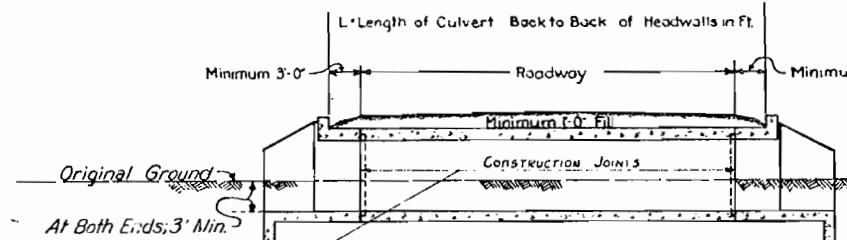


TYPICAL SECTION SHOWING RELATION OF CULVERT TO ROADWAY


Limit these Construction Joints when fill is less than 5'-0" and distance is not greater than 35'




HALF-LAP CONSTRUCTION JOINT

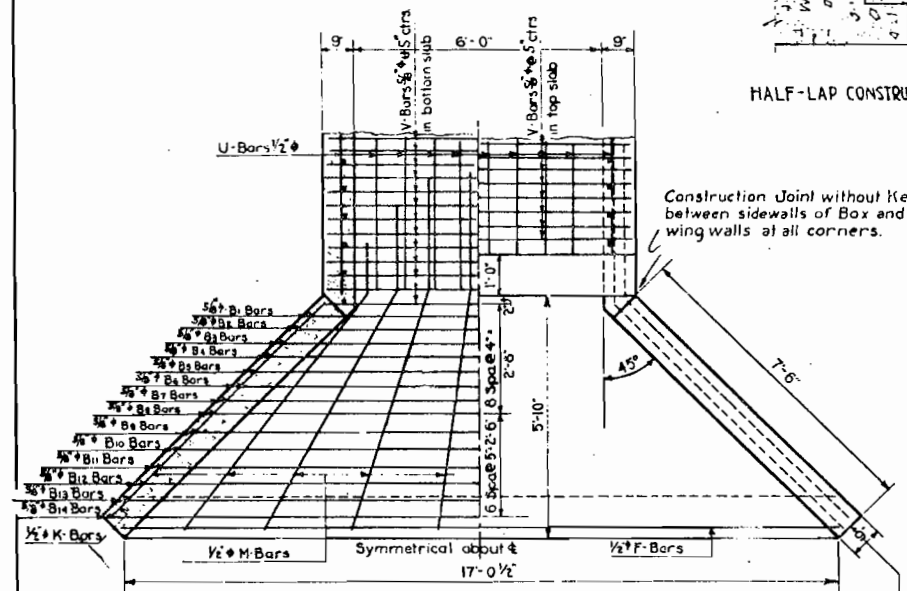

PART PLAN

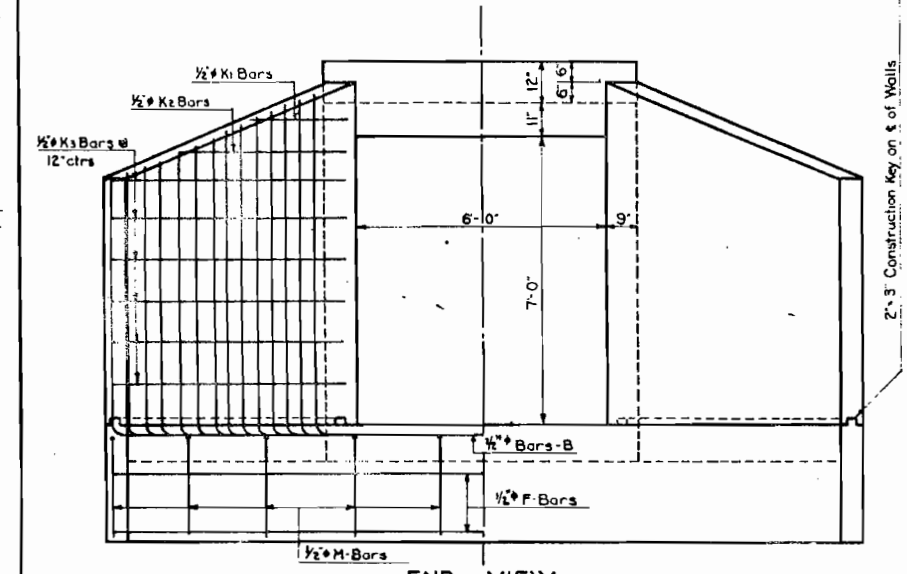

END VIEW

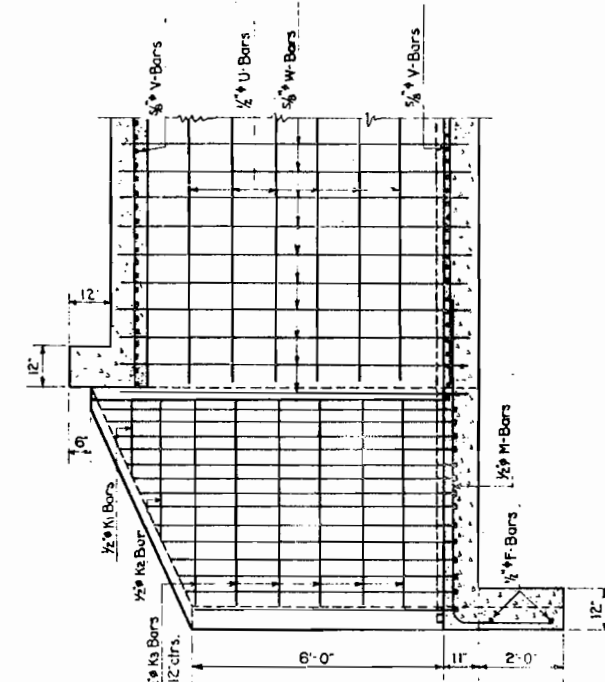


LONGITUDINAL SECTION ON & OF BOX

BAR LIST

MARK	SIZE	NUMBER	DIMENSION P	DIMENSION Q	TOTAL LENGTH
V	5/8"	48	10'-0"	6'-10"	8'-6"
W	5/8"	24	5'-0"	7'-10"	9'-6"
F	1/2"	4	Str.		17'-3"
U	1/2"	36			L+1'-8"
K1	1/2"	4			2'-6"
K2	1/2"	4			4'-8"
K3	1/2"	24			7'-2"
B1	5/8"	2	7'-11"	8'-1"	23'-11"
B2	5/8"	2	8'-7"	7'-11"	24'-3"
B3	5/8"	2	9'-3"	7'-10"	24'-9"
B4	5/8"	2	9'-11"	7'-5"	25'-1"
B5	5/8"	2	10'-7"	7'-6"	25'-5"
B6	5/8"	2	11'-3"	7'-5"	25'-11"
B7	5/8"	2	11'-11"	7'-3"	26'-3"
B8	5/8"	2	12'-7"	7'-1"	26'-7"
B9	5/8"	2	13'-5"	6'-11"	27'-1"
B10	5/8"	2	14'-3"	6'-9"	27'-7"
B11	5/8"	2	15'-1"	6'-7"	28'-1"
B12	5/8"	2	15'-11"	6'-4"	28'-5"
B13	5/8"	2	16'-9"	6'-2"	28'-11"
B14	5/8"	2	17'-7"	6'-0"	29'-5"
</					

NOTE: TO BE USED AS A STOCK PASS ONLY

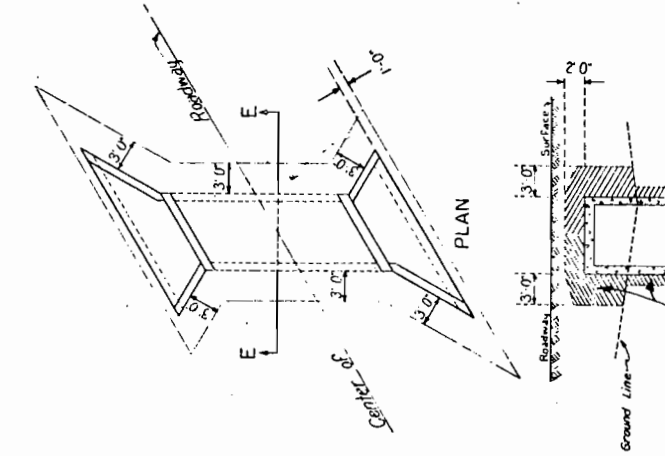

SECTION E-E
MECHANICALLY TAMPED BACKFILL
Contractor's attention is called to Specifications covering Mechanical Tamping. Especial care shall be taken to prevent deflection of the wing walls by wedging action.

TABLE OF QUANTITIES					
SPAN S	HEIGHT H	QUANTITIES FOR ONE LINEAL FT OF BOX		QUANTITIES FOR TWO HEADWALLS	
		CLASS 1 CONCRETE CU YDS	STEEL LBS	CLASS 1 CONCRETE CU YDS	STEEL LBS
6'-0"	7'-0"	0.898	91.3	16.5	1296

GENERAL NOTES

ALL WORK SHALL BE DONE ACCORDING TO THE STANDARD SPECIFICATIONS OF THE COLORADO STATE HIGHWAY DEPARTMENT, ADOPTED JUNE 1, 1940.
ALL CONCRETE SHALL BE CLASS 1.
FORMS FOR THE FINEST FINISH SHALL BE EMPLOYED IN THE FINISHED WORK SHALL BE CONSTRUCTED OF ANGLE OF 10000 AND GROOVE LUMBER ALL EXPOSED SURFACES SHALL BE FINISHED FREE OF FORM MARKS.
ALL JOINTS SHALL BE FINISHED ON BOTH SIDES.
ALL CONSTRUCTION JOINTS SHALL BE THOROUGHLY CLEANED BEFORE FRESH CONCRETE IS PLACED.
JOINTS IN WORK SHALL BE PLACED OUT TO THE ROCK AND NOT FORMED.
ALL REINFORCING BARS SHALL BE DEFORMED AND BOUND ON SQUARE AS SHOWN AND NOTED.
ALL REINFORCING BARS SHALL BE TIED WITH THE STATION NUMBER AND LETTER DESIGNATION.
SECONDARY BARS WHEN SPICED SHALL BE GIVEN A LAP OF 15 DIAMETERS.
MAIN BARS SHALL NOT BE SPICED.
LOADINGS AND DEPTH OF FOOTINGS SHOWN ARE ACCORDING TO THE BEST AVAILABLE DATA.
IF ESSENTIALLY DIFFERENT CONDITIONS ARE ENCOUNTERED THE BRIDGE ENGINEER WILL INQUIRE AND DETERMINE IF MODIFICATION IS NECESSARY.
POUR WITH FOOTINGS MONOLITHICALLY WITH FLOOR OF BOX.
THE USE OF ADDITIONAL CONSTRUCTION JOINTS UNDESIRABLE SHOULD FIELD CONDITIONS REQUIRE CONSTRUCTION JOINTS MAY BE MADE ON A VERTICAL PLANE PERPENDICULAR TO CENTERLINE OF CULVERT AND SHALL BE LAP-TYPE. (SEE DETAILS).
SUPPORTING SOIL FOR ALL CULVERTS MUST BE COMPOSED OF FIRM AND UNIFORM MATERIAL THROUGHOUT.
ALL BACKFILLING IN APPROACHES TO AND OVER CULVERTS SHALL BE LAID IN LAYERS NOT EXCEEDING 6" IN DEPTH AND EACH LAYER SHALL BE ROLLED OR MECHANICALLY TAMPED WHERE INACCESSIBLE TO ROLLER, ALSO COMPACTED WHEN NECESSARY.





LOADING DATA
1100 LBS PER SQ YD MAXIMUM 9'-0" FILL

COLORADO
STATE HIGHWAY DEPARTMENT
SPECIAL 6FT x 7FT
CONCRETE BOX CULVERT
FOR
STOCK PASS




Designed by G.A.M. Approved by O. Bailey
Made by E.W.T. Bridge Engineer
Checked by G.A.M. Date: May 27th 1935

STRUCTURE NO.

		F.A.P.		
		S.N. FAR 21000		

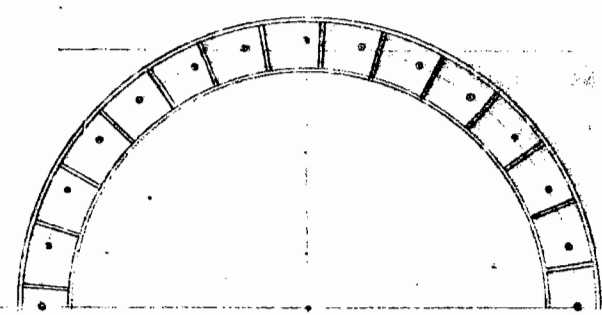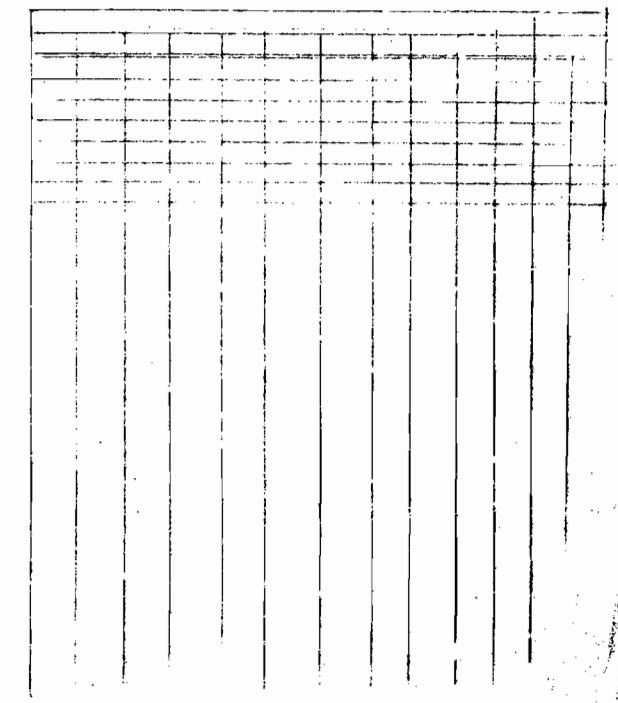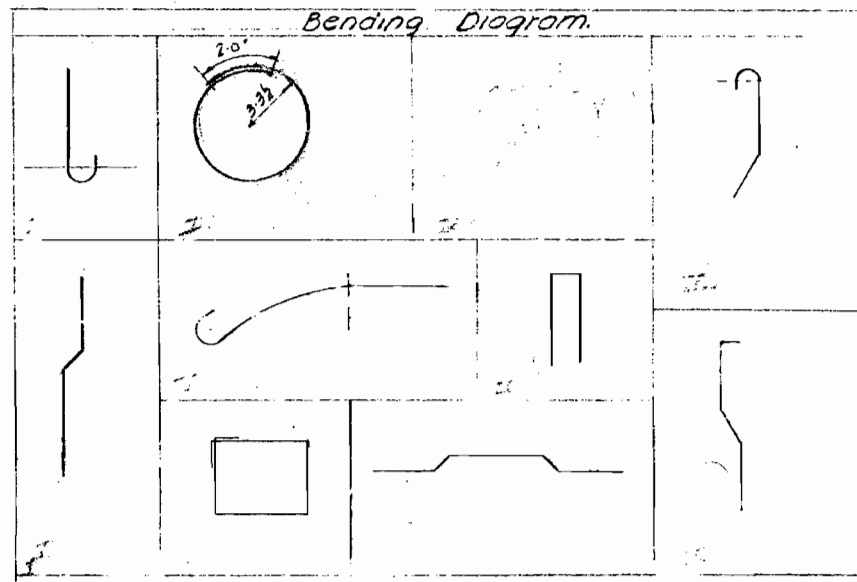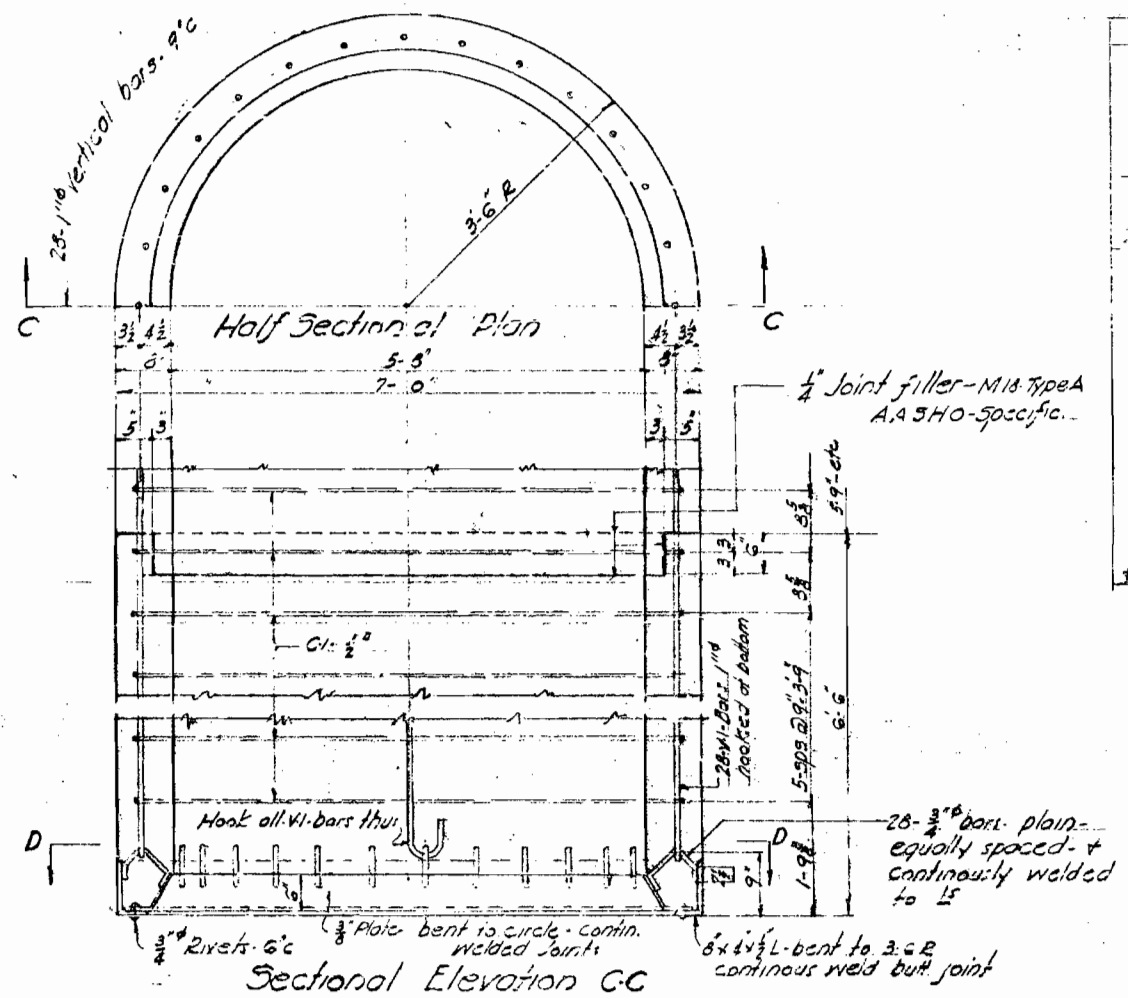

COLORADO
 State Highway Dept.
 3-150-0 Thru. Truss
 30'0" Roadway - with
 light concrete grill floor
 Abutments & Piers
 Across - Colorado River
 Sta. 84+85.71 to 84+87.15
 Near Dabney 524 - Twp 27N
 Design by R.M. Arch. 1927
 Made by R.M. Bridge Engineer
 Ck. by Data

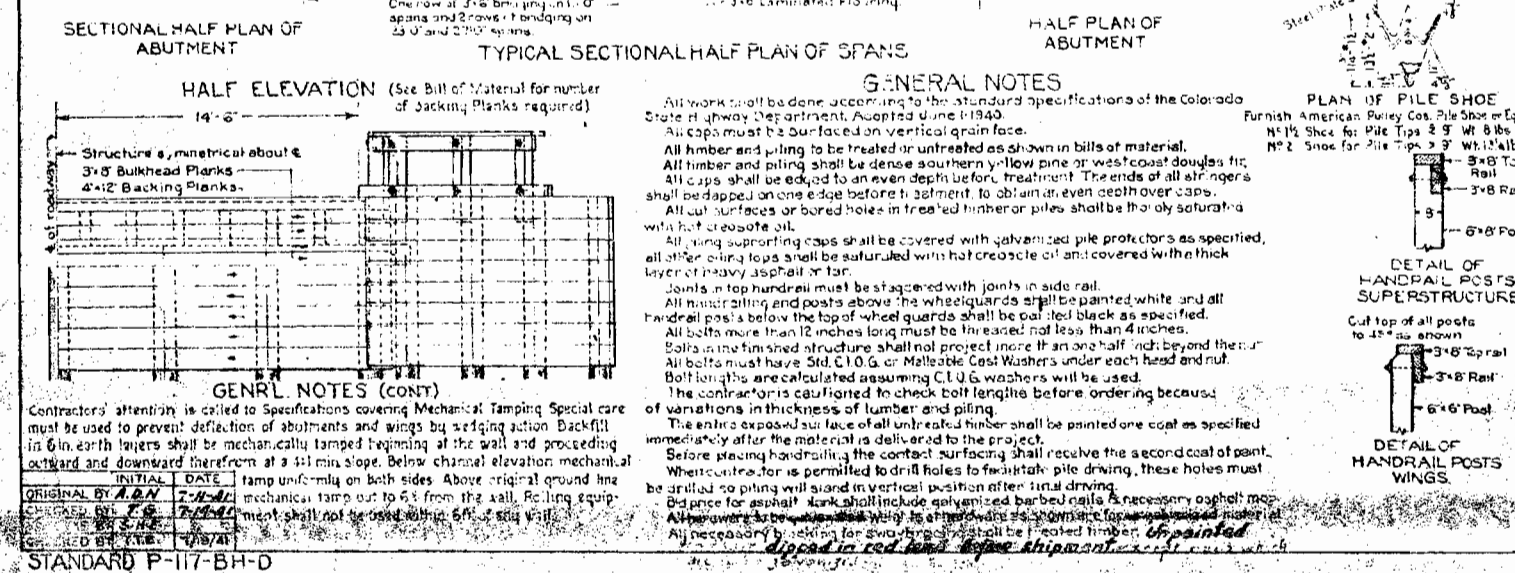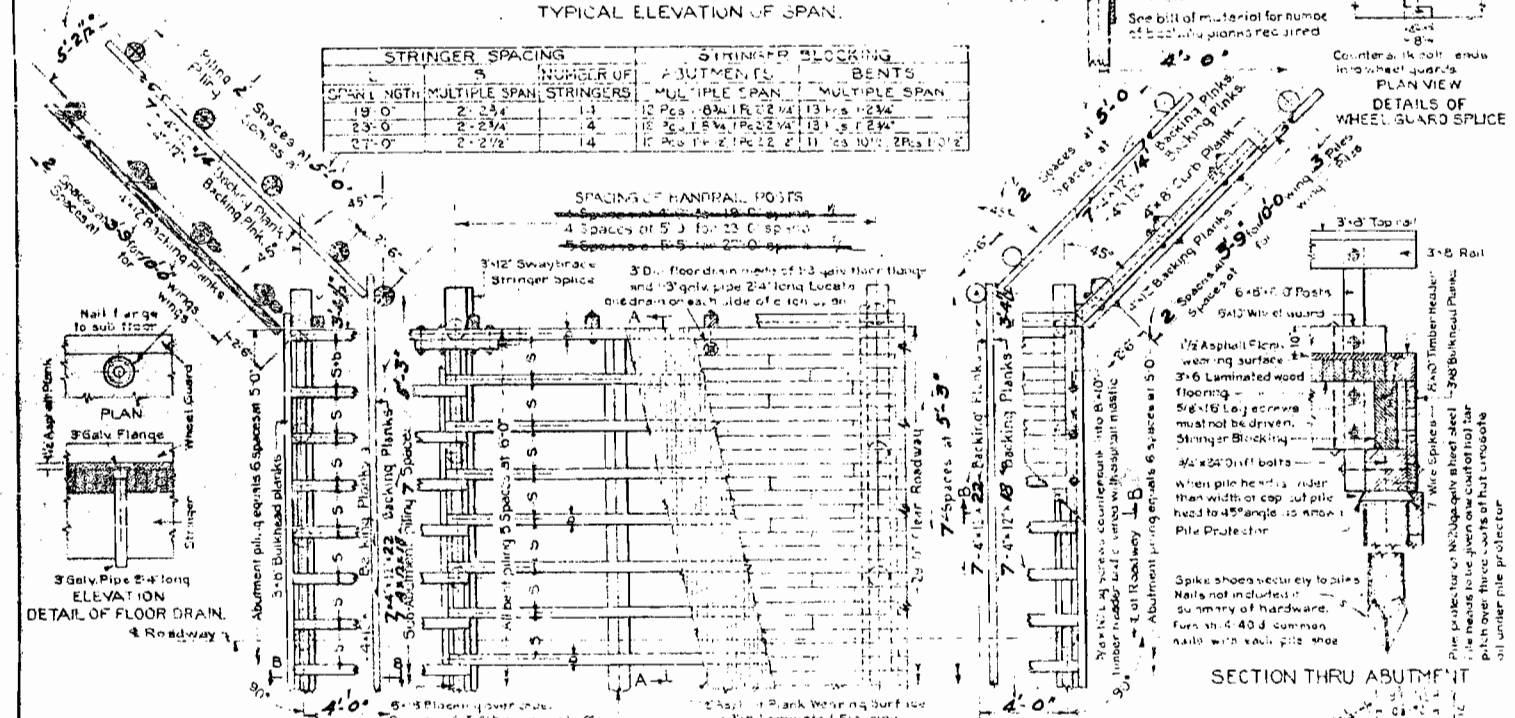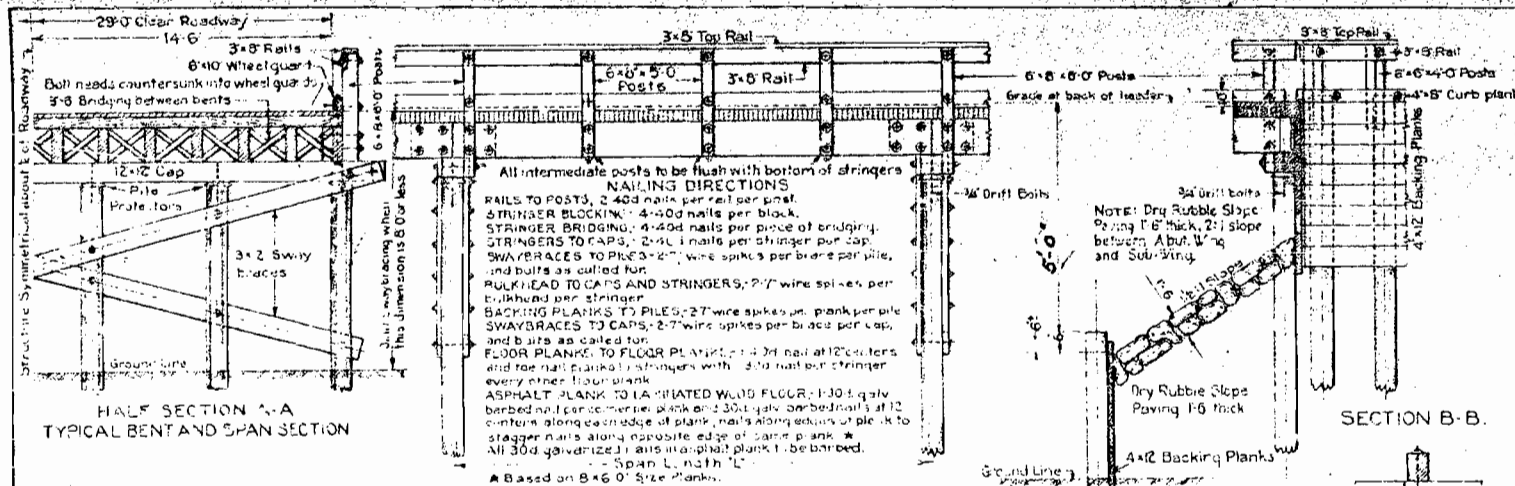

STANDARD P-117-BH-D

FED. ROAD DIST. NO.	STATE	SHEET NO.	TOTAL SHEETS
3	COLO.	210 C (1)	

BOLTS AND WASHERS FOR ONE SPAN OF SUPERSTRUCTURE

LOCATION	SIZE	19.0' SPAN	23.0' SPAN	27.0' SPAN
POSTS TO RAILS	3/8"	10	10	10
POSTS TO WHEEL GUARDS	3/4"	12	12	12
POSTS TO STRINGERS	3/4"	12	12	12
WHEEL GUARDS TO STRINGERS	3/4"	12	12	12
WHEEL GUARDS TO CAPS	3/4"	12	12	12
TOTAL WEIGHT		147.0 LBS	147.0 LBS	147.0 LBS

BOLTS AND WASHERS FOR ONE ABUTMENT

LOCATION	ITEM	SIZE	19.0' SPAN	23.0' SPAN	27.0' SPAN
POSTS TO RAILS	BOLTS	3/8"	10	10	10
POSTS TO BULKHEAD TO CAP	BOLTS	3/8"	10	10	10
POSTS TO STRINGERS	BOLTS	3/8"	10	10	10
POSTS TO WHEEL GUARDS	BOLTS	3/8"	10	10	10
WHEEL GUARDS TO STRINGERS	BOLTS	3/8"	10	10	10
WHEEL GUARDS TO CAPS	BOLTS	3/8"	10	10	10
WASHERS, STD. C.I. G.	WASHERS	3/8"	10	10	10
CAPS TO PILES	DRIFT BOLTS	3/4"	10	10	10
TOTAL WEIGHT			106.0 LBS	106.0 LBS	106.0 LBS

BOLTS AND WASHERS FOR ONE WING

LOCATION	ITEM	SIZE	19.0' SPAN	23.0' SPAN	27.0' SPAN
POSTS TO RAILS	BOLTS	3/8"	10	10	10
POSTS TO BULKHEAD	BOLTS	3/8"	10	10	10
POSTS TO STRINGERS	BOLTS	3/8"	10	10	10
POSTS TO WHEEL GUARDS	BOLTS	3/8"	10	10	10
WHEEL GUARDS TO STRINGERS	BOLTS	3/8"	10	10	10
WHEEL GUARDS TO CAPS	BOLTS	3/8"	10	10	10
WASHERS, STD. C.I. G.	WASHERS	3/8"	10	10	10
CAPS TO PILES	DRIFT BOLTS	3/4"	10	10	10
TOTAL WEIGHT			106.0 LBS	106.0 LBS	106.0 LBS

BOLTS AND WASHERS FOR ONE BENT

LOCATION	ITEM	SIZE	19.0' SPAN	23.0' SPAN	27.0' SPAN
POSTS TO RAILS	BOLTS	3/8"	10	10	10
POSTS TO WHEEL GUARDS	BOLTS	3/8"	10	10	10
POSTS TO STRINGERS	BOLTS	3/8"	10	10	10
POSTS TO WHEEL GUARDS	BOLTS	3/8"	10	10	10
WHEEL GUARDS TO STRINGERS	BOLTS	3/8"	10	10	10
WHEEL GUARDS TO CAPS	BOLTS	3/8"	10	10	10
WASHERS, STD. C.I. G.	WASHERS	3/8"	10	10	10
CAPS TO PILES	DRIFT BOLTS	3/4"	10	10	10
TOTAL WEIGHT			115.0 LBS	115.0 LBS	115.0 LBS

NAILS

LOCATION	ITEM	SIZE	19.0' SPAN	23.0' SPAN	27.0' SPAN
ONE SPAN OF SUPERSTRUCTURE	300 COMMON	16D	10	10	10
ONE ABUTMENT	300 COMMON	16D	10	10	10
ONE WING	300 COMMON	16D	10	10	10
ONE SUB-ABUTMENT	300 COMMON	16D	10	10	10
ONE BENT	300 COMMON	16D	10	10	10

SUMMARY FOR HARDWARE

LOCATION	ITEM	SIZE	19.0' SPAN	23.0' SPAN	27.0' SPAN
SPANS	AT	167 LBS PER SPAN	10	10	10
ABUTMENTS	AT	108 LBS PER ABUTMENT	10	10	10
WINGS	AT	108 LBS PER WING	10	10	10
SUB-ABUTMENTS	AT	108 LBS PER SUB-ABUTMENT	10	10	10
BENTS	AT	108 LBS PER BENT	10	10	10
TOTAL WEIGHT			1175 LBS	1175 LBS	1175 LBS

SUMMARY OF QUANTITIES

ITEM	QUANTITY	UNIT	PRICE	TOTAL
ITEM 14.3 DRY ROCK	167	CU YD	1.00	167.00
ITEM 14.4 WET ROCK	108	CU YD	1.00	108.00
ITEM 14.5 WEST COMMON	108	CU YD	1.00	108.00
ITEM 42.1 UNREATED BRIDGE TIMBER	300	LF	1.00	300.00
ITEM 42.2 TREATED BRIDGE TIMBER	300	LF	1.00	300.00
ITEM 43 ASPHALT PLANK WEARING SURFACE	300	LF	1.00	300.00
ITEM 60.1 METAL PILE SHOES	300	LF	1.00	300.00
ITEM 60.2 DRY RUBBLE SLOPE PAVING F-6 THICK	300	LF	1.00	300.00

ONE SPAN OF SUPERSTRUCTURE

DESCRIPTION	SIZE	19.0' SPAN	23.0' SPAN	27.0' SPAN
HANDRAIL S4S	3x6	10	10	10
HANDRAIL POSTS S4S	6x8	10	10	10
TOTAL UN-TREATED TIMBER		200.00 FT	200.00 FT	200.00 FT

TREATED TIMBER

DESCRIPTION	SIZE	19.0' SPAN	23.0' SPAN	27.0' SPAN
FLOORING S4S	3x6	10	10	10
BRICK LING	3x6	10	10	10
WHEEL GUARDS	6x12	10	10	10
STRINGERS	6x12	10	10	10
OUTSIDE	6x12	10	10	10
INTERMEDIATE SPANS	6x12	10	10	10
UTSIDE	6x12	10	10	10
NO SPANS	6x12	10	10	10
STRAIN LBS	6x12	10	10	10
INSIDE INTERMEDIATE	6x12	10	10	10
AND END SPANS	6x12	10	10	10
TOTAL TREATED TIMBER		672.00 FT	672.00 FT	672.00 FT
TOTAL TRIMMED INTERMEDIATE		672.00 FT	672.00 FT	672.00 FT
ASPHALT PLANK WEARING SURF		672.00 FT	672.00 FT	672.00 FT

ONE ABUTMENT

DESCRIPTION	SIZE	19.0' SPAN	23.0' SPAN	27.0' SPAN
HANDRAIL POSTS S4S	6x8	10	10	10
TOTAL UN-TREATED TIMBER		48.00 FT	48.00 FT	48.00 FT
TREATED TIMBER		48.00 FT	48.00 FT	48.00 FT
TIMBER HEADER	1x6	10	10	10
CAP	1x6	10	10	10
BULKHEAD PLANKS	1x6	10	10	10
BACKING PLANKS	1x6	10	10	10
STRINGER BLOCKING	1x6	10	10	10
CURB PLANKS	1x6	10	10	10
TOTAL TREATED TIMBER		192.00 FT	192.00 FT	192.00 FT
PILING - TREATED		7 PIECES AT 30 LIN. FT EACH = 210 LIN. FT		

ONE WING

DESCRIPTION	SIZE	19.0' SPAN	23.0' SPAN	27.0' SPAN
HANDRAILS S4S	3x6	10	10	10
HANDRAIL POSTS S4S	6x8	10	10	10
TOTAL UN-TREATED TIMBER		84.00 FT	84.00 FT	84.00 FT
TREATED TIMBER		84.00 FT	84.00 FT	84.00 FT
CURB PLANKS	1x6	10	10	10
BACKING PLANKS	1x6	10	10	10
TOTAL TREATED TIMBER		168.00 FT	168.00 FT	168.00 FT
PILING - TREATED		3 PIECES AT 32 LIN. FT EACH = 96 LIN. FT		

ONE SUB-ABUTMENT AND WINGS

DESCRIPTION	SIZE	19.0' SPAN	23.0' SPAN	27.0' SPAN
BACKING PLANKS	1x6	10	10	10
BACKING PLANKS	1x6	10	10	10
BACKING PLANKS	1x6	10	10	10
BACKING PLANKS	1x6	10	10	10
TOTAL TREATED TIMBER		144.00 FT	144.00 FT	144.00 FT
PILING - TREATED		14 PIECES AT 24 LIN. FT EACH = 336 LIN. FT		

ONE BENT

DESCRIPTION	SIZE	19.0' SPAN	23.0' SPAN	27.0' SPAN
HANDRAIL POSTS S4S	6x8	10	10	10
TOTAL UN-TREATED TIMBER		48.00 FT	48.00 FT	48.00 FT
TREATED TIMBER		48.00 FT	48.00 FT	48.00 FT
WHEEL GUARDS	6x12	10	10	10
STRINGERS	6x12	10	10	10
OUTSIDE	6x12	10	10	10
INTERMEDIATE SPANS	6x12	10	10	10
UTSIDE	6x12	10	10	10
NO SPANS	6x12	10	10	10
STRAIN LBS	6x12	10	10	10
INSIDE INTERMEDIATE	6x12	10	10	10
AND END SPANS	6x12	10	10	10
TOTAL TREATED TIMBER		448.00 FT	448.00 FT	448.00 FT
PILING - TREATED		6 PIECES AT 30 LIN. FT EACH = 180 LIN. FT		

STRUCTURES REQUIRED

STRUCTURE	SIZE	19.0' SPAN	23.0' SPAN	27.0' SPAN
SPANS	AT	10	10	10
ABUTMENTS	AT	10	10	10
WINGS	AT	10	10	10
SUB-ABUTMENTS	AT	10	10	10
BENTS	AT	10	10	10

LOADING DATA

LOADING DATA	SIZE	19.0' SPAN	23.0' SPAN	27.0' SPAN
LIVE LOAD AASHO 93B	10	10	10	10
DEAD LOAD ASSUMED 25 LBS. PER SQ. FT.	10	10	10	10
ADDITIONAL WEARING SURF INCLUDES THE 1/2" ASPHALT PLANK WEARING SURFACE	10	10	10	10

PILE SHOE

PILE SHOE	SIZE	19.0' SPAN	23.0' SPAN	27.0' SPAN
SPANS	AT	10	10	10
ABUTMENTS	AT	10	10	10
WINGS	AT	10	10	10
SUB-ABUTMENTS	AT	10	10	10
BENTS	AT	10	10	10

DETAIL OF HANDRAIL POSTS

DETAIL OF HANDRAIL POSTS	SIZE	19.0' SPAN	23.0' SPAN	27.0' SPAN
SPANS	AT	10	10	10
ABUTMENTS	AT	10	10	10
WINGS	AT	10	10	10
SUB-ABUTMENTS	AT	10	10	10
BENTS	AT	10	10	10





DETAIL OF HANDRAIL POSTS

DETAIL OF HANDRAIL POSTS	SIZE	19.0' SPAN	23.0' SPAN	27.0' SPAN
SPANS	AT	10	10	10
ABUTMENTS	AT	10	10	10
WINGS	AT	10	10	10
SUB-ABUTMENTS	AT	10	10	10
BENTS	AT	10	10	10

STRUCTURE NO. 645

STRUCTURE NO. 645

REVISIONS

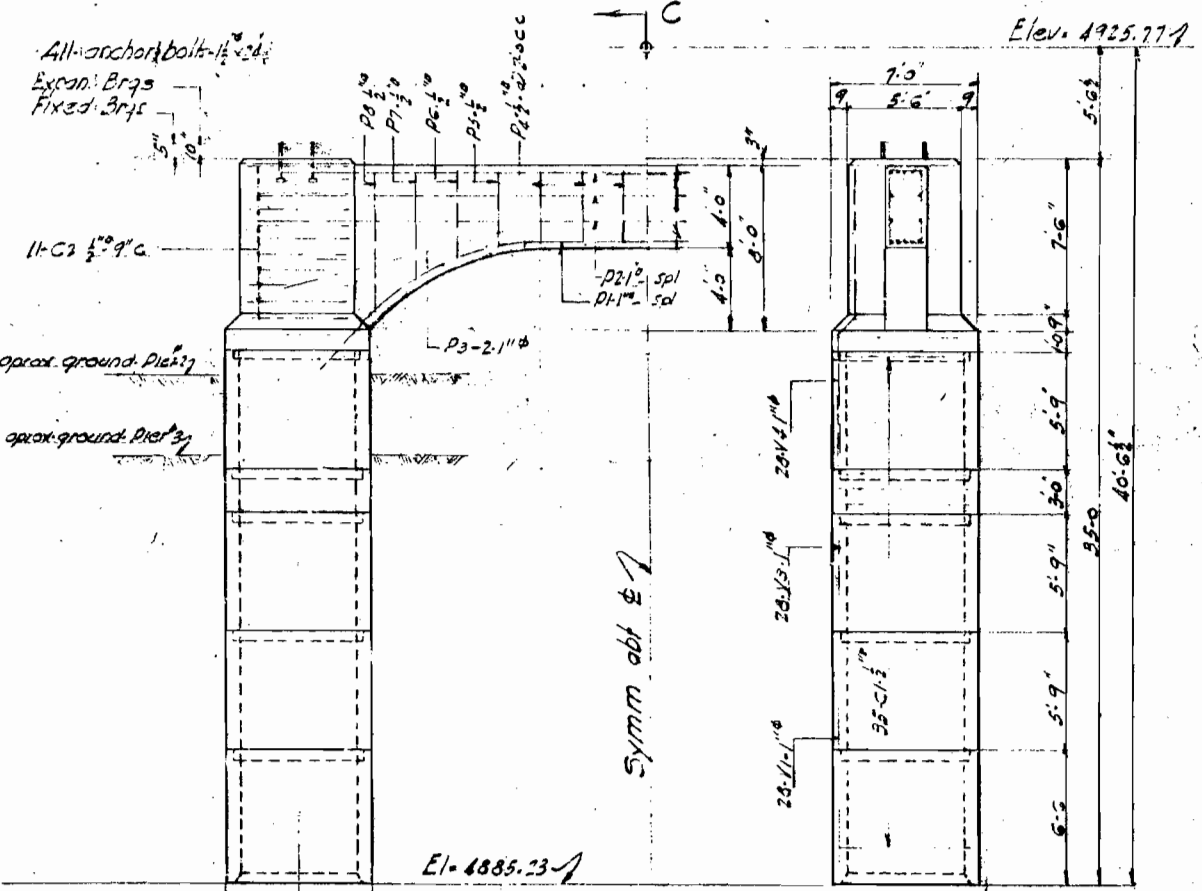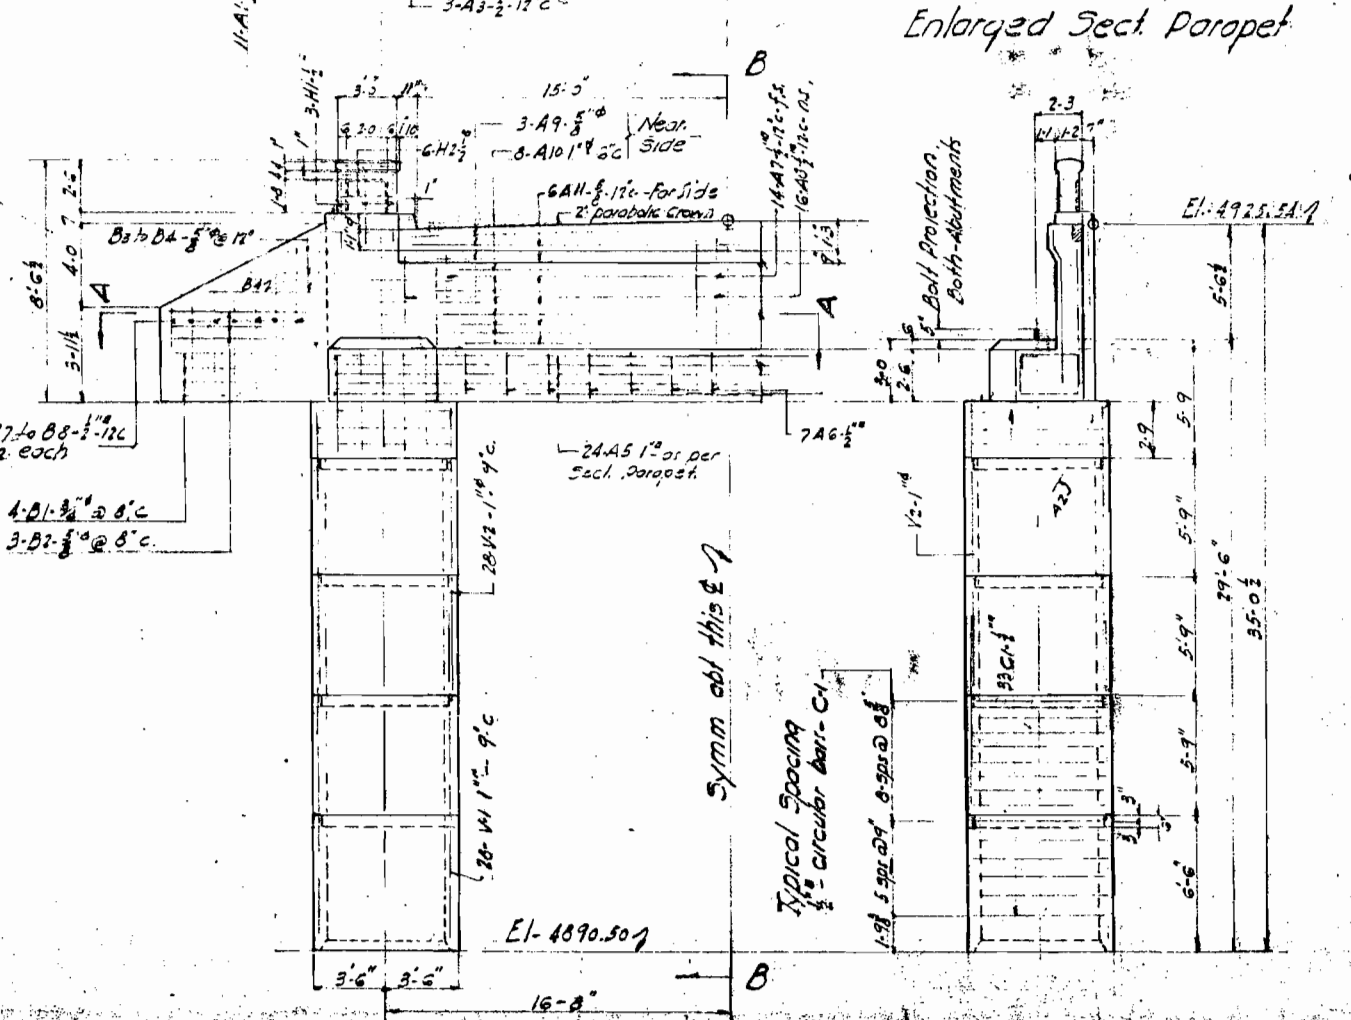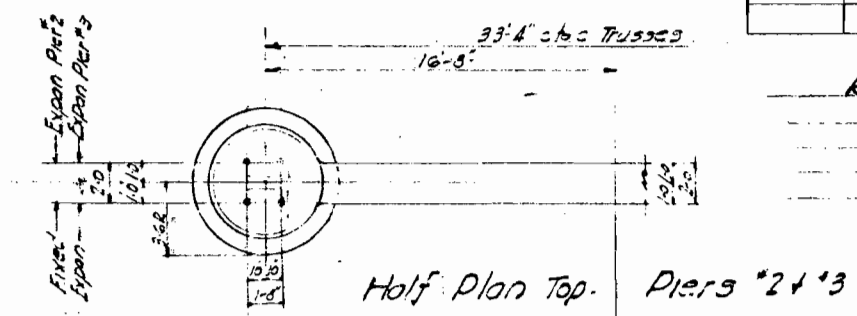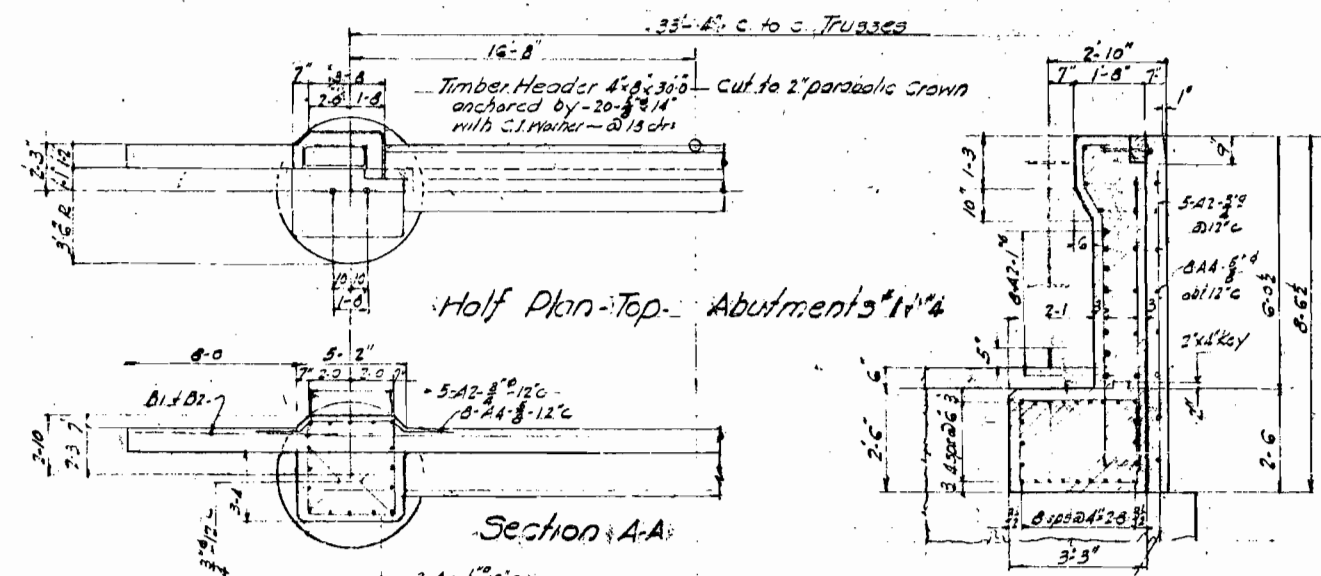

Half Elevation Abutments #1 & 4

Section B-B


Section C-C

Max. Bearing on Rock = 7 1/2 Tons

Loading - H-15-AASHO-1941
for 530 ft 1300 ft 12

COLORADO
State Highway Dept.
3-150.0 - Three Trusses
30.0 Roadway with
light concrete and floor
Abutments & Piers
Across Colorado River
Sta. 64+85.15 to 64+125.15
Near DeBeque 3 1/2 - 185.2 R 97 W
Designed by W.M.
Checked by W.M.
Approved by
Date

Design, Mortenson July 1941

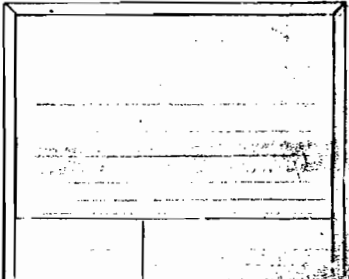

DATA REQUIRED TO ACCOMPANY SITUATION PLAN.

I. GENERAL REMARKS.

Fill out all blanks with care, giving information on all points listed, and supplementary remarks on features not listed. High water and foundation conditions are especially important and should be thoroughly investigated.

II. PROFILE.

Plot profile of centerline of roadway. Use natural scale, preferably 1"=10' or multiple of 10'. At proper locations show section of test pits, noting material encountered, if available at time of survey.

Show present, and if possible, proposed finished grade noting elevations and gradients.

III. MAP.

Show present and proposed alignment of bridge and all approaches, as far as affected. Extend cross sections at least 100 ft. each side of C. L., giving location and elevation of points so that at least 2-foot contours may be accurately plotted. Show edge of water, islands, shoals, other obstructions, and direction of current at high water and at low water. Plot location of test pits, position and pointing of camera for each photo, all buildings, fences, and other features affected. Establish bench marks and give location of same. Reference C. L. and show North point. Give a C. L. profile of stream-bed for 500 feet up-stream and 500 feet down-stream from center line of survey. Plot proposed structure in soft pencil only. Do not ink.

IV. REPORT OF EXAMINATION OF BRIDGE-SITE.

Div. _____ County Monte Route _____ Sec. _____ Sta. _____

Date of survey _____ To be built by _____

1. Bridge Site 1 1/2 Miles E. of De Beque

Location _____

Sec. 22 Twp. 8 S Range 97 W Local name _____

Over Colorado River Main Channel River _____ Creek _____

Distance from nearest shipping point 1 1/2 miles

2. Source of materials.

Sand _____ Length of haul to site _____ miles
Gravel _____ " " " " " "
Stone _____ " " " " " "
Falsework Timber _____ " " " " " "
Piling _____ " " " " " "

3. Cost Data.

Cost of following materials at site.
Portland Cement _____ Per Bbl.
Sand, coarse and clean _____ " Cu. Yd.
Gravel _____ " " "
Stone _____ " " "
Falsework Timber _____ " Ft. B. M.
Piling _____ " Lin. Ft.
Co. per ton-mile for hauling _____

4. Waterway.

Drainage area in Sq. Miles (approximate) _____
Character of watershed _____
Elevation of Highest water 7917 Date _____
Source of information on water elevation _____
Elevation of ordinary high water _____
Elevation of low water _____
Elevation of permanent ground-water _____
Is stream ever dry? No During what months? _____
Will all flood water pass through recommended structure? _____
Can channel be cleaned to afford more waterway? _____
Is stream-bed cutting or silting up? _____
Is stream stable in its banks? _____ Depth of scour? _____
Does stream carry light, medium, or heavy drift? _____
What clearance above high water should be allowed? _____
Is channel change necessary? _____
If channel change is necessary, illustrate location on sketch map.

5. Foundation Data.

Character of material _____
Distance from stream-bed to solid foundation _____
Recommended depth of footings _____
Should piles be used? _____ What length? _____ Pile Shoes? _____

6. Old Bridge.

If there is no bridge at the present location include here data on nearest bridge over same stream. If possible show location of such bridge or bridges on the map. Photographs if available.
Type _____ Roadway Width _____ Number and length of spans _____
Area of waterway provided under old structure _____ Sq. Ft., Elev. of Underclearance _____
Has this area proved sufficient at flood times? _____ Skew Angle _____
Is it too large? _____ Disposition of Existing Structure _____

7. Give foundation data on bridges in vicinity. When possible, get pile driving data, logs of borings, etc., for adjoining structures, and where considered advantageous procure plans.

Sketch profile of Rail Road Crossing if within 1000 ft. of Highway. (Show X-section of entire waterway.)
Elevation of base of Rail _____ Elevation of Rail Road Underclearance _____
Remarks _____

8. Recommendations for New Structure.

Type _____ Width curb to curb _____ Number and length of spans _____
What is the least clear span permissible? _____
Are sidewalks desired? _____ Lighting conduit? _____ Light standards? _____
Angle of Skew recommended _____
Will approaches be desired, or will same be filled? _____
Approximate cost per Cu. Yd. of approach-filling at bridge site? _____
Is it necessary to maintain traffic alongside old structure? _____

If so, how shall it be done? _____

R. R. Siding _____ Haul to Bridge Site _____ Mts.
Remarks _____


Submitted by _____ Engineer.

NOTE.—When bridge is recommended to be left in place, complete structural details shall be procured from the bridge itself or from existing plans of the structure. When possible these plans shall be forwarded with the plans of the project.

FED. ROAD DIST. NO.	STATE	PROJ. NO.	SHEET NO.	TOTAL SHEETS
3	COLO.	5-N-AP		1

210 C (1)

Layout Sheet for 2 Spans @ 200'
H.W. 5-21-41.

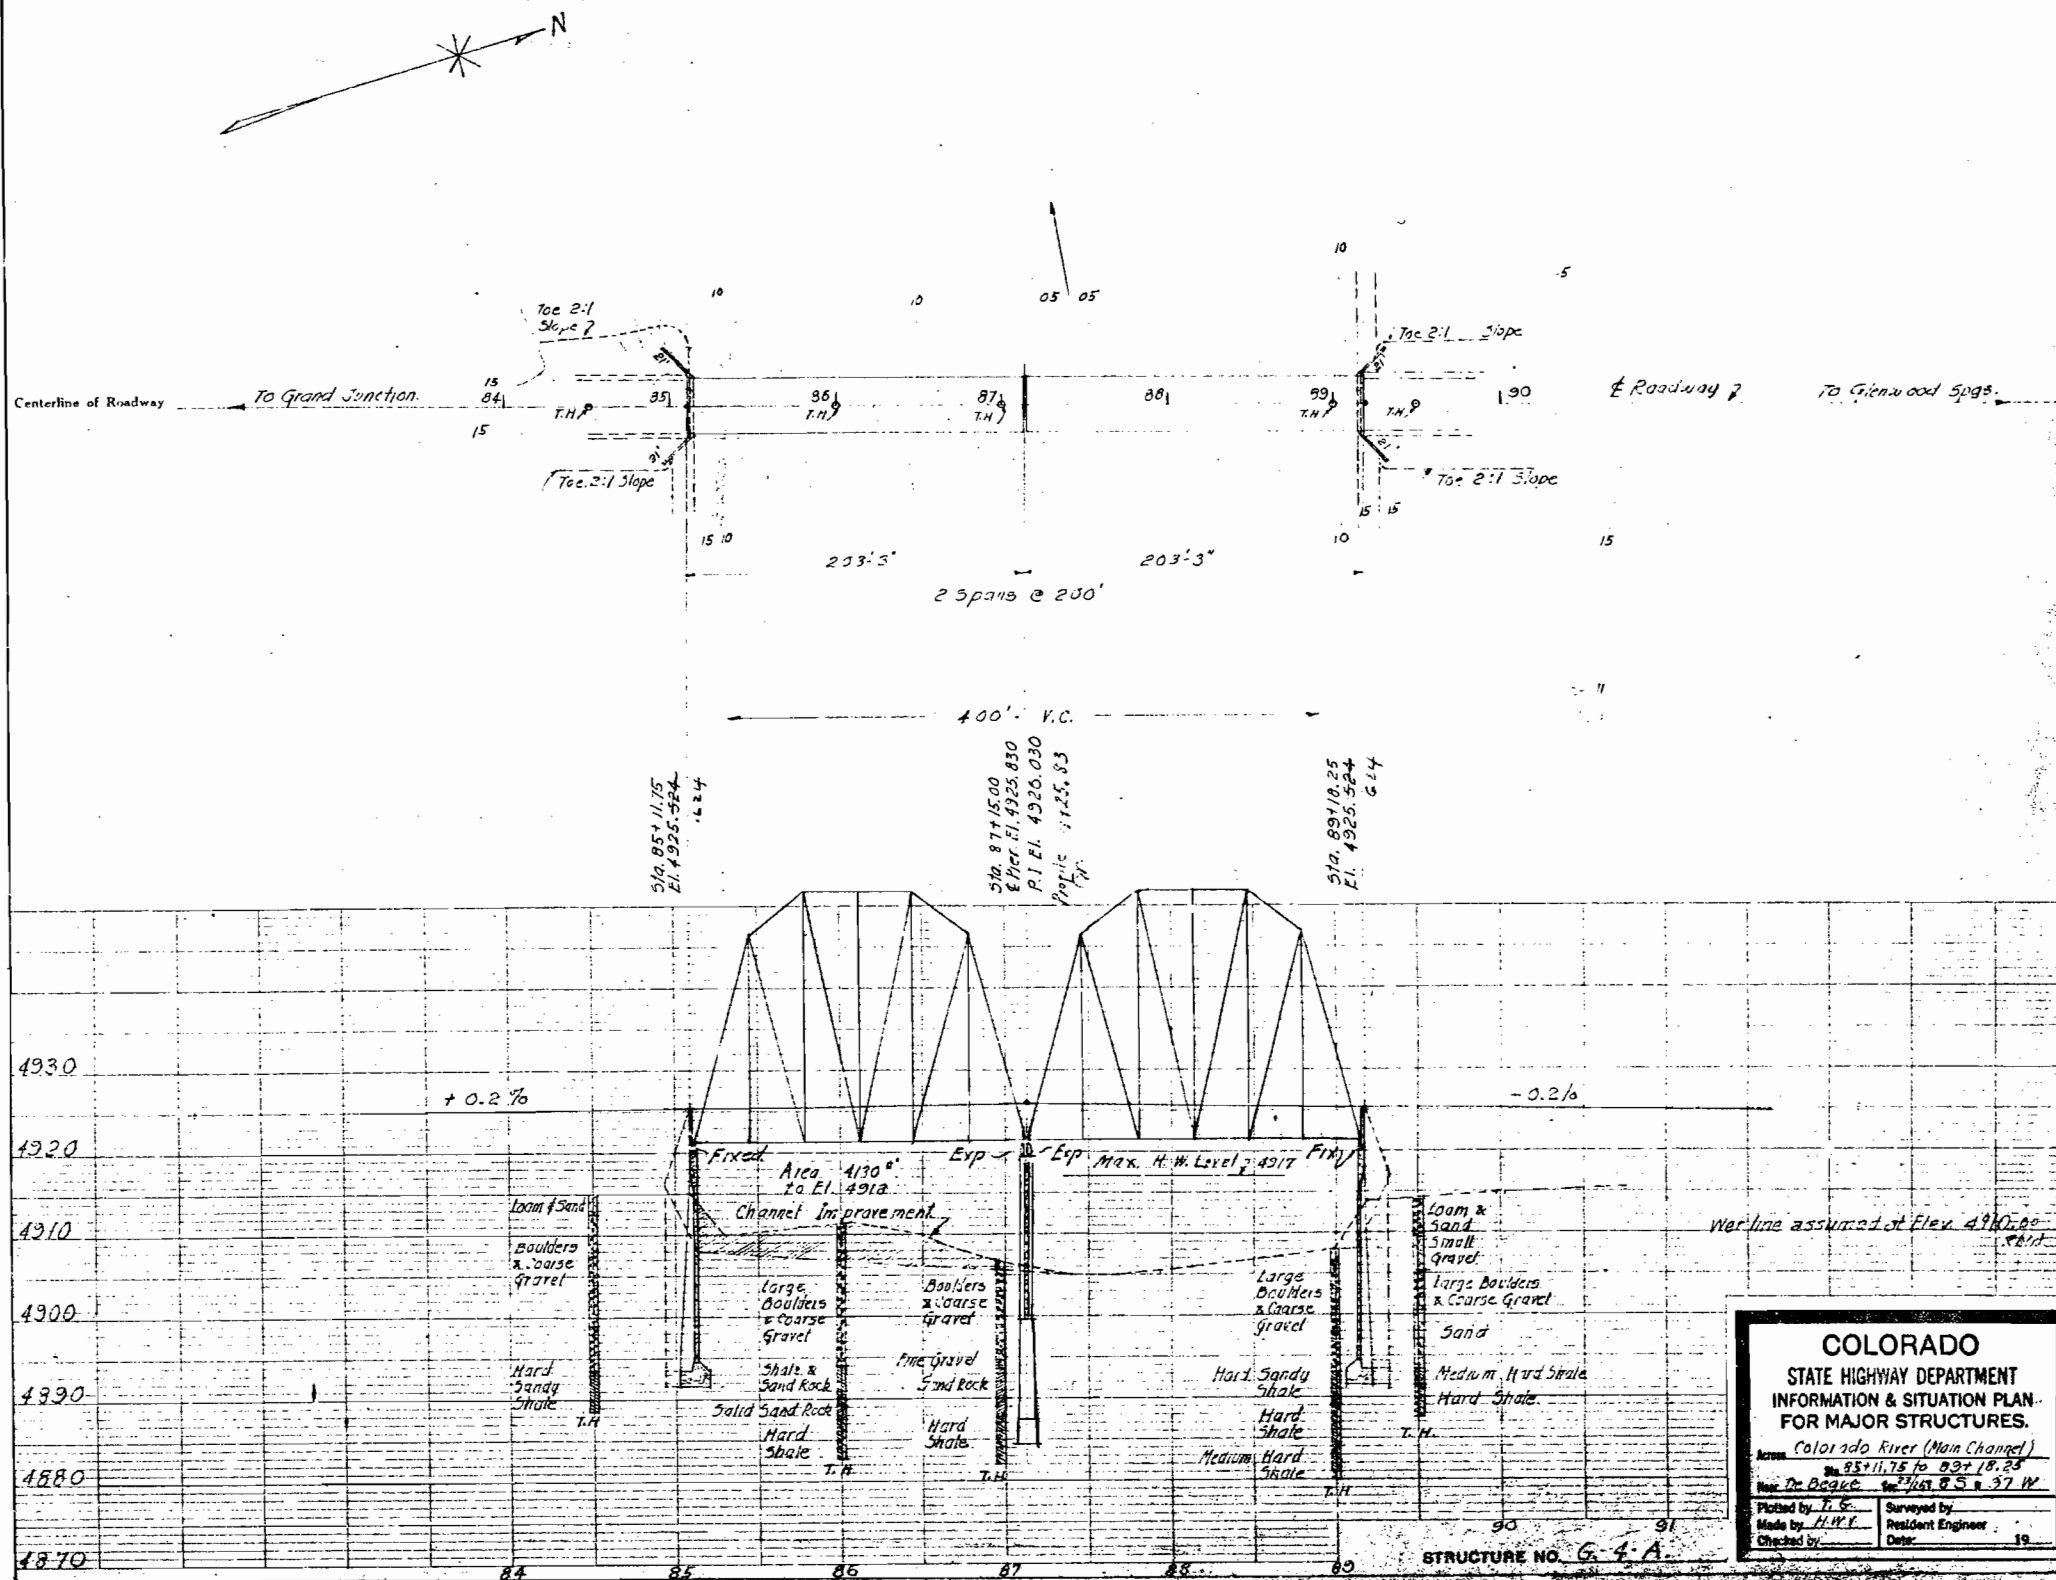


COLORADO
STATE HIGHWAY DEPARTMENT
INFORMATION & SITUATION PLAN
FOR MAJOR STRUCTURES.


Across Colorado River (Main Channel)
Sta. 85+11.75 to 83+18.25
Near De Beque on Highway 97 W

Plotted by J. E.
Made by H. W. F.
Checked by _____


Surveyed by _____
Resident Engineer _____
Date _____

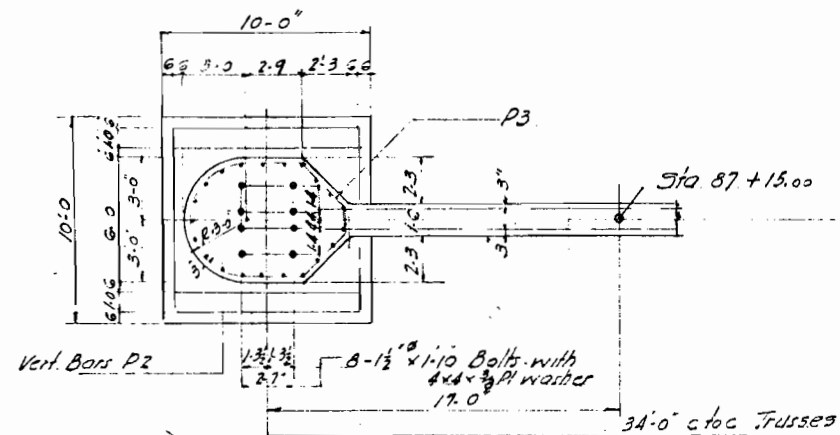

Half Plan

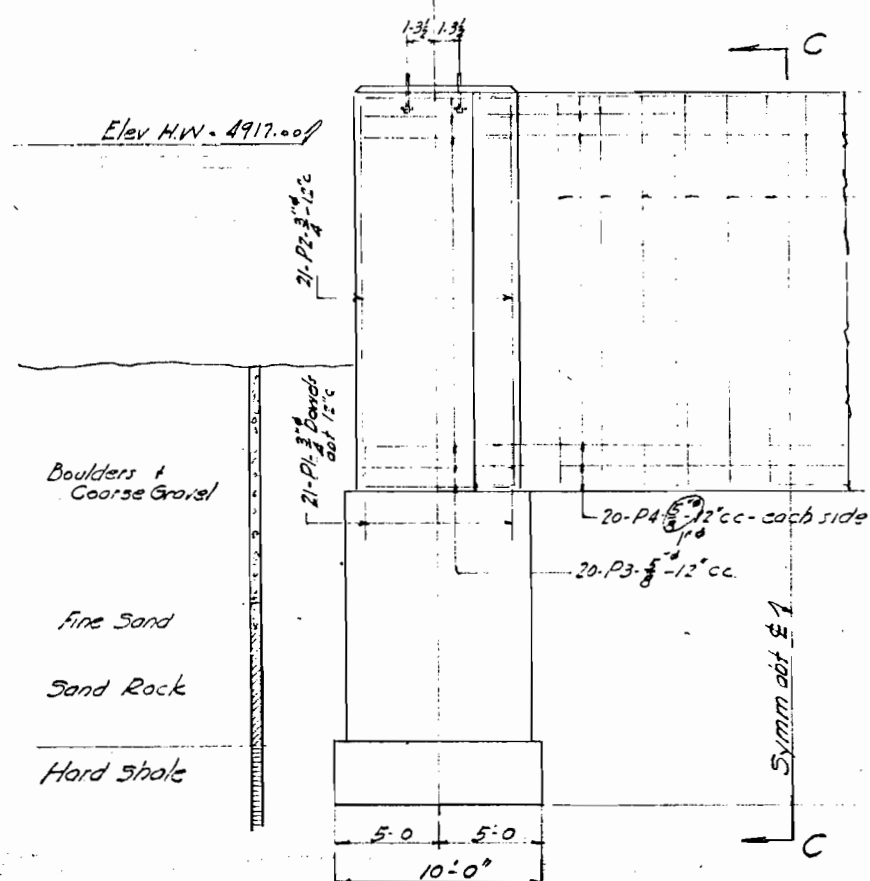

Half Elevation

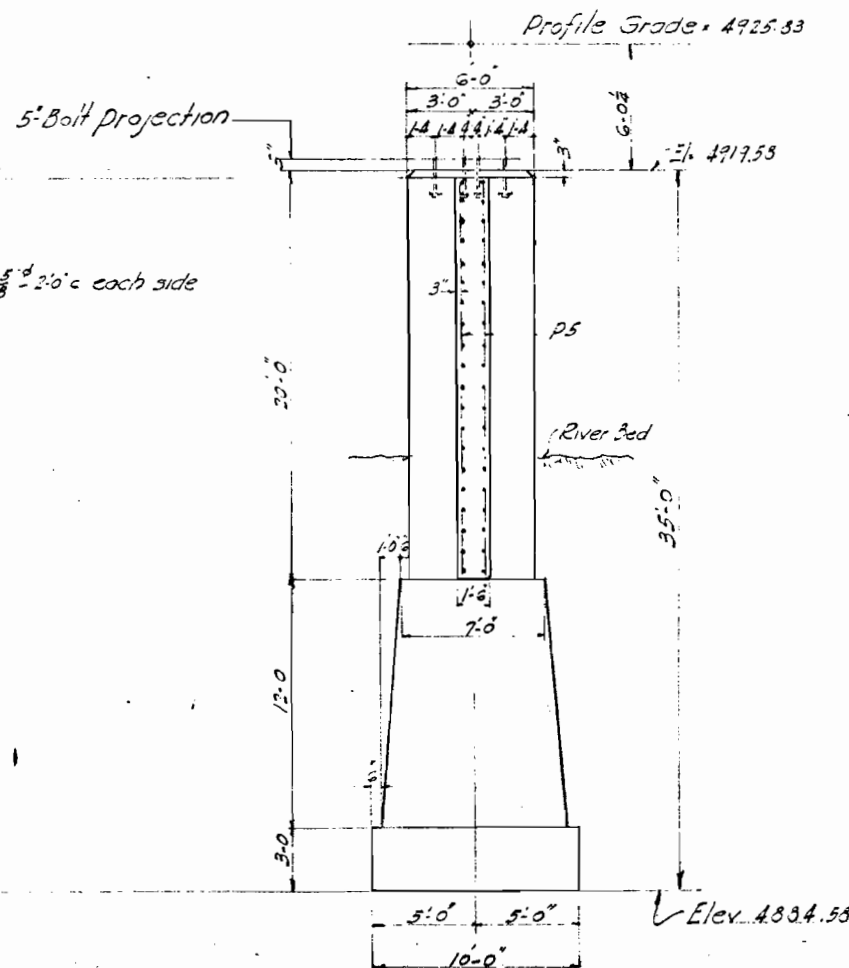

Section C-C

Pressure on footing = 5 Tons/sq ft

Structure No. G-A-A

COLORADO State Highway Dept 2-200-0 Thru. Trusses Details - Pier #2 over Colorado River Sta 85+11.15 to 87+13.35 N. D. DeBevoise 5/2/20 S. T. O. S. 2/27/21 Design - H. M. M. Approved - Bridge Eng. Made - H. M. M. Check - Data	
--	--

Madison, Nov. 2, 1921

FED. ROAD DIST. NO.	STATE	PROJ. NO.	SHEET NO.	TOTAL SHEETS
2	COLO.	EA2300		

Layout-Sizer #2

Fill out all blanks with care, giving information on all points listed, and supplementary remarks on features not listed. High water and foundation conditions are especially important and should be thoroughly investigated.

Plot profile of centerline of roadway. Use natural scale, preferably 1"=10' or multiple of 10'.
At proper locations show section of test pits, noting material encountered, if available.

III. MAP. Show present and proposed alignment of bridge and all approaches, as far as affected. Establish cross sections at least 100-ft. each side of C. L., giving location and elevation of points. Show that at least 2-foot contours may be accurately plotted. Show edge of water, islands, shoals, other obstructions, and direction of current at high water and at low water. Plot location of test pits, position and pointing of camera for each photo, all buildings, fences, and other features affected. Establish bench marks and give location of same. References C. L. and show North point. Give a C. L.-profile of stream for 500 feet up-stream and 500 feet down-stream from center line of survey. Plot proposed structure in soft pencil only. Do not ink.

Div. _____ County _____ Route _____ Sec. _____ Sta. _____
 Date of survey _____ To be built by _____

Location _____
 Sec. _____ Twp. _____ Range _____ Local name _____
 Over _____ River _____ Creek _____
 Distance from nearest shipping point _____

Sand _____	Length of haul to slits _____	_____ fathoms
Gravel _____	" " " " " "	" "
Stones _____	" " " " " "	" "
Falsework Timber _____	" " " " " "	" "
Piling _____	" " " " " "	" "

Cost of following materials at site		
Portland Cement		Per Bbl.
Sand, coarse and clean		" Cu. Yd.
Gravel		" " "
Stone		" " "
Falsework Timber		" Ft. B. M.
Piling		" Lin. Ft.
Cost per ton-mile for hauling		

Drainage area in Sq. Miles (approximate) _____
 Character of watershed _____
 Elevation of Highest water _____ Date _____
 Source of information on water elevation _____
 Elevation of ordinary high water _____
 Elevation of low water _____
 Elevation of permanent ground-water _____
 Is stream ever dry? _____ During what months? _____
 Will all flood water pass through recommended structure? _____
 Can channel be cleaned to afford more waterway? _____
 Is stream-bed cutting or silting up? _____
 Is stream stable in its banks? _____ Depth of scour? _____
 Does stream carry light, medium, or heavy drift? _____
 What clearance above high water should be allowed? _____
 Is channel change necessary? _____
 If channel change is necessary, illustrate location on sketch map. _____

Character of material _____
 Distance from stream-bed to solid foundation _____
 Recommended depth of footings _____
 Should piles be used? _____ What length? _____ Pile Shoes? _____

If there is no bridge at the present location include here data on nearest bridge over same stream. If possible show location of such bridge or bridges on the map. Photographs if available.

Type _____ Roadway Width _____ Number and length of spans _____

Area of waterway provided under old structure _____ Sq. Ft., Elev. of Underclearance _____

Has this area proved sufficient at flood times? _____ Skew Angle _____

Is it too large? _____ Disposition of Existing Structure _____


7. Give foundation data on bridges in vicinity. When possible, get pile driving date, logs of borings, etc., for adjoining structures, and where considered advantageous procure plans.

Sketch profile of Rail Road Crossing if within 1000 ft. of Highway. (Show X-section of entire waterway.)
Elevation of base of Rail _____ Elevation of Rail Road Underclearance _____
Remarks _____

8. Recommendations for New Structure.—
Type _____ Width curb to curb _____ Number and length of spans _____
What is the least clear span permissible? _____
Are sidewalks desired? _____ Lighting conduit? _____ Light standards? _____
Angle of Skew recommended _____
Will approaches be desired, or will same be filled? _____
Approximate cost per Cu. Yd. of approach-filling at bridge site? _____
Is it necessary to maintain traffic alongside old structure? _____
If so, how shall it be done? _____

R. R. Siding _____ Haul to Bridge Site _____ M
Remarks _____
Submitted by _____ Engineer.

NOTE.—When bridge is recommended to be left in place, complete structural details shall be procured from the bridge itself or from existing plans of the structure. When possible these plans shall be forwarded with the plans of the project.

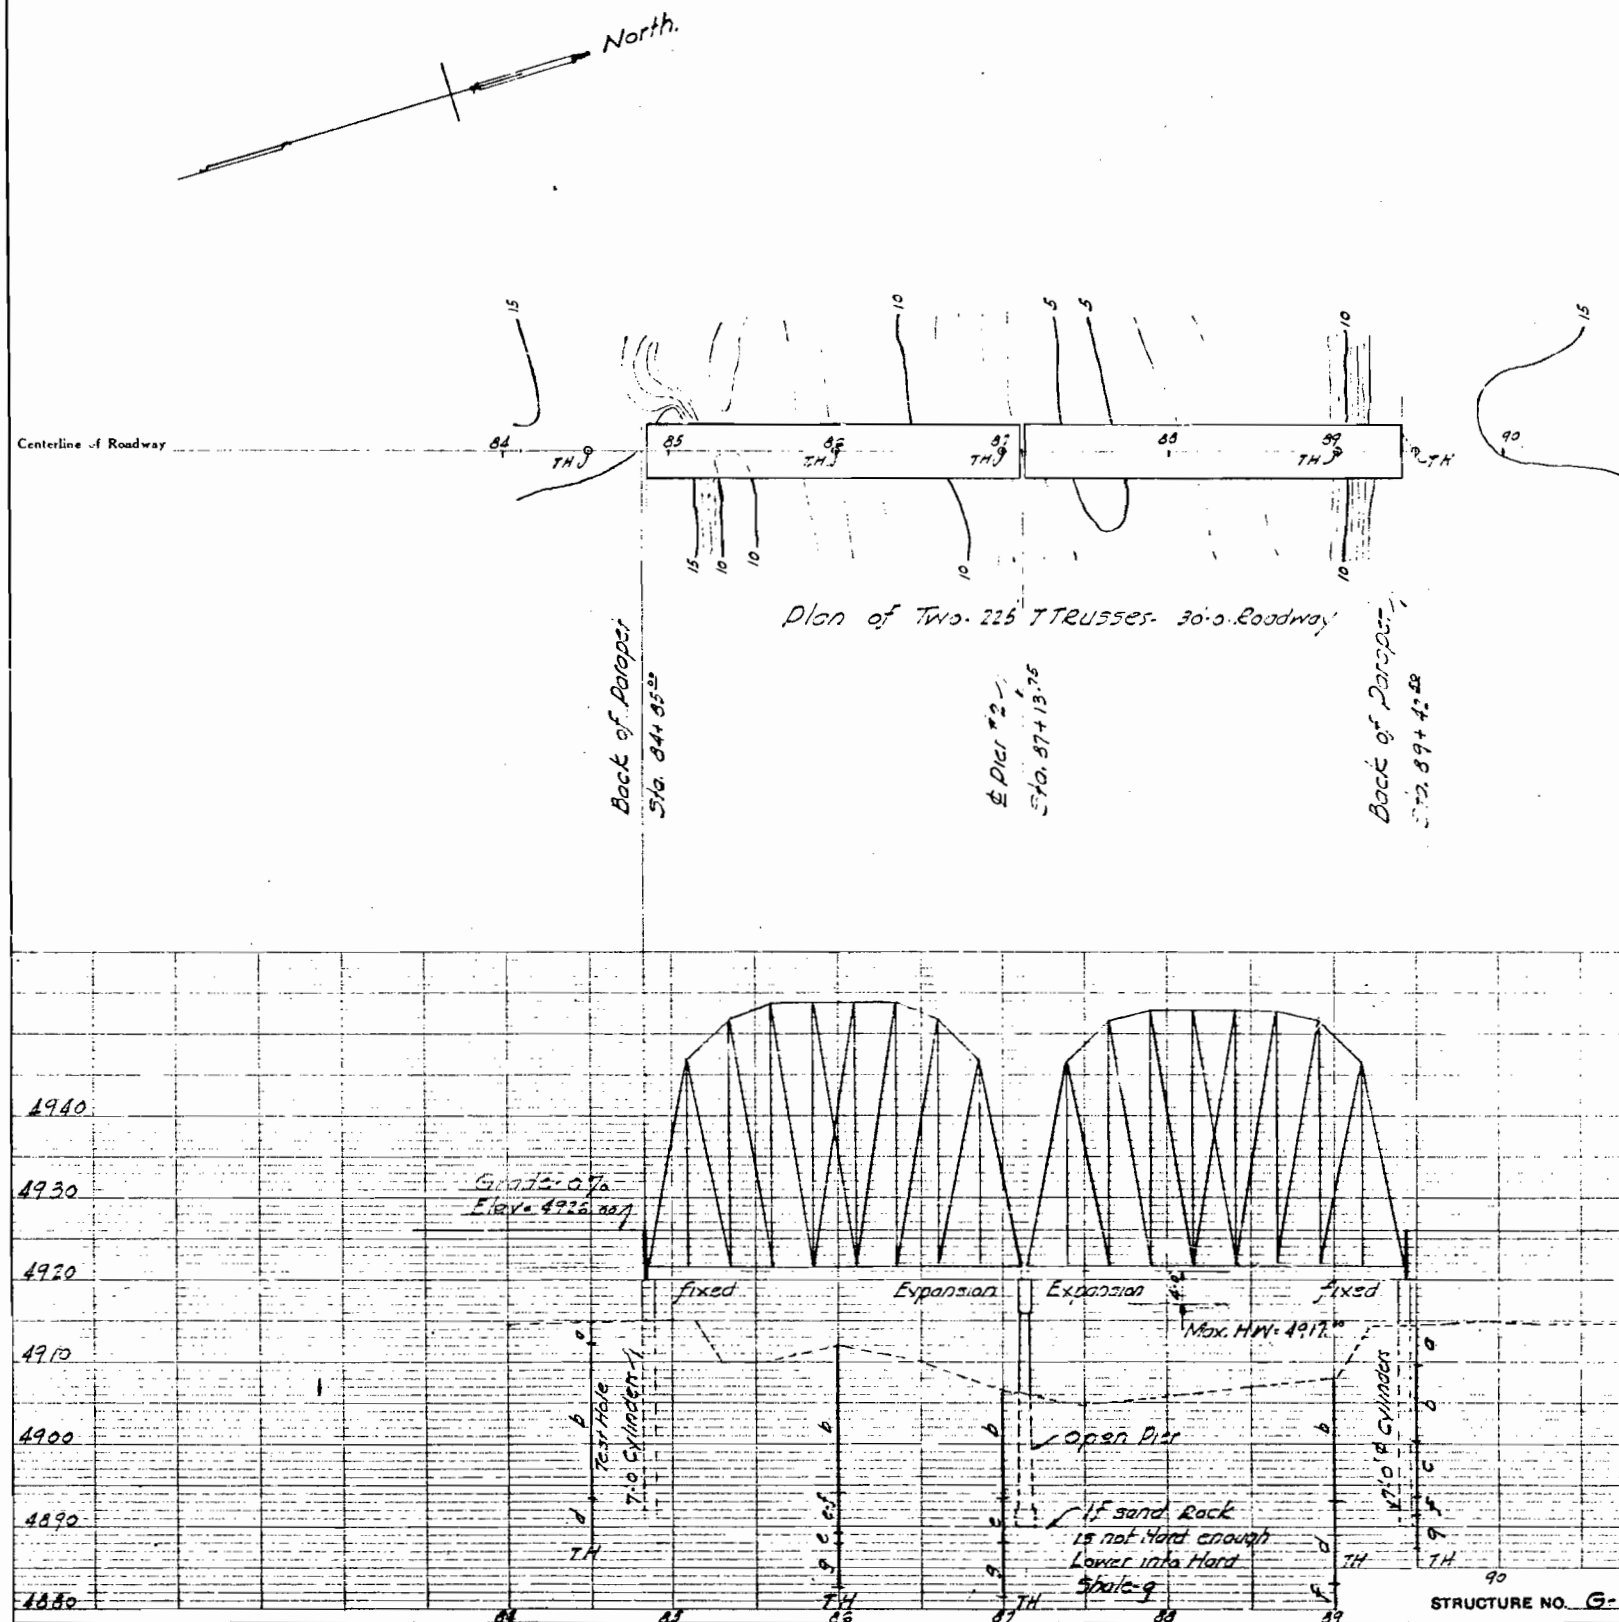

Test Holes - T.H.

- a. - Loom & Sand.
- b. - Boulder & Coarse Gravel.
- c. - Sand
- d. - Hard Sand Shale
- e. - Sand Rock
- f. - Medium Hard Shale
- g. - Hard Shale

Note: - Boulder in Stream Bed. Large

COLORADO
STATE HIGHWAY DEPARTMENT
INFORMATION & SITUATION PLAN
FOR MAJOR STRUCTURES.

Across Colorado River
 Sta. 44+43
 Near De Beque on 143 W 97N

Plotted by WME
 Made by _____
 Checked by _____

Surveyed by _____
 Resident Engineer
 Date: May 6 1961

STRUCTURE NO. G-4-A