

CONSTRUCTION SUBACCOUNT NO. 11169

AS CONSTRUCTED
NO REVISIONS

REGION	DIVISION	PROJECT NO.	SHEET NO.	SHEET TOTALS
	COLORADO	STA 0471-020	1	

REVISIONS

COLORADO DEPARTMENT OF TRANSPORTATION

PLAN AND PROFILE OF PROPOSED

FEDERAL AID PROJECT NO. STA 0471-020


STATE HIGHWAY NO. 47

TROY AVENUE EAST AND WEST PUEBLO COUNTY


INDEX OF SHEETS

LENGTH AND DESIGN DATA

STATION	LINEAR FEET	
	ROADWAY	MAJOR STRUCTURE
STATE HIGHWAY 47		
BEG. PROJ. NO. STA 0471-020 STA. 70+50.00 ~ STA. 70+50.00 PROJ. NO. FFU 047-1(6) = M.P. 0.91		
BEGIN MAJOR STRUCTURE K-18-GA STA. 149+56.50	7906.50	
END MAJOR STRUCTURE K-18-GA STA. 151+24.00		167.50
END PROJ. NO. STA 0471-020 STA. 191+07.29 ~ STA. 191+34.97 PROJ. NO. FCU 047-1(10) = M.P. 3.19	3983.29	
TOTALS		
SUMMARY	LIN. FT.	MILES
ROADWAY	11,889.79	2.252
MAJOR STRUCTURE	167.50	0.032
PROJECT GROSS LENGTH	12,057.29	2.284
PROJECT NET LENGTH	12,057.29	2.284
DESIGN DATA		
	SH47	RAMPS
MAXIMUM DEGREE OF CURVE	3'00"	2'00"
MAXIMUM GRADE	3.90%	3.66%
MINIMUM SSD HORIZONTAL	>650 FT.	>400 FT.
MINIMUM SSD VERTICAL	585 FT.	>365 FT.
MAXIMUM DESIGN SPEED	60 MPH	
TRAFFIC DATA		
	M.P. 0.8 - 2.4	M.P. 2.4 - 3.4
CURRENT ADT (1994)	12,900	6,700
FUTURE ADT (2015)	16,100	9,400
FUTURE DHV (2015)	1,771	1,034
PERCENT TRUCKS	5%	5%

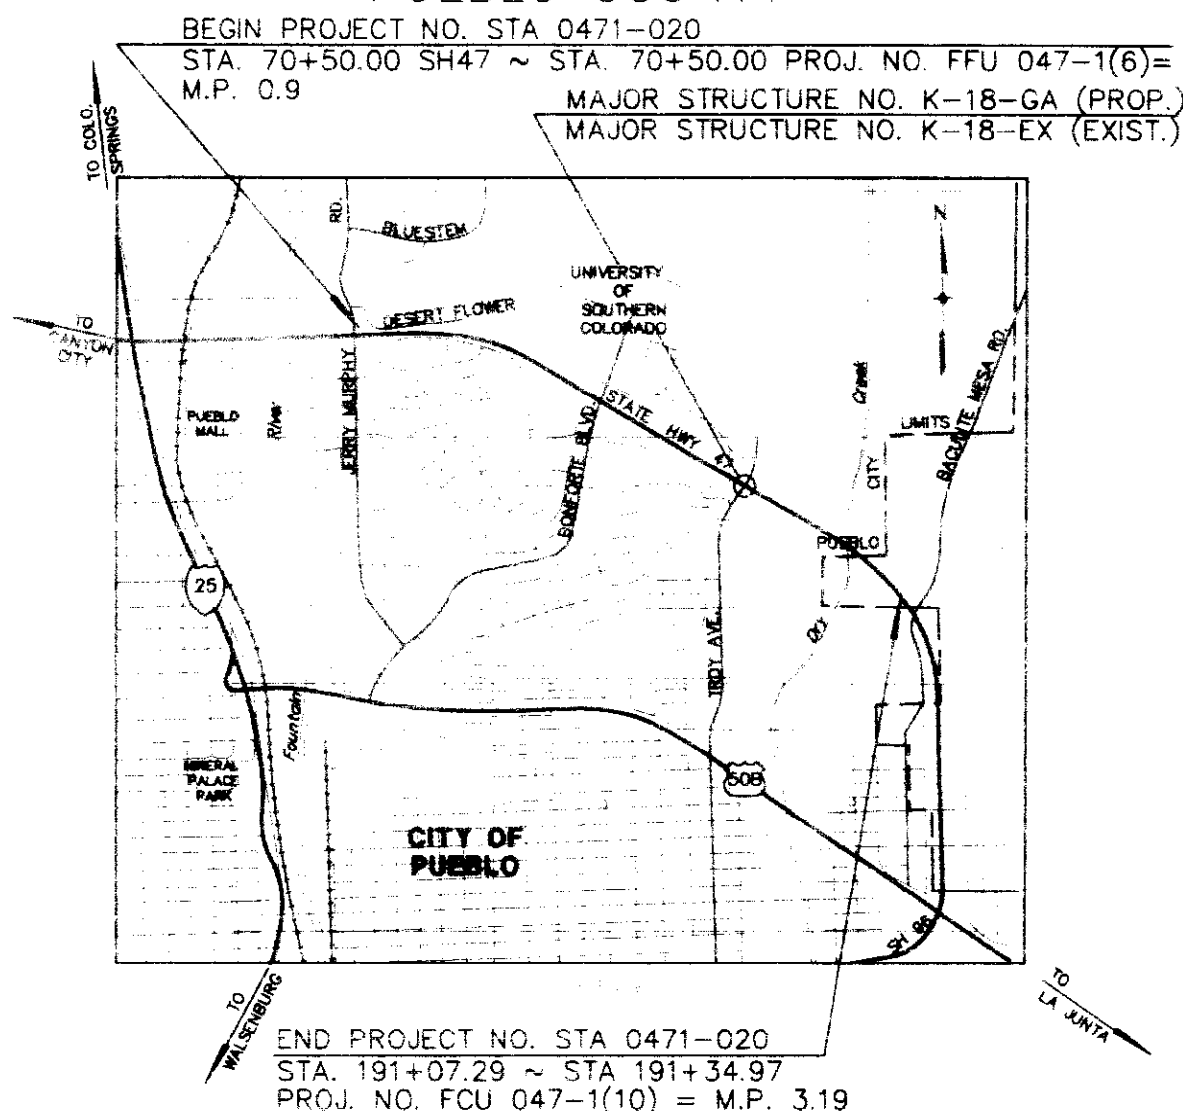

SHEET NO.	DESCRIPTION
1	TITLE SHEET AND TABULATION OF LENGTH & DESIGN DATA
2	STANDARD PLANS LIST
3	GENERAL NOTES & PAVEMENT STABILIZATION DATA
4-5	TYPICAL SECTIONS AND DETAILS
6-10	SUMMARY OF APPROXIMATE QUANTITIES
11	STRUCTURE QUANTITIES LIST
12	SUMMARY OF EARTHWORK QUANTITIES, TABULATION OF GUARDRAIL, AND GALVANIZED PIPE IRRIGATION SLEEVING
13	SURFACING PLAN
14	SURVEY TABULATION SHEET
15	CONTROL DIAGRAM SHEET
16-17	GEOMETRIC CONTROL LAYOUT
18	OUTLET PAVING DETAIL - 178+50
19	TABULATION & DETAILS OF RIPRAP BERM AND DIVERSION STRUCTURES
20	UNDERDRAIN DETAILS
21-51	MAJOR STRUCTURES NO. K-18-GA & K-18-EX
52-61	ROADWAY PLAN & PROFILE
62	SH47/JERRY MURPHY ROAD INTERCHANGE RAMP B PLAN & PROFILE
63-65	SH47/TROY AVENUE INTERCHANGE RAMPS A & B PLAN & PROFILE
66-68	ROADWAY DITCH PROFILES
69-70	WETLAND MITIGATION & TABULATIONS
71-74	STORMWATER MANAGEMENT PLAN
75-83	SIGNING AND STRIPING PLANS
84	TABULATION OF TRAFFIC ENGINEERING ITEMS, CONSTRUCTION TRAFFIC SIGNS, AND DELINEATORS
85-93	CONSTRUCTION TRAFFIC CONTROL PLANS
94-96	LIGHTING PLANS
97	POWER SOURCE DETAIL
98-99	SLOTTED RAIL TERMINAL DETAILS
100-104	STRUCTURE CROSS SECTIONS

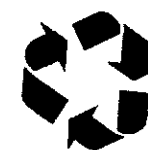

AS CONSTRUCTED INFORMATION

CONTRACTOR	
ENGINEER	
PROJECT STARTED	
PROJECT COMPLETED	
AS CONSTRUCTED PLANS	
APPROVED	
TITLE	DATE

DLM - R2 FHWA OVERSIGHT NO ☒ YES ☐ NOT APPLICABLE ☐ NHS SYSTEM NO ☐ YES ☒

PLAN NUMBER	M STANDARD TITLE	PAGE NUMBER	PLAN NUMBER	M STANDARD TITLE	PAGE NUMBER	PLAN NUMBER	S STANDARD TITLE	PAGE NUMBER
☒ M-100-1	STANDARD SYMBOLS	1	☐ M-607-1	WIRE FENCES AND GATES	(2 SHEETS) 64	☒ S-612-1	TYPICAL DELINEATOR INSTALLATIONS	(5 SHEETS) 93
☐ M-107-1	TEMPORARY EROSION CONTROL	2	☒ M-607-2	CHAIN LINK FENCE	(3 SHEETS) 66	☒ S-614-1	TYPICAL GROUND SIGN PLACEMENT	98
☐ M-203-1	APPROACH ROADS	3	☐ M-607-3	BARRIER FENCE	69	☒ S-614-2	CLASS I GROUND SIGN INSTALLATIONS	99
☐ M-203-2	DITCH TYPES	4	☐ M-607-4	DEER FENCE AND GATE	(2 SHEETS) 70	☒ S-614-3	CLASS II GROUND SIGN INSTALLATIONS	100
☐ M-203-10	SUPERELEVATION CROWNED HIGHWAYS	5	☐ M-607-10	PICKET SNOW FENCE	72	☒ S-614-4	CLASS III SIGNS, SHEET ALUMINUM PANELS	(3 SHEETS) 101
☐ M-203-11	SUPERELEVATION DIVIDED HIGHWAYS SHOULDER PIVOT	6	☐ M-608-1	CURB RAMPS	73	☒ S-614-5	BREAK-AWAY SIGN SUPPORT DETAILS FOR GROUND SIGNS	(2 SHEETS) 104
☐ M-203-12	SUPERELEVATION STREETS	7	☐ M-609-1	CURBS AND GUTTERS	74	☒ S-614-6	CONCRETE FOOTINGS AND SIGN ISLANDS FOR CLASS III SIGNS	(2 SHEETS) 106
☒ M-203-13	SUPERELEVATION DIVIDED HIGHWAYS CENTER PIVOT	8	☐ M-611-1	CATTLE GUARD	(2 SHEETS) 75	☒ S-614-10	TYPICAL MARKER ASSEMBLY INSTALLATIONS	108
☒ M-206-1	EXCAVATION AND BACKFILL FOR STRUCTURES (3 SHEETS)	9	☒ M-613-1	CONVENTIONAL HIGHWAY LIGHTING	(3 SHEETS) 77	☒ S-614-11	MILEPOST SIGN AND INSTALLATION	109
☒ M-206-2	EXCAVATION AND BACKFILL FOR BRIDGES	12	☐ M-613-2	HIGH MAST LIGHTING	(2 SHEETS) 80	☒ S-614-12	STRUCTURE NUMBER INSTALLATION (BRIDGE INFORMATION SHEET)	110
☐ M-210-1	MAILBOX SUPPORTS	(2 SHEETS) 13	☐ M-614-1	RUMBLE STRIPS	82	☐ S-614-14	FLASHING BEACON AND SIGN INSTALLATION	(2 SHEETS) 111
☐ M-214-1	PLANTING DETAILS	15	☐ M-615-1	EMBANKMENT PROTECTOR, TYPE 3	83	☐ S-614-20	TYPICAL POLE MOUNT SIGN INSTALLATION	113
☐ M-412-1	CONCRETE PAVEMENT JOINTS	16	☒ M-615-2	EMBANKMENT PROTECTOR, TYPE 5	84	☐ S-614-21	CONCRETE BARRIER SIGN POST INSTALLATIONS	114
☐ M-412-2	CURBED CONCRETE PAVEMENT JOINTS	17	☐ M-616-1	INVERTED SIPHON (ALSO USE APPLICABLE M-603)	85	☐ S-614-22	TYPICAL MULTI-SIGN INSTALLATIONS	115
☐ M-504-1	STEEL CRIBBING	18	☐ M-620-1	FIELD LABORATORY, CLASS 1	86	☐ S-614-40	TYPICAL TRAFFIC SIGNAL INSTALLATION DETAILS (3 SHEETS)	116
☐ M-506-1	GABIONS AND SLOPE MATTRESS	19	☒ M-620-2	FIELD LABORATORY, CLASS 2	87	☒ S-627-1	TYPICAL PAVEMENT MARKINGS	(4 SHEETS) 119
☐ M-510-1	STRUCTURAL PLATE CULVERT PIPE H-20 LOADING	20	☐ M-620-11	FIELD OFFICE, CLASS 1	88	☒ S-630-1	TRAFFIC CONTROLS FOR HIGHWAY CONSTRUCTION	(9 SHEETS) 123
☐ M-601-1	SINGLE CONCRETE BOX CULVERT	(2 SHEETS) 21	☒ M-620-12	FIELD OFFICE, CLASS 2	89	☒ S-630-2	BARRICADES, DRUMS, CONCRETE BARRIERS (TEMP) & VERTICAL PANELS	132
☐ M-601-2	DOUBLE CONCRETE BOX CULVERT	(2 SHEETS) 23	☒ M-629-1	SURVEY MONUMENTS	(2 SHEETS) 90	☒ S-630-3	FLASHING BEACON (PORTABLE) DETAILS	133
☐ M-601-3	TRIPLE CONCRETE BOX CULVERT	(2 SHEETS) 25						
☐ M-601-10	HEADWALL FOR PIPE CULVERTS	27						
☐ M-601-11	TYPE "S" SADDLE HEADWALL FOR PIPE CULVERTS	28						
☒ M-601-12	HEADWALLS AND CULVERT OUTLET PAVING	29						
☐ M-601-20	WINGWALLS FOR PIPE OR BOX CULVERTS	30						
☒ M-603-1	METAL AND PLASTIC CULVERT PIPE	(2 SHEETS) 31						
☒ M-603-2	REINFORCED CONCRETE PIPE	33						
☐ M-603-3	PRECAST CONCRETE BOX CULVERT	34						
☒ M-603-10	CONCRETE AND METAL END SECTIONS	(2 SHEETS) 35						
☒ M-604-10	INLET, TYPE C	37						
☒ M-604-11	INLET, TYPE D	38						
☐ M-604-12	CURB INLET, TYPE R	(2 SHEETS) 39						
☐ M-604-13	CONCRETE INLET, TYPE 13	41						
☐ M-604-20	MANHOLES	(3 SHEETS) 42						
☒ M-605-1	SUBSURFACE DRAINS	45						
☒ M-606-1	GUARDRAIL, TYPE 3, W-BEAM	(12 SHEETS) 46						
☒ M-606-12	GUARDRAIL, TYPE 4, CONCRETE BARRIER	(16 SHEETS) 58						

THE STANDARD PLAN SHEETS INDICATED HEREON BY A MARKED BOX ARE TO BE USED TO CONSTRUCT THIS PROJECT.

COLORADO
DEPARTMENT OF TRANSPORTATION
STANDARD PLANS LIST
M & S STANDARDS NOVEMBER 1992

PROJECT NO.		SHEET NO.		SHEET TOTALS	
STA 0471-020		3			

REGION		ADDITIONAL FIELD		SECTION	

NO. OF LANE		ADDITIONAL FIELD		SECTION	

GENERAL NOTES:

FOR PRELIMINARY PLAN QUANTITIES OF PAVEMENT MATERIALS, THE FOLLOWING RATES OF APPLICATION WERE USED:

TACK COAT DILUTED EMUL. ASPH. (SLOW SETTING) ● 0.1 GALS./SQ. YD. (DILUTED)
BITUMINOUS PAVEMENT (GRADING C) ● 110 LBS. PER SQ. YD./INCH
DILUTED EMULSIFIED ASPHALT FOR TACK COAT SHALL CONSIST OF 1 PART EMULSIFIED ASPHALT AND ONE PART WATER.

WATER SHALL BE USED AS A DUST PALLIATIVE WHERE REQUIRED. LOCATIONS SHALL BE AS ORDERED. WATER FOR DUST PALLIATIVE SHALL BE PAID FOR SEPERATELY. THE COST OF WATER FOR COMPACTION SHALL BE INCLUDED IN THE WORK.

THE CONTRACTOR SHALL USE CARE WHEN REWORKING THE SUBGRADE IN HIGH MOISTURE CONTENT CONDITIONS NECESSARY FOR RECONDITIONING WHICH MAY CAUSE DIFFICULTY FOR EARTHWORK EQUIPMENT.

THE FOLLOWING SHALL BE FURNISHED WITH EACH BITUMINOUS PAVER:

1. A SKI TYPE DEVICE AT LEAST 30 FEET IN LENGTH.
2. A SHORT SKI OR SHOE.
3. A PAVING LEVELER AT LEAST 60 FEET IN LENGTH OR A LONG STRING LINE.

ANY LAYER OF BITUMINOUS PAVEMENT THAT IS TO HAVE A SUCCEEDING LAYER PLACED THEREON SHALL BE COMPLETED FULL WIDTH BEFORE SUCCEEDING LAYER IS PLACED.

DEPTH OF MOISTURE-DENSITY CONTROL FOR THIS PROJECT SHALL BE AS FOLLOWS:

FULL DEPTH OF EMBANKMENTS.

BASES OF CUTS AND FILLS - PER RECONDITIONING DETAIL AND SPECIAL PROVISIONS

EXCAVATION REQUIRED FOR COMPACTION OF BASES OF CUTS AND FILLS WILL BE CONSIDERED AS SUBSIDIARY TO RECONDITIONING. IT IS ESTIMATED THAT 122,502 SQ. YDS. OF RECONDITIONING WILL BE REQUIRED FOR THIS PROJECT.

TYPE OF COMPACTION FOR THIS PROJECT WILL BE AASHTO T 99. COMPACTION SHALL BE AT A MOISTURE CONTENT BETWEEN OPTIMUM AND 2% ABOVE OPTIMUM.

CONCRETE PIPE JOINT FASTENERS AS SHOWN ON M STANDARD ARE REQUIRED ON:

ALL CONCRETE CULVERT INSTALLATIONS.

THE MINIMUM THICKNESS OF TOPSOIL SHALL BE 6 INCHES. IT IS ESTIMATED THAT 16,133 CU. YDS. WILL BE REQUIRED, BASED ON AVERAGE THICKNESS, AND WILL BE OBTAINED FROM THE PROJECT SITE. THE TOP 2" - 6" OF EXISTING SOIL SHALL BE STOCKPILED FOR USE AS TOPSOIL. THE SOIL TO BE PLACED AS TOPSOIL SHALL BE FREE OF REFUSE, STUMPS, ROOTS, BRUSH, WEEDS, HARD CLODS, TOXIC SUBSTANCES, OR OTHER MATERIAL WHICH WOULD BE DETRIMENTAL TO ITS USE ON THE PROJECT. IT SHALL HAVE A MINIMUM P.I. OF 5 BUT SHALL NOT BE SUCH HEAVY CLAY AS TO PRECLUDE PLACEMENT WITH A SHOULDER MACHINE. TOPSOIL WILL NOT BE PAID FOR SEPARATELY BUT SHALL BE INCLUDED IN THE COST OF EMBANKMENT MATERIAL (C.I.P.).

IT IS ESTIMATED THAT 50 DELINEATORS WILL BE REMOVED ON THIS PROJECT AND WILL BE PAID FOR AS "REMOVAL OF DELINEATOR".

IT IS ESTIMATED THAT 56,140 SQ. YDS. OF GEOTEXTILE (PAVING) WILL BE REQUIRED FOR THE OVERLAY PORTION OF THE SH47 MAINLINE.

IT IS ESTIMATED THAT 40 LIN. FT. OF RESET FENCE WILL BE REQUIRED AT THE OUTLETS OF THE CULVERTS LOCATED AT STA. 71+45.41 AND STA. 76+15.39.

IT IS ESTIMATED THAT 220 SQ. YDS. OF DETOUR PAVEMENT WILL BE REQUIRED FOR TEMPORARY SURFACING FOR CONSTRUCTION DETOURS.

IT IS ESTIMATED THAT THE FOLLOWING WILL BE REQUIRED TO CONSTRUCT THE 3 DETOURS. THIS WILL NOT BE PAID FOR SEPARATELY BUT SHALL BE PAID FOR AS ITEM 621 - DETOUR PAVEMENT, SQ. YDS.:

HOT BITUMINOUS PAVEMENT	40 TONS
EMBANKMENT MATERIAL	146 CU. YDS.
CULVERT PIPE	170 LIN. FT.

CLEARING AND GRUBBING FOR THIS PROJECT WILL NOT BE PAID FOR SEPARATELY BUT SHALL BE INCLUDED IN THE WORK.

PAVEMENT STABILIZATION DATA

WIDENING SECTION-ADDITION OF TWO LANES MAINLINE

DESIGN TRAFFIC LOADING

DESIGN PERIOD	20 YR.
18K ESAL (FLEXIBLE PAVEMENT)	2,880,000
RELIABILITY	90%
STANDARD DEVIATION (SO)	0.44

DESIGN STRUCTURAL NUMBER (SN) 5.05

STRENGTH COEFFICIENT

HOT BITUMINOUS PAVEMENT 0.44

REQUIRED PAVEMENT THICKNESS 6.84 IN.

THICKNESS USED 7.00 IN.

SOIL SUPPORT VALUES

"R" VALUE (BORROW)	61
RESILIENT MODULUS (MR) (BORROW)	18,865 PSI
"R" VALUE (SUBGRADE)	6-20

SERVICEABILITY

INITIAL SERVICEABILITY INDEX	4.5
TERMINAL SERVICEABILITY INDEX	2.5
DESIGN SERVICEABILITY LOSS (ΔPSI)	2.0

RAMPS

DESIGN TRAFFIC LOADING

DESIGN PERIOD	20 YR.
18K ESAL (FLEXIBLE PAVEMENT)	1,250,000
RELIABILITY	90%
STANDARD DEVIATION (SO)	0.44

DESIGN STRUCTURAL NUMBER (SN) 4.49

STRENGTH COEFFICIENT

HOT BITUMINOUS PAVEMENT 0.44

REQUIRED PAVEMENT THICKNESS 5.57 IN.

THICKNESS USED 5.00 IN.

SOIL SUPPORT VALUES

"R" VALUE (BORROW)	61
RESILIENT MODULUS (MR) (BORROW)	18,865 PSI

SERVICEABILITY

INITIAL SERVICEABILITY INDEX	4.5
TERMINAL SERVICEABILITY INDEX	2.5
DESIGN SERVICEABILITY LOSS (ΔPSI)	2.0

OVERLAY SECTION-EXISTING TWO LANES MAINLINE-WEST OF BACULITE MESA ROAD

DESIGN TRAFFIC LOADING

DESIGN PERIOD	10 YR.
18K ESAL (FLEXIBLE PAVEMENT)	1,275,000
RELIABILITY	90%
STANDARD DEVIATION (SO)	0.44

DESIGN STRUCTURAL NUMBER (SN2) 4.50

EXISTING STRUCTURAL NUMBER (SN1) 2.84

REQUIRED STRUCTURAL NUMBER (SN) 1.66

STRENGTH COEFFICIENTS

EXISTING HOT BITUMINOUS PAVEMENT 0.26

EXISTING BASE COURSE 0.12

EXISTING SUBBASE COURSE 0.11

NEW HOT BITUMINOUS PAVEMENT 0.44

SOIL SUPPORT VALUES

"R" VALUE (SUBGRADE)	10
RESILIENT MODULUS (MR) (SUBGRADE)	3,560 PSI


SERVICEABILITY LOSS

2.0


REQUIRED PAVEMENT THICKNESS 3.77 IN.

THICKNESS USED 4.0 IN.


DESIGNED BY		REVIEWED BY	DATE	PROJECT NO.	SHEET NO.	SHEET TOTAL
				STA 0471-020	4	
REVISIONS						

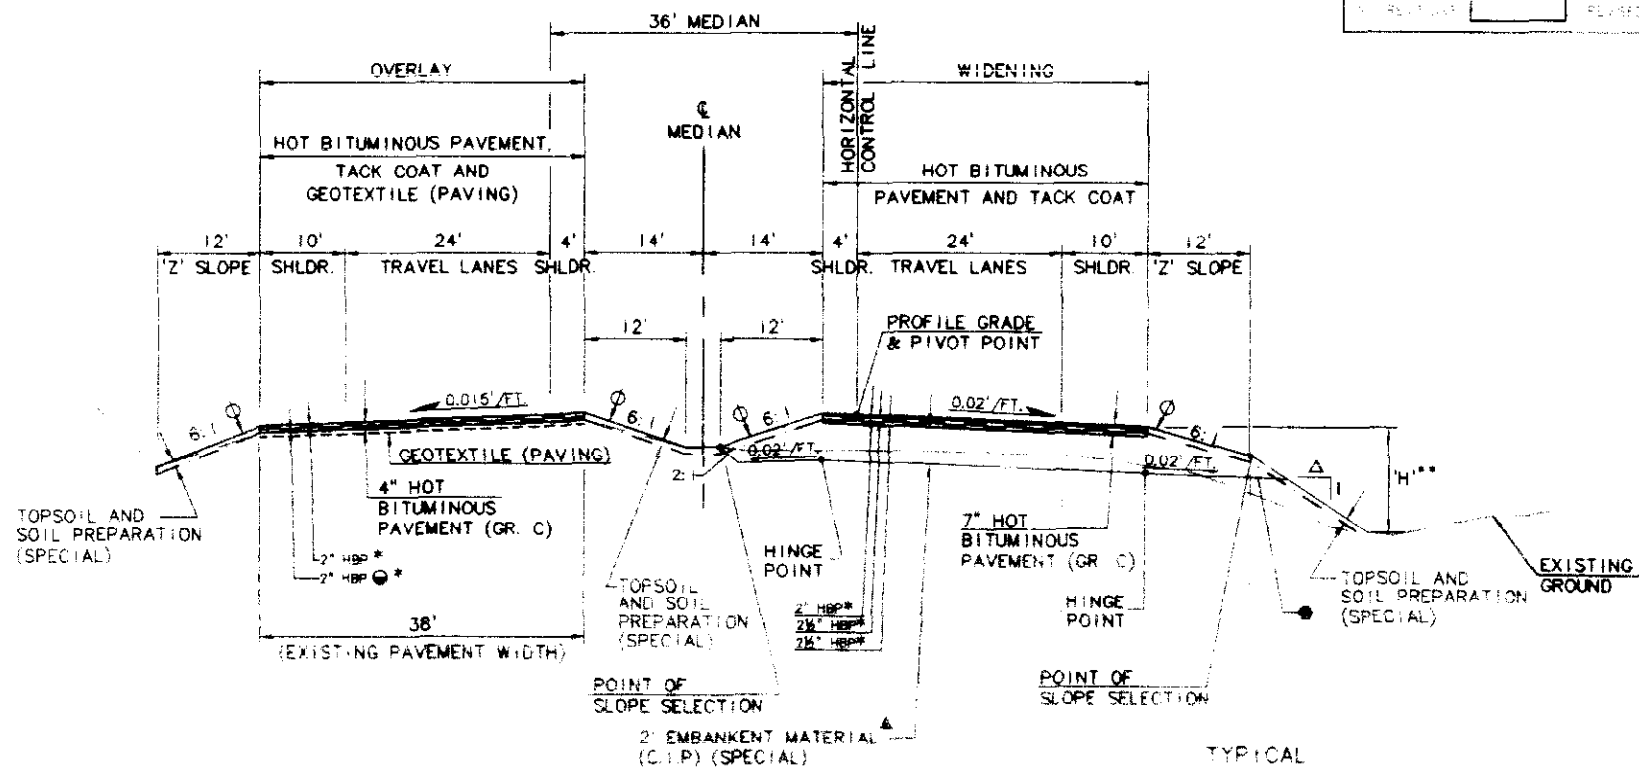


STATE HIGHWAY 47 (4 LANE)
STA. 70+50 TO STA. 175+07.38

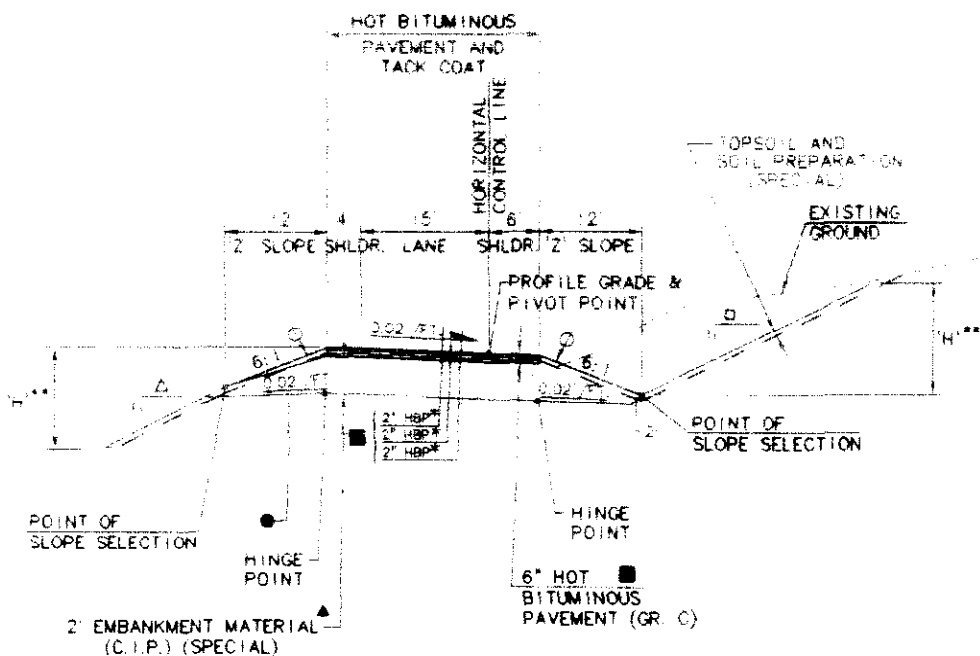

JERRY MURPHY - RAMP B
TROY AVE. - RAMPS A & B

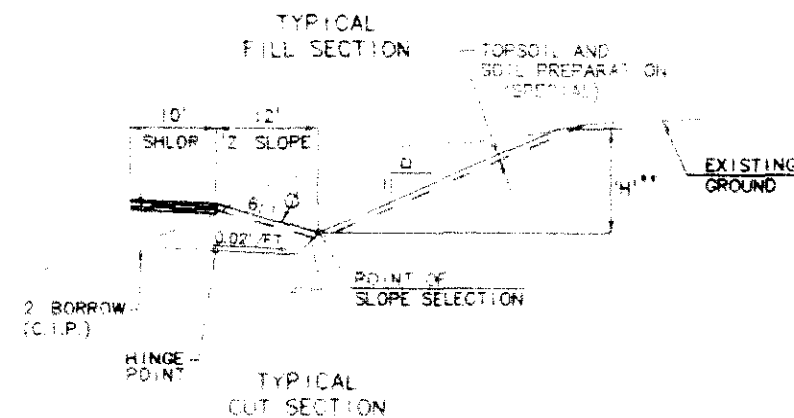

TYPICAL CUT SECTION

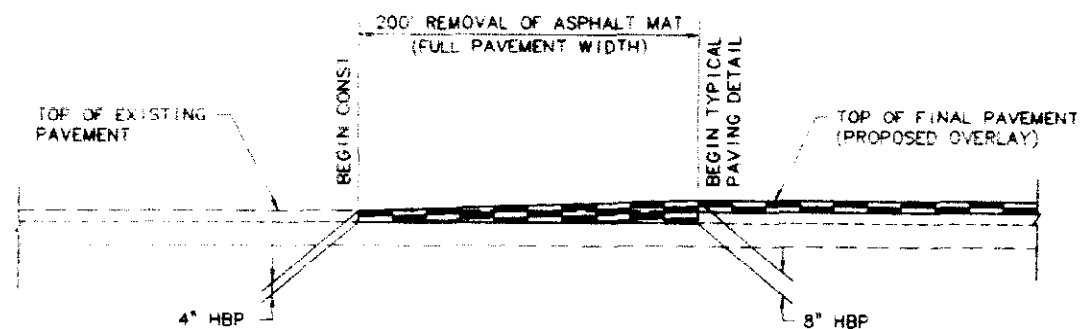

HBP TRANSITION DETAIL (PROFILE)
(TYPICAL BEGIN AND END OVERLAY CONSTRUCTION)

SLOPE TABLE

H**	CUT	FILL
< 5'	6:1	6:1
≥ 5'-10'	4:1	4:1
> 10'	3:1	3:1

2.5:1 STA. 111+00 TO STA. 116+00, RT.
AND STA. 124+00 TO STA. 128+00, RT.

* APPROXIMATE THICKNESS

2\" HBP OVERLAY OVER 1\" (AVG.) HBP
LEVELING COURSE. GEOTEXTILE TO BE
PLACED OVER LEVELING COURSE.

EMBANKMENT MATERIAL (C.I.P.) (SPECIAL)
SHALL HAVE A MINIMUM $M_R = 18865$ psi
(R61). PLACEMENT OF HBP FOR ALL
ROADWAYS SHALL BE ON TWO FEET OF
EMBANKMENT MATERIAL (C.I.P.) (SPECIAL)

MATERIAL GENERATED ON SITE
MAY BE USED BELOW THIS LINE
(ESTABLISHED SUBGRADE LINE)


TOPSOIL SHALL BE PLACED TO THIS
LINE AFTER COMPLETION OF GRADING
OPERATIONS AND PRIOR TO TREATMENT
WITH SOIL PREPARATION (SPECIAL),
SEEDING AND MULCHING.

HBP FOR TROY AVE. RAMP A (STA. 708+50
TO STA. 711+50) SHALL BE 4\" HOT
BITUMINOUS PAVEMENT (GRADING C)
AND SHALL BE CONSTRUCTED IN TWO
2\" INCH LIFTS.

NOTE: CROSS SECTIONS SHOW FINISH GRADING
OF EARTHWORK. CONSTRUCTION OF \"2\" SLOPE
AREAS TO FINISH GRADE SHALL BE DONE WITH
TOPSOIL OVER EMBANKMENT MATERIAL (C.I.P.)
(SPECIAL).

AS CONSTRUCTED	FED. ROAD DIST. NO.	DIVISION	PROJECT NO.	SHEET NO.	SHEET TOTALS
NO. H.P. RAMP 12' 12' 12'	VI	COLORADO	STA 0471-020	5	


REVISIONS

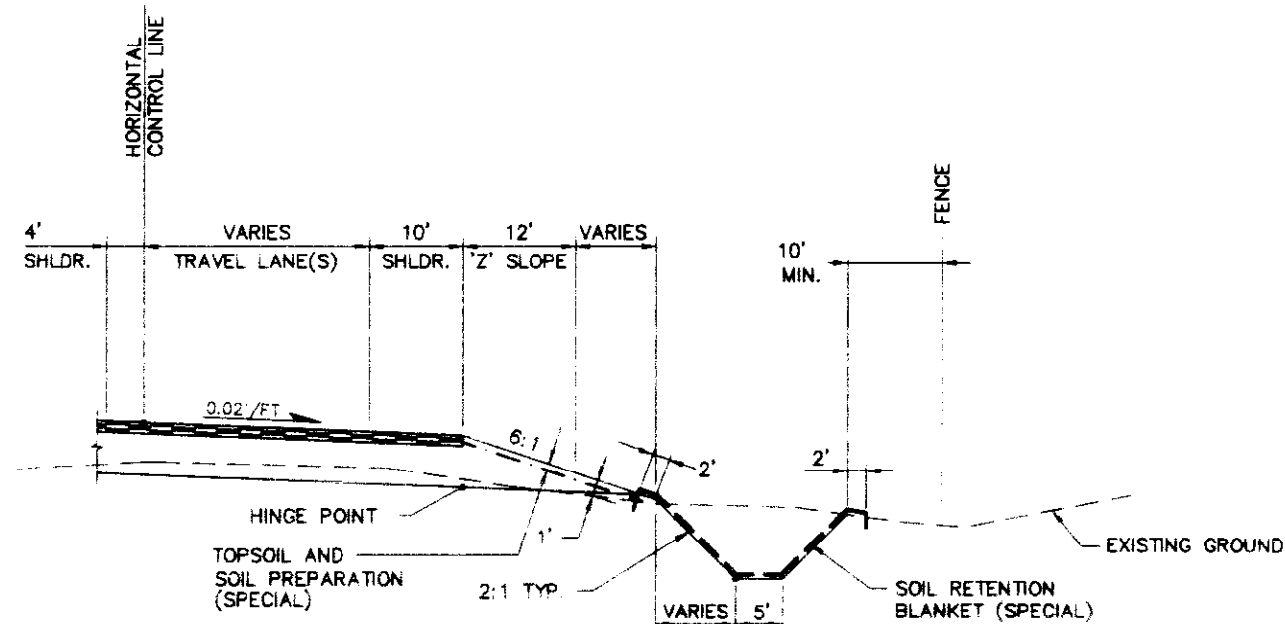

STATE HIGHWAY 47 (PROPOSED DITCH)


STA. 76+15.39, RT. TO STA. 93+00, RT.

NOTE: THE LIMITS OF THE SOIL RETENTION BLANKET SHALL EXTEND 2 FEET BEYOND THE CATCH POINT OF THE DITCH AND SHALL BE EMBEDDED TO A DEPTH OF 1 FOOT.

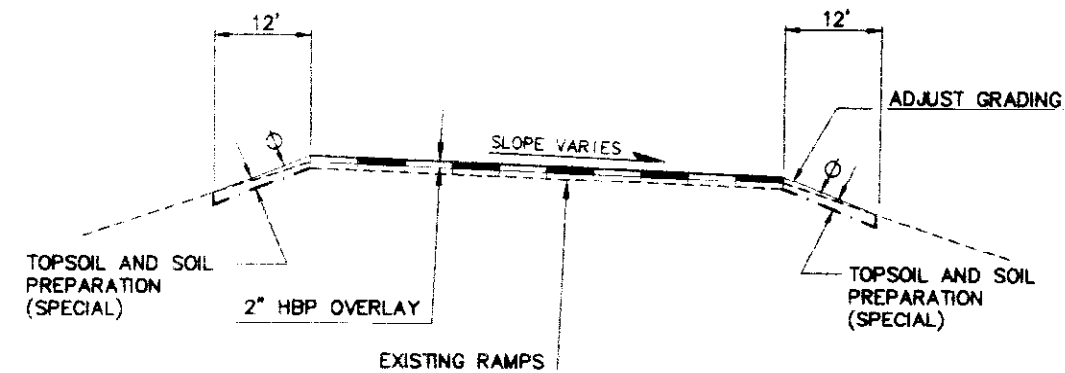


RAMP OVERLAYS
 JERRY MURPHY - RAMP B & D (EXISTING)
 TROY AVE. - RAMPS B, C, & D (EXISTING)

TOPSOIL SHALL BE PLACED TO THIS LINE AFTER COMPLETION OF PAVING OPERATIONS

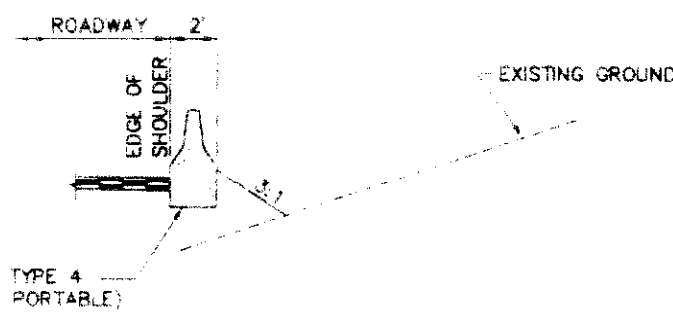


GUARD RAIL TYPE 4 DETAIL

STA. 118+50 RT. TO STA. 123+50 RT.

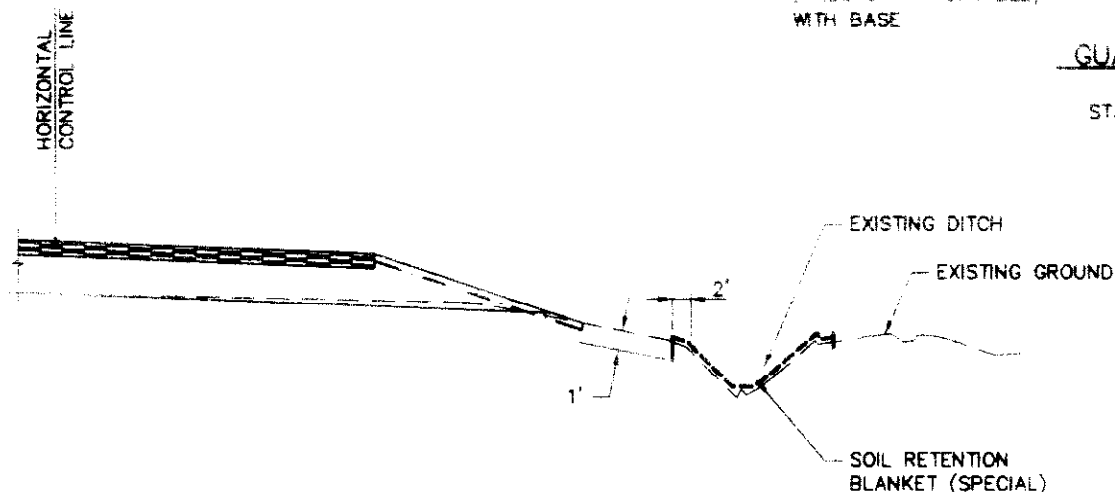

STATE HIGHWAY 47 (EXISTING DITCH)

STA. 93+00.00, RT. TO STA. 96+00.00, RT.

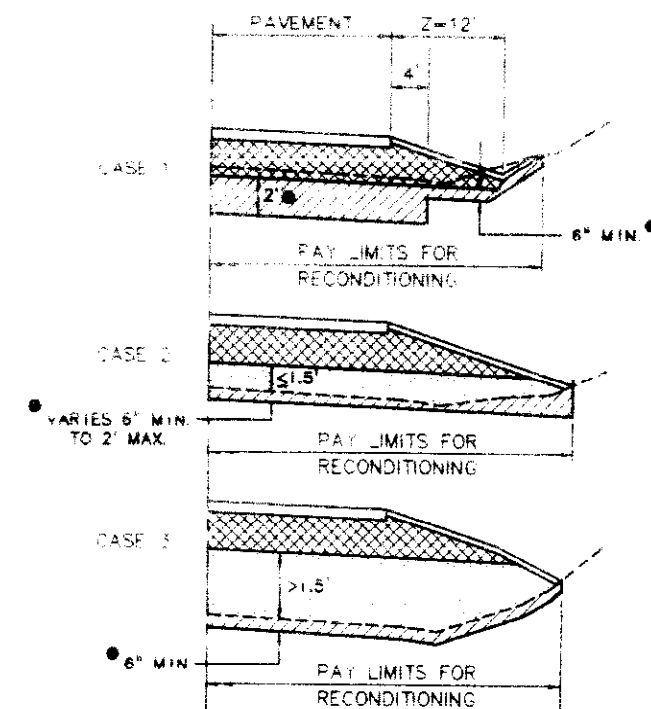

SUBGRADE RECONDITIONING DETAIL

DEPTH OF RECONDITIONING

LEGEND

EMBANKMENT MATERIAL (CIP) (SPECIAL)	EMBANKMENT MATERIAL (CIP)	RECONDITIONING
-------------------------------------	---------------------------	----------------

SUMMARY OF APPROXIMATE QUANTITIES

AS CONSTRUCTED			C D O T	FED. ROAD REGION	DIVISION	PROJ. NO.	SHEET NO.
NO REVISIONS	REVISED	VOID		VIII	COLO.	STA 0471-020	6

INDEX			CONTRACT ITEM NO.	CONTRACT ITEM	UNIT	ROADWAY		STRUCTURE NO. K-18-GA		STRUCTURE NO. K-18-EX		PROJECT TOTALS	
						PLAN	AS CONST.	PLAN	AS CONST.	PLAN	AS CONST.	PLAN	AS CONST.
			202	REMOVAL OF STRUCTURE	EACH	2						2	
			202	REMOVAL OF SLOPE AND DITCH PAVING	SY	2						2	
			202	REMOVAL OF PIPE	LF	960						960	
			202	REMOVAL OF DELINEATOR	EACH	50						50	
			202	REMOVAL OF ASPHALT MAT	SY	14,191						14,191	
			202	REMOVAL OF ASPHALT MAT (PLANING)	SY					780		780	
			202	REMOVAL OF PAVEMENT MARKING	SF	3,000						3,000	
			202	REMOVAL OF BRIDGE RAILING	LF					414		414	
			202	REMOVAL OF GROUND SIGN	EACH	12						12	
			202	REMOVAL OF GUARDRAIL TYPE 3	LF	381						381	
			202	EMBANKMENT MATERIAL (COMPLETE IN PLACE)	CY	60,240						60,240	
			203	EMBANKMENT MATERIAL (COMPLETE IN PLACE) (SPECIAL)	CY	59,486						59,486	
			203	DOZING (LANDSCAPING)	HOUR	20						20	
			206	STRUCTURE EXCAVATION	CY	2,693		38		216		2,647	
			206	STRUCTURE BACKFILL (FLOW-FILL)	CY			382		176		558	
			206	STRUCTURE BACKFILL (CLASS 1)	CY	323		474				797	
			206	STRUCTURE BACKFILL (CLASS 2)	CY	989						989	
			206	FILTER MATERIAL (CLASS 1)	CY	68						68	
			207	WETLAND TOPSOIL	CY	180						180	
			208	EROSION BALES	EACH	140						140	
			208	SILT FENCE	LF	50						50	
			209	WATER	MGAL	500						500	
			210	RESET LIGHT STANDARD	EACH	5						5	
			210	RESET LUMINAIRE	EACH	5						5	
			210	RESET GROUND SIGN	EACH	9						9	
			210	RESET FLASHING BEACON	EACH	1						1	
			210	RESET FENCE	LF	40						40	
			212	SEEDING (NATIVE)	ACRE	20						20	
			212	SOIL PREPARATION (SPECIAL)	ACRE	20						20	
			213	MULCHING	ACRE	20						20	
			213	MULCH TACKIFIER	LB	2,500						2,500	
			216	SOIL RETENTION BLANKET (SPECIAL)	SY	9,310						9,310	
			306	RECONDITIONING	SY	122,502						122,502	

VIEW NAME(SHEET) DRAWING NAME: D:\DATA\718-CADD\RD0471.DWG DATE: 11-07-1995 TIME: 14:03:31

SUMMARY OF APPROXIMATE QUANTITIES

AS CONSTRUCTED			C	FED. ROAD REGION	DIVISION	PROJ. NO.	SHEET NO.
NO REVISIONS REVISED VOID			D	VIII	COLO.	STA 0471-020	7
			O				
			T				

INDEX			CONTRACT ITEM NO.	CONTRACT ITEM	UNIT	ROADWAY		STRUCTURE NO. K-18-GA		STRUCTURE NO. K-18-EX		PROJECT TOTALS	
BOOK	PAGE	SHEET				PLAN	AS CONST.	PLAN	AS CONST.	PLAN	AS CONST.	PLAN	AS CONST.
			403	HOT BITUMINOUS PAVEMENT (PATCHING) (ASPHALT)	TDN	115						115	
			403	HOT BITUMINOUS PAVEMENT (GRADING C) (ASPHALT) (C 100)	TDN	38,517		90		14		38,621	
			411	EMULSIFIED ASPHALT (SLOW-SETTING)	GAL	5,660						5,660	
			420	GEOTEXTILE (EROSION CONTROL) (CLASS A)	SY	699						699	
			420	GEOTEXTILE (DRAINAGE) (CLASS B)	SY	30						30	
			420	GEOTEXTILE (PAVING)	SY	56,140						56,140	
			502	STEEL PILING (HP 12X74)	LF			525				525	
			506	RIPRAP (12 INCH)	CY	224						224	
			506	RIPRAP (18 INCH)	CY	123						123	
			506	RIPRAP (24 INCH)	CY	469						469	
			507	CONCRETE SLOPE AND DITCH PAVING (REINFORCED)	CY	2		90				92	
			507	BITUMINOUS SLOPE AND DITCH PAVING (ASPHALT)	TDN	12						12	
			513	BRIDGE DRAIN (SPECIAL)	EACH			1				1	
			515	WATERPROOFING (MEMBRANE)	CY			920		192		955	
			516	BRIDGE EXPANSION DEVICE (0-2 INCH)	LF			76		84		160	
			601	CONCRETE CLASS A (WALL)	CY	11						11	
			601	CONCRETE CLASS B (MISCELLANEOUS)	CY	28						28	
			601	CONCRETE CLASS B (BRIDGE)	CY			41				41	
			601	CONCRETE CLASS D (BRIDGE)	CY			54		64		118	
			601	CONCRETE CLASS S (BRIDGE)	CY			521				521	
			602	REINFORCING STEEL	LB	2,626		94,005		9,675		96,306	
			602	REINFORCING STEEL (EPOXY COATED)	LB			42,210				42,210	
			603	24 INCH REINFORCED CONCRETE PIPE	LF	205						205	
			603	36 INCH REINFORCED CONCRETE PIPE	LF	663						663	
			603	42 INCH REINFORCED CONCRETE PIPE	LF	167						167	
			603	60X30 INCH REINFORCED CONCRETE PIPE ELLIPTICAL	LF	168						168	
			603	24 INCH REINFORCED CONCRETE END SECTION	EACH	2						2	
			603	36 INCH REINFORCED CONCRETE END SECTION	EACH	1						1	
			603	60X30 INCH REINFORCED CONCRETE END SECTION ELLIPTICAL	EACH	1						1	
			603	24 INCH CORRUGATED STEEL PIPE	LF	29						29	
			603	24 INCH STEEL END SECTION	EACH	3						3	
			604	INLET TYPE C (5 FOOT)	EACH	2						2	

VIEW NAME SHEET: DRAWING NAME: C:\DATA\718\CA001\WASAP DATE: 11-01-1995 TIME: 14:34:47

SUMMARY OF APPROXIMATE QUANTITIES

AS CONSTRUCTED			C D O T	FED. ROAD REGION	DIVISION	PROJ. NO.	SHEET NO.
NO REVISIONS	REVISED	VOID		VIII	COLO.	STA 0471-020	8

INDEX			CONTRACT ITEM NO.	CONTRACT ITEM	UNIT	ROADWAY		STRUCTURE NO. K-18-GA		STRUCTURE NO. K-18-EX		PROJECT TOTALS	
						PLAN	AS CONST.	PLAN	AS CONST.	PLAN	AS CONST.	PLAN	AS CONST.
			604	INLET TYPE D (10 FOOT)	EACH	2						2	
			605	6 INCH PERFORATED PIPE UNDERDRAIN	LF	1,520						1,520	
			605	SUBSURFACE DRAIN OUTLET	LF	31						31	
			606	GUARDRAIL TYPE 3 (6-3 POST SPACING)	LF	1,287.5						1,287.5	
			606	GUARDRAIL TYPE 4 (PRECAST-PORTABLE)	LF	500						500	
			606	END ANCHORAGE TYPE 3D	EACH	2						2	
			606	END ANCHORAGE TYPE 3F	EACH	4						4	
			606	END ANCHORAGE TYPE 3G	EACH	5						5	
			606	END ANCHORAGE TYPE 3H	EACH	4						4	
			606	END ANCHORAGE (SLOTTED RAIL TERMINAL)	EACH	3						3	
			606	BRIDGE RAIL TYPE 10 SPECIAL	LF			423				423	
			606	BRIDGE RAIL TYPE 10R SPECIAL	LF					414		414	
			612	DELINEATOR (FLEXIBLE) (TYPE 1)	EACH	199						199	
			612	DELINEATOR (FLEXIBLE) (TYPE 11)	EACH	100						100	
			612	DELINEATOR (FLEXIBLE) (TYPE 111)	EACH	8						8	
			613	3/4 INCH ELECTRICAL CONDUIT	LF			55				55	
			613	2 INCH ELECTRICAL CONDUIT	LF			862				862	
			613	2 INCH ELECTRICAL CONDUIT (JACKETED)	LF	265						265	
			613	2 INCH ELECTRICAL CONDUIT (PLASTIC)	LF	5,340						5,340	
			613	WIRING	LS	1						1	
			613	LIGHT STANDARD METAL (40 FOOT)	EACH	11						11	
			613	CONCRETE FOUNDATION PAD	EACH	16						16	
			613	LIGHTING SYSTEM	EACH			1				1	
			613	LUMINAIRE HIGH PRESSURE SODIUM (100 WATT)	EACH	2						2	
			613	LUMINAIRE HIGH PRESSURE SODIUM (400 WATT)	EACH	11						11	
			614	SIGN PANEL (CLASS I)	SF	9						9	
			614	SIGN PANEL (CLASS II)	SF	123						123	
			614	SIGN PANEL (CLASS III)	SF	392						392	
			614	TIMBER SIGN POST 6X6 INCH	LF	220						220	
			614	STEEL SIGN POST (U-2)	LF	84						84	
			614	STEEL SIGN POST (W 6X12)	LF	60						60	
			614	STEEL SIGN POST (W 6X15)	LF	56						56	

VIEW NAME SHEET: DRAWING NAME (FUNDATING/ENCLOSURE/ROADWAY) DATE: 11 DEC 1995 TIME: 14:05:00

SUMMARY OF APPROXIMATE QUANTITIES

AS CONSTRUCTED

NO REVISIONS REVISED VOID

C
D
O
T

FED. ROAD
REGION

DIVISION

PROJ. NO.

SHEET
NO.

VIII

COLO.

STA 0471-020

9

INDEX			CONTRACT ITEM NO.	CONTRACT ITEM	UNIT	ROADWAY		STRUCTURE NO. K-18-GA		STRUCTURE NO. K-18-EX		PROJECT TOTALS	
BOOK	PAGE	SHEET				PLAN	AS CONST.	PLAN	AS CONST.	PLAN	AS CONST.	PLAN	AS CONST.
			614	STEEL SIGN POST (W 8X18)	LF	34						34	
			614	CONCRETE FOOTING (TYPE 1)	EACH	4						4	
			614	CONCRETE FOOTING (TYPE 2)	EACH	4						4	
			614	CONCRETE FOOTING (TYPE 3)	EACH	2						2	
			615	EMBANKMENT PROTECTOR TYPE 5	EACH	1						1	
			615	LOG DAM	EACH	3						3	
			618	PRESTRESSING STEEL WIRE OR STRAND	MMFT			2,090				2,090	
			619	4 INCH GALVANIZED PIPE	LF	225						225	
			619	6 INCH GALVANIZED PIPE	LF	225						225	
			620	FIELD OFFICE (CLASS 2)	EACH	1						1	
			620	FIELD LABORATORY (CLASS 2)	EACH	1						1	
			620	SANITARY FACILITY	EACH	2						2	
			621	DETOUR PAVEMENT	SY	220						220	
			625	CONSTRUCTION SURVEYING	L.S.	0.8		0.15		0.05		1	
			626	MOBILIZATION	L.S.	0.8		0.15		0.05		1	
			627	PAVEMENT MARKING PAINT	GAL	220						220	
			627	THERMOPLASTIC PAVEMENT MARKING	SF	19,620						19,620	
			627	PREFORMED PLASTIC PAVEMENT MARKING (60 MILS)	SF	6,715						6,715	
			627	PREFORMED PLASTIC PAVEMENT MARKING (60 MIL) (WALK-STOP LINE)	SF	180						180	
			627	PREFORMED THERMOPLASTIC PAVEMENT MARKING (WORD-SYMBOL)	SF	126						126	
			629	SURVEY MONUMENT (TYPE 1)	EACH	9						9	
			630	FLAGGING	HOUR	4,000						4,000	
			630	TRAFFIC CONTROL SUPERVISOR	DAY	170						170	
			630	TRAFFIC CONTROL INSPECTION	DAY	100						100	
			630	BARRICADE (TYPE 3 H-B) (TEMPORARY)	EACH	8						8	
			630	CONSTRUCTION TRAFFIC SIGN (PANEL SIZE A)	EACH	29						29	
			630	CONSTRUCTION TRAFFIC SIGN (PANEL SIZE B)	EACH	60						60	
			630	ADVANCE WARNING FLASHING OR SEQUENCING ARROW PANEL (C TYPE)	EACH	2						2	
			630	DRUM CHANNELIZING DEVICE	EACH	300						300	
			630	CONCRETE BARRIER (TEMPORARY)	LF	1,200						1,200	
			630	TRAFFIC CONE	EACH	200						200	

VIEW NAME SHEET 4
DRAWING NAME: CONSTRUCTION QUANTITIES
DATE: 11-03-1995
FILE: 1427-05

AS CONSTRUCTED	C D O T	FED. ROAD REGION	DIVISION	PROJ. NO.	SHEET NO.
NO REVISIONS REVISED VOID		VIII	COLO.	STA 0471-020	10

[illegible]

50137MS-1: MON AM 31/1/

AS CONSTRUCTED

NO REVISIONSREVISEDVOID

FED. ROAD REGION

DIVISION

PROJECT NO.

SHEET NO.

SHEET TOTALS

VII

COLORADO

STA 0471-020

11

STRUCTURE QUANTITIES

INDEX			LOCATION	REMOVAL OF PIPE	REMOVAL OF STRUCTURE	CLEAN CULVERT	EMBANKMENT MATERIAL		STRUCTURE EXCAVATION	STRUCTURE BACKFILL		HOT BITUMINOUS PAVEMENT (PATCHING) (ASPHALT)	CONCRETE CLASS A	INLET		REINFORCED CONCRETE PIPE					CORRUGATED STEEL PIPE	7" OVER CULV.	END SECTION					PERFORATED PIPE UNDERDRAIN	CONCRETE SLOPE AND DITCH PAV. (REIN.)	SOIL RETENTION BLANKET (SPECIAL)	RIPRAP (12 INCH)	FILTER MATERIAL CLASS A	GEOTEXTILE (FIB. C/W) (CLASS A)	GEOTEXTILE (FIB. C/W) (CLASS B)	MISCELLANEOUS																																																																																																																																																																																																																																																																																																																																																																																																																																																																																																																																																																																																																																																																																																																																																																																																																																																																																																																																																																																																																																																																																																																																																																																																																																																														
CUBIC YARD							CUBIC YARD	CUBIC YARD		TON	(WALL)			5'	10'	LINEAR FEET							80"x36"	24"	FT.	EACH																																																																																																																																																																																																																																																																																																																																																																																																																																																																																																																																																																																																																																																																																																																																																																																																																																																																																																																																																																																																																																																																																																																																																																																																																																																																							
INFORMATION ONLY	EMB	C.I.P.														ROP	RCHP	CSP	LINEAR FEET	ROP						RCHP	CSP									LINEAR FEET																																																																																																																																																																																																																																																																																																																																																																																																																																																																																																																																																																																																																																																																																																																																																																																																																																																																																																																																																																																																																																																																																																																																																																																																																																																													
																																					EXCAV	DITCH	CL 1	CL 2	TYPE C	TYPE D	24"	36"	42"	24"																																																																																																																																																																																																																																																																																																																																																																																																																																																																																																																																																																																																																																																																																																																																																																																																																																																																																																																																																																																																																																																																																																																																																																																																																																																			
BOOK	PAGE	SHEET	LF.	EACH	EACH																																																																																																																																																																																																																																																																																																																																																																																																																																																																																																																																																																																																																																																																																																																																																																																																																																																																																																																																																																																																																																																																																																																																																																																																																																																																																												

● : PAYMENT FOR REMOVAL OF FLARED END SECTION WILL NOT BE MADE SEPARATELY BUT SHALL BE INCLUDED IN THE COST OF THE WORK.

▲ : FOR INFORMATION ONLY.

▲ : CARRIED TO EARTHWORK SUMMARY.

□ : FOR ADDITIONAL QUANTITIES, SEE BRIDGE SUMMARY.

* : CARRIED TO SURFACING PLAN.

** : FROM WETLAND DROP STRUCTURE SUMMARY

REVISIONS		AS CONSTRUCTED		PROJECT NO.	SHEET NO.	SHEET TOTALS
NO REVISIONS	REVISED	ADD		STA 0471-020	12	

TABULATION OF GUARDRAIL

LOCATION	SIDE	REMOVAL OF GUARD RAIL TYPE 3		GUARD RAIL TYPE 3 6'-3" POST SPACING		GUARD RAIL TYPE 4 (PRECAST- PORTABLE)		END ANCHORAGE				
		LIN. FT.		LIN. FT.		LIN. FT.		SRT	TYPE 3D	TYPE 3F	TYPE 3G	TYPE 3H
		PLAN	AS CONST.	PLAN	AS CONST.	PLAN	AS CONST.	EACH	EACH	EACH	EACH	EACH
SH47 MAINLINE												
STA. 117+31.25 ~ STA. 117+68.75	RT.							1				
STA. 117+68.75 ~ STA. 118+31.25	RT.			62.5								
STA. 118+31.25 ~ STA. 118+50.00	RT.										1	
STA. 118+50.00 ~ STA. 123+50.00	RT.					500						
STA. 118+89.60 ~ STA. 119+14.60	LT.			25*						1		
STA. 119+14.60 ~ STA. 119+89.60	LT.			150								
STA. 119+33.00 ~ STA. 121+20.00	LT.	187										
STA. 119+89.60 ~ STA. 120+52.10	LT.			125								
STA. 120+52.10 ~ STA. 121+27.10	LT.			150								
STA. 121+27.10 ~ STA. 121+52.10	LT.			25*						1		
STA. 147+53.98 ~ STA. 147+78.98	LT.			25*								
STA. 147+78.98 ~ STA. 148+41.48	LT.			125								
STA. 148+33.66 ~ STA. 148+41.48	RT.			37.5^								
STA. 148+41.48 ~ STA. 149+16.48	LT.			150								
STA. 148+41.48 ~ STA. 149+16.48	RT.			75								
STA. 148+88.48	LT.								1			
STA. 148+88.48 ~ STA. 149+16.48	LT.			50								
STA. 148+89.00 ~ STA. 149+37.00	LT. & RT.	98										
STA. 149+16.48 ~ STA. 149+36.96	LT.											2
STA. 149+16.48 ~ STA. 149+36.96	RT.										1	
STA. 151+43.00 ~ STA. 151+92.00	LT. & RT.	98										
STA. 151+43.54 ~ STA. 151+64.02	LT.										2	1
STA. 151+43.54 ~ STA. 151+64.02	RT.											1
STA. 151+64.02 ~ STA. 152+39.02	LT.			75								
STA. 151+64.02 ~ STA. 152+39.02	LT.			150								
STA. 151+64.02 ~ STA. 152+14.02	RT.			50								
STA. 152+14.02	RT.								1			
STA. 152+39.02 ~ STA. 152+78.52	LT.			37.5^				1				
STA. 152+39.02 ~ STA. 153+01.52	LT.			125								
STA. 153+01.52 ~ STA. 153+26.52	LT.			25*						1		
PROJECT TOTAL		381		1287.5		500		3	2	4	5	4

CONSTRUCTION OF GUARDRAIL POSTS BETWEEN STA. 117+ AND STA. 121+50 MAY ENCOUNTER CLAYSTONE BEDROCK. COST OF CONSTRUCTING POSTS IN CLAYSTONE SHALL BE INCLUDED IN THE WORK. STEEL POSTS SHALL BE USED FOR ALL TYPE 3 GUARDRAIL.

- * FOR INFORMATION ONLY - PAID FOR UNDER ITEM 606 END ANCHORAGE (3F) - EACH
- * FOR INFORMATION ONLY - PAID FOR UNDER ITEM 606 END ANCHORAGE (SRT) - EACH
- ◆ GUARD RAIL TYPE 3 SHALL BE GALVANIZED.

SUMMARY OF EARTHWORK QUANTITIES

PAY ITEMS	PROJECT TOTALS CU. YD.	
	PLAN	AS CONST.
EMBANKMENT MATERIAL (COMPLETE IN PLACE) ROADWAY (COMPUTER GENERATED EARTHWORK) FROM STRUCTURE QUANTITY LIST TOTAL	59,799 441 60,240	
WETTING DUST PALLIATIVE TOTAL	500 MGAL 500 MGAL	
EMBANKMENT (COMPLETE IN PLACE) (SPECIAL)	59,488	
FOR INFORMATION ONLY		
COMPACTION (AASHTO T99) EMBANKMENT MATERIAL (C.I.P.) EMBANKMENT MATERIAL (C.I.P.) (SPECIAL) BASE OF CUTS AND FILLS (PAID AS RECONDITIONING BY SQ. YD.) FROM STRUCTURE QUANTITY LIST TOTAL	59,799 59,488 37,410 441 157,138	
ROADWAY QUANTITIES BALANCE EXCAVATION ROADWAY (COMPUTER GENERATED EARTHWORK) FROM STRUCTURE QUANTITY LIST (INCLUDES DITCH EXCAVATION) FROM WETLAND MITIGATION CONSTRUCTION ESTIMATE FOR CUT SLOPE TREATMENT BORROW (FROM CONTRACTOR'S SOURCE) TOTAL	34,040 2,316 842 2,890 26,176 66,264	
EMBANKMENT (NET) ROADWAY FROM STRUCTURE QUANTITY LIST TOTAL	59,799 441 60,240	
EMBANKMENT X FACTOR (1.10) ROADWAY FROM STRUCTURE QUANTITY LIST TOTAL	65,779 485 66,264	

EARTHWORK NOTES:

- EMBANKMENT MATERIAL (C.I.P.) (SPECIAL) SHALL HAVE A MINIMUM M_R VALUE OF 18865 psi. (R 61).
- EMBANKMENT MATERIAL (C.I.P.) DOES NOT REQUIRE A MINIMUM M_R VALUE.

TABULATION OF GALVANIZED PIPE IRRIGATION SLEEVING

LOCATION	SIDE	GALVANIZED PIPE IRRIGATION SLEEVING			
		4 INCH (LIN FT)		6 INCH (LIN FT)	
		PLAN	AS CONST.	PLAN	AS CONST.
SH47					
STA. 119+55 ~ STA. 120+75	85' LT.	120		120	
STA. 148+70	166' LT.	35		35	
STA. 152+50	163' LT.	40		40	
TROY AVE. RAMP B					
STA. 719+30	LT. & RT.	30		30	
TOTAL		225		225	

SURFACING PLAN

STATION TO STATION	SIDE	REMOVAL OF ASPHALT MAT	QUANTITY - TONS																QUANTITY - GALLONS				REMARKS
			* HOT BITUMINOUS PAVEMENT (GRADING C) (ASPHALT) (C100)																HBP (PATCHING) (HAUL & ASPHALT)		EMULSIFIED ASPHALT (SLOW SETTING)		
			OVERLAY								FULL DEPTH CONSTRUCTION												
			TRANSITION (VARIES)		BOTTOM LIFT (2")		TOP LIFT (2")		BOTTOM LIFT (2 1/2")		BOTTOM LIFT (2")		MIDDLE LIFT (2 1/2")		MIDDLE LIFT (2")		TOP LIFT (2")						
SQ. YD.	PLAN	AS CONST.	PLAN	AS CONST.	PLAN	AS CONST.	PLAN	AS CONST.	PLAN	AS CONST.	PLAN	AS CONST.	PLAN	AS CONST.	PLAN	AS CONST.	PLAN	AS CONST.	PLAN	AS CONST.			
SH 42																							
70+50 TO 72+50	LT.	967	319																	48			
72+50 TO 86+00	LT.	2950			776		776													353	● ASPH REMOVAL FROM MEDIAN		
86+00 TO 133+00	LT.				2315		2315													105			
133+00 TO 165+00	LT.	3232			1747		1747													794	● ASPH REMOVAL FROM MEDIAN		
165+00 TO 182+00	LT.				811		811													369			
182+00 TO 191+07.29	LT.				330		330													150			
191+07.29 TO 193+34.97	LT.	812	268																	41			
149+43 TO 151+36	LT.	224																36			ABUT 1 & 2 APPROACH SLAB REHAB		
70+50 TO 73+79.59	RT.	809							192				192				154			70			
73+79.59 TO 86+00	RT.	571							869				869				695			316			
86+00 TO 133+00	RT.								2705				2705				2164			984			
133+00 TO 172+38.55	RT.	2212							2646				2646				2117			962			
172+38.55 TO 182+00	RT.								558				558				447			203			
182+00 TO 191+07.29	RT.								343				343				274			125			
JERRY MURPHY RAMP B OVERLAY							95													43			
302+85 TO 306+78.78		1234								121				121		121				55			
JERRY MURPHY RAMP D OVERLAY							203													92			
TROY AVENUE RAMP A 708+47.94 TO 711+50		949								93						93				42			
TROY AVENUE RAMP B OVERLAY							303													138			
726+70 TO 727+38.76		231								21				21		21				10			
TROY AVENUE RAMP C OVERLAY							252													115			
TROY AVENUE RAMP D OVERLAY							285													130			
QUANTITIES FROM STRUCTURES																	68						
SUBTOTALS			587		5979		7117		7313		235		7313		142		6086		104		5145		
LEVELING					2990																		
IRREGULARITIES (10%)									731		24								11		515		
TOTALS			587		8969		7117		8044		259		7313		142		6086		115		5660		
PROJECT TOTALS		14191							38517										115		5660		

* NOTE PAVEMENT SMOOTHNESS CATEGORY FOR THIS PROJECT SHALL BE CATEGORY 2. FROM CONTRACTOR'S SOURCE

To establish geometric control for the construction of this project, the Department has provided the following information:

☒ Horizontal Control	Format: Plans
☒ Vertical Control	Plans
☒ Roadway Alignment	Plans
☒ Original Terrain Data	Cross Sections
☐ Other	

Specify the information format, i.e. plan sheet, computer disk, computer printout, or other.

The information marked is either contained on the plans or is available from the Engineer.

TYPE OF PROJECT

- ☒ Landscaping
- ☐ Signalization
- ☐ Safety Improvement
- ☐ Asphalt Overlay
- ☐ Concrete Overlay
- ☐ Minor Widening
- ☐ Major Reconstruction
- ☐ New Roadway Construction
- ☐ Bridge Replacement
- ☐ Bridge Widening
- ☐ New Bridge
- ☐ Other

WORK PERFORMED BY OTHERS: Utility Relocation

WORK PERFORMED BY THE CONTRACTOR'S SURVEYOR UNDER ITEM 625:

- ☒ Establish project centerline
- ☒ Verification and Maintenance of horizontal and vertical control
- ☒ Verify or determine existing grades and alignments
- ☒ Verify or determine existing topography
- ☒ Clearing and Grubbing Limits
- ☒ Retention Limits

Excavation and Embankment

- ☒ Excavation
 - ☒ Unclassified
 - ☐ Stripping
 - ☐ Muck
 - ☐ Rock
 - ☐ Borrow
 - ☐ Other
- ☒ Embankment
 - ☐ Site Grading
 - ☐ Erosion Control (Perm)
 - ☐ Other

GRADE STAKING	GRID	GRADE STAKES	SPECIAL INTERVAL
Yes		Yes	50'
Yes		Yes	50'
Yes		Yes	50'

- ☒ Landscaping
 - ☐ Topsoil
 - ☐ Seeding
 - ☐ Mulching
 - ☐ Planting
 - ☐ Other: Sprinkler Irrigation

Crossing Control

- ☐ Seeding (Temp)
- ☐ Silt Fences
- ☐ Straw Bales
- ☐ Temporary Barr
- ☐ Riprap (Temp)
- ☐ Other (Temp Diversion, Temp Slope Drain, Bush Barrier, Check Dam, Other)

Roadway Bases

- ☐ Untreated Subgrade
- ☐ Treated Subgrade
- ☐ Aggregate Base Course
- ☐ Other

Pavements

- ☐ PMBB - Plant Mix Bituminous Base
- ☐ HBP - Hot Bituminous Pavement
- ☐ Concrete
- ☐ Other

BLUE TOPS	GRID	SPECIAL INTERVAL
Yes		50'
Yes		50'

- ☒ Roadway Elements
 - ☐ Curb and Gutter
 - ☐ Drop inlets - alignment and grades
 - ☐ Retaining Walls
 - ☐ Guard Rail
 - ☐ Sidewalk
 - ☐ Other

Riprap (Perm)

Slope and Ditch Paving

Minor Structures

- ☐ Structure Excavation Limits
- ☐ Culverts
- ☐ Culverts w/ Headwalls and Wingwalls
- ☐ Concrete Box Culverts w/ Headwalls and Wingwalls
- ☐ Pipes
 - ☐ Sanitary Sewer
 - ☐ Storm Sewer
 - ☐ Water
 - ☐ Irrigation
 - ☐ Miscellaneous
- ☐ Manholes
- ☐ Inlets
- ☐ Other

Major Structures - Overhead Signs, Concrete Box Culverts, Bridges, and all other structures assigned a structure number

- ☐ Structure Excavation Limits
- ☐ Concrete Box Culverts w/ Headwalls and Wingwalls
- ☐ Piling locations and out off elevations
- ☐ Collision locations and elevations
- ☐ Footing locations, alignment, and elevations
- ☐ Abutment/Pier alignment
- ☐ Abutment form locations
- ☐ Wingwall skew angles/offsets
- ☐ Structural concrete form locations
- ☐ Substructure survey (See Revision or Subsection 6C - 2.0.1)
- ☐ Bridge expansion joints alignment and grade (longitudinal and transverse)
- ☐ Girder 10th or 11th point locations and elevations
- ☐ Slope and Ditch Paving

Fencing

- ☐ Temporary
- ☐ Permanent
- ☐ Sound Barriers
- ☐ Other

Delineators

- ☐ Temporary
- ☐ Permanent

Lighting and Traffic Control Devices (Perm)

- ☐ Signal pole locations and elevations
- ☐ Light pole locations and elevations
- ☐ Signs
 - ☐ Field verify sign post locations, elevations and lengths before fabrication
- ☐ Other

Pavement Marking

- ☐ Striping (Temp)
- ☐ Striping (Perm)
- ☐ Symbols
- ☐ Other

Temporary Lighting and Construction Traffic Control Devices

- ☐ Signal pole locations and elevations (Temp)
- ☐ Light pole locations and elevations (Temp)
- ☐ Signs (Temp)
- ☐ Other: Construction Traffic Control Devices

Easement (Temp)(Staking)

WORK PERFORMED BY THE CONTRACTOR'S SURVEYOR UNDER ITEM 629:

Monumentation

- ☐ Control
- ☐ Right of Way (Temp) (Staking)
- ☐ Right of Way
- ☐ Land corners, aliquot corners
- ☐ Easement (Temp)(Staking)
- ☐ Easement (Perm)
- ☐ Reference the specified existing monuments
- ☐ Relocate the specified existing monuments 9 TYPE 1 CONTROL MONUMENTS
- ☐ Locate monuments. It is estimated _____ hours are required.

AS CONSTRUCTED

NO REVISIONS ☐ REVISED ☐ VOID ☐

FEDERAL ROAD REGION NO.	DIVISION	PROJECT NO.	SUB ACCOUNT	SHEET NO.
700	COLORADO	STA 0471-020		14

GENERAL NOTES:

All work shall be done in accordance with the CDOT Survey Manual.

Adequate information for establishing lines, grades, and locations for all work items have been specified on the plans. Any additional information required to stake the item or element shall be generated by the Contractor's surveyor.

The Contractor's surveyor shall provide an estimate of the man-hours necessary to complete the work items indicated on this sheet. A copy of this sheet, with the estimated man-hours written on the blank line to the left of the specified items, shall be submitted with the survey schedule to the Engineer at the Presurvey Conference.

The following surveying notebooks are required:

- ☒ Alignment Notebook
- ☒ Benchmark Notebook
- ☒ Control Survey/Monumentation Notebook
- ☒ Minor Structure Notebook
- ☒ Major Structure Notebook
- ☒ Slope Staking Notebook
- ☒ Grade Notebook
- ☒ Miscellaneous Notebook(s)

Stakes and Monuments set by CDOT forces which are damaged or destroyed by the progress of construction shall be replaced by the Contractor at no additional cost to the Department.

The Contractor shall furnish or "be staked" earth work quantity to the Engineer prior to completion of twenty percent (20%) of the planned earth work in any phase as per the CDOT Survey Manual. The Contractor shall field verify original ground cross sections at maximum 500 ft (150 m) intervals.

The Contractor shall coordinate construction staking of the project with any utility work.

The Contractor shall perform any field surveying and calculations necessary to re-plot grades into field grades.

COLORADO
DEPARTMENT OF TRANSPORTATION

SURVEY TABULATION SHEET

JUNE 1994

Xref Drawings

CONTROL MONUMENT

REVISIONS	

PROJECT INFORMATION		
PROJECT NAME		
PROJECT NO.		

PROJECT NO.	SHEET NO.	SHEET TOTALS
STA 0471-020	15	

LOCATION: S.H. 47
PUEBLO COUNTY, COLORADO
T. 20 S., R. 64 W.


SURVEY CONTROL SYSTEM

POINT NO.	NORTHING	EASTING	ELEVATION	DESCRIPTION
1001	599397.051	259574.068	4784.81	CONTROL MONUMENT ~ M.P. 0.88
1002	599203.595	260139.790	4783.37	CONTROL MONUMENT ~ M.P. 0.98
1003	599425.861	260481.853	4792.03	CONTROL MONUMENT ~ M.P. 1.04
1004	599325.089	260827.618	4798.29	SPIKE ~ M.P. 1.11
1005	599479.062	261176.581	4812.43	CONTROL MONUMENT ~ M.P. 1.18
1006	599315.340	261541.694	4814.40	SPIKE ~ M.P. 1.25
1007	599315.964	261949.267	4831.10	CONTROL MONUMENT ~ M.P. 1.32
1008	599062.051	262219.209	4836.16	SPIKE ~ M.P. 1.39
1009	598988.088	262574.672	4844.55	CONTROL MONUMENT ~ M.P. 1.45
1010	598701.524	262843.684	4856.36	SPIKE ~ M.P. 1.52
1011	598647.922	263212.112	4865.55	CONTROL MONUMENT ~ M.P. 1.59
1012	598376.444	263503.506	4877.36	SPIKE ~ M.P. 1.66
1013	598350.562	263855.827	4898.33	CONTROL MONUMENT ~ M.P. 1.72
1014	597955.843	264081.513	4899.90	CONTROL MONUMENT ~ M.P. 1.79
1015	598012.115	264481.200	4906.90	CONTROL MONUMENT ~ M.P. 1.85
1016	597707.058	264574.572	4900.20	CONTROL MONUMENT ~ M.P. 1.89
1017	597751.141	265021.759	4899.77	CONTROL MONUMENT ~ M.P. 1.96
1018	597453.522	265053.812	4882.71	CONTROL MONUMENT ~ M.P. 1.99
1019	597513.351	265431.947	4887.17	CONTROL MONUMENT ~ M.P. 2.05
1020	597231.986	265675.773	4851.87	SPIKE ~ M.P. 2.11
1021	597132.232	266040.067	4837.93	CONTROL MONUMENT ~ M.P. 2.18
1022	596825.695	266279.853	4827.79	SPIKE ~ M.P. 2.25
1023	596768.893	266679.929	4822.87	CONTROL MONUMENT ~ M.P. 2.30
1024	596269.815	266936.322	4803.22	PK NAIL ON WATER VAULT ~ M.P. 2.41
1025	596670.761	267397.875	4796.65	CONTROL MONUMENT ~ M.P. 2.52
1026	596216.469	267576.752	4809.21	SPIKE ~ M.P. 2.52
1027	596127.872	267974.837	4793.18	CONTROL MONUMENT ~ M.P. 2.60
1028	595817.573	268169.302	4784.25	SPIKE ~ M.P. 2.66
1029	595767.574	268553.724	4771.06	CONTROL MONUMENT ~ M.P. 2.73
1030	595374.578	268898.564	4762.73	CONTROL MONUMENT ~ M.P. 2.82
1031	595469.482	269201.610	4764.70	CONTROL MONUMENT ~ M.P. 2.86
1032	595102.727	269400.469	4758.17	CONTROL MONUMENT ~ M.P. 2.93
1033	595106.263	269870.576	4766.27	CONTROL MONUMENT ~ M.P. 3.00
1034	594818.152	269934.464	4760.95	CONTROL MONUMENT ~ M.P. 3.02
1035	594782.735	270476.150	4773.00	CONTROL MONUMENT ~ M.P. 3.13
1036	594423.355	270636.292	4777.82	CONTROL MONUMENT ~ M.P. 3.19
1037	594455.758	271078.147	4788.90	CONTROL MONUMENT ~ M.P. 3.24
1038	593865.652	270982.631	4776.35	CONTROL MONUMENT ~ M.P. 3.32
1039	594247.438	271469.311	4764.82	CONTROL MONUMENT ~ M.P. 3.36
1040	593267.706	271319.236	4789.01	CONTROL MONUMENT ~ M.P. 3.47
1041	592996.346	271749.643	4768.50	CONTROL MONUMENT ~ M.P. 3.50
1042	592628.781	271525.278	4757.14	CONTROL MONUMENT ~ M.P. 3.61
1043	592269.827	271727.783	4751.97	CONTROL MONUMENT ~ M.P. 3.68
1044	591943.556	271562.632	4746.42	CONTROL MONUMENT ~ M.P. 3.75
1045	591590.136	271748.387	4742.19	CONTROL MONUMENT ~ M.P. 3.81
1046	591242.105	271563.790	4739.30	CONTROL MONUMENT ~ M.P. 3.88
1047	590915.392	271805.663	4733.63	CONTROL MONUMENT ~ M.P. 3.94
1048	590469.251	271582.357	4730.22	CONTROL MONUMENT ~ M.P. 4.02
1049	590065.711	271801.849	4719.55	CONTROL MONUMENT ~ M.P. 4.10
1050	589769.059	271597.747	4735.41	CONTROL MONUMENT ~ M.P. 4.15
1051	589482.336	271997.141	4718.18	CONTROL MONUMENT ~ M.P. 4.21
1052	589145.814	271618.065	4692.55	CONTROL MONUMENT ~ M.P. 4.27
1053	588805.009	271796.089	4702.72	CONTROL MONUMENT ~ M.P. 4.33
1054	588706.208	271565.418	4679.27	CONTROL MONUMENT ~ M.P. 4.38
1055	588324.180	271724.602	4696.13	CONTROL MONUMENT ~ M.P. 4.43
1056	588179.469	271438.144	4667.16	CONTROL MONUMENT ~ M.P. 4.46
1057	587812.671	271542.847	4686.06	CONTROL MONUMENT ~ M.P. 4.53
1058	587466.383	270883.320	4653.38	SPIKE SH50 ~ M.P. 318.64
1059	587248.245	271116.615	4666.17	CONTROL MONUMENT SH96 ~ M.P. 58.77
1060	587188.813	270502.793	4657.55	CONTROL MONUMENT SH96 ~ M.P. 58.87
1061	586794.353	270572.747	4653.05	CONTROL MONUMENT SH96 ~ M.P. 58.64
1062	586713.443	270203.488	4655.35	CONTROL MONUMENT SH96 ~ M.P. 58.58
1063	586374.708	270016.516	4659.71	CONTROL MONUMENT SH96 ~ M.P. 58.51
1064	586047.958	270014.651	4672.31	CONTROL MONUMENT SH50 ~ M.P. 318.45
1065	586268.285	270046.253	4675.20	CONTROL MONUMENT SH50 ~ M.P. 318.43
1066	587637.906	270495.629	4664.24	CONTROL MONUMENT SH50 ~ M.P. 318.57
1067	587837.863	270601.257	4666.08	CONTROL MONUMENT SH50 ~ M.P. 318.56
1068	587077.444	271469.354	4647.31	CONTROL MONUMENT SH50 ~ M.P. 318.73
1069	587192.773	271761.837	4662.43	CONTROL MONUMENT SH50 ~ M.P. 318.76
1070	586773.814	272041.854	4639.73	CONTROL MONUMENT SH50 ~ M.P. 318.85
1071	586562.820	272631.320	4634.12	CONTROL MONUMENT SH50 ~ M.P. 318.96
1074	599329.761	258938.481	4764.17	CONTROL MONUMENT ~ M.P. 0.69
1075	599050.090	258305.021	4751.15	CONTROL MONUMENT ~ M.P. 0.64
1076	598964.840	257683.227	4746.85	CONTROL MONUMENT ~ M.P. 0.52
1077	598986.631	255904.342	4765.78	CONTROL MONUMENT ~ M.P. 0.27
1078	598399.804	255317.657	4757.51	CONTROL MONUMENT ~ M.P. 101.26
1079	599752.229	255383.611	4750.16	CONTROL MONUMENT ~ M.P. 101.32
1080	599220.756	255166.641	4770.98	CONTROL MONUMENT ~ M.P. 101.42
1090	598950.047	256309.197	4765.55	CONTROL MONUMENT ~ M.P. 0.35
2026	598872.910	255073.606	4763.06	CONTROL MONUMENT ~ M.P. 101.37

SURVEY MONUMENT TABULATION


POINT NO.	STATION	OFFSET	SURVEY MONUMENT (TYPE 1)
1002	72+72.6	95.2 RT.	1
1004	79+70.0	48.1 RT.	1
1006	87+01.8	40.0 RT.	1
1008	94+36.8	17.6 RT.	1
1010	101+57.5	38.6 RT.	1
1012	108+92.6	11.7 RT.	1
1020	133+47.8	11.6 LT.	1
1022	140+72.3	59.5 RT.	1
1028	162+13.9	50.4 RT.	1
TOTAL			9


MATERIALS FOR SURVEY MONUMENT TYPE 1 SHALL BE SUPPLIED BY CDOT.

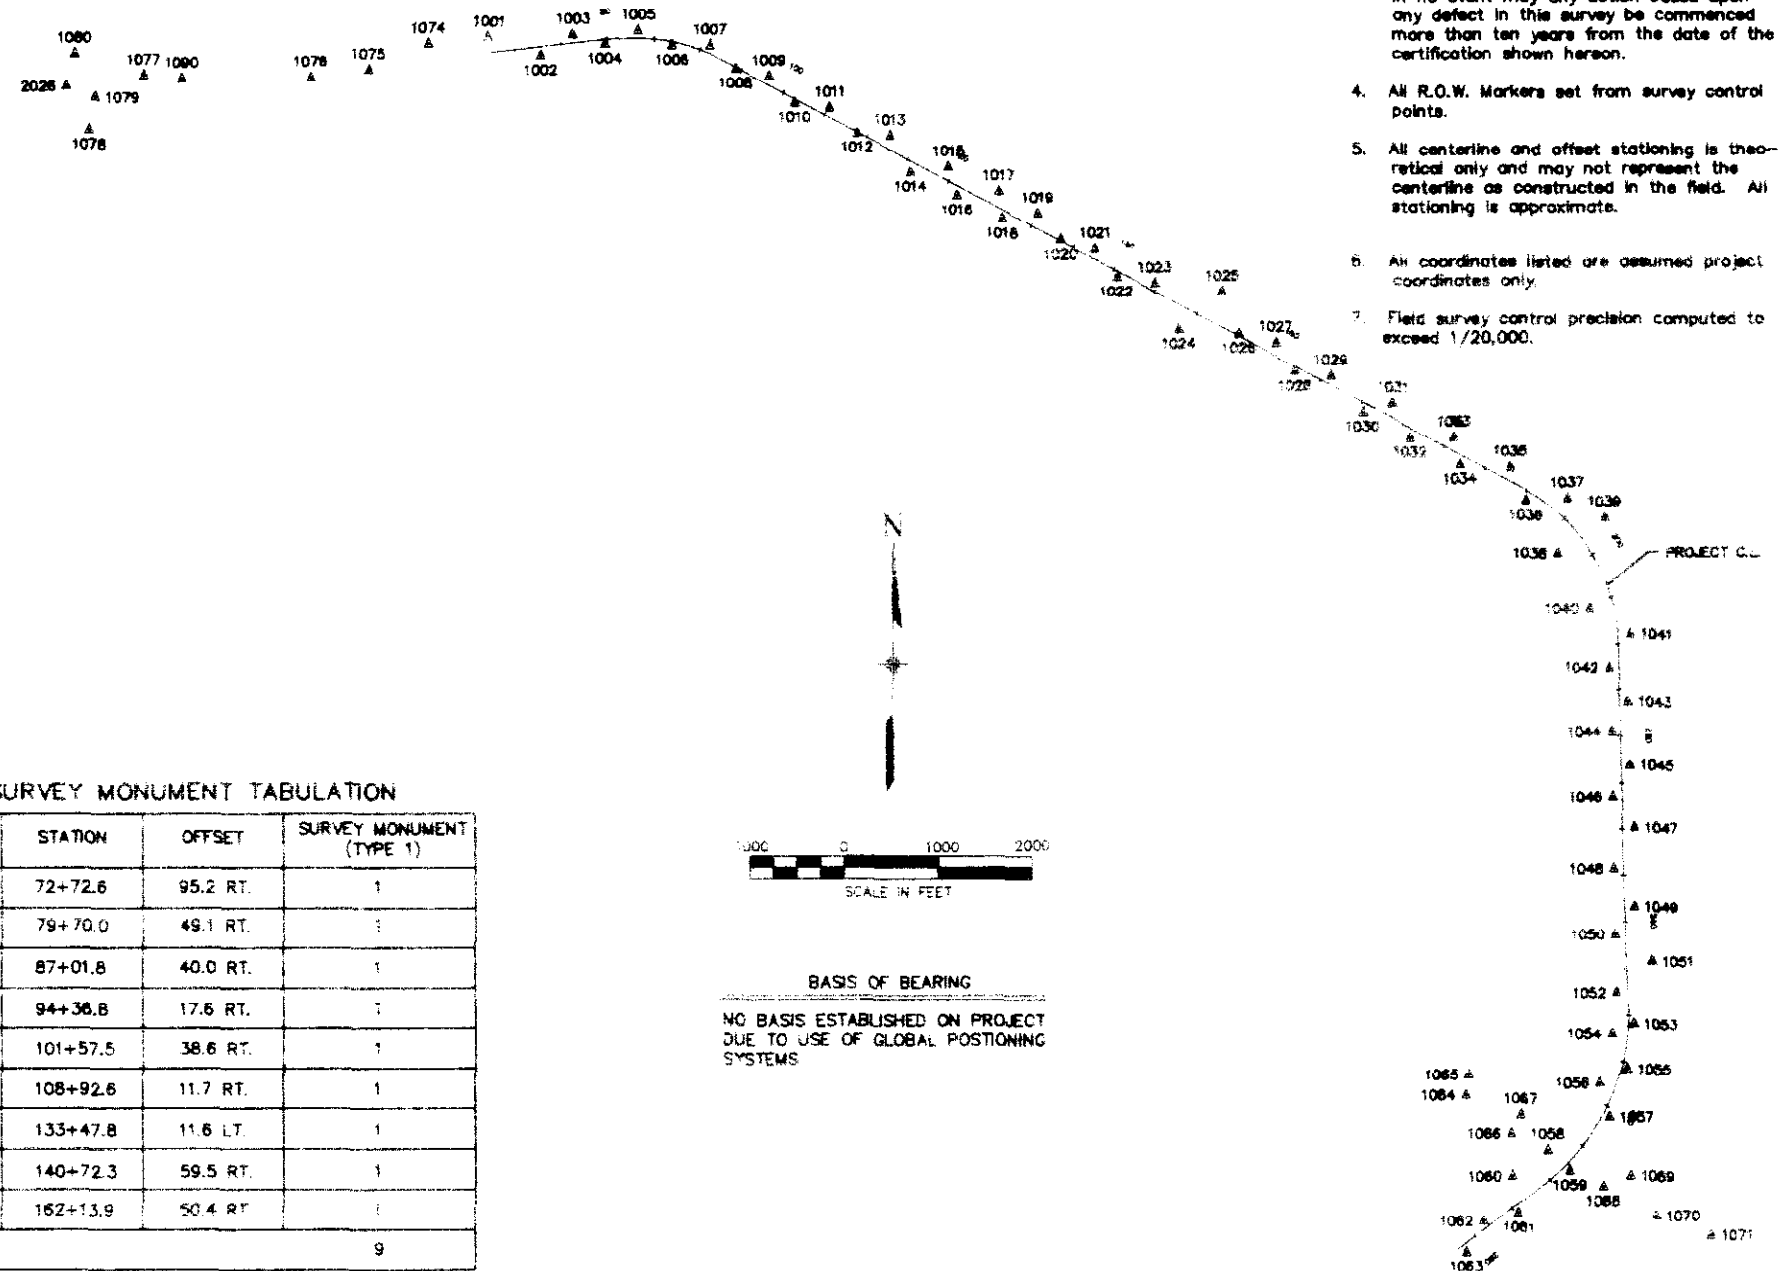

GENERAL NOTES

1. This Right of Way plan is not a complete boundary survey of all adjoining owners and is prepared for Highway Department purposes only.
2. Survey Control Points set with a higher degree of accuracy than R.O.W. Markers.
3. NOTICE: According to Colorado law you must commence any legal action based upon any defect in this survey within three years after you first discover such defect. In no event may any action based upon any defect in this survey be commenced more than ten years from the date of the certification shown hereon.
4. All R.O.W. Markers set from survey control points.
5. All centerline and offset stationing is theoretical only and may not represent the centerline as constructed in the field. All stationing is approximate.
6. All coordinates listed are assumed project coordinates only.
7. Field survey control precision computed to exceed 1/20,000.

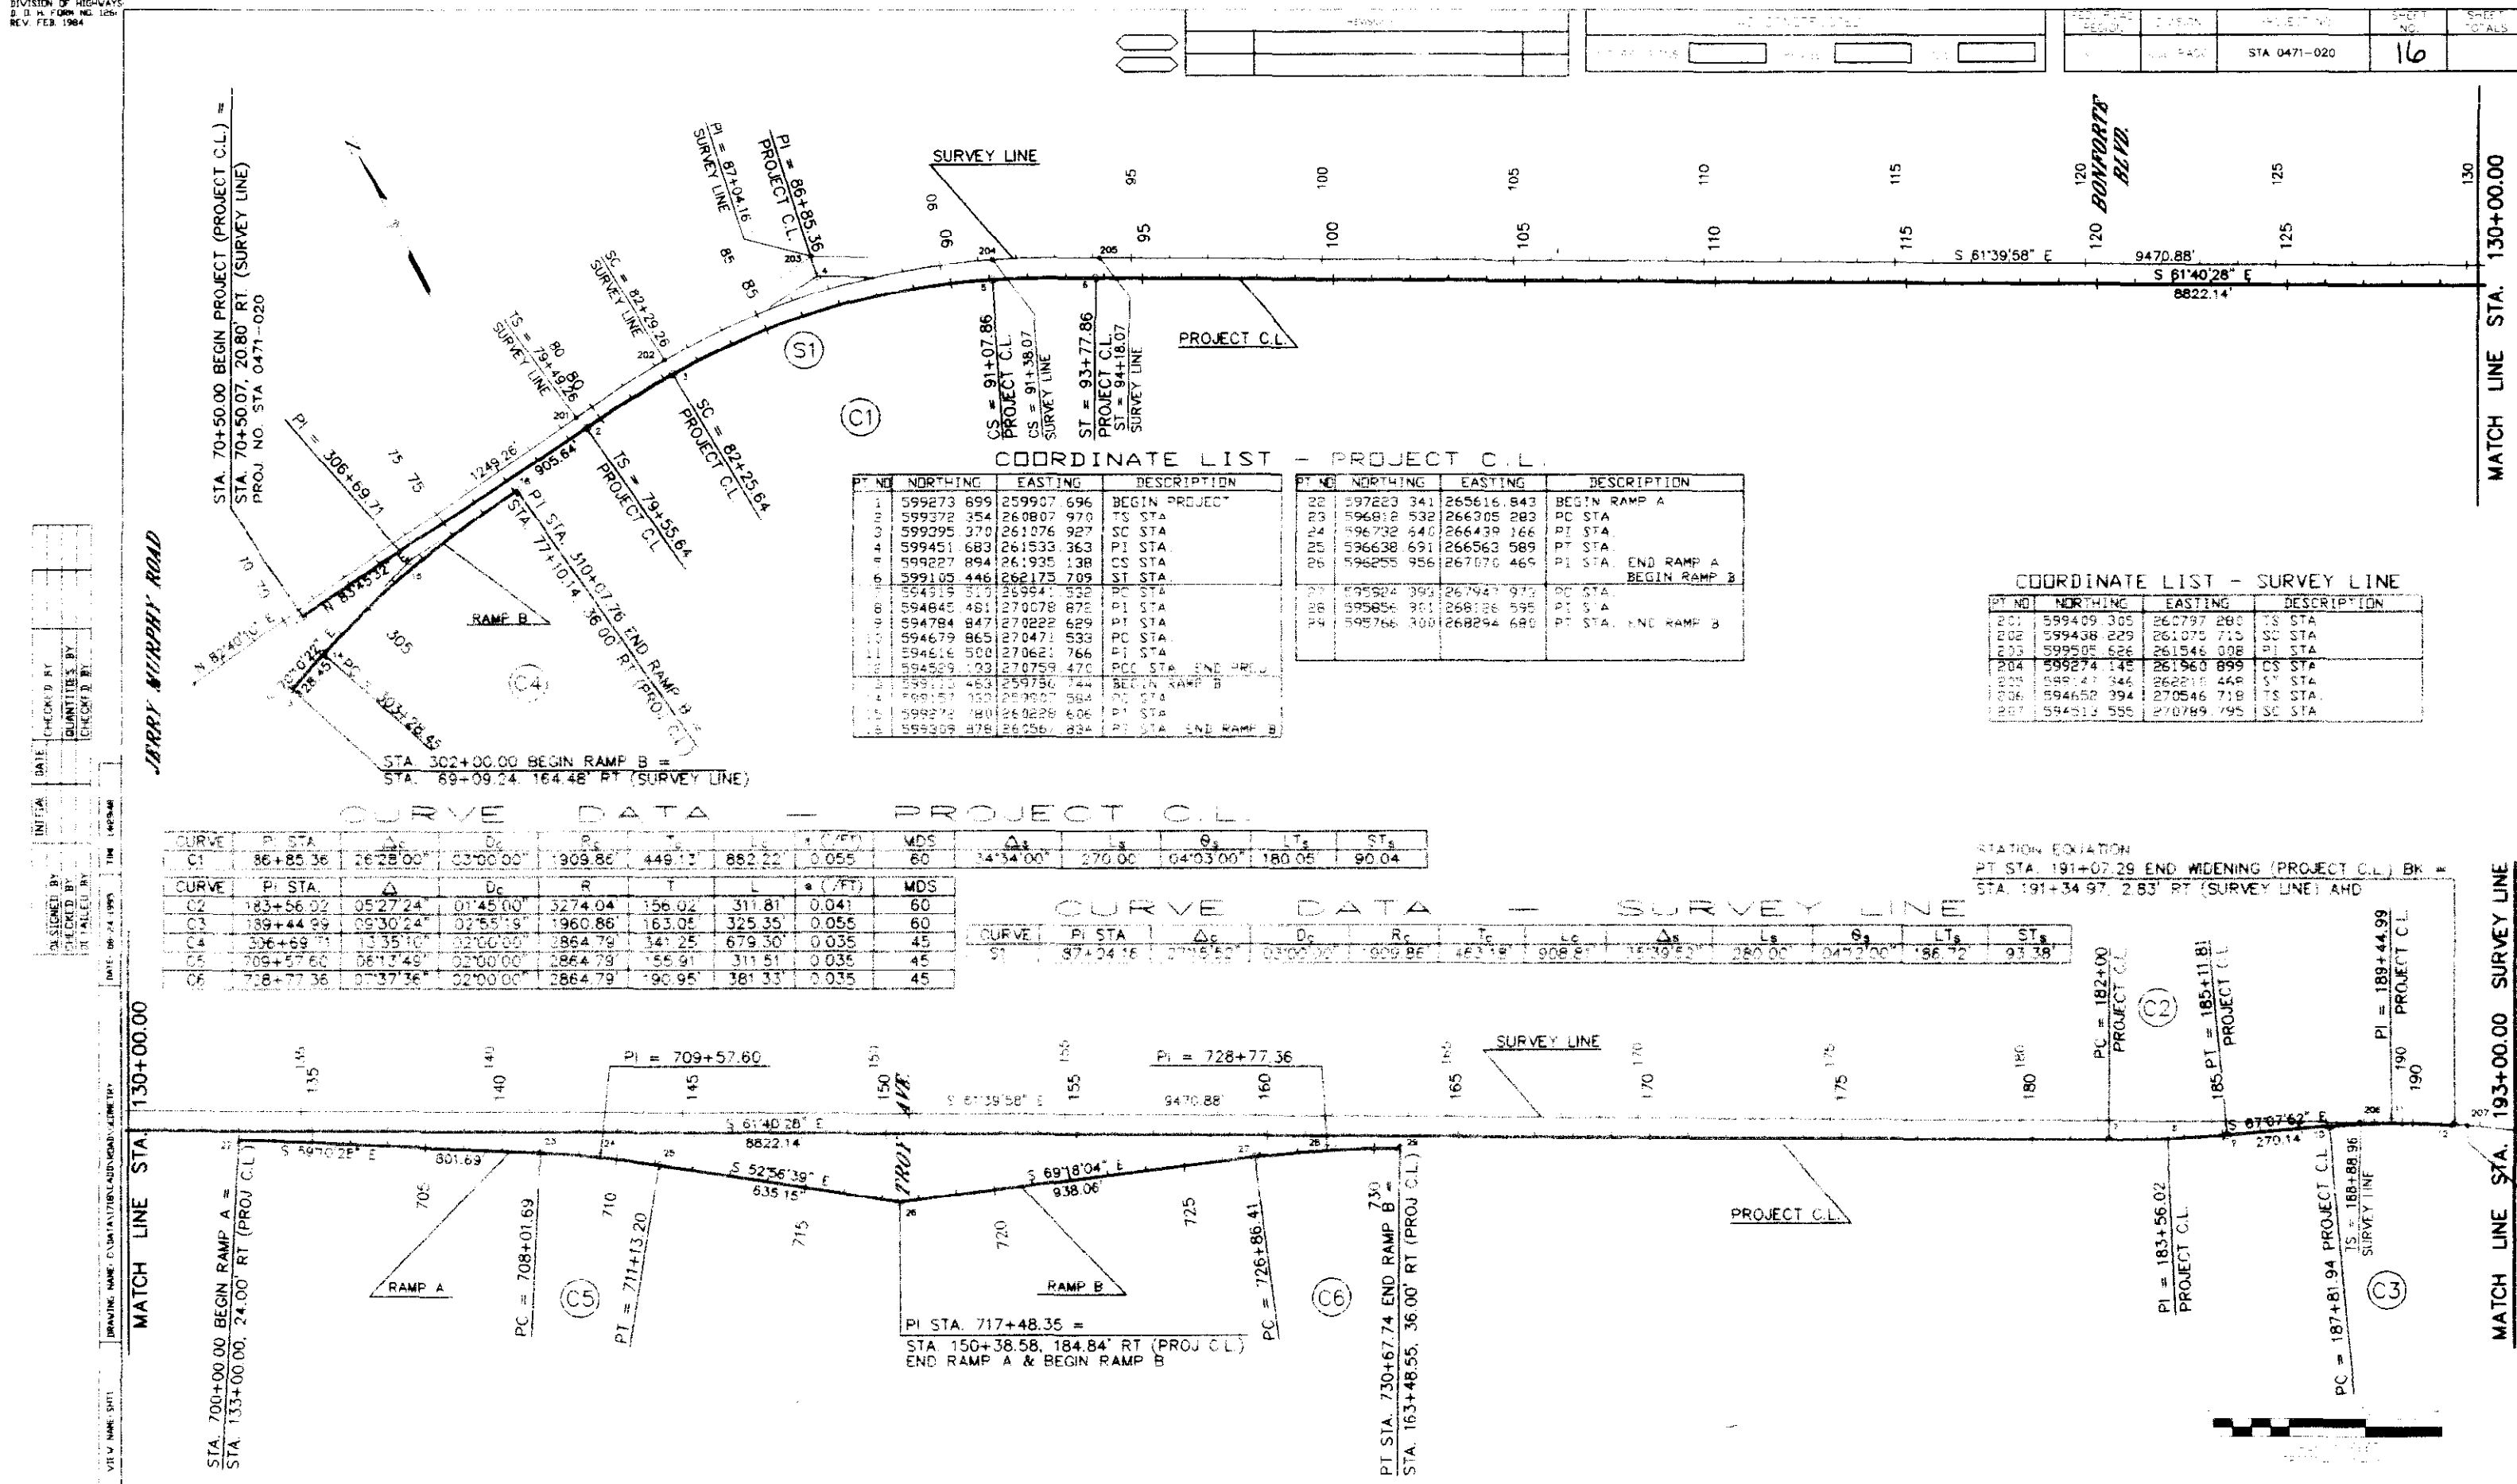

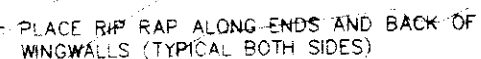


EXISTING —
11'X10' CBC

NOTES:


THE FOLLOWING APPROXIMATE QUANTITIES ARE REQUIRED FOR
THIS STRUCTURE (CARRIED TO STRUCTURE QUANTITIES SHEET)

STRUCTURE EXCAVATION	489 CY
STRUCTURE BRICK/CLT TOLARS (2)	278 CY
PILE MATERIAL (CLASS A)	43 CY
GEOTEXTILE (EROSION CONTROL CLASS A)	460 SY
RIEPAF (24 INCH)	469 CY
SOIL RETENTION BLANKET (SPECIAL)	225 CY

OUTLET PLAN
STA. 178+50, RT.

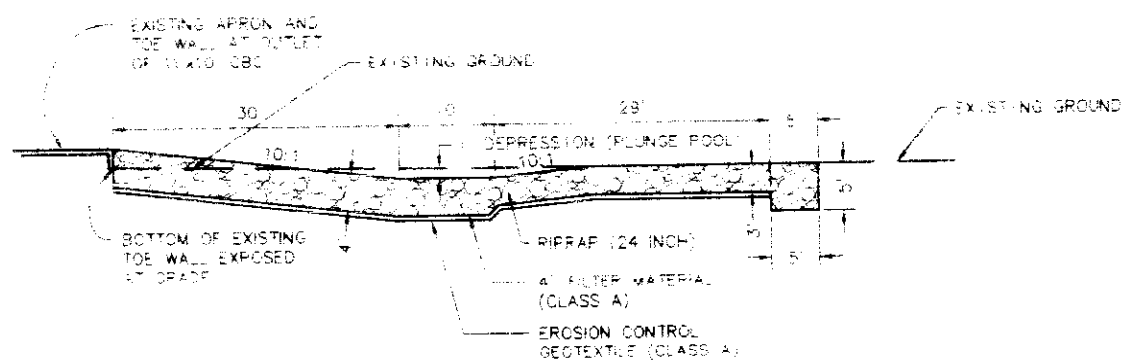

SECTION A-A

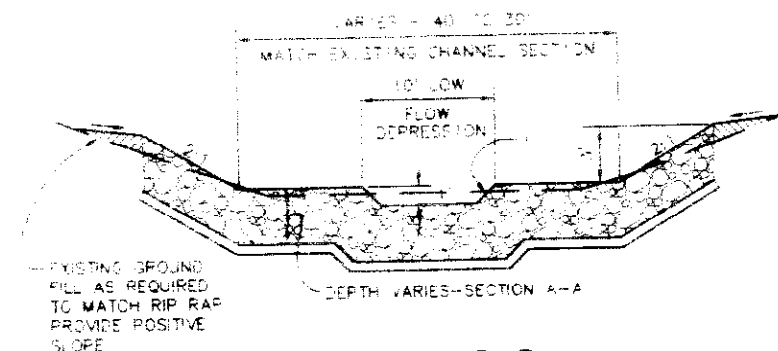

SECTION B-B


OUTLET PAVING DETAIL

STA. 178+50 - 11'x10' CBC OUTLET

DESIGNED BY	CHECKED BY
CHECKED BY	QUANTITIES BY
RETAILED BY	CHECKED BY


PROJECT NO.	STA 0471-020	SHEET NO.	19	SHEET TOTALS
-------------	--------------	-----------	----	--------------

REVISIONS

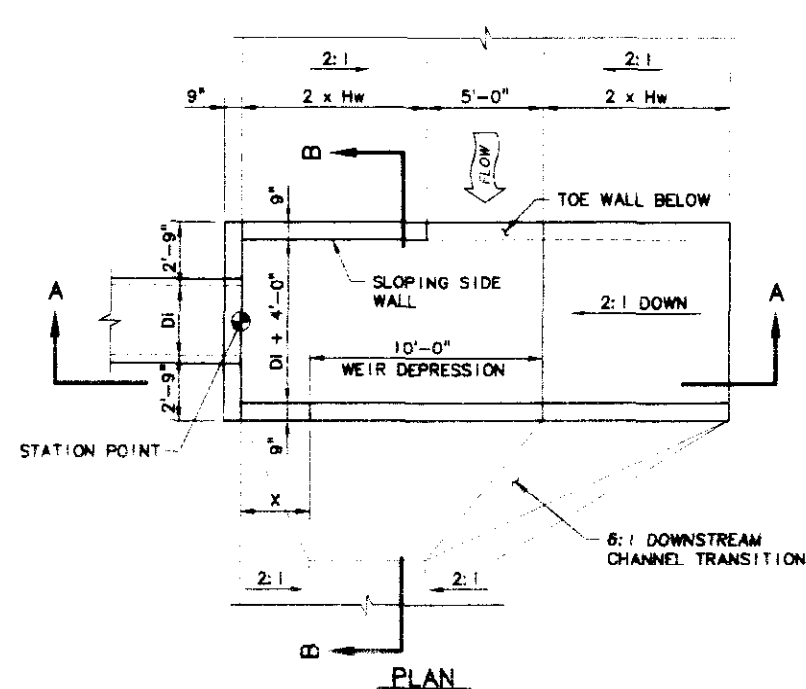


PLAN
DIVERSION STRUCTURE DETAIL


STA. 76+29.7, RT.
STA. 86+24.7, RT.
STA. 91+23.7, RT.

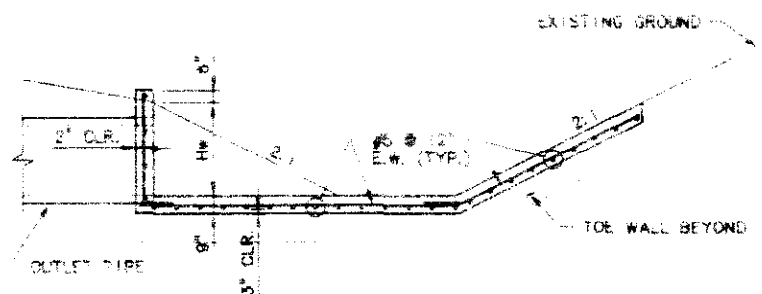


SECTION A-A

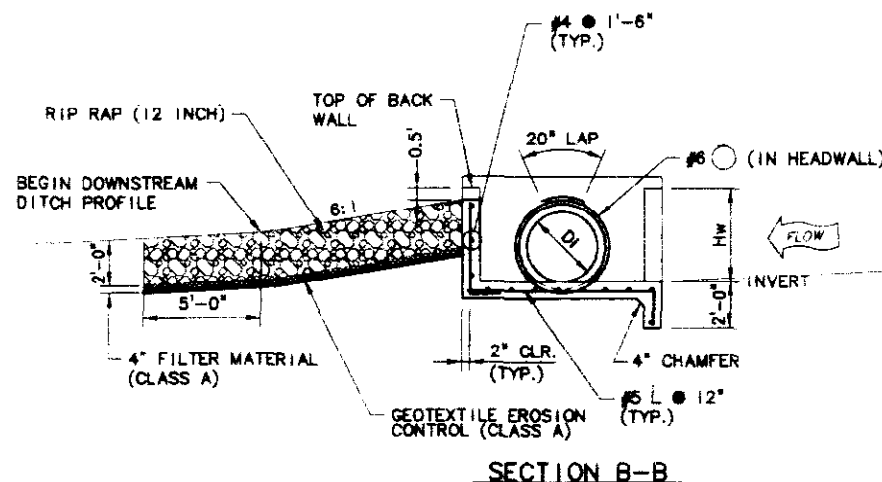


SECTION B-B

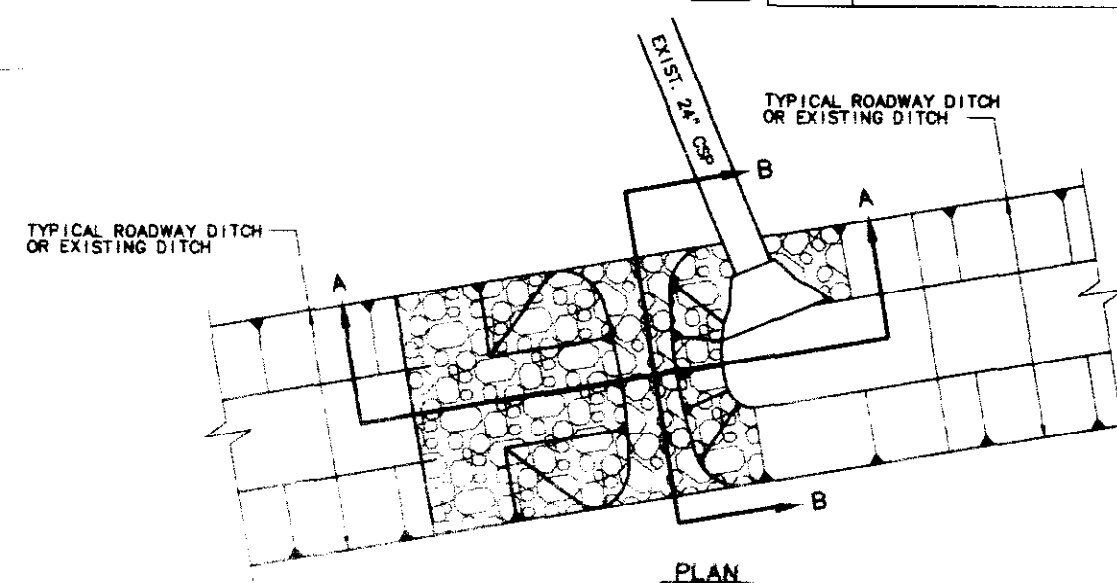

PLAN

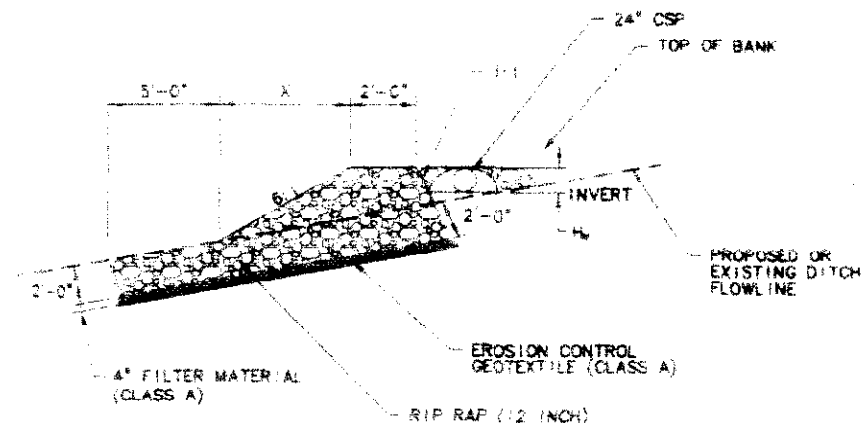

SECTION A-A

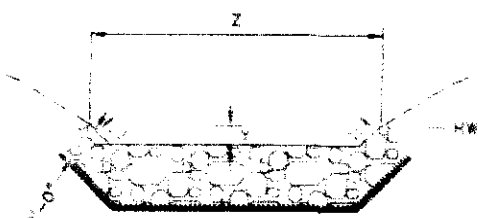

SECTION B-B

RIP RAP BERM DETAIL

RIP RAP BERM STRUCTURE NOTES

STRUCTURE EXCAVATION AND BACKFILL FOR RIP RAP BERM STRUCTURES WILL NOT BE PAID FOR SEPARATELY BUT SHALL BE INCLUDED IN THE COST OF THE WORK.

DIVERSION STRUCTURE NOTES

ALL CONCRETE SHALL BE CLASS B (MISC).

ALL REINFORCING STEEL SHALL BE GRADE 60.

UNLESS NOTED OTHERWISE, ALL REINFORCING STEEL SHALL HAVE A MINIMUM OF 2" CLEARANCE.

STRUCTURE EXCAVATION AND BACKFILL FOR DIVERSION STRUCTURES WILL NOT BE PAID FOR SEPARATELY BUT SHALL BE INCLUDED IN THE COST OF THE WORK.

EXPOSED CONCRETE CORNERS SHALL BE CHAMFERED 3/4".

EXPOSED CONCRETE SURFACES SHALL RECEIVE EITHER A CLASS 2 OR CLASS 5 FINISH AT THE CONTRACTOR'S OPTION.

TABULATION OF DIVERSION STRUCTURES

STATION	INVERT	DI	Hw	X	CONCRETE CLASS B (MISC) CU. YDS.	REINF. STEEL LBS.	RIP RAP (12 INCH) CU. YDS.	GEOTEXTILE ERO. CTRL. (CLASS A) SQ. YDS.	FILTER MATERIAL (CLASS A) CU. YDS.
76+29.7, 56.14' RT.	4786.70	2-36"	3.85'	2.7'	11	1,063	23	35	4
86+24.7, 55' RT.	4810.12	42"	3.20'	1.4'	8	707	17	25	3
91+23.7, 55' RT. (b)	4822.93	60"x38"	3.20'	1.4'	9	856	26	39	4
TOTALS					28	2,626	66	99	11

- (a) : TWIN 36" RCP (EFFECTIVE INSIDE DIMENSION = 11'-6")
(b) : 42" EQUIV. RCHP (EFFECTIVE INSIDE DIMENSION = 8'-5")
● : QUANTITY CARRIED DIRECTLY TO SUMMARY OF APPROXIMATE QUANTITIES.
▲ : QUANTITY CARRIED TO STRUCTURE QUANTITIES LIST.

TABULATION OF RIP RAP BERM STRUCTURES

STATION	INVERT	Hw	X	Y	Z	RIP RAP (12 INCH) CU. YDS.	GEOTEXTILE ERO. CTRL. (CLASS A) SQ. YDS.	FILTER MATERIAL (CLASS A) CU. YDS.
81+13.24	4800.09	2.0'	15'	0.09'	13'	30	32	4
96+01.50	4837.29	2.1'	16'	1.3'	18'	44	46	5
107+05.38	4870.95	1.7'	13'	0.5'	20'	43	44	4
TOTALS						117	122	13


▲ : QUANTITY CARRIED TO STRUCTURE QUANTITIES LIST.

TABULATION & DETAILS OF RIP RAP
BERM & DIVERSION STRUCTURES


REVISION	

AUTOMATICALLY GENERATED		
NO. REVISIONS	REVISION	DATE

REGIONAL REGION	DIVISION	PROJECT NO.	SHEET NO.	SHEET TOTALS
V	COLORADO	STA 0471-020	20	

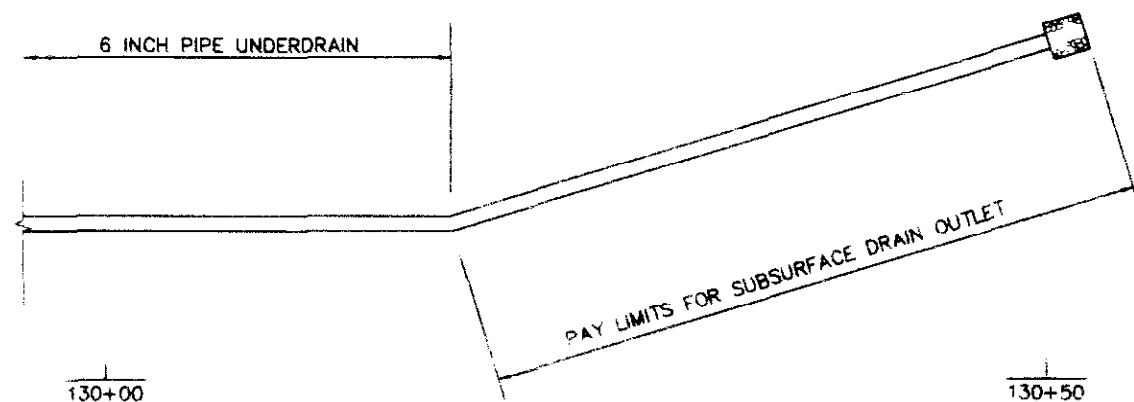

SCALE: HORIZ. 1" = 50'
VERT. 1" = 10'

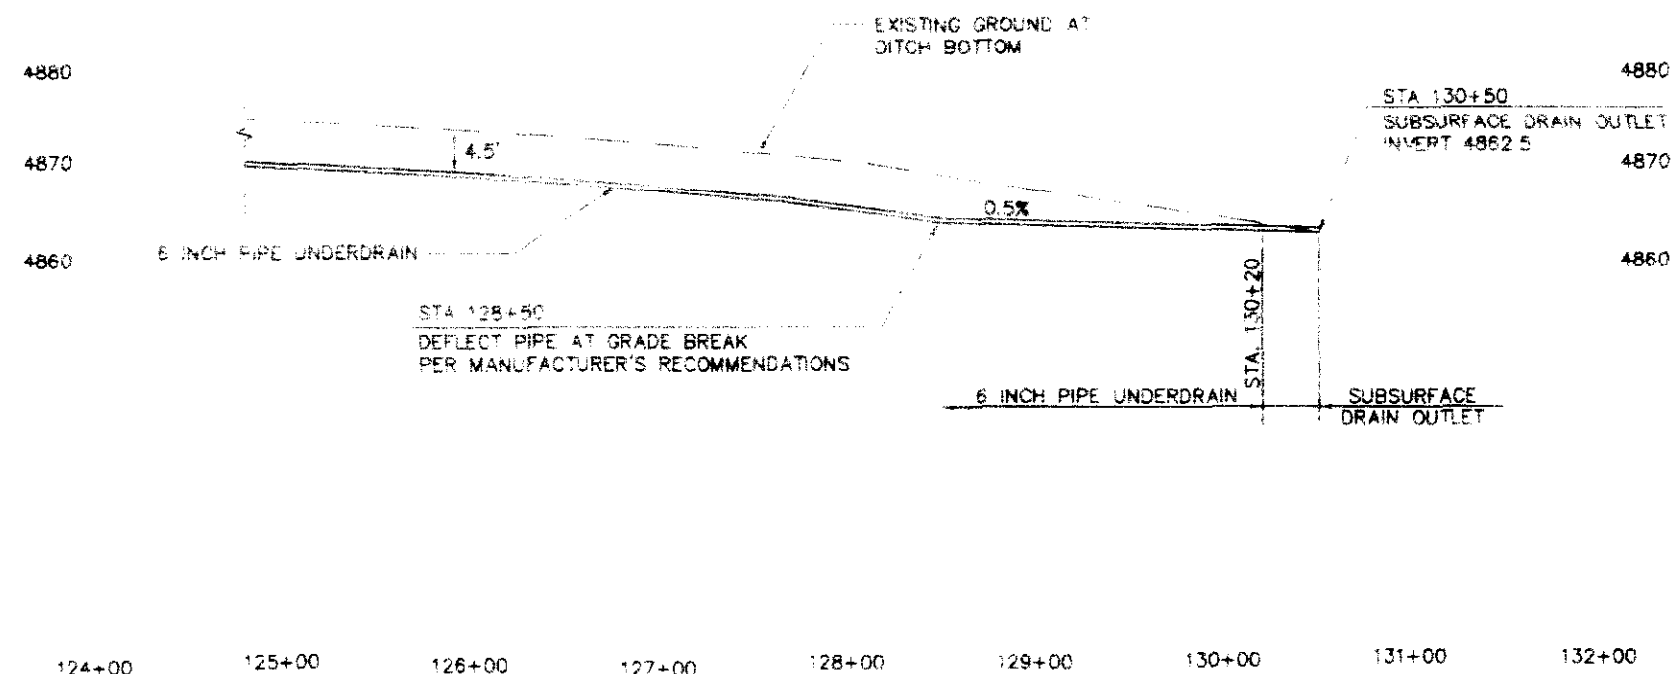

PIPE UNDERDRAIN NOTES

PIPE UNDERDRAIN SHALL BE INSTALLED IN A SMOOTH ALIGNMENT ALONG THE FLOWLINE OF THE EXISTING DITCH.

STA. 115+00 TO 128+50, LT.: PIPELINE INVERT SHALL BE 4.5' MIN. BELOW EXISTING DITCH FLOWLINE. PIPELINE SLOPE SHALL BE A SMOOTH PROFILE WHICH MATCHES THE EXISTING DITCH FLOWLINE SLOPE.

STA. 128+50 TO 130+50, LT.: PIPELINE SLOPE SHALL BE 0.5% TO DAYLIGHT

SEE STANDARD PLAN M-805-1 FOR ADDITIONAL NOTES AND DETAILS

PIPE UNDERDRAIN PROFILE

AS CONSTRUCTED			FEDERAL ROAD REGION NO.	DIVISION	PROJECT NUMBER	SHEET NO.
NO REVISIONS	REVISED	VOID	VIII	COLORADO	STA 0471-020	21

REVISIONS		

GENERAL NOTES

Except as shown in the plans for Structure Backfill (Flow-Fill), structure excavation and backfill shall be in accordance with M-206-2 for Abutments and Wingwalls.

The information shown on these plans concerning the type and location of underground utilities is not guaranteed to be accurate or all inclusive. The contractor is responsible for making their own determination as to the type and location of underground utilities as may be necessary to avoid damage thereto. The contractor shall contact the Utility Notification Center of Colorado at 1-800-922-1987 at least 2 days (not including the day of notification) prior to any excavation or other earthwork.

The Contractor is responsible for the stability of the structure during construction.

Permanent steel bridge deck forms are optional.

All exposed concrete surfaces, excluding the top of deck shall receive a Class 2, rubbed finish. Cost of the finish shall be included in Item 601 Concrete Class S (Bridge).

Expansion joint material shall meet AASHTO specification M213.

ABBREVIATIONS

E.F. = Each Face	Bot. = Bottom	W.P. = Work Point
F.F. = Far Face	(E) = Epoxy Coated	Eq. = Equal
No. = Number	Sta. = Station	Pvmt. = Pavement
Cont. = Continuous	B.F. = Back Face	Clr. = Clear
R = Radius	Dist. = Distance	Jt. = Joint
N.F. = Near Face	T&B = Top & Bottom	Btwn = Between
E.W. = Each Way	El. = Elevation	Spa. = Spaces
Abut. = Abutment	Dwg. = Drawing	
Typ. = Typical	Brg. = Bearing	

DESIGN DATA

AASHTO, Standard Specifications for Highway Bridge, Fifteenth Edition, 1994 Interim.

Live Load:

AASHTO HS25-44 & Alternate Military Loading.

Dead Load:

Assumes 48 lbs. per sq. ft. for bituminous pavement.
Assumes 5 lbs. per sq. ft. for Deck Forms.

Reinforced Concrete:

Class B Concrete $n=9$, $f_c=3,000$ p.s.i.

Prestressed Concrete:

Low relaxation strands meeting the requirements of ASTM416 grade 270.
Class S Concrete $n=8$, $f_c=5,000$ p.s.i.

Reinforcing Steel:

$F_y = 60,000$ p.s.i.; All reinforcing steel shall be ASTM A615 Grade 60 and shall be non-epoxy coated unless otherwise noted.

The following table gives the minimum Class B lap splice length for reinforcing bars:

Bar Size	#4	#5	#6	#7	#8	#9	#10	#11
Splice Length for Class B BZ Concrete	1'-3"	1'-6"	2'-0"	2'-8"	3'-6"	4'-5"	5'-7"	6'-10"
Splice Length for Class S Concrete	1'-3"	1'-6"	1'-10"	2'-2"	2'-10"	3'-7"	4'-7"	5'-7"

When the Contractor elects to substitute epoxy coated reinforcement for black steel bars, the minimum lap splice shall be as designated above. The above splice lengths shall be increased by 25% for bars spaced less than 6 inches on center or with clear cover less than 3 inches, measured in the direction of bar spacing.


Design Method: Load Factor Design

INDEX OF DRAWINGS

B1	General Information
B2	Summary of Quantities
B3	General Layout
B4	Engineering Geology
B5	Construction and Foundation Layout
B6	Abutment 1 Plan and Elevation
B7	Abutment 1 Reinforcement
B8	Abutment 2 Plan and Elevation
B9	Abutment 2 Reinforcement
B10	Abutment Wingwalls and Reinforcement
B11	Superstructure Deck Reinforcement Plan
B12	Superstructure Section Details
B13	Superstructure Post Tensioning Layout
B14	Cast-in-Place Post-Tensioned Box Girder Details
B15	Cast-in-Place post-Tensioned Box Girder Details
B16	Slope Paving Details
B17	Interior Lighting (Concrete Box Girder)
B18	Bridge Rail Type 10 Special
B19	Bridge Rail Type 10 Special
B20	Bridge Rail Type 10 Special
B21	Bridge Rail Type 10 Special
B22	Bridge Drain Details
B23	Approach Slab Details
B24	Structure Backfill (Flow-Fill)
B25	Bar Lists
B26	Bridge Deck Elevations
B27	Roadway Approaches
B28	Approach Slab Retrofit Details
B29	Approach Slab Details
B30	Structure Backfill (Flow-Fill)
B31	Bridge Rail Removal and Retrofit Details

BRIDGE DESCRIPTION

1 span (167'-6") bridge
Concrete box girder, prestressed
38'-0" roadway curb to curb
1'-3" Bridge rail type 10 special

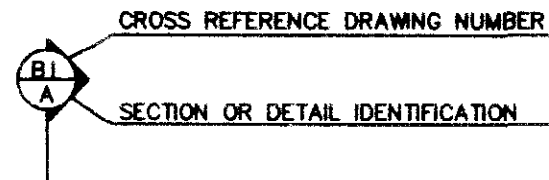

DEPARTMENT OF TRANSPORTATION		
S.H. 47 OVER TROY AVENUE PUEBLO, COLORADO		
GENERAL INFORMATION		
Designer G. Tsouvaras	Structure	K-18-GA
Detailer G. Tsouvaras	Numbers	K-18-EX
Drawing Number	B1	of 31 Drawings
Revision Dates (Preliminary Stage Only)		

11	12	13	14	15	16
AS CONSTRUCTED			FEDERAL ROAD REGION NO.	DIVISION	PROJECT NUMBER
NO REVISIONS	REVISED	VOID	VIII	COLORADO	STA 0471-020
			SHEET NO.		
			ZZ		

STRUCTURE NO. K-18-EX

APPROACH SLAB	SUPER STRUCTURE	APPROACH SLAB	TOTAL
	780		780
	414		414
108		108	216
88		88	176
7	85	7	99
66		66	132
42		42	84
30	4	30	64
4135	1405	4135	9675
	414		414
			.05
			.05





DEPARTMENT OF TRANSPORTATION
S.H. 47 OVER TROY AVENUE
PUEBLO, COLORADO
SUMMARY OF QUANTITIES

Designer G. Tsiouvaras	Structure Numbers	K-18-GA
Detailer G. Tsiouvaras		K-18-EX
Drawing Number	B2 of 31	Drawings

Revision Dates	(Preliminary Stage Only)
----------------	--------------------------

SUMMARY OF QUANTITIES

INITIAL	DATE	DESIGNED BY	CHECKED BY	DATE	QUANTITIES BY	DATE
BY	9/7/90	BY	9/7/90	BY	9/7/90	BY
BY	9/7/90	BY	9/7/90	BY	9/7/90	BY
BY	9/7/90	BY	9/7/90	BY	9/7/90	BY

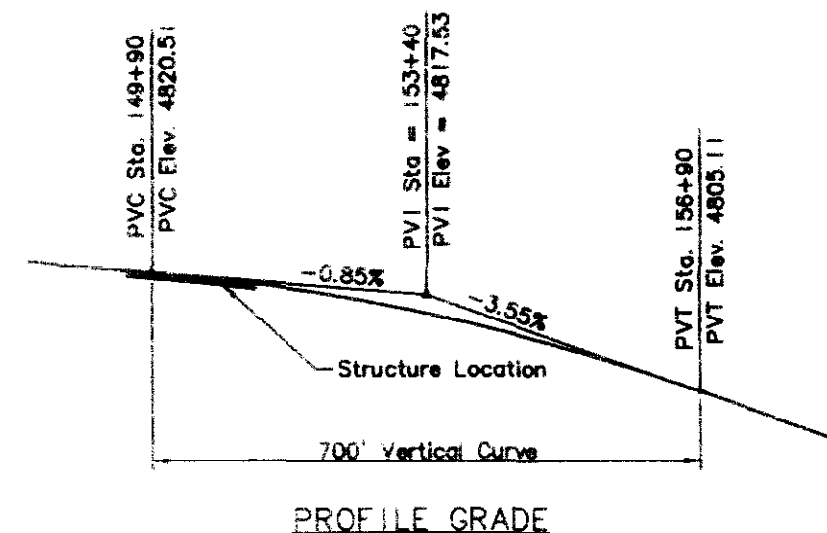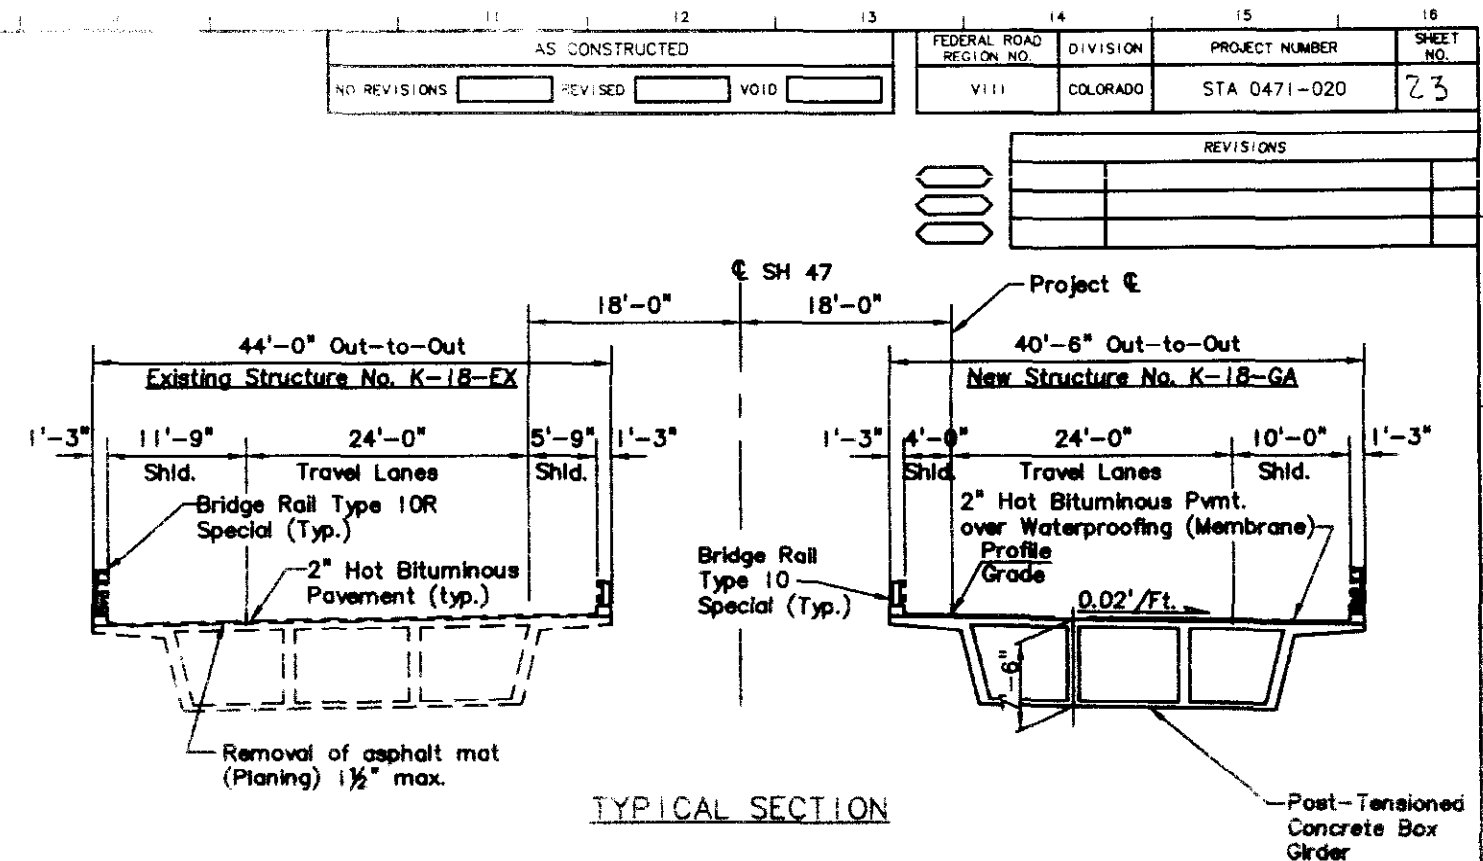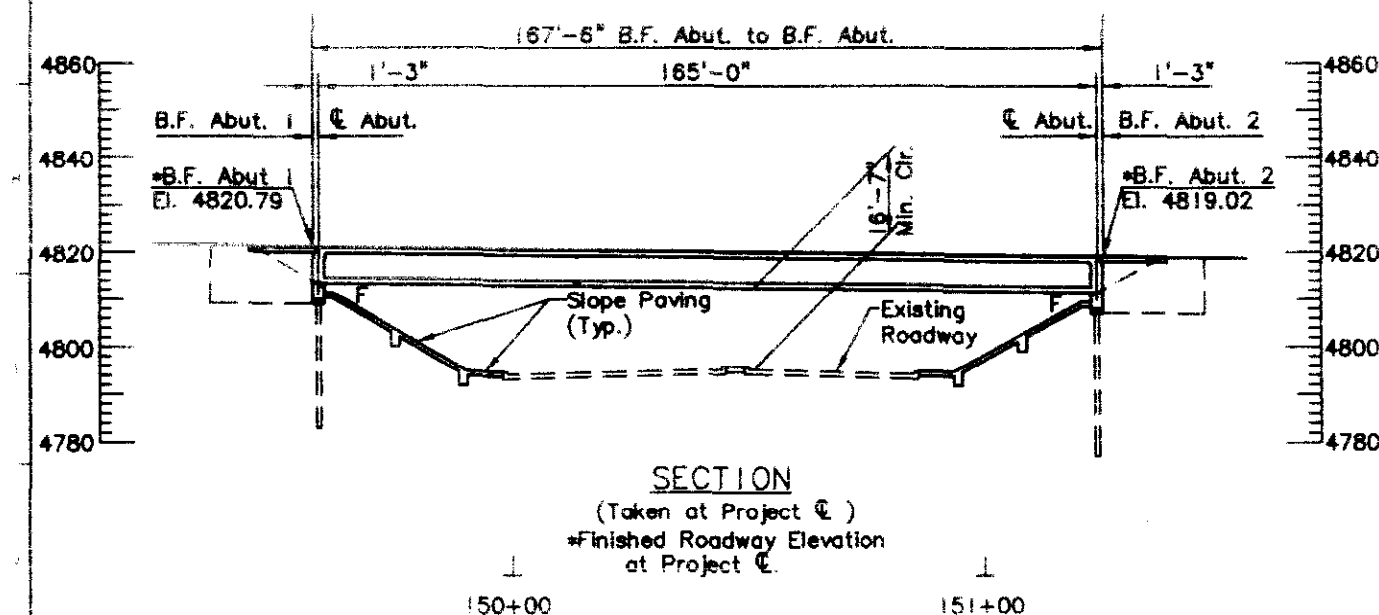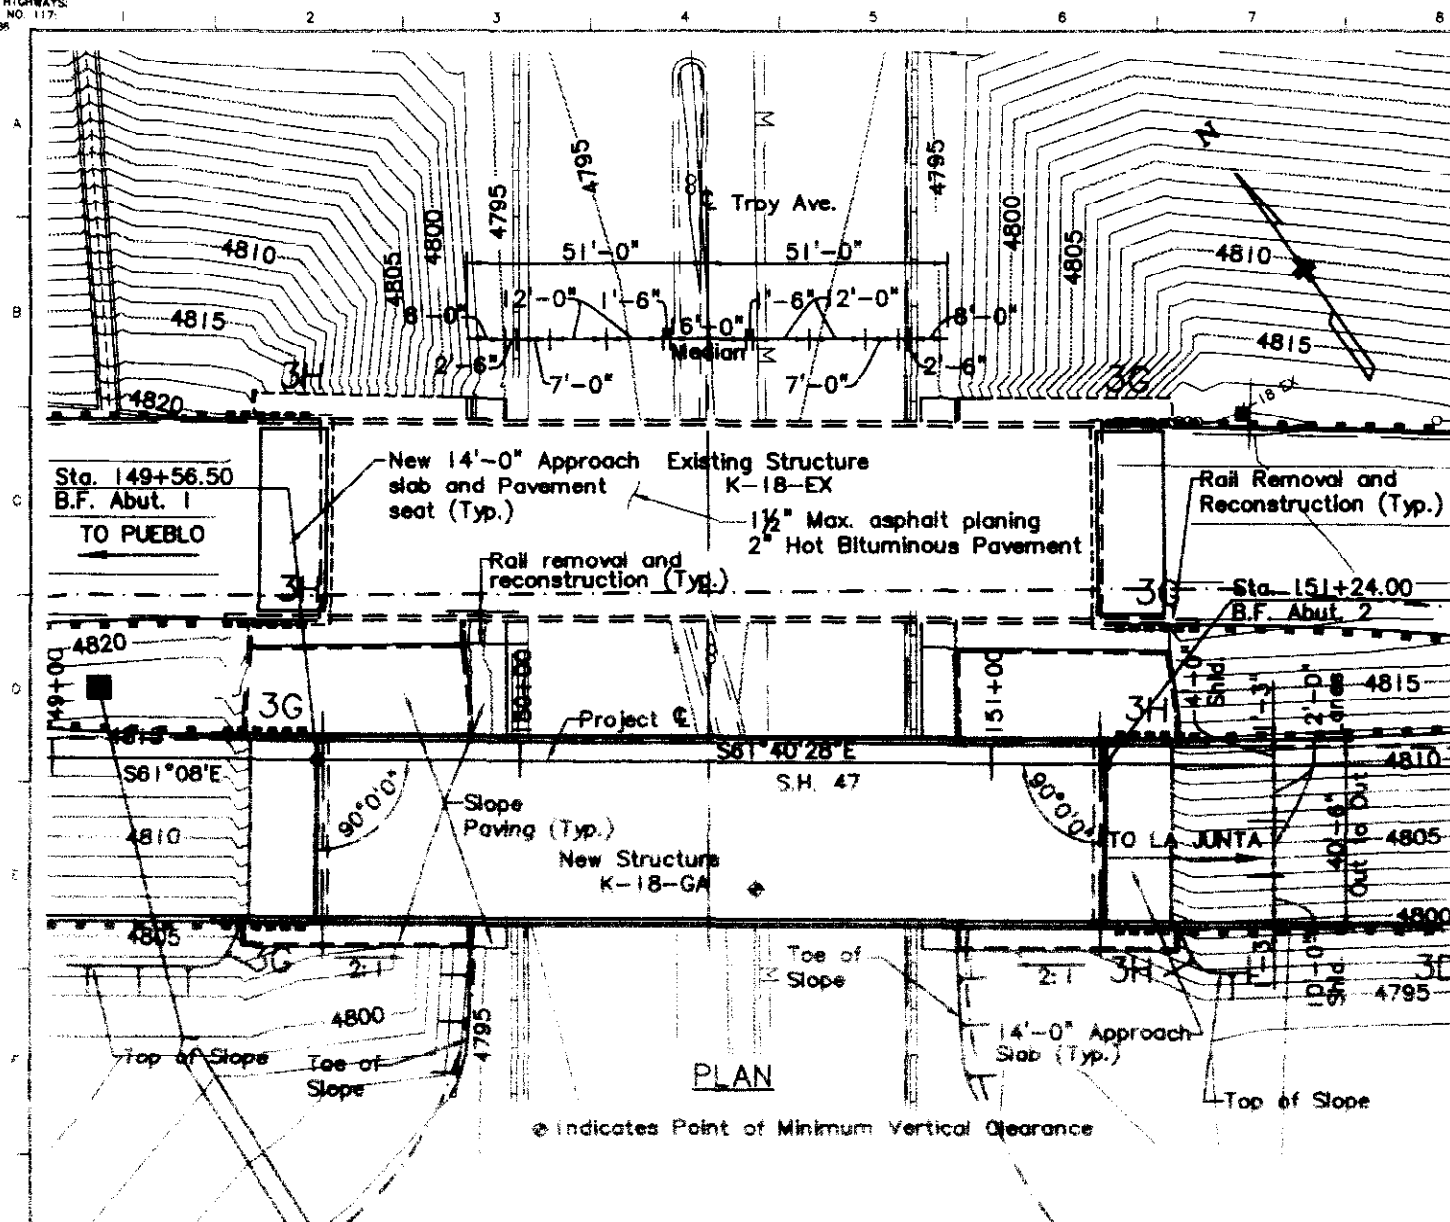


Live Loading: HS-25 and Alternate Military Loading.



DEPARTMENT OF TRANSPORTATION			
S.H. 47 OVER TROY AVENUE PUEBLO, COLORADO			
GENERAL LAYOUT			
Designer	P. Encinas	Structure	K-18-GA
Detailer	T. Rick	Numbers	K-18-EX
Drawing Number	B3	of	31 Drawings

Revision	Dates	(Preliminary Stage Only)
1/4/90		

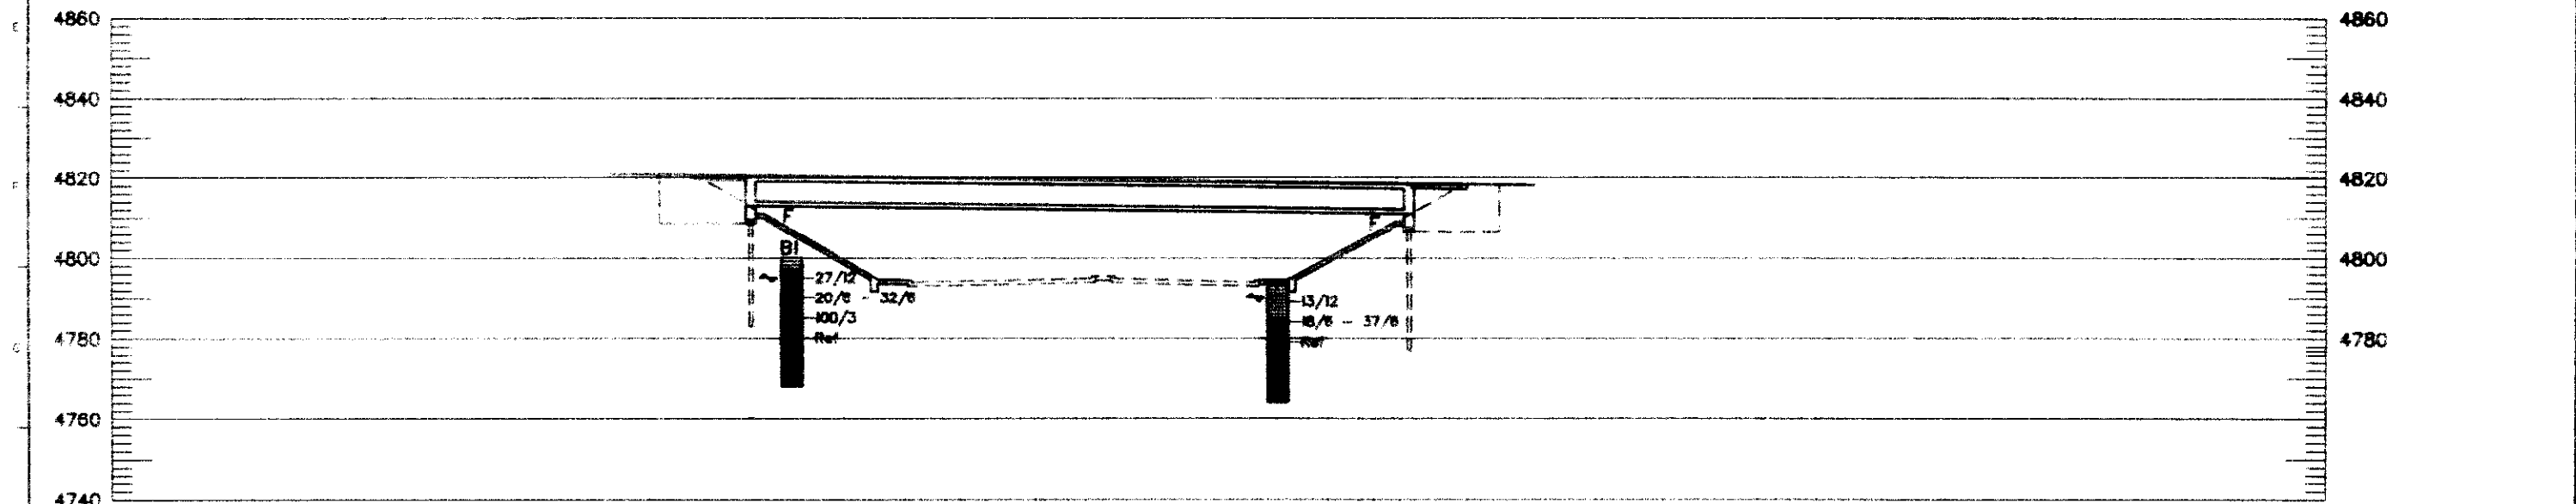

SECTION


Revision Dates	(Preliminary Stage Only)
----------------	--------------------------

VIEW NAME: PW	DRAWING NAME: C:\DATA\718\CAOD\STRUCT\TROY\47BEG01	DATE: 10-24-1995	TIME: 10:17:36
---------------	--	------------------	----------------

AS CONSTRUCTED		
NO REVISIONS	REVISED	VOID


FEDERAL ROAD REGION NO.	DIVISION	PROJECT NUMBER	SHEET NO.
VIII	COLORADO	STA 0471-020	25

REVISIONS	

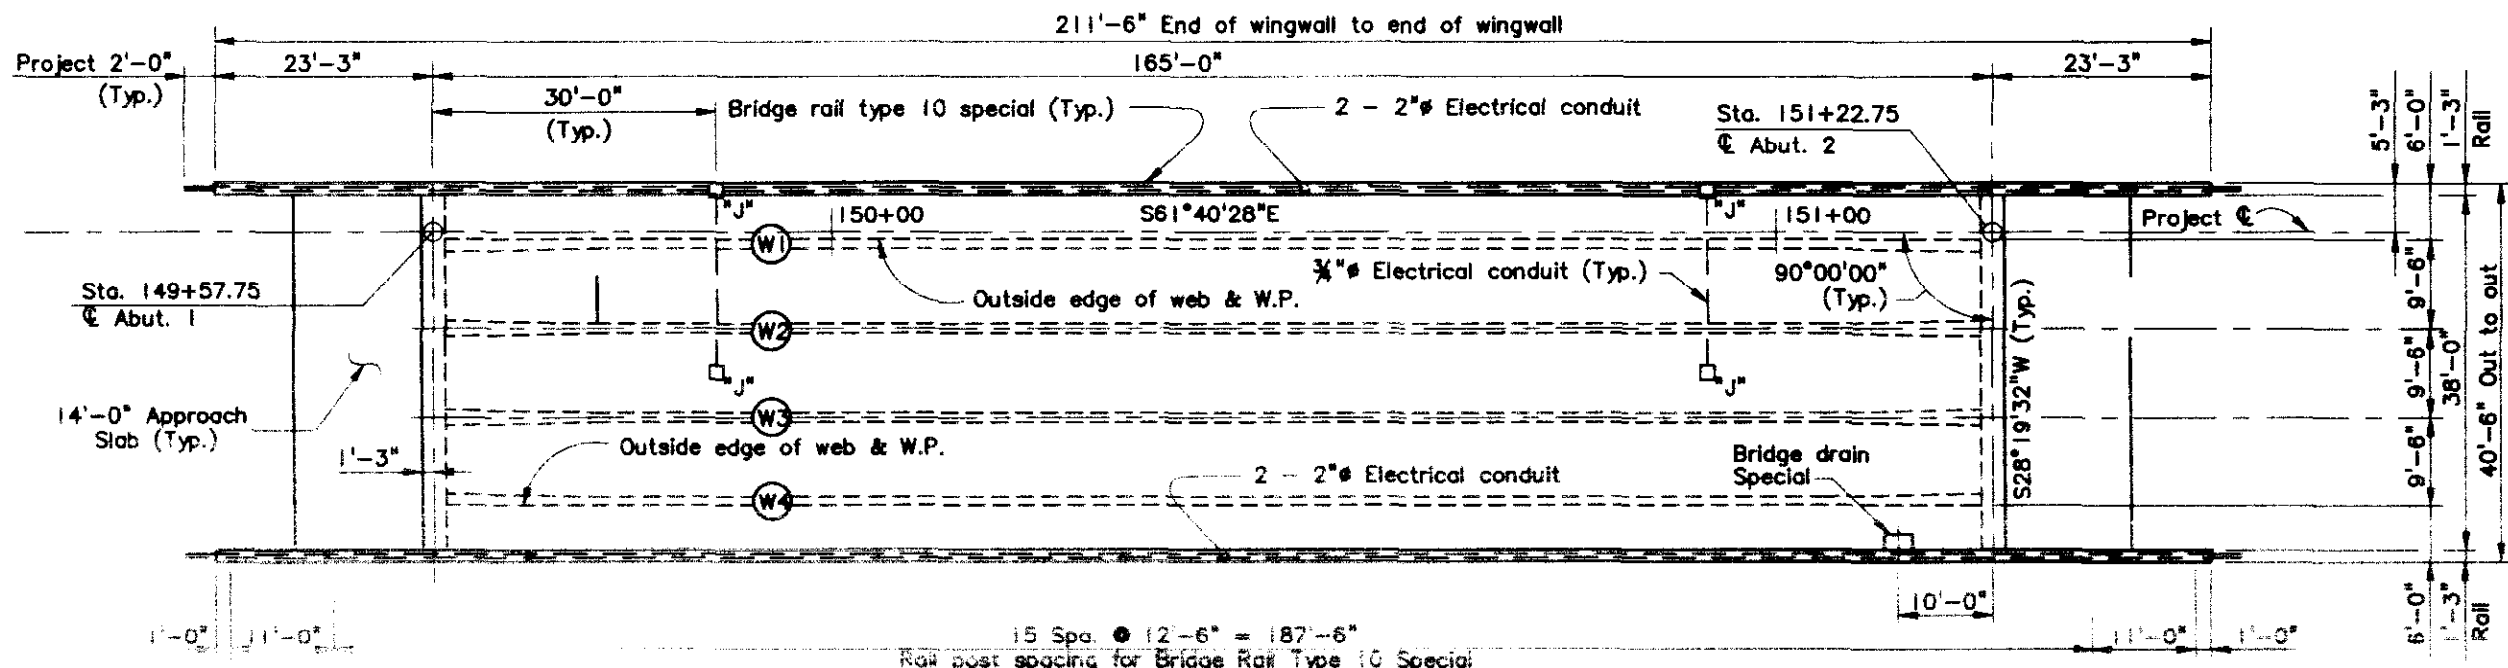

CONSTRUCTION LAYOUT

NOTE: See Dwg. B18 to B21 for bridge rail details

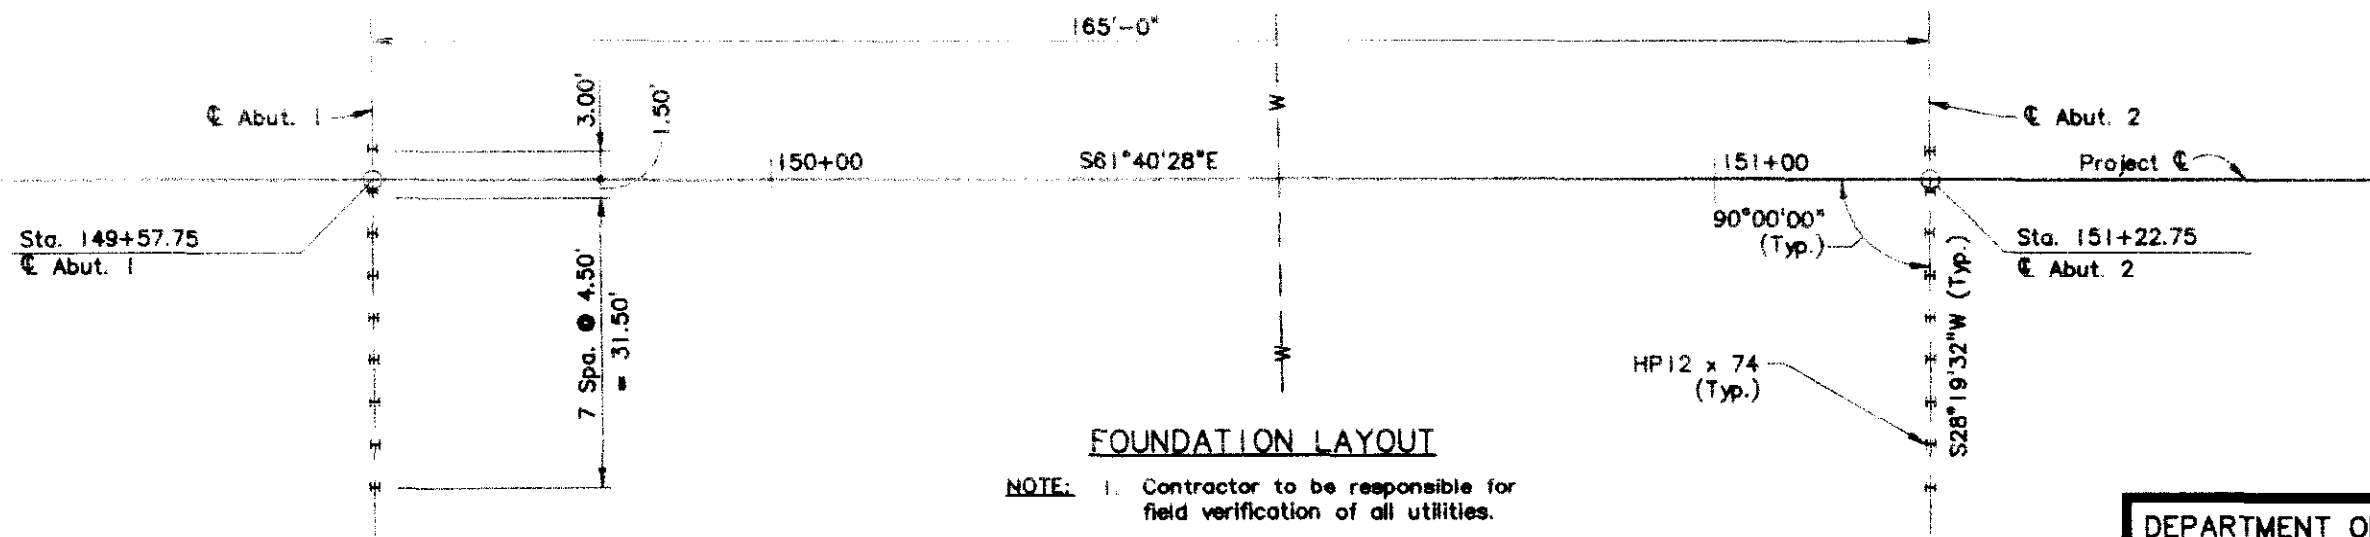

FOUNDATION LAYOUT

- NOTE:
- Contractor to be responsible for field verification of all utilities.
 - "J" = 6"x 6"x 4" junction box flush with bottom of slab. Drain for interior condensation.
 - All piling shall be end bearing HP12x74.
 - All piling shall be driven to a minimum end bearing capacity of 98 tons.

LOCATION	ACTUAL PILE LOAD (Kips)	FACTORED MINIMUM END BEARING (KIPS)	ESTIMATED BEDROCK ELEVATION (FT.)	ESTIMATED TIP ELEVATION (FT.)	ESTIMATED MIN. TIP ELEVATION (FT.)	TOP ELEVATION (FT.)
Abutment 1	194	270	4790.00	4783.00	4786.00	4810.00
Abutment 2	194	270	4784.00	4777.00	4780.00	4808.34





DEPARTMENT OF TRANSPORTATION		
S.H.47 OVER TROY AVENUE PUEBLO, COLORADO		
CONSTRUCTION AND FOUNDATION LAYOUT		
Designer G. Tsouvaras	Structure Numbers	K-18-GA
Detailer G. Tsouvaras	Numbers	
Drawing Number	B5 of 31	Drawings

INITIAL	DATE	BY	DATE
DESIGNED BY	1/2/90	CHKD BY	1/2/90
DRAWN BY	1/2/90	APP'D BY	1/2/90
CHECKED BY	1/2/90	REVIEWED BY	1/2/90
DATE	1/2/90	DATE	1/2/90

AS CONSTRUCTED			
NO REVISIONS	REVISED	VOID	
FEDERAL ROAD REGION NO.	DIVISION	PROJECT NUMBER	SHEET NO.
VIII	COLORADO	STA 0471-020	26
REVISIONS			

NOTE
Concrete Class S (Bridge) may be substituted for Concrete class B (Bridge) at no additional cost.

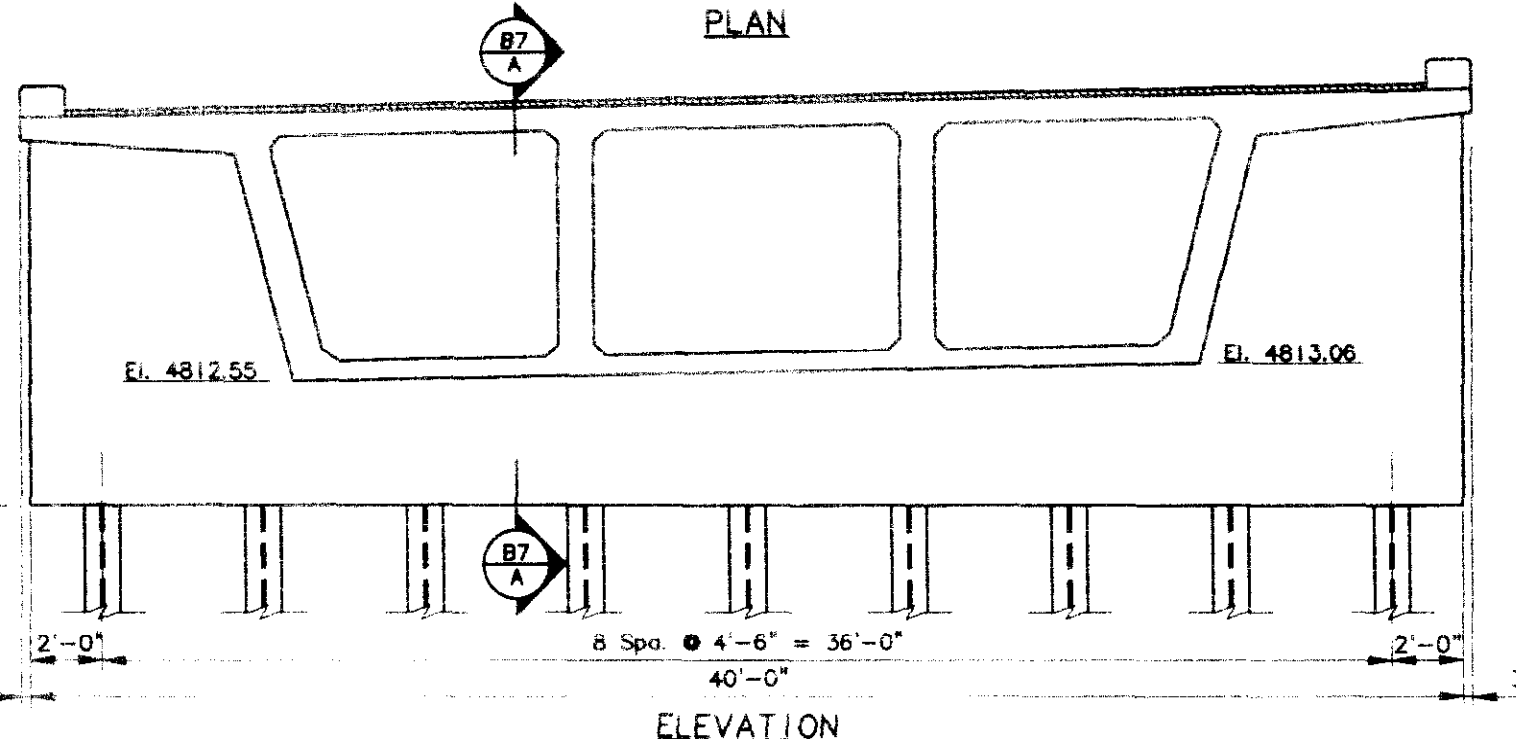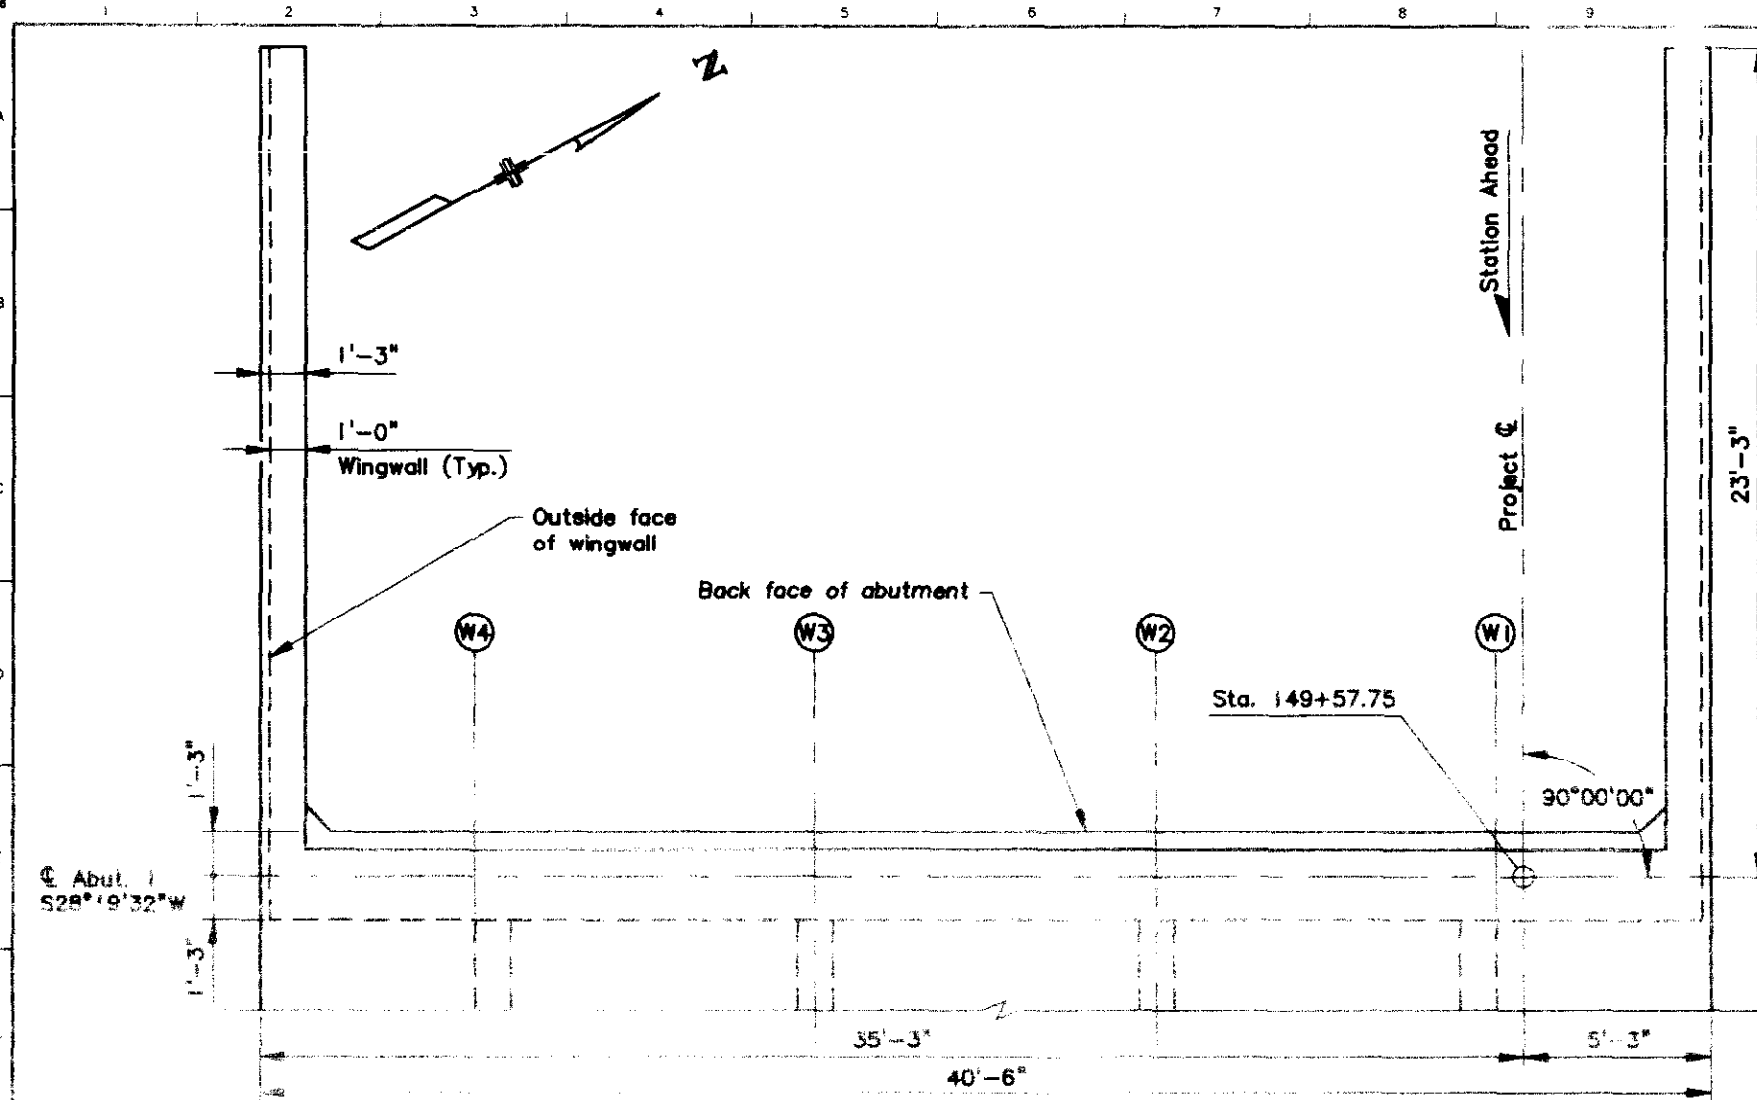


DEPARTMENT OF TRANSPORTATION		
S.H.47 OVER TROY AVENUE PUEBLO, COLORADO		
ABUTMENT I PLAN AND ELEVATION		
Designer G. Tsouvaras	Structure Numbers	K-18-GA
Detaller K. Erickson	Drawings	
Drawing Number 86	of 31	

Revision	Date	By	Remarks
			Preliminary Stage Only

INITIAL	DATE	DESIGNED BY	CHECKED BY	DATE	DESIGNED BY	CHECKED BY	DATE

AS CONSTRUCTED			FEDERAL ROAD REGION NO.	DIVISION	PROJECT NUMBER	SHEET NO.
NO REVISIONS	REVISED	VOID	VIII	COLORADO	STA 0471-02-	27

REVISIONS			

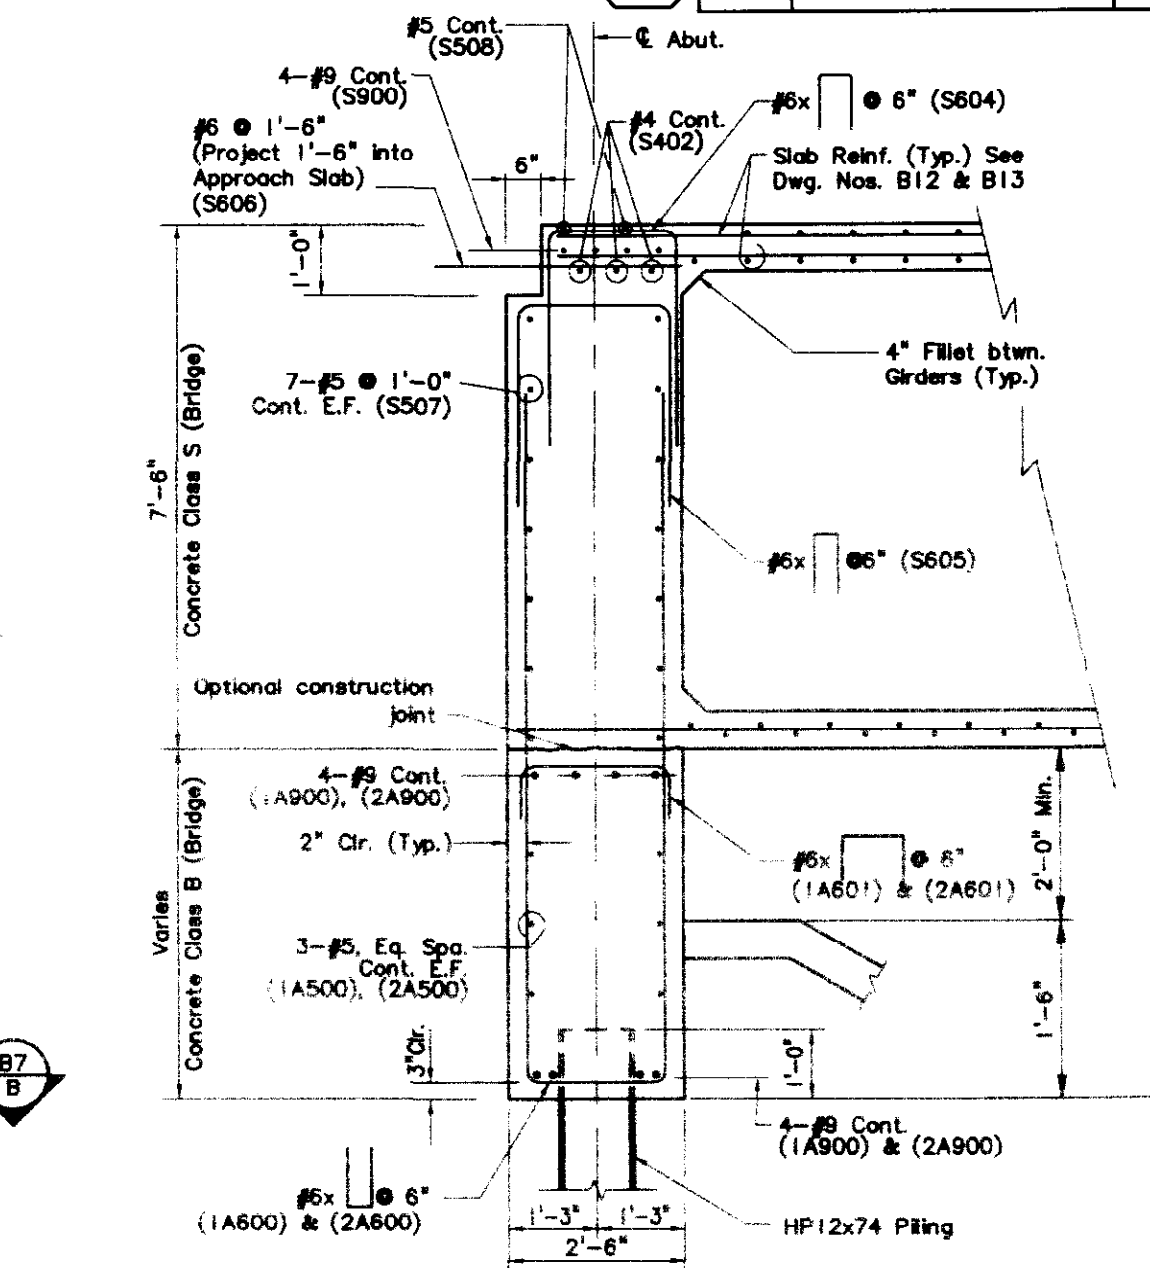

DEPARTMENT OF TRANSPORTATION
S.H.47 OVER TROY AVENUE
PUEBLO, COLORADO

**ABUTMENT I
REINFORCEMENT**


Designer G. Tsilouvaras	Structure Numbers	K-18-GA
Detailer K. Erickson	Drawings	

Drawing Number B7 of 31

BRW INC. 1225 LAWRENCE ST., SUITE 200, DENVER, CO 80202

PLANNING
TRANSPORTATION
ENGINEERING
URBAN DESIGN

Revision	Date	By	Check	Notes


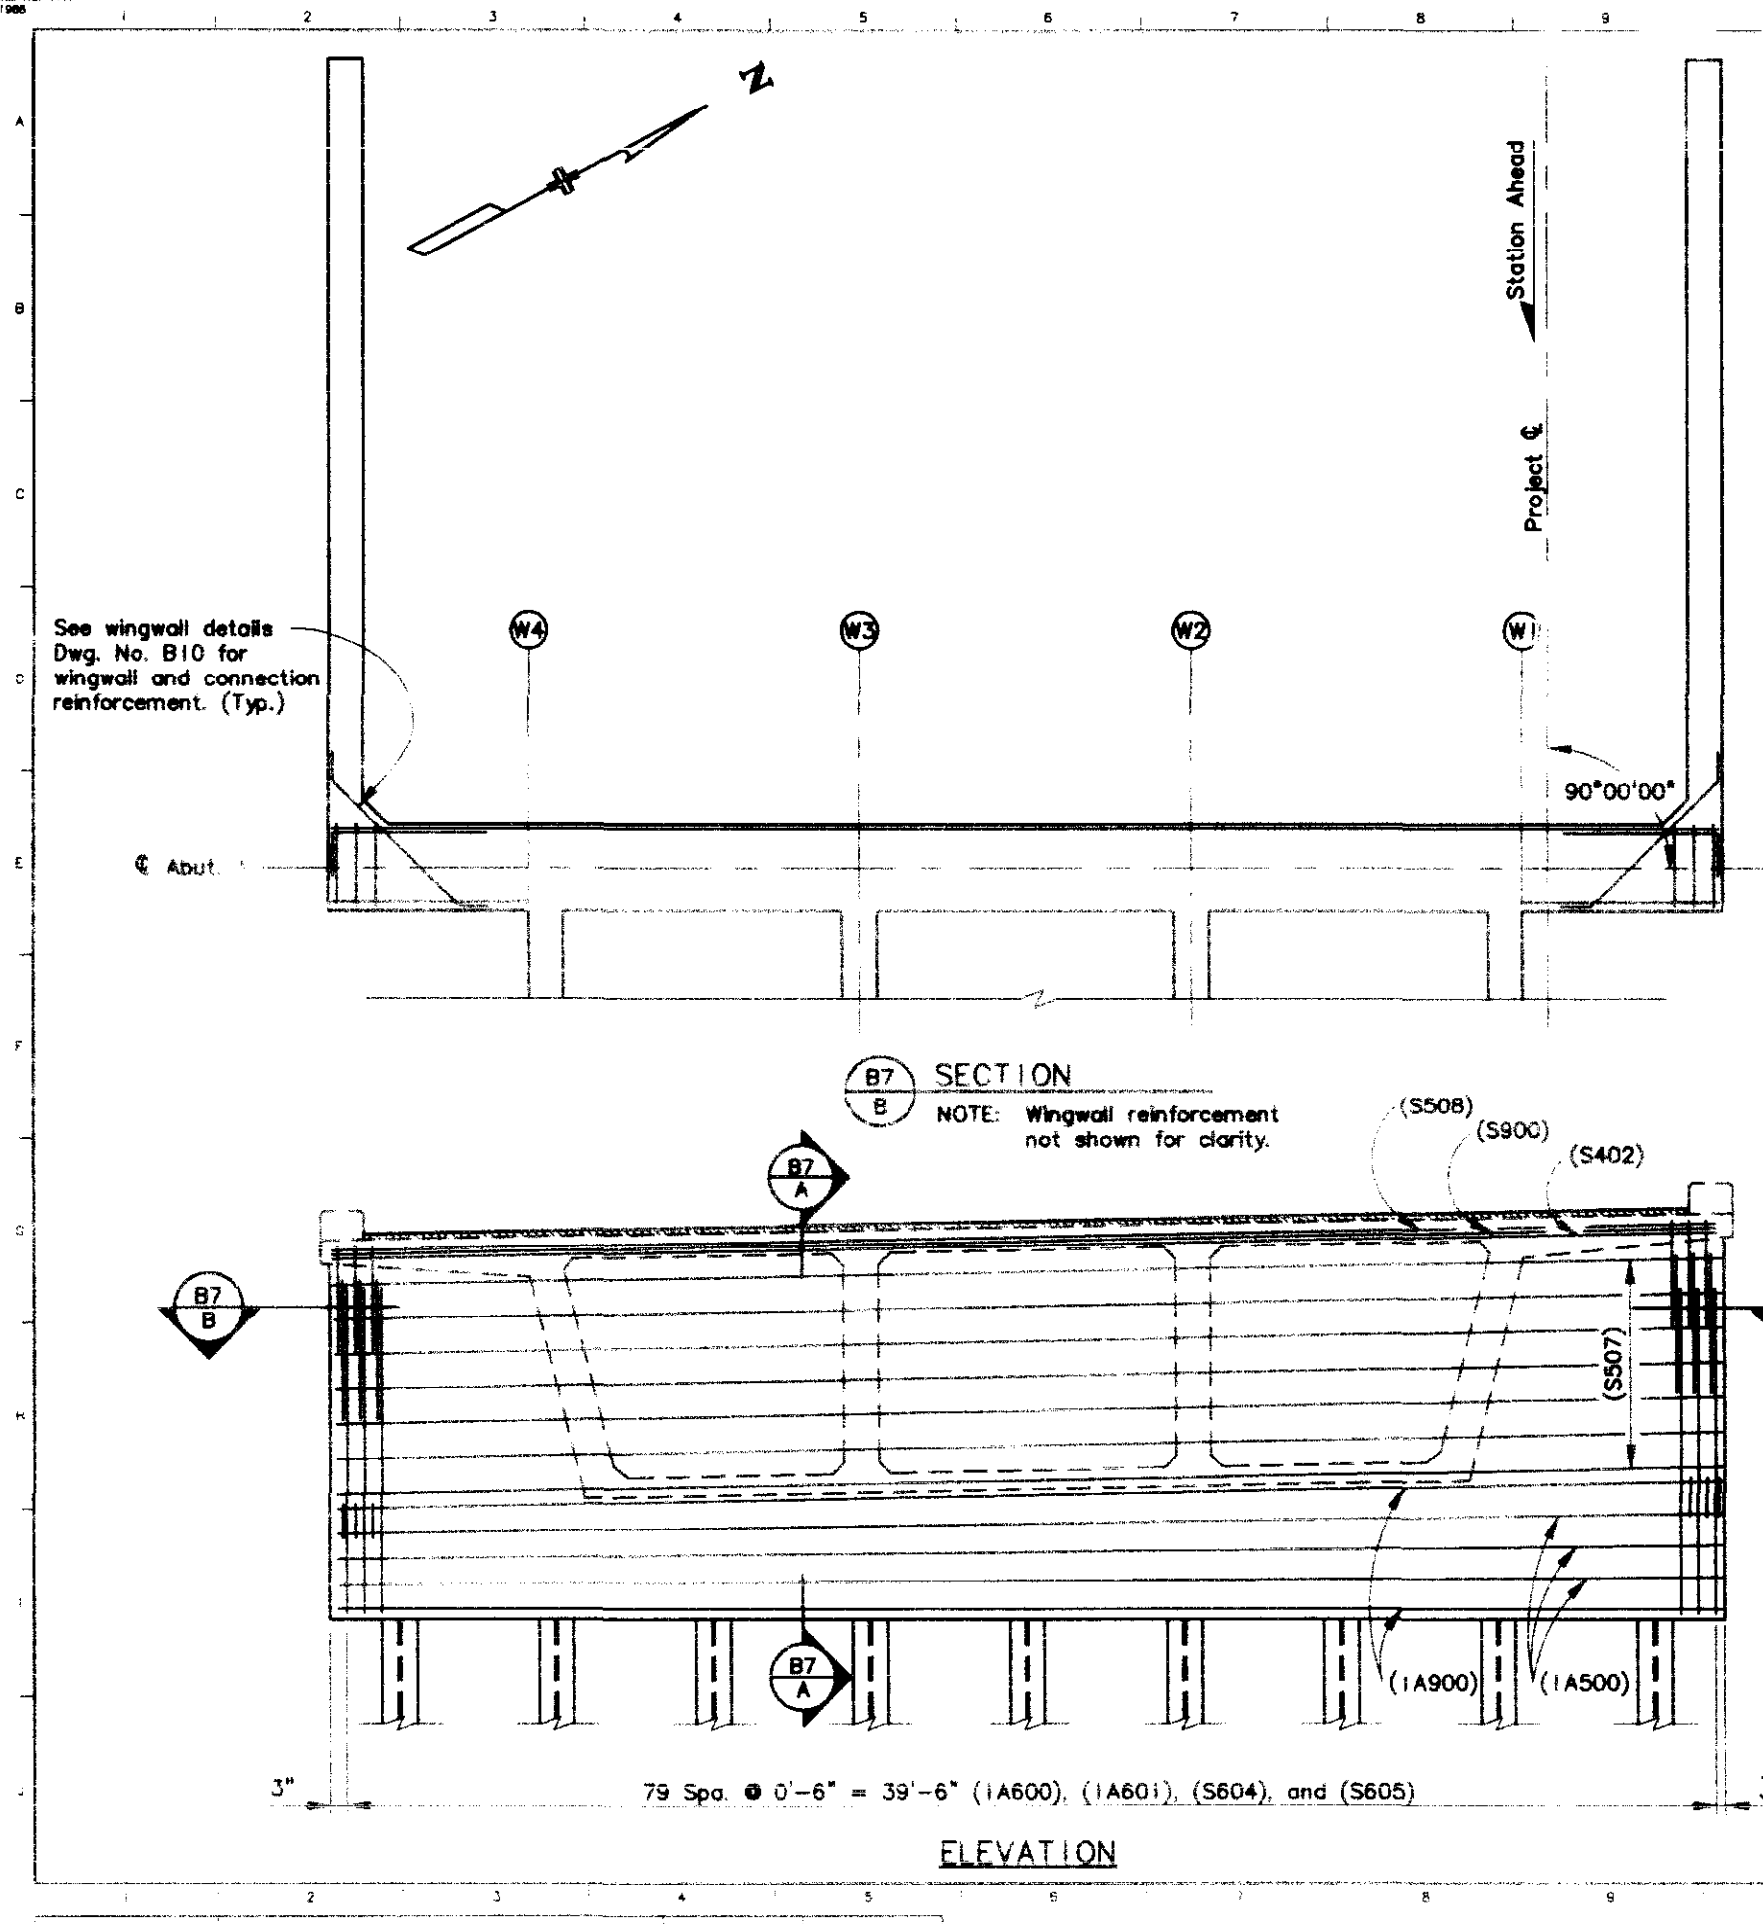


SECTION
NOTE: Wingwall reinforcement not shown for clarity.

ELEVATION

79 Spa. @ 0'-6" = 39'-6" (1A600), (1A601), (S604), and (S605)

DESIGNED BY	CHECKED BY	DATE	INITIAL	DATE	INITIAL
BY	BY	1/28	BY	BY	1/28
BY	BY	1/28	BY	BY	1/28
BY	BY	1/28	BY	BY	1/28
BY	BY	1/28	BY	BY	1/28

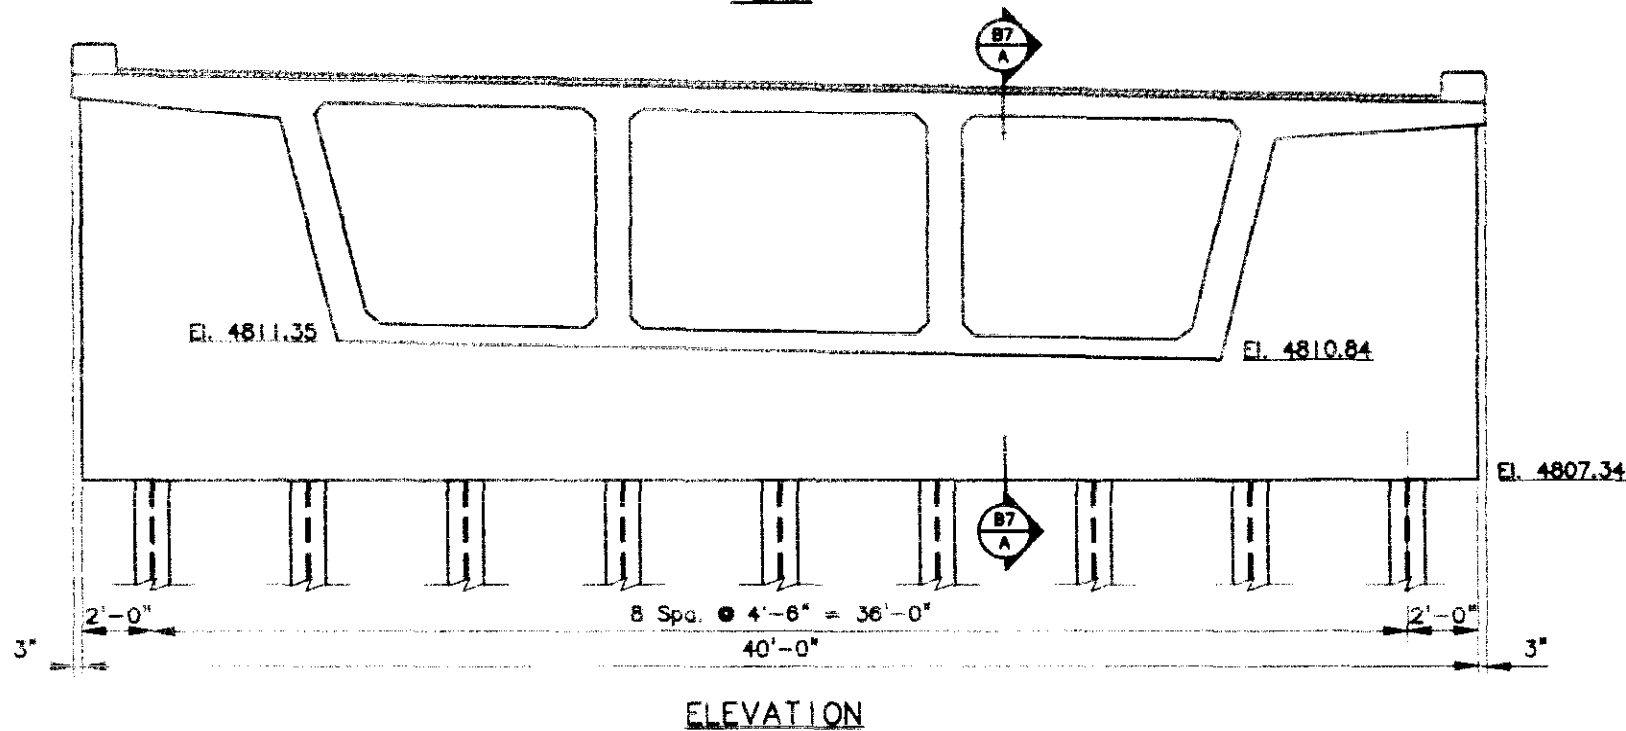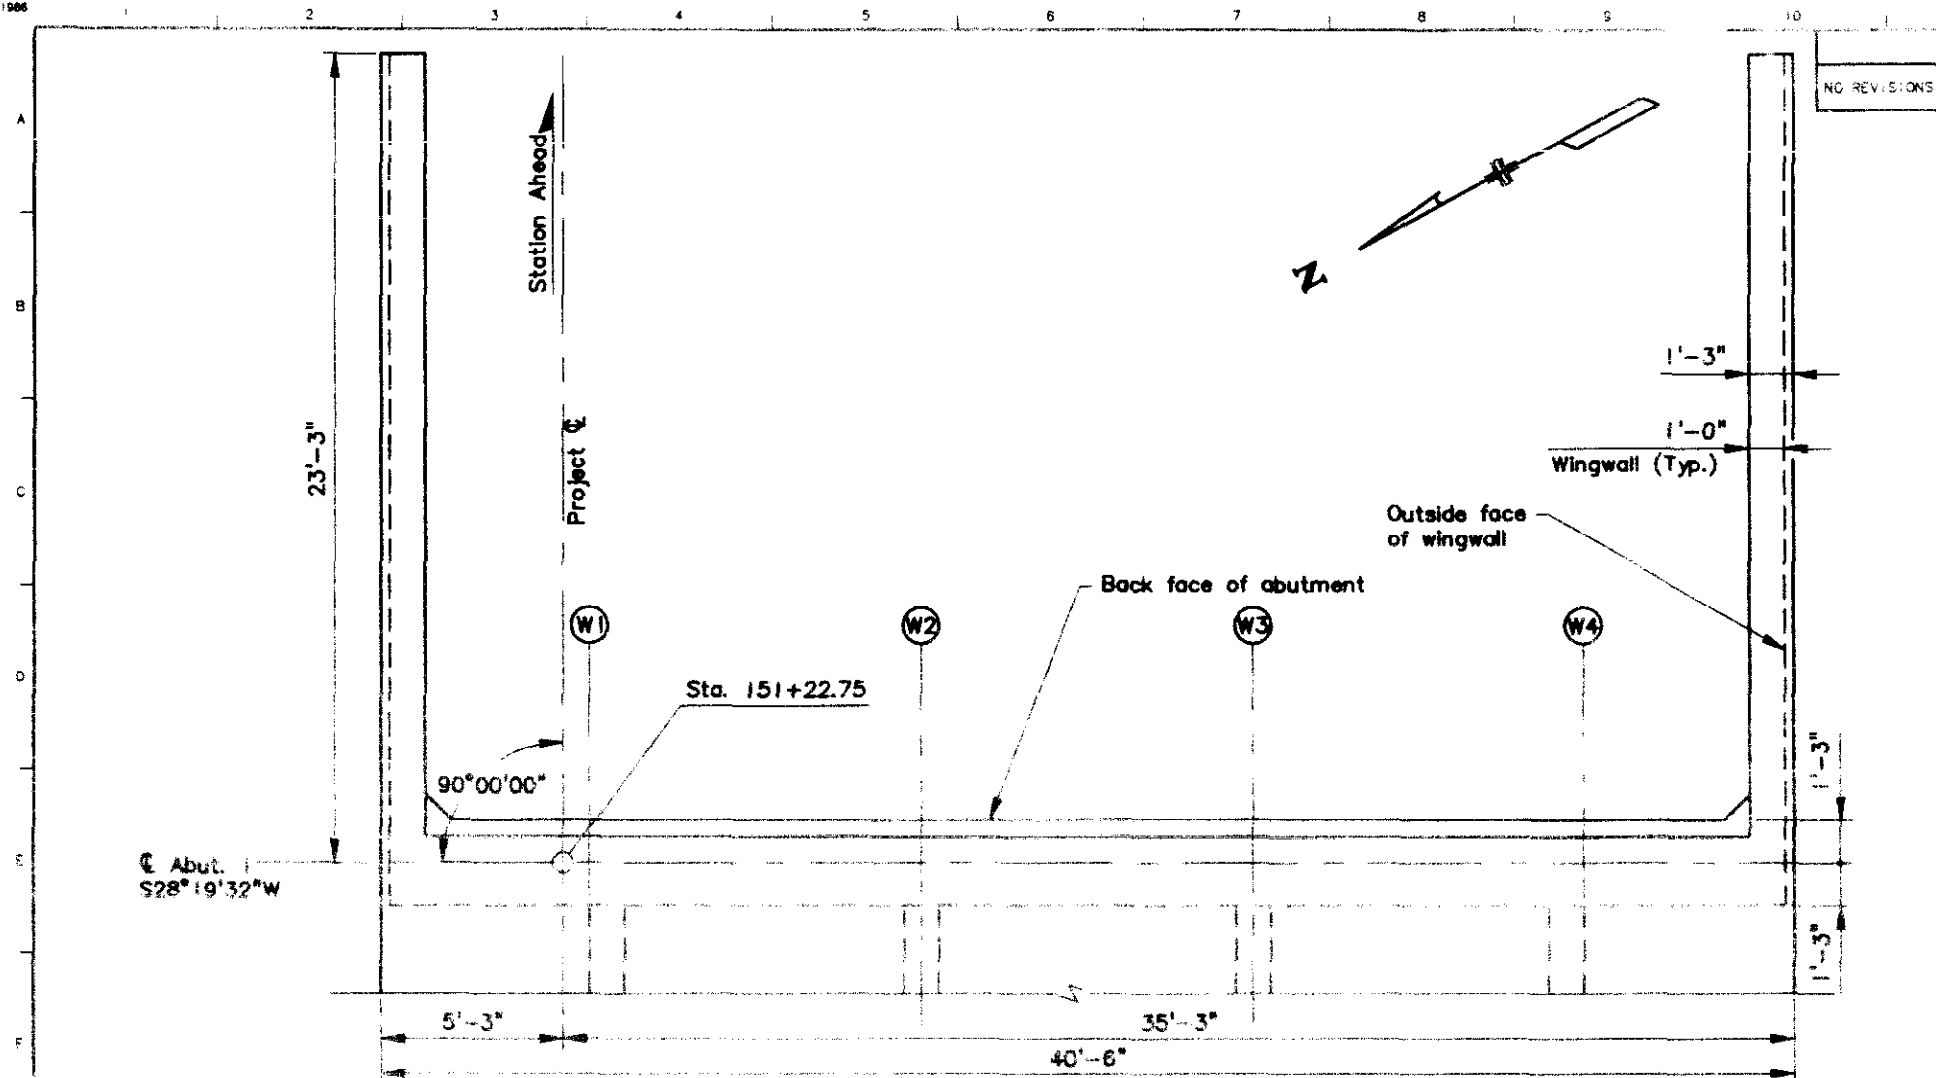

AS CONSTRUCTED		
NO REVISIONS	REVISED	VOID

FEDERAL ROAD REGION NO.	DIVISION	PROJECT NUMBER	SHEET NO.
VIII	COLORADO	STA 0471-020	28

REVISIONS	

DEPARTMENT OF TRANSPORTATION		
S.H.47 OVER TROY AVENUE PUEBLO, COLORADO		
ABUTMENT 2 PLAN AND ELEVATION		
Designer G. Tsikouras	Structure	K-18-GA
Detailer K. Erickson	Numbers	
Drawing Number	B8 of 31	Drawings




Revision Dates (Preliminary Stage Only)

DESIGNED BY	CHECKED BY	INITIAL DATE	DESIGNED BY	CHECKED BY	INITIAL DATE
WJ	WJ	1/2/85	WJ	WJ	1/2/85
WJ	WJ	1/2/85	WJ	WJ	1/2/85
WJ	WJ	1/2/85	WJ	WJ	1/2/85
WJ	WJ	1/2/85	WJ	WJ	1/2/85

AS CONSTRUCTED			FEDERAL ROAD REGION NO.	DIVISION	PROJECT NUMBER	SHEET NO.
NO REVISIONS	REVISED	VOID	VIII	COLORADO	STA 0471-020	29


REVISIONS	

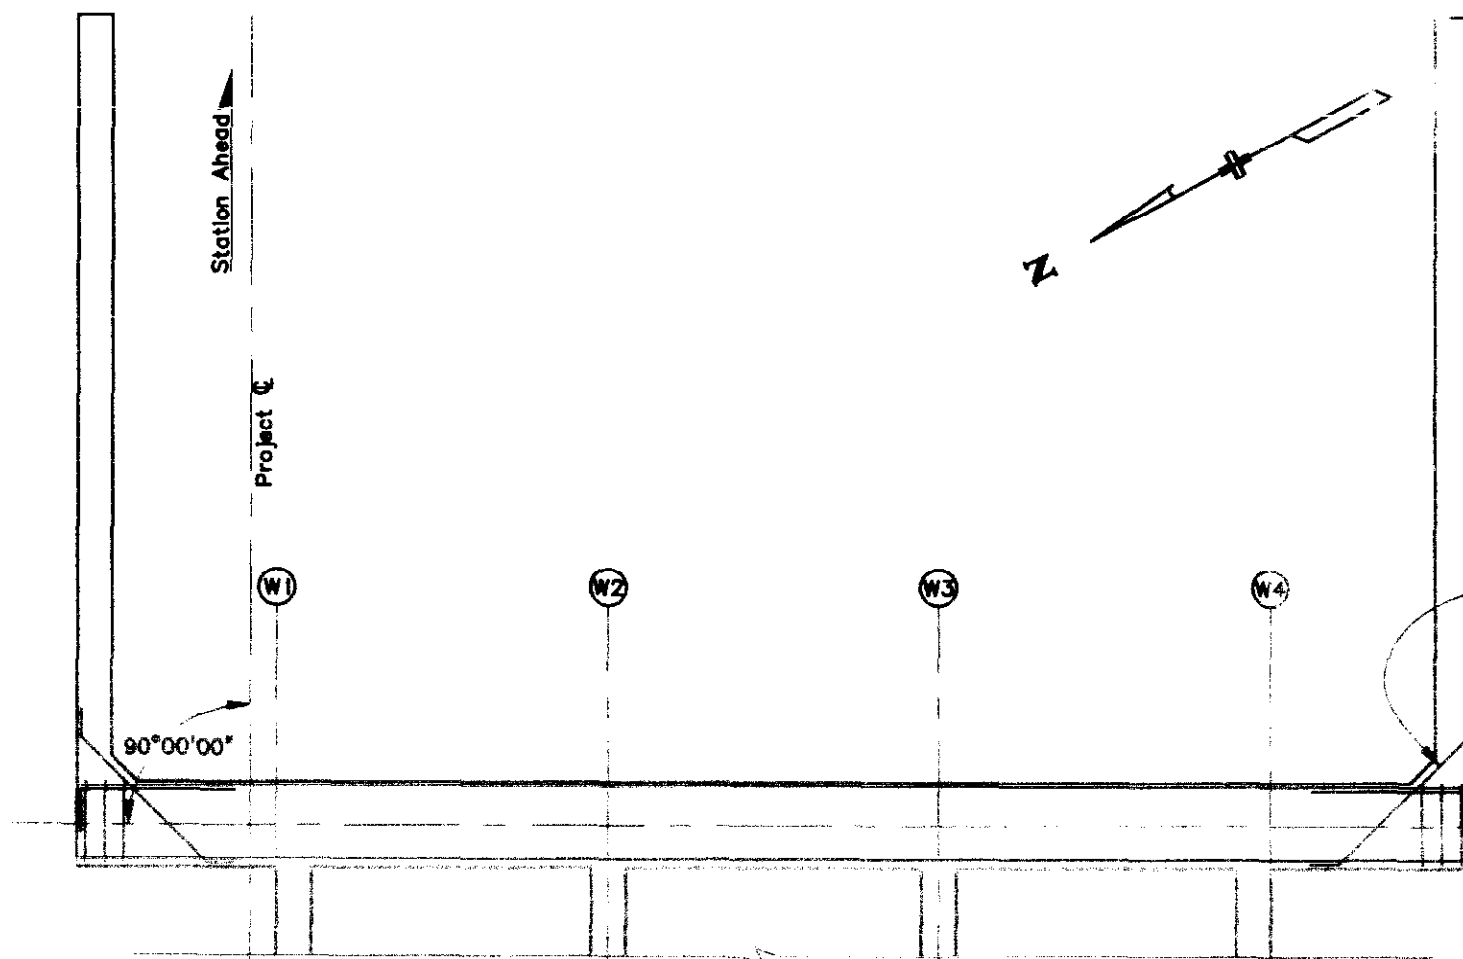

See wingwall details
Dwg. No. B10 for
wingwall and connection
reinforcement. (Typ.)

Abut. 2

B9 SECTION
NOTE: Wingwall reinforcement
not shown for clarity.

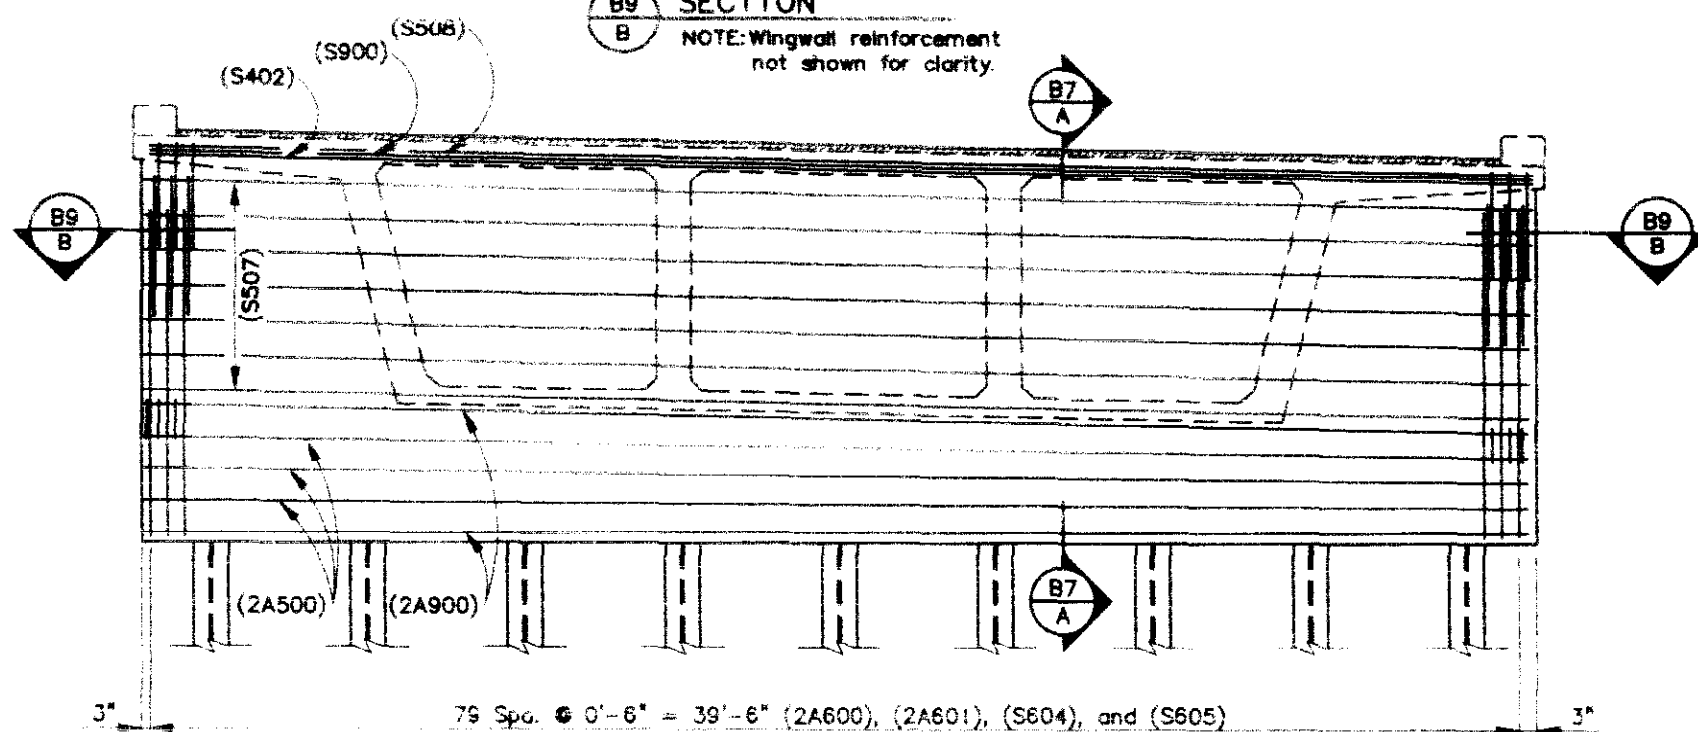

ELEVATION



DEPARTMENT OF TRANSPORTATION			
S.H. 47 OVER TROY AVENUE PUEBLO, COLORADO			
ABUTMENT 2 REINFORCEMENT			
Designer G. Tsouvaras	Structure	K-18-GA	
Detailer K. Erickson	Numbers		
Drawing Number	89 of 31	Drawings	

Revision Dates	(Preliminary Stage Only)
----------------	--------------------------


INITIAL	DATE	DESIGNED BY	CHECKED BY	DATE	DESIGNED BY	CHECKED BY	DATE

FEDERAL ROAD REGION NO.	DIVISION	PROJECT NUMBER	SHEET NO.
VIII	COLORADO	STA 0471-020	30


REVISIONS	

Note: The Class S portion of the Concrete in Wingwalls shall be placed Monolithic with the Deck.


LOCATION	EL. A	EL. B	EL. C
IN	4820.92	4820.72	4809.00
IS	4820.11	4819.91	4809.00
2N	4818.65	4818.98	4807.34
2S	4817.84	4818.17	4807.34

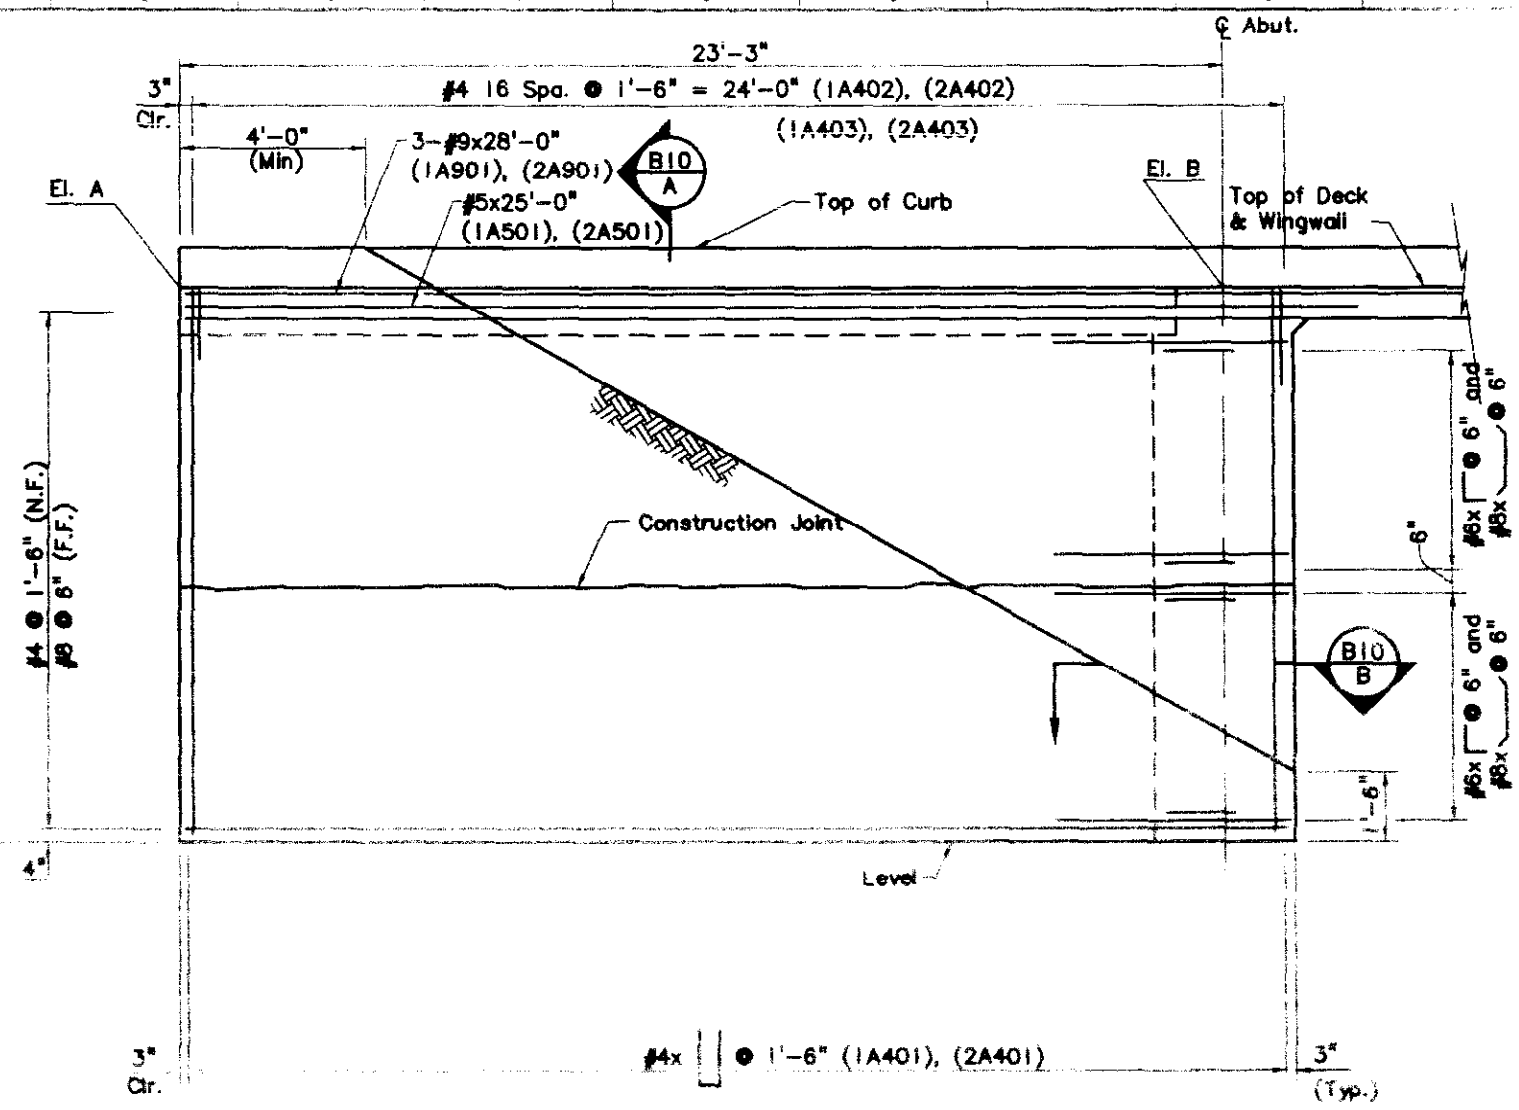


WINGWALL ELEVATION

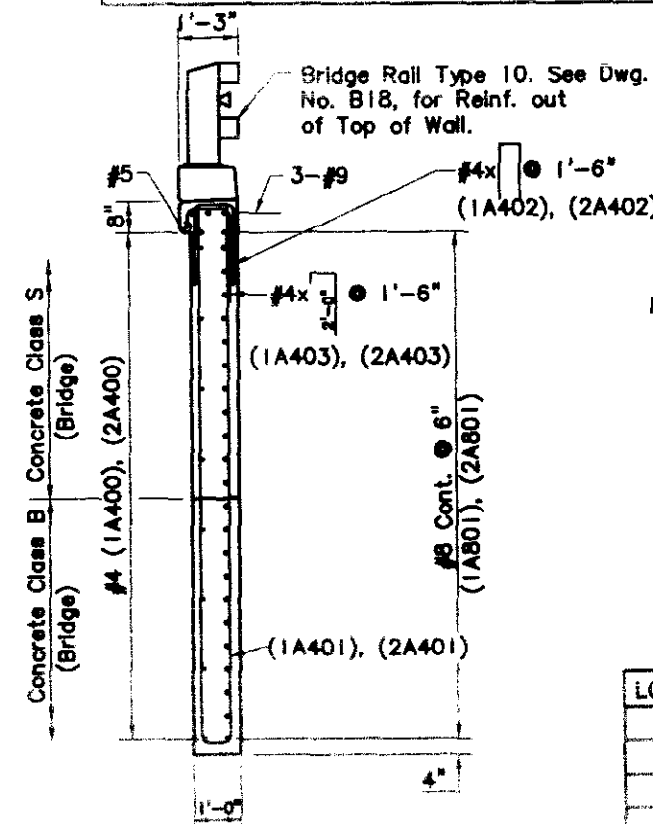

SECTION

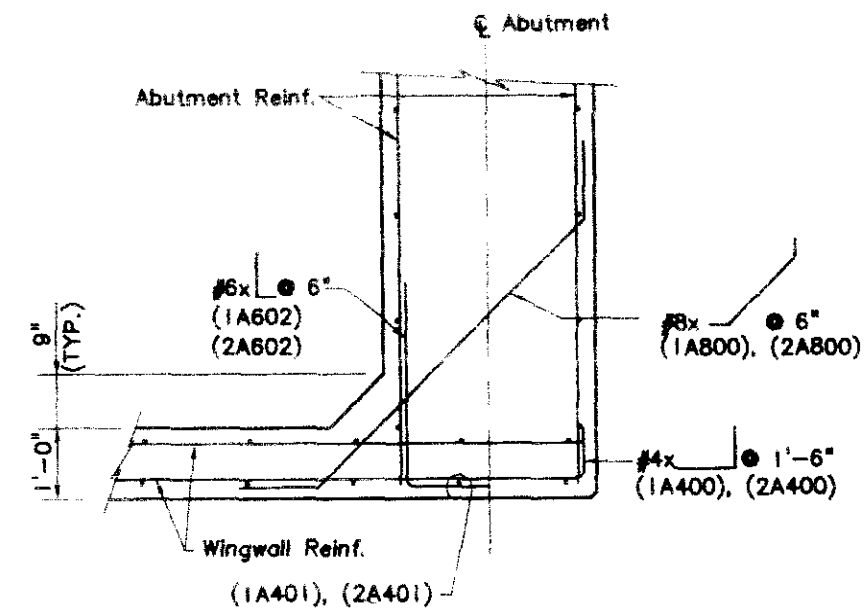

SECTION

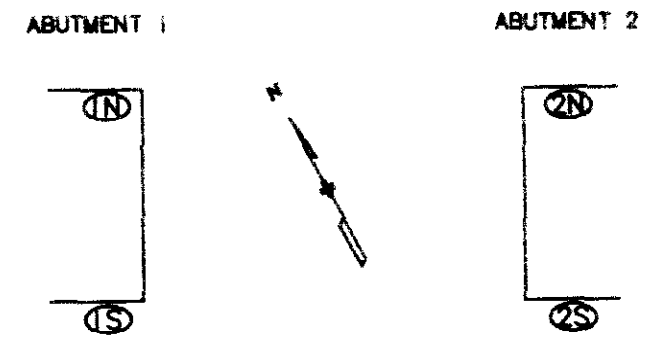

WINGWALL KEY PLAN

DEPARTMENT OF TRANSPORTATION
S.H.47 OVER TROY AVENUE
PUEBLO, COLORADO

ABUTMENT WINGWALLS
AND REINFORCEMENT

Designer G. Tsalouvardas
Detailer K. Erickson
Drawing Number B10 of 31 Drawings


Structure Numbers K-18-GA




AS CONSTRUCTED
NO REVISIONS ☐ REVISED ☐ VOID ☐

FEDERAL ROAD REGION NO. VIII	DIVISION COLORADO	PROJECT NUMBER STA 0471-020	SHEET NO. 31
------------------------------------	----------------------	--------------------------------	--------------------

REVISIONS

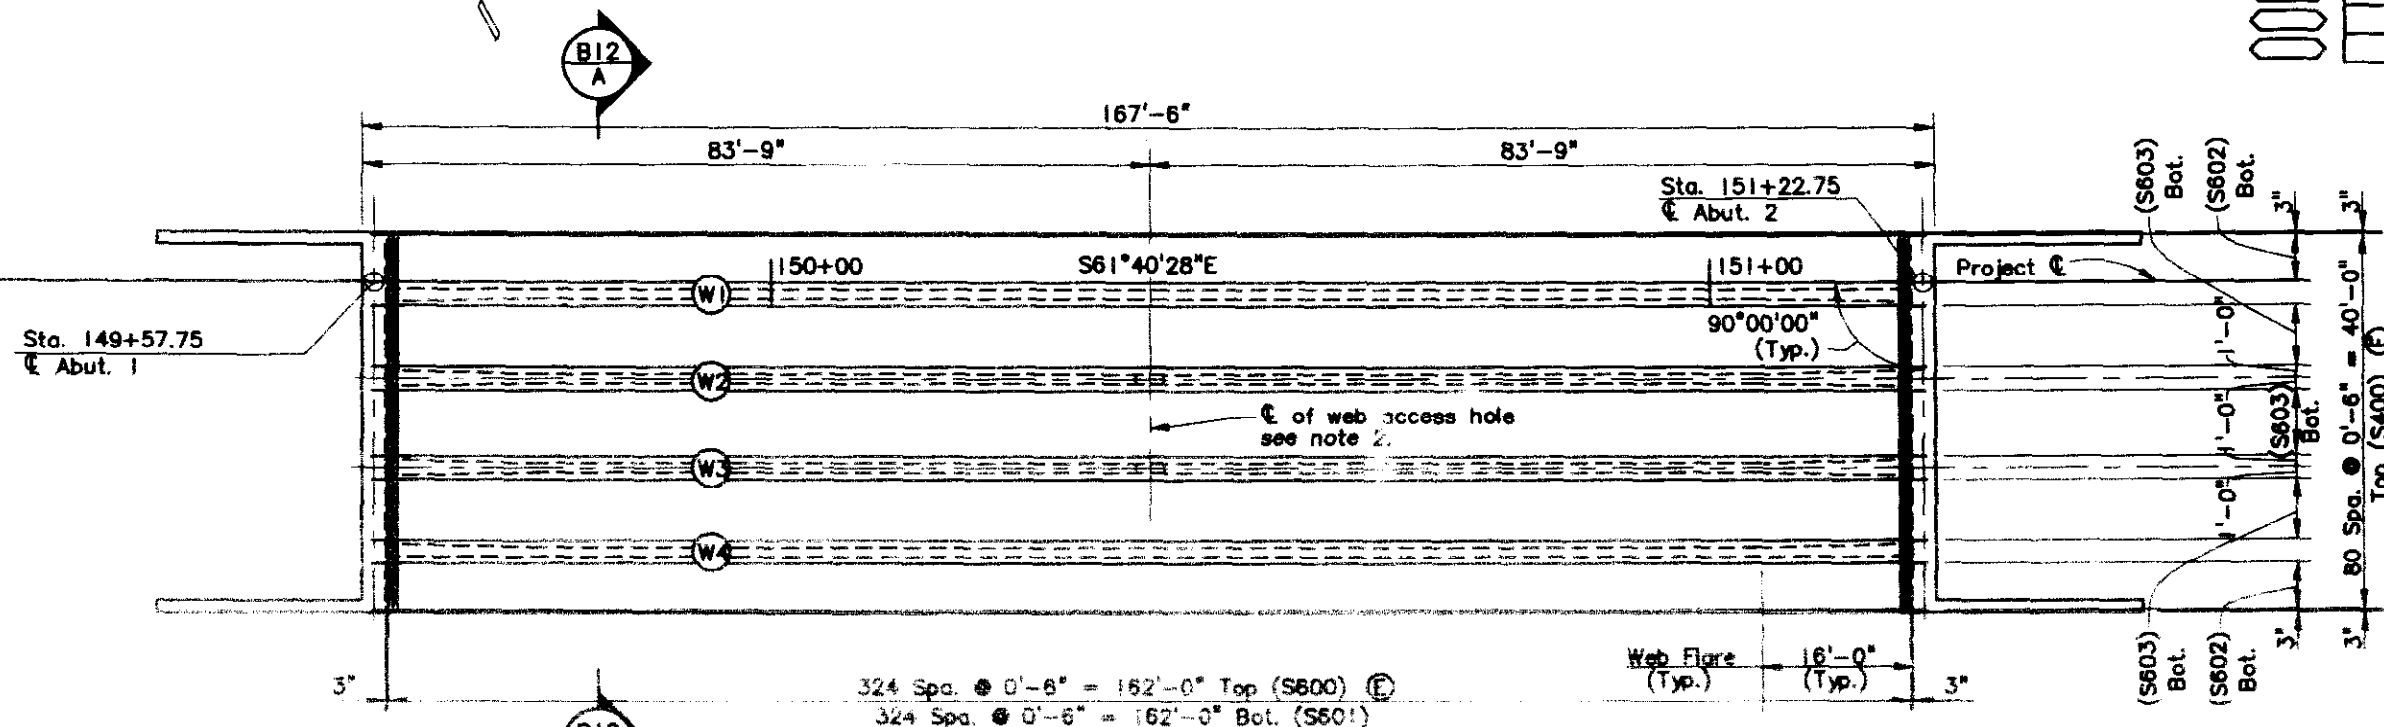

TOP DECK REINFORCING PLAN

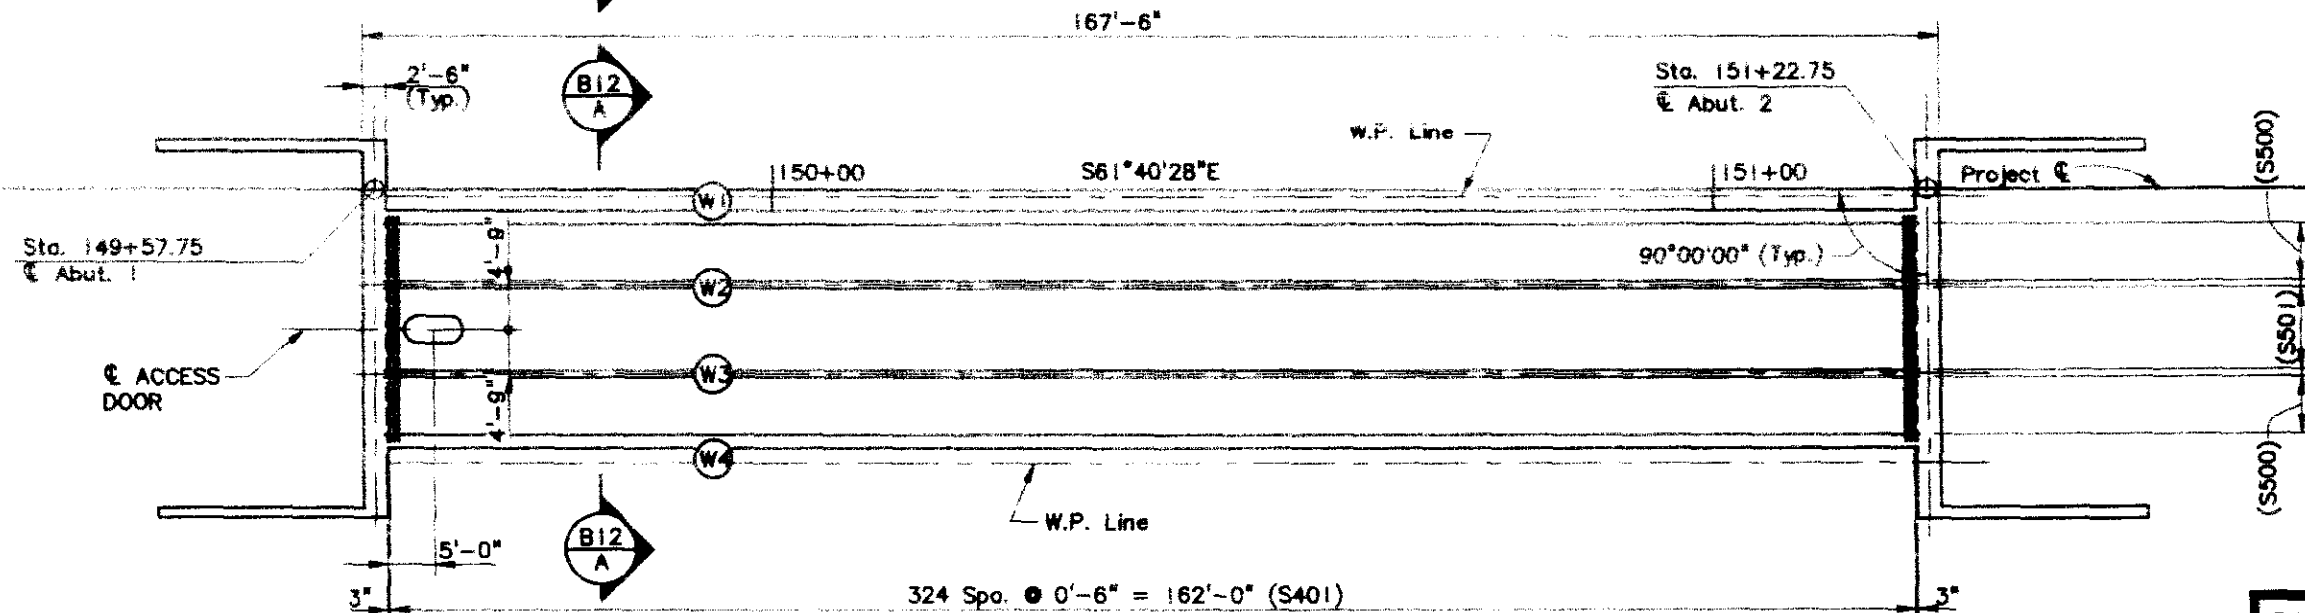

BOTTOM DECK REINFORCING PLAN


- Notes:
1. Stagger all splices.
 2. For web access hole dimensions and reinforcement see access door details Dwg. No. B14.

DEPARTMENT OF TRANSPORTATION			
S.H.47 OVER TROY AVENUE PUEBLO, COLORADO			
SUPERSTRUCTURE DECK REINFORCEMENT PLAN			
Designer G. Tsakouvaras	Structure Numbers	K-18-GA	
Detailer K. Erickson	Numbers		
Drawing Number	B11 of 31	Drawings	




INITIAL	DATE	DESIGNED BY	CHECKED BY	DATE	DESIGNED BY	CHECKED BY	DATE	DESIGNED BY	CHECKED BY	DATE

DESIGNED BY	DATE	INITIALS	CHECKED BY	DATE	INITIALS	REVIEWED BY	DATE	INITIALS

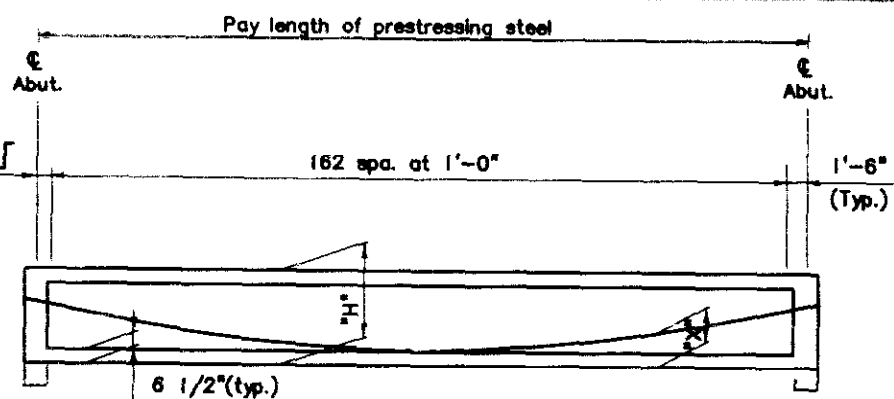

Point	1.00	1.10	1.20	1.30	1.40	1.50	1.60	1.70	1.80	1.90	2.00
H	7.50	7.50	7.50	7.50	7.50	7.50	7.50	7.50	7.50	7.50	7.50
X	4.50	3.30	2.38	1.71	1.31	1.18	1.31	1.71	2.38	3.30	4.50
Deflection	0.00'	0.09	0.17	0.24	0.28	0.29	0.28	0.24	0.17	0.09	0.00'

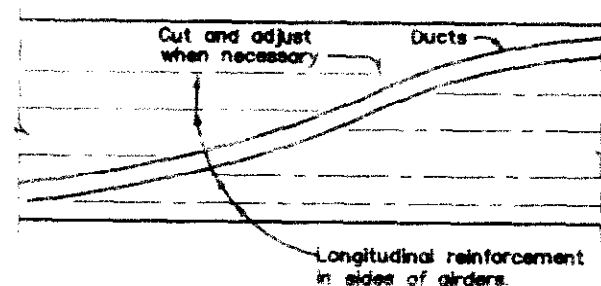

ADJUSTED GIRDER REINFORCING ELEVATION

CRITICAL POINT	KL+ ΔC	INITIAL STRESS RATIO
1.5	0.037	.964
2.000	0.073	.930

AS CONSTRUCTED		FEDERAL ROAD REGION NO.	DIVISION	PROJECT NUMBER	SHEET NO.
NO REVISIONS	REVISED	VIII	COLORADO	STA 0471-020	33

B-618-1
(use with B-618-2 and B-618-3)

NOTES:

Reinforcing that interferes with the prestressing tendon alignment shall be adjusted as approved by the Engineer.

Where dead end anchorage and tendons are accessible, the anchorage system and length of projecting prestressing steel shall permit jacking with the same jacking equipment that was used on the live end.

Deviations from the duct pattern, duct size, and strand size assumed in the design must be approved by the Engineer. Duct patterns 1 and 2 are the only acceptable patterns.

The deflection shown is positive downward. It includes the instantaneous effects of dead load and prestressing, and a factor of three (3) multiplier to account for long term creep. Formed web elevations must be adjusted upward for the indicated positive deflection.

Use stress relieved or low-relaxation strands meeting the requirements of ASTM A416 grade 270.

STRESSING SEQUENCE:

Tendons may be jacked from both ends, either simultaneously or sequentially, or 1/2 the tendons may be jacked from each end. If jacking force or steel area is greater than assumed in the design, prestressing quantities shall not be adjusted.

No more than 1/2 of the prestressing force in any web may be stressed before an equal force is stressed in the adjacent webs. At no time during the stressing operations will more than 1/8 of the total prestressing force be applied eccentrically about the centerline of the structure.

At the Contractor's option, the prestressing force may vary ±5% from the theoretical force per web provided the total P(JACK) force is obtained and is distributed symmetrically about the centerline of the typical section. P(JACK) is the sum of the peak forces reached during jacking in each tendon.

DESIGN:

Design is based on $K=0.0002$ and $\mu=0.25$. P(JACK) at the jacking ends includes friction, anchor set of 0.625" at the jacking end, elastic shortening, and provisions for an additional 32 KSI long term loss in stress.

Duct pattern 2, on Dwg. B14, with 0.8 inch diameter low-relaxation strands in 4" O.D. ducts was assumed in the design.

P(JACK) = 12655 KIPS total at jacking ends
 Area minimum = 82.50 SQ. IN.
 f'_s = 270 KSI
 f'_c = 5000 PSI at 28 days field compressive strength
 f'_{ci} = 4000 PSI at stressing

⊗ Designates critical points for P(JACK). The Contractor shall submit elongation and jacking calculations based on $KL + \mu \Delta C$ (including anchor set if any) and initial stress (initial stress ratio times jacking stress before long term losses) at the points labeled "⊗" and tabulated on this sheet.

DEPARTMENT OF TRANSPORTATION
S.H.47 OVER TROY AVENUE
PUEBLO, COLORADO

SUPERSTRUCTURE POST
TENSIONING LAYOUT


Designer G. Tsouvaras	Structure K-18-GA
Detaller K. Erickson	Numbers
Drawing Number B13 of 31	Drawings

BRW
PLANNING
TRANSPORTATION
ENGINEERING
URBAN DESIGN
BRW INC. 1225 LAWRENCE ST. SUITE 200 DENVER CO 80202

AS CONSTRUCTED
NO REVISIONS ☐ REVISED ☐ VOID ☐


FEDERAL ROAD REGION NO.	DIVISION	PROJECT NUMBER	SHEET NO.
VIII	COLORADO	STA 0471-020	34

REVISIONS

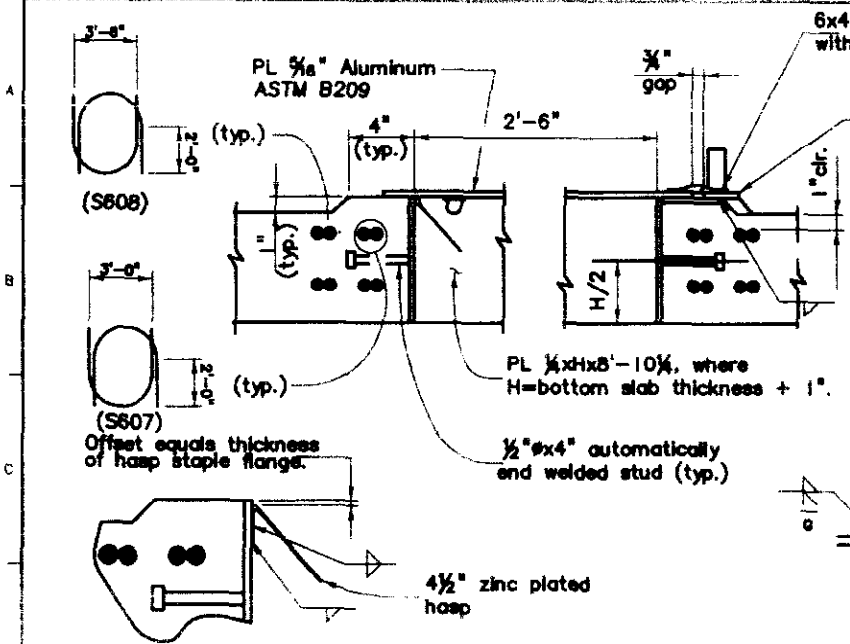

ACCESS DOOR DETAILS

Door, galv. frame, and hardware to be paid for in item No. 601 - Concrete Class S.

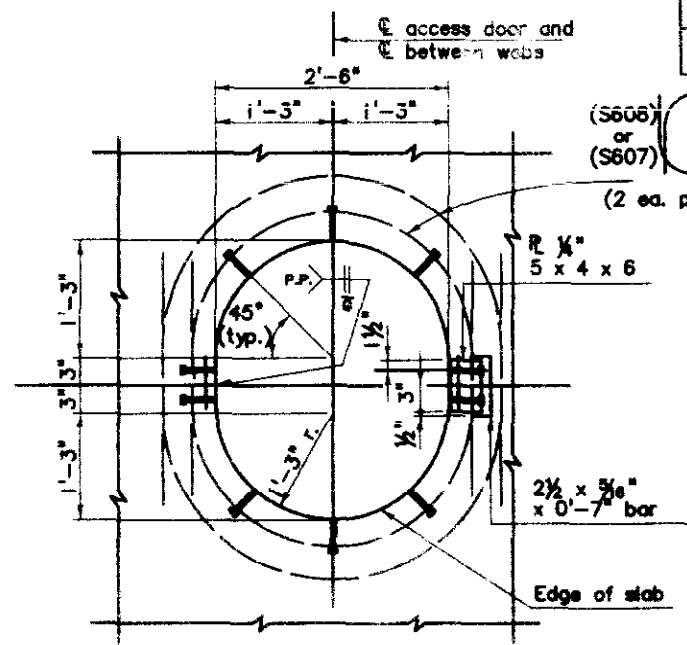

B-618-2
(use with B-618-1 and B-618-3; also add B-618-7 when horizontal curve is present.)


NOTES:

See abutment details and superstructure details for dimensions and reinforcing not shown.


Grind galvanizing from frame, where the hasp or hinge attach, prior to welding. After welding, paint the weld and surrounding areas with zinc rich paint meeting Military Specification DOD-P-21035A.

Attach door with 4 - 1/8" zinc plated bolts with countersunk heads. Use double nuts; burr threads after tightening. Attach hasp staple in a similar manner. Leave door in the open position while pouring the bottom slab.

Point door stop with zinc rich paint, meeting the above specification, after welding.

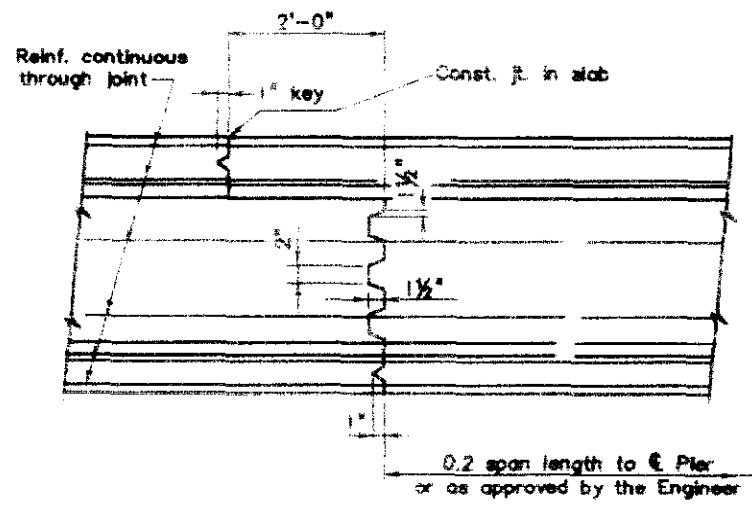


TRANSVERSE WEB CONSTRUCTION JOINT

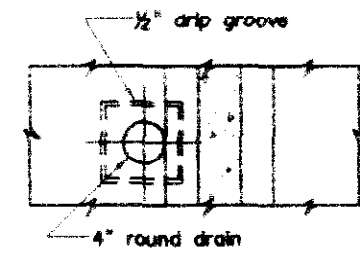


PLAN

BOTTOM SLAB DRAIN DETAIL

Locate at low point of each cell.

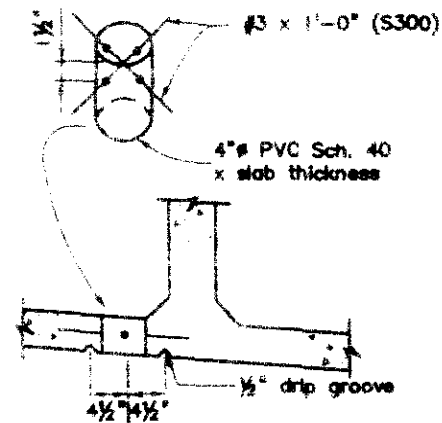


ELEVATION

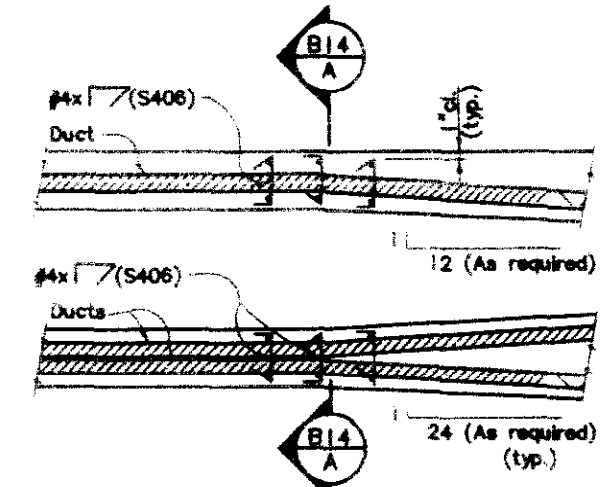

PLAN VIEW OF DUCTS AT GIRDER WEB FLARE

The webs shall be flared near the anchorage as required to maintain a 1 1/2" minimum cover over the ducts and a 1" minimum cover over the stirrups. The flare may be on one side only for exterior girder webs. Provide #4 ties above, below, and between each row of ducts, tie to three stirrups at beginning of web flare.

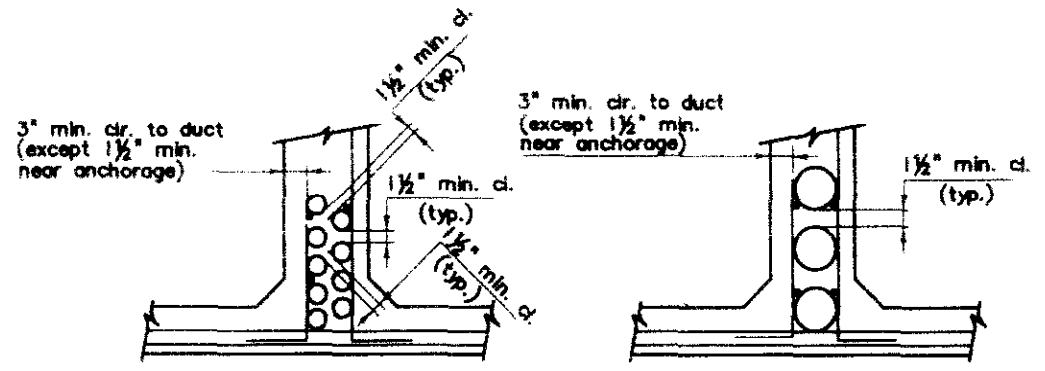

PATTERN 1

PATTERN 2

CLEARANCE REQUIREMENTS FOR DUCTS



DEPARTMENT OF TRANSPORTATION			
S.H.47 OVER TROY AVENUE PUEBLO, COLORADO			
CAST-IN-PLACE POST-TENSIONED BOX GIRDER DETAILS			
Designer G. Tsouvaras	Structure	K-18-GA	
Detailer K. Erickson	Numbers		
Drawing Number	B14 of 31	Drawings	
Revision Dates (Preliminary Stage Only)			


INITIAL	DATE	BY	DATE	BY

PL 117B
REFS. NOW

AS CONSTRUCTED			FEDERAL ROAD REGION NO.	DIVISION	PROJECT NUMBER	SHEET NO.
NO REVISIONS	REVISED	VOID	VIII	COLORADO	STA 0471-020	55


B-618-3
(use with B-618-1 and B-618-2)

REVISIONS		

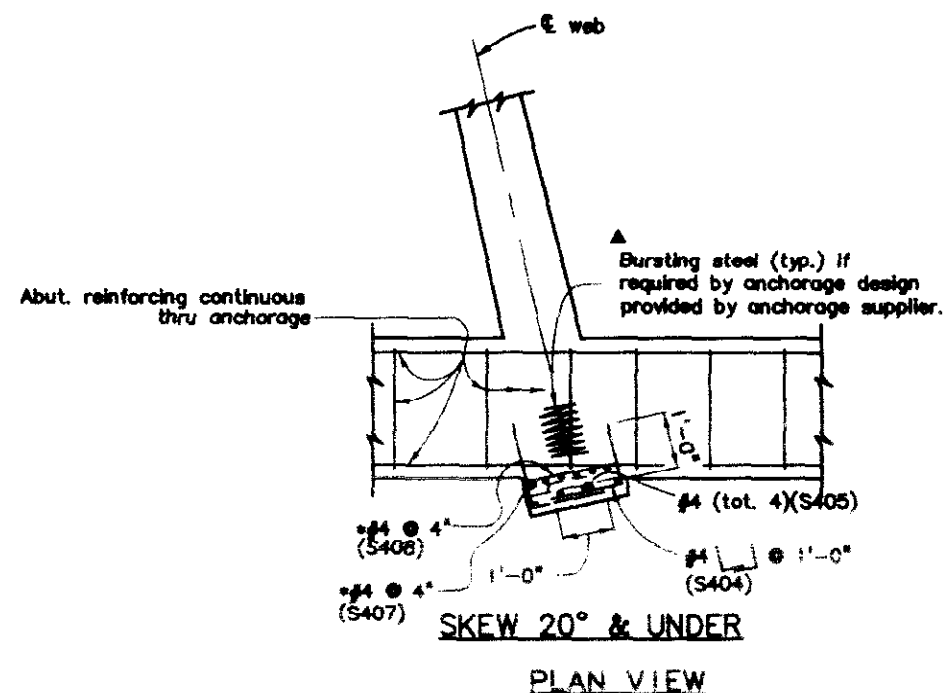

SEAT FOR PRESTRESSED ANCHORAGE AT ABUTMENTS

*Adjust reinforcement spacing to facilitate anchorage device placement. Provide equivalent area of reinforcement either side of anchorage device.

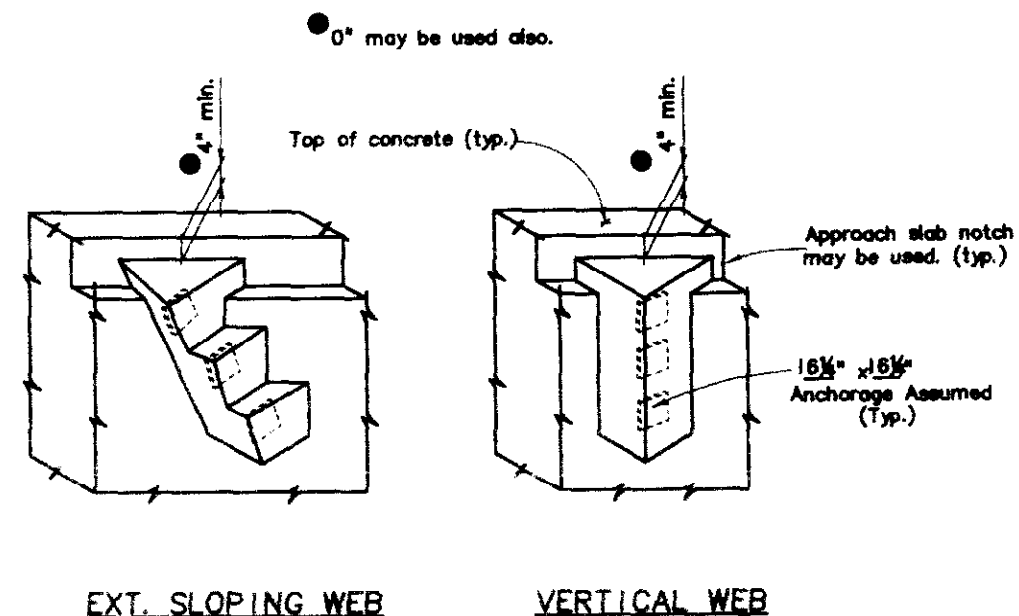

TYPICAL ANCHORAGE ILLUSTRATIONS

Details may be modified to specific anchorage.

NOTES:

- The anchorage shall be covered with concrete to provide a minimum of 2" of cover.
- The distance between the edge of a bearing plate and the edge or corner of the concrete shall be 2" minimum.
- The webs shall be flared near the anchorage as required to maintain a 1 1/2" minimum cover over the ducts and a 1" minimum cover over the stirrups. The flare may be on one side only for exterior webs.
- All reinforcing designated Δ , and concrete in flares not included in explicit details, shall not be included in concrete and reinforcing quantities, but shall be included in the price of the prestressing steel.
- See abutment details and superstructure details for dimensions and reinforcing not shown.


DEPARTMENT OF TRANSPORTATION		
S.H.47 OVER TROY AVENUE PUEBLO, COLORADO		
CAST-IN-PLACE POST-TENSIONED BOX GIRDER DETAILS		
Designer G. Tsouvaras	Structure Numbers	K-18-GA
Detailer K. Erickson	Numbers	
Drawing Number	B15 of 31	Drawings



AS CONSTRUCTED		
NO REVISIONS	REVISED	VOID

FEDERAL ROAD REGION NO.	DIVISION	PROJECT NUMBER	SHEET NO.
VIII	COLORADO	STA 0471-020	36

REVISIONS	

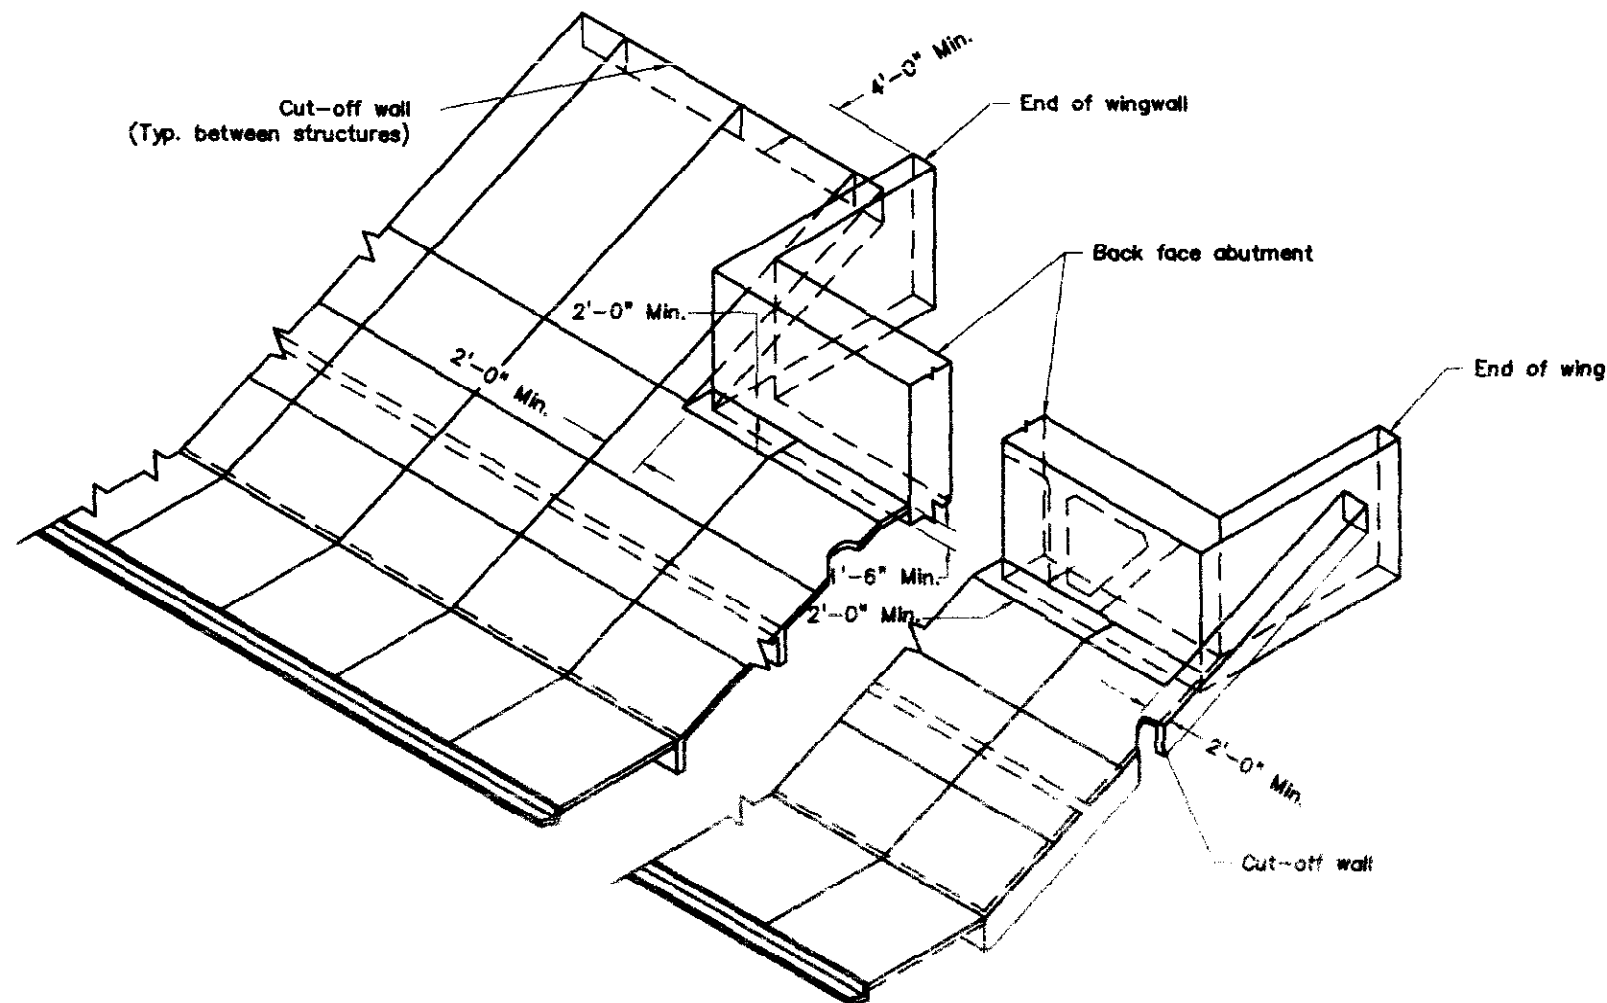


NOTES:

WIRE FABRIC SHALL BE 2" FROM THE END OF JOINTS AND SHALL LAP 8" AT SPLICES.


WHERE SLOPE OR BERM PAVING BUTTS AGAINST ABUTMENT AND CURB AND GUTTER SEPERATE WITH 1" EXPANSION JOINT MATERIAL.

EXPANSION JOINT MATERIAL AND WELDED WIRE FABRIC SHALL NOT BE PAID FOR SEPARATELY, BUT SHALL BE INCLUDED IN THE WORK.

STRUCTURE EXCAVATION FOR CONCRETE SLOPE AND DITCH PAVING SHALL BE LIMITED TO THE ACTUAL VOLUME OCCUPIED BY THE SLOPE PAVING CONCRETE.

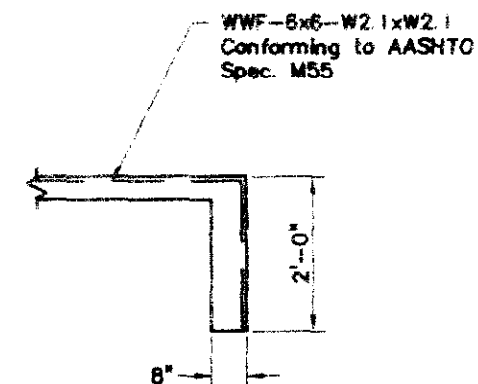

TYPICAL SECTION THRU CUT-OFF WALL

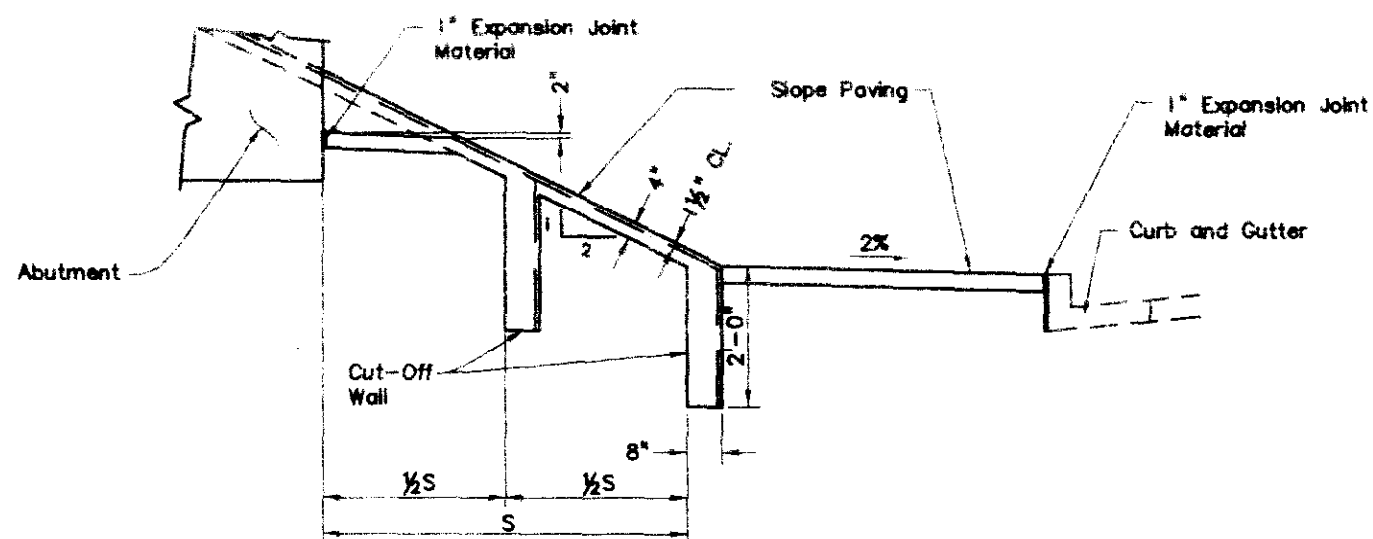

TYPICAL SECTION THRU SLOPE PAVING



DEPARTMENT OF TRANSPORTATION		
S.H.47 OVER TROY AVENUE PUEBLO, COLORADO		
SLOPE PAVING DETAILS		
Designer G. Tsouvaras	Structure Numbers	K-18-GA
Detaller K. Erickson	Numbers	
Drawing Number	B16 of 31	Drawings


Revision Dates	(Preliminary Stage Only)
----------------	--------------------------

AS CONSTRUCTED		
NO REVISIONS	REVISED	VOID


FEDERAL ROAD REGION NO.	DIVISION	PROJECT NUMBER	SHEET NO.
VIII	COLORADO	STA 0471-020	37

REVISIONS			


B-613-C

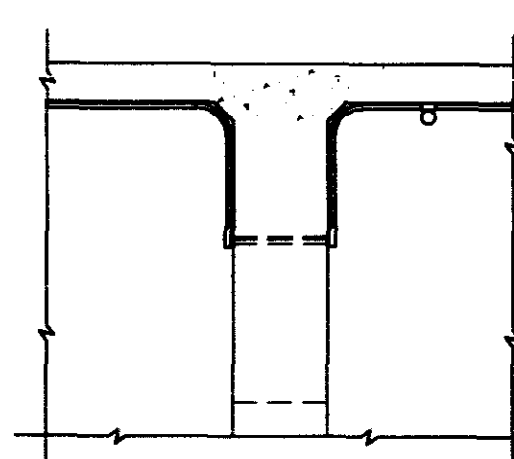


SECTION B17 A

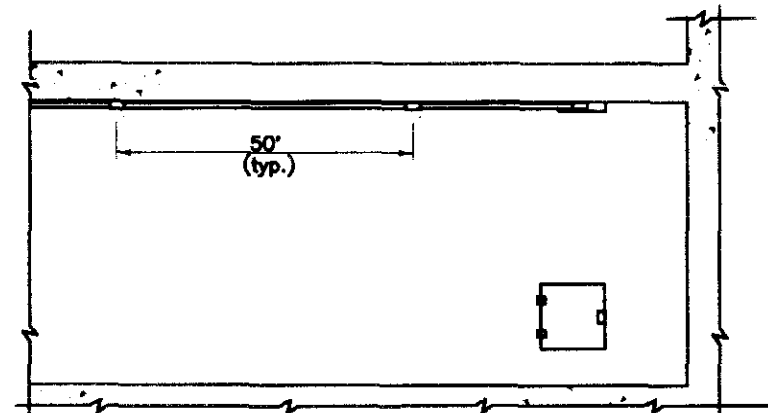


PLAN

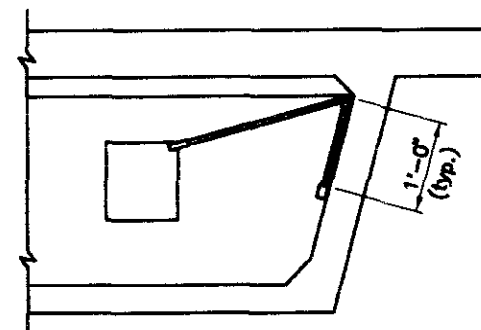

SECTION B17 B

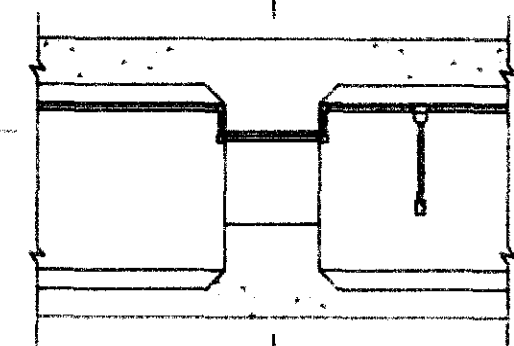


B17 B

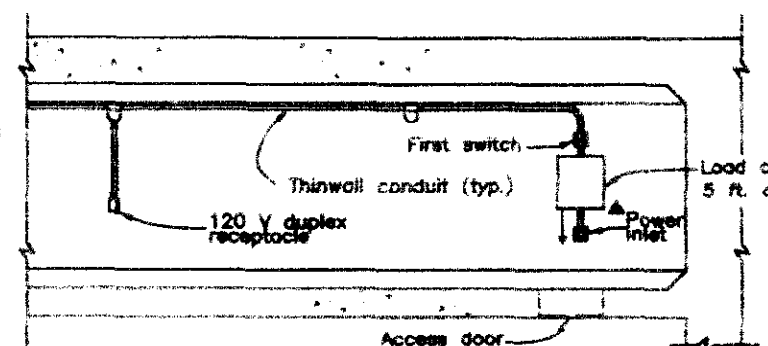


ELEVATION

▲ When conduit is shown on the Construction Layout, the load center shall be connected to this power source instead of using a separate power inlet. Use 3 - #8 copper wires in conduit.

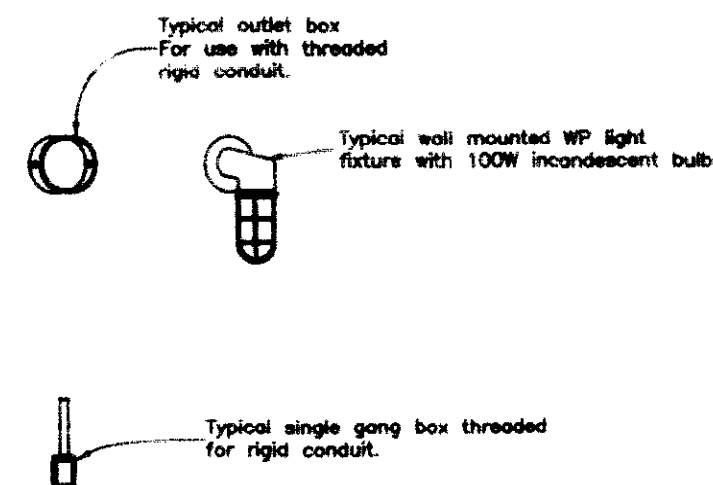

FIXTURE DETAILS

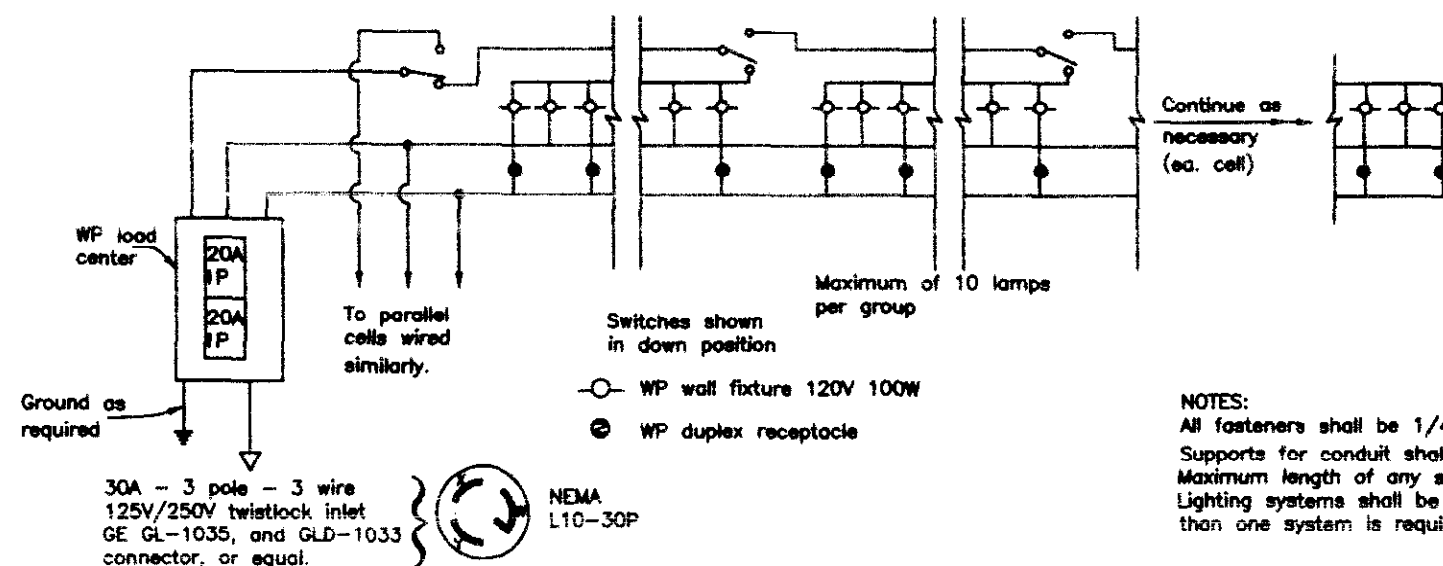

WIRING DIAGRAM

NOTES:
All fasteners shall be 1/4"
Supports for conduit shall be at 10' spacing (max.).
Maximum length of any system shall be 1300'.
Lighting systems shall be similar length when more than one system is required.




DEPARTMENT OF TRANSPORTATION			
S.H.47 OVER TROY AVENUE PUEBLO, COLORADO			
INTERIOR LIGHTING (CONCRETE BOX GIRDER)			
Designer G. Tsouvaras		Structure Numbers	K-18-GA
Detailer		Numbers	
Drawing Number		B17 of 31	Drawing

NO. REVISIONS	REVISED	VOID	FEDERAL ROAD REGION NO.	DIVISION	PROJECT NUMBER	SHEET NO.
			VIII	COLORADO	STA 0471-202	38

B-606-10

REVISIONS

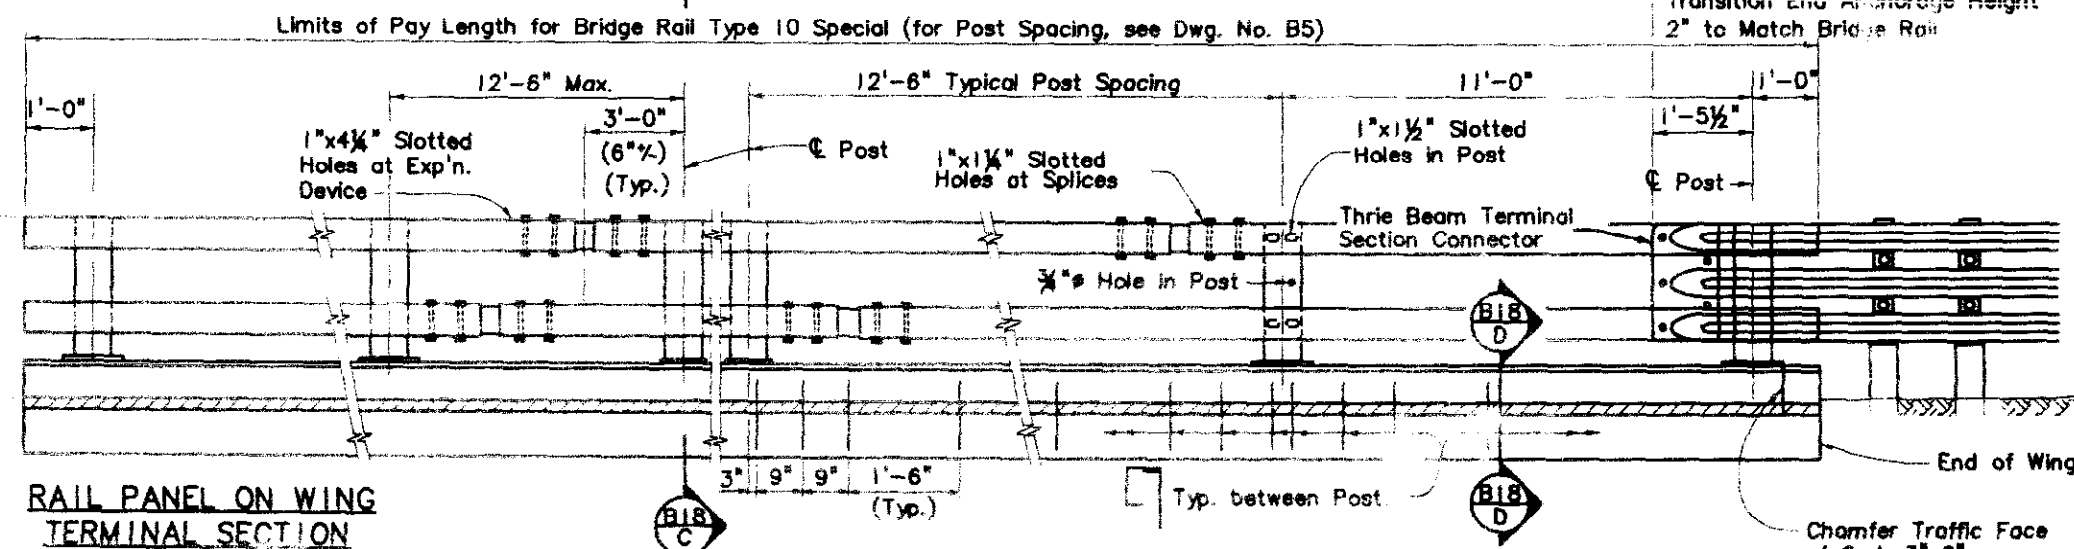

GENERAL NOTES

ALL TUBES SHALL BE FABRICATED FROM ASTM A500 GRADE B. ALL POSTS SHALL BE FABRICATED FROM ASTM A36 STEEL.

THE ABOVE MATERIAL AND ALL ANCHOR BOLTS AND MISCELLANEOUS BOLTS, NUTS, AND WASHERS SHALL BE GALVANIZED AFTER FABRICATION. IN ACCORDANCE WITH SECTION 509.

CONCRETE, REINFORCING STEEL, AND STRUCTURAL STEEL ELEMENTS SHALL CONFORM TO THE REQUIREMENTS OF SECTIONS 601, 602, AND 508, RESPECTIVELY.

POST ANCHOR, ENCASED IN CONCRETE, SHALL BE ASTM A36 OR AASHTO M183 STEEL, AS NOTED, AND NEED NOT BE GALVANIZED.

THE TUBES SHALL BE SHOP BENT OR FABRICATED TO FIT HORIZONTAL CURVE WHEN RADIUS IS LESS THAN 1500 FEET.

TUBES SHALL BE CONTINUOUS OVER NOT LESS THAN TWO POSTS.

THE CENTERLINE OF THE POSTS AT THE BRIDGE EXPANSION DEVICE SHALL BE A MINIMUM OF 3'-0" FROM THE CENTERLINE OF THE BRIDGE EXPANSION DEVICE, MEASURED ALONG THE CENTERLINE OF POSTS.

ALL BOLTS THAT HAVE LOCK WASHERS SHALL BE TIGHTENED TO SNUG ONLY.

POSTS SHALL BE PERPENDICULAR TO THE GRADE OF THE DECK.

ONE OR MORE 12'-6" POST SPACINGS MAY BE REDUCED (8'-4" MIN.) IN ORDER TO MAINTAIN DIMENSIONS FROM THE END OF THE WINGS AND EXPANSION JOINTS.

OPTIONAL DRAIN HOLE FOR GALVANIZING MAY BE DRILLED, PUNCHED OR CLIPPED, LEAVING SMOOTH SURFACES AND TRANSITIONS. NO FLAME CUTTING OR AIR CARBON ARC GOUGING IS ALLOWED.






POSTS, POST ANCHORS, BASE PLATES, BACKING PLATES, ANCHOR BOLTS, MISCELLANEOUS BOLTS, NUTS, WASHERS, TUBES, TUBE EXPANSION DEVICES, TUBE SPLICES, END PLATES, CURB CONCRETE (CLASS D), CURB REINFORCING STEEL, AND REFLECTOR TABS SHALL BE INCLUDED IN ITEM 508, BRIDGE RAIL TYPE 10 Special.

PRIOR TO FABRICATION OF THIS ITEM, TWO SETS OF SHOP DRAWINGS WHICH COMPLY WITH THE REQUIREMENTS OF SECTION 105, SHALL BE SUBMITTED TO THE DIVISION FOR INFORMATION ONLY. ONE SET SHALL BE SENT TO THE COLORADO DIVISION OF HIGHWAYS, STAFF MATERIALS BRANCH, MATERIALS INSPECTION UNIT, 4340 E. LOUISIANA AVENUE, DENVER, COLORADO 80222, AND ONE SET SHALL BE SENT TO THE ENGINEER. THE SHOP DRAWINGS WILL NOT BE APPROVED OR RETURNED.

STRUCTURAL STEEL:
AASHTO M183 (ASTM A36) f = 36,000 psi
COLD FORMED ASTM A500 GRADE B f = 46,000 psi

INFORMATION ONLY

DESCRIPTION	UNIT	PER LIN. FT.
STRUCTURAL STEEL (GALVANIZED)	LB.	33.1
CONCRETE CLASS D (BRIDGE)	CU. YD.	0.04
REINFORCING STEEL (EPOXY COATED)	LB.	4.0

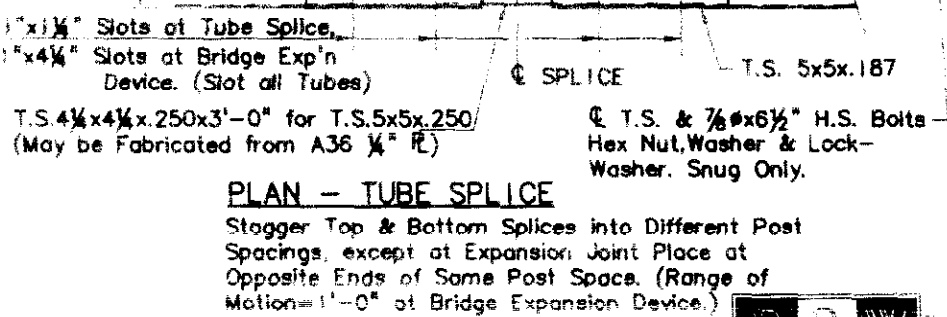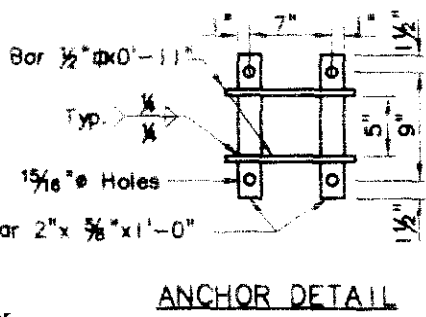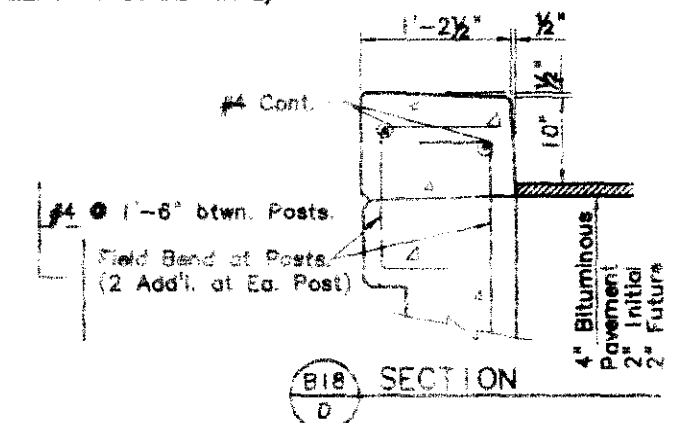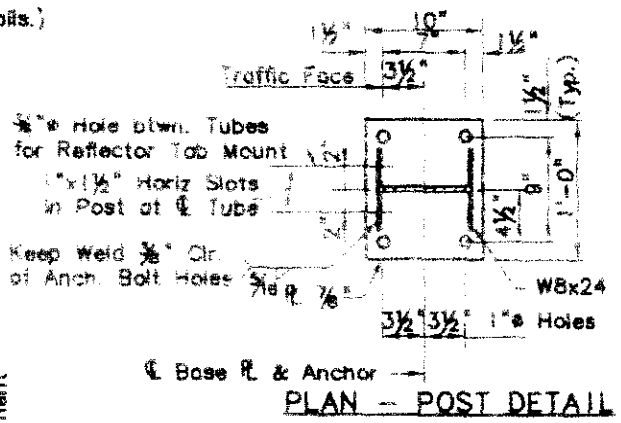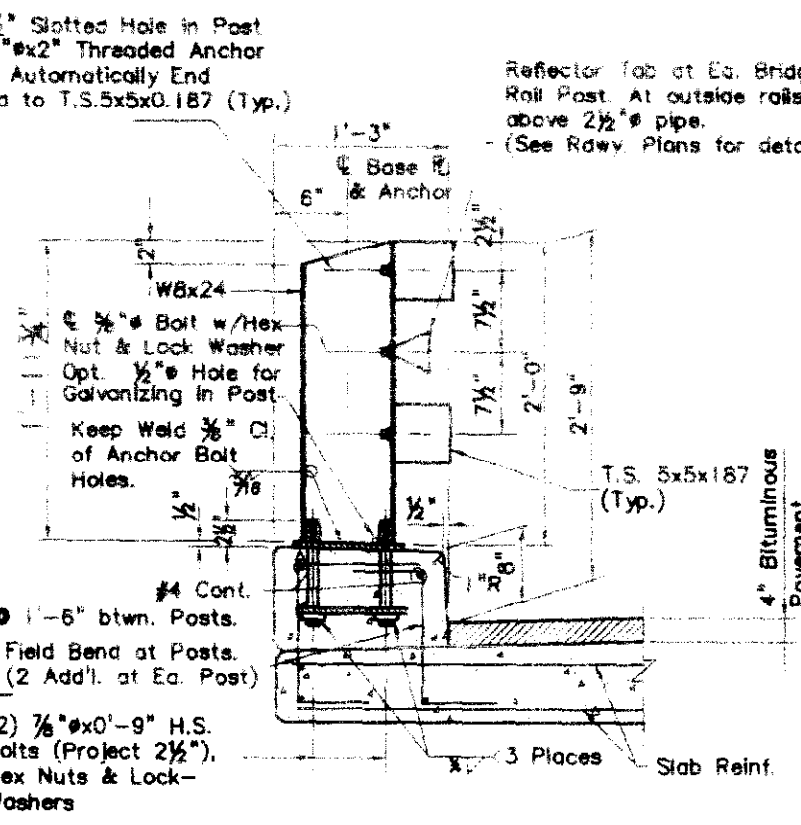

NOTE: Outside bridge rails of Str. Nos. K-18-EX and K-18-GA require an additional bicycle railing. Refer to Dwg. B21 for details.



DEPARTMENT OF TRANSPORTATION
S.H. 47 OVER TROY AVENUE
PUEBLO, COLORADO

BRIDGE RAIL TYPE 10 SPECIAL

Designer G. Iakovouros	Structure K-18-GA
Detailer K. Erickson	Numbers
Drawing Number B18 of 31	Drawings


Revision Dates (Preliminary Stage Only)

AS CONSTRUCTED
NO REVISIONS ☐ REVISED ☐ VOID ☐

FEDERAL ROAD REGION NO.	DIVISION	PROJECT NUMBER	SHEET NO.
VIII	COLORADO	STA 0471-020	39


REVISIONS		

B-606-10A

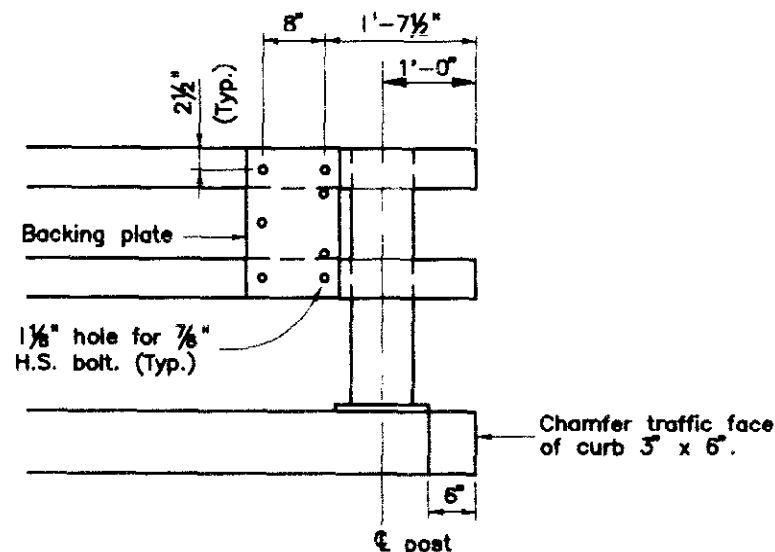


RAIL TUBE DETAILS

Three beam not shown.

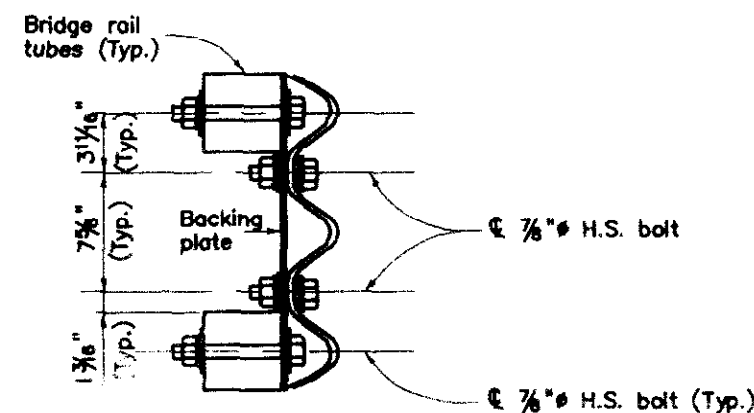


SECTION THRU BACKING PLATE

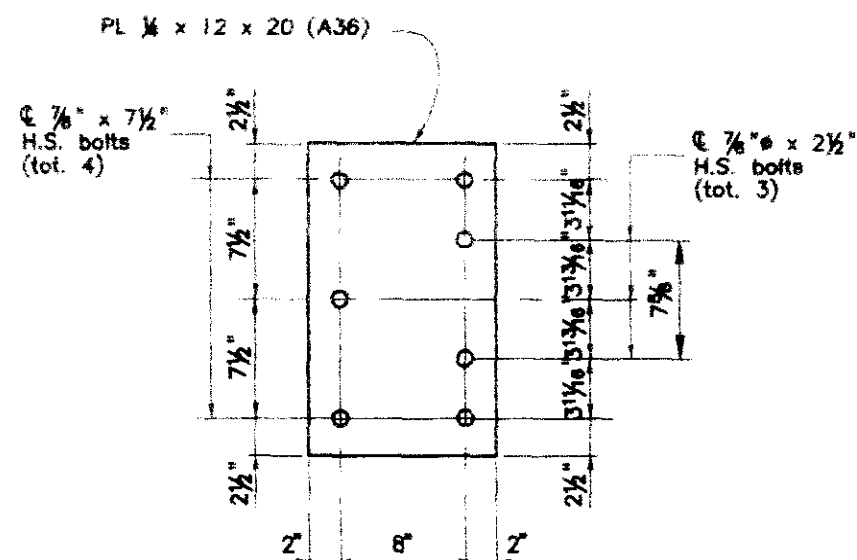

BACKING PLATE

Holes are 1 1/8" for 7/8" H.S. Bolts with Hex Nuts
2 PL washers, and 1 lock washer.

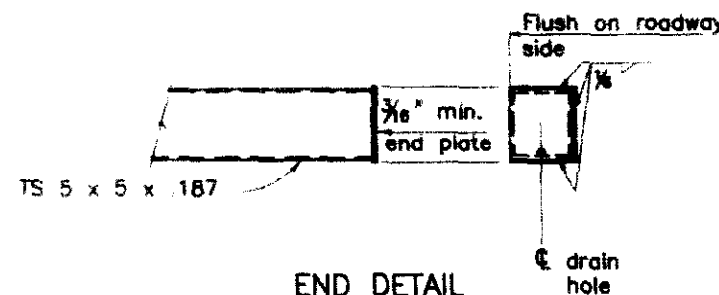

END DETAIL

DEPARTMENT OF TRANSPORTATION		
S.H.47 OVER TROY AVENUE PUEBLO, COLORADO		
BRIDGE RAIL TYPE 10 SPECIAL		
Designer G. Telouvaras	Structure	K-18-GA
Detaller K. Erickson	Numbers	
Drawing Number	B19 of 31	Drawings

BRW
PLANNING
TRANSPORTATION
ENGINEERING
URBAN DESIGN
BRW INC. 225 LAMAR ST. SUITE ONE BOWEN CO. MISSOURI

Revision Dates (Preliminary Stage Only)

AS CONSTRUCTED		
NO REVISIONS	REVISED	VOID

FEDERAL ROAD REGION NO.	DIVISION	PROJECT NUMBER	SHEET NO.
VIII	COLORADO	STA 0471-020	40


REVISIONS	

NOTES:


Type 3G end anchorage is for use at both ends of bridges on two-way roads, and at the approach end of bridges on one-way roads.

Backup plate not required at posts on 3G.

☐ This shows rectangular washer is required under post bolt head.

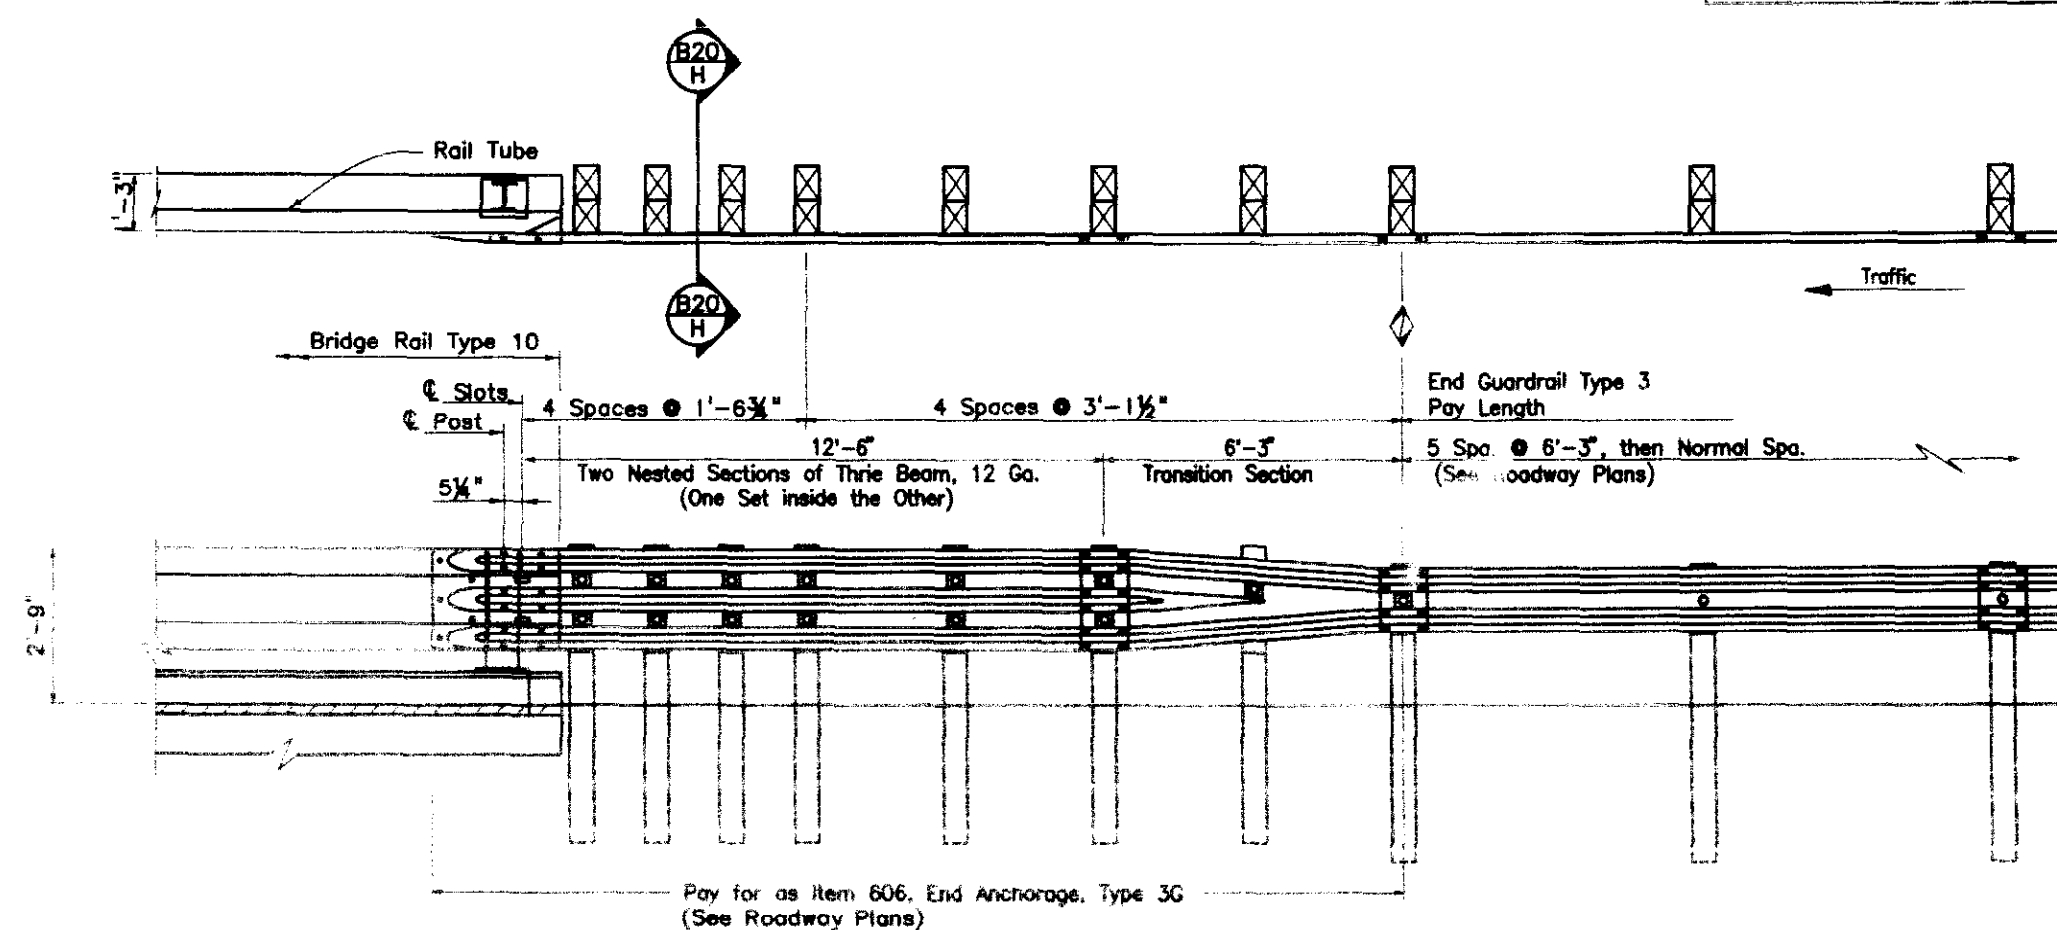


TYPE 3G END ANCHORAGE

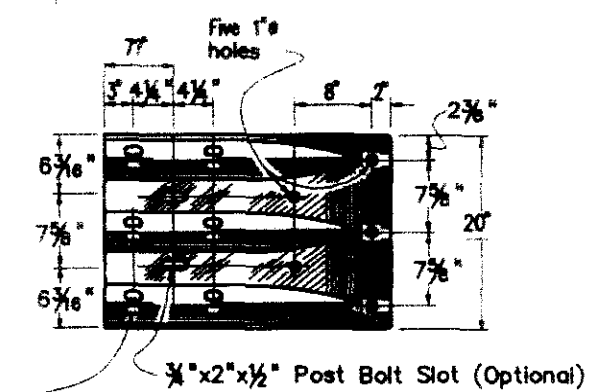

RE-63 (Class B, Type 1 or 2)-76 (Galv.)

THRIE BEAM TERMINAL SECTION (CONNECTOR)

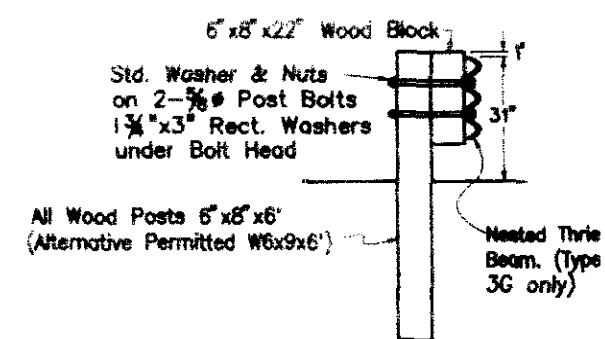

B20 SECTION

DEPARTMENT OF TRANSPORTATION			
S.H.47 OVER TROY AVENUE PUEBLO, COLORADO			
BRIDGE RAIL TYPE 10 SPECIAL			
Designer G. Tsakouras	Structure	K-18-GA	
Detaller K. Erickson	Numbers		
Drawing Number	B20	of	31
Drawings			
Revision Dates (Preliminary Stage Only)			



INITIAL	DATE	BY	FOR


F117B
GROUPS NONE

AS CONSTRUCTED		
NO REVISIONS	REVISED	VOID


FEDERAL ROAD REGION NO.	DIVISION	PROJECT NUMBER	SHEET NO.
VIII	COLORADO	STA 0471-020	41

B-606-10


REVISIONS	

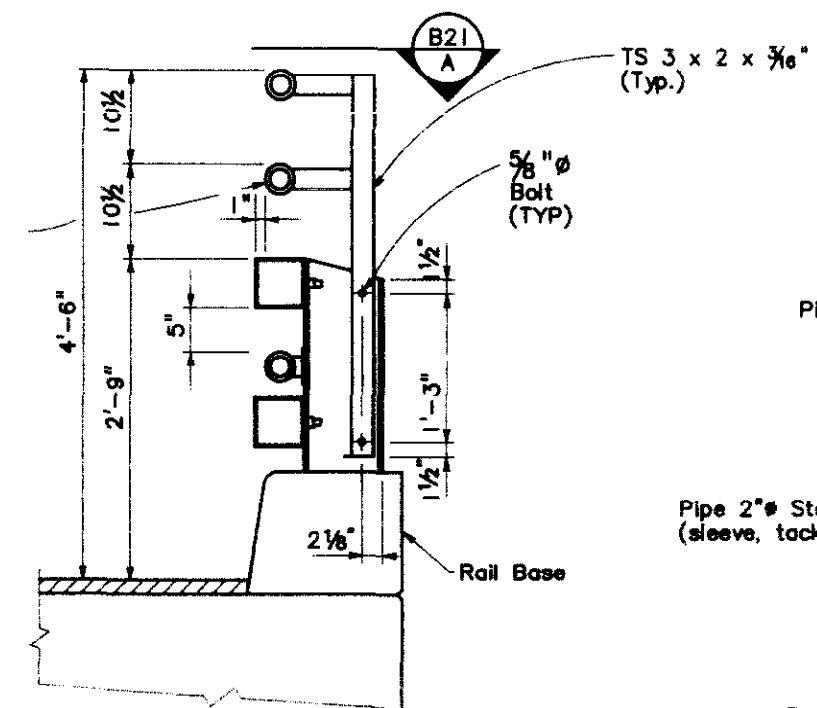


BICYCLE RAILING DETAIL

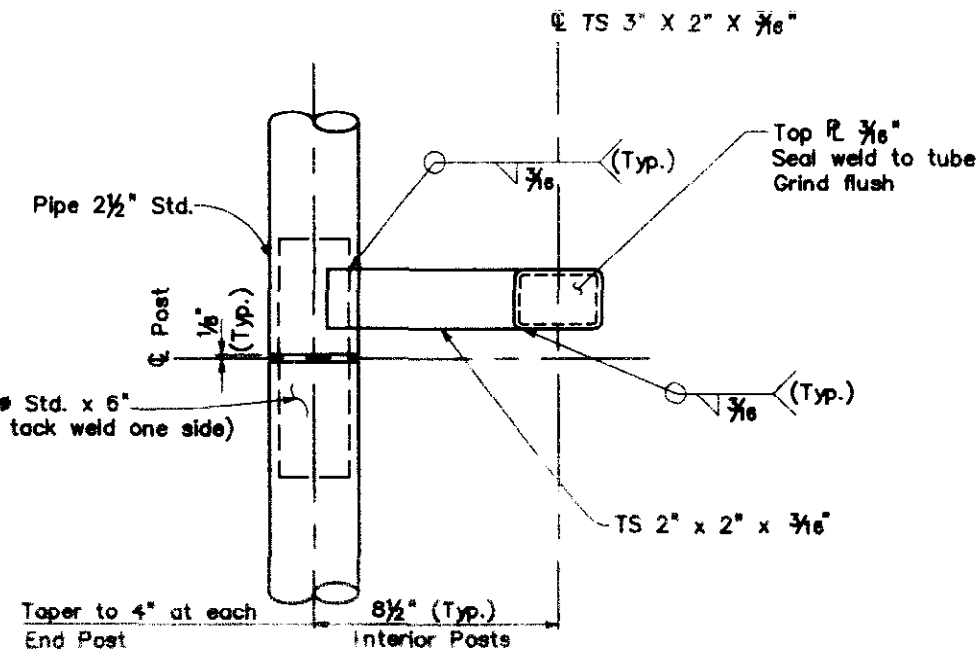


SECTION A

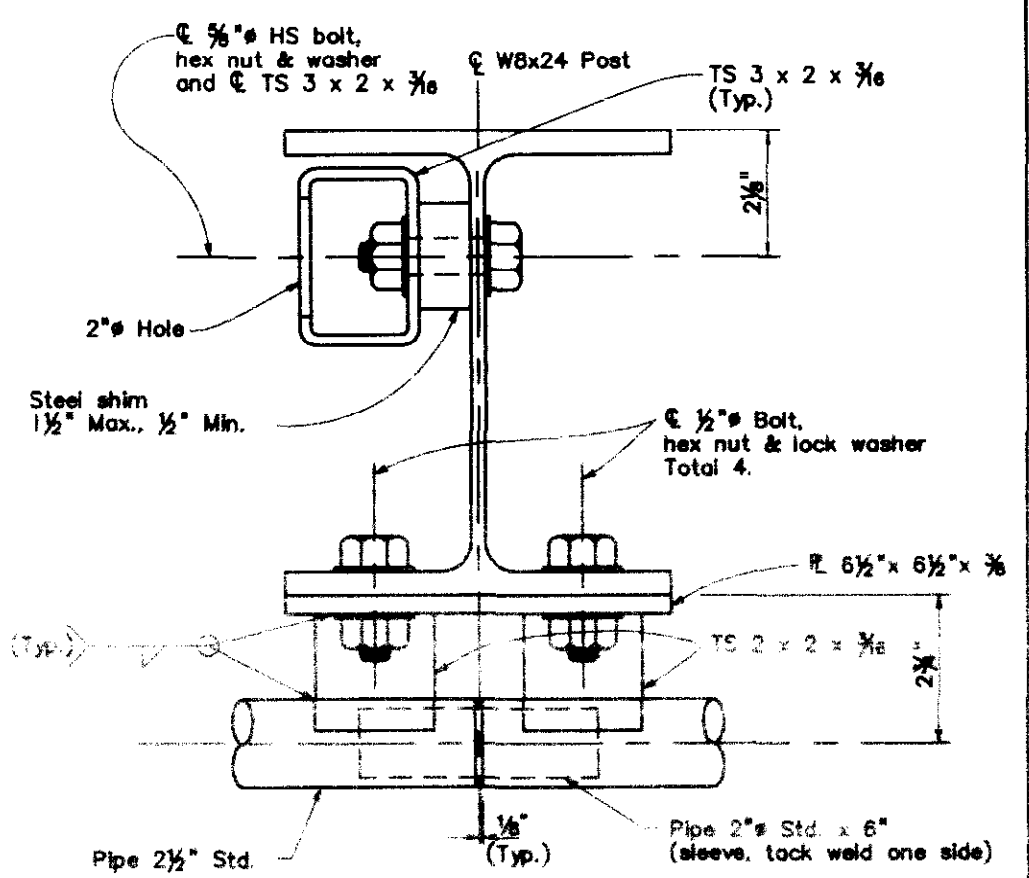

SECTION B

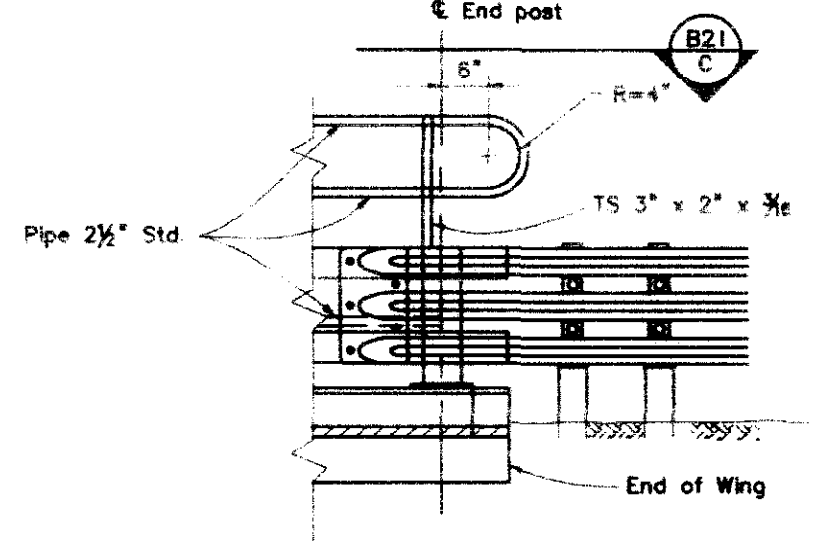


BICYCLE RAILING TERMINAL DETAIL

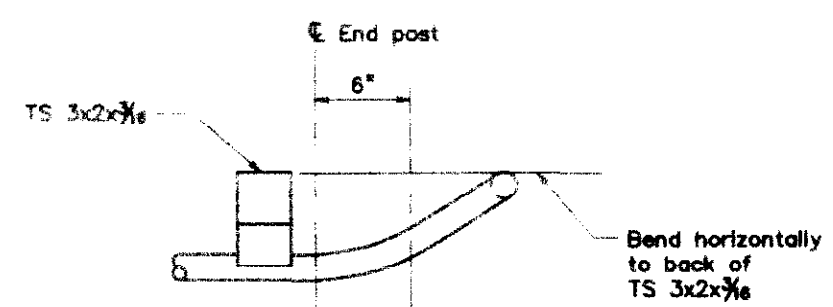

SECTION C

NOTE:
Attach bicycle railing to outside bridge rail of structure Nos. K-18-EX and K-18-GA. For details not shown, refer to Dwg. Nos. B18, B19 & B31. Cost of bicycle railing shall be included in Item 606, Bridge Rail Type 10 Special.

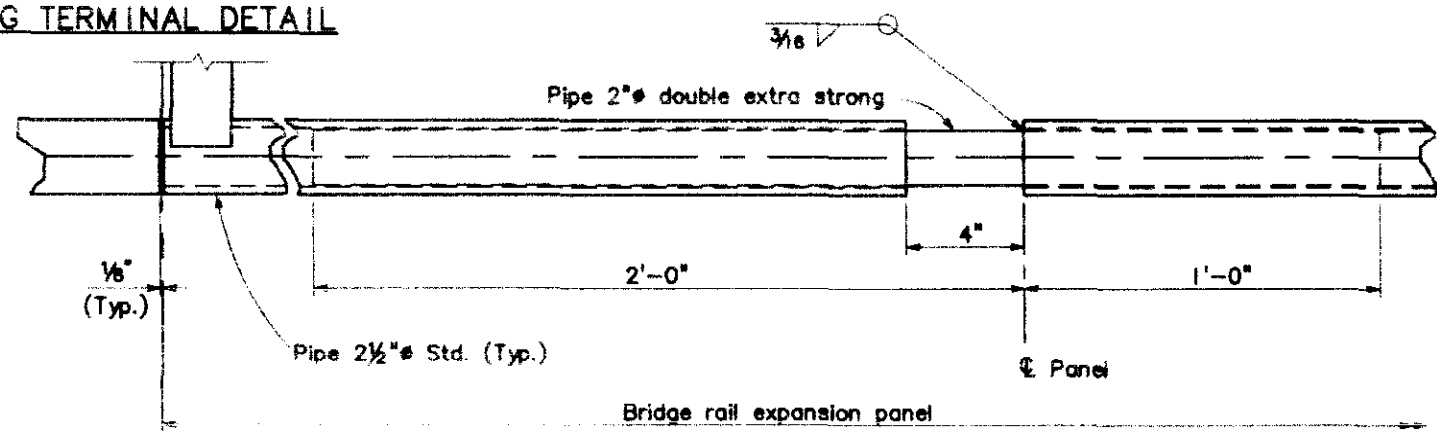

BICYCLE RAIL EXPANSION PANEL

DEPARTMENT OF TRANSPORTATION			
S.H.47 OVER TROY AVENUE PUEBLO, COLORADO			
BRIDGE RAIL TYPE 10 SPECIAL			
Designer G. Tsakouras	Structure Numbers	K-18-GA	
Detaller K. Erickson	Drawings	B21 of 31	
Drawing Number	B21	of	31



NOTES:


Cut slab reinforcing bars to clear Bridge Drains. Additional #5 Bars shall be set between top and bottom slab bars. Bend bridge rail reinforcing to clear drain.

Bridge drains shall be placed and secured at the locations shown on the plans prior to the placement of concrete. Prior to fabrication, two sets of shop drawings which comply with the requirements of Section 105 shall be submitted to the Department for information only. One set shall be sent to the Colorado Department of Transportation, Staff Materials Branch, Materials Inspection Unit, 4340 E. Louisiana Avenue, Denver, Colorado 80222, one set shall be sent to the Engineer.


Metal used in the manufacture of castings shall meet the requirements of ASTM A48 Class 35B, and shall not be Painted or galvanized.

Drawings for alternate welded steel bridge drains may be submitted to the Engineer for approval. Welded steel drains shall be galvanized after fabrication in accordance with AASHTO M111.


Payment for bridge drains will be made under Item 513, Bridge Drain (Special).

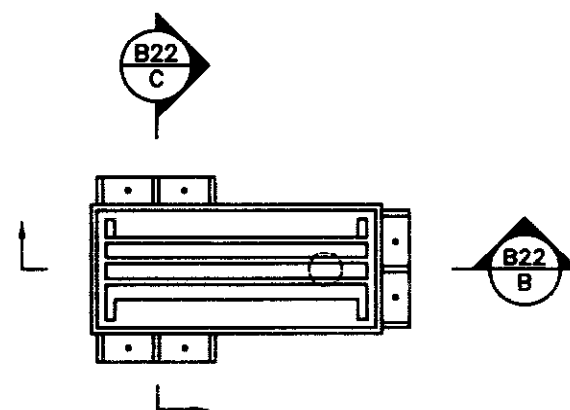


PLAN

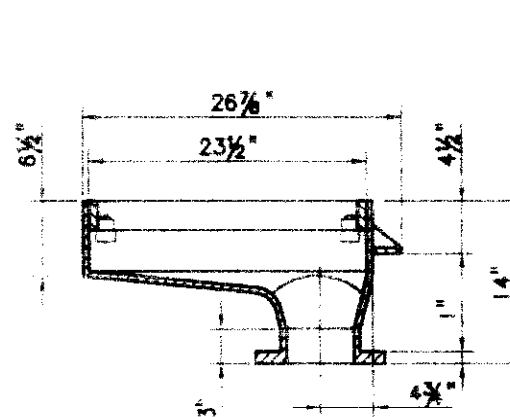

B22 SECTION

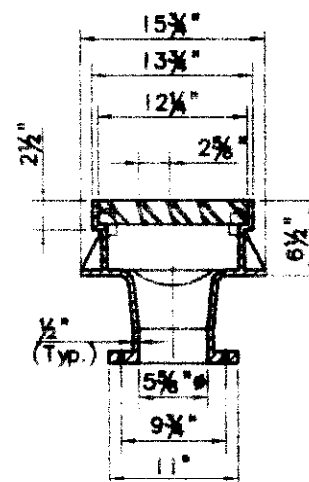

B22 SECTION

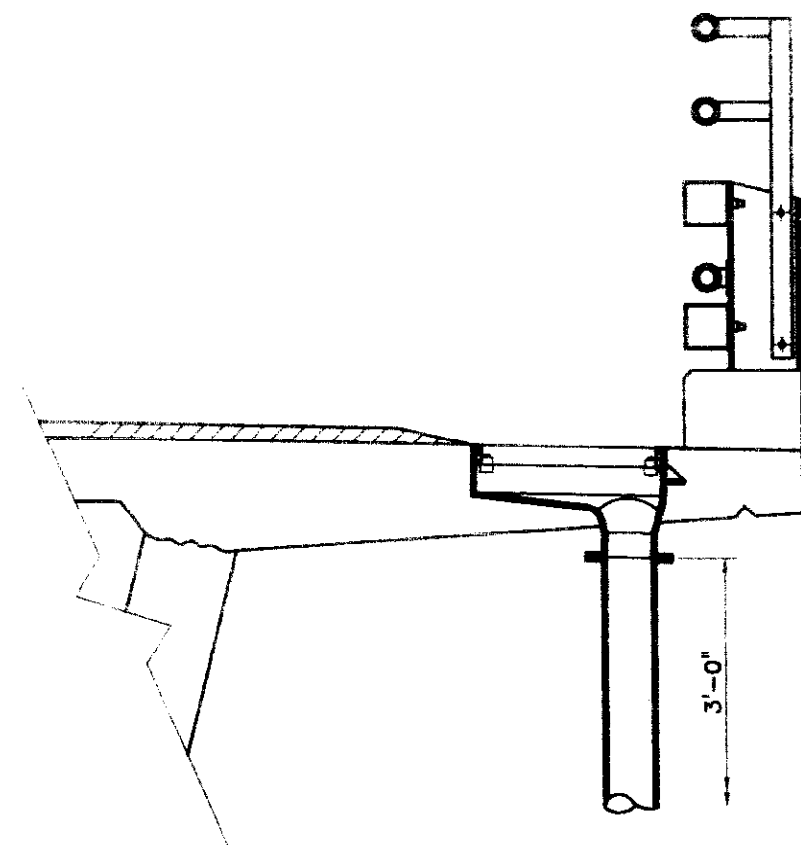

B22 SECTION
A

DEPARTMENT OF TRANSPORTATION
S.H.47 OVER TROY AVENUE
PUEBLO, COLORADO
BRIDGE DRAIN
DETAILS

Designer G. Tsiouvaras	Structure	K-18-CA
Detailer K. Erickson	Numbers	
Drawing Number	B22 of 31	Drawings

Revision Dates	(Preliminary Stage Only)
----------------	--------------------------



PLANNING
TRANSPORTATION
ENGINEERING
URBAN DESIGN

ERW INC. 1225 LAWRENCE ST., SUITE 200, DENVER, CO 80202

AS CONSTRUCTED		
NO REVISIONS	REVISED	VOID

FEDERAL ROAD REGION NO.	DIVISION	PROJECT NUMBER	SHEET NO.
VIII	COLORADO	STA 0471-020	43

REVISIONS	

B-601-1A

NOTES


- Concrete Class D (Bridge) shall be used for approach slabs.
- $\frac{1}{2}$ " expansion joint material shall meet A.A.S.H.T.O. Spec. M213.
- The expansion joint system shall include all labor and materials to install the expansion joint according to the Manufacturer's directions and according to these plans.
- The backer rod shall be secured and sealed according to the Manufacturer's directions.
- The cover plate shall be the size and type recommended by the Manufacturer and installed in accordance with the Manufacturer's directions.
- The joint bonding agent shall be the type recommended by the Manufacturer for the joint system being installed. It shall be applied according to the Manufacturer's recommendations.
- All surfaces in joint opening shall be cleaned according to the Manufacturer's directions.
- The joints shall be installed and compacted according to the Manufacturer's procedures.
- The finished joint, after compacting, shall be flush with the top of the adjacent asphalt surface.
- A representative of the Manufacturer shall be on site prior to installing the expansion joints and shall approve the methods and materials before work commences.
- See Special Provisions for Bridge Expansion Device (0"-2")

ACCEPTABLE ALTERNATES


Koch B J S System
Linear Dynamics Thorma-Joint
Watson Bowman Acme Expandex

DEPARTMENT OF TRANSPORTATION			
S.H.47 OVER TROY AVENUE PUEBLO, COLORADO			
APPROACH SLAB DETAILS			
Designer G. Talouvaras	Structure	K-18-GA	
Detailer K. Erickson	Numbers		
Drawing Number	B23	of	31
Revision Dates		(Preliminary Stage Only)	


PLANNING
TRANSPORTATION
ENGINEERING
URBAN DESIGN
ERW
DRW, INC. 1225 LAWRENCE ST., SUITE 200, DENVER, CO 80202

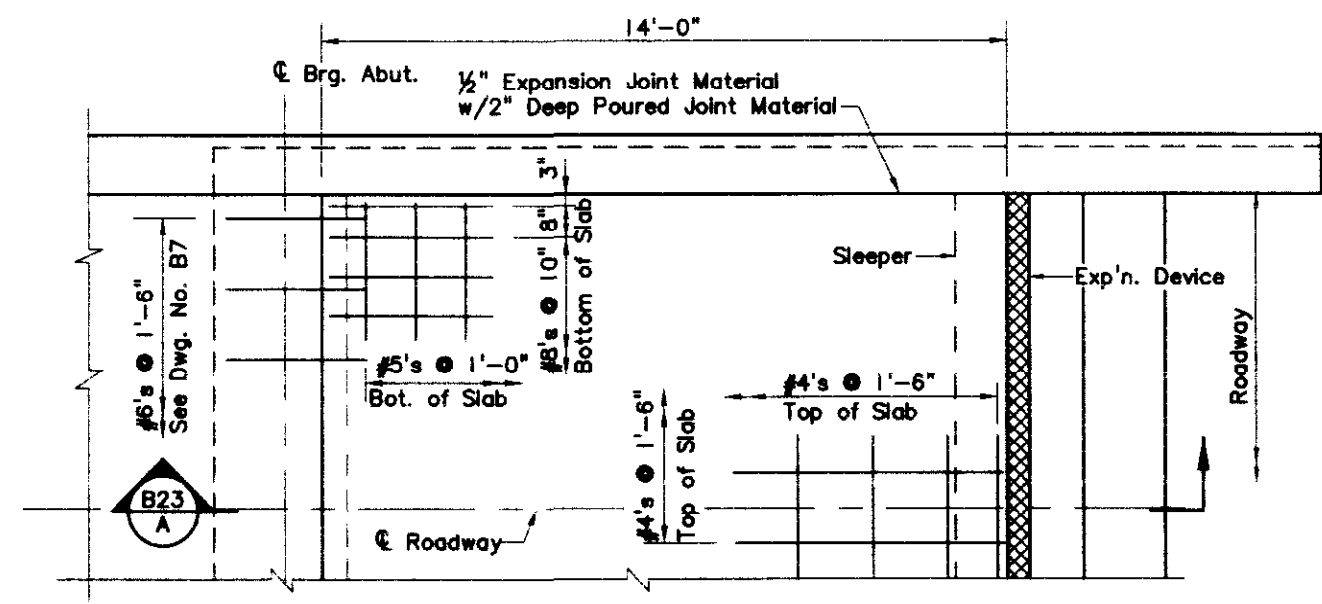


PLAN

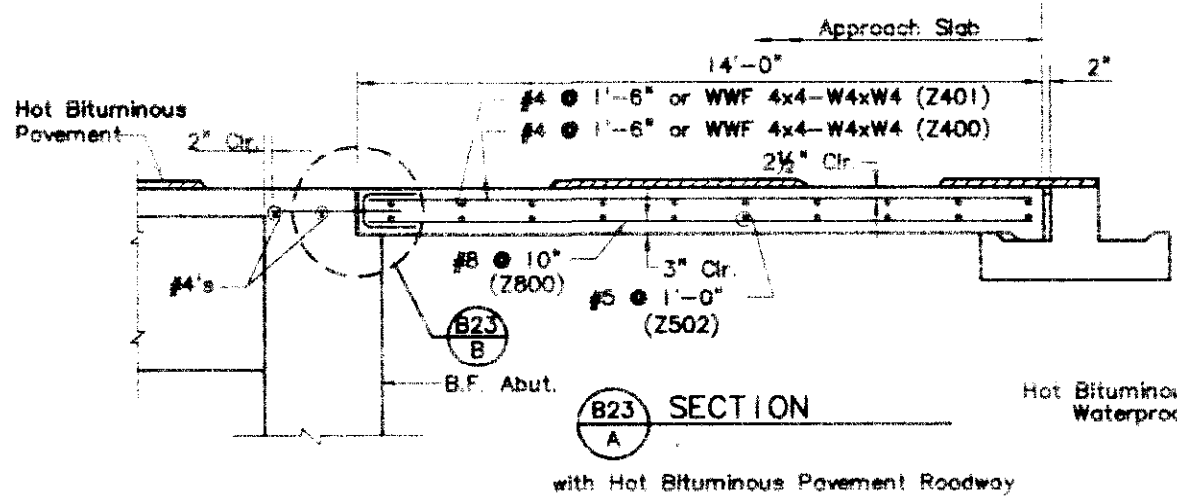

SECTION

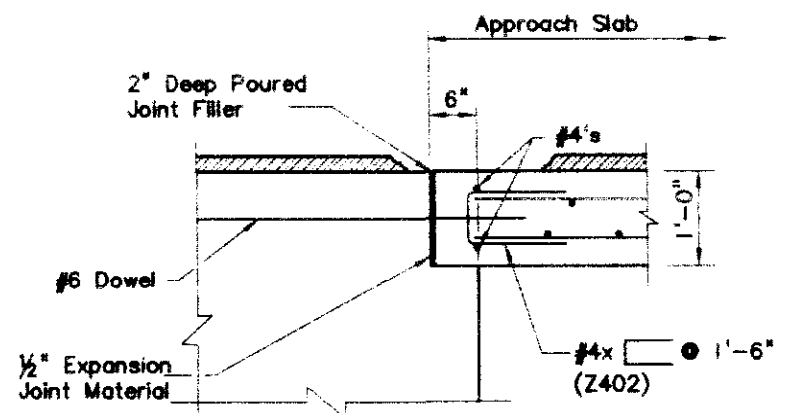

DETAIL

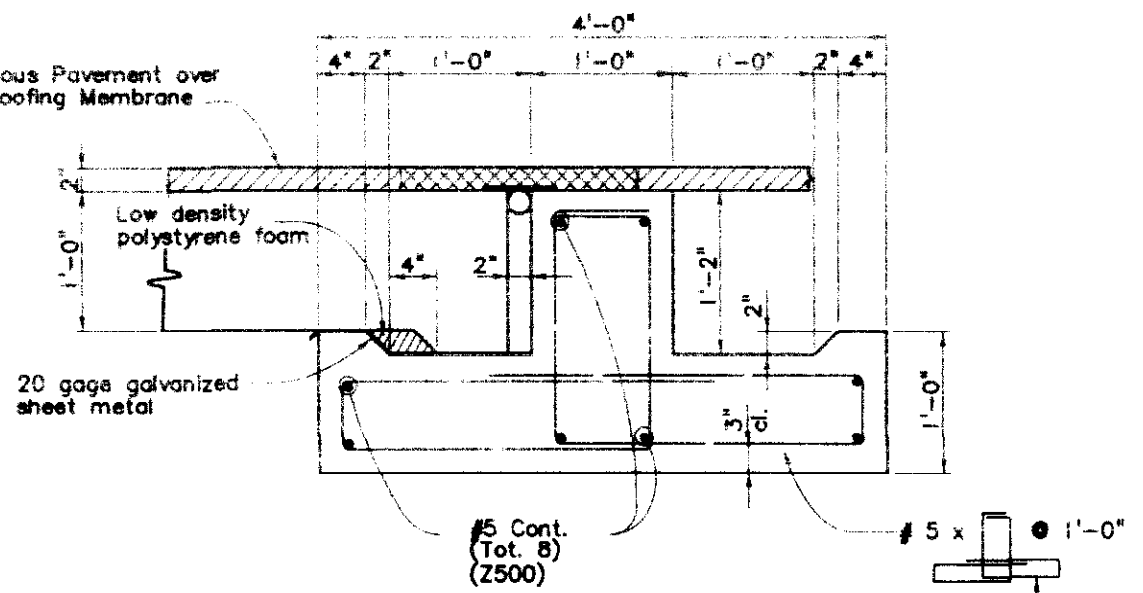


SLEEPER SECTION

Taken normal to expansion device
Sleeper may be precast.


AS CONSTRUCTED		
NO REVISIONS	REVISED	VOID

FEDERAL ROAD REGION NO.	DIVISION	PROJECT NUMBER	SHEET NO.
VIII	COLORADO	STA 0471-020	44

REVISIONS	

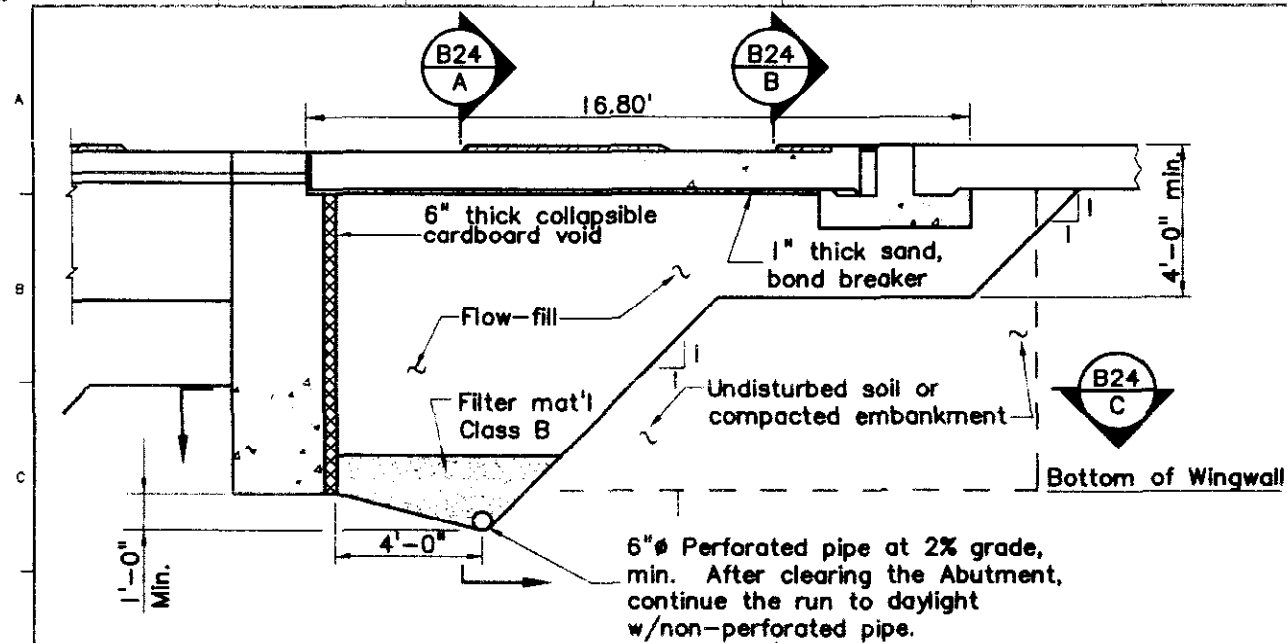

SECTION PERPENDICULAR TO ABUTMENT

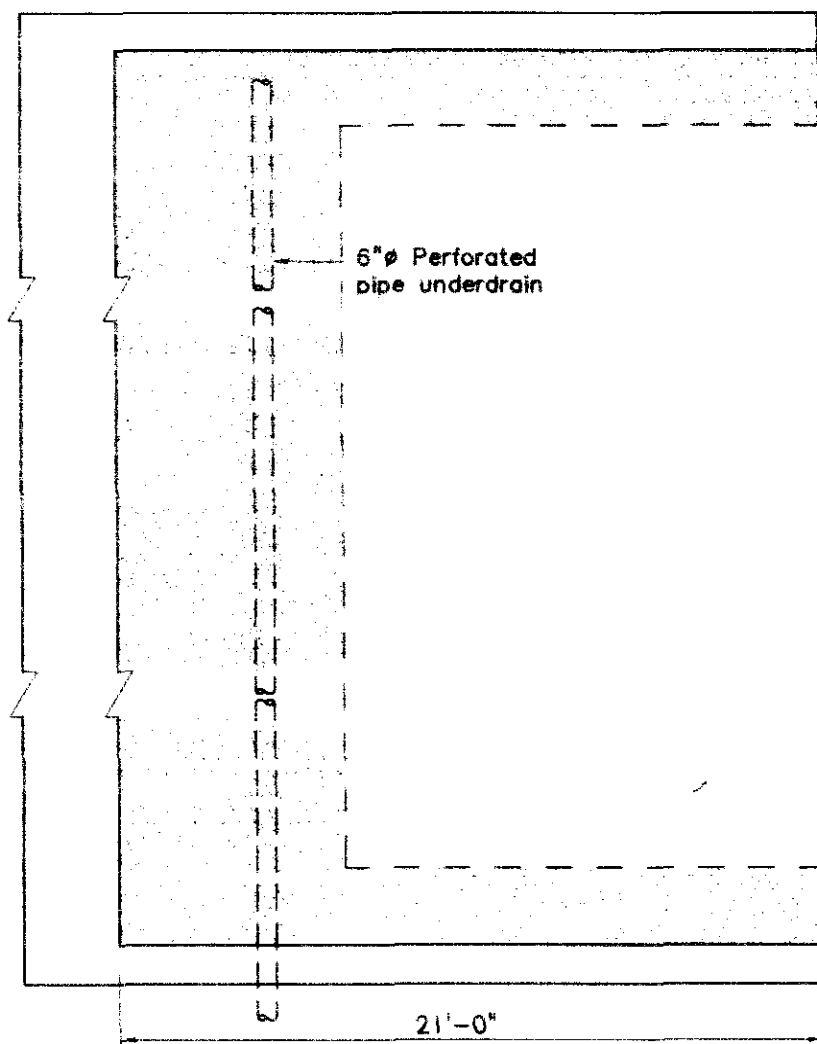


SECTION C
(Symmetrical about C)

6" Perforated Pipe Underdrain includes all Filter material and Geotextile. Quantity shown is measured along the Perforated Pipe from inside face to inside face of wingwalls.


For Information Only			Location	
Item No.	Description	Units	Abut. 1	Abut. 2
605	6" Perforated Pipe Underdrain	Lin. Ft.	37	37
605	Geocomposite Drain	Sq. Yd.	50	50
605	Subsurface Drain Outlet	Lin Ft.	30	30

Sand bond breaker, cardboard void, Geocomposite Drain, 6" Perforated Pipe Underdrain, and Subsurface Drain Outlet (6" nonperforated pipe) will not be measured or paid for separately but shall be included in the work.


Installation of Perforated Pipe Underdrain, Subsurface Drain Outlet, and Geocomposite Drain will conform to the Construction requirement of section 605.03, 605.06 and 605.04, respectively.

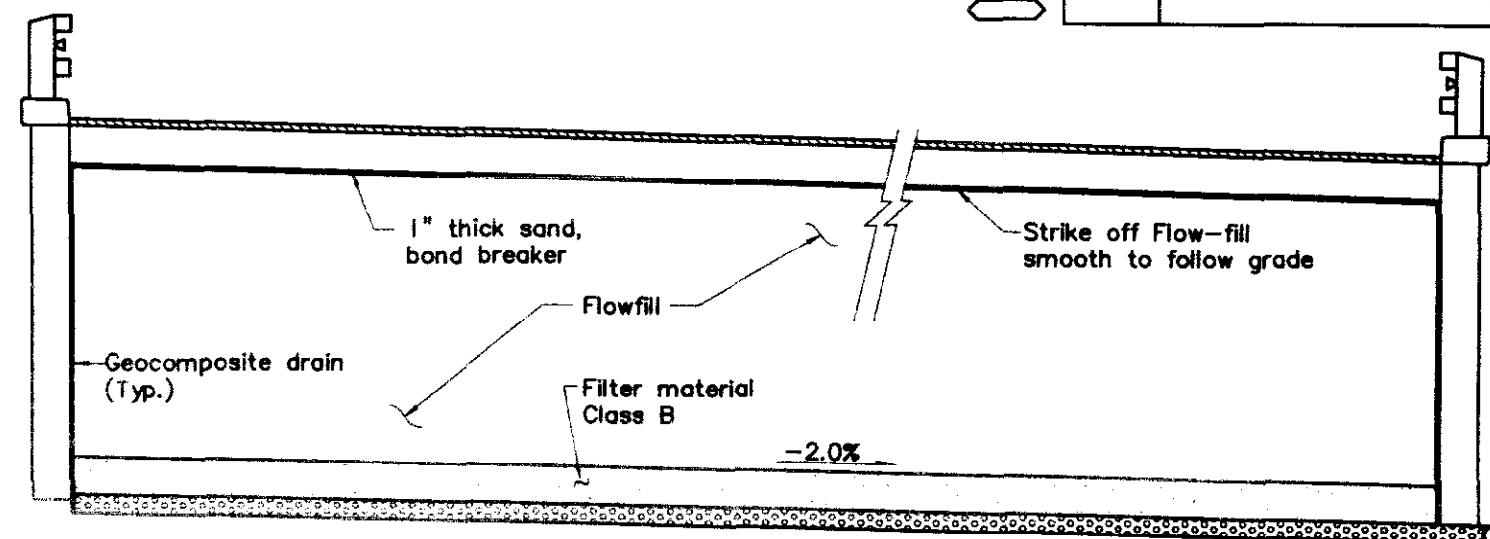

SECTION A

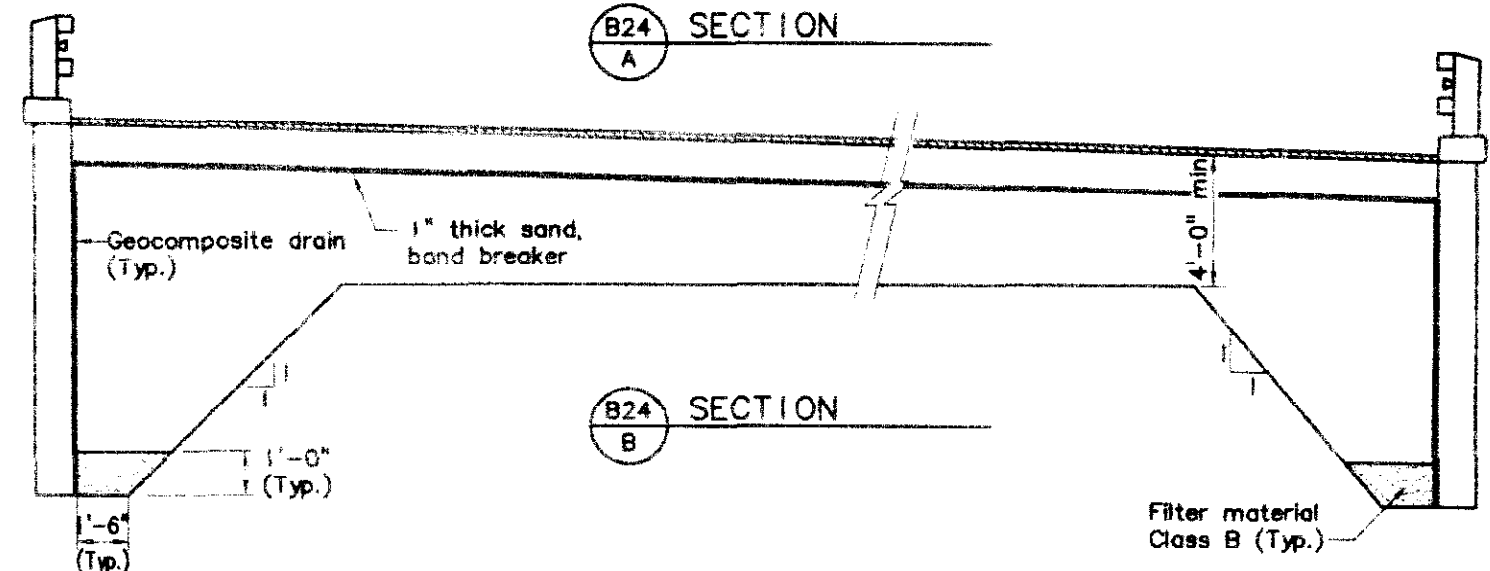

SECTION B

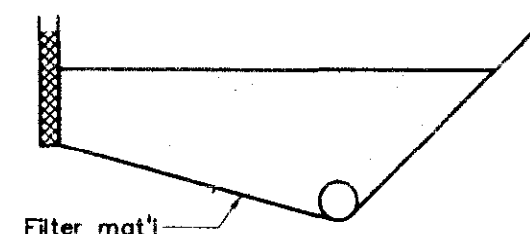

FILTER FABRIC DETAIL



DEPARTMENT OF TRANSPORTATION	
S.H.47 OVER TROY AVENUE PUEBLO, COLORADO	
STRUCTURE BACKFILL (FLOW-FILL)	
Designer G. Tsouvaras	Structure K-18-GA
Detaller K. Erickson	Numbers
Drawing Number B24 of 31	Drawings

Revision Dates	(Preliminary Stage Only)
----------------	--------------------------

AS CONSTRUCTED
NO REVISIONS ☐ REVISED ☐ VOID ☐

FEDERAL ROAD REGION NO. DIVISION PROJECT NUMBER SHEET NO.
VIII COLORADO STA 0471-020 45

REVISIONS

BAR LIST - ABUTMENT NO. 1

MARK	NO. REQ'D.	LENGTH	TYPE	DIMENSIONS		
				A	B	C
1A900	8	39'-8"				
1A800	80	21'-2"	VIII	9'-8"	2'-2"	
1A801	80	4'-2"	VI	1'-0"	2'-2"	
1A500	8	39'-8"				
1A800	42	8'-3"	IV	1'-4"	5'-7"	
1A802	42	4'-8"	IX	1'-0"	3'-8"	
1A801	44	24'-0"				
1A501	2	25'-0"				
1A400	16	24'-8"	IX	0'-8"	24'-0"	
1A901	8	28'-0"				
1A401	34	18'-8"	VIII	9'-0"	0'-8"	
1A402	34	6'-8"	VI	3'-0"	0'-8"	
1A403	34	3'-0"	X	0'-4"	0'-8"	2'-0"

BAR SUMMARY

1359 LIN. FT. # 4 BARS @ 0.668 LB./FT. = 908 LBS.
288 LIN. FT. # 5 BARS @ 1.043 LB./FT. = 300 LBS.
2216 LIN. FT. # 6 BARS @ 1.502 LB./FT. = 3328 LBS.
1403 LIN. FT. # 8 BARS @ 2.670 LB./FT. = 3748 LBS.
485 LIN. FT. # 9 BARS @ 3.400 LB./FT. = 1650 LBS.
TOTAL = 9932 LBS.

BAR LIST-APPROACH SLAB CORBEL K-18-EX

MARK	NO. REQ'D.	LENGTH	TYPE	DIMENSIONS		
				A	B	C
X800	58	3'-8"	XV	2'-0"	1'-6"	
X801	88	2'-8"	XIII	0'-7"	2'-1"	
X802	88	3'-2"	XIV	0'-7"	0'-7"	2'-0"
X500	8	41'-8"				

BAR SUMMARY

332 LIN. FT. # 5 BARS @ 1.043 LB./FT. = 348 LBS.
705 LIN. FT. # 6 BARS @ 1.502 LB./FT. = 1059 LBS.
TOTAL = 1405 LBS.

BAR LIST - ABUTMENT NO. 2

MARK	NO. REQ'D.	LENGTH	TYPE	DIMENSIONS		
				A	B	C
2A900	8	39'-8"				
2A800	80	22'-2"	VIII	10'-0"	2'-2"	
2A801	80	4'-2"	VI	1'-0"	2'-2"	
2A500	8	39'-8"				
2A800	41	8'-3"	IV	1'-4"	5'-7"	
2A802	41	4'-8"	IX	1'-0"	3'-8"	
2A801	43	24'-0"				
2A501	2	25'-0"				
2A400	15	24'-8"	IX	0'-8"	24'-0"	
2A901	8	28'-0"				
2A401	34	18'-8"	VIII	9'-0"	0'-8"	
2A402	34	6'-8"	VI	3'-0"	0'-8"	
2A403	34	3'-0"	X	0'-4"	0'-8"	2'-0"

BAR SUMMARY

1334 LIN. FT. # 4 BARS @ 0.668 LB./FT. = 891 LBS.
288 LIN. FT. # 5 BARS @ 1.043 LB./FT. = 300 LBS.
2291 LIN. FT. # 6 BARS @ 1.502 LB./FT. = 3388 LBS.
1370 LIN. FT. # 8 BARS @ 2.670 LB./FT. = 3658 LBS.
485 LIN. FT. # 9 BARS @ 3.400 LB./FT. = 1650 LBS.
TOTAL = 9688 LBS.

BAR LIST - APPROACH SLABS K-18-GA

MARK	NO. REQ'D.	LENGTH	TYPE	DIMENSIONS		
				A	B	C
Z400	52	13'-8"				
Z401	20	37'-8"				
Z402	52	3'-0"	VII	1'-2"	0'-8"	
Z500	16	37'-8"				
Z501	156	7'-10"	V	(AS SHOWN)		
Z502	30	37'-8"				
Z800	92	13'-8"				

BAR SUMMARY

1808 LIN. FT. # 4 BARS @ 0.668 LB./FT. = 1074 LBS.
2946 LIN. FT. # 5 BARS @ 1.043 LB./FT. = 3073 LBS.
1242 LIN. FT. # 8 BARS @ 2.670 LB./FT. = 3316 LBS.
TOTAL = 7463 LBS.

BAR LIST - APPROACH SLABS K-18-EX

MARK	NO. REQ'D.	LENGTH	TYPE	DIMENSIONS		
				A	B	C
Y400	58	13'-8"				
Y401	20	41'-8"				
Y402	58	3'-0"	VII	1'-2"	0'-8"	
Y500	16	41'-8"				
Y501	172	7'-10"	V	(AS SHOWN)		
Y502	30	41'-8"				
Y800	102	13'-8"				

BAR SUMMARY

1787 LIN. FT. # 4 BARS @ 0.668 LB./FT. = 1194 LBS.
3258 LIN. FT. # 5 BARS @ 1.043 LB./FT. = 3396 LBS.
1377 LIN. FT. # 8 BARS @ 2.670 LB./FT. = 3677 LBS.
TOTAL = 8267 LBS.

BAR LIST - SUPERSTRUCTURE


MARK	NO. REQ'D.	LENGTH	TYPE	DIMENSIONS		
				A	B	C
S400	81	188'-8"				
S401	325	28'-4"	I	24'-10"	0'-9"	
S800	325	40'-0"				
S801	325	40'-0"				
S802	14	189'-10"				
S803	33	189'-10"				
S804	162	7'-8"	VI	3'-0"	1'-8"	
S805	162	8'-2"	VI	3'-0"	2'-2"	
S500	16	170'-2"				
S501	9	170'-2"				
S503	652	8'-10"	VII	10"	7'-2"	
S504	328	9'-1"	II	7'-5"	10"	
S505	328	9'-1"	III	7'-5"	10"	
S506	40	170'-2"				
S507	28	38'-8"				
S402	8	38'-8"				
S806	4	40'-0"				
S806	52	3'-8"				
S800	8	40'-0"				
S506	8	5'-3"				
S510	8	4'-0"				
S408	1	7'-6"	IV	2'-6"	2'-8"	
S403	2	5'-3"				
S807	12	9'-6"	XI	3'-8"	2'-0"	
S806	12	8'-8"	XI	3'-0"	2'-0"	
S406	178	1'-8"				
S404	80	2'-8"	IX	1'-8"	1'-0"	
S405	32	7'-0"				
S408	120	2'-0"	XII	0'-8"	0'-8"	0'-8"
S407	48	7'-0"				

BAR SUMMARY


10102 LIN. FT. # 4 BARS @ 0.668 LB./FT. = 6748 LBS.
12401 LIN. FT. # 5 BARS @ 1.043 LB./FT. = 12934 LBS.
23949 LIN. FT. # 6 BARS @ 1.502 LB./FT. = 35989 LBS.
320 LIN. FT. # 9 BARS @ 3.400 LB./FT. = 1088 LBS.
TOTAL = 56739 LBS.
13682 LIN. FT. # 4 BARS @ 0.668 LB./FT. = 9126 LBS.
11679 LIN. FT. # 5 BARS @ 1.043 LB./FT. = 13559 LBS.
13000 LIN. FT. # 6 BARS @ 1.502 LB./FT. = 19526 LBS.
TOTAL = 42211 LBS.

NOTE: Any Reinforcing paid for in items other than item 602, Reinforcing Steel are not shown on the bar list.

BENDING DIAGRAMS

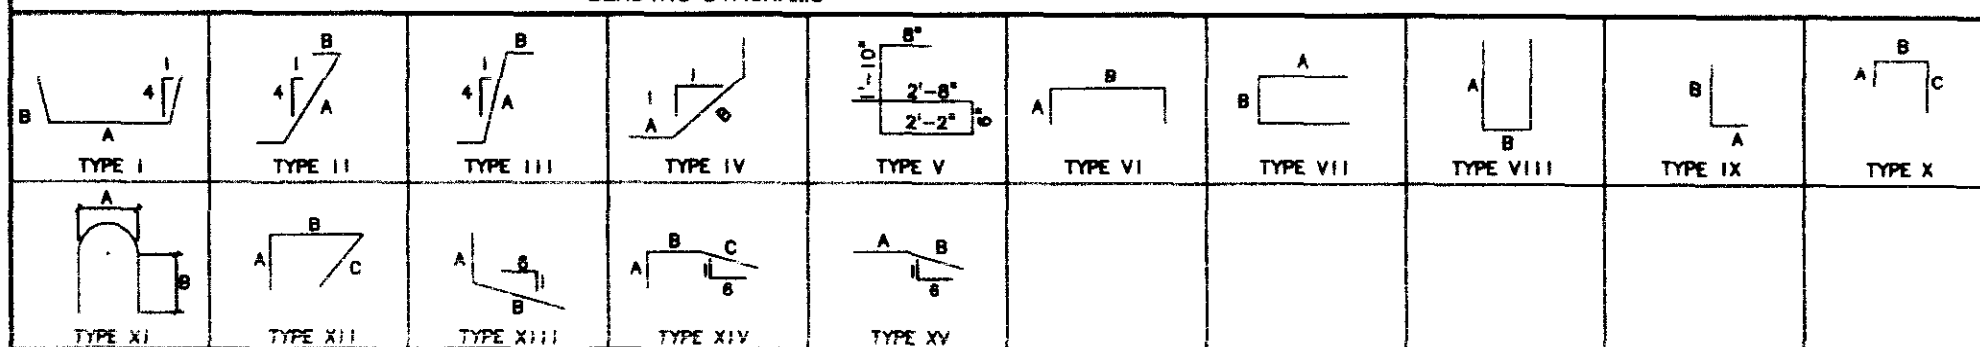

LEGEND

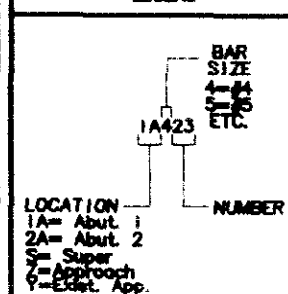

DEPARTMENT OF TRANSPORTATION

S.H. 47 OVER TROY AVENUE
PUEBLO, COLORADO

BAR LISTS

Designer G. Tsakouvaras Structure K-18-GA
Detailer K. Erickson Numbers K-18-EX
Drawing Number B25 of 31 Drawings

Revision Dates (Preliminary Stage Only)

NOTE: ELEVATIONS ARE
AT TOP OF CONCRETE
DECK 0.1667' BELOW
FINISHED GRADE.

DEPARTMENT OF TRANSPORTATION
S.H. 47 OVER TROY AVENUE
PUEBLO, COLORADO

BRIDGE DECK ELEVATIONS

Designer G. Tsiouvaras	Structure Numbers	K-18-GA
Detailer K. Erickson		
Drawing Number B 26 of 31 Drawings		

Revision Dates (Preliminary Stage Only)

AS CONSTRUCTED

NO REVISIONSREVISEDVOID

FEDERAL ROAD REGION NO.	DIVISION	PROJECT NUMBER	SHEET NO.
VIII	COLORADO	STA 0471-020	47

REVISIONS		


BRIDGE STANDARD I

ROADWAY APPROACHES

ELEVATIONS ARE AT FINISHED GRADE

ELEVATIONS ON ROADWAY APPROACHES (AT FINISHED GRADE)					
STATION	OFFSETS				
	-4.0000	0.0000	12.0000	24.0000	34.0000
148+00.0	4822.20	4822.12	4821.88	4821.64	4821.44
+10.0	22.12	22.04	21.80	21.56	21.36
+20.0	22.03	21.95	21.71	21.47	21.27
+30.0	21.95	21.87	21.63	21.39	21.19
148+40.0	4821.86	4821.78	4821.54	4821.30	4821.10
+50.0	21.78	21.70	21.46	21.22	21.02
+60.0	21.69	21.61	21.37	21.13	20.93
+70.0	21.61	21.53	21.29	21.05	20.85
148+80.0	4821.52	4821.44	4821.20	4820.96	4820.76
+90.0	21.44	21.36	21.12	20.88	20.68
149+00.0	21.35	21.27	21.03	20.79	20.59
+10.0	21.27	21.19	20.95	20.71	20.51
149+20.0	4821.18	4821.10	4820.86	4820.62	4820.42
+30.0	21.10	21.02	20.78	20.54	20.34
+40.0	21.01	20.93	20.69	20.45	20.25
+50.0	20.93	20.85	20.61	20.37	20.17

ELEVATIONS ON ROADWAY APPROACHES (AT FINISHED GRADE)					
STATION	OFFSETS				
	-4.0000	0.0000	12.0000	24.0000	34.0000
151+30.0	4818.02	4818.94	4818.70	4818.46	4818.26
+40.0	18.88	18.80	18.56	18.32	18.12
+50.0	18.73	18.65	18.41	18.17	17.97
+60.0	18.58	18.50	18.26	18.02	17.82
151+70.0	4818.43	4818.35	4818.11	4817.87	4817.67
+80.0	18.27	18.19	17.95	17.71	17.51
+90.0	18.11	18.03	17.79	17.55	17.35
152+00.0	17.95	17.87	17.63	17.39	17.19
152+10.0	4817.78	4817.70	4817.46	4817.22	4817.02
+20.0	17.61	17.53	17.29	17.05	16.85
+30.0	17.43	17.35	17.11	16.87	16.67
+40.0	17.28	17.18	16.94	16.70	16.50
152+50.0	4817.07	4816.99	4816.75	4816.51	4816.31
+60.0	16.88	16.80	16.56	16.32	16.12
+70.0	16.69	16.61	16.37	16.13	15.93
+80.0	16.50	16.42	16.18	15.94	15.74

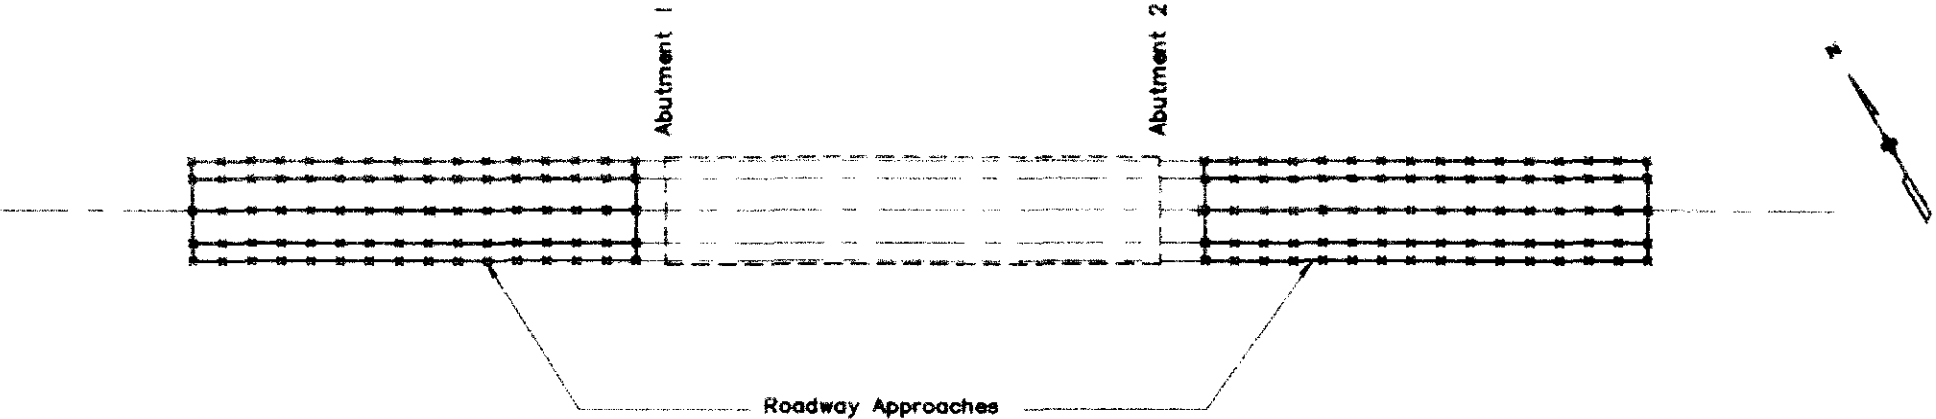

TANGENT ALIGNMENT

DEPARTMENT OF TRANSPORTATION

S.H. 47 OVER TROY AVENUE
PUEBLO, COLORADO

ROADWAY APPROACHES

Designer	G. Tsouvaros	Structure	K-18-GA
Detaller	T. Rick	Numbers	
Drawing Number	B 27	of	31 Drawings



INITIAL	DATE	CHECKED BY	DATE
DESIGNED BY	1/28	1/28	1/28
CHECKED BY	1/28	1/28	1/28
DETAILS BY	1/28	1/28	1/28


F117B

WORK NAME

AS CONSTRUCTED		
NO REVISIONS	REVISED	VOID

FEDERAL ROAD REGION NO.	DIVISION	PROJECT NUMBER	SHEET NO.
VIII	COLORADO	STA 0471-020	4B

REVISIONS	

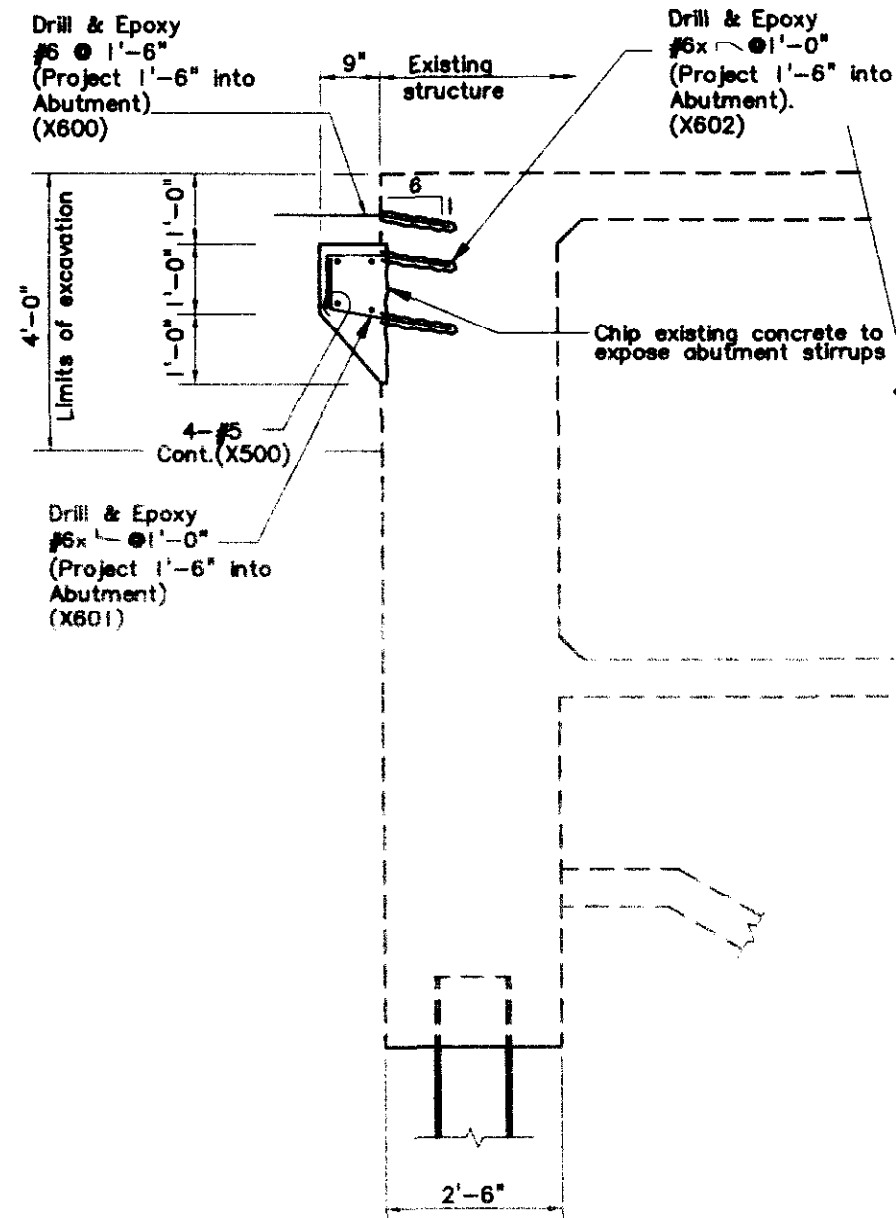


B28
A SECTION


DEPARTMENT OF TRANSPORTATION		
S.H. 47 OVER TROY AVENUE PUEBLO, COLORADO		
APPROACH SLAB RETROFIT DETAILS		
Designer G. Tsionvaras	Structure	K-18-EX
Detailer K. Erickson	Numbers	
Drawing Number	B28 of 31	Drawings




Revision Dates	(Preliminary Stage Only)
----------------	--------------------------

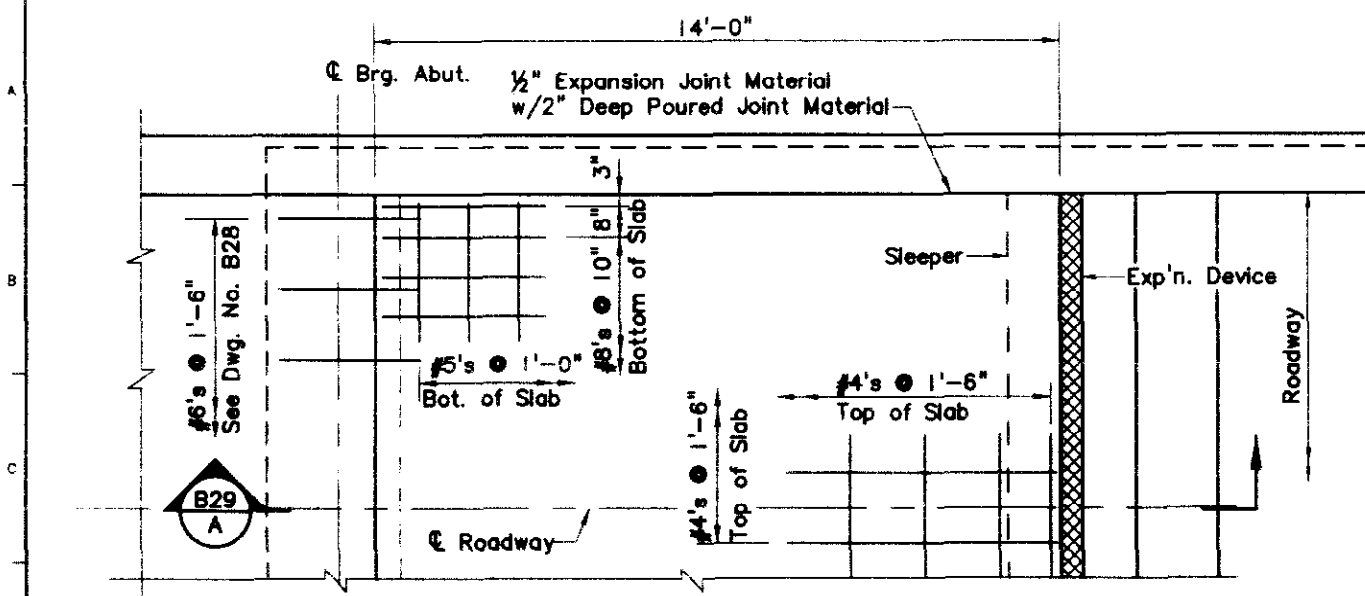


PLAN

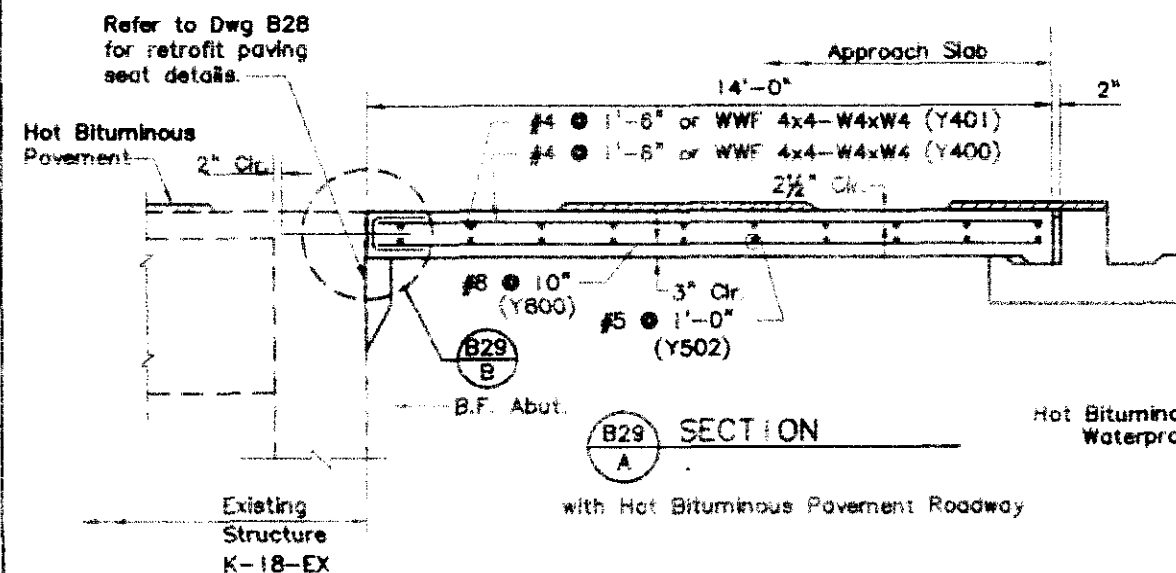


B29 SECTION

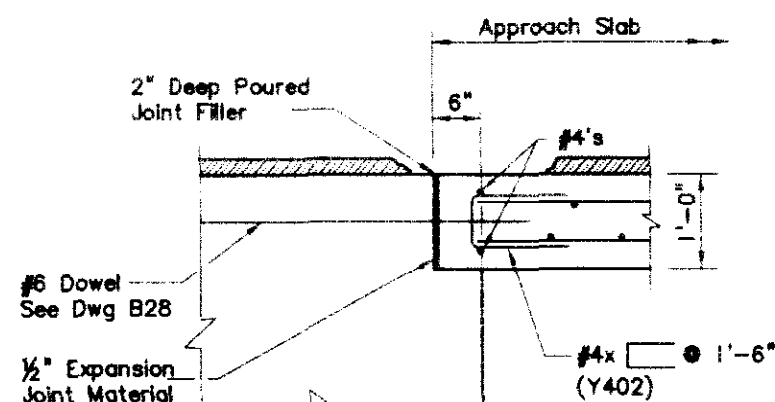

B29 DETAIL

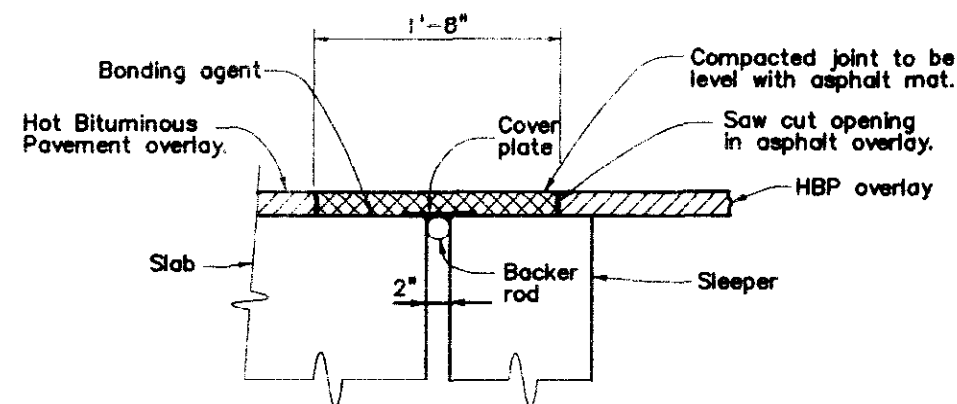

JOINT DETAIL

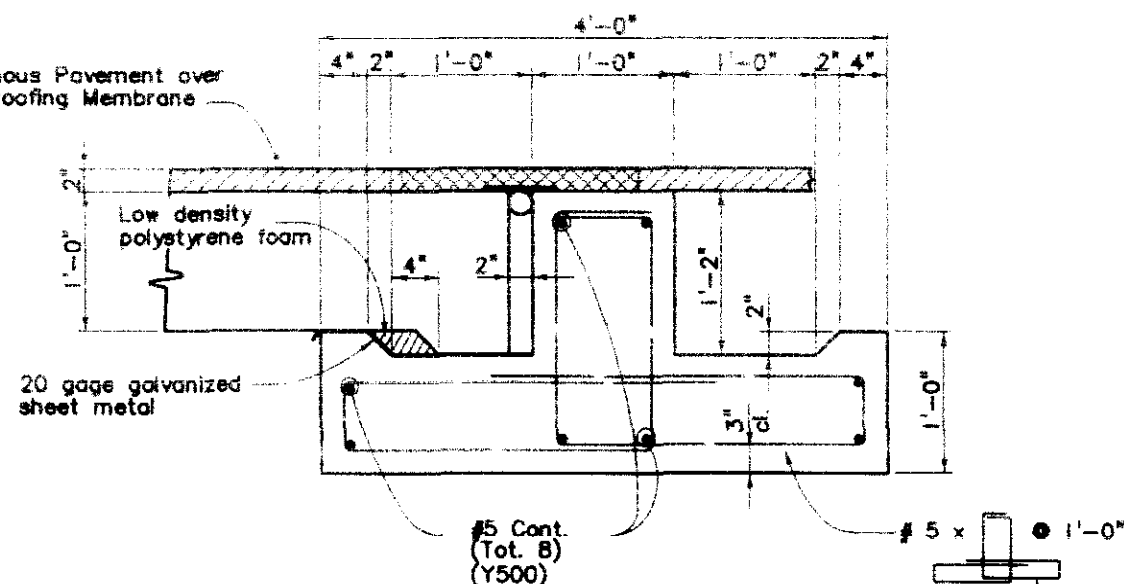

SLEEPER SECTION

Taken normal to expansion device
 Sleeper may be precast.



AS CONSTRUCTED

NO REVISIONS ☐ REVISED ☐ VOID ☐

FEDERAL ROAD REGION NO.	DIVISION	PROJECT NUMBER	SHEET NO.
VIII	COLORADO	STA 0471-020	49

REVISIONS			

B-601-1A

NOTES

Concrete Class D (Bridge) shall be used for approach slabs.

1/2" expansion joint material shall meet
A.A.S.H.T.O. Spec. M213.

The expansion joint system shall include all labor and materials to install the expansion joint according to the Manufacturer's directions and according to these plans.

The backer rod shall be secured and sealed according to the Manufacturer's directions.

The cover plate shall be the size and type recommended by the Manufacturer and installed in accordance with the Manufacturer's directions.

The joint bonding agent shall be the type recommended by the Manufacturer for the joint system being installed. It shall be applied according to the Manufacturer's recommendations.

All surfaces in joint opening shall be cleaned according to the Manufacturer's directions.

The joints shall be installed and compacted according to the Manufacturer's procedures.

The finished joint, after compacting, shall be flush with the top of the adjacent asphalt surface.

A representative of the Manufacturer shall be on site prior to installing the expansion joints and shall approve the methods and materials before work commences.

See Special Provisions for Bridge Expansion Device
(0"-2")


ACCEPTABLE ALTERNATES

Koch B J S System
Linear Dynamics Thorma-Joint
Watson Bowman Acme Expandex


DEPARTMENT OF TRANSPORTATION		
S.H.47 OVER TROY AVENUE PUEBLO, COLORADO		
APPROACH SLAB DETAILS		
Designer G. Talouvaras	Structure	K-18-EX
Detailer K. Erickson	Numbers	
Drawing Number	B29 of 31	Drawings

INSTRUCTED	FEDERAL ROAD REGION NO.	DIVISION	PROJECT NUMBER	SHEET NO.
NO REVISIONS	VIII	COLORADO	STA 0471-020	50


REVISIONS		

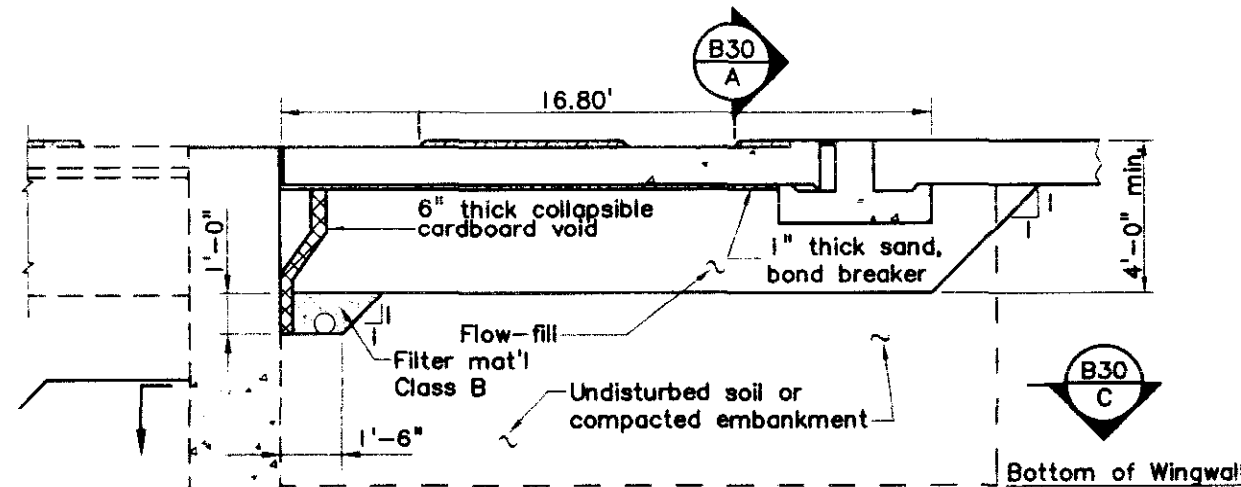

SECTION PERPENDICULAR TO ABUTMENT

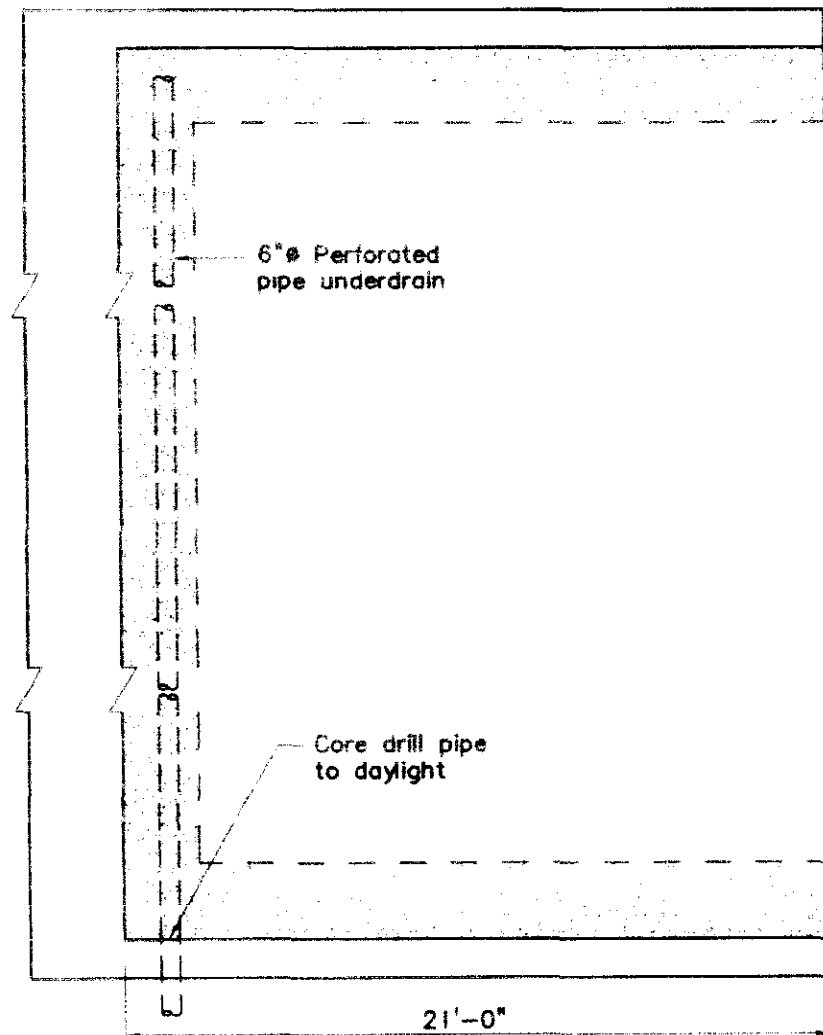

SECTION C
(Symmetrical about C)

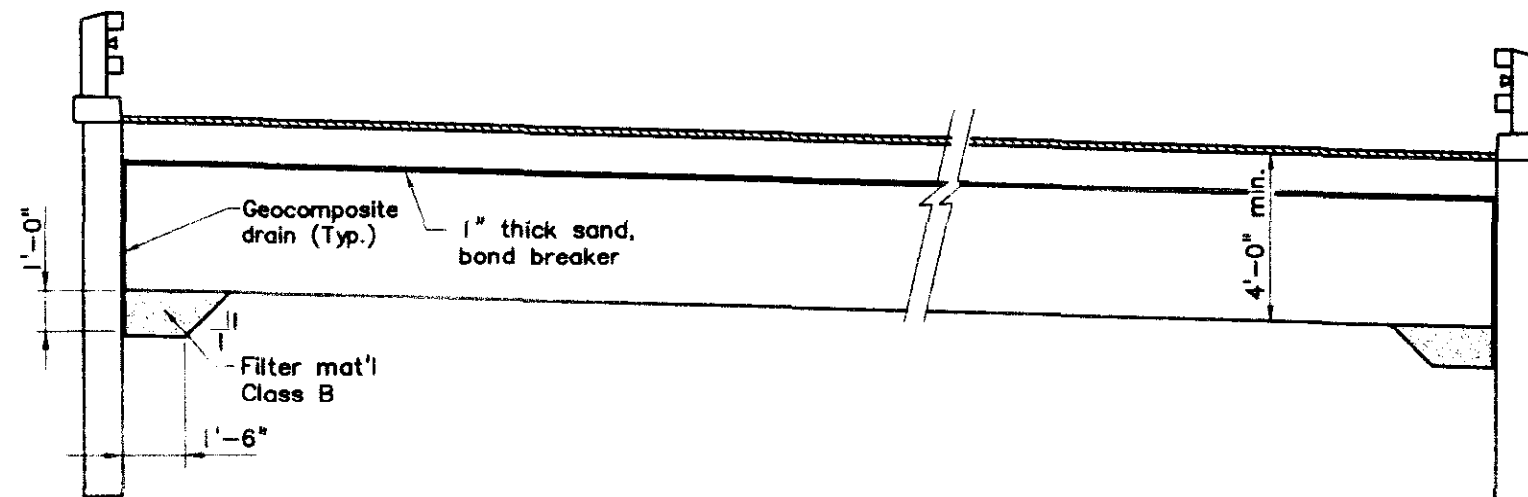

SECTION A

6" Perforated Pipe Underdrain includes all Filter material and Geotextile. Quantity shown is measured along the Perforated Pipe from inside face to inside face of wingwalls.

For Information Only

		Location	
Item No.	Description	Units	Abut. 1 Abut. 2
605	6" Perforated Pipe Underdrain	Lin. Ft.	42 42
605	Geocomposite Drain	Sq. Yd.	18 18
605	Subsurface Drain Outlet	Lin. Ft.	5 5

Sand bond breaker, cardboard void, Geocomposite Drain, 6" Perforated Pipe Underdrain, Core drilling and Subsurface Drain outlet (6" nonperforated pipe) will not be measured or paid for separately but shall be included in the work.

Installation of Perforated Pipe Underdrain, Subsurface Drain Outlet, and Geocomposite Drain will conform to the Construction requirement of section 605.03, 605.06 and 605.04, respectively.



DEPARTMENT OF TRANSPORTATION		
S.H.47 OVER TROY AVENUE PUEBLO, COLORADO		
STRUCTURE BACKFILL (FLOW-FILL)		
Designer G. Tsilouvaras	Structure Numbers	K-18-EX
Detailer K. Erickson	Numbers	
Drawing Number	30 of 31	Drawings

DESIGNED BY	DATE	CHECKED BY	DATE
INITIAL	DATE	INITIAL	DATE
BY	BY	BY	BY
BY	BY	BY	BY

FEDERAL ROAD REGION NO.	DIVISION	PROJECT NUMBER	SHEET NO.
VIII	COLORADO	STA 0471-020	51

REVISIONS		

GENERAL NOTES

ALL TUBES SHALL BE FABRICATED FROM ASTM A500 GRADE B.
ALL POSTS SHALL BE FABRICATED FROM ASTM A36 STEEL.

THE ABOVE MATERIAL AND ALL ANCHOR BOLTS AND MISCELLANEOUS BOLTS, NUTS, AND WASHERS SHALL BE GALVANIZED AFTER FABRICATION, IN ACCORDANCE WITH SECTION 509.

CONCRETE, REINFORCING STEEL, AND STRUCTURAL STEEL ELEMENTS SHALL CONFORM TO THE REQUIREMENTS OF SECTIONS 601, 602, AND 509, RESPECTIVELY.

POST ANCHOR, ENCASED IN CONCRETE, SHALL BE ASTM A36
OR AASHTO M108 STEEL, AS NOTED, AND NEED NOT BE
GALVANIZED.

THE TUBES SHALL BE SHOP BENT OR FABRICATED TO FIT HORIZONTAL CURVE WHEN RADIUS IS LESS THAN 1500 FEET.

TUBES SHALL BE CONTINUOUS OVER NOT LESS THAN TWO POSTS.

THE CENTERLINE OF THE POSTS AT THE BRIDGE EXPANSION DEVICE SHALL BE A MINIMUM OF 3'-0" FROM THE CENTERLINE OF THE BRIDGE EXPANSION DEVICE, MEASURED ALONG THE CENTERLINE OF POSTS.

ALL BOLTS THAT HAVE LOCK WASHERS SHALL BE TIGHTENED TO SNUG ONLY.

POSTS SHALL BE PERPENDICULAR TO THE GRADE OF THE DECK.

ONE OR MORE 12'-6" POST SPACINGS MAY BE REDUCED (8'-4" MIN.) IN ORDER TO MAINTAIN DIMENSIONS FROM THE END OF THE WINGS AND EXPANSION JOINTS.

OPTIONAL DRAIN HOLE FOR GALVANIZING MAY BE DRILLED,
PUNCHED OR CLIPPED, LEAVING SMOOTH SURFACES AND TRAN-
SITIONS. NO FLAME CUTTING OR AIR CARBON ARC GOUGING IS
ALLOWED.

POSTS, POST ANCHORS, BASE PLATES, BACKING PLATES, ANCHOR BOLTS, MISCELLANEOUS BOLTS, NUTS, WASHERS, TUBES, TUBE EXPANSION DEVICES, TUBE SPLICES, END PLATES, CURB CONCRETE (CLASS D), CURB REINFORCING STEEL, AND REFLECTOR TABS SHALL BE INCLUDED IN ITEM 808, BRIDGE RAIL, TYPE FOR SPECIAL.

PRIOR TO FABRICATION OF THIS ITEM, TWO SETS OF SHOP DRAWINGS WHICH COMPLY WITH THE REQUIREMENTS OF SECTION 105, SHALL BE SUBMITTED TO THE DISTRICT ENGINEER. FOR ONLY ONE SET SHALL BE SENT TO THE COLORADO DIVISION OF HIGHWAYS, STAFF MATERIALS BRANCH, MATERIALS INSPECTION UNIT, 4340 E. LOUISIANA AVENUE, DENVER, COLORADO 80222, AND ONE SET SHALL BE SENT TO THE ENGINEER. THE SHOP DRAWINGS WILL NOT BE APPROVED OR RETURNED.

STRUCTURAL STEEL:
AASHTO M183 (ASTM A36) $f_y = 36,000$ psi
COLD FORMED ASTM A500 GRADE B $f_y = 48,000$ psi

INFORMATION ONLY

DESCRIPTION	UNIT	PER LIN. F.
STRUCTURAL STEEL (GALVANIZED)	LB.	33.1
CONCRETE CLASS D (BRIDGE)	CU.YD.	0.04
REINFORCING STEEL (EPOXY COATED)	LB.	4.0


DEPARTMENT OF TRANSPORTATION

S.H.47 OVER TROY AVENUE
PUEBLO, COLORADO

BRIDGE RAIL REMOVAL AND RETROFIT DETAILS

Designer G. Telouvoras	Structure	K-18-EX
Detailer K. Erickson	Numbers	
Drawing Number	B31 of 31	Drawings

Revision Dates (Preliminary Stage Only)

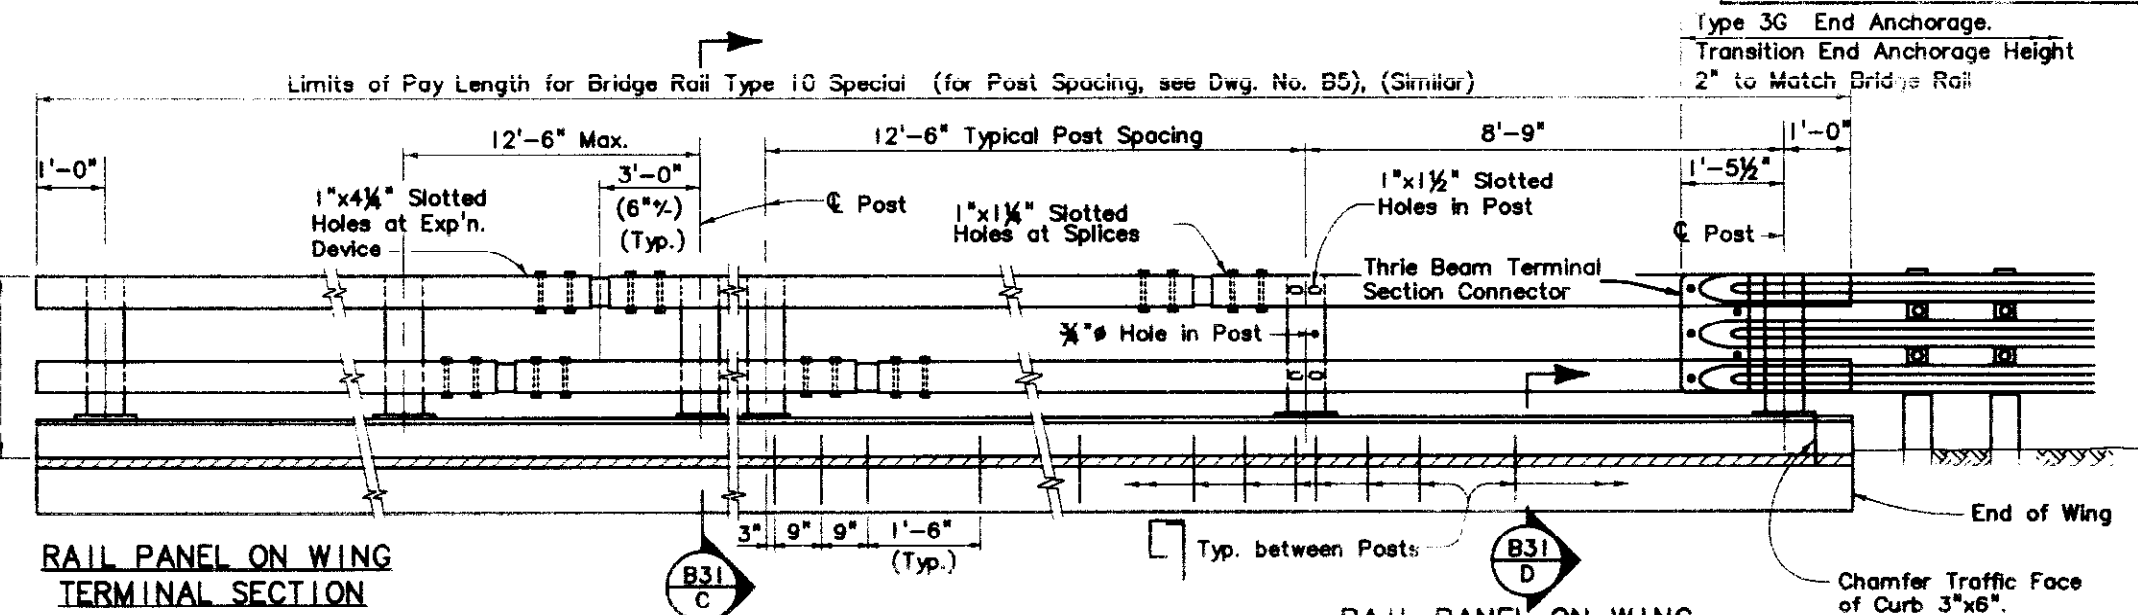


RAIL PANEL ON WING
TERMINAL SECTION
(SEE ROADWAY PLANS FOR ENDS
NOT ATTACHED TO GUARD RAIL.)

ELEVATION - BRIDGE RAIL

Refer to Dwgs. B18-B20 for details not shown
Existing railing above deck or wingwall surface shall be removed. Preserve existing parapet vertical reinforcement.


RAIL PANEL ON WING
TRANSITION SECTION

(SEE ROADWAY PLANS FOR ENDS REQUIRING
ATTACHMENT TO GUARD RAIL)

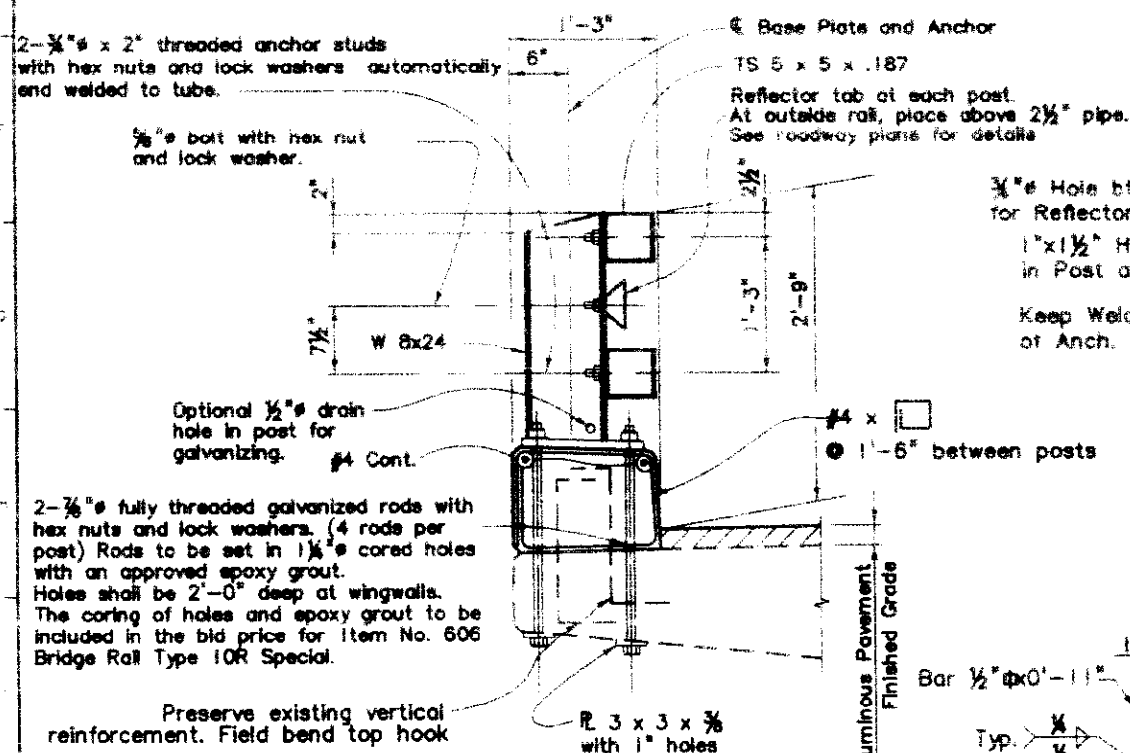


B31 SECTION


NOTE: Outside rails of Str. Nos. K-18-EX and K-18-GA require an additional bicycle railing. Refer to Dwg. B21 for details.

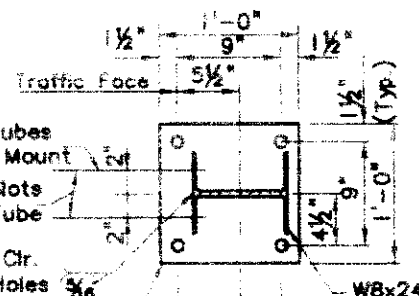

PLAN - POST DETAIL

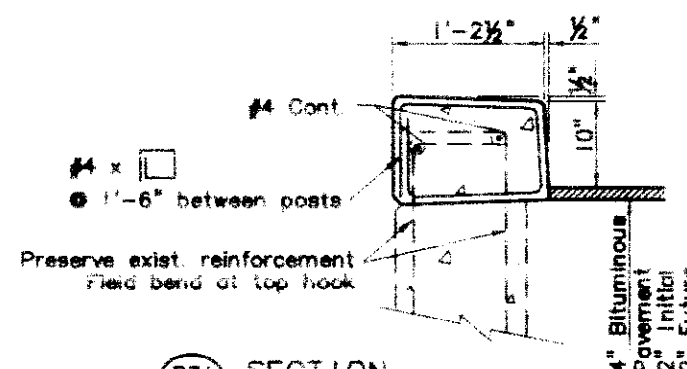


(B3) SECTION

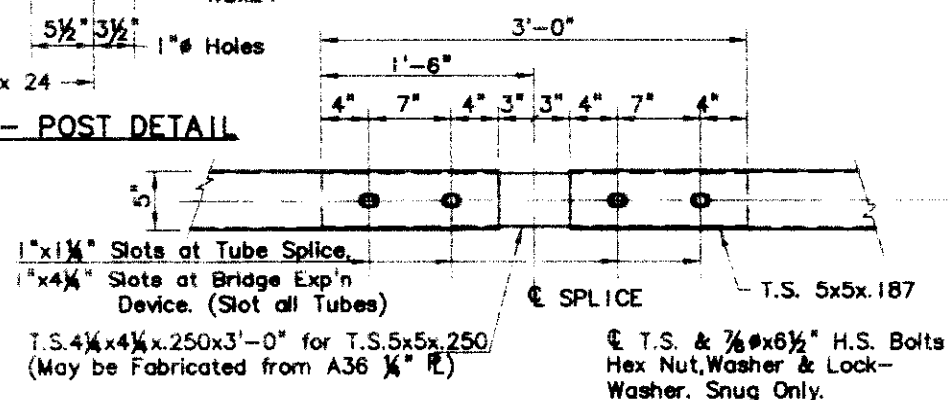

PLAN - TUBE SPLICE

Stagger Top & Bottom Splices into Different Post Spacings, except at Expansion Joint Place at Opposite Ends of Same Post Space. (Range of Motion = $\pm 0"$ at Bridge Expansion Device.)

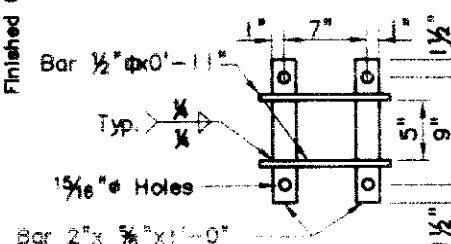

ANCHOR DETAIL
(Applies to wingwall only)

STA 0471-020
12 1994

Kref'd Drawings

PROJECT
SHEET NO. 52

UTILITIES
U.S. WEST
WEST PLAINS ELECTRIC
PUEBLO BOARD OF WATER WORKS
CITY OF PUEBLO SANITARY SEWER
TCI CABLE VISION OF COLORADO
PUBLIC SERVICE COMPANY

LEGEND
△ SURVEY MONUMENT

JERRY MURPHY ROAD

BEGIN PROJECT NO. STA 0471-020
STA. 70+50
BEGIN WIDENING / BEGIN OVERLAY =
STA. 70+50.00 PROJ. NO. FFU 047-1(6) =
M.P. 0.91

STA. 73+46.41 RECD.
REMOVE 31.3 LF EXIST. 24" CSP
AND INLET. INSTALL 30.3 LF
OF 36" RCP WITH END SECTION,
TYPE D INLET 18" LT. & CONC.
HEADWALL, LT.
L.A. = 9.4 AC. (PLUS UPSTREAM)
Q₁₀₀ = 30.2 CFS
D.H.W. = 4778.1'
A.H.W. = 4778.1'
H.W./D₁₀₀ = 1.3
S₁₀₀ = 0.0066 & 0.005 / F
S₁₀₀ W 8 = 89.39' RT.
L = 303 LF
(175' LT & 130' RT)

STA. 73+79.59, 35' RT. (PROJ. C.L.) =
STA. 306+78.78, 20' LT. (RAMP B)
R.P. R = 1.0'

STA. 76+15.39 RECD.
REMOVE 175 LF EXIST.
24" CSP. INSTALL 180 LF
TWIN 36" RCP WITH
CONC. HEADWALL, LT. &
CONCRETE DIVERSION
STRUCTURE, RT.

DIA. = 18.1 AC.
(PLUS UPSTREAM)
Q₁₀₀ = 90.3 CFS
(0 CFS FLOWBY)
D.H.W. = 4790.55'
A.H.W. = 4790.55'
H.W./D₁₀₀ = 1.3
S = 0.0120 / FT.
SKEW = 75.41' RT.
L = 134 LF
(22.06' LT & 57.94' RT)

SEC 18 T20S R64W

ORIGINAL SCALE 1"=50'

MATCH LINE STA. 80+00

SOIL SURVEY
REFER TO "GEOTECHNICAL ENGINEERING
STUDY, STATE HIGHWAY 47,
JERRY MURPHY EAST"
BY GOODSON & ASSOC. INC.
APRIL 7, 1995

T.H. NO. R-1
STA. 68+00, 50.0' LT.
ASPHALT PAVEMENT OVERLYING
BASE COURSE AND SUBBASE
OVER SLIGHTLY SANDY CLAYSTONE.
CLAYSTONE DATA:
A-7-6(16)
LL = 43%
PI = 16%

P.V. STA = 76+50
P.V. ELEV = 4793.50

T.H. NO. R-2
STA. 78+00, 20.0' RT.
SANDY CLAYSTONE
CLAYSTONE DATA:
A-7-6(10)
LL = 36%
PI = 17% R = 20

STA. 70+50.00 BEGIN PROFILE
ELEV. 4776.70

PROFILE GRADE

+2.85%

+2.57%

PVC STA 74+50
PVC ELEV 4788.10

TWIN 36" RCP INV. = 4786.01

APPROXIMATE EXISTING
GROUND ● PROJECT C.L.

PVT STA 78+50
PVT ELEV. 4798.94

400' VC
K = 1428
SSD > 650 FT.
MDS = 60 MPH


MATCH LINE STA. 80+00

67+00 68+00 69+00 70+00 71+00 72+00 73+00 74+00 75+00 76+00 77+00 78+00 79+00 80+00

4776.70
4776.70
4778.11
4778.13
4779.41
4779.55
4780.78
4780.98
4782.12
4782.40
4783.45
4783.83
4784.59
4785.25
4785.98
4786.68
4788.24
4788.10
4789.48
4789.52
4790.65
4790.92
4791.54
4792.30
4792.98
4793.66
4792.99
4795.01
4794.00
4796.34
4795.32
4797.65
4796.55
4798.94
4797.78
4800.23
4799.00
4801.51
4800.27



Project	0471-020
Sheet	53
Scale	1" = 50'
Author	...
Checked	...
Approved	...

DESIGNED BY	...
CHECKED BY	...
IN CHARGE	...
DATE	...
QUANTITIES BY	...
CHECKED BY	...

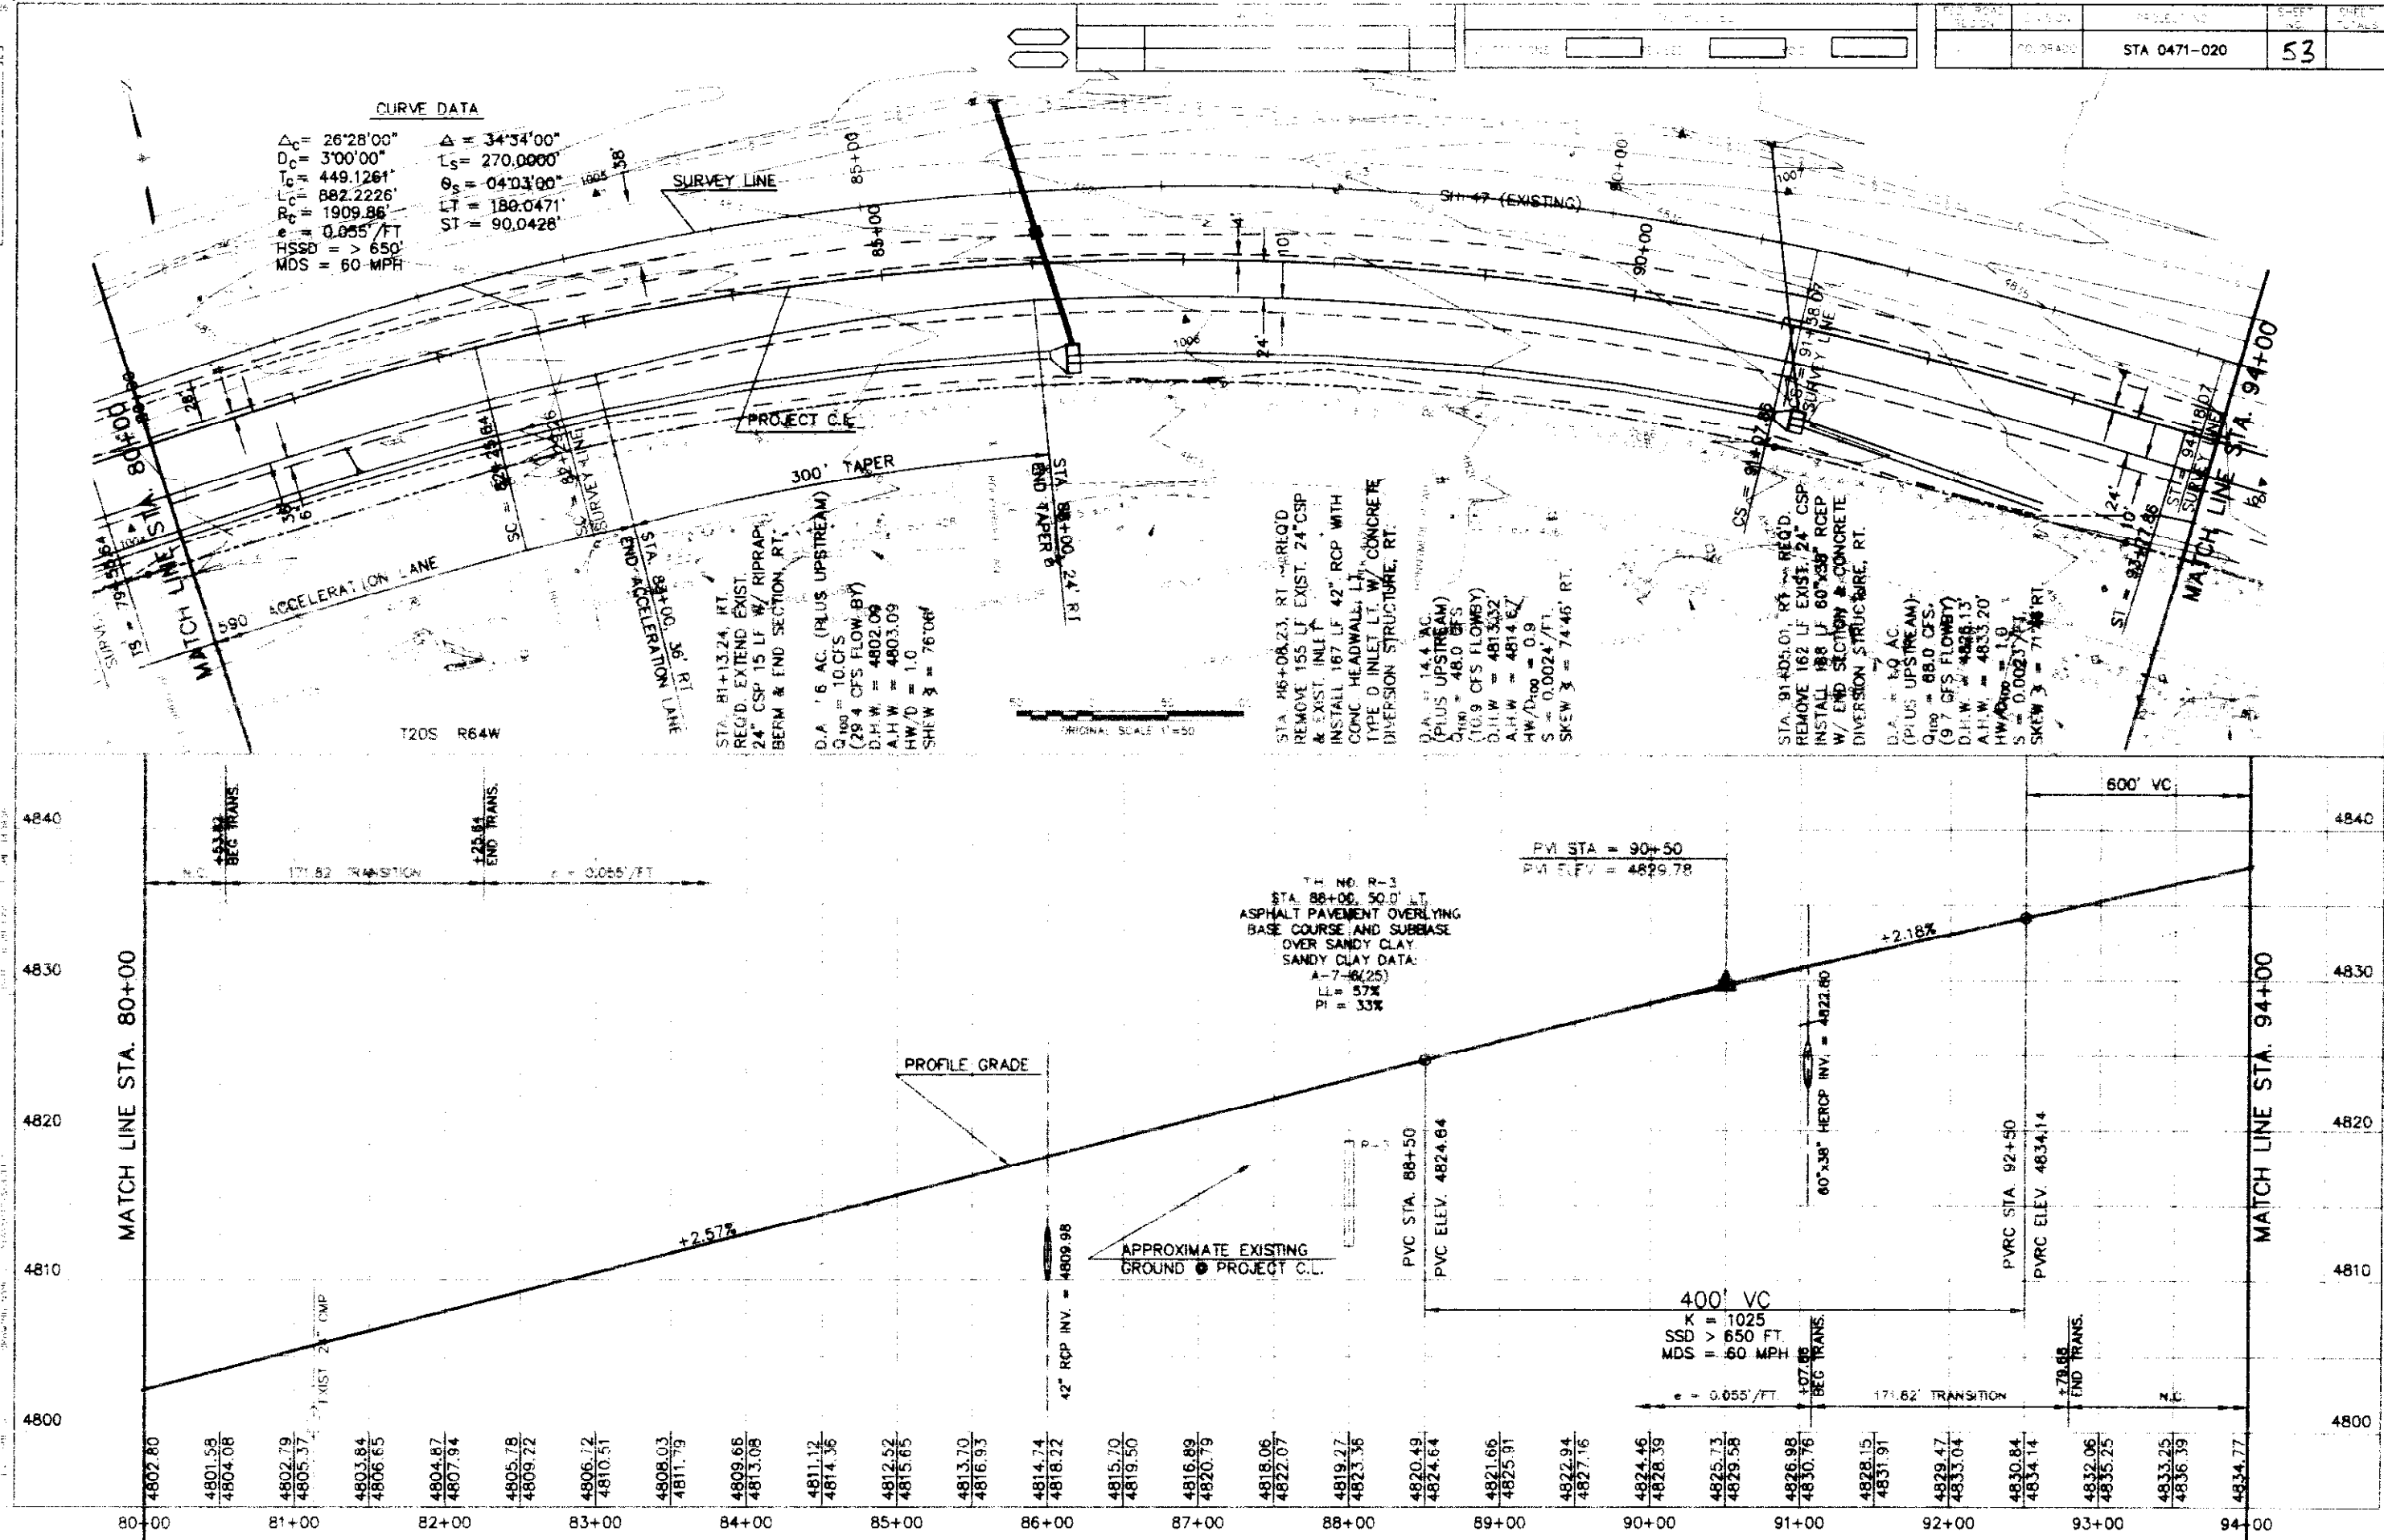

$\frac{1}{2} \times \frac{1}{2} = \frac{1}{4}$


DESIGNED BY	INITIAL DATE	CHECKED BY
CHECKED BY		QUANTITIES BY
DETAILED BY		CHECKED BY

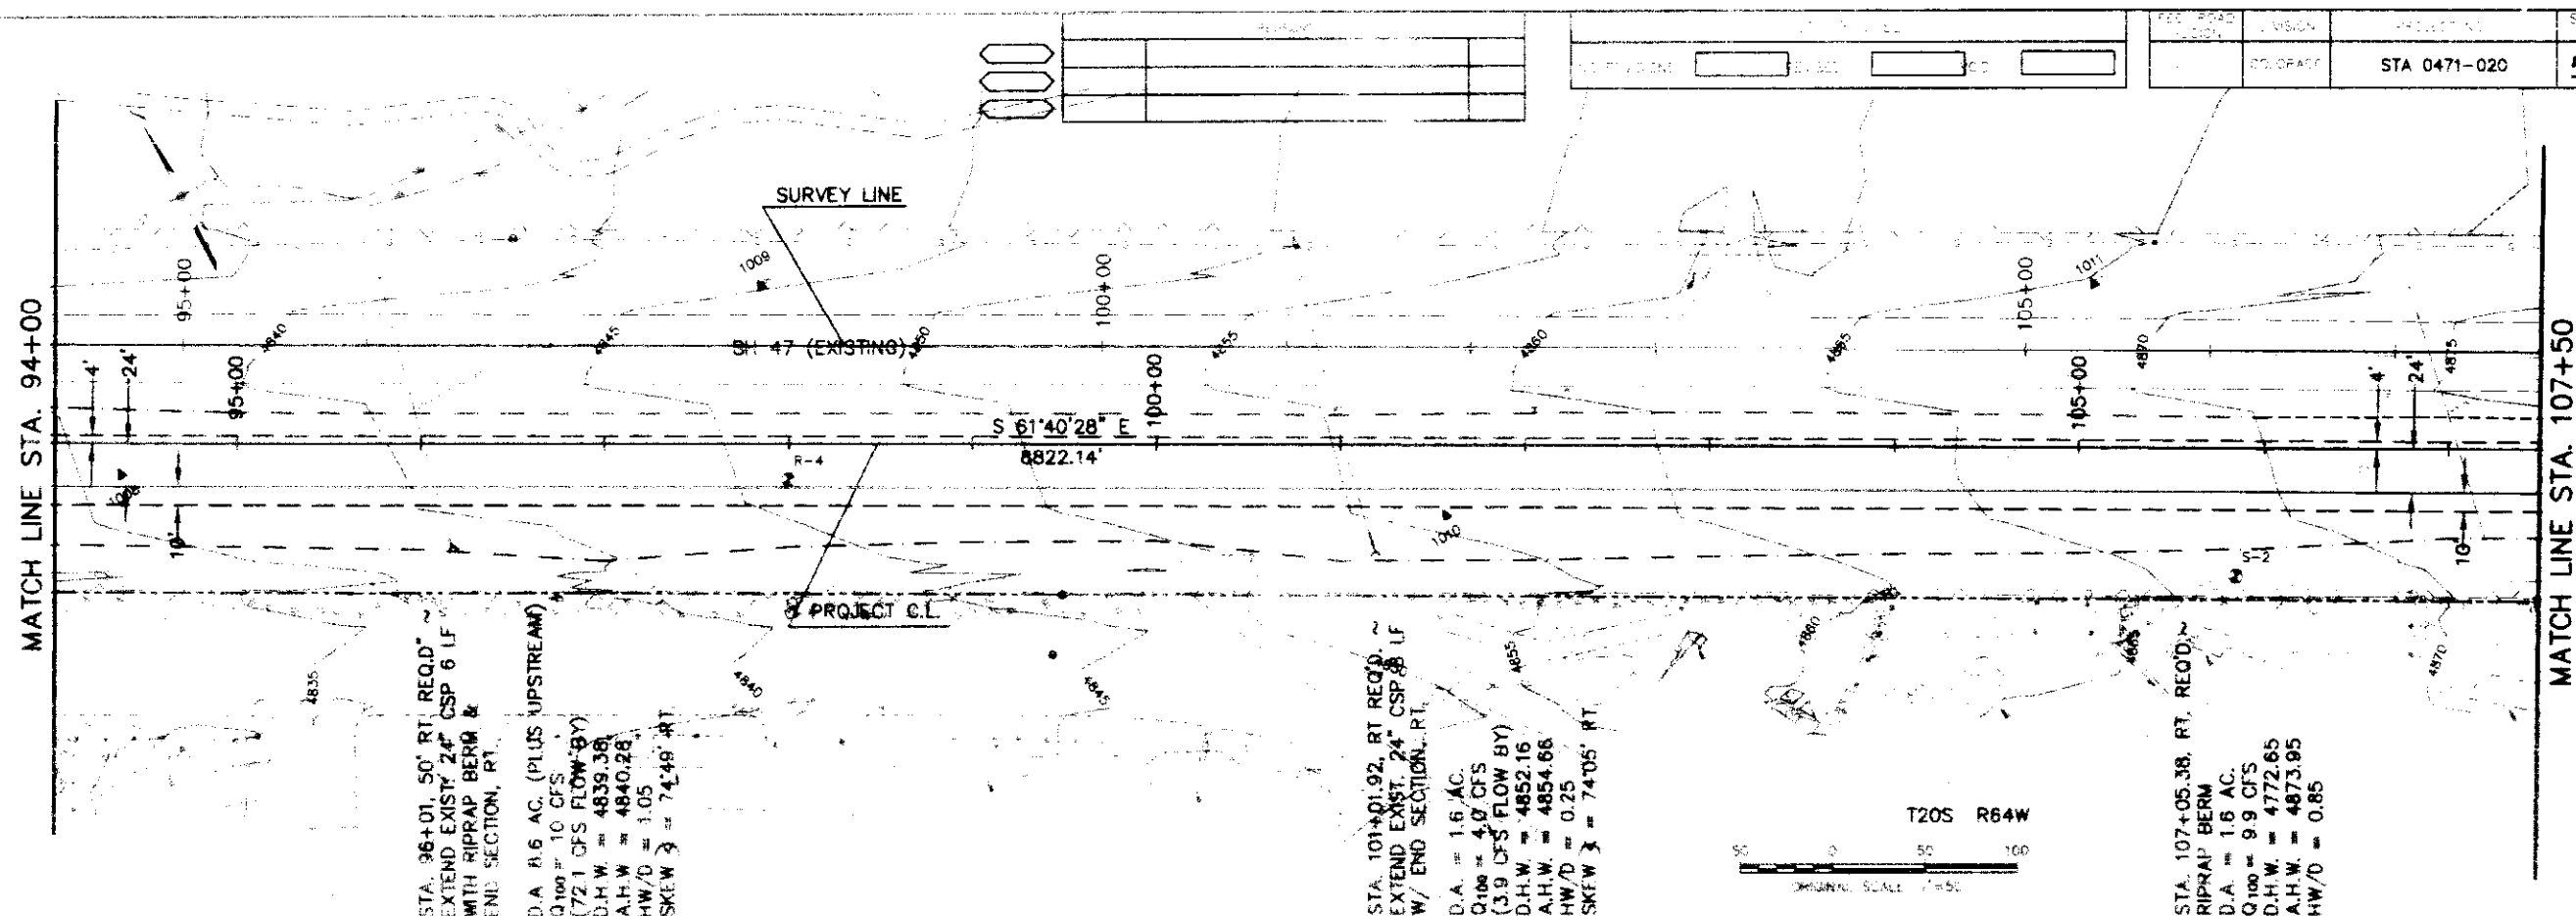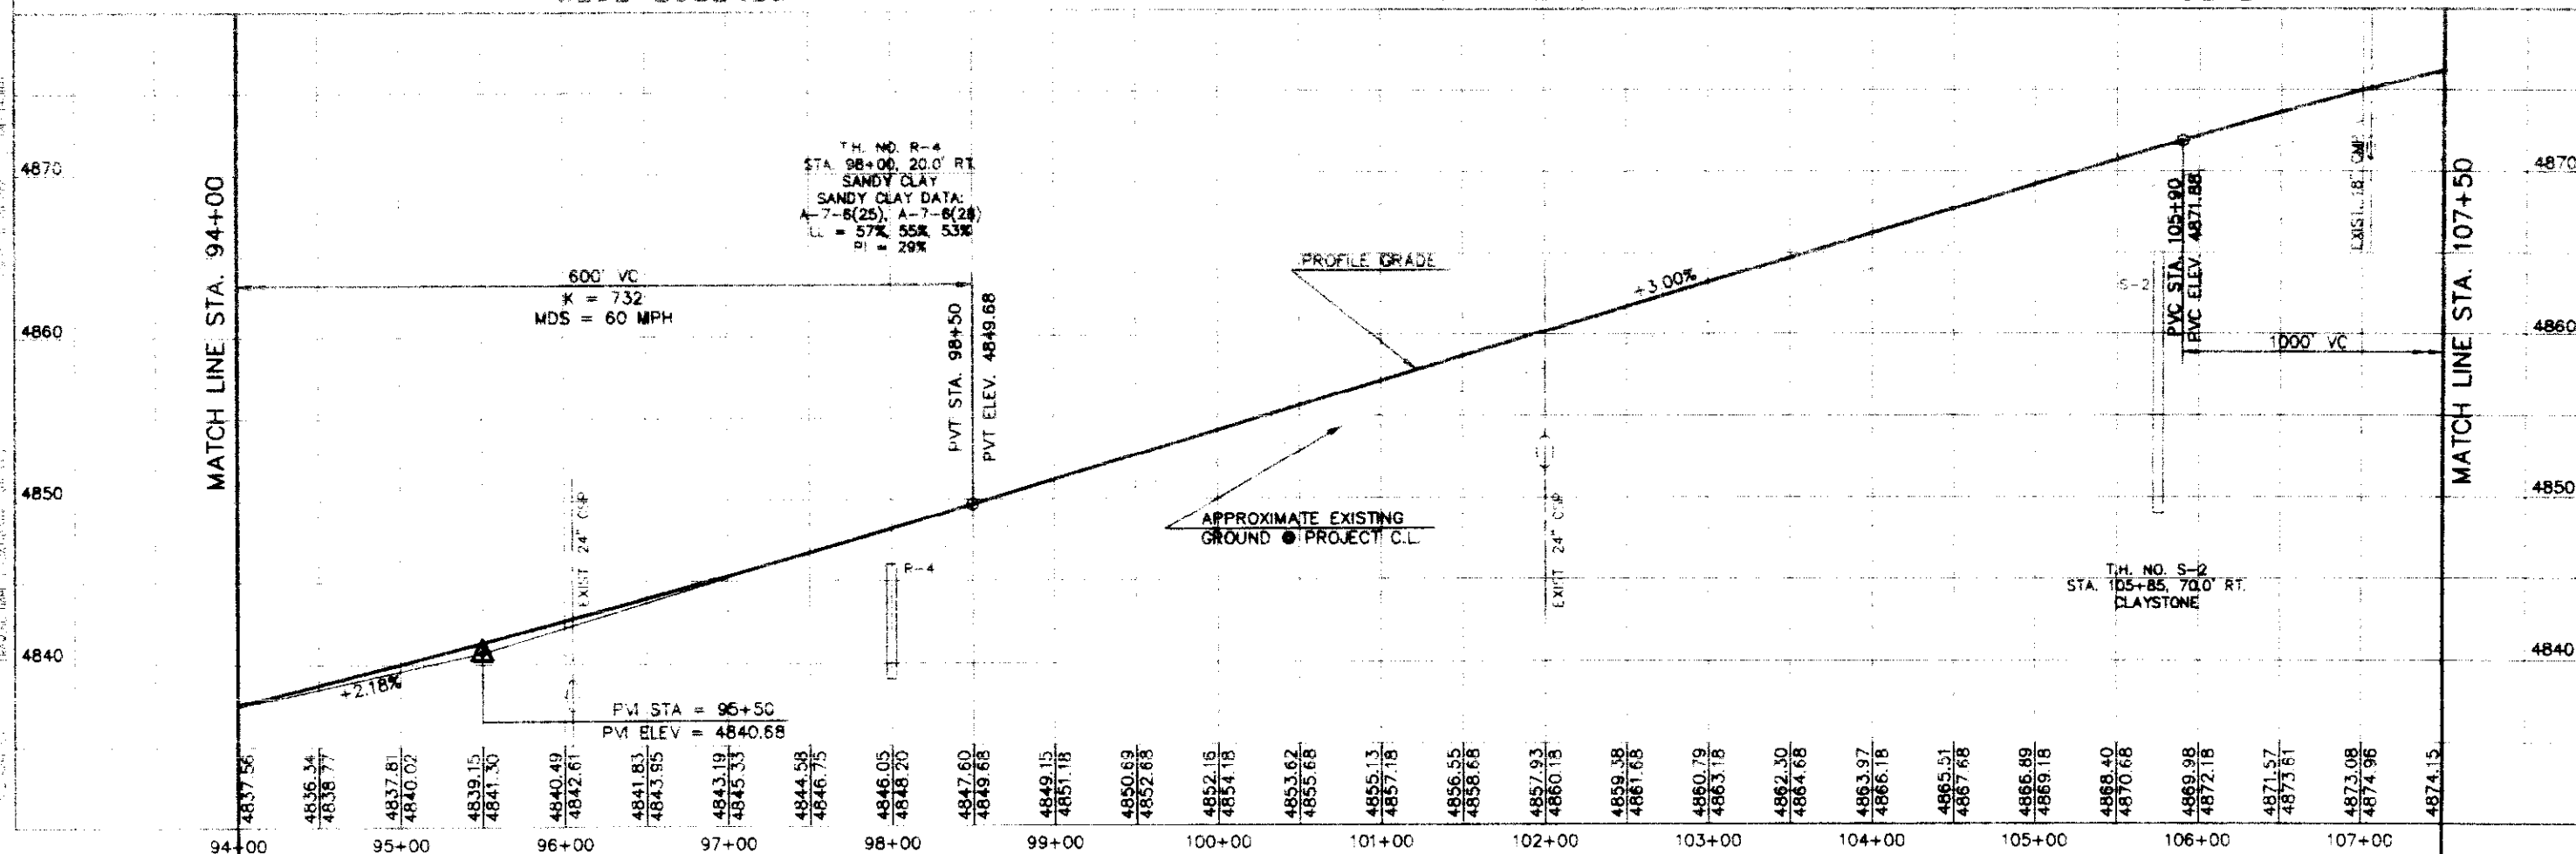



FILE NO.	SECTION	PROJECT NO.	SHEET NO.	SHEET TOTALS
	CO. GRADE	STA 0471-020	54	

Xref'd Drawings
 LOCATION
 PROJECT
 SHEET NO.
 DATE

DESIGNED BY	CHECKED BY	INITIAL	DATE
CHECKED BY	QUANTITIES BY		
DETAILS BY	CHECKED BY		


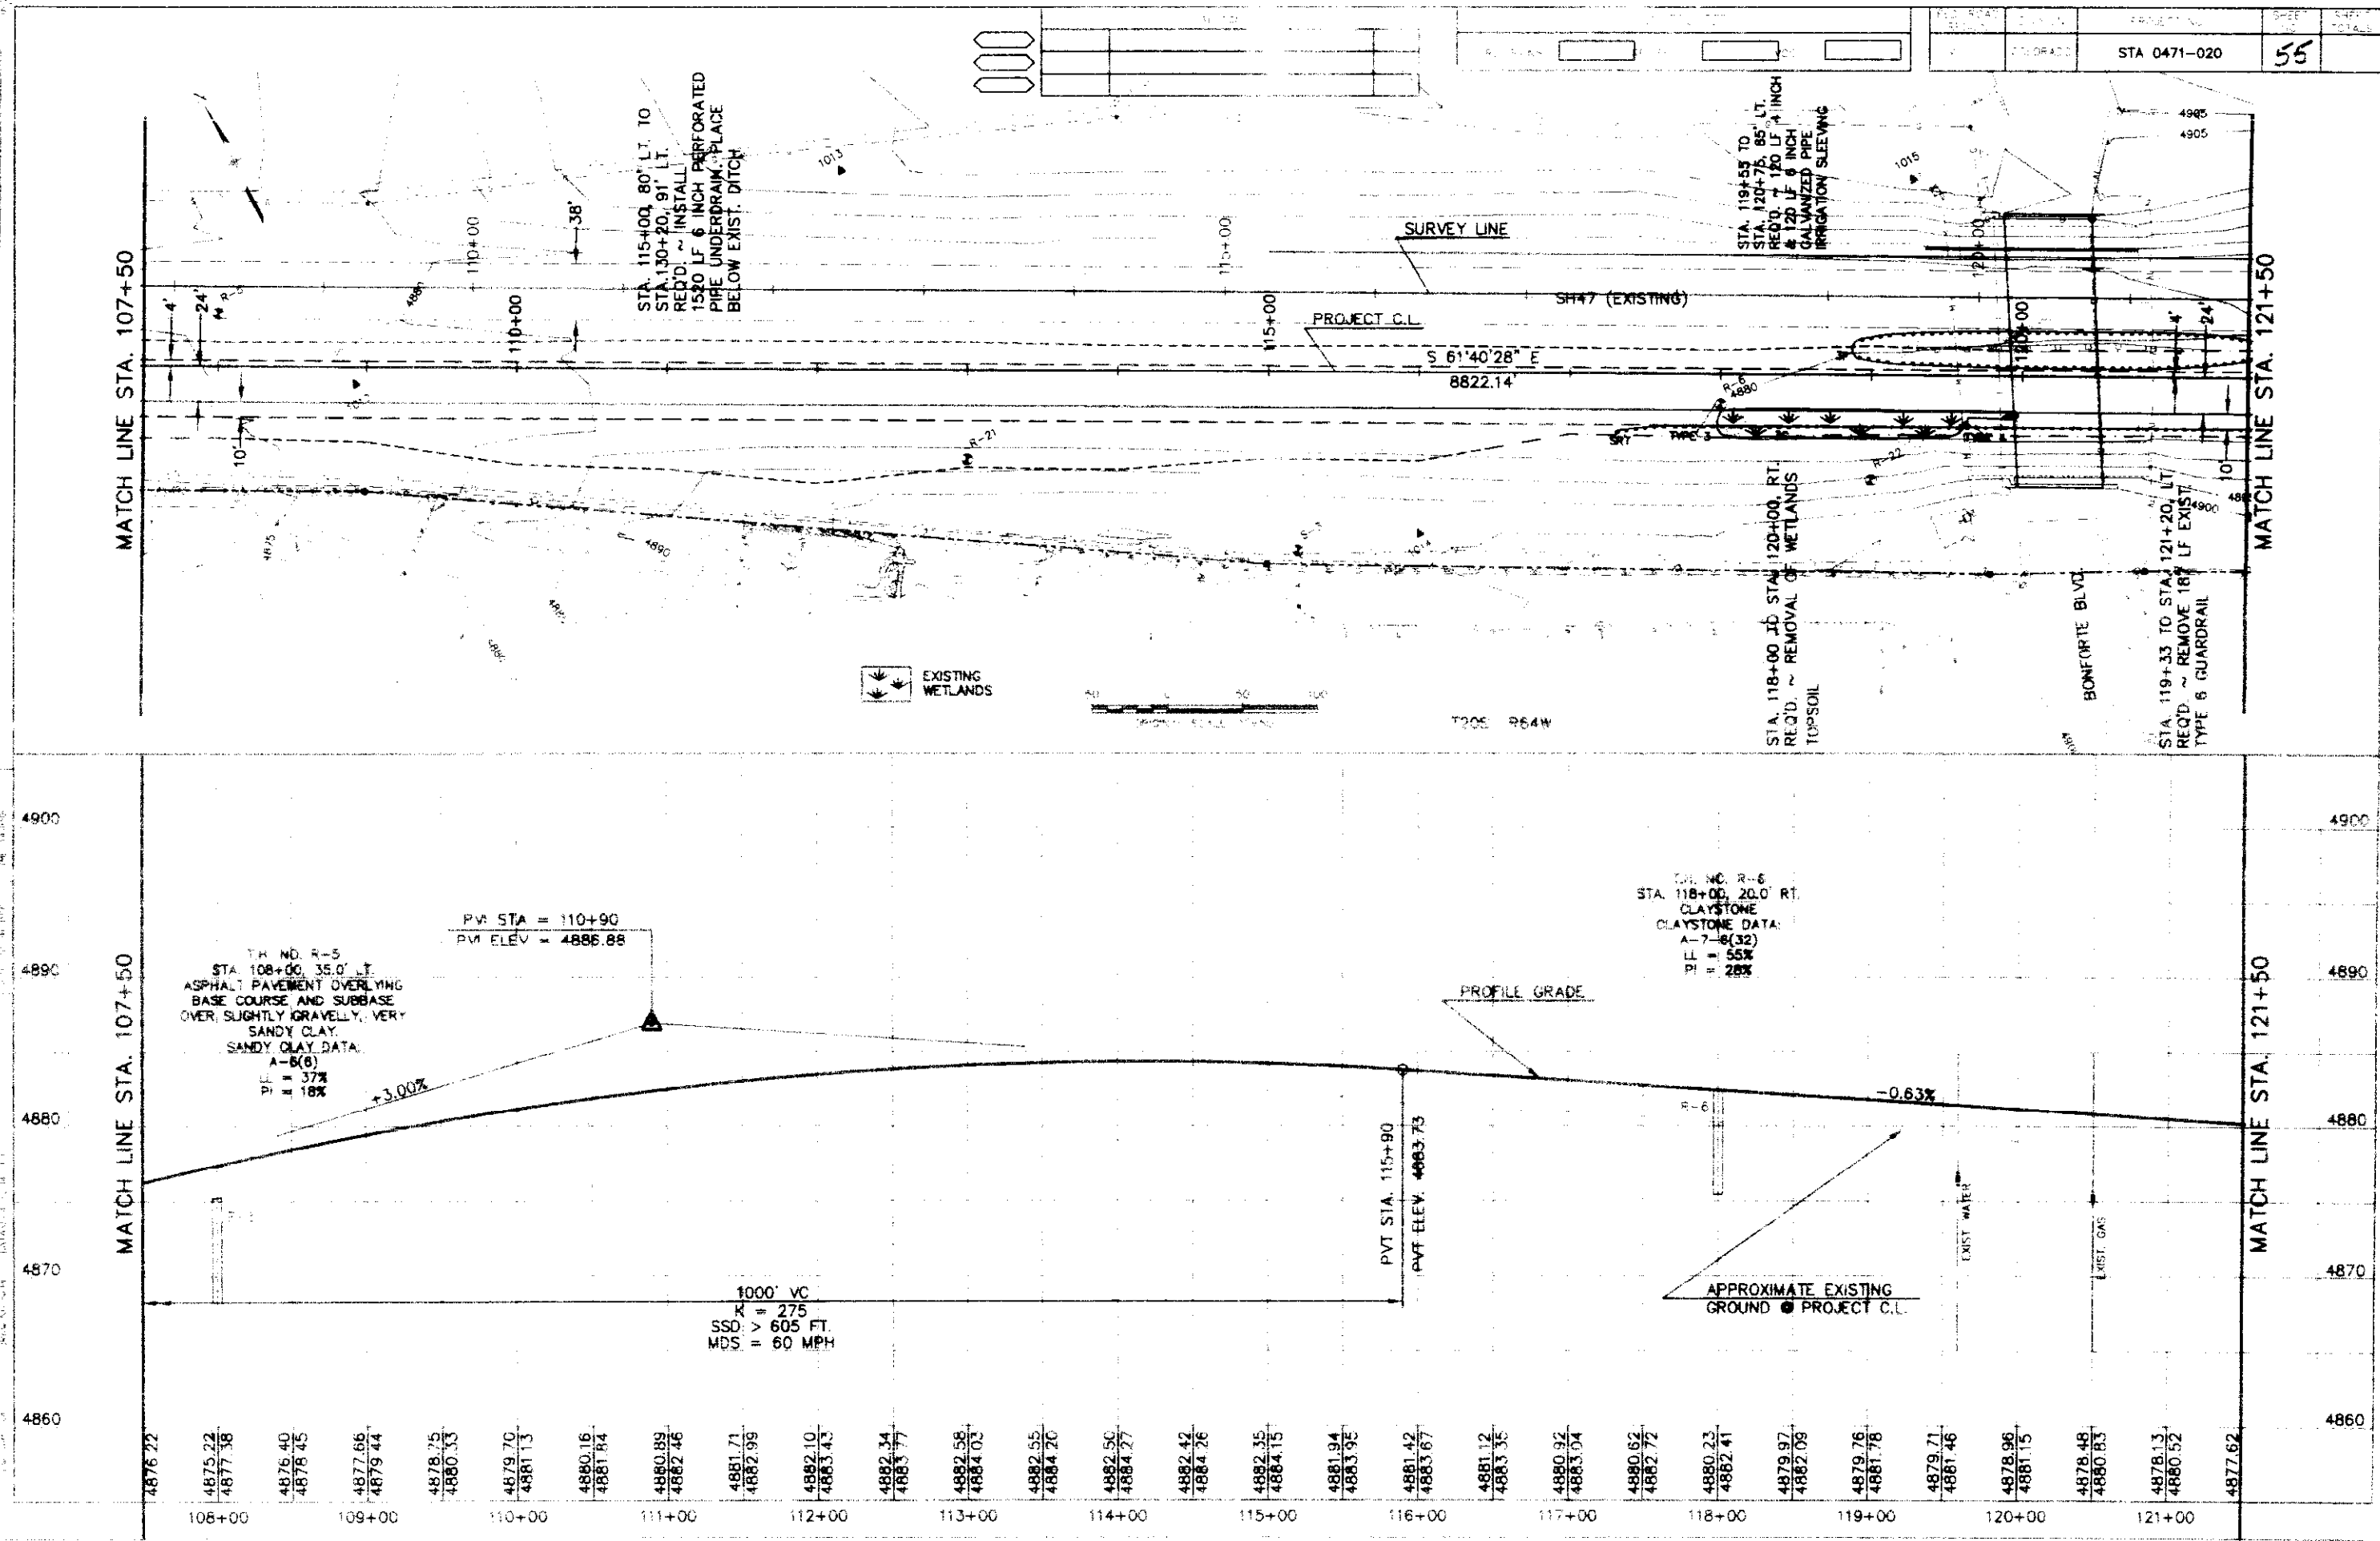


STA 0471-020	55
--------------	----

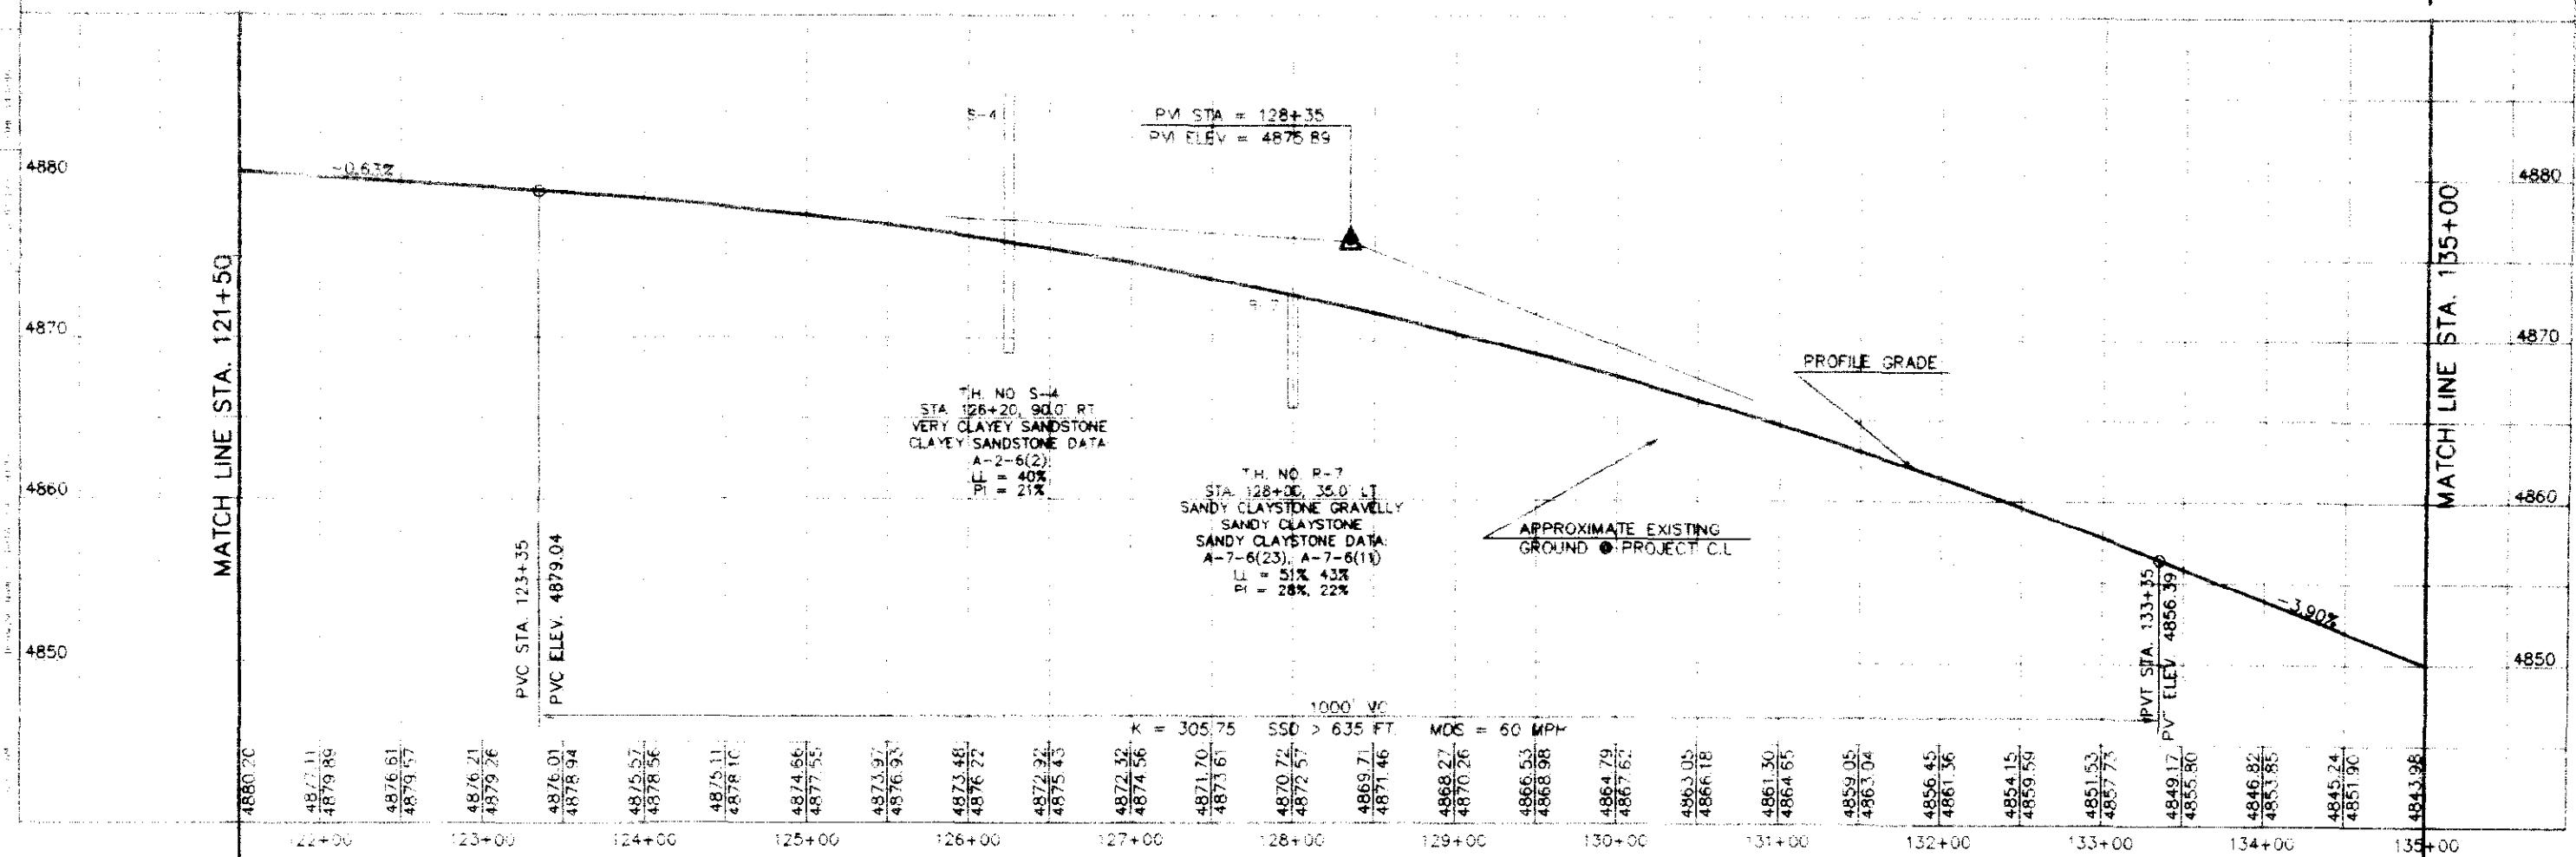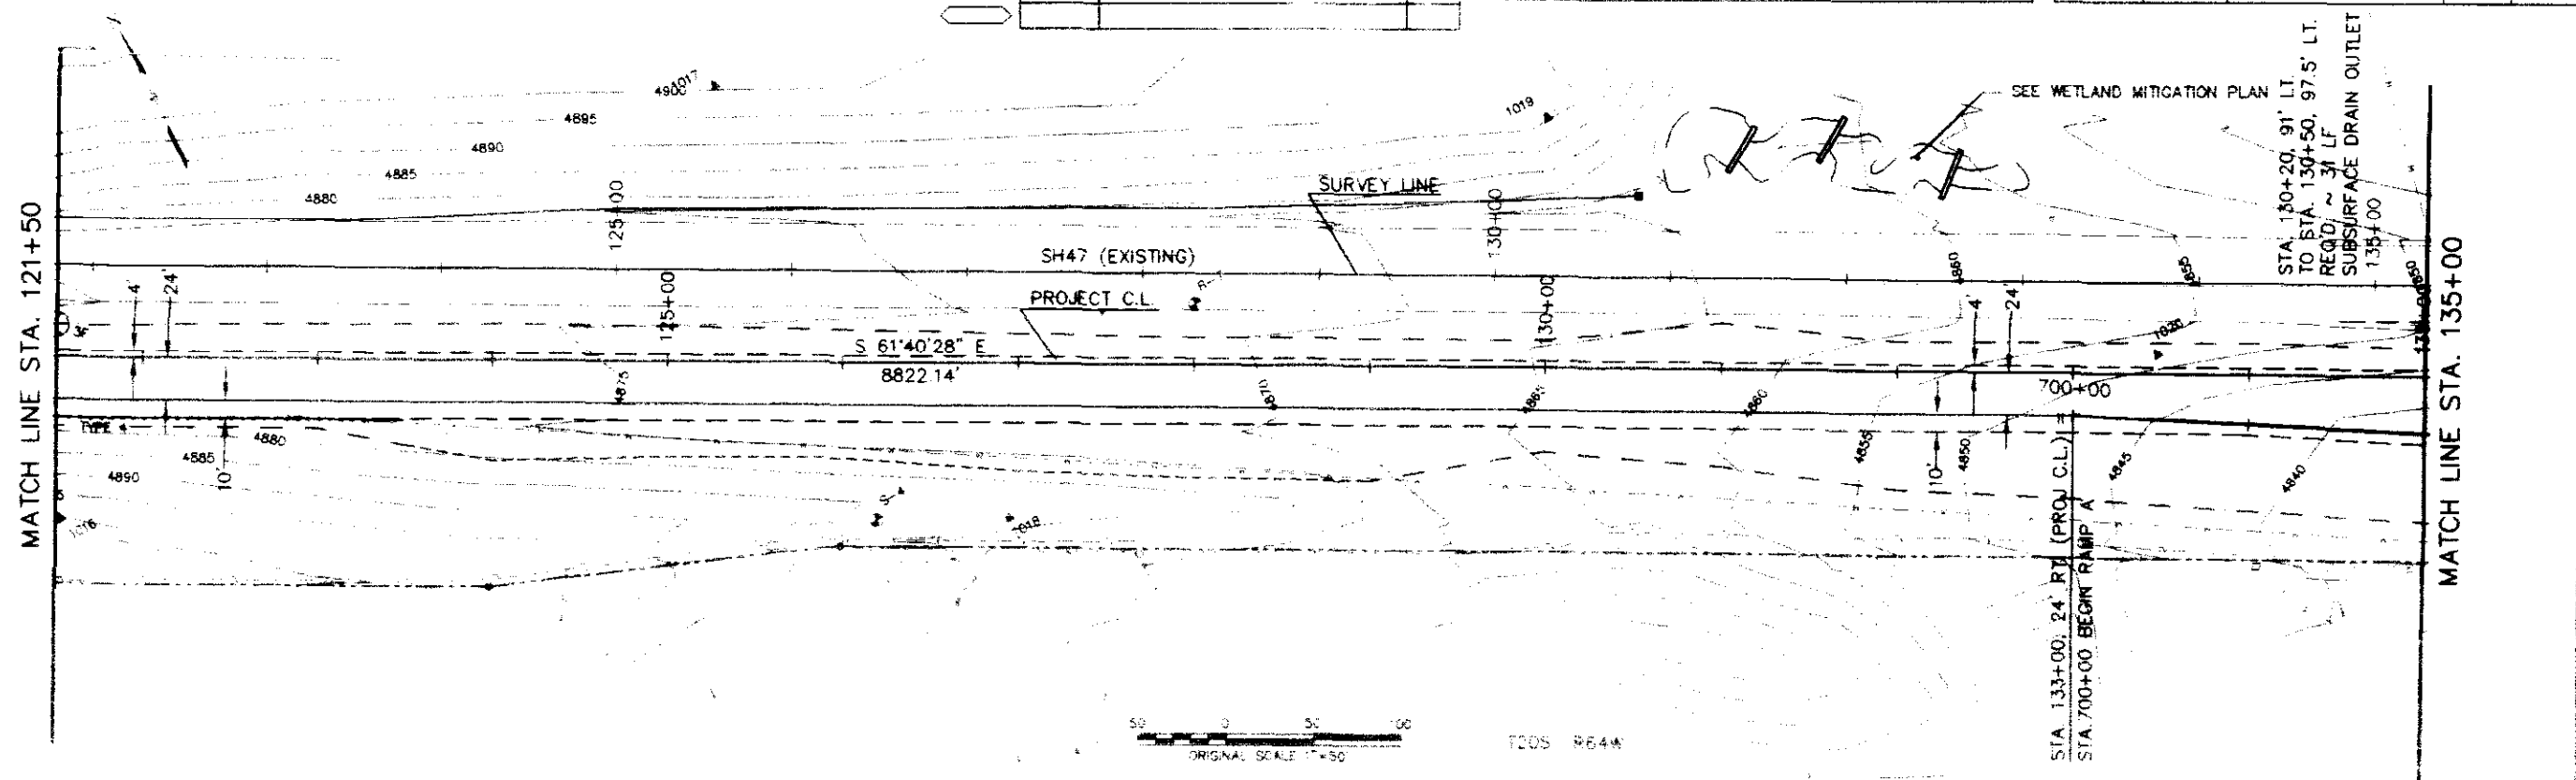


Field Drawings

DESIGNED BY	DATE	CHECKED BY
CHECKED BY		QUANTITIES BY
DETAILED BY		CHECKED BY

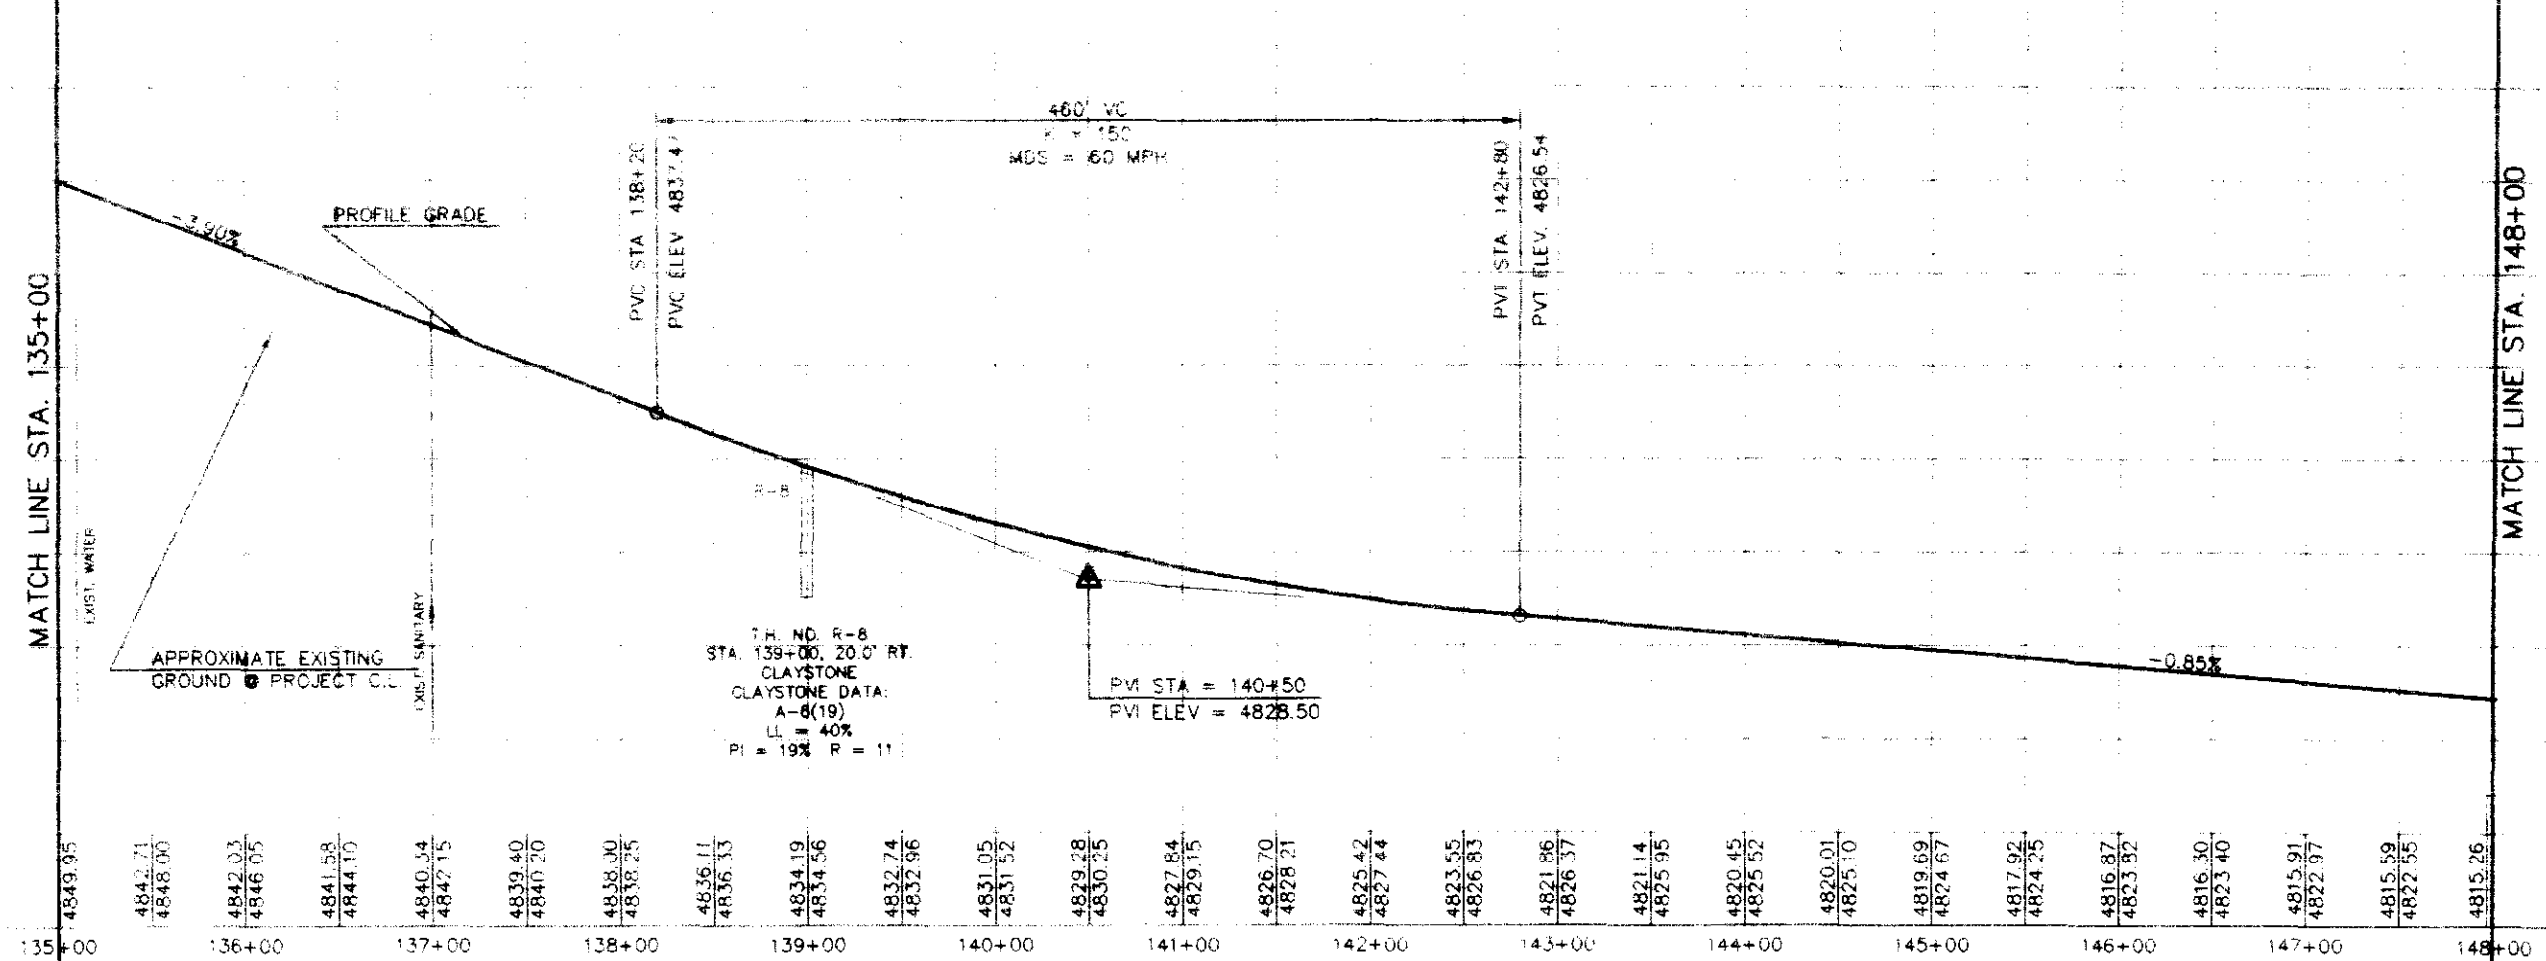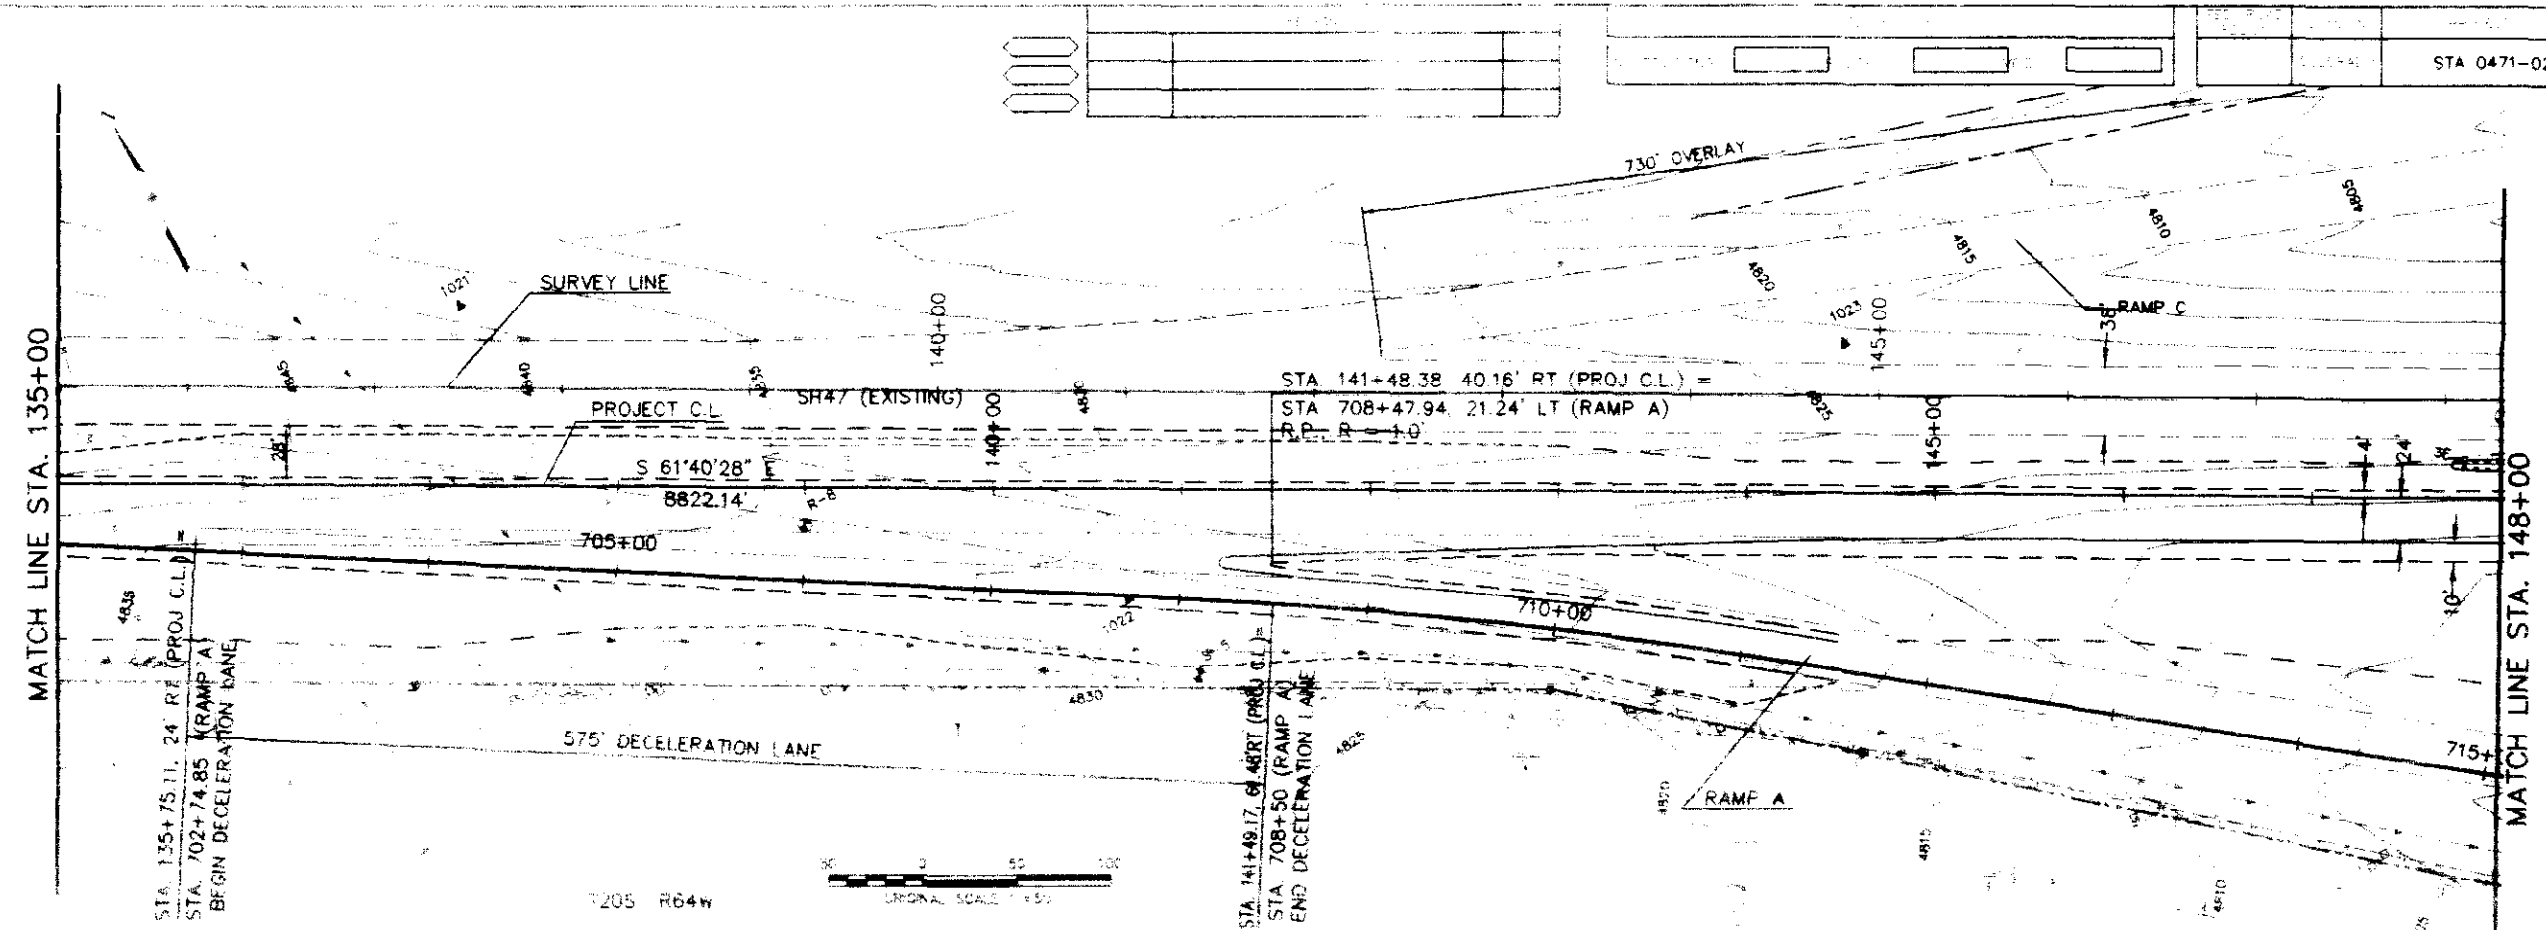


Extra Drawings
PROJECT NO. 0471-020
SHEET NO. 5B

DESIGNED BY	CHECKED BY	DATE
CHECKED BY	QUANTITIES BY	CHECKED BY

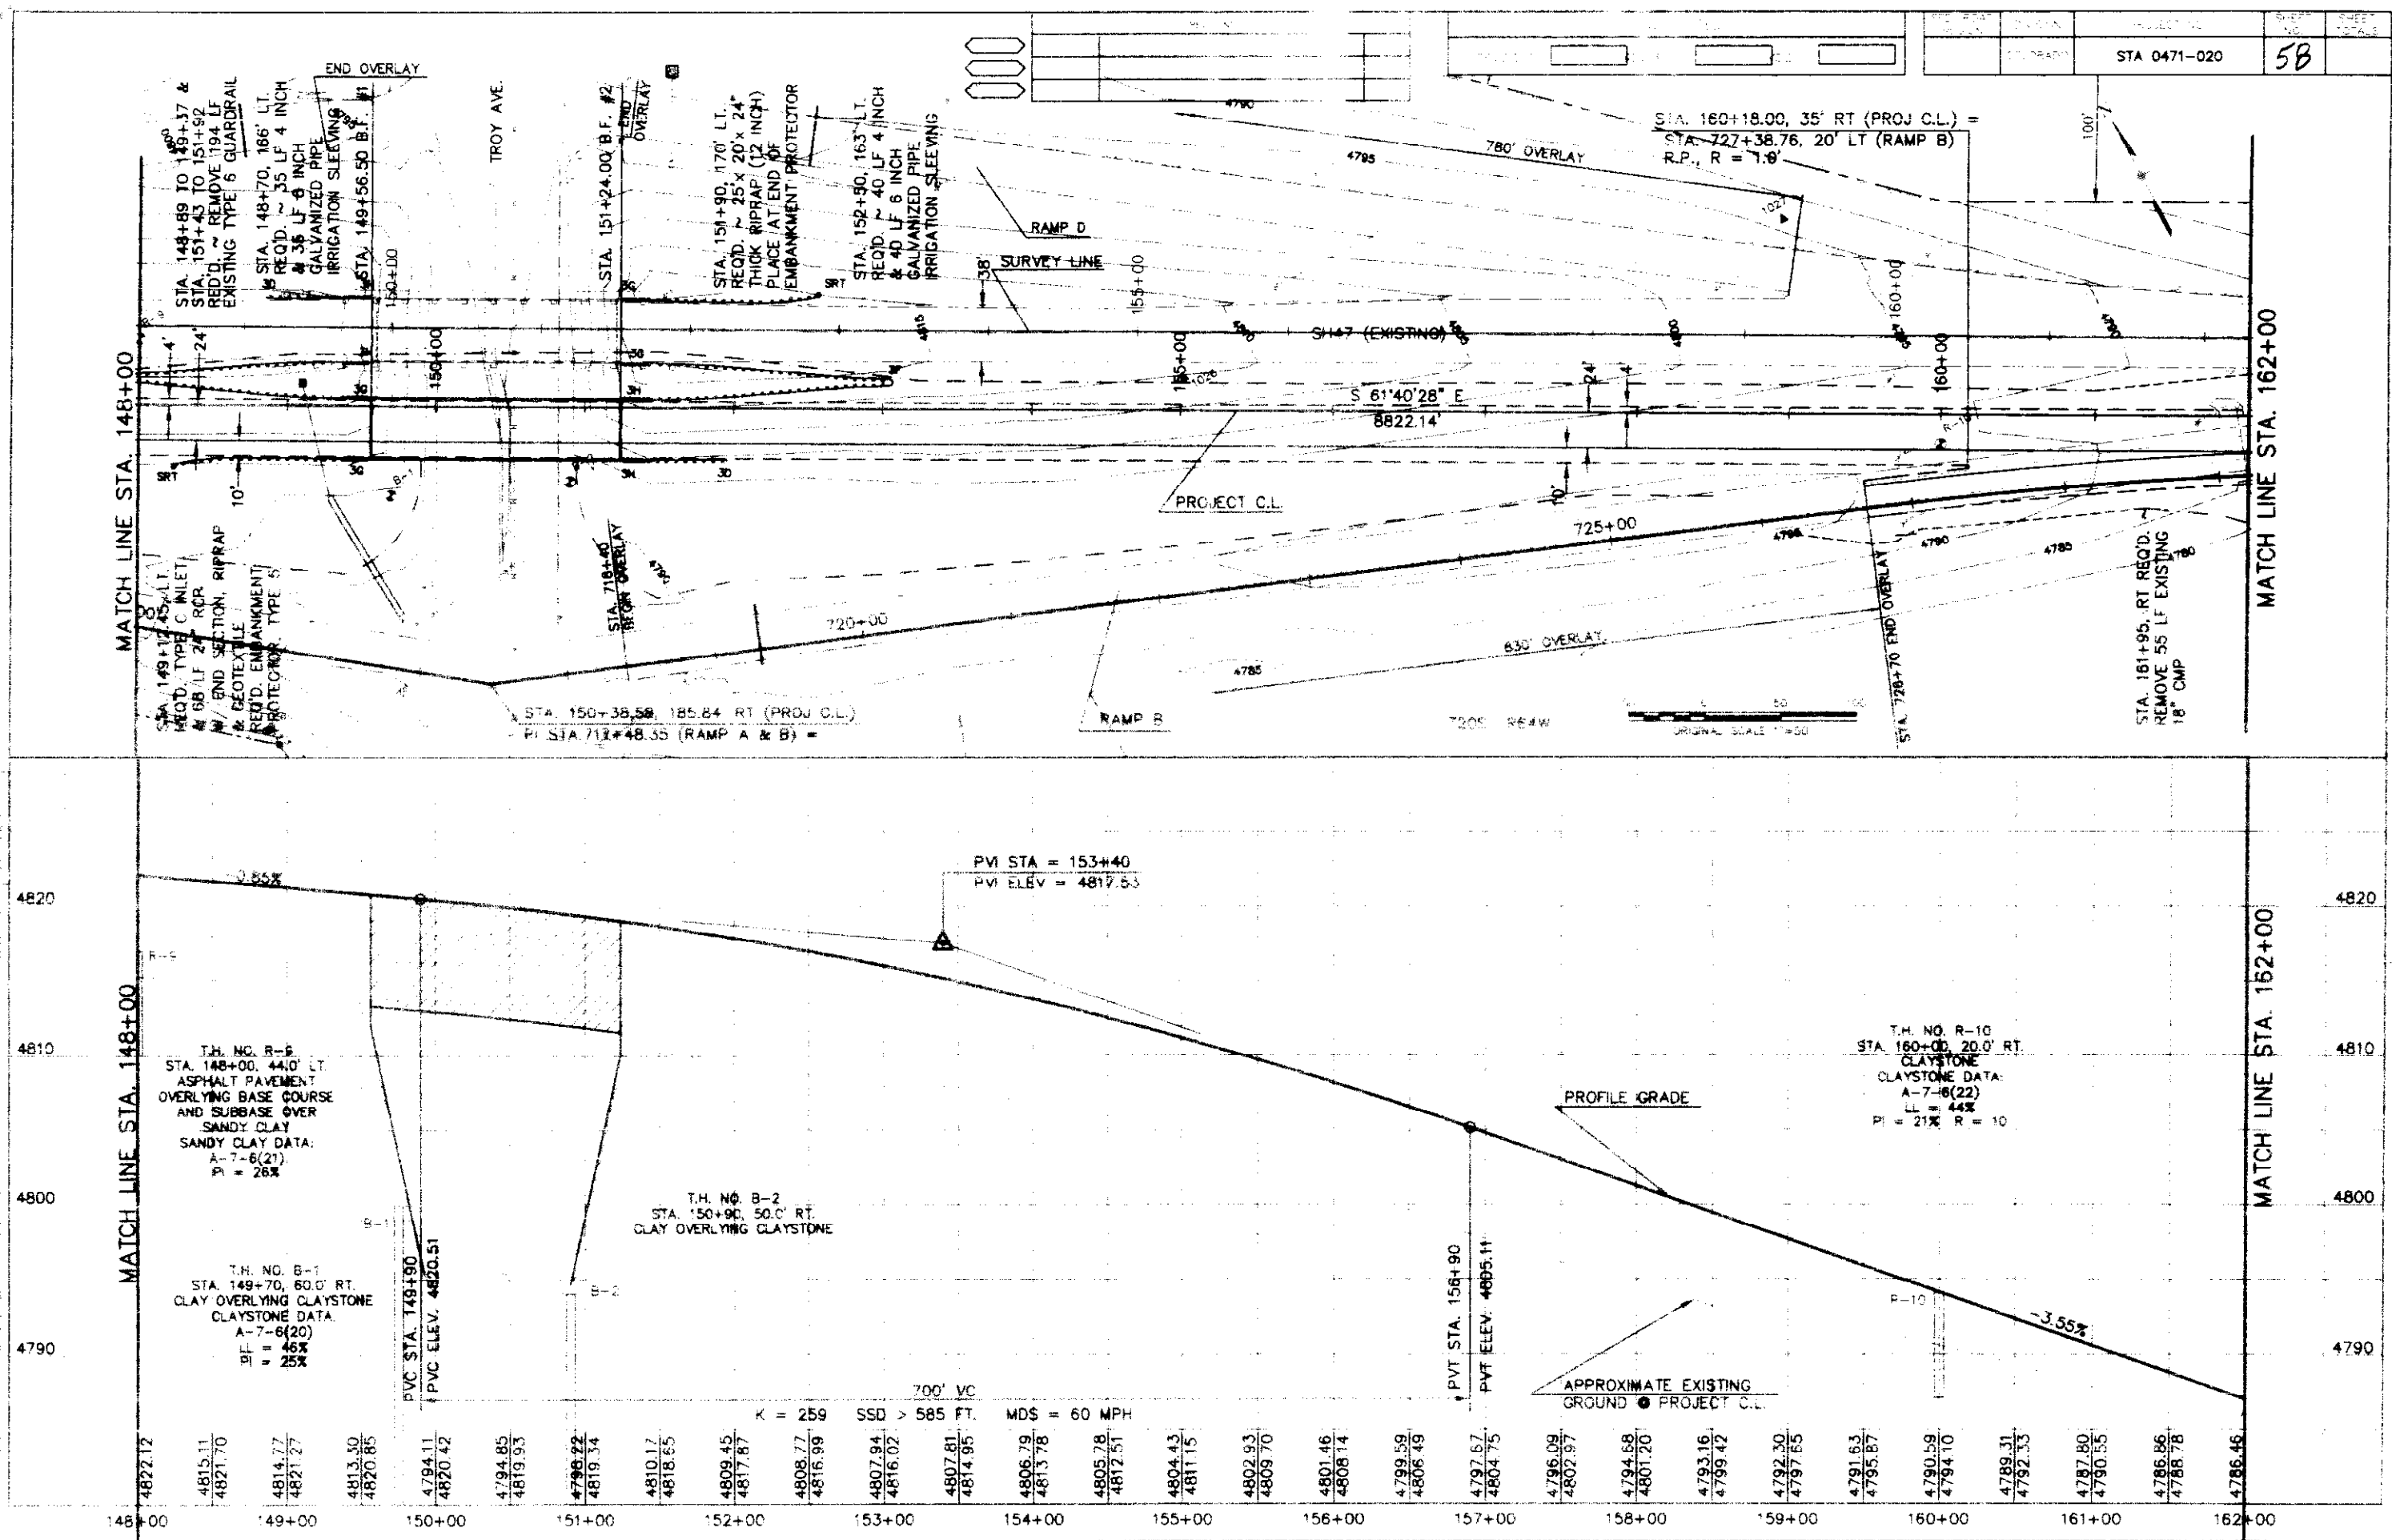


DESIGNED BY	INITIAL	DATE	CHECKED BY
CHECKED BY			QUANTITIES BY
DETAILED BY			CHECKED BY

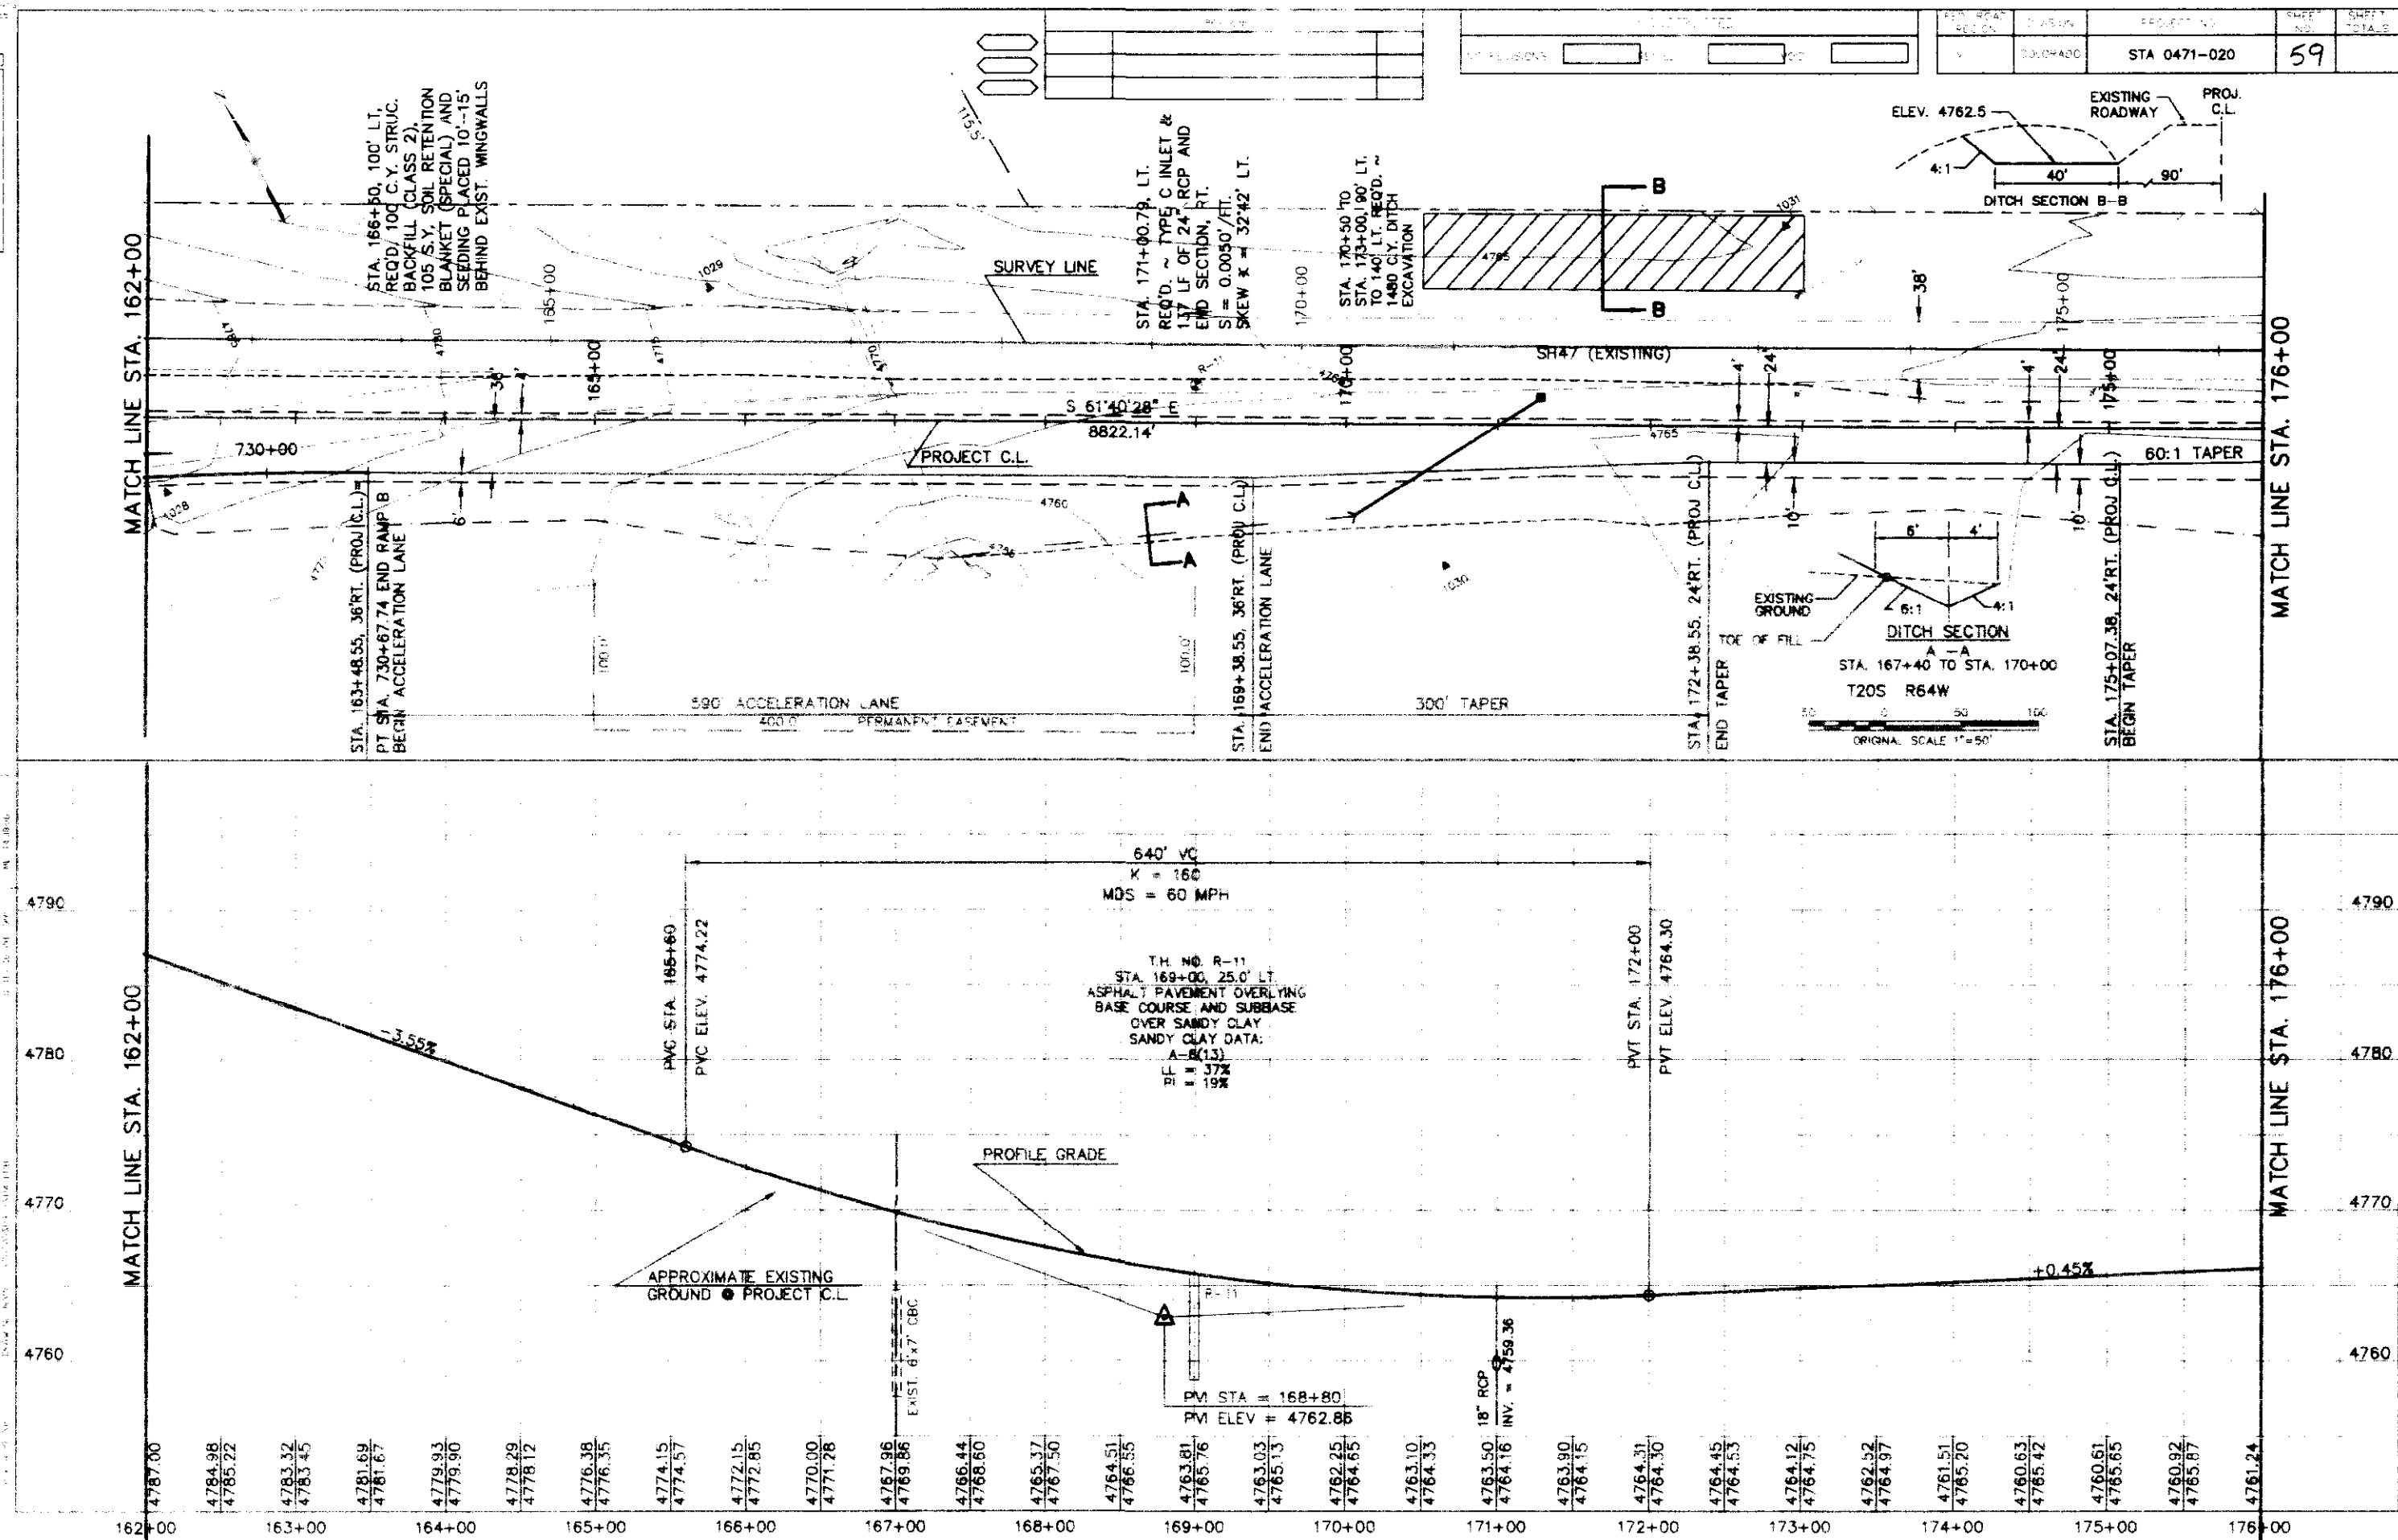

DESIGNED BY	INITIAL DATE	CHECKED BY
CHECKED BY	QUANTITIES BY	
DETAILED BY	CHECKED BY	


FEED BACK REV. NO.	DATE	PROJECT NO.	SHEET NO.	SHEET TOTALS
	10-21-45	STA 0471-020	60	

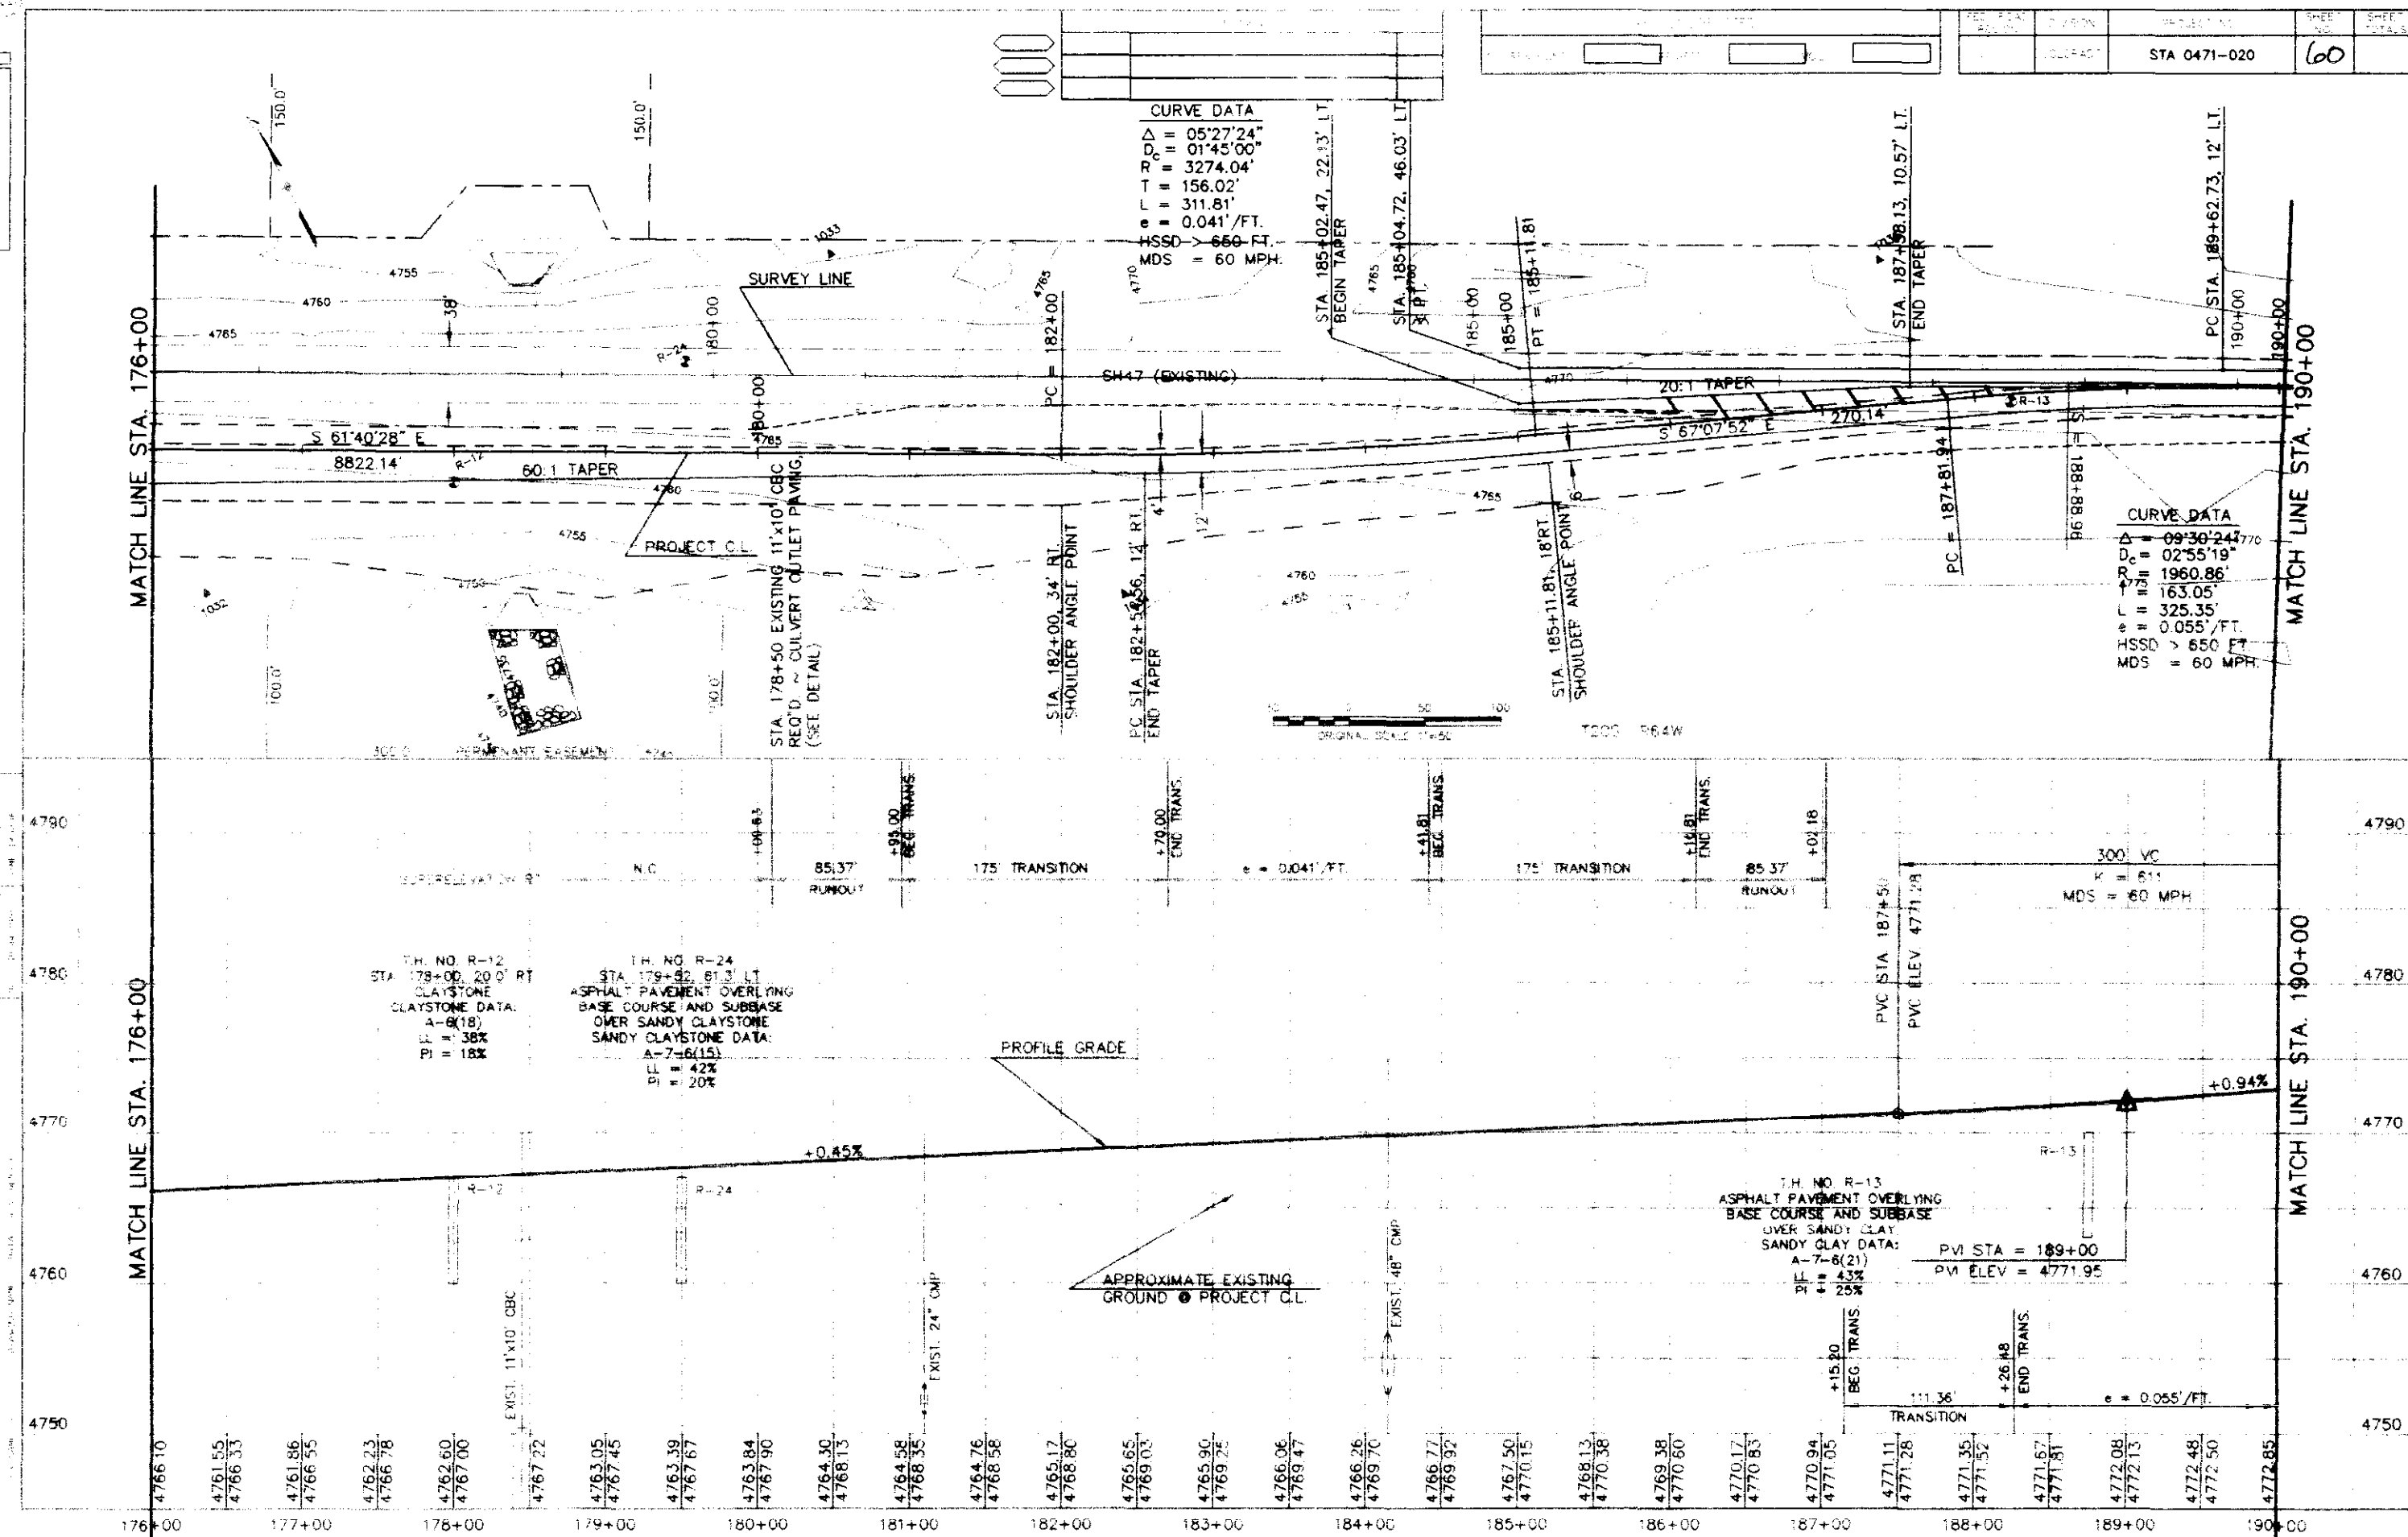


Krefd Drawing

END PROJECT NO. STA 0471-020
 STA 191+07.29 (PROJ. C.L.)
 END OVERLAY / END WIDENING =
 STA 191+34.97 PROJECT FCU 047-1(10) =
 M.P. 3.19



PROJECT NO.	SHEET NO.	SHEET TOTAL
STA 0471-020	61	

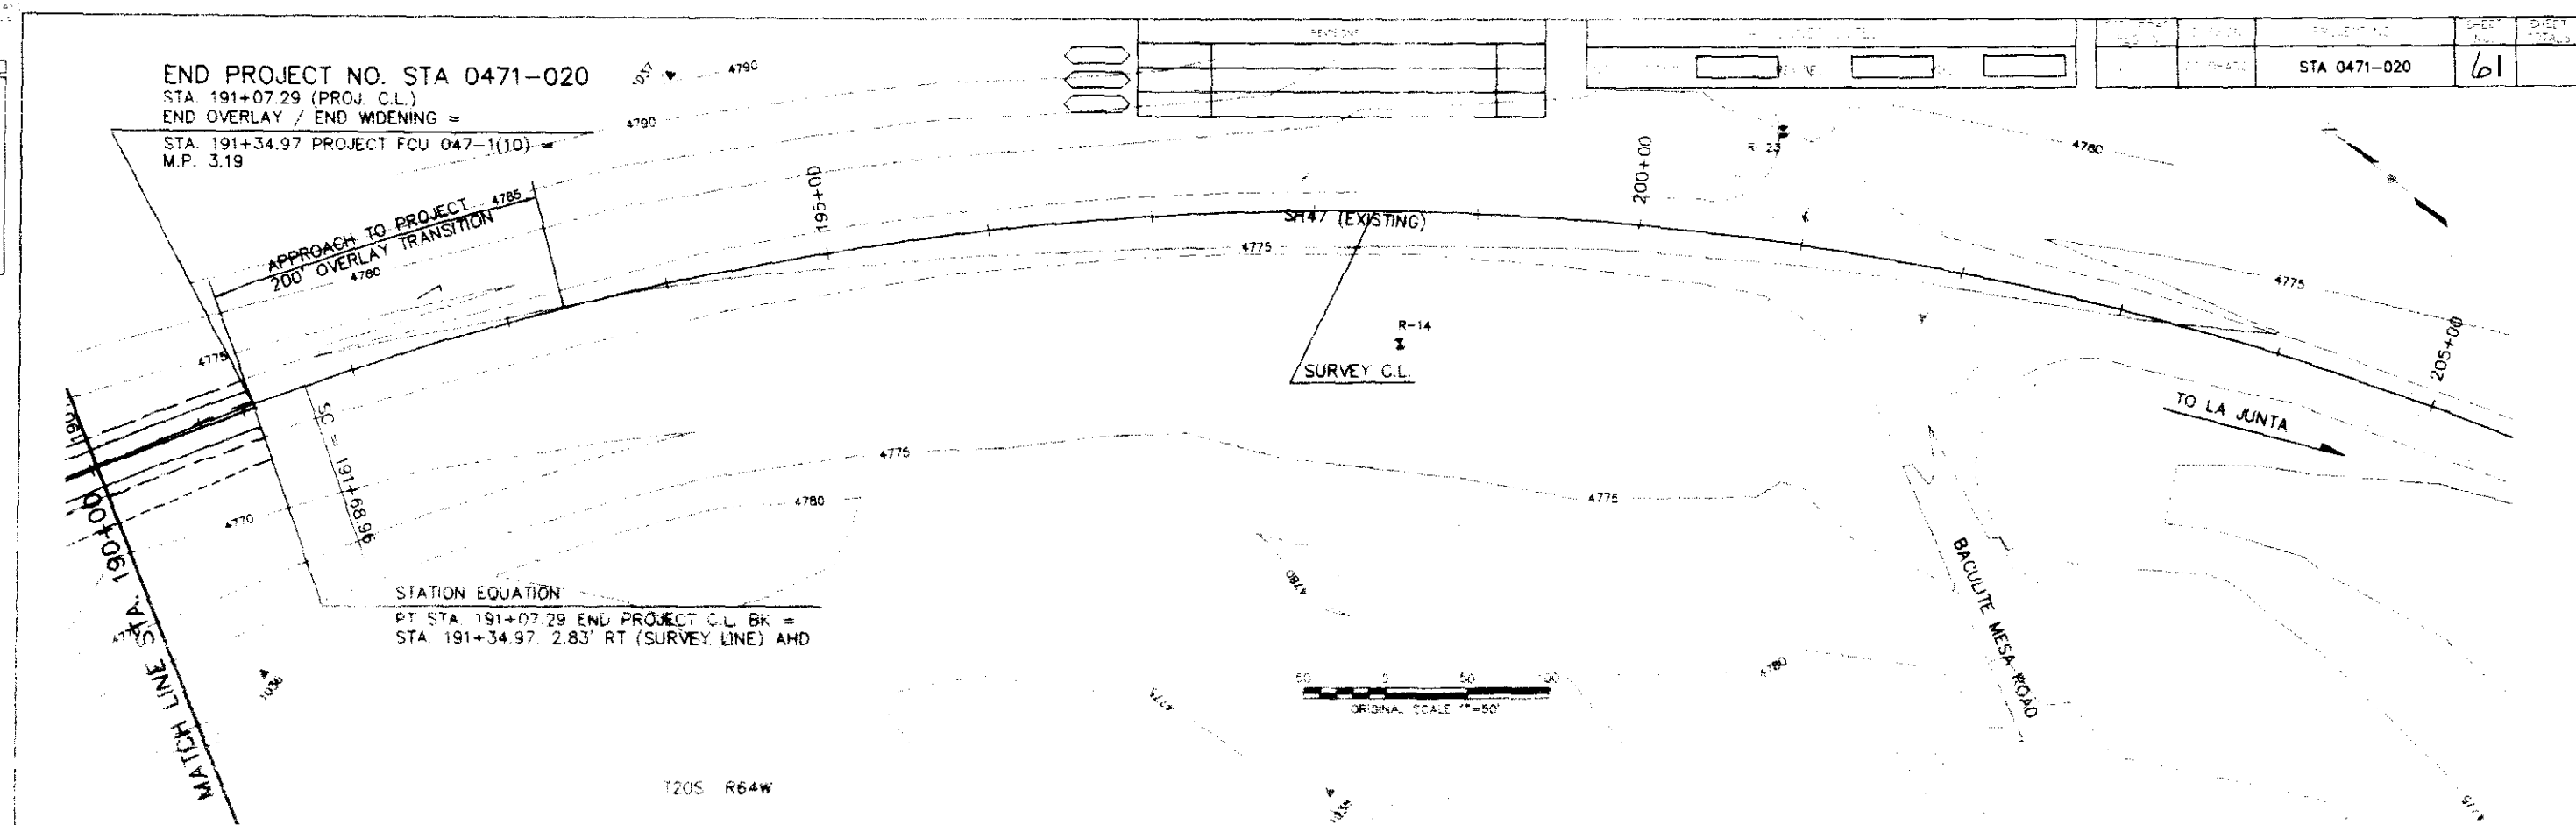

DATE	CHECKED BY	QUANTITIES BY	CHECKED BY

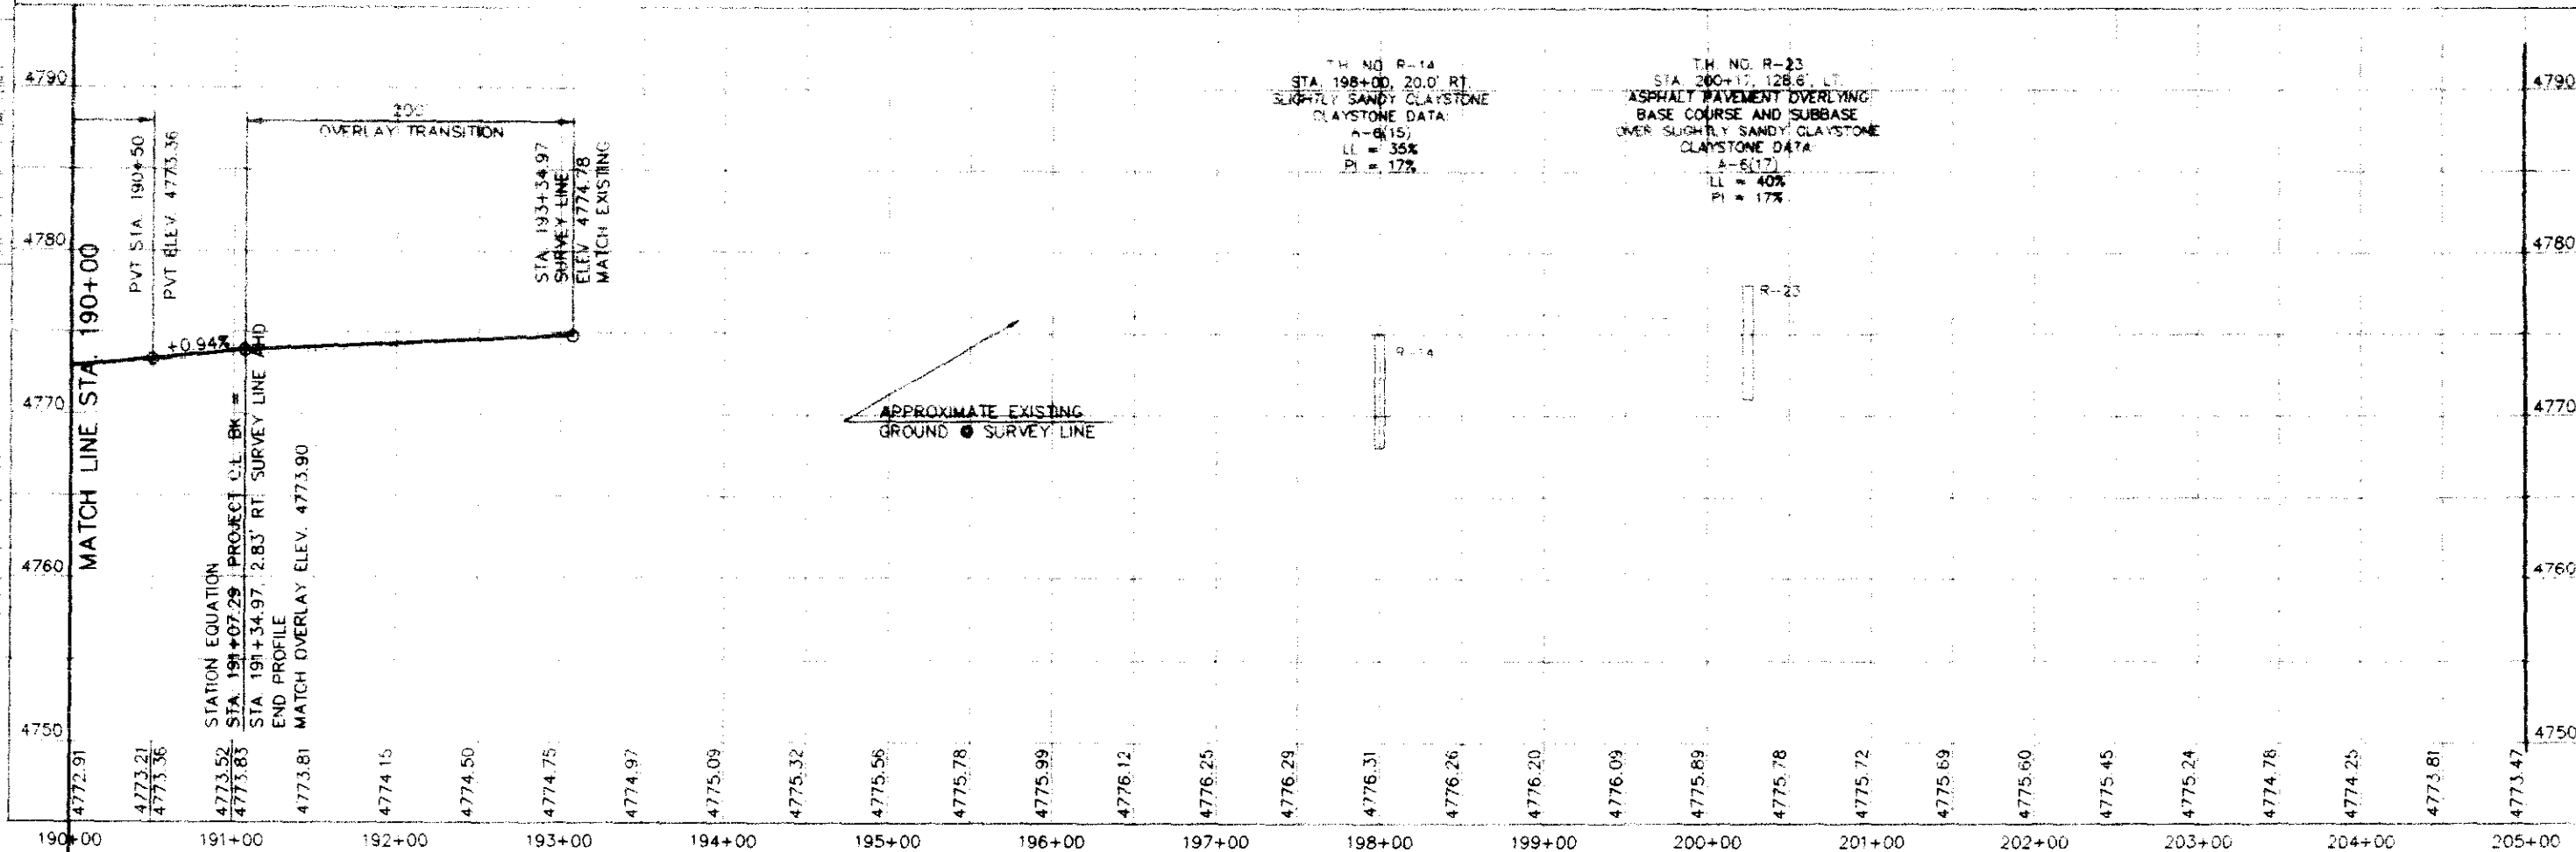




1. The first step is to identify the problem. In this case, the problem is that the system is not working properly.

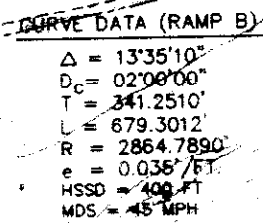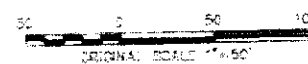

STA. 302+85 BEGIN RAMP B =
STA. 50+92.22 146.09' RT (SURVEY LINE)

SEC 18 T20S R64W

 JERRY MURPHY
RAMP B

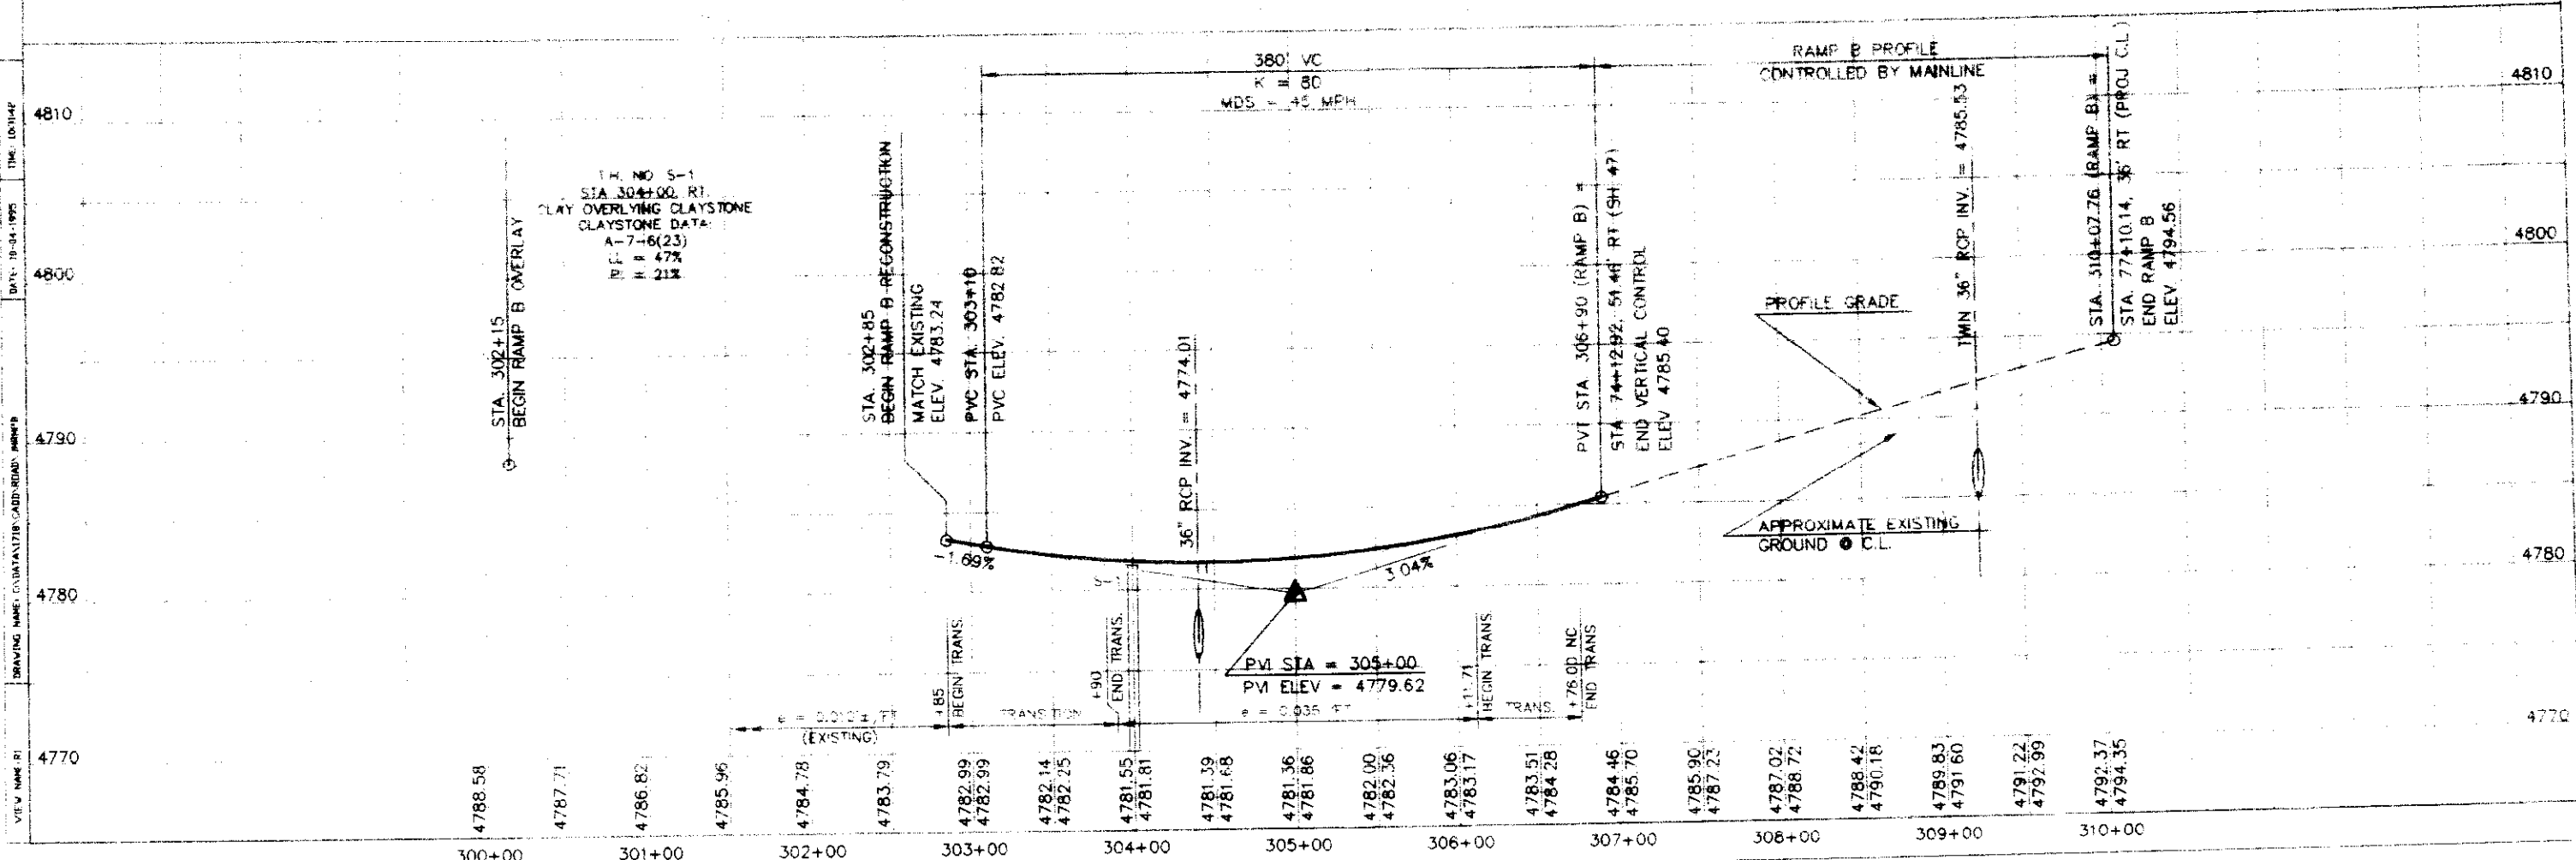
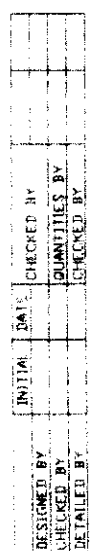


DESIGNED BY	INITIAL	DATE	CHECKED BY	QUANTITIES BY	CHECKED BY	DETAILS BY	TIME 1:37:00
-------------	---------	------	------------	---------------	------------	------------	--------------


100-11-10-04-1993

DRAWING NAME : C:\DATA\718\CAD\DRAWING\BAMP.A... B)

OFFICE OF THE ATTORNEY GENERAL

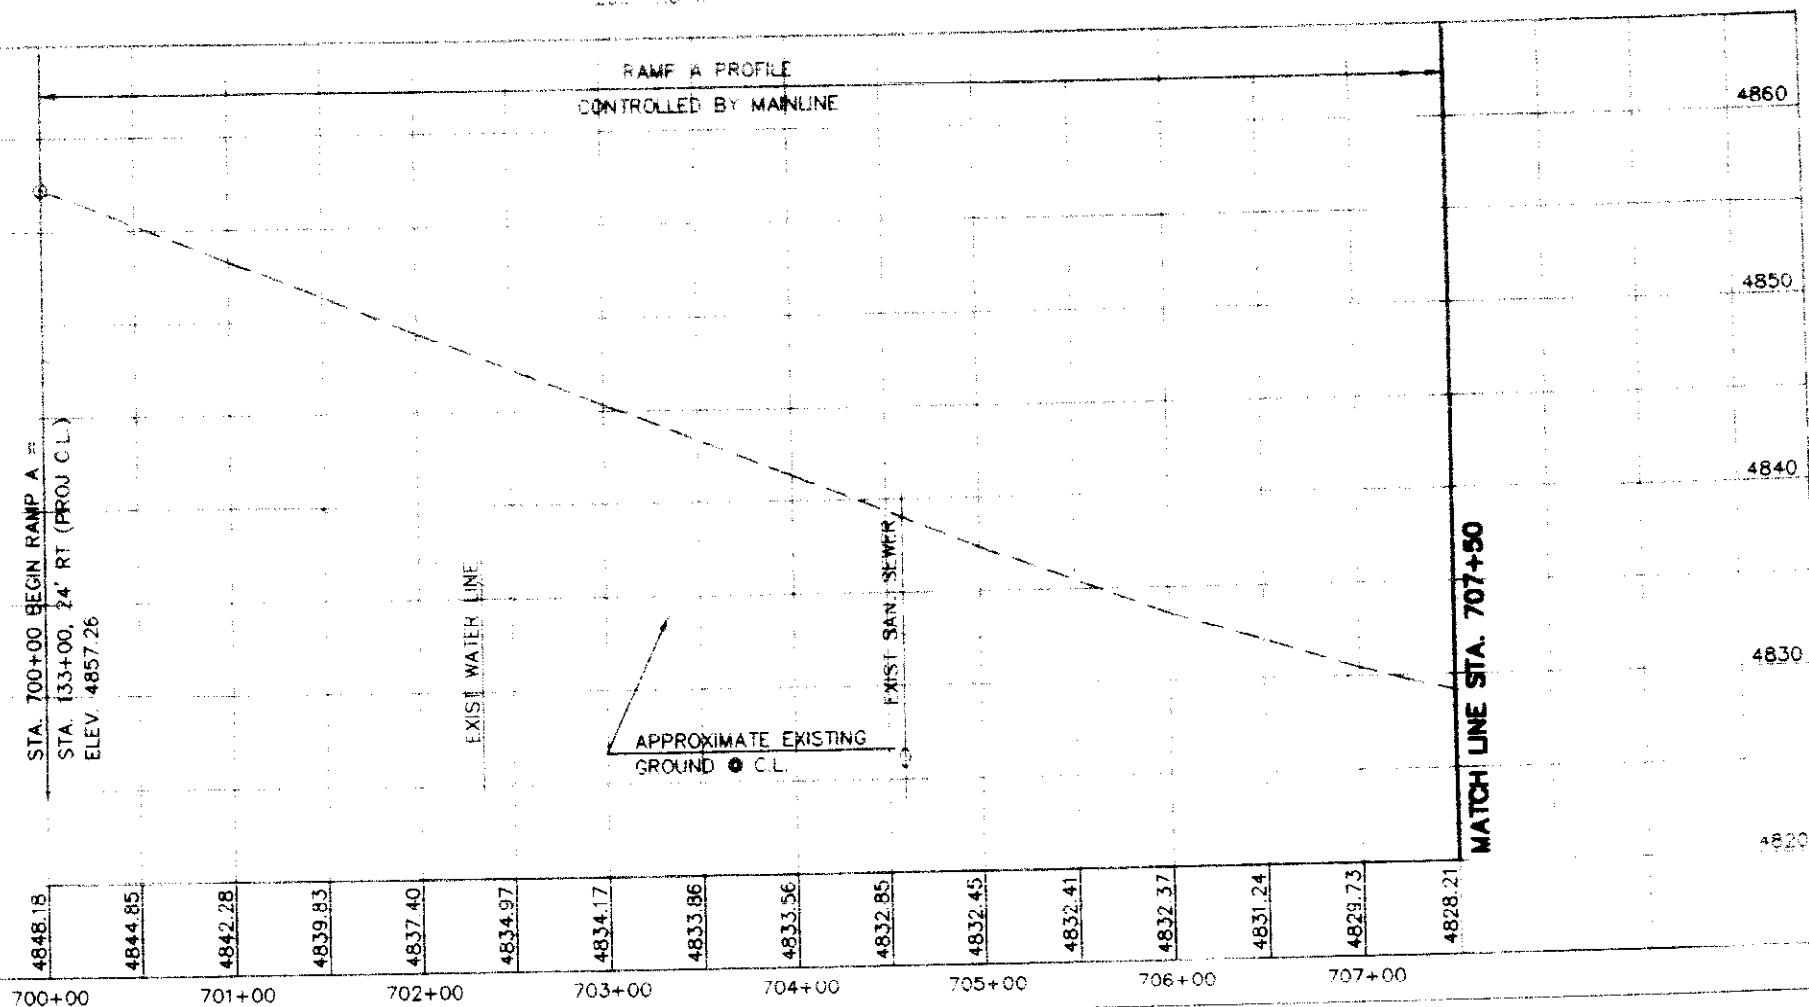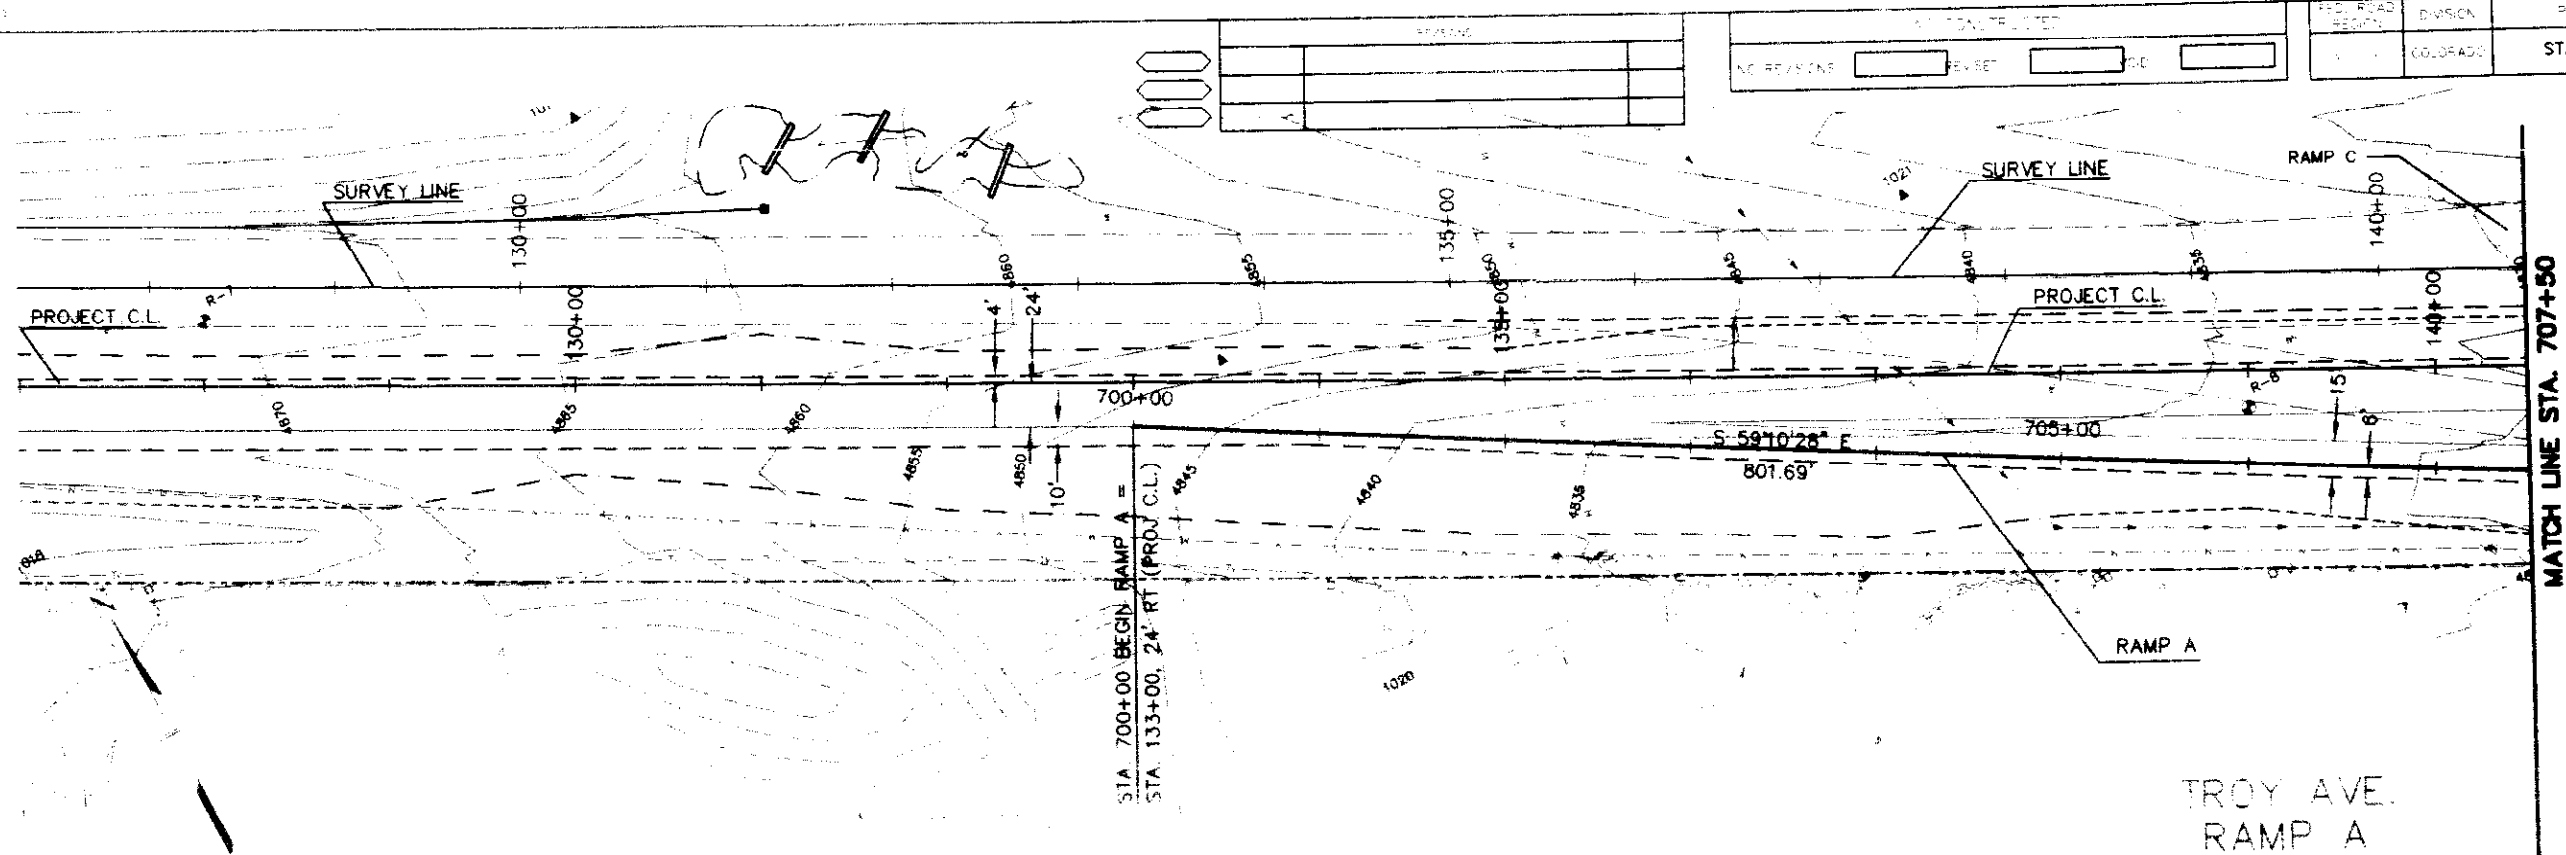

REC'D ROAD SECTION	LOCATION	PROJECT NO.	SHEET NO.	SHEET TOTAL
	COLORADO	STA 0471-020	64	

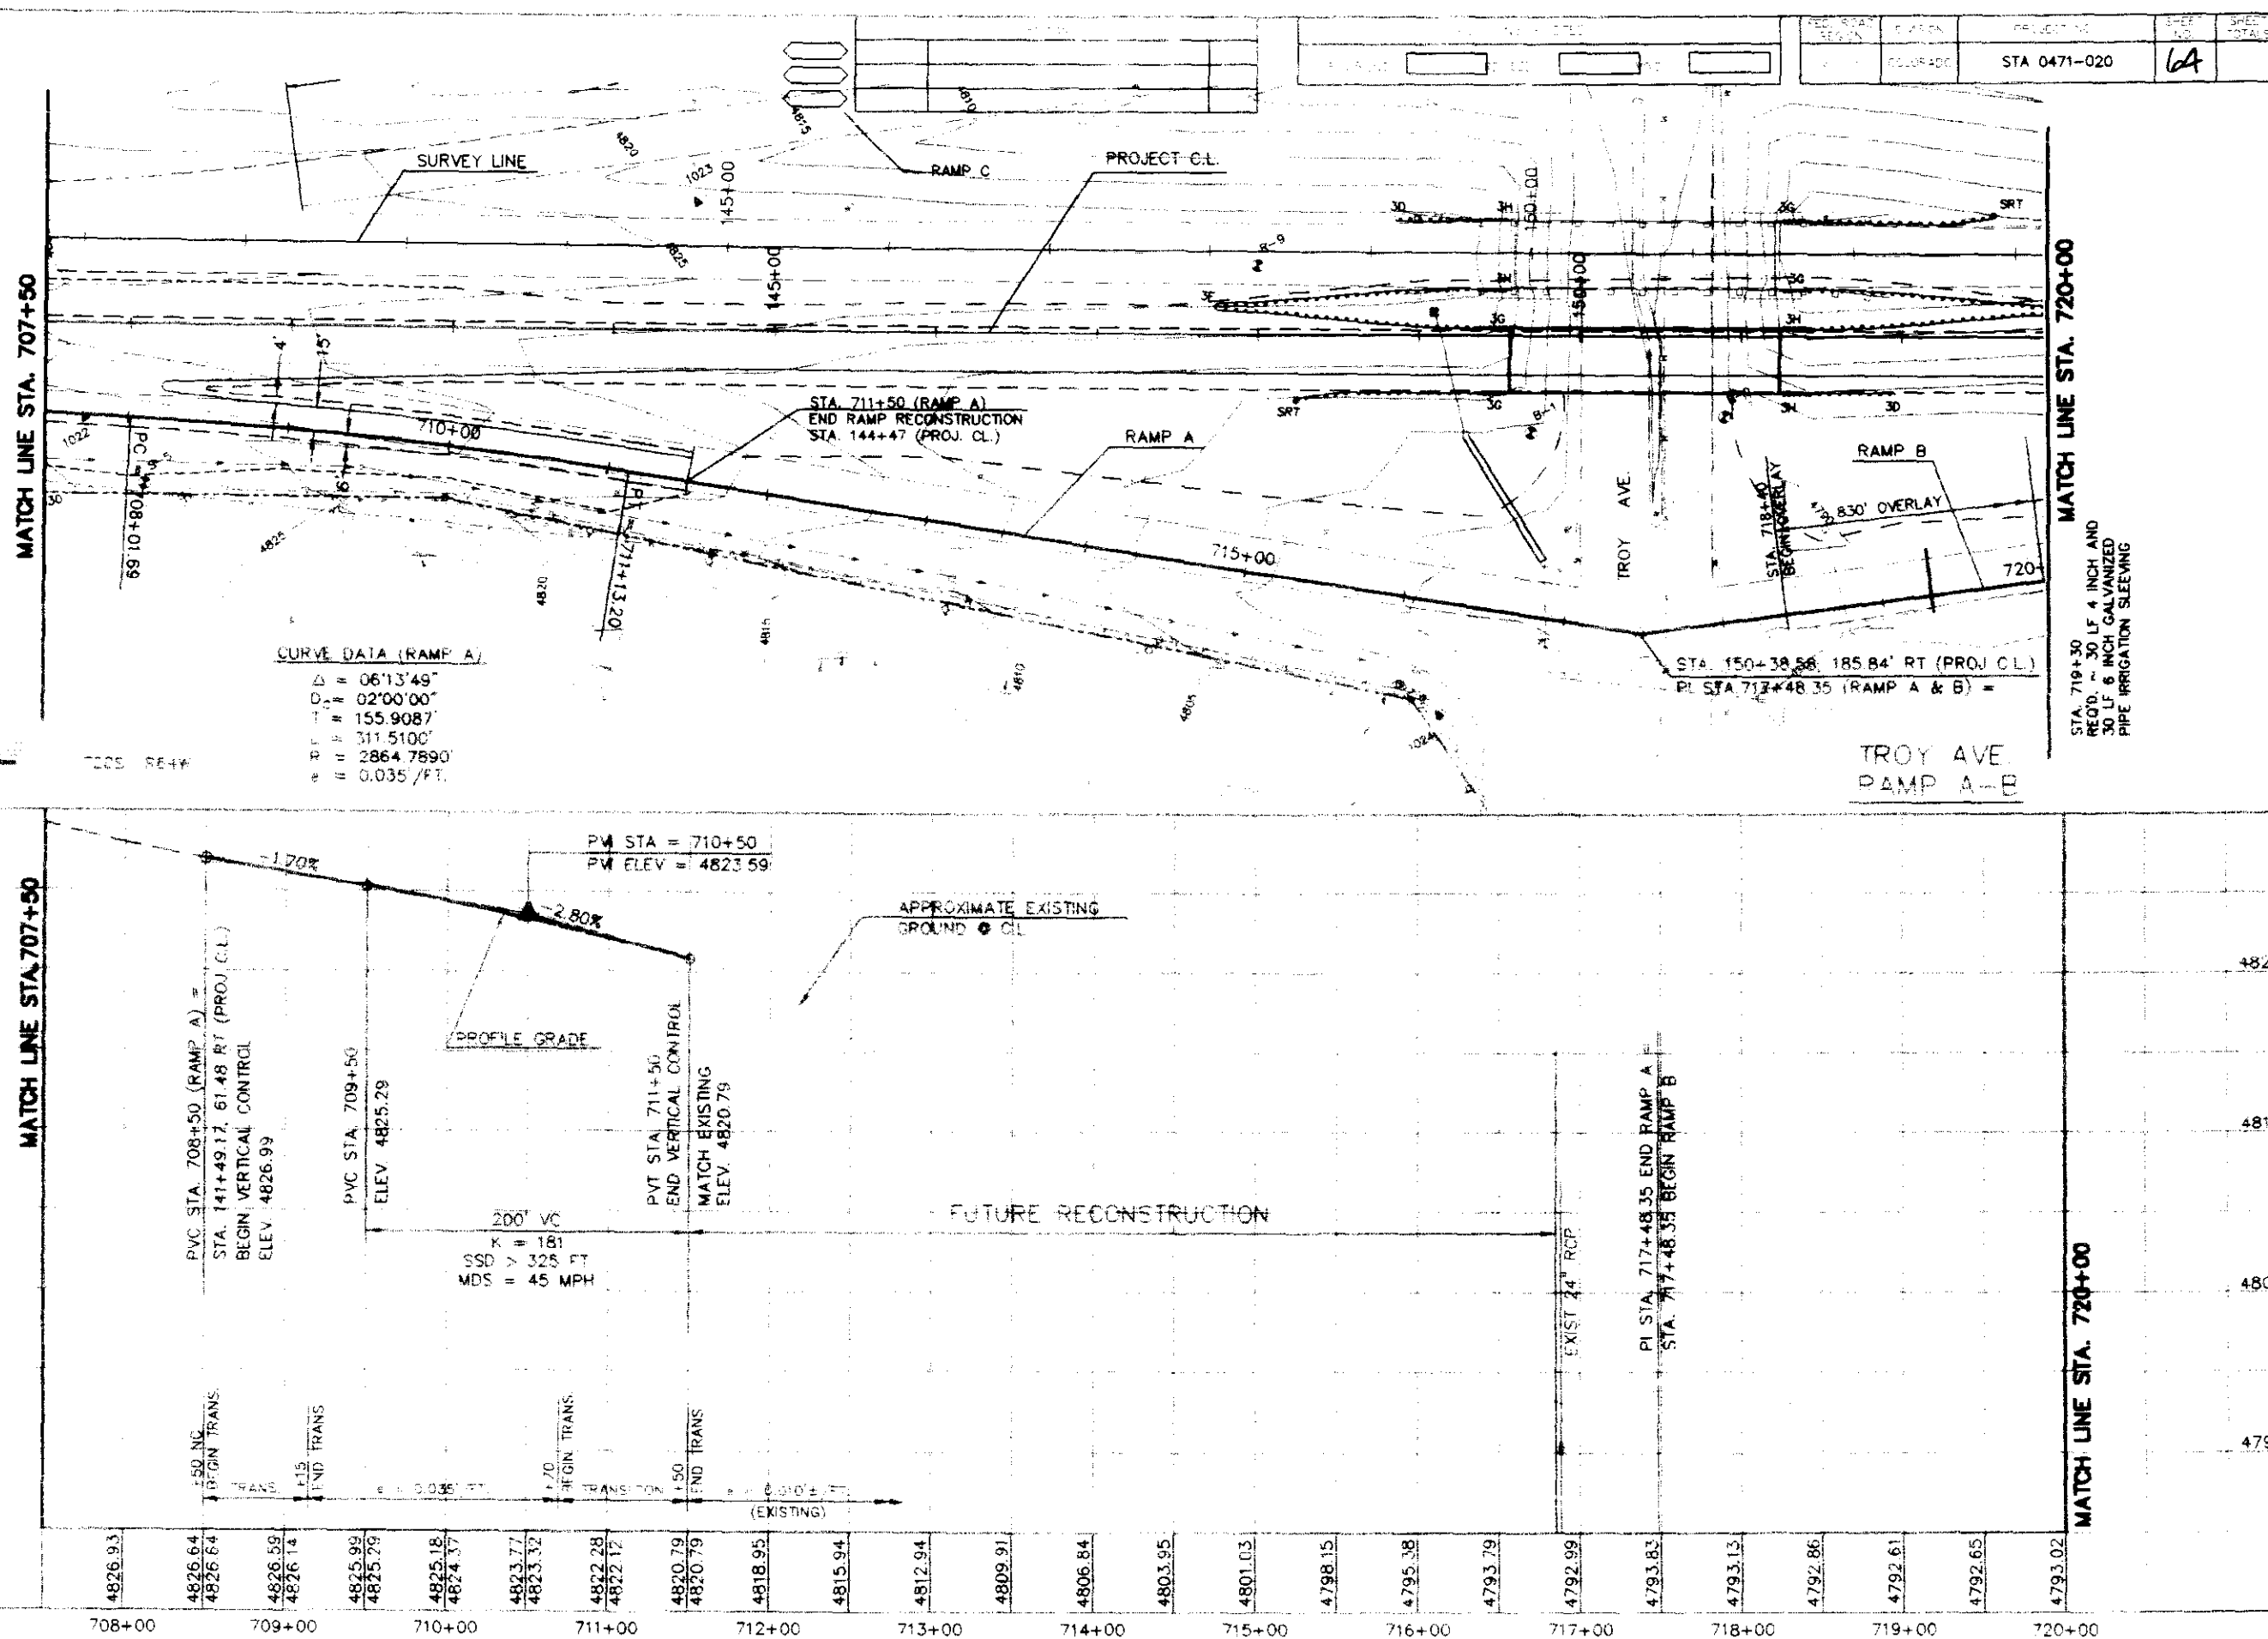


REVISIONS			REVISIONS			DESIGNED BY	CHECKED BY	PROJECT NO.	SHEET NO.	SHEET TOTALS
								STA 0471-020	66	

DESIGNED BY	CHECKED BY	DATE	QUANTITIES BY	CHECKED BY	DATE

DATE: 10-05-85

DRAWING NAME: JERRY MURPHY RAMP B DITCH

VIEW NAME: DITCH

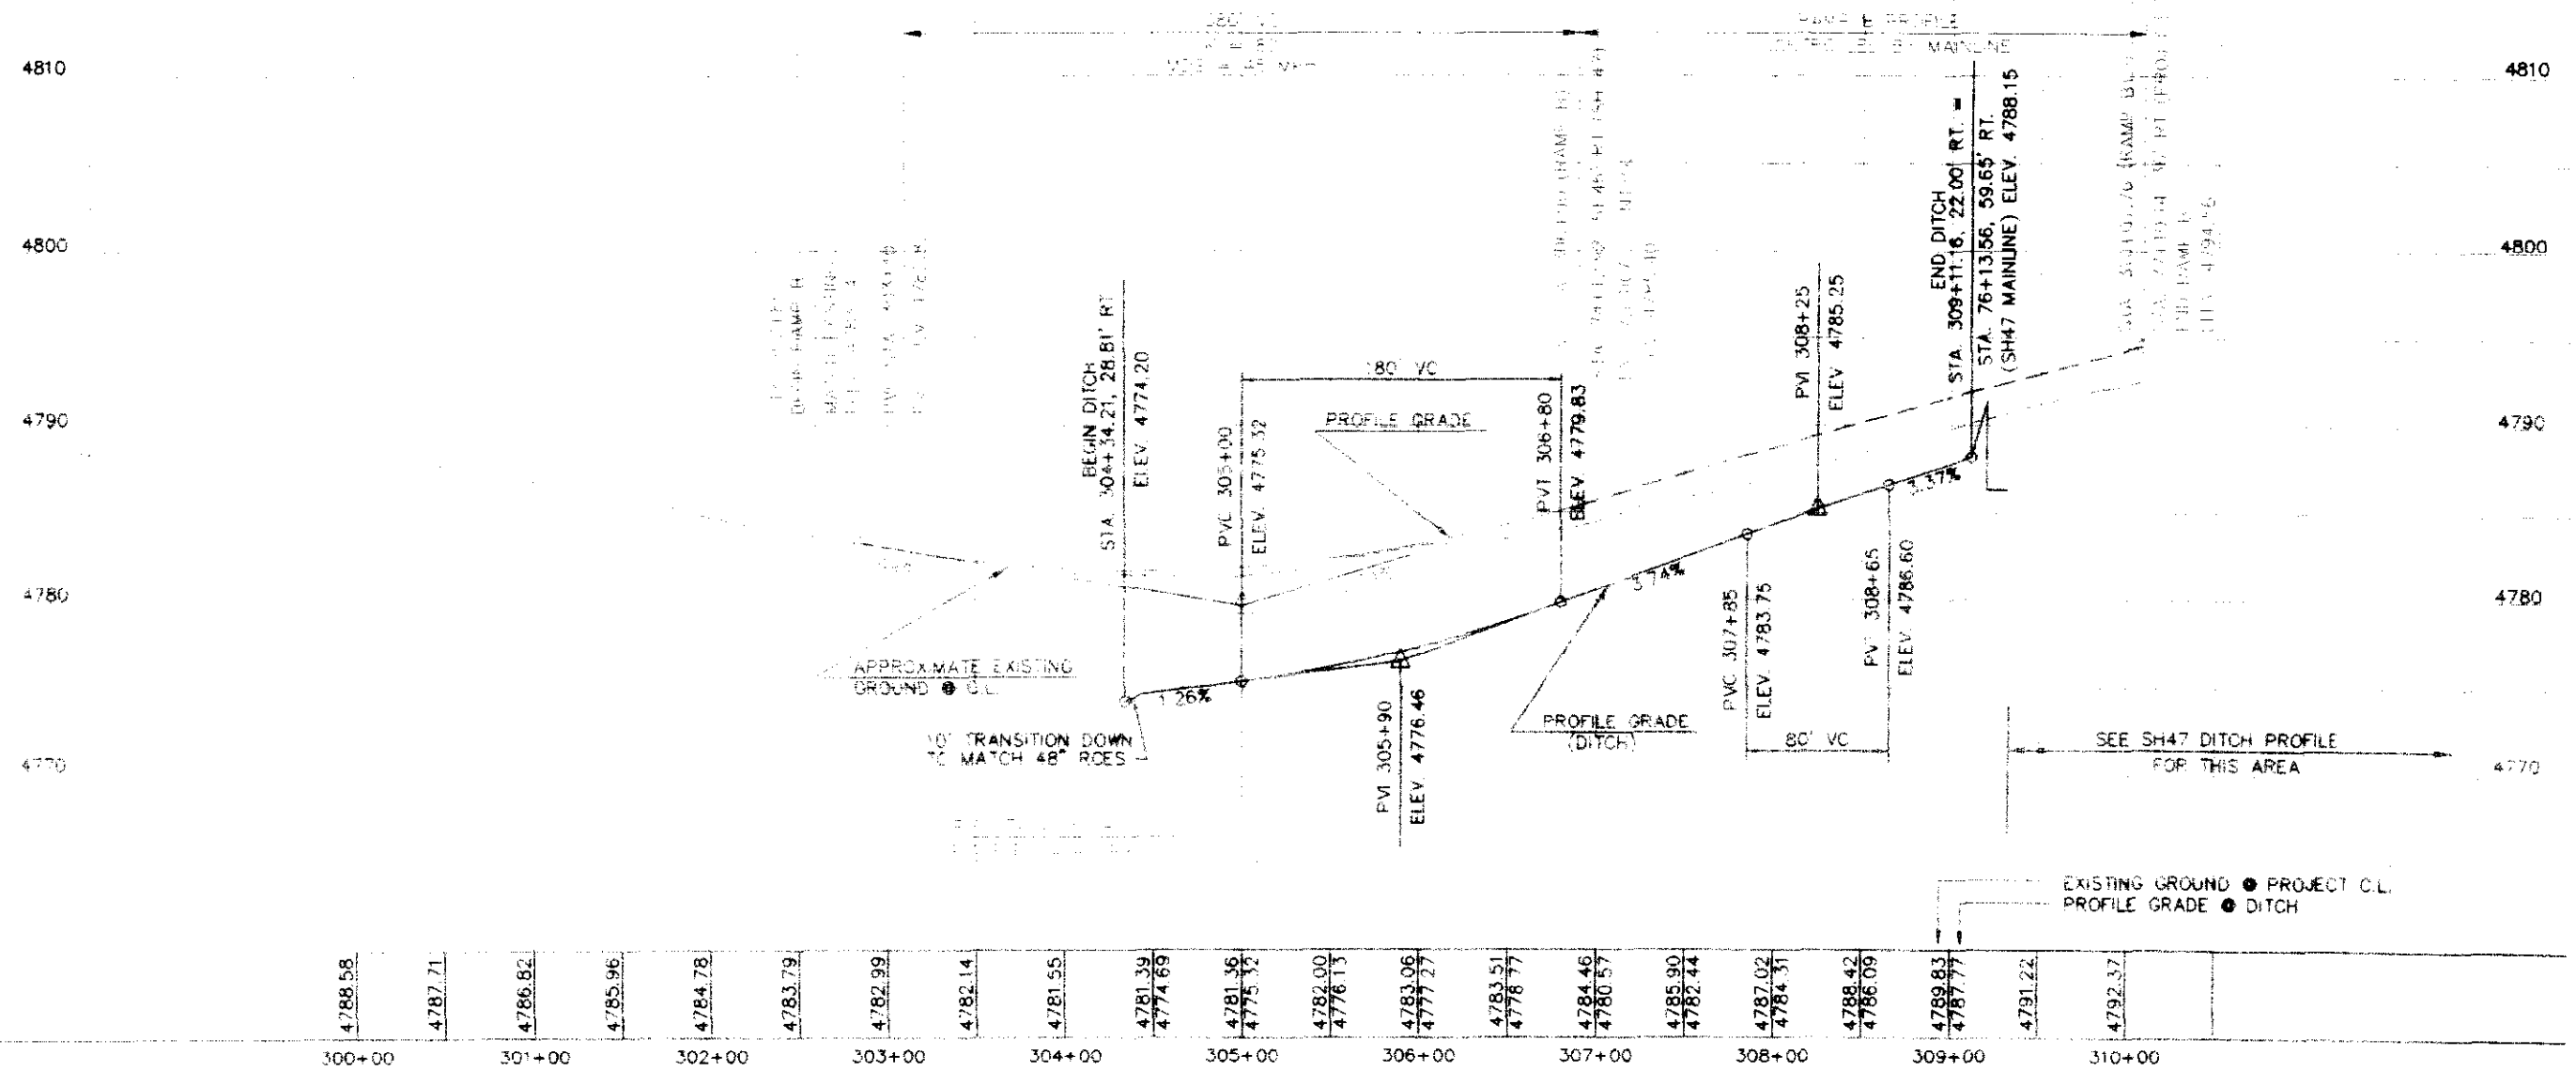


PROJECT NO.		SECTION NO.		SHEET NO.		SHEET TOTALS	
VC 0471-020		VC 0471-020		VC 0471-020		VC 0471-020	
VC 0471-020		VC 0471-020		VC 0471-020		VC 0471-020	

DESIGNED BY	CHECKED BY
DATE	DATE
QUANTITIES BY	QUANTITIES BY
CHECKED BY	CHECKED BY


DATE: 10-05-1995 TIME: 10:00:00

DRAWING NAME: DITCH PROFILE

VIEW NAME: DITCH

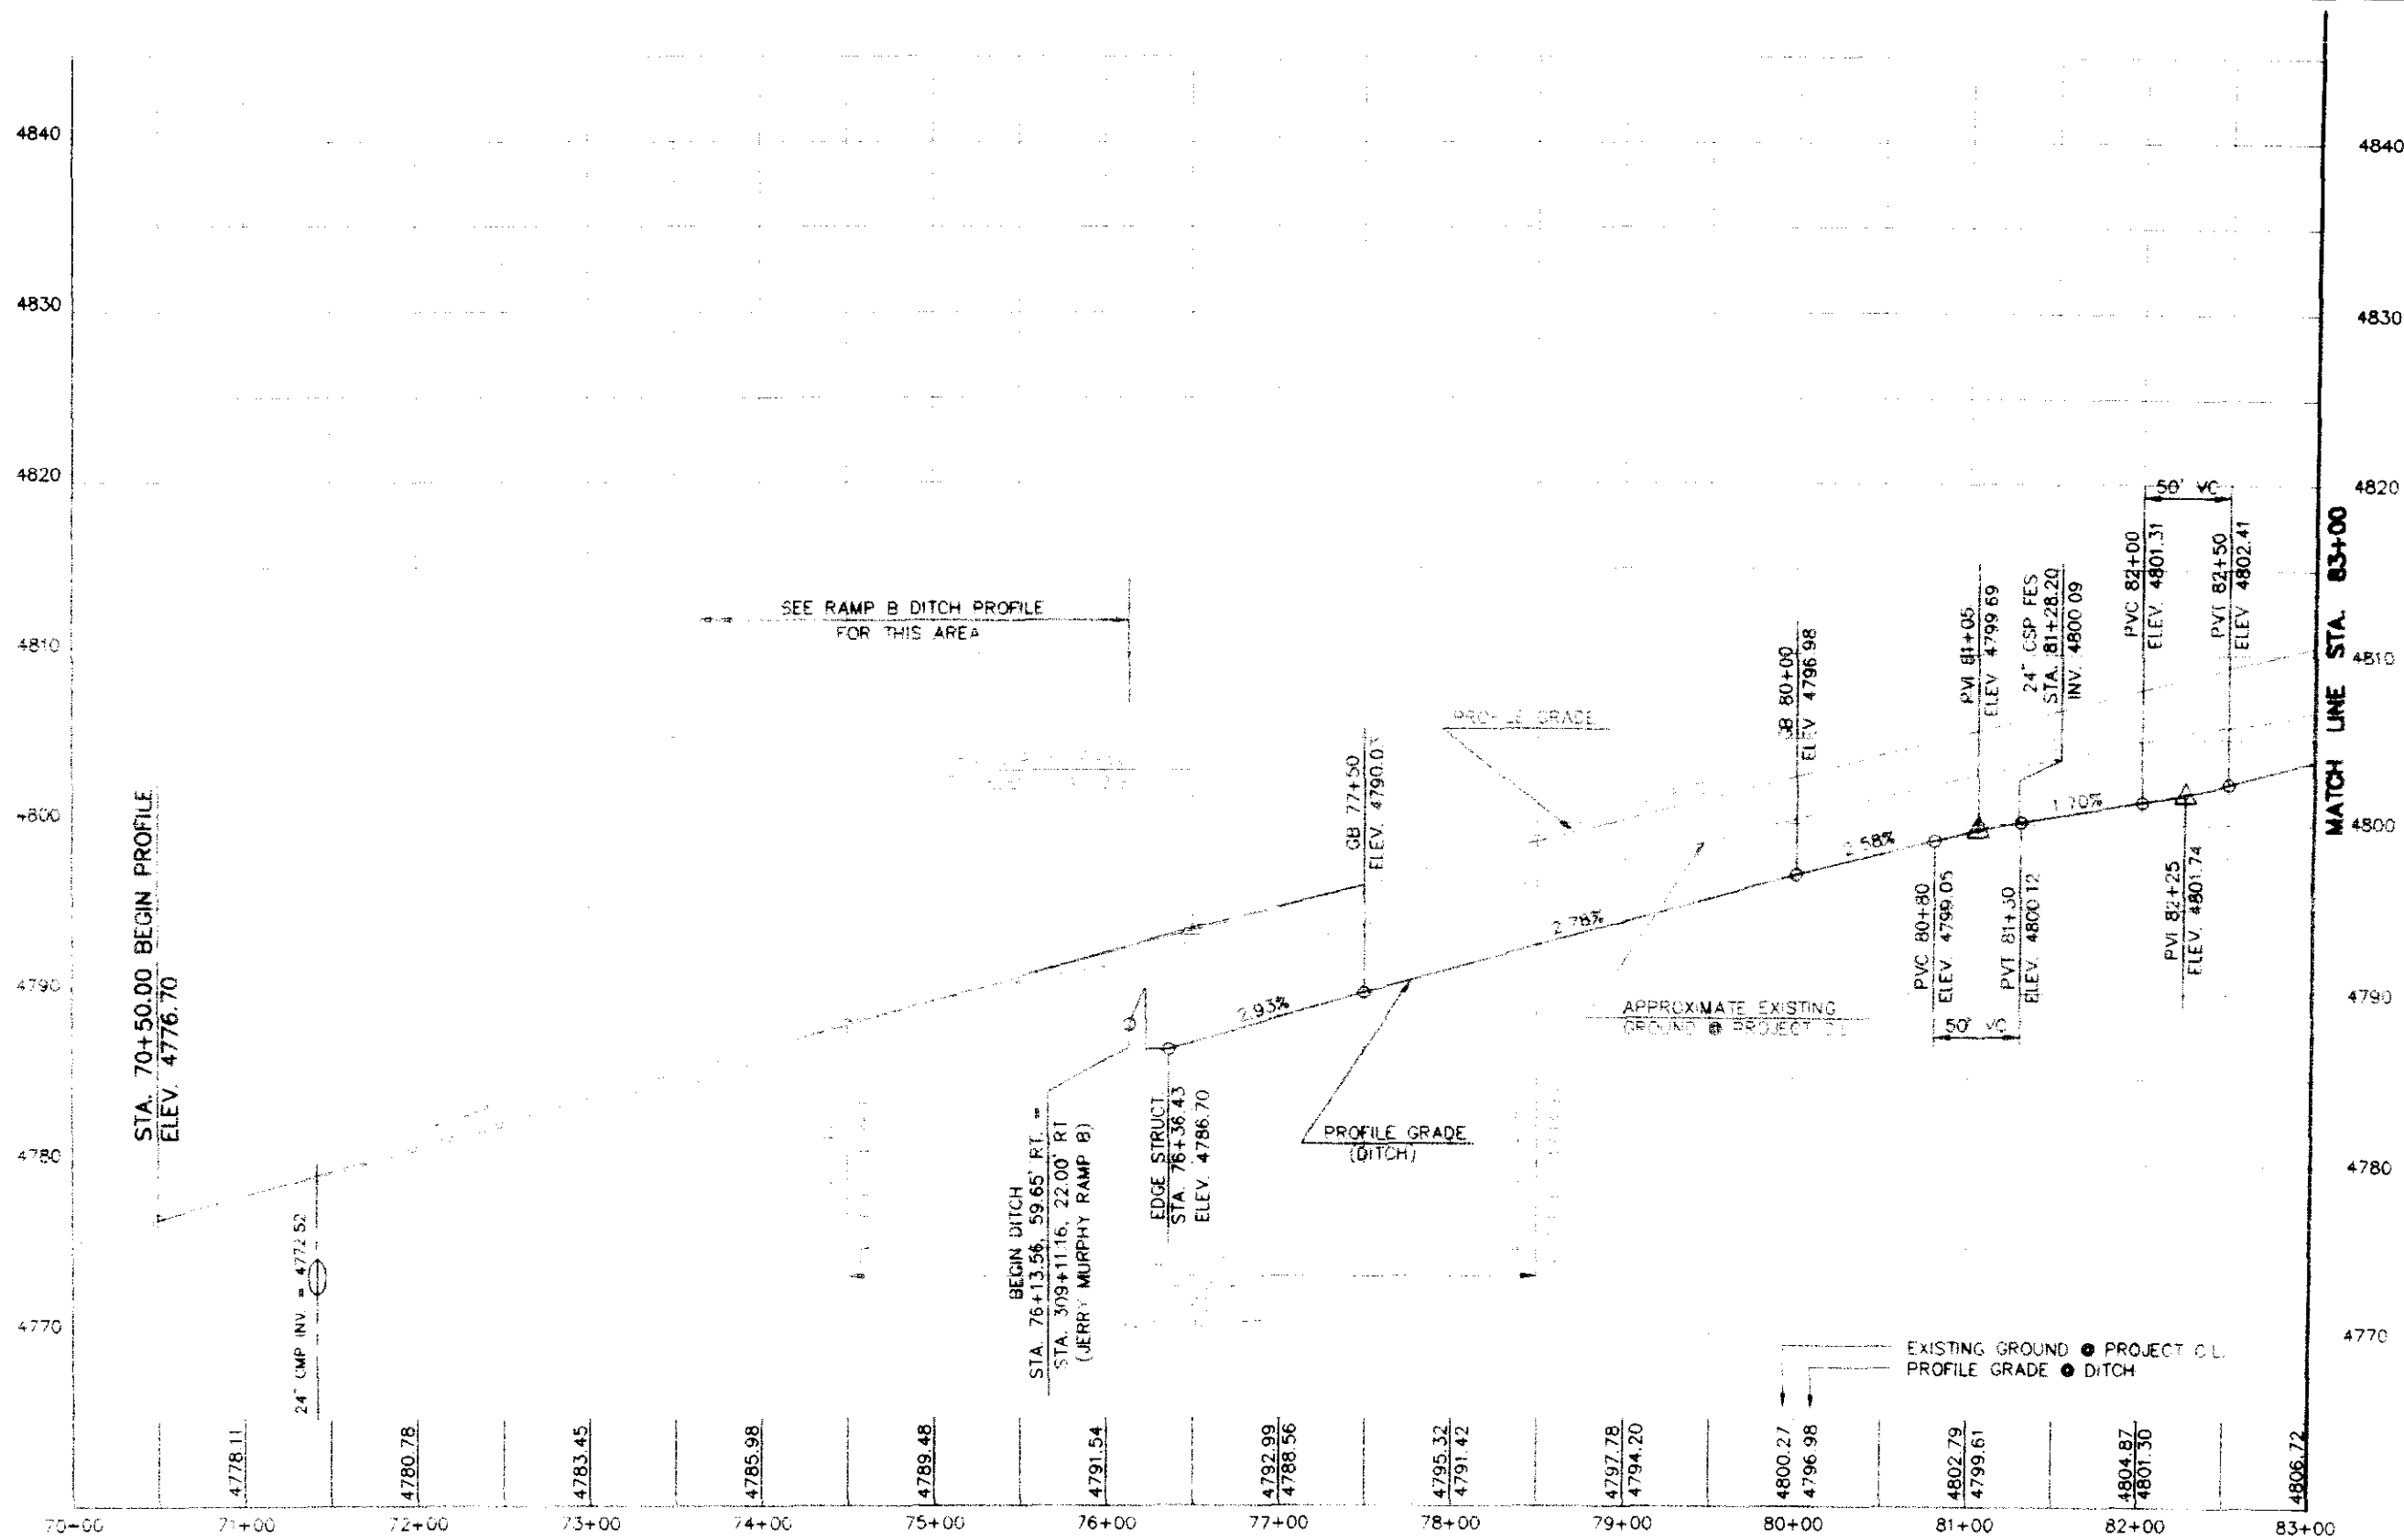

PROJECT NO.	DIVISION	PROJECT NO.	SHEET NO.	SHEET TOTALS
		STA 0471-020	68	

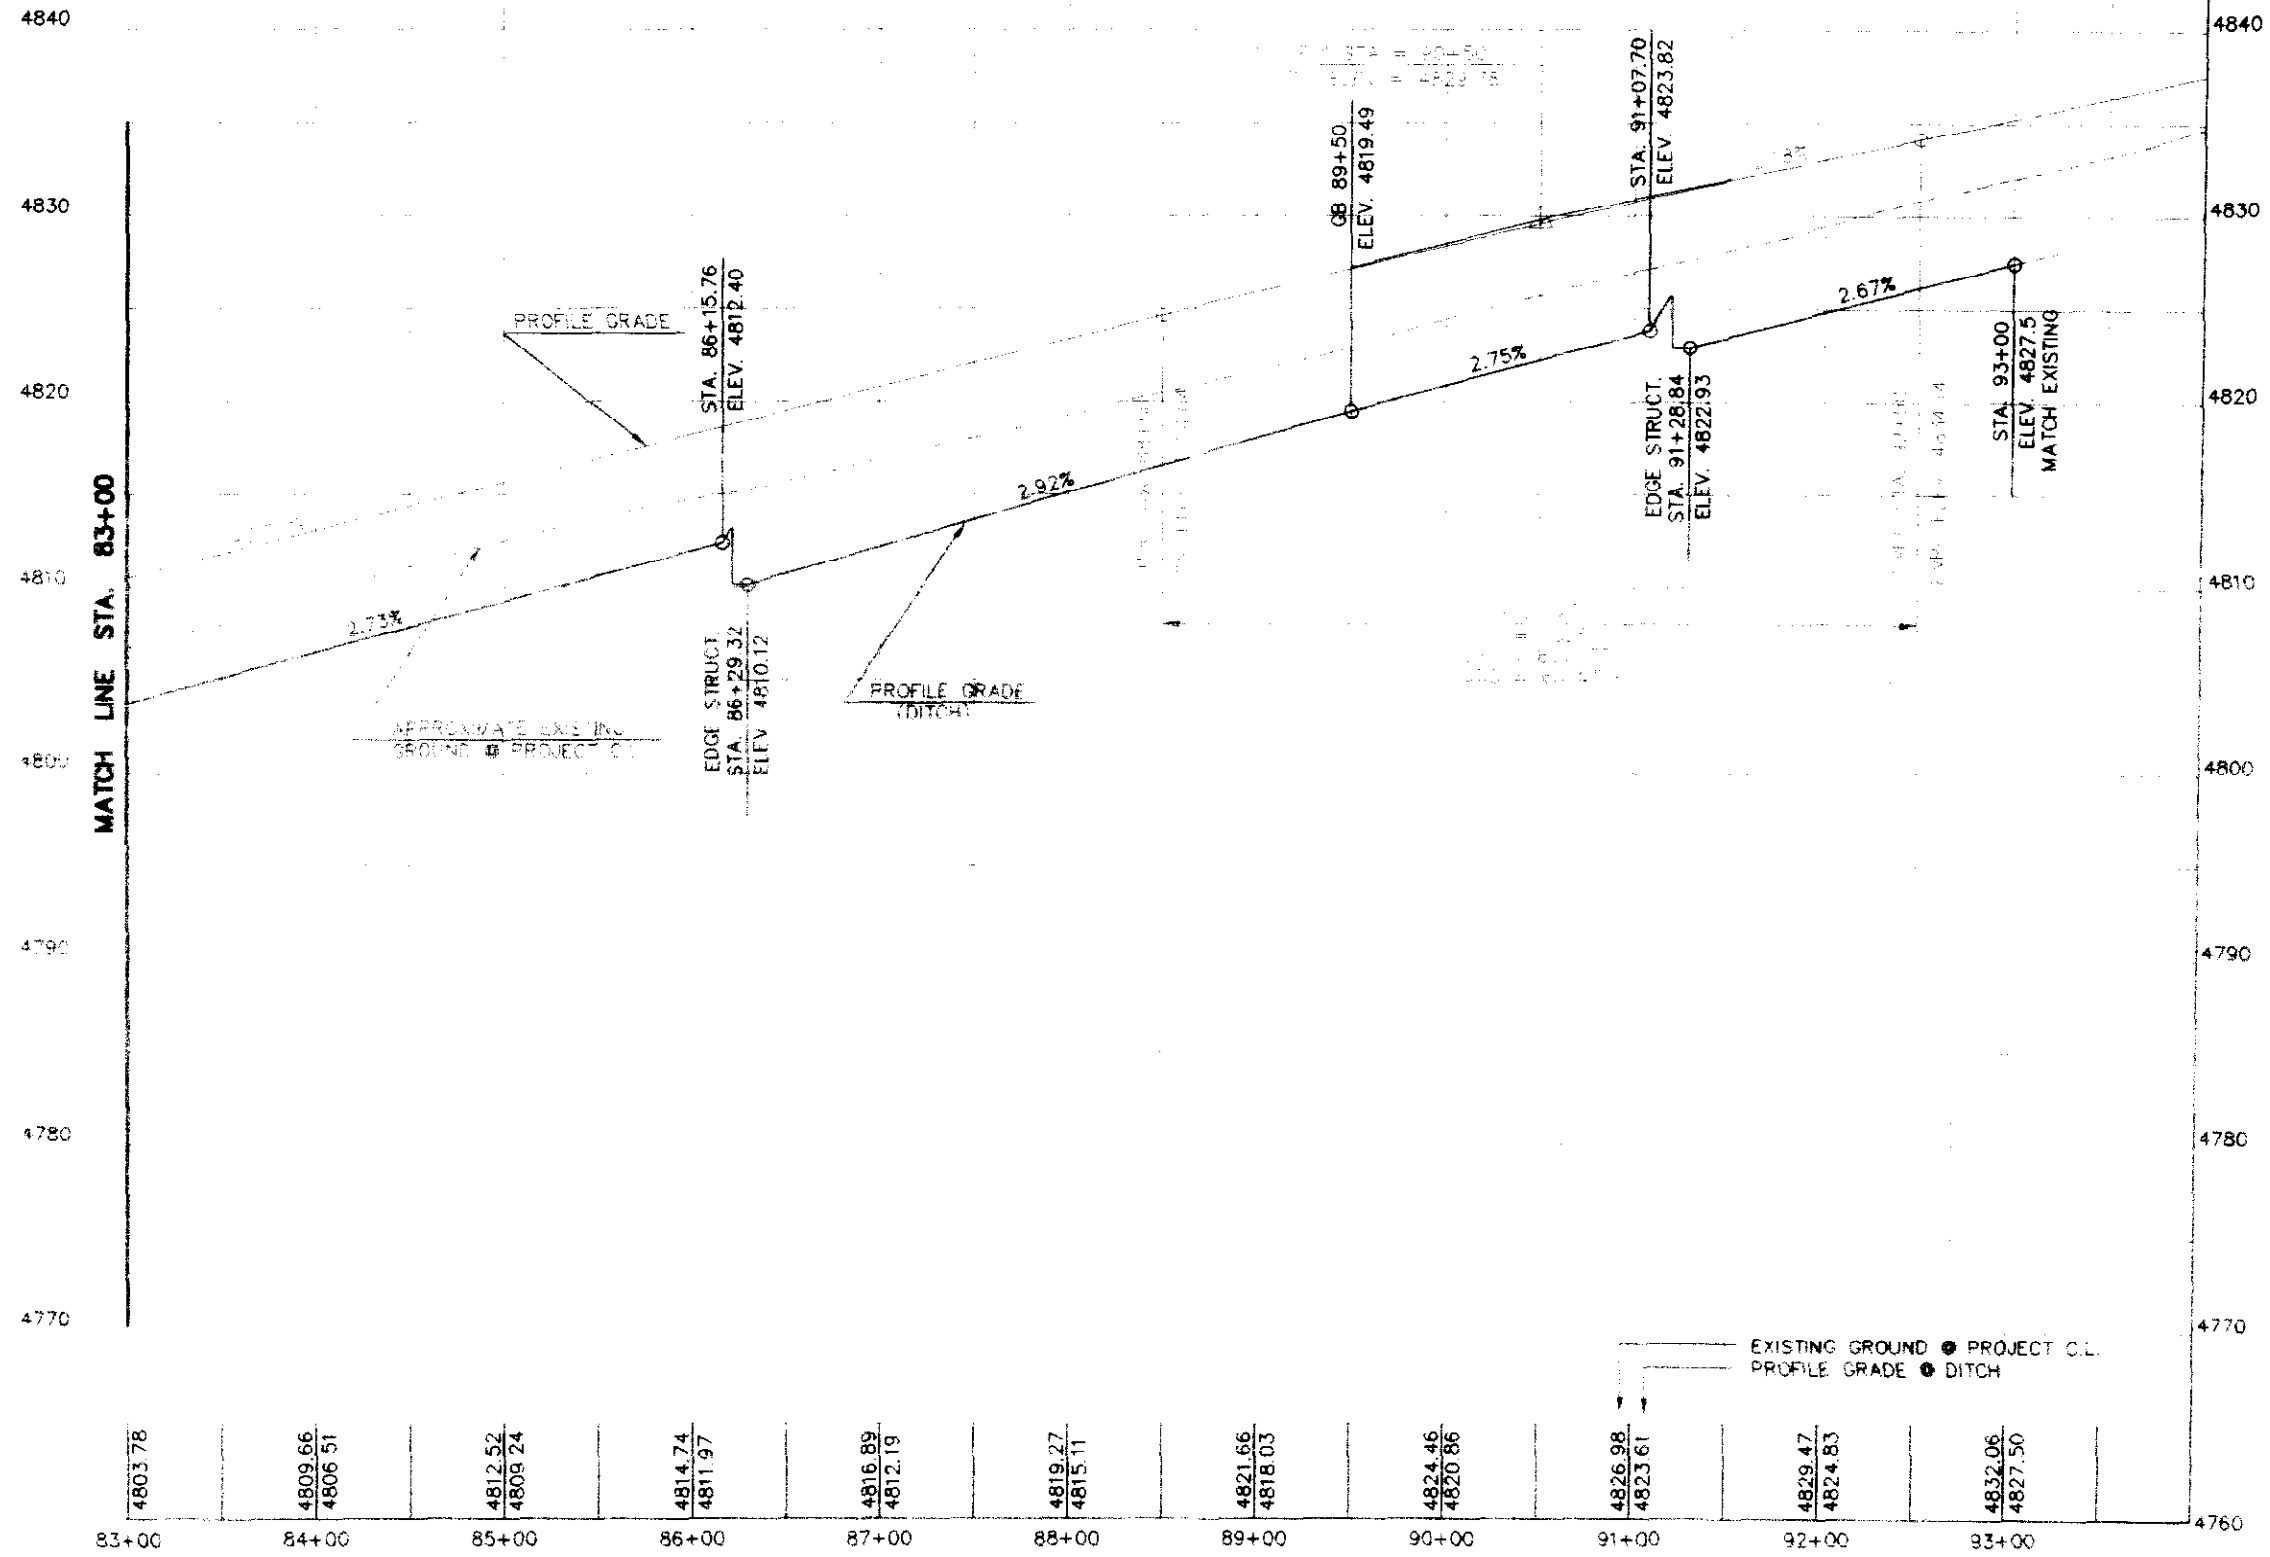

DESIGNED BY	CHECKED BY
CHECKED BY	QUANTITIES BY
DATE	CHECKED BY

DATE: 10-10-1990

DRAWING NAME: SH47 MAINLINE DITCH PROFILE

VIEW NAME: DITCH

STATE OF COLORADO
TRANSPORTATION DEPARTMENT
DIVISION OF HIGHWAYS
7700 East Hampden Avenue
Denver, Colorado 80231

Project Drawings
WETLAND


LEGEND

WETLAND TOPSOIL PLACEMENT

REVISION	DATE	BY	DESCRIPTION

PROJECT NO.	STA 0471-020
SHEET NO.	69
SHEET TOTALS	

REGION	DIVISION	PROJECT NO.	SHEET NO.	SHEET TOTALS
		STA 0471-020	69	

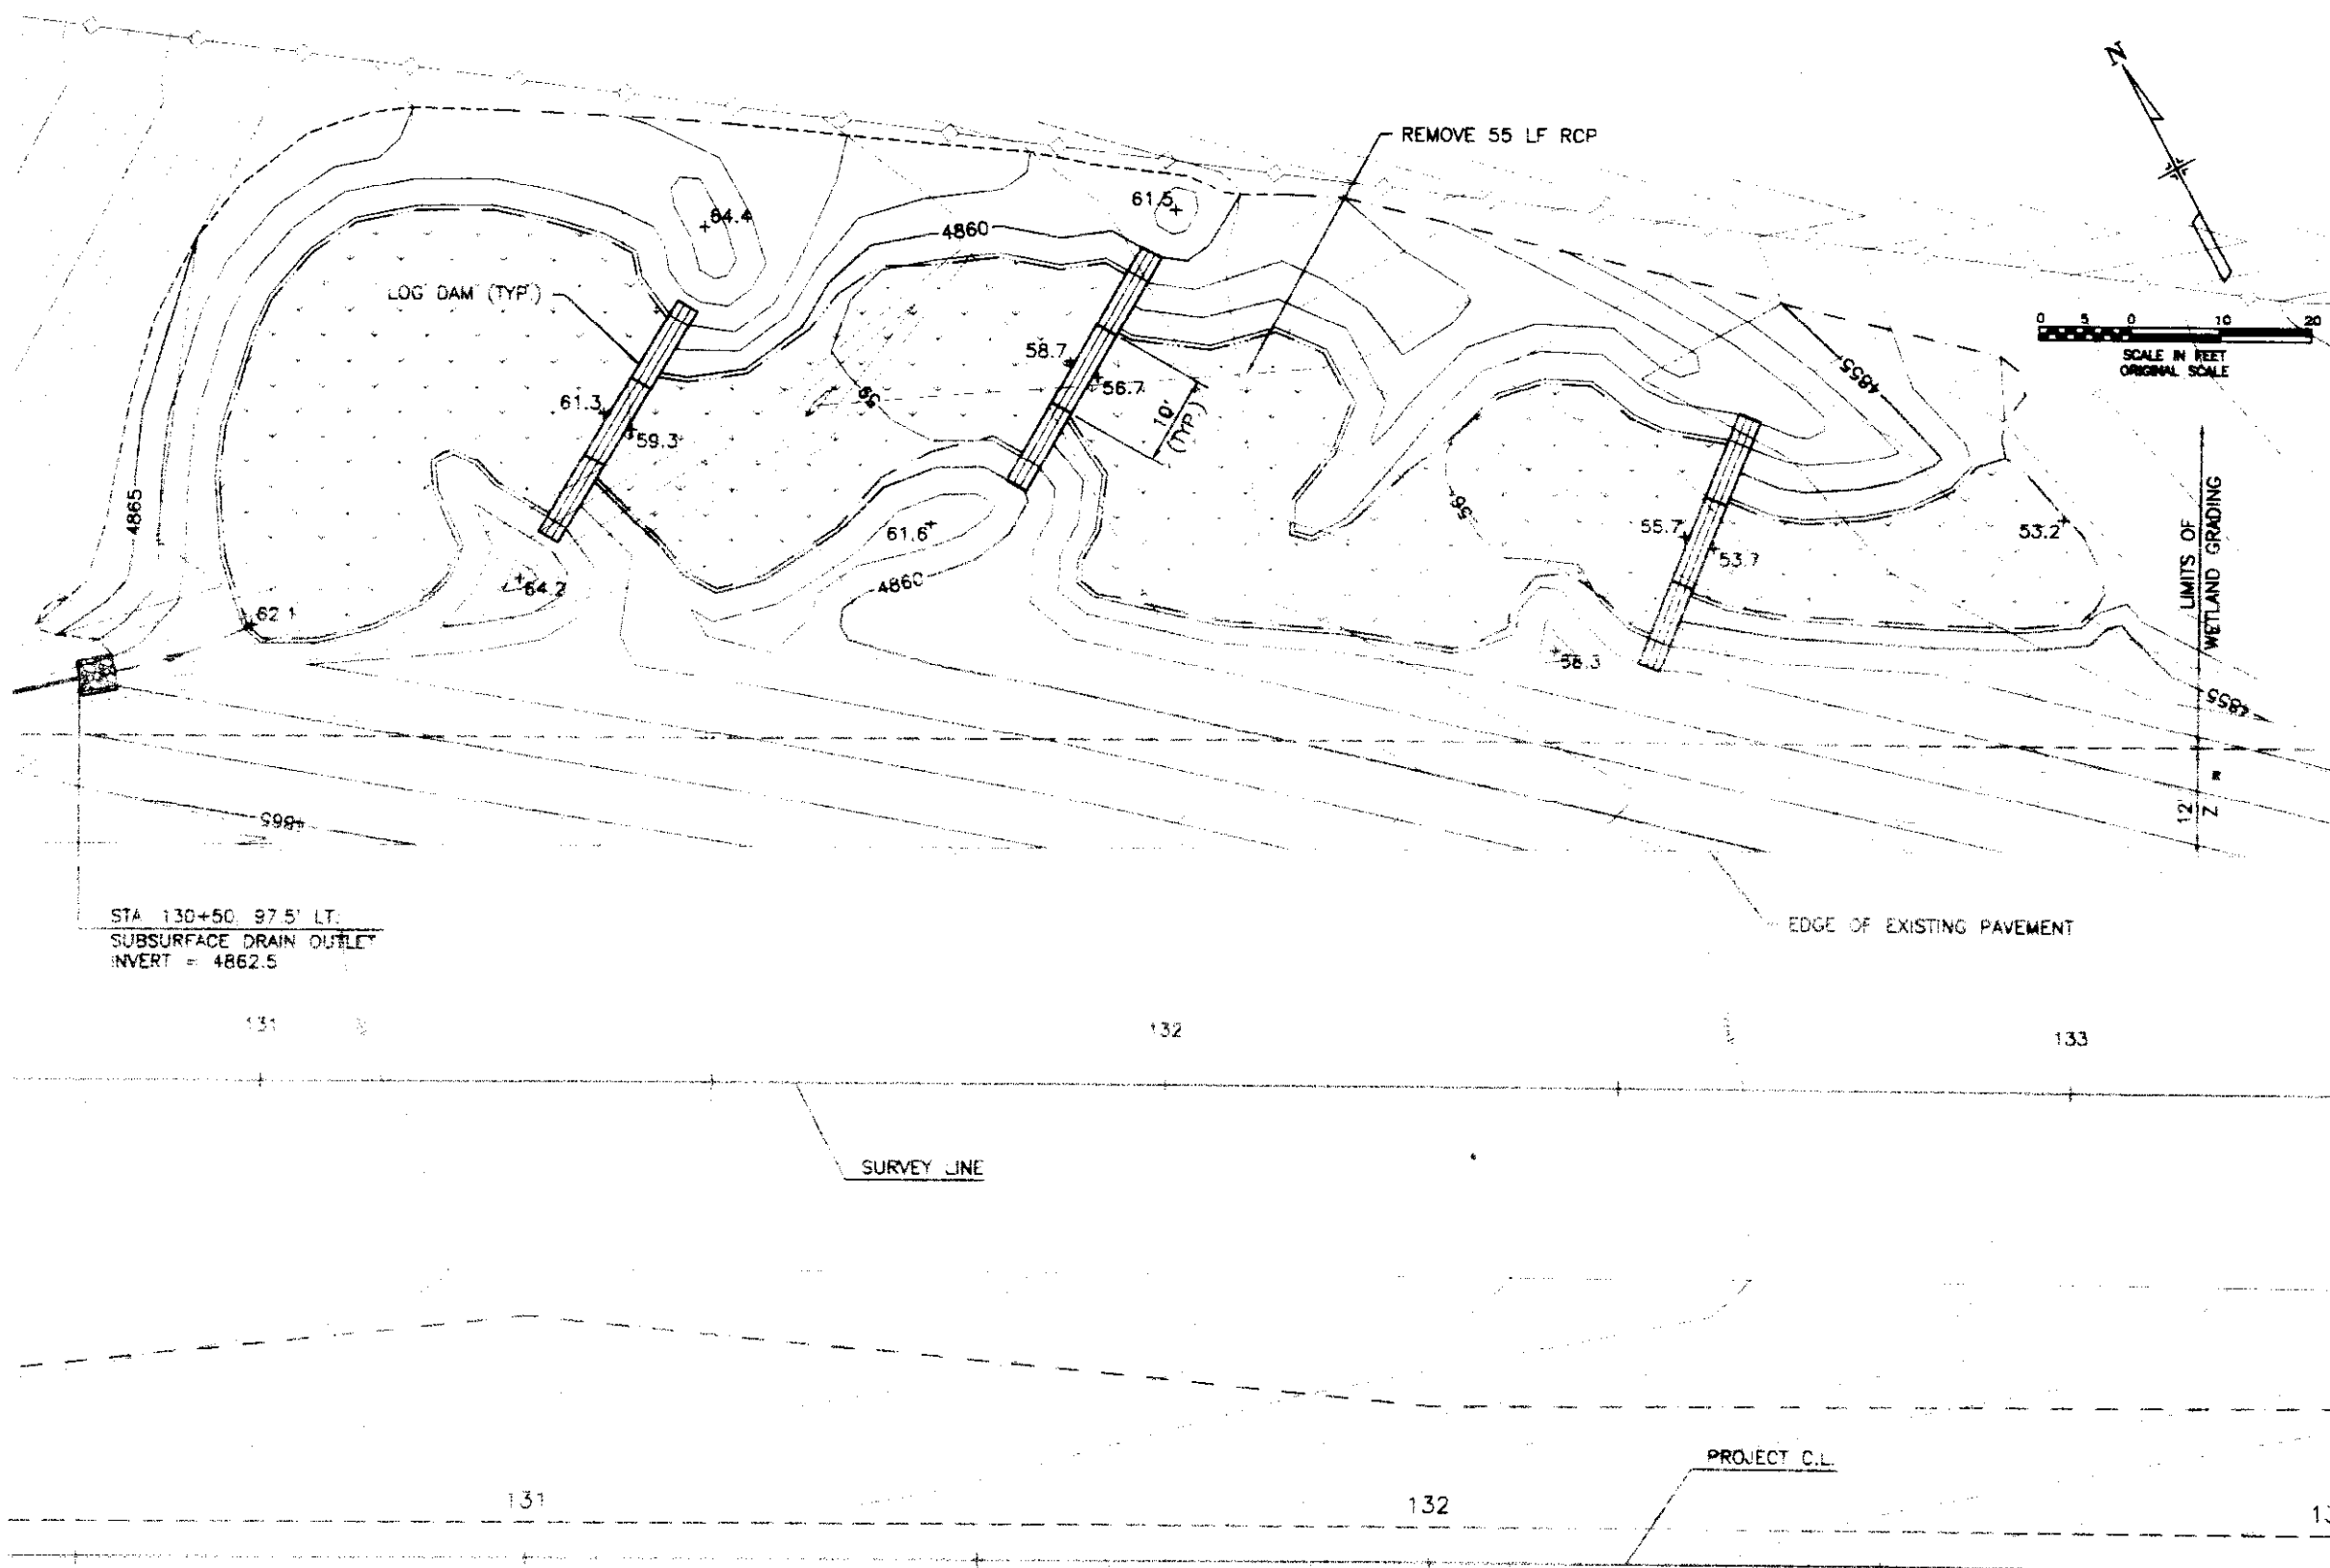

WETLAND MITIGATION PLAN NOTES:

THE CONTRACTOR SHALL GIVE THE ENGINEER A TWO WEEK NOTICE PRIOR TO EXCAVATING AND FINAL GRADING THE WETLAND MITIGATION AREA SO THAT THE ENGINEER CAN CONTACT THE STAFF LANDSCAPE ARCHITECT TO BE ON THE SITE.

IT IS ESTIMATED THAT 20 HOURS OF DOZING (LANDSCAPING) WITH A DOZER (55 TO 75 HP RANGE) WILL BE REQUIRED TO FINAL GRADE THE WETLAND MITIGATION AREA.

UNDULATE THE SIDE SLOPES OF THE WETLAND MITIGATION AREA FROM 3:1 TO 10:1 TO PROVIDE HABITAT DIVERSITY.

EXCAVATE APPROXIMATELY 180 CY OF WETLAND TOPSOIL FROM THE AREA LOCATED FROM STA. 118+00 TO 120+00, RT. AS SHOWN ON THE PLANS. PLACE WETLAND TOPSOIL TO A DEPTH OF 12".

FINAL GRADES IN THE MITIGATION AREA SHALL BE LEFT IN A ROUGHENED CONDITION.

SEE STORMWATER MANAGEMENT SHEETS FOR EROSION CONTROL DETAILS.



IT IS ESTIMATED THAT APPROXIMATELY 342 CY OF UNCLASSIFIED EXCAVATION WILL BE REQUIRED FOR THE GRADING OF THE WETLAND MITIGATION AREA. THIS MATERIAL WILL NOT BE PAID FOR SEPARATELY BUT SHALL BE INCLUDED IN THE WORK. (SEE EARTHWORK SUMMARY).

WETLAND TABULATION




ITEM	DESCRIPTION	UNIT	QUANT
203	DOZING (LANDSCAPING)	HR	20
207	WETLAND TOPSOIL	CY	180

PROJECT NO.		SHEET NO.		SHEET TOTALS	
		70			

CONTRACT NO.	STA 0471-020
--------------	--------------

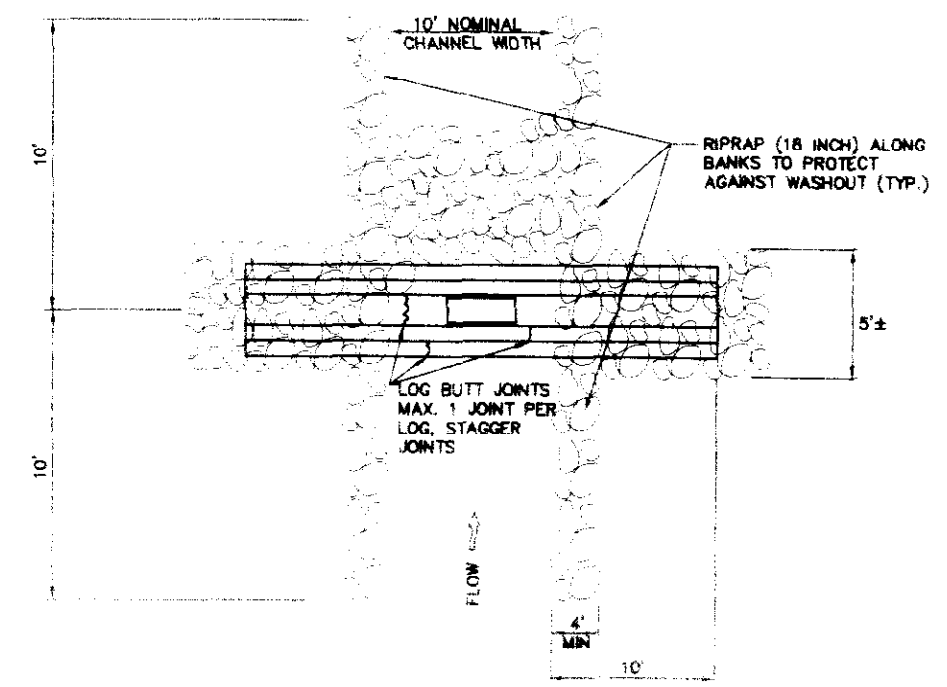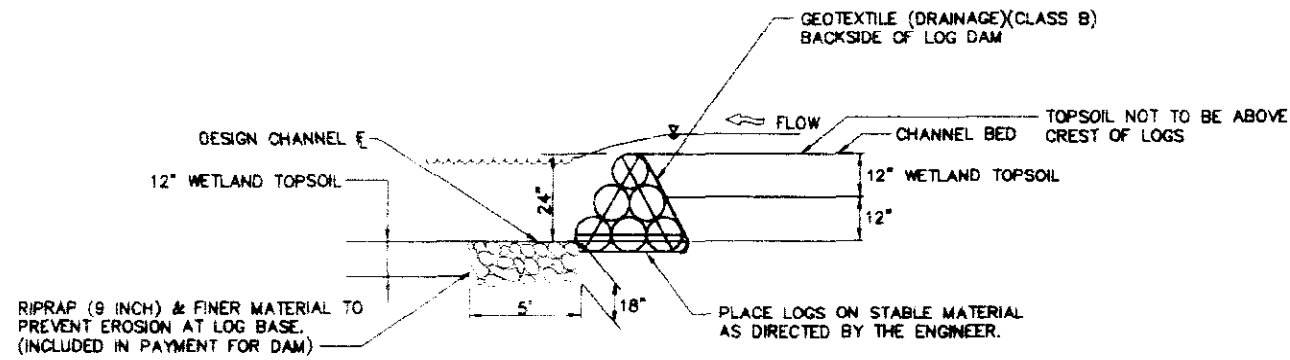

PLAN

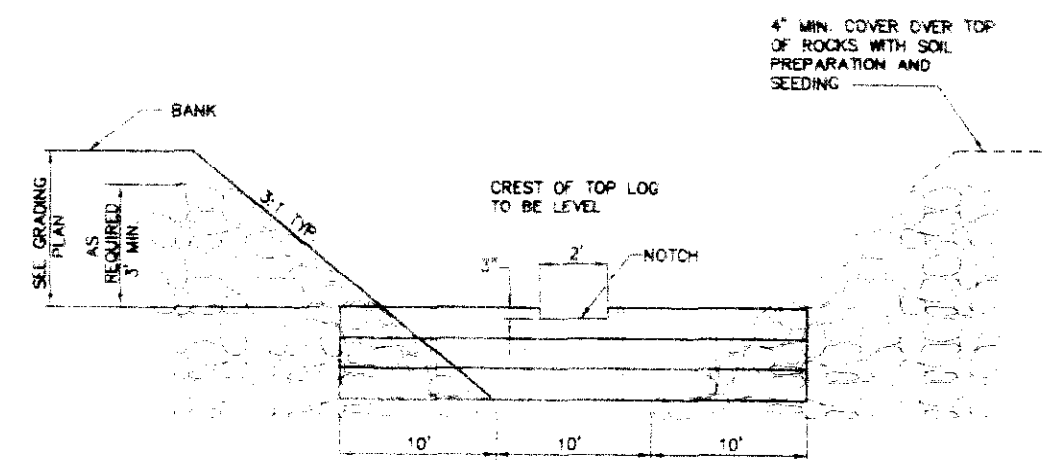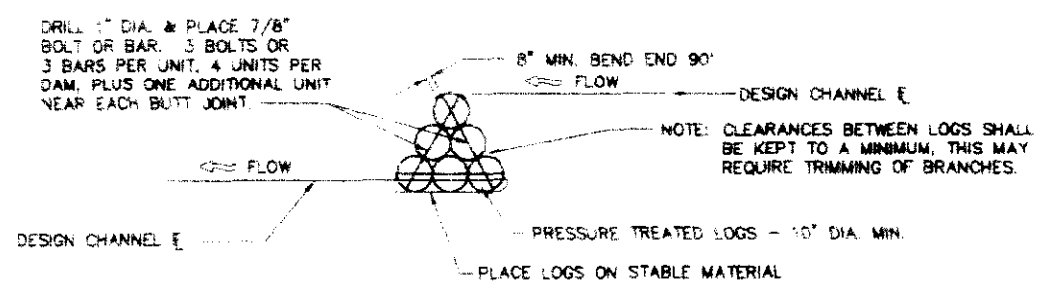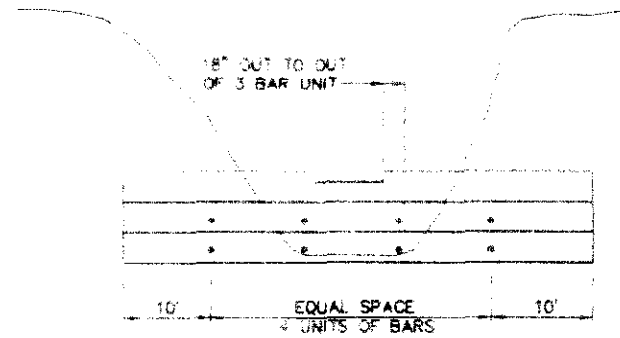

DOWNSTREAM LOOKING UPSTREAM ELEVATION

PAY ITEMS

420	GEOTEXTILE (DRAINAGE)(CLASS B)	SQ. YDS.	30
506	RIPRAP (9 INCH)	CU. YDS.	90
506	RIPRAP (18 INCH)	CU. YDS.	123
615	LOG DAM	EACH	3

ALL COSTS FOR INSTALLING LOGS INCLUDING COST OF BARS OR BOLTS, NUTS & WASHERS AND ANY SAWING, PLACEMENT, EXCAVATION & BACKFILL SHALL BE INCLUDED IN THE COST OF LOG DAM.

• FOR INFORMATION ONLY
 • QUANTITY CARRIED TO STRUCTURE QUANTITIES LIST

STORMWATER MANAGEMENT PLAN - ADDITIONAL INFORMATION

Estimated Runoff coefficient
Pre-construction: 0.49 Post-construction: 0.57

Existing data describing soil
or quality of discharge: SANDY CLAYS AND WEATHERED TO VERY HARD
CLAYSTONE BEDROCK

Existing vegetation: SPARSE TO MEDIUM NATIVE GRASSES AND WEEDS

Proposed sequence for major activities, location
of any other potential pollution source, areas
used for storage of building materials, soils
or wastes, and location of any dedicated asphalt
or concrete batch plants: see water quality and
erosion control specifications, and documents
submitted by the contractor at the preconstruction
conference.

100-year Flood plain boundaries:
see bridge hydraulic information
sheet (if existent).

Description of the construction activity,
estimate of the total site area
and of the area expected to undergo
excavation, and name of the receiving
water: see CDPS stormwater permit
application.

Contract Document location of erosion control and stormwater quality management measures
not referenced above nor included on the Stormwater Management Plan Sheet(s):

N/A

Site map and construction site
boundaries: see title sheet

Areas of cuts and fills and
areas of soil disturbance: see
plan and profile sheets and
roadway cross sections.

Surface waters: see title sheet
and bridge hydraulic information sheet
(if existent)

Materials handling and spill prevention:
see water quality specification (107.25).

Inspection and maintenance: see erosion
control specifications (107.25 or 208).

TABULATION OF EROSION CONTROL ITEMS

LOCATION (STA.)	SIDE	EROSION BALES (EACH)		SILT FENCE (LF.)
		EROSION BALE FILTER	EROSION CONTROL CHECK DAM	
304+40, RAMP B	RT	5		
73+00, SH47 TO 95+00, SH47 (200 FT. SPACING)	RT		60	
110+00, SH47 TO 118+00, SH47 (200 FT. SPACING)	RT		10	
122+00, SH47 TO 130+00, SH47	RT		10	
131+10, SH47 AND 132+90, SH47	LT		4	
132+00, SH47	RT			30
137+00, SH47	RT			20
167+50, SH47	RT	20		
707+00, RAMP A TO 715+00, RAMP A (200 FT. SPACING)	RT		10	
716+80, RAMP A	LT	10		
718+80, RAMP B	LT	10		
TOTAL		46	94	50

SPECIAL PROJECT NOTES:

PLACEMENT OF TOPSOIL, SEEDING AND MULCHING WILL NOT BE DONE IN A SINGLE OPERATION, BUT SHALL
BE COMPLETED AFTER EACH CONSTRUCTION PHASE. IT IS ESTIMATED THAT THREE MOBILIZATIONS FOR SOIL
PREPARATION, SEEDING, AND MULCHING WILL BE REQUIRED AND SHALL BE INCLUDED IN THE PRICE OF THE WORK.

DISTURBED SURFACES SHALL BE LEFT IN A ROUTHERED CONDITION AT ALL TIMES DURING CONSTRUCTION.

WHEN DISTURBED AREA EXCEEDS LIMITS REFERENCED IN THE STANDARD SPECIAL PROVISION 208, APPLY 2 TONS
PER ACRE NATIVE HAY MECHANICALLY CRIMPED INTO THE SOIL. IT IS ESTIMATED THAT SEVERAL MOBILIZATIONS
FOR MULCHING WILL BE REQUIRED AND SHALL BE INCLUDED IN THE PRICE OF THE WORK.

PRIOR TO WINTER SHUTDOWN ALL COMPLETED SLOPES SHALL BE TOPSOILED, SEEDED, AND MULCHED.
UNCOMPLETED SLOPES SHALL BE MULCHED WITH 1 1/2 TONS NATIVE HAY MECHANICALLY CRIMPED
IN COMBINATION WITH AN ORGANIC MULCH TACKIFIER PER PROJECT SPECIAL PROVISION 213.

SEDIMENT REMOVAL AND DISPOSAL SHALL BE INCLUDED IN THE WORK.

AS CONSTRUCTED			FED. ROAD REGION	DIVISION	PROJ. NO.	SHEET NO.
NO REVISIONS	REVISED	VOID	VIII	COLO.	STA 0471-020	71

SEEDING PLAN

SOIL PREPARATION, FERTILIZER, SEEDING AND MULCHING WILL BE REQUIRED FOR AN
ESTIMATED 25 ACRES OF DISTURBED AREA WITHIN THE RIGHT-OF WAY LIMITS WHICH ARE
NOT SURFACED.

THE FOLLOWING TYPES AND RATES SHALL BE USED:

COMMON NAME	BOTANICAL NAME	LBS PLS/ACRE
BLUE GRAMA V. HACHITA	BOUTELOUA GRACILIS	0.3
WESTERN WHEATGRASS V. ARRIBA	PASCOPYRUM SMITHII	7.0
SIDEOTS GRAMA V. VAUGHN	BOUTELOUA CURTIPENDULA	1.0
GALLETA V. VIVA (CARYOPSIS)	HILARIA JAMESII	1.0
ALKALI SACATON	SPOROBOLUS AIROIDES	0.4
SWITCHGRASS V. NEBR 28	PANICUM VIRGATUM	1.0
BLANKETFLOWER	GAILLARDIA ARISTATA	1.0
PRAIRIE CONEFLOWER	RATIBIDA COLUMNIFERA	0.1
OATS	AVENA SATIVA	5.0
TOTAL		16.8

SEEDING APPLICATION: DRILL SEED 0.25" - 0.5" INTO THE TOPSOIL.

MULCHING APPLICATION: 1 1/2 TONS NATIVE HAY PER ACRE MECHANICALLY CRIMPED INTO
THE TOPSOIL IN COMBINATION WITH AN ORGANIC MULCH TACKIFIER
PER SPECIAL PROVISION 213.

SPECIAL REQUIREMENTS:
* IF FALL SEEDING SUBSTITUTE WITH WINTER WHEAT
(TRITICUM AESTIVUM) AT 5 LBS. PLS/ACRE

FERTILIZER	RATE PER ACRE
NITROGEN	45
PHOSPHORUS (P205)	87
POTASSIUM (K20)	43.5
ZINC SULFATE	11
IRON CHELATE	11

PROJECT PAY TOTALS		
PAY ITEM	DESCRIPTION	TOTALS
208	SILT FENCE	50
208	EROSION BALE	140
212	SEEDING (NATIVE)	20
212	SOIL PREPARATION (SPECIAL)	20
213	MULCHING (NATIVE)	20
213	MULCH TACKIFIER	2500
F/A	TEMPORARY EROSION CONTROL	1

*FERTILIZER	(NITROGEN)	LB	1125
*FERTILIZER	(PHOSPHORUS P205)	LB	2175
*FERTILIZER	(POTASSIUM K20)	LB	1087.5
*FERTILIZER	ZINC SULFATE	LB	275
*FERTILIZER	IRON CHELATE	LB	275
*SEEDING (NATIVE)		LB	420
*MULCHING (NATIVE)		TONS	30

*FOR INFORMATION ONLY


COLORADO
DEPARTMENT OF TRANSPORTATION

STORMWATER MANAGEMENT PLAN


DESIGNER D. HILLIARD

PROJECT NO.	STA. 0471-020
SECTION	
DATE	
BY	
CHECKED BY	
DESIGNED BY	
APPROVED BY	

REGION	DIVISION	PROJECT NO.	SHEET NO.	SHEET TOTAL
		STA 0471-020	72	

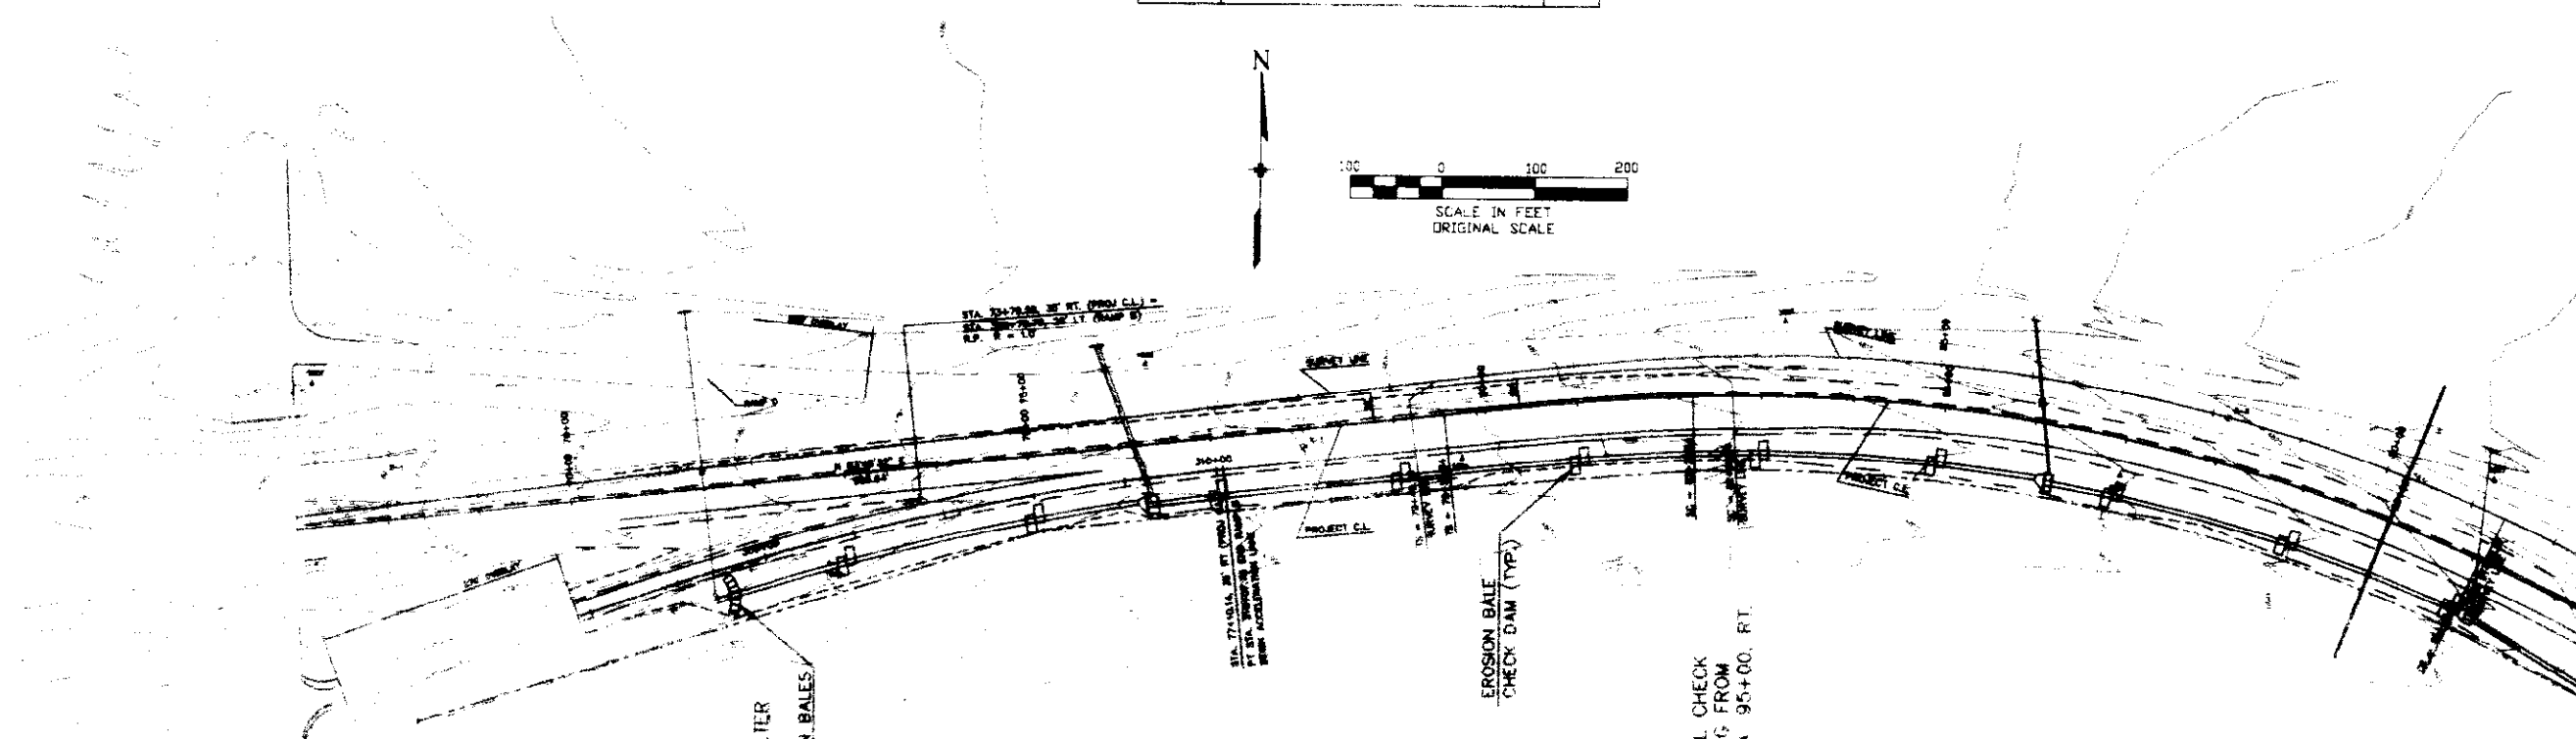

DESIGNED BY	CHECKED BY
CHECKED BY	QUANTITIES BY
REVIEWED BY	CHECKED BY

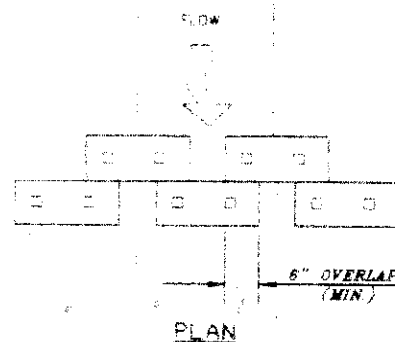


FLAT BOTTOM DITCH




V - DITCH


EROSION CONTROL CHECK DAM

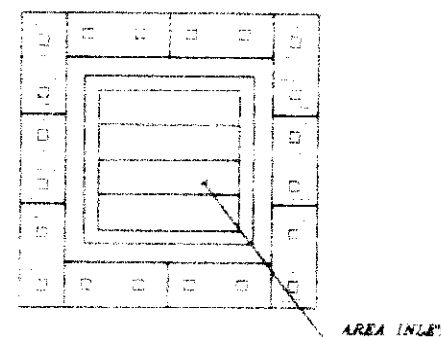


EROSION BALE FILTER

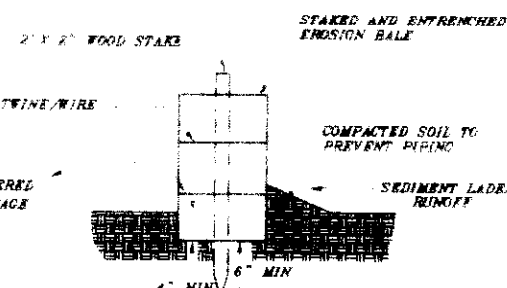

CROSS SECTION OF A PROPERLY INSTALLED EROSION BALE

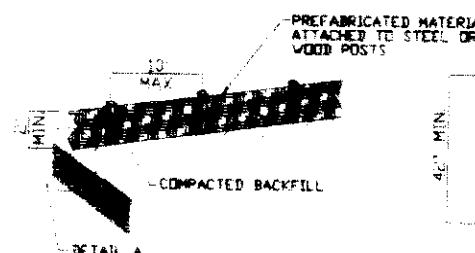

DETAIL A
SILT FENCE DETAIL
NOT TO SCALE

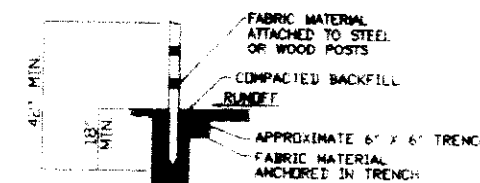


DETAIL A
NOT TO SCALE


NOTES

1. EROSION PROTECTION SHALL BE PROVIDED FOR ALL AREAS DISTURBED DURING CONSTRUCTION.
2. INSTALLATION OF SOIL EROSION CONTROLS SHALL BE IN ADVANCE OF ANY CONSTRUCTION ACTIVITY WHICH MAY PRODUCE SEDIMENT CONTAMINATED RUNOFF.
3. EROSION BALE STAKES SHALL NOT BE PLACED THROUGH GEOTEXTILE FABRIC. CHECK DAMS SHALL BE REMOVED, IF NECESSARY, PRIOR TO PLACEMENT OF GEOTEXTILE FABRIC.
4. ALL WORK NECESSARY TO CONTROL EROSION AND MAINTAIN WATER QUALITY DURING CONSTRUCTION SHALL BE PAID FOR UNDER THE APPROPRIATE BID ITEMS OR FORCE ACCOUNT.
5. ALL WORK SHALL BE PERFORMED IN ACCORDANCE WITH SECTION 208 OF THE STANDARD SPECIAL PROVISIONS AND IN ACCORDANCE WITH THESE DETAILS.
6. EROSION BALES SHALL BE PLACED WITH RESPECT TO THE SHAPE OF THE DITCH. WHERE BALES ARE TO BE STAGGERED, OVERLAP BALES A MINIMUM OF 6 INCHES. REFER TO DETAILS FOR TYPICAL EROSION BALE CHECK DAM CONFIGURATION.

PROJECT NO.	DIVISION	PROJECT NO.	SHEET NO.	SHEET TOTALS
0471-020	0471-020	0471-020	73	73

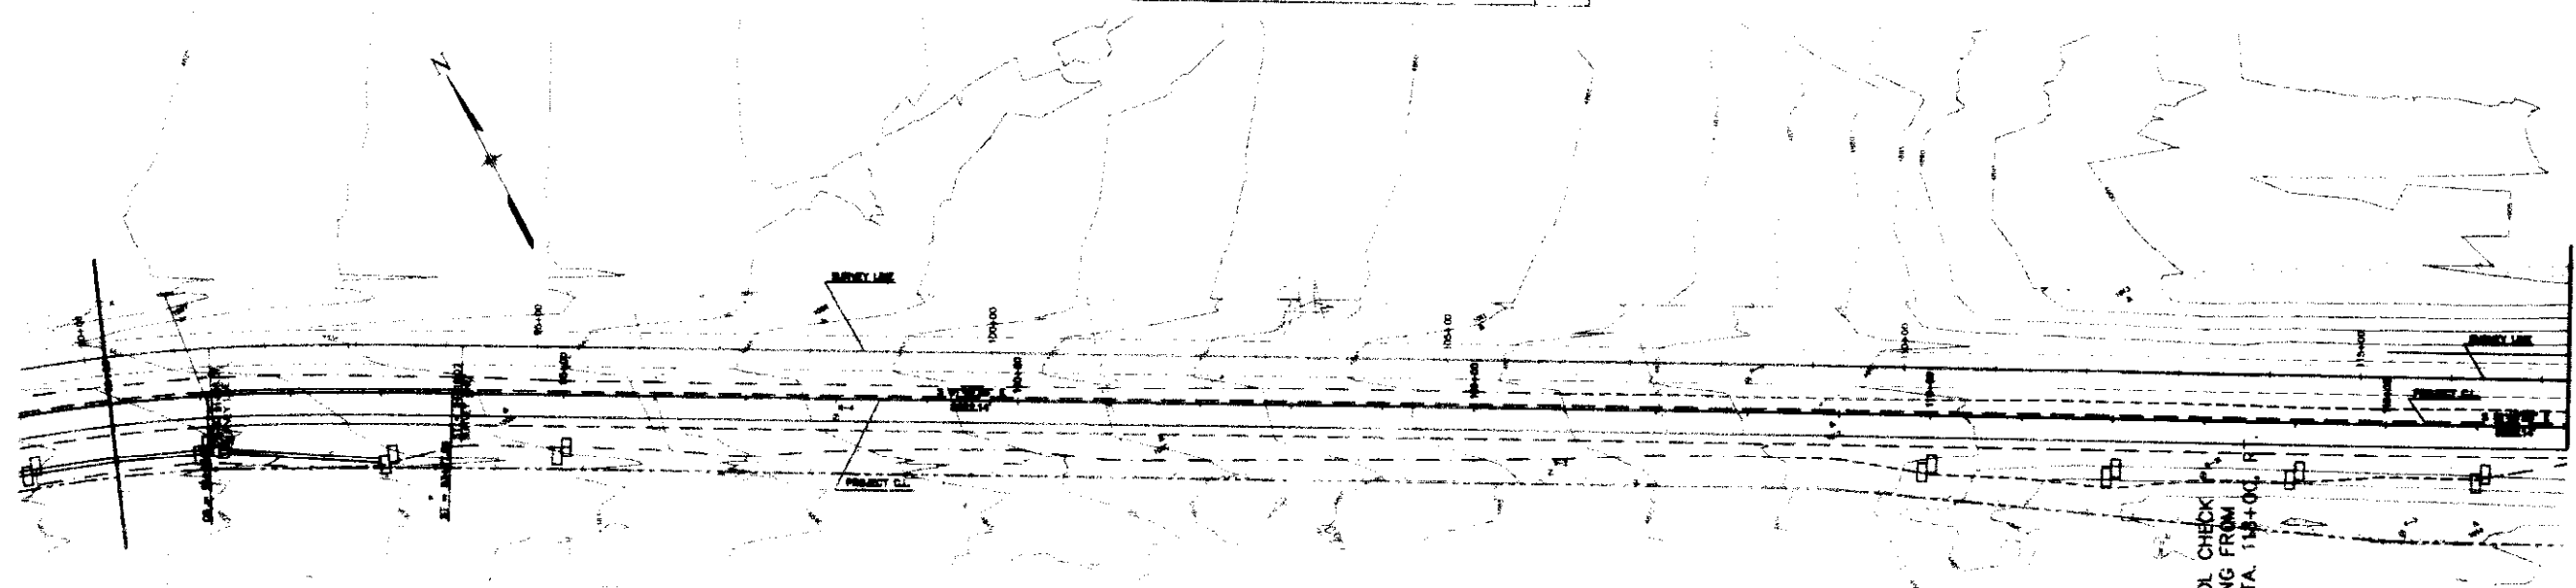

SCALE IN FEET
ORIGINAL SCALE

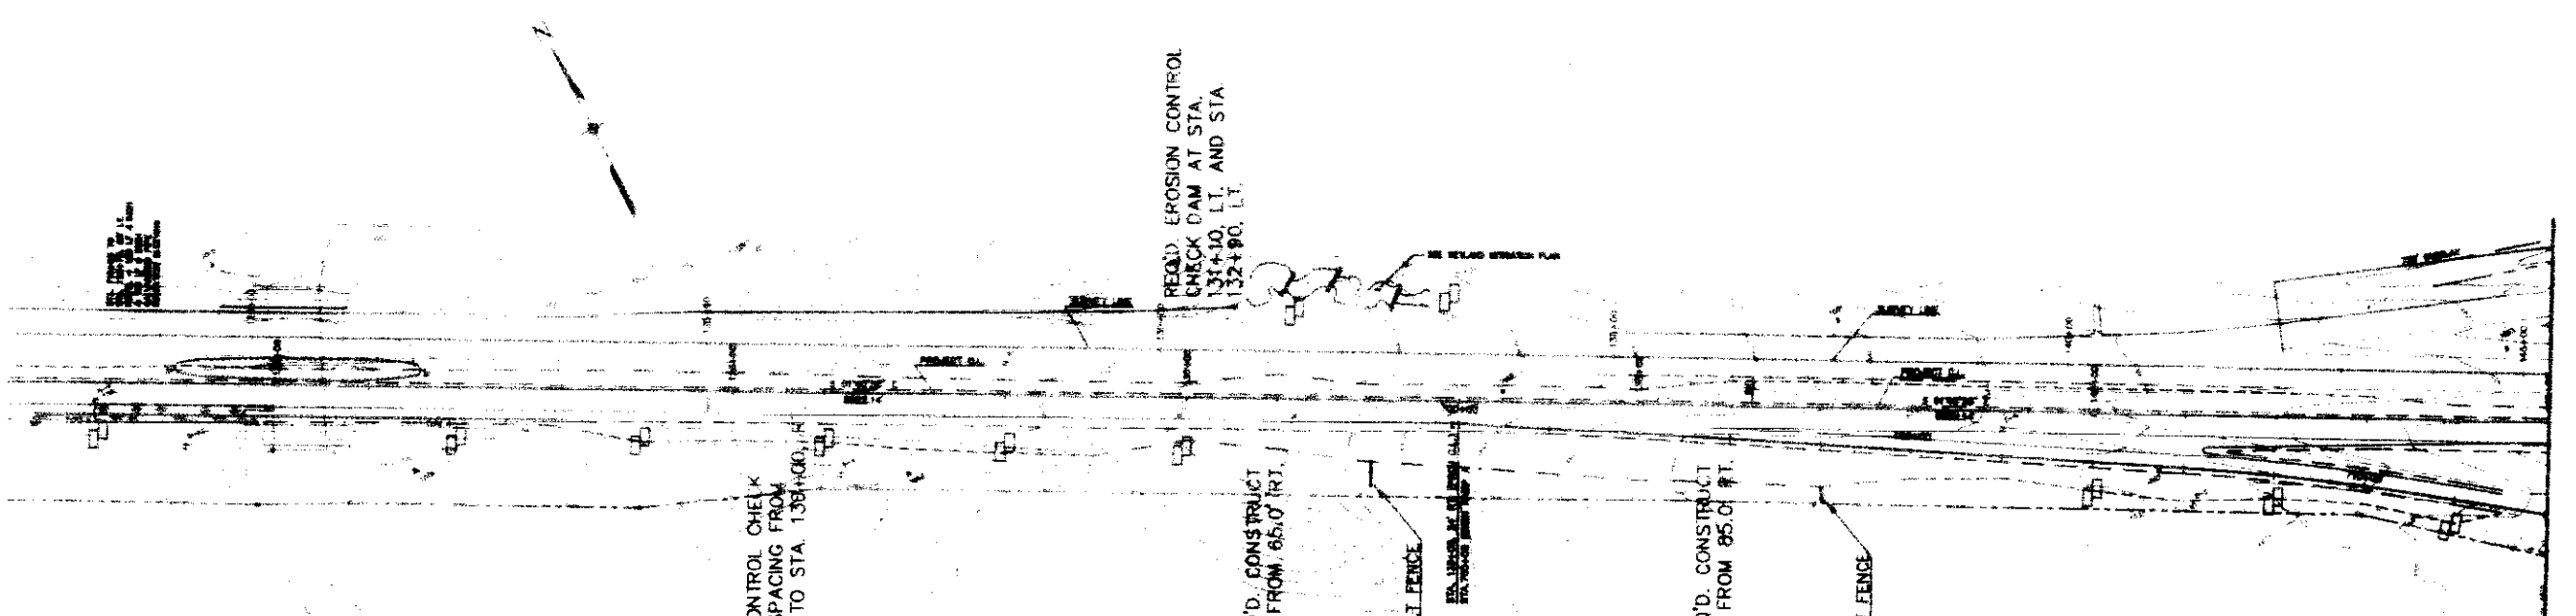

SCALE IN FEET
ORIGINAL SCALE

REQ'D. EROSION CONTROL CHECK DAM AT 200 FT. SPACING FROM STA. 122+00, RT. TO STA. 130+00, RT.

STA. 132+00 ~ REQ'D. CONSTRUCT 30 L.F. SILT FENCE FROM 65.0' RT. TO 95.0' RT.



STA. 137+00 ~ REQ'D. CONSTRUCT 20 L.F. SILT FENCE FROM 85.0' RT. TO 105' RT.

REQ'D. EROSION CONTROL CHECK DAM AT 200 FT. SPACING FROM STA. 707+00, RT. TO STA. 715+00, RT.

STORMWATER MANAGEMENT PLAN

DESIGNED BY	CHECKED BY
CHECKED BY	QUANTITIES BY
DETAILS BY	CHECKED BY

PROJECT NO.	DIVISION	PROJECTING	SHEET NO.	SHEET TOTALS
0471-020	0471-020	0471-020	74	

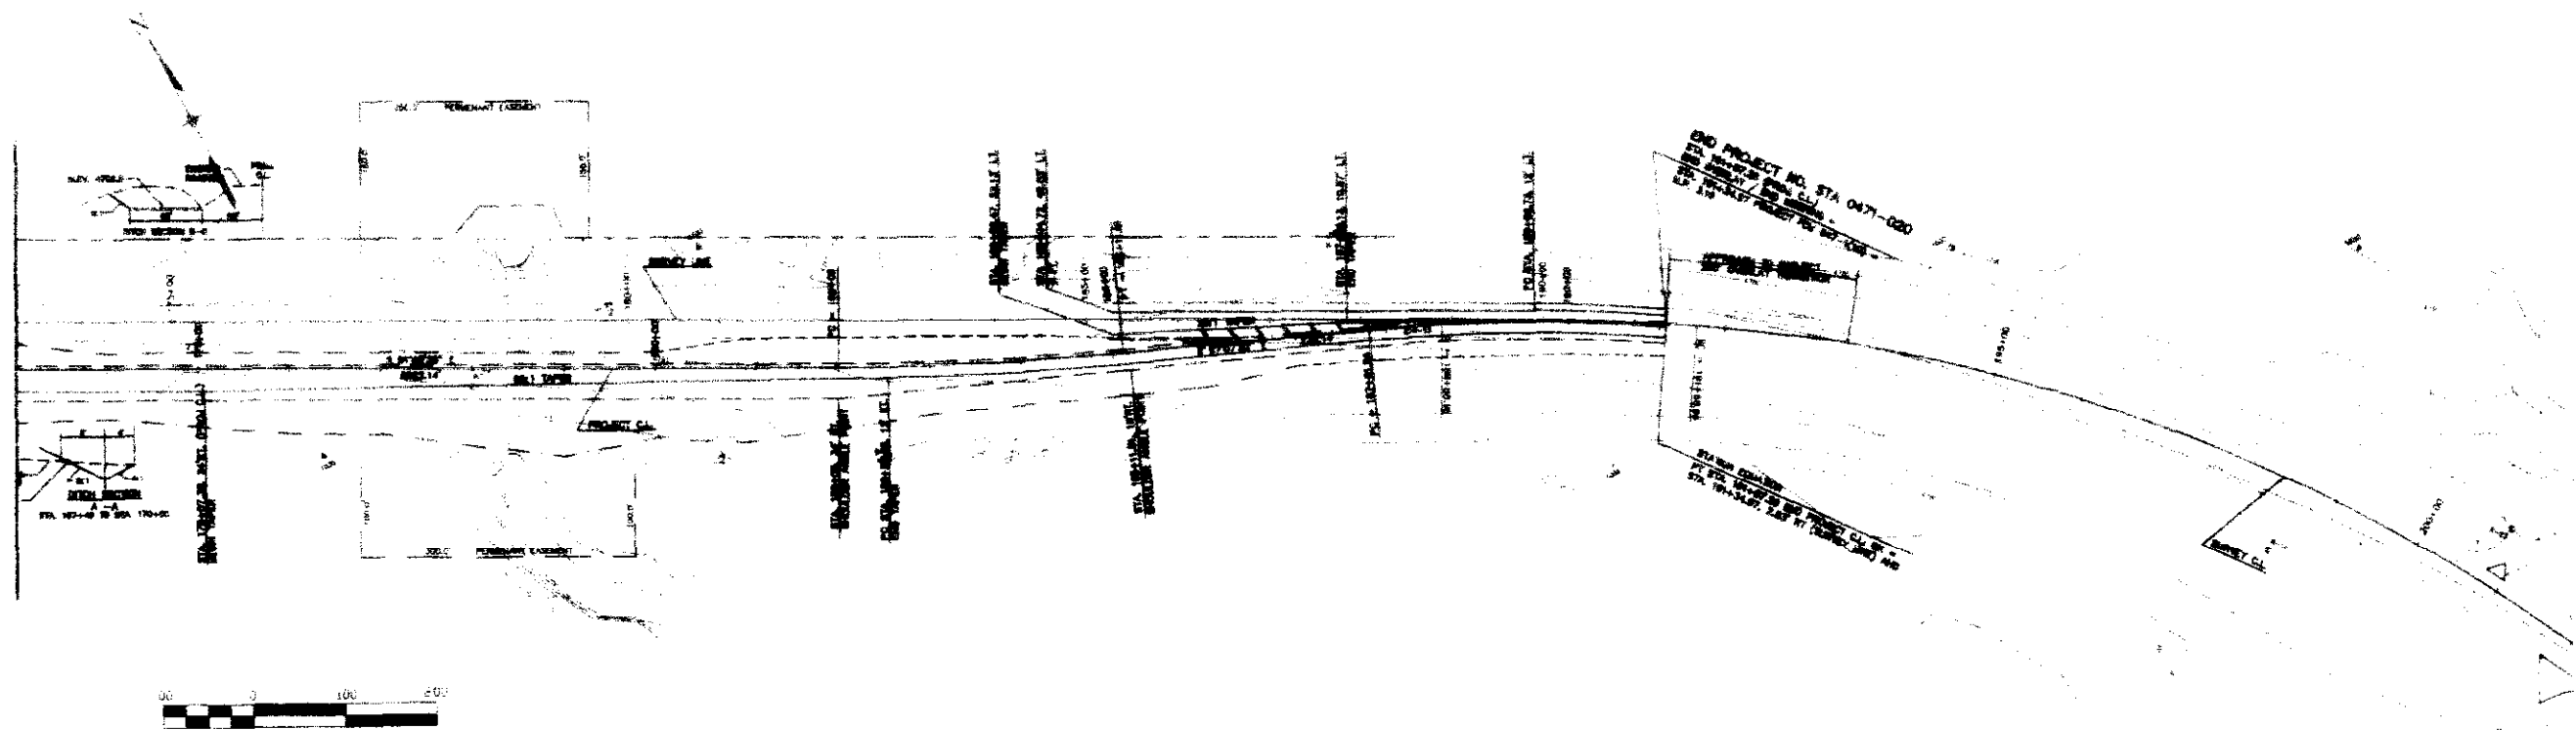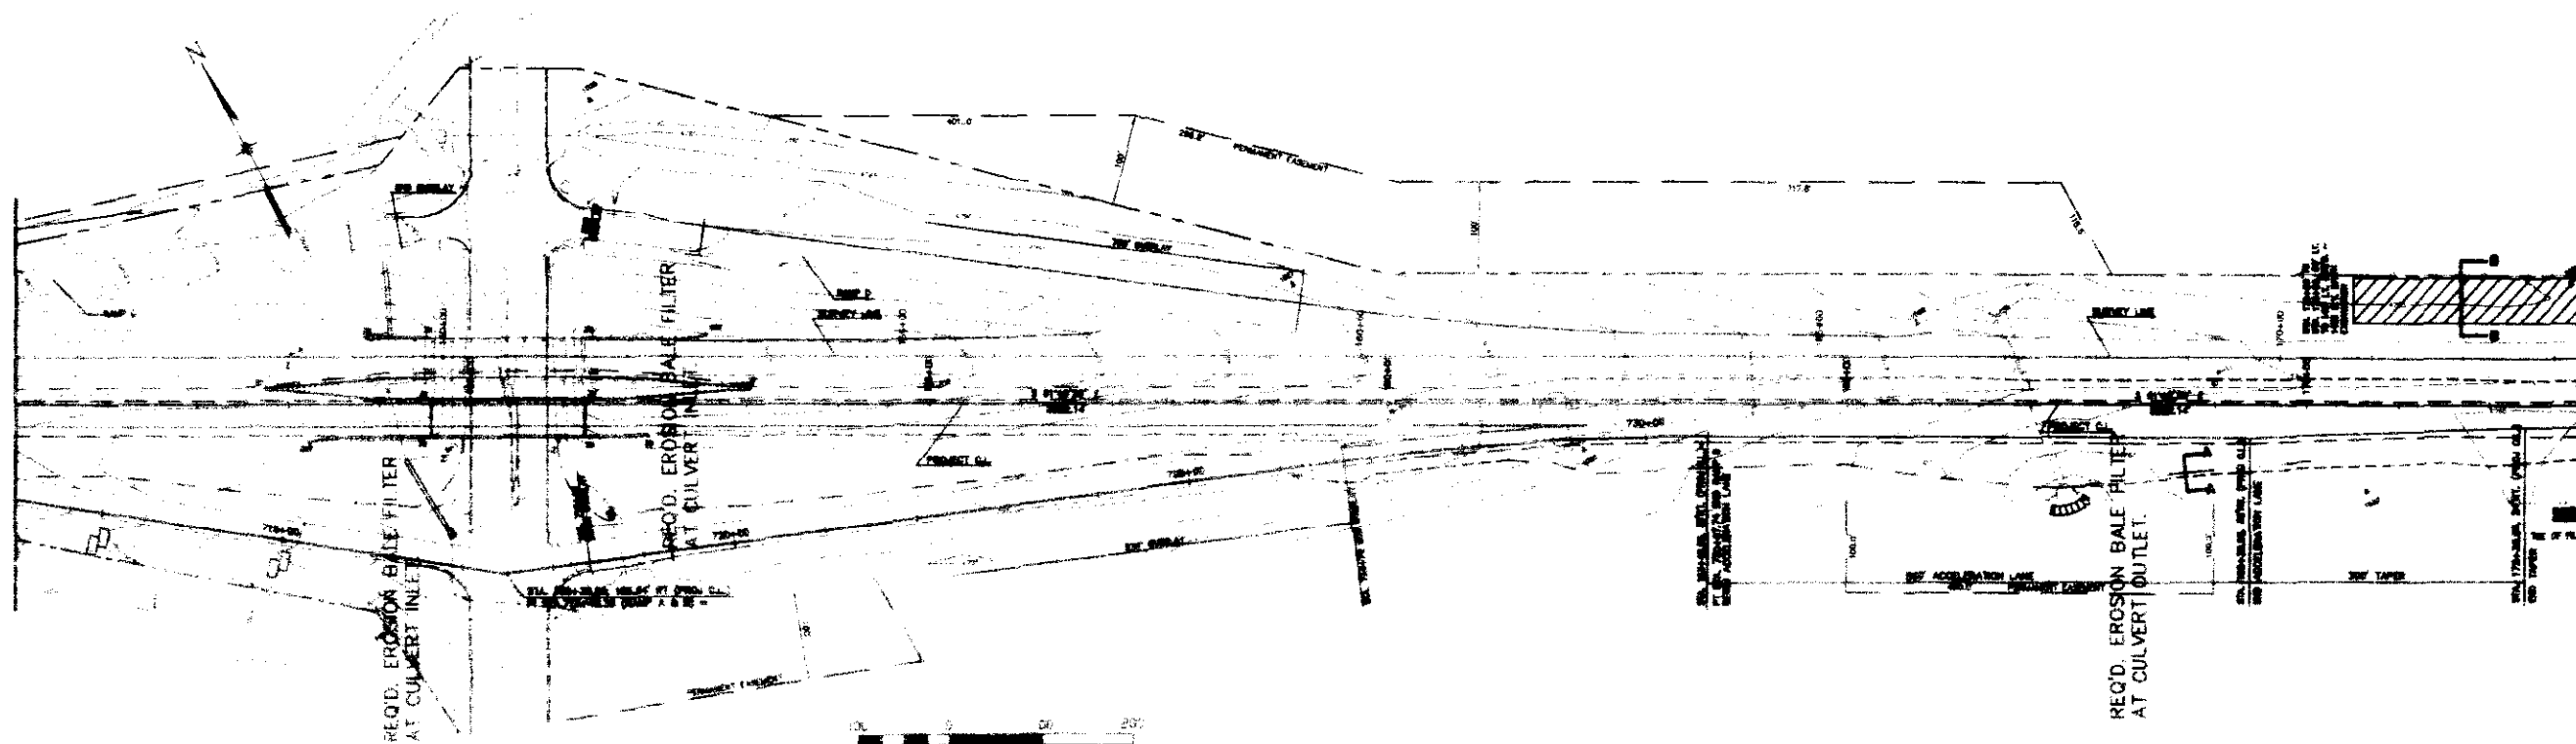

STORMWATER MANAGEMENT PLAN

TABULATION OF SIGNS

SIGN NO.	SIGN CODE	STATION	SIGN PANEL SIZE	BACK-GROUND COLOR	REMOVE GROUND SIGN (EACH)	RESET GROUND SIGN (EACH)	NO OF POSTS	RESET FLASHING BEACON (EACH)	LENGTH OF POST	POST TYPE (IN FT.)										U-2	CONC. FOOTING TYPE (EACH)			SIGN PANEL (SQ. FT.)																																																																																																																																																																																																																																																																																																																																																																																																																																																																																																																																																																																																																																																																																																																																																																																																																																																																																																																																																																																																																																																																																																																																																																																																																																																																																																							
										4 x 4 TIMBER	6 x 6 TIMBER	W6X12 BEAM	W6X15 BEAM	W8X15 BEAM	W8X21 BEAM	W10X22 BEAM	W10X27 BEAM	W12X30 BEAM	W12X42 BEAM		1	2	3	CLASS I	CLASS II	CLASS III																																																																																																																																																																																																																																																																																																																																																																																																																																																																																																																																																																																																																																																																																																																																																																																																																																																																																																																																																																																																																																																																																																																																																																																																																																																																																																					
1		68+35 RT				1																																																																																																																																																																																																																																																																																																																																																																																																																																																																																																																																																																																																																																																																																																																																																																																																																																																																																																																																																																																																																																																																																																																																																																																																																																																																																																																									


■ SURVEY LINE STATIONING

AS		REV: TED		FED. ROAD REGION	DIVISION	PROJ. NO.	SHEET NO.
NO. REVISIONS		REVISED		VOID		STA 0471-020	76

SUMMARY OF PAVEMENT MARKING QUANTITIES

COLOR	PAINT (GAL.)	THERMOPLASTIC (SQ. FT.)	PREFORMED THERMOPLASTIC (SQ. FT.) (WORD/SYMBOL)	PREFORMED PLASTIC (SQ. FT.) (X 60 MIL.) LANE/CENTER	STOP/X-WALK
YELLOW	X	8,105		2,090	
WHITE	X	10,915	126	4,625	180
TOTAL	✓	19,620	126	6,715	180

NOTE:
FOR DETAILS OF PAVEMENT MARKING LINES, SYMBOLS
AND PLACEMENT, SEE STANDARD NO. S-627-1
EXCEPT AS CALLED OUT ON THE PLANS


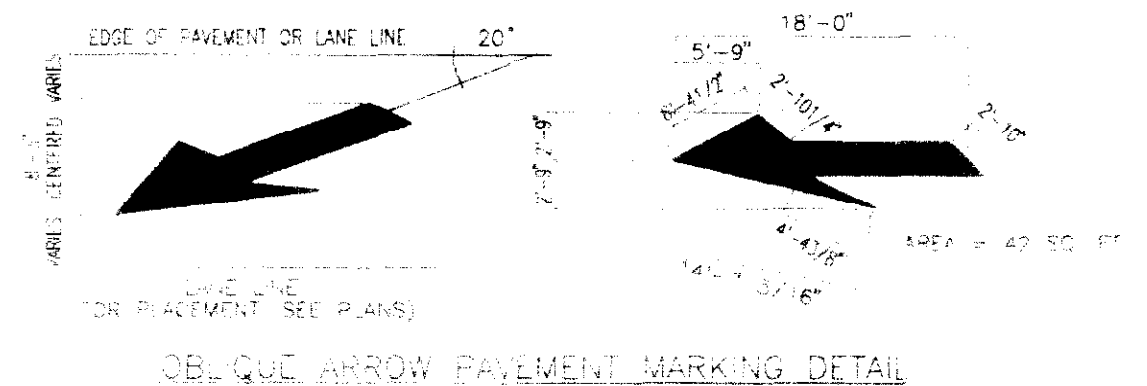


DESIGNED BY	CHECKED BY
CHECKED BY	QUANTITIES BY
DETAILS BY	CHECKED BY

DATE: 8-2-88

DRAWING NAME: R177A(CO)TRAPPE\177S1.DWG

NEW NAME:

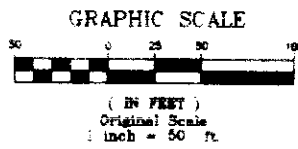
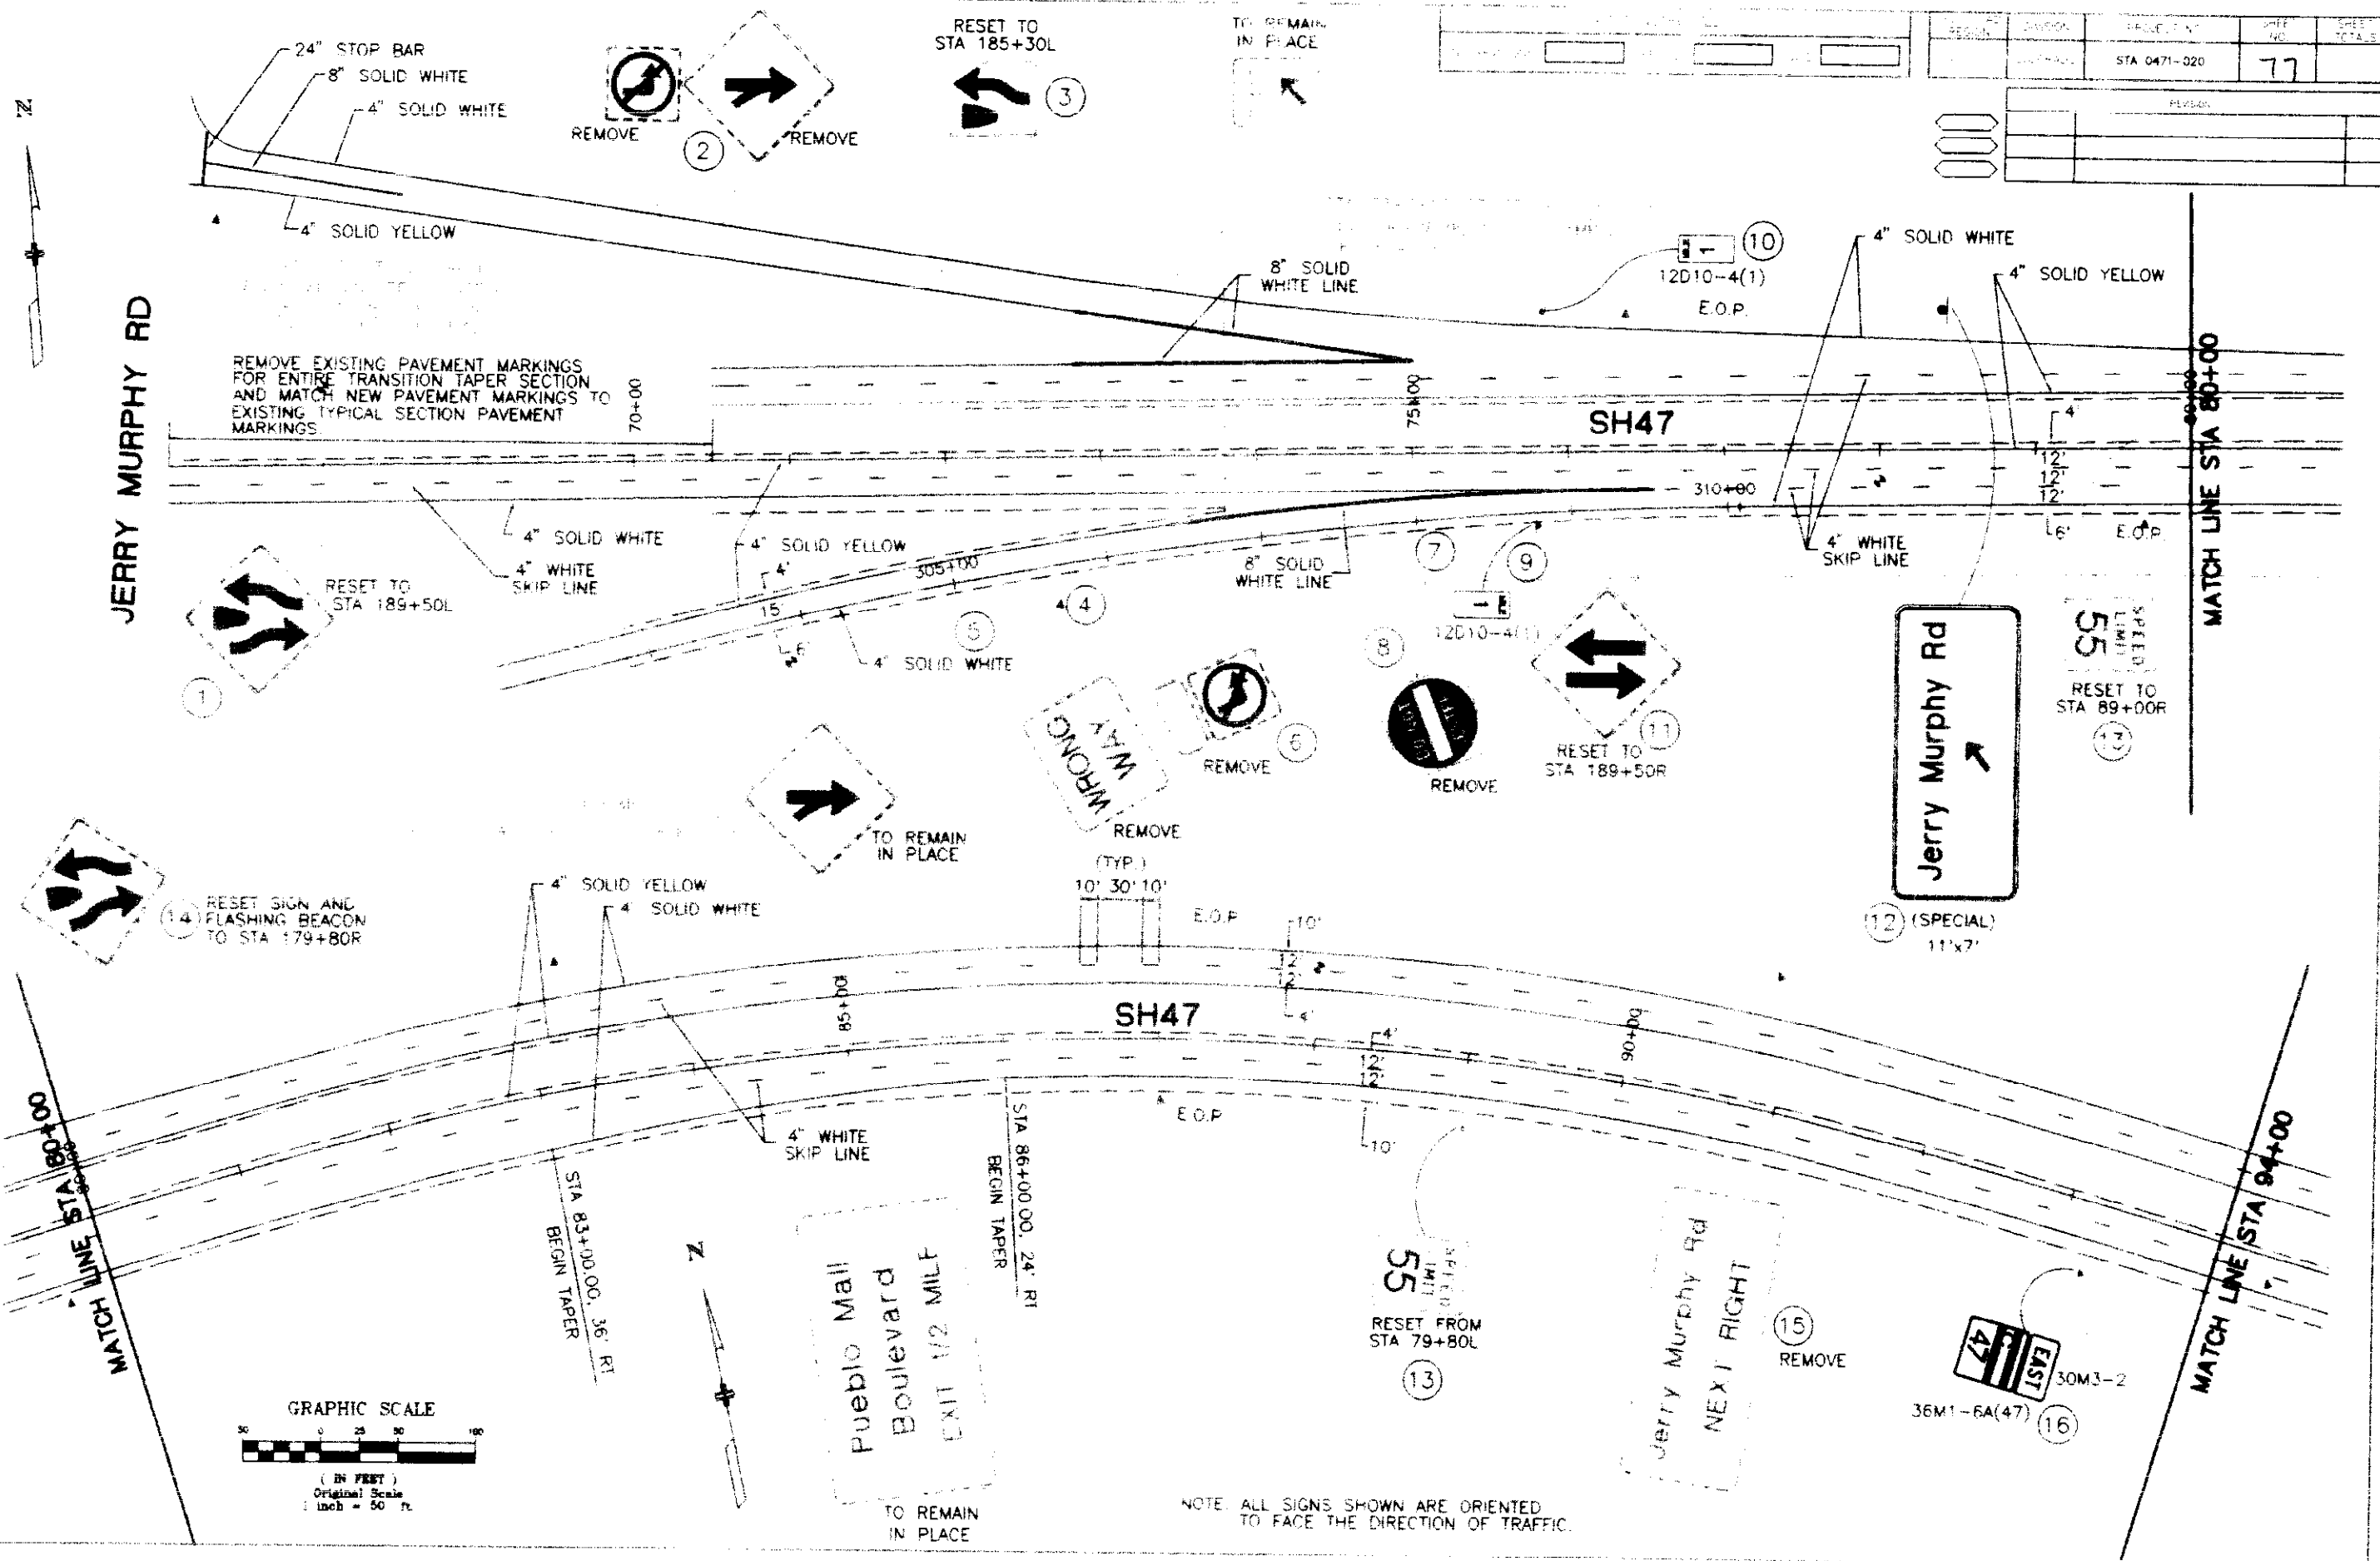


NOTE: ALL SIGNS SHOWN ARE ORIENTED TO FACE THE DIRECTION OF TRAFFIC.

PROJECT NO.	STA 0471-020	SHEET NO.	78	SHEET TOTALS
REVISIONS				

DESIGNED BY	CHECKED BY
CHECKED BY	QUANTITIES BY

DATE: 8-24-88
DRAWING NAME: R1718 CADD TRAFFIC/STRIPING

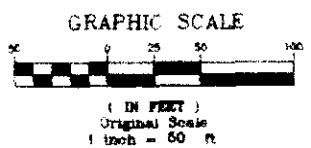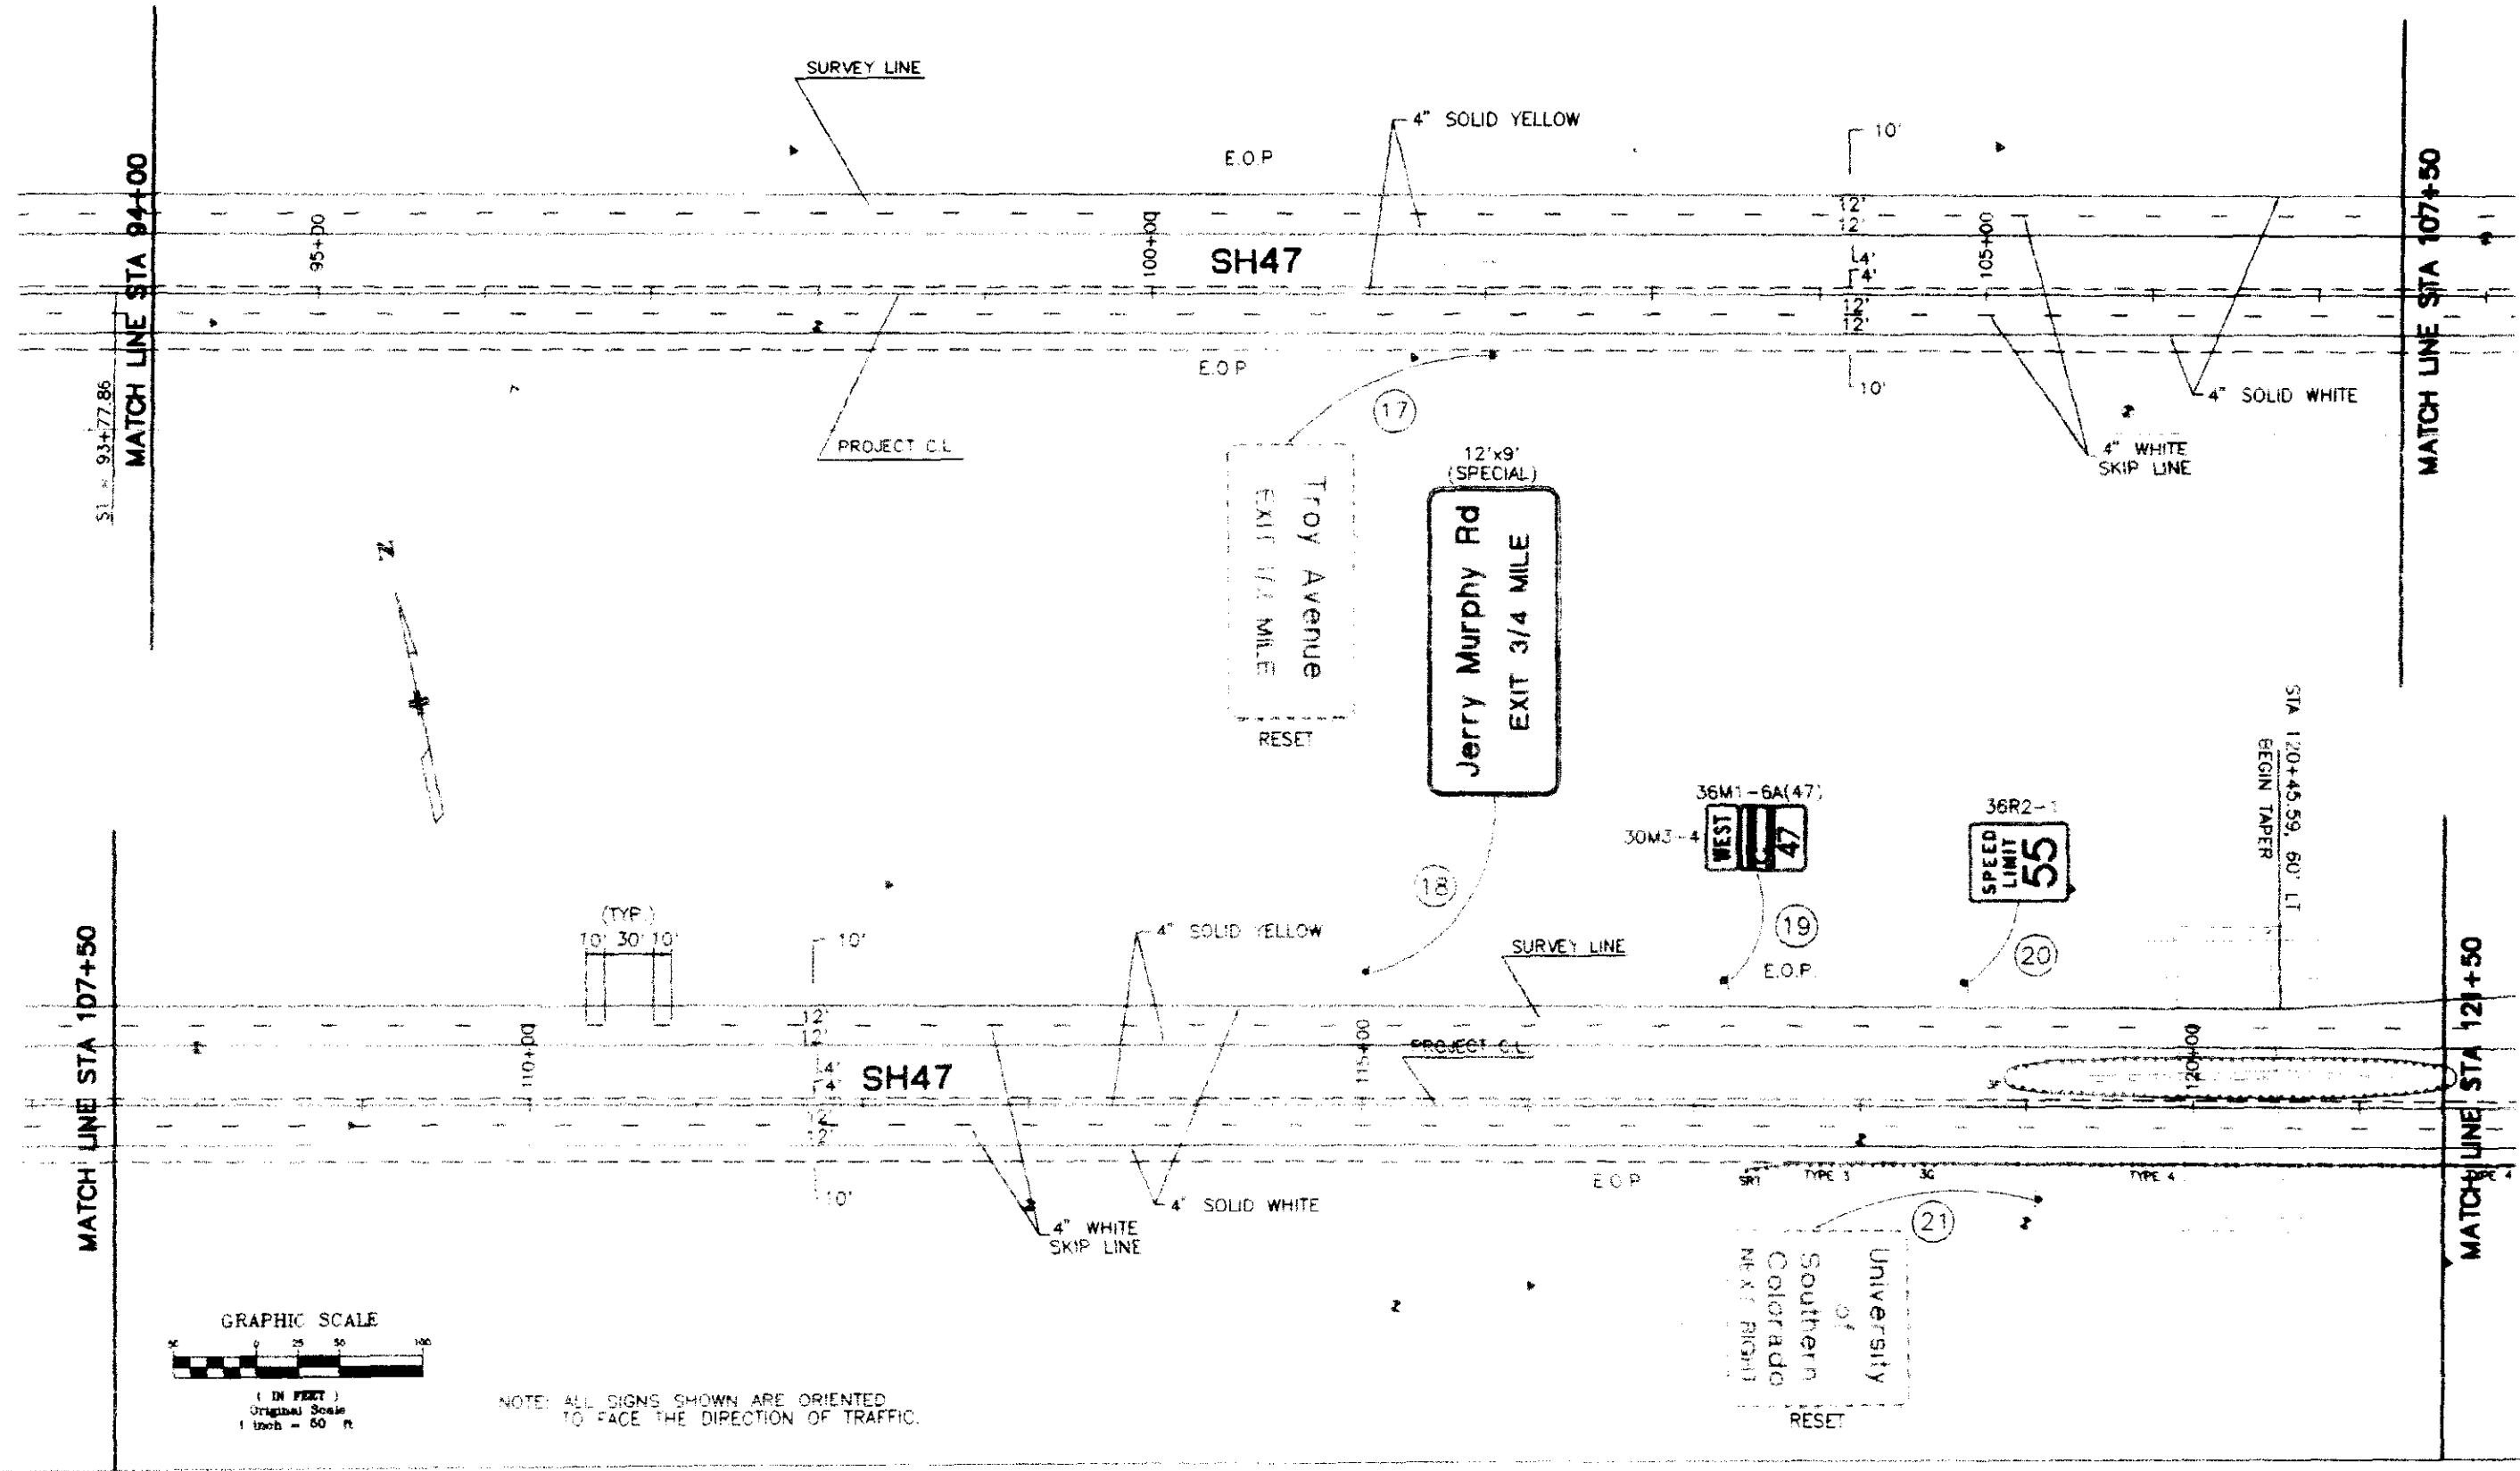

NOTE: ALL SIGNS SHOWN ARE ORIENTED TO FACE THE DIRECTION OF TRAFFIC.

NOTE: ALL SIGNS SHOWN ARE ORIENTED
TO FACE THE DIRECTION OF TRAFFIC

REGION	DIVISION	PROJECT NO.	SHEET NO.	SHEET TOTAL
		STA 0471-020	79	

DESIGNED BY	CHECKED BY	DATE
QUANTITIES BY	CHECKED BY	DATE


DRAWING NAME: RUTHERFORD TUNNEL PROJECT
DATE: 8-24-88
SHEET NO.: 79

MATCH LINE STA 121+50

MATCH LINE STA 135+00

MATCH LINE STA 148+00

MATCH LINE STA 135+00

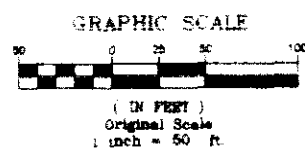

STA 123+45.59, 72' LT
END TAPER

6'
4" SOLID YELLOW
24'
12'
4"
12'
10'

4" SOLID WHITE

RESET

12D10-4(2)

REMOVE

30

Troy Avenue
11'x5' (SPECIAL)

REMOVE

31

32

TO REMAIN IN PLACE

TO REMAIN IN PLACE

4" SOLID WHITE

4" SOLID YELLOW

SH47

8" SOLID WHITE LINE

4" SOLID WHITE

4" SOLID YELLOW

4" SOLID WHITE

RESET

28

REMOVE

EXIT
(SPECIAL)
5'x4'

29

TO REMAIN IN PLACE

MATCH PAVEMENT MARKINGS TO
EXISTING PAVEMENT MARKINGS

TO REMAIN IN PLACE

WRONG WAY



715+00

SIGNING AND STRIPING

NOTE: ALL SIGNS SHOWN ARE ORIENTED TO FACE THE DIRECTION OF TRAFFIC

PROJECT NO.	SECTION	SHEET NO.	SHEET TOTALS
STA 0471-020		80	


REVISIONS

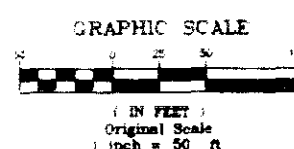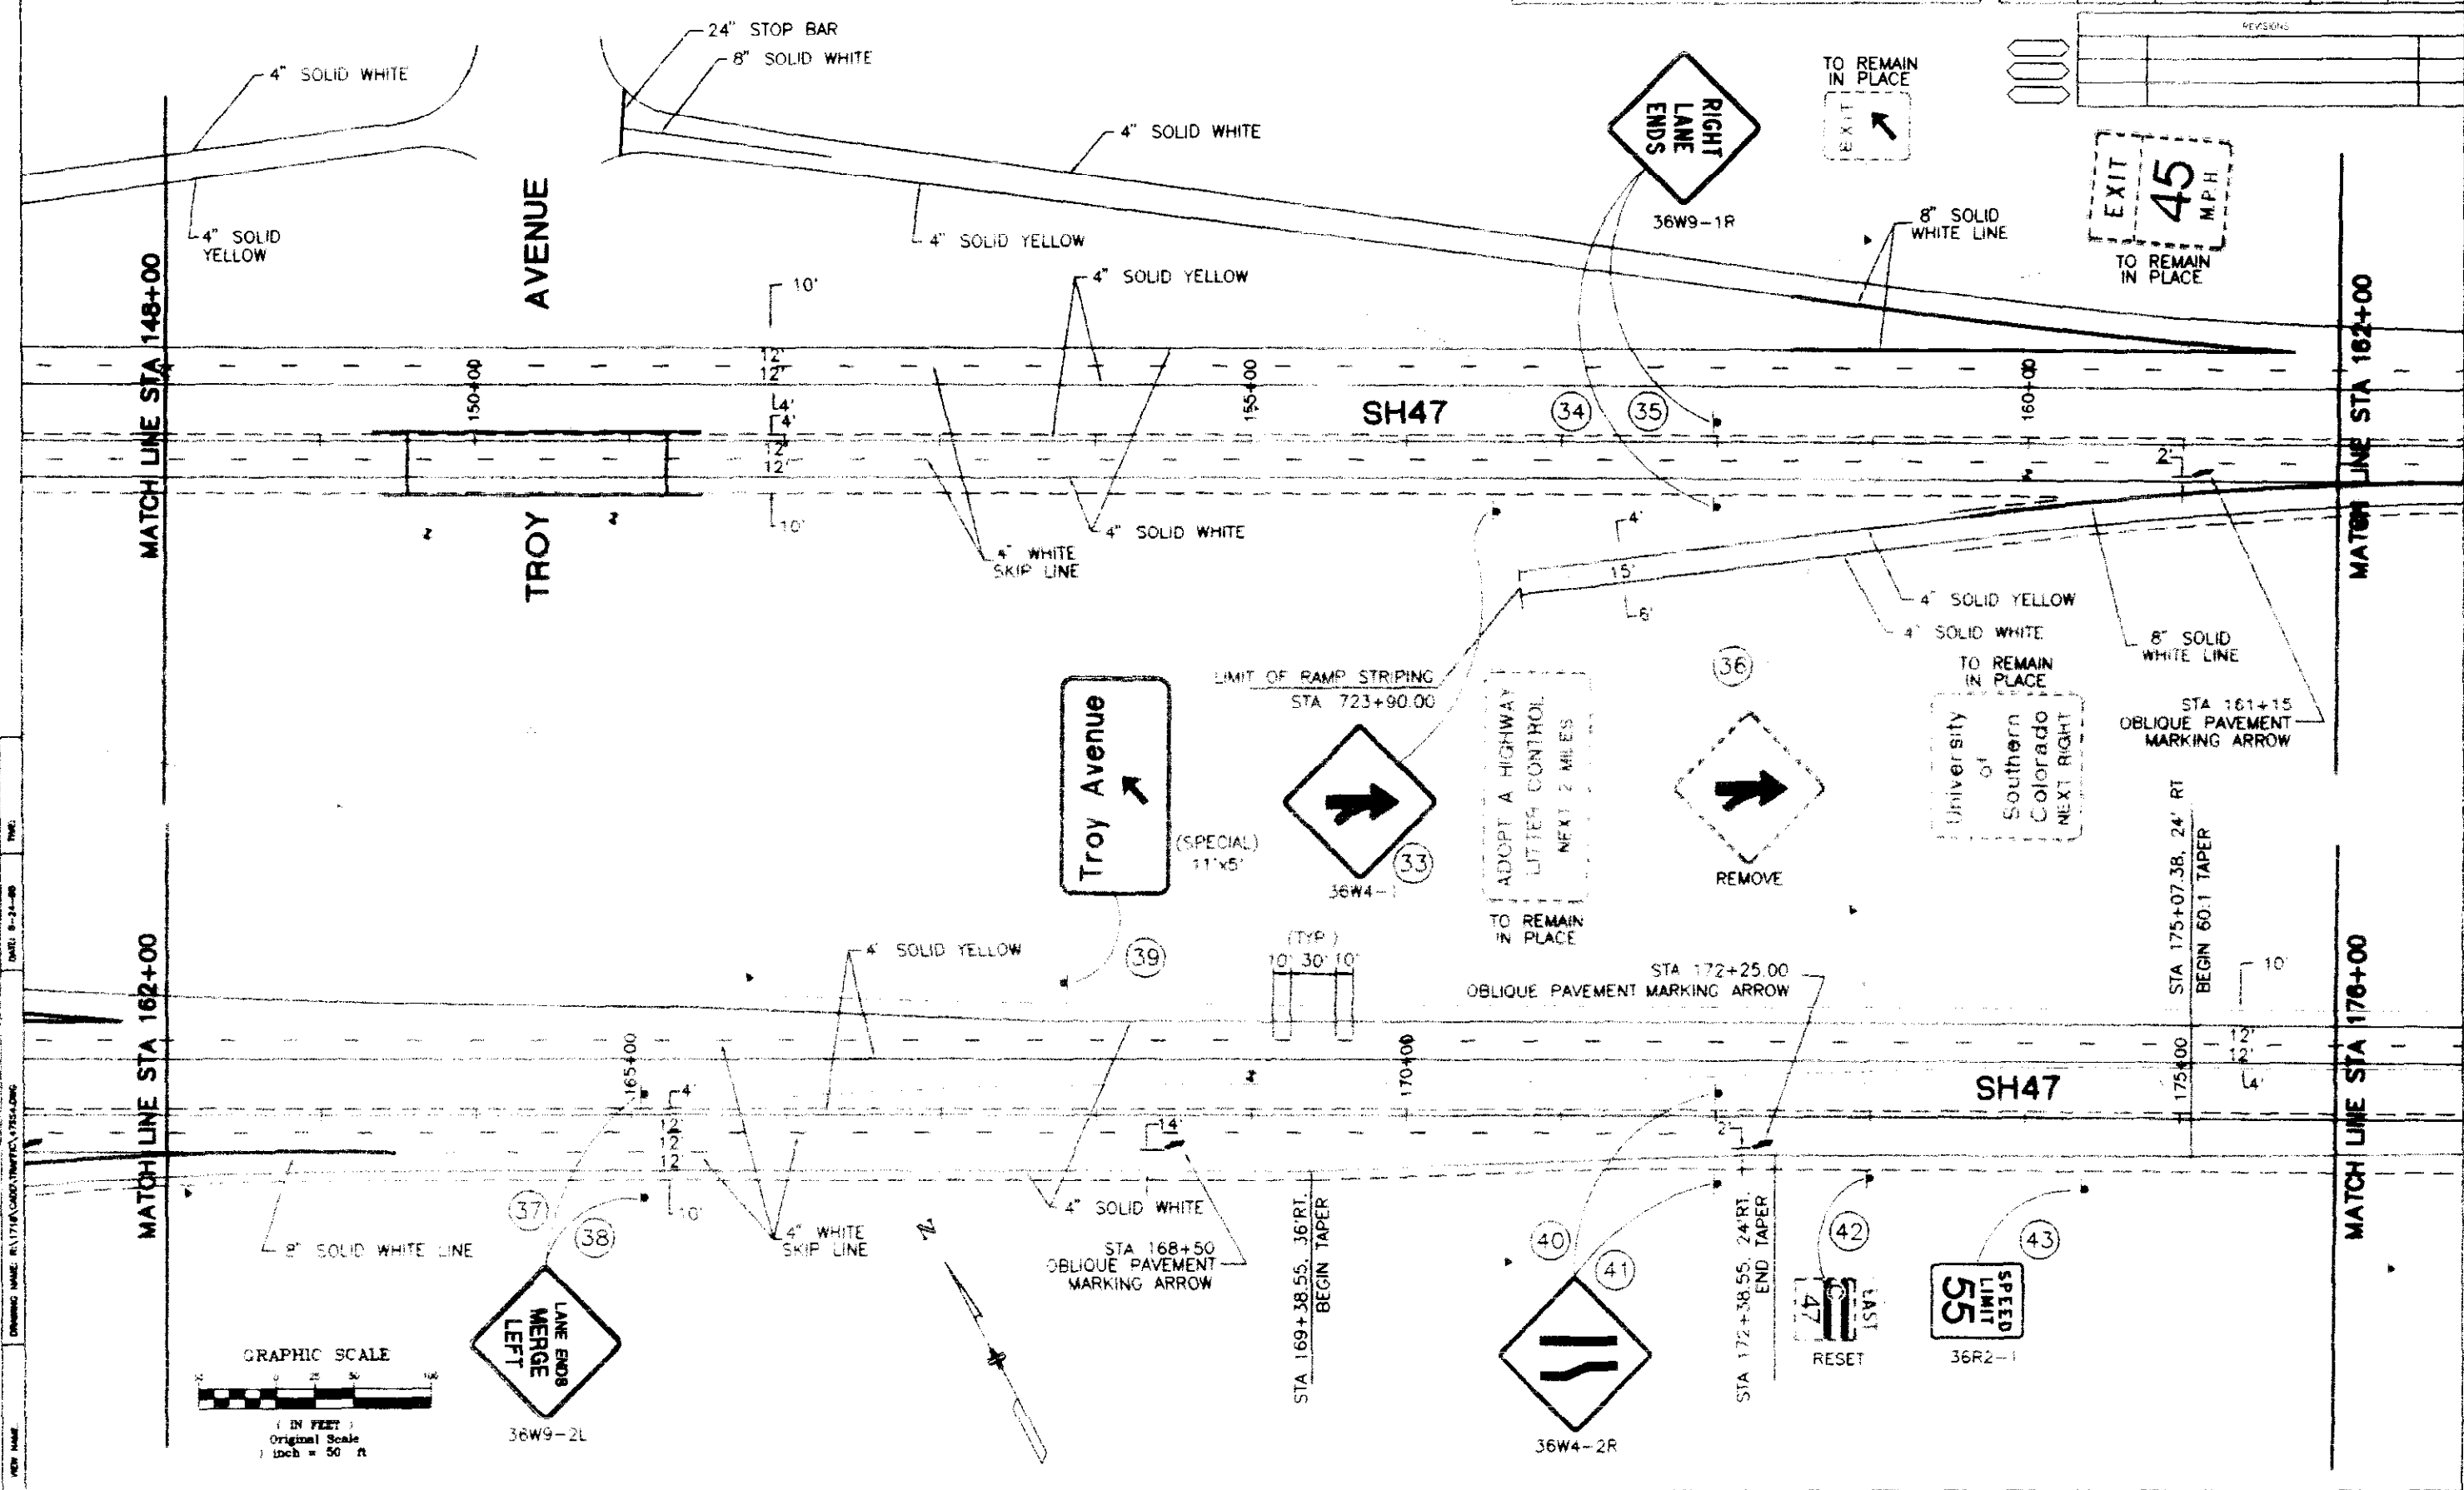

DESIGNED BY	CHECKED BY
CHECKED BY	QUANTITIES BY
CHECKED BY	CHECKED BY

DATE: 8-24-69
DRAWING NAME: R.1718/ADA TRAFFIC/7588.LWG
SHEET NO.: 81
SHEET TOTALS: 1

PROJECT NO.	SHEET NO.	SHEET TOTALS
STA 0471-020	81	1

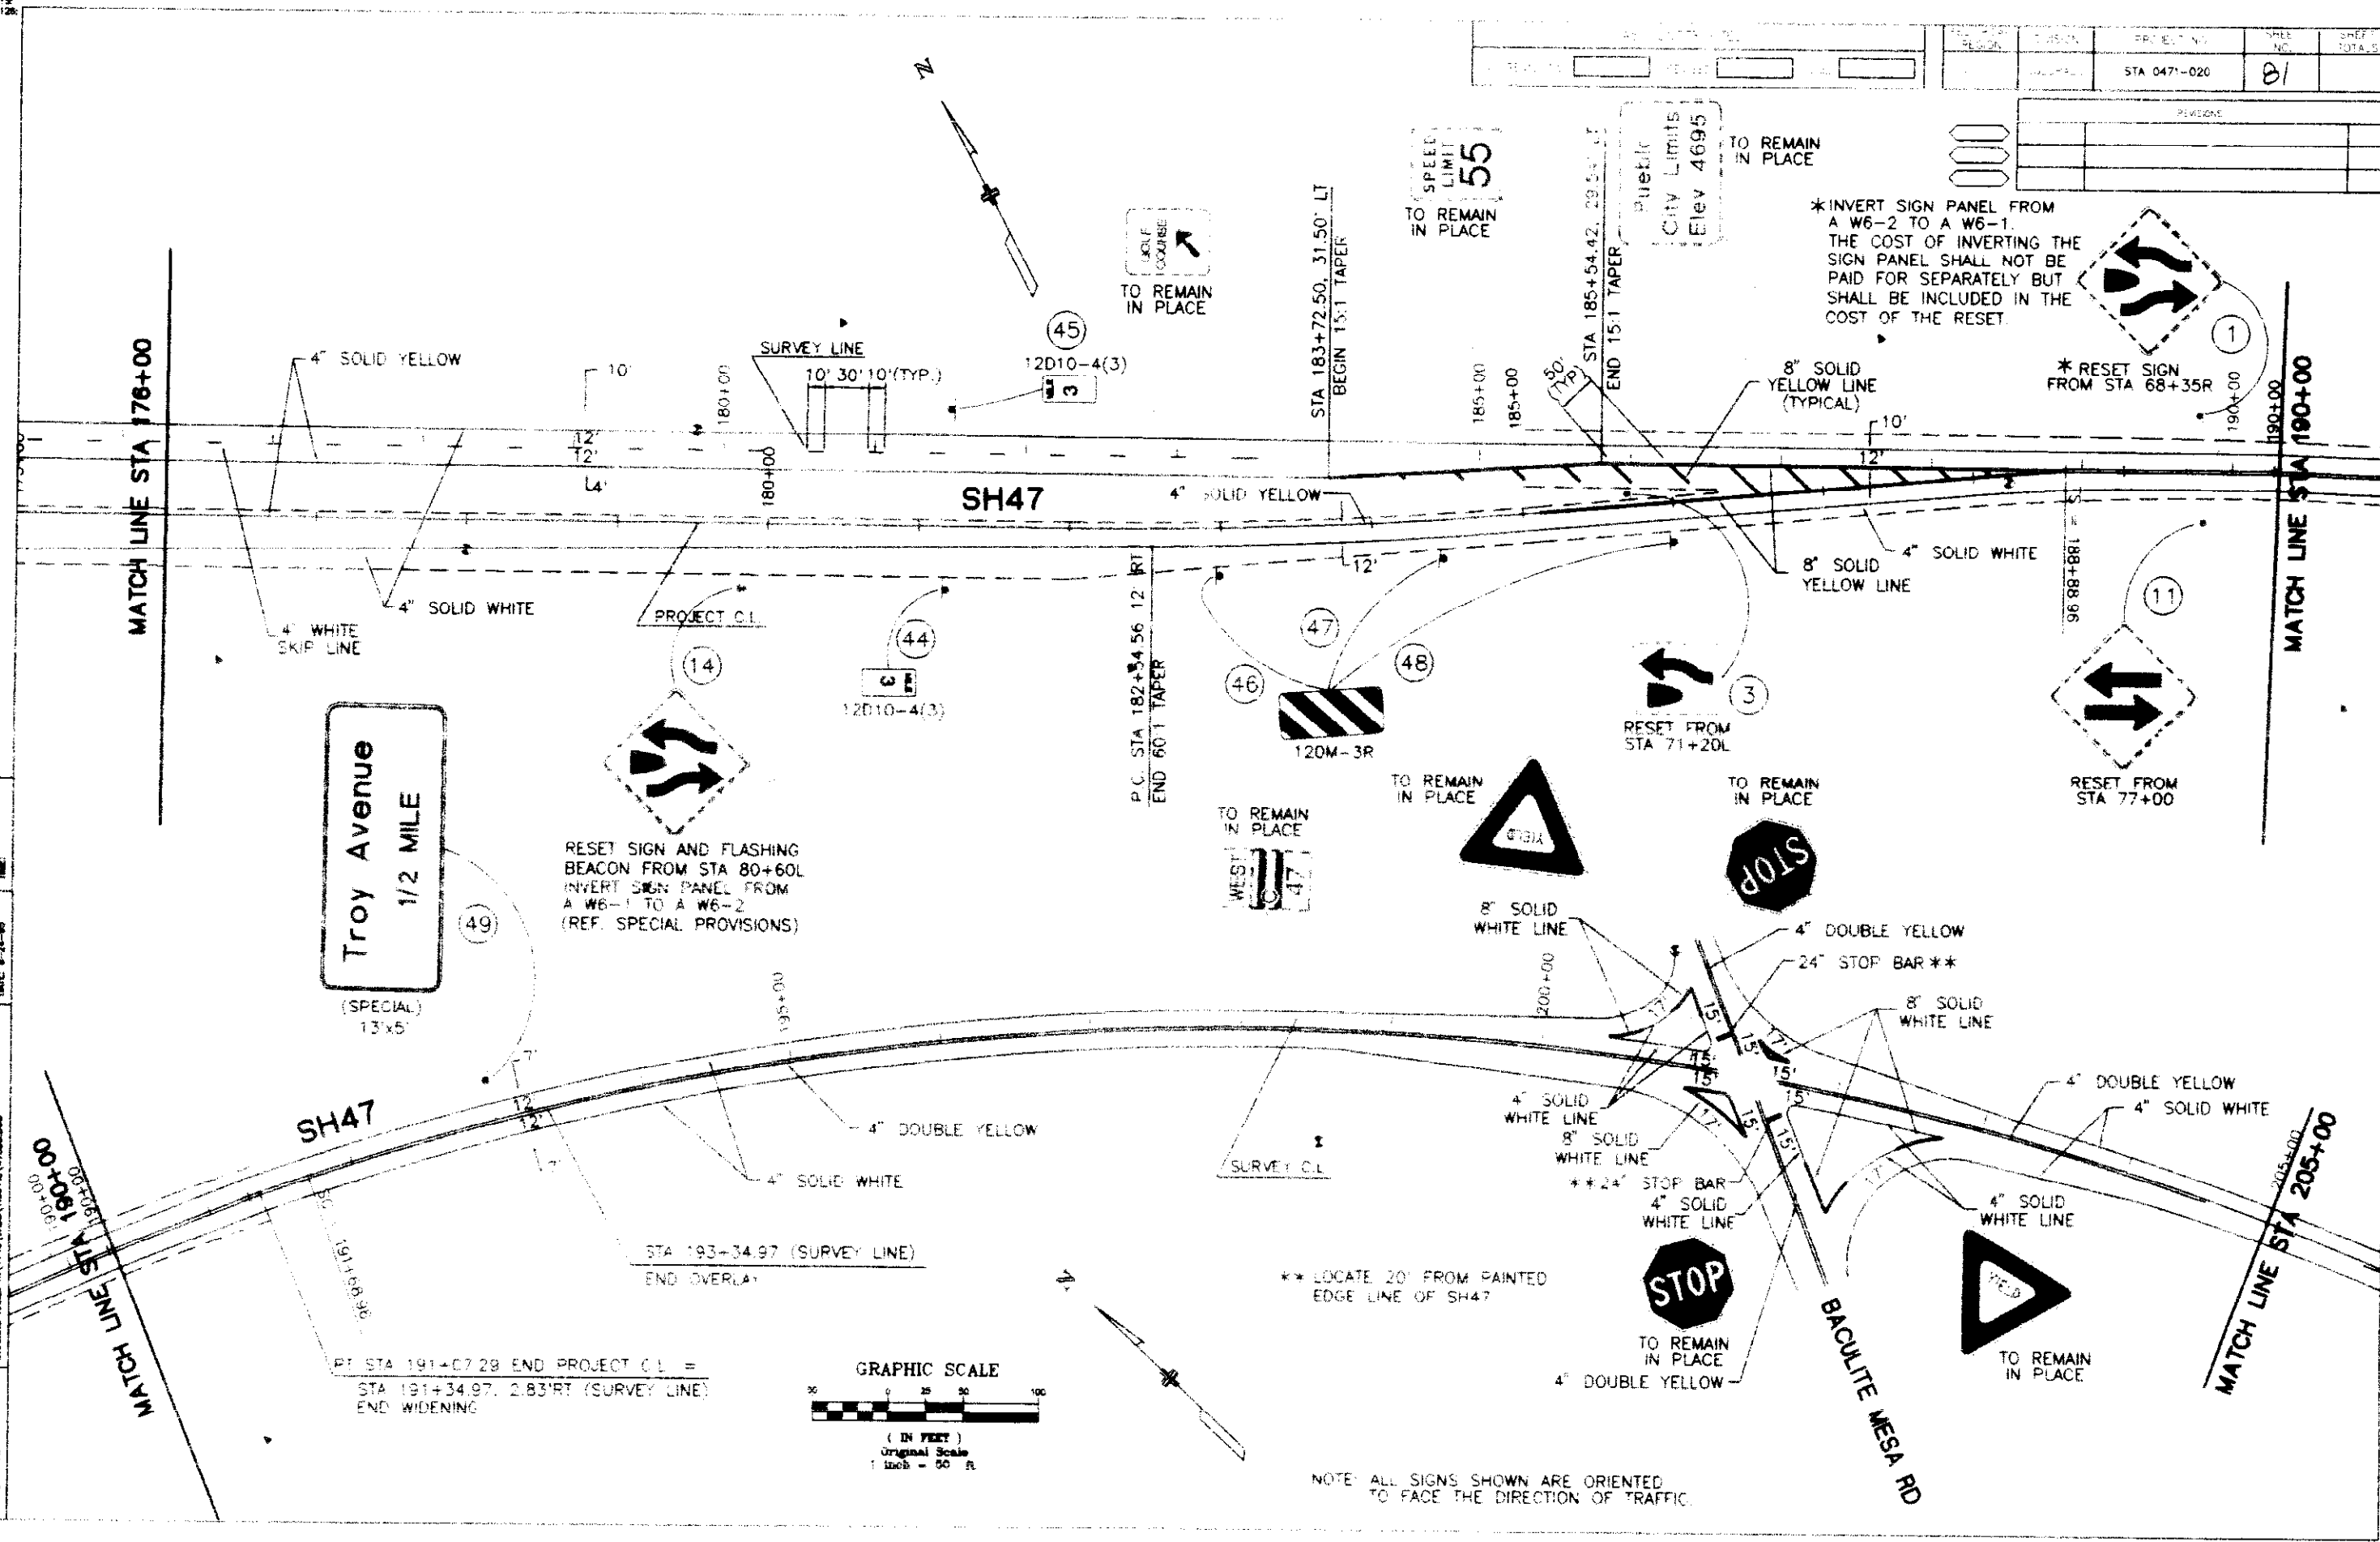

NOTE: ALL SIGNS SHOWN ARE ORIENTED
TO FACE THE DIRECTION OF TRAFFIC.


PROJECT NO.		SHEET NO.		SHEET TOTALS	
STA 0471-020		82			
REVISIONS					

DESIGNED BY	CHECKED BY	DATE	INITIAL
CHECKED BY	QUANTITIES BY	CHECKED BY	






DATE: 8-24-88

DRAWING NAME: R11718, CADA TRAFFIC, PMS&ING

VIEW NAME:

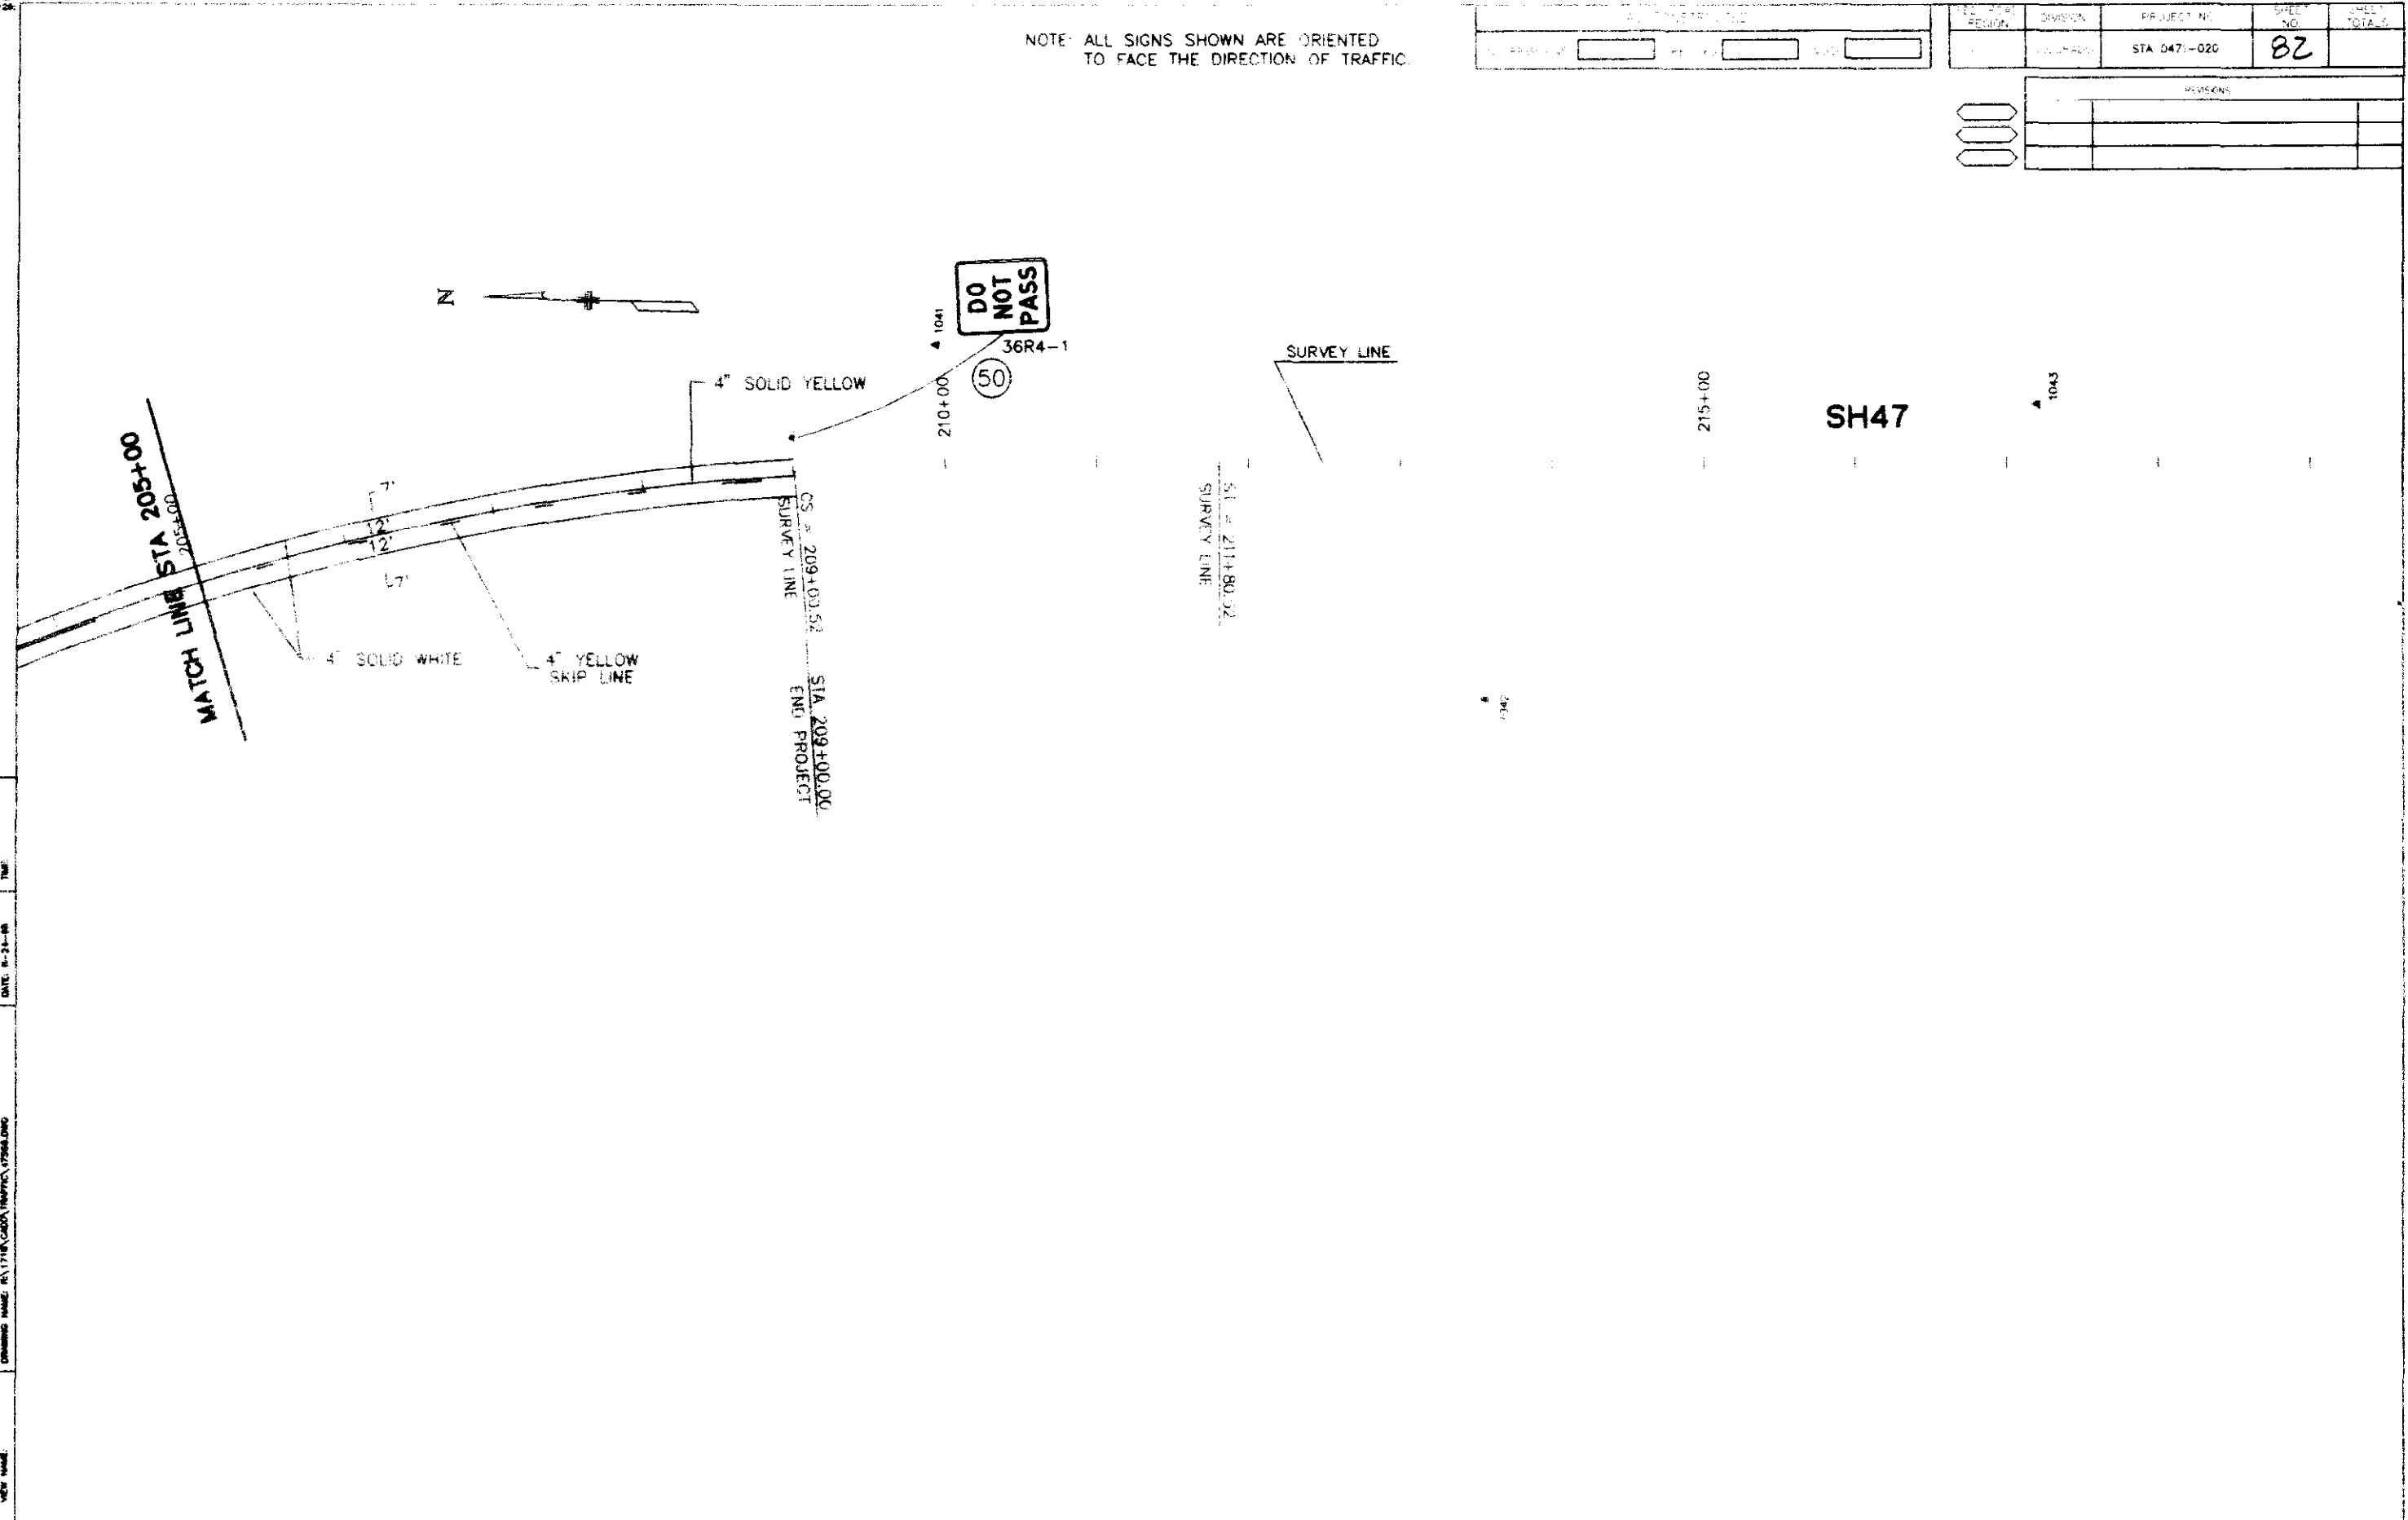

PROJECT NO.	SHEET NO.	SHEET TOTALS
STA 0471-020	83	
REMARKS		

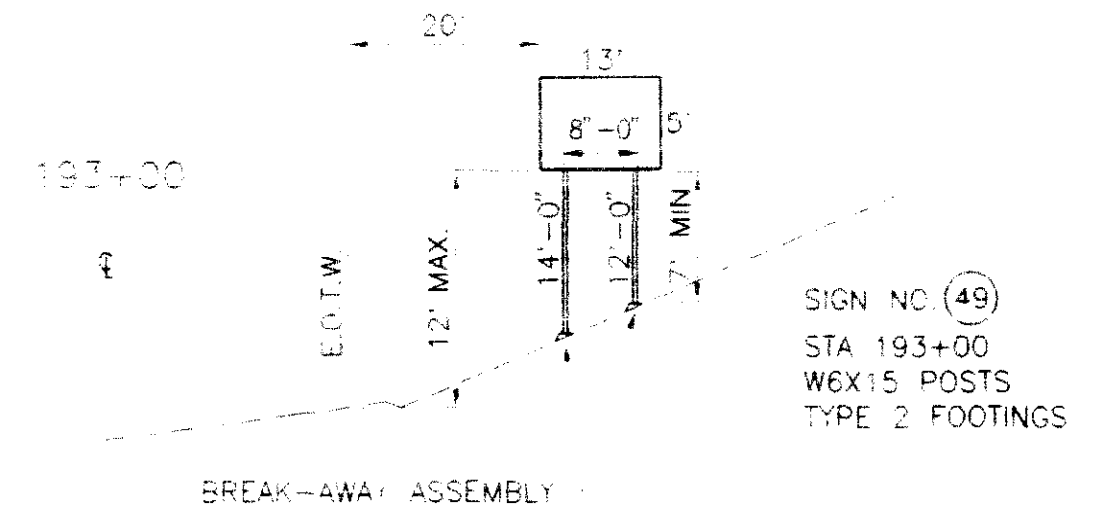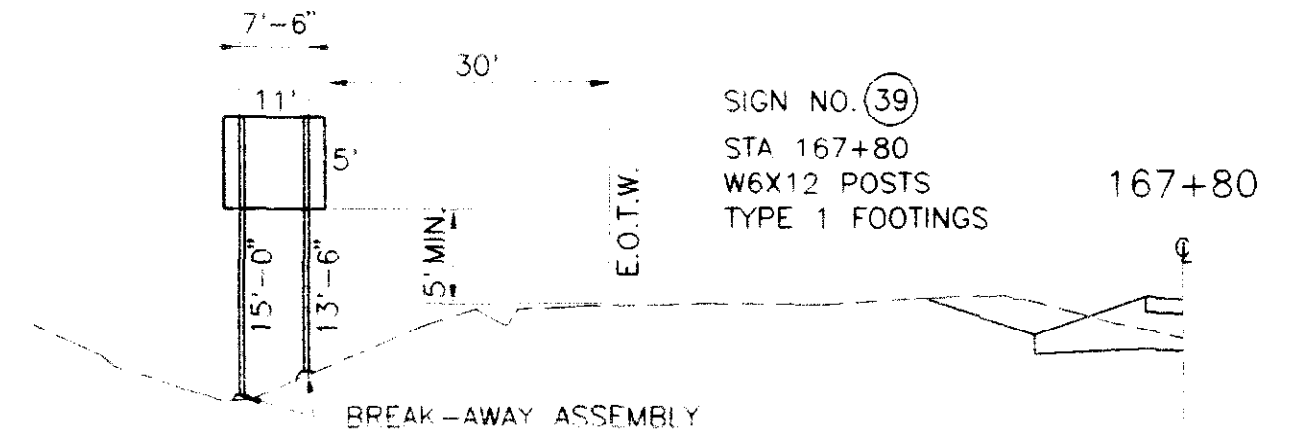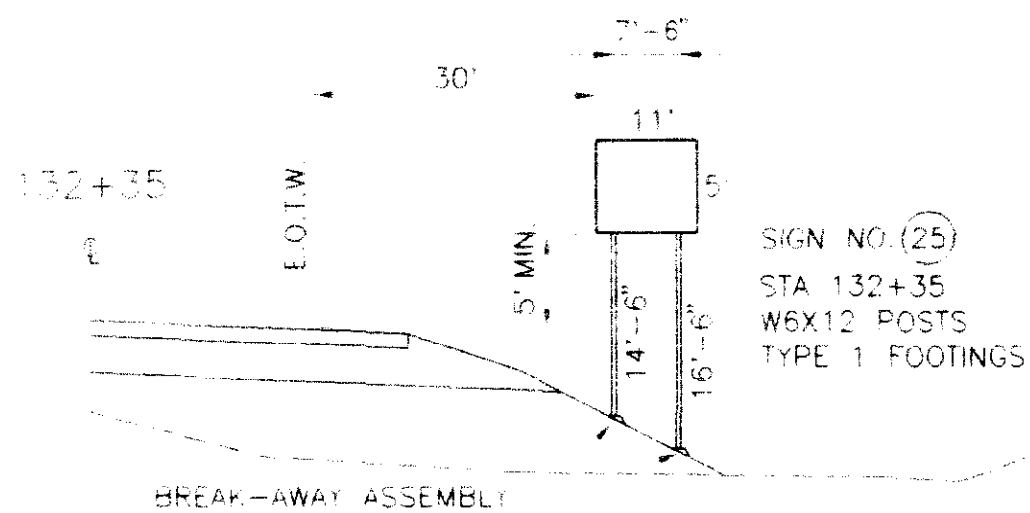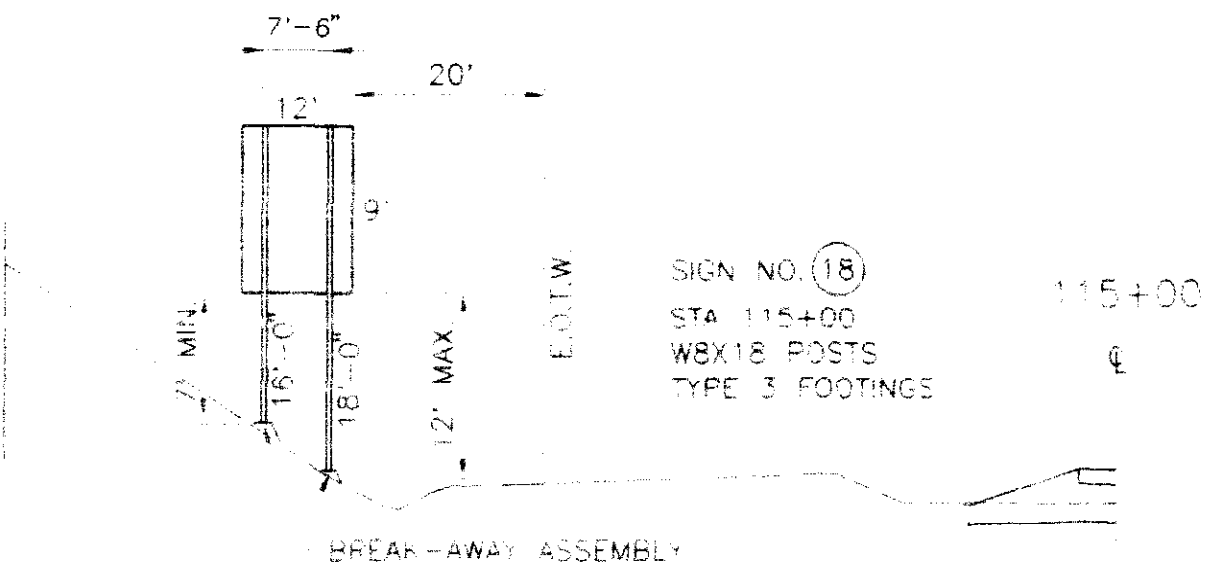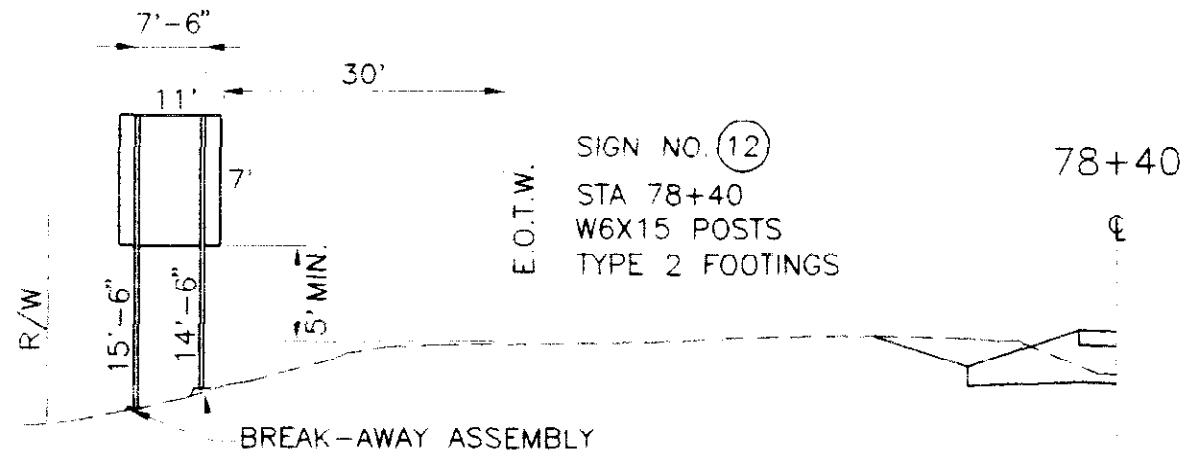

ORIGINAL SCALE
1"=10' HORIZONTAL
1"=5' VERTICAL

TABULATION OF TRAFFIC ENGINEERING ITEMS

ITEM NO.	DESCRIPTION	UNIT	QUANTITY
202	REMOVAL OF PAVEMENT MARKING	SQ. FT.	3000
202	REMOVAL GROUND SIGN	EA.	12
210	RESET GROUND SIGN	EA.	9
210	RESET FLASHING BEACON	EA.	1
612	DELINEATOR (FLEXIBLE)(TYPE I)	EA.	199
612	DELINEATOR (FLEXIBLE)(TYPE II)	EA.	100
612	DELINEATOR (FLEXIBLE)(TYPE III)	EA.	8
614	SIGN PANEL (CLASS I)	SQ. FT.	9
614	SIGN PANEL (CLASS II)	SQ. FT.	123
614	SIGN PANEL (CLASS III)	SQ. FT.	392
614	TIMBER SIGN POST (6x6)	LIN. FT.	220
614	STEEL SIGN POST (U-2)	LIN. FT.	84
614	STEEL SIGN POST (W 6X12)	LIN. FT.	60
614	STEEL SIGN POST (W 6X15)	LIN. FT.	56
614	STEEL SIGN POST (W 8X18)	LIN. FT.	34
614	CONCRETE FOOTING (TYPE 1)	EA.	4
614	CONCRETE FOOTING (TYPE 2)	EA.	4
614	CONCRETE FOOTING (TYPE 3)	EA.	2
627	PAVEMENT MARKING PAINT	GAL.	220
627	THERMOPLASTIC PAVEMENT MARKING	SQ. FT.	19,620
627	PREFORMED PLASTIC PAVEMENT MARKING (60 MILS)	SQ. FT.	6,715
627	PREFORMED PLASTIC PAVEMENT MARKING (60 MILS) (XWALK - STOP LINE)	SQ. FT.	180
627	PREFORMED THERMOPLASTIC PAVEMENT MARKING (WORD - SYMBOL)	SQ. FT.	126
630	FLAGGING	HOUR	4,000
630	TRAFFIC CONTROL SUPERVISOR	DAY	170
630	TRAFFIC CONTROL INSPECTION	DAY	100
630	BARRICADE (3M-B)(TEMP)	EA.	8
630	CONST TRAF SIGN (A)	EA.	29
630	CONST TRAF SIGN (B)	EA.	60
630	FLASHING ARROW PANEL (C TYPE)	EA.	2
630	DRUM CHANNELIZING DEVICE	EA.	300
630	CONCRETE BARRIER (TEMPORARY)	LIN. FT.	1,200
630	TRAFFIC CONE	EA.	200
630	IMPACT ATTENUATOR (SAND FILLED PLASTIC BARREL)(TEMPORARY)	EA.	2

SCHEDULE OF CONSTRUCTION TRAFFIC SIGNS

Symbol	Description	Size	Quantity
48G20-10	THANK YOU	48"x48"	4
48M4-10()	DETOUR ARROW	48"x18"	2
48R1-2	YIELD	36"x36"x36"	2
36R2-1()	SPEED/LIMIT/XX	36"x48"	9
36R4-1	DO/NOT/PASS	36"x48"	4
24R4-7()	KEEP RIGHT SYMBOL	24"x36"	2
36R5-1	DO NOT ENTER	36"x36"	6
36R5-9	WRONG/WAY	36"x24"	6
48R11-2	ROAD /CLOSED	48"x30"	4
48W1-4()	REVERSE CURVE ARROW	48"x48"	3
48W3-2a	YIELD AHEAD SYMBOL	48"x48"	2
48W4-1()	MERGE SYMBOL	48"x48"	3
48W4-2	LANE TRANSITION SYMBOL	48"x48"	4
48W6-3	TWO-WAY TRAFFIC SYMBOL	48"x48"	2
18W8-1	CHEVRON SYMBOL	18"x24"	6
30W12-1	DOUBLE ARROW SYMBOL	30"x30"	1
48W12-2	LOW CLEARANCE SYMBOL (14'-6")	48"x48"	4
24W13-1	XX MPH	24"x24"	4
48W13-2	EXIT/XX MPH	48"x60"	1
48W20-1	ROAD WORK AHEAD/DISTANCE	48"x48"	8
48W20-4	ONE LANE /ROAD/DISTANCE	48"x48"	2
48W20-5	()LANE/CLOSED/DISTANCE	48"x48"	4
48W20-7a	FLAGGER SYMBOL	48"x48"	6

* CONSTRUCT FROM DIAMOND GRADE SHEETING.

TABULATION OF DELINEATORS

[illegible]

TABULATION OF TRAFFIC ENGINEERING ITEMS

PHASE 1

PHASE 1 WORK SHALL INCLUDE CONSTRUCTING THE PORTIONS OF EASTBOUND SH47 WHICH ARE CLEAR OF THE EXISTING SH47 TRAVELED WAY. EXISTING TRAFFIC FLOW SHALL BE MAINTAINED ON THE EXISTING SH47 ROADWAY INCLUDING RAMP JUNCTIONS AT JERRY MURPHY AND TROY AVENUE.

PHASE 1a SHALL INCLUDE ALL ROADWAY CONSTRUCTION ITEMS, WITH THE EXCEPTION OF THE FINAL LIFT OF ASPHALT, AND FOUNDATION CONSTRUCTION FOR THE TROY AVENUE BRIDGE. CONSTRUCTION TRAFFIC CONTROL (NOT SHOWN) SHALL INCLUDE W20-1 SIGNS ("ROAD WORK / 1500 FT / AHEAD") AND G20-10 SIGNS ("THANK YOU") AT EACH END OF THE WORK ZONE AND AT RAMP JUNCTIONS. WORK WITHIN 30 FEET OF THE TRAVELED WAY SHALL BE DELINEATED WITH CHANNELIZING DEVICES SPACED AT 50 FT INTERVALS ALONG THE SOUTH SIDE OF THE EXISTING SH47 PAVEMENT EDGE. WHEN DIRECTED BY THE ENGINEER, THE CONTRACTOR SHALL PLACE **TEMPORARY CONCRETE BARRIER** (SEE NOTE 7) ALONG THE EXISTING TRAVELED WAY FOR WORK ZONE PROTECTION. BARRIER PLACEMENT, FLARE RATE, AND END TREATMENTS SHALL BE IN ACCORDANCE WITH STANDARD PLAN NO. S-630-1.

PHASE 1b SHALL INCLUDE CONSTRUCTION OF THE EASTBOUND TROY AVENUE BRIDGE SUPERSTRUCTURE. PHASE 1b WORK MAY BE COMPLETED CONCURRENTLY WITH PHASE 2 WORK BUT MUST BE COMPLETED PRIOR TO COMMENCEMENT OF PHASE 3. CONSTRUCTION TRAFFIC CONTROL SHALL BE AS SHOWN ON THE FOLLOWING PHASE 1b PLAN SHEET.

PHASE 2

PHASE 2 WORK SHALL INCLUDE CONSTRUCTION OF THE RAMP JUNCTION AND ROADWAY TRANSITION PORTIONS OF EASTBOUND SH47. THIS WORK SHALL EXCLUDE PLACEMENT OF THE FINAL ASPHALT LIFT UNTIL PHASE 4. BOTH DIRECTIONS OF MAINLINE SH47 TRAFFIC FLOW SHALL BE MAINTAINED ON THE EXISTING WESTBOUND ROADWAY. AT THE RAMP JUNCTION AND TRANSITION AREAS, EXISTING TRAFFIC FLOW SHALL BE MAINTAINED THROUGH THE USE OF FLAGGING AND TEMPORARY ALIGNMENT SHIFTS WITHIN THE EXISTING AND NEWLY CONSTRUCTED PORTIONS OF SH47. APPROPRIATE LANE WIDTHS AND ALIGNMENT TAPERS SHALL BE USED TO ACCOMMODATE TRUCKS AND BUSES. FLAGGERS SHALL ALSO BE USED TO CONTROL RAMP AND MAINLINE TRAFFIC WHERE ADEQUATE SIGHT DISTANCE CANNOT BE MAINTAINED FOR MERGING TRAFFIC.

PHASE 3


PHASE 3 WORK SHALL INCLUDE CONSTRUCTION OF THE NORTH PORTIONS OF THE DRAINAGE CULVERTS BETWEEN JERRY MURPHY ROAD AND BONFORTE BLVD AND THE REHABILITATION OF THE EXISTING WESTBOUND SH47 BRIDGE OVER TROY AVENUE. EASTBOUND SH47 TRAFFIC SHALL BE PLACED ON THE NEW EASTBOUND SH47 ROADWAY WITH TEMPORARY STRIPING FOR DELINEATION. WESTBOUND SH47 TRAFFIC SHALL BE DETOURED ONTO THE NEW EASTBOUND BRIDGE OVER TROY AVENUE USING THE EXISTING EASTBOUND TROY AVENUE ON RAMP AS A **MEDIAN CROSSOVER**. IT IS ANTICIPATED THAT SOME ASPHALT PAVEMENT WILL NEED TO BE PLACED AT MINOR GRADE DIFFERENCES BETWEEN THE NEW EASTBOUND TRAVEL LANES AND THE EXISTING RAMP CROSSOVER. WESTBOUND TRAFFIC SHALL BE DETOURED BACK TO THE WESTBOUND ROADWAY IN ADVANCE OF WESTBOUND JERRY MURPHY OFF RAMP USING A TEMPORARY MEDIAN CROSSOVER DETOUR AS SHOWN IN THE PLANS. CONSTRUCTION OF THE TEMPORARY DETOURS SHALL BE PAID FOR AS **ITEM 621-DETOUR-S.Y.** EASTBOUND AND WESTBOUND TRAFFIC SHALL BE RESTRICTED TO ONE LANE IN EACH DIRECTION THROUGH THE DETOUR.

PHASE 4

PHASE 4 WORK SHALL INCLUDE THE FINAL ASPHALT LIFT ON ALL NEW ROADWAY AND BRIDGE SECTIONS AND AN ASPHALT OVERLAY OF THE EXISTING ROADWAY AS SHOWN IN THE PLANS. EASTBOUND SH47 TRAFFIC SHALL BE MAINTAINED ON THE NEW EASTBOUND ROADWAY WHILE WESTBOUND TRAFFIC SHALL BE MAINTAINED ON THE EXISTING WESTBOUND ROADWAY. THE ASPHALT SHALL BE PLACED WHILE MAINTAINING AT LEAST ONE LANE OF TRAFFIC IN EACH DIRECTION. TRAFFIC CONTROL (NOT SHOWN) SHALL CONFORM TO CDOT STANDARD PLAN S-630-1 CASE X. DETOURING TRAFFIC WILL NOT BE PERMITTED.


GENERAL NOTES:

- EXISTING TRAFFIC CONTROL DEVICES IN CONFLICT WITH CONSTRUCTION TRAFFIC CONTROL SHALL BE REMOVED OR COVERED DURING CONSTRUCTION. ALL OTHER TRAFFIC CONTROL DEVICES SHALL BE MAINTAINED DURING CONSTRUCTION.
- ADVANCE CONSTRUCTION SIGN SPACING SHALL BE 300 FEET MINIMUM, UNLESS OTHERWISE DIRECTED BY THE ENGINEER.
- CHANNELIZING DEVICES SHALL BE 18" DRUMS. DRUMS WITH "TYPE C" STEADY BURN LIGHTS SHALL BE USED WHEN DIRECTED BY THE ENGINEER. 36" TRAFFIC CONES MAY BE USED FOR DAYTIME FLAGGING OPERATIONS.
- ALL BARRICADES SHALL HAVE "TYPE A" FLASHING WARNING LIGHTS MOUNTED ON TOP.
- DURING ONE LANE ROAD CONDITIONS, SUFFICIENT ROADWAY WIDTH SHALL BE MAINTAINED TO ALLOW PASSAGE OF HEAVY VEHICLES THROUGH THE CONSTRUCTION ZONE.
- ANY PROPOSED CHANGES BY THE CONTRACTOR TO THE PHASING PLAN WILL REQUIRE A WRITTEN PROPOSAL TO BE SUBMITTED TO THE ENGINEER FOR APPROVAL (REF. SPECIAL PROVISIONS).
- IT IS ESTIMATED THAT **1200** FEET OF TEMPORARY CONCRETE BARRIER WILL BE REQUIRED DURING PHASE 1a TO PROTECT TRAFFIC ALONG EXISTING SH47 FROM EXCESSIVE CROSS SLOPES OR VERTICAL DROP-OFFS WITHIN THE CLEAR ZONE. THE FOLLOWING GUIDELINES ARE FOR THE ENGINEERS USE IN DETERMINING TEMPORARY BARRIER PLACEMENT. THE GUIDELINES DO NOT ACCOUNT FOR EXTENUATING FIELD CONDITIONS WHICH MAY OR MAY NOT REQUIRE THE USE OF TEMPORARY BARRIER. WITHIN THE 24 FT. CLEAR ZONE, TEMPORARY BARRIER IS RECOMMENDED FOR THE FOLLOWING CONDITIONS:
WHERE A VERTICAL DROP-OFF OF 2 FT. OR MORE EXISTS, OR
WHERE HEIGHT DIFFERENTIAL BETWEEN EDGE OF EXISTING PAVEMENT AND BOTTOM OF WORK AREA EQUALS 2-3 FT. AND SIDE SLOPE IS GREATER THAN 1 1/2:1, OR
WHERE HEIGHT DIFFERENTIAL BETWEEN EDGE OF EXISTING PAVEMENT AND BOTTOM OF WORK AREA EQUALS 4-6 FT. AND SIDE SLOPE IS GREATER THAN 2:1, OR
WHERE HEIGHT DIFFERENTIAL BETWEEN EDGE OF EXISTING PAVEMENT AND BOTTOM OF WORK AREA EQUALS 7-9 FT. AND SIDE SLOPE IS GREATER THAN 2 1/2:1, OR
WHERE HEIGHT DIFFERENTIAL BETWEEN EDGE OF EXISTING PAVEMENT AND BOTTOM OF WORK AREA IS GREATER THAN OR EQUAL TO 10 FT.

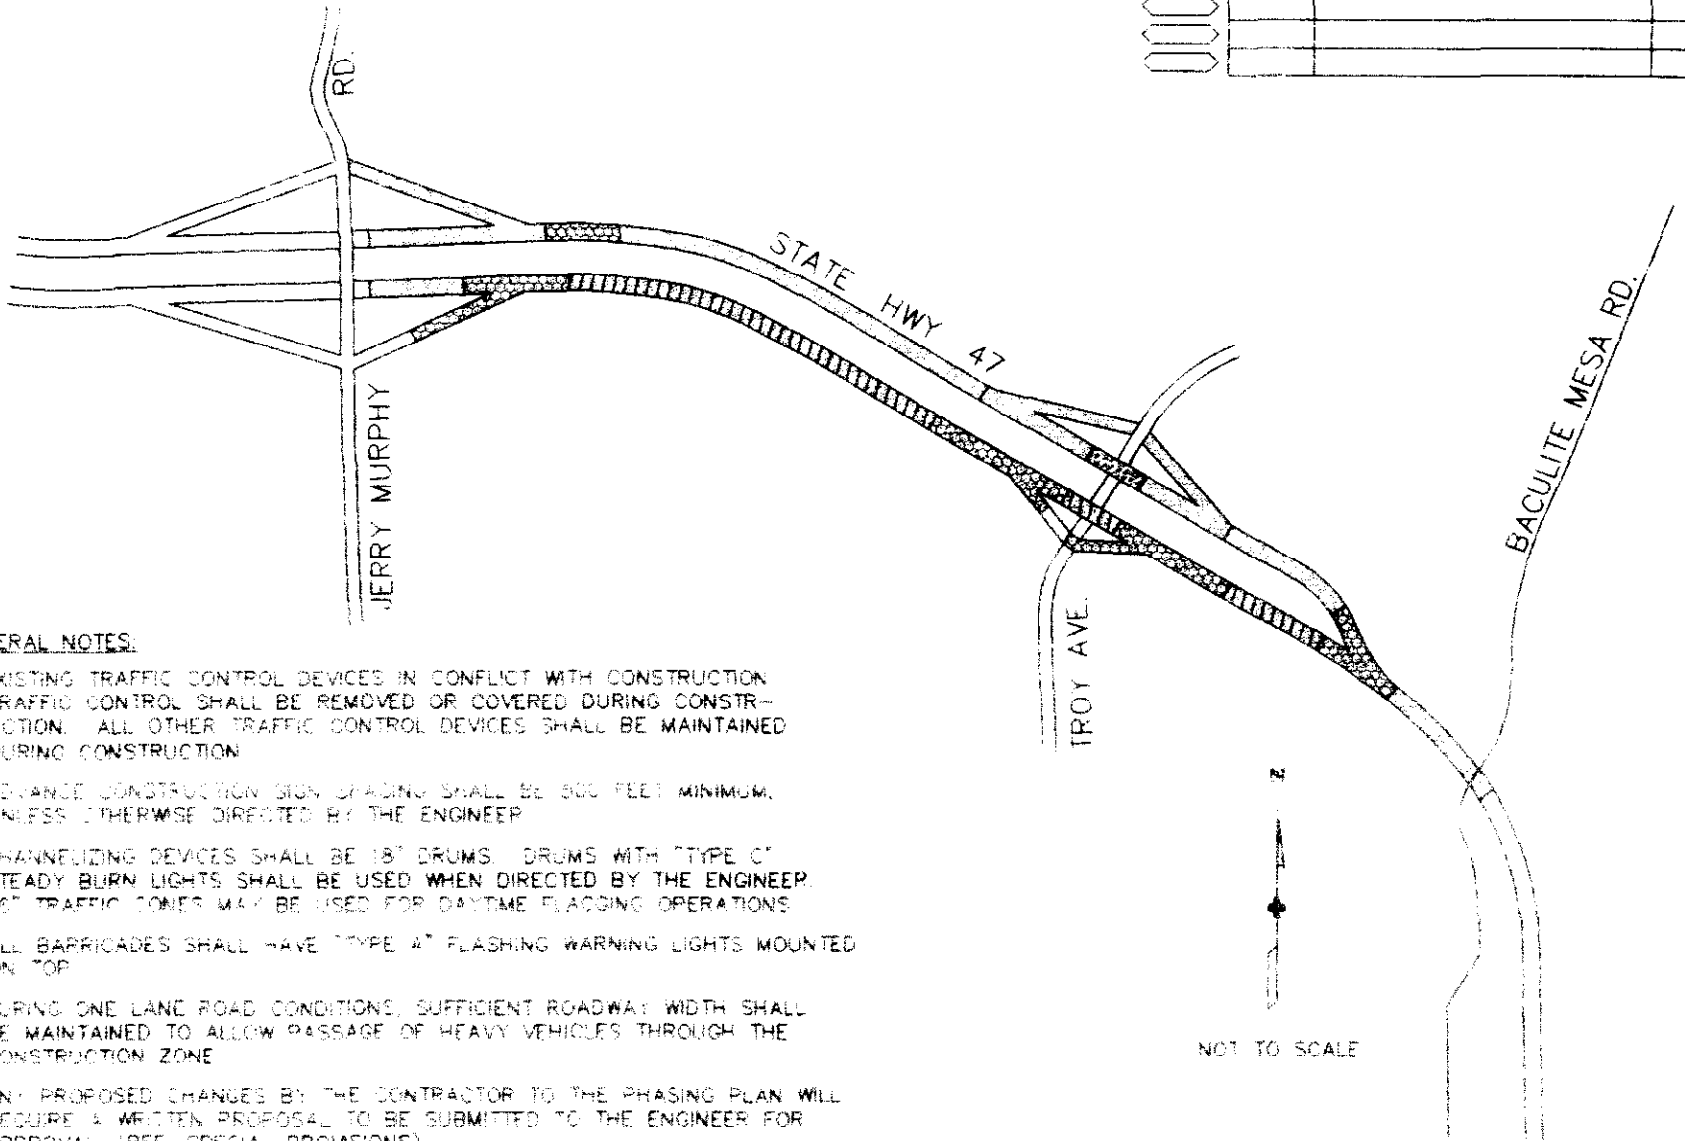

CONSTRUCTION TRAFFIC CONTROL PLAN

NOTE: ALL SIGNS SHOWN ARE ORIENTED
TO FACE THE DIRECTION OF TRAFFIC

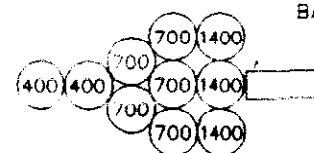

SAND BARREL IMPACT
ATTENUATOR DETAIL
DESIGN SPEED - 45MPH



48W20-5



48W4-2L
TO BE PLACED ON TROY
AVE. DIRECTLY SOUTH
OF ALAMEDA RD.
INTERSECTION



48W12-2


TAPER LENGTH
540 FT OR AS
DIRECTED BY
ENGINEER



48W20-1
TO BE PLACED ON
ALAMEDA RD 350 FT IN
ADVANCE OF TROY AVE

THANK YOU

4BG20-10
PLACE 500 FT
FROM RAMP TERMINUS

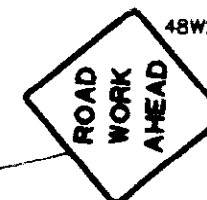

48W20-1


CONSTRUCTION TRAFFIC CONTROL PLAN
PHASE 1b - SHEET 1

INITIAL	DATE	DESIGNED BY	CHECKED BY	DETAILED BY	QUANTITIES BY	CHECKED BY


24-24-90

ROUTING NAME: N:\171\ACADA TRAFFIC\XCTCAR.DWG


• **SWING BACK**

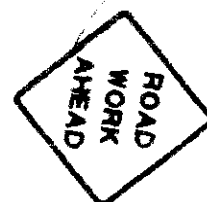


4BW20-

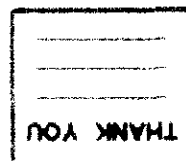


48G20-10
PLACE 500 FT
FROM RAMP TERMINUS

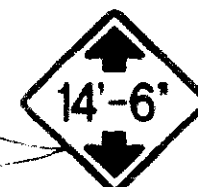

48W12-2

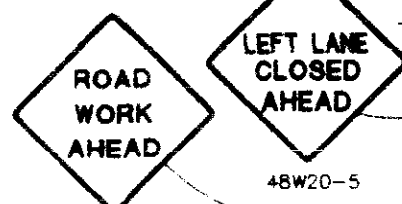

48W20-1

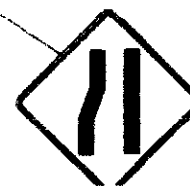


48W4-2L


NOTE: DURING BRIDGE DECK CONCRETE POURING, ONE DIRECTION OF TRAFFIC ON TROY AVENUE WILL NEED TO BE CLOSED. REFERENCE CDOT STANDARD DRAWING 9-630-1, CASEXVII.

LEGEND

-  - TYPE 3 BARRICADE
-  - DIRECTION OF TRAFFIC
-  - FLAGGER
-  - CONCRETE BARRIER (TEMP)
-  - CHANNELIZING DEVICE
-  - IMPACT ATTENUATOR
-  - WORK ZONE

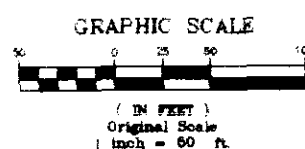

SECTION (A) - (A)

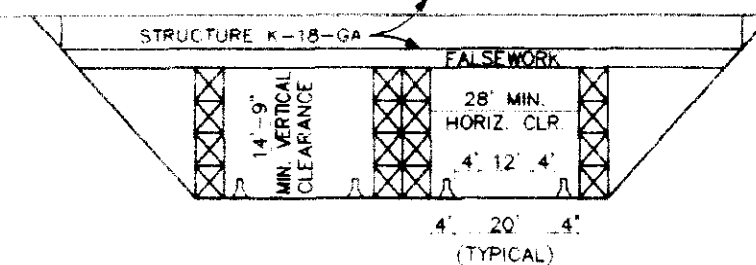


BRIDGE CONSTRUCTION ELEVATION DETAIL
TRAFFIC CONTROL LANE RESTRICTIONS
(NOT TO SCALE)

PROJECT NO.		
SECTION	DATE	BY

PROJECT NO.	SECTION	DATE	BY	SHEET NO.	SHEET TOTALS
				87	
REVISIONS					

PHASE 2 - SHEET 1

DESIGNED BY	CHECKED BY
CHECKED BY	QUANTITIES BY
CHECKED BY	CHECKED BY
DATE: 9-24-88	TIME:
DRAWING NAME: R-1718-000-TRAFFIC CONTROL	
SHEET NAME:	

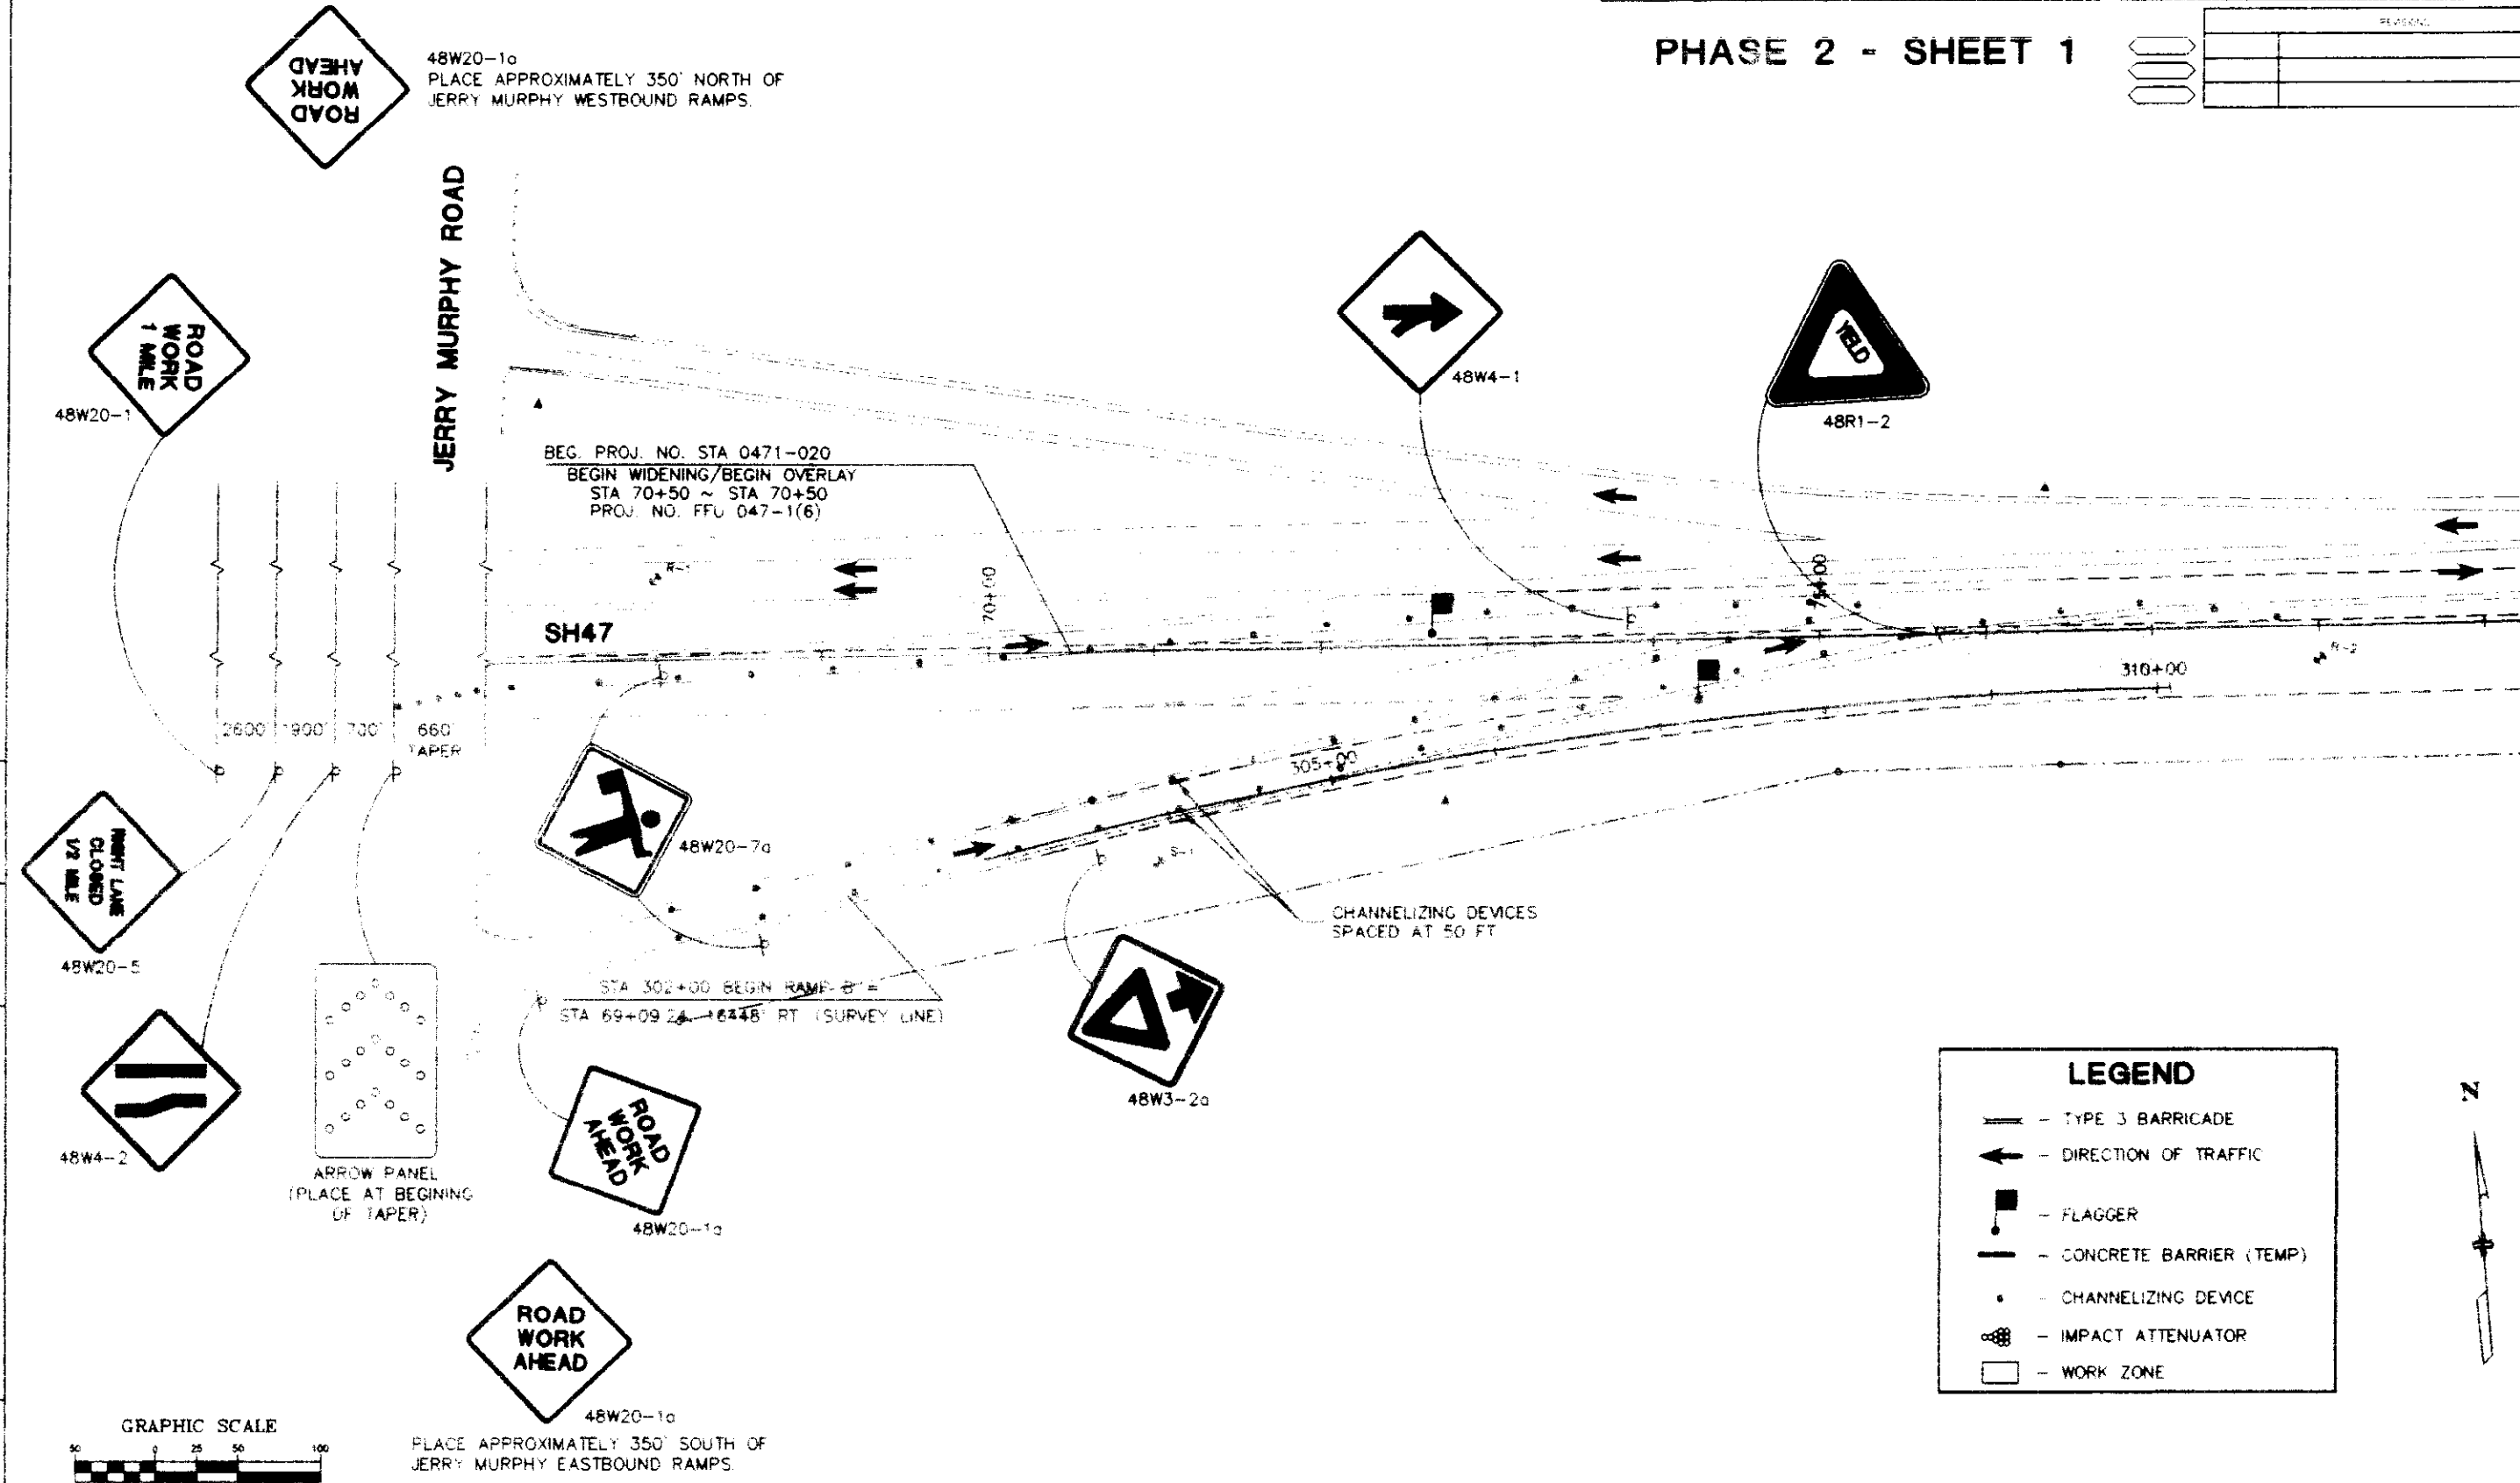

48W20-1a
PLACE APPROXIMATELY 350' NORTH OF
JERRY MURPHY WESTBOUND RAMP.

BEG. PROJ. NO. STA 0471-020
BEGIN WIDENING/BEGIN OVERLAY
STA 70+50 ~ STA 70+50
PROJ. NO. FFU 047-1(6)


SH47

STA 302+00 BEGIN RAMP "B"
STA 69+09 24' 16.448' RT (SURVEY LINE)

48W20-1a
PLACE APPROXIMATELY 350' SOUTH OF
JERRY MURPHY EASTBOUND RAMP.

LEGEND

- TYPE 3 BARRICADE
- ← DIRECTION OF TRAFFIC
- FLAGGER
- CONCRETE BARRIER (TEMP)
- CHANNELIZING DEVICE
- ⊞ IMPACT ATTENUATOR
- WORK ZONE

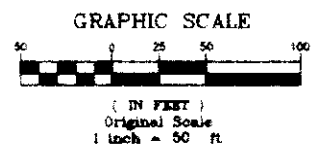

NOTE ALL SIGNS SHOWN ARE ORIENTED
TO FACE THE DIRECTION OF TRAFFIC.


CONSTRUCTION TRAFFIC CONTROL PLAN

PROJECT NO.		
STA 0471-020		

DATE	DESIGNED BY	CHECKED BY	QUANTITIES BY	DATE	DESIGNED BY	CHECKED BY	QUANTITIES BY

PHASE 2 - SHEET 2

REVISIONS			

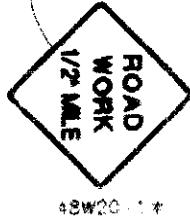

48W20-1 *
PLACE 1500 FT
IN ADVANCE OF
GORE AREA

* THESE SIGNS ONLY NEEDED IF
SIGNS ARE NOT IN PLACE AT
JERRY MURPHY ROAD


RESET AS NEEDED
TO MAINTAIN
SIGN VISIBILITY **



** THE COST OF THE RESET
WILL NOT BE PAID FOR
SEPARATELY BUT SHALL
BE INCLUDED IN THE COST
OF CONSTRUCTION.

LEGEND


- TYPE 3 BARRICADE
- DIRECTION OF TRAFFIC
- FLAGGER
- CONCRETE BARRIER (TEMP)
- CHANNELIZING DEVICE
- IMPACT ATTENUATOR
- WORK ZONE

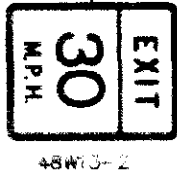

48W20-2

MATCH LINE STA 135+00

MATCH LINE STA 145+00

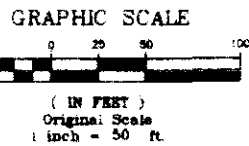

NOTE: ALL SIGNS SHOWN ARE ORIENTED
TO FACE THE DIRECTION OF TRAFFIC.

CONSTRUCTION TRAFFIC CONTROL PLAN

NO. REVISED	REVISED	DATE

PHASE 2 - SHEET 3

ALL PHASE 2 CONSTRUCTION SHALL
EXCLUDE THE FINAL ASPHALT LIFT.

REVISIONS	DATE	BY	REASON

DESIGNED BY	CHECKED BY
CHECKED BY	CHECKED BY
CHECKED BY	CHECKED BY
CHECKED BY	CHECKED BY

DATE: 8-24-88

CONTRACT NAME: R-1716, C-1716, C-1716, C-1716

VIEW NAME

MATCH LINE STA 148+00

TRON AVENUE

MATCH LINE STA 162+00

MATCH LINE STA 162+00

ROAD
WORK
AHEAD

PLACE APPROX. 350' IN ADVANCE
OF SH47 WESTBOUND RAMP.

ROAD
WORK
AHEAD

48W20-1A

ROAD
WORK
AHEAD

PLACE APPROX. 350' IN ADVANCE
OF SH47 EASTBOUND RAMP.

CHANNELIZING DEVICES
SPACED AT 50 FT

48W20-7A

48W3-2A

EXISTING SIGN TO BE RESET. COST OF RESET
WILL NOT BE PAID FOR SEPARATELY BUT SHALL
BE INCLUDED IN THE COST OF CONSTRUCTION.

LEGEND

- TYPE 3 BARRICADE
- DIRECTION OF TRAFFIC
- FLAGGER
- CONCRETE BARRIER (TEMP)
- CHANNELIZING DEVICE
- IMPACT ATTENUATOR
- WORK ZONE

CHANNELIZING DEVICES
SPACED AT 50 FT
ADJUST AS NEEDED
TYPE 3 BARRICADES



48R1-2

SH47

GRAPHIC SCALE



(IN FEET)
Original Scale
1 inch = 50 ft.

NOTE: ALL SIGNS SHOWN ARE ORIENTED
TO FACE THE DIRECTION OF TRAFFIC


CONSTRUCTION TRAFFIC CONTROL PLAN

NOTE: ALL SIGNS SHOWN ARE ORIENTED
TO FACE THE DIRECTION OF TRAFFIC.

PHASE 2 - SHEET 4

SECTION	LENGTH	SEQUENCE	SHEET NO.	SHEET TOTALS
		STA 0471-020	90	
DIVISIONS				

MATCH LINE STA 176+00

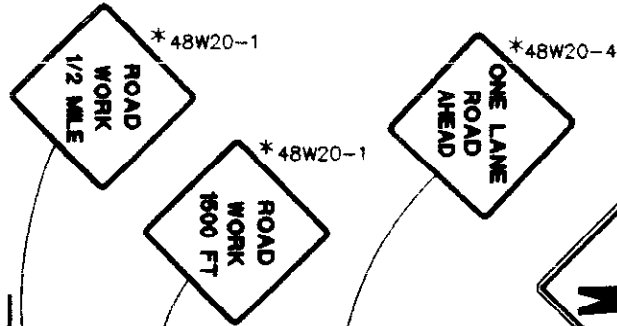

48W20-7a
SURVEY LINE

SH47

CHANNELIZING DEVICES
SPACED AT 50 FT.


MATCH LINE STA 190+00

* THIS SIGN ONLY NEEDED IF SIGN
IS NOT IN PLACE AT TRON AVE




48W20-7a


SH47

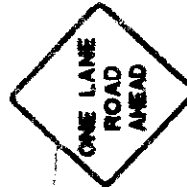

48W20-4

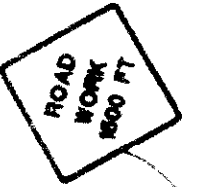

**48W20-1

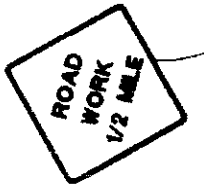


**48W20-1

BACULITE MESA RD.

** ADJUST SIGN PLACEMENT
ACCORDING TO LOCATION
OF WORK AREA


LEGEND	
	- TYPE 3 BARRICADE
	- DIRECTION OF TRAFFIC
	- FLAGGER
	- CONCRETE BARRIER (TEMP)
	- CHANNELIZING DEVICE
	- IMPACT ATTENUATOR
	- WORK ZONE

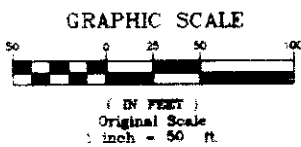

CONSTRUCTION TRAFFIC CONTROL PLAN


DESIGNED BY	CHECKED BY	DATE	INITIAL
QUANTITIES BY	CHECKED BY	DATE	INITIAL

DRAWING NAME: R-1718, CADD, TRAFFIC, DETOURING
VIEW NAME:

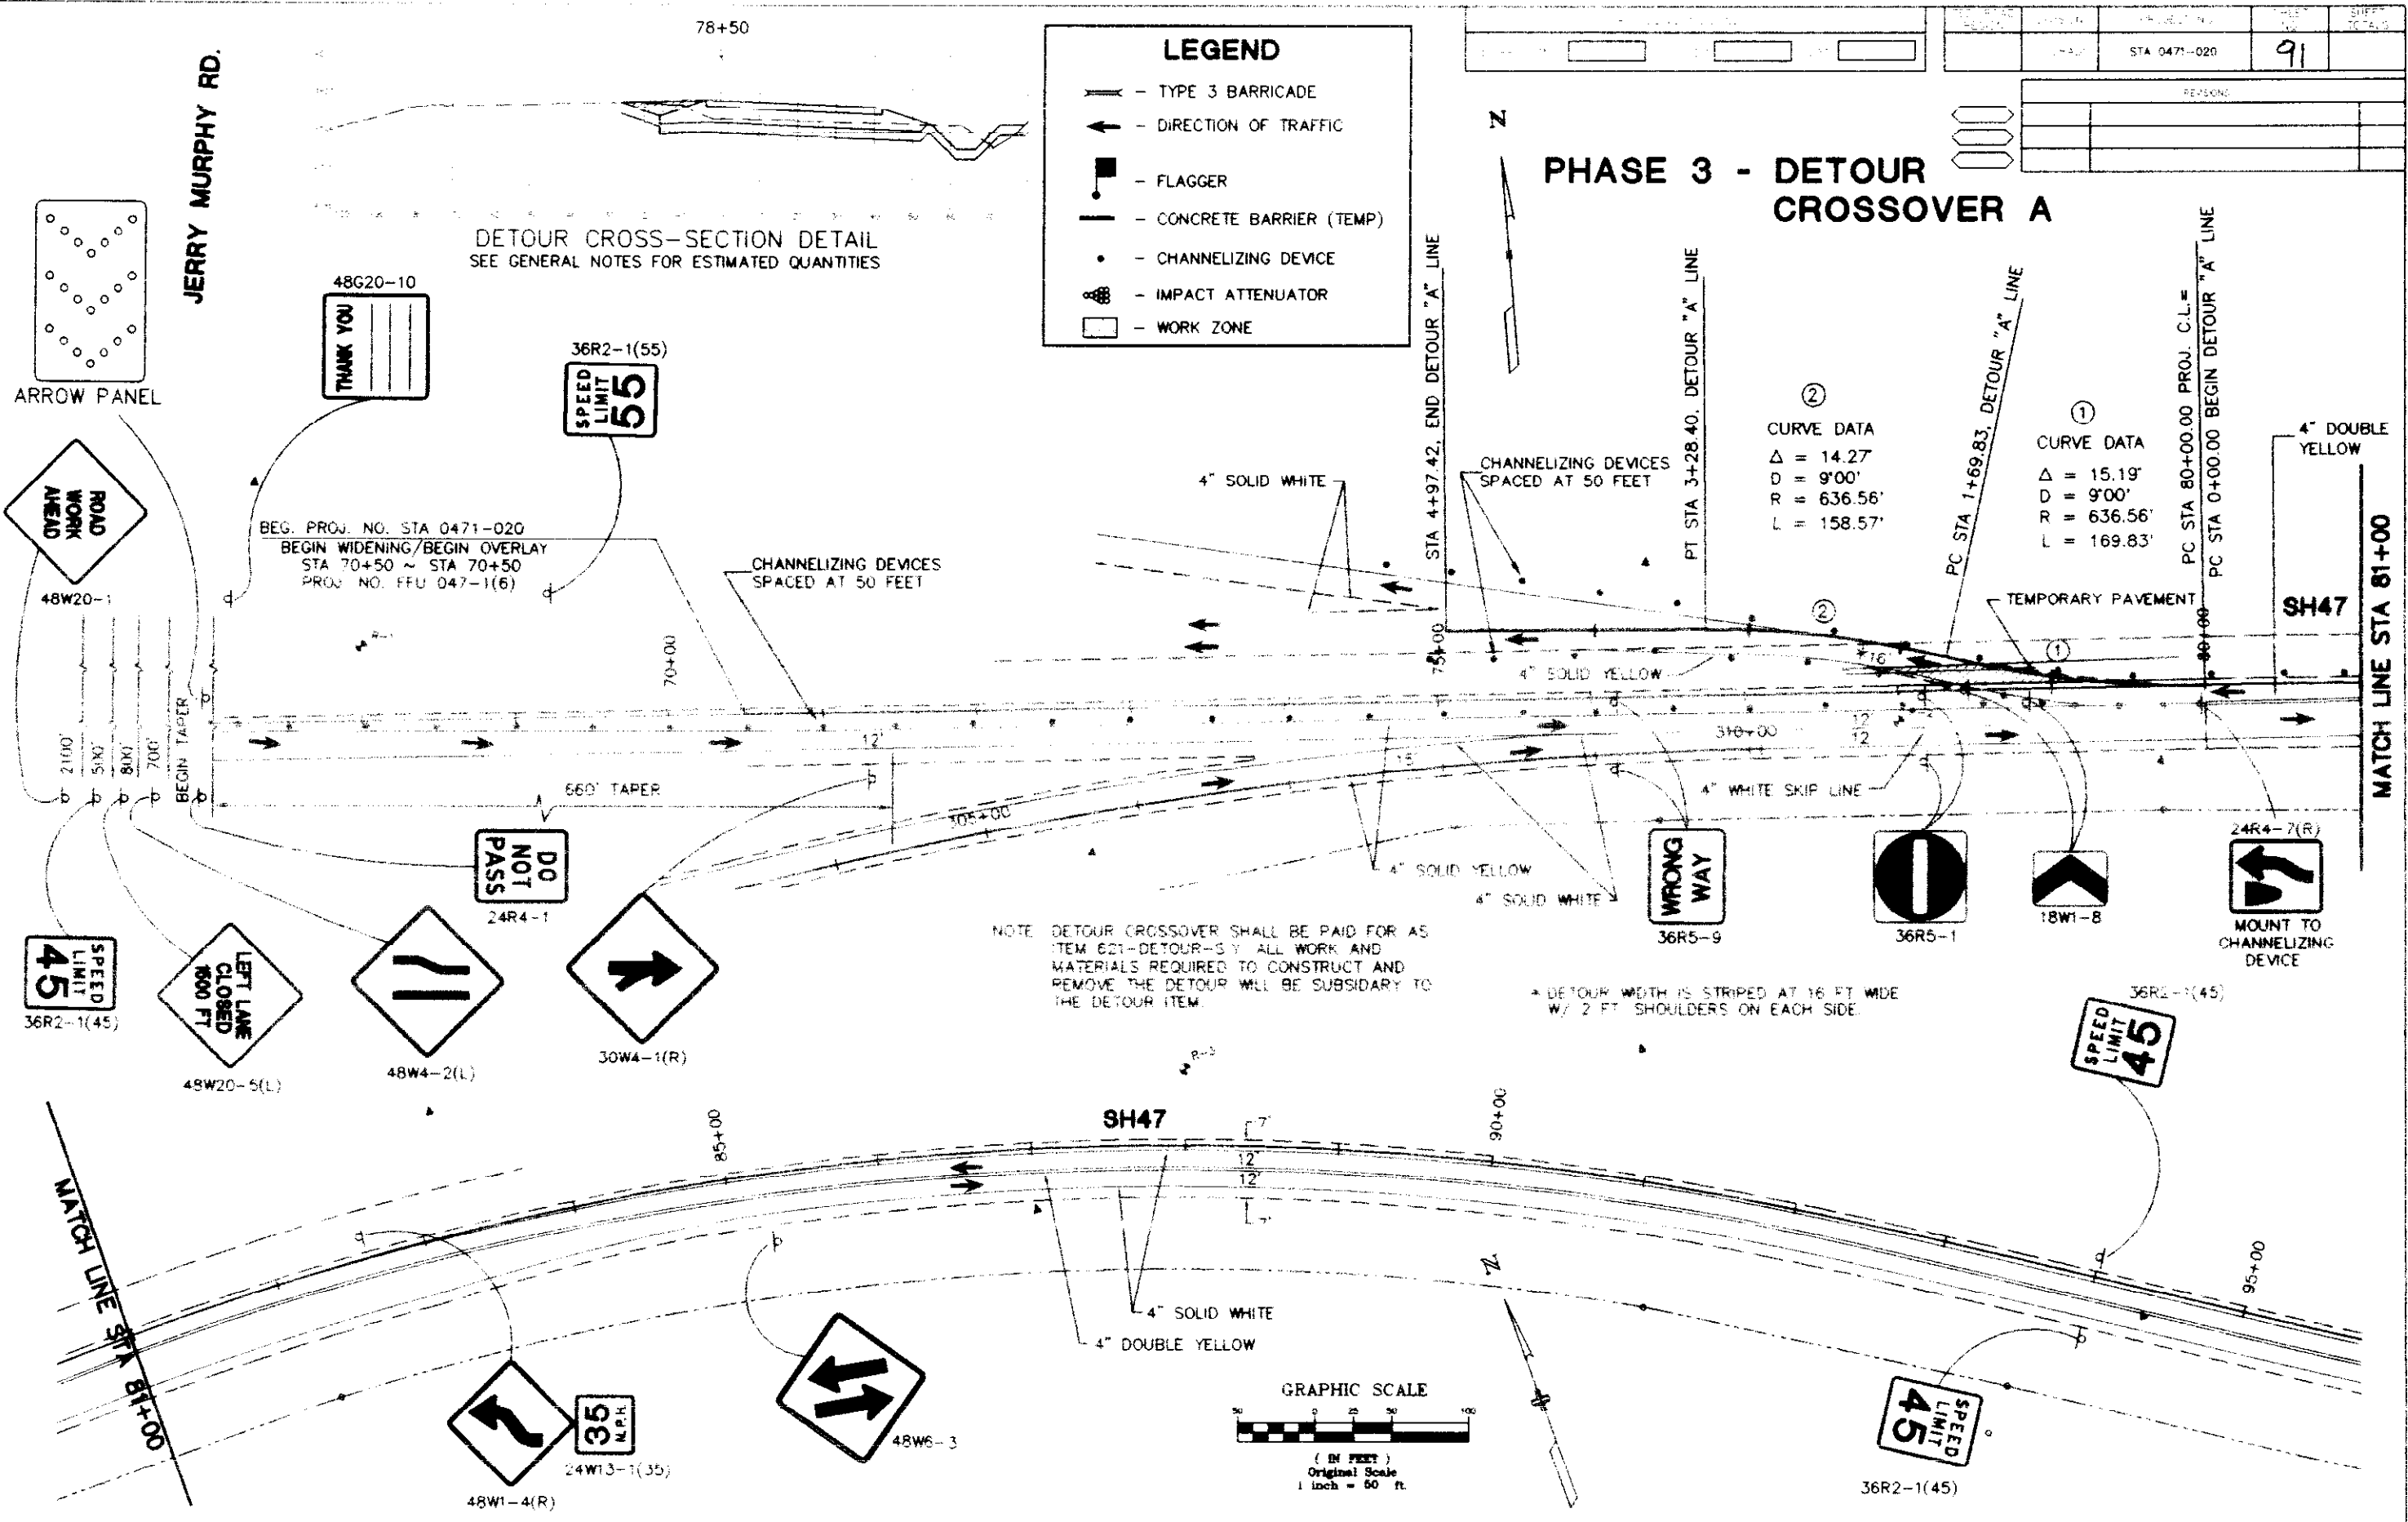


PROJECT NO.	STA 0471 020	SHEET NO.	92
REVISIONS			
NO.	DESCRIPTION	DATE	BY

DESIGNED BY	CHECKED BY
CHECKED BY	QUANTITIES BY
DETAILED BY	CHECKED BY


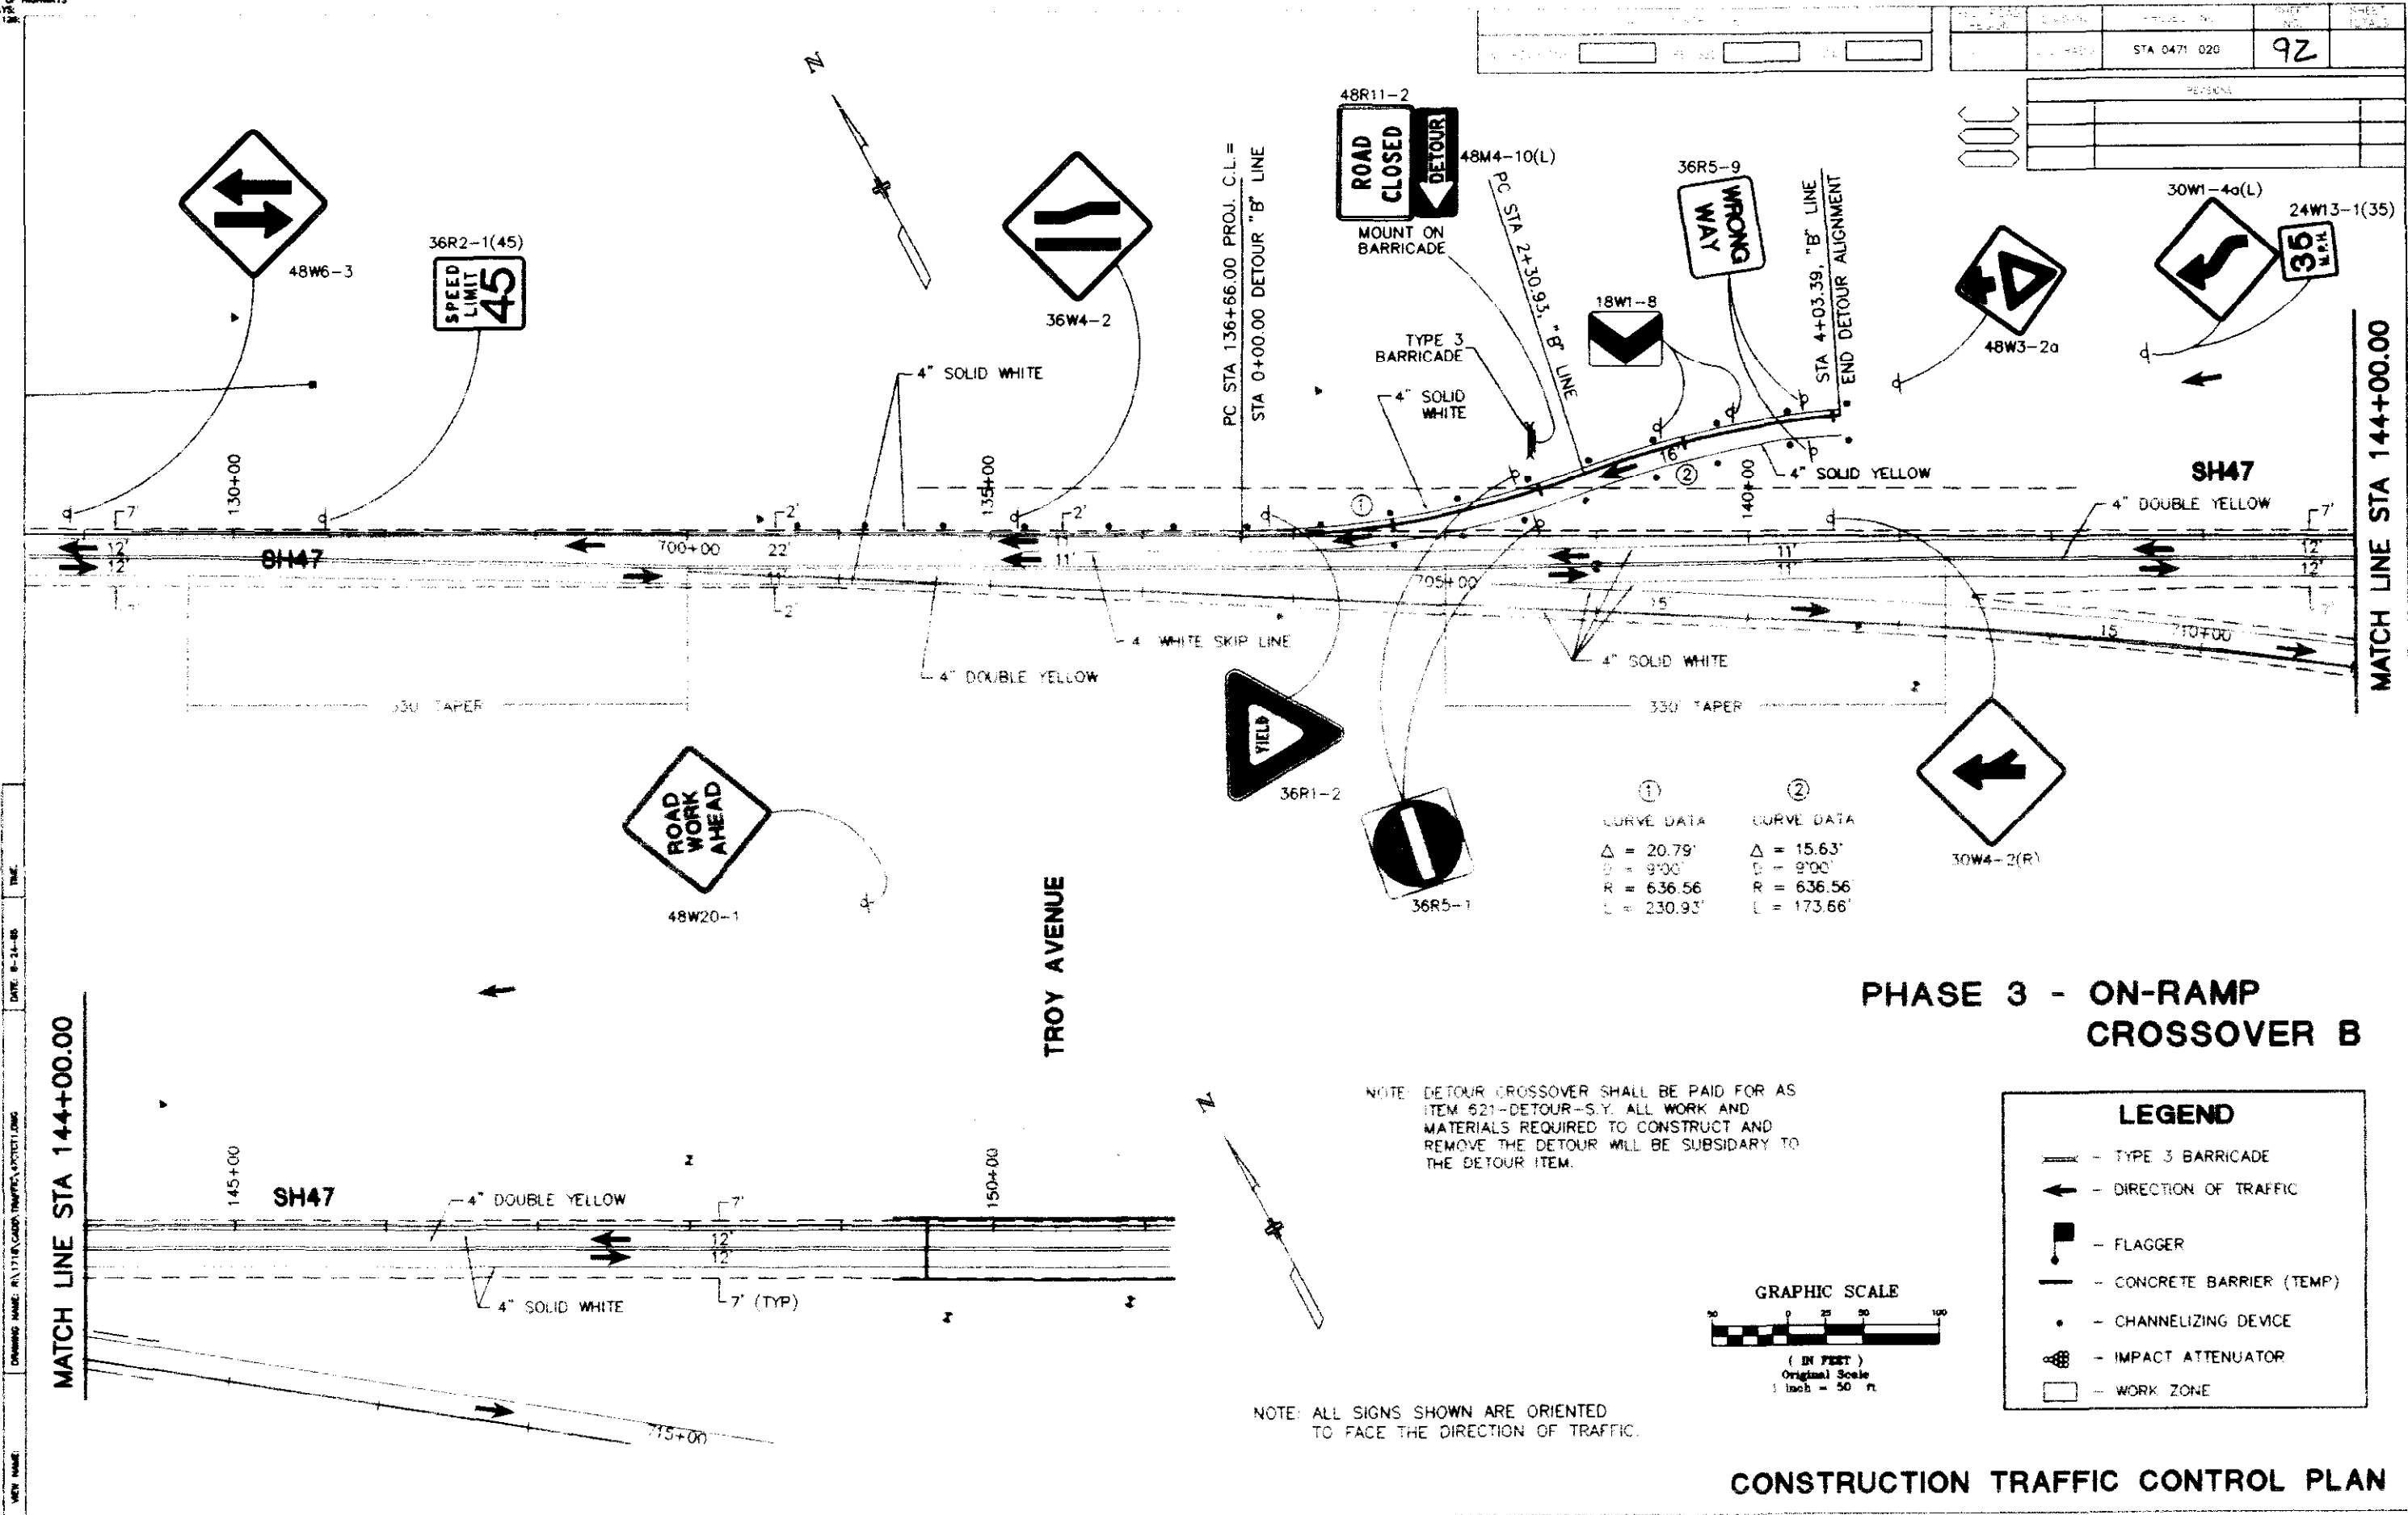


CONSTRUCTION TRAFFIC CONTROL PLAN

PROJECT NO.	SECTION	SHEET NO.	SHEET TOTAL
STA 0471-020		93	
REVISIONS			

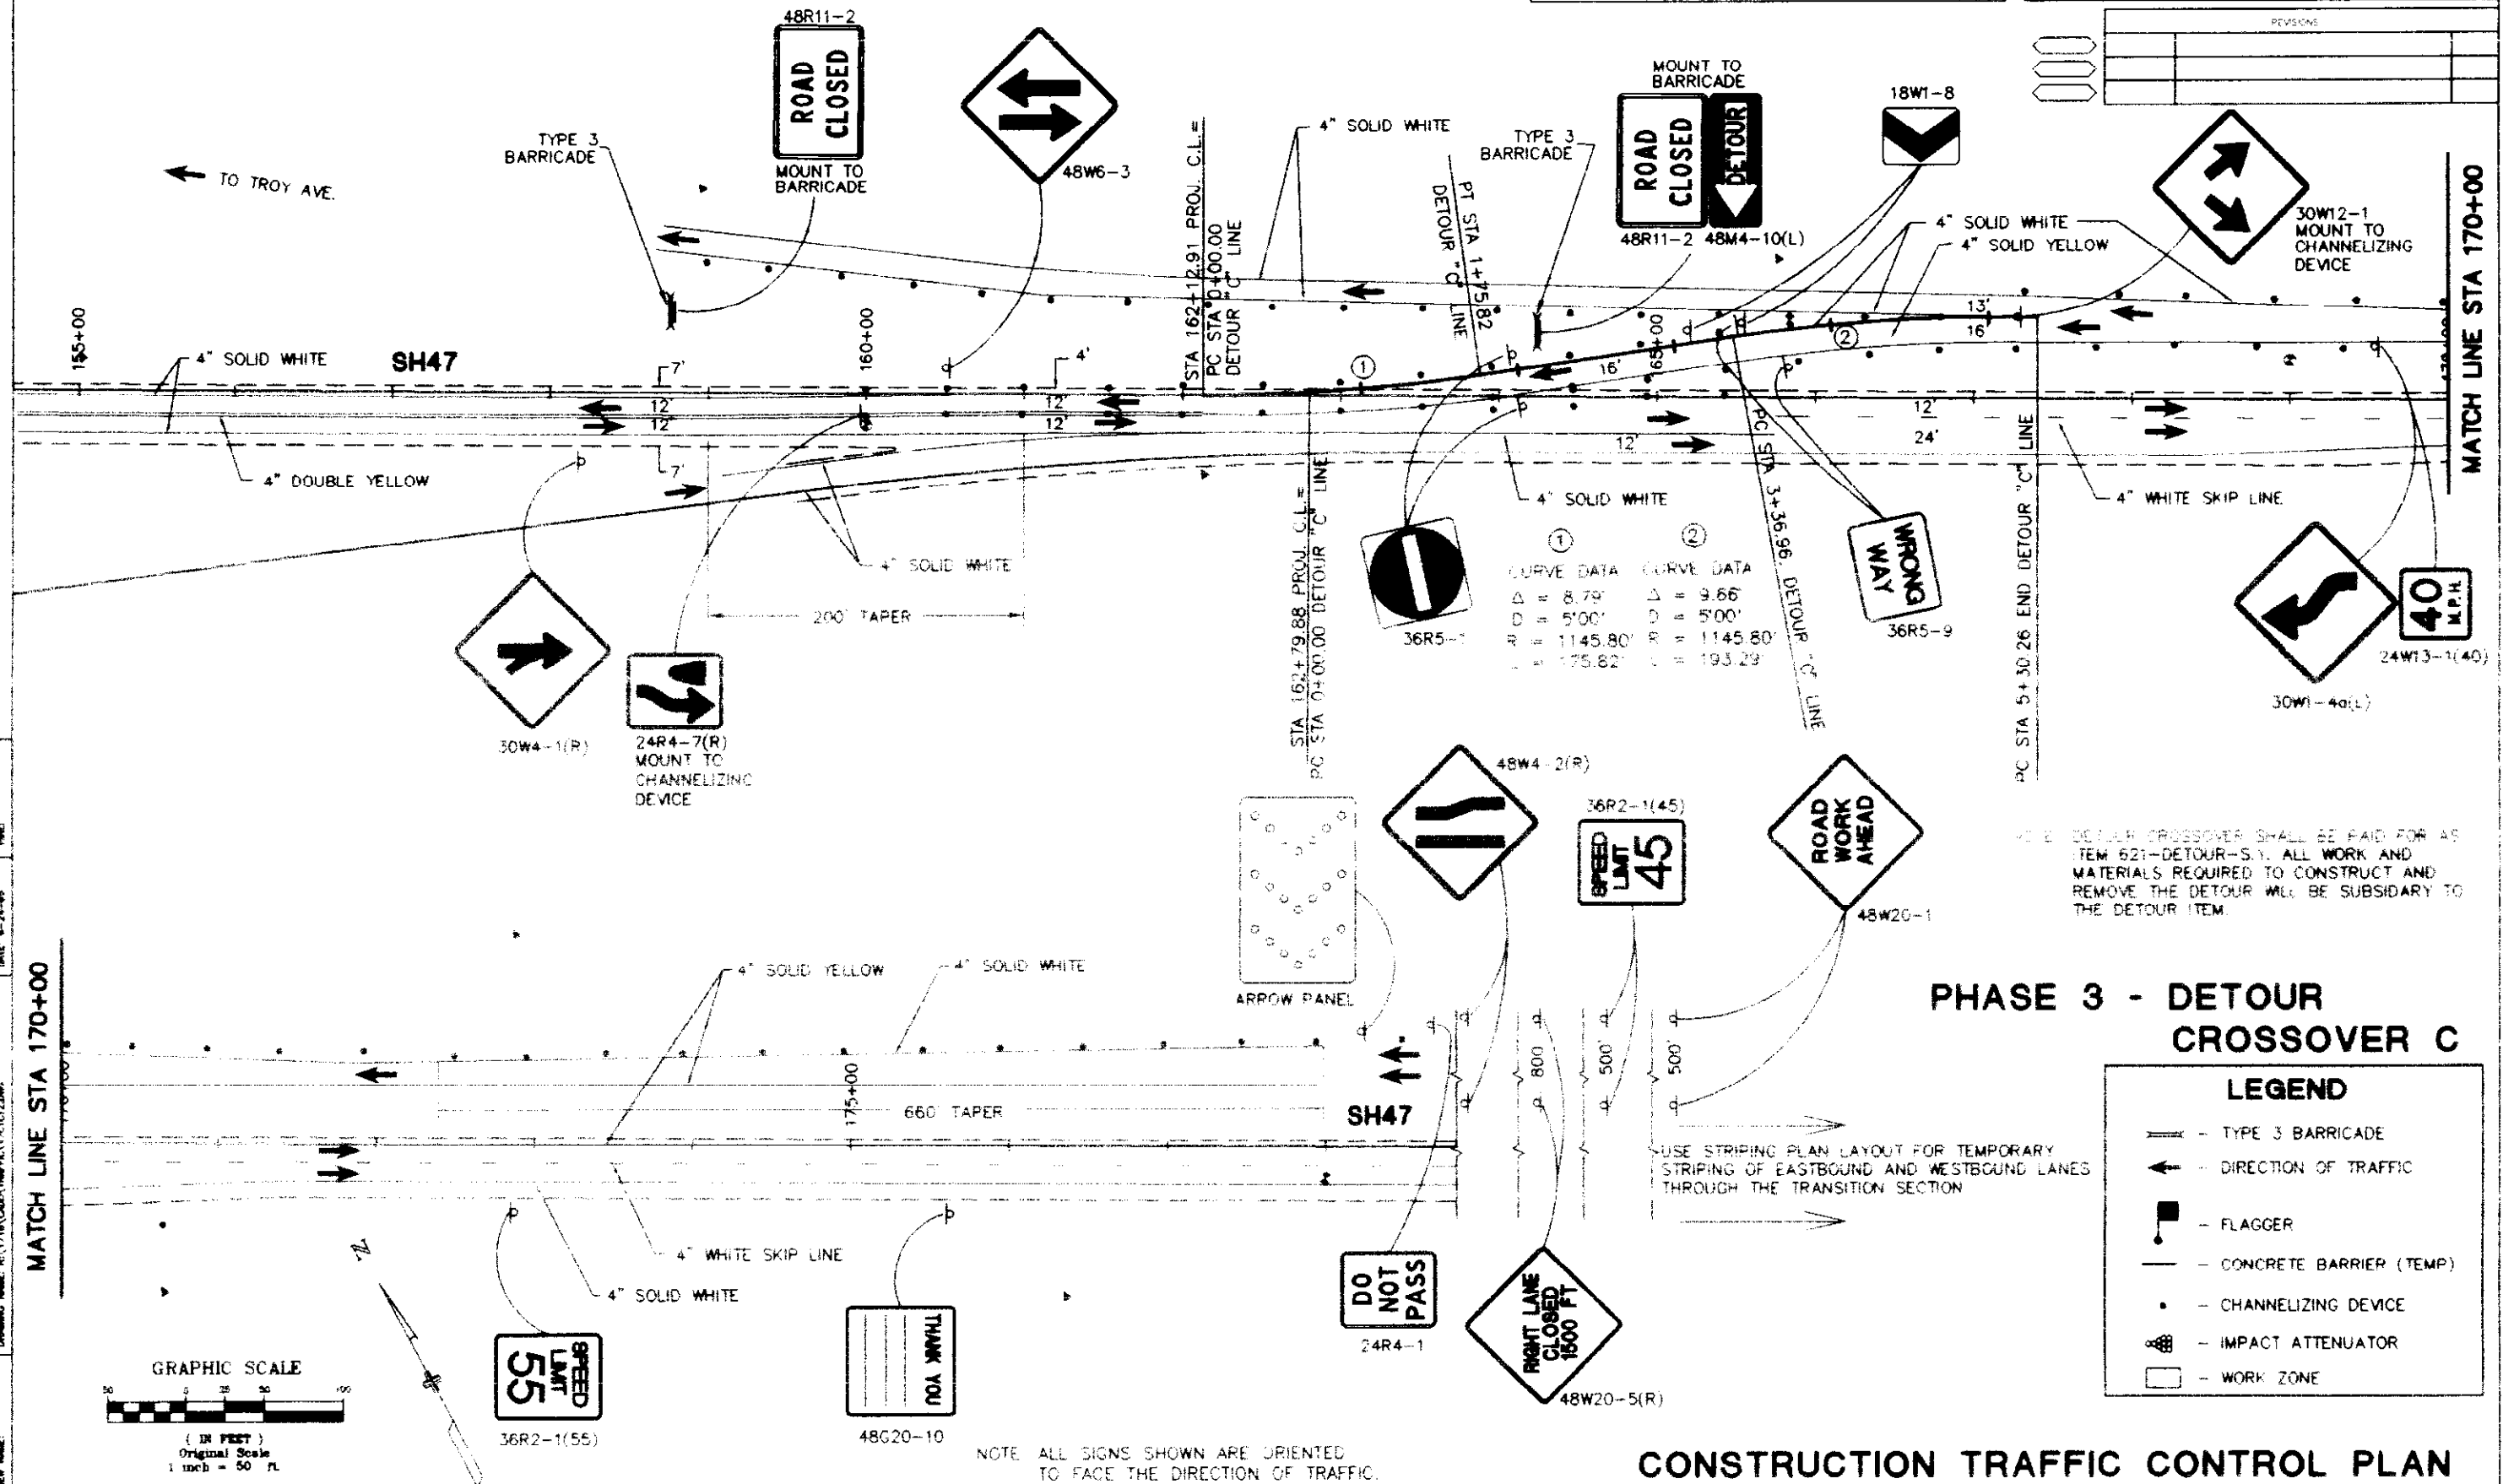

FILE NO.	SECTION	COLLECTOR NO.	DATE	TIME
94	COLUMBIA	STA 0471-020	94	

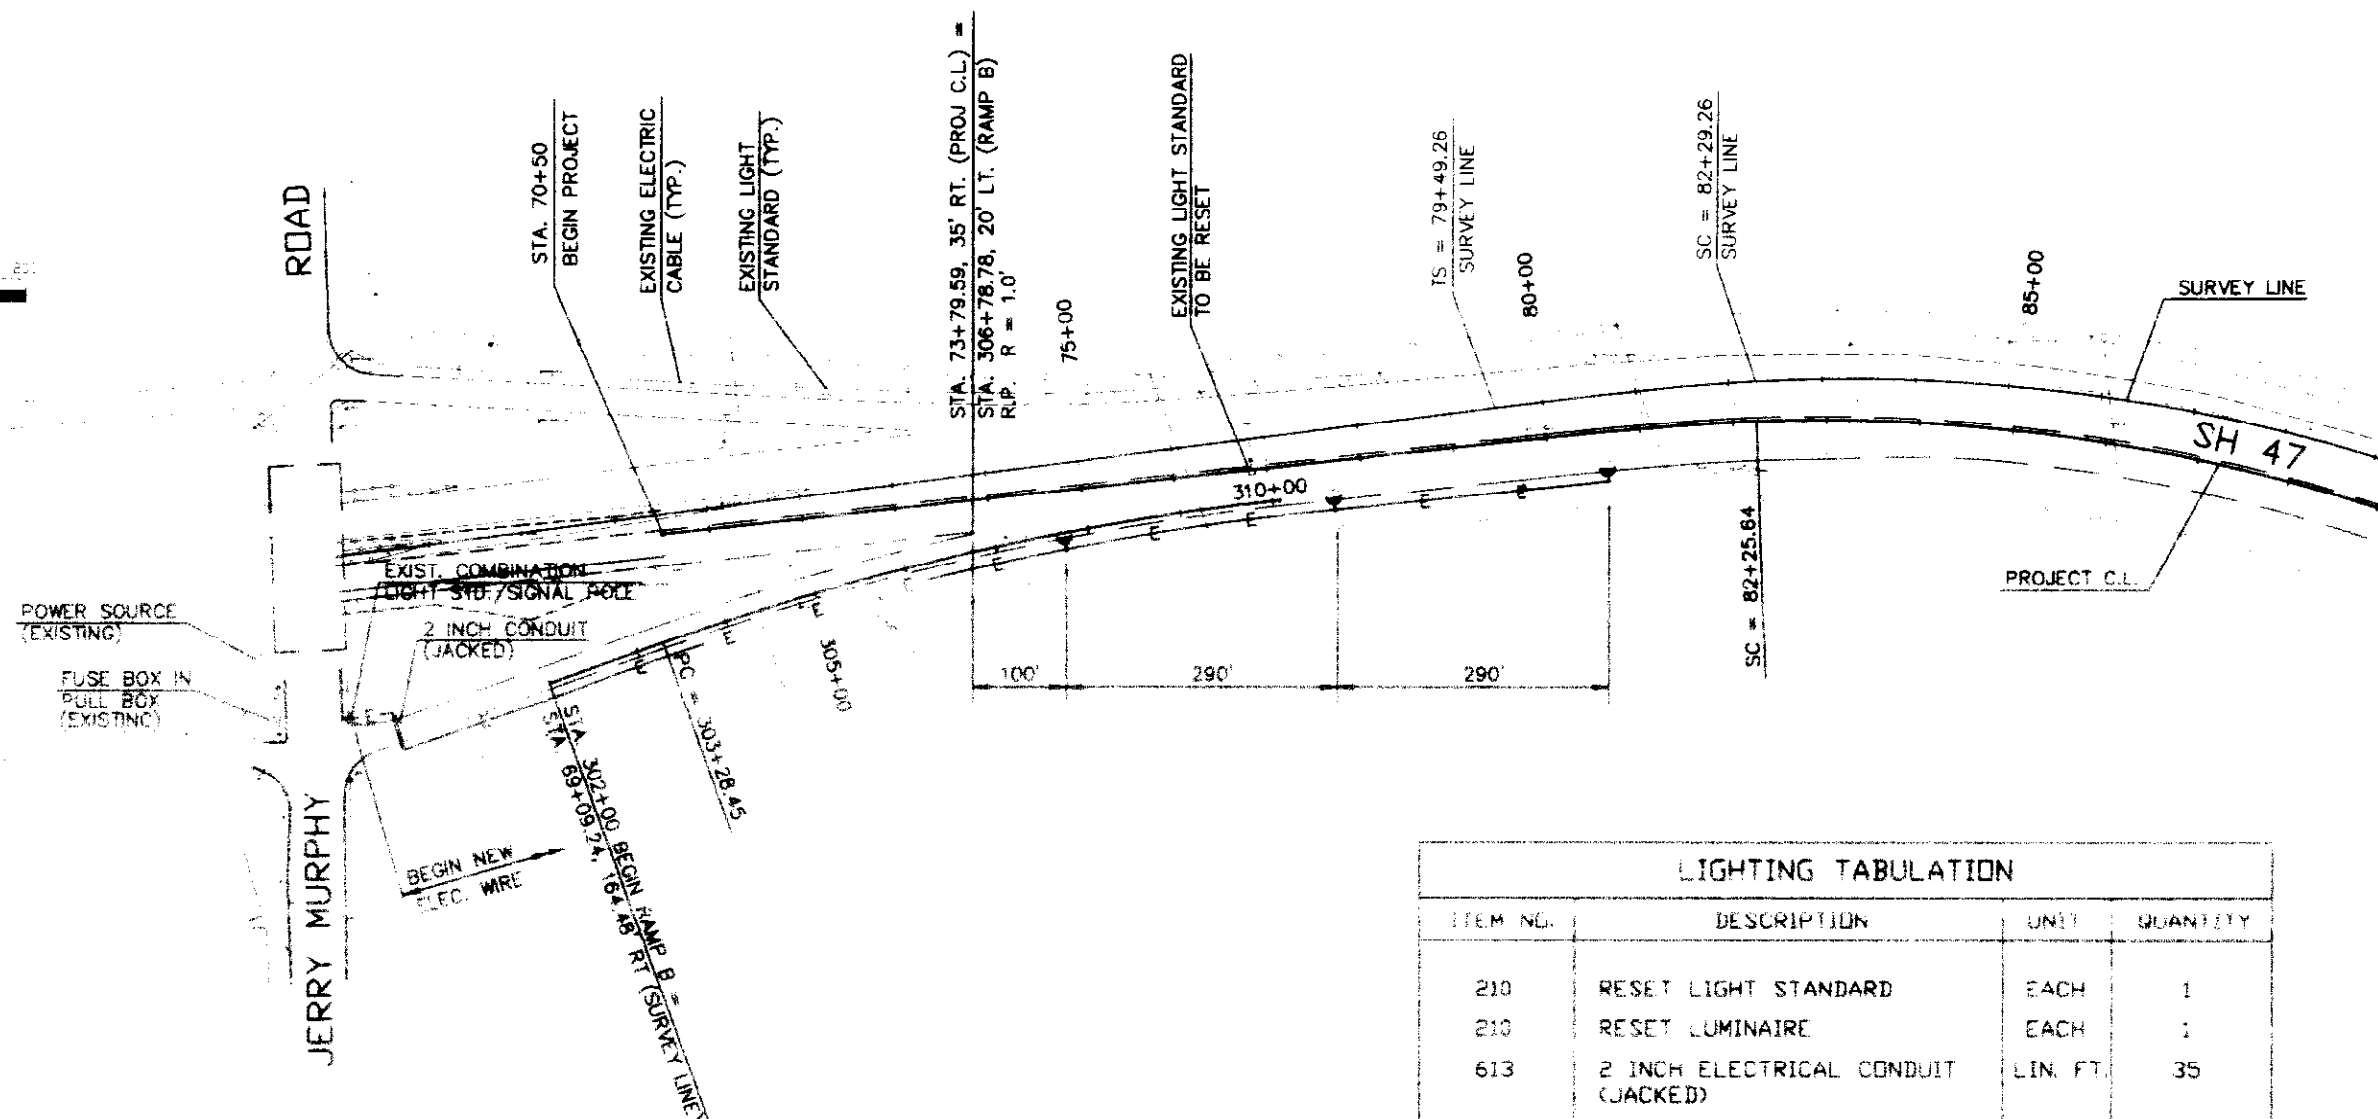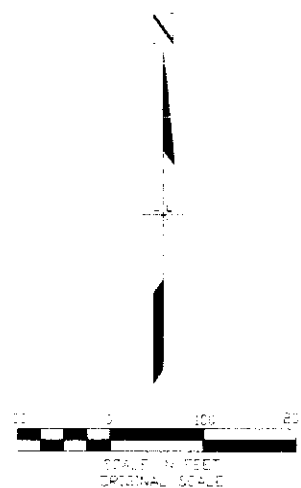

NOTES.

EXISTING CONCRETE FOUNDATION PAD AND APPROXIMATELY 90 L.F. OF ELECTRIC CABLE TO BE REMOVED. THE COST FOR REMOVAL SHALL NOT BE MEASURED AND PAID FOR SEPARATELY, BUT INCLUDED IN ITEM 210 RESET LIGHT STANDARD.

EXISTING ELECTRICAL INFORMATION WAS TAKEN FROM BEST AVAILABLE SOURCES. CONTRACTOR TO FIELD VERIFY EXISTING ELECTRICAL FACILITY LOCATIONS.

SCHEDULE 80 ELECTRICAL CONDUIT SHALL BE USED FOR ALL ROAD CROSSINGS. ALL OTHER CONDUIT MAY BE SCHEDULE 40.


LIGHTING TABULATION			
ITEM NO.	DESCRIPTION	UNIT	QUANTITY
210	RESET LIGHT STANDARD	EACH	1
210	RESET LUMINAIRE	EACH	1
613	2 INCH ELECTRICAL CONDUIT (JACKED)	LIN. FT.	35
613	2 INCH ELECTRICAL CONDUIT (PLASTIC)	LIN. FT.	1440
613	WIRING	L.S.	0.26
613	LIGHT STANDARD METAL (40 FOOT)	EACH	2
613	CONCRETE FOUNDATION PAD	EACH	3
613	LUMINAIRE HIGH PRESSURE SODIUM (400 WATT)	EACH	2

INTERCHANGE LIGHTING PLAN
JERRY MURPHY ROAD

DESIGNED BY
CHECKED BY
IN CHARGE
DATE
CHECKED BY
QUANTITIES BY
CHECKED BY
DATE
PROJECT NO.
SHEET NO.
TOTAL SHEETS

REVISIONS	BY	DATE	DESCRIPTION

PROJECT NO.	STA 0471-020
SHEET NO.	95
TOTAL SHEETS	

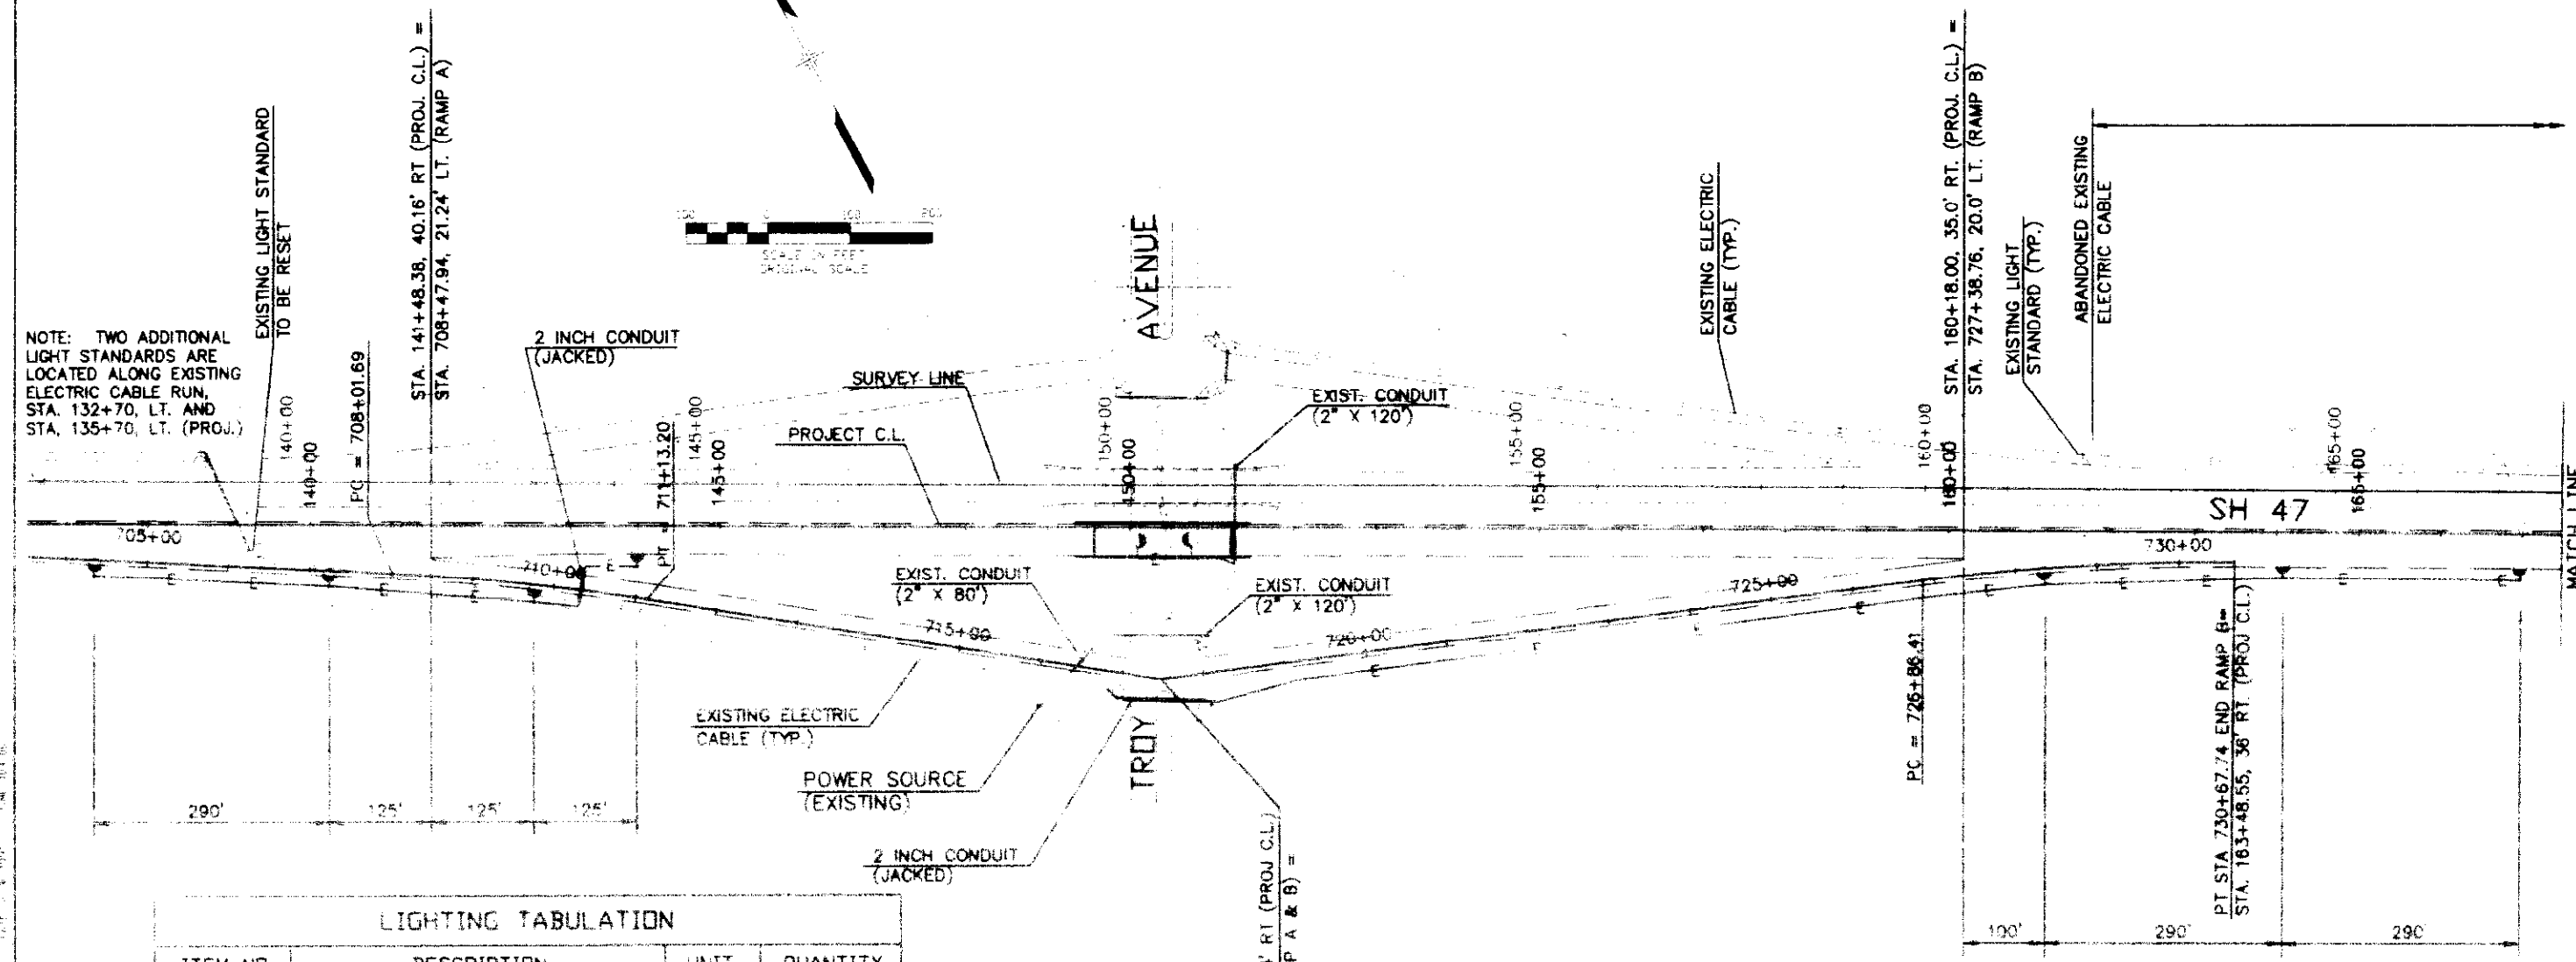

LIGHTING TABULATION			
ITEM NO	DESCRIPTION	UNIT	QUANTITY
210	RESET LIGHT STANDARD	EACH	1
210	RESET LUMINAIRE	EACH	1
613	2 INCH ELECTRICAL CONDUIT (JACKED)	LIN. FT.	140
613	2 INCH ELECTRICAL CONDUIT (PLASTIC)	LIN. FT.	2550
613	WIRING	L.S.	0.48
613	LIGHT STANDARD METAL (40 FOOT)	EACH	6
613	CONCRETE FOUNDATION PAD	EACH	7
613	LUMINAIRE HIGH PRESSURE SODIUM (WALL TYPE)(100 WATT)	EACH	2
613	LUMINAIRE HIGH PRESSURE SODIUM (400 WATT)	EACH	6

NOTES:

FOR EXISTING LIGHT STANDARDS DESIGNATED TO BE RESET, THE EXISTING CONCRETE FOUNDATION PAD AND EXPOSED ELECTRICAL WIRING SHALL BE REMOVED. THE REMOVAL AND DISPOSAL OF EXISTING CONCRETE FOUNDATIONS AND WIRING SHALL NOT BE MEASURED AND PAID FOR SEPARATELY, BUT WILL BE INCLUDED IN BID ITEM 210 RESET LIGHT STANDARD.


EXISTING ELECTRICAL INFORMATION WAS TAKEN FROM BEST AVAILABLE SOURCES. CONTRACTOR TO FIELD VERIFY EXISTING ELECTRICAL FACILITY LOCATIONS.

SCHEDULE 80 ELECTRICAL CONDUIT SHALL BE USED FOR ALL ROAD CROSSINGS. ALL OTHER CONDUIT MAY BE SCHEDULE 40.

INTERCHANGE LIGHTING PLAN
TROY AVENUE

REVISIONS	DATE	BY	APP'D

PROJECT NO.	DIVISION	PROJECT NO.	SHEET NO.	SHEET TOTALS
			96	

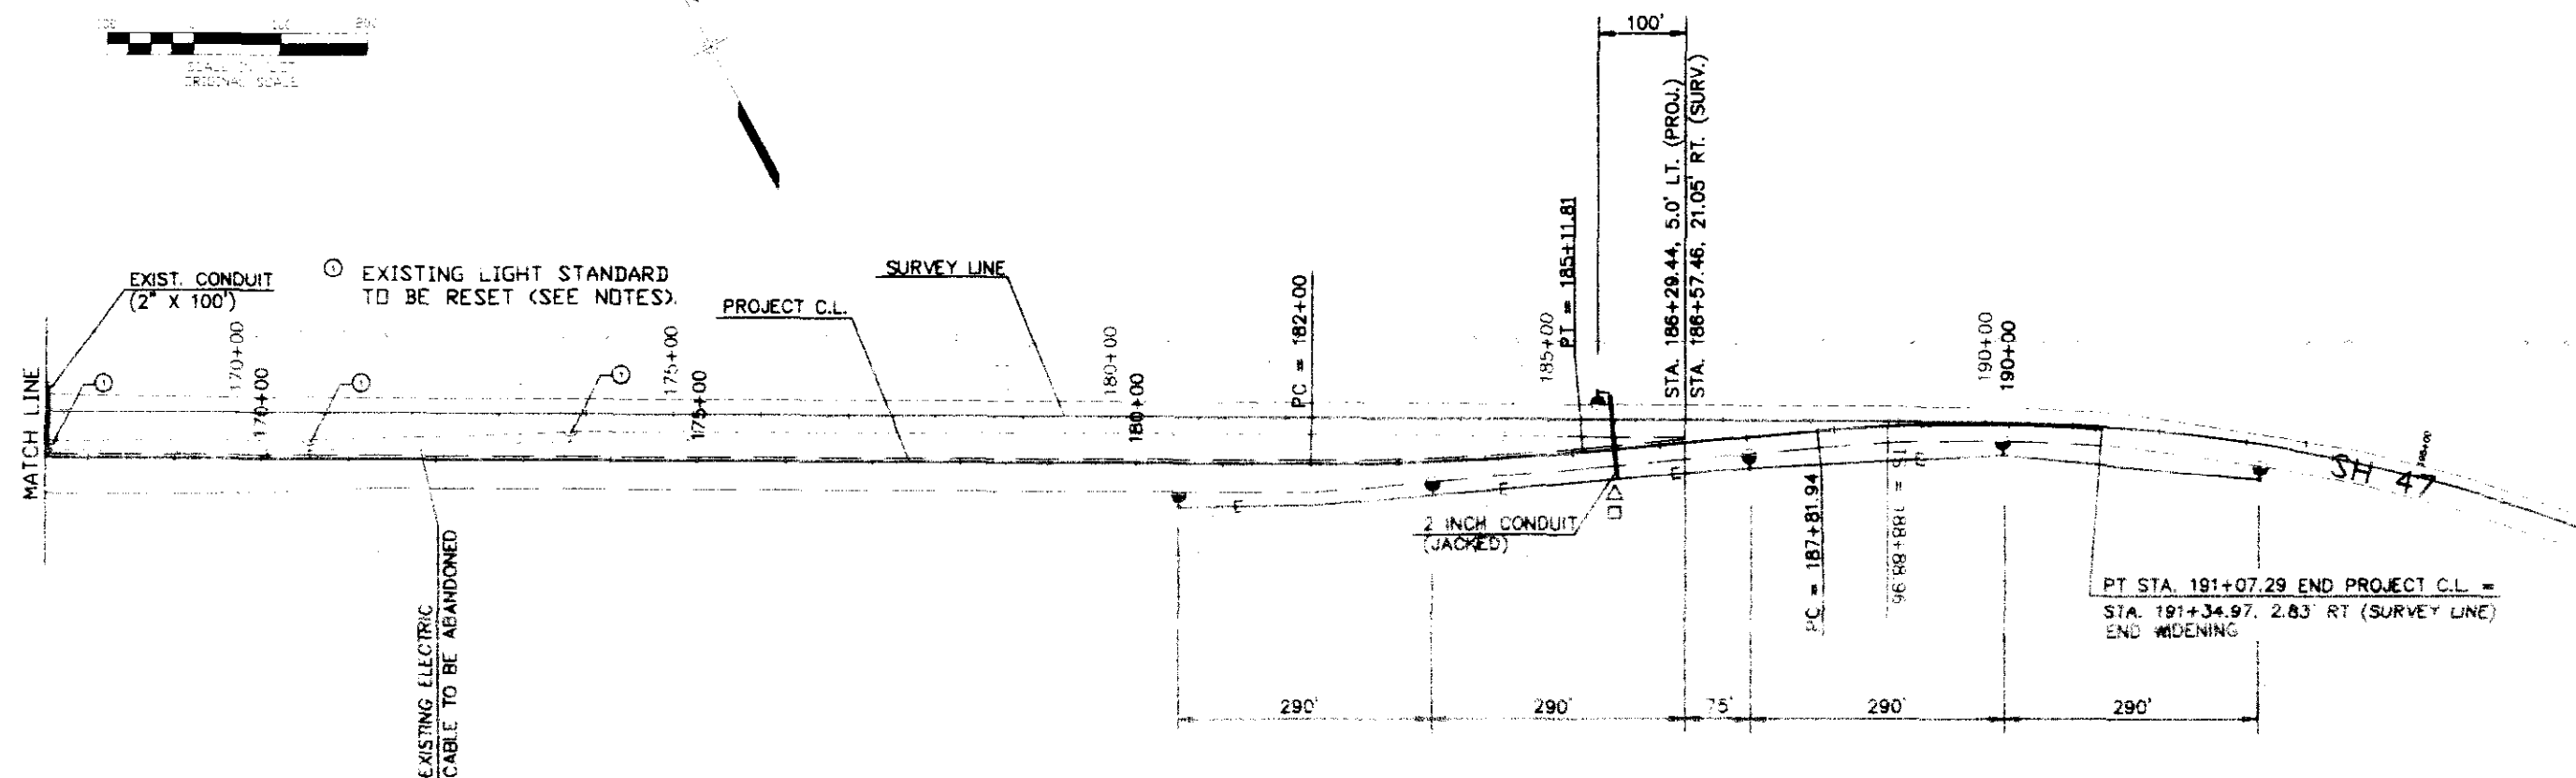

DESIGNED BY	CHECKED BY	DATE	INITIAL
QUANTITIES BY	CHECKED BY	DATE	INITIAL

LIGHTING TABULATION			
ITEM NO.	DESCRIPTION	UNIT	QUANTITY
210	RESET LIGHT STANDARD	EACH	3
210	RESET LUMINAIRE	EACH	3
613	2 INCH ELECTRICAL CONDUIT (JACKED)	LIN. FT.	90
613	2 INCH ELECTRICAL CONDUIT (PLASTIC)	LIN. FT.	1350
613	WIRING	L.S.	0.26
613	LIGHT STANDARD METAL (40 FOOT)	EACH	3
613	CONCRETE FOUNDATION PAD	EACH	6
613	LUMINAIRE HIGH PRESSURE SODIUM (400 WATT)	EACH	3

NOTES:

FOR EXISTING LIGHT STANDARDS DESIGNATED TO BE RESET, THE EXISTING CONCRETE FOUNDATION PAD AND EXPOSED ELECTRICAL WIRING SHALL BE REMOVED. THE REMOVAL AND DISPOSAL OF EXISTING CONCRETE FOUNDATIONS AND WIRING SHALL NOT BE MEASURED AND PAID FOR SEPARATELY, BUT WILL BE INCLUDED IN BID ITEM 210 RESET LIGHT STANDARD.

EXISTING ELECTRICAL INFORMATION WAS TAKEN FROM BEST AVAILABLE SOURCES. CONTRACTOR TO FIELD VERIFY EXISTING ELECTRICAL FACILITY LOCATIONS.

POWER SOURCE TO SERVICE THE ROADWAY TRANSITION AREA SHOWN ABOVE TO BE PROVIDED BY WEST PLAINS ELECTRIC, AND TO BE COORDINATED BY THE CONTRACTOR. WEST PLAINS ELECTRIC WILL EXTEND UNDERGROUND CABLE ON THE SOUTH SIDE OF SH47, FROM THE TROY AVE. INTERCHANGE TO STA. 190+00. THIS WORK WILL BE COORDINATED WITH CONSTRUCTION.

SCHEDULE 80 ELECTRICAL CONDUIT SHALL BE USED FOR ALL ROAD CROSSINGS. ALL OTHER CONDUIT MAY BE SCHEDULE 40.

△ POWER SOURCE CONNECTION
□ POWER SOURCE TO BE INSTALLED BY OWNER

IT IS ESTIMATED THAT 1 POWER SOURCE CONNECTION WILL BE REQUIRED. IT SHALL BE PAID FOR UNDER THE FORCE ACCOUNT ITEM "INSTALL POWER SOURCE CONNECTION."

IT IS ESTIMATED THAT 1 POWER SOURCE FOR HIGHWAY LIGHTING WILL BE REQUIRED. IT SHALL BE PAID FOR UNDER THE FORCE ACCOUNT ITEM "POWER SOURCE FOR HIGHWAY LIGHTING."


LIGHTING PLAN
AT ROADWAY TRANSITION

PROJECT NO.		LOCATION	SECTION	SHEET NO.	SHEET TOTAL
100-100-100		CDL 00-11	STA 0471-020	97	
REVISIONS					

Power Source and Meter Pedestal Details

STATE PERMIT AND INSPECTION REQUIRED.

POWER SOURCE CONNECTION METER PEDESTAL

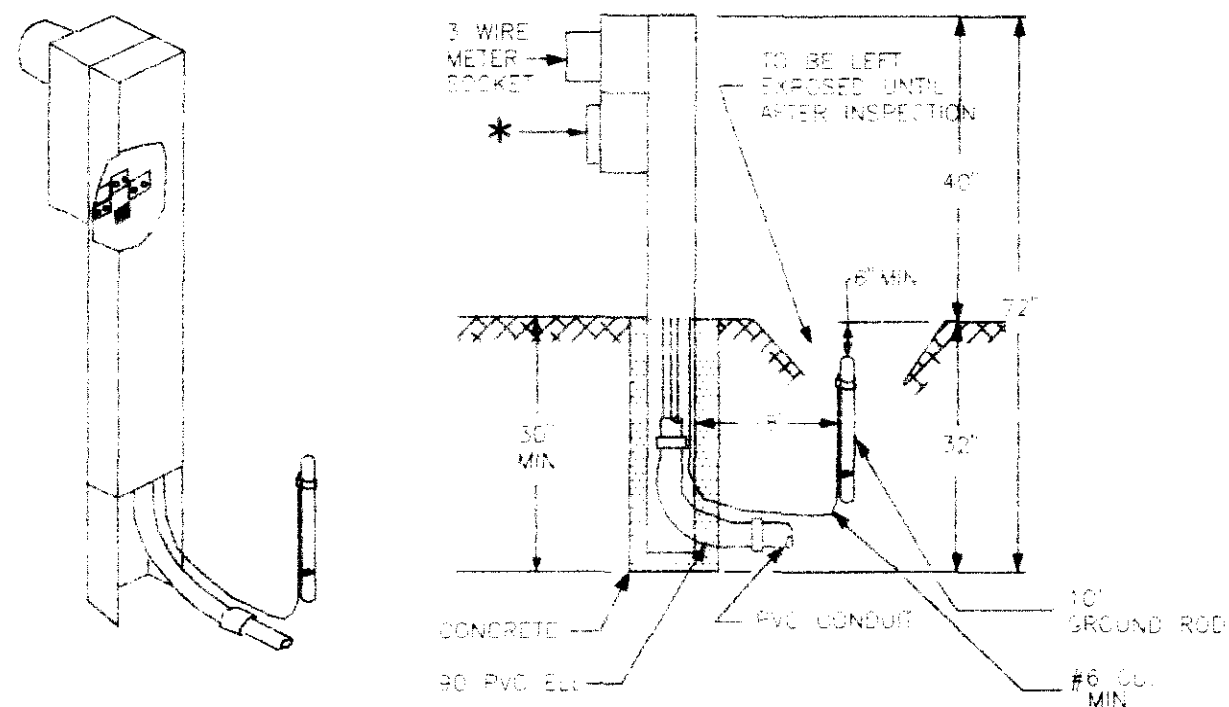

* NOTES

One two pole meter disconnect 120/240 volt 3 wire circuit breaker rated at 50 AMPS. Equipped with 4 or 6 - 20 AMP breakers.

Pedestal shall be weatherproof

ALL NON-CURRENT CARRYING METALLIC PARTS TO BE EFFECTIVELY GROUNDED


DESIGNED BY	CHECKED BY
CHECKED BY	QUANTITIES BY
INITIAL	DATE

DATE: 9-20-1990 TIME: 1400H

DRAWING NAME: D-DATA/1718-CADREDA-RIVER


FILE NAME

REVISIONS	DATE	BY	APP'D	REASON	SHEET NO.	SHEET TOTAL
1. REVISIONS					98	
REVISIONS						

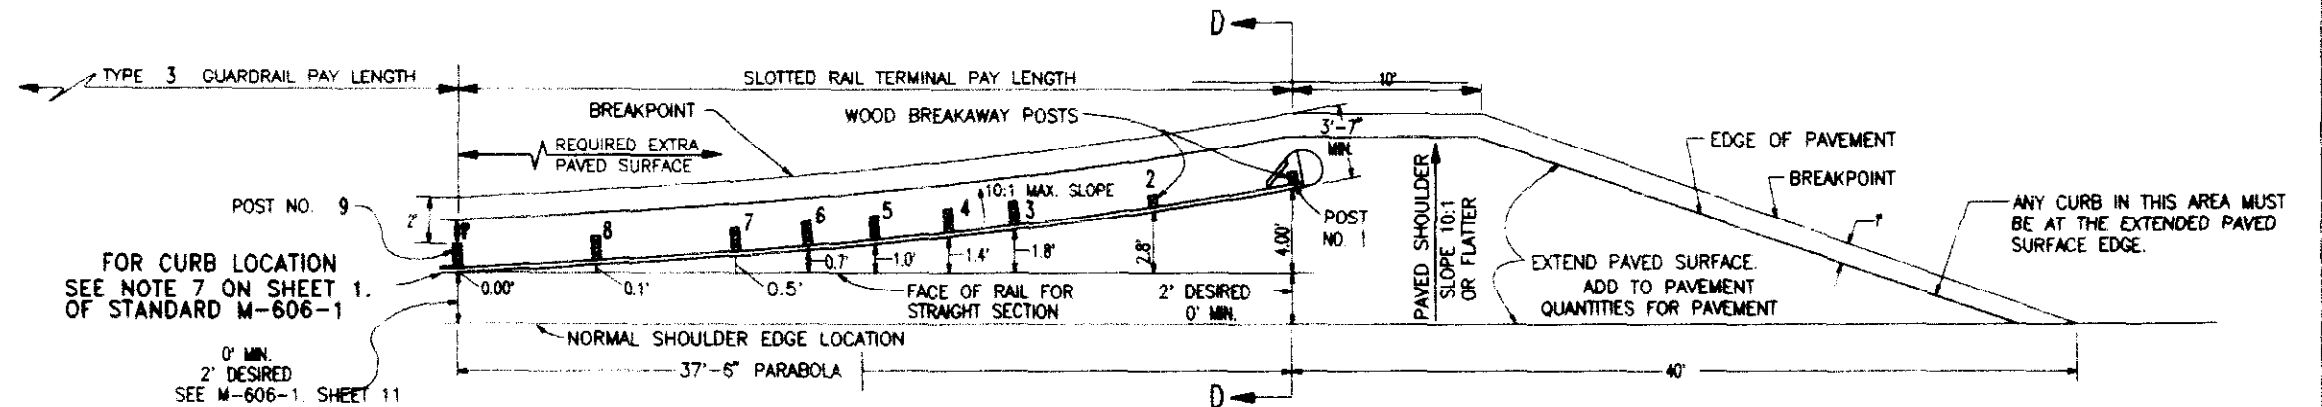


PLAN VIEW


END ANCHORAGE (SLOTTED RAIL TERMINAL)

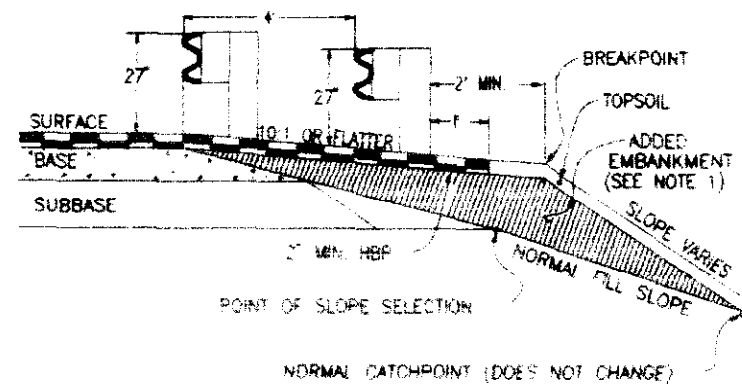

VIEW D-D

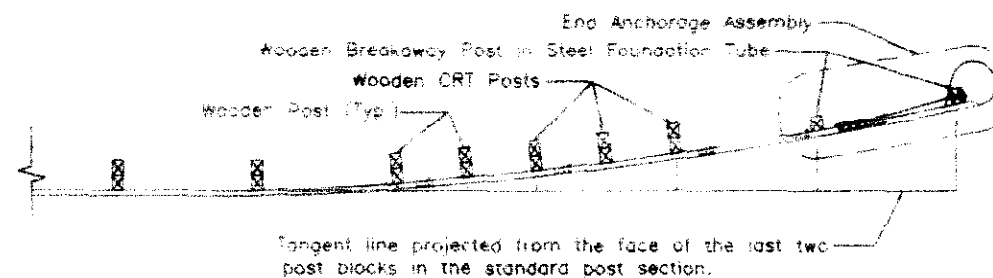

PLAN VIEW

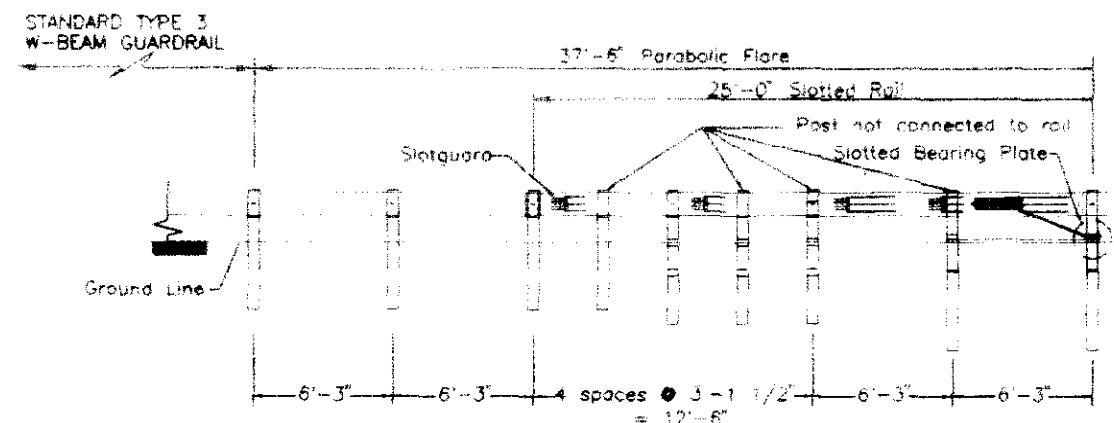


ELEVATION

SLOTTED RAIL TERMINAL

- PAYMENT FOR THE ADDED EMBANKMENT (APPROXIMATELY 60 CU.YDS.) FOR THE FLARE SHALL BE AS FOLLOWS:
 - UNDER PAY ITEM 203 WHEN THE CONTRACT PLAN INCLUDES PAY ITEM 203
 - INCLUDED IN THE COST OF END ANCHORAGE, TYPE SRT, ITEM 606 PAY ITEM WHEN THE CONTRACT PLAN DOES NOT INCLUDE PAY ITEM 203.

ENGLISH UNITS

COLORADO
DEPARTMENT OF TRANSPORTATION
**GUARDRAIL
END ANCHORAGE
(SLOTTED RAIL TERMINAL)**

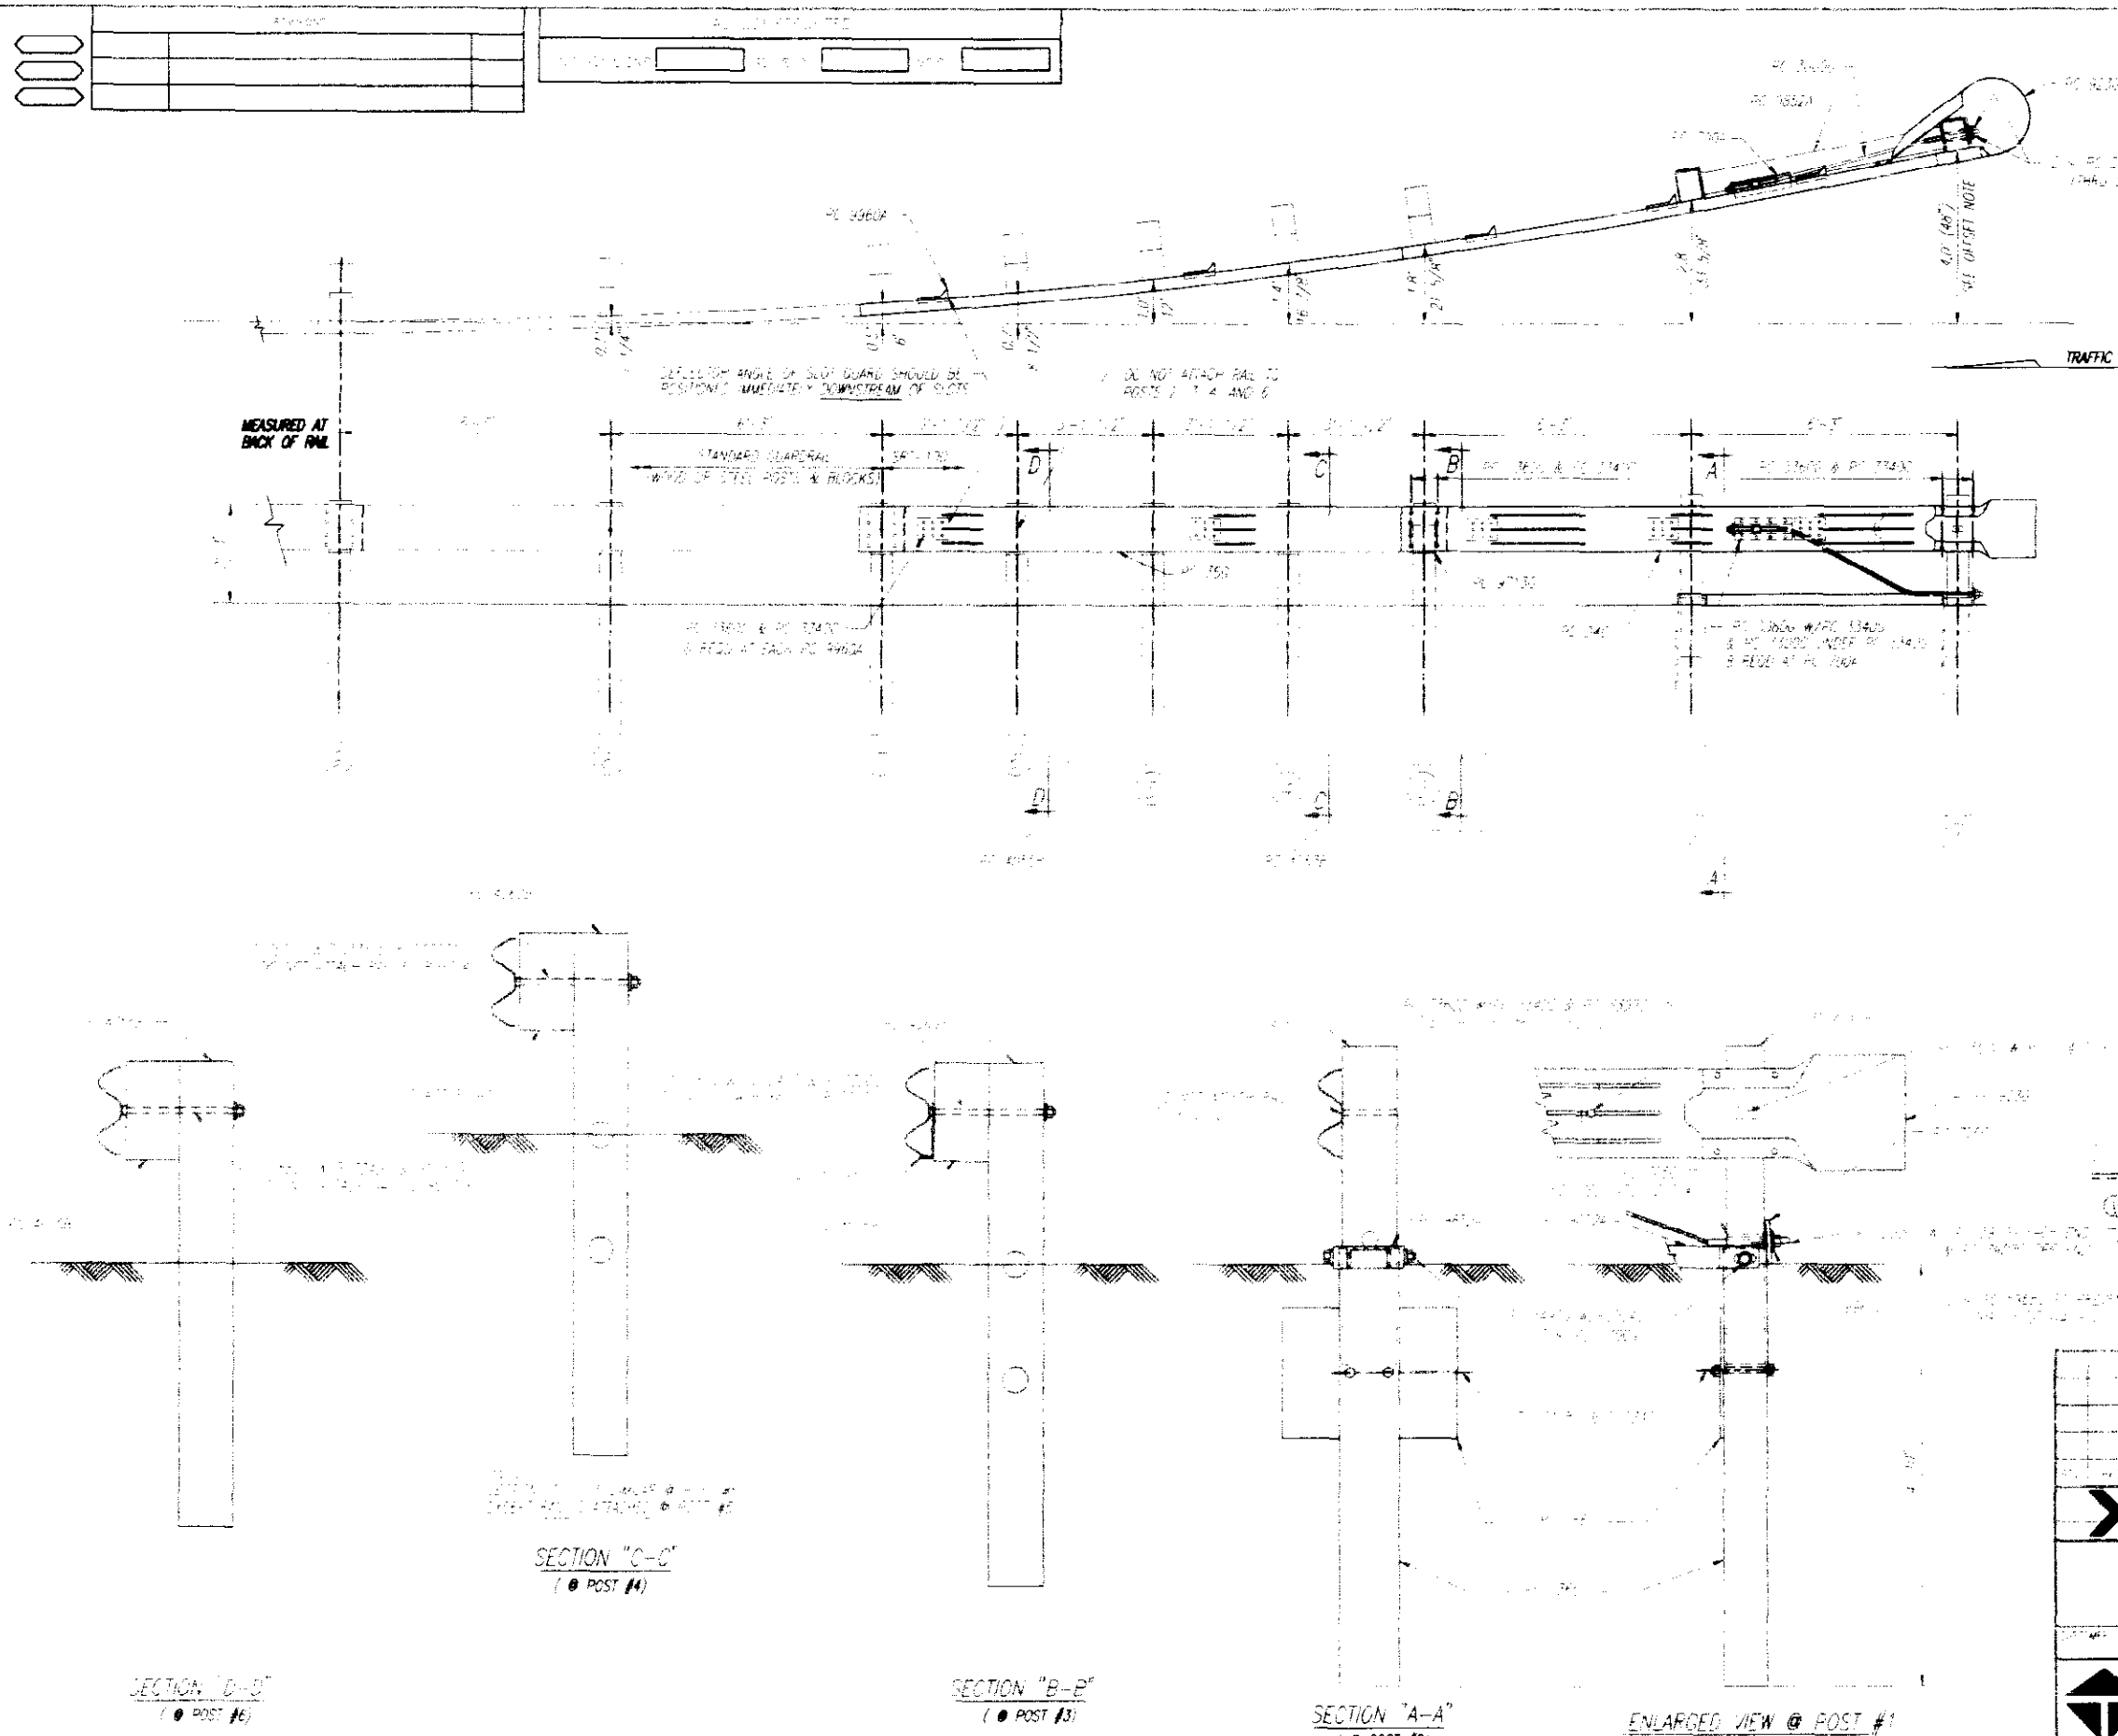

OFFSET NOTE:
THE POST OFFSET DIMENSIONS ARE GIVEN TO THE CENTER OF THE TRAFFIC FACE OF THE BLOCKOUTS, EXCEPT AT THE FIRST TWO POSTS, WHERE THE DIMENSION IS TO THE CENTER OF THE TRAFFIC FACE OF THE POST. OFFSET POINTS ARE TO BE LOCATED BY CHORD MEASUREMENTS AT THE BACK OF THE RAIL EQUAL TO THE NOMINAL POST SPACING SHOWN. POSTS ARE TO BE SET APPROXIMATELY RADIAL TO THE RAILING AT EACH POST LOCATION.

BILL OF MATERIAL		
PC	QTY	DESCRIPTION
346	1	12/12/6/S SRT-1 (GUARDRAIL)
356	1	12/12/6/8/3/S SRT-2 (GUARDRAIL)
700A	1	CABLE ANCHOR BRACKET
705G	1	2" x 5 1/2" PIPE
736G	2	50 TUBE SLEEVE
766G	2	1/4 x 18 x 24 SOIL PLATE
775G	1	5/8 x 6 x 8 BEARING PLATE
923G	1	12/BARRIER/98" (TERMINAL)
3000G	1	3/4 x 6'6" CABLE
3300G	18	5/8" WASHER
3320G	1	3/16 x 1 3/4 x 3 WASHER
3340G	72	5/8" HEX NUT
3360G	53	5/8" x 1 1/4" SPLICE BOLT
3380G	8	5/8" x 1 1/2" HEX HD BOLT
3478G	4	5/8" x 7 1/2" HEX HD BOLT
3497G	2	5/8" x 9 1/2" HEX HD BOLT
3500G	1	5/8" x 10" POST BOLT
3580G	4	5/8" x 18" POST BOLT
3900G	2	1" WASHER
3910G	2	1" HEX NUT
4055B	1	5/4 POST 6 x 8
4063B	3	6/10 POST 6 x 8
4075B	4	14" BLOCK 6 x 8
4147B	2	7 9 POST 5 1/2 x 7 1/2
5968G	2	16d NAIL SRT
9713G	1	SHELF ANGLE
9852A	1	STRUT ASSEMBLY
9960A	5	SLOT GUARD
9961G	1	3/8 x 3 x 4 PLATE WASHER

REMARKS

STRT-100


SLOTTED RAIL TERMINAL (SRT-100)
POST LAYOUT AND ERECTION DETAILS

TRINITY INDUSTRIES, INC.

SS 400

DATE	DESIGNED BY	CHECKED BY	QUANTITIES BY	CHECKED BY

AS CONSTRUCTED	FEEDBACK	REVISIONS	SHEET NO.	SHEET TOTALS
			100	

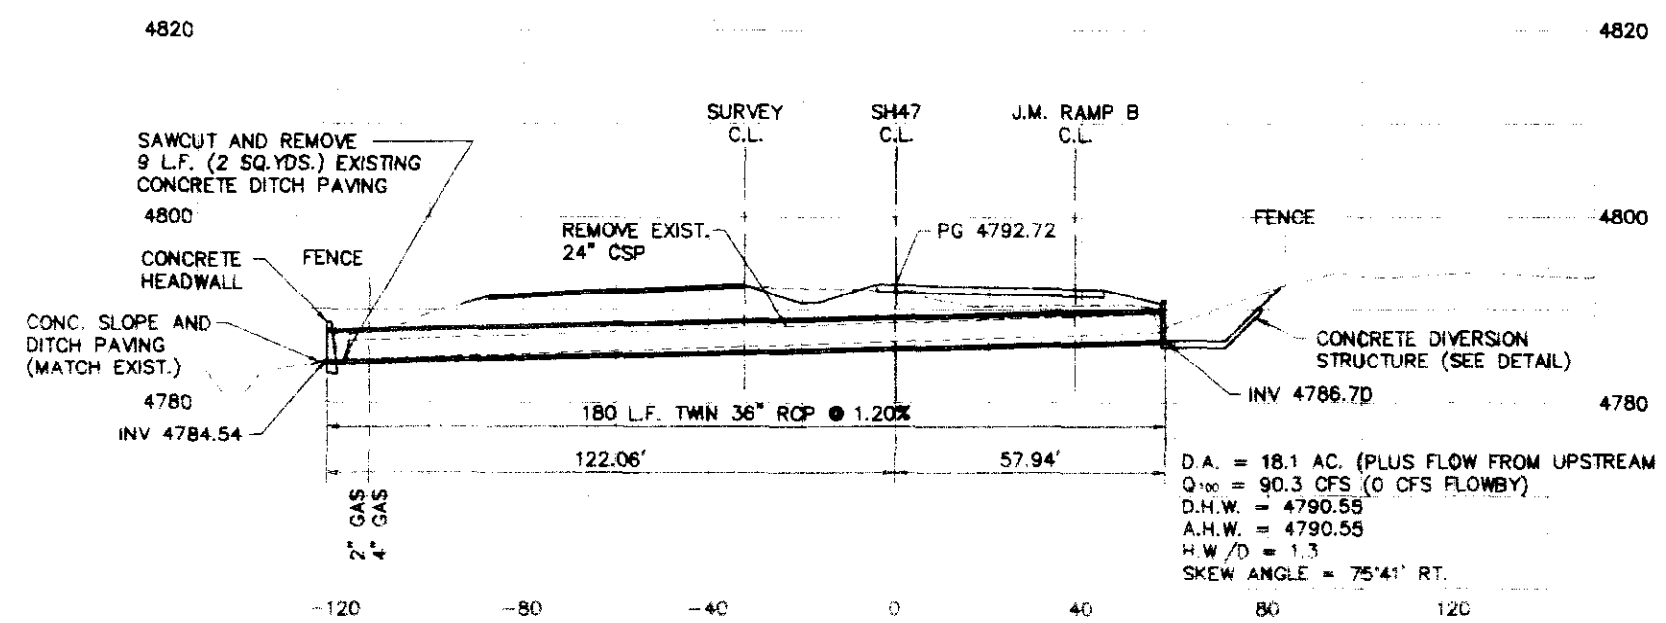


STA. 76+15.39

TWIN 36" REINFORCED CONCRETE PIPES

STA. 76+15.39 REQ'D. ~ REMOVE 175 LF EXIST. 24" CSP. INSTALL 180 LF TWIN 36" RCP WITH CONC. HEADWALL, LT. & CONCRETE DIVERSION STRUCTURE, RT.

D.A. = 18.1 AC. (PLUS FLOW FROM UPSTREAM BASIN)
Q₁₀₀ = 90.3 CFS (0 CFS FLOWBY)
D.H.W. = 4790.55
A.H.W. = 4790.55
H.W./D = 1.3
SKEW ANGLE = 75°41' RT.

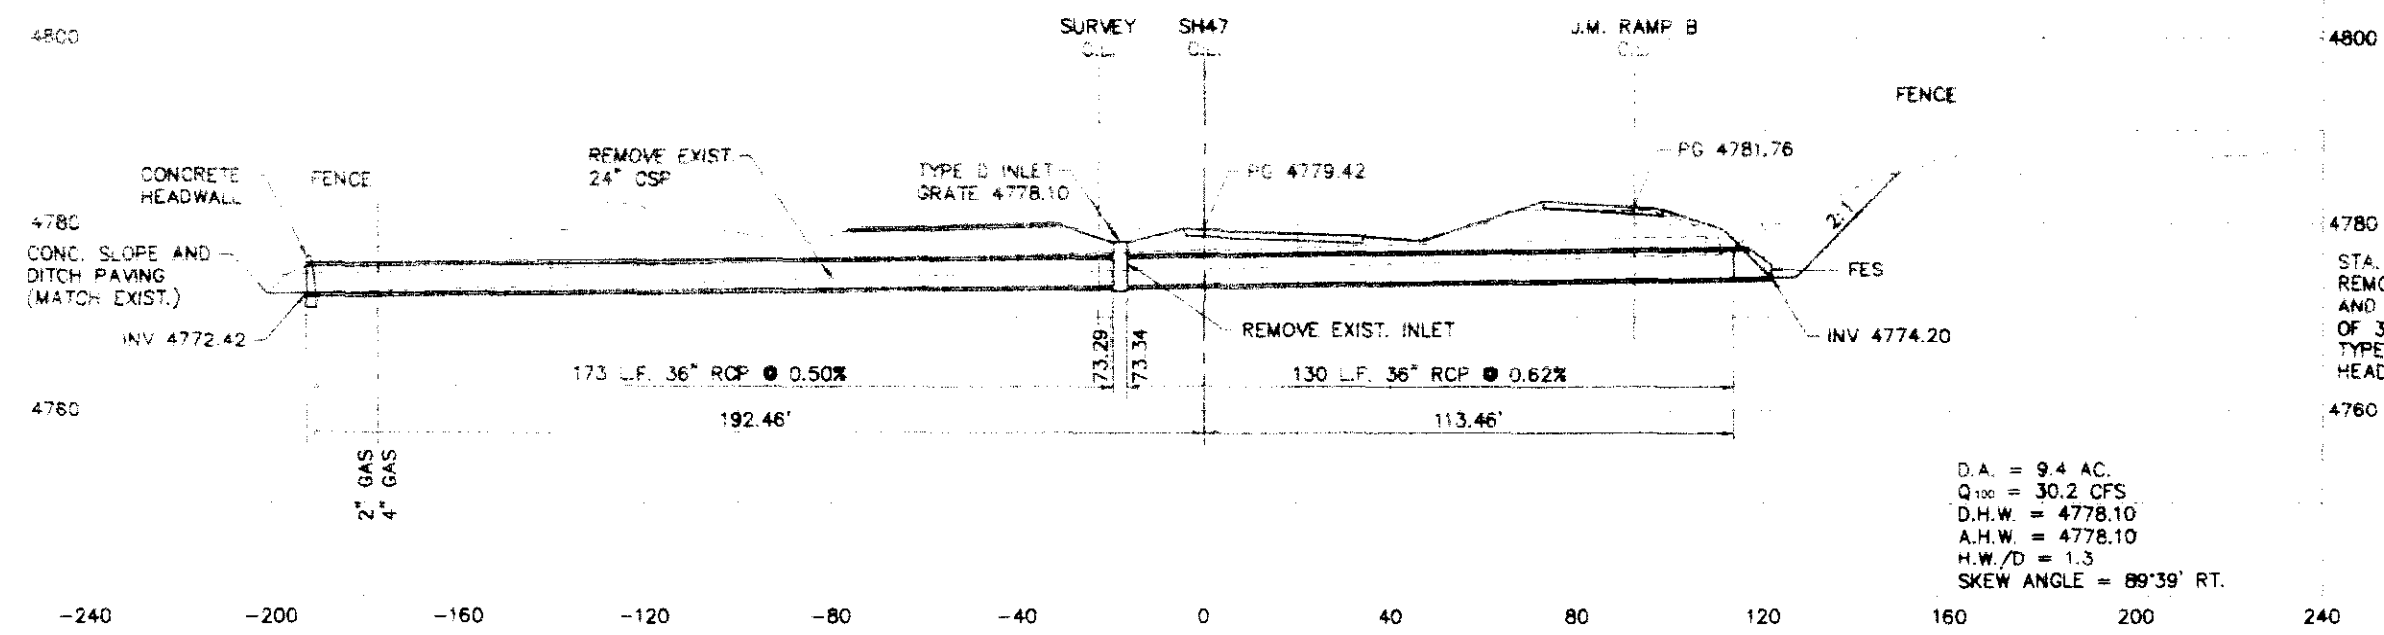

STA. 71+45.41

36" REINFORCED CONCRETE PIPE

D.A. = 9.4 AC.
Q₁₀₀ = 30.2 CFS
D.H.W. = 4778.10
A.H.W. = 4778.10
H.W./D = 1.3
SKEW ANGLE = 89°39' RT.


STA. 71+45.41 REQ'D. ~ REMOVE 313 LF EXIST. 24" CSP AND INLET. INSTALL 303 LF OF 36" RCP WITH END SECTION, TYPE D INLET 18' LT. & CONC. HEADWALL, LT.

ORIGINAL SCALES: 1"=20' HORIZONTAL
1"=10' VERTICAL

NO. REVISIONS			APPROVED			VOID		
---------------	--	--	----------	--	--	------	--	--

FEED ROAD SECTION	DIVISION	PROJECT NO.	SHEET NO.	SHEET TOTALS
W	COLORADO	STA 0471-020	101	

REVENUES		

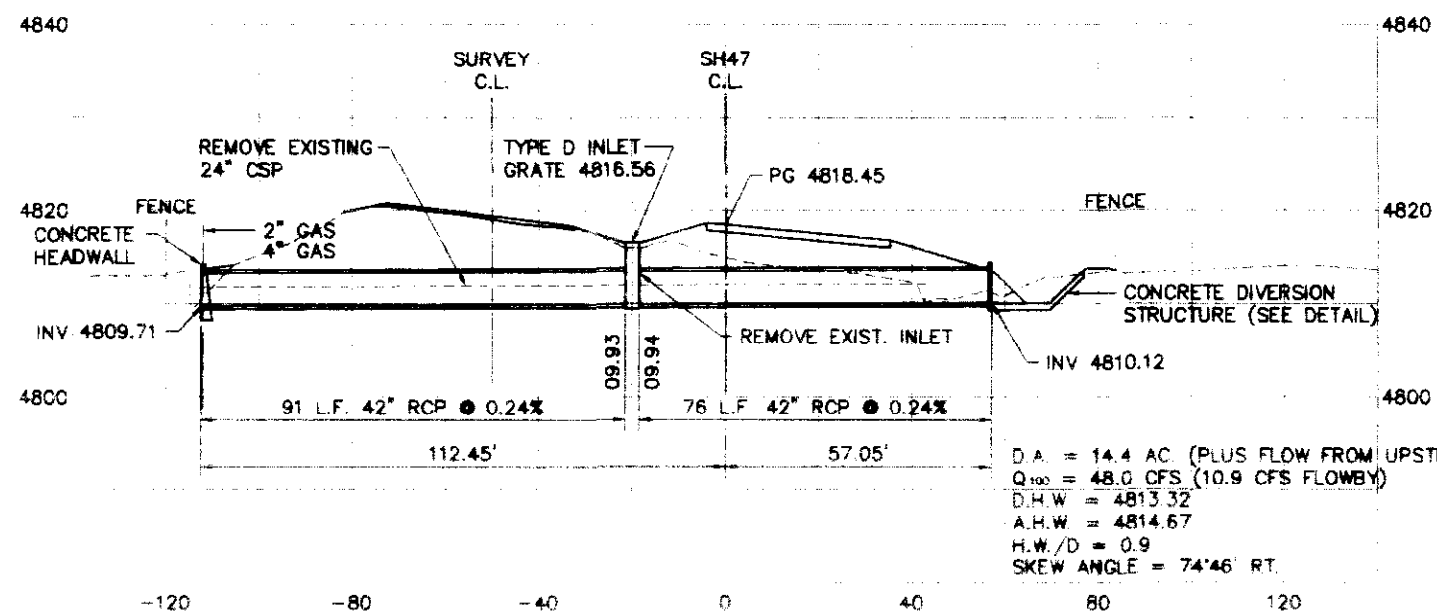


STA. 86+08.23, RT ~ REQ'D.
REMOVE 155 LF EXIST. 24" CSP
& EXIST. INLET
INSTALL 167 LF 42" RCP WITH
CONC. HEADWALL, LT.
TYPE D INLET LT. W/ CONCRETE
DIVERSION STRUCTURE, RT.

D.A. = 14.4 AC (PLUS FLOW FROM UPSTREAM BASIN)
 Q₁₀₀ = 48.0 CFS. (10.9 CFS FLOWBY)
 D.H.W. = 4813.32
 A.H.W. = 4814.67
 H.W./D = 0.9
 SKEW ANGLE = 74°46' RT.

STA. 86+08.23

42" REINFORCED CONCRETE PIPE

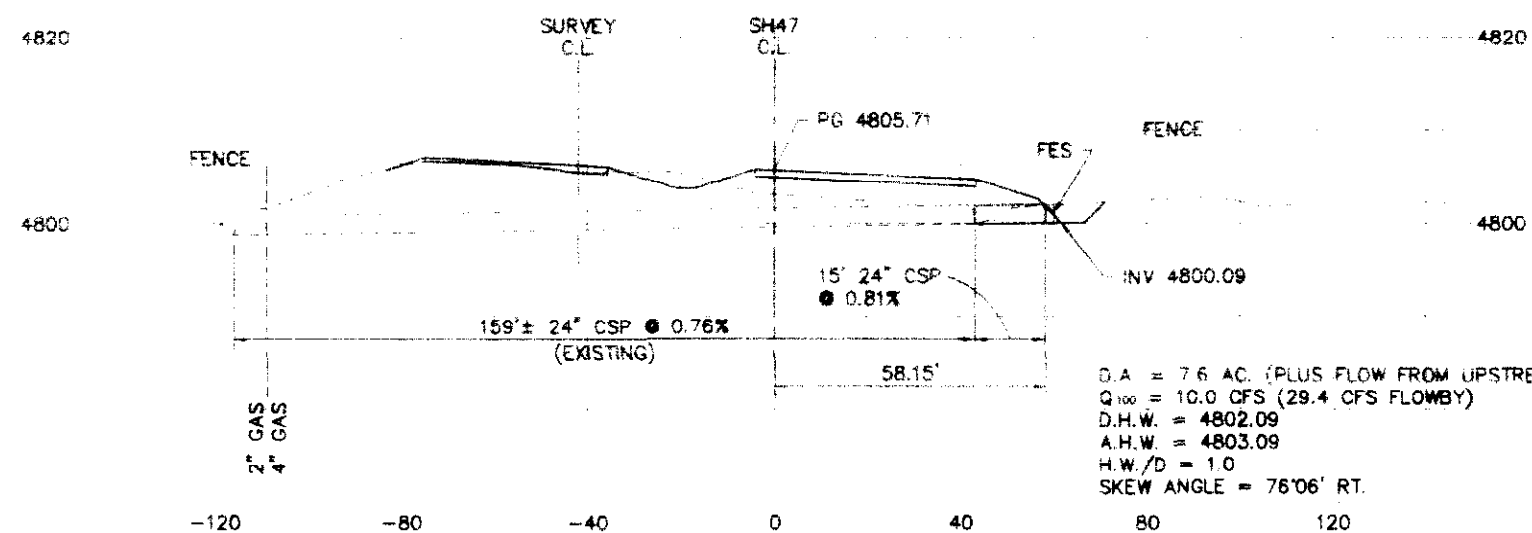

STA. 81+13.24, RT.
REQ'D. EXTEND EXIST.
24" CSP 15 LF W/ RIPRAP
BERM & END SECTION, RT.

D.A. = 7.6 AC. (PLUS FLOW FROM UPSTREAM BASIN)
 Q₁₀₀ = 10.0 CFS (29.4 CFS FLOWBY)
 D.H.W. = 4802.09
 A.H.W. = 4803.09
 H.W./D = 1.0
 SKEW ANGLE = 76°06' RT.

STA. 81+13.24


24" CORRUGATED STEEL PIPE

ORIGINAL SCALES: 1"=20' HORIZONTAL
1"=10' VERTICAL


NO TELEVISIONS [] ALCOHOL [] VIO []

FILE NO.	DIVISION	PROJECT NO.	SHEET NO.	SHEET TOTAL
V	COLORADO	STA 0471-020	102	

REVISIONS		

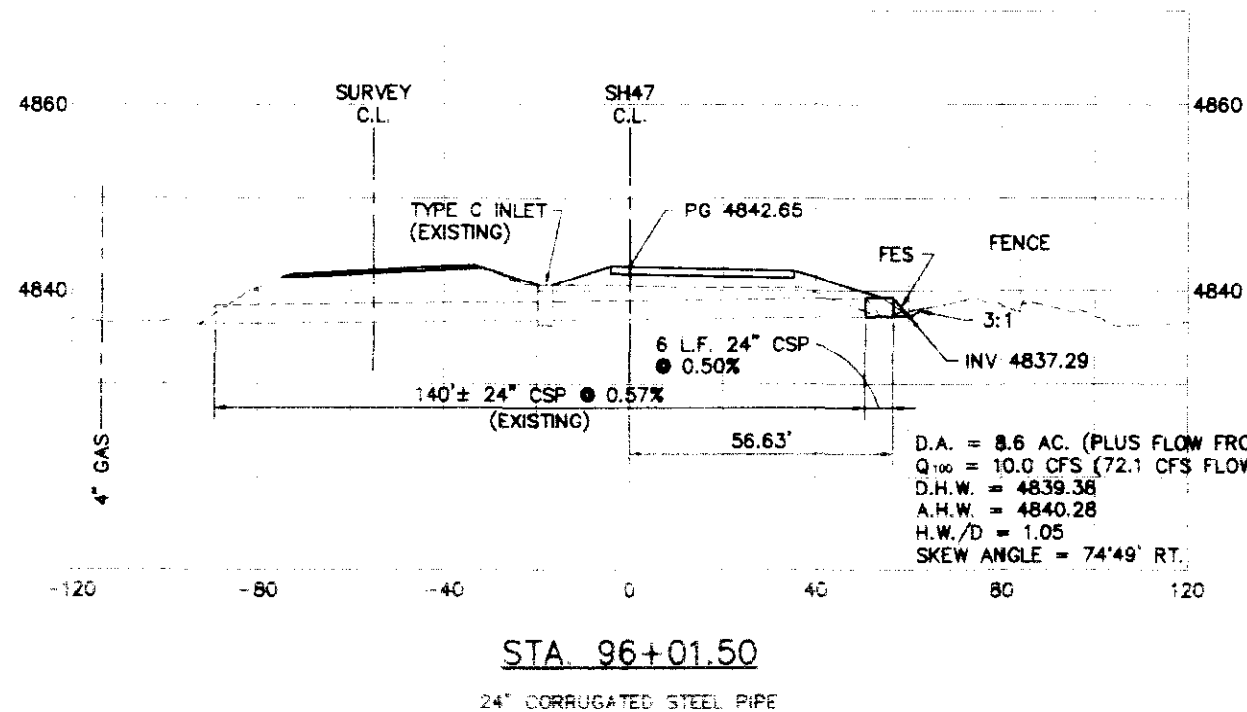

STA. 96+01, 50' RT. REQ.D" ~
EXTEND EXIST. 24" CSP 6 LF
WITH RIPRAP BERM &
END SECTION, RT.

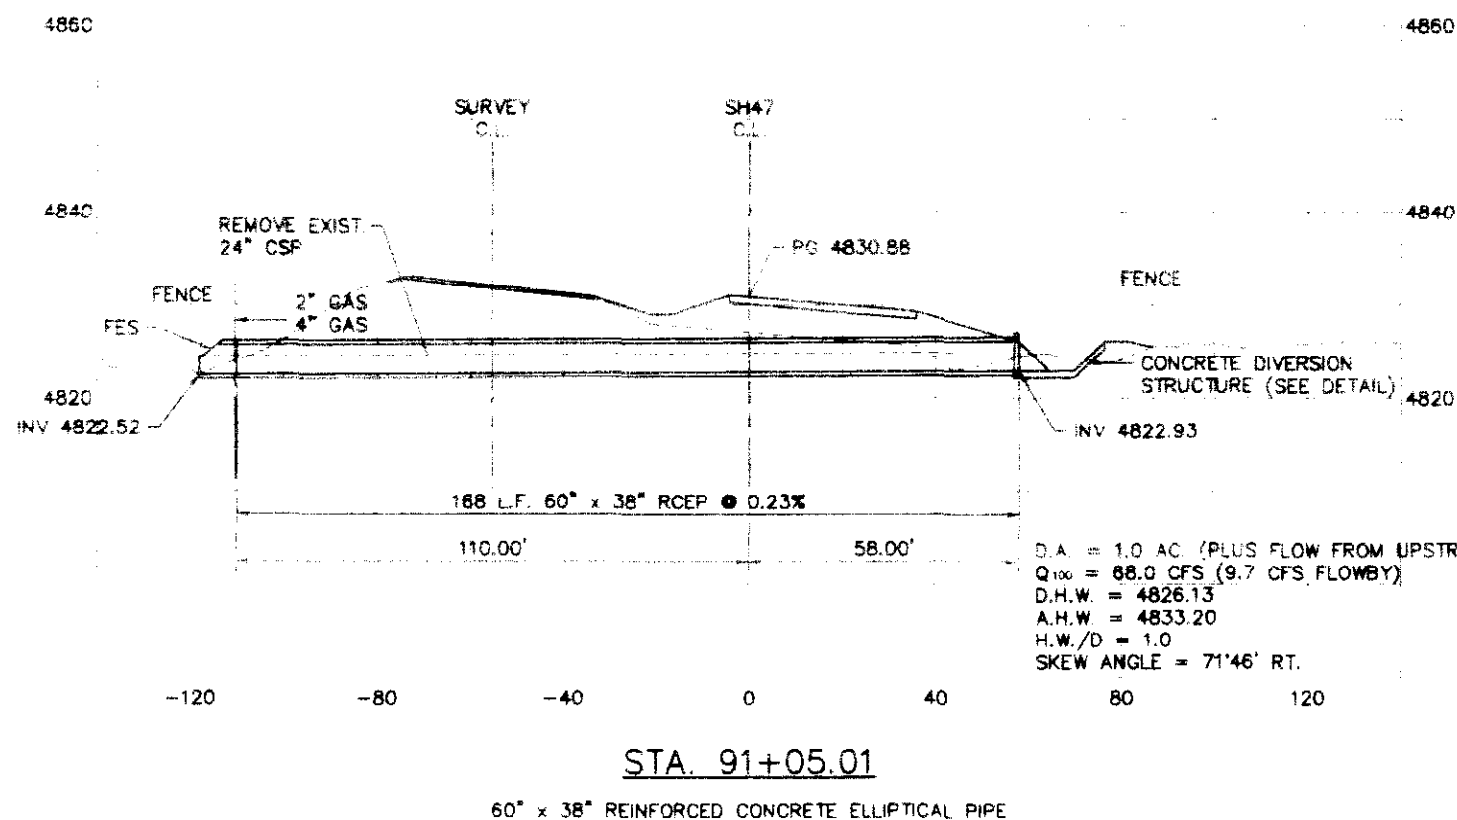


STA. 91+05.01, RT ~ REQ'D.
REMOVE 162 LF EXIST. 24" CSP
INSTALL 168 LF 60"x38" RCEP
W/ END SECTION & CONCRETE
DIVERSION STRUCTURE, RT.

ORIGINAL SCALES: 1"=20' HORIZONTAL
1"=10' VERTICAL

Xref'd Drawings

AS INSTRUCTED			FEE ROAD	DIVISION	PROJECT NO.	SHEET NO.	SHEET TOTALS
NO. OF LANE		FEET		COLORADO	STA 0471-020	103	

REVISIONS		

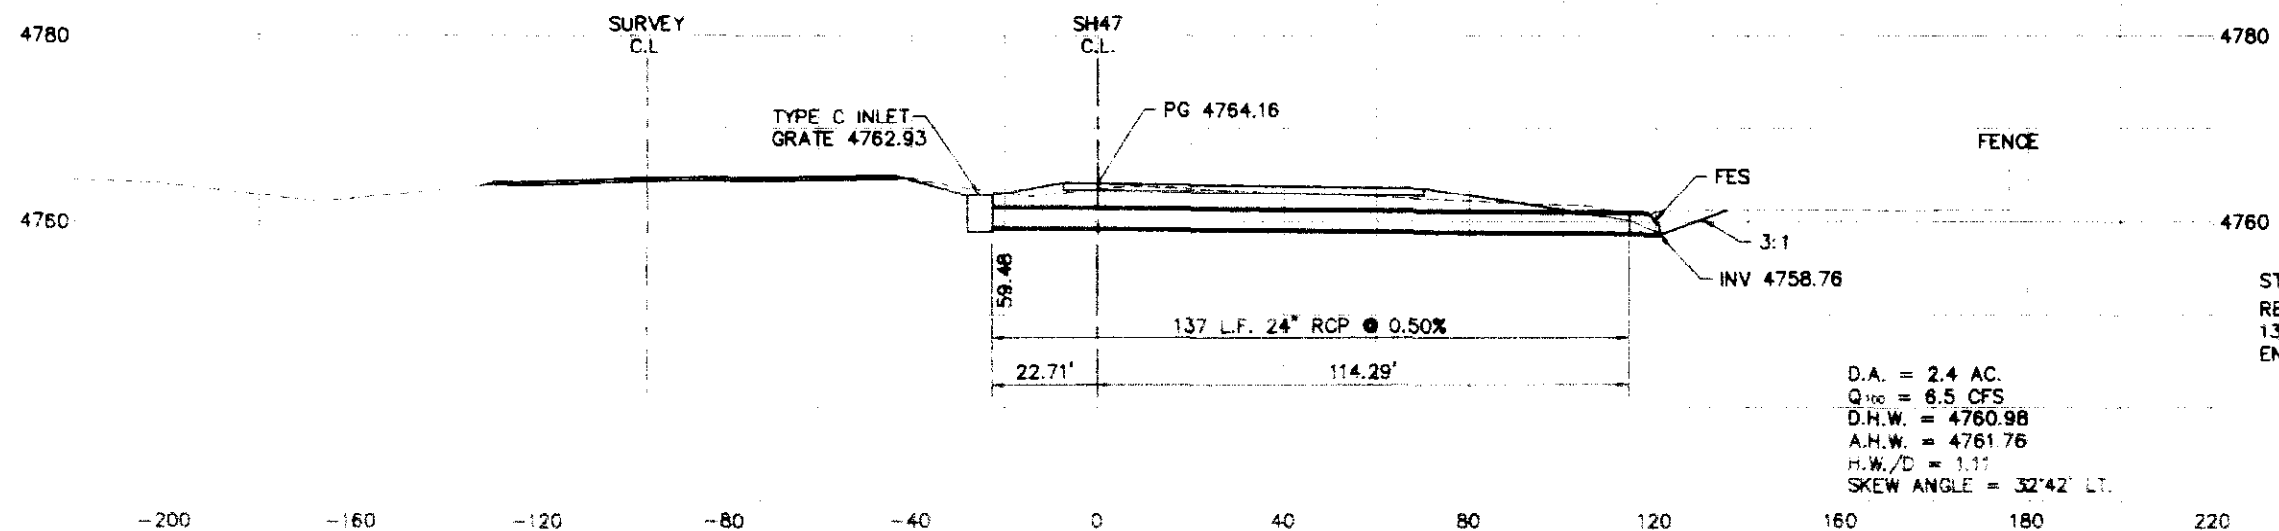


STA. 171+00.79, LT.
REQ'D. ~ TYPE C INLET &
137 LF OF 24" RCP AND
END SECTION, RT.

D.A. = 2.4 AC.
Q₁₀₀ = 6.5 CFS
D.H.W. = 4760.98
A.H.W. = 4761.76
H.W./D = 1.17
SKEW ANGLE = 32°42' LT.

STA. 171+00.79

24" REINFORCED CONCRETE PIPE

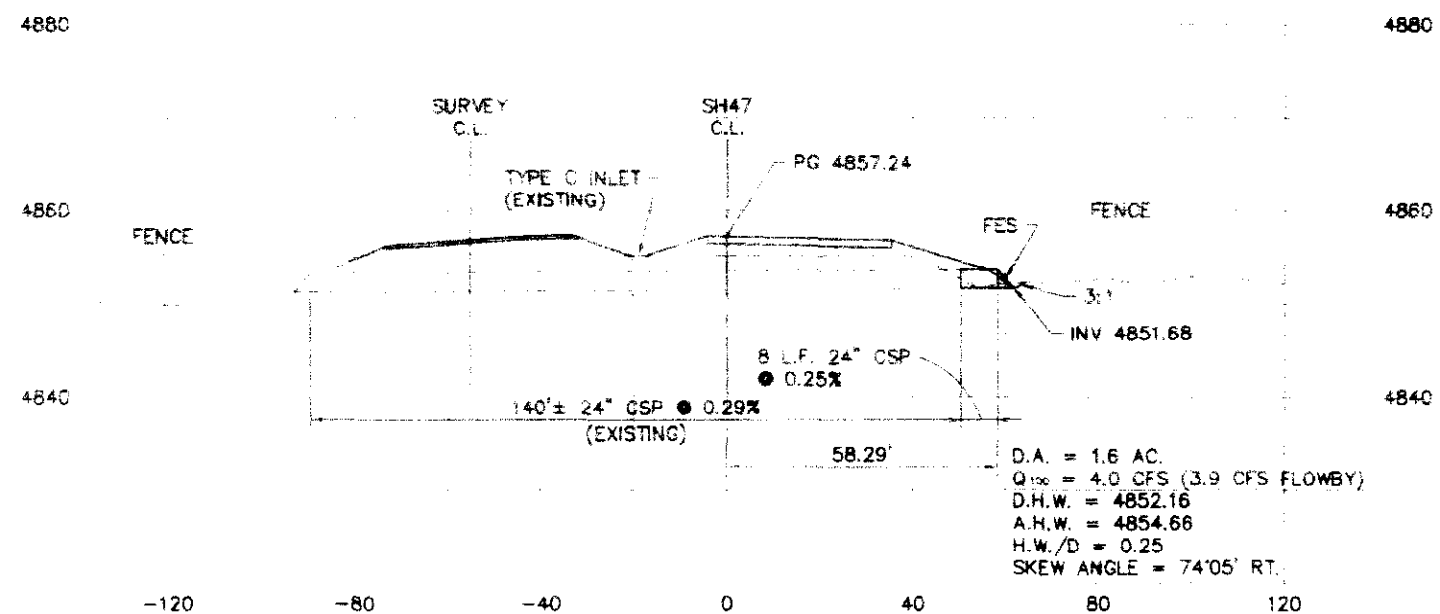

STA. 101+01.92, RT REQ'D. ~
EXTEND EXIST. 24" CSP 8 LF
W/ END SECTION, RT.

D.A. = 1.6 AC.
Q₁₀₀ = 4.0 CFS (3.9 CFS FLOWBY)
D.H.W. = 4852.16
A.H.W. = 4854.66
H.W./D = 0.25
SKEW ANGLE = 74°05' RT.

STA. 101+01.92

24" CORRUGATED STEEL PIPE

ORIGINAL SCALES: 1"=20' HORIZONTAL
1"=10' VERTICAL

Xref'd Drawings


100% RCP

DESIGNED BY	CHECKED BY	DATE	INITIAL	DATE	CHECKED BY	DATE	INITIAL

AS CORRECTED		
NO REVISIONS	REVISED	ADD

FEED ROAD	DIVISION	PROJECT NO.	SHEET NO.	SHEET TOTALS
V-1	COLORADO	STA 0471-020	104	

REVISIONS		

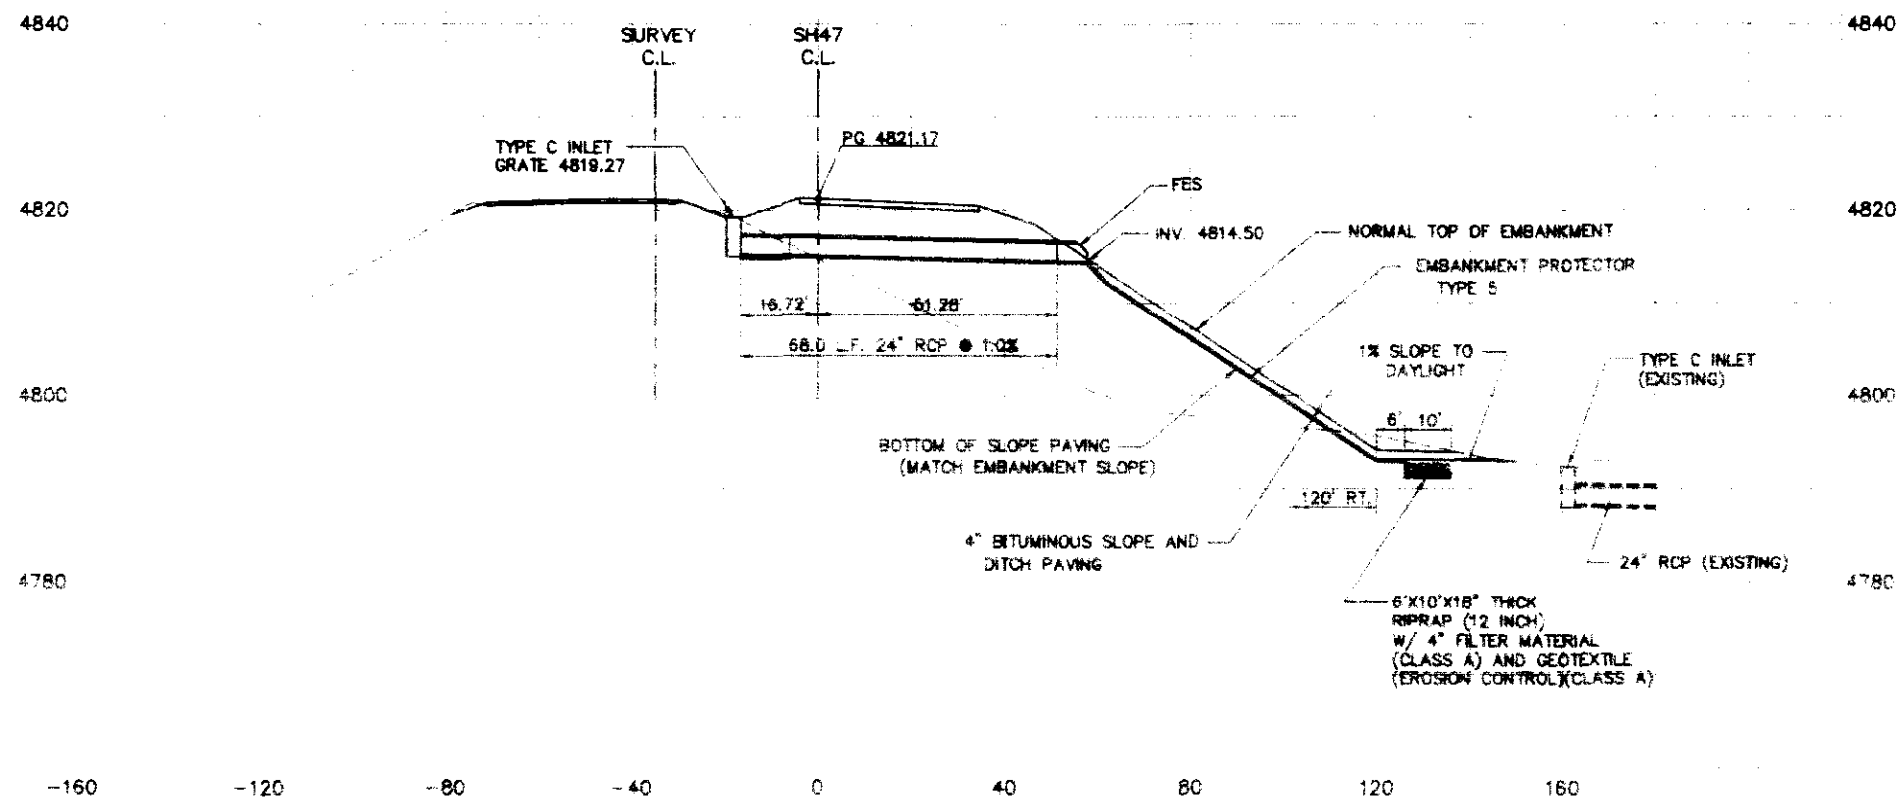

STA. 149+12.45, LT.
REQ'D. TYPE C INLET
& 68 LF 24" RCP
W/ END SECTION, RIPRAP
& GEOTEXTILE
REQ'D. EMBANKMENT
PROTECTOR, TYPE 5

STA. 149+12.45

24" REINFORCED CONCRETE PIPE

D.A. = 2.2 AC
Q₁₀₀ = 3.7 CFS
D.H.W. = 21.0'
A.H.W. = 21.0'
H.W./D = 1.0
SKEW ANGLE = 75°59' RT

ORIGINAL SCALES: 1"=20' HORIZONTAL
1"=10' VERTICAL