


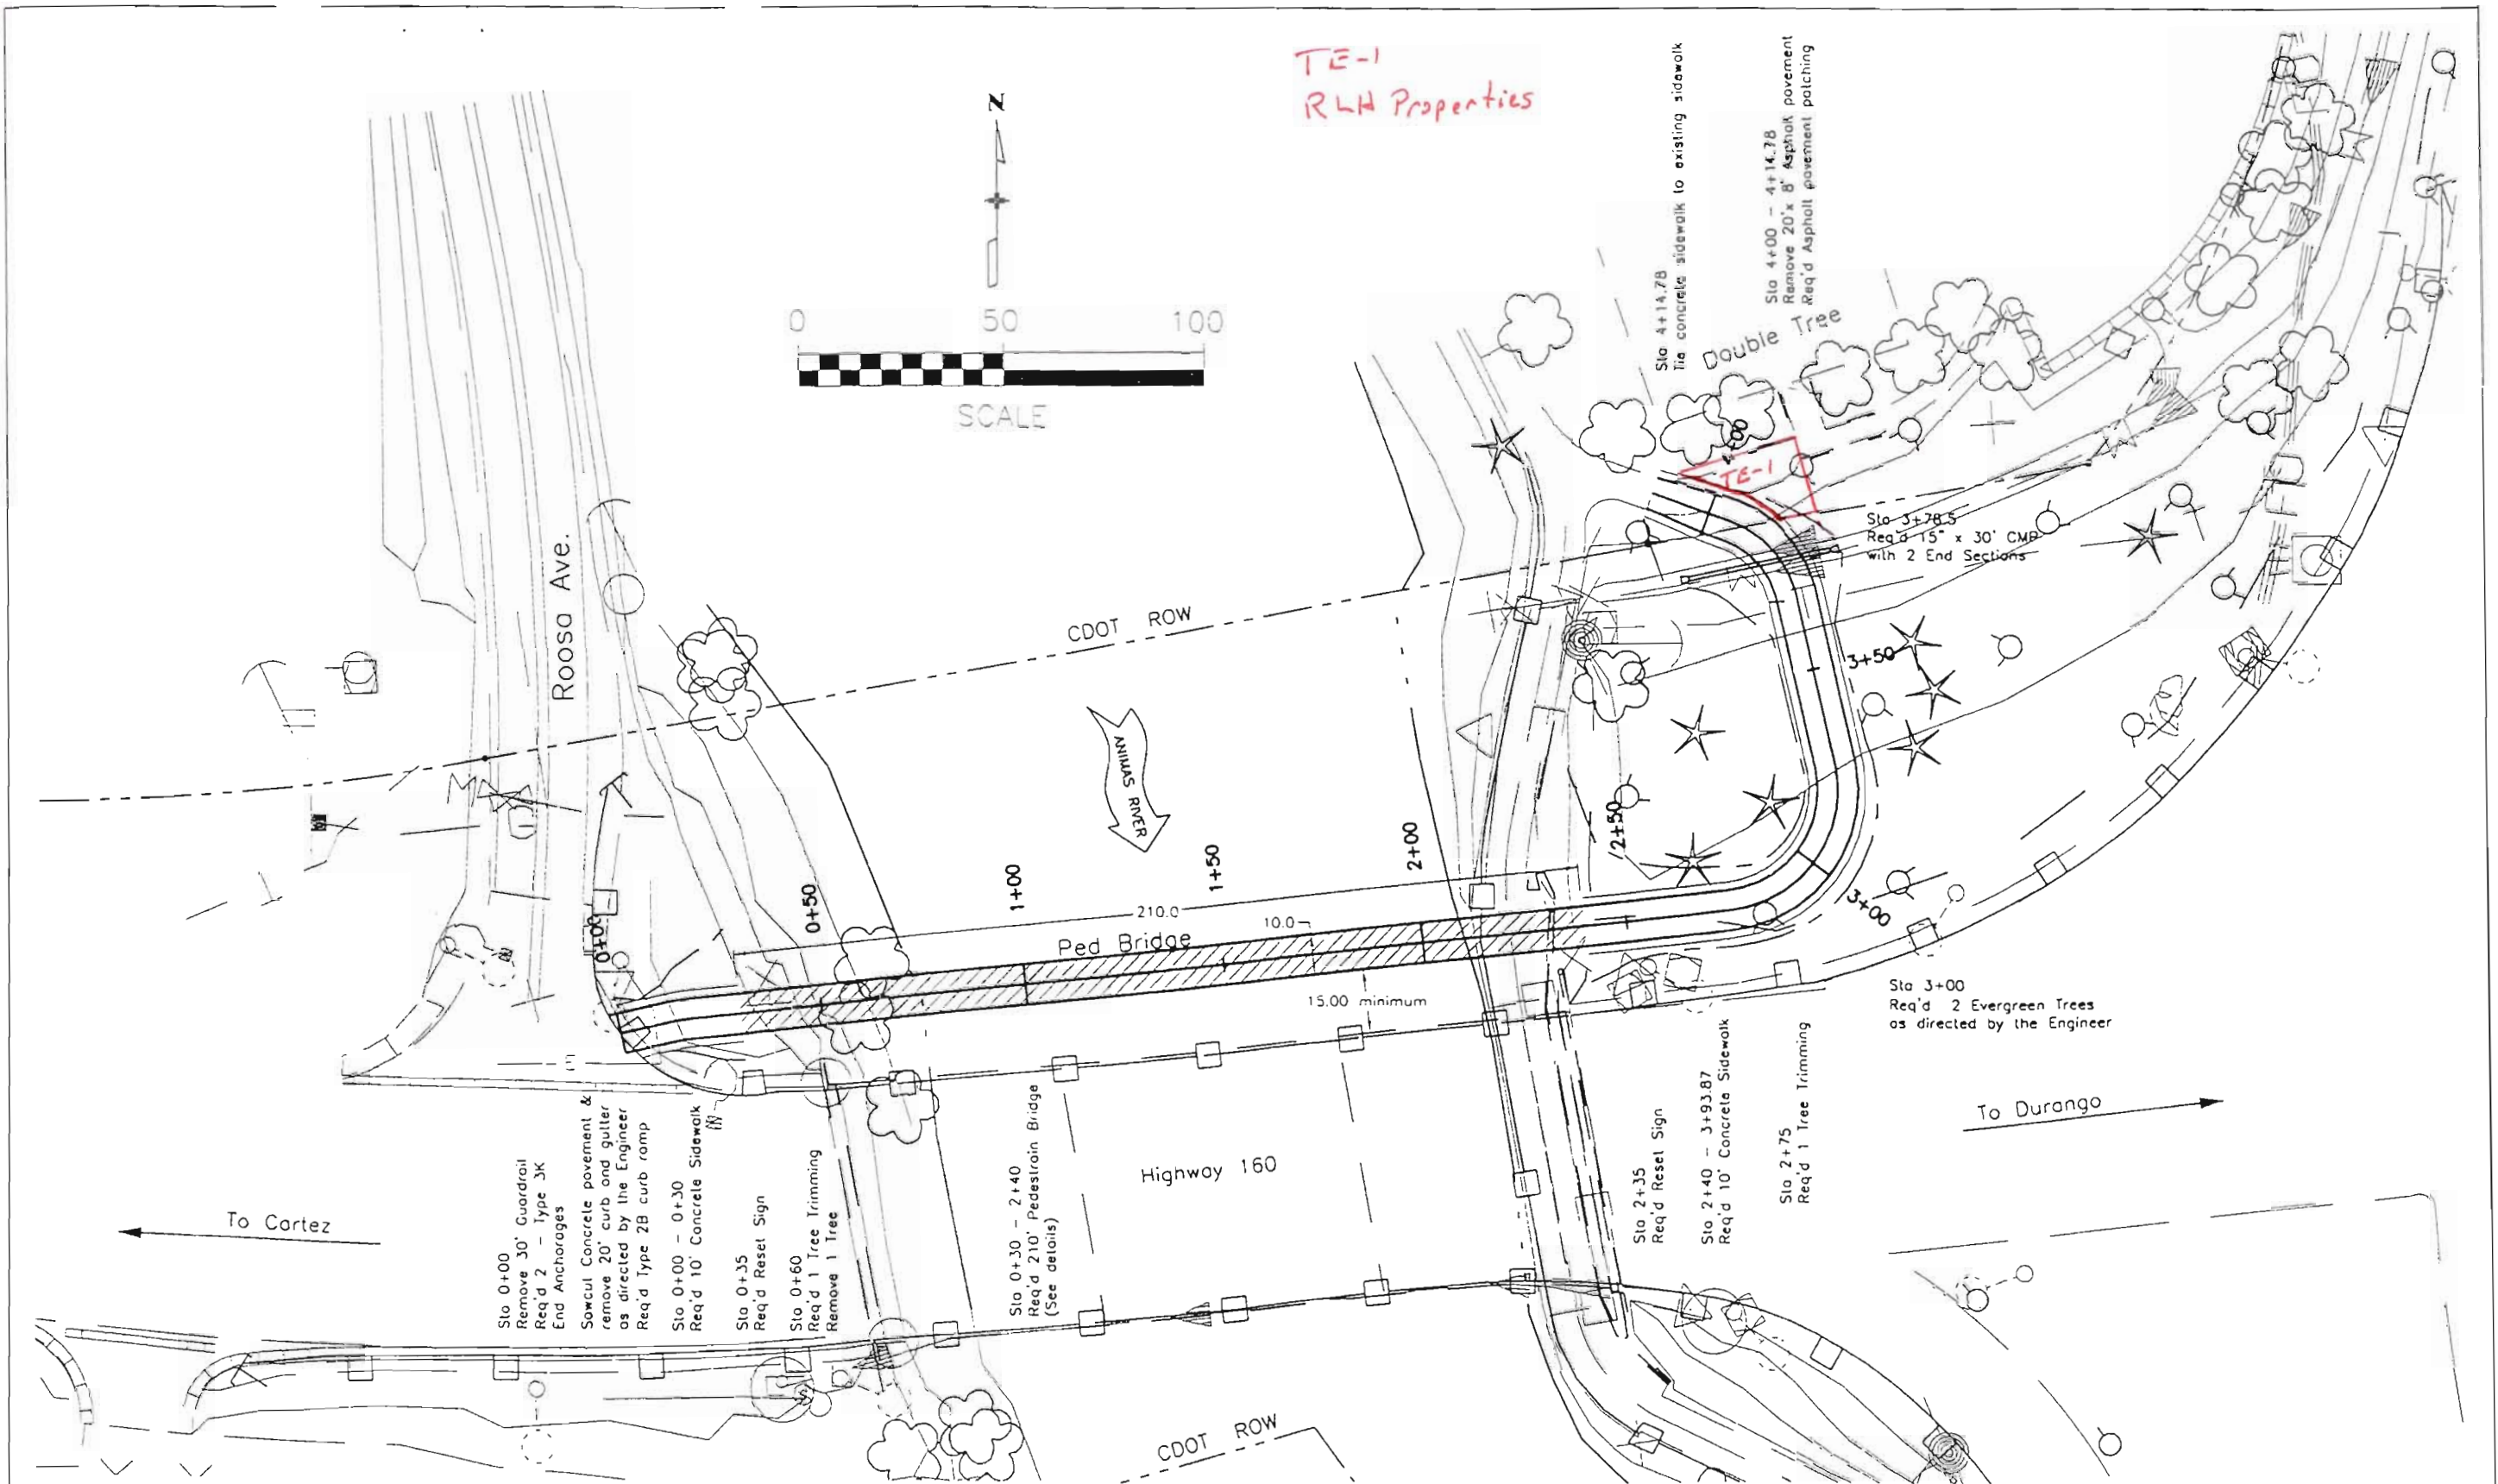

Computer File Information

Creation Date: 07/29/99 Initials: dtm
 Last Modification Date: 1/17/01 Initials: dtm
 Full Path: c:\projects\12815
 Drawing File Name: Ped Plan
 Acad Ver. R14 Scale: 1:1 Units: ENGLISH

(R-1)

00

00

00

00

Sheet Revisions

Rev	Date	Description	By
1	1/17/01	Modified Alignment	dtm

Colorado Department of Transportation



Region 5

3803 North Main Ave.
 Suite 300
 Durango, CO 81301
 Phone: (970) 385-1400 FAX: (970) 385-1410

B.S.

As Constructed

No Revisions:

Revised:

Void:

PLAN

Designer: dtm

Detailer: dtm

Sheet Subst: Roadway Subst Sheets:

1 of 1

Project No./Code

STE C 200-003

12815R

Sheet Number

8