

DEPARTMENT OF HIGHWAYS STATE OF COLORADO

EDERA ROAD REG O NO	DIVISION	PROJECT NO	SHEET NO.
9	COLORADO	S0020(12) Sec 2	1


RIGHT OF WAY

East of Puckin Center

INDEX OF SHEETS

REVISIONS		
8 25 67	Rev Length of Proj	DI

CONVENTIONAL SIGNS

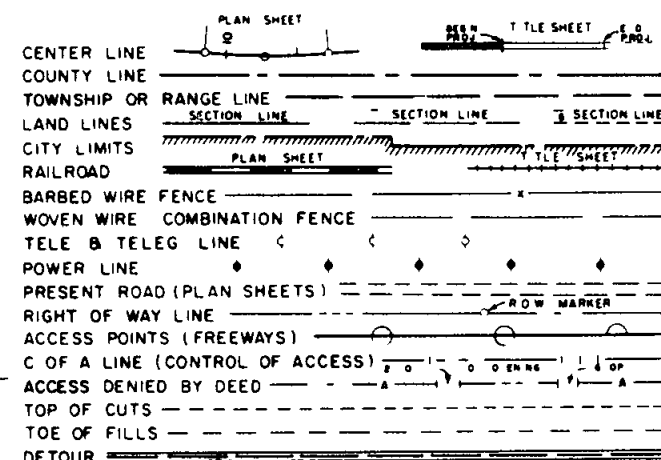

PLAN AND PROFILE OF PROPOSED FEDERAL AID PROJECT NO. S0020(12) SEC. 2 STATE HIGHWAY NO 94 LINCOLN COUNTY & CHEYENNE COUNTY

SCALES OF ORIGINAL DRAWINGS
ON PLAN 1 IN 100 FT
ON PROFILE 1 IN 100 FT HORIZONTAL
1 IN 10 FT VERTICAL
GRADE LINE ON PROFILE IS SHOWN AS GRADE OF FINISHED ROAD
GROSS LENGTH OF PROJECT 61 629.7 FT 11.672 MI (ROW)
NET LENGTH OF PROJECT 66 657.9 FT 12.625 MI CONST

Information obtained from Available County Records

SHEET NO

- 1 TITLE PAGE AND SKETCH
2-3 TABULATION OF PROPERTIES
3 A TABULATION OF EASEMENTS
4-24 PLAN & PROFILE SHEETS
SHOWING RIGHT OF WAY
25 OWNERSHIP MAP


NOTE Plans and Description on this Project
calculated and checked by Field Forces

RIGHT OF WAY

STA 4550+57.9 END ROW S0020(12) Sec 2 =
STA 4550+57.9 END CONST S0020(14) =
STA 2188+59.7 on Proj FOI7-3(5)

STA 3884+00.0 BEGIN S0020(14) CONST
STA 3884+00.0 END S0020(12) CONST

STA 3934+28.2 BEGIN S0020(12) SEC 2 ROW =
STA 3934+28.2 END S0020(12) SEC 1 ROW =
STA 3934+28.2 on S0020(14) Const

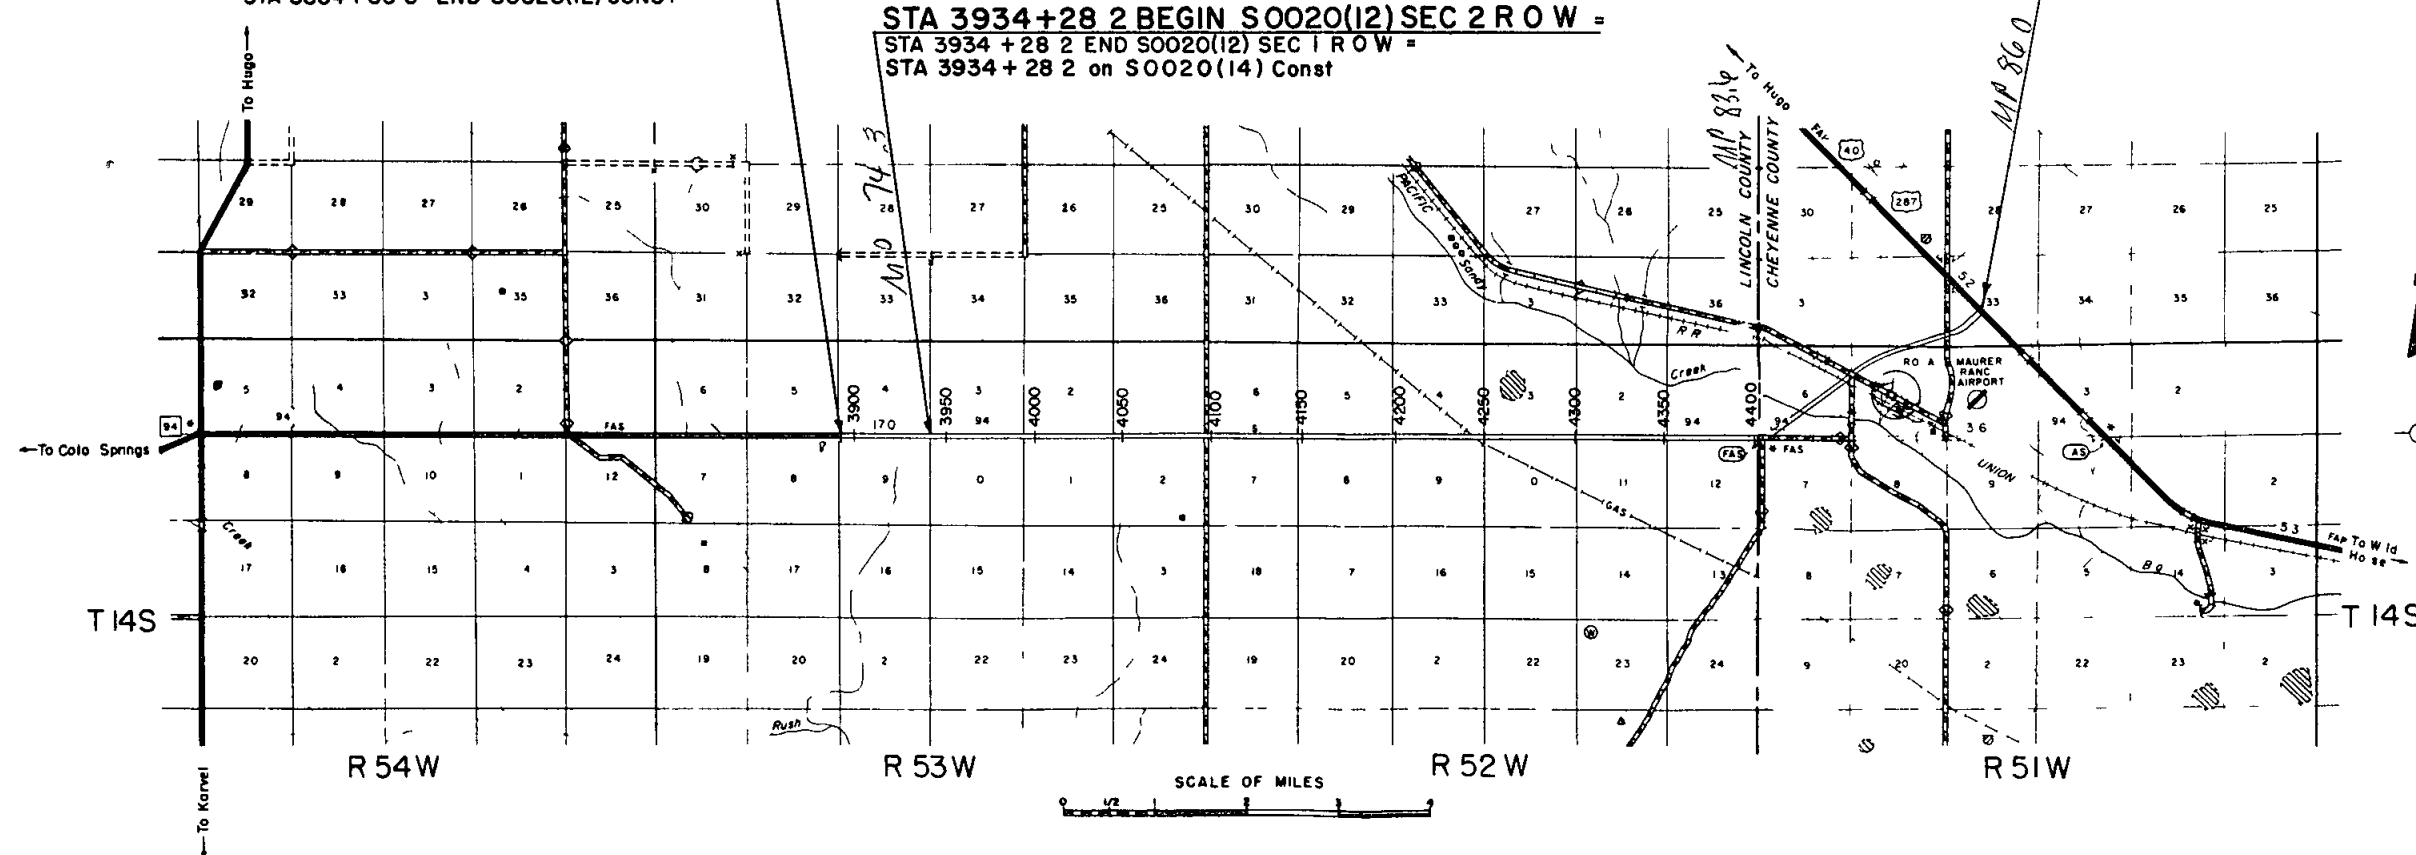

FEDERAL ROAD DIVISION NO.	DISTRICT	PROJECT NO	SHEET NO
9	COLORADO	S 0020(12)Sec 2	3

[illegible]

FEDERAL ROAD DIVISION NO.	DISTRICT	PROJECT NO	SHEET NO
9	COLORADO	S 0020(12) Sec 2	3-A

[illegible]

FEDERAL ROAD DIVISION NO.	DISTRICT	PROJECT NO	SHEET NO
9	COLORADO	S 0020(12)Sec. 2	3

[illegible]

SE 1/4 Sec 4
T 14 S, R 53 W

(15) All of Sec 3
T 14 S, R 53 W
John M Holland
Alice D Holland
Bovero, Colorado

RIGHT OF WAY
SW 1/4 Sec 3
T 14 S, R 53 W

S0020(12) Sec 2 4	
East of Punkin Center	
REVISIONS	

STA 3934 + 28.2 BEGIN S0020(12) SEC 2 R.O.W. =
STA 3934 + 28.2 END S0020(12) SEC 1 R.O.W. =
STA 3934 + 28.2 on S0020(14) CONST

NE 1/4 Sec 9
T 14 S, R 53 W

(16) All of Sec 10
T 14 S, R 53 W
John M Holland
Bovero, Colorado


NW 1/4 Sec 10
T 14 S, R 53 W

NOTE Profile and Grade Line Subject to Change

EMB FACTOR
UNCL EXCAV
EMBANKMENT
EMB x FACTOR
HAUL-YD MILE
UNCL EXCAV
SOURCE

28.77
28.78

28.44

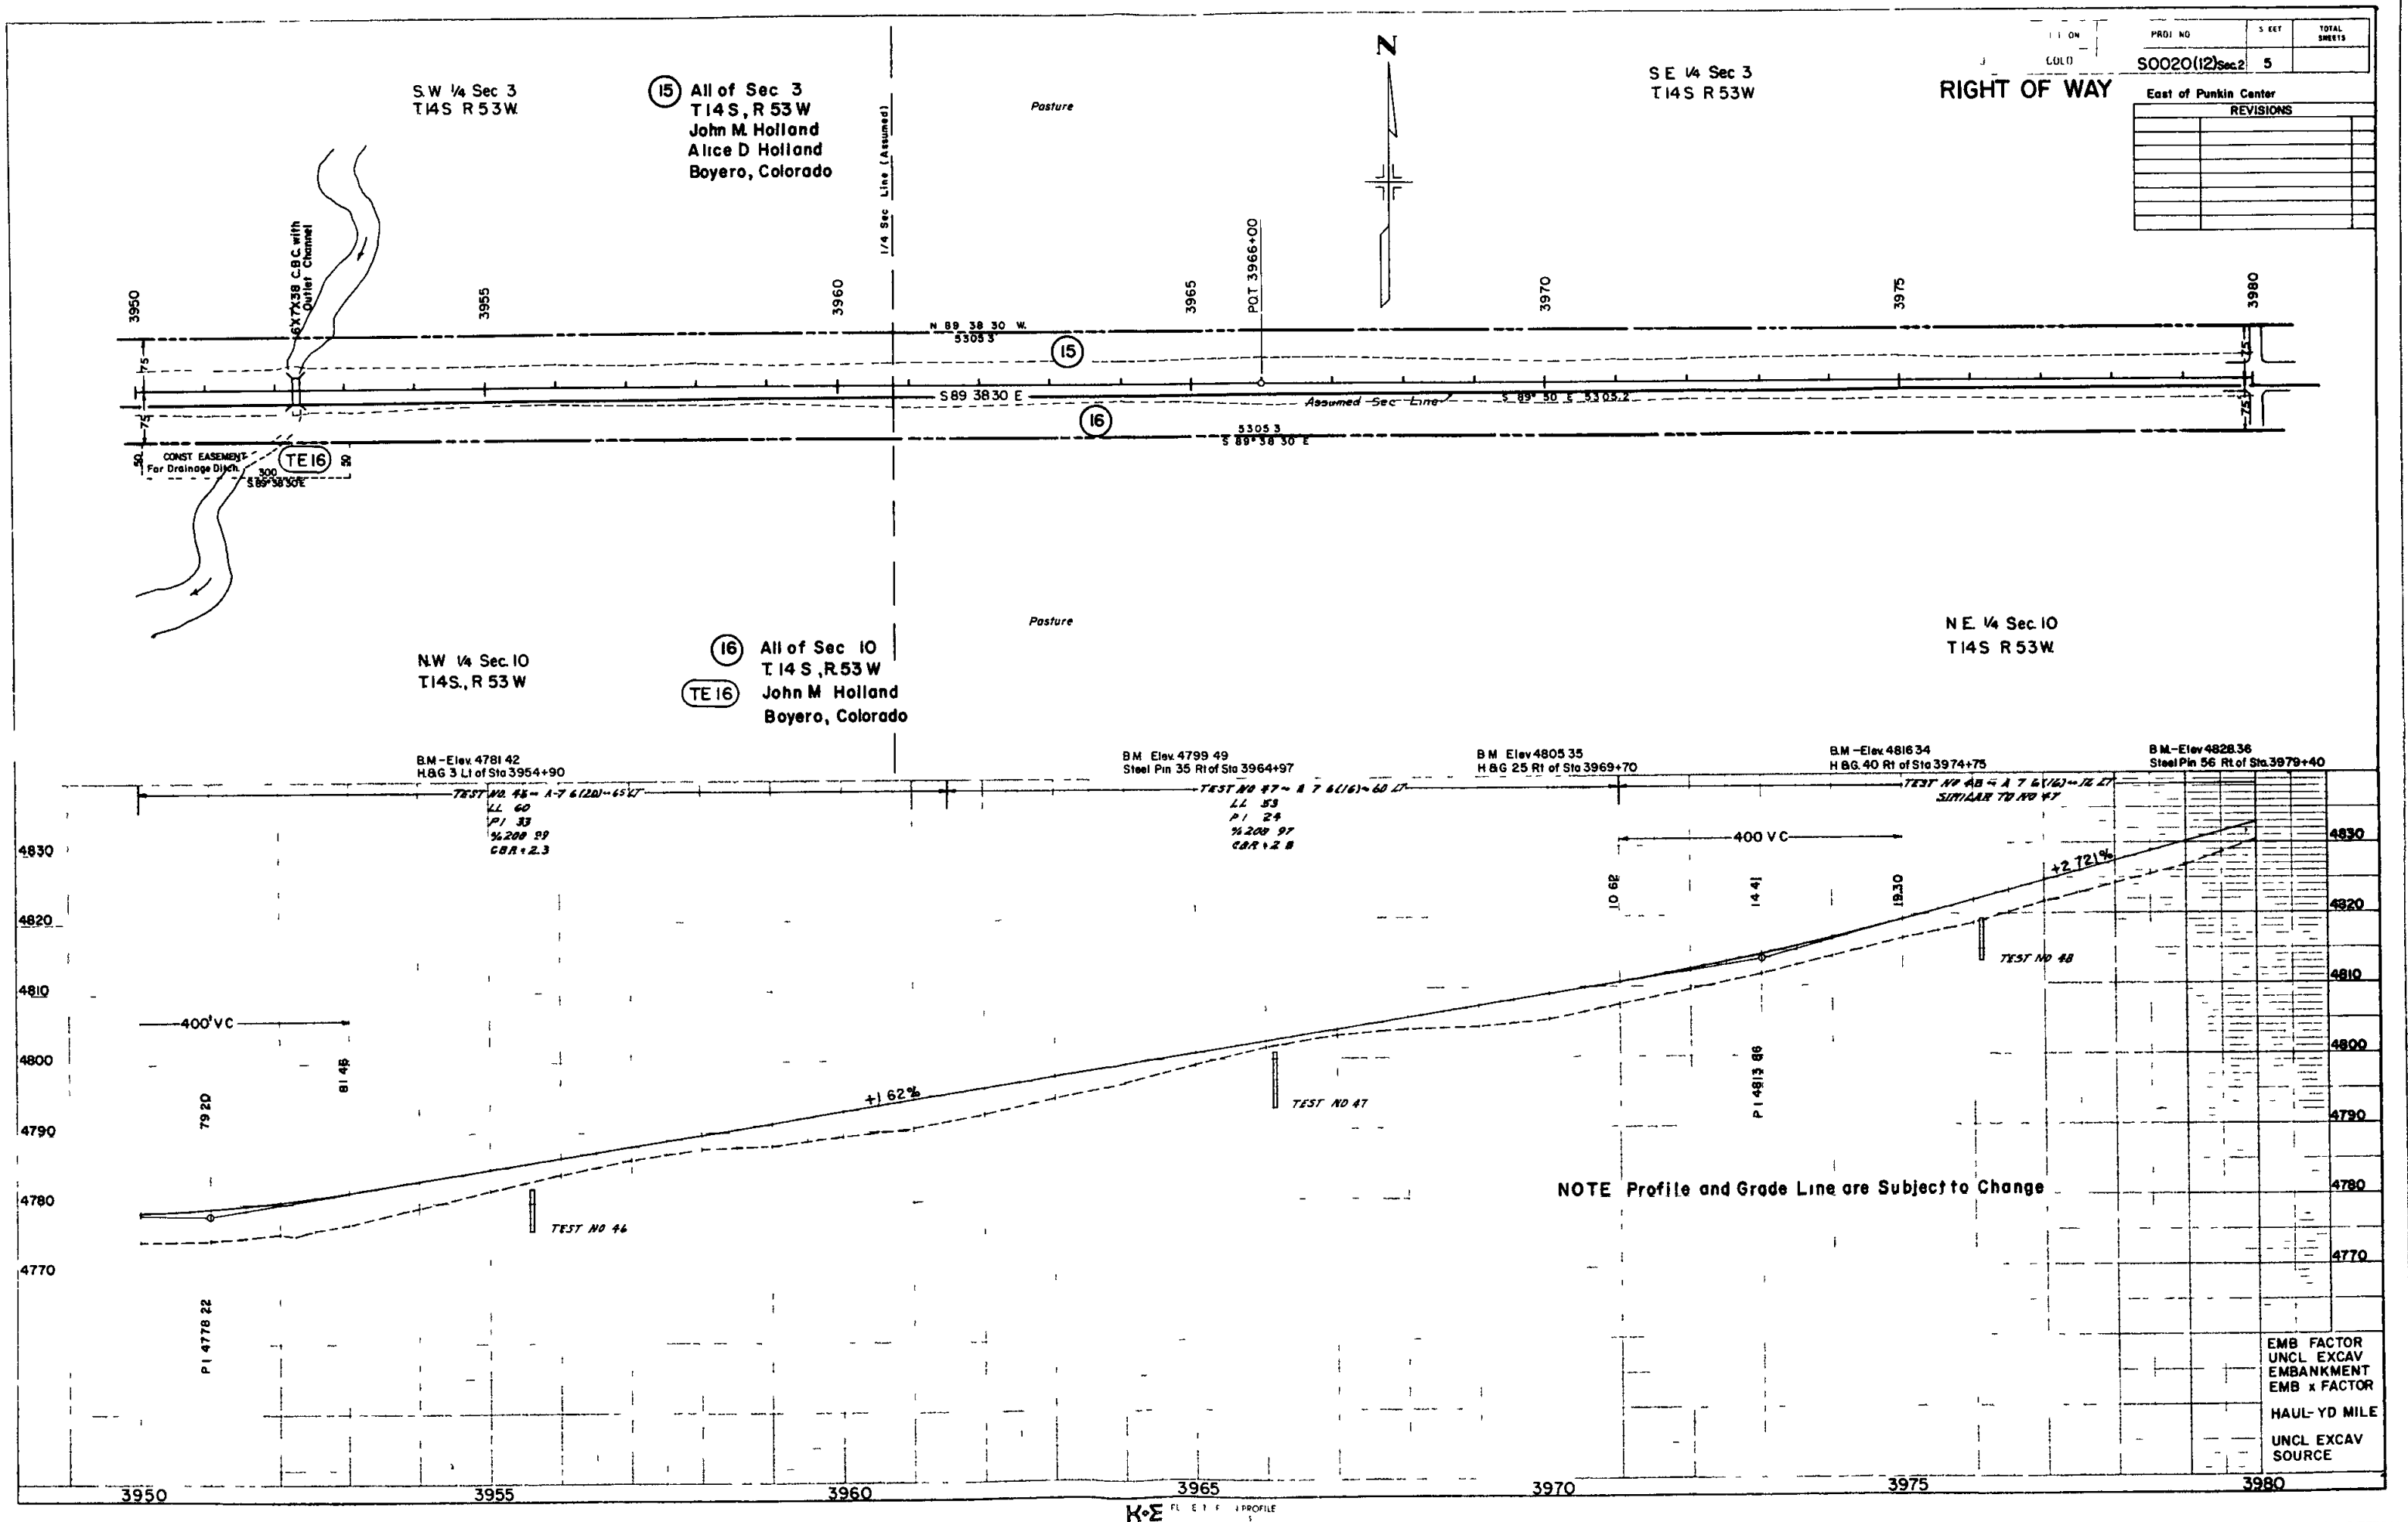


PROJ NO	SHEET	TOTAL SHEETS
S0020(12)Sec2	5	

REVISIONS	

EMB FACTOR
UNCL EXCAV
EMBANKMENT
EMB x FACTOR
HAUL-YD MILE
UNCL EXCAV
SOURCE

K-E FL E T F 1 PROFILE

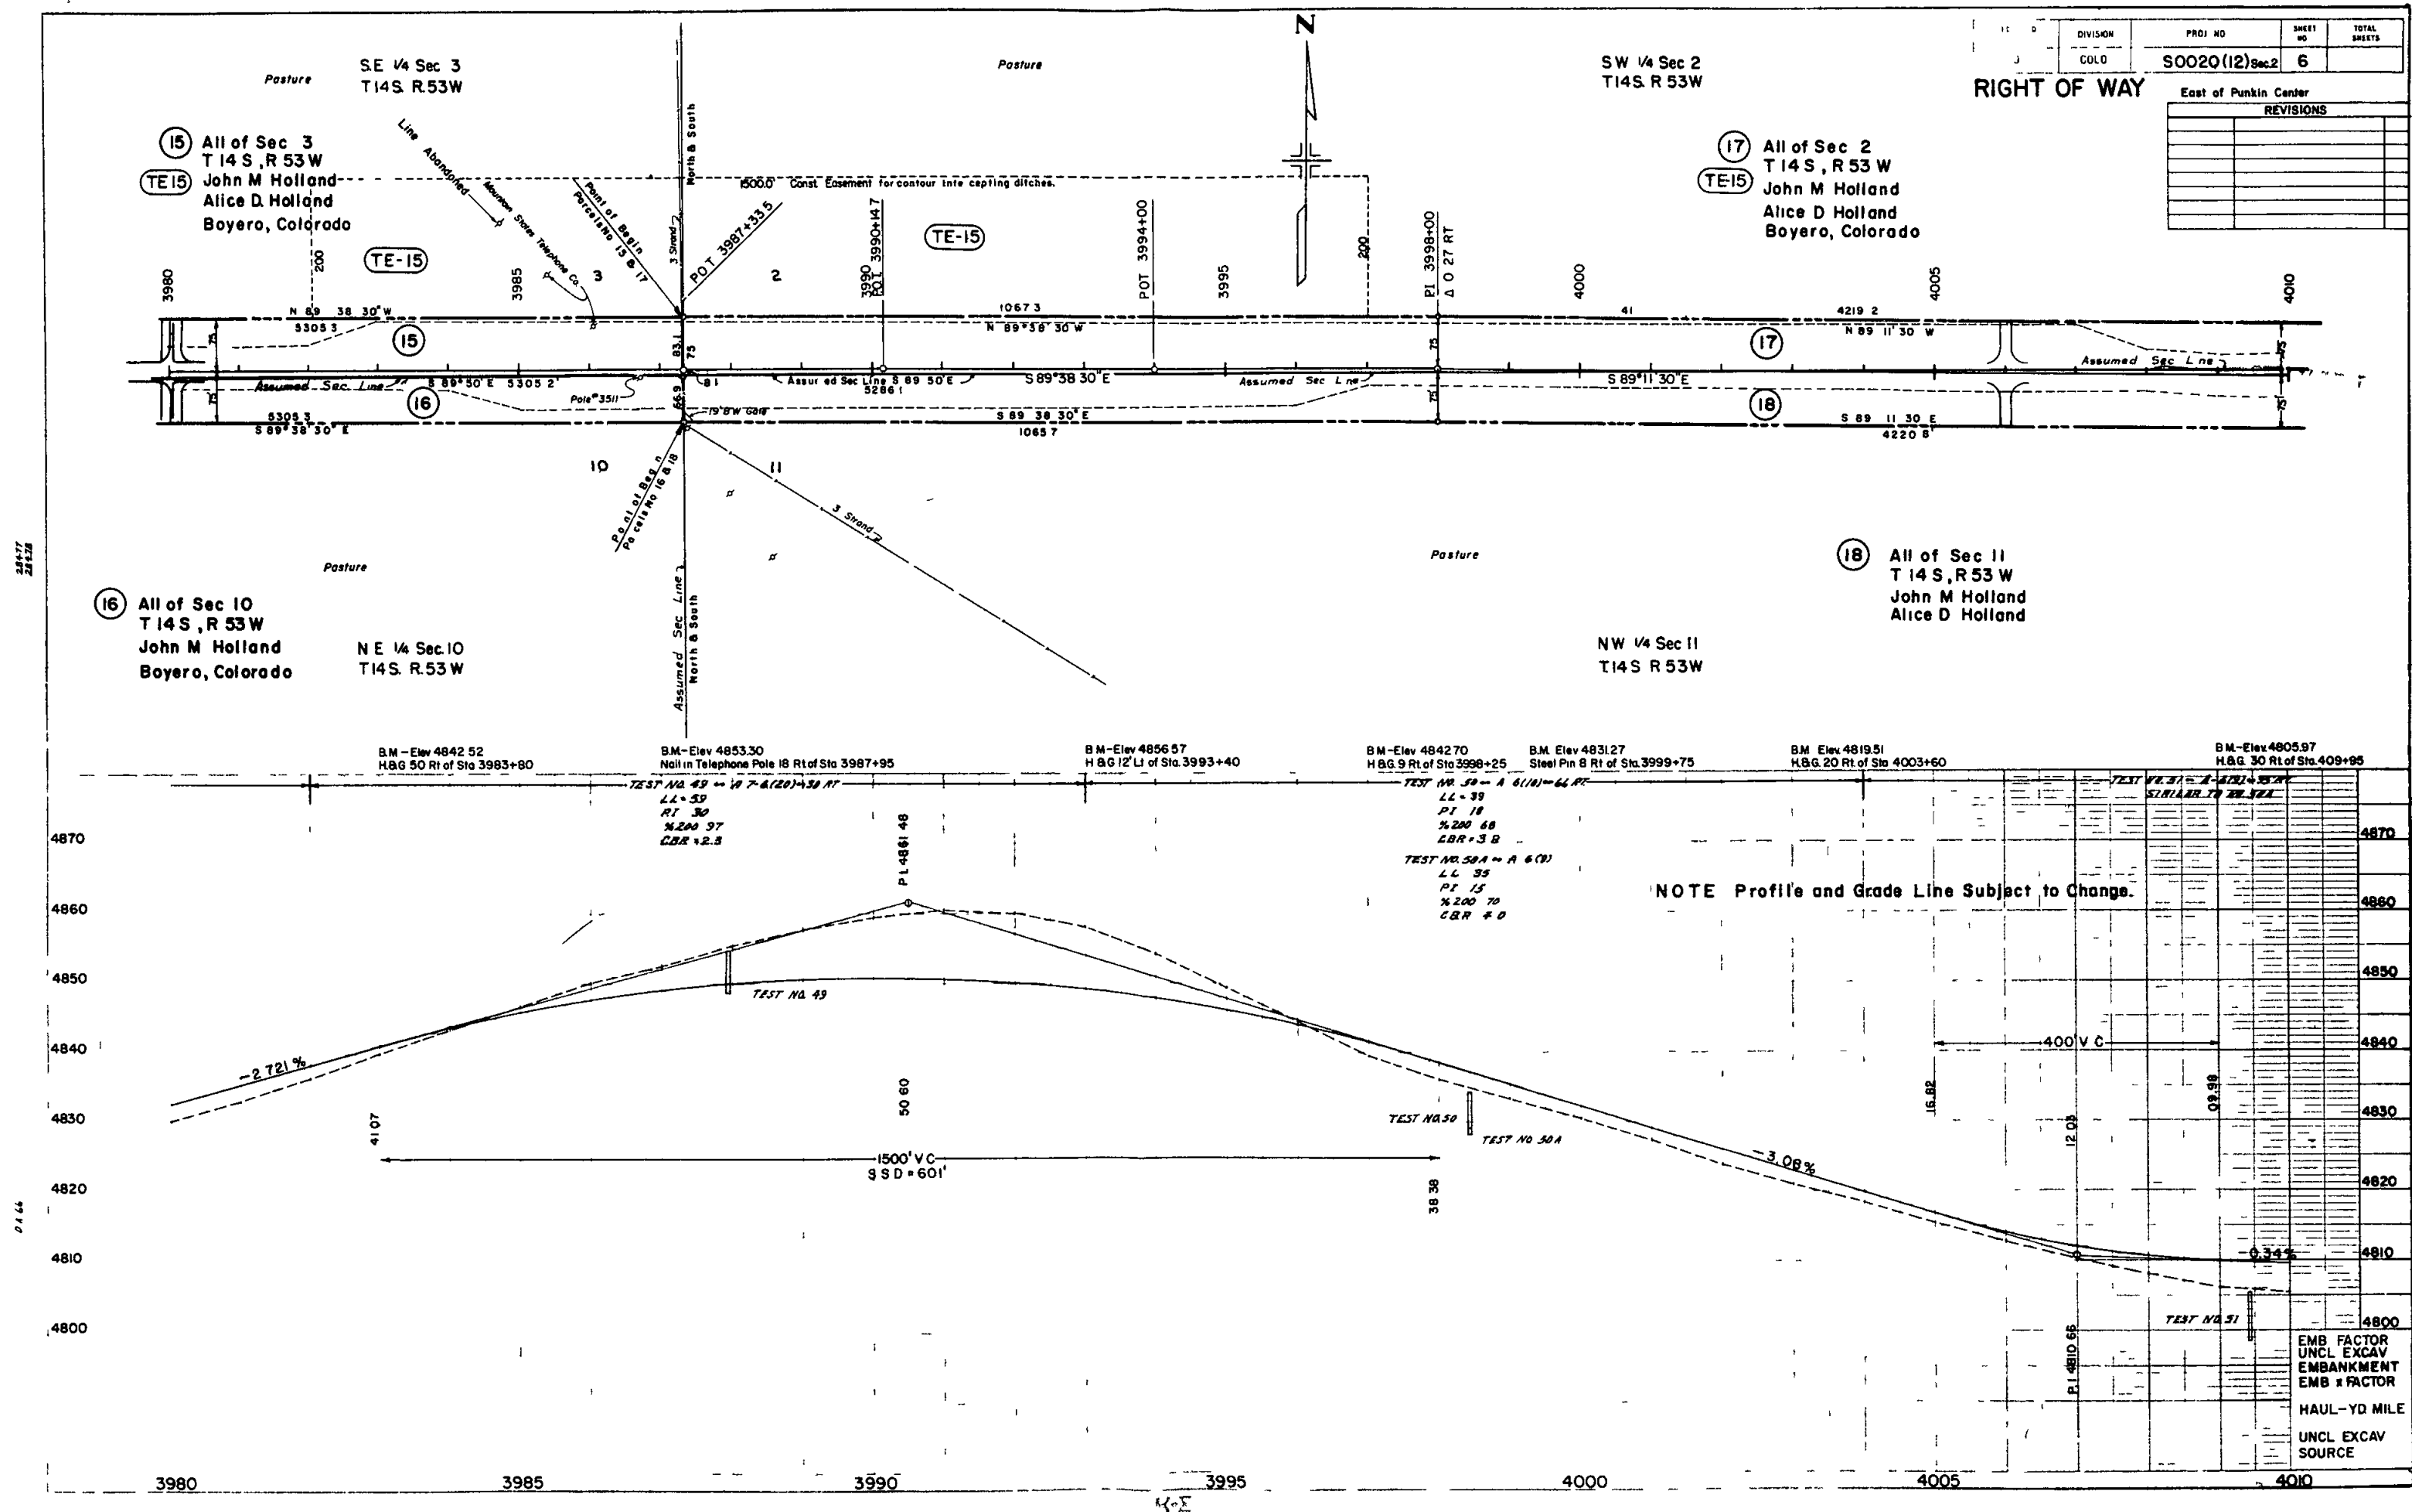

SW 1/4 Sec 2
T 14 S R 53 W

(17) All of Sec 2
T 14 S, R 53 W
John M Holland
Alice D Holland
Bovero, Colorado

(18) All of Sec 11
T 14 S, R 53 W
John M Holland
Alice D Holland
Bovero, Colorado

SE 1/4 Sec 2
T 14 S R 53 W

NE 1/4 Sec 11
T 14 S R 53 W

RIGHT OF WAY

East of Punkin Center

REVISIONS

NO. DESCRIPTION

1

2

B.M. Elev 4803.25
Steel Pin 50 Rt of Sta 4013+70

B.M. Elev 4800.97
H&G 10 Lt of Sta 4019+04

B.M. Elev 4788.66
H&G 30 Lt of Sta 4024+39

B.M. Elev 4788.41
Steel Pin 80 Lt of Sta 4029+10

B.M. Elev 4782.67
H&G 105 Lt of Sta 4034+80

B.M. Elev 4776.52
H&G 105 Lt of Sta 4038+75

TEST NO 51 - A 6(2) - 95 RT.
SIMILAR TO NO 504

TEST NO 52 - A 2 1(2) - 90 RT.
LL 35
PI 15
L 200 TO
SSD 40

TEST NO 53 - A 3 4(2) - 60 RT.
SIMILAR TO NO 52

TEST NO 54 - A 4 1(2) - 75 RT.
LL 35
PI 15
L 200 TO
SSD 40

TEST NO 501 - A 6(2) - 95 RT.
LL 35
PI 15
L 200 TO
SSD 40



NOTE Profile and Grade Line Subject to Change

EMB FACTOR
UNCL EXCAV
EMBANKMENT
EMB x FACTOR
HAUL-YD MILE
UNCL EXCAV
SOURCE

TO	DIVISION	PROJ NO	SHEET NO	TOTAL SHEETS
9	COLO	S0020(12)Sec.2	8	

RIGHT OF WAY
East of Punkin Center
SE 1/4 Sec. 1
T14S. R.53W

REVISIONS	
8-25-67	Rev Parcel No 19 D1

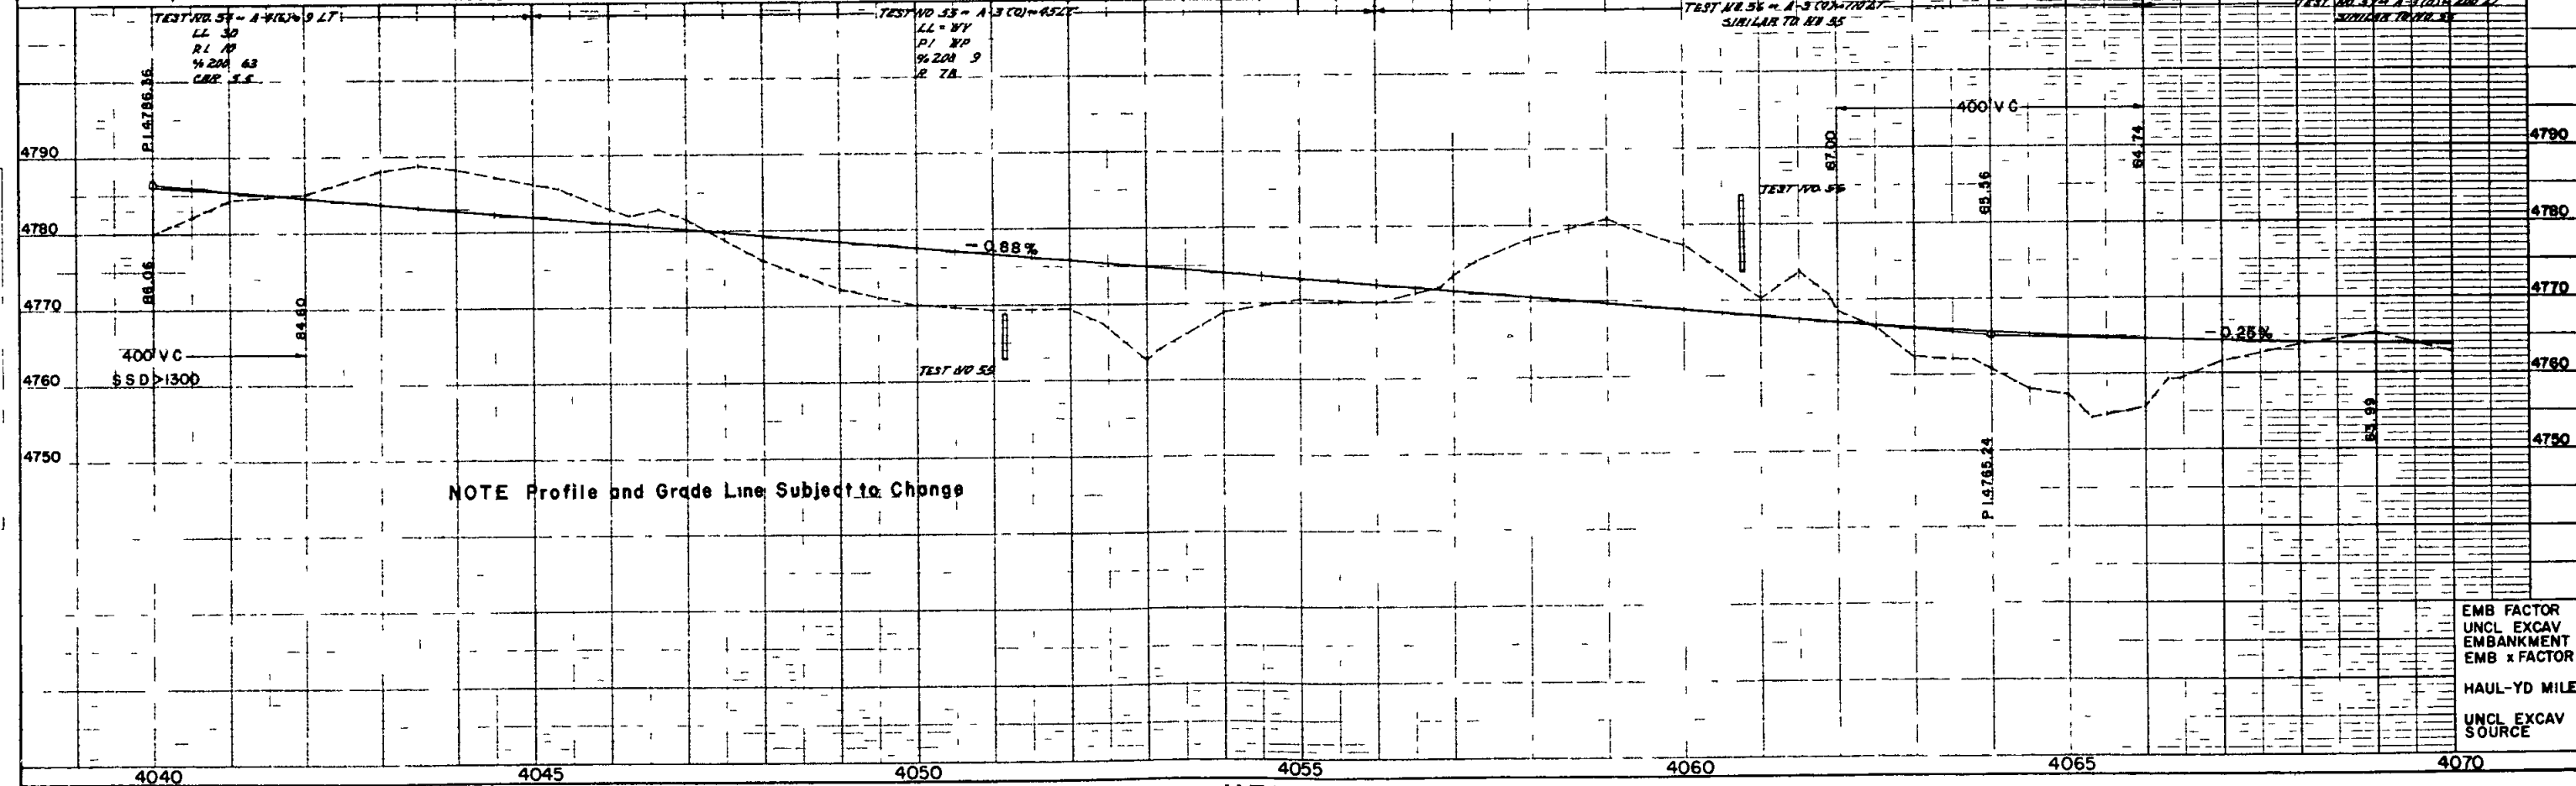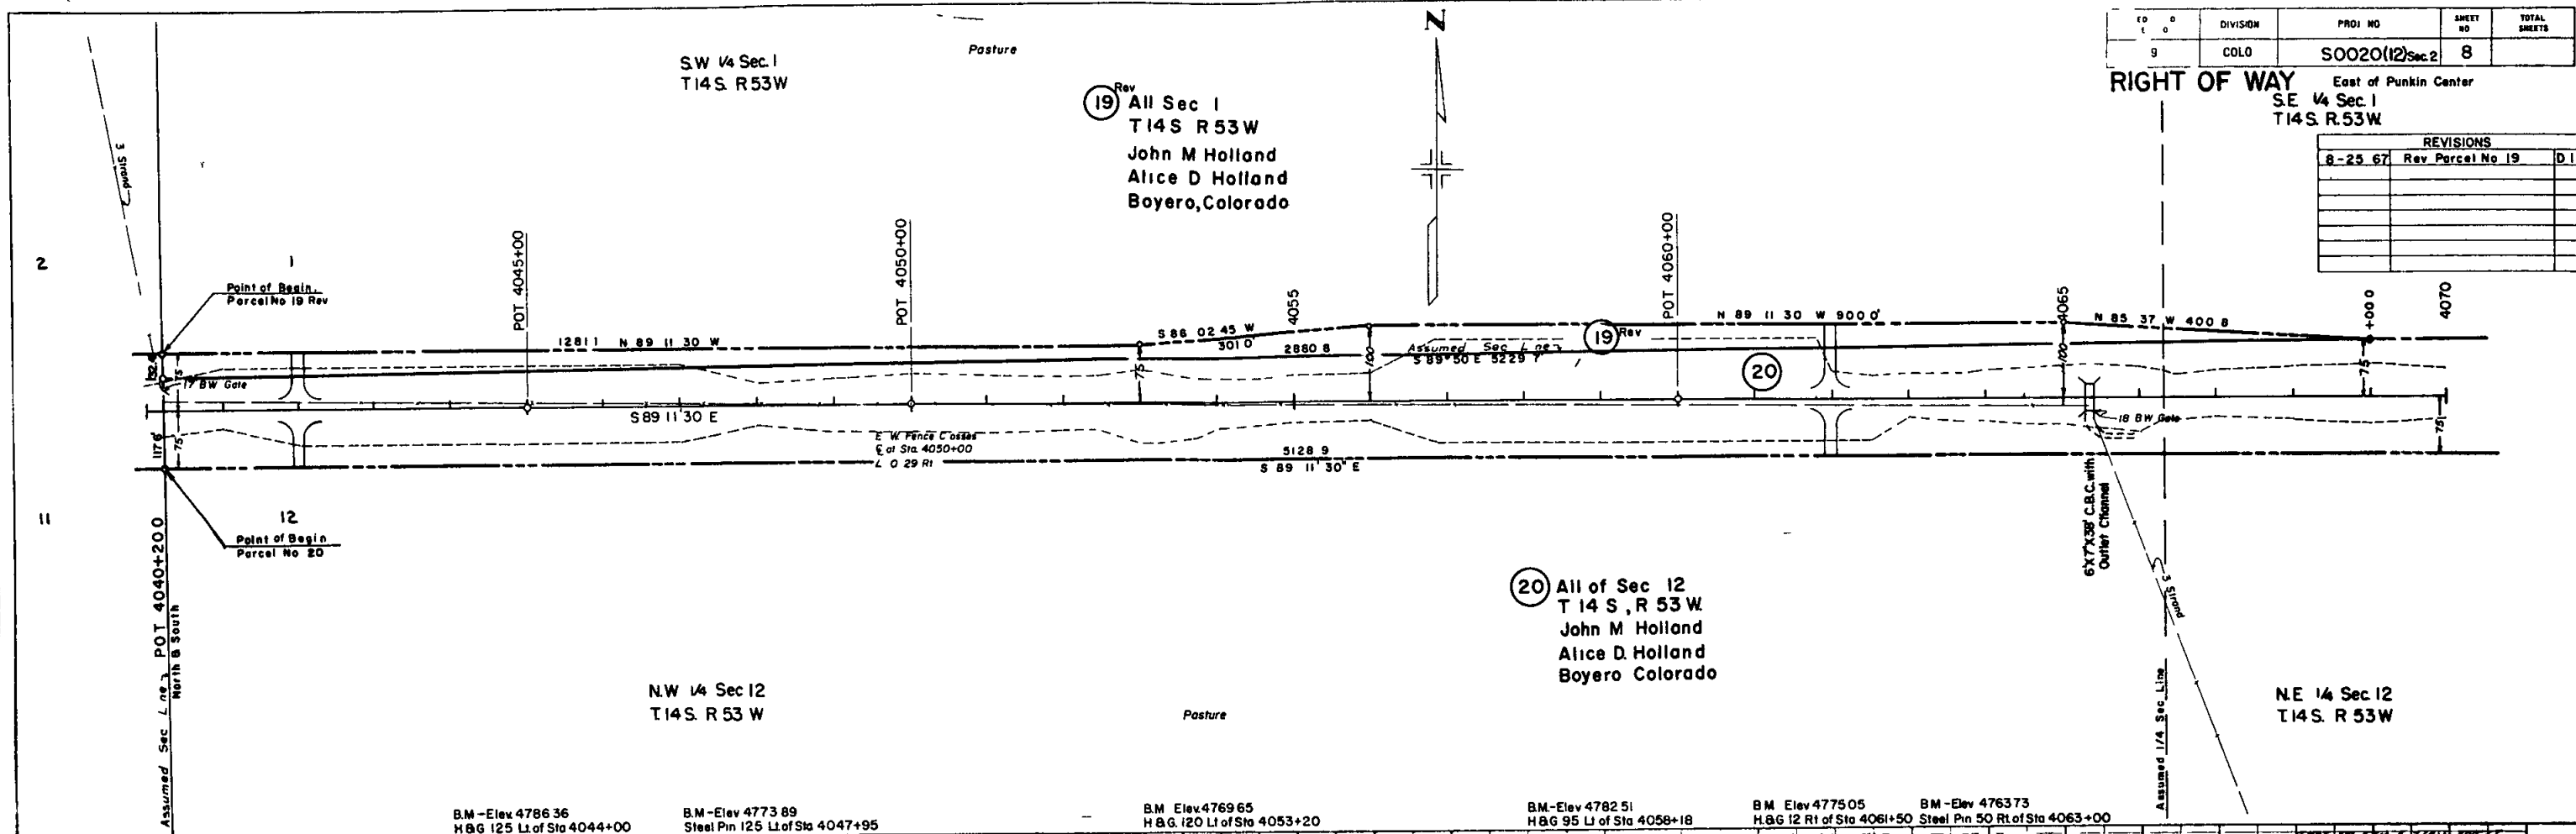

EMB FACTOR
UNCL EXCAV
EMBANKMENT
EMB x FACTOR
HAUL-YD MILE
UNCL EXCAV
SOURCE

DIVISION	PROJ NO	SHEET NO	TOTAL SHEETS
9	COLO	SO020(12)Sec.2	9

RIGHT OF WAY East of Punkin Center

N 1/2 S W 1/4 Sec 6
T 14 S, R 52 W
John Robert Schafer
John Keith Schafer
Robert Gary Schafer
Hugo, Colorado

S W 1/4 Sec 6
T 14 S, R 52 W

REVISIONS

All of Sec 1
T 14 S, R 53 W
John M Holland
Alice D Holland
Bovero, Colorado


SE 1/4 Sec 1
T 14 S, R 53 W

NE 1/4 Sec 12
T 14 S, R 53 W

(20) All of Sec 12
T 14 S, R 53 W
John M Holland
Alice D Holland
Bovero, Colorado

(21) All of Sec 7
T 14 S, R 52 W
Clifford J Palmer
Hugo, Colorado

N W 1/4 Sec 7
T 14 S, R 52 W

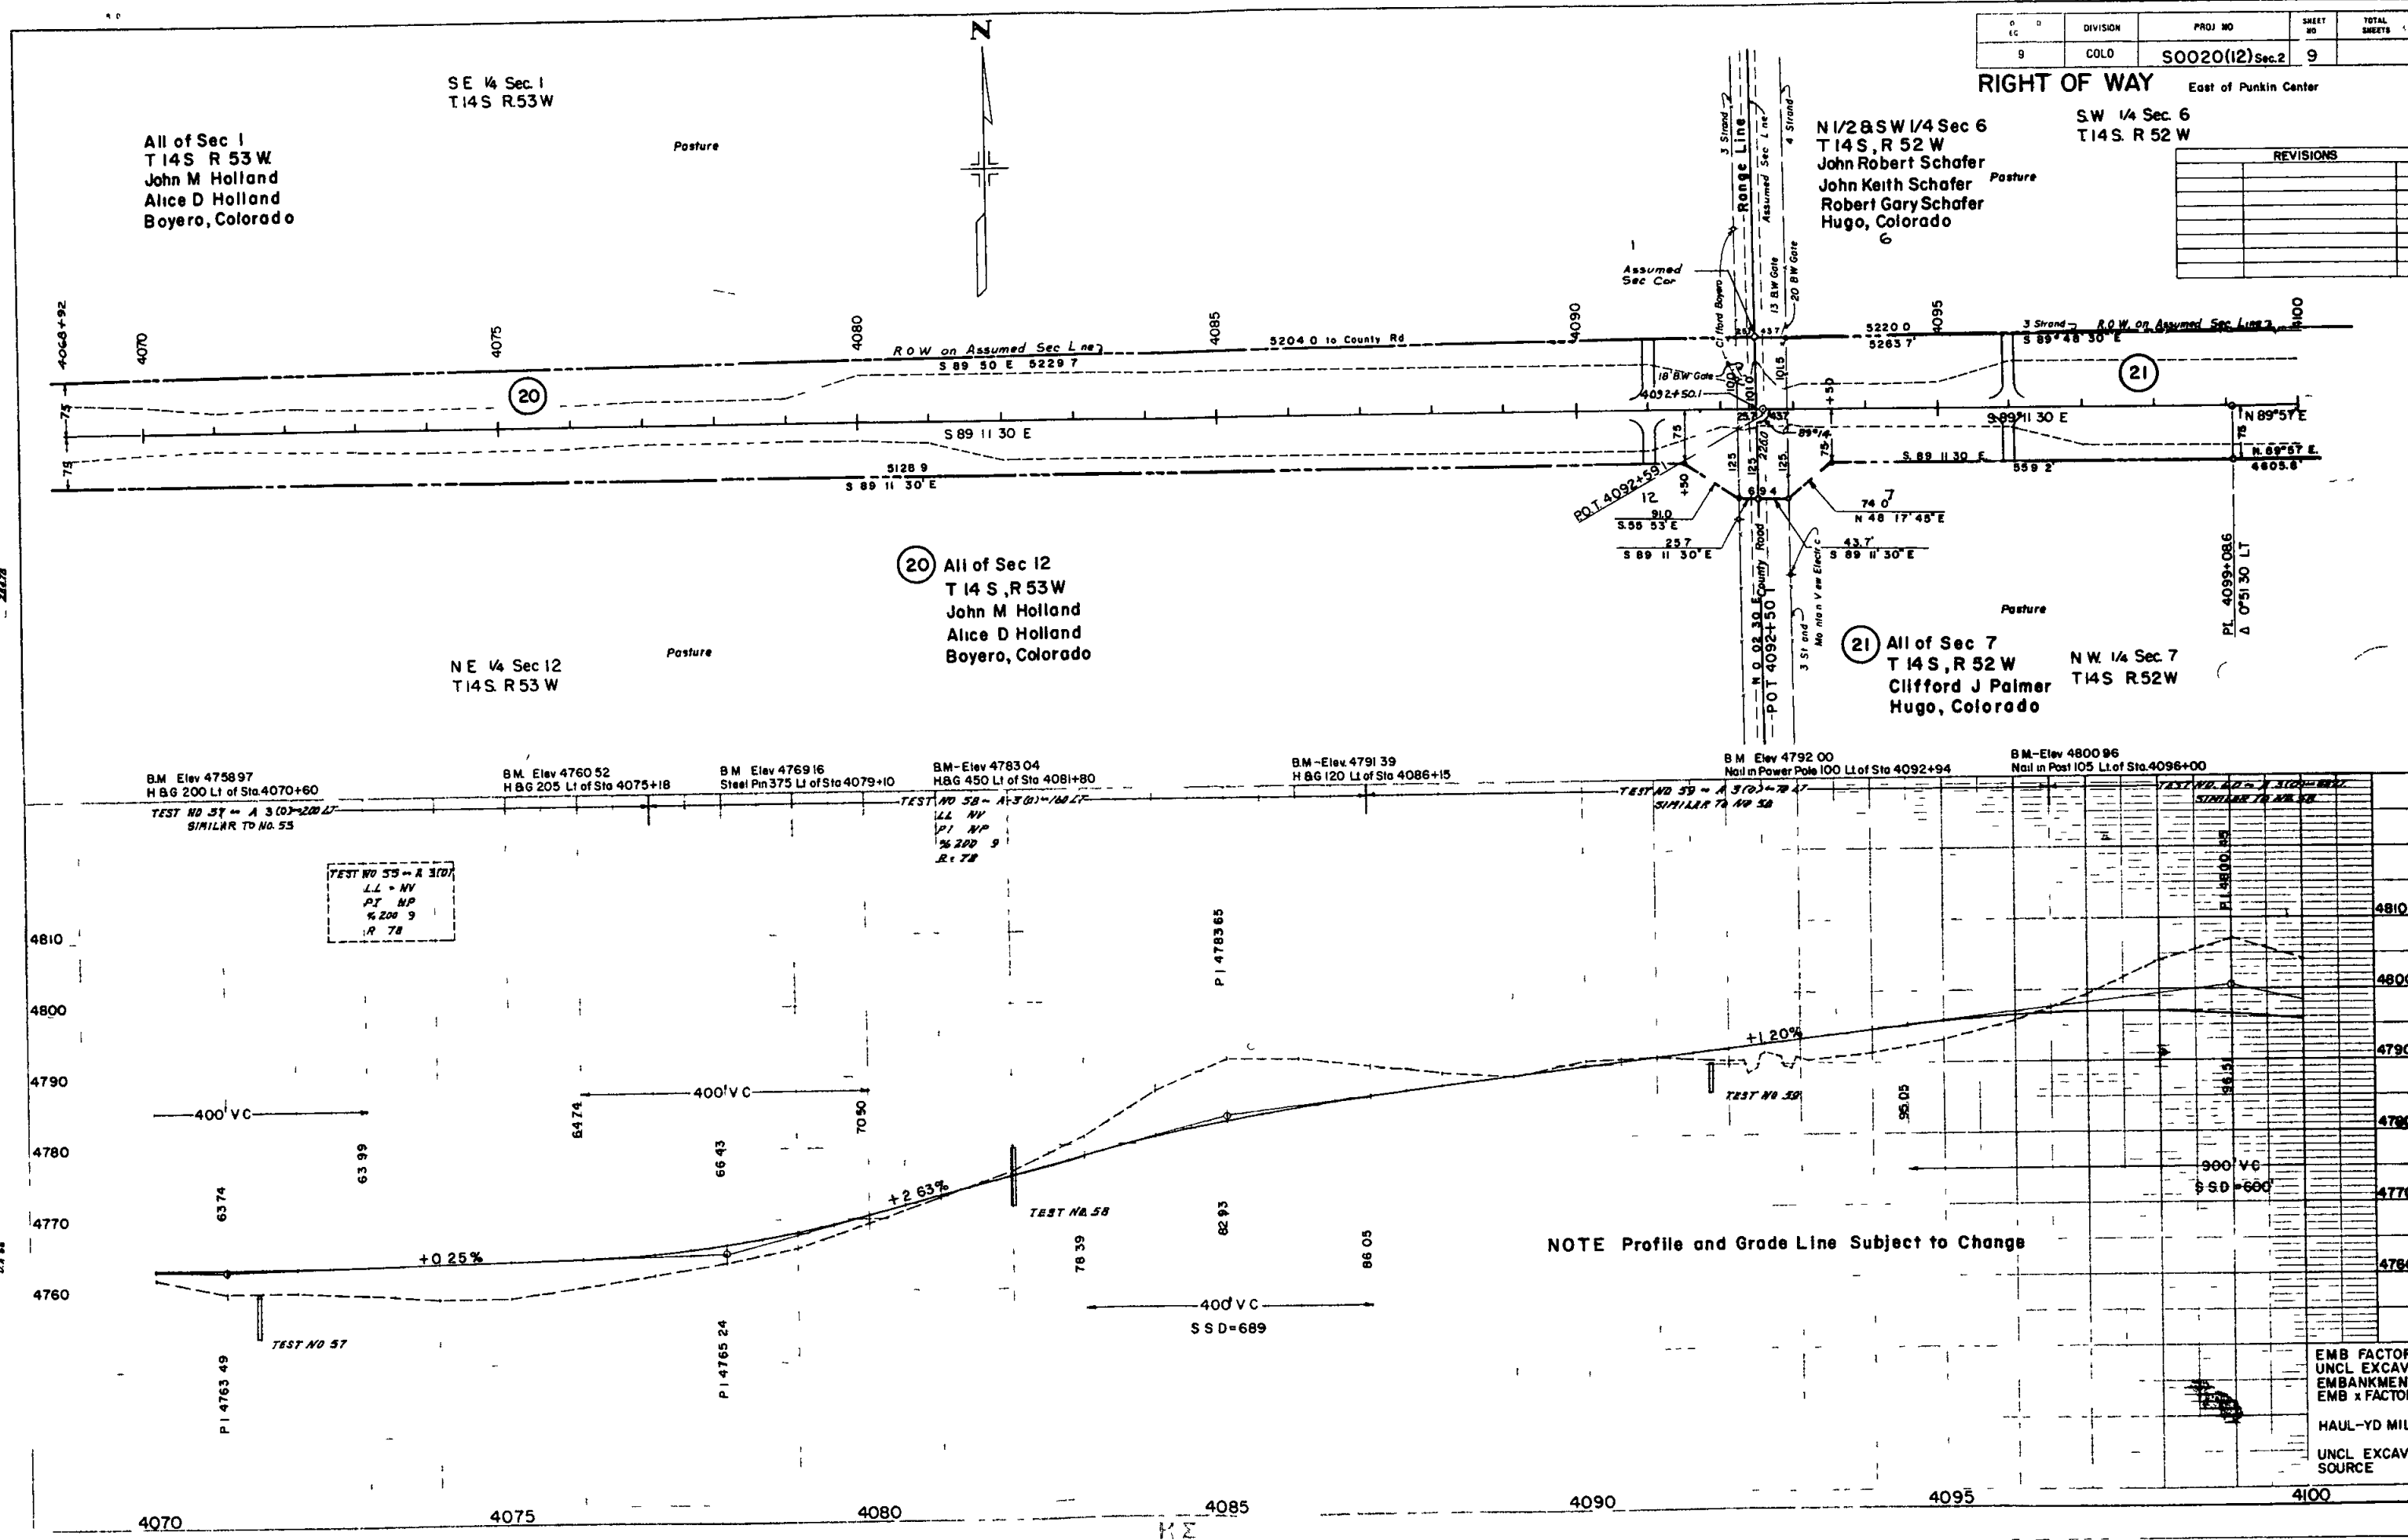

NET F L N S S E O G O R D D

S.W 1/4 Sec 6
T14S R52W

Pasture

N 1/2 & S.W 1/4 Sec 6
T14S, R 52 W
John Robert Schafer
John Keith Schafer
Robert Gary Schafer
Hugo, Colorado

Pasture


SE 1/4 Sec 6
T14S, R 52 W
Robert E Palmer
Hugo, Colorado

DIST	DIVISION	PROJ NO	SHEET NO	TOTAL SHEETS
9	COLO	SOO2002	Sec 2 10	

RIGHT OF WAY

SE 1/4 Sec 6
T14S R 52 W

REVISIONS

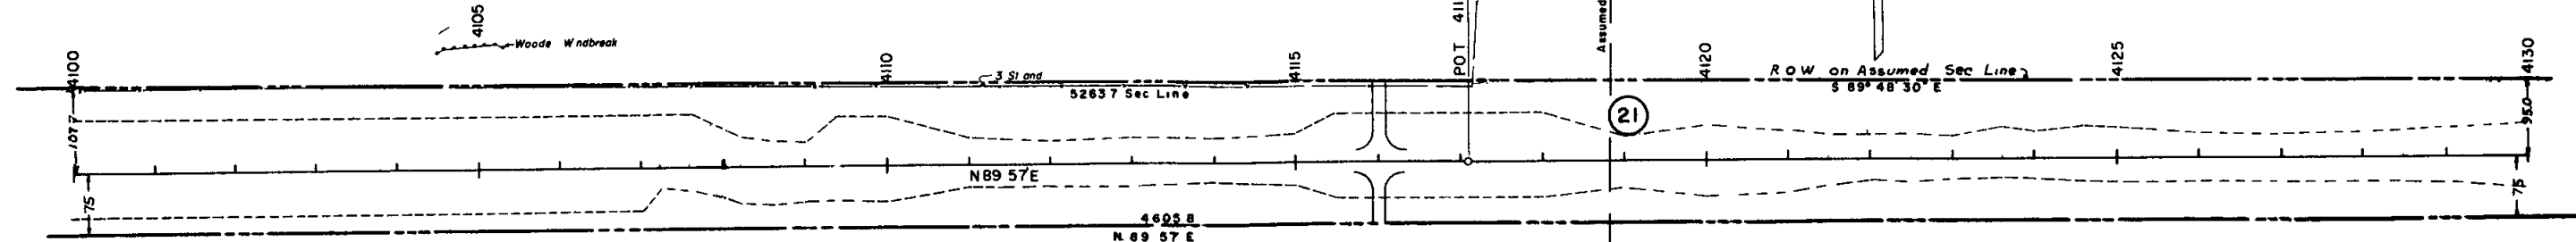


N.W 1/4 Sec 7
T14S R 53 W

Pasture

(21) All of Sec 7
T14S, R 52 W
Clifford J Palmer
Hugo, Colorado

N.E 1/4 Sec 7
T14S, R 52 W

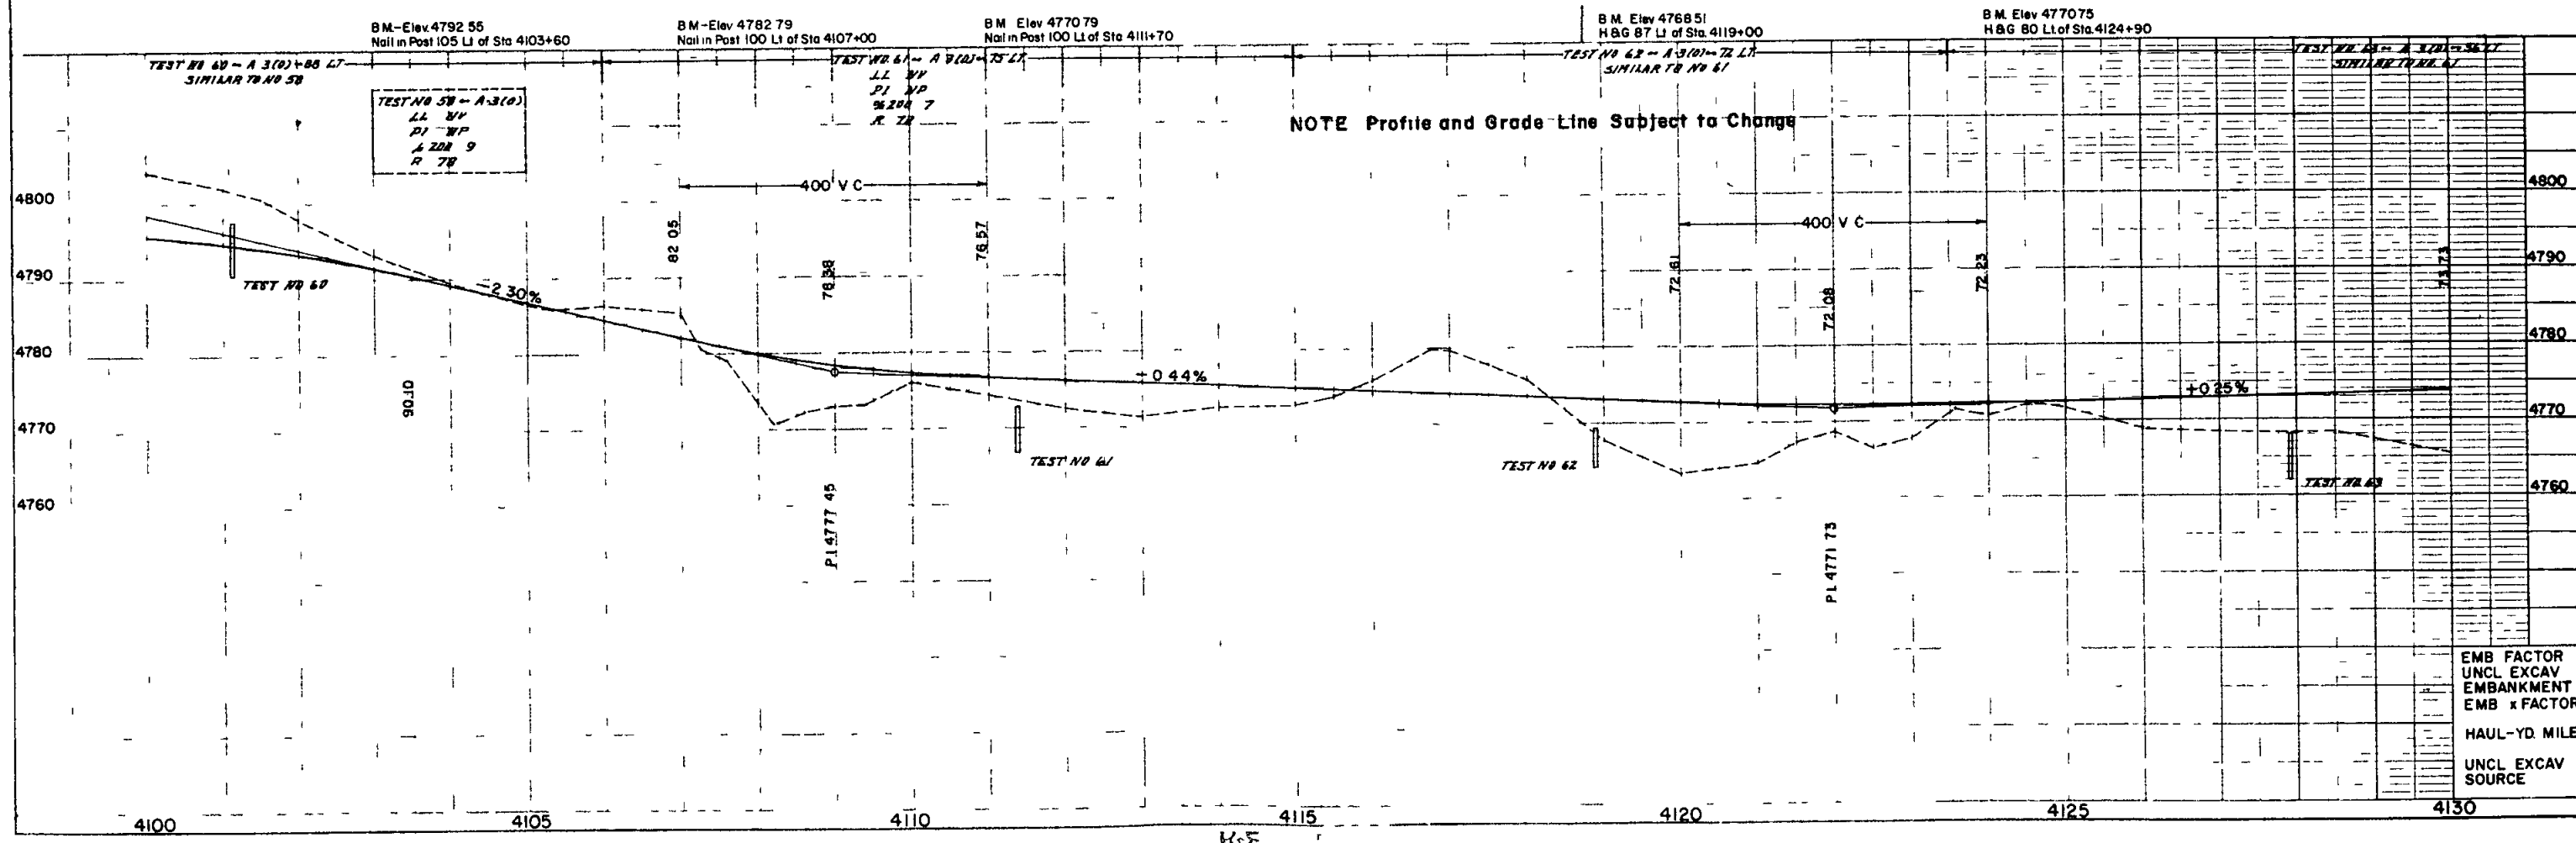

EMB FACTOR
UNCL EXCAV
EMBANKMENT
EMB x FACTOR
HAUL-YD. MILE
UNCL EXCAV
SOURCE

SE 1/4 Sec 6
T14S R52 W

Pasture

SE 1/4 Sec 6
T14S, R52 W
Robert E Palmer
Hugo, Colorado

6

5

All of Sec 5
T14 S R52 W
Robert E Palmer
Hugo, Colorado


RIGHT OF WAY

S.W. 1/4 Sec 5
T14S. R 52 W

East of Punkin Center

REVISIONS

NO.	DESCRIPTION

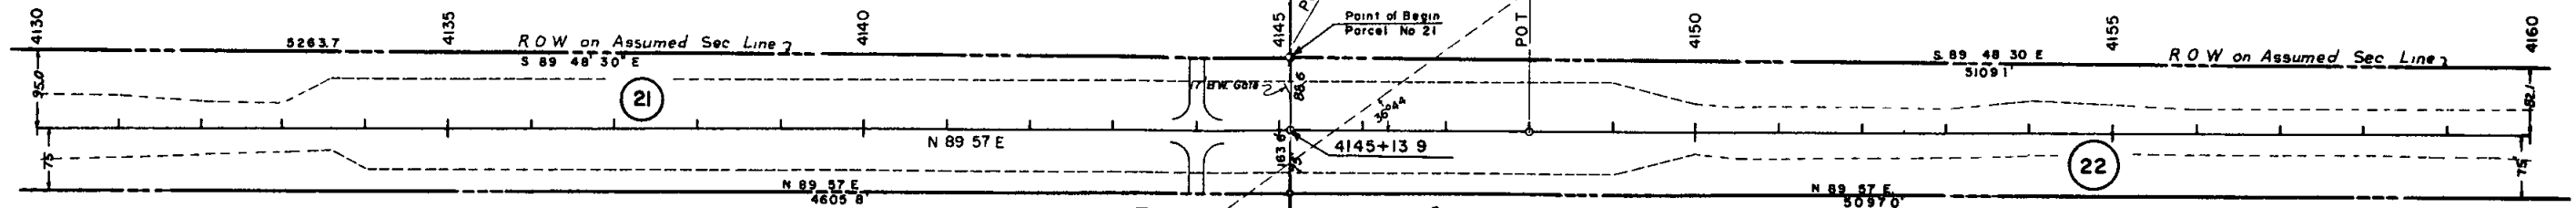

NE 1/4 Sec 7
T14 S R52 W

(21) All of Sec 7
T14 S, R 52 W
Clifford J Palmer
Hugo, Colorado

(22) All of Sec 8
T14 S R52 W
Robert E Palmer
Hugo, Colorado

NW 1/4 Sec 8
T14S. R 52 W

B.M. Elev 476445
H&G 90 Lt of Sta 4130+40

B.M. Elev 477366
Steel Pin 84 Lt of Sta 4133+30

B.M. Elev 478133
H&G 80 Lt of Sta 4138+50


B.M. Elev 478395
Nail in Post 30 Lt of Sta. 4145+13.9

B.M. Elev 477741
H&G 60 Lt of Sta 4149+25

B.M. Elev 476483
H&G 72 Lt of Sta 4151+15

B.M. Elev 475076
Steel Pin 50 Lt of Sta 4156+50

NOTE: Profiles and Grade Line Subject to Change

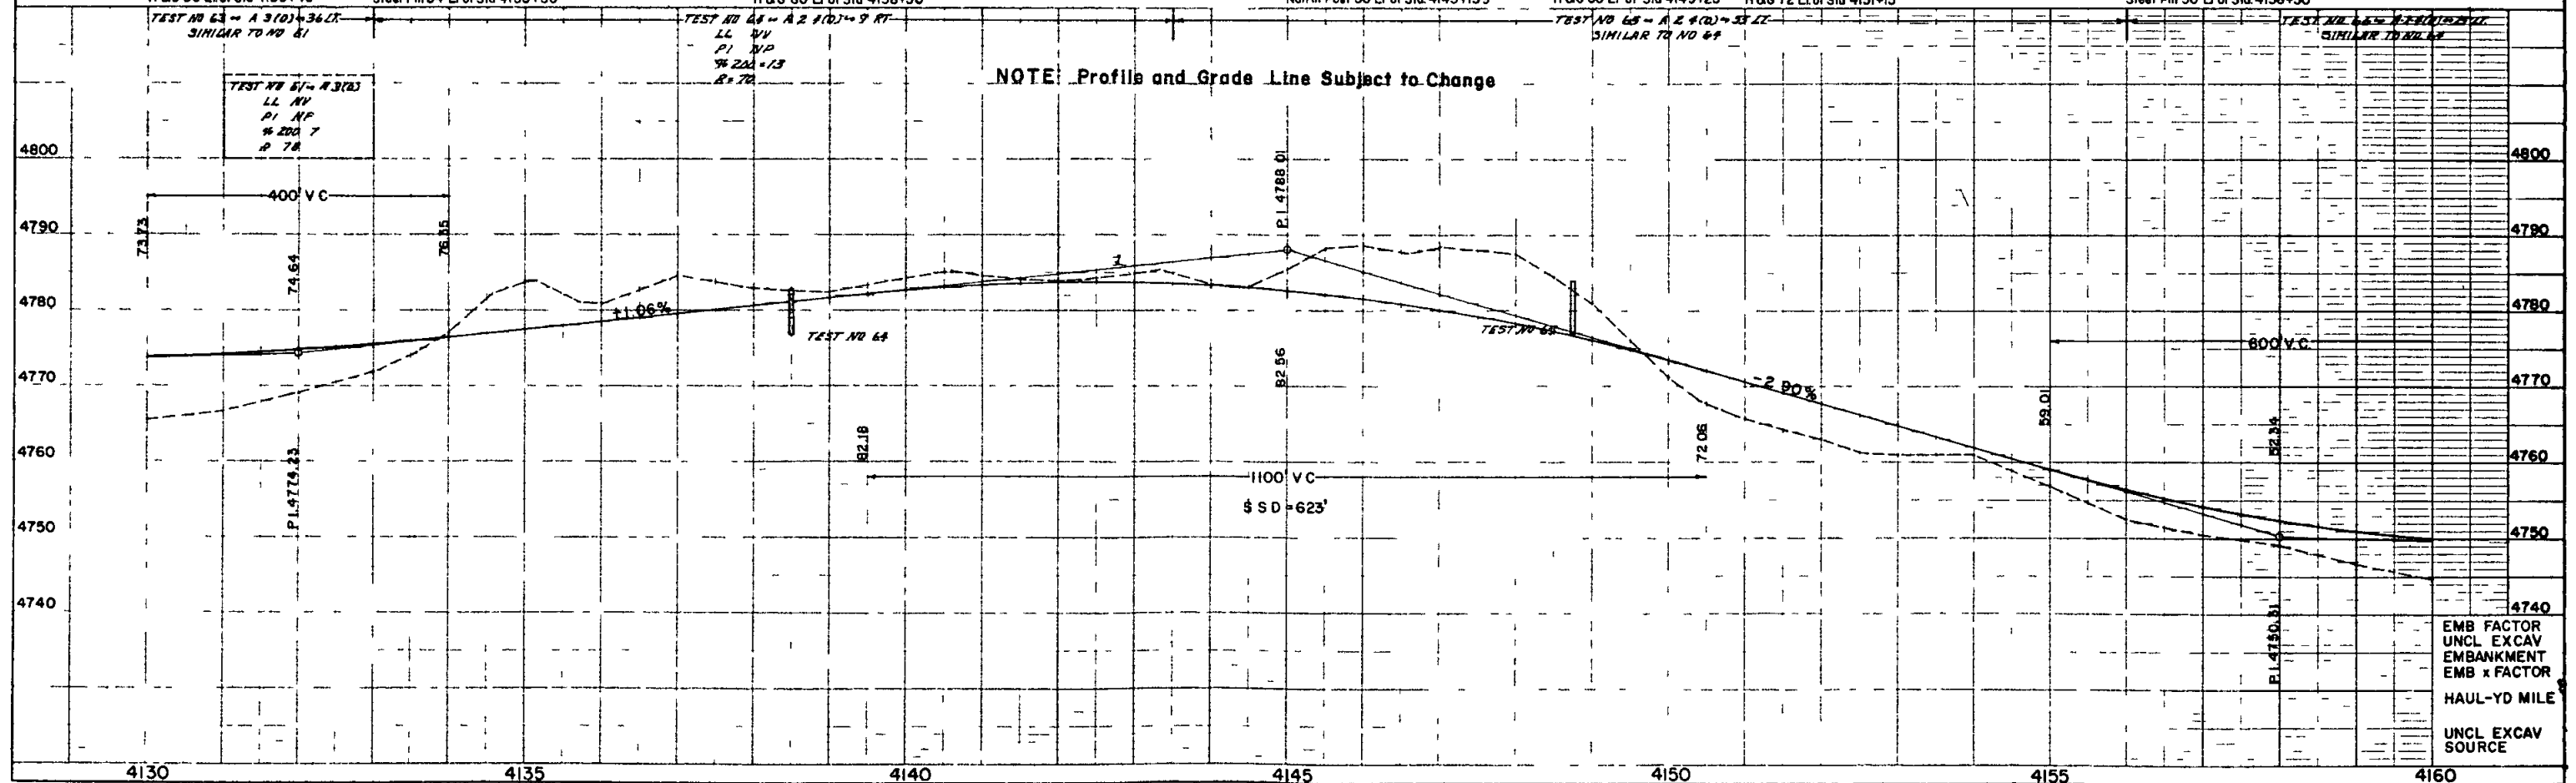


EMB FACTOR
UNCL EXCAV
EMBANKMENT
EMB x FACTOR
HAUL-YD MILE
UNCL EXCAV
SOURCE

[illegible]

East of Punkin Center

All of Sec. 5
T14S, R 52W
Robert E Palmer
Hugo, Colorado

22 All of Sec 8
T 14 S, R 52 W
Robert E Palmer
Hugo, Colorado

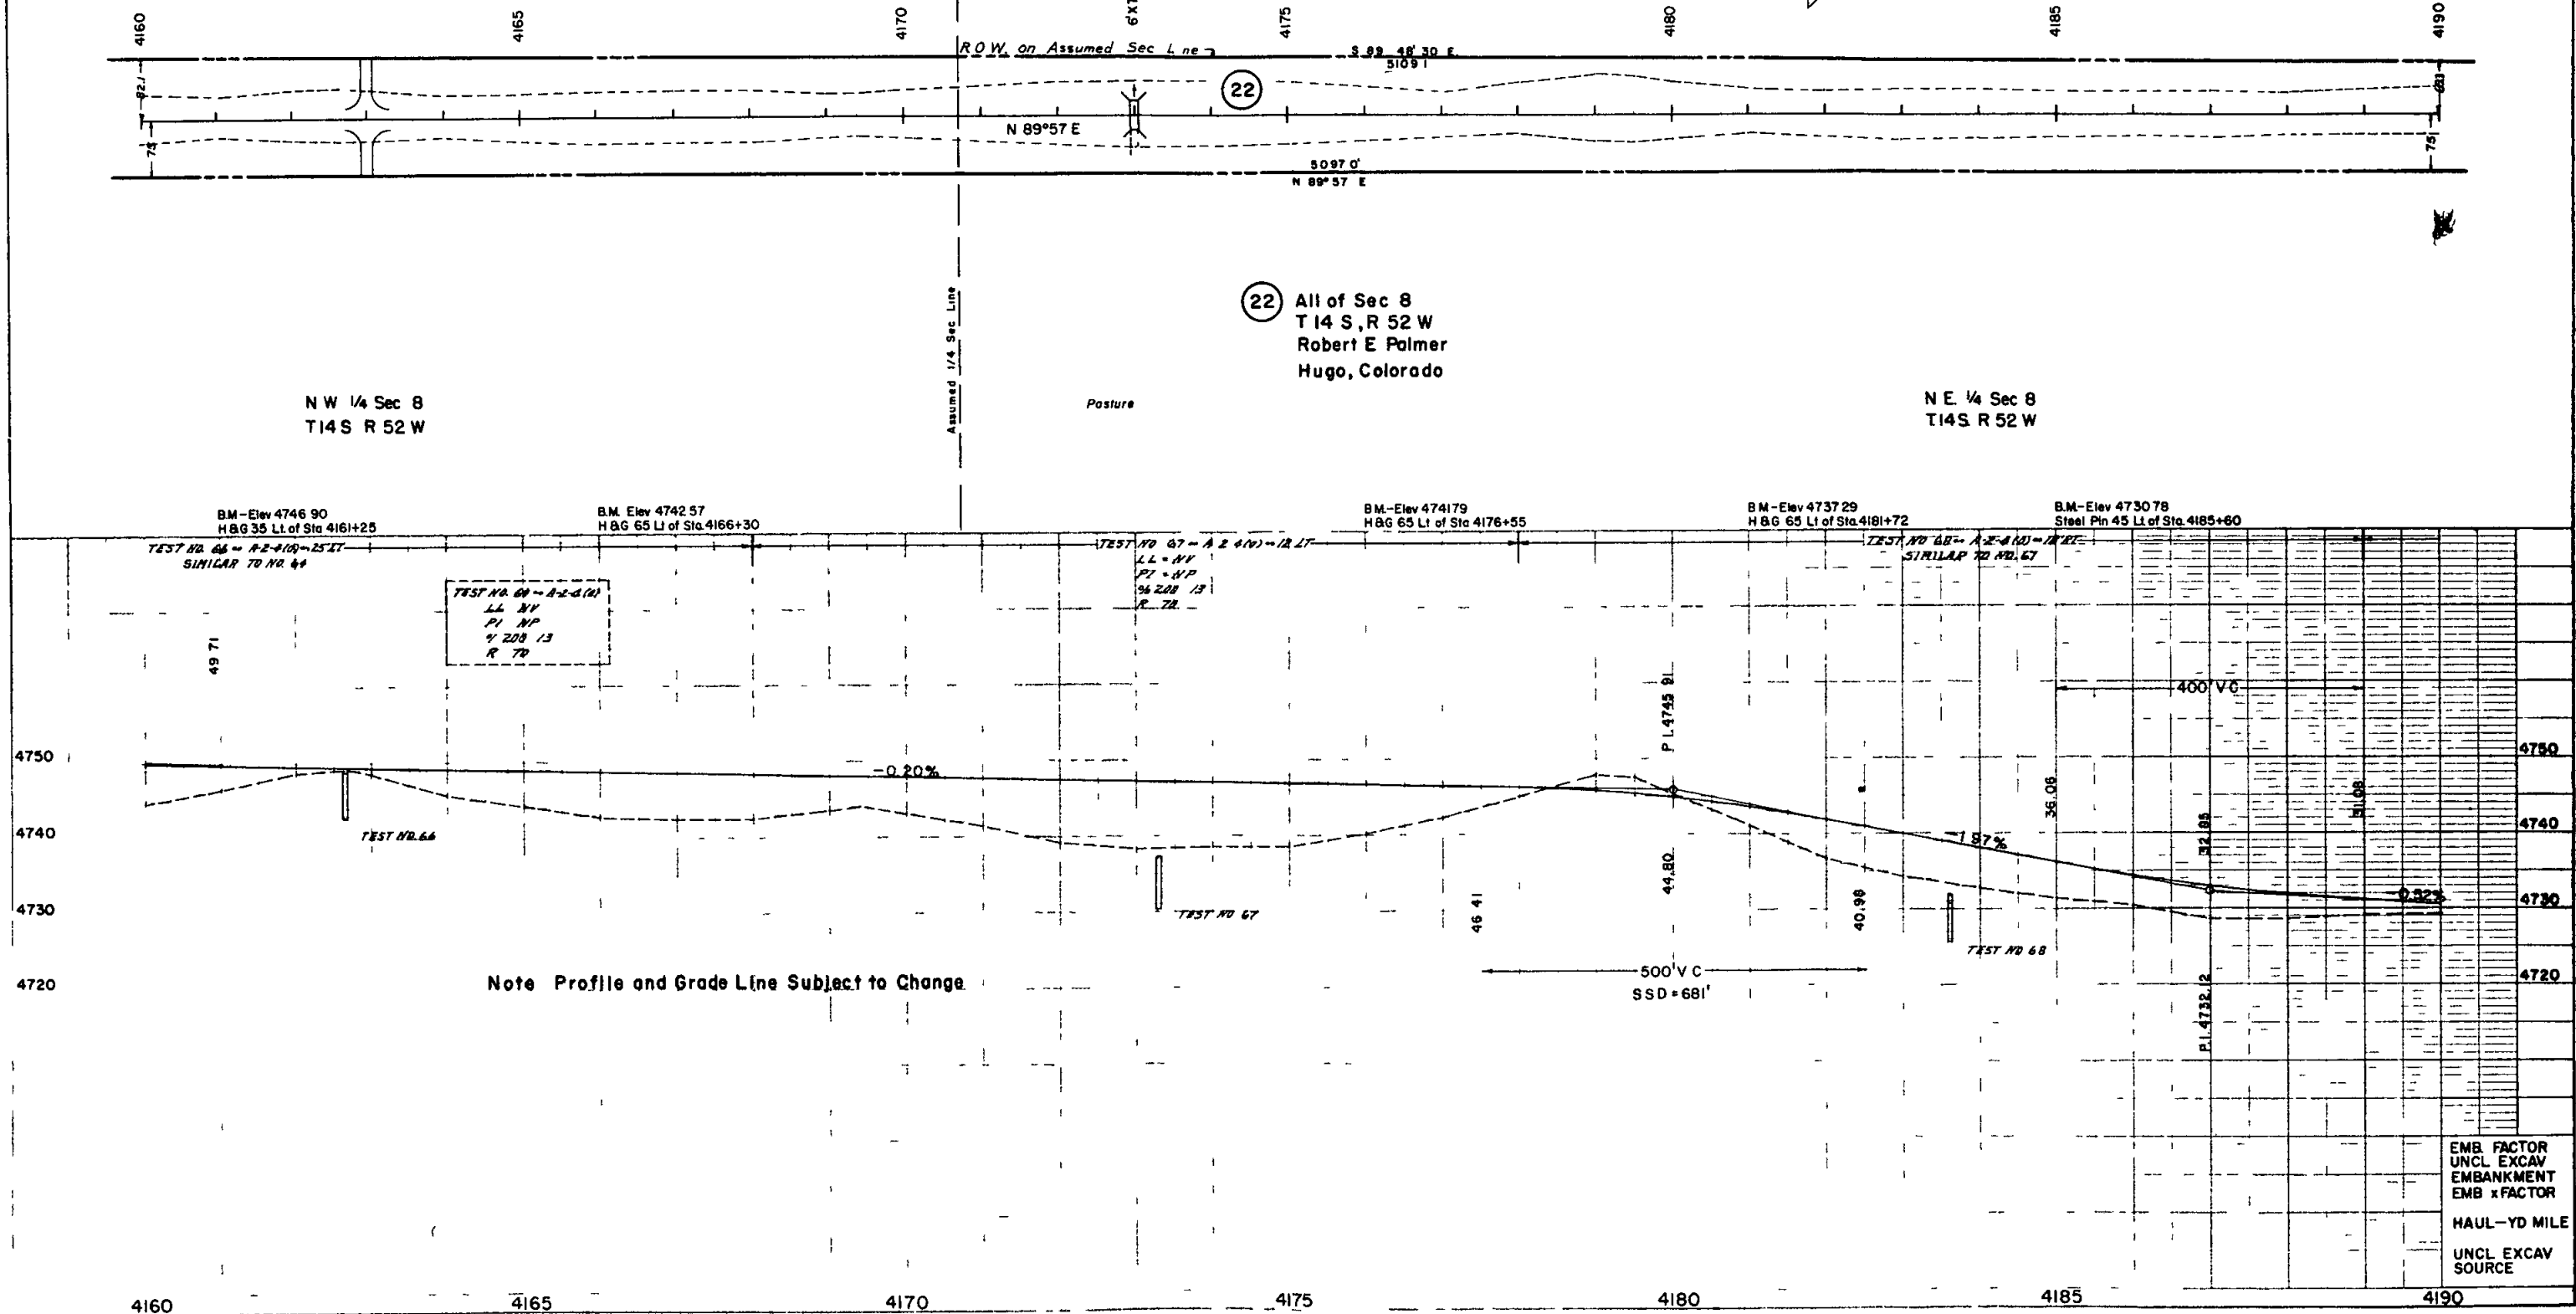

S.E. 1/4 Sec. 5
T14S. R. 52 W


All of Sec 5
T14 S, R 52 W
Robert E Palmer
Hugo, Colorado

All of Sec 4
T14 S, R 52 W
John Robert Schafer
John Keith Schafer
Robert Gary Schafer
Hugo, Colorado

S.W. 1/4 Sec. 4
T14 S R 52 W

DIVISION	PROJECT NO	SHEET NO	TOTAL SHEETS
LOLO	S0020(12) Sec. 2	13	

RIGHT OF WAY East of Punkin Center

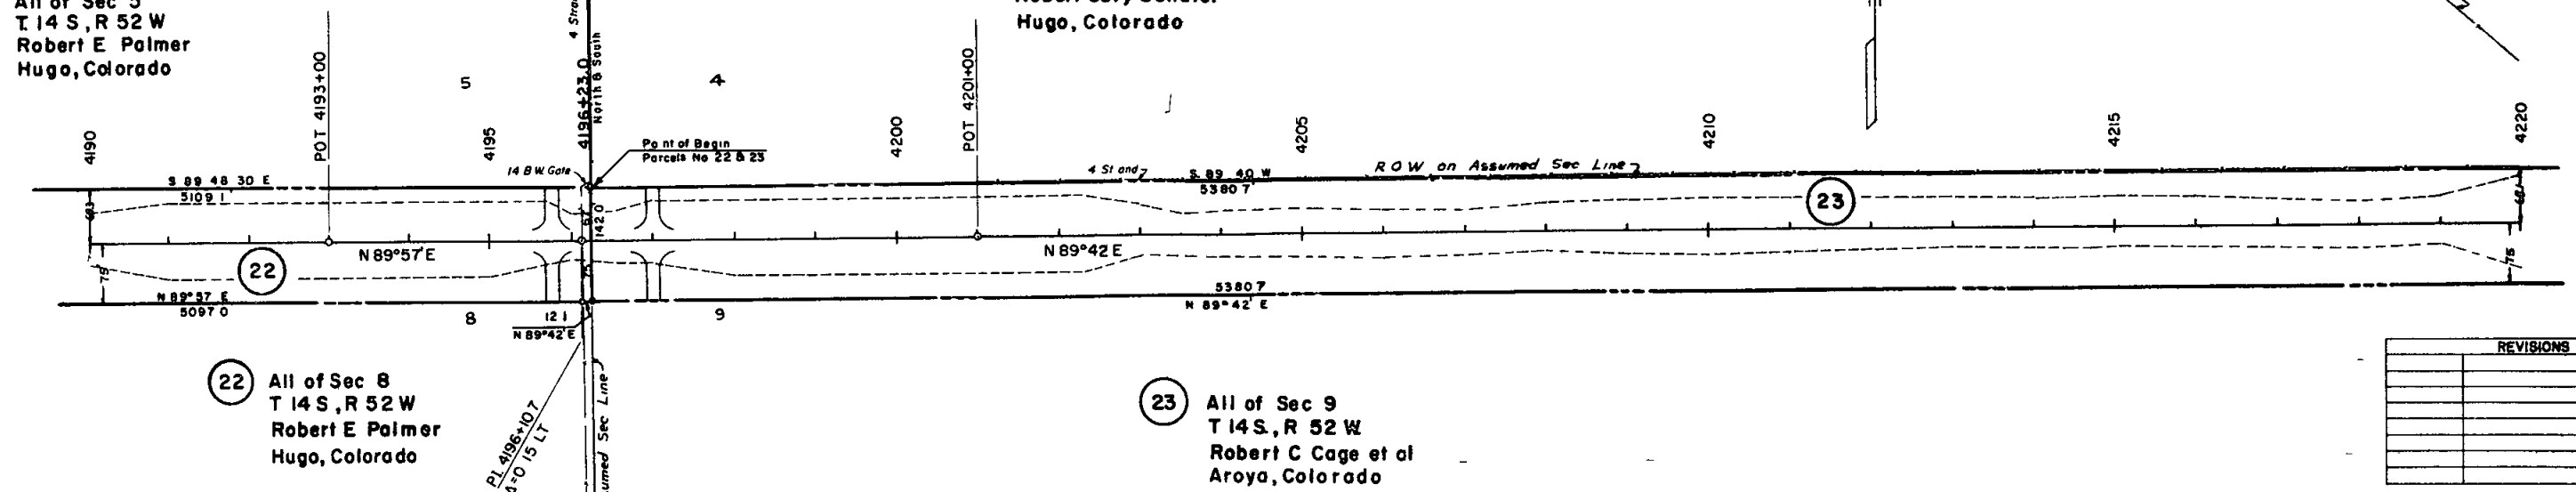


REVISIONS

N.E. 1/4 Sec 8
T14S. R 52 W

N.W. 1/4 Sec 9
T14 S. R 52 W


BM - Elev 4729.11 H.B.G. 60 Lt of Sta 4191+20
BM - Elev 4724.43 Nail in Post 70 Lt of Sta 4197+50
BM - Elev 4711.45 Nail in Post 70 Lt of Sta 4203+15
BM - Elev 4702.49 Nail in Post 70 Lt of Sta 4208+75
BM - Elev 4695.38 H.B.G. 70 Lt of Sta 4214+10

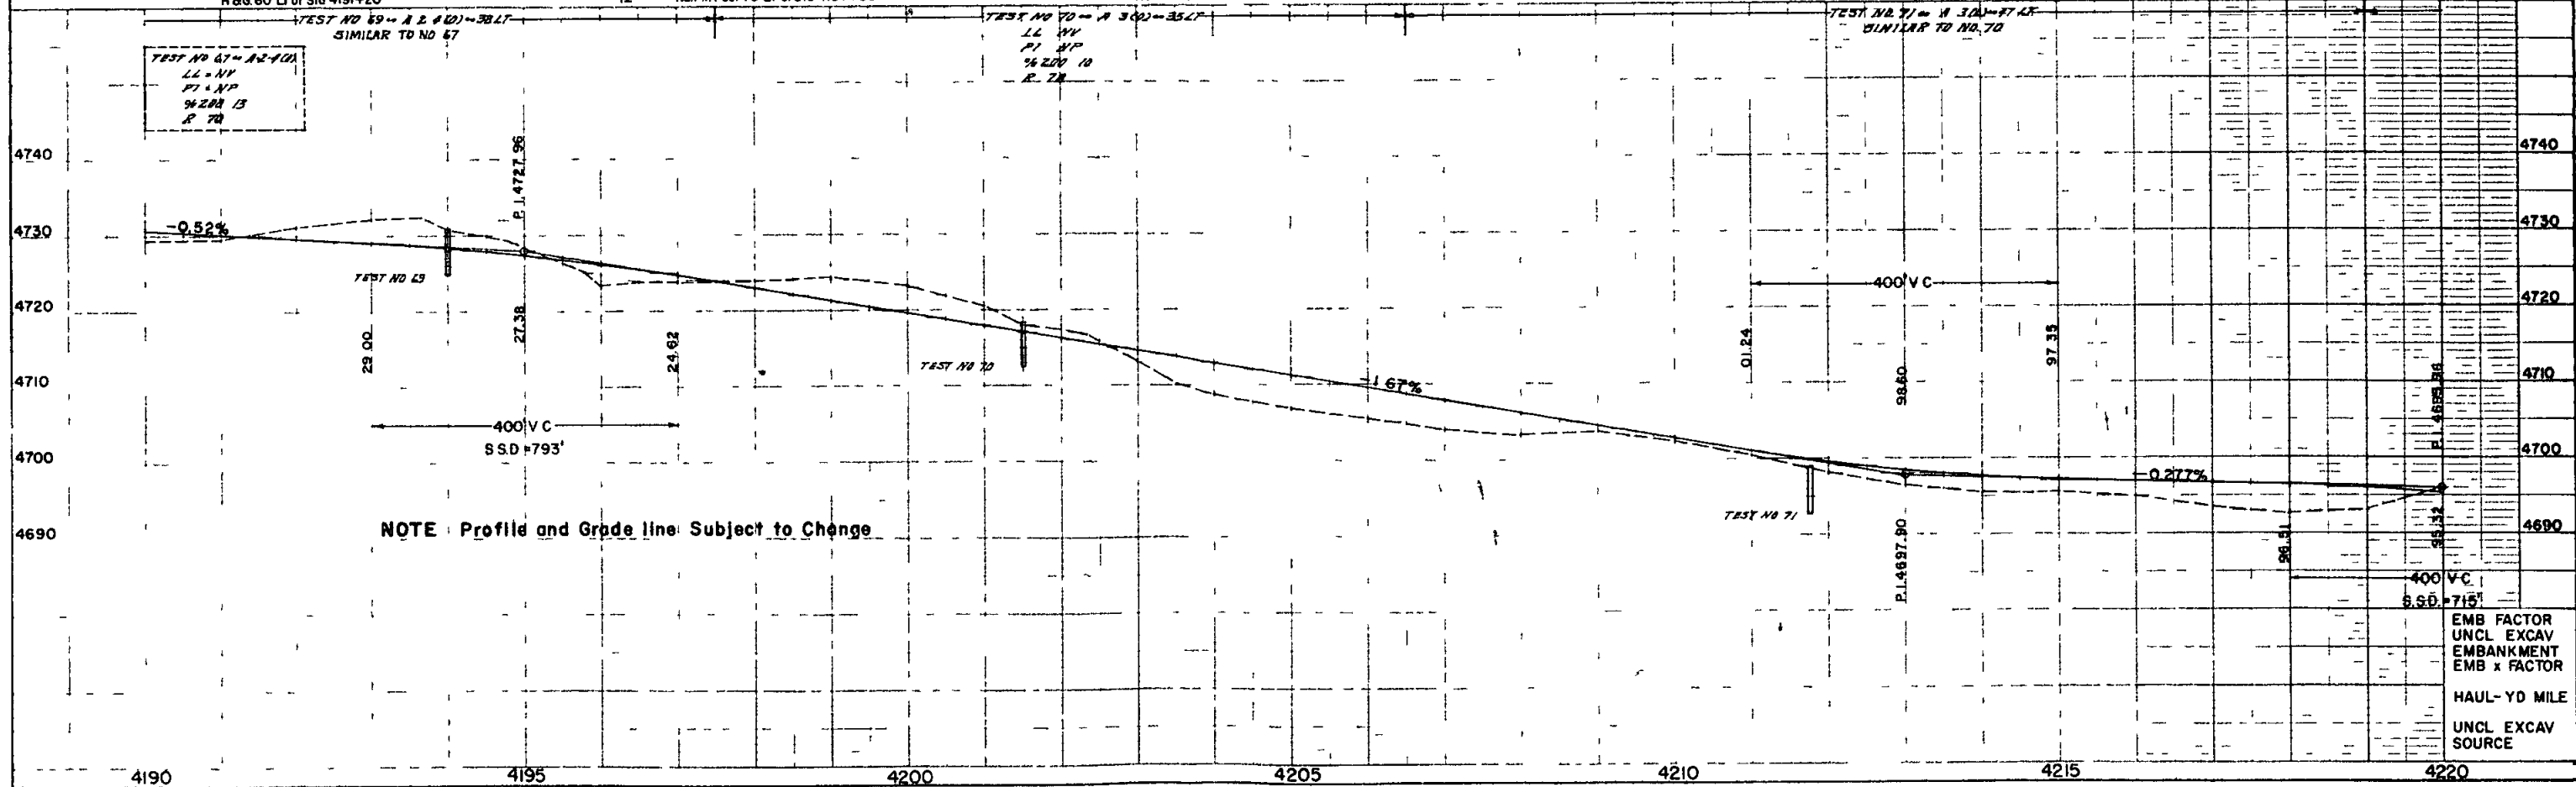



NOTE: Profile and Grade line: Subject to Change

EMB FACTOR
UNCL EXCAV
EMBANKMENT
EMB x FACTOR

HAUL - YD MILE
UNCL EXCAV
SOURCE

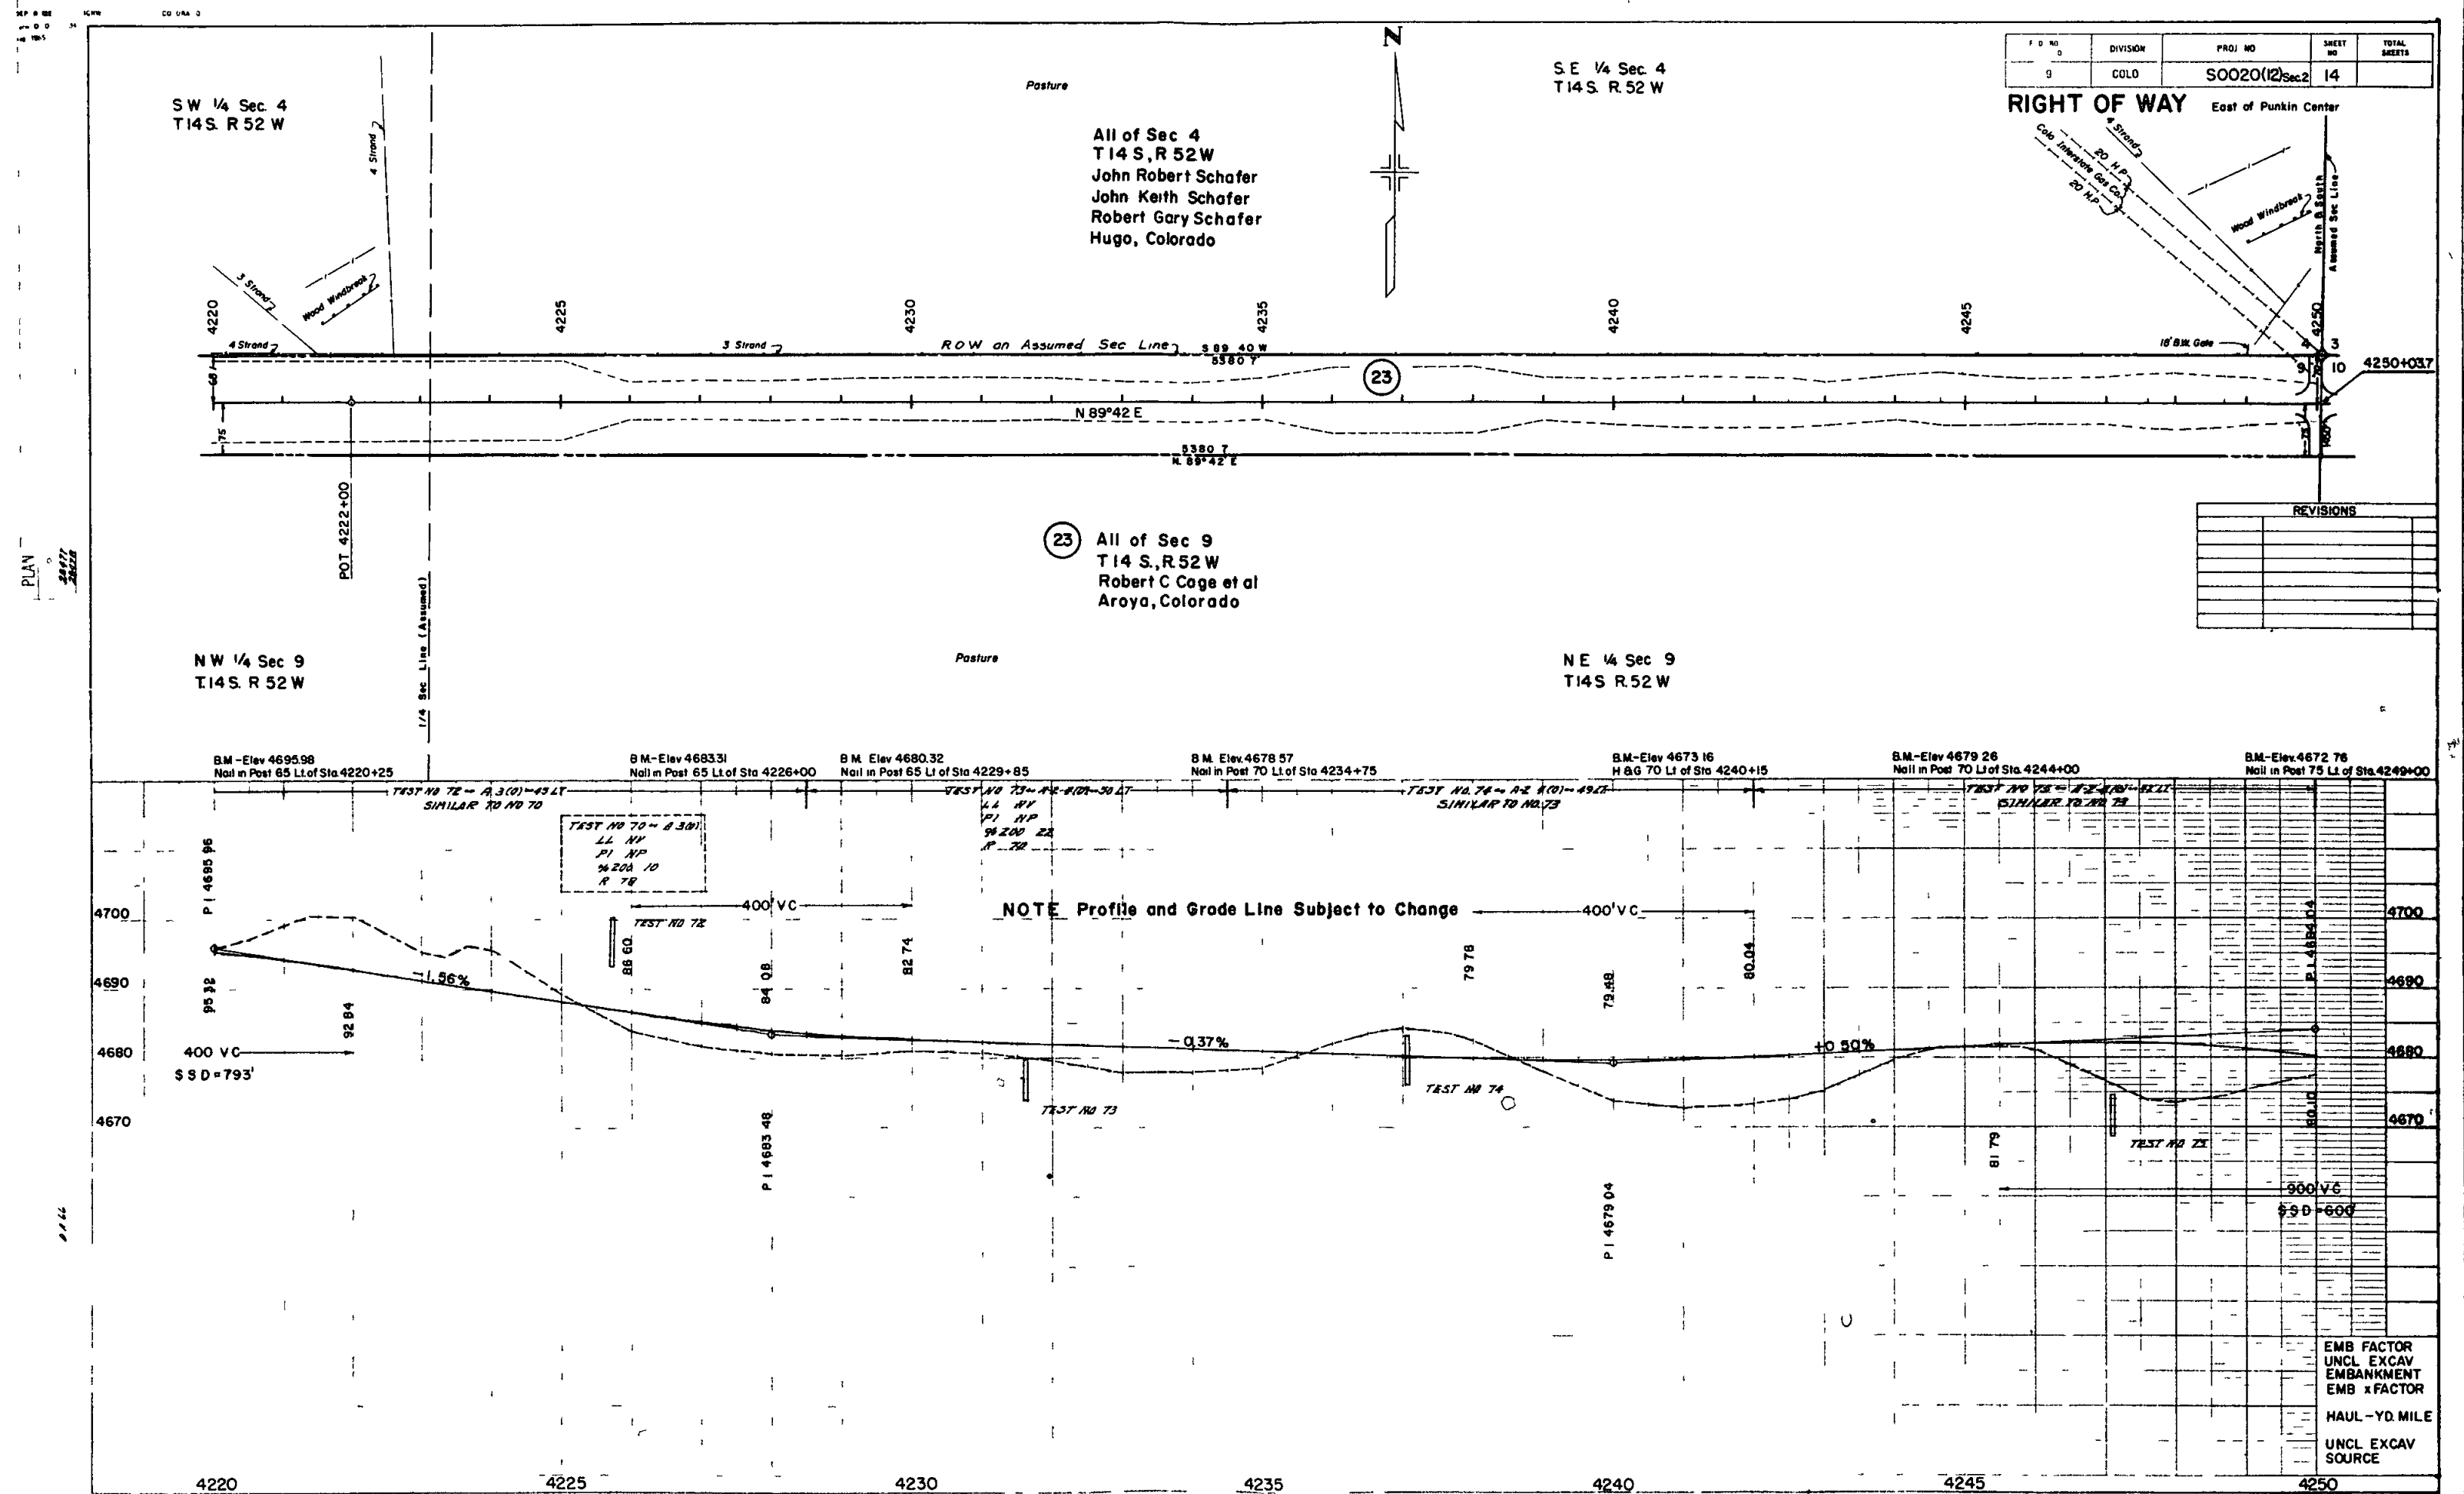

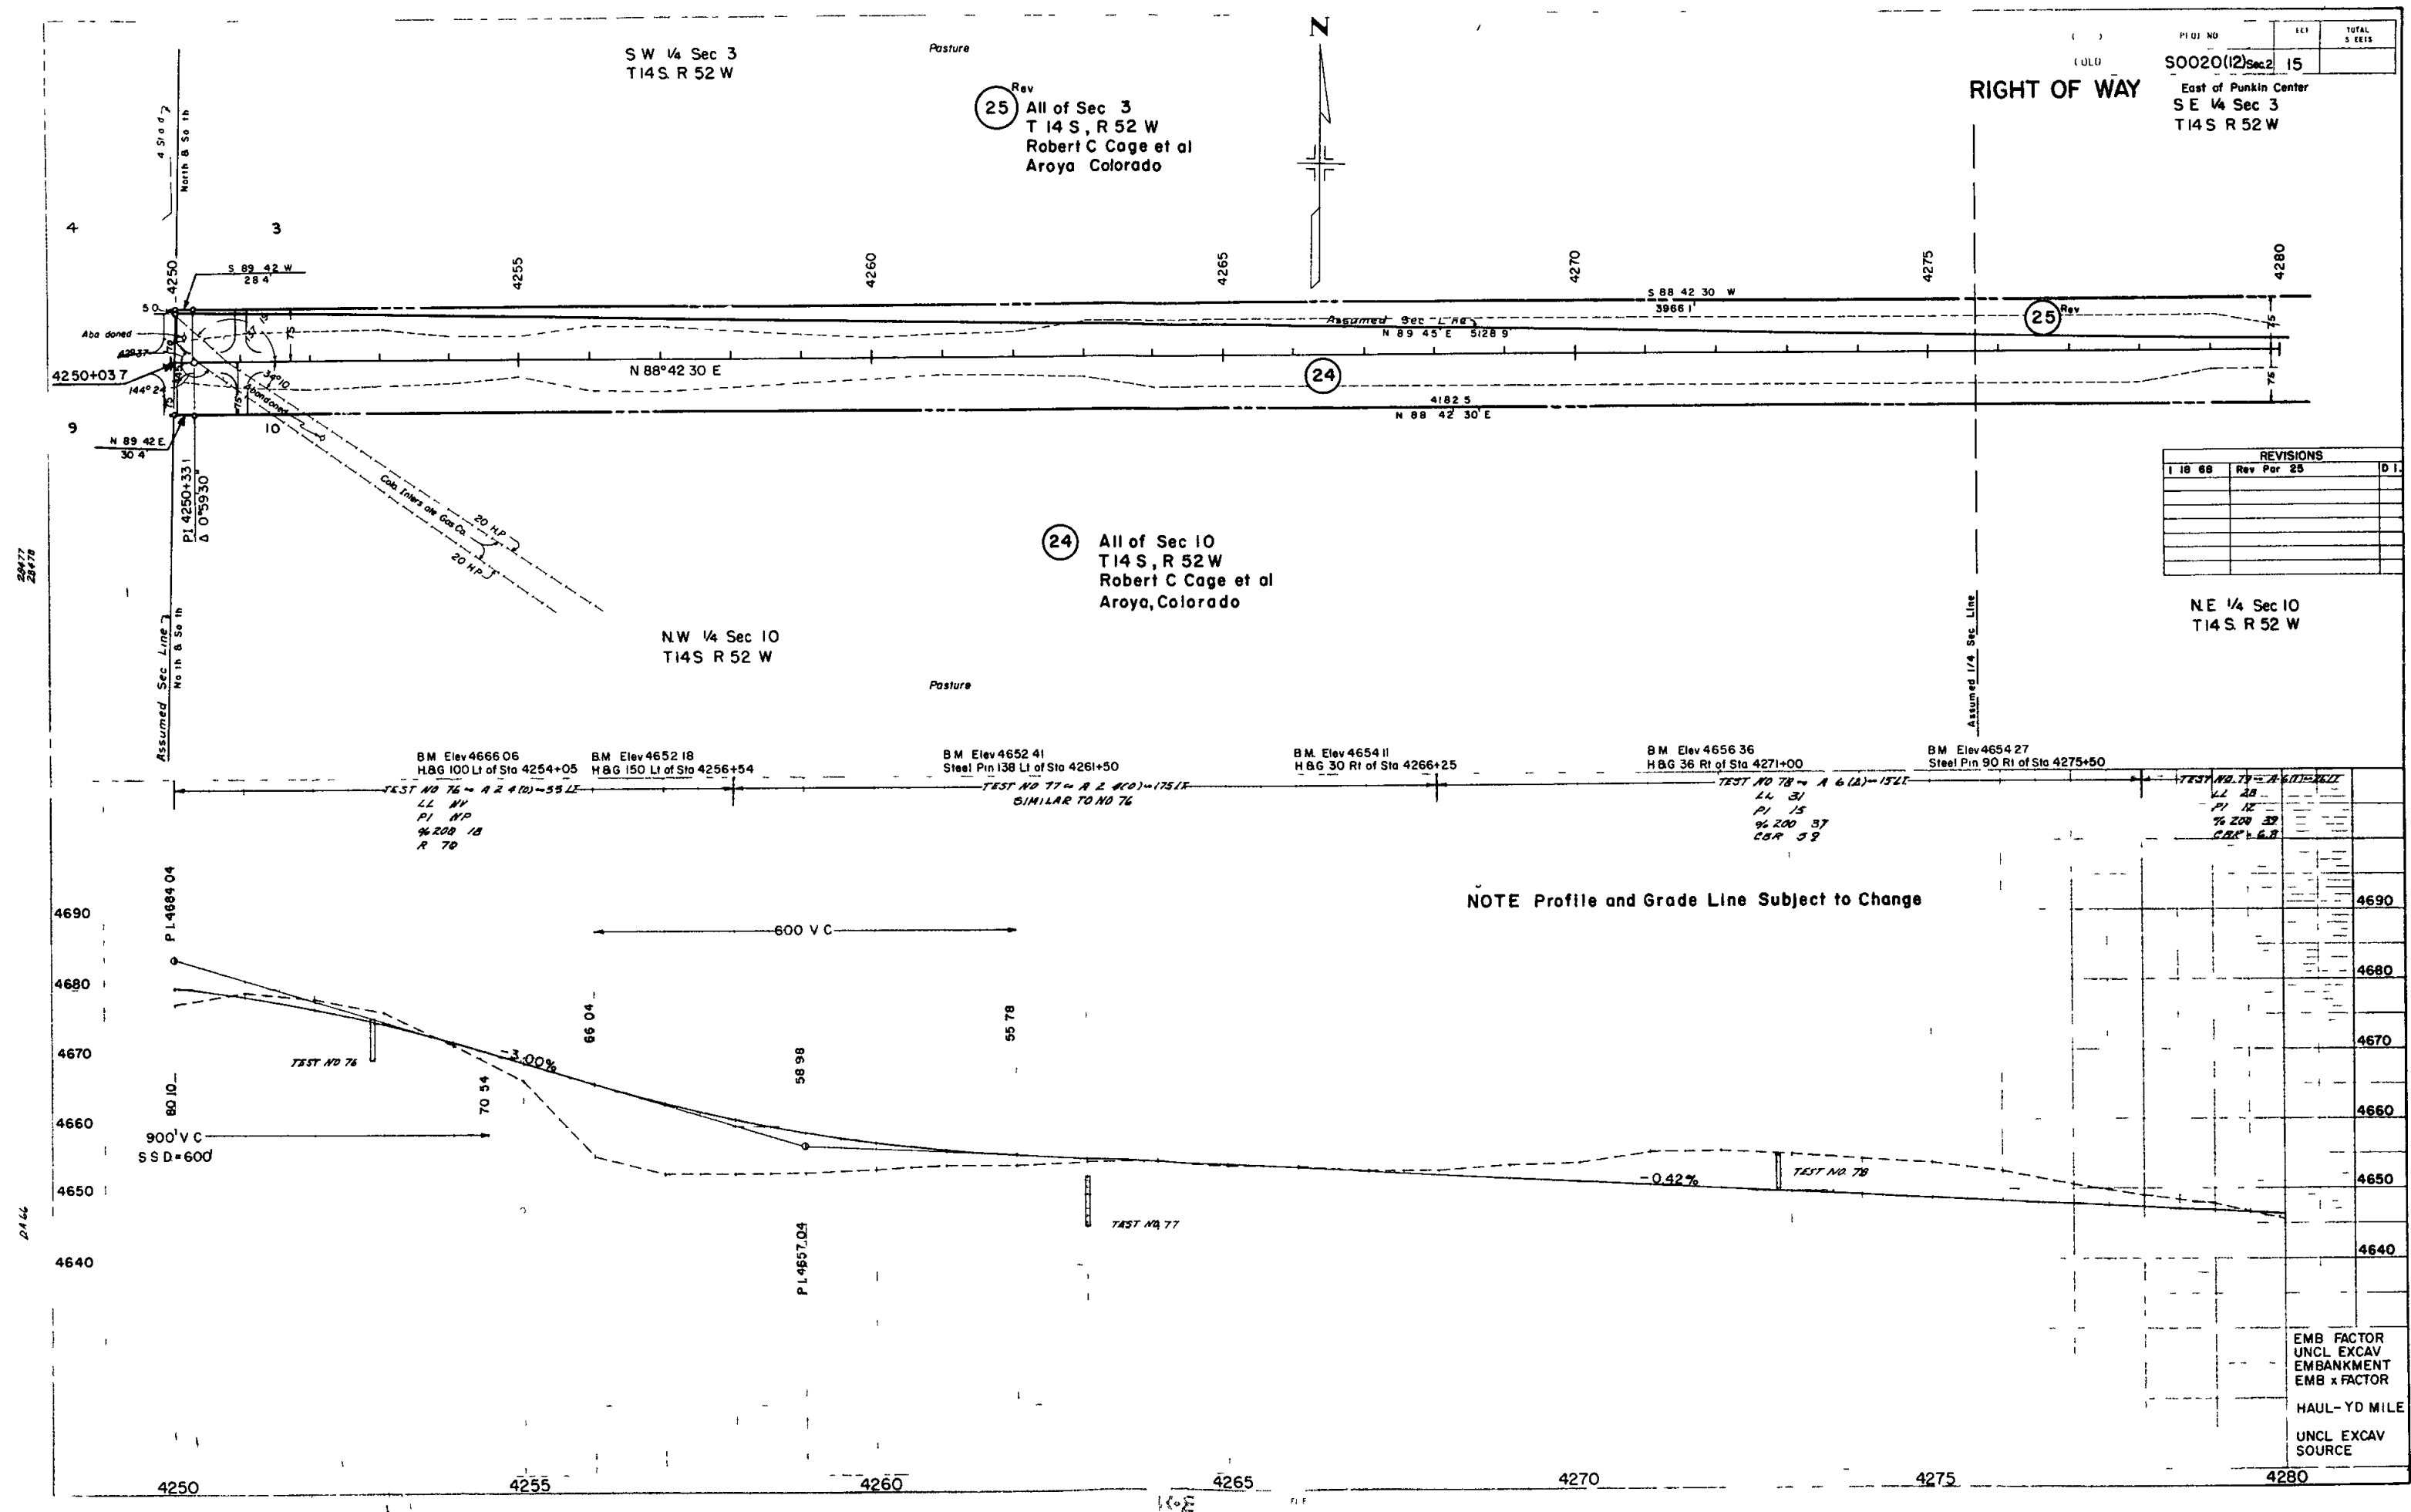

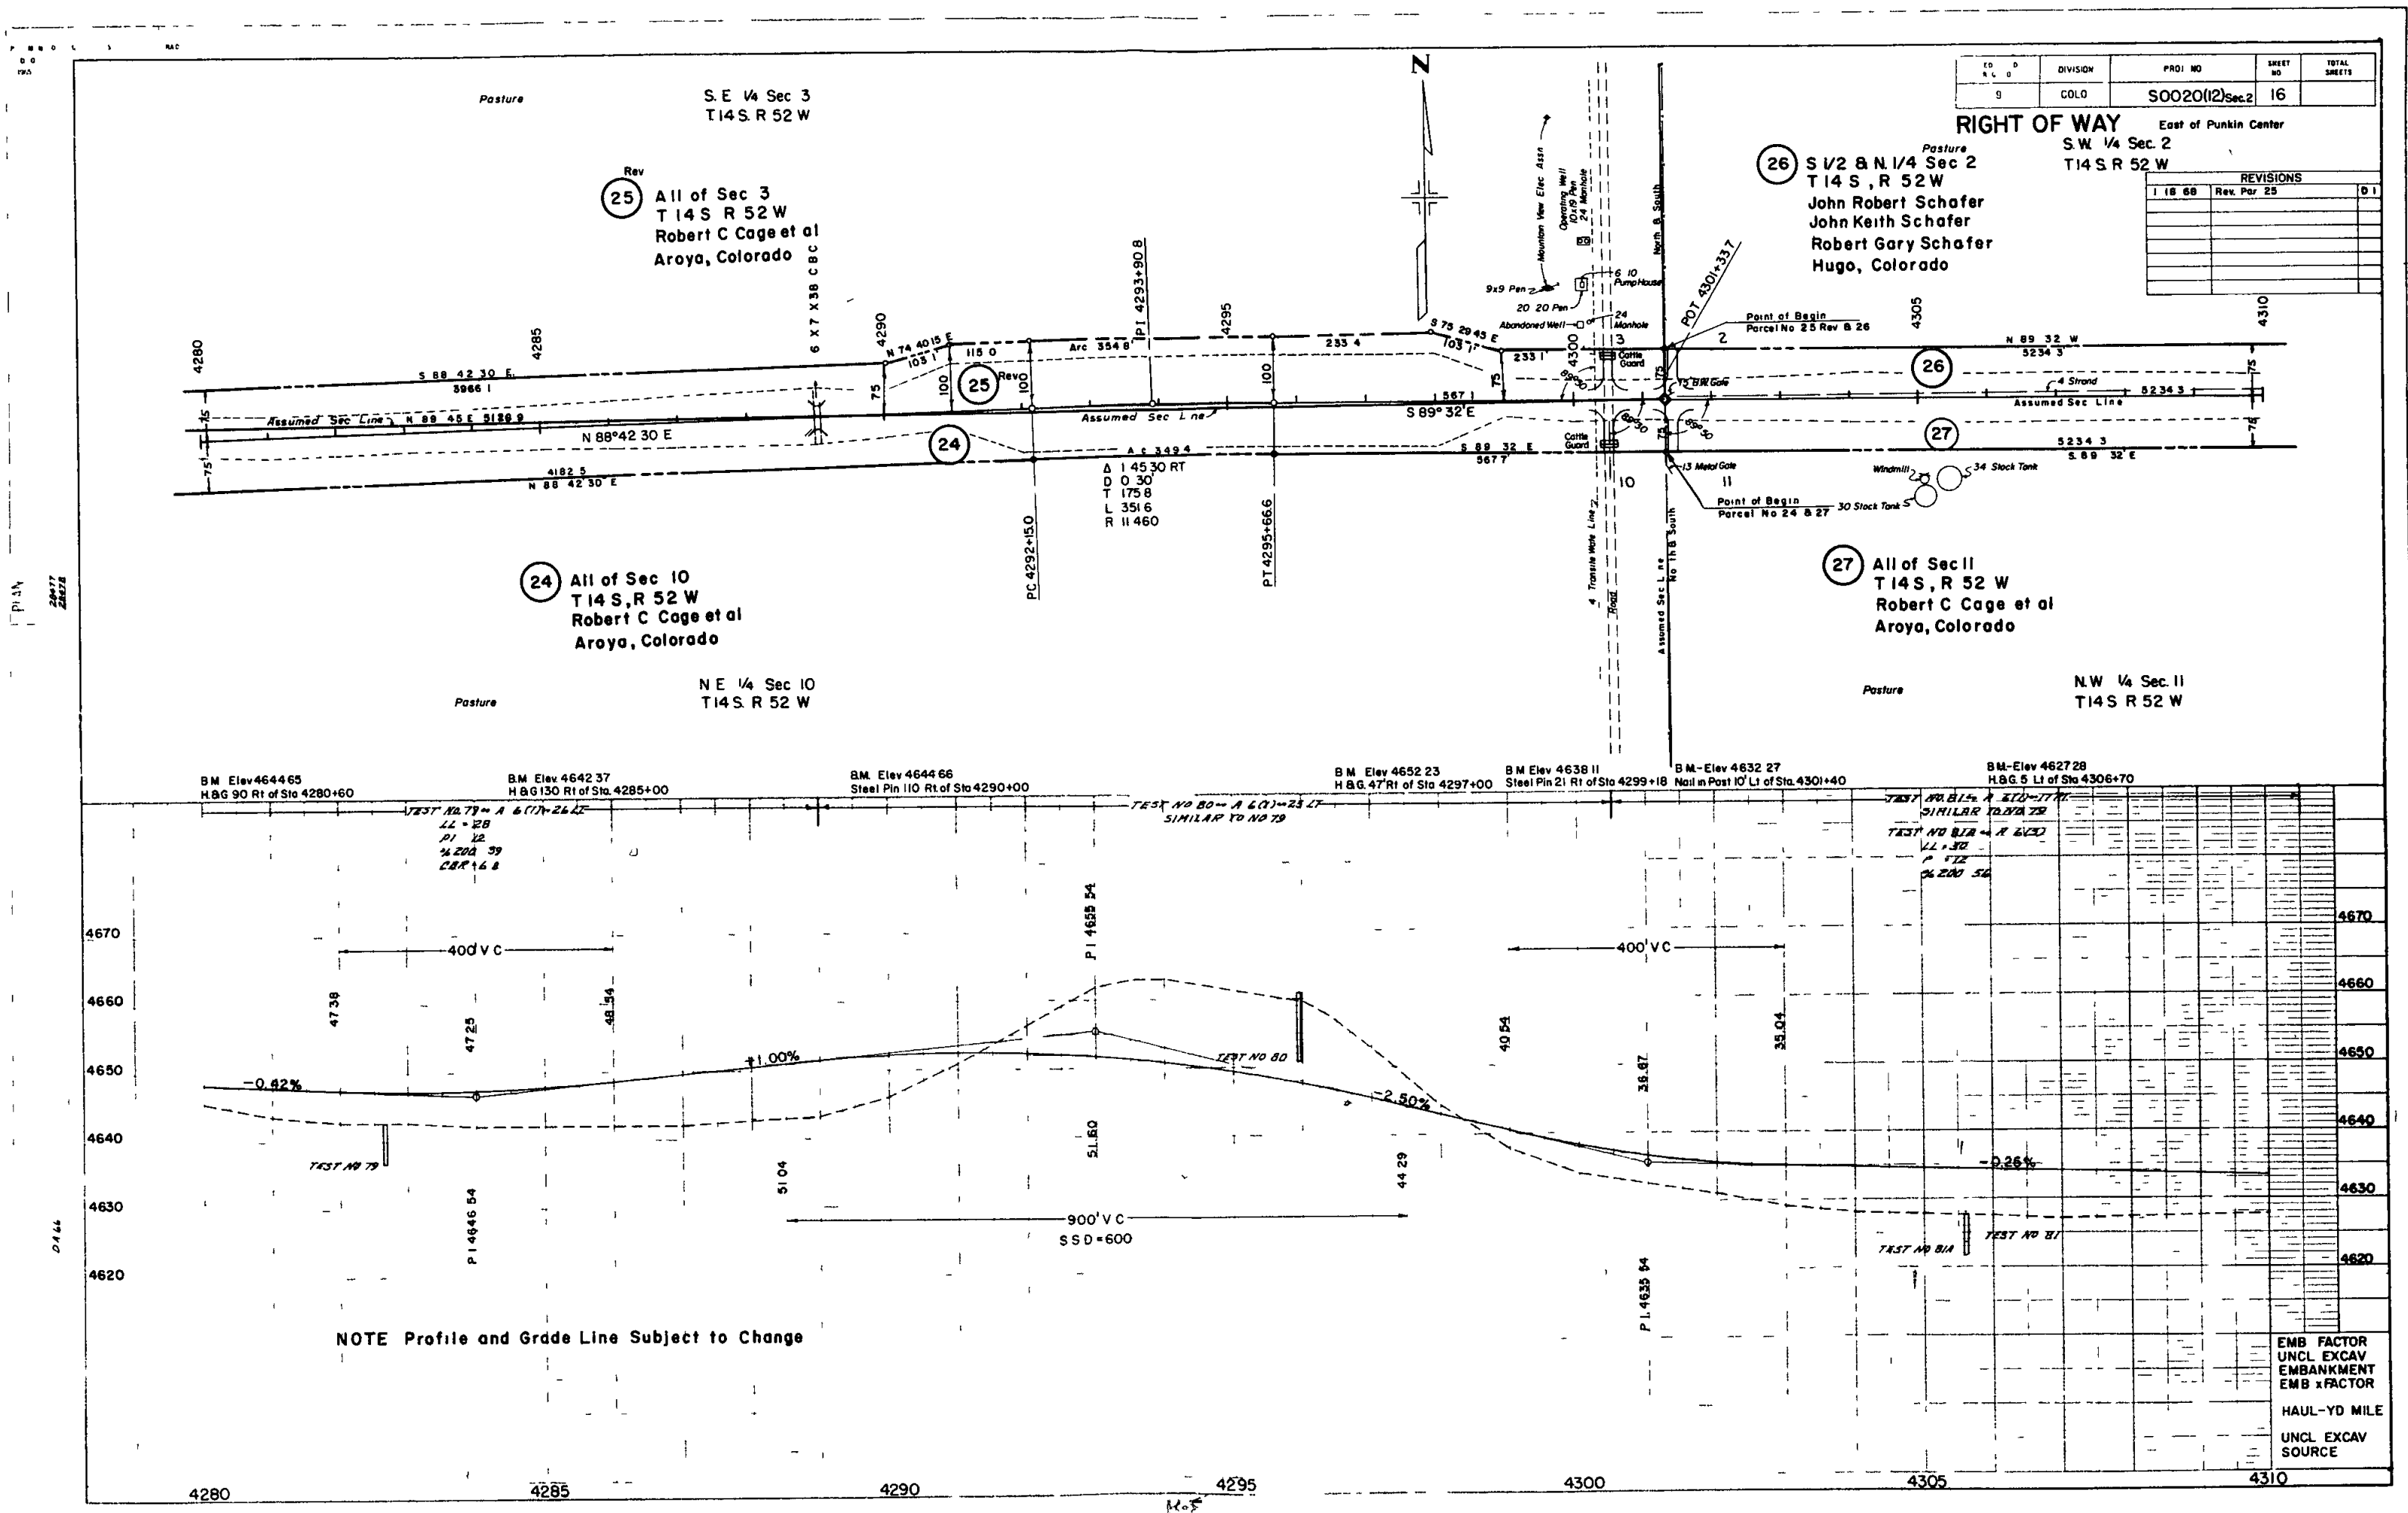

SW 1/4 Sec 2
T14S R 52 W

(26) S 1/2 & NE 1/4 Sec 2
T14S, R 52 W
John Robert Schafer
John Keith Schafer
Robert Gary Schafer
Hugo, Colorado


SE 1/4 Sec 2
T14S R 52 W

RIGHT OF WAY

East of Punkin Center

REVISIONS


NO.	DESCRIPTION

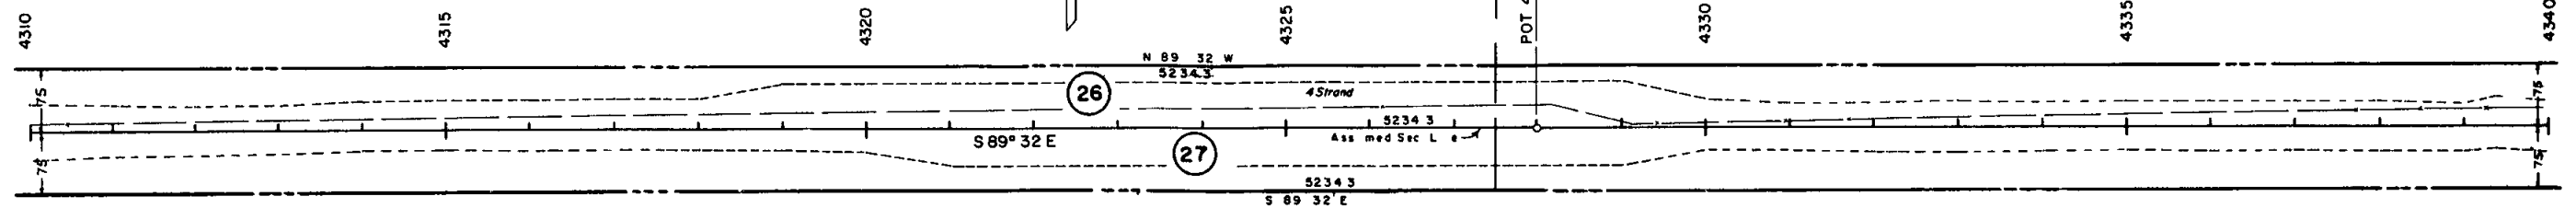


(27) All of Sec II
T 14S, R 52 W
Robert C Cage et al
Aroya, Colorado

NW 1/4 Sec II
T14S R 52 W

NE 1/4 Sec II
T14S R 52 W

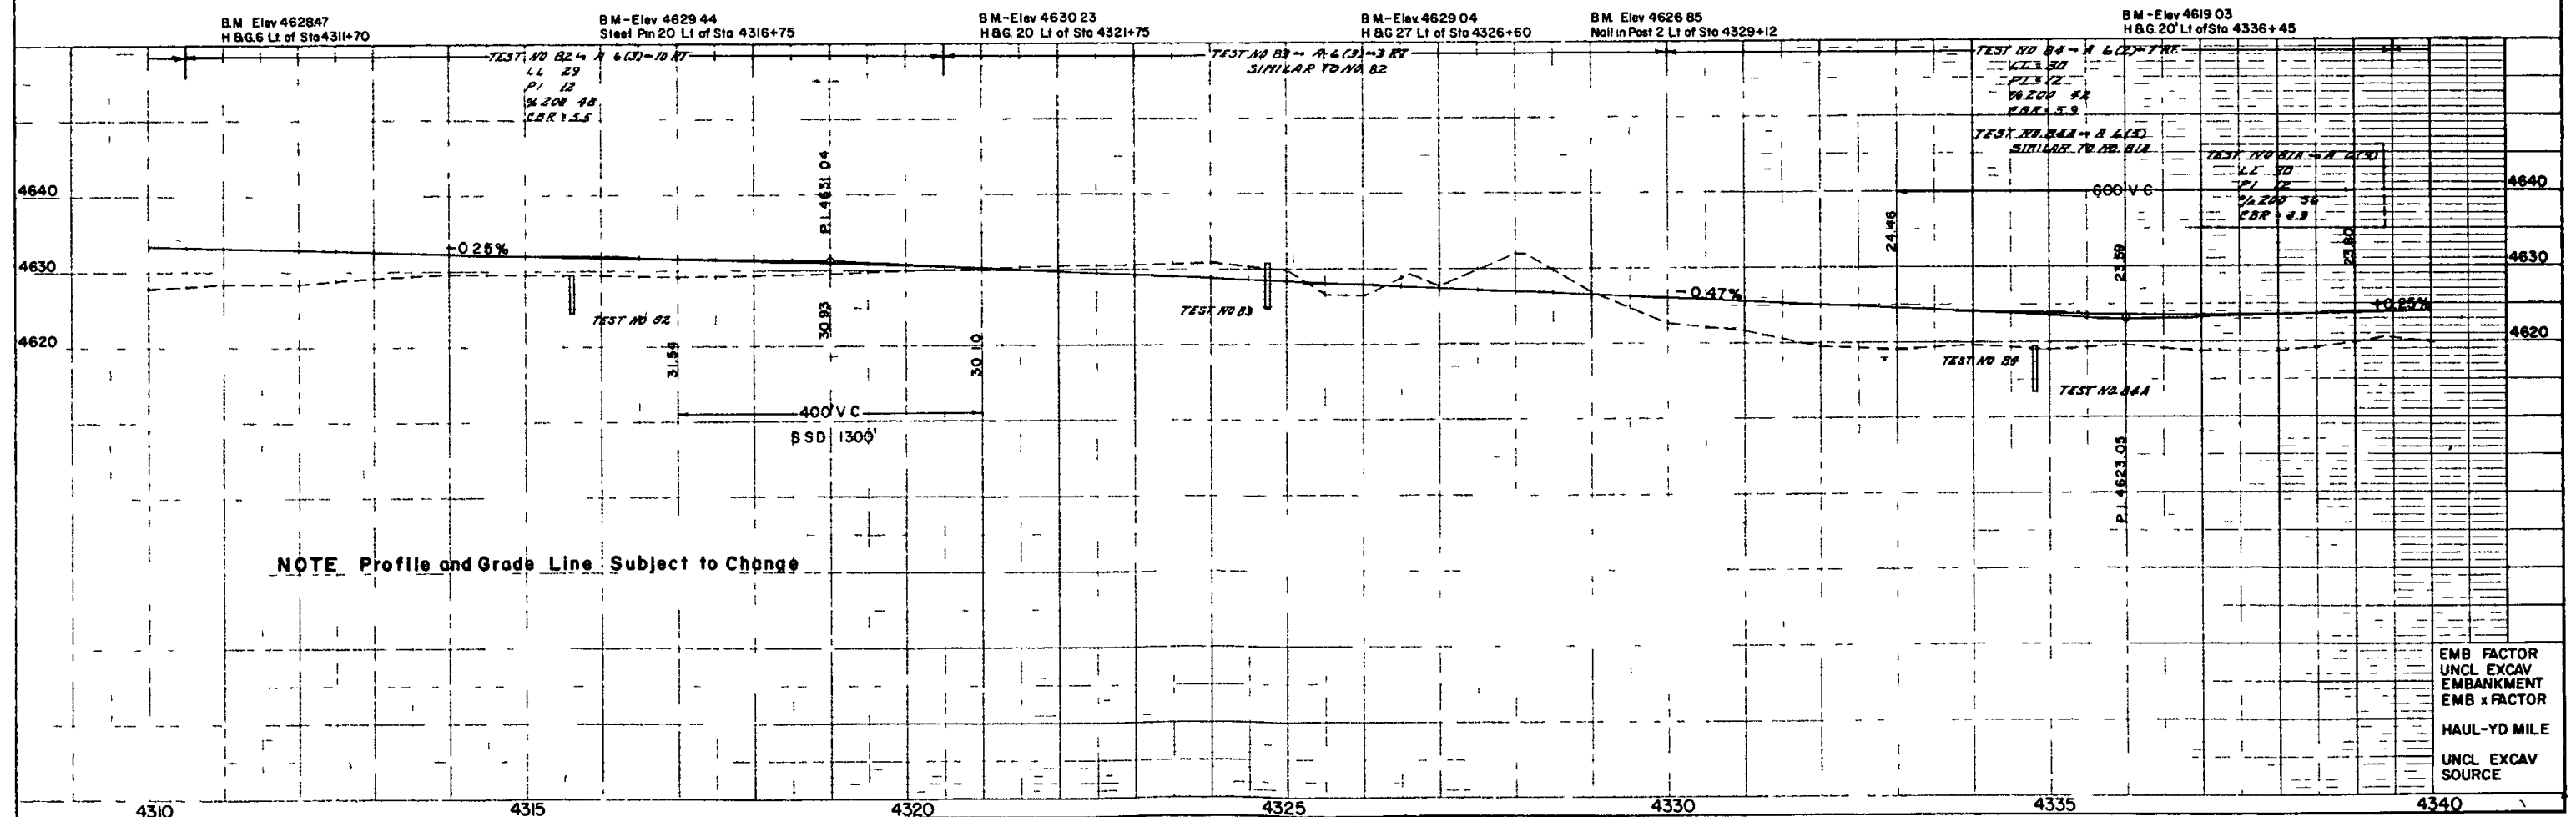

EMB FACTOR
UNCL EXCAV
EMBANKMENT
EMB x FACTOR
HAUL-YD MILE
UNCL EXCAV
SOURCE

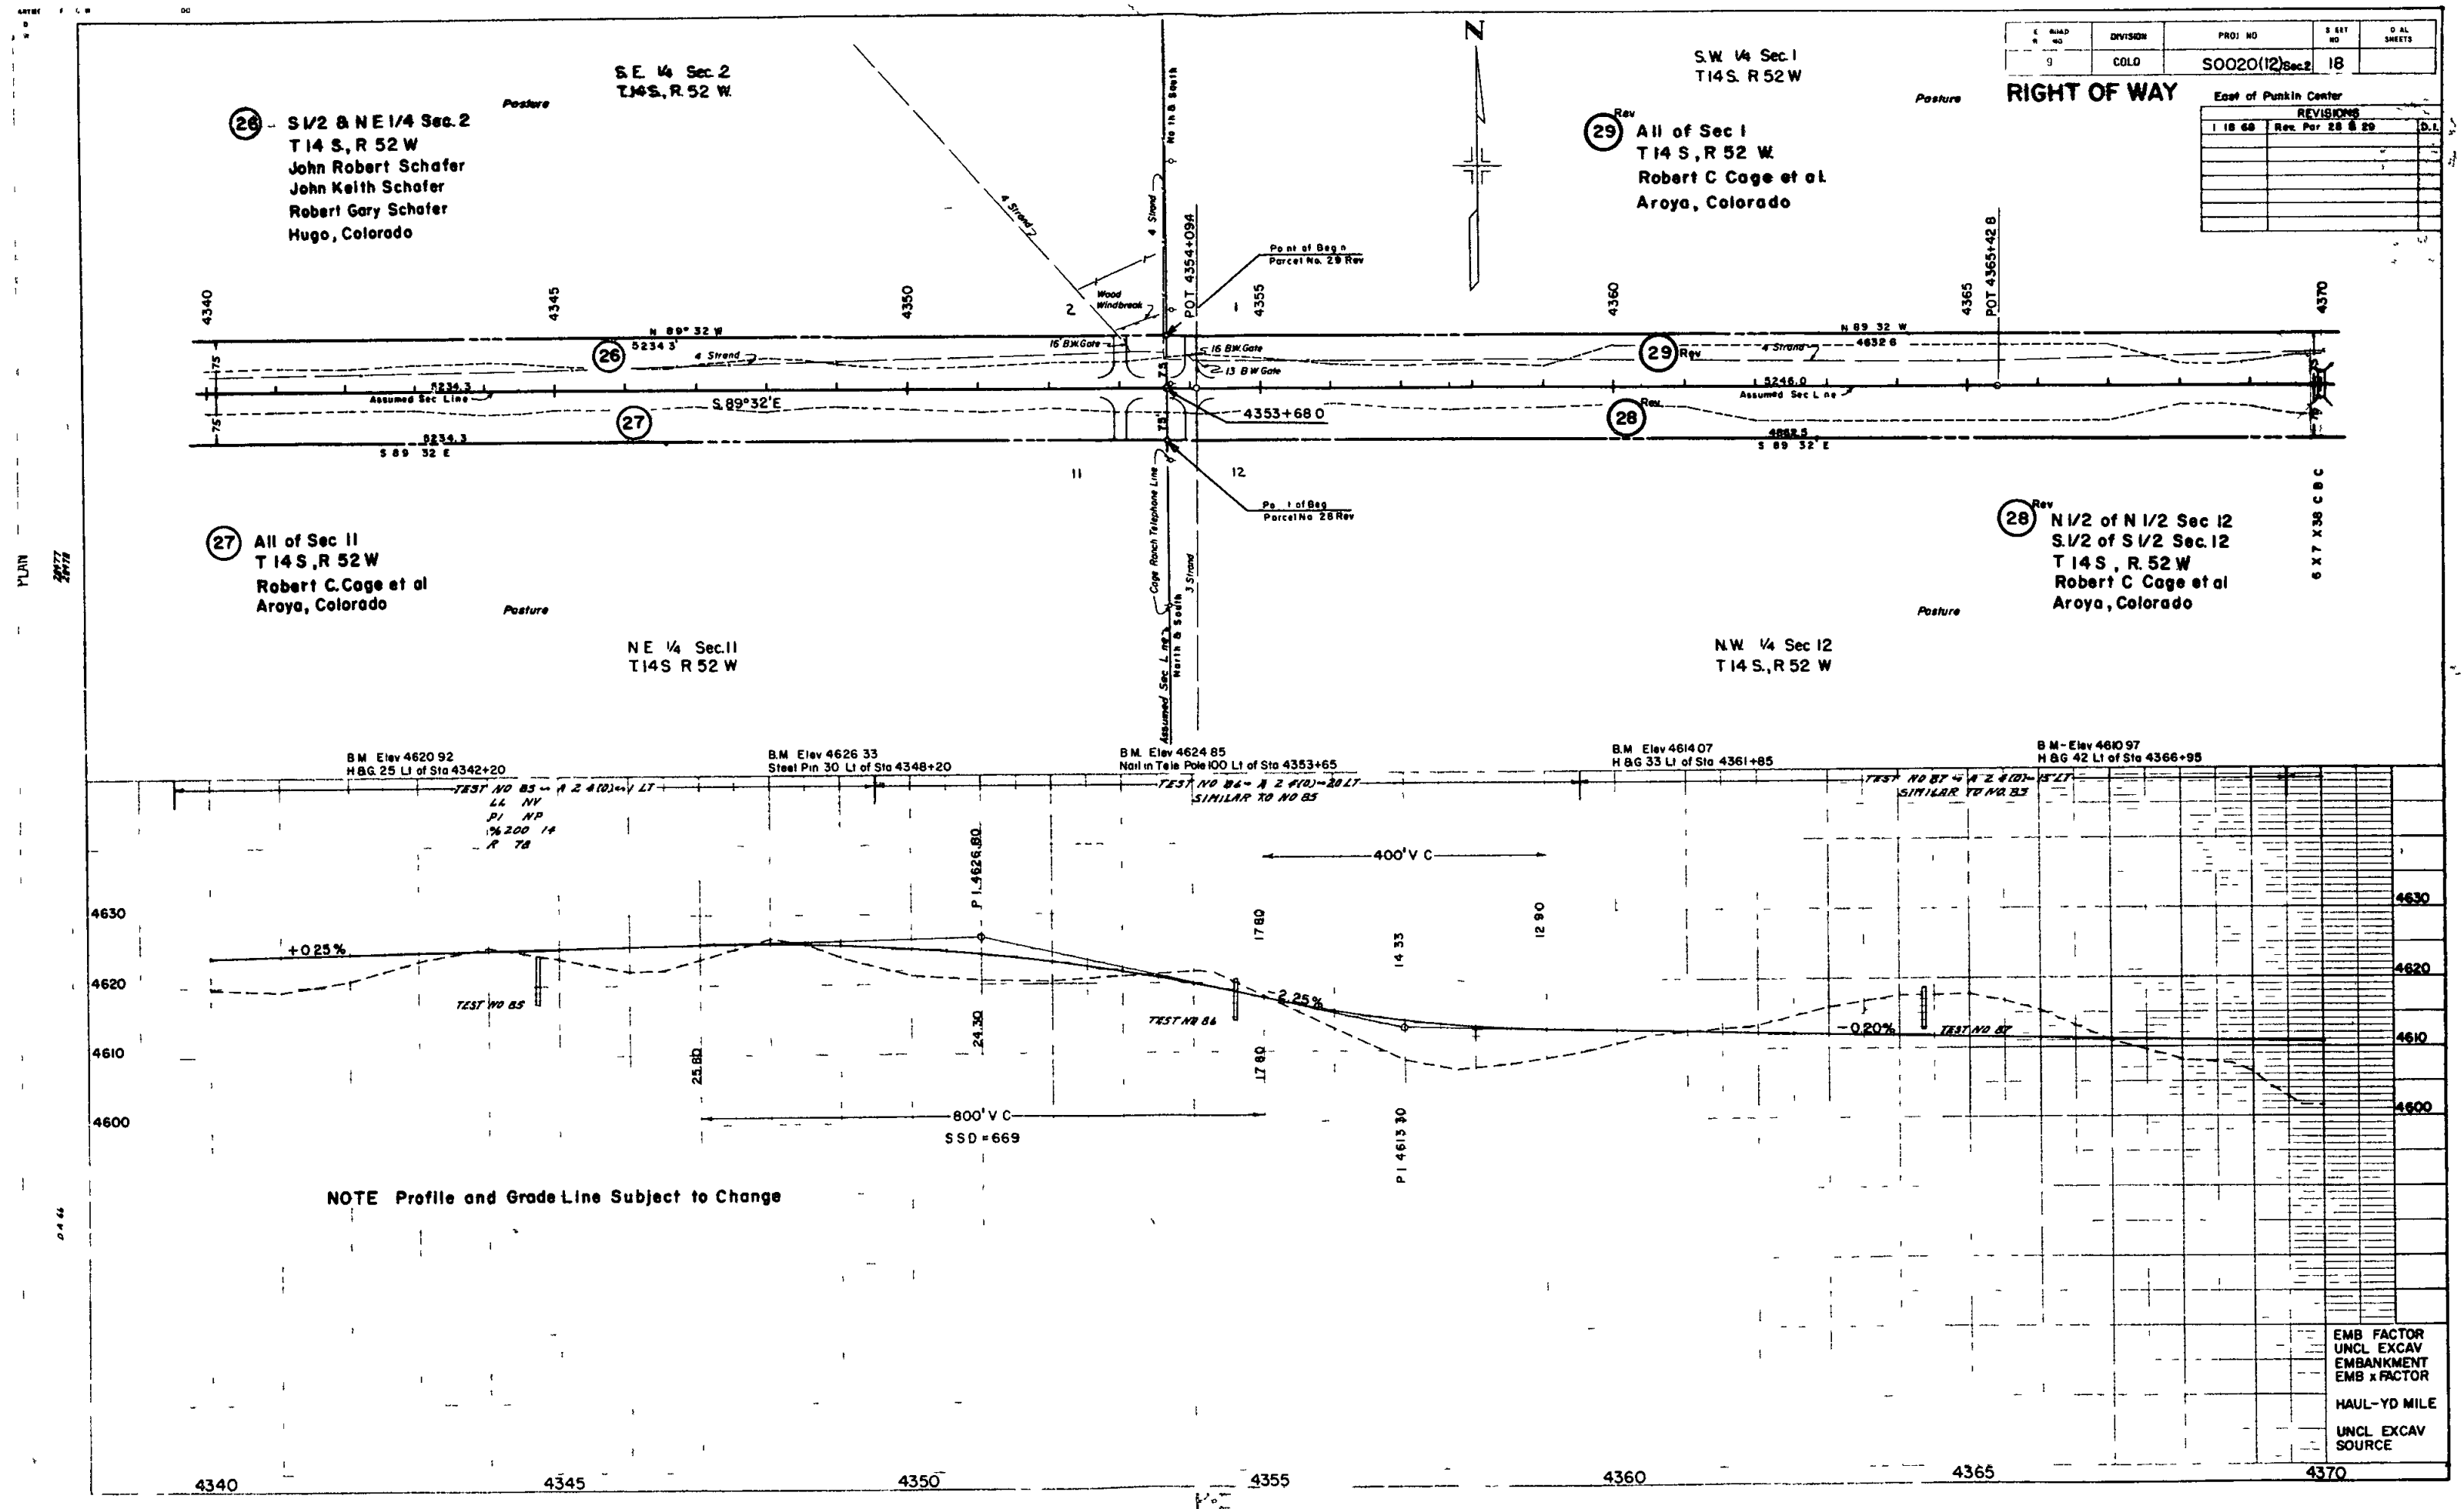

ROAD NO.	DIVISION	PROJ. NO.	SHEET NO.	TOTAL SHEETS
9	COLD	S0020(12)Sec.2	18	

REVISIONS		
NO.	REV.	DESCRIPTION
1	18 68	Rev. Per 28 & 29

26 S 1/2 & NE 1/4 Sec. 2
T 14 S, R 52 W
John Robert Schafer
John Keith Schafer
Robert Gary Schafer
Hugo, Colorado

29 All of Sec 1
T 14 S, R 52 W
Robert C. Cage et al
Aroya, Colorado

27 All of Sec 11
T 14 S, R 52 W
Robert C. Cage et al
Aroya, Colorado

28 N 1/2 of N 1/2 Sec 12
S 1/2 of S 1/2 Sec 12
T 14 S, R 52 W
Robert C. Cage et al
Aroya, Colorado

NOTE Profile and Grade Line Subject to Change

EMB FACTOR
UNCL EXCAV
EMBANKMENT
EMB x FACTOR
HAUL-YD MILE
UNCL EXCAV
SOURCE


S.W. 1/4 Sec 1
T14S R 52 W

29 Rev
All of Sec 1
T14S R 52W
Robert C Cage et al
Aroya, Colorado

S.E. 1/4 Sec 1
T14S R 52W

RIGHT OF WAY


DIVISION		PROJ NO	SHEET NO	TOTAL SHEETS
COLO		50020(12) Sec.2	19	
East of Punkin Center				
REVISIONS			D.L.	
1	18 88	Rev Per 28 & 29		

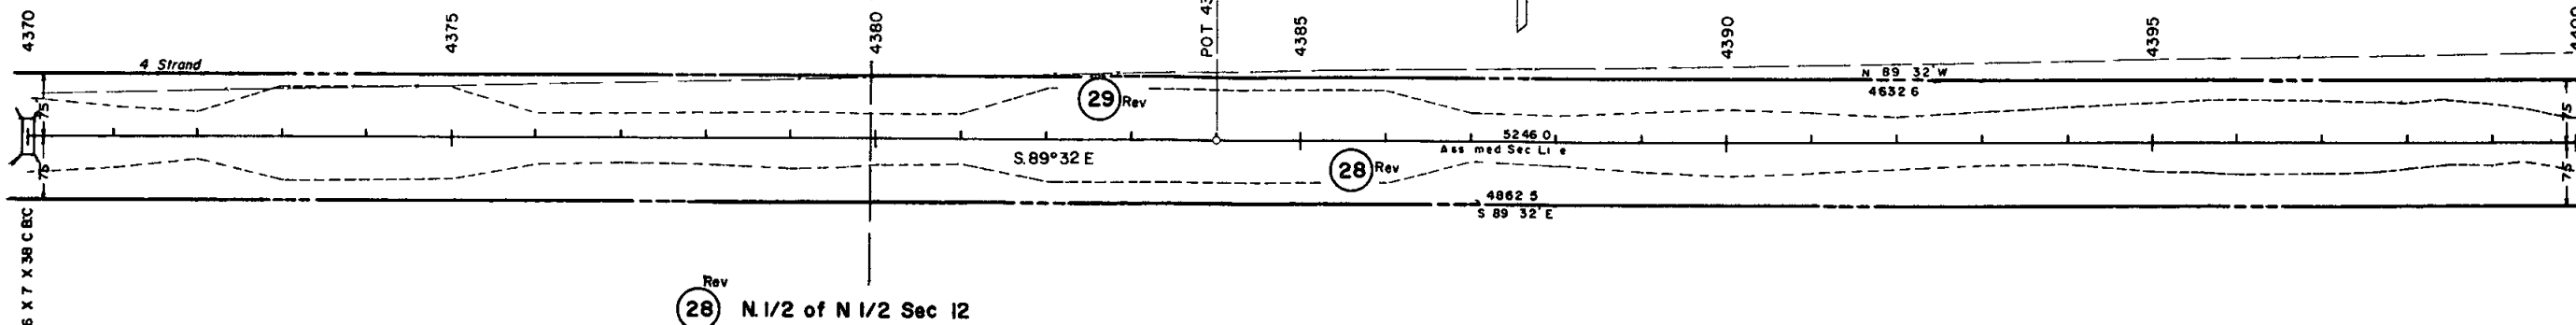

N.W. 1/4 Sec 12
T14S R 52 W


28 Rev
N.1/2 of N.1/2 Sec 12
S.1/2 of S.1/2 Sec 12
T14S R 52W
Robert C Cage et al
Aroya, Colorado

N.E. 1/4 Sec 12
T14S R 52 W

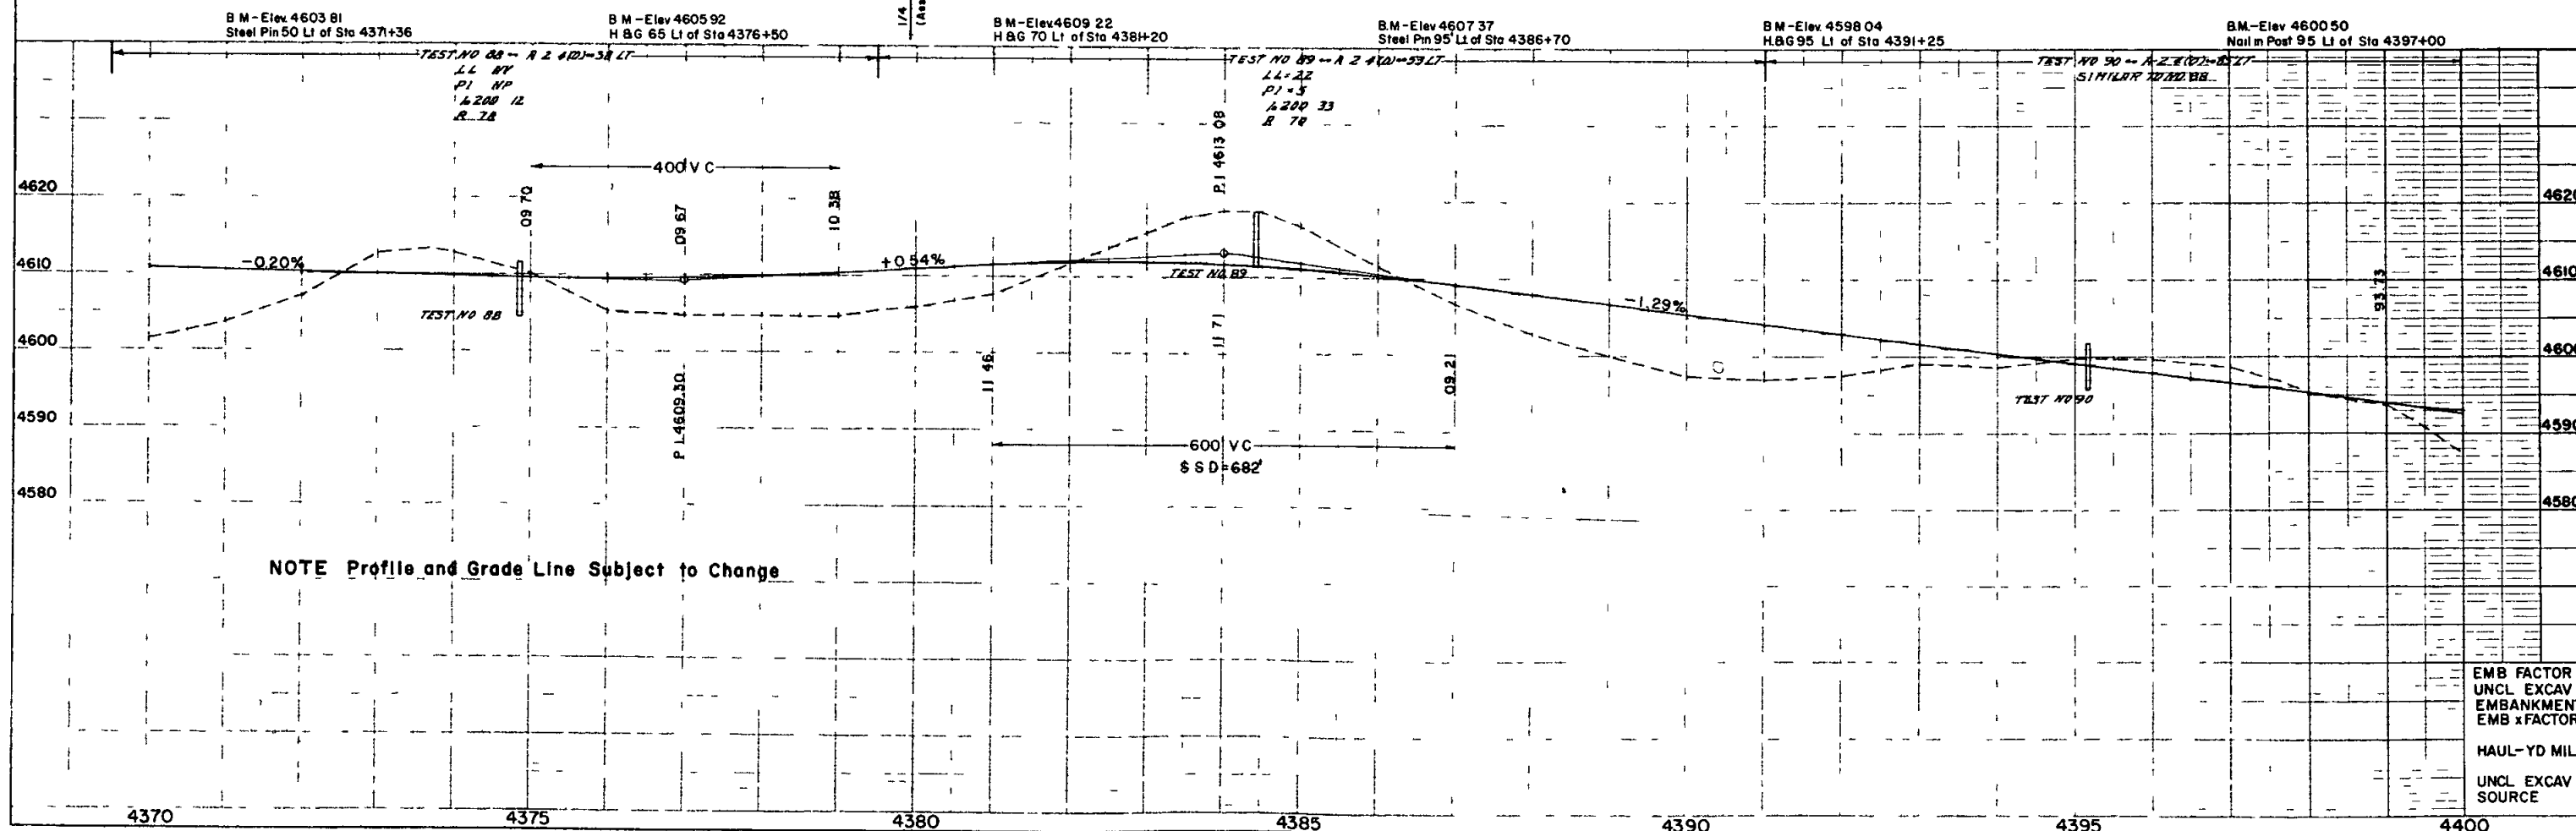



NOTE Profile and Grade Line Subject to Change

EMB FACTOR
UNCL EXCAV
EMBANKMENT
EMB x FACTOR
HAUL-YD MILE
UNCL EXCAV
SOURCE

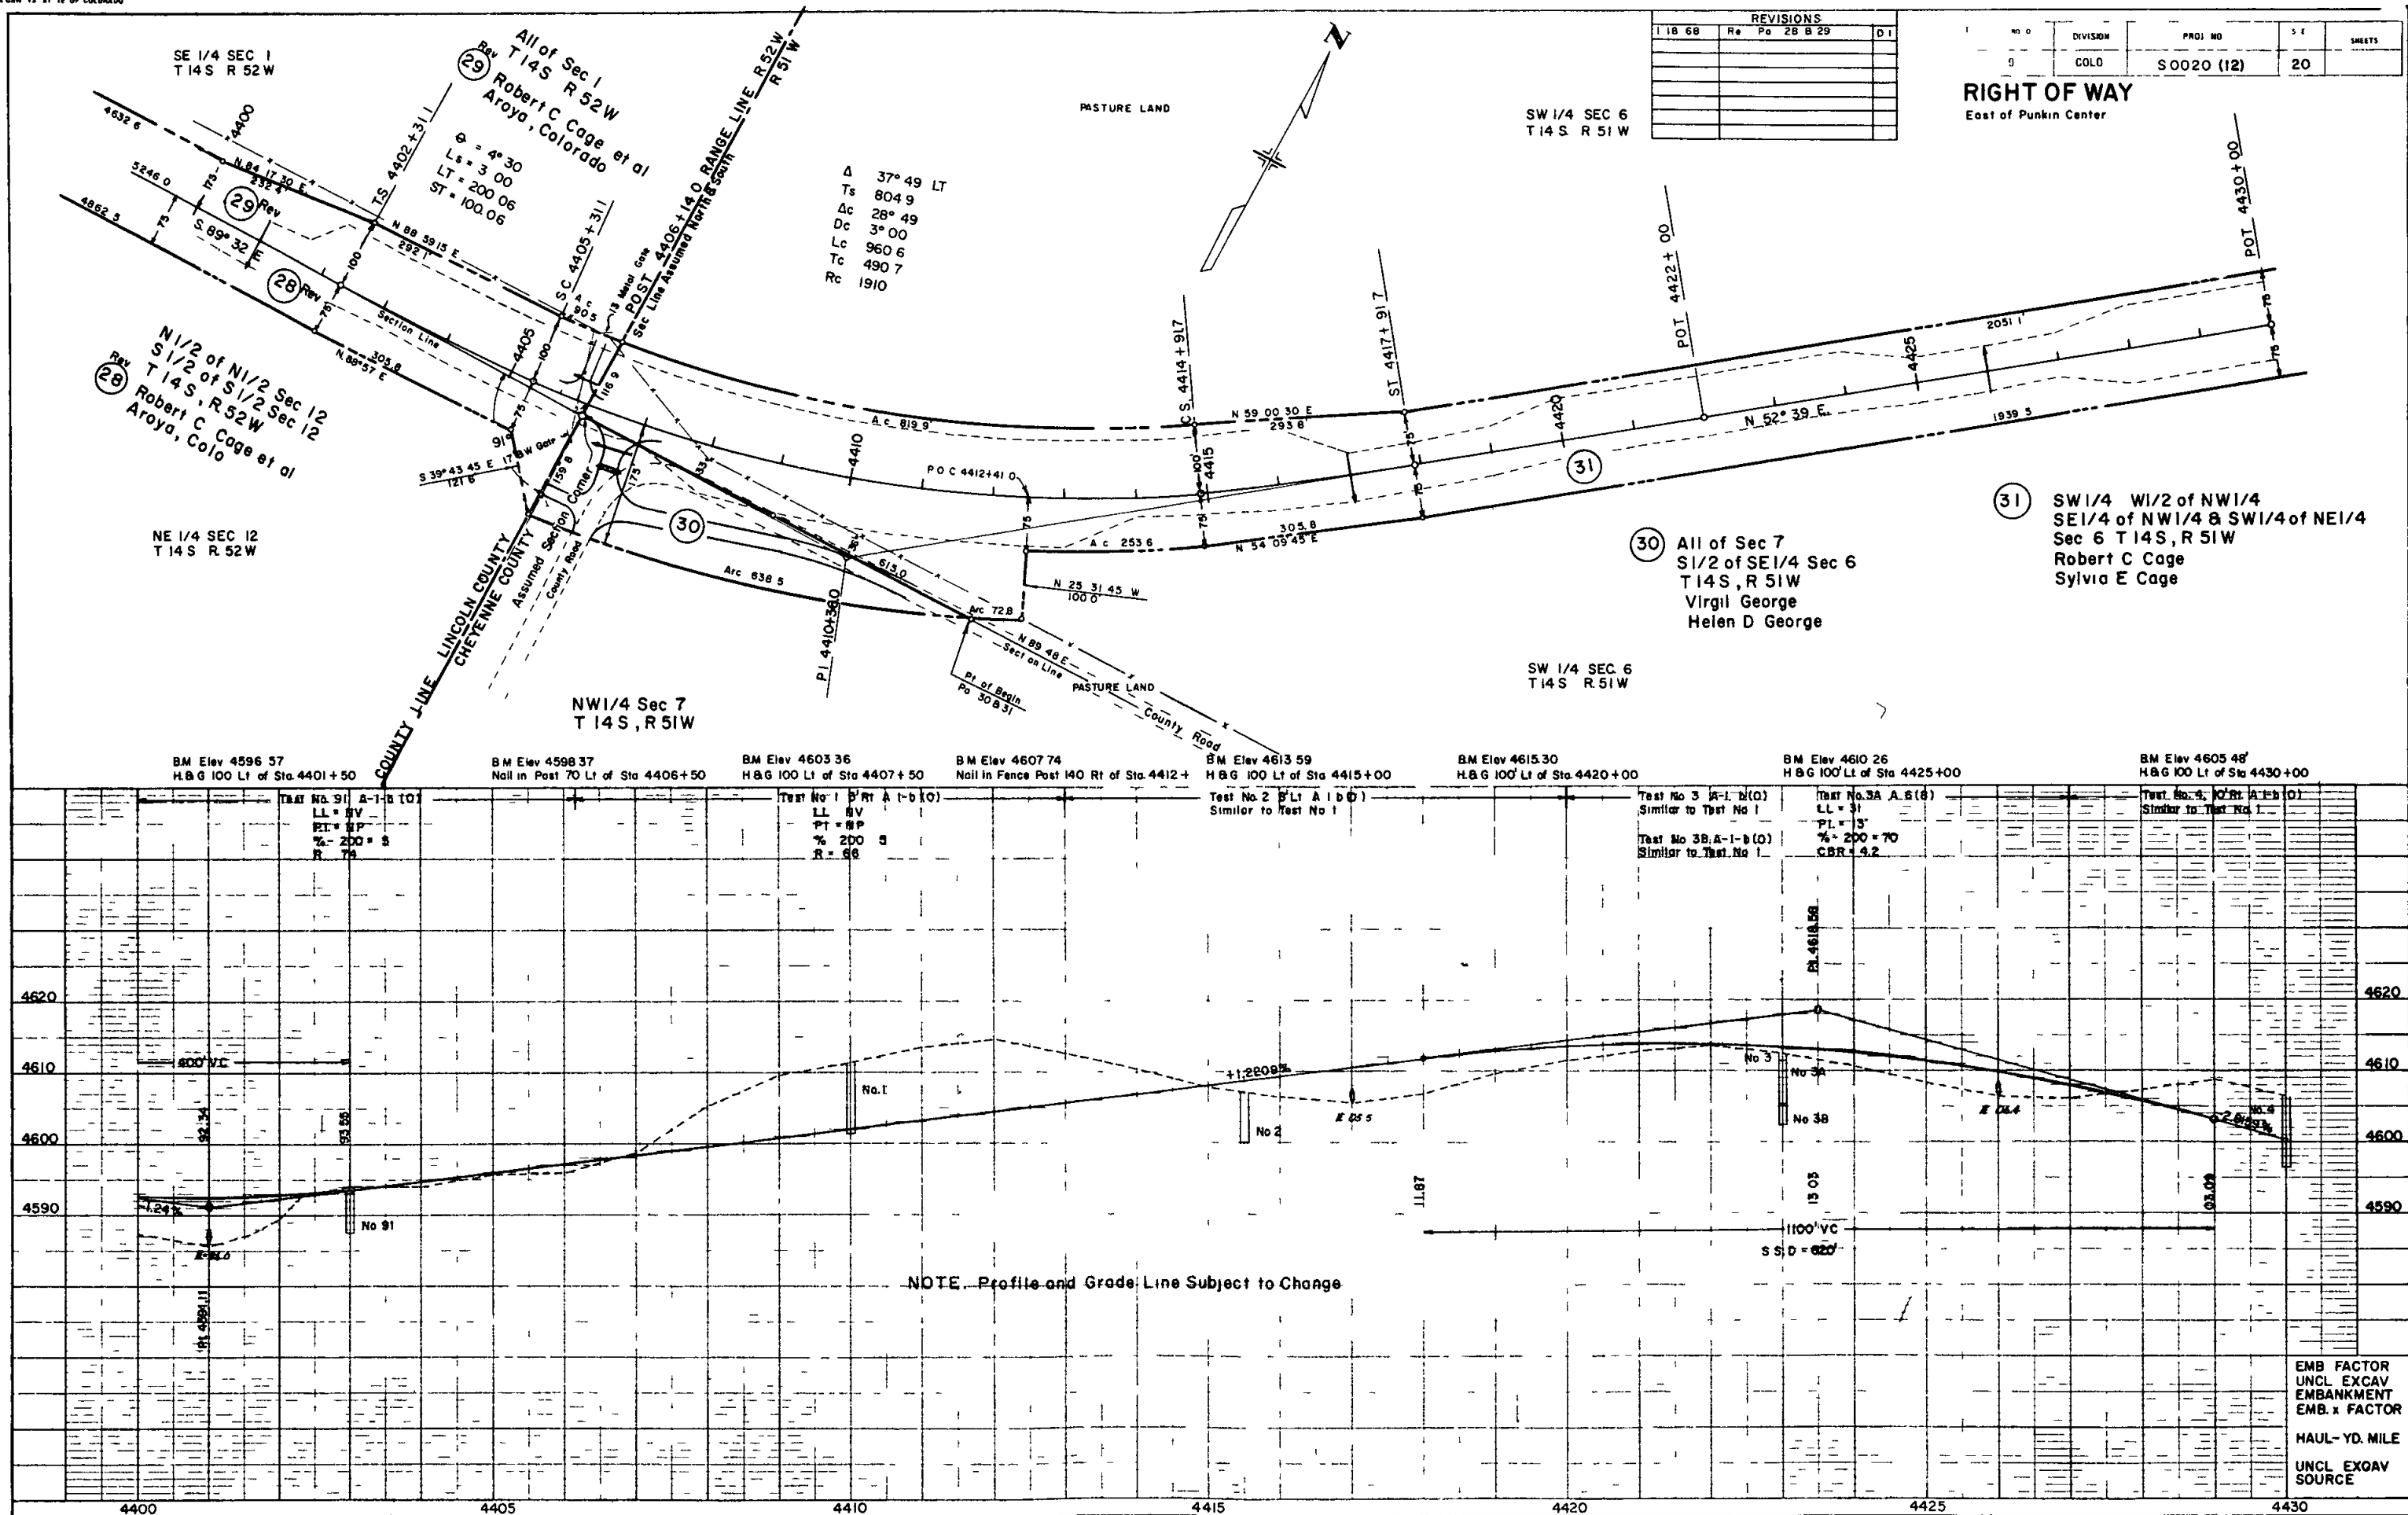

REVISIONS				
4-8-68	Re	Pa	N° 32, 33 & 34	D.I.
5-15-68	Re	32 Re	Del 34 Re	LB



DIVISION	PROJ NO	SHEET NO	TOT L SHEETS
9	SOO20 (12)	21	

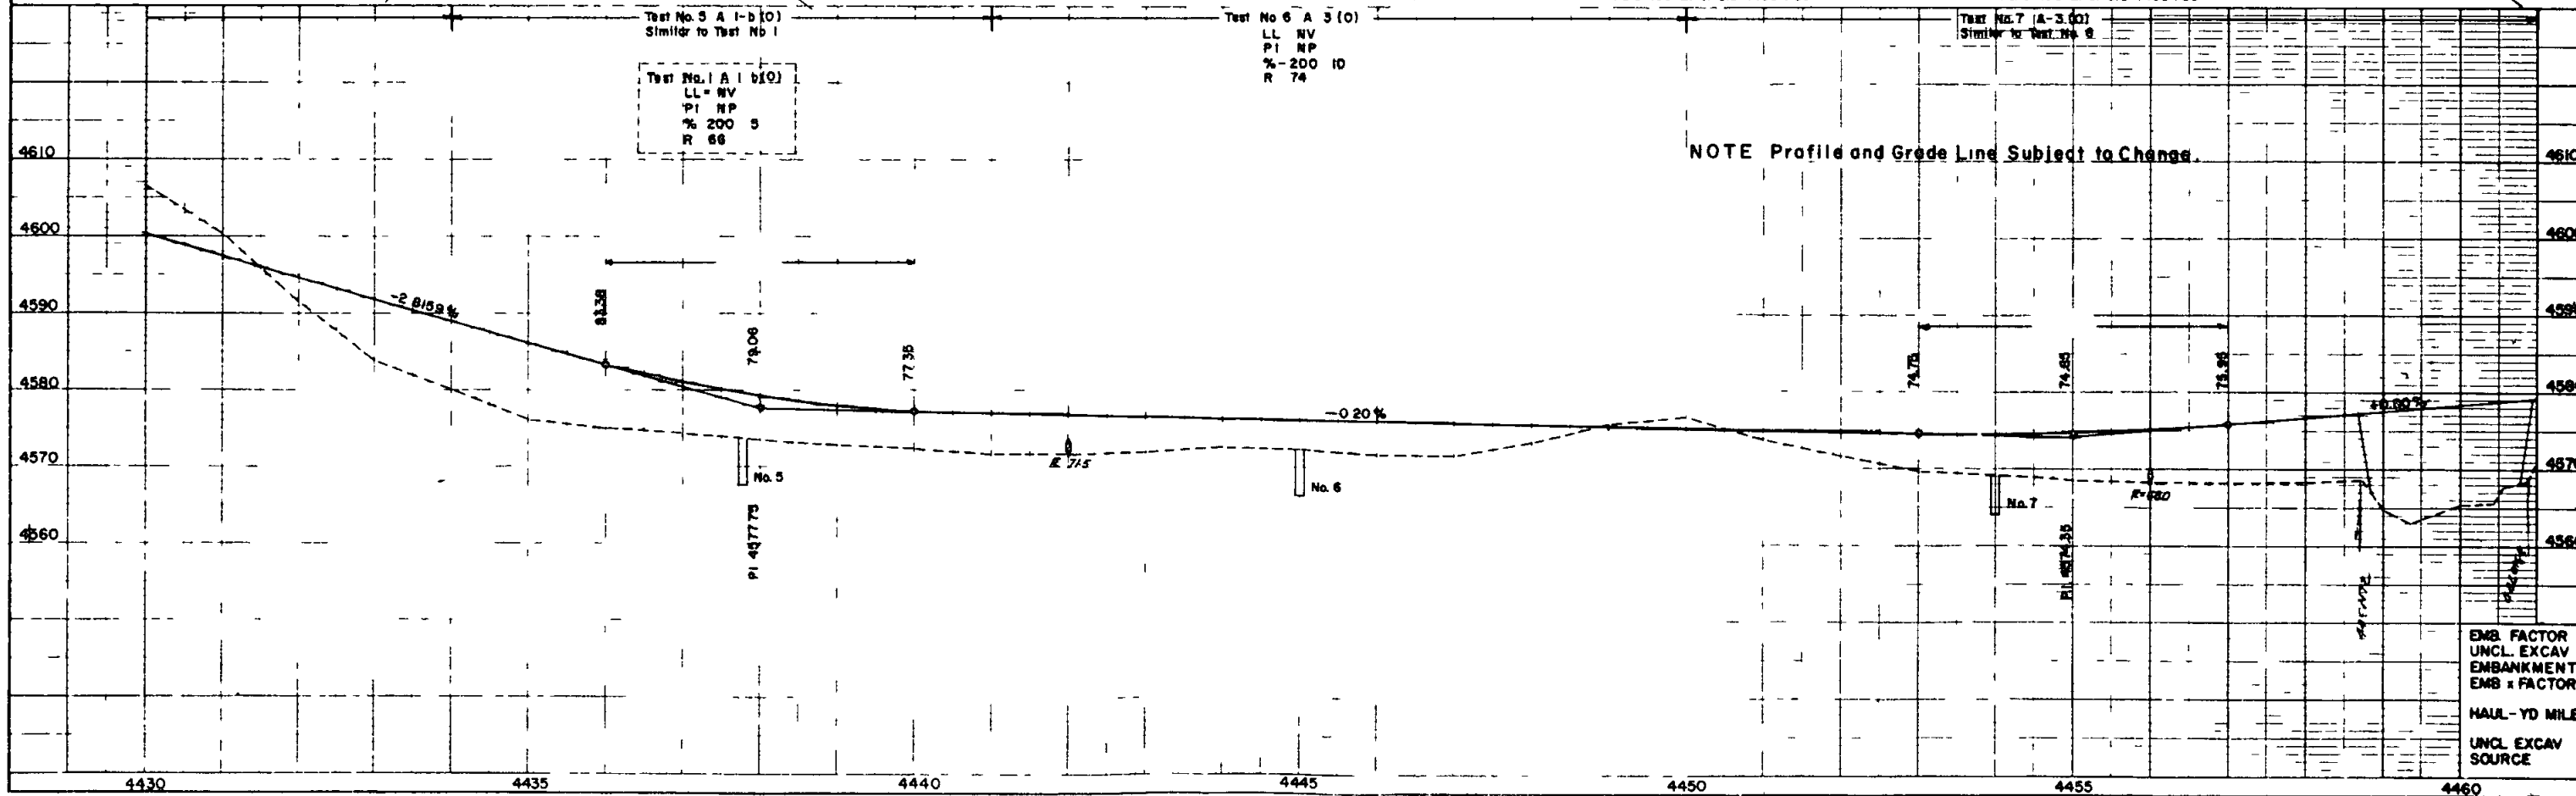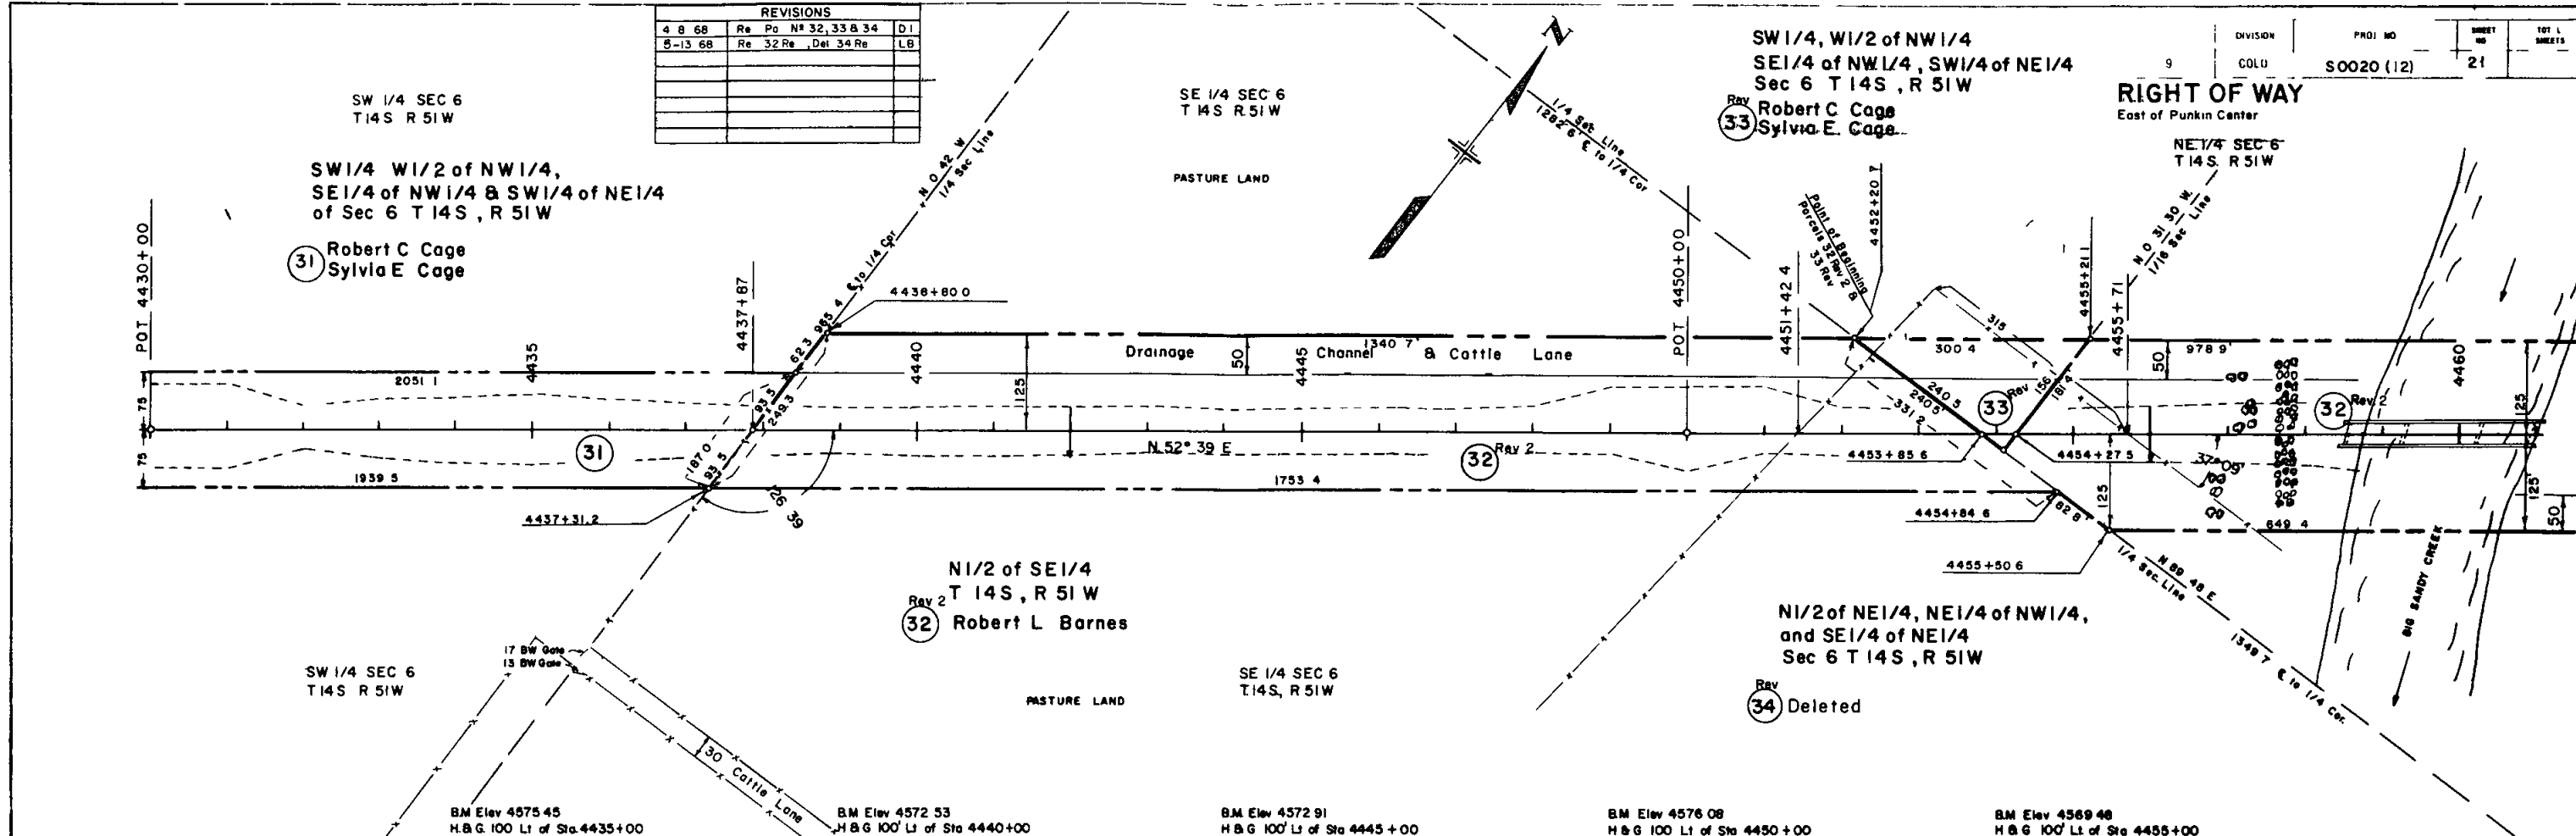

K-E

RIGHT OF WAY East of Pumpkin Center


East of Puntir Center

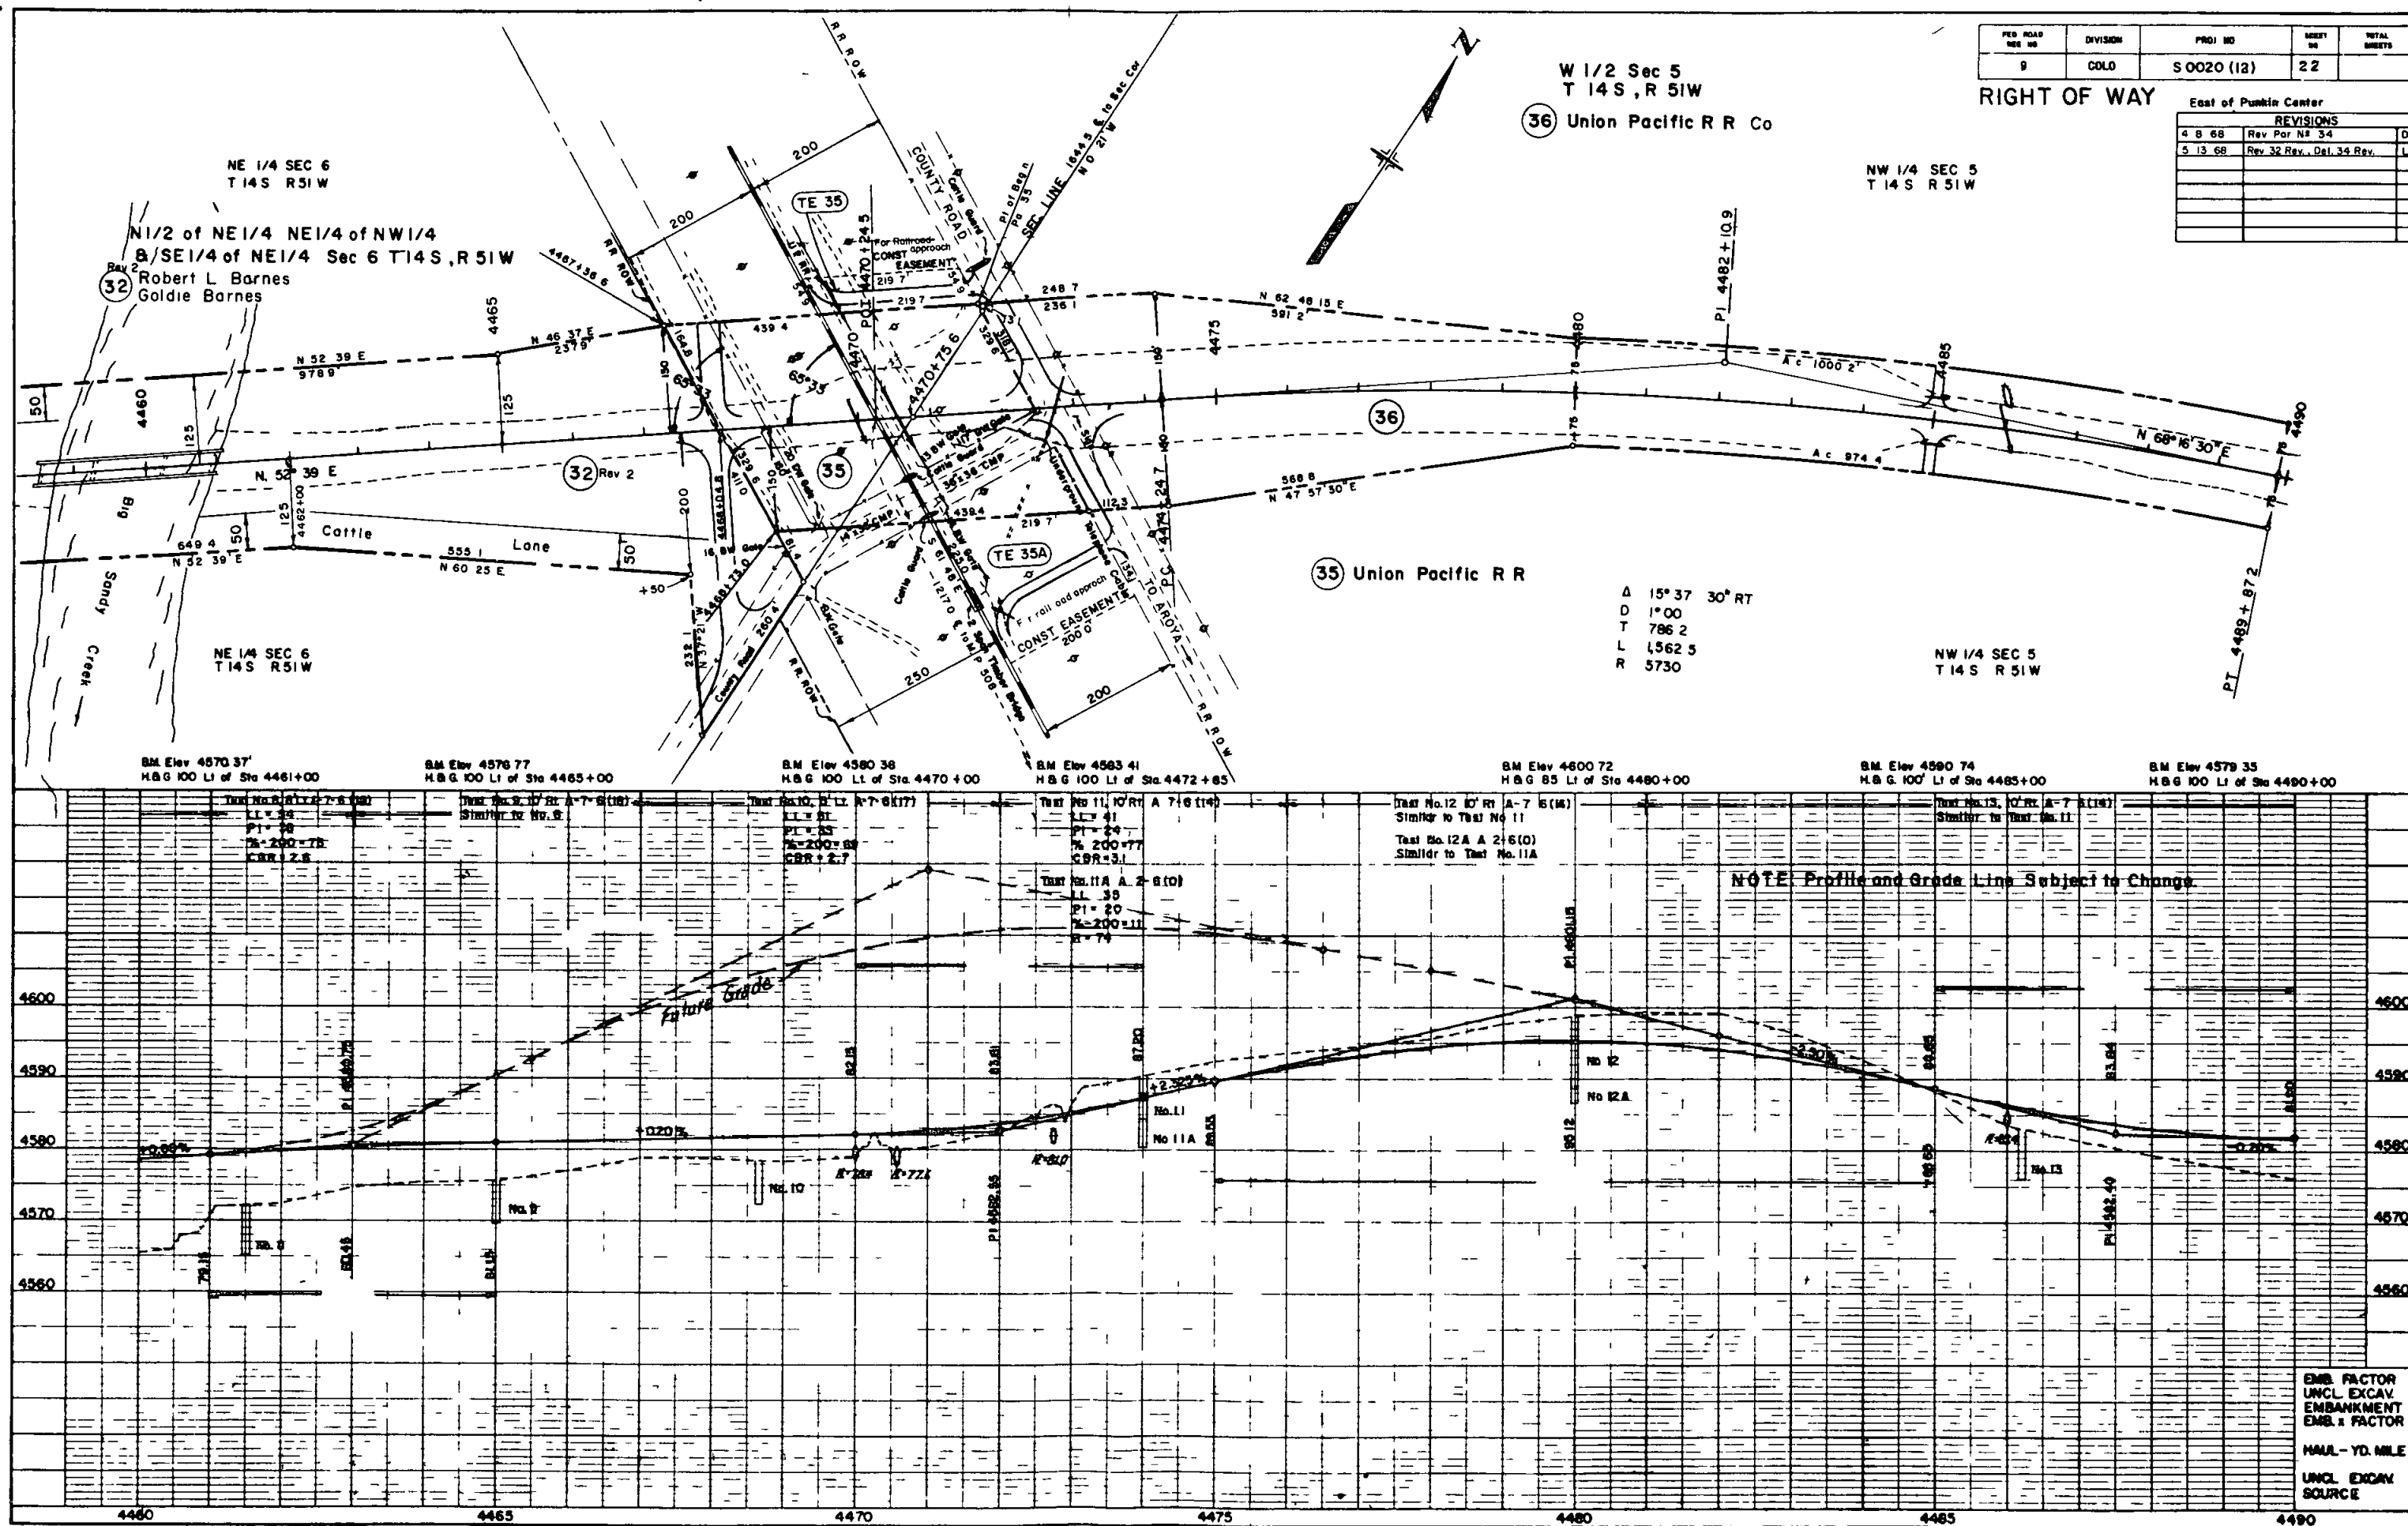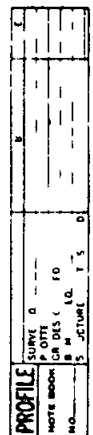[illegible]

NO.	DIVISION	PROJ. NO.	SHEET NO.	TOTAL SHEETS
9	COLO.	S0020 (14)	23	

REVISIONS


RIGHT OF WAY
East of Punkin Center

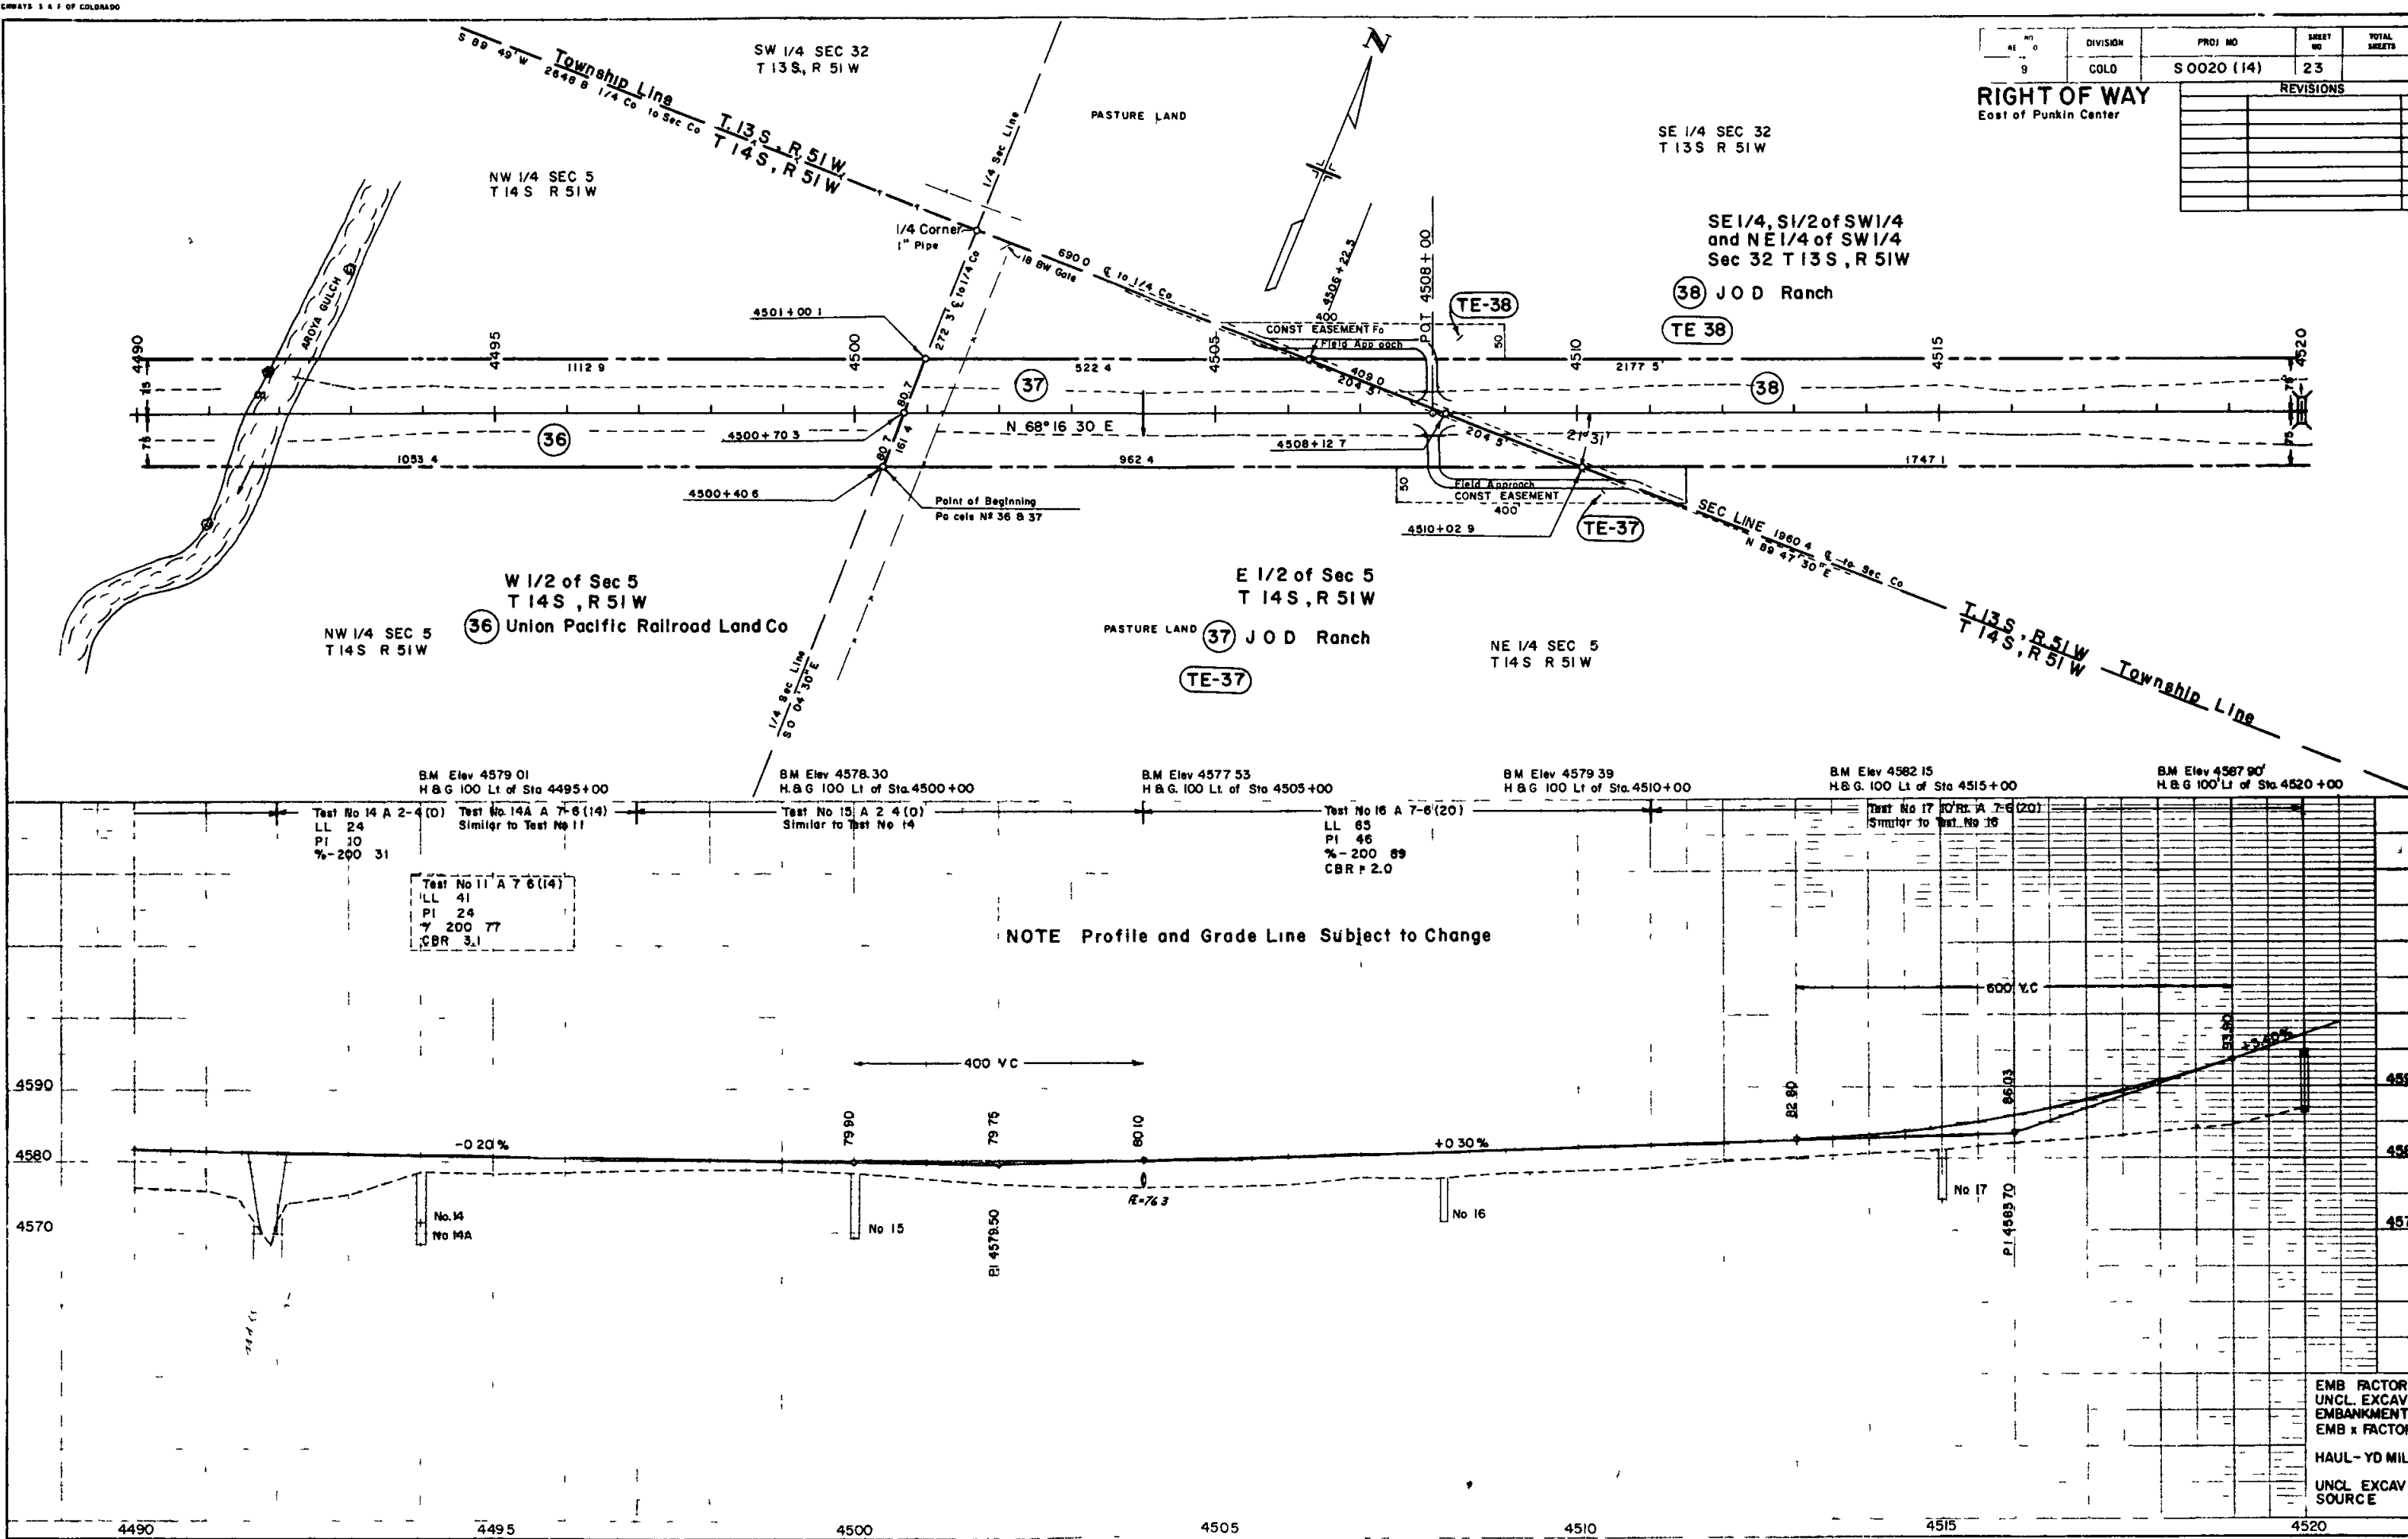

NOTE Profile and Grade Line Subject to Change

EMB. FACTOR
UNCL. EXCAV.
EMBANKMENT
EMB. x FACTOR
HAUL - YD MILE
UNCL. EXCAV.
SOURCE

0	DIVISION	PROJ NO	SEE	0
5	COL	S0020 (12)	24	SHEETS

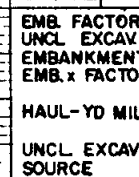

FEDERAL ROAD REGION NO	DISTRICT	PROJ NO	SHEET NO	TOTAL SHEETS
9	COLORADO	S0020(12) Sec 2	25	

RIGHT OF WAY
EAST OF PUNKIN CENTER

REVISIONS


- (A) Ray A Mosher
Boyero Colo
- (B) John M Holland
Alice D Holland
Boyero Colo
- (C) Clifford J Palmer
Hugo Colo
- (D) George Schafer Trustee
Hugo Colo
State of Colo
- (E) R A Vick
Boyero Colo
- (F) Robert Schafer
Hugo Colo
- (H) Virgil S Davis
Alice Davis
Boyero Colo
- (I) Robert E Palmer
- (J) Robert T Cage
Sylvia E Cage
- (K) Virgil George
Helen D George
Wildhorse Colo
- (L) Robert L Barnes
48 Gordon Dr
Alexandra Vir
- (M) Union Pacific Land Co
- (N) J O D Ranch
Maurer Cattle Co
Livestock Exchange Bldg
Kansas City Mo
- (O) Gladys R Everette et al
Boyero Colo
- (P) Joe Carrigan
Wildhorse Colo
- (Q) Harold Sanders
Olga Sanders
Wildhorse Colo
- (R) F M Henderson
- (S) Gussie Headen
- (T) Ted Shaver
Wildhorse Colo
- (U) J A Watson
Sublette Kansas
- (V) Baughman Farms Co
- (W) John Goodwin
- (X) Dale M George
- (Y) Glen Winship

PRELIMINARY OWNERSHIP MAP
FOR THAT PART OF
T 14S, R 51,52 & 53W IN LINCOLN & CHEYENNE CO
FOR PROJECT S0020(12) Sec 2

DATE SCALE 1 mi

- NOTE -

Recommended Minimum Right of Way For This Project
Each Side of Project Center Line

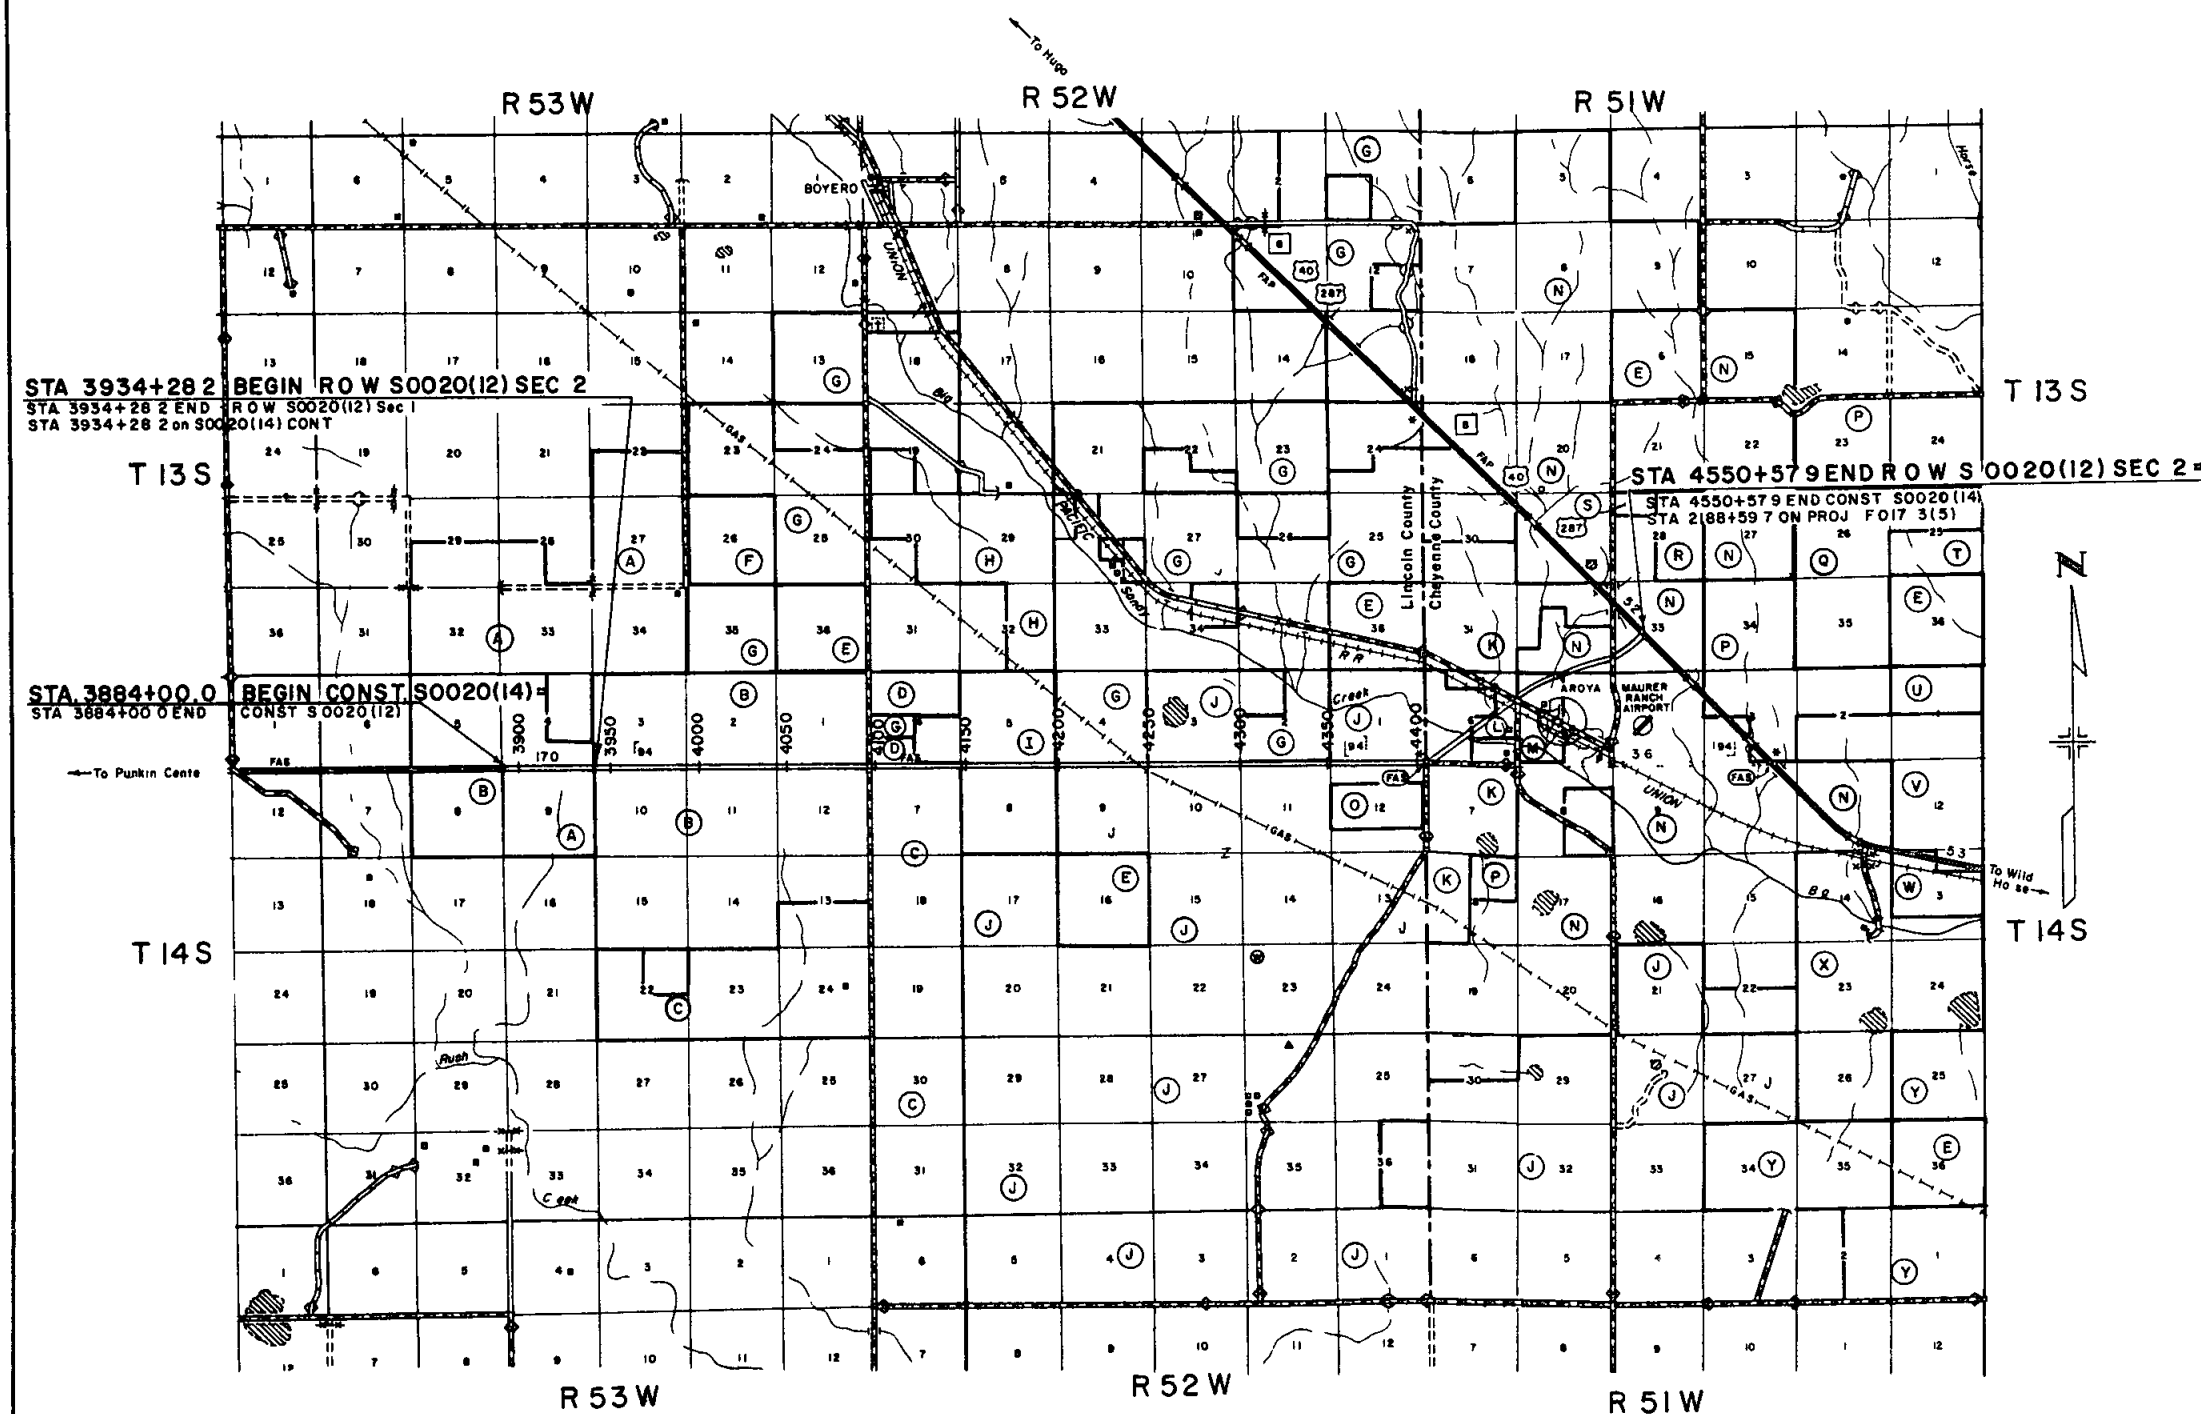

FEDERAL ROAD REGION NO	DISTRICT	PROJ NO	SHEET NO	TOTAL SHEETS
9	COLORADO	S0020(14)	11	

FENCING TABULATION

LOCATION	SIDE	REMOVE FENCE	BUILD B.W FENCE
		LIN FT	LIN FT
3884 + 00	X	150	
3934 + 28	X	150	
3987 + 34	X	150	
4040 + 20	X	65 151	
4040 + 20 to 4050 + 00	LT	980 0	
4050 + 00 to 4055 + 40	RT	2 065 0	
4082 + 24	X	230 200	
4092 + 91	X	220 228	
4092 + 91 to 4117 + 15	LT	2 430	
4145 + 14	X	170 164	
4196 + 11	X	140 142	
4196 + 25 to 4249 + 00	LT	5 275	
4301 + 34	X	150	
4301 + 34 to 4353 + 14	LT	5 310 5311	
4353 + 14	X	150	
4353 + 14 to 4382 + 58	LT	2 965	
4406 + 00	X	165 178	
4406 + 40 to 4407 + 70	LT	105 261	
4407 + 70 to 4412 + 50	RT	525	
4437 + 87	X	100 250	
4451 + 42	X	210 210	
4455 + 71	X	250 400	
4467 + 50 to 4469 + 30	RT	280 295	
4468 + 70	X	330 324	
4469 + 30 to 4472 + 70	RT	615 612	
4472 + 45	X	170 169	
4473 + 15	X	330	
4501 + 20	X	160	
4528 + 80	X	160 300	
4549 + 82	X	600	
3884 + 00 to 3925 + 36	LT & RT		8 272
3925 + 36 to 3925 + 86	LT & RT		130
3926 + 14 to 3926 + 64	LT & RT		130
3926 + 64 to 3951 + 36	LT & RT		4 944
3951 + 36 to 3951 + 86	LT & RT		130
3952 + 14 to 3952 + 64	LT & RT		130
3952 + 64 to 4037 + 36	LT & RT		16 944
4037 + 36 to 4037 + 86	LT & RT		130
4038 + 14 to 4038 + 64	LT & RT		130
4038 + 64 to 4064 + 71	LT & RT		5 614
4064 + 71 to 4065 + 21	LT & RT		130
4065 + 49 to 4065 + 99	LT & RT		130
4065 + 99 to 4092 + 24	LT & RT		5 270
4092 + 91 to 4173 + 64	LT & RT		16 020
4173 + 64 to 4288 + 36	LT & RT		22 944
4288 + 36 to 4288 + 86	LT & RT		130
4289 + 14 to 4406 + 15	LT & RT		23 486
4406 + 15 to 4412 + 50	RT		1 380
4406 + 15 to 4458 + 50	LT		5 290
4412 + 50 to 4458 + 50	RT		4 660
4461 + 00 to 4469 + 50	LT		850
4438 + 80 to 4467 + 50	LT & RT		3 070
4461 + 00 to 4470 + 70	RT		1 090
4469 + 60 to 4491 + 52	LT		2 190
4470 + 80 to 4491 + 52	RT		2 070
4492 + 15 to 4549 + 82	LT & RT		11 655
TOTAL LINCOLN COUNTY		17 793	26 705
TOTAL CHEYENNE COUNTY		4 476	4 065
PROJECT TOTAL		22 269	30 770


ESTIMATED CORNER & LINE BRACE POSTS - LINCOLN COUNTY 136
CHEYENNE COUNTY 43

ESTIMATED END POSTS - LINCOLN COUNTY 131
CHEYENNE COUNTY 32

Extra Fence required for Cattle Lane

DETAIL OF FENCE CONNECTION TO CBC'S

(REPLACES EYEBOLT DETAIL ON
M-607 A)

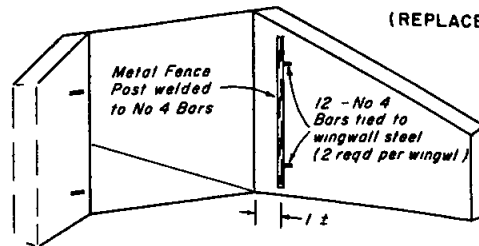

ALL COSTS TO BE INCLUDED
IN PRICE BID FOR FENCING

AS CONSTRUCTED -
REVISED DATE DEC 13 1968

TABULATION OF GATES

STATION	SIDE	20 BW	30 BW
		GATES EACH	GATES EACH
3928 +	LT & RT	2	
3935 + 00	LT & RT	2	
3980 + 00	LT & RT	2	
3987 +	RT	1	
4006 + 00	LT & RT	2	
4030 + 00	LT & RT	2	
4040 +	LT & RT	2	
4042 + 00	LT & RT	2	
4062 + 00	LT & RT	2	
4065 +	RT	1	
4091 + 00	LT & RT	2	
4092 + 25	LT	1	
4096 + 00	LT & RT	2	
4116 + 00	LT & RT	2	
4144 + 00	LT & RT	2	
4145 +	LT & RT	2	
4163 + 00	LT & RT	2	
4195 +	LT & RT	2	
4196 +	LT & RT	2	
4197 + 00	LT & RT	2	
4249 +	LT	1	
4251 + 00	LT & RT	2	
4290 +	LT & RT	2	
4250 + 00	LT & RT	2	
4300 + 48	LT & RT	2	
4301 +	LT	1	
4301 + 43.7	LT & RT	1	2
4352 +	LT	1	
4353 + 00	LT & RT	2	
4353 +	LT	1	
4354 + 00	LT & RT	2	
4354 +	RT	1	
4406 +	LT & RT	2	
4438 +	LT	1	
4468 + 00	LT	2	
4471 +	LT	1	
4473 +	RT	1	
4485 +	LT & RT	2	
4501 + 00	LT & RT	2	
4508 + 00	LT & RT	2	
4547 + 00	RT	1	

GATE STATIONS ARE APPROXIMATE ONLY
ACTUAL LOCATIONS TO BE STAKED BY ENGINEER

DETAIL SHOWING REVISED WIRE SPACING THROUGH CERTAIN AREAS

APPLIES AT STATIONS

4250+00 to 4301+33.7 Lt
4350+33 to 4501+00 Lt
4196+10.7 to 4500+40 Rt

AS PER PLAN ROW MARKERS

STATION	SIDE	NO
3911 + 00	Lt & Rt	2
3934 + 28.2	Lt & Rt	2
3966 + 00	Lt & Rt	2
3987 + 33.5	Lt & Rt	2
3998 + 00	Lt & Rt	2
4022 + 00	Lt & Rt	2
4040 +	Lt & Rt	2
4056 + 00	Lt & Rt	2
4089 + 00	Lt & Rt	2
4099 + 08.6	Lt & Rt	2
4116 + 00	Lt & Rt	2
4145 + 13.9	Lt & Rt	2
4180 + 00	Lt & Rt	2
4196 + 10.7	Lt & Rt	2
4225 + 00	Lt & Rt	2
4250 + 33.1	Lt & Rt	2
4292 + 15	Lt & Rt	2
4301 + 33.7	Lt & Rt	2
4329 + 00	Lt & Rt	2
4354 + 09.4	Lt & Rt	2
4386 + 00	Lt & Rt	2
4402 + 31.1	Lt & Rt	2
4422 + 00	Lt & Rt	2
4450 + 00	Lt & Rt	2
4474 + 24.7	Lt & Rt	2
4489 + 87.2	Lt & Rt	2
4508 + 00	Lt & Rt	2
4533 + 54.5	Lt & Rt	2
4547 + 47.8	Lt & Rt	2
TOTAL LINCOLN COUNTY		44
TOTAL CHEYENNE COUNTY		14
PROJECT TOTAL		58