


LE SHEET

SEE NO. 1


INDEX OF SHEETS

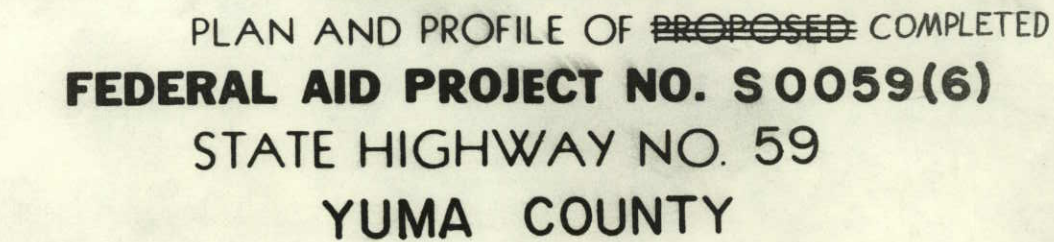

1.	TITLE PAGE, SKETCH MAP, TABULATION OF LENGTH AND DESIGN DATA.	
2.	TYPICAL SECTION AND GENERAL NOTES.	
3.	SUMMARY OF APPROXIMATE QUANTITIES.	
4.	SUMMARY OF EARTHWORK QUANTITIES, BASE COURSE & SURFACING PLANS.	
5.	PIT SKETCHES.	
6.	STRUCTURE QUANTITIES.	
7-16.	ALIGNMENT PLAN AND PROFILE.	
17-18.	STRUCTURE CROSS SECTIONS.	
M-203-B	APPROACH ROADS, FLARING, CUT SLOPE TREATMENT, BRIDGE & CREST WIDENING.	4-1-69
M-206-A	EXCAVATION AND BACKFILL FOR STRUCTURES. (2 SHEETS)	11-1-68
M-603-M	METAL CULVERT PIPE.	7-23-68
M-603-RC	REINFORCED CONCRETE PIPE.	7-23-68
M-614-A	TIMBER BARRICADES.	4-23-69
M-614-1C	STANDARD CONSTRUCTION IDENTIFICATION SIGNS. (2 SHEETS)	5-20-69
M-614-TB	TRAFFIC SIGNING FOR HIGHWAY CONSTRUCTION (3 SHEETS)	12-24-68

STATION	ROADWAY LIN. FT.	
210+00.0 BEGIN S0059(6)	21,140.3	
421+40.3 = 447+75.3 END S0007(1)	5,316.5	
474+56.8 END S0059(6) = 394+54.5 on S0007(1)		
TOTAL	26,456.8	
SUMMARY	LIN. FT.	MILES
ROADWAY (NET AND GROSS LENGTH) S0059(6)	26,456.8	5.011

DESIGN DATA	
MAXIMUM DEGREE OF CURVE	TANGENT
MAXIMUM GRADE	1.70%
MINIMUM S.S.D. HORIZONTAL	> 900'
MINIMUM S.S.D. VERTICAL	615'
MAXIMUM DESIGN SPEED	60 M.P.H.
1989 DESIGN TRAFFIC VOLUME	$\left\{ \begin{array}{l} 680 \text{ A.D.T.} \\ 115 \text{ D.H.V.} \end{array} \right.$

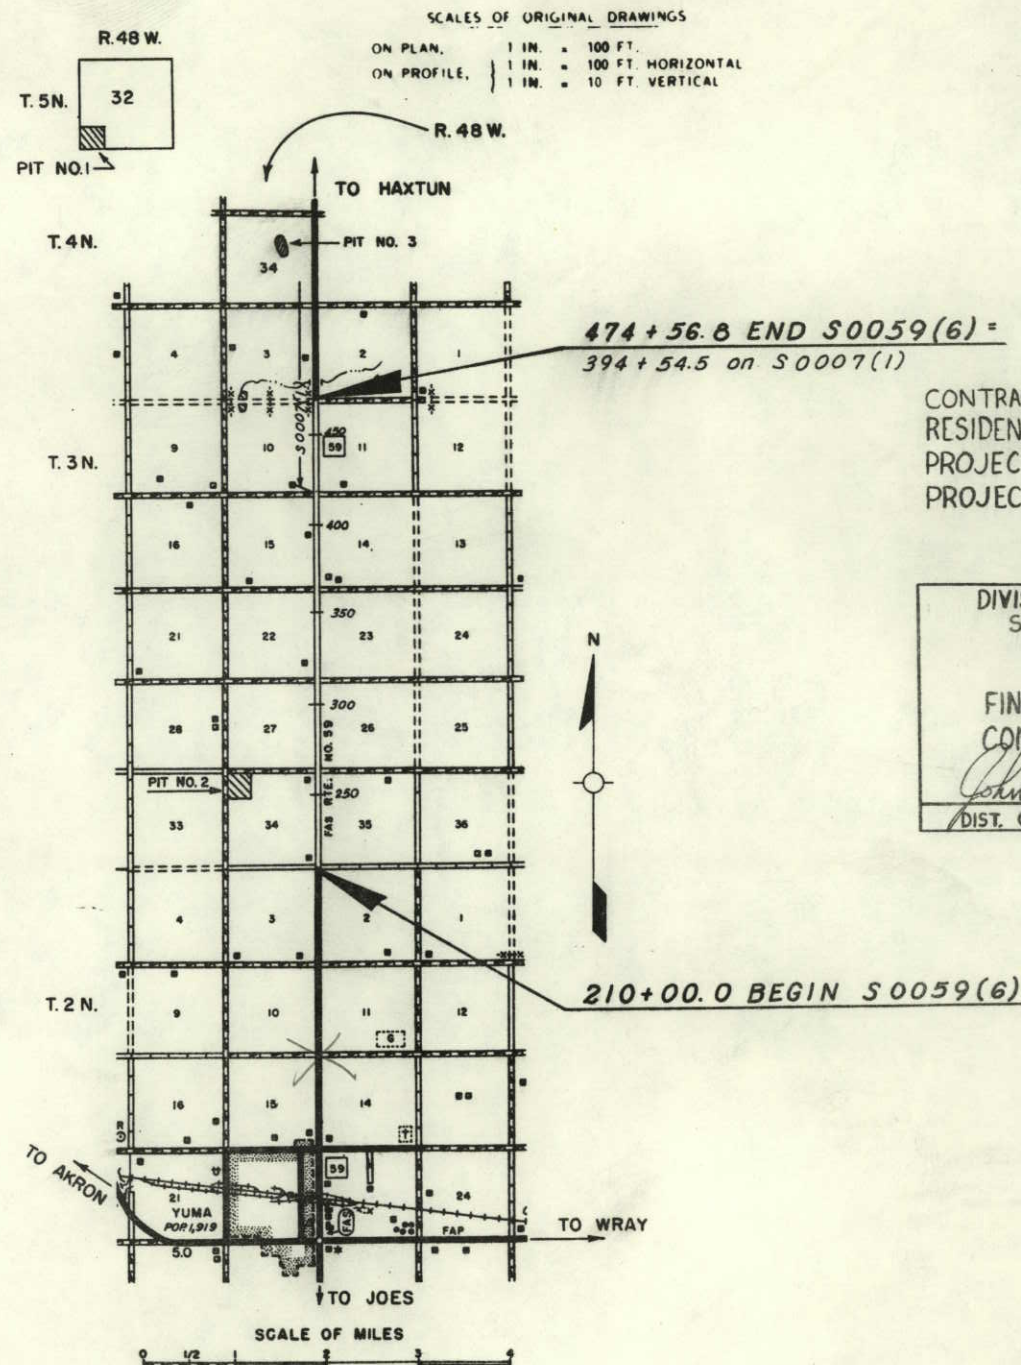

DIVISION OF HIGHWAYS STATE of COLO.	
FINAL APPROVAL, AS CONSTRUCTED PLANS	
<i>John C. Peterson</i> DIST. CONST. ENGR.	9/21/77 DATE

**SEE SPECIAL PROVISIONS FOR
NOTICE TO BIDDERS**

DIVISION OF HIGHWAYS

APPROVED:

[Signature]

CHIEF ENGINEER

[Date]

DATE

DEPARTMENT OF TRANSPORTATION FEDERAL HIGHWAY ADMINISTRATION BUREAU OF PUBLIC ROADS	
APPROVED: _____	DATE _____
_____ DIVISION ENGINEER	

T.A.L.

FEDERAL ROAD DISTRICT NO.	DIVISION	PROJ. NO.	SHEET NO.	TOTAL SHEETS
	CONTRACT	S0059(6)	7	

CONSTRUCTED
DATE AUG. 7, 1970


Sec. 34
T. 3 N., R. 48 W.

Sec. 3
T. 2 N., R. 48 W.

Sec. 35
T. 3 N., R. 48 W.

Sec. 2
T. 2 N., R. 48 W.

NOTE:
All Telephone Poles Shown on this Project Belong to the North-East Telephone Co., Yuma, Colo.
All Power Poles Shown on this Project Belong to Y-W Electric Association.
Location of new underground Telephone Cable shown every mile plus crossings.

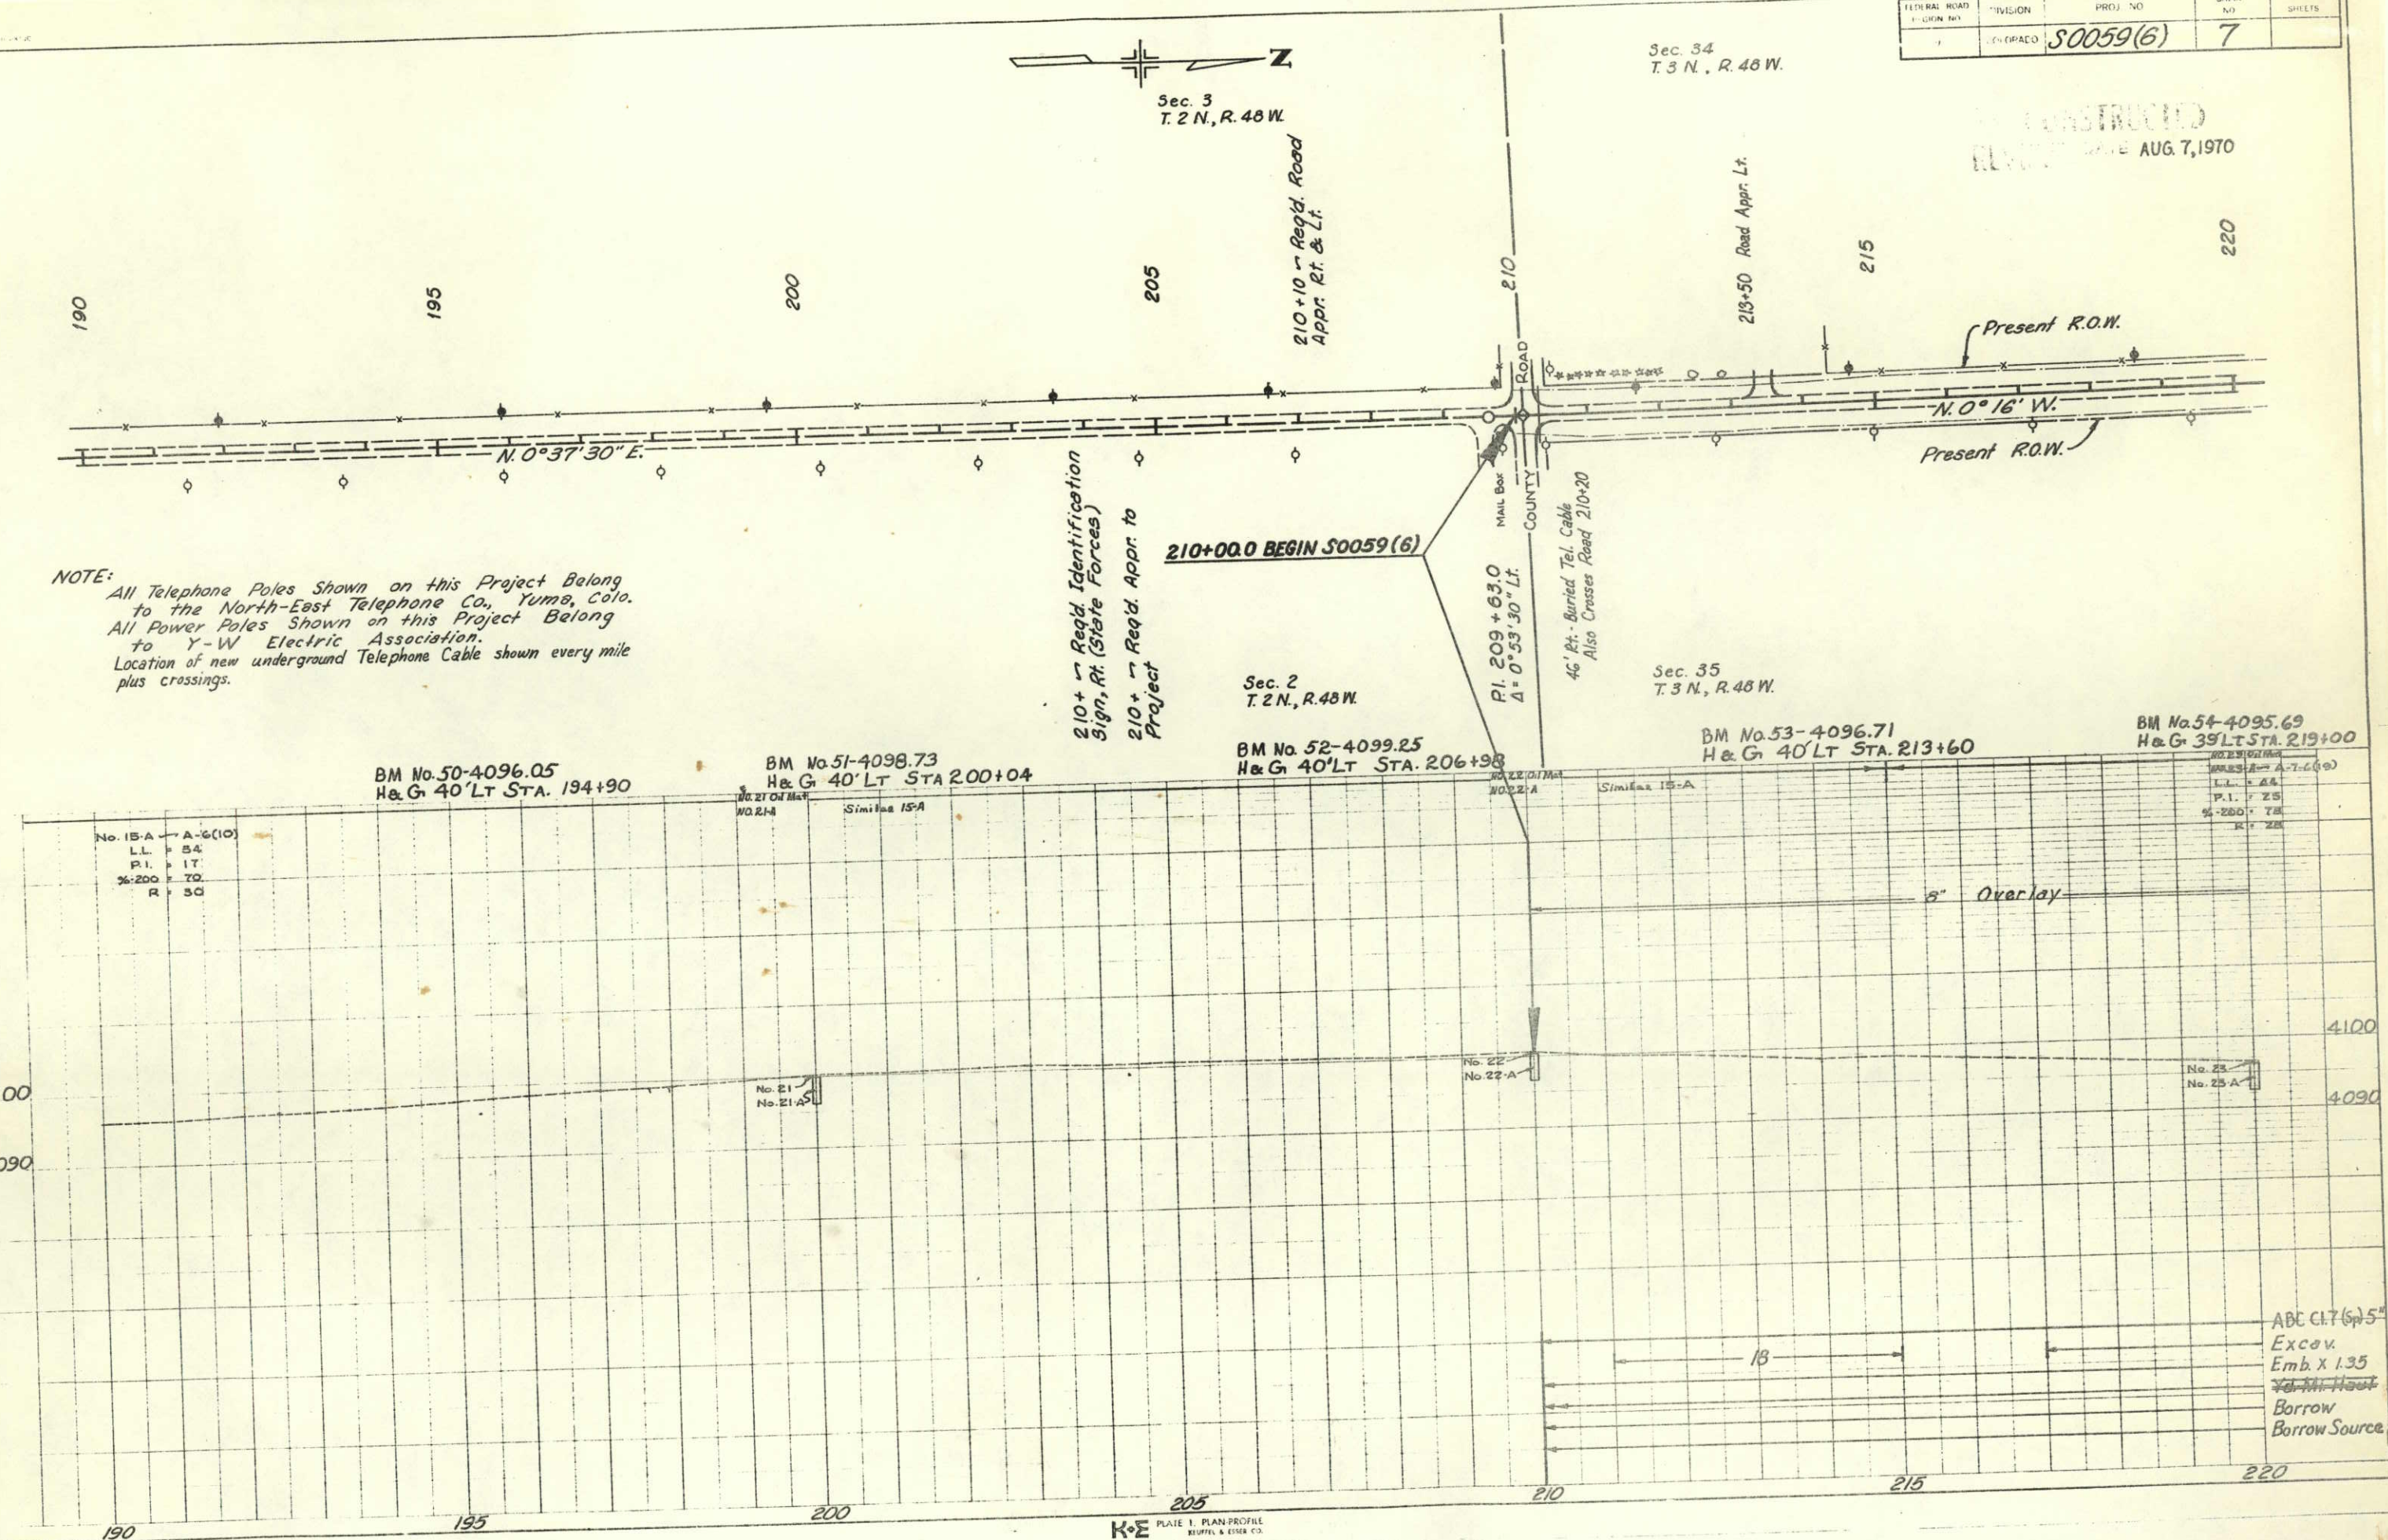

BM No. 50-4096.05
H&G 40' LT STA. 194+90

BM No. 51-4098.73
H&G 40' LT STA. 200+04

BM No. 52-4099.25
H&G 40' LT STA. 206+98



BM No. 53-4096.71
H&G 40' LT STA. 213+60

BM No. 54-4095.69
H&G 39' LT STA. 219+00

ABC C1.7(5) 5"
Excav.
Emb. x 1.35
Yd. M. Heat
Borrow
Borrow Source

FEDERAL ROAD REGION NO.	DIVISION	PROJ. NO.	SHEET NO.	TOTAL SHEETS
9	COLORADO	S0059(6)	8	



AS CONSTRUCTED
 DATE AUG. 7, 1970

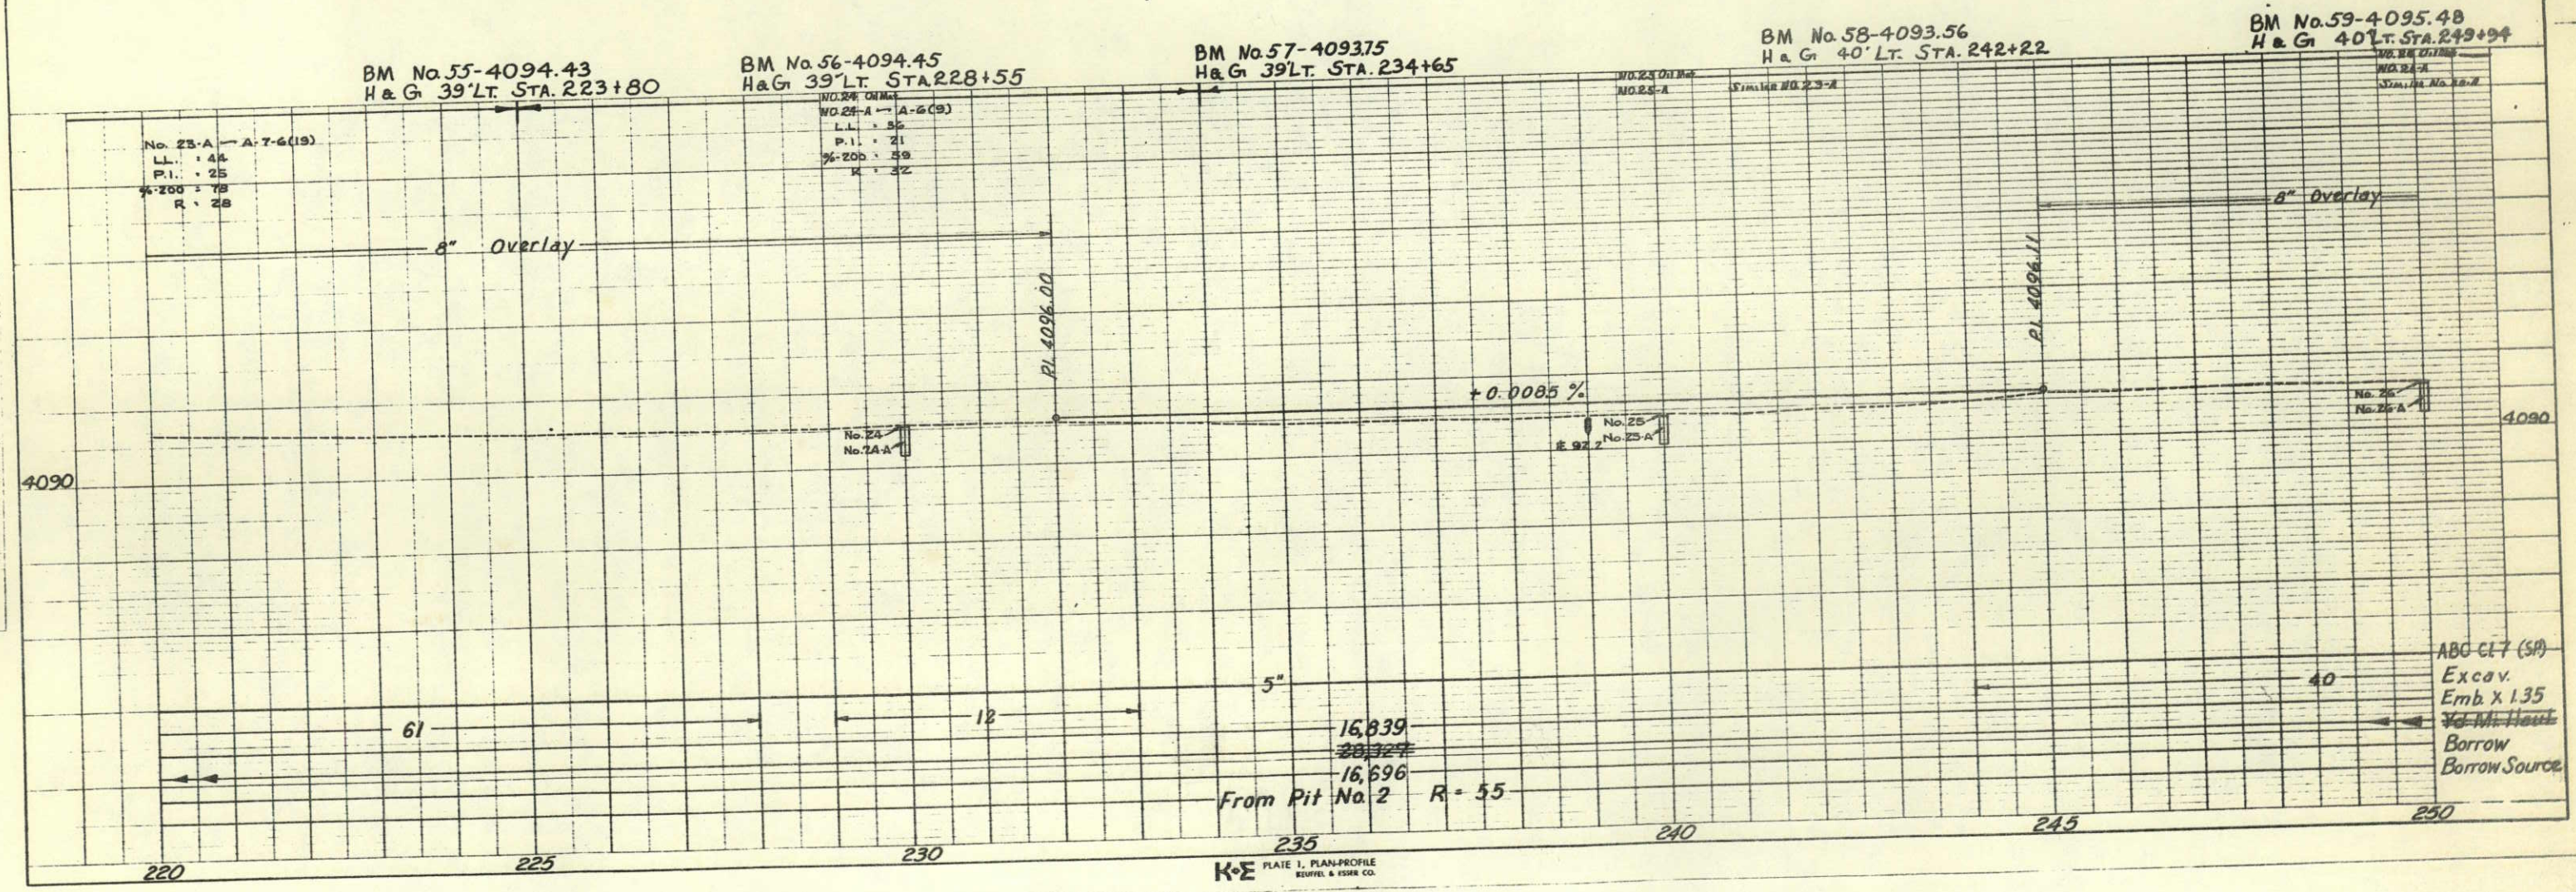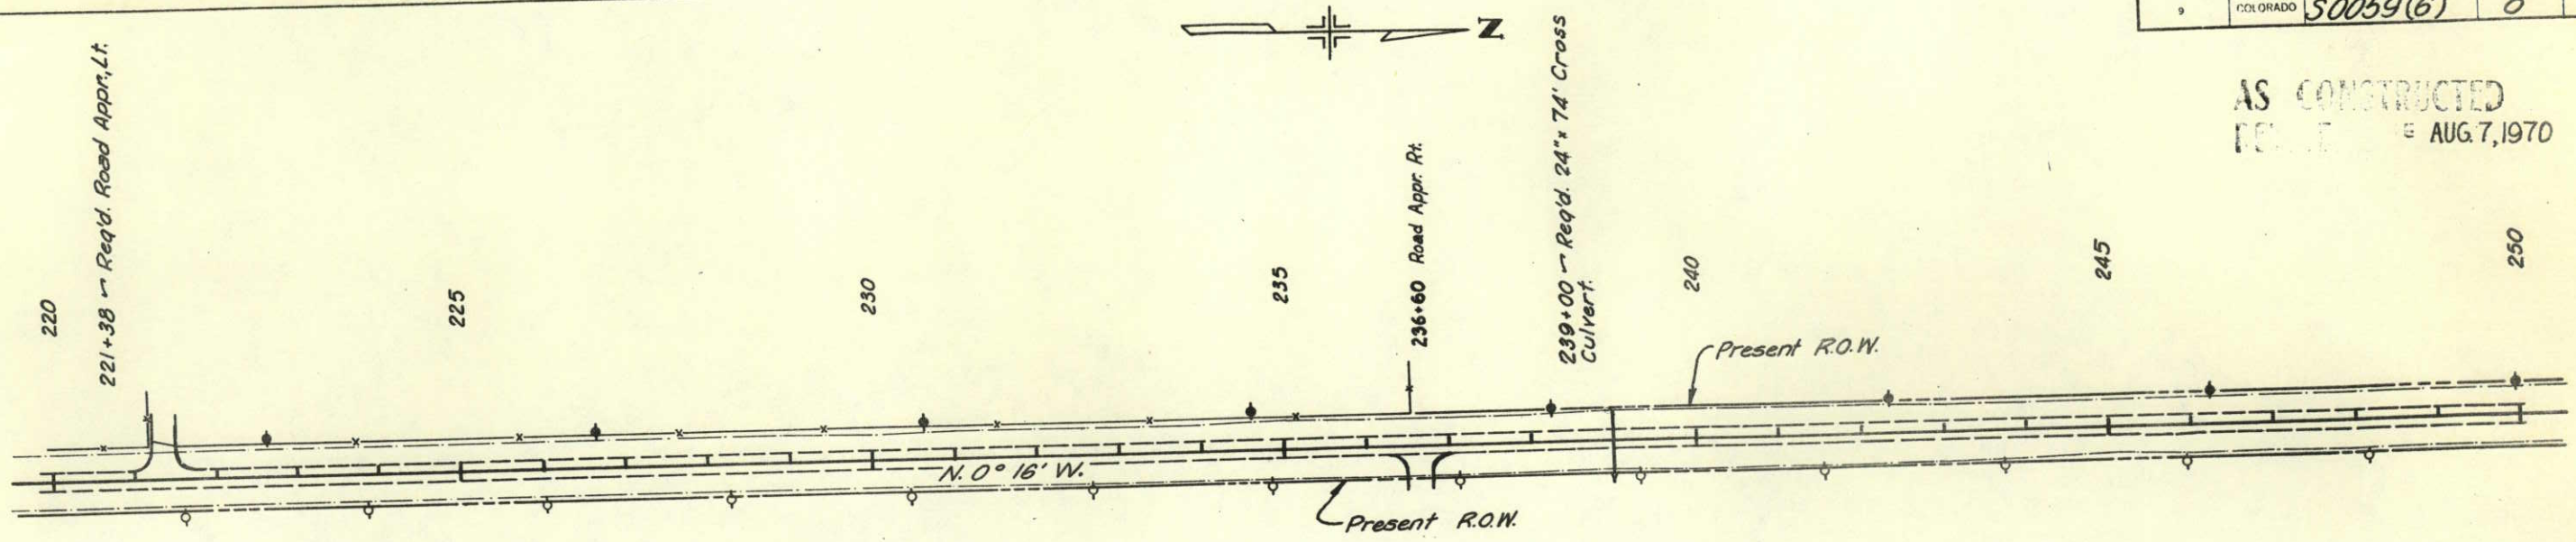

30705



FEDERAL ROAD REGION NO.	DIVISION	PROJ NO.	SHEET NO.	TOTAL SHEETS
9	COLORADO	S0059(6)	9	

AS CONSTRUCTED
REVISED DATE AUG. 7, 1970

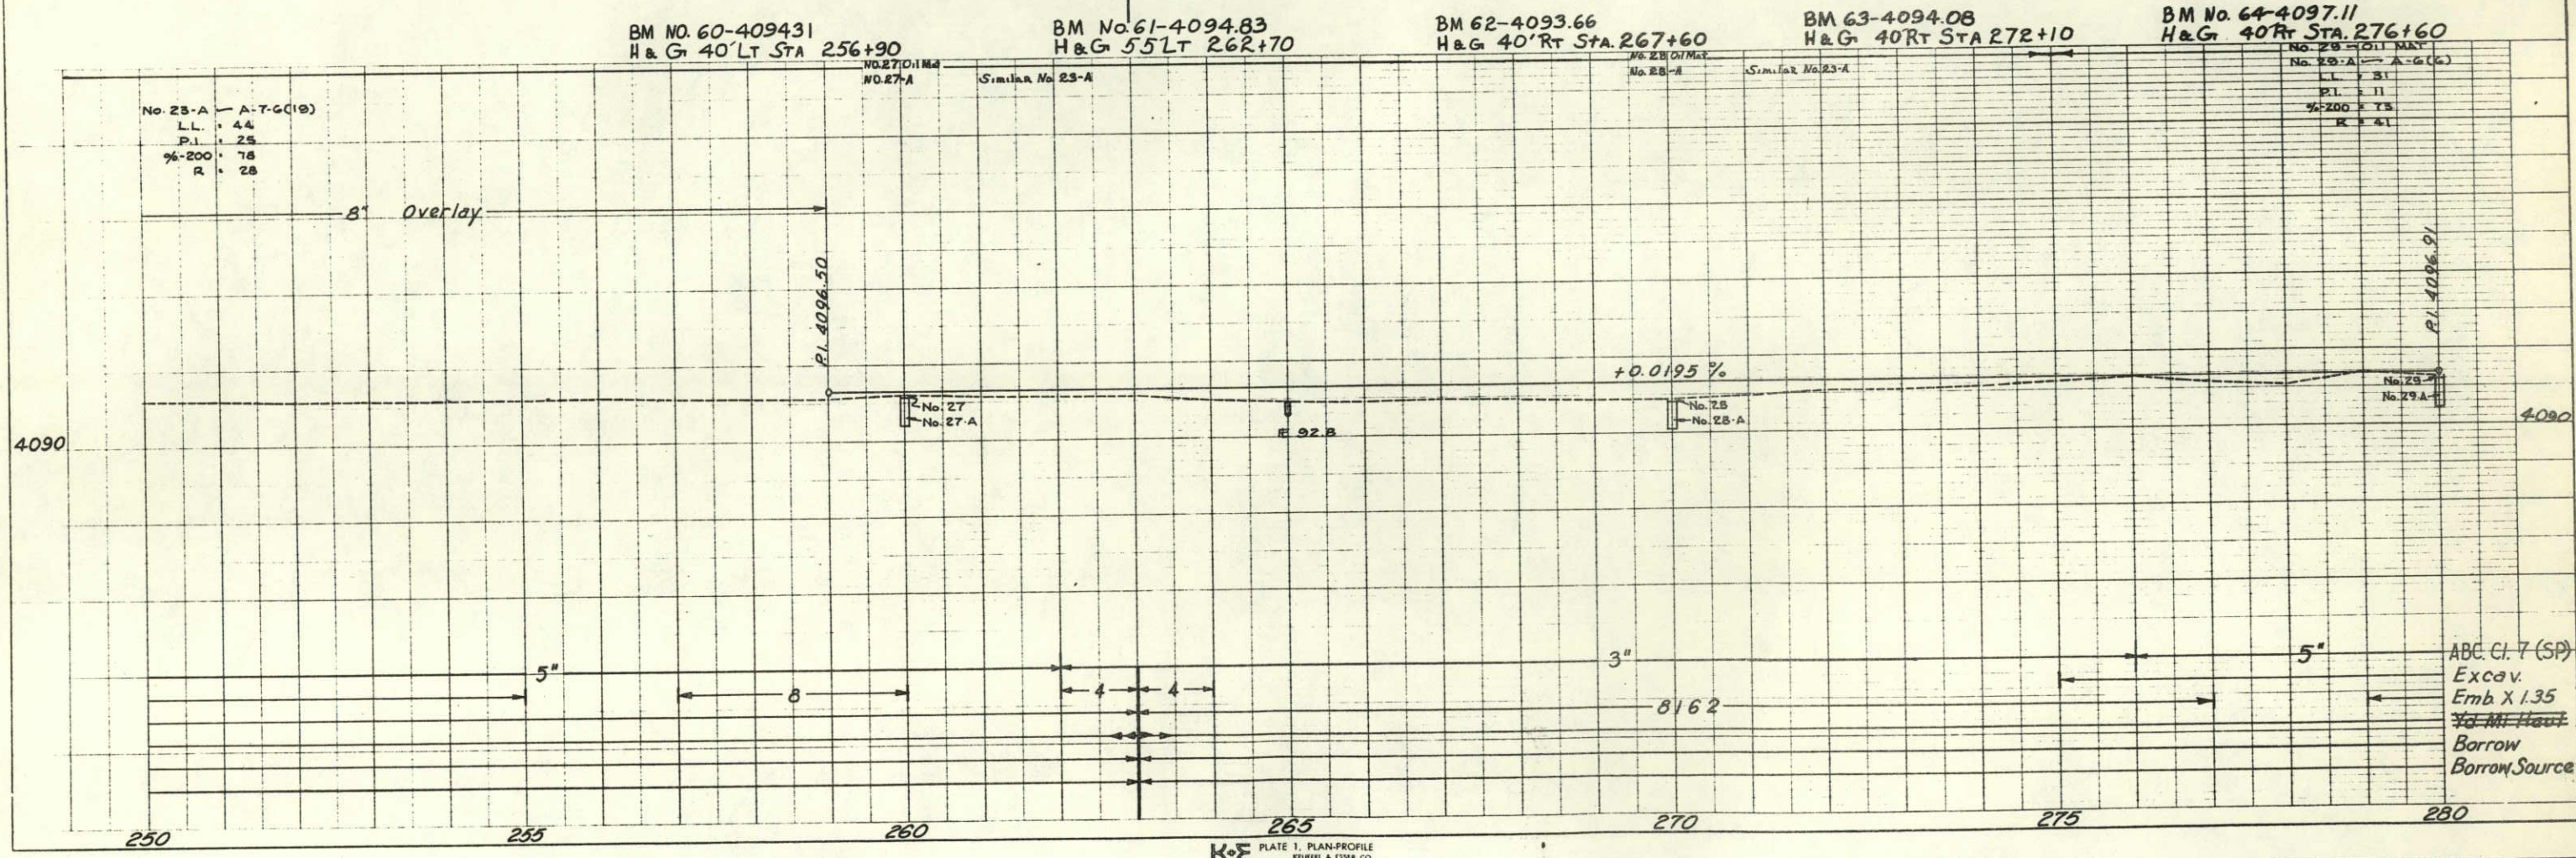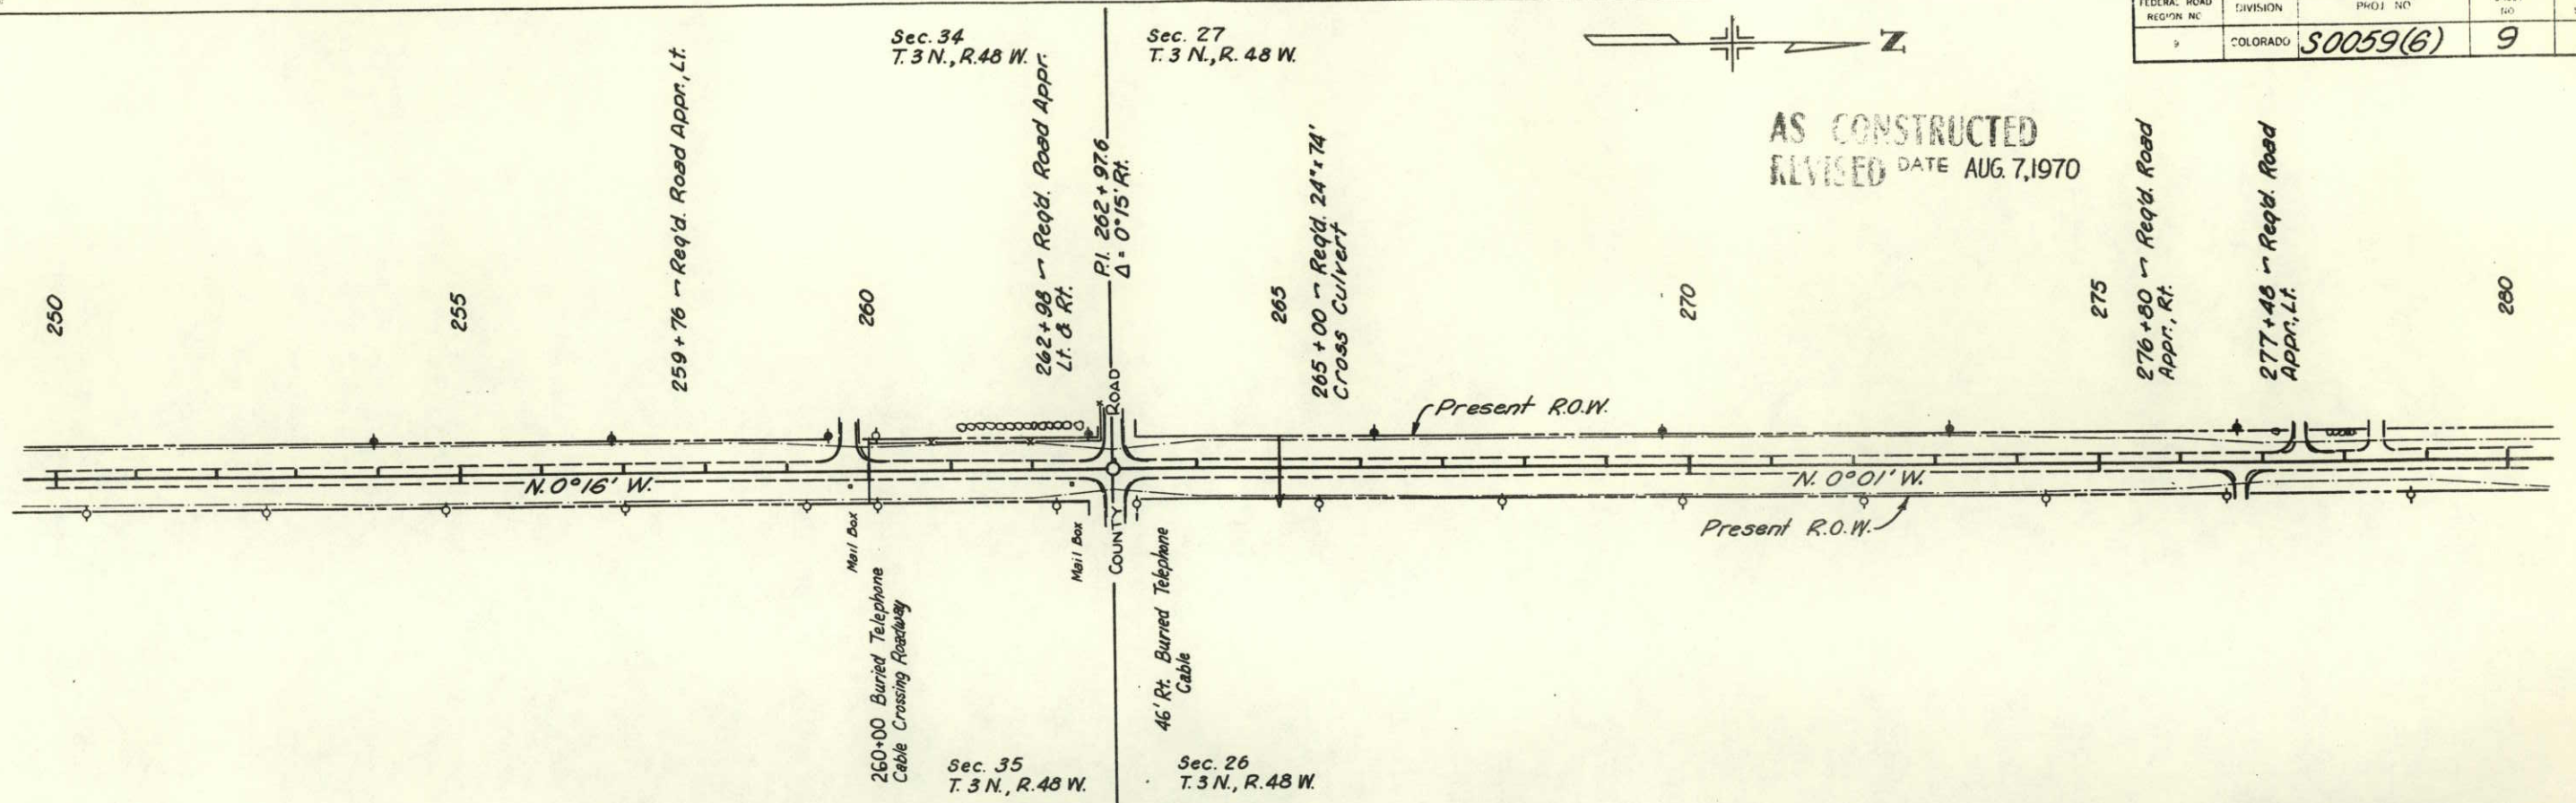




FEDERAL ROAD REGION NO.	DIVISION	PROJ. NO.	SHEET NO.	TOTAL SHEETS
9	COLORADO	50059(6)	10	

AS CONSTRUCTED
 REVISION DATE AUG. 7, 1970

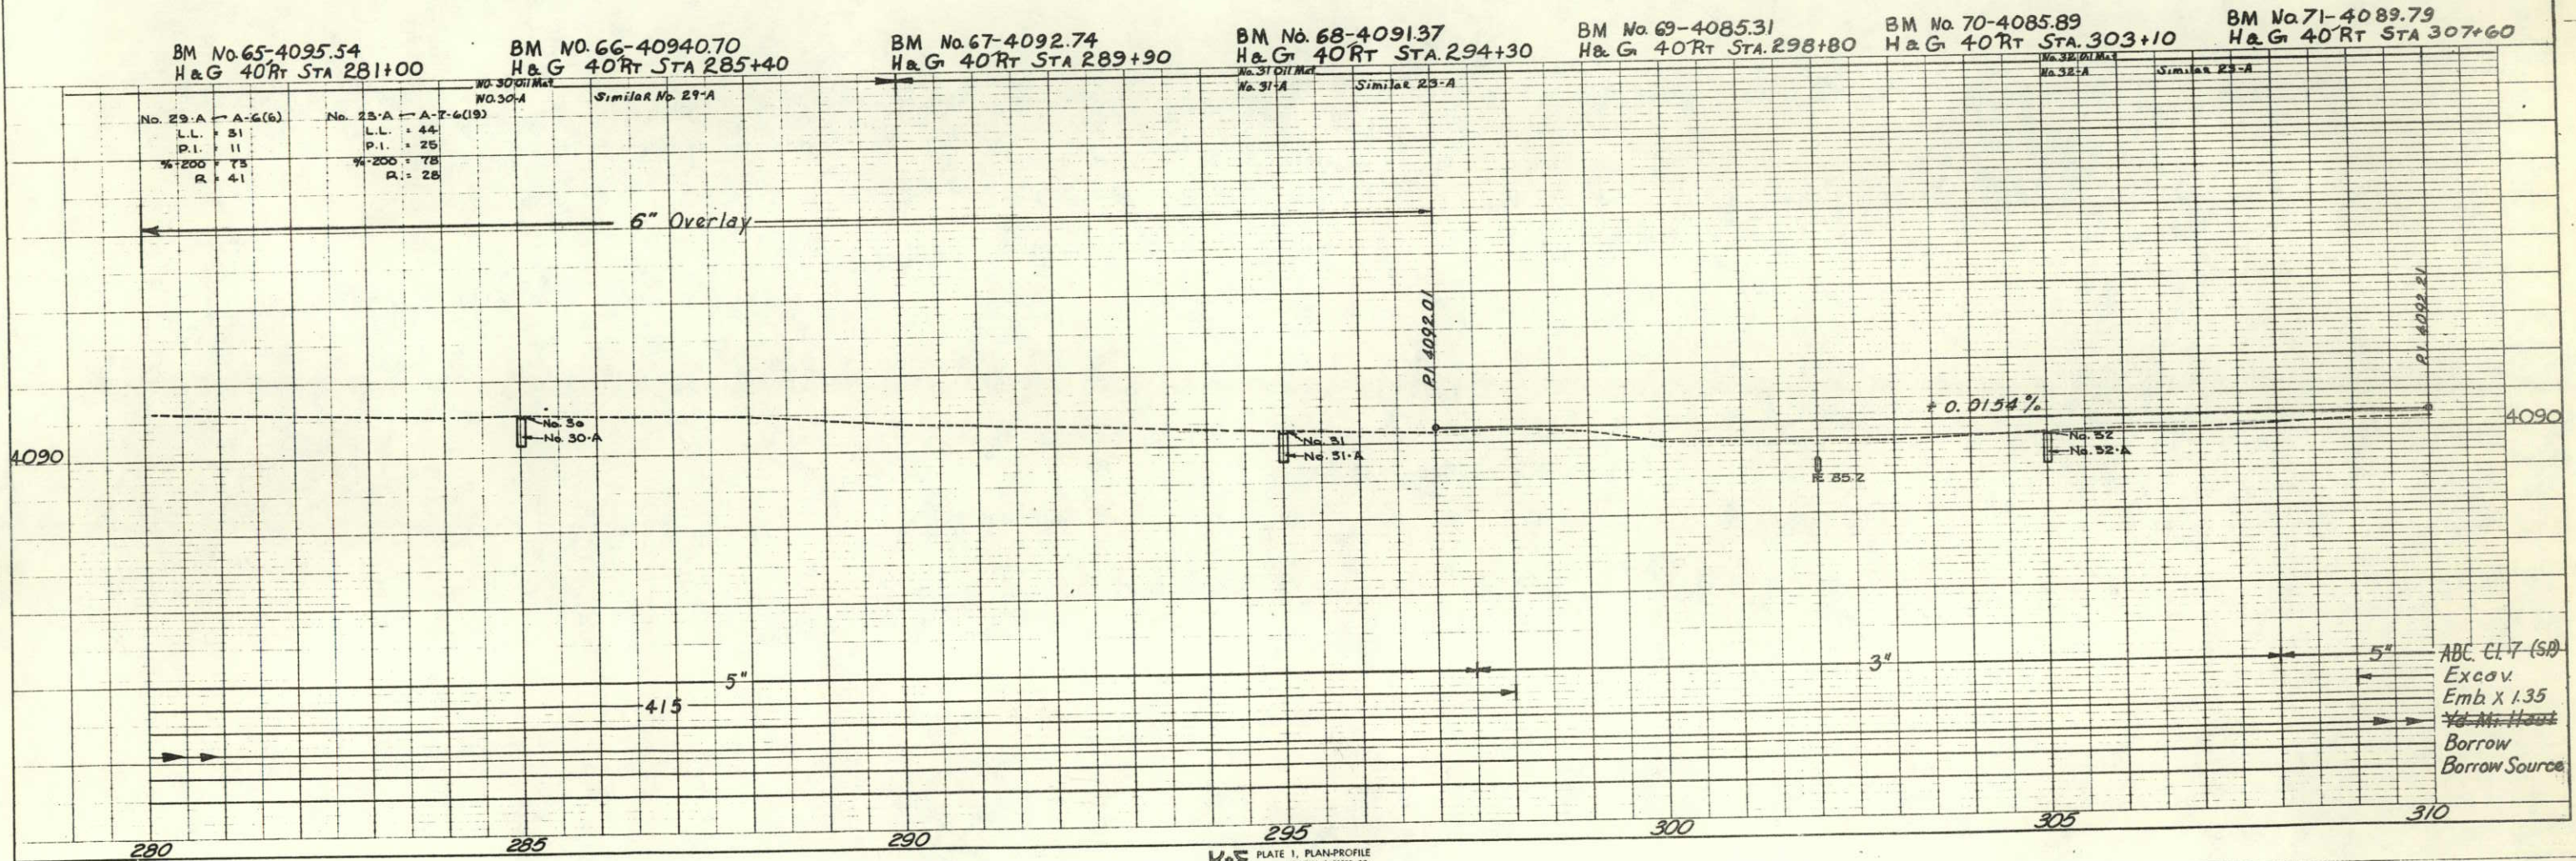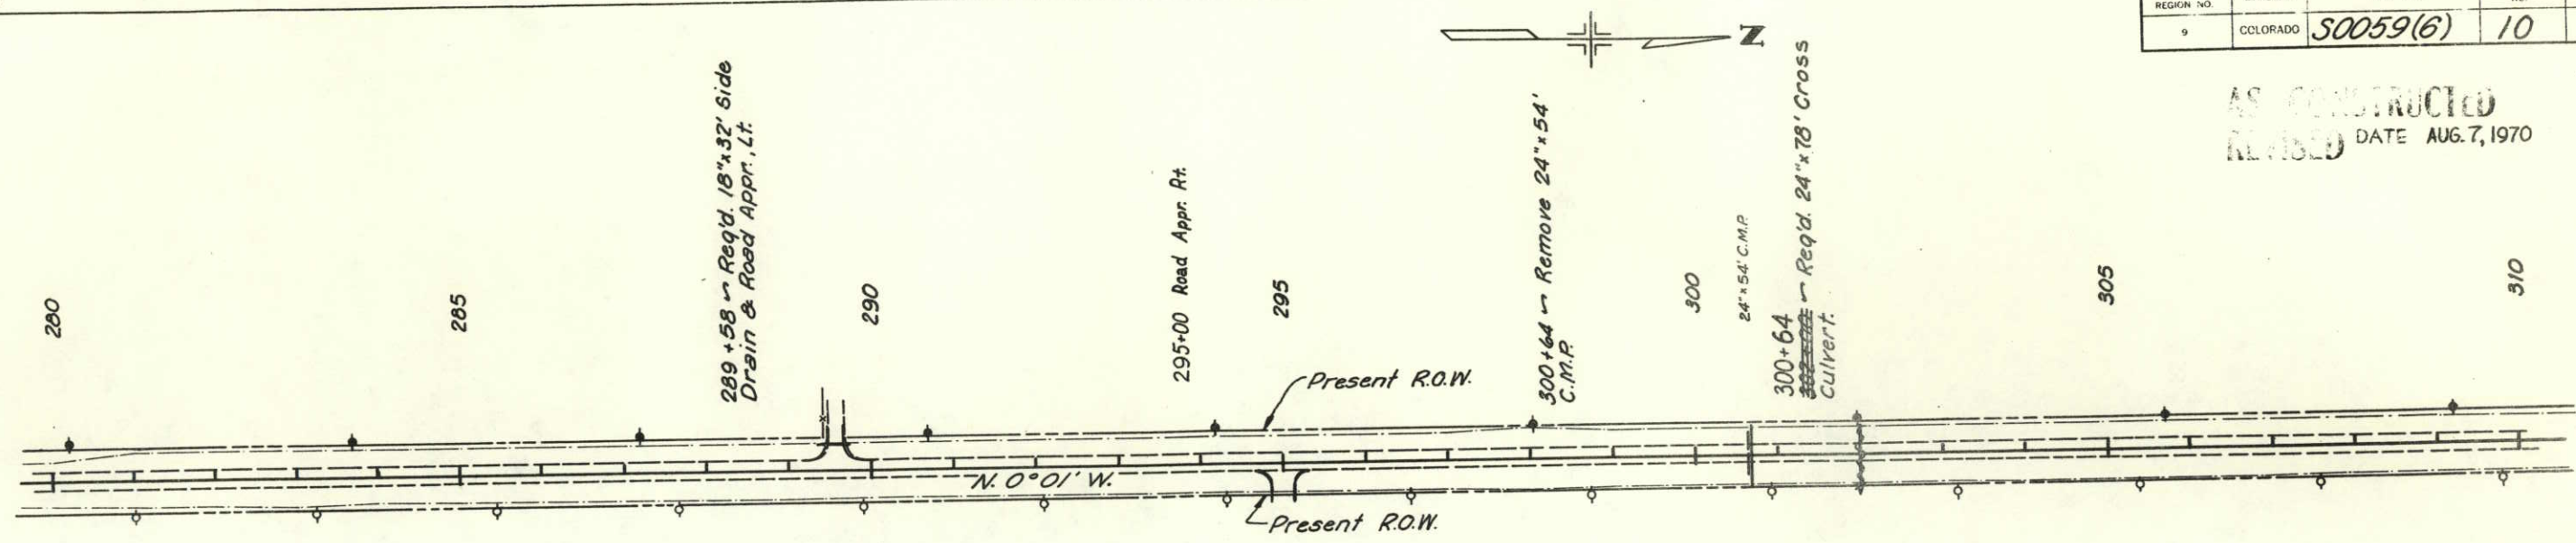

FEDERAL ROAD REGION NO.	DIVISION	PROJ. NO.	SHEET NO.	TOTAL SHEETS
9	COLORADO	50059(6)	11	

DATE AUG. 7, 1970

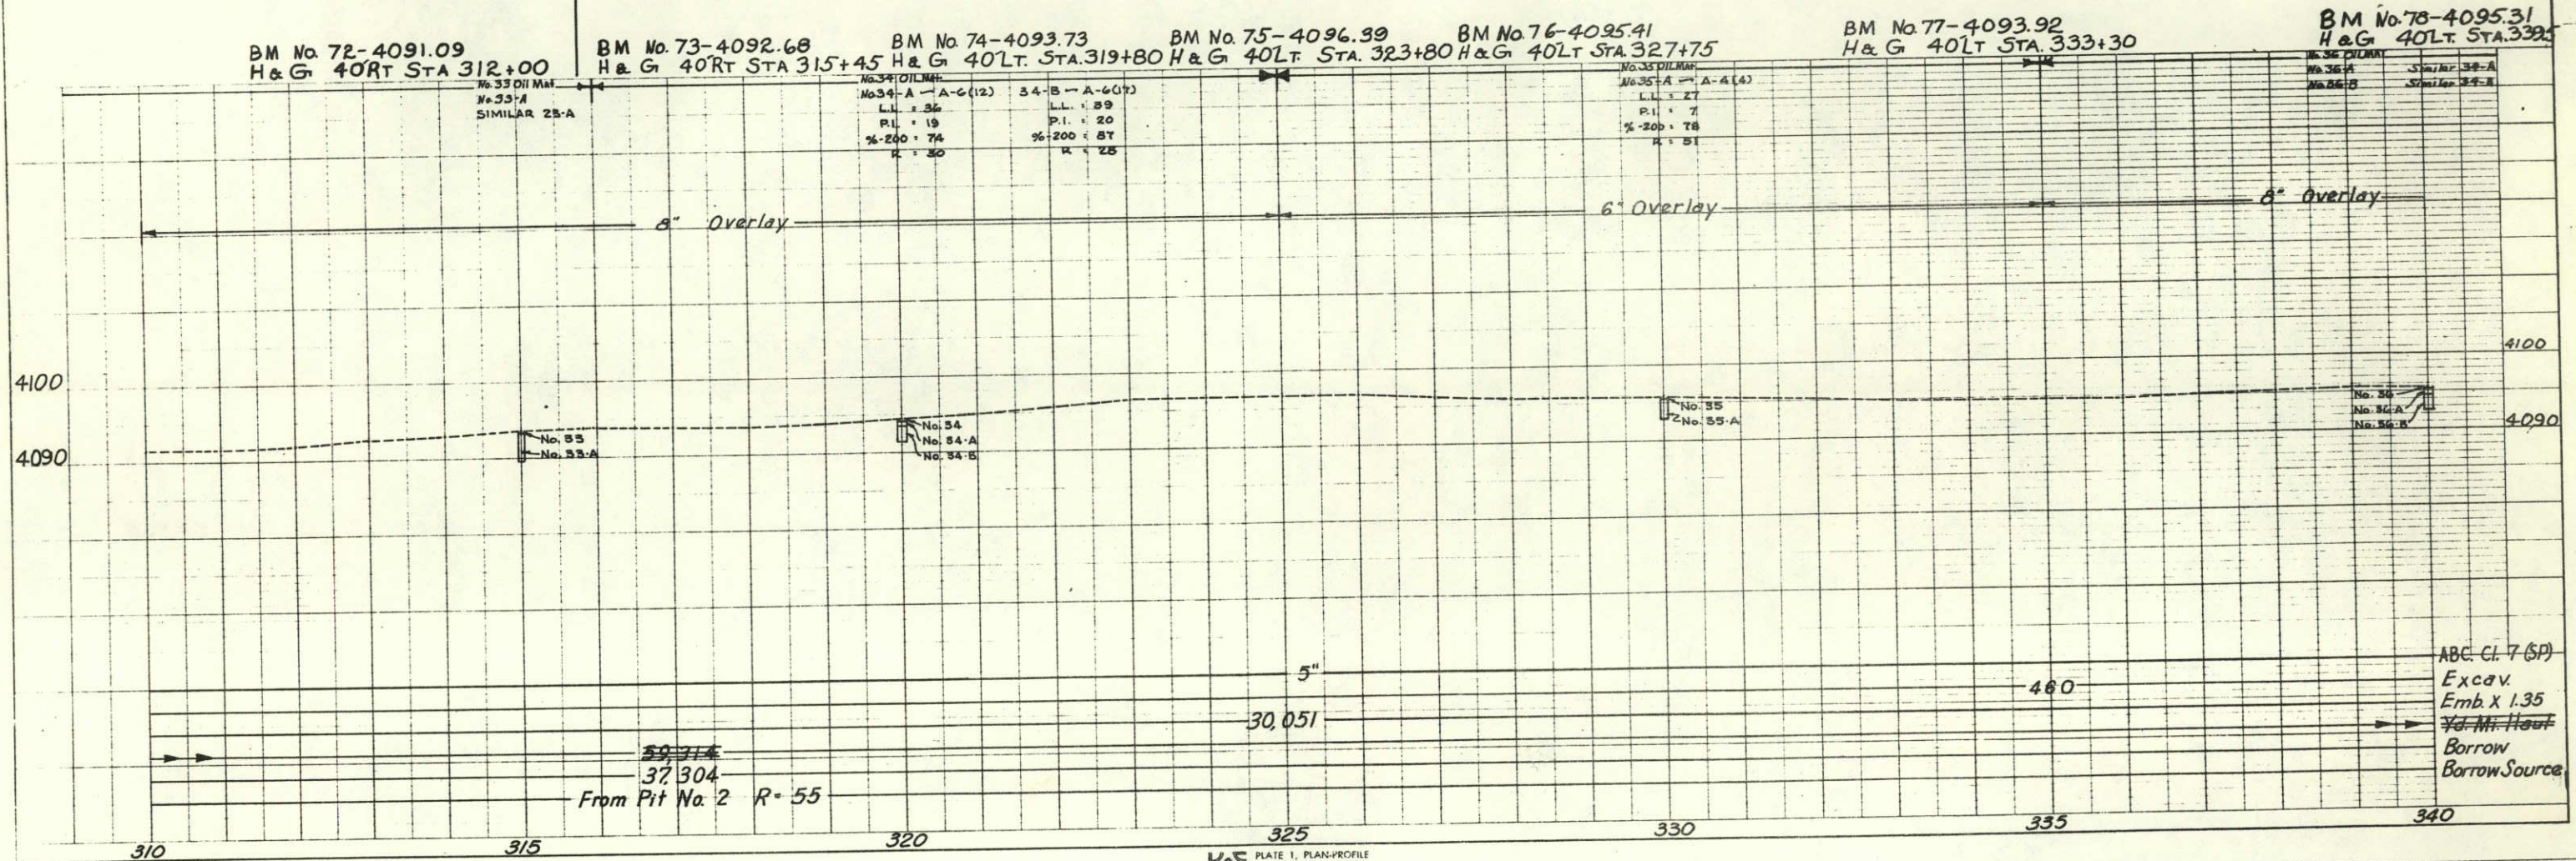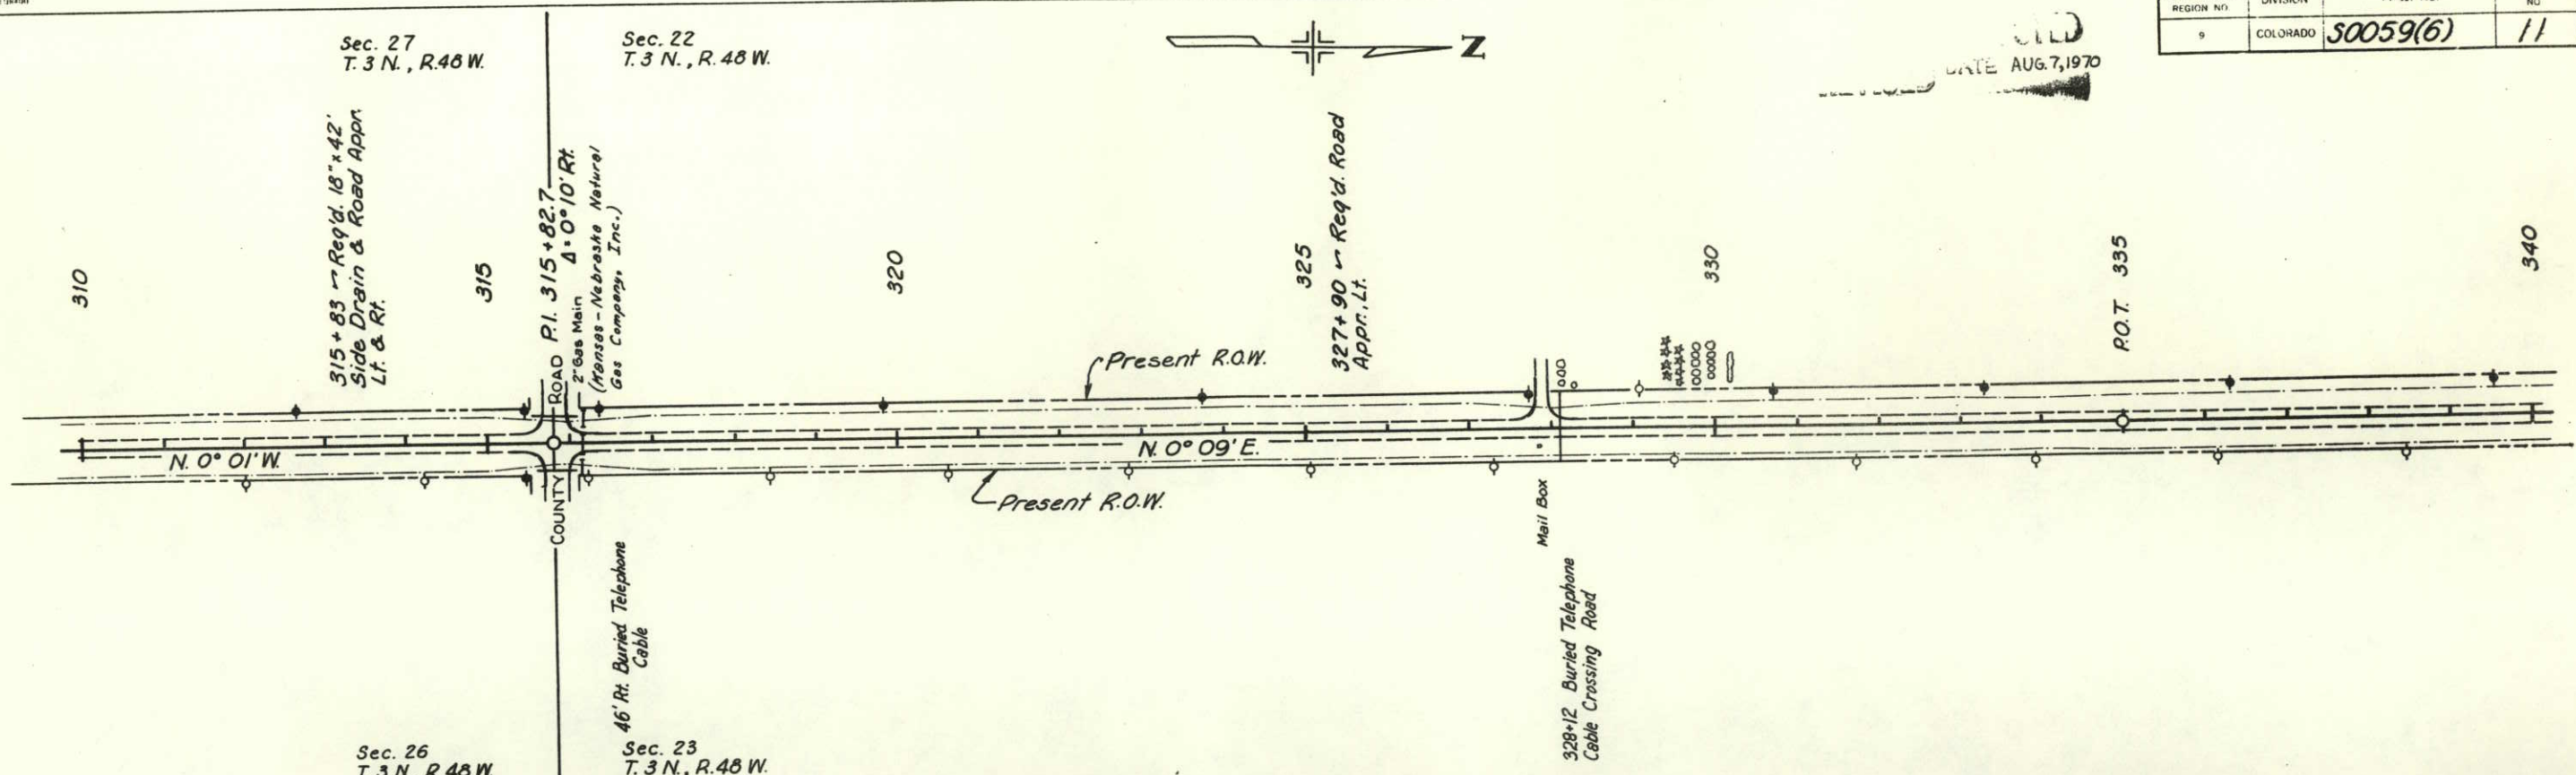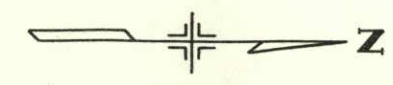


FEDERAL ROAD REGION NO.	DIVISION	PROJ. NO.	SHEET NO.	TOTAL SHEETS
9	COLORADO	50059(6)	12	

Sec. 22
T. 3 N., R. 48 W.

Sec. 15
T. 3 N., R. 48 W.

Sec. 23
T. 3 N., R. 48 W.



Sec. 14
T. 3 N., R. 48 W.

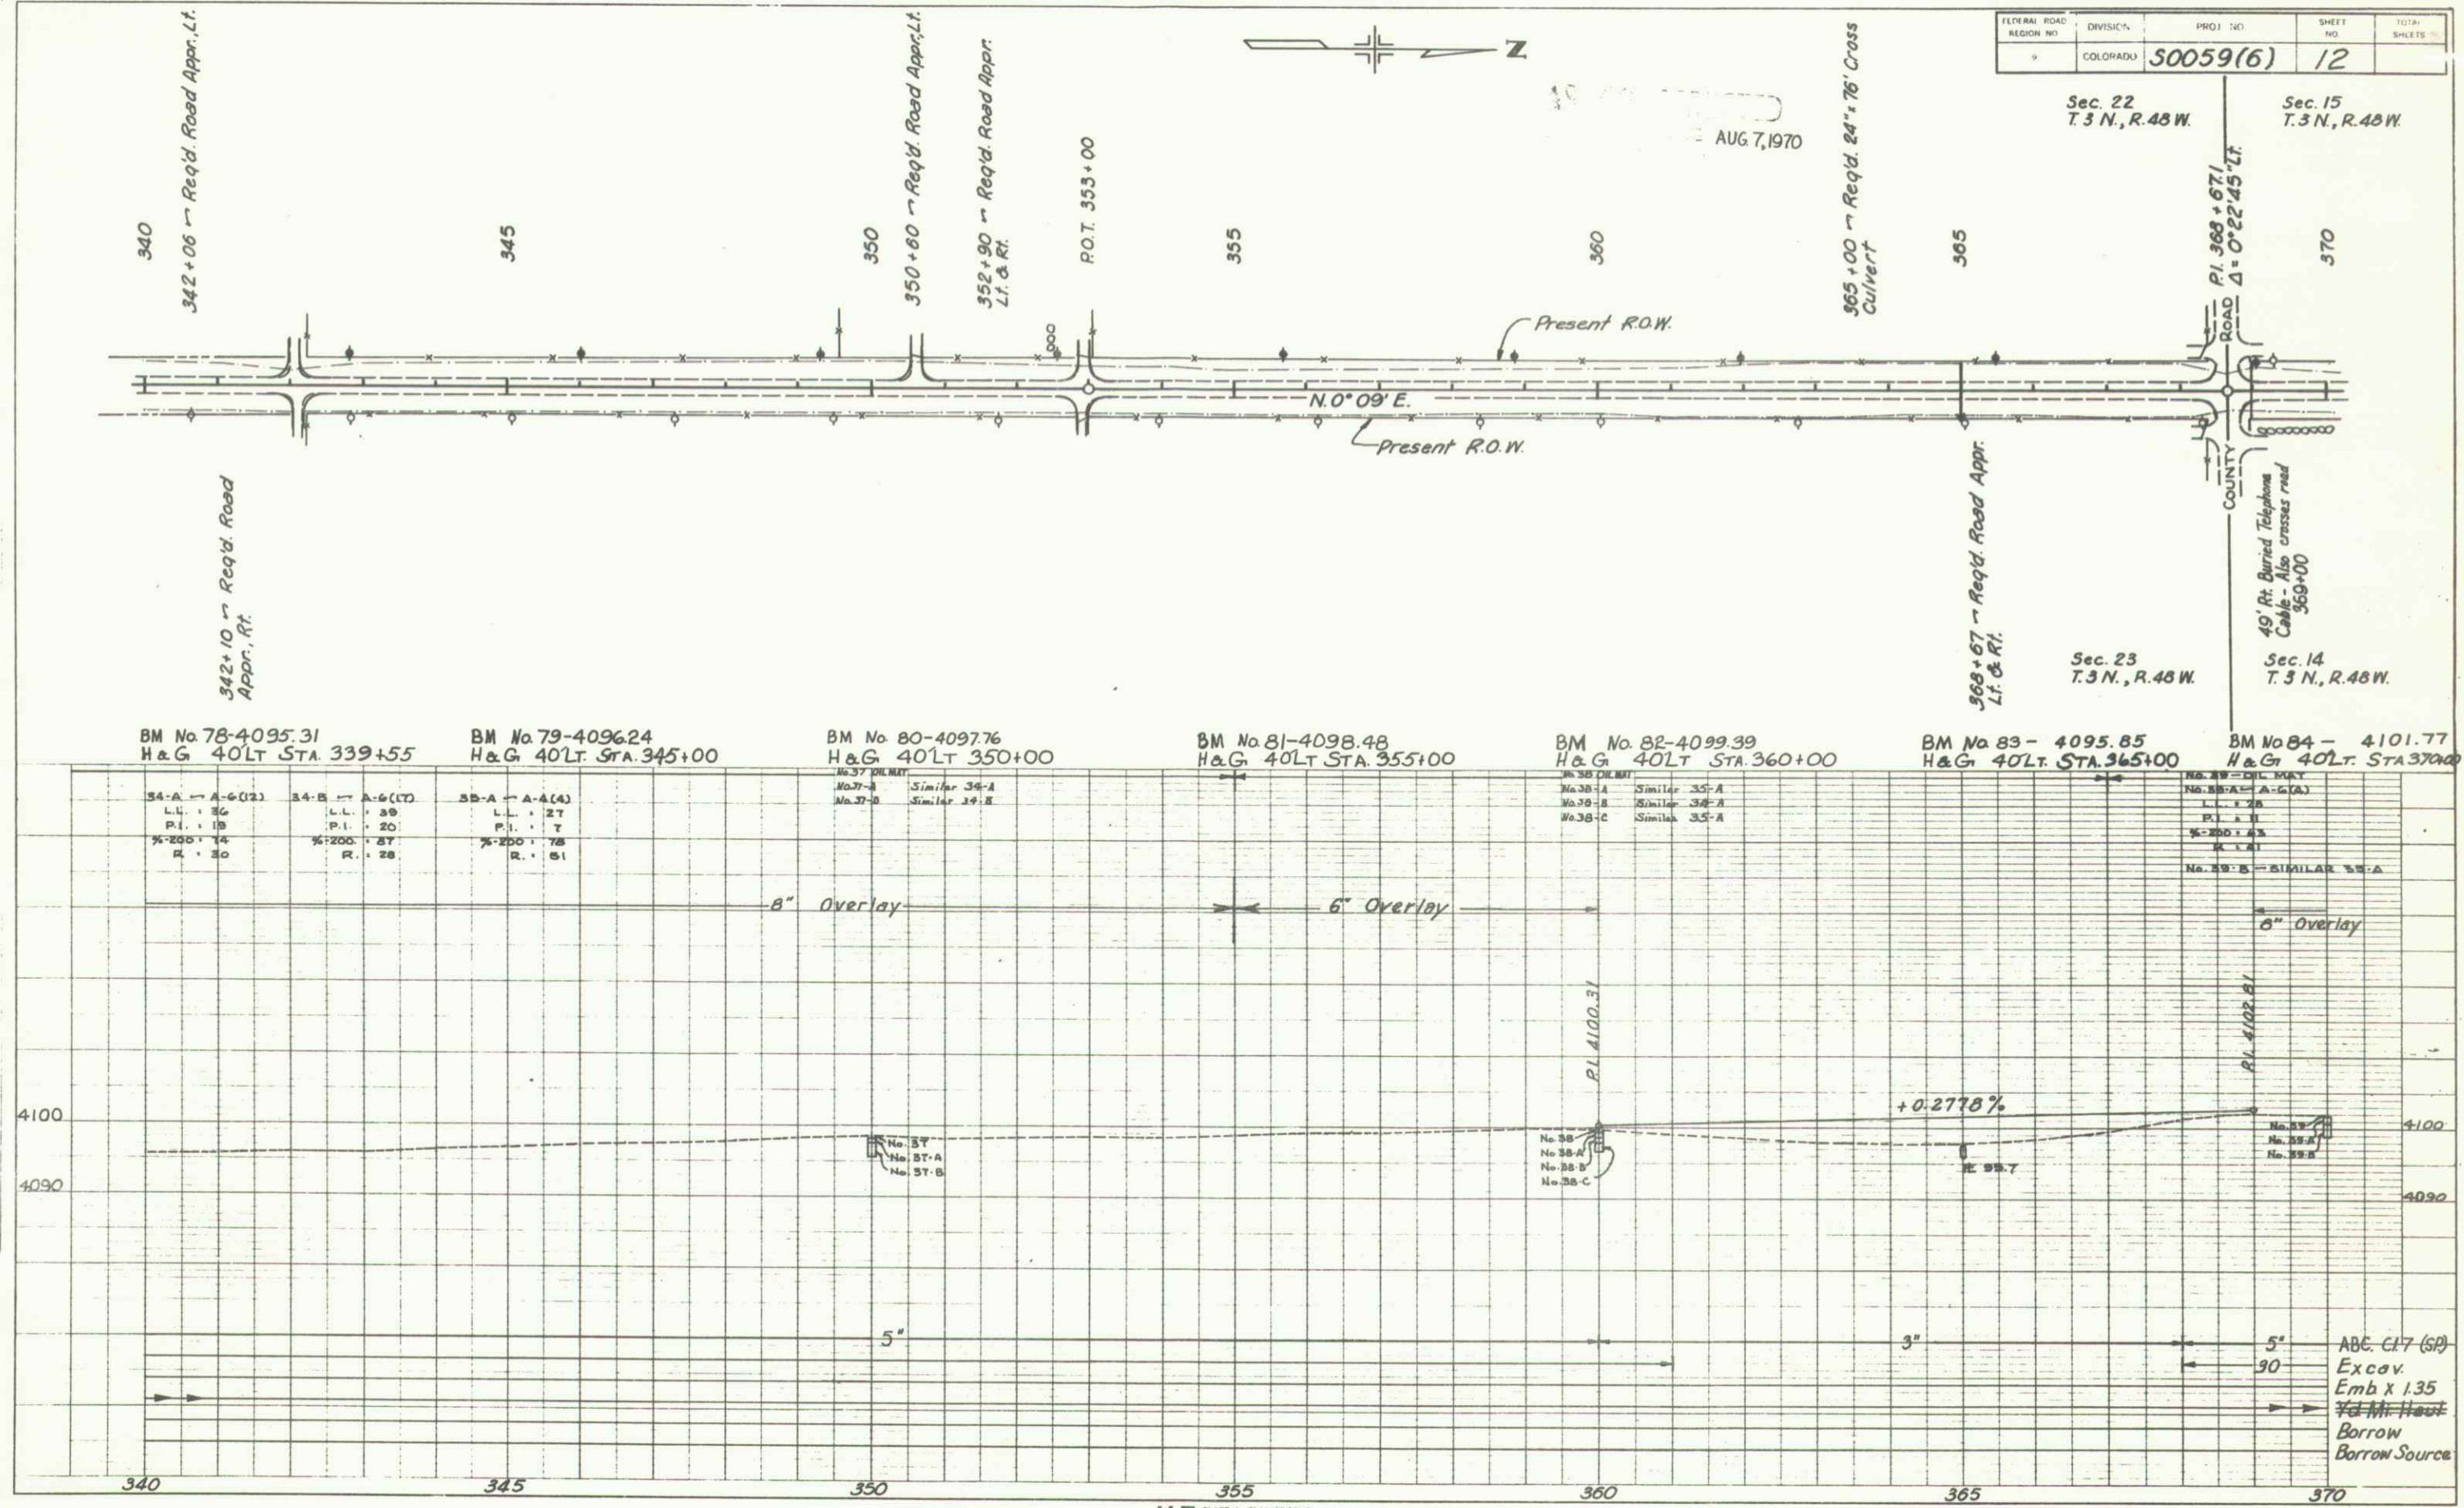

DESIGN OF HIGHWAYS
BY HIGHWAYS - STATE OF COLORADO

FEDERAL ROAD DISTRICT NO.	DIVISION	PROJ. NO.	SHEET NO.	TOTAL SHEETS
9	COLORADO	50059(6)	13	

DATE AUG. 7, 1970

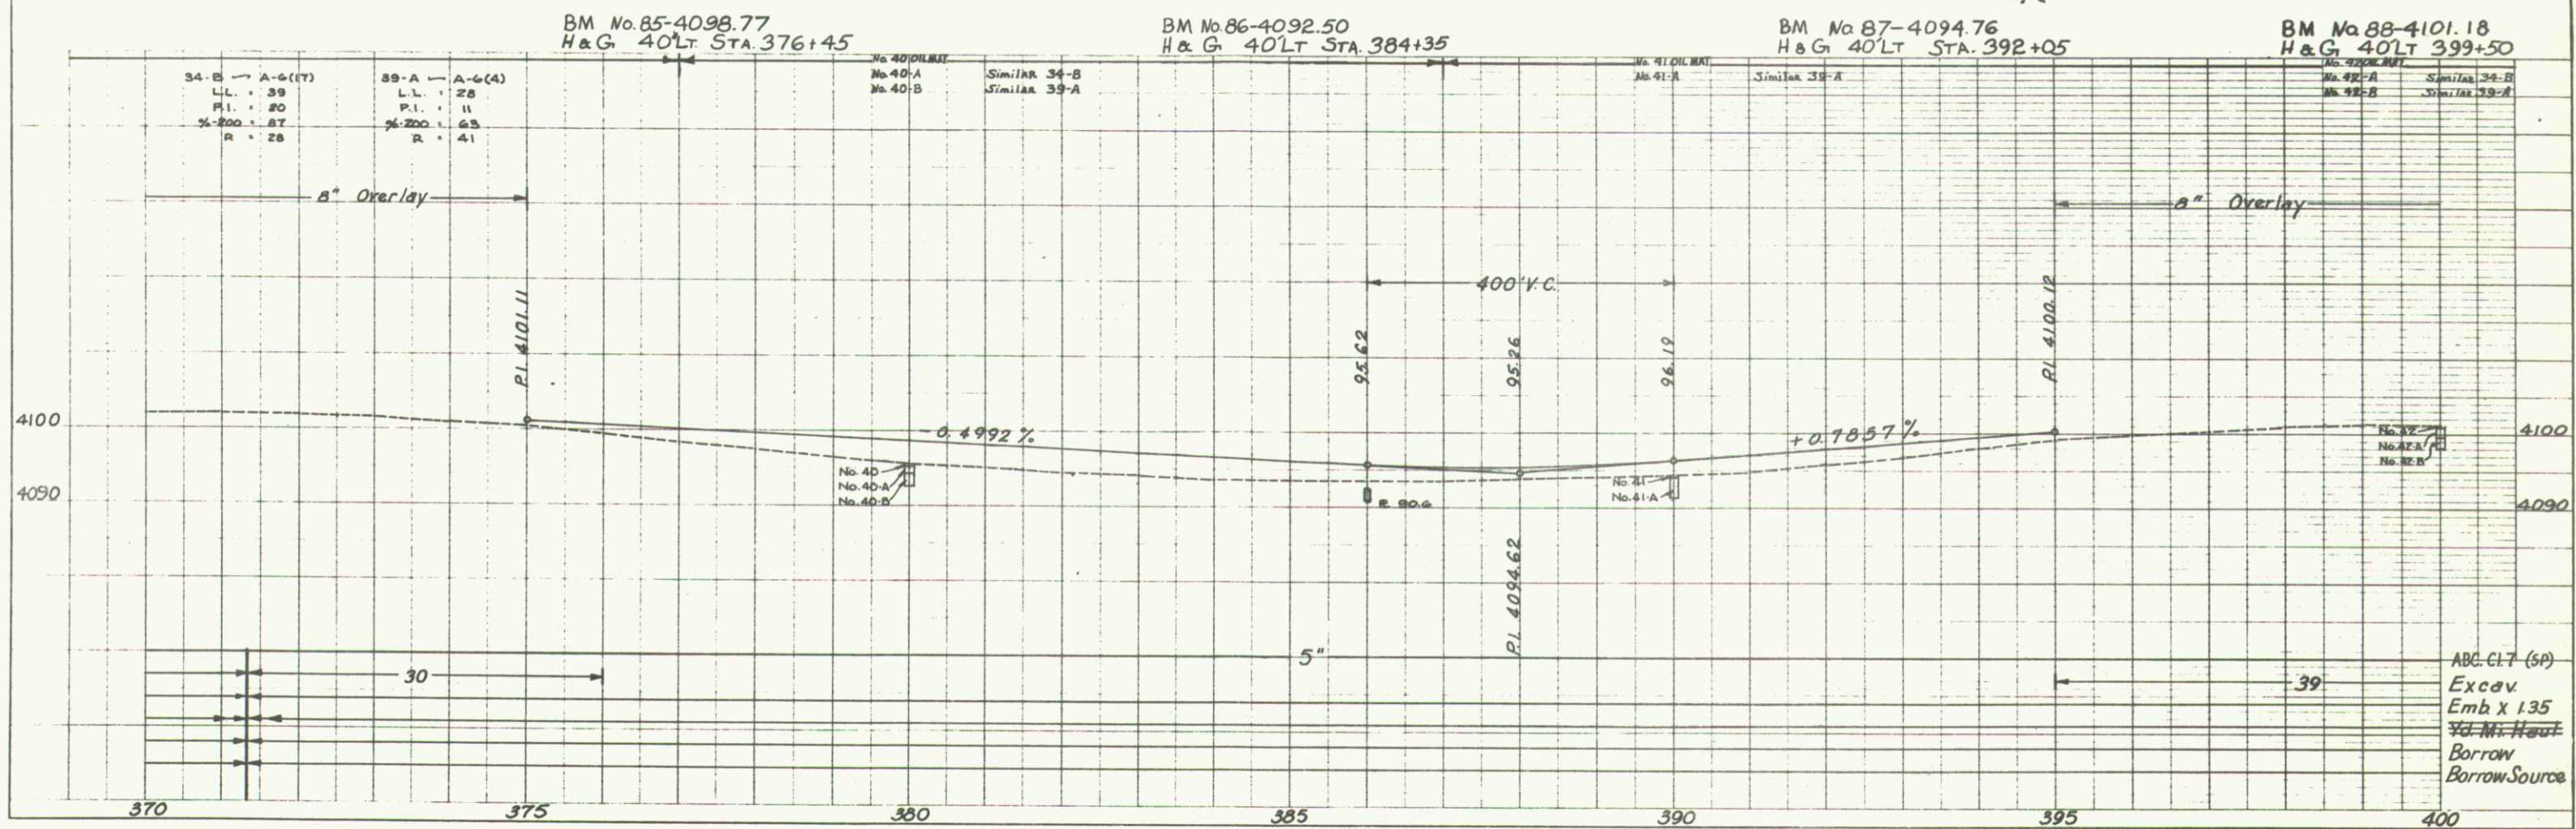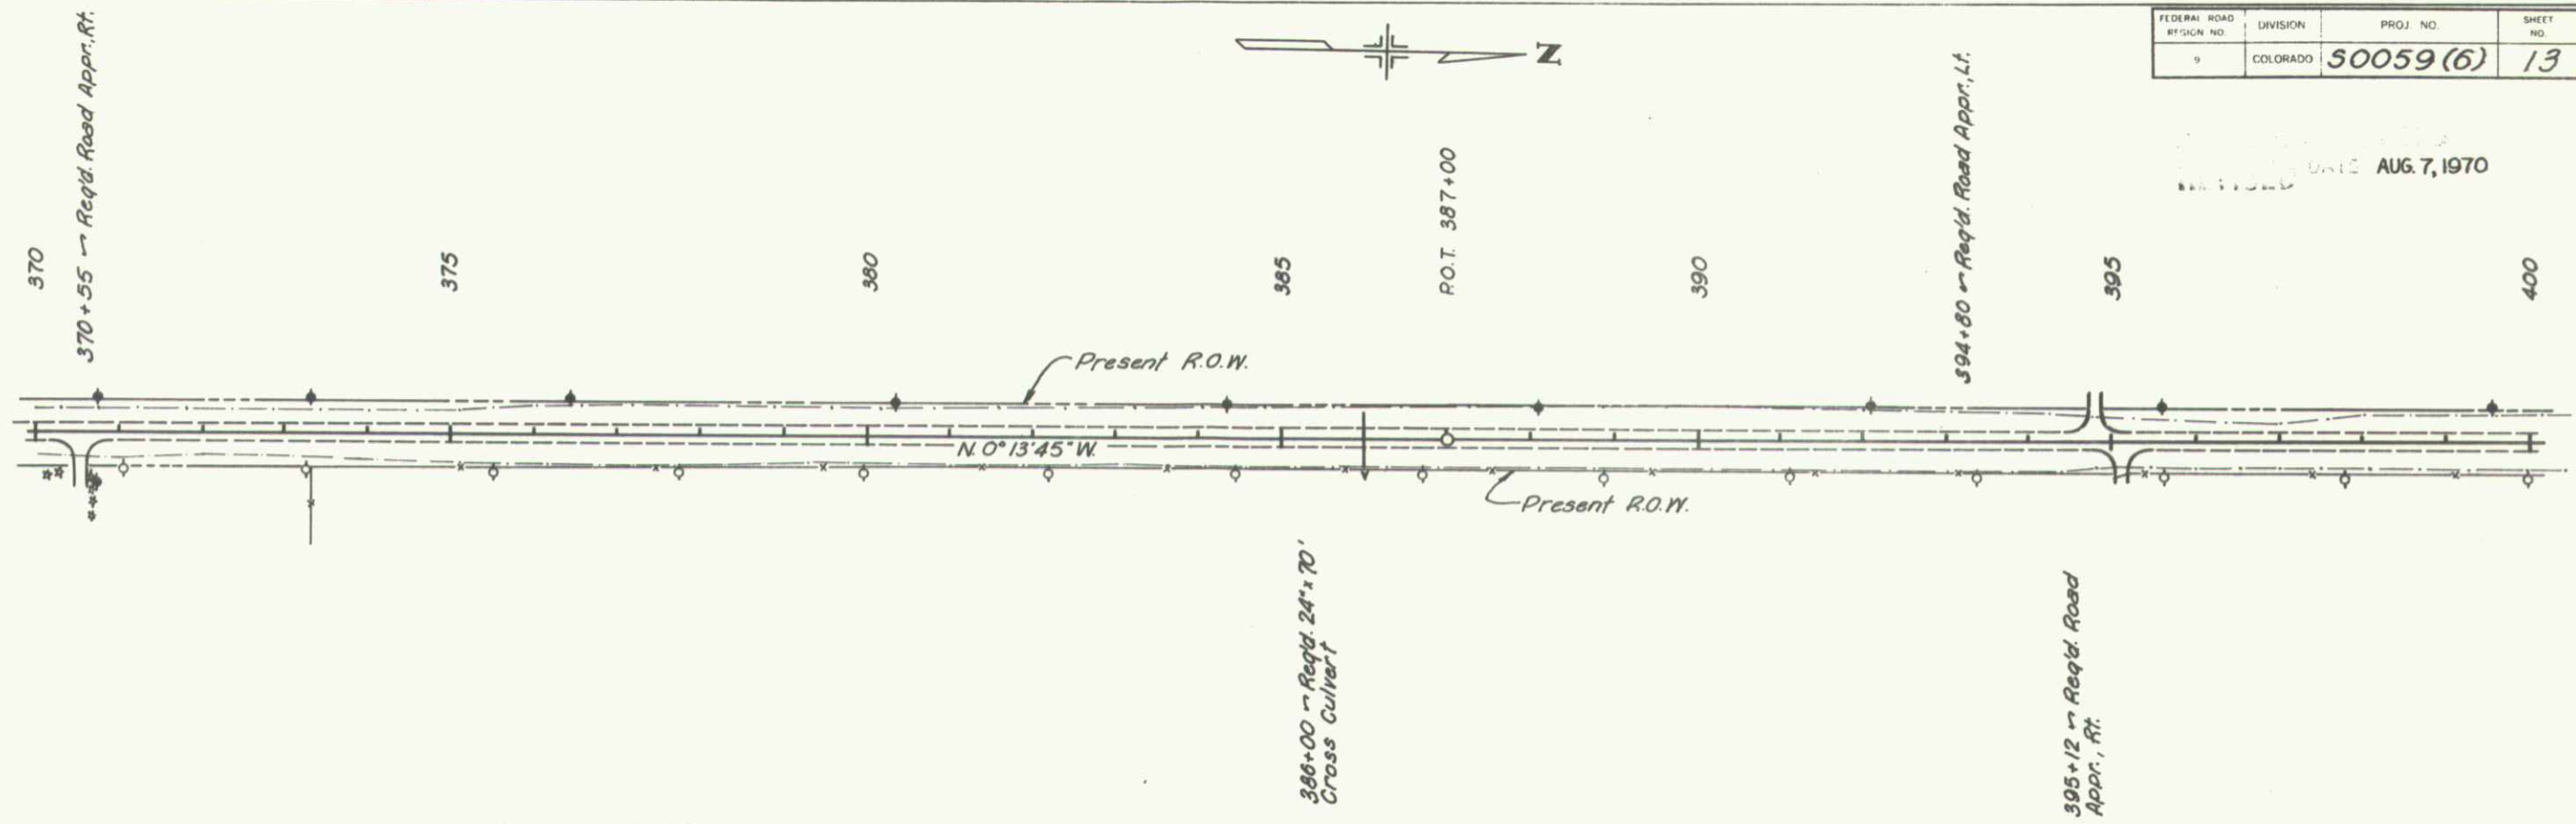


PLAN
30709

PROFILE
30709


FEDERAL ROAD DISTRICT NO.	DIVISION	PROJ. NO.	SHEET NO.	TOTAL SHEETS
9	COLORADO	50059(6)	14	

RECEIVED
AUG. 7, 1970

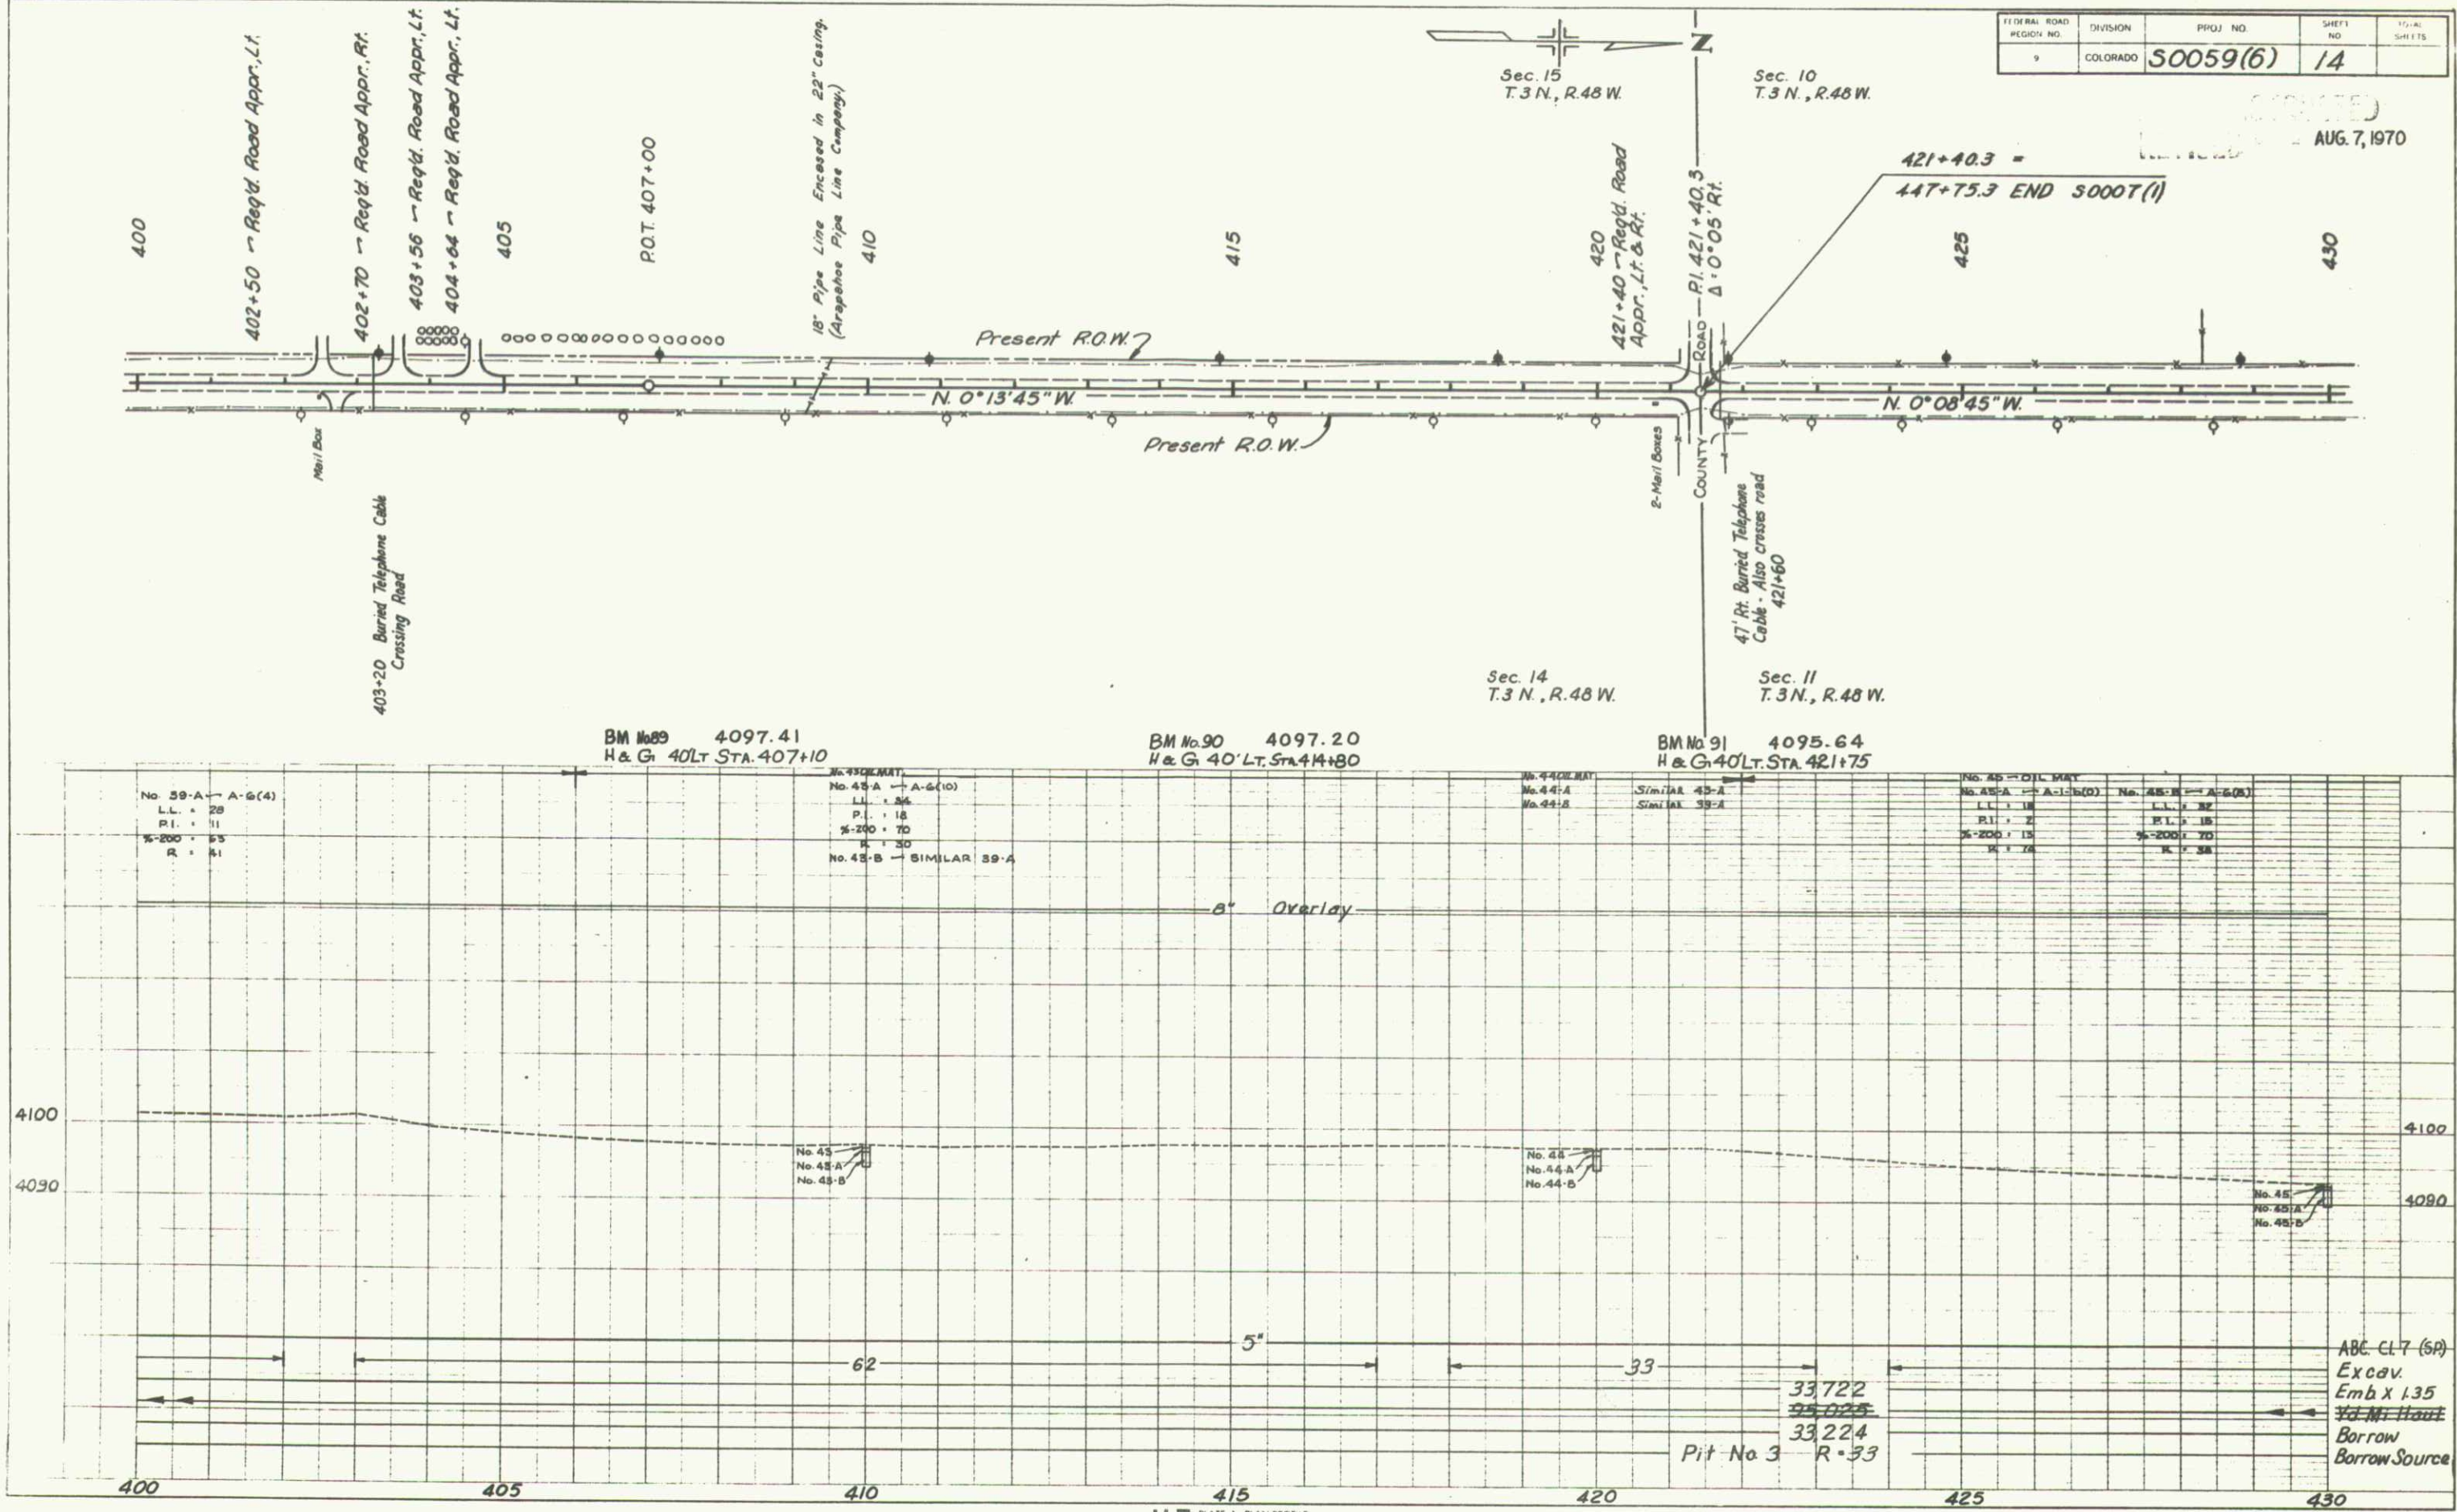

FEDERAL ROAD REGION NO.	DIVISION	PROJ. NO.	SHEET NO.	TOTAL SHEETS
9	COLORADO	50059(6)	15	

AUG. 7, 1970

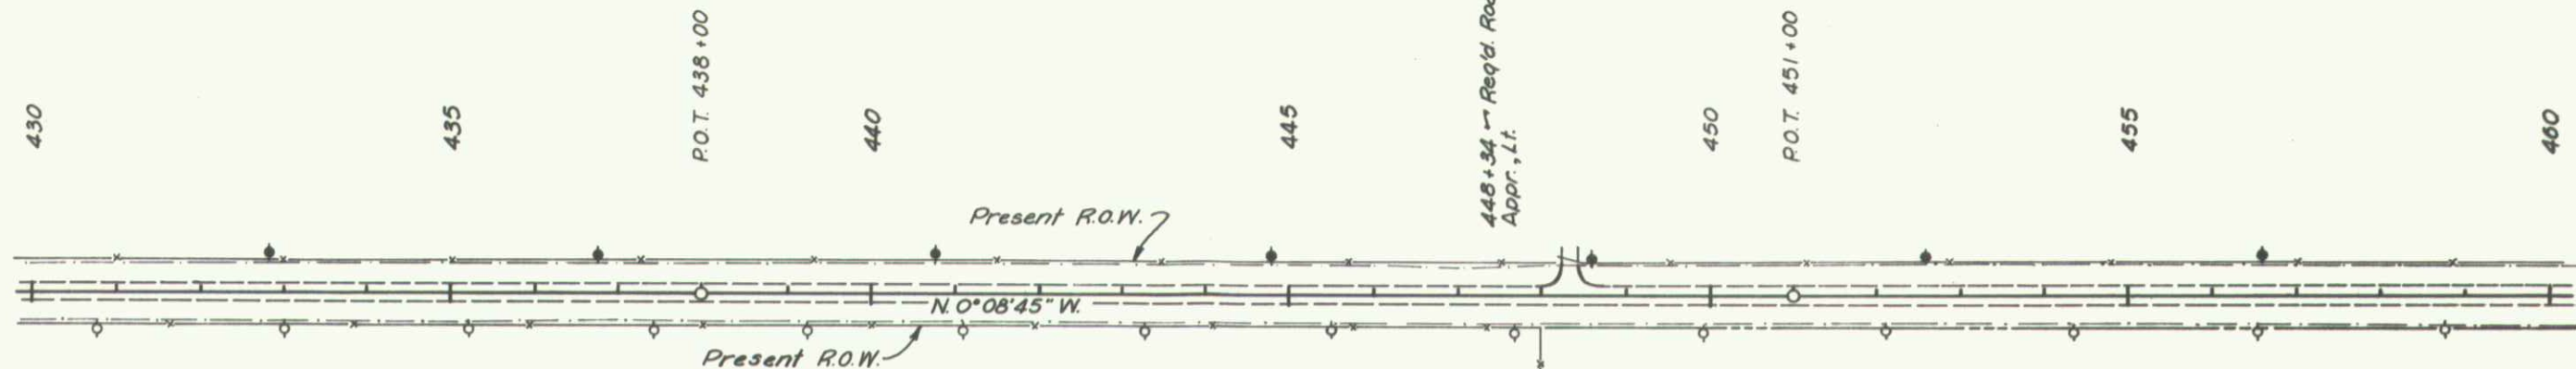

BM No 93 4091.71
H & G 40' LT. STA. 432+00

BM No 94 4092.54
H & G 40' LT. STA. 437+00

BM No 95 4090.85
H & G 40' LT. STA. 442+00

BM No 96 4089.65
H & G 40' LT. STA. 447+00

BM No 97 4087.41
H & G 40' LT. STA. 452+00

BM No 98 4085.02
H & G 40' LT. STA. 457+00

No. 45-A - A-1+1b(0)
LL: 18
PI: 2
%: 200: 13
R: 74

No. 45-B - A-5(0)
LL: 32
PI: 15
%: 200: 70
R: 38

No. 46 DIL. MAT.
No. 46-A
No. 46-B


Similar 45-A (Gravel)
Similar 45-B

No. 47 DIL. MAT.
No. 47-A
No. 47-B

Similar 45-A (Gravel)
Similar 45-B

No. 48 DIL. MAT.
No. 48-A
No. 48-B

Similar 45-A (Gravel)
Similar 45-B

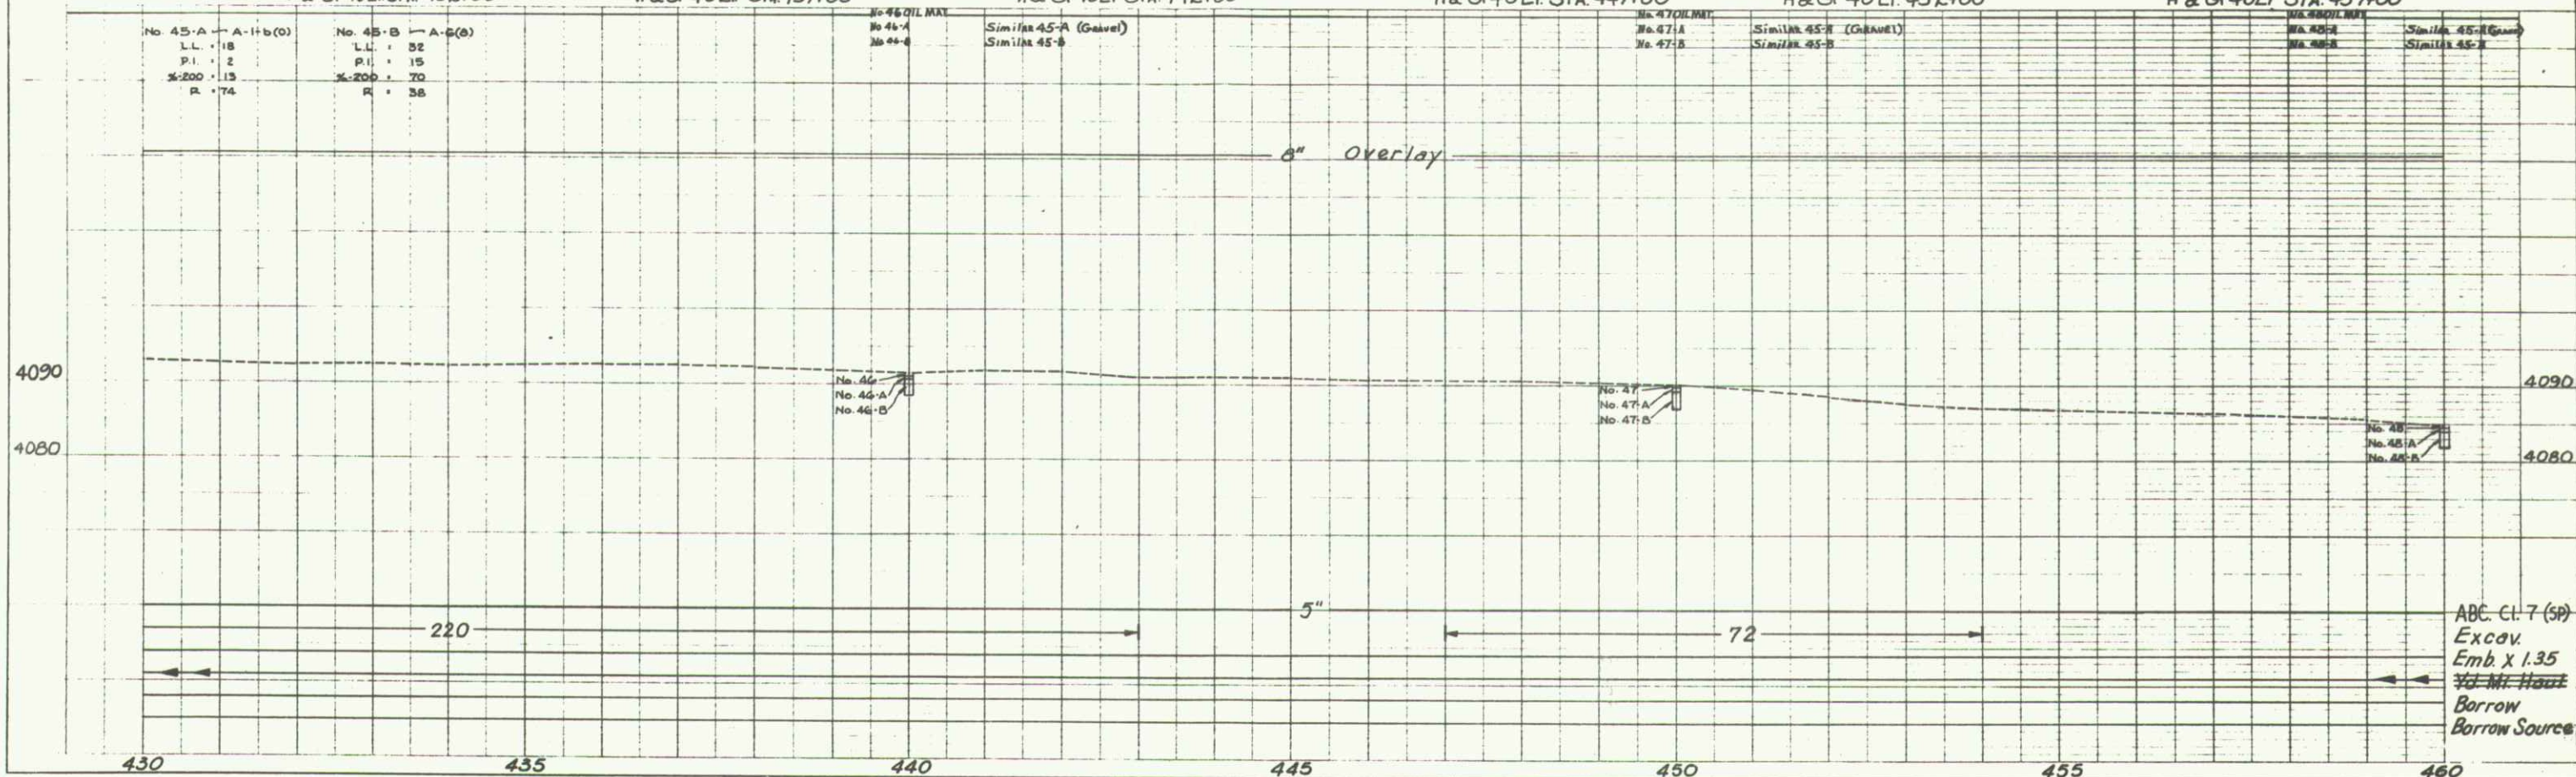


K-E PLATE 1. PLAN-PROFILE
MURPHY & FISHER CO.

45 7012 IMPERIAL™ TRAFFIC CLOTH

FEDERAL ROAD REGION NO.	DIVISION	PROJECT NO.	SHEET NO.	TOTAL SHEETS
9	COLUMBIA	50059(6)	16	

AS CONSTRUCTED
REVISED DATE AUG. 7, 1970

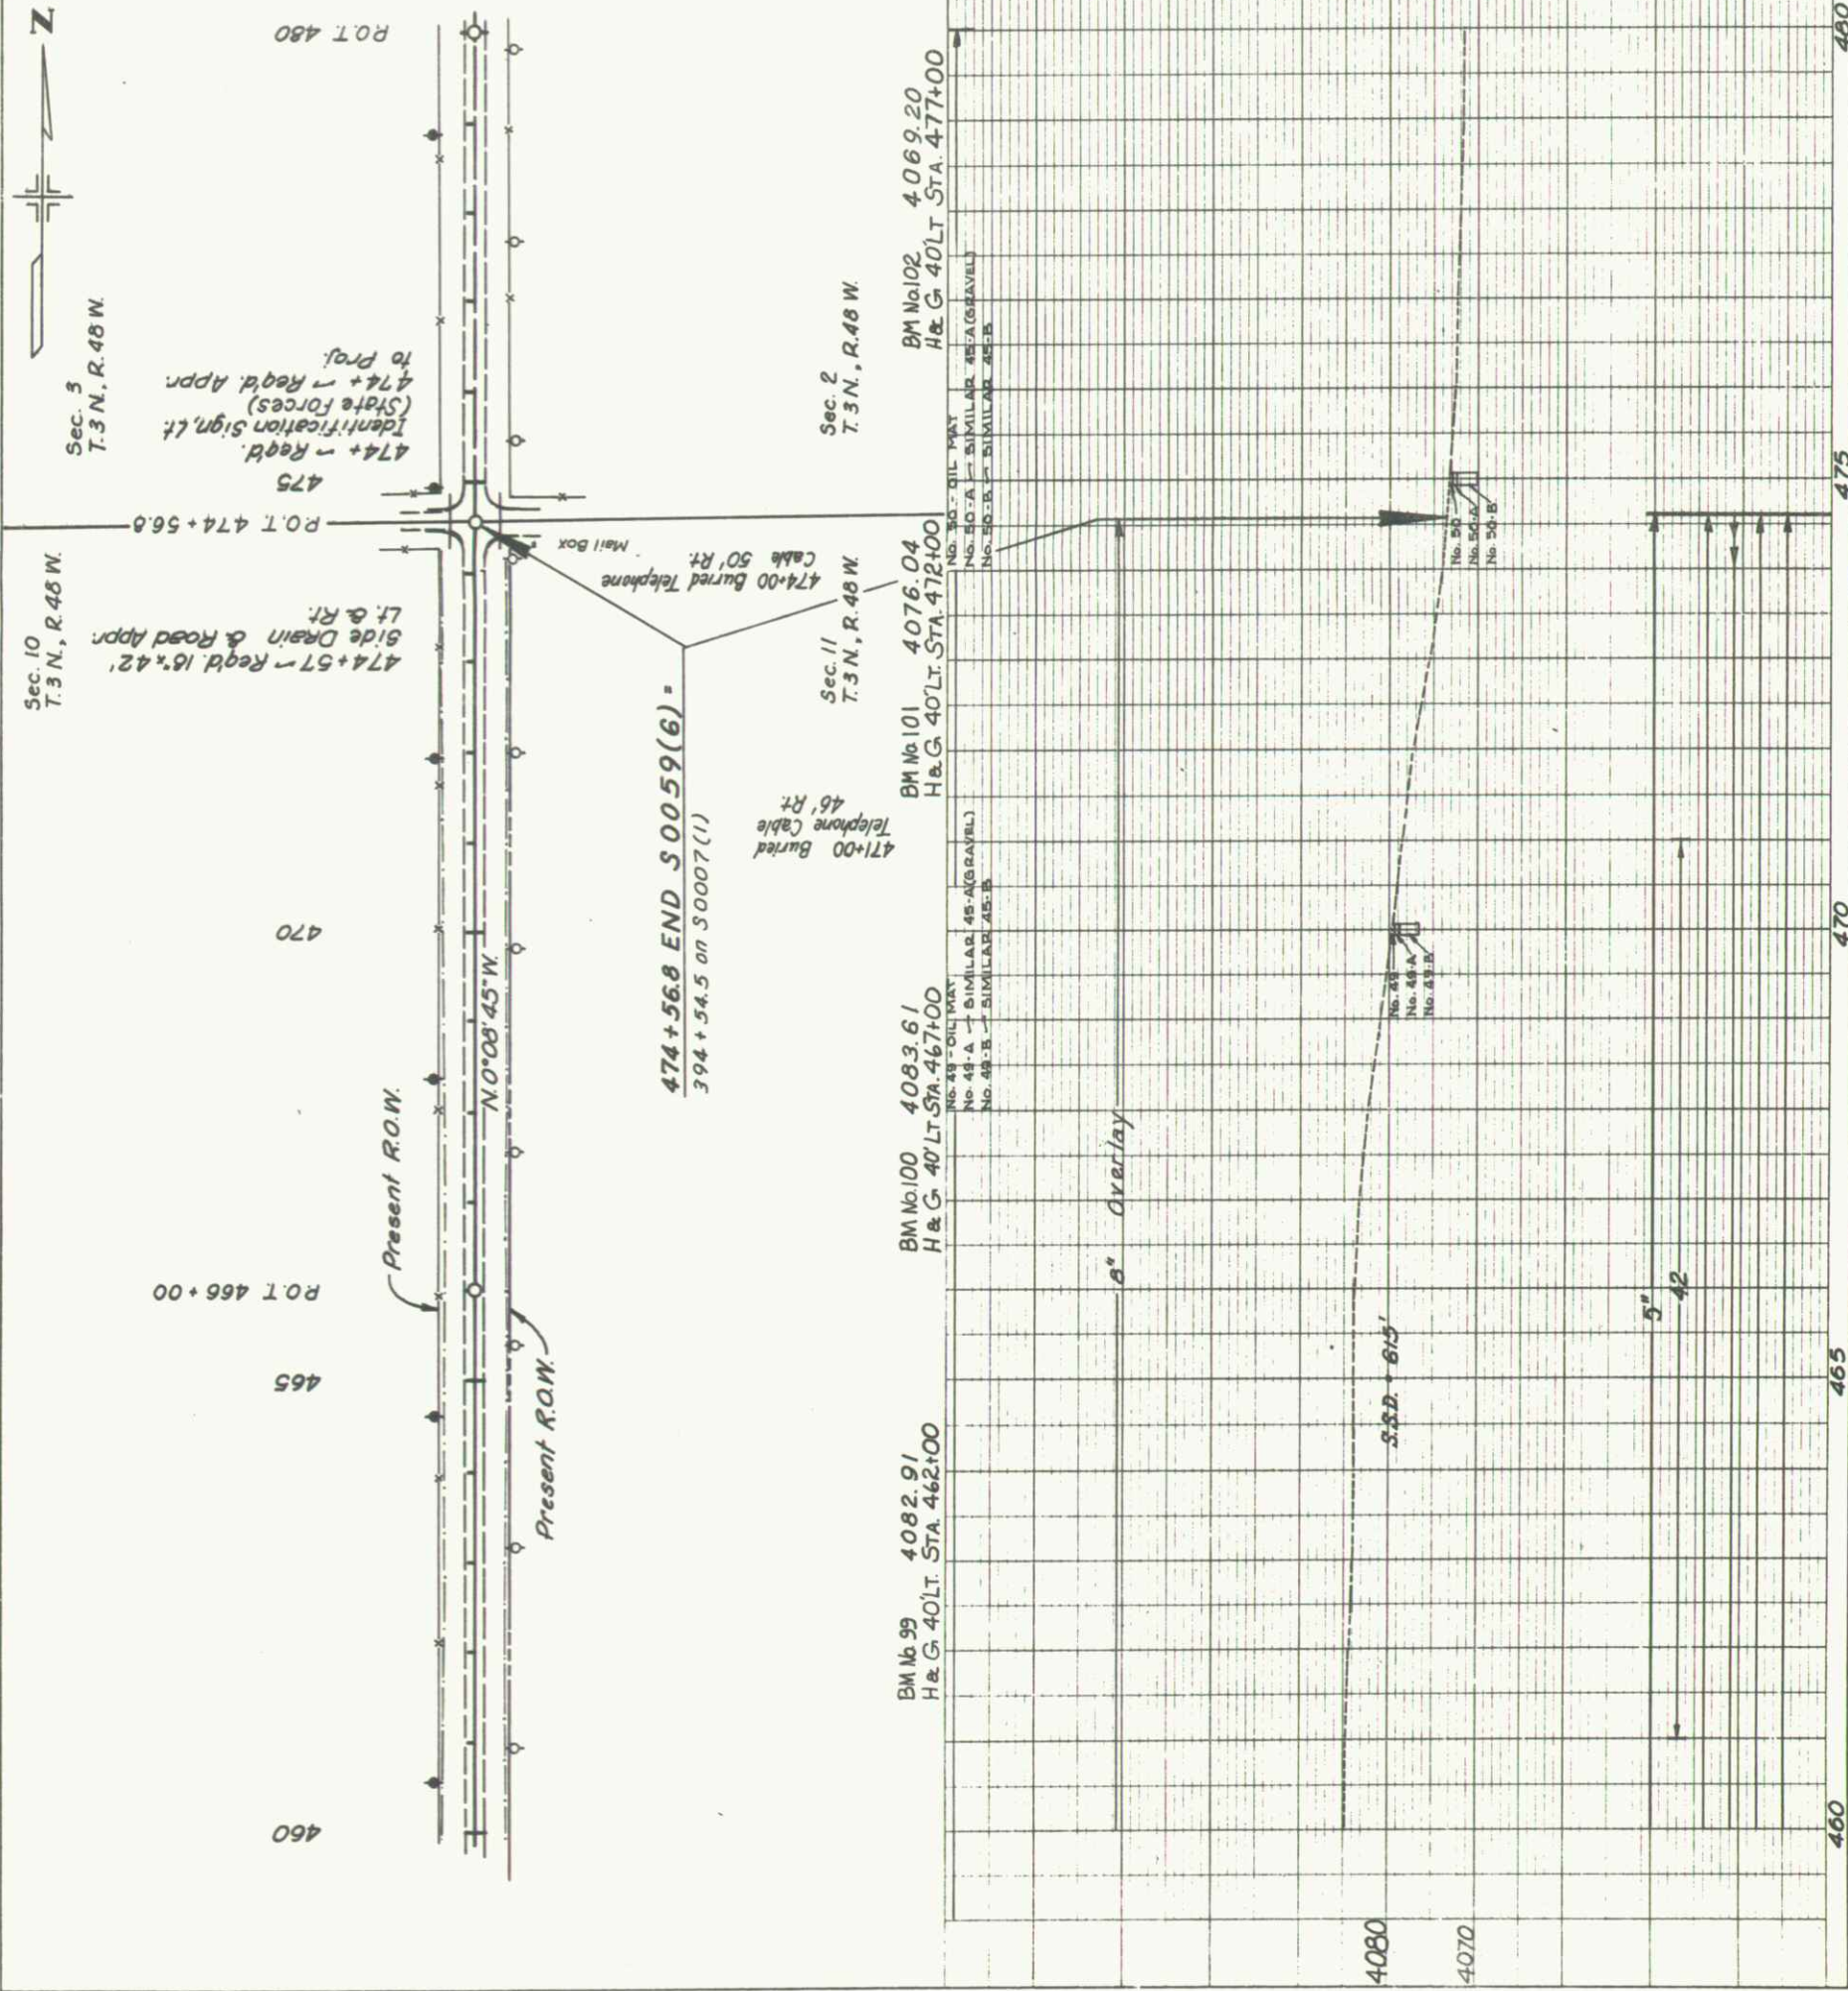

ABC Cl. 7 (50)
Excav
Emb x 1.35
Borrow
Borrow Source