


STATE DEPARTMENT OF HIGHWAYS DIVISION OF HIGHWAYS—STATE OF COLORADO

FEDERAL ROAD REGION NO.	DIVISION	PROJECT NO.	SHEET NO.
9	COLORADO	S 0089 (4)	1

(R-1) 4-20-71 D.H.H.

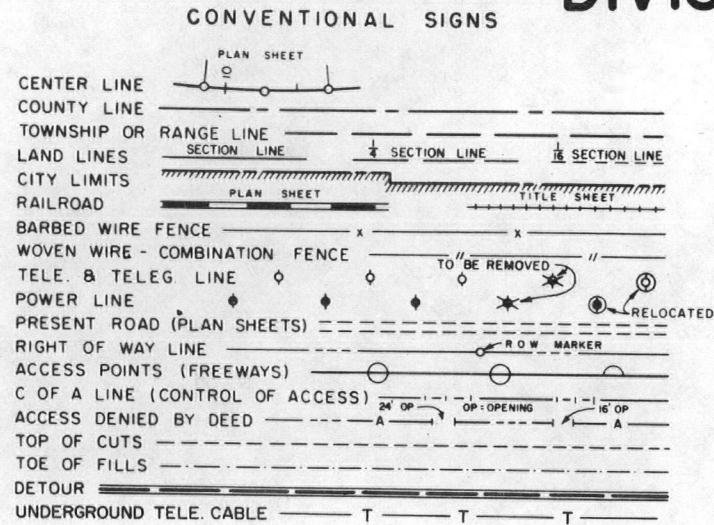

PLAN AND PROFILE OF PROPOSED COMPLETED FEDERAL AID PROJECT NO. S 0089 (4) STATE HIGHWAY NO. 89 PROWERS COUNTY

INDEX OF SHEETS


SHEET NO.	DESCRIPTION	DATE
1	TITLE PAGE, SKETCH MAP AND TABULATION OF LENGTH AND DESIGN DATA.	
2	TYPICAL SECTIONS AND GENERAL NOTES.	
3	SUMMARY OF APPROXIMATE QUANTITIES.	
4	STRUCTURE QUANTITIES.	
5	SURFACE COURSE PLAN, BASE COURSE PLAN, GUARD RAIL TABULATION AND SUMMARY OF EARTHWORK QUANTITIES.	
6	PIT SKETCHES.	
7	STANDARD M-601-A SINGLE AND DOUBLE CONCRETE BOX CULVERTS SPECIAL FOR THIS PROJECT.	
8-18	ALIGNMENT, PLAN AND PROFILE.	
19-21	STRUCTURE CROSS SECTIONS.	
19-20	BORROW PIT CROSS SECTIONS	
21-24	FINAL ROADBED CROSS SECTIONS - FILL AREAS	
M-203-B	APPROACH ROADS, FLARING, CUT SLOPE TREATMENT, BRIDGE AND CREST WIDENING.	4-27-70
M-203-C	DITCH TYPES.	7-23-68
M-206-AA	EXCAVATION AND BACKFILL FOR STRUCTURES (2 SHEETS).	3-1-71
M-500-A	LETTERS AND FIGURES FOR STRUCTURE NUMBERS.	7-1-65
M-601-C	WINGWALLS FOR CONCRETE BOX CULVERTS - 4:1 SIDE SLOPES (2 SHEETS).	10-25-68
M-603-M	METAL CULVERT PIPE - H-20 LOADING.	2-11-71
M-603-RC	REINFORCED CONCRETE PIPE.	3-1-71
M-606-AB	GUARD RAIL, TYPE 3. (3 SHEETS)	11-25-70
M-607-A	WIRE FENCES AND GATES. (2 SHEETS)	9-15-69
M-614-A	TIMBER BARRICADES.	4-23-69
M-614-IC	STANDARD CONSTRUCTION IDENTIFICATION SIGNS. (2 SHEETS)	9-25-70
M-614-TB	TRAFFIC SIGNING FOR HIGHWAY CONSTRUCTION. (3 SHEETS)	12-24-68
(R-1) S-614-29A	TYPICAL PAVEMENT MARKINGS	12-1-70

**AS CONSTRUCTED
REVISED DATE 9-16-71**

SCALES OF ORIGINAL DRAWINGS
ON PLAN, 1 IN. = 100 FT.
ON PROFILE { 1 IN. = 100 FT. HORIZONTAL
 1 IN. = 10 FT. VERTICAL
GRADE LINE ON PROFILE IS SHOWN AS GRADE OF FINISHED ROAD
GROSS LENGTH OF PROJECT } 31,022.1 FT. = 5.875 MI.
NET LENGTH OF PROJECT }

TABULATION OF LENGTH AND DESIGN DATA

STATION	ROADWAY	MAJOR STRUCTURE
	LIN. FT.	LIN. FT.
974+77.9 Begin S 0089(4) = 974+77.9 End S 0089(3)	10,099.0	
1075+76.9 Begin C.B.C. Str. No. M-28-D		26.2
1076+03.1 End C.B.C.	20,896.9	
1285+00 End S0089(4)		
TOTALS	30,995.9	26.2
<i>SUMMARY</i>	LIN. FT.	MILES
Roadway	30,995.9	5.870
Major Structure	26.2	0.005
TOTALS (NET AND GROSS LENGTH)	31,022.1	5.875
<i>DESIGN DATA</i>		
Maximum Degree of Curve	Tangent	
Maximum Grade	1.76 %	
Minimum S.S.D. - Horizontal	> 900'	
Minimum S.S.D. - Vertical	730'	
Maximum Design Speed	70 M.P.H.	
1991 Design Traffic Vol. { ADT 310 DHW 37		

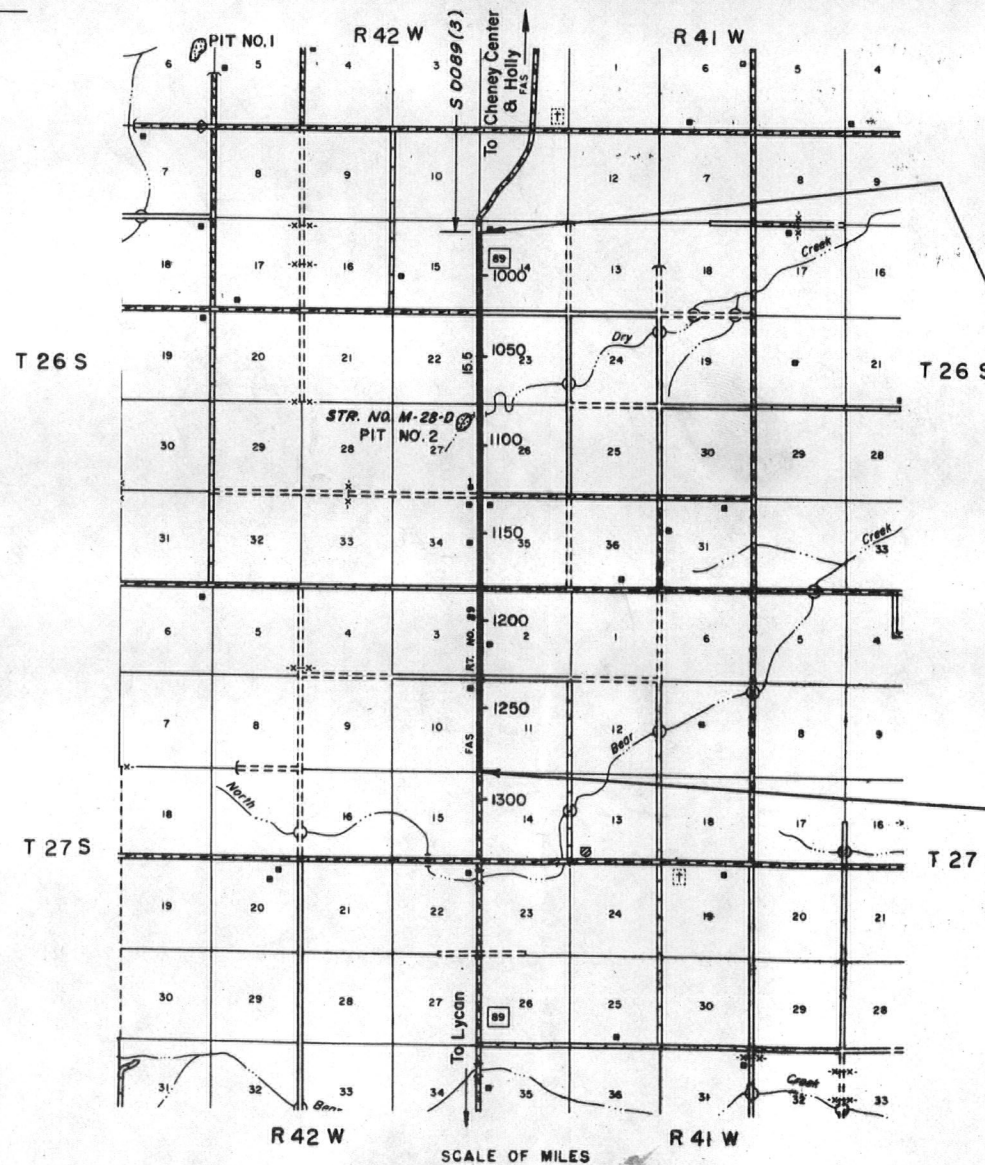

**STA. 974+77.9 BEGIN S 0089 (4) =
STA. 974+77.9 END S 0089 (3)**

STA. 1285+00 END S 0089 (4)

PROJECT STARTED - MAY 10, 1971
PROJECT COMPLETED - SEPTEMBER 16, 1971
CONTRACTOR - ROCKY MOUNTAIN OIL PAVING INC.
RESIDENT ENGINEER - L.D. MULLER

"As Constructed No Revisions"
Sheets 2, 7-9, 13-14 & 16-18

SEE SPECIAL PROVISIONS FOR
NOTICE TO BIDDERS

DIVISION OF HIGHWAYS

APPROVED: _____ DATE: 10-25-71
DIST. CONST. ENGR.

DIVISION OF HIGHWAYS

APPROVED: *John E. Shumaker* 4-27-71 DATE
CHIEF ENGINEER

By: *L. B. Brown* Dep. Ch. Engr.


DEPARTMENT OF TRANSPORTATION
FEDERAL HIGHWAY ADMINISTRATION

APPROVED: _____ DATE: _____
DIVISION ENGINEER

FEDERAL ROAD REGION NO.	DIVISION	PROJ. NO.	SHEET NO.	TOTAL SHEETS
9	COLORADO	S 0089 (4)	2	

TYPICAL SECTION

Note:
See standards for details of cut slope treatment, flaring and widening.

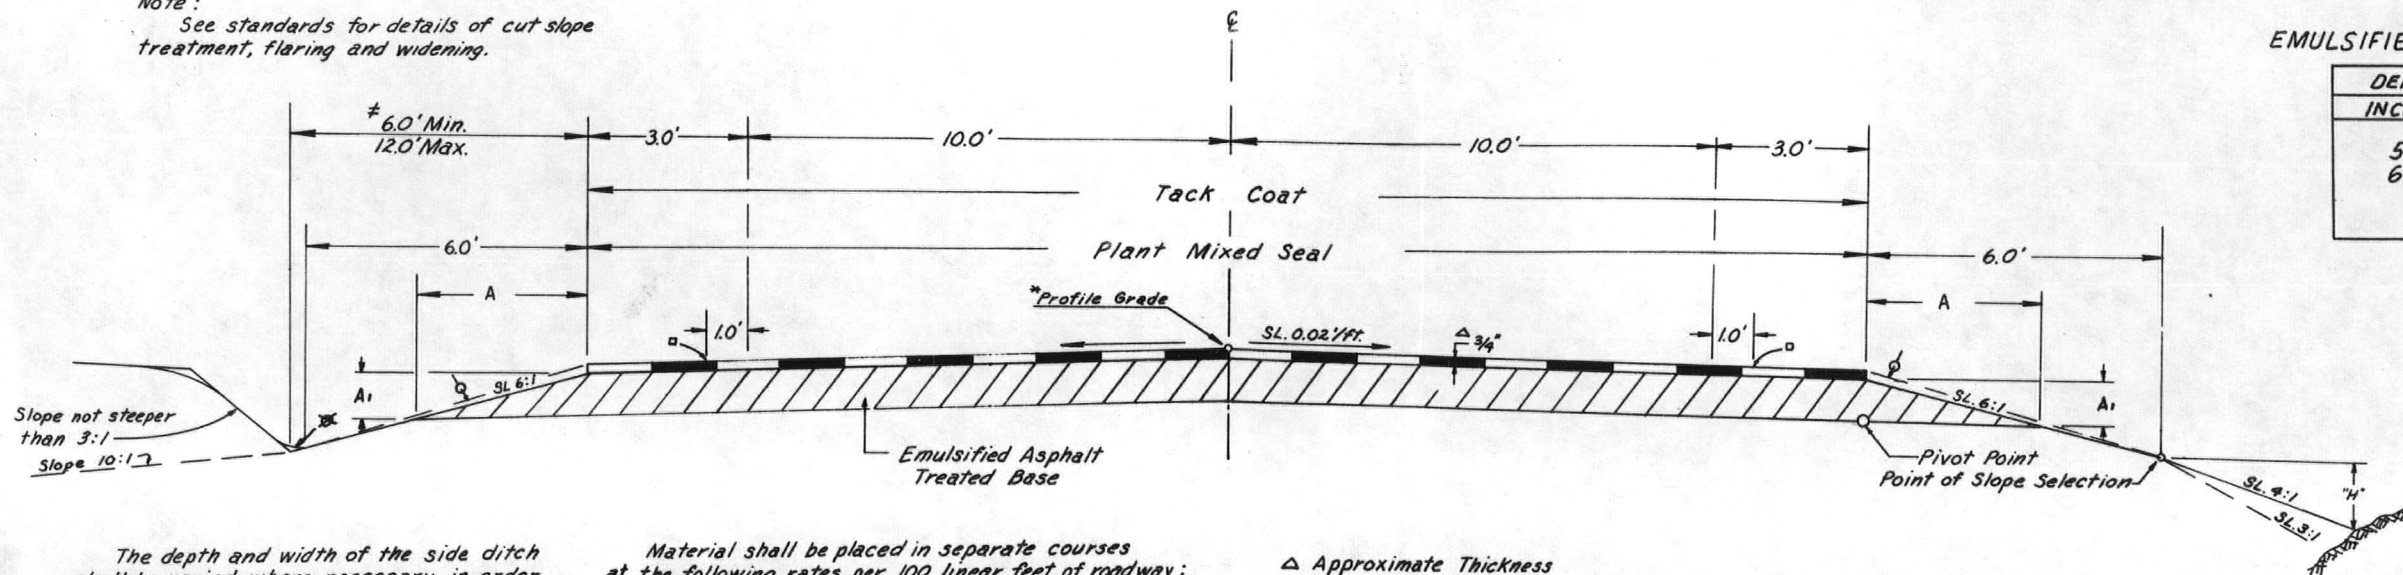

EMULSIFIED ASPHALT TREATED BASE

DEPTH INCHES	A FEET	A ₁ FEET
5	2.8	0.5
6	3.4	0.6

Fill Slopes

Slope 4:1 where 'H' is 3' or less.
Slope 3:1 where 'H' is over 3'.
In special cases, slope may be steepened.

The depth and width of the side ditch shall be varied where necessary in order to provide proper drainage.

Excavation below 6:1 slope and/or 10:1 slope will not be permitted.

Break points on slopes and in bottom of ditches shall be rounded on construction for a pleasing appearance.

Material shall be placed in separate courses at the following rates per 100 linear feet of roadway:

Plant Mixed Seal	12 Tons
5" Emul. Asph. Treat. Base	80 Tons
6" Emul. Asph. Treat. Base	98 Tons


△ Approximate Thickness

□ Location of 3" wide solid white painted stripe.

± 8.0' used for preliminary.

∅ The Contractor will be required to place suitable material to this line after completion of sealing operation.

Typical Section for Detour

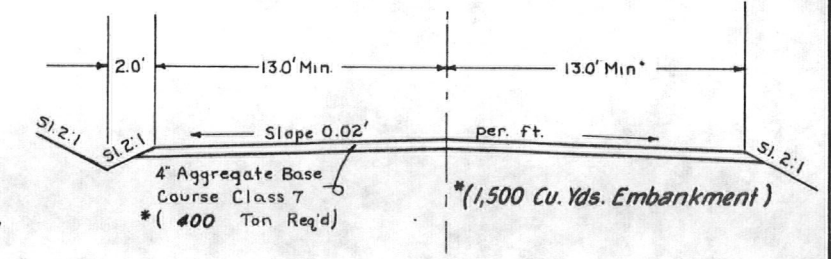

* Quantities for information only.

Note: Detour drainage structures to be furnished by State Forces.

GENERAL

NOTES

For preliminary plan quantities of Bituminous Materials the following rates of application were used:

Tack Coat, Emul. Asph. @ 0.10 Gals. per Sq. Yd. (Diluted)
Plant Mixed Seal @ 82.5 Lbs. per Sq. Yd. per 0.75 Inch Thickness

Rates of application shall be as determined by the Engineer at the time of application.

Flexible conduits on this project with helical corrugations, joined by dimpled connecting bands, shall use a sealing compound or gasket with the connecting band.

The Type of Compaction for reconditioning shall be AASHTO T-99.

Depth of Moisture-Density control for Grading Sections shall be as follows:

Full depth of all embankments.

The Contractor shall conduct his operations so that a minimum of existing vegetation, adjacent to the roadway, is destroyed.

Plain water shall be used as a dust palliative where required. Locations shall be as ordered.

Road approaches which require Plant Mixed Seal shall be tacked and a 3/4" thickness of P.M. Seal placed as follows:

Public approaches and entrances to buildings or residences shall be sealed 50 ft. out from edge of shoulder or to the Right of Way line, whichever is less. Field entrances shall be sealed 4 ft. out from edge of shoulder.

Approaches shall have Emulsified Asphalt Treated Base.

Guard posts, signs and delineators will be removed by State Forces.

It is estimated that 500 Hours of Flagging for controlling traffic will be required for this project.

Ski-type device 30 feet in length or short shoe shall be furnished with the automatic control system of each bituminous paver.

It is estimated that 264 gal. of Pavement Marking Paint will be required for this project. This quantity includes the following:

White Paint 259 gal.
Yellow Paint 5 gal.

The Engineer will establish all terminal points for no-passing zones on the project.

FINAL
SUMMARY OF APPROXIMATE QUANTITIES

AS CONSTRUCTED
REVISED DATE 9-16-71

FEDERAL ROAD DISTRICT NO.	DIVISION	PROJ. NO.	SHEET NO.	TOTAL SHEETS
	COLORADO	S 0089(4)	3	

INDEX			CONTRACT	CONTRACT ITEM	UNIT	ROADWAY	FINAL	MAJOR STRUCTURE M-28-D	FINAL	PROJECT TOTALS	FINAL PROJECT TOTALS	DIFF.
BOOK	PAGE	SHEET										
2	31,35		202	Removal of Structure	Each	1	2			1	2	+1
2	18		202	Removal of Bridge	Each			1	1	1	1	0
2	17		202	Removal of Fence	Lin. Ft.	400	400			400	400	0
2	53		203	Unclassified Excavation	Cu. Yd.	1,000	1,128			1,000	1,128	+128
	5		203	Borrow	Cu. Yd.	15,000	12,959			15,000	12,959	-2,041
	5		203	Compaction (AASHTO T99)	Cu. Yd.	12,000	12,114			12,000	12,114	+114
	5		204	Haul	Yd. Mi.	3,700	4,284			3,700	4,284	+584
	5		204	Haul	Ton Mi.	276,000	265,930			276,000	265,930	-10,070
	4		206	Structure Excavation	Cu. Yd.	230	229	60	153	290	382	+92
	4		206	Structure Backfill (Class 2)	Cu. Yd.	145	140	185	276	330	416	+86
FORM	7 1/2		209	Wetting	M Gal.	1,330	1,632			1,330	1,632	+302
2	40		210	Reset Mailbox Structure	Each	2	2			2	2	0
	5		303	Emulsified Asphalt Treated Base (Class 7)	Ton	34,200	32,983.25			34,200	32,983.25	-1,216.75
FORM	305		306	Reconditioning	Mile	5.5	5.50			5.5	5.50	0
	5		410	Plant Mixed Seal Coat (Type B)(Haul and Asphalt)	Ton	4,000	4,049.00			4,000	4,049.00	+49.00
FORM	49		411	Emulsified Asphalt (CSS-1)	Gal.	406,000	359,292			406,000	359,292	-46,708
	4		601	Concrete Class A	Cu. Yd.			152	151.05	152	151.05	-0.95
	4		602	Reinforcing Steel	Lb.			14,300	14,248	14,300	14,248	-52
	4		603	43 x 27 Inch Corrugated Steel Pipe Arch	Lin. Ft.	8	8			8	8	0
	5		606	End Anchorage Type 1	Each	4	4			4	4	0
	5		606	Guard Rail Type 3	Lin. Ft.	500	500			500	500	0
	4		607	End Post	Each	3	2			3	2	-1
	4		607	Corner and Line Brace Post	Each	4	3			4	3	-1
	4		607	Fence Barbed Wire with Metal Posts	Lin. Ft.	400	434			400	434	+34
FORM	7 1/2		614	Flagging	Hour	500	952			500	952	+452
2	44		614	Pavement Marking Paint	Gal.	264	230			264	230	-34
	4		617	18 Inch Culvert Pipe	Lin. Ft.	410	410			410	410	0
	4		617	24 Inch Culvert Pipe	Lin. Ft.	298	298			298	298	0
2	41		620	Field Office, Deleted By C.O. 15609	Each	1	0			1	0	-1
2	42		620	Field Laboratory	Each	1	1			1	1	0
2	43		620	Sanitary Facility	Each	1	1			1	1	0
FORM	305		621	Maintenance of Detours	L.S.	0	0			0	0	0
FORM	305		626	Mobilization	L.S.	0	0			0	0	0
2	7,39			STATE FORCES Furnishing and Installing Identification Sign Signaling (Non Federal Aid) RIGHT OF WAY Easements	Each L.S. L.S.	2 0 0	2			2 0 0	2	0
				SALVAGE MATERIAL Salvage Bridge Timber Sta. 1075+90	L.S.	0	0			0	0	0

STRUCTURE QUANTITIES

AS CONSTRUCTED
REVISED DATE 9-16-71

FEDERAL ROAD REGION NO.	DIVISION	PROJECT NO.	SHEET NO.
9	COLORADO	S 0089 (4)	4

INDEX	LOCATION	UNCLASSIFIED EXCAVATION CUBIC YARD			STRUCTURE EXCAVATION	STRUCTURE BACKFILL	REMOVAL OF STRUCTURE	E.A.T.B. (CLASS 7)	P.M. SEAL (TYPE 2)	CONCRETE CUBIC YARD	REINFORCING STEEL LB.	HAUL YARD MILE	CULVERT PIPE LINEAR FEET				"H" OVER GULV. FT.	SLOPE AND DITCH PAVING CUBIC YARD	END SECTION EACH	MISCELLANEOUS
		EXCAV.	EMB.	DITCH	CUBIC YARD	CUBIC YARD	EACH	TON	TON	CL. A	LB.	YARD MILE	18"	24"						
2 7	974+77.9 974+77.9						*	*											1 - Identification Sign (State Forces)	
2 8	987+15				8	5														
2 9	995+35				6	5														
2 10	1007+70				9	5														
2 11	1022+17.6		30									36								
2 12	1023+00		12		30	15						15		62						
2 13	1046+00		12		38	15						9		64						
2 14	1048+70		30									20								
2 14	1048+75		30		6	5						20		30						
2 15	1071+60				11	5														
2 17	1072+ to 1075+				153	276				151.1	14,292									
2 18	1075+90				60	763				151.05	14,248									
2 16	1072+60 to 1078+60																			
2 20	1101+57		30									10								
2 21	1102+55		30		6	5						11		30						
2 22	1125+00		12		34	15						11		62						
2 23	1125+90				7	5								30						
2 24	1128+12				6	7								50						
2 25	1129+80		30									26								
2 26	1154+ to 1156+		50									68								
2 27	1154+40 1157+00 1157+80 1158+50 1181+21 1181+30 1181+55 1181+75																			
2 28	1207+60		12		12	13						25		54						
2 29	1207+90		30		10	5						70		30						
2 30	1207+90				2	5								30						
2 31	1216+35		30		8	5						75		30						
2 32	1234+00																			
2 33	1234+14																			
2 34	1234+50		12		23	13						38		30	56					
2 35	1236+95				7	5														
2 36	1247+60																			
2 37	1256+65				1	2						108		30						
2 38	1273+95		30		5	5														
2 39	1285+00																			
2 40	ENTIRE PROJECT		380									542								
TOTALS			320		229	140						410	298							8 Lin. Ft. 43"x27" C.S.P.A. 1 - Identification Sign (State Forces) 2 - Reset Mailbox Structure

⊛ Not included in Roadway Quantities * Included in Roadway Quantities

AS CONSTRUCTED
REVISED DATE 9-16-71

FEDERAL ROAD REGION NO.	DIVISION	PROJ. NO.	SHEET NO.	TOTAL SHEETS
9	COLORADO	S0089 (4)	5	

SURFACE COURSE PLAN

STATION To STATION	SOURCE	TONS USED	
		PLANT MIX SEAL (TYPE B)	FINAL
		TOP LAYER	FINAL
974 + 00 ~ 1015 + 00	UNDESIGNATED	492	521.50
1015 + 00 ~ 1022 + 17		86	91.25
1022 + 17 ~ 1025 + 00		34	35.95
1025 + 00 ~ 1285 + 00		3,120	3,400.30
FROM STRUCTURE QUANTITIES		186	*
TOTALS:			3,918

GUARD RAIL

STA. To STA.	SIDE	GUARD RAIL	
		TYPE 3 LIN. FT.	FINAL
1074 + 42 To 1076 + 93	Rt	250	250
1074 + 87 To 1077 + 38	Lt	250	250
TOTAL:		500	500

NOTE: TYPE I END ANCHORAGE ON EACH END, TOTAL 4 REQUIRED.
W = 4' Bk#2, Page 19 Total 4 Placed

BASE COURSE PLAN

STATION To STATION	SOURCE	THICK	TONS USED		HAUL - TON MILE	
			EMULSIFIED TREATED BASE (CLASS 7)	ASPHALT BASE FINAL	EMULSIFIED TREATED BASE (CLASS 7)	ASPHALT BASE FINAL
974 + 00 ~ 1015 + 00	Pit No.1	6"	4,018	4,399.25	25,736	28,261
1015 + 00 ~ 1022 + 17		5"	574	700.60	3,426	4,181
1022 + 17 ~ 1025 + 00		5"	226	470.15	1,339	2,786
1025 + 00 ~ 1285 + 00		6"	25,480	27,413.25	214,433	230,702
ESTIMATED FOR CORRECTION:						
IRREGULARITIES IN SUBGRADE			3,030	*	24,493	*
FROM STRUCTURE QUANTITIES			820	*	6,492	*
TOTALS:			34,148	32,983.25	275,919	265,930

NOTE - STABILIZATION BASED ON:

- EDLA 18K 6.0
- REGIONAL FACTOR 1.25
- SERVICEABILITY INDEX 2.00
- PLANT MIXED SEAL (TYPE B) 0.25
- EMULSIFIED ASPHALT TREATED BASE (CL. 7) 0.23 (R₀ = 96)

* INCLUDED IN ROADWAY QUANTITIES

* FROM TON-MILE HAUL WORK SHEETS

SUMMARY OF EARTH WORK QUANTITIES


INDEX	Book	Page	Sheet	CU. YD.	FINAL CU. YD.
UNCLASSIFIED EXCAVATION:					
	2	53		400	564
	2	53		400	564
				TOTAL:	1,128
BORROW:					
				12,943	12,553
	19,20			1,294	
				376	406
				TOTAL:	14,613
COMPACTION:					
	21-24			11,002	11,734
	4			320	380
				TOTAL:	11,322
HAUL:					
					Yd. Mi.
	Mass			2,908	3,742
	Diag.			444	542
				TOTAL:	3,643
ROADWAY QUANTITIES BALANCE:					
				12,943	
				11,002	
				11,002	

FEDERAL ROAD REGION NO.	DIVISION	PROJ. NO.	SHEET NO.	TOTAL SHEETS
9	COLORADO	50089(4)	6	

AS CONSTRUCTED
REVISED DATE 9-16-71

PIT NO. 2

Owner: Melvin Rushton, Holly, Colorado 81047
Location: Northeast 1/4 Northeast 1/4 Sec. 27, T. 26-S, R. 42 W.
Use: Borrow
Quantity Available: 30,000 Cu. Yds.
Stripping: ~~800~~ ^{1,128} Cu. Yds.
Haul Distance: 260 Feet to Sta. 1081+00
Includes Remove and Replace Overburden.

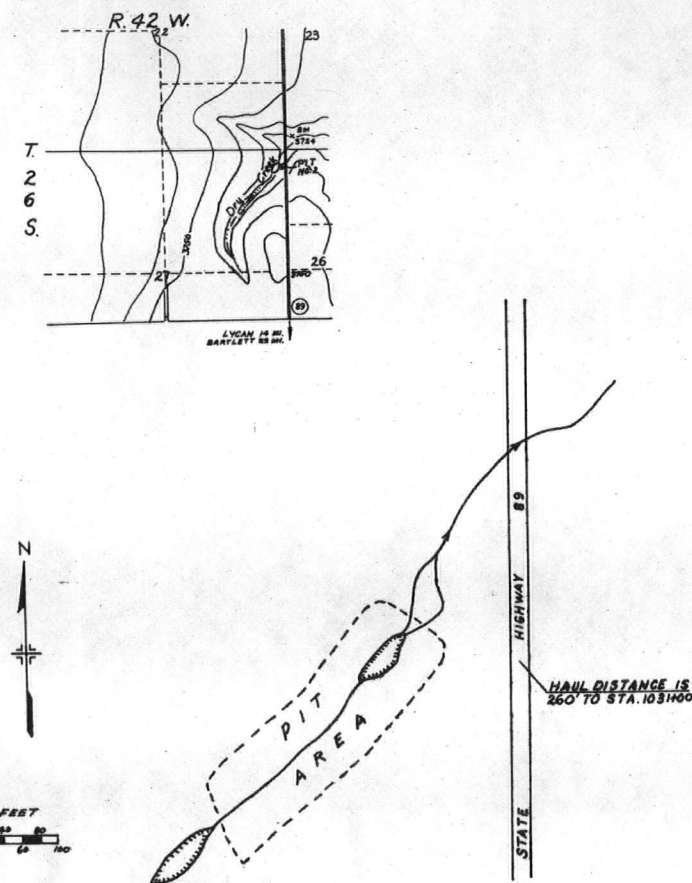


LOG OF PIT Sample No. 1412
March 19, 1971

Test No.	Depth in Feet	Description of Test Hole Material
1	00-100+	Sandy Clay

PIT NO. 1

Owner: Mr. Howard C. Plunkett, Coolidge, Kansas 67836
Location: Part of the East 1/2 of the N.E. 1/4 Sec. 6, T. 26 S, R. 42 W.
Use: Emulsified Asphalt Treated Base.
Quantity Available: 46,000 Cu. Yds.
Stripping: None
Haul Distance: 5.90 Miles to Sta. 1022+17

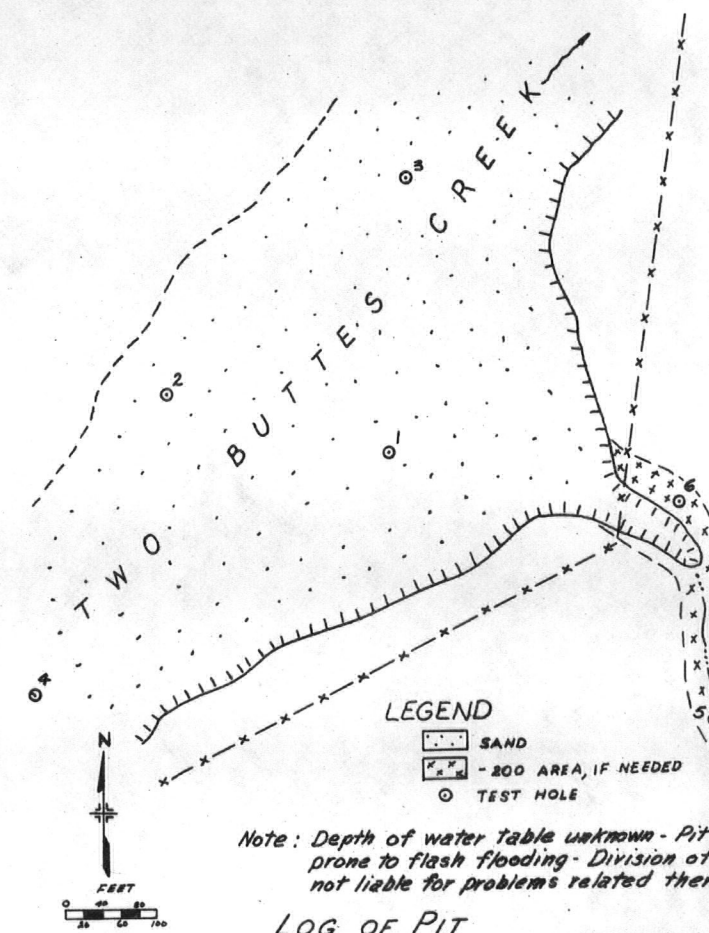

LOG OF PIT Sample No. 1426
March 9, 1971

Test No.	Depth in Feet	Description of Test Hole Material
1	00-6.1	Sand: well-graded, some fine gravel, some silt & clay
1A	6.1-9.0	Sand: medium to coarse-grained, gravelly, clay balls up to about 2" in diameter
1B	9.0+	Sand: fine, very silty & clayey
2	00-5.7	Sand: fine to medium-grained, trace of fine gravel
2A	5.7-6.7+	Sand: fine to medium-grained, silty, clayey
3	00-50+	Sand: fine to medium-grained, trace of pebbles, some silt
4	00-6.3+	Sand: fine to medium-grained, some silt
5	00-2.8	Sand: fine, silty, clayey
5A	2.8+	Sand: fine, silty, clean
6	00-3.4+	Silt & Fine Sand: Clayey

SINGLE CONCRETE BOX CULVERT


STANDARD M-60I-A

SPECIAL FOR THIS PROJECT

FED. ROAD REG. NO.	DIVISION	PROJECT NO.	SHEET NO.
9	COLORADO	S 0089(4)	7


Dimensions & Quantities (see Wingwall Standard for Wings)

Height of Fill Allowed	Type	Span S	Height H	Slab T	Wall W	Bar Size & Spacing		No. Bars Required	Quantities for One Lin. Ft. of Box		Quantities for Two Headwalls	
						V ₁	W ₁		Concrete Cu Yds	Steel Lbs	Concrete Cu Yds	Steel Lbs
35'-0"	2A	2'-0"	2'-0"	6"	8"	3/4"	12"	12	0.332	17.3	1.30	41
30'-0"	3A	3'-0"	3'-0"	7"	8"	3/4"	12"	12	0.349	22.0	1.65	123
25'-0"	4A	4'-0"	4'-0"	7 1/2"	8"	3/4"	12"	12	0.362	31.8	1.75	150
20'-0"	5A	5'-0"	5'-0"	8"	8"	3/4"	12"	12	0.377	42.3	2.10	183
16'-0"	6A	6'-0"	6'-0"	8 1/2"	8"	3/4"	12"	12	0.390	54.7	2.40	187
12'-0"	7A	7'-0"	7'-0"	9"	9"	3/4"	12"	12	0.403	68.9	2.80	227
8'-0"	8A	8'-0"	8'-0"	9 1/2"	10"	3/4"	12"	12	0.416	84.9	3.20	289
4'-0"	9A	9'-0"	9'-0"	10"	11"	3/4"	12"	12	0.429	102.7	3.70	337
35'-0"	2B	2'-0"	2'-0"	6"	8"	3/4"	12"	12	0.332	17.3	1.30	41
30'-0"	3B	3'-0"	3'-0"	7"	8"	3/4"	12"	12	0.349	22.0	1.65	123
25'-0"	4B	4'-0"	4'-0"	7 1/2"	8"	3/4"	12"	12	0.362	31.8	1.75	150
20'-0"	5B	5'-0"	5'-0"	8"	8"	3/4"	12"	12	0.377	42.3	2.10	183
16'-0"	6B	6'-0"	6'-0"	8 1/2"	8"	3/4"	12"	12	0.390	54.7	2.40	187
12'-0"	7B	7'-0"	7'-0"	9"	9"	3/4"	12"	12	0.403	68.9	2.80	227
8'-0"	8B	8'-0"	8'-0"	9 1/2"	10"	3/4"	12"	12	0.416	84.9	3.20	289
4'-0"	9B	9'-0"	9'-0"	10"	11"	3/4"	12"	12	0.429	102.7	3.70	337

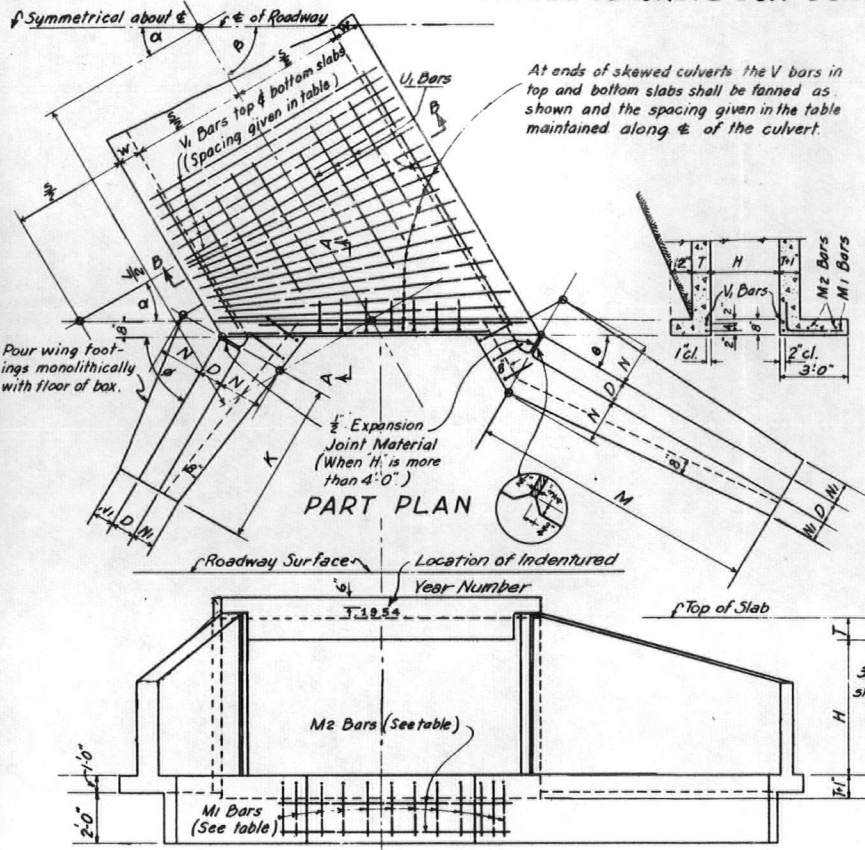


Bar List for Culvert & Headwalls (See Wingwall Standard for Wings)

Mark	Size	No. Req'd	Type	Length
V ₁	See table	10'	24L Spa.	I 5+2w-6'
W ₁	See table	6+	24L Spa.	I H+2T-5'
U ₁	1/2"	See table	I	L+1'-0"
M ₁	1/2"	See table	II	3'-6"
M ₂	1/2"	4	I	5+2w-6' Cos α

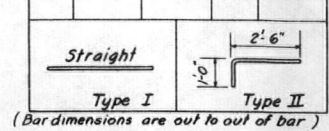

Possible Combinations (Span & Height)

2' x 2'	5' x 5'	9' x 5'	10' x 7'	11' x 8'	11' x 10'
3' x 2'	7' x 4'	8' x 6'	9' x 8'	10' x 9'	14' x 8'
4' x 2'	6' x 5'	7' x 7'	12' x 6'	13' x 7'	13' x 9'
3' x 3'	8' x 4'	9' x 6'	11' x 7'	12' x 8'	12' x 10'
4' x 3'	7' x 5'	8' x 7'	13' x 6'	14' x 7'	14' x 9'
5' x 3'	6' x 6'	10' x 6'	10' x 8'	11' x 9'	13' x 10'
4' x 4'	8' x 5'	9' x 7'	9' x 9'	10' x 10'	14' x 10'
5' x 4'	6' x 7'	8' x 8'	12' x 7'	13' x 8'	
6' x 4'	7' x 6'	11' x 6'	14' x 6'	12' x 9'	

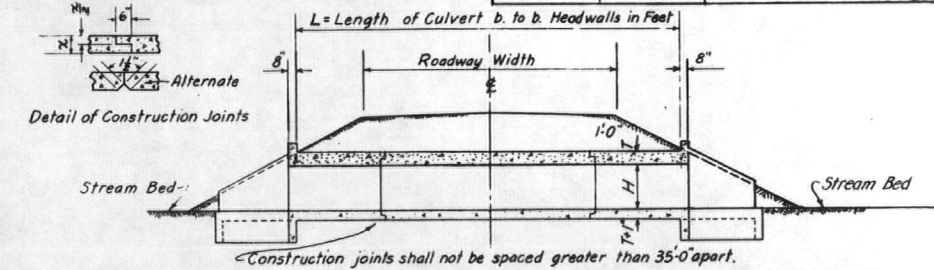

REVISIONS	

Initial Date
WWD 5-1-54

WWD 5-1-54
TJM 5-4-54
TJM 5-8-54
HSD 8-6-54


END ELEVATION

SECTION B-B

Note: K, M, N, Ni and D are dimensioned on Wingwall Standard for the various heights of culverts.


Dimensions & Quantities (see Wingwall Standard for Wings)

Height of Fill Allowed	Type	Span S	Height H	Slab T	Wall W	Bar Size & Spacing		No. Bars Required	Quantities for One Lin. Ft. of Box		Quantities for Two Headwalls	
						V ₁	W ₁		Concrete Cu Yds	Steel Lbs	Concrete Cu Yds	Steel Lbs
10'-0"	6-6-A	6'-0"	6'-0"	3'-0"	8"	5/8"	12"	12	1.28	48	32	120
15'-0"	6-6-B	6'-0"	6'-0"	3'-0"	9 1/2"	5/8"	12"	12	1.35	52	32	120
20'-0"	6-6-C	6'-0"	6'-0"	3'-0"	10 1/2"	5/8"	12"	12	1.42	56	32	120
10'-0"	8-8-A	8'-0"	8'-0"	3'-0"	10"	5/8"	12"	12	1.50	60	40	120
15'-0"	8-8-B	8'-0"	8'-0"	3'-0"	11"	5/8"	12"	12	1.58	64	40	120
20'-0"	8-8-C	8'-0"	8'-0"	3'-0"	12"	5/8"	12"	12	1.66	68	40	120
5'-0"	10-10-A	10'-0"	10'-0"	3'-0"	12"	5/8"	12"	12	1.74	72	40	120
10'-0"	10-10-B	10'-0"	10'-0"	3'-0"	12"	5/8"	12"	12	1.82	76	40	120
15'-0"	10-10-C	10'-0"	10'-0"	3'-0"	14"	5/8"	12"	12	1.90	80	40	120
5'-0"	12-12-A	12'-0"	12'-0"	3'-0"	12"	5/8"	12"	12	1.98	84	40	120
10'-0"	12-12-B	12'-0"	12'-0"	3'-0"	14"	5/8"	12"	12	2.06	88	40	120
15'-0"	12-12-C	12'-0"	12'-0"	3'-0"	16"	5/8"	12"	12	2.14	92	40	120
5'-0"	14-14-A	14'-0"	14'-0"	3'-0"	12"	5/8"	12"	12	2.22	96	40	120
10'-0"	14-14-B	14'-0"	14'-0"	3'-0"	16"	5/8"	12"	12	2.30	100	40	120

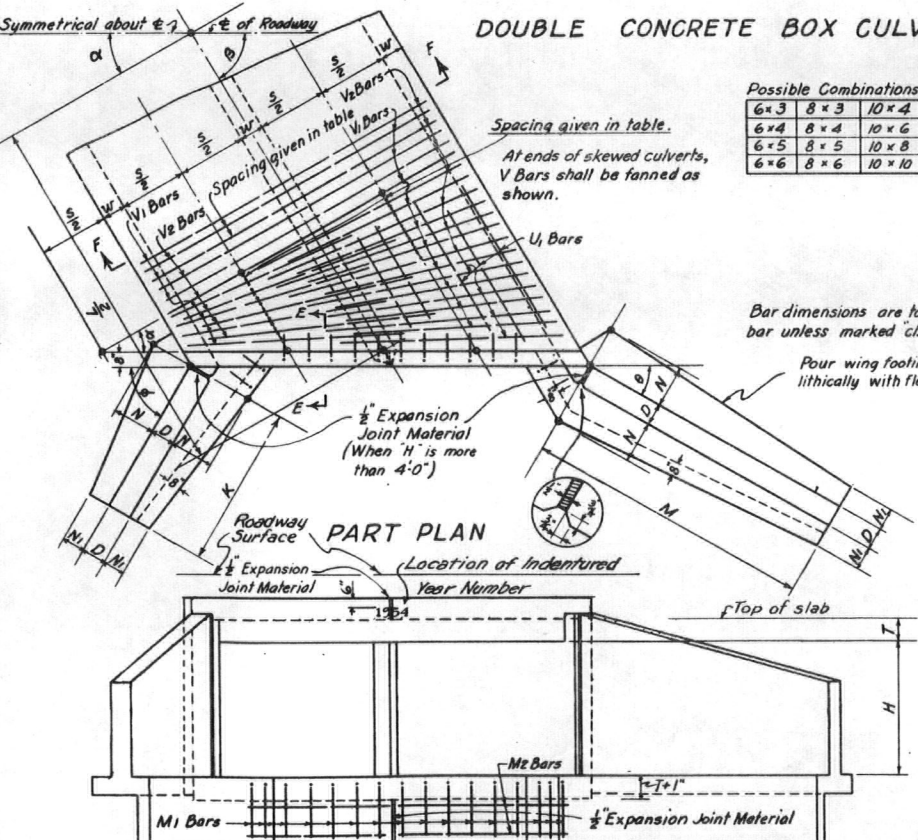

Possible Combinations (Span & Height)

6' x 3'	8' x 3'	10' x 4'	12' x 6'	14' x 6'
6' x 4'	8' x 4'	10' x 6'	12' x 8'	14' x 8'
6' x 5'	8' x 5'	10' x 8'	12' x 10'	14' x 10'
6' x 6'	8' x 6'	10' x 10'		

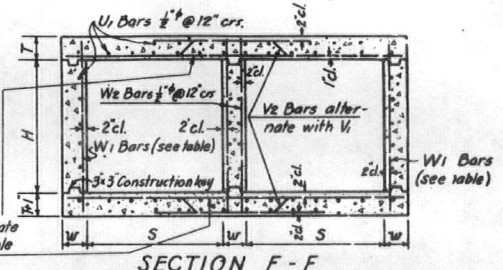

Bar List for Culvert and Two Headwalls (See Wingwall Std. for Wings)

Mark	Size	Number Required	Type	Total Length
V ₁	See Table	24(L+2)	I	S+15w+4'
V ₂	See Table	Spacing	II	0.75S+4' 2Z+M
W ₁	1/2"	See Table	I	H+2T-4'
U ₁	1/2"	See Table	I	L+12'
M ₁	1/2"	See Table	III	3'-6"
M ₂	1/2"	8	I	5+15w-6' Cos α

(Bar dimensions are out to out of bar.)
For General Notes, Loading and Design Data, see Wingwall Std.

DEPARTMENT OF HIGHWAYS
STATE OF COLORADO
DIVISION OF HIGHWAYS

SINGLE AND DOUBLE
CONCRETE BOX CULVERTS

(FOR SIZES SEE TABLE OF
POSSIBLE COMBINATIONS)

Designed by: WWD Approved by: J.D. Kamm
Made by: WWD Bridge Engineer
Checked by: T.J.M. Date: July 1, 1955

Quantities for one culvert shall be (quantity for one lin. ft. of box times L) plus quantity for two Head Walls plus (quantities for four wings).



Quantities for one culvert shall be (quantity for one lin. ft. of box times L) plus (quantity for two head walls) plus (quantities for four wings).

Note: This design not to be used when height of fill exceeds the allowed amount tabulated.

FEDERAL ROAD REGION NO.	DIVISION COLORADO	PROJ. NO. 50089 (4)	SHEET NO. 9	TOTAL SHEETS
-------------------------	-------------------	---------------------	-------------	--------------

PLAN
 NAVYED.
 ROUTE.
 NOTE BOOK NO. 118
 BY DATE

PROFILE
 NAVYED.
 ROUTE.
 NOTE BOOK NO. 118
 BY DATE

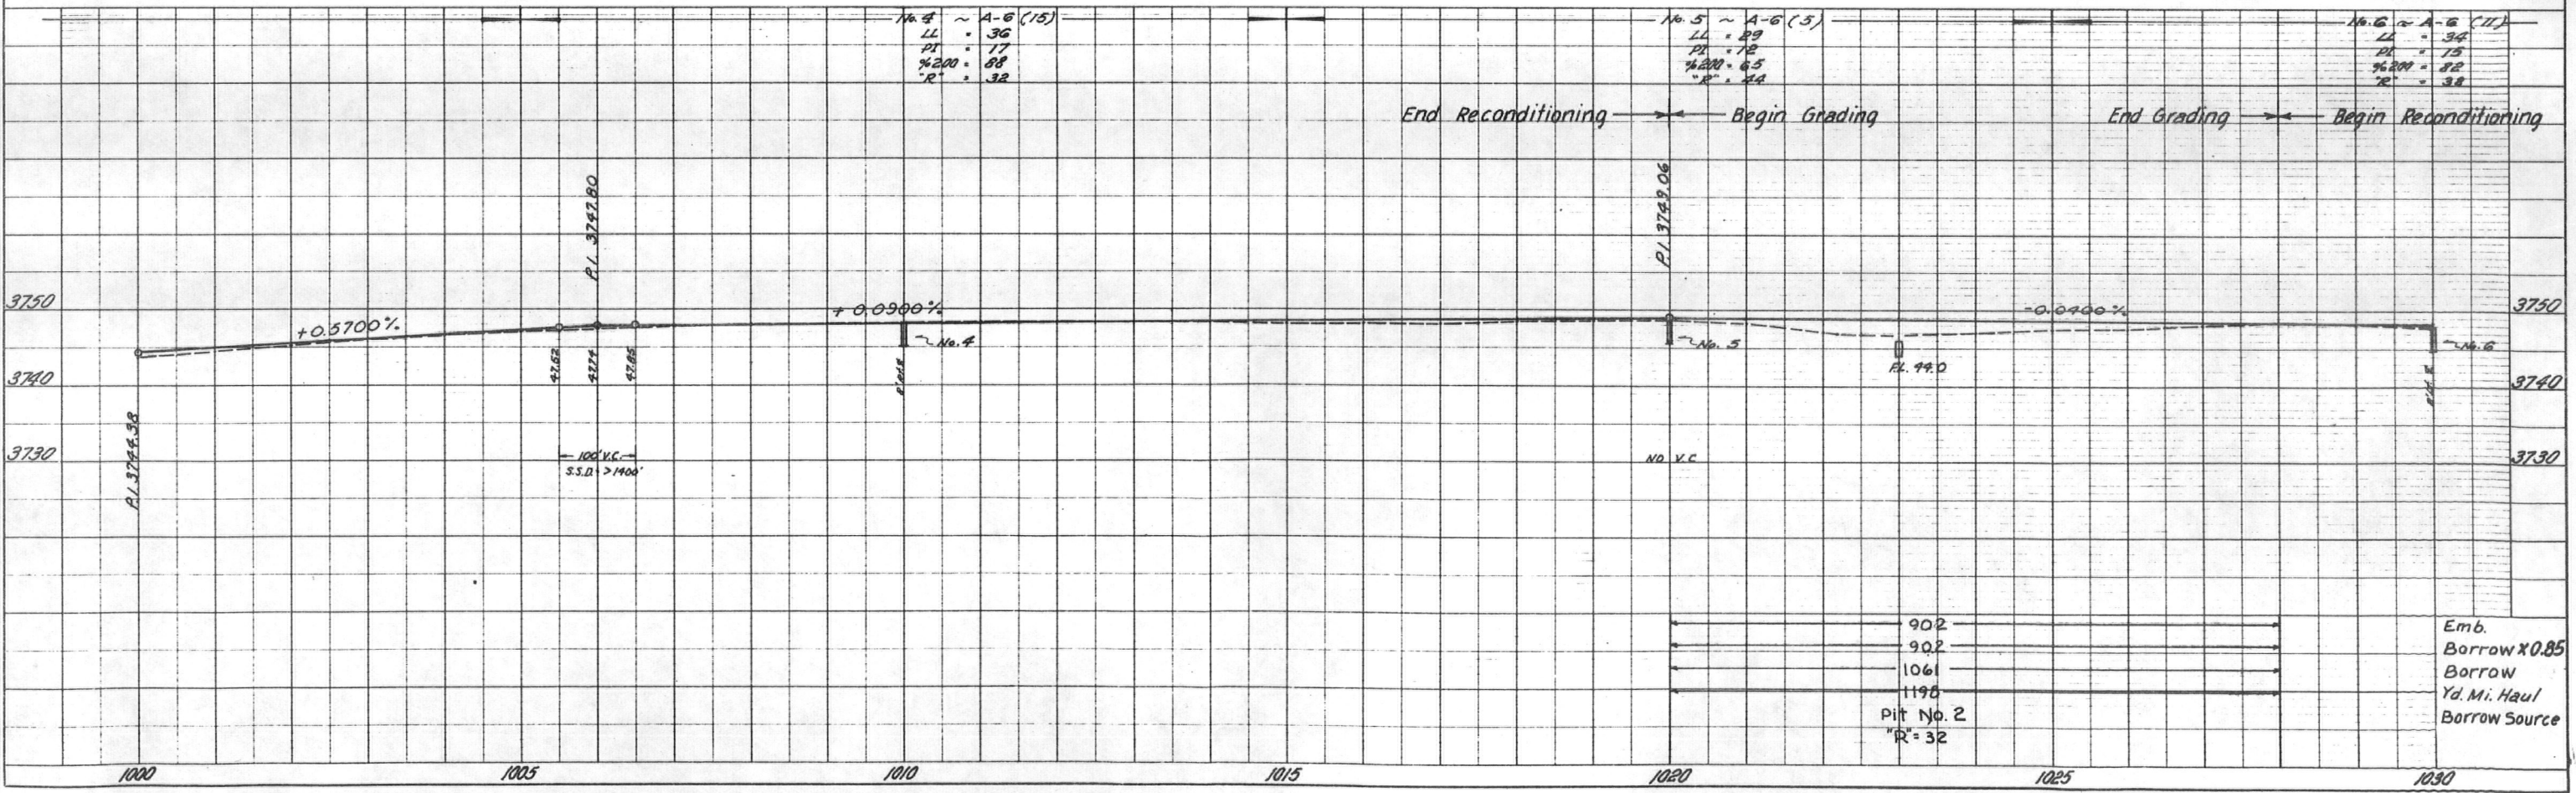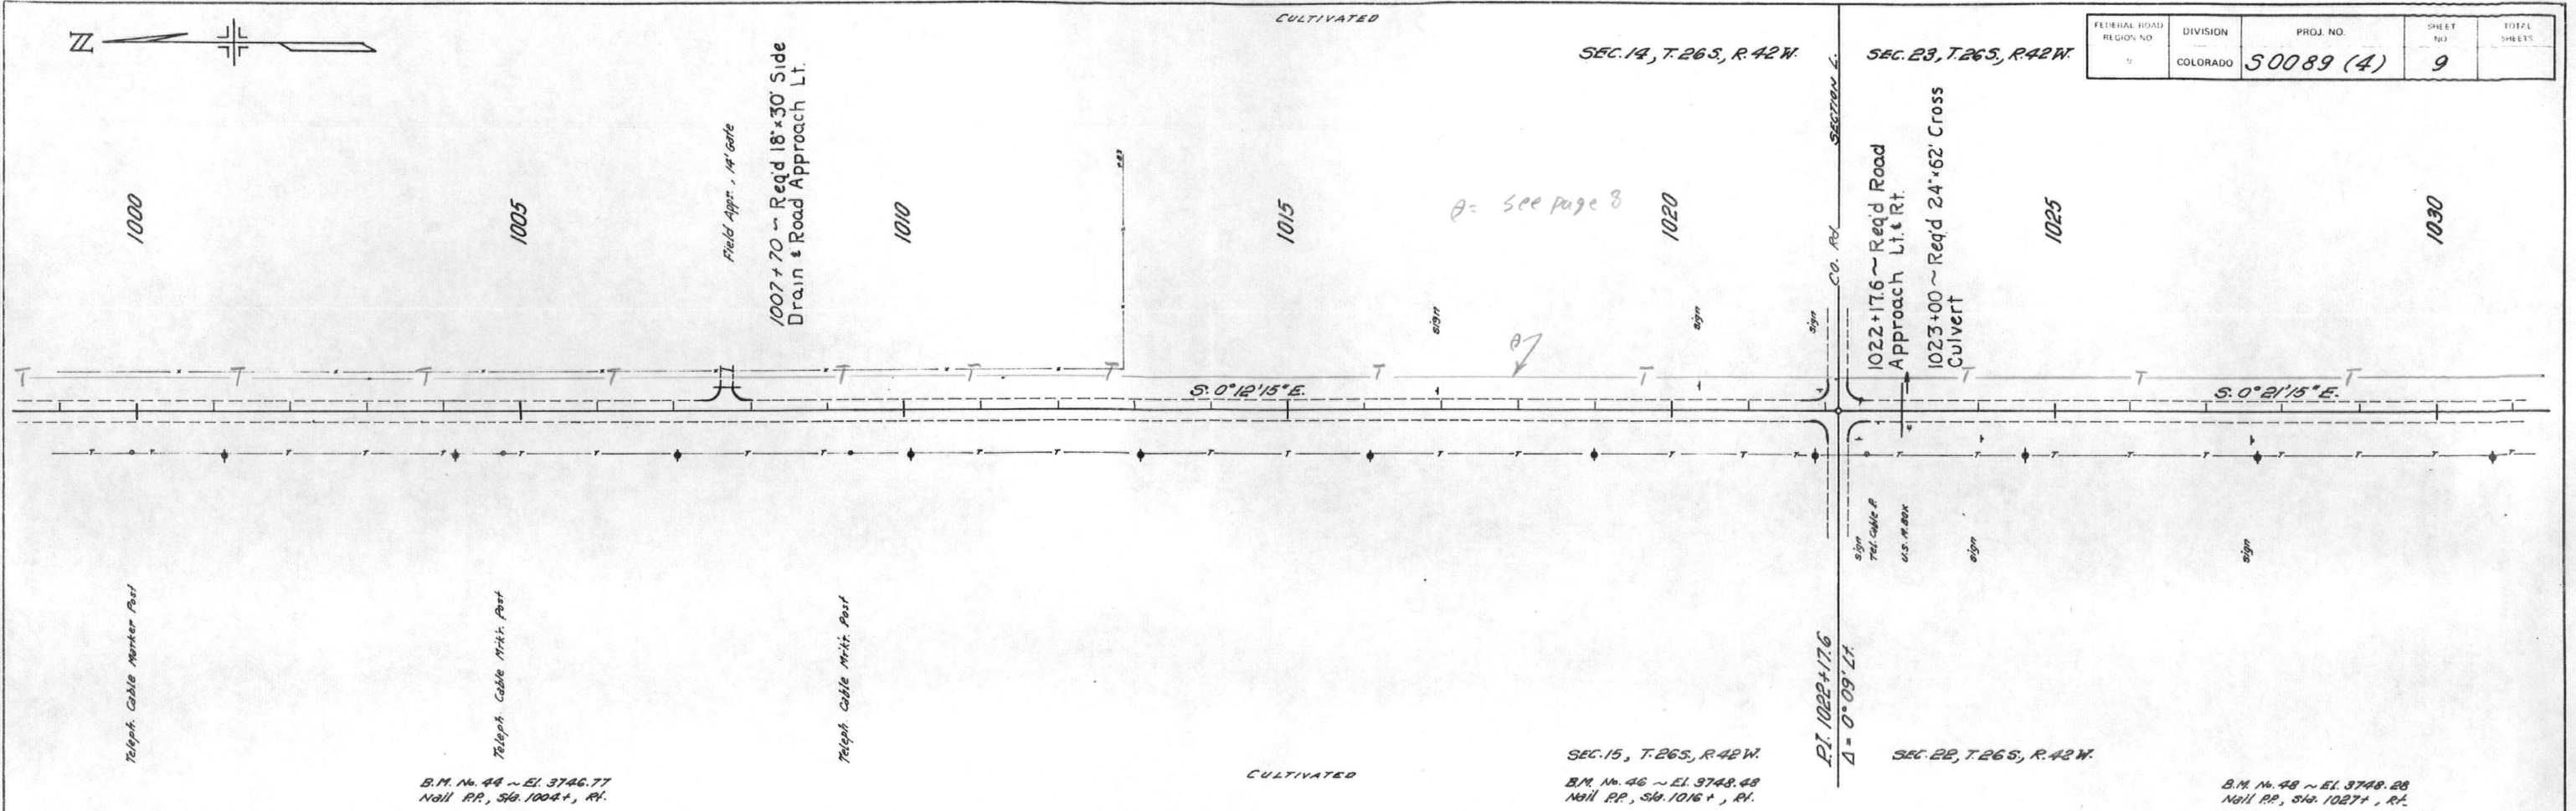

No. 4	~	A-6 (15)
LL	=	36
PI	=	17
%200	=	88
"R"	=	32

No. 5	~	A-6 (5)
LL	=	89
PI	=	78
%200	=	65
"R"	=	32



No. 6	~	A-6 (11)
LL	=	34
PI	=	75
%200	=	82
"R"	=	32

Emb. Borrow x 0.85
 Borrow
 Yd. Mi. Haul
 Borrow Source

Pit No. 2
 "R" = 32

AS CONSTRUCTED
REVISED DATE 9-16-71

FEDERAL ROAD REGION NO.	DIVISION	PROJ. NO.	SHEET NO.	TOTAL SHEETS
9	COLORADO	50089 (4)	10	

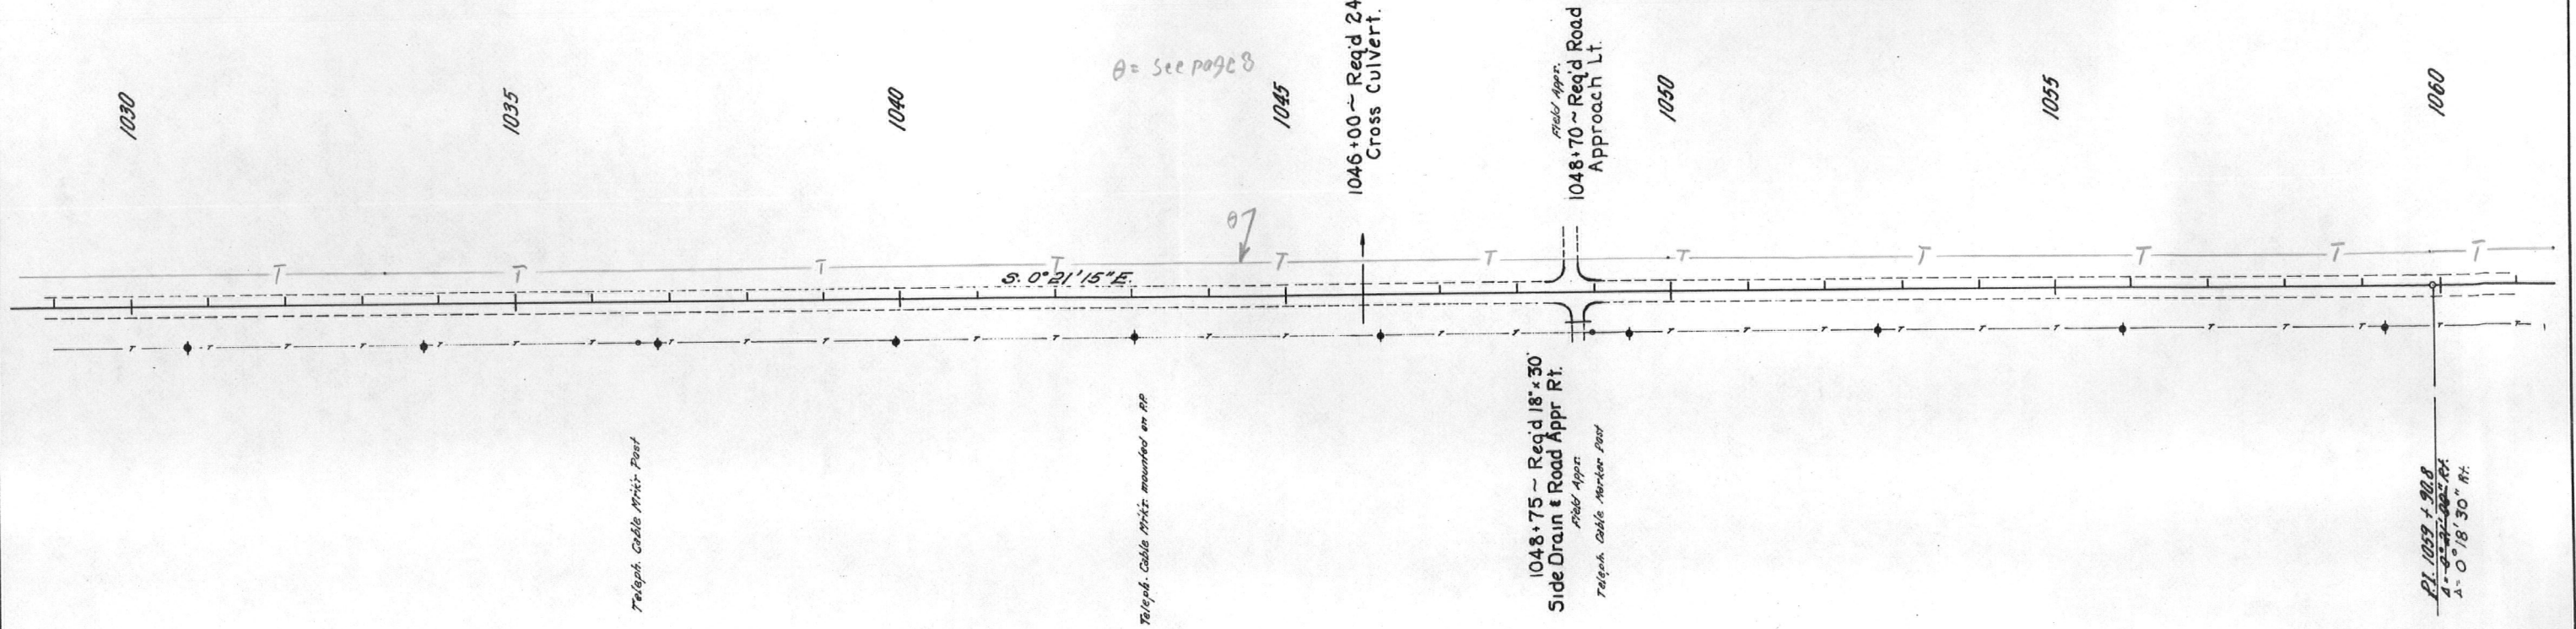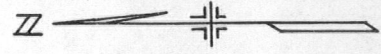

PLAN


DATE	
BY	
CHECKED	
APPROVED	

NOTE BOOK PLANNING CHECKED
 No. 30538

PROFILE

DATE	
BY	
CHECKED	
APPROVED	

NOTE BOOK GRADE CHECKED
 B. M. NOTED
 No. 30538

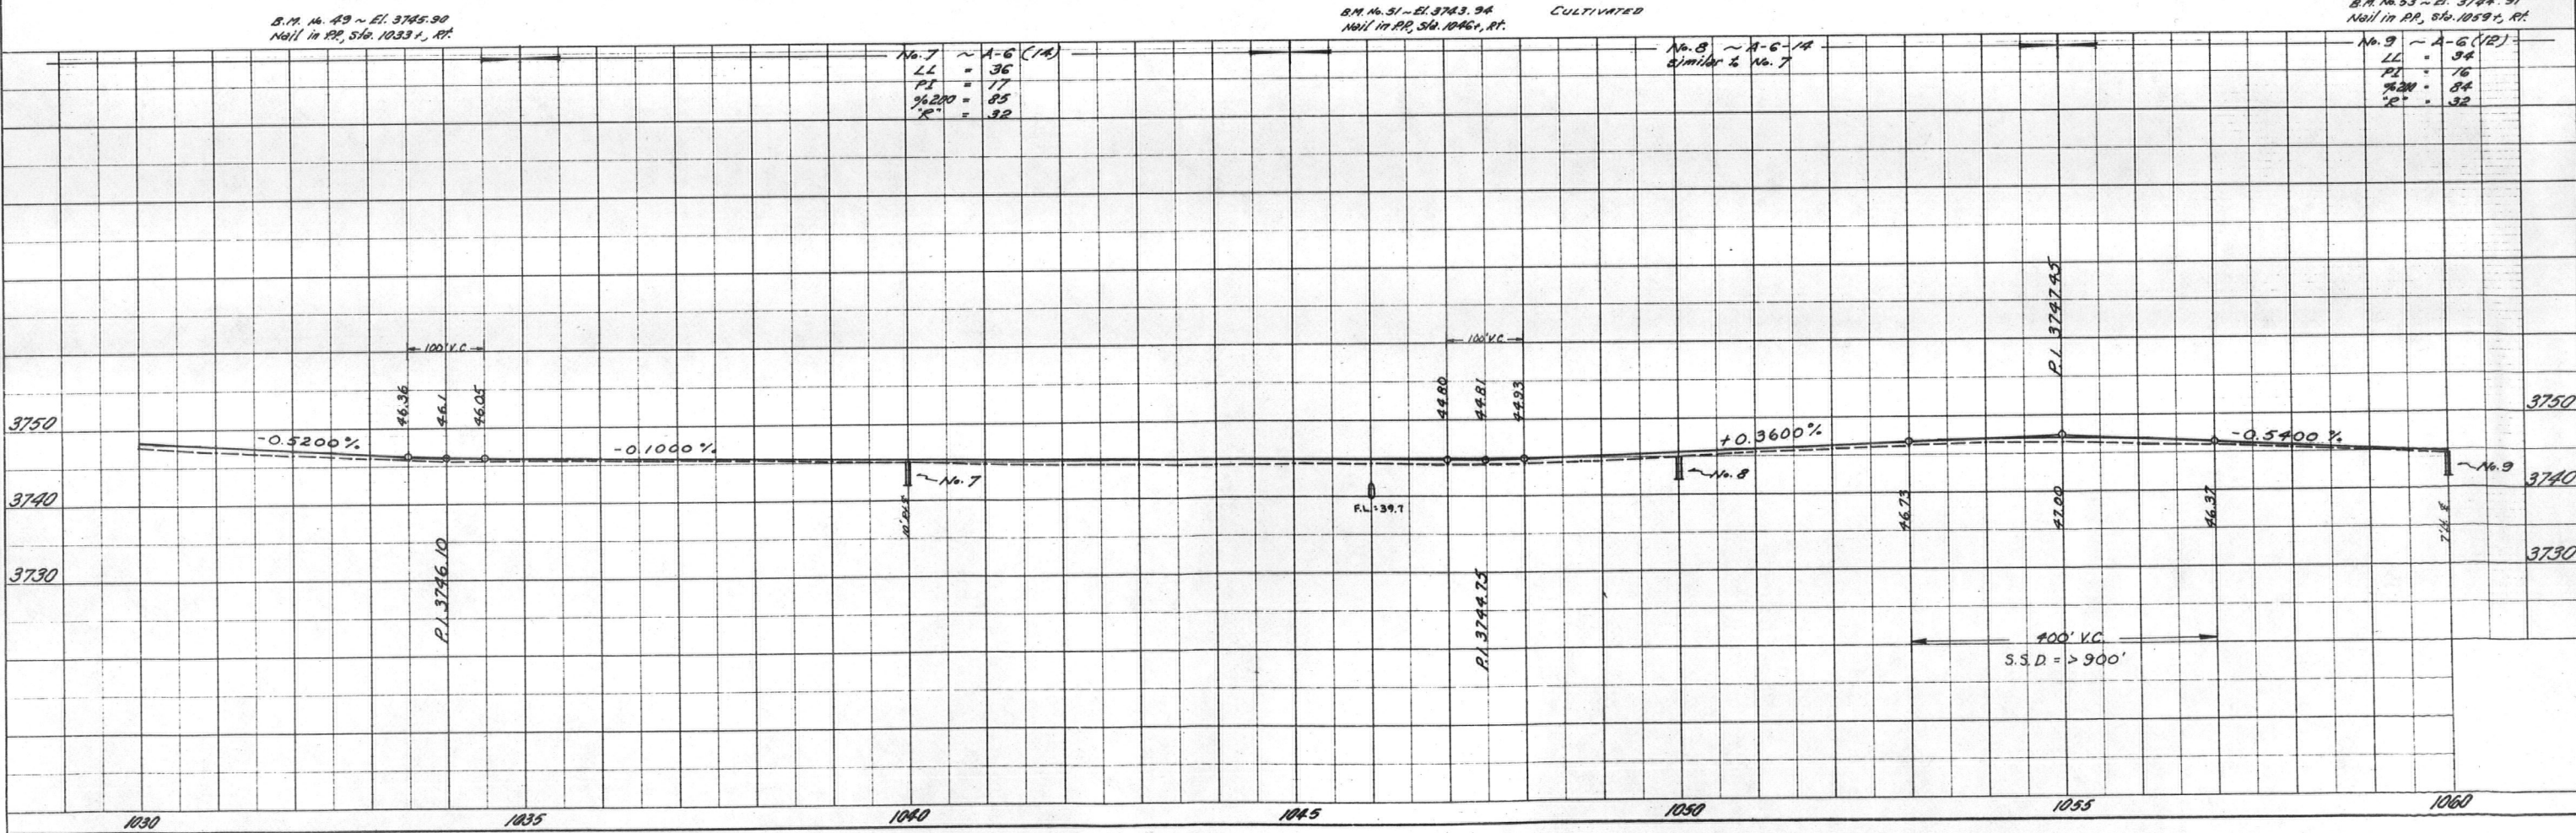

B.M. No. 49 ~ El. 3745.90
 Nail in RP, Sta. 1033 +.00

B.M. No. 51 ~ El. 3743.94
 Nail in RP, Sta. 1046 +.00

B.M. No. 53 ~ El. 3744.91
 Nail in RP, Sta. 1059 +.00

$\theta = \text{See page 8}$

1046+00 ~ Req'd 24' x 64'
 Cross Culvert.

1048+70 ~ Req'd Road
 Approach Lt.

1048+75 ~ Req'd 18' x 30'
 Side Drain + Road Appr Rt.

P.I. 1059 + 90.8
 2' - 0" 18' 30" RT.

FEDERAL ROAD REGION NO.	DIVISION	PROJ. NO.	SHEET NO.	TOTAL SHEETS
9	COLORADO	50089 (4)	11	

(R-1) 4-20-71 D.H.H.

AS CONSTRUCTED
REVISED DATE 9-16-71

PLAN

DATE: _____ BY: _____

REVISIONS:

NOTE BOOK ALUMINUM CHECKED: _____

NO. 8/429


PROFILE

DATE: _____ BY: _____

REVISIONS:

NOTE BOOK GRAPHIC CHECKED: _____

NO. _____

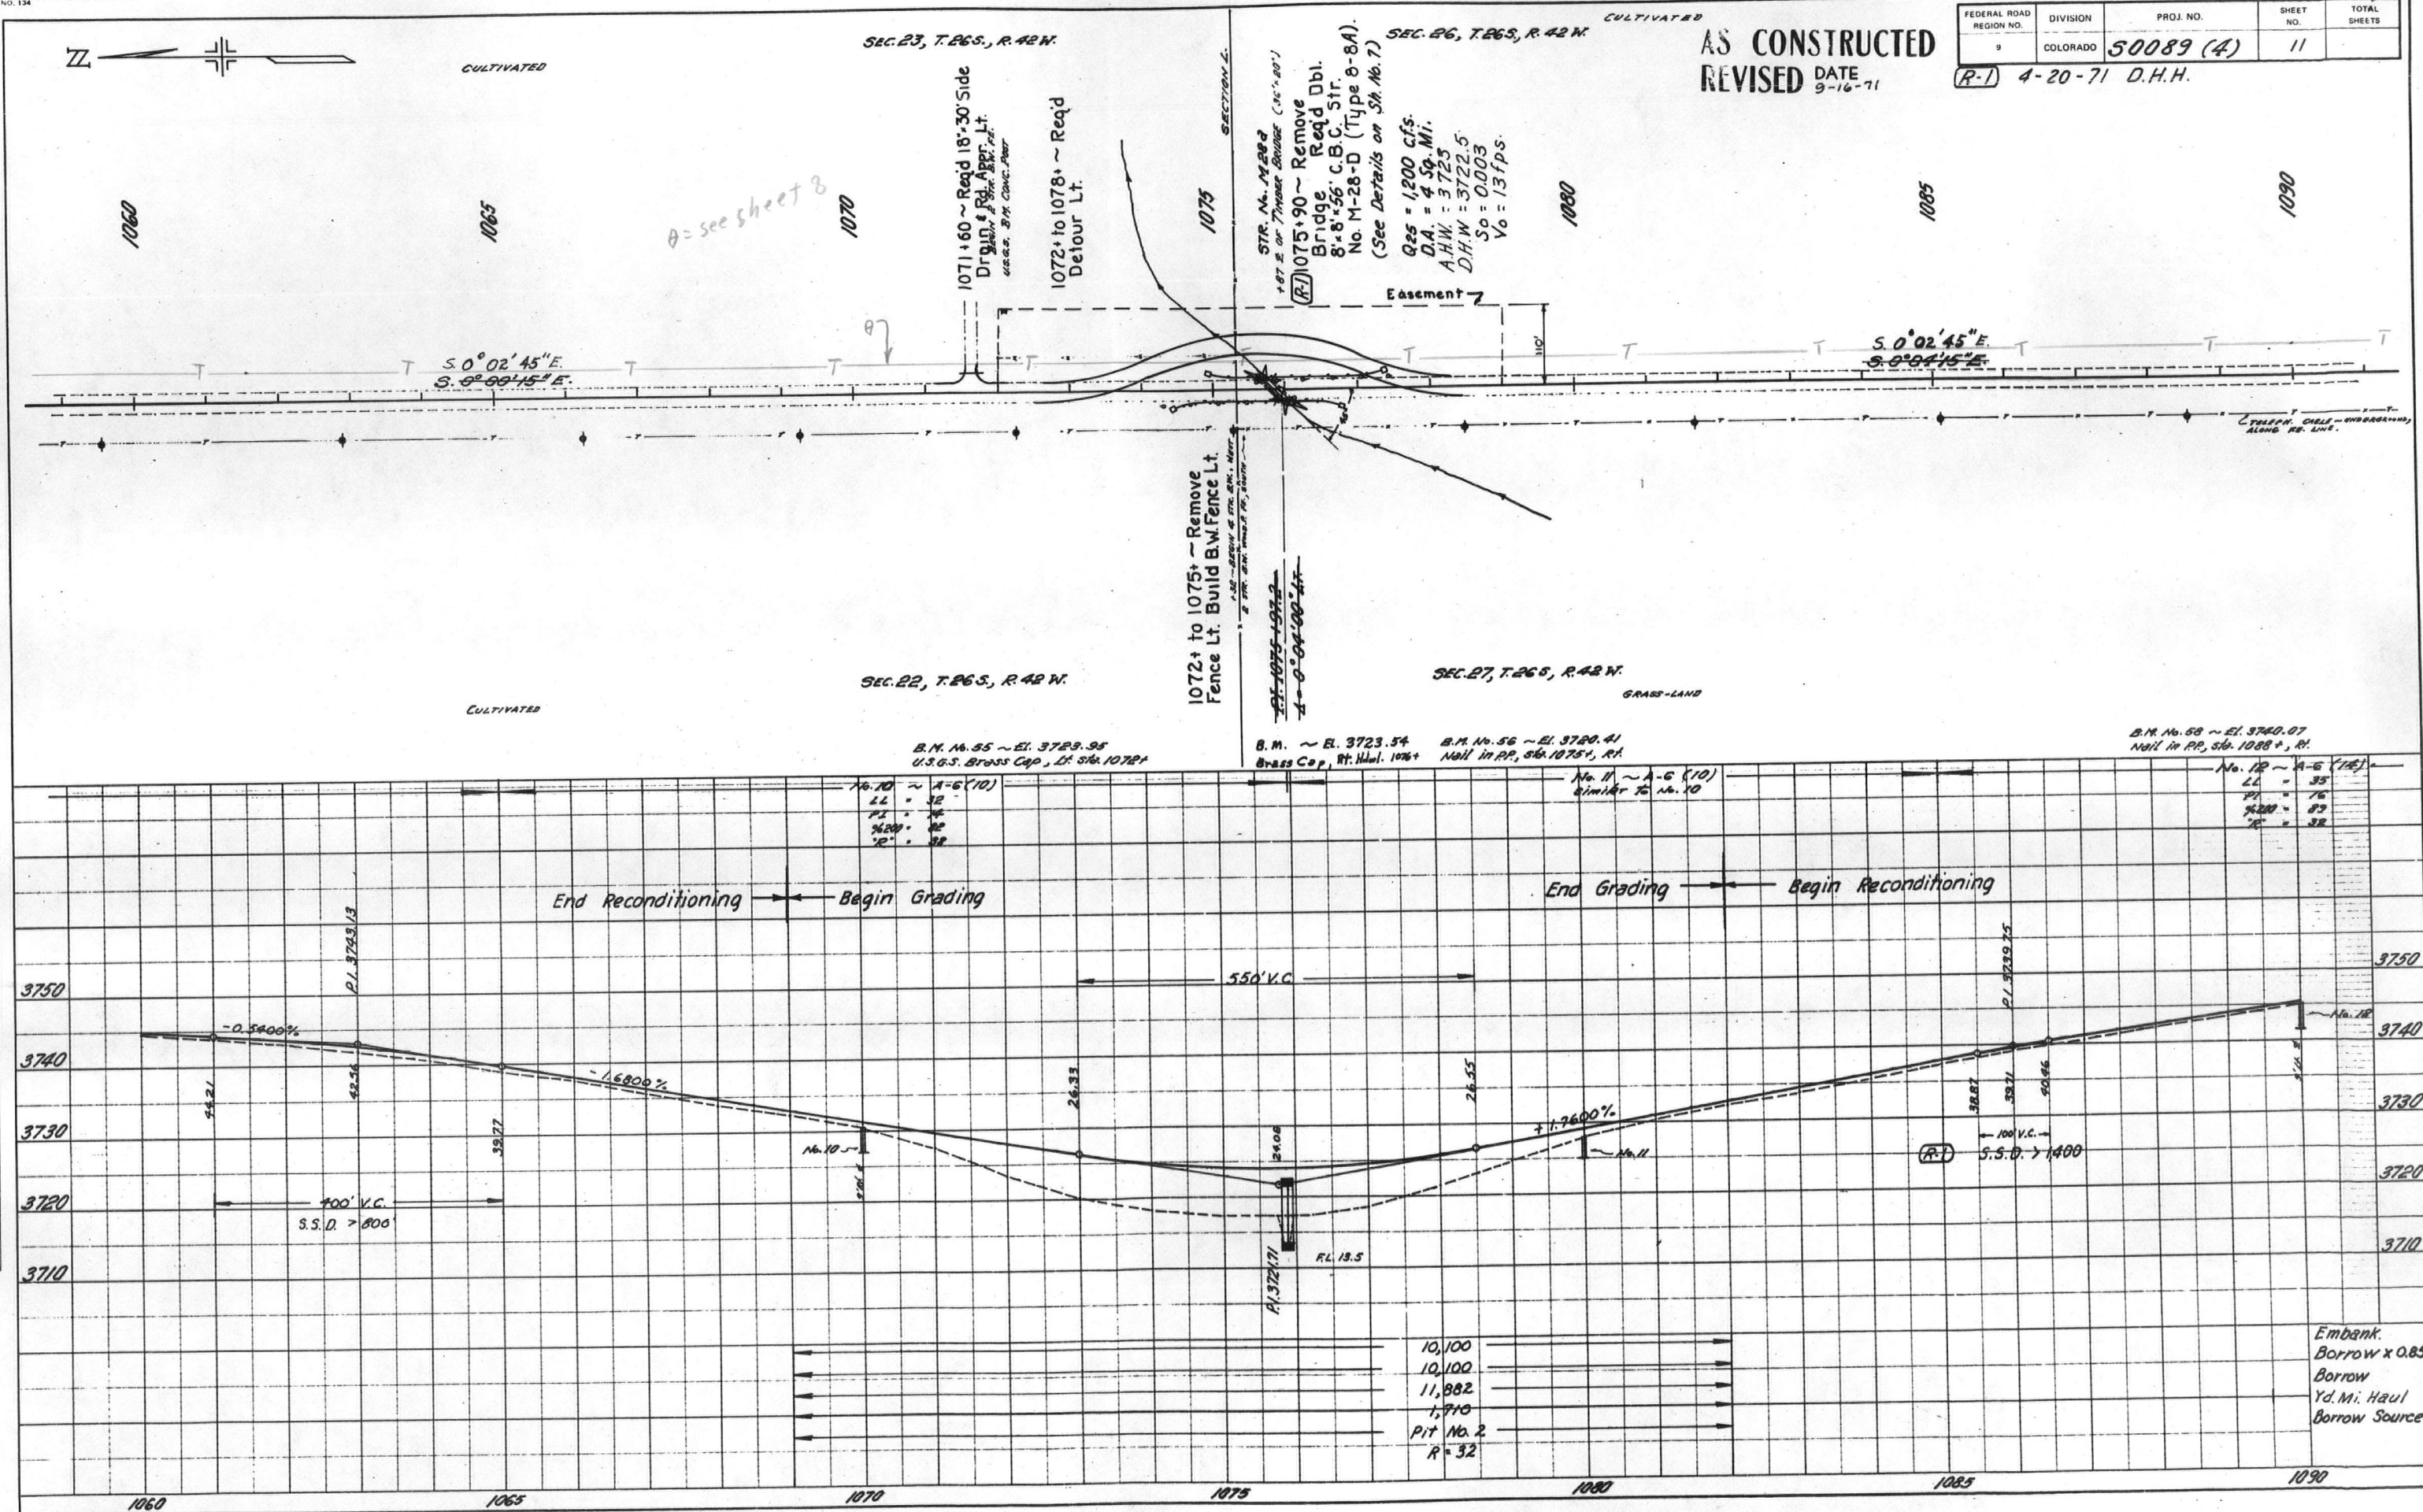


AS CONSTRUCTED
REVISED DATE 9-16-71

FEDERAL ROAD REGION NO.	DIVISION	PROJ. NO.	SHEET NO.	TOTAL SHEETS
9	COLORADO	50089 (4)	12	

PLAN
SURVEYED
NOTE BOOK
NO. 31438
BY
DATE


PROFILE
SURVEYED
NOTE BOOK
NO. 31438
BY
DATE

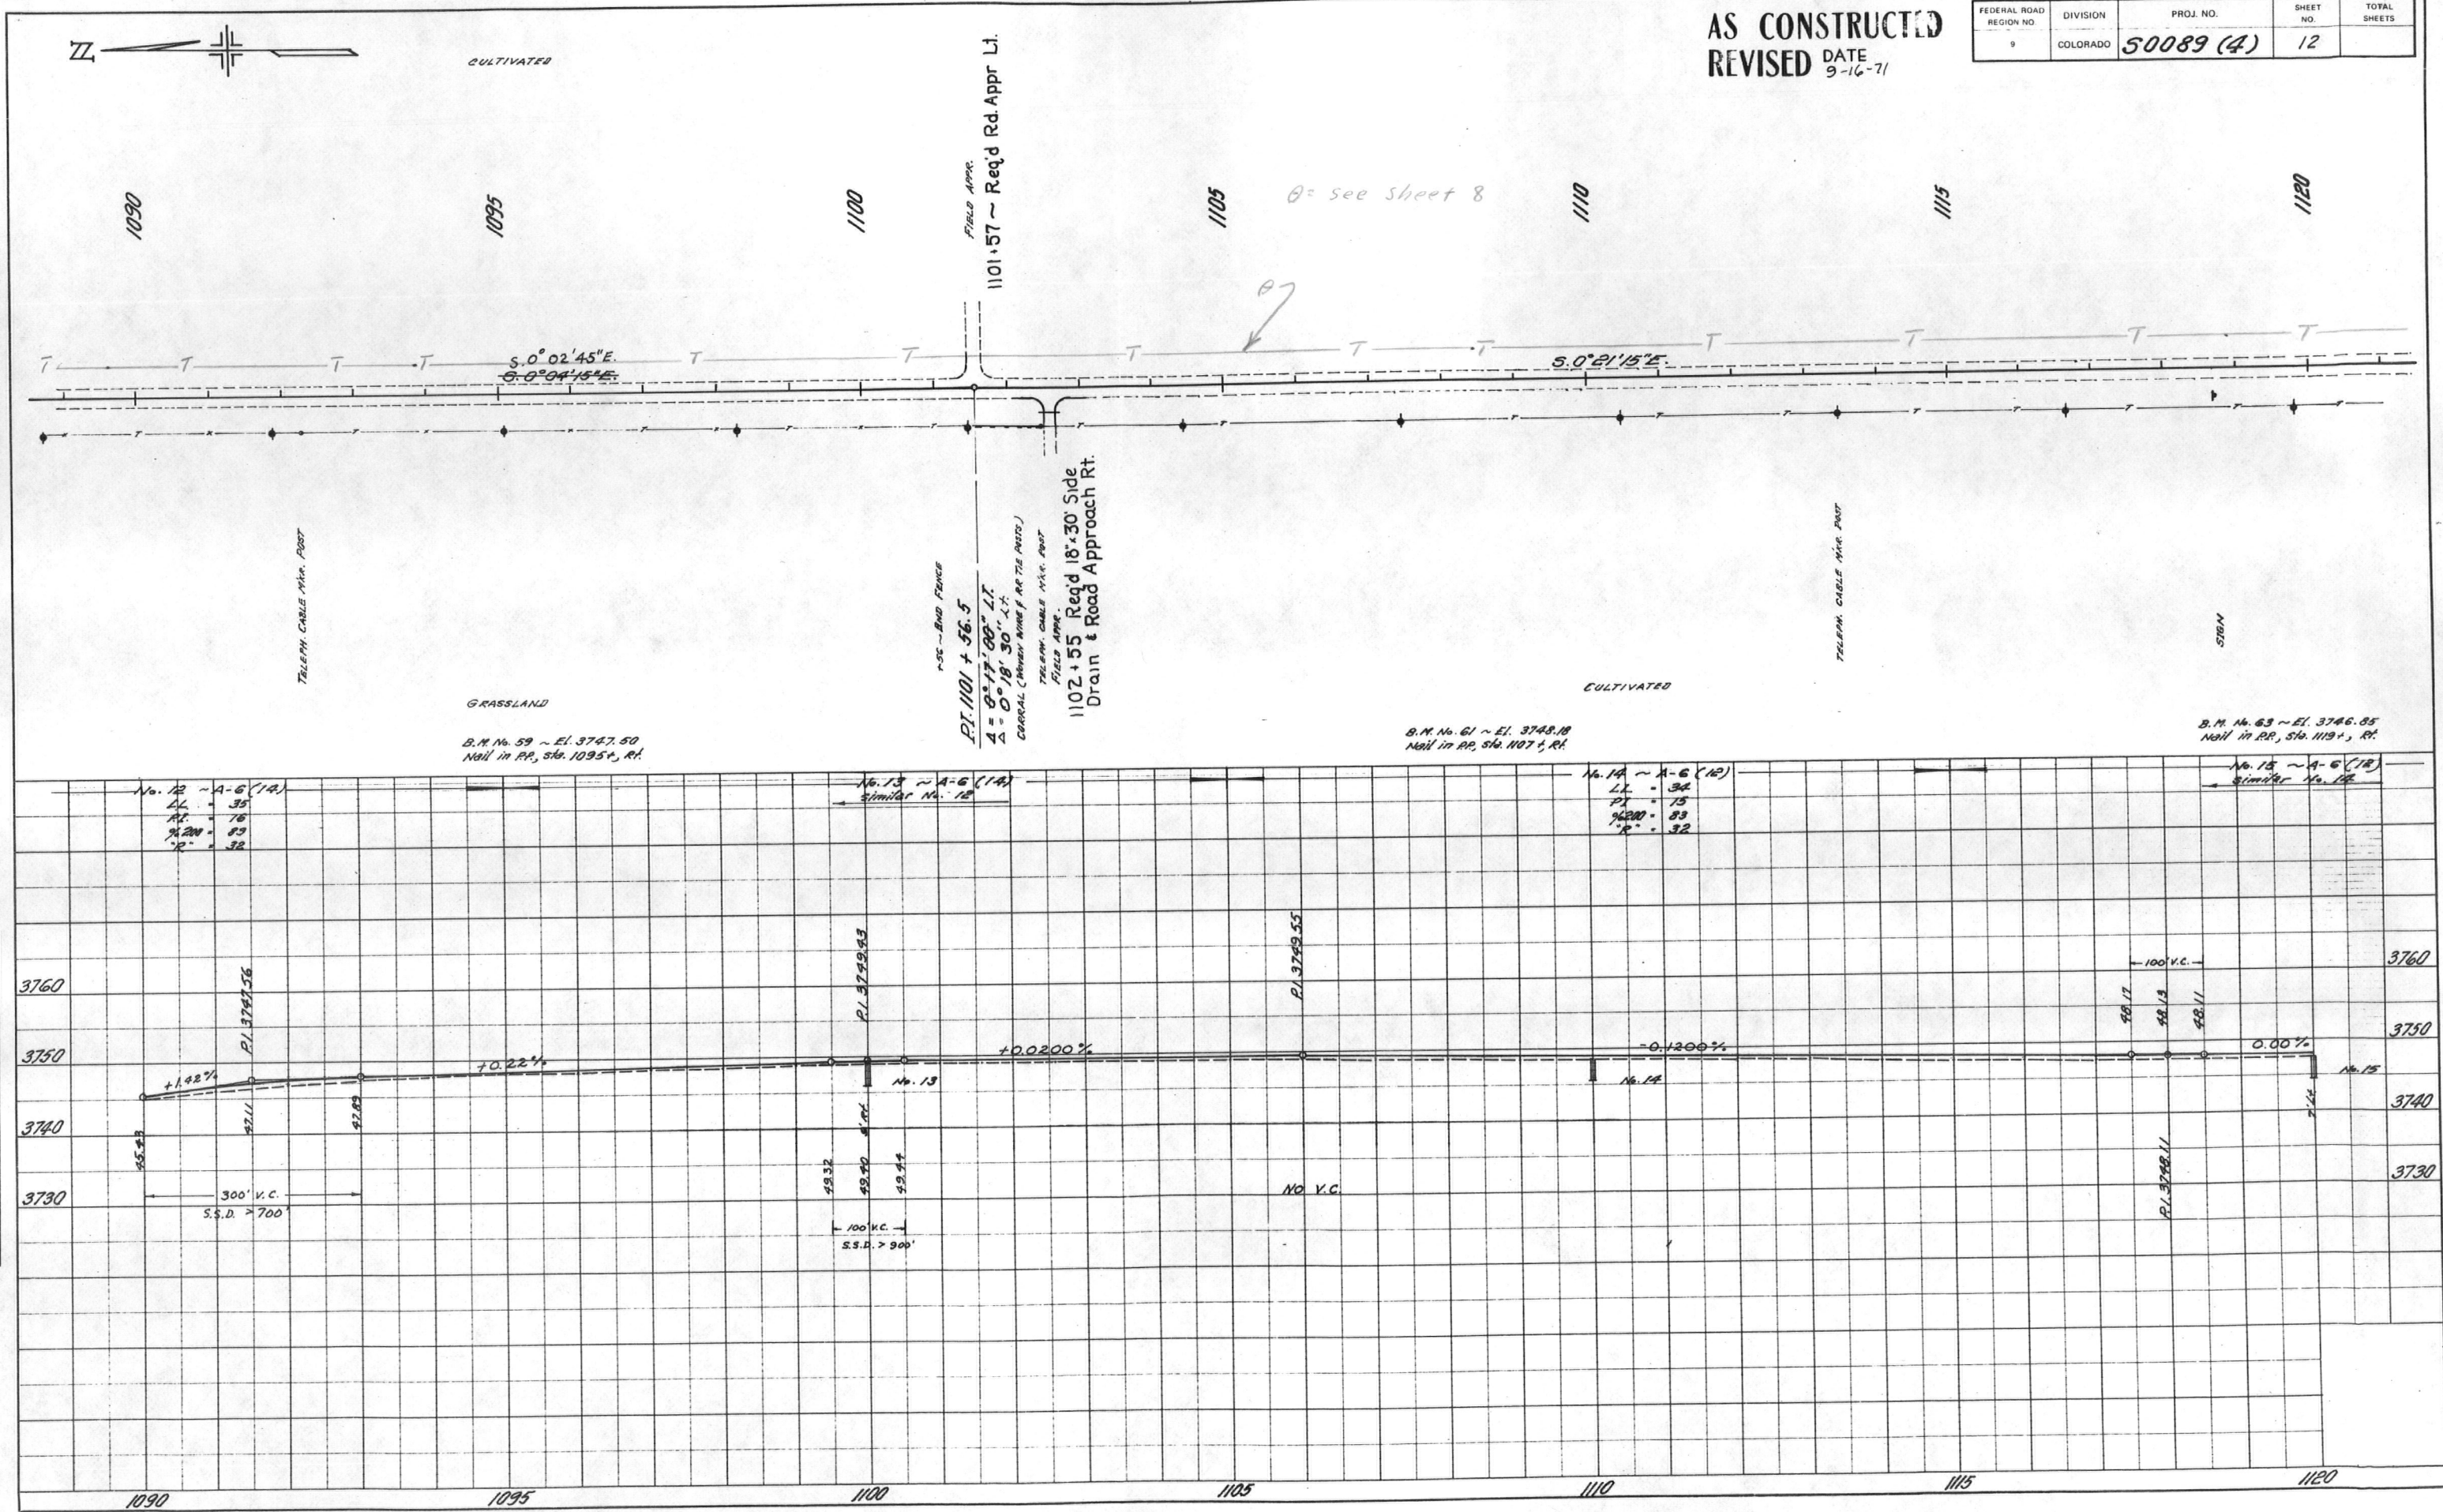

FEDERAL ROAD REGION NO.	DIVISION	PROJ. NO.	SHEET NO.	TOTAL SHEETS
9	COLORADO	50089 (4)	13	

PLAN
NOTED:
NO. 1125
NO. 1126


PROFILE
NOTED:
NO. 1125
NO. 1126

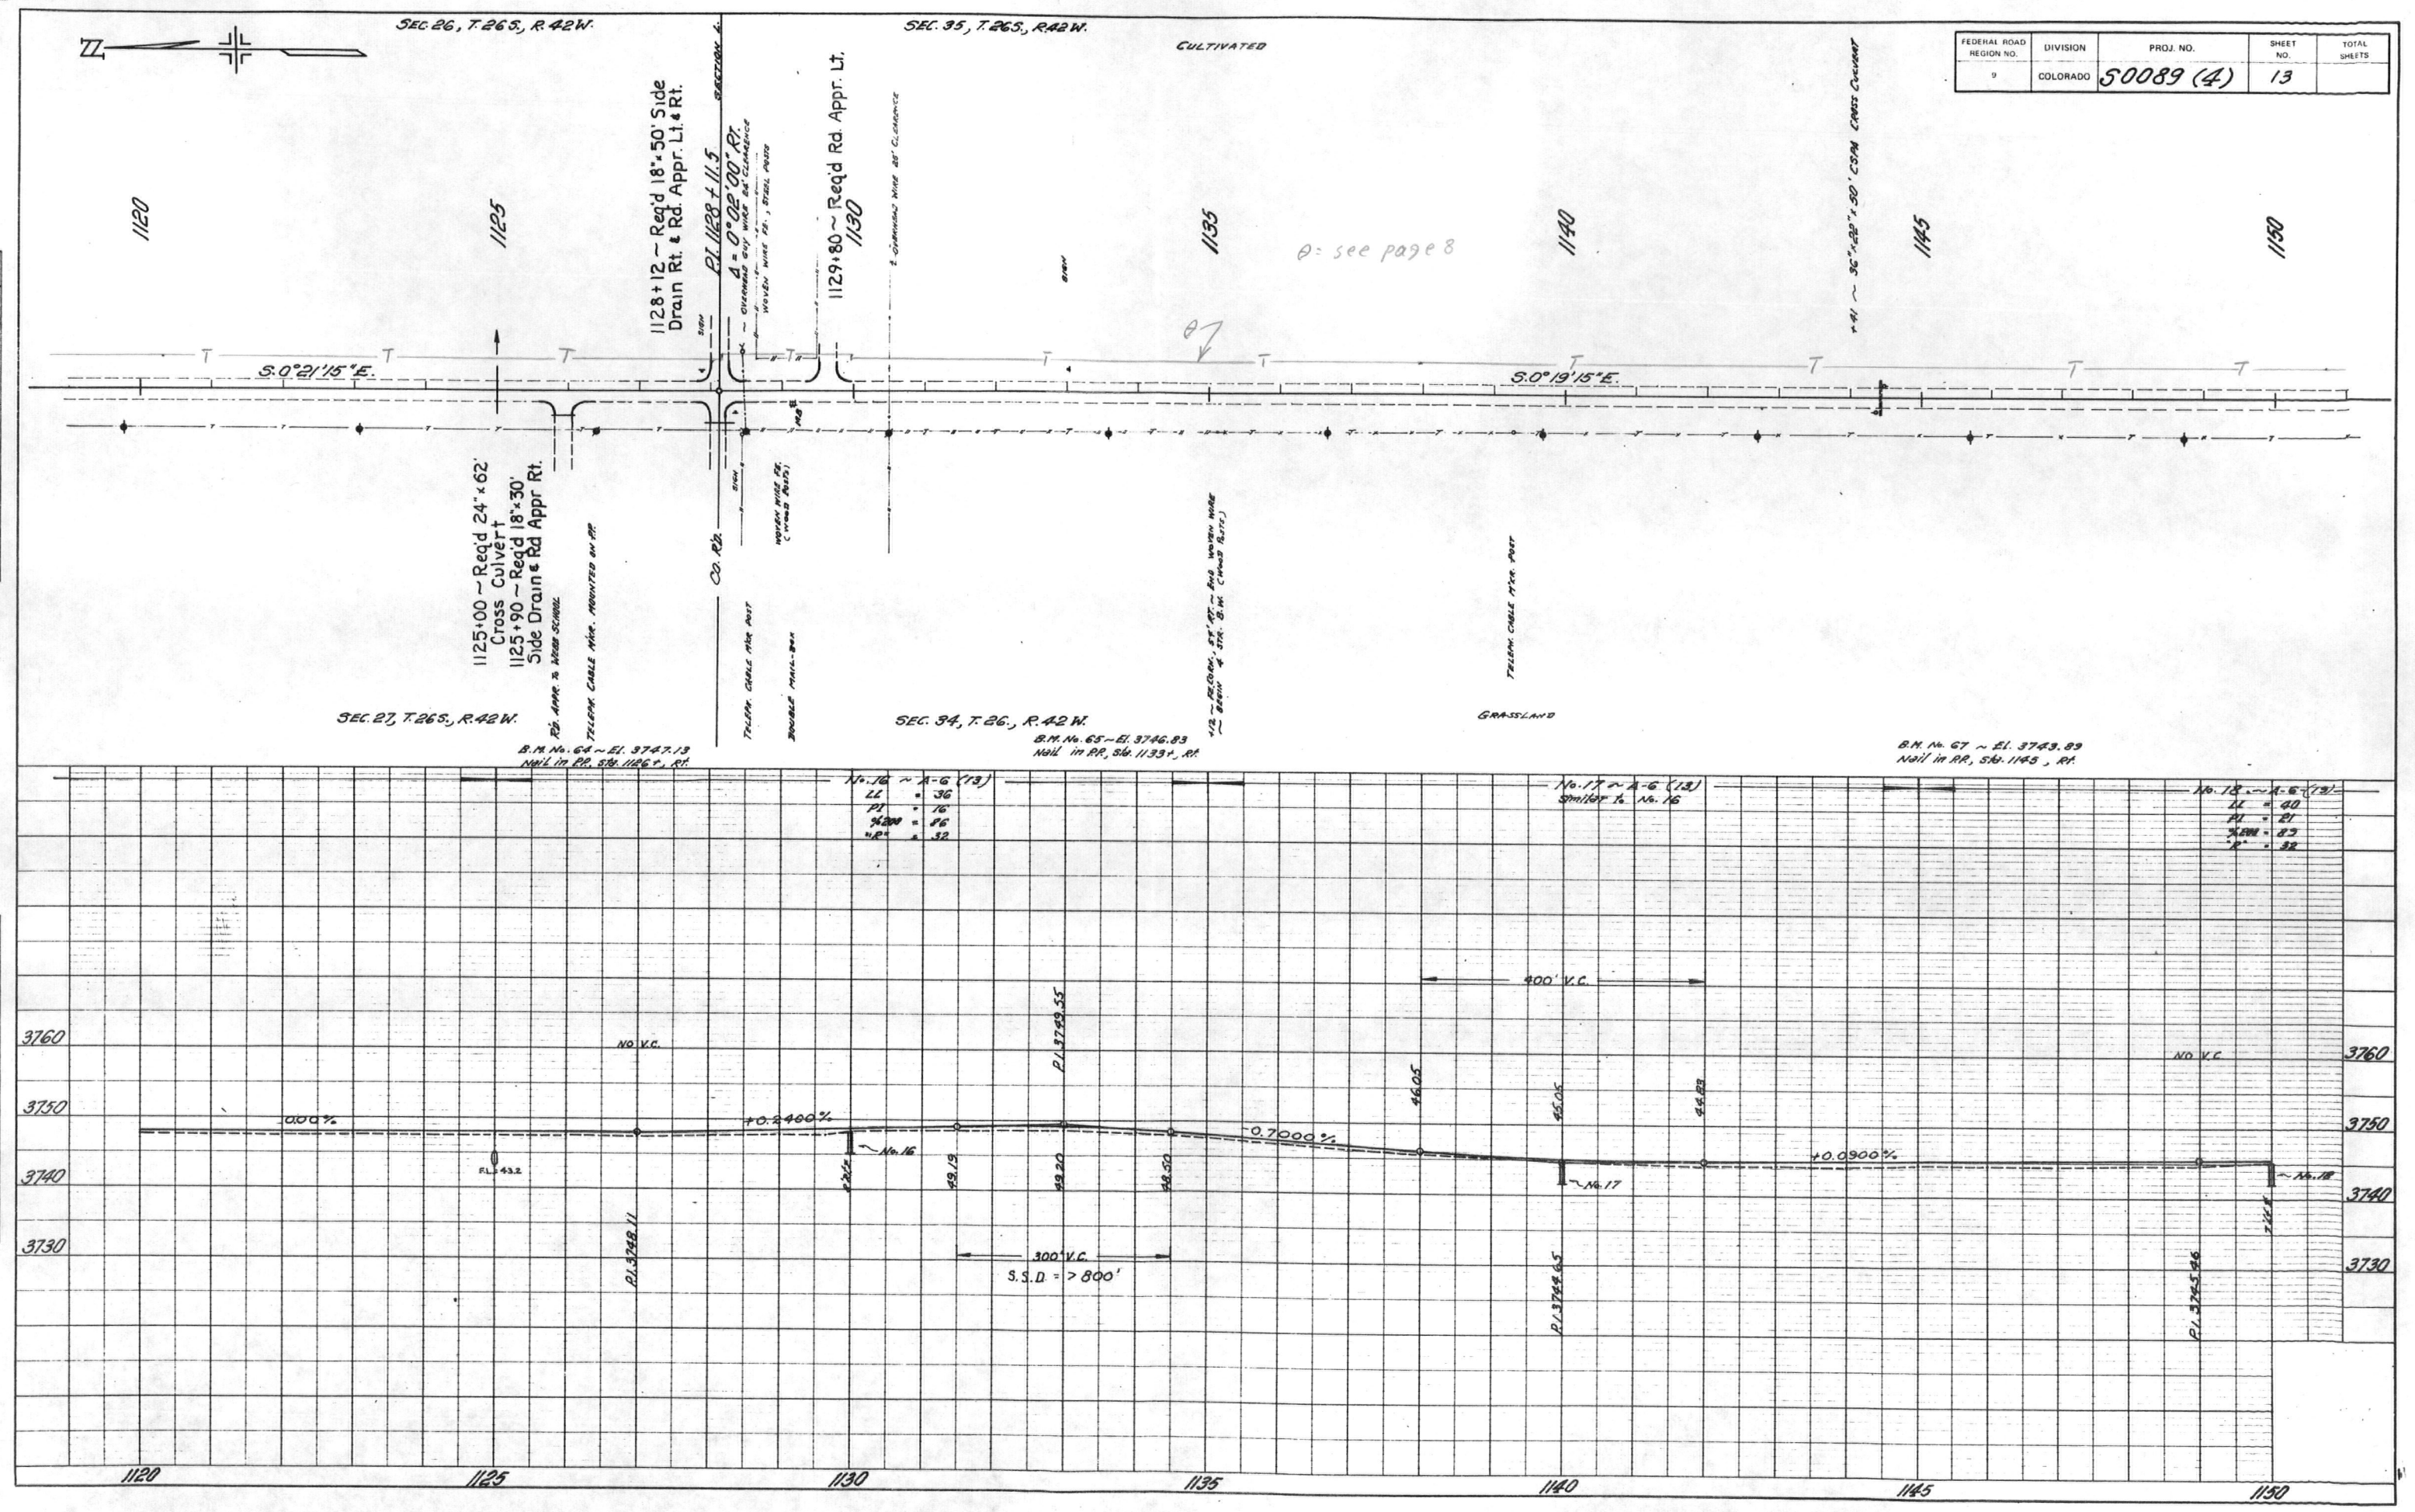

FEDERAL ROAD REGION NO.	DIVISION	PROJ. NO.	SHEET NO.	TOTAL SHEETS
9	COLORADO	50089 (4)	14	



PLAN
 DRAWN BY: _____
 CHECKED BY: _____
 DATE: _____
 NOTE BOOK ALIGNED CHECKED
 No. 3/5/58

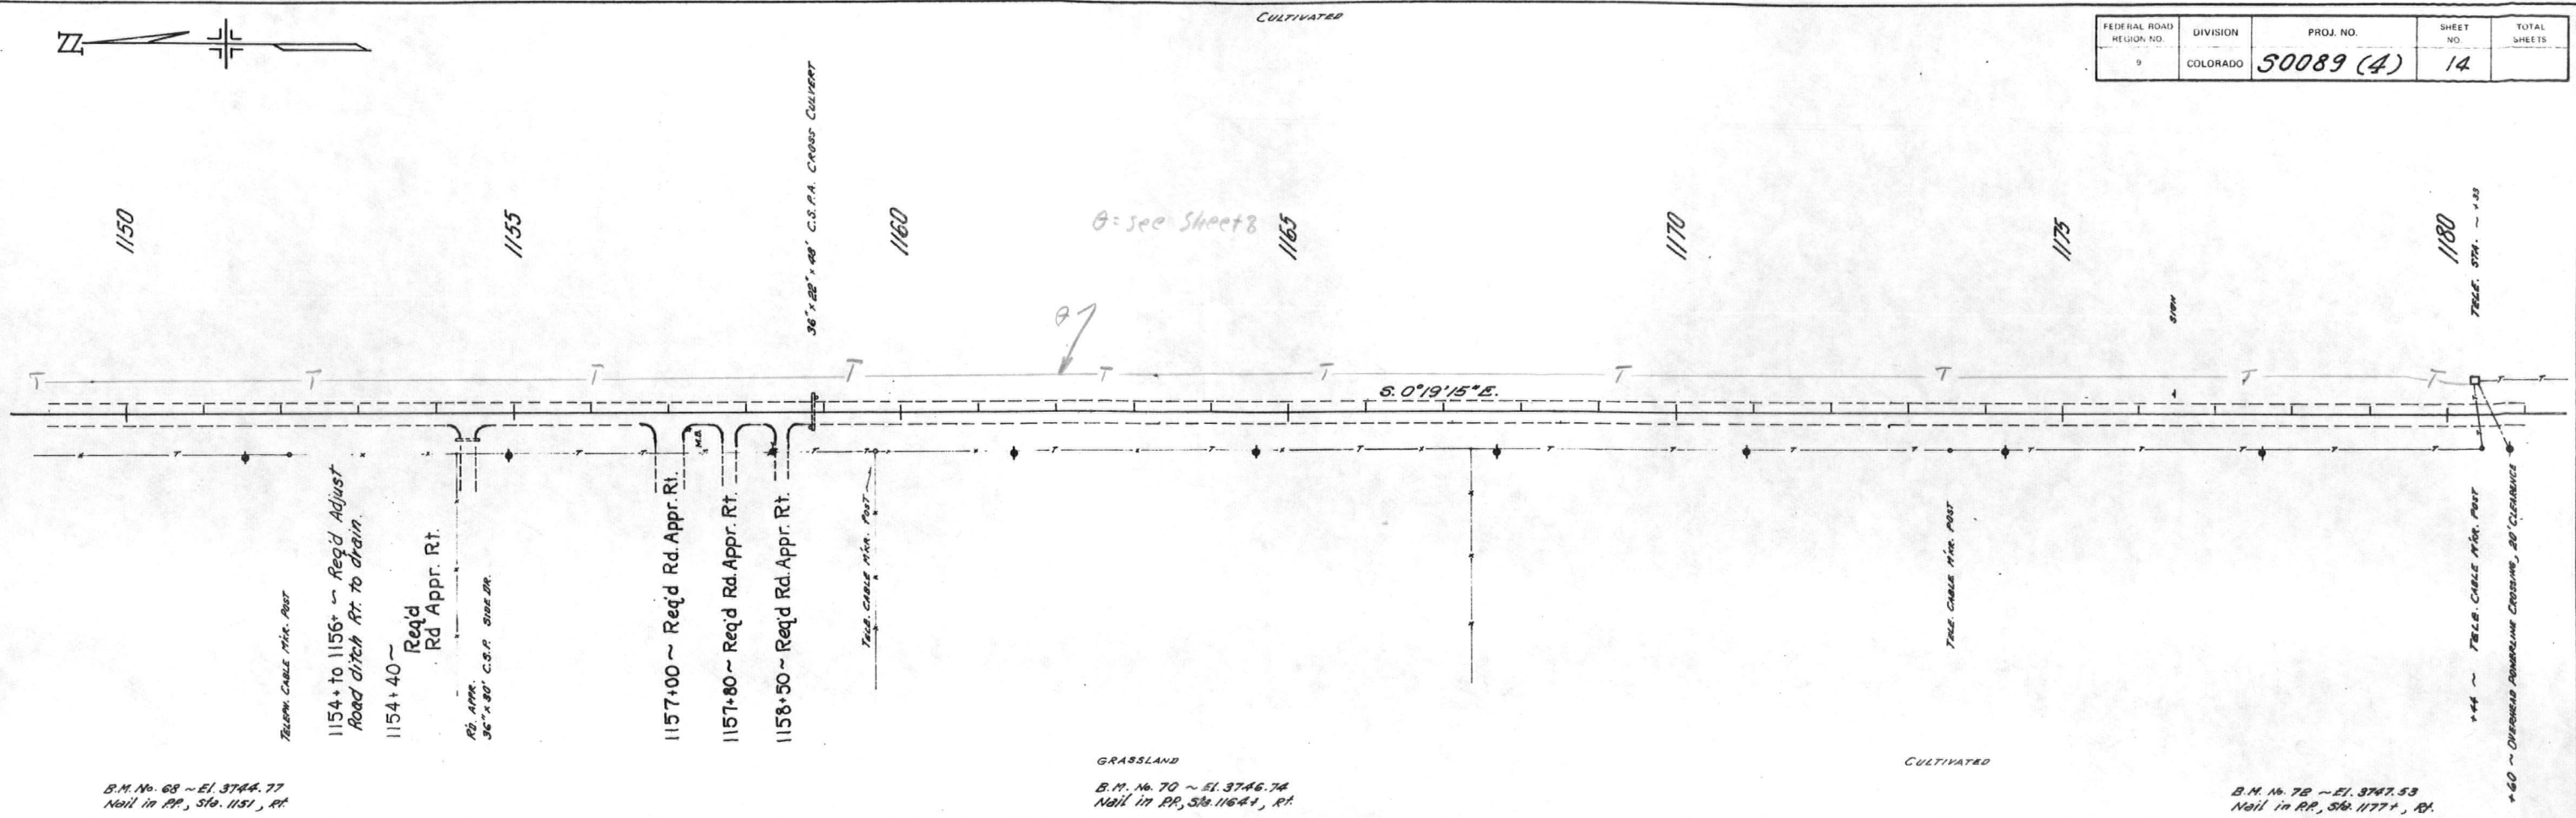

B.M. No. 68 ~ El. 3744.77
 Nail in RR, Sta. 1151, Rt.

GRASSLAND
 B.M. No. 70 ~ El. 3746.74
 Nail in RR, Sta. 1164, Rt.

B.M. No. 78 ~ El. 3747.53
 Nail in RR, Sta. 1177, Rt.


No. 18 ~ A-6 (19)
 LL = 40
 LA = 21
 PA = 29
 PC = 32

No. 19 ~ A-6 (19)
 similar to No. 18

No. 20 ~ A-6 (8)
 LL = 31
 LA = 11
 PA = 21
 PC = 28



No. 21 ~ A-6 (21)
 similar to No. 20

PROFILE
 DRAWN BY: _____
 CHECKED BY: _____
 DATE: _____
 NOTE BOOK B.M. 11/1/58
 STRUCTURE ADDITIONAL CHECKED

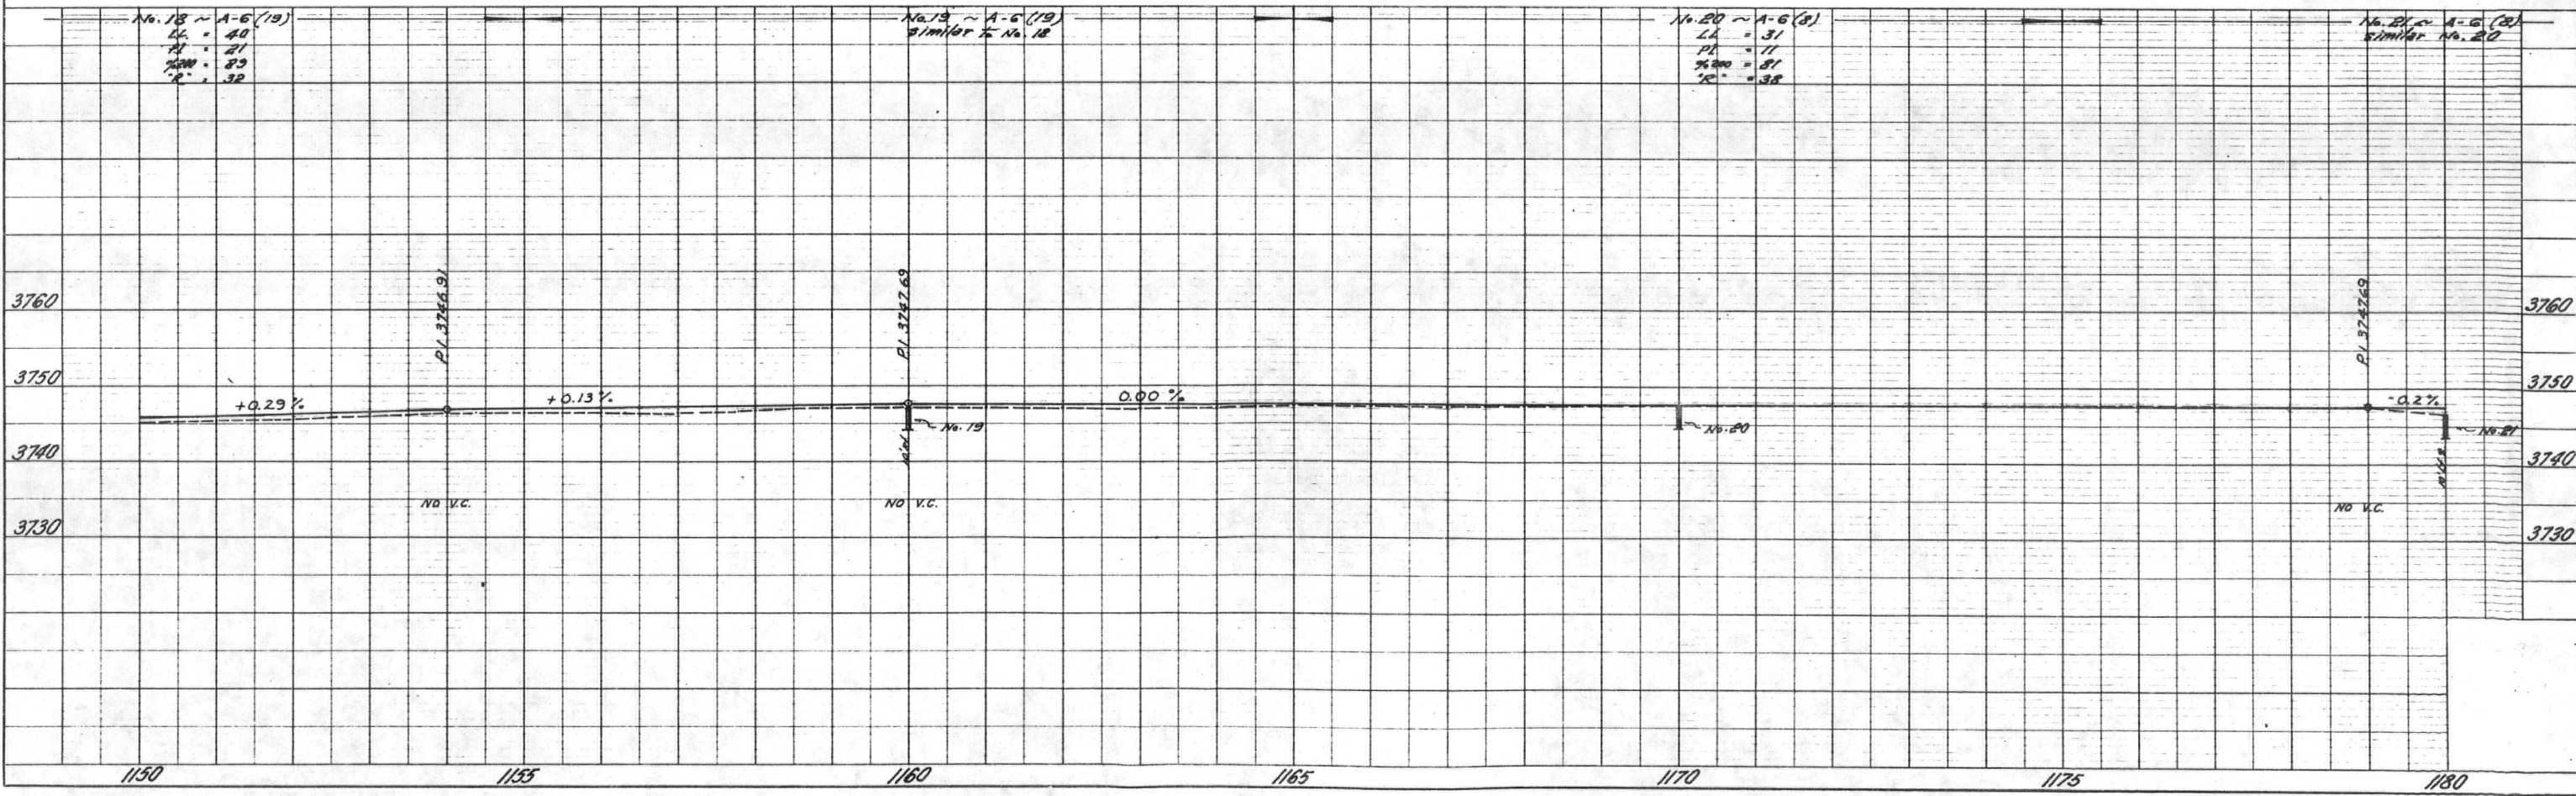

FEDERAL ROAD REGION NO.	DIVISION	PROJ. NO.	SHEET NO.	TOTAL SHEETS
9	COLORADO	50089 (4)	15	

AS CONSTRUCTED
REVISED DATE 9-16-71

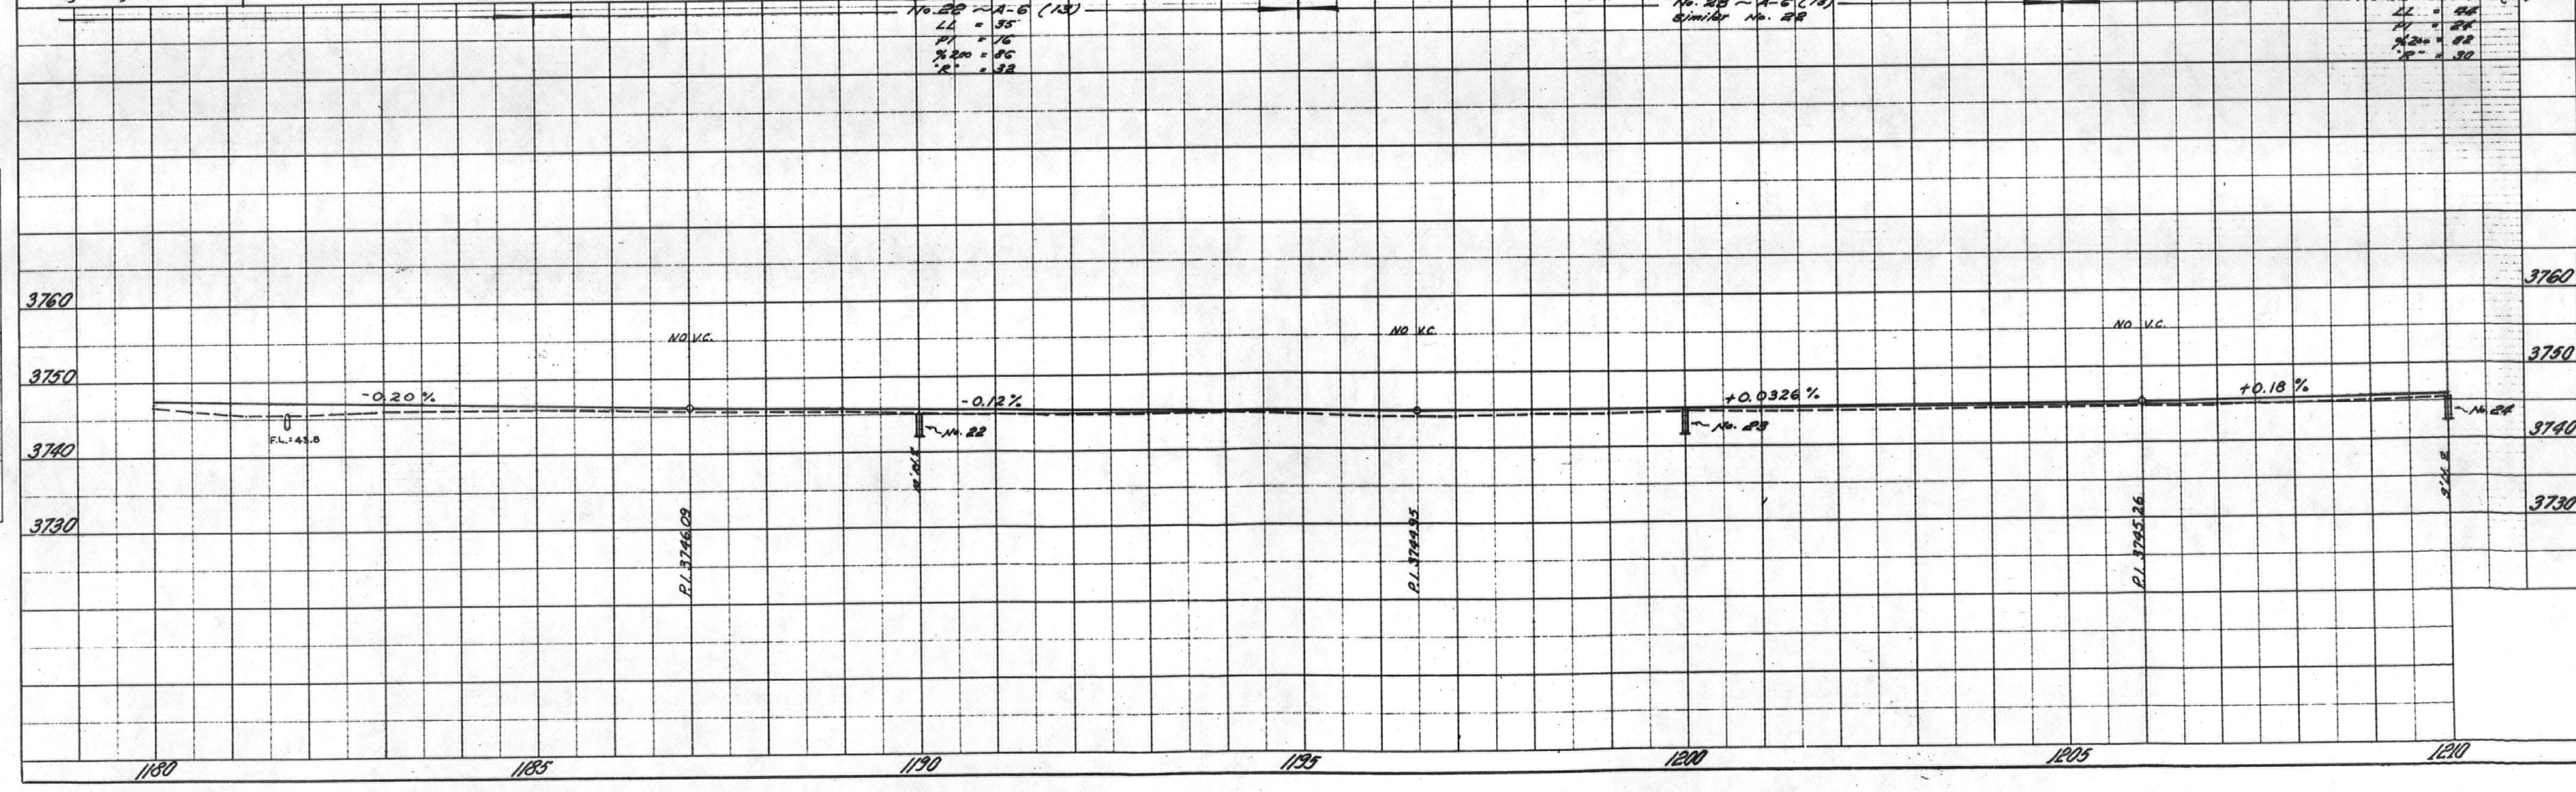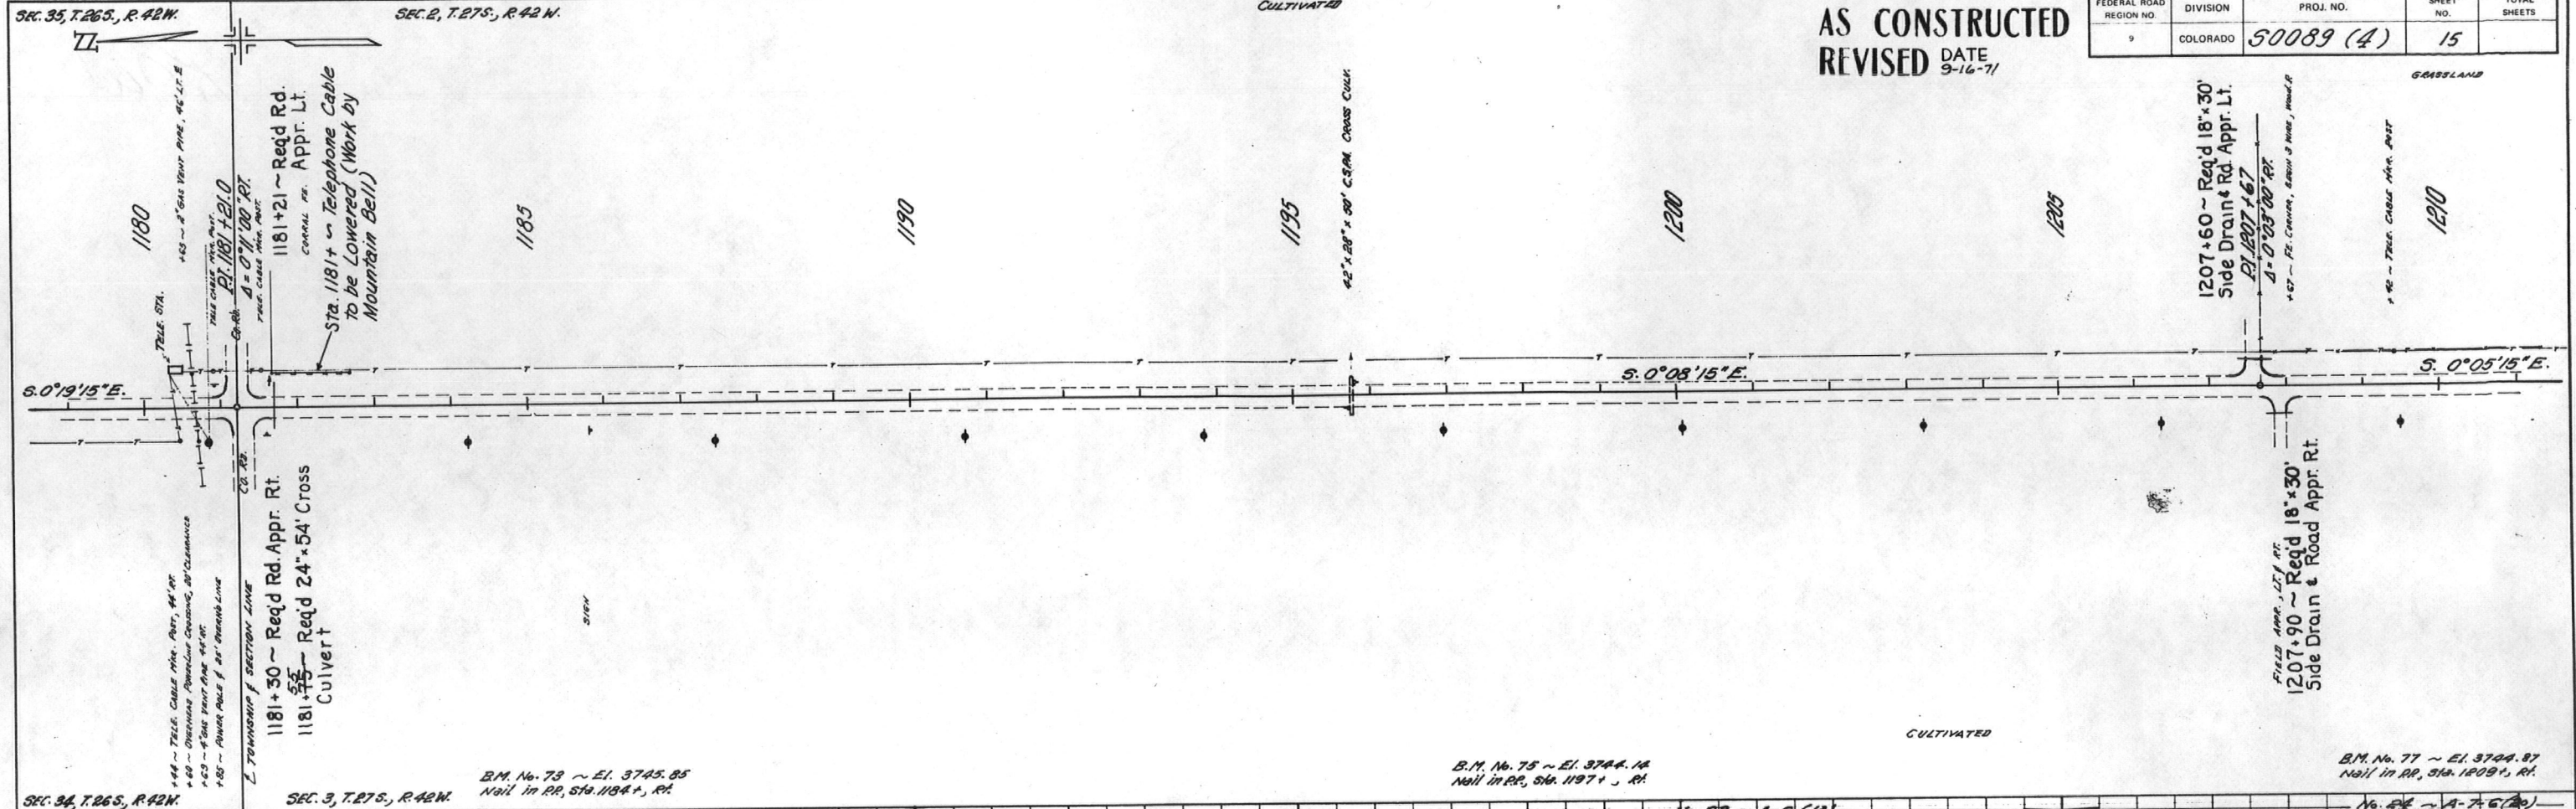

PLAN

DATE: _____ BY: _____

REVISIONS:

NO. 1: _____

NO. 2: _____

NO. 3: _____

NO. 100: _____

PROFILE

DATE: _____ BY: _____

REVISIONS:

NO. 1: _____

NO. 2: _____

NO. 3: _____

NO. 100: _____

FEDERAL ROAD REGION NO.	DIVISION	PROJ. NO.	SHEET NO.	TOTAL SHEETS
9	COLORADO	50089 (4)	15	


DATE: _____ BY: _____
 PLAN
 SURVEIL:
 NOTE BOOK ALUMINUM CHECKED:
 NO. 314238 BY: OF WAY CHECKED:

DATE: _____ BY: _____
 PROFILE
 SURVEIL:
 NOTE BOOK ALUMINUM CHECKED:
 NO. _____ BY: OF WAY CHECKED:

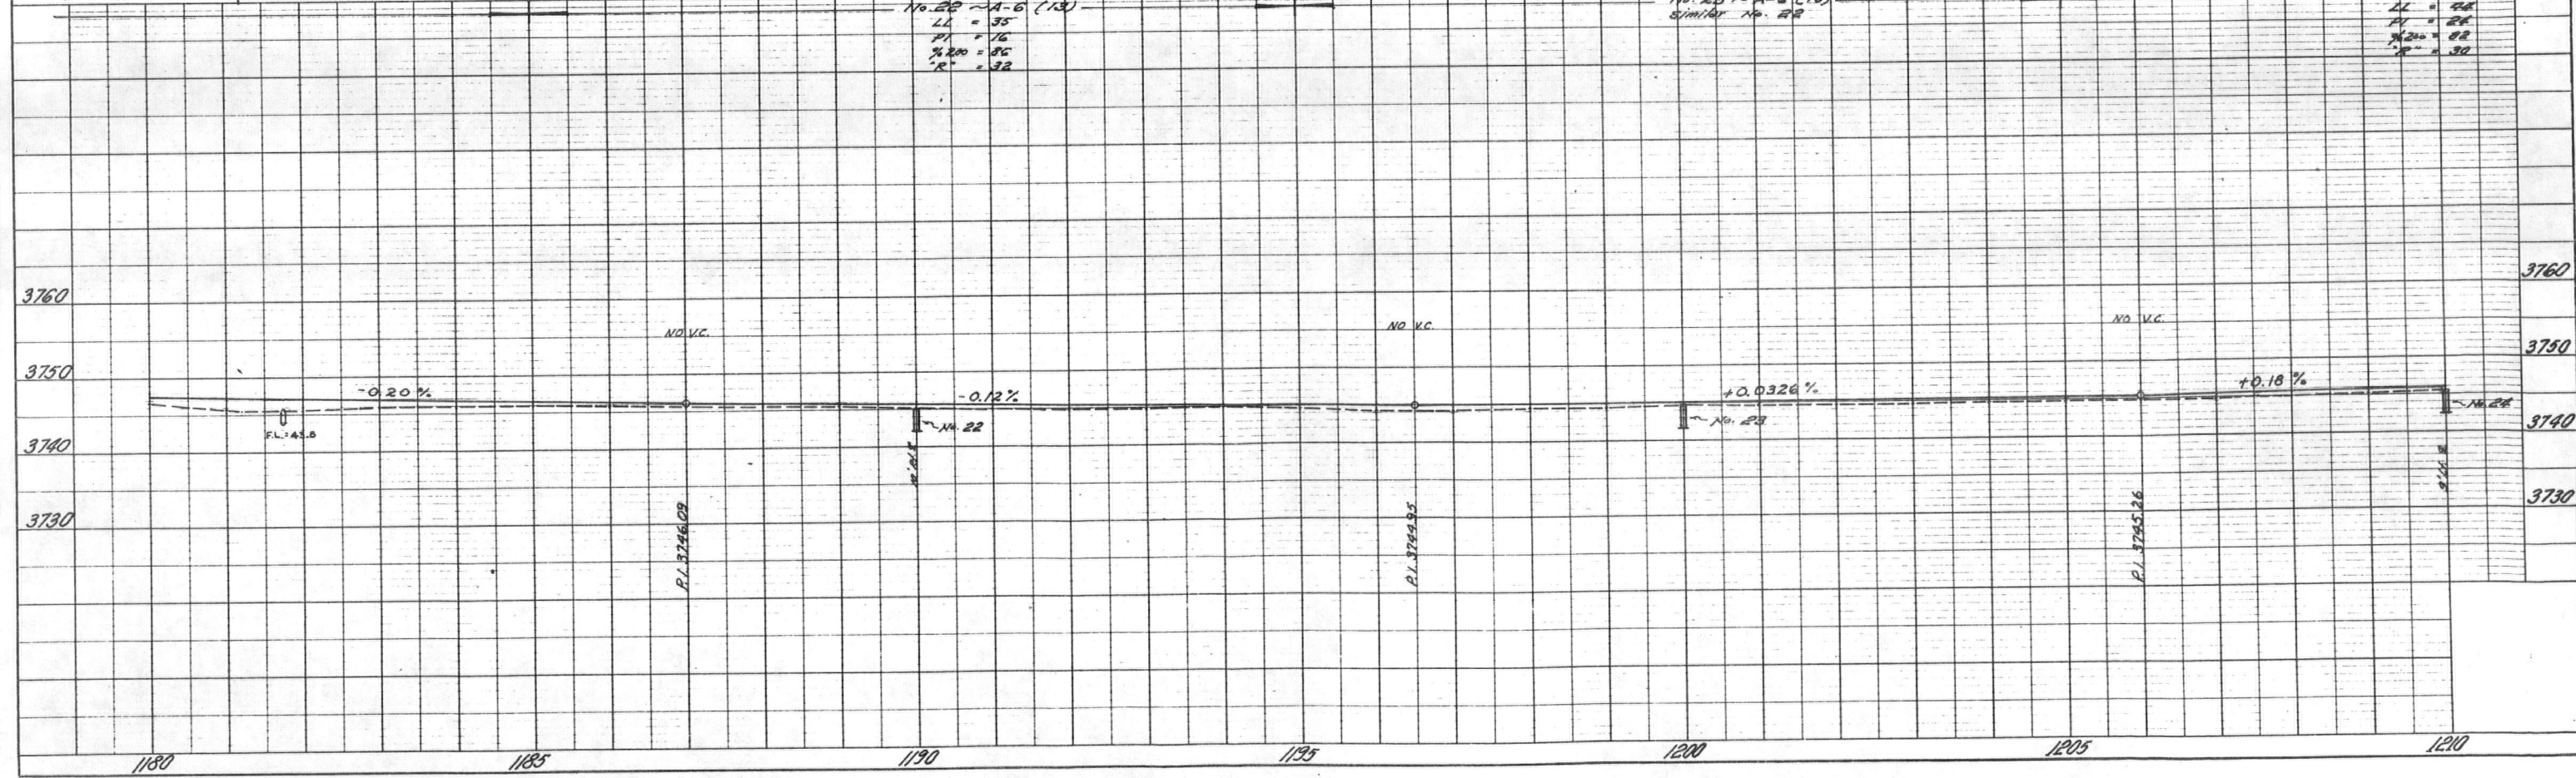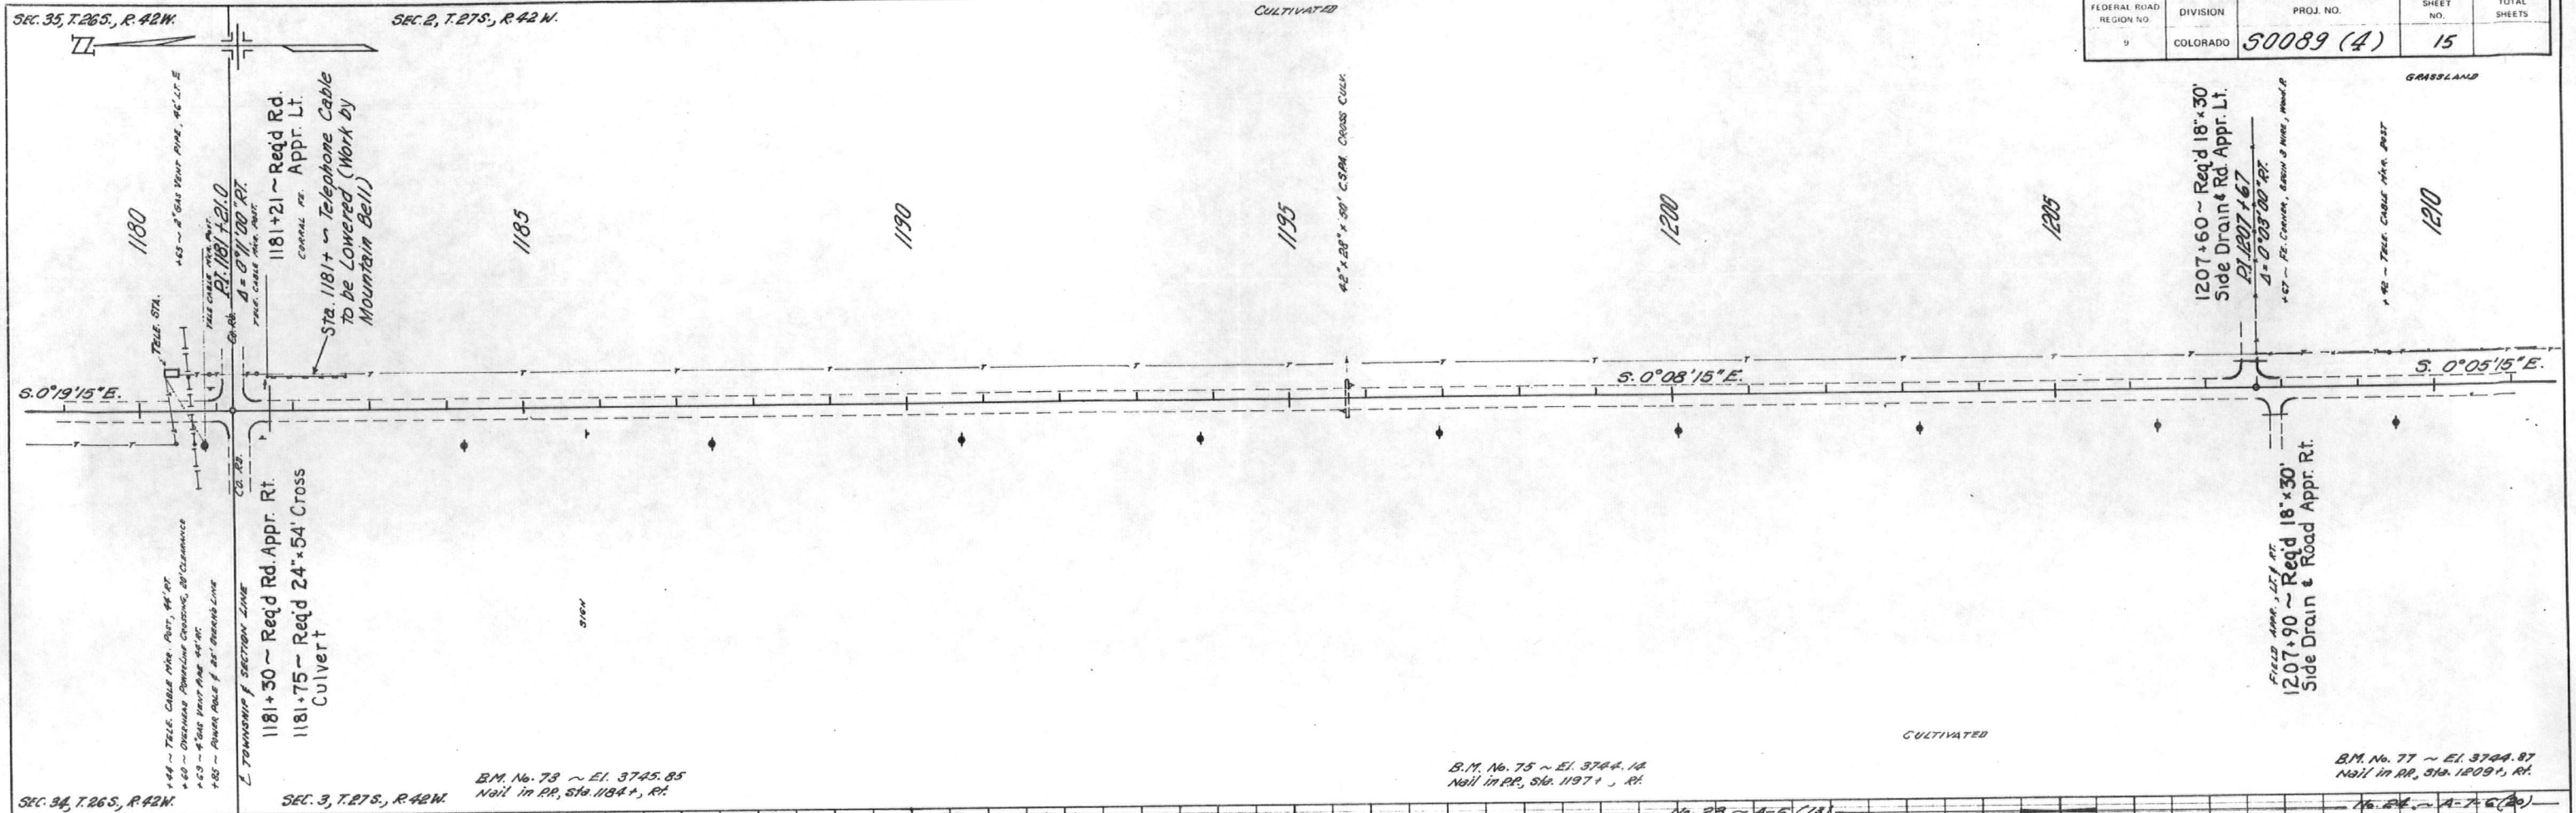

PLAN	DATE	
	BY	
	CHECKED	
	NO. OF SHEETS	

PROFILE	DATE	
	BY	
	CHECKED	
	NO. OF SHEETS	

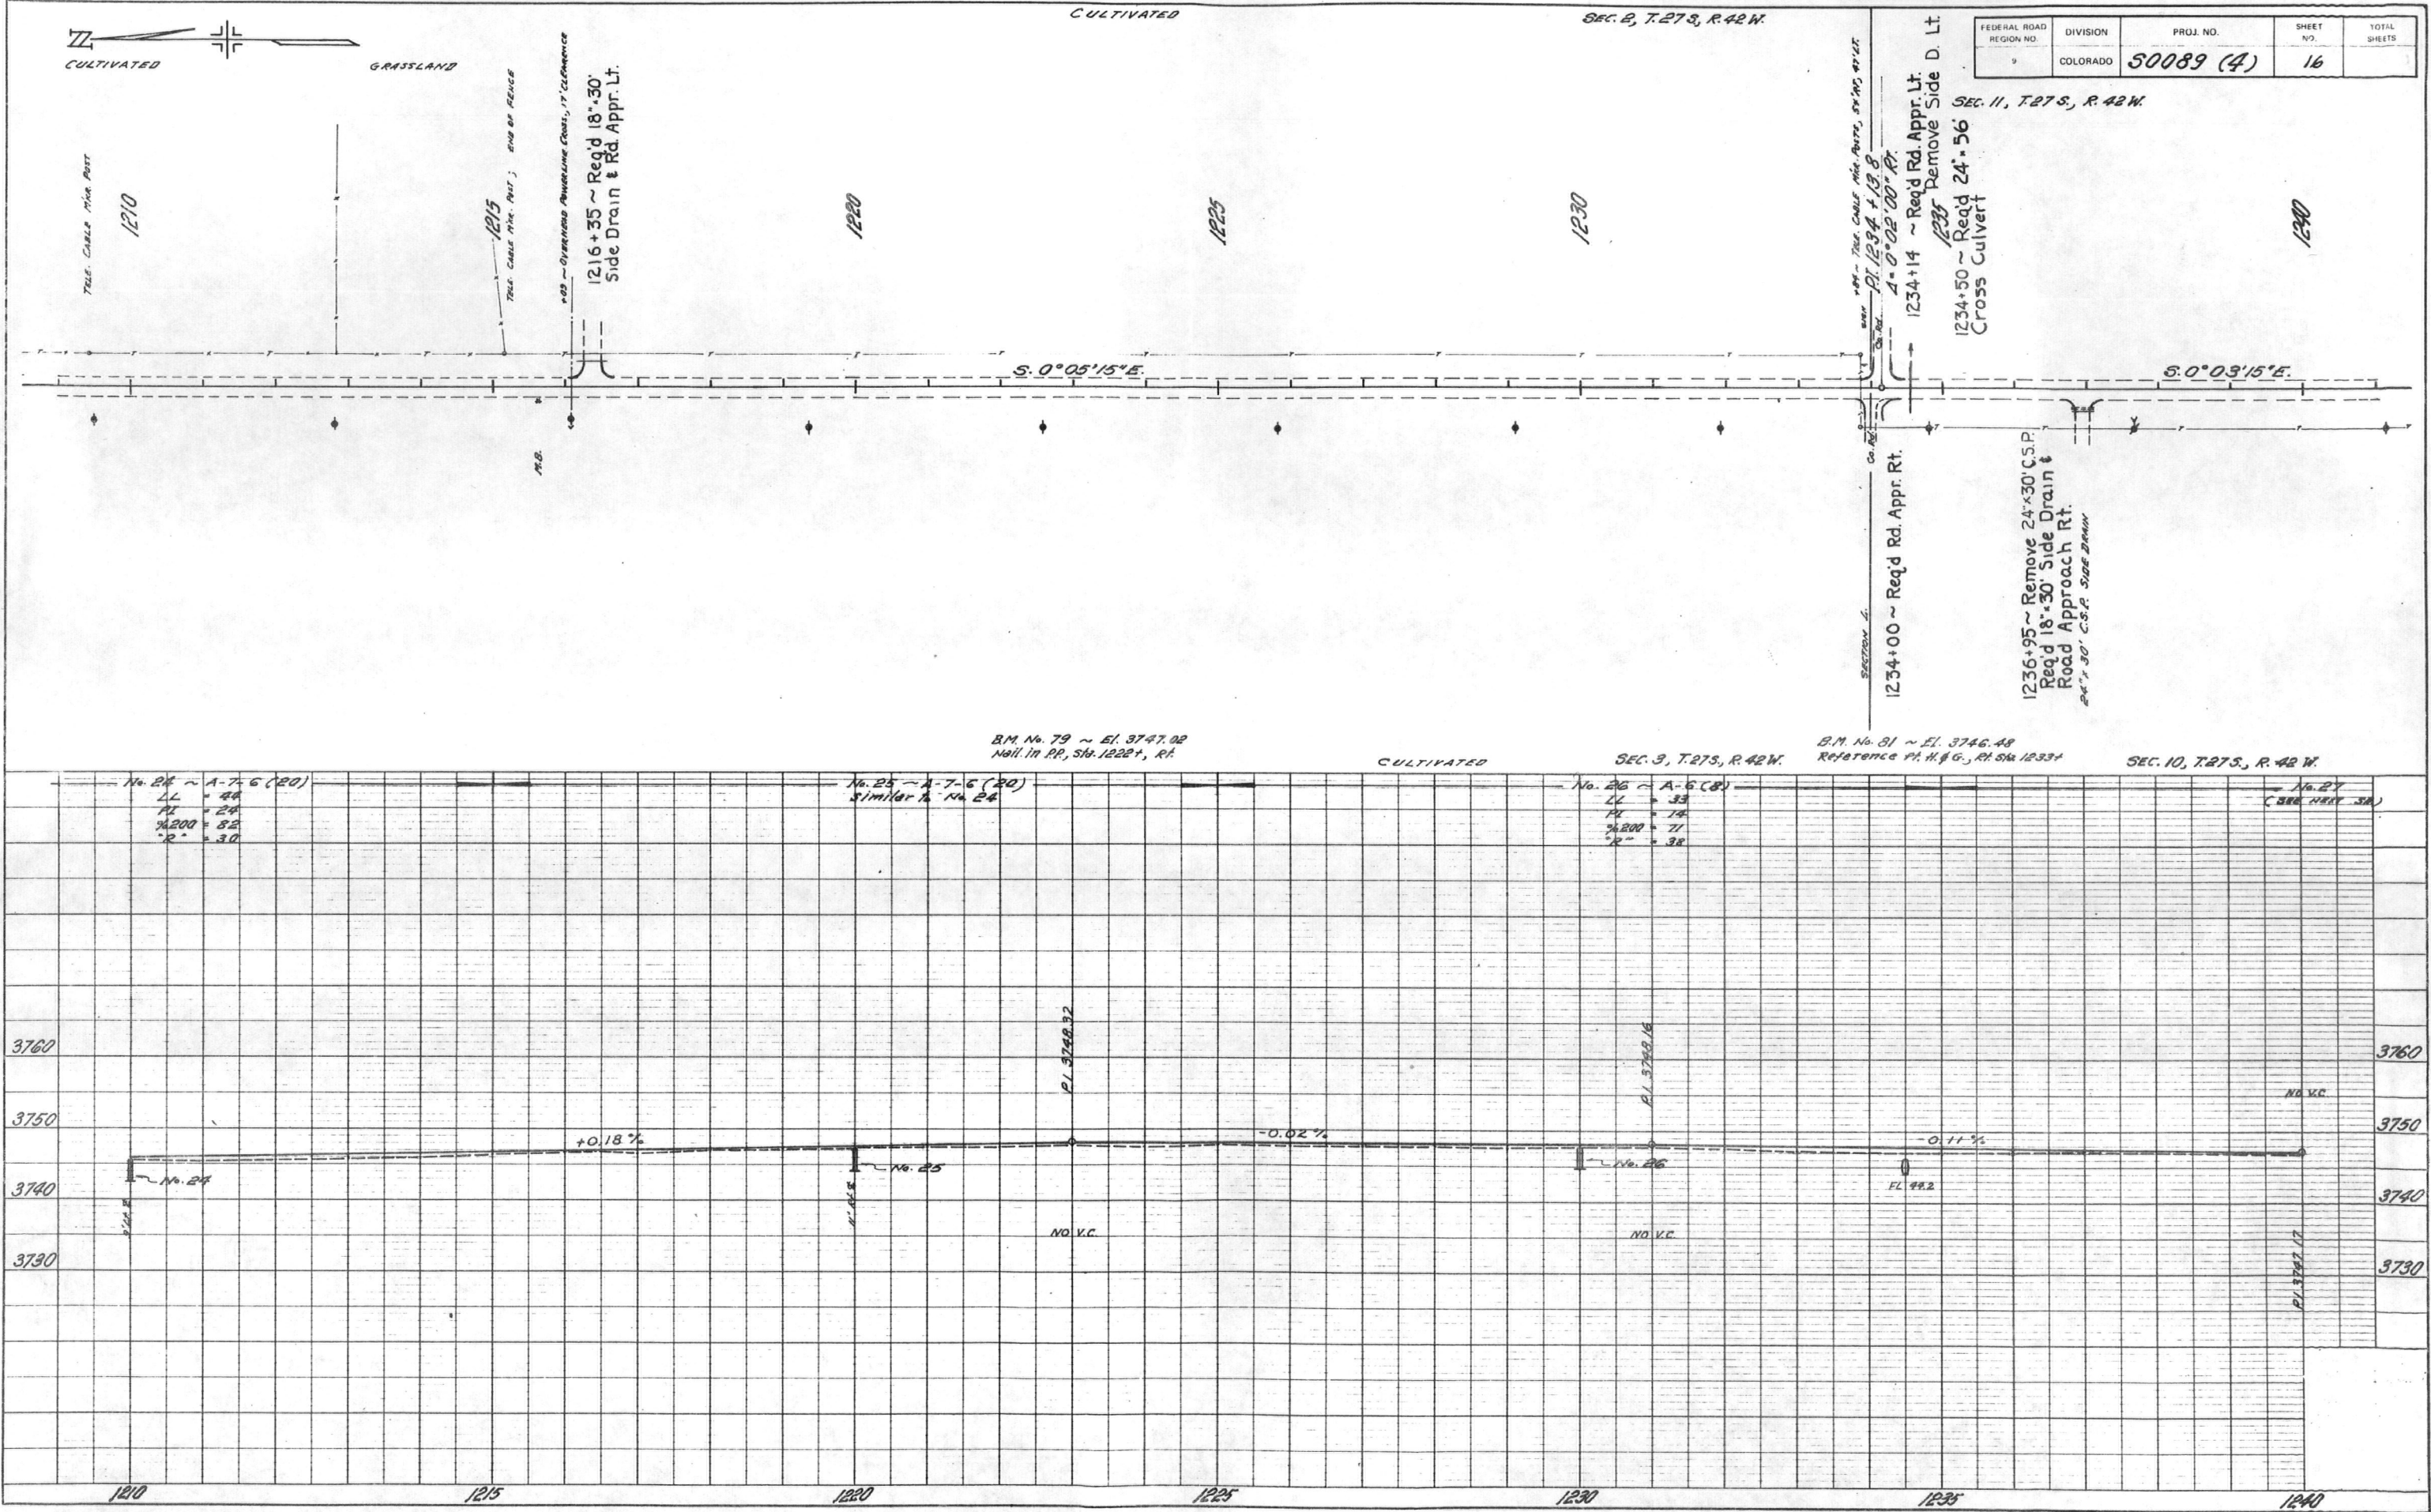

FEDERAL ROAD REGION NO.	DIVISION	PROJ. NO.	SHEET NO.	TOTAL SHEETS
9	COLORADO	50089 (4)	16	

1210

1215

1220

1225

1230

1240

S. 0° 05' 15\"/>

S. 0° 03' 15\"/>

B.M. No. 79 ~ El. 3747.02
Nail in RR, Sta. 1222+, RA.

SEC. 3, T.27S, R. 42W.

B.M. No. 81 ~ El. 3746.48
Reference Pt. H. & G., RA. Sta. 1233+

SEC. 10, T.27S, R. 42W.

No. 24 ~ A-7.6 (20)
LL = 44
HL = 24
X200 = 82
R = 30

No. 25 ~ A-7.6 (20)
Similar to No. 24

No. 26 ~ A-6 (8)
LL = 33
HL = 14
X200 = 71
R = 32

No. 27
(See next sheet)

3760

3750

3740

3730

3760

3750

3740

3730

1210

1215

1220

1225

1230

1235

1240

+0.18%

-0.02%

-0.11%

PL 3748.92

PL 3749.18

NO V.C.

NO V.C.

NO V.C.

NO V.C.

No. 24


No. 25

No. 26

FL 442


PL 3747.17

FEDERAL ROAD REGION NO.	DIVISION	PROJ. NO.	SHEET NO.	TOTAL SHEETS
9	COLORADO	50089 (4)	17	

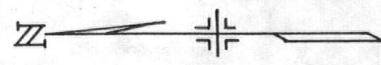

CULTIVATED

PLAN
 DATE: _____ BY: _____
 CHECKED: _____
 NOTE BOOK ALUMINUM CHECKED: _____
 NO. 31428

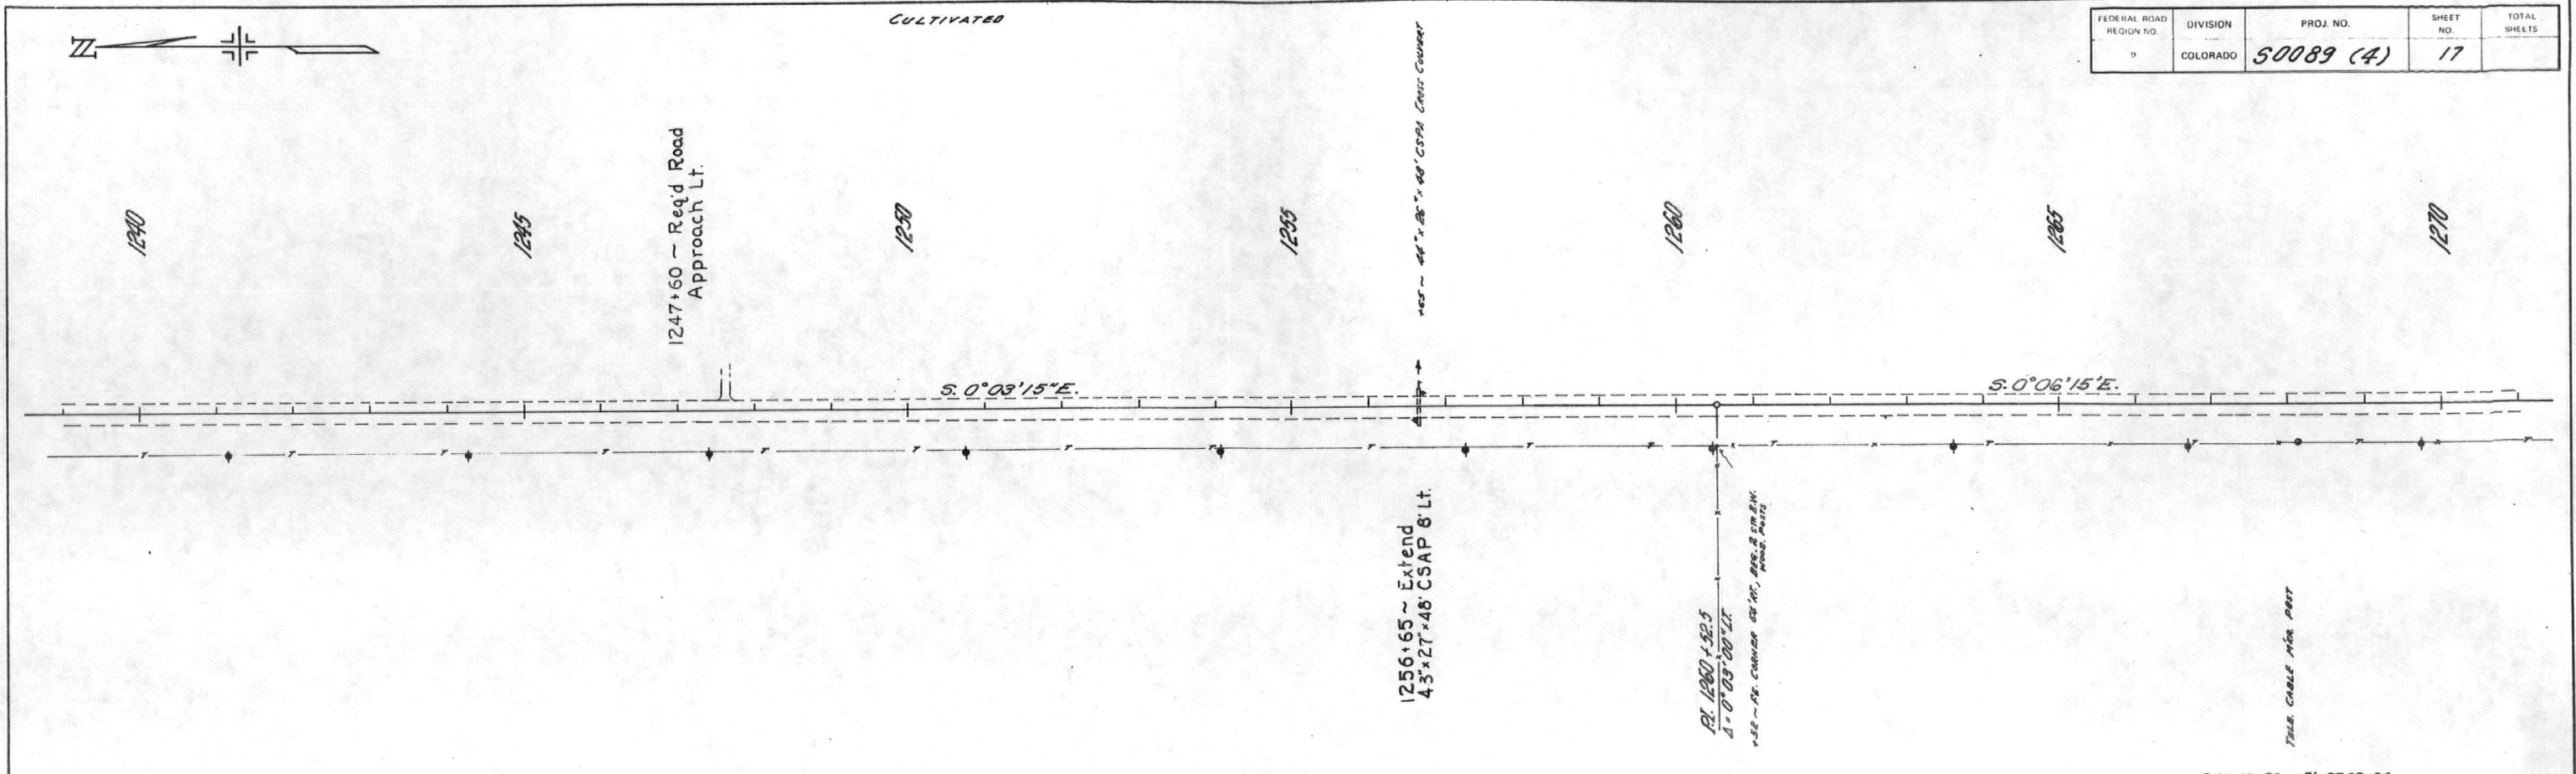

B.M. No. 82 ~ EL. 3746.22
 Nail in RR, Sta. 1241+, RT.


B.M. No. 84 ~ EL. 3745.10
 Nail in RR, Sta. 1254+, RT.

B.M. No. 86 ~ EL. 3749.04
 Nail in RR, Sta. 1266+, RT.

CULTIVATED

GRASSLAND


PROFILE
 DATE: _____ BY: _____
 CHECKED: _____
 NOTE BOOK ALUMINUM CHECKED: _____
 NO. 31428

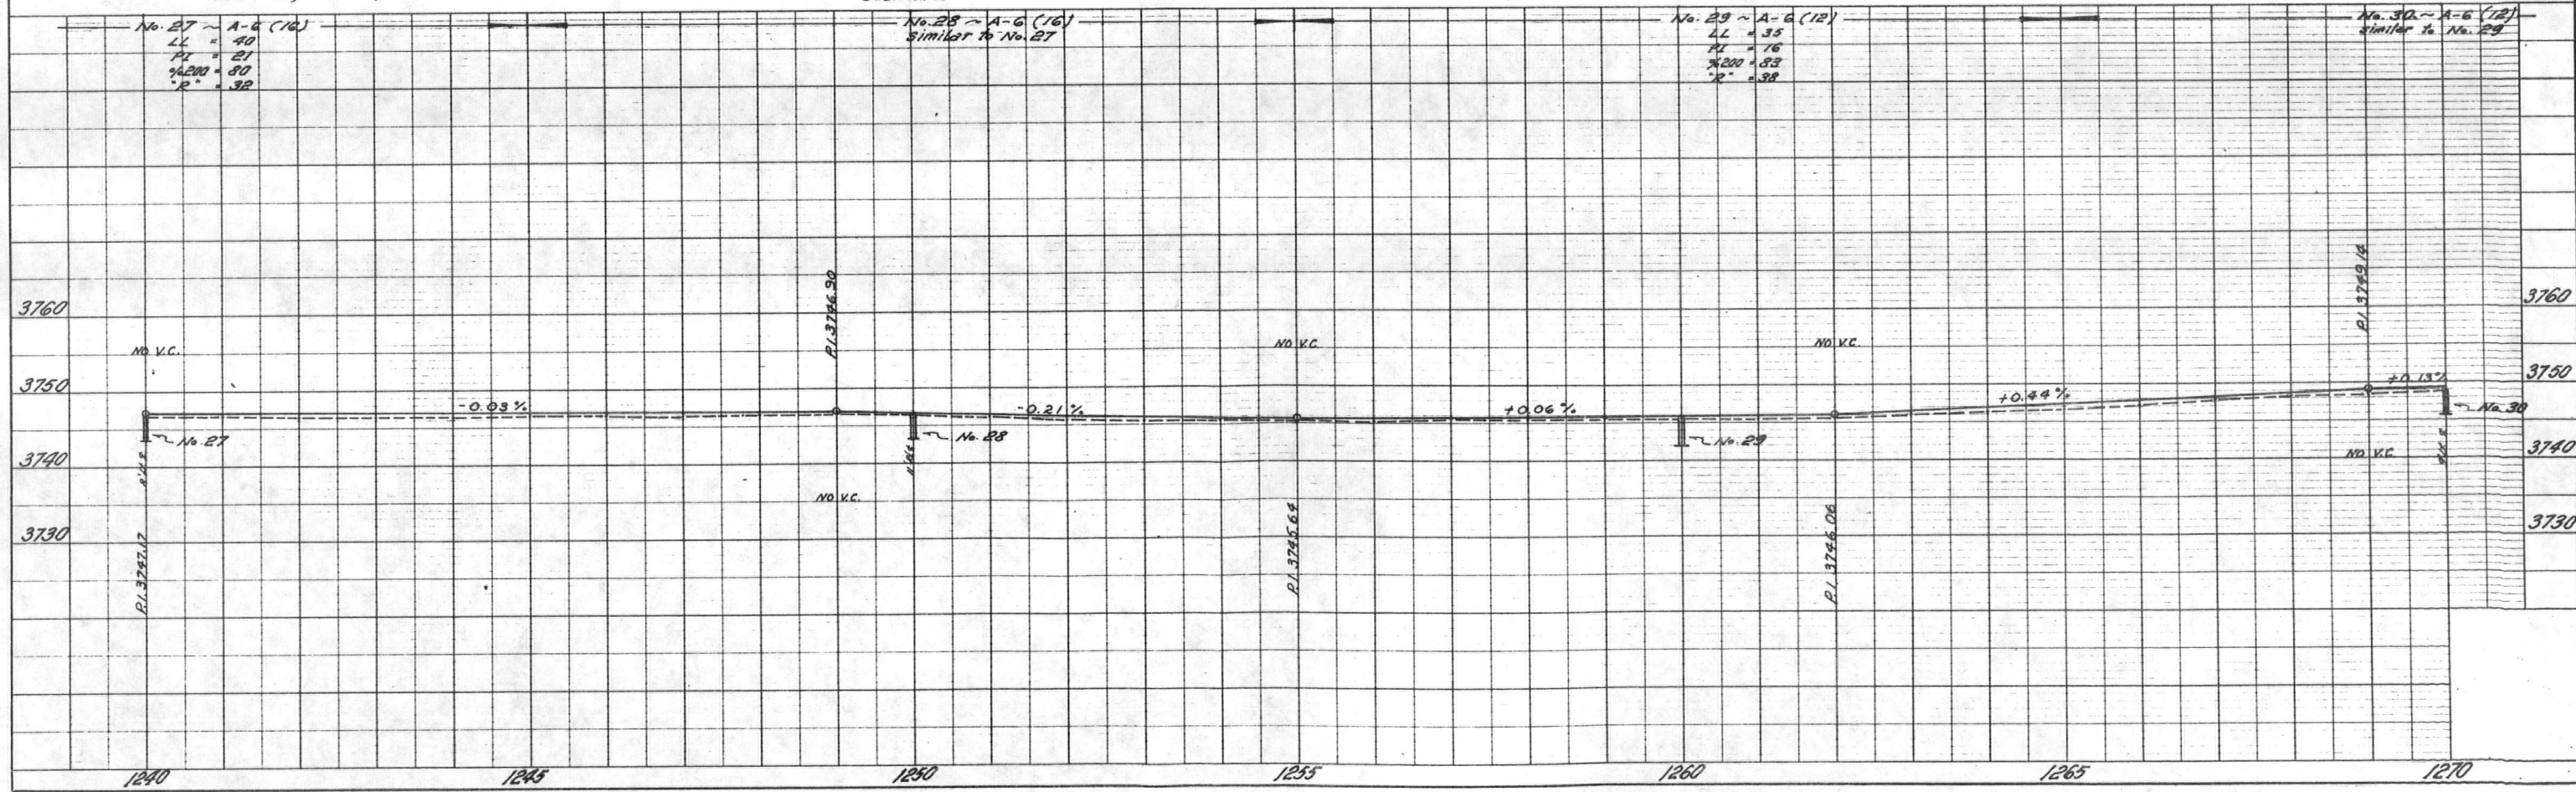

FEDERAL ROAD REGION NO.	DIVISION	PROJ. NO.	SHEET NO.	TOTAL SHEETS
9	COLORADO	50089 (4)	18	

PLAN
DATE: _____ BY: _____
REVISIONS:
NO. 1: _____
NO. 2: _____
NO. 3: _____
NO. 100: _____

PROFILE
DATE: _____ BY: _____
REVISIONS:
NO. 1: _____
NO. 2: _____
NO. 3: _____
NO. 100: _____

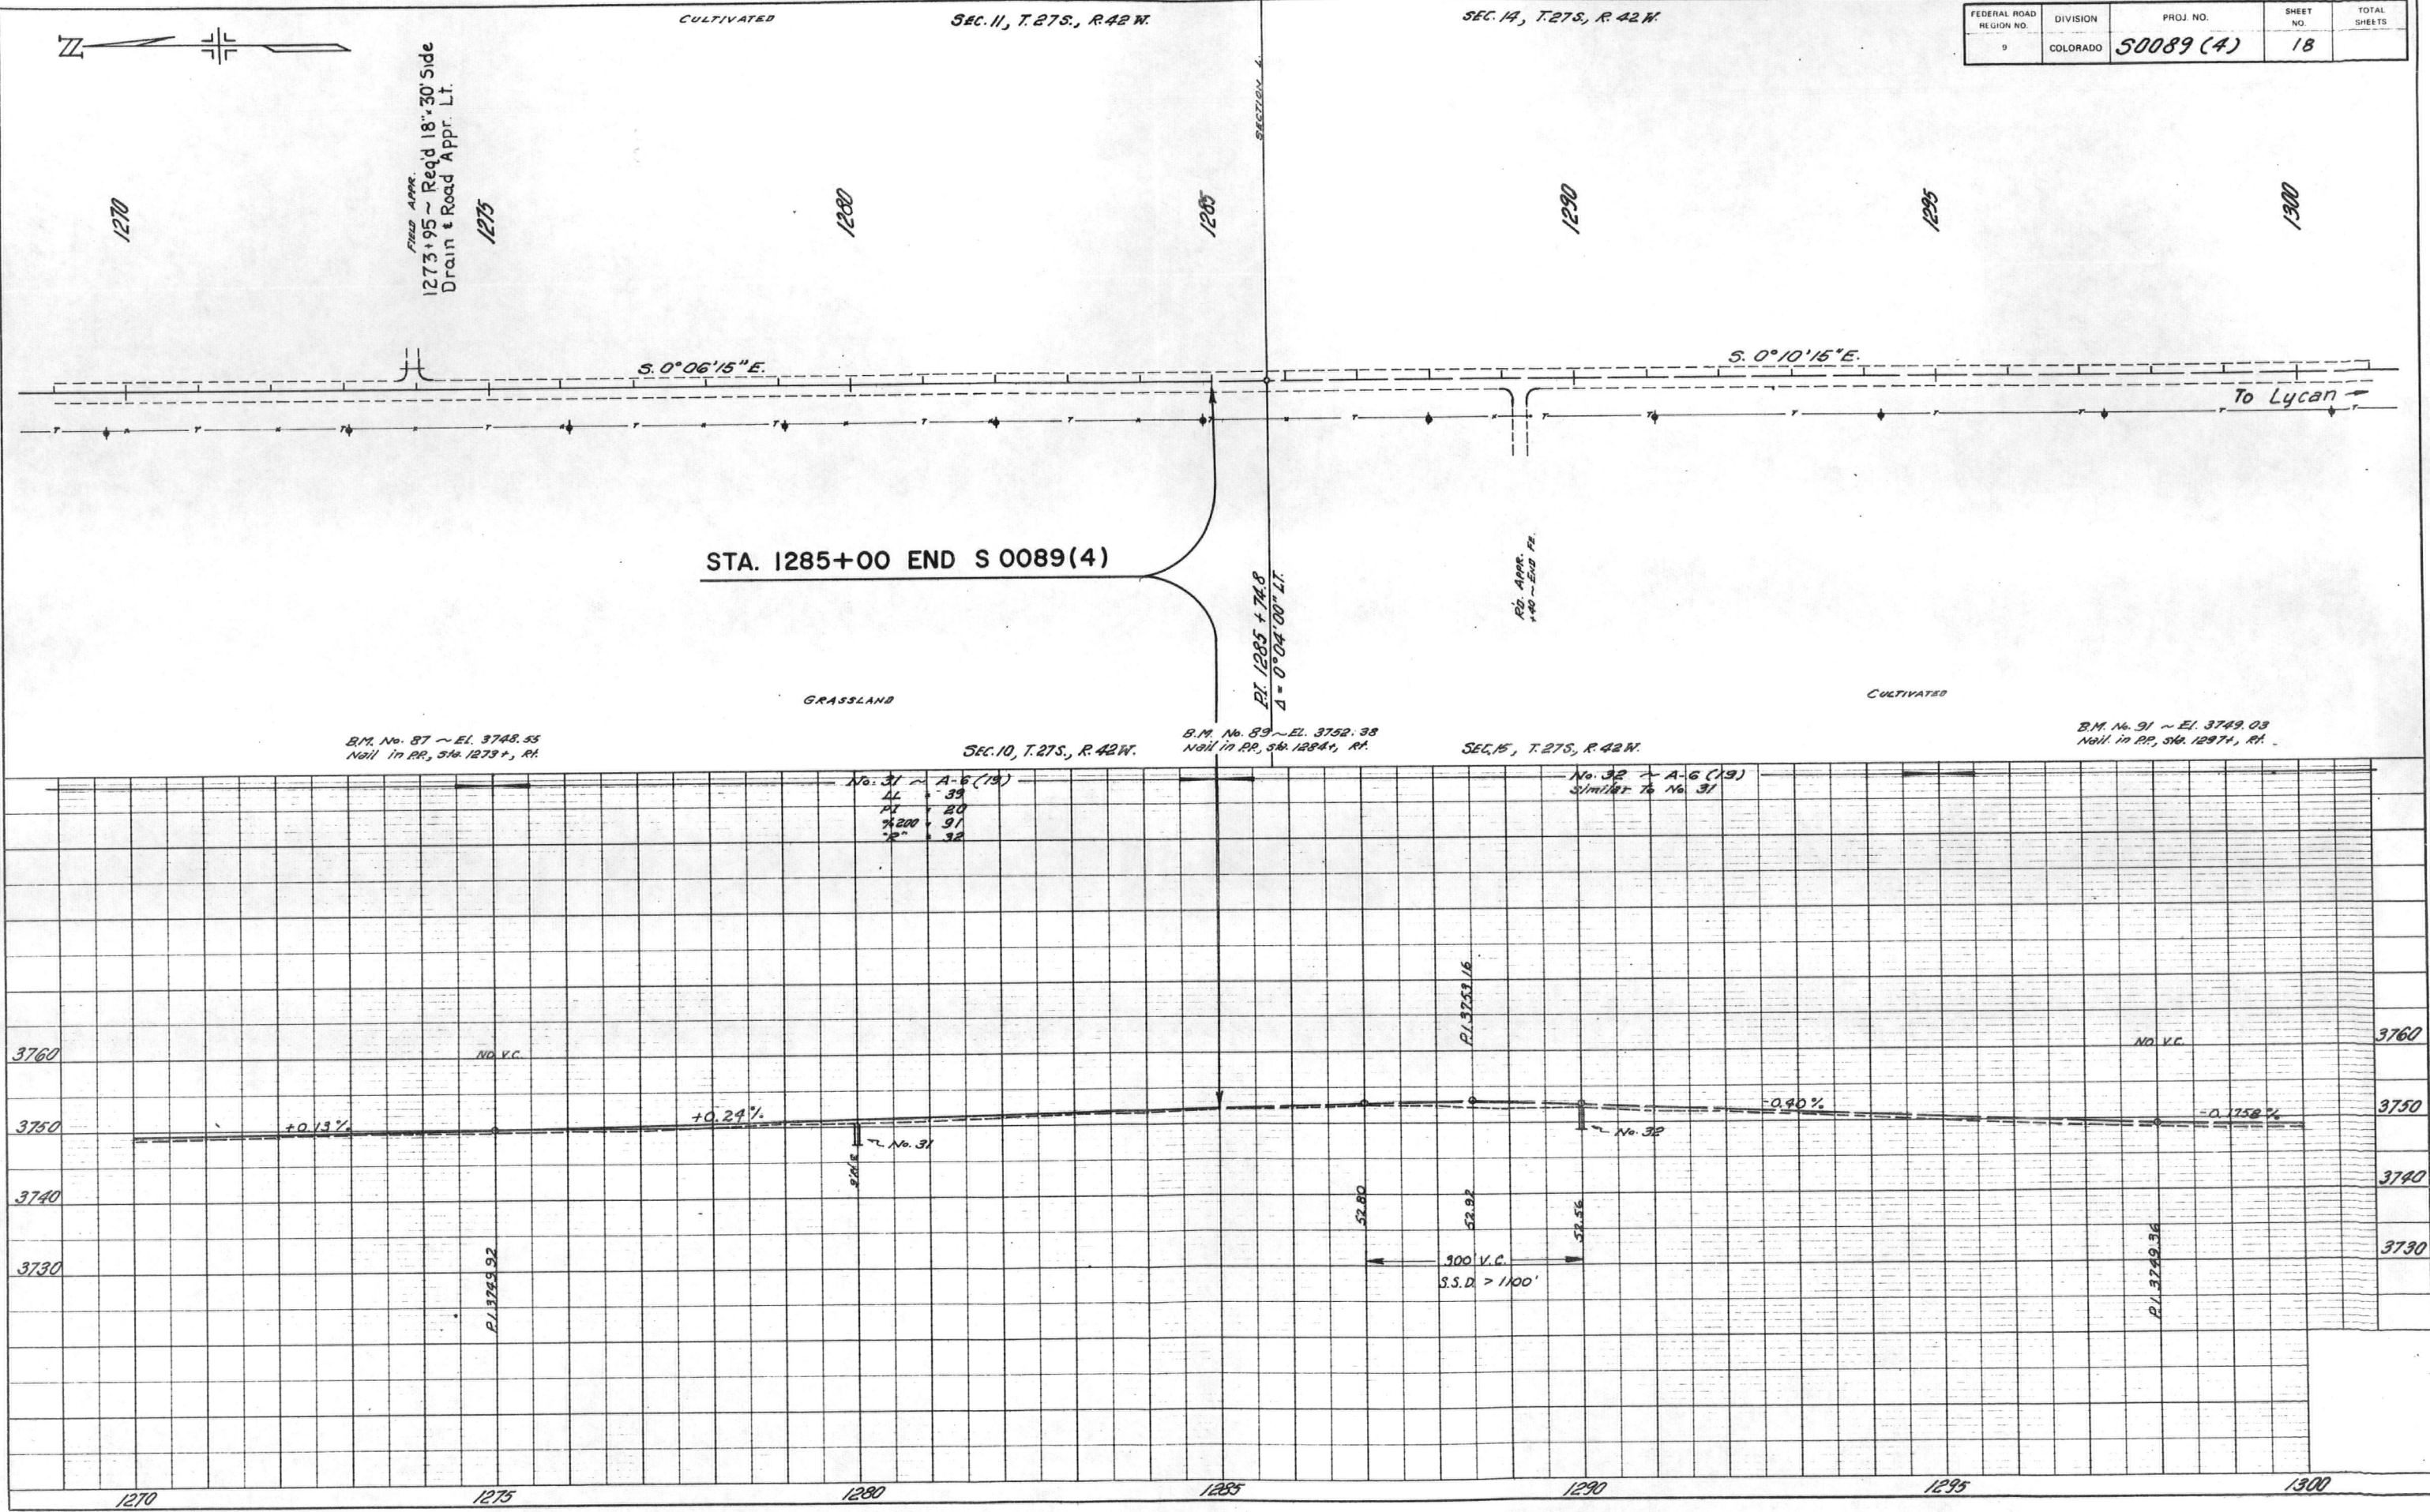

STA. 1285+00 END S 0089(4)

No. 31	A-6 (19)
4L	39
4R	20
4200	91
42	32

No. 32 ~ A-6 (19)
Similar to No. 31


STANDARD SIDE APPROACH ROADS, FLARING, CUT SLOPE TREATMENT & WIDENING AT BRIDGES AND AT CREST OF GRADES

STANDARD M-203-B (JULY 1, 1965)

FED. ROAD REG. NO.	DIVISION	PROJECT NO.	SHEET NO.
9	COLO.		



REVISIONS			
(R-1)	2-6-68	Median Cross Over	MRH
(R-2)	7-30-68	Dept. Name	MRH
(R-3)	4-1-69	Widening for Guard Rail	MRH
(R-4)	4-27-70	Cut Slope and Note	MRH

GENERAL DETAILS FOR FLARING OF EARTH CUTS, CUT SLOPE TREATMENT & WIDENING AT BRIDGES

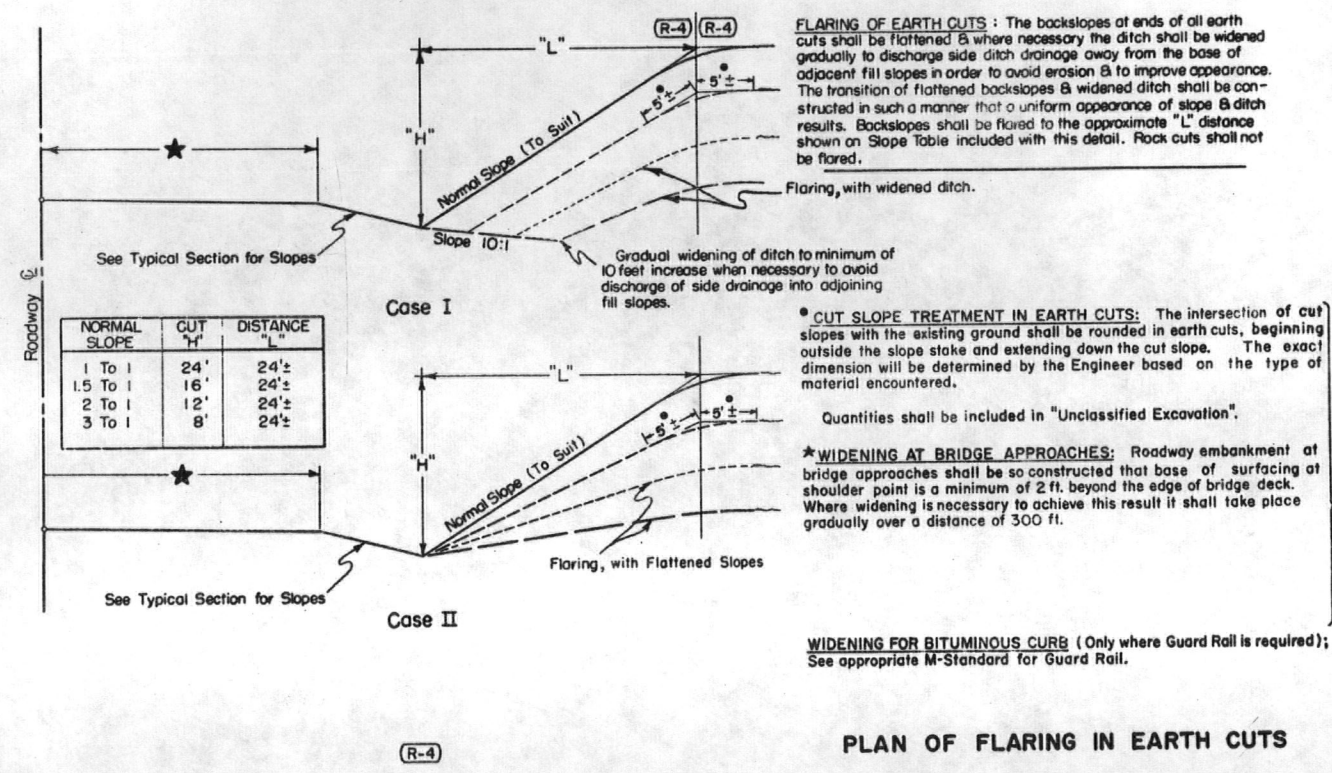


PLAN OF FLARING IN EARTH CUTS

TYPICAL PLANS FOR SIDE APPROACH ROADS AND EMERGENCY MEDIAN CROSS OVERS

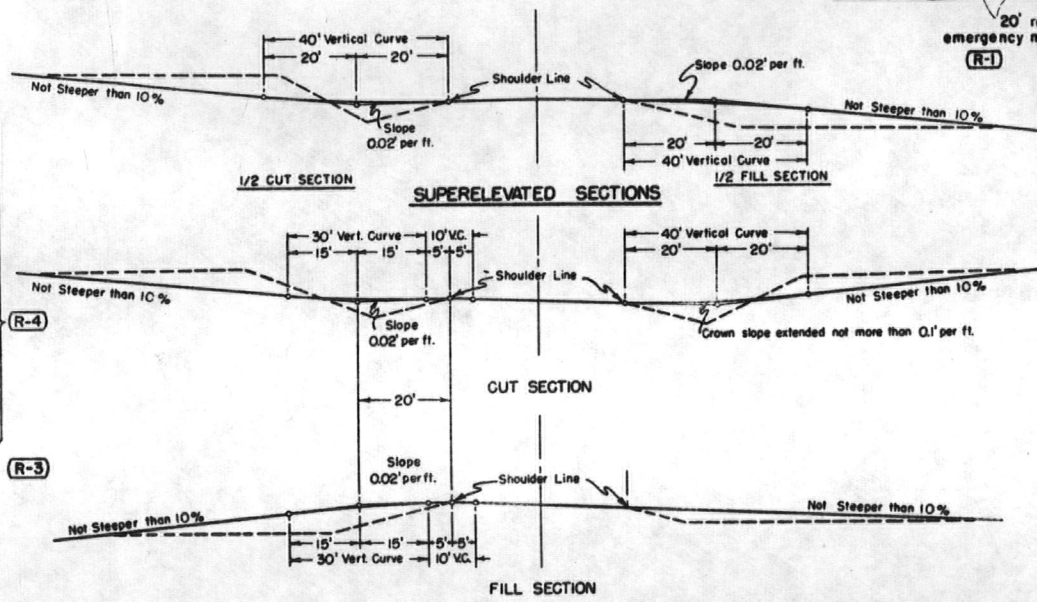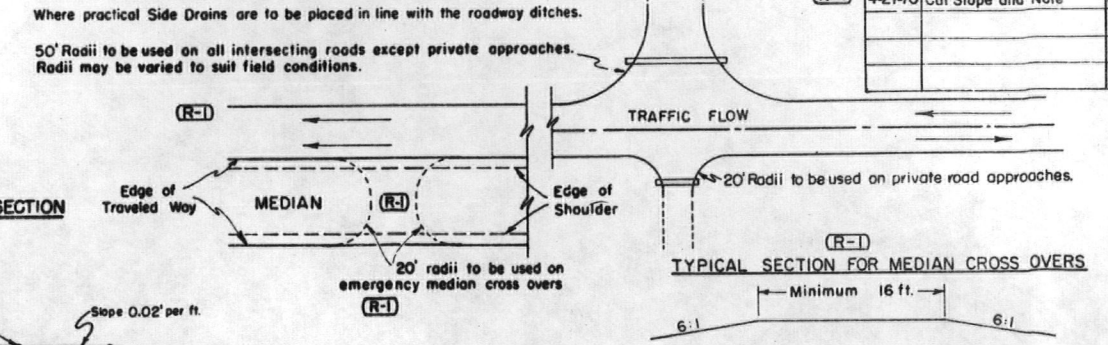

DETAILS FOR DITCH & WIDENED SHOULDERS AT CREST OF GRADES (TO BE USED ONLY WHERE SIGHT DISTANCE AT CREST OF GRADE IS 600 FT. OR LESS)

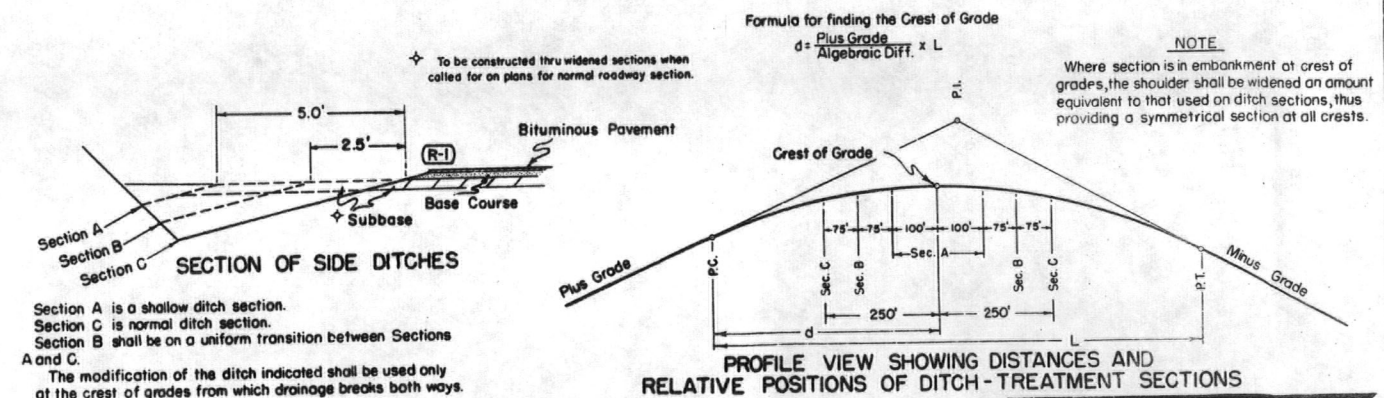

GENERAL NOTES

All work shall be done in accordance with the Standard Specifications applicable to the Project.

All side approach roads to the Project shall be Gravel Surfaced with a 4 inch thickness of Aggregate Base Course extending approximately to the Right of Way Line. Estimated tonnage and class of material required for this operation are shown in the Aggregate Base Course Plan.

The maximum grades shown are to be the limiting grades for all road approaches. Modifications of grades will be permitted where adherence to the grades as shown would cause damage to property or create other unsatisfactory conditions. Grades flatter than the maximum shown are to be used wherever feasible.

DEPARTMENT OF HIGHWAYS
STATE OF COLORADO
DIVISION OF HIGHWAYS

APPROACH ROADS,
FLARING, CUT SLOPE TREATMENT,
BRIDGE & CREST WIDENING

Designed by A. Z.
Made by SJM BASH
Checked by C.R.S.

Approved by [Signature]
Staff Design Engr.
Date: July 1, 1965.


STANDARD TYPES OF DITCHES and CONSTRUCTION METHODS

STANDARD M-203-C
(JULY 1, 1965)

FED. ROAD RE. NO.	DIVISION	PROJECT NO.	SHEET NO.
9.	COLO.		

DETAILS for CONTOUR INTERCEPTING DITCHES

Typical Section for Contour Intercepting Ditches

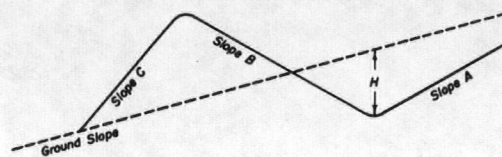

PURPOSE & USE OF THE TABLE

The primary purpose of the information for Contour and Intercepting Ditches shown on this sheet is to serve as a guide in construction and to readily arrive at yardages of excavation involved. Foremost consideration in constructing these ditches is given first to the natural ground line slope confronted in construction, thence to the other values shown on the Typical Section. By properly arriving at the combination of values shown on the Typical Section and in the Table for a specified condition, the number of cubic yards of excavation per 100 lin. ft. of ditch may be read under the appropriate column for this item.

Typical Construction Layouts


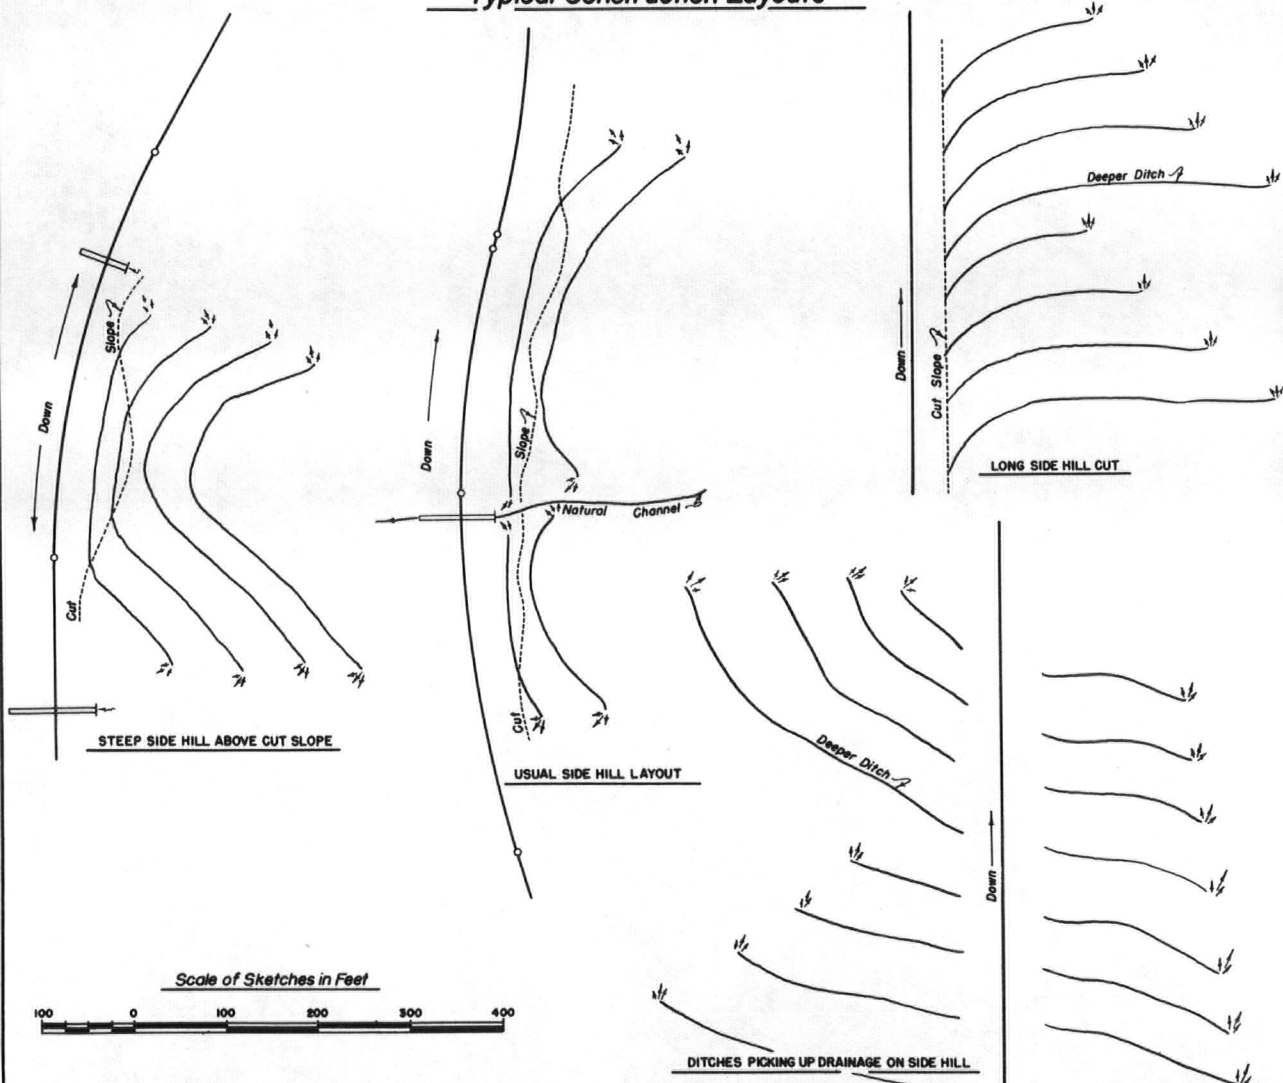


Table of Slopes and Yardages

Ground	SLOPES			H	Cubic Yards per 100 lin. ft. of Ditch		
	A	B	C				
5:1 Or Flatter	2:1	4:1	2:1	15"	16		
				18"	23		
				21"	32		
	1-1/2:1	3:1	2:1	15"	15		
				18"	22		
				21"	30		
		2:1	1-1/2:1	1-1/2:1	15"	14	
					18"	20	
					21"	27	
	1-1/2:1	4:1	1-1/2:1	15"	13		
				18"	19		
				21"	25		
3:1		2:1	1-1/2:1	15"	12		
				18"	18		
				21"	25		
4:1	2:1	4:1	2:1	15"	12		
				18"	17		
				21"	23		
	3:1	2:1	1-1/2:1	1-1/2:1	15"	10	
					18"	15	
					21"	20	
		1-1/2:1	4:1	1-1/2:1	1-1/2:1	15"	10
						18"	14
						21"	19
	3:1	2:1	3:1	2:1	15"	17	
					18"	25	
					21"	34	
1-1/2:1		3:1	2:1	1-1/2:1	15"	17	
					18"	24	
					21"	32	
		2:1	1-1/2:1	1-1/2:1	1-1/2:1	15"	15
						18"	22
						21"	30
2:1		1-1/2:1	4:1	1-1/2:1	15"	21	
					18"	29	
					21"	38	
	3:1	3:1	2:1	1-1/2:1	15"	13	
					18"	18	
					21"	25	
		2:1	1-1/2:1	1-1/2:1	1-1/2:1	15"	12
						18"	17
						21"	23
	3:1	2:1	3:1	2:1	15"	11	
					18"	16	
					21"	21	
1-1/2:1		2:1	1-1/2:1	1-1/2:1	15"	10	
					18"	14	
					21"	20	
		1-1/2:1	3:1	1-1/2:1	1-1/2:1	15"	22
						18"	31
						21"	43
2:1		1-1/2:1	2:1	1-1/2:1	15"	21	
					18"	30	
					21"	41	
	1-1/2:1	2:1	1-1/2:1	1-1/2:1	15"	20	
					18"	29	
					21"	40	
		1-1/2:1	3:1	1-1/2:1	1-1/2:1	15"	13
						18"	19
						21"	26
	1-1/2:1	1:1	2:1	1:1	15"	12	
					18"	17	
					21"	24	
1-1/2:1		1-1/2:1	1-1/2:1	1-1/2:1	15"	12	
					18"	17	
					21"	23	
		1-1/2:1	1:1	1-1/2:1	1:1	15"	20
						18"	29
						21"	40
1-1/2:1			1:1	1-1/2:1	1:1	15"	9
						18"	13
						21"	17
	1-1/2:1	1-1/2:1	1-1/2:1	1-1/2:1	15"	8	
					18"	12	
					21"	16	
	1-1/2:1	1:1	1-1/2:1	1:1	15"	11	
					18"	16	
					21"	21	


Slopes are approximate and may be varied to suit conditions encountered during construction.

TYPICAL SECTIONS for DRAINAGE, IRRIGATION DITCHES and CHANNEL CHANGES

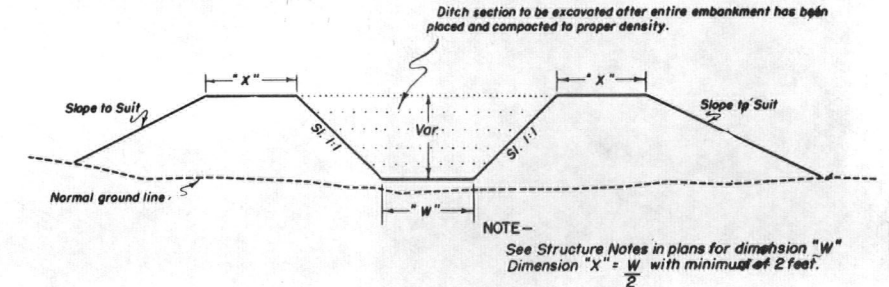

For Embankment Sections

(Generally for use in Irrigation Ditches & Channel Changes)

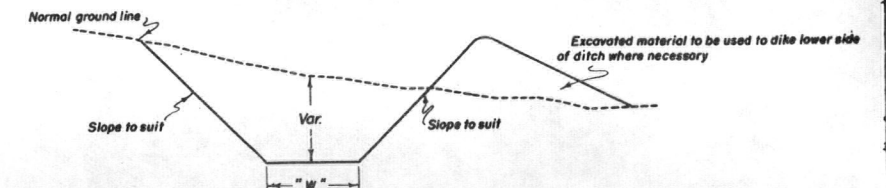

NOTE - Unless otherwise shown in Structure Notes of plans, dimension "W" = 1 foot.

For Cut Sections

REVISIONS			
(R-1)	7-23-68	Dept. Name	M.R.H.

GENERAL NOTES

- All work shall be done in accordance with the Standard Specifications applicable to the Project.
- All ditches are to be constructed to lines and grades as staked by the Engineer using the ditch section shown on plans or as ordered by the Engineer.
- CONTOUR INTERCEPTING DITCHES: Ditches are to be laid out along the ground contour on a grade of not over 1%. (Type of soil shall govern the grade).
- Ends of ditches are to be lined up so that concentration of flow from a higher contour ditch into one of lower contour is, as far as possible avoided. The use of a deeper ditch is recommended where this condition is encountered.
- The following horizontal spacing of ditches is recommended:
 - 4% to 6% Approximately 70' Centers
 - 8% to 10% Approximately 60' Centers
 - 20% to 4:1 Slope Approximately 55' Centers
 - 30% to 1-1/2:1 Slope Approximately 50' Centers
- Where ditch checks are required the intervening ditch between one set of ditch checks shall not exceed a grade of 1.0%. Details of checks will be shown on plans when required.

DEPARTMENT OF HIGHWAYS
STATE OF COLORADO
DIVISION OF HIGHWAYS

DITCH TYPES

Designed by C.G.M. Approved by *[Signature]*
Made by C.G.M. Staff Design Engr.
Checked by Date: July 1, 1965


STANDARD M-206-AA

(MARCH 1, 1971)
(SHEET 1 OF 2)

FED. ROAD REGION NO.	DIVISION	PROJECT NO.	SHEET NO.
9	COLO.		


REVISION	

CONCRETE BOX CULVERTS & WINGWALLS

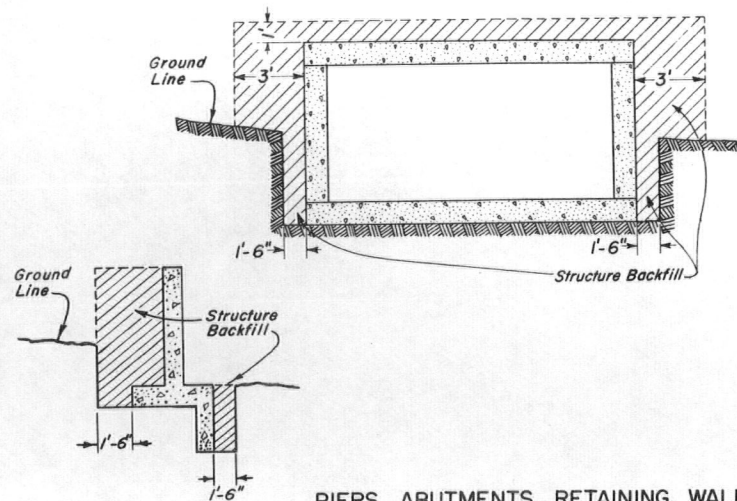


PIERS, ABUTMENTS, RETAINING WALLS ETC.

CAST IN PLACE CONDUIT

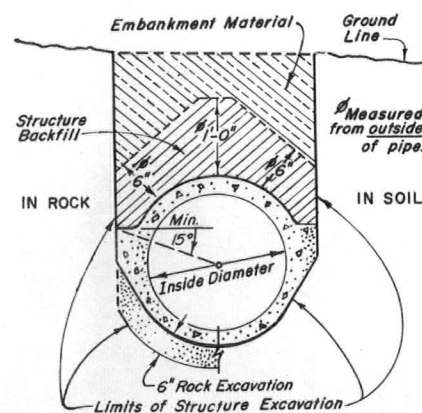


CIRCULAR CONDUIT

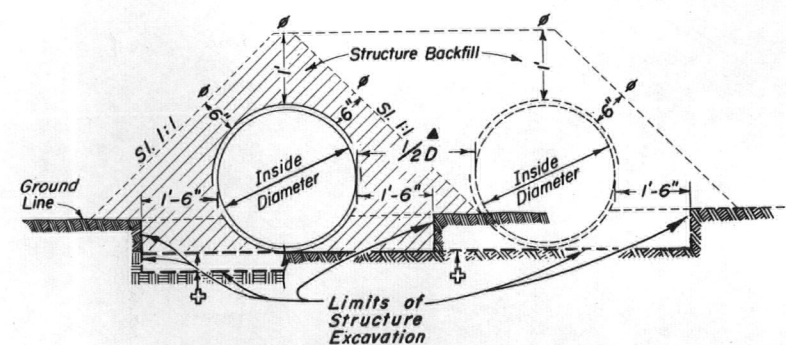

ELLIPTICAL OR ARCH CONDUIT

SIPHONS OR CONDUIT IN TRENCH

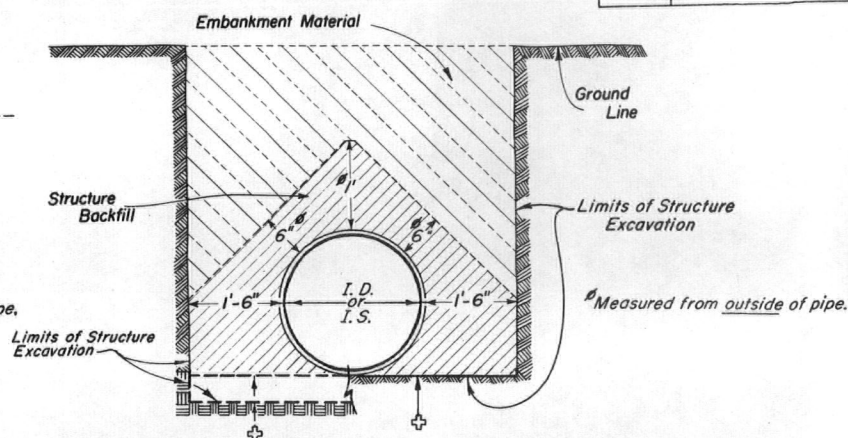

NOTES:

▲ When two or more conduits are laid side by side they shall be spaced so that the adjacent pipes will be $1/2$ I.D., $1/2$ I.S. or 3 feet apart (including wall thickness), whichever is less. Minimum spacing shall be not less than 1 foot between outside walls of pipe.
For additional culvert installation details see M Standards for metal, concrete, or structural plate pipe culverts.

⊕ Bottom of trench as excavated. For applicable limits of Structure Excavation, see bedding details on standards for culverts.

GENERAL NOTES


All work shall be done according to the Standard Specifications applicable to the Project.

Where the roadway cross section is in fill, excavation for concrete footings (except those in rock or those on piles) and for box culverts shall be done according to the following:
Embankment shall be built up and compacted to a point one foot above the bottom of the box or one foot above the bottom of the footing. The trench shall then be excavated to accommodate construction of the box or footing.


Excavation and backfill patterns different from those indicated on these sheets will be shown elsewhere on the plans.

Excavation for structure installation shall be classified as "Structure Excavation" unless otherwise shown on plans.


All material that is to be compacted shall be placed in horizontal layers not more than 6" inches in depth and compacted before the next layer is placed. For Arches, Rigid Frames and Box Culverts the fill shall be brought up uniformly on both sides of the center of structure to avoid stresses in the structure caused by unsymmetrical loading.

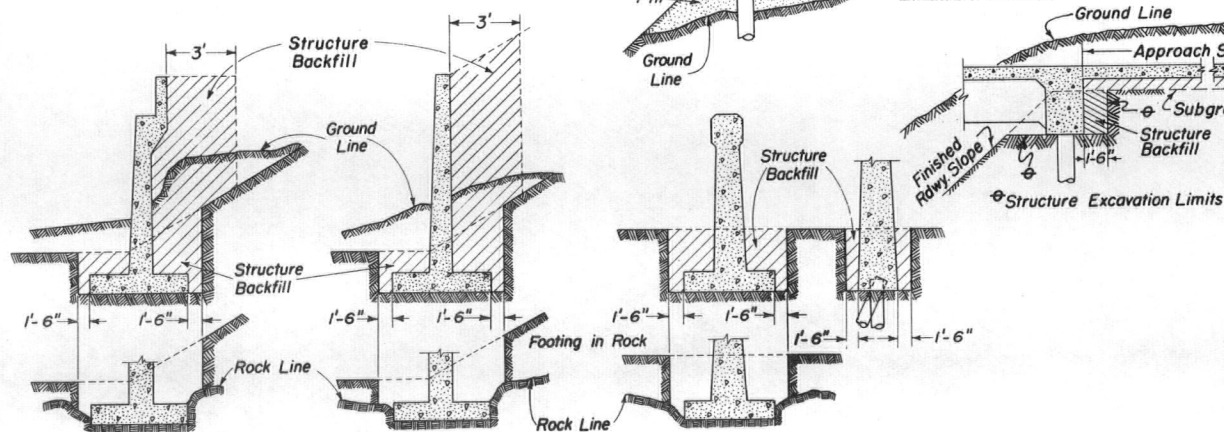

HEADWALLS AND END OF CULVERTS

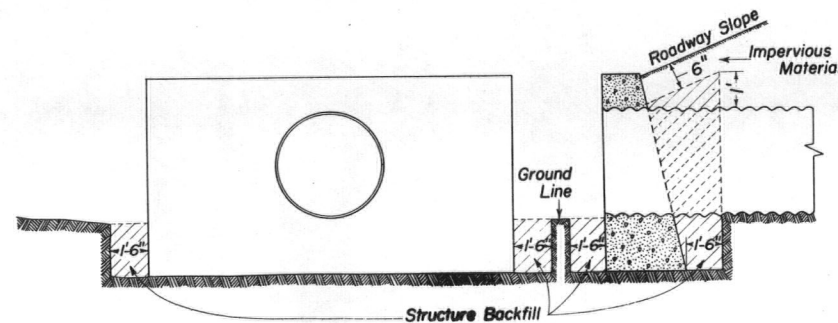


DROP INLETS, DIVISION BOXES, INTERCEPTING HEADWALLS, ETC.

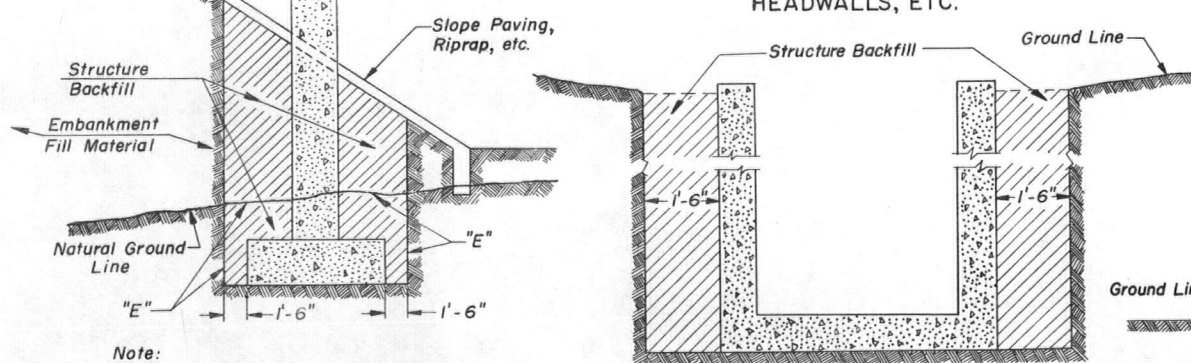

Note:
"E" = Limits of Structure Excavation

TRENCH FOR PIPE UNDERDRAIN

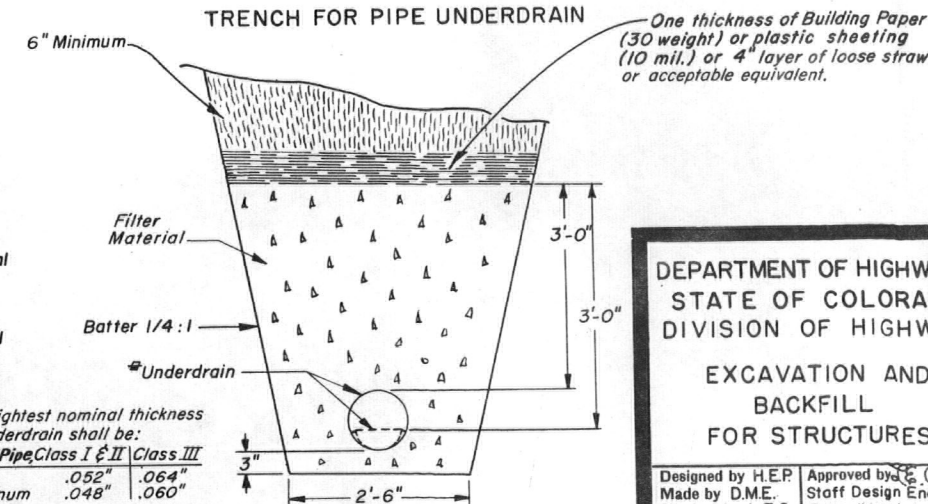

▲ The lightest nominal thickness for underdrain shall be:
Type III Pipe, Class I & II Class III
Steel .052" .064"
Aluminum .048" .060"

DEPARTMENT OF HIGHWAYS
STATE OF COLORADO
DIVISION OF HIGHWAYS

EXCAVATION AND
BACKFILL
FOR STRUCTURES

Designed by H.E.P. Approved by E. Osburn
Made by D.M.E. Staff Design Engr.
Checked by L.E.O. Date: March 1, 1971


STANDARD M-206-AA

(MARCH 1, 1971)
(SHEET 2)


FEDERAL ROAD REGION NO.	DIVISION	PROJ. NO.	SHEET NO.	TOTAL SHEETS
9	COLORADO			

REVISIONS:	




STRUCTURE EXCAVATION MEASUREMENT FOR PIPE CULVERTS

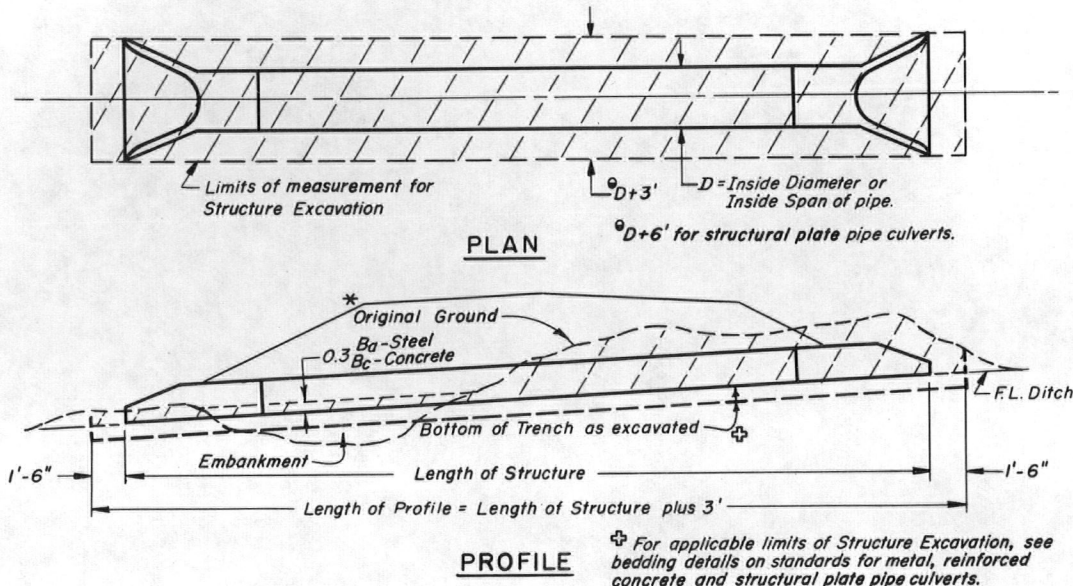

STRUCTURE EXCAVATION MEASUREMENT FOR CONCRETE BOX CULVERTS

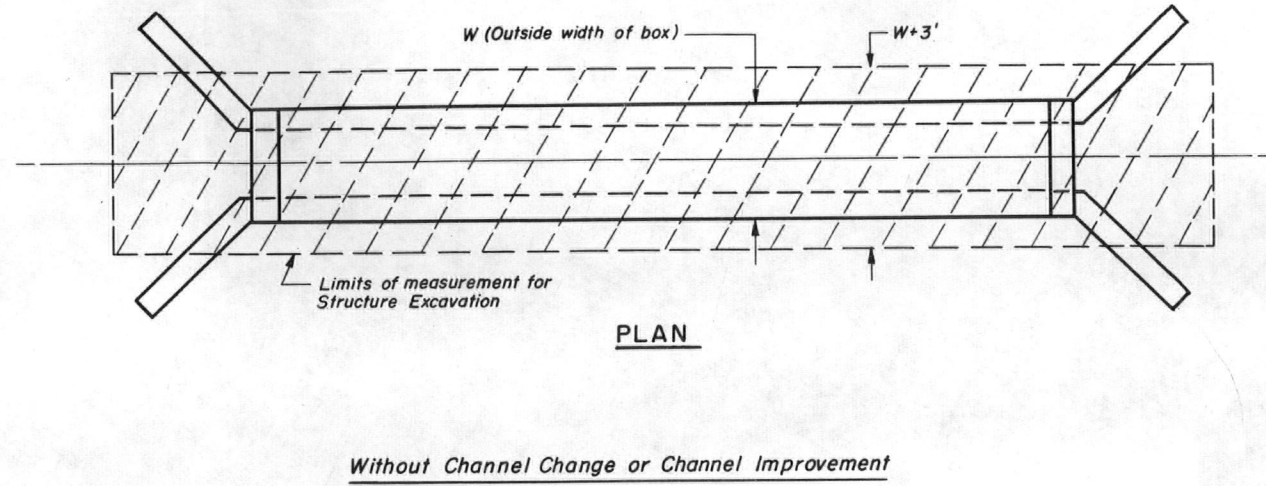

STRUCTURE EXCAVATION MEASUREMENT FOR DIVERSION OR DIVISION BOXES

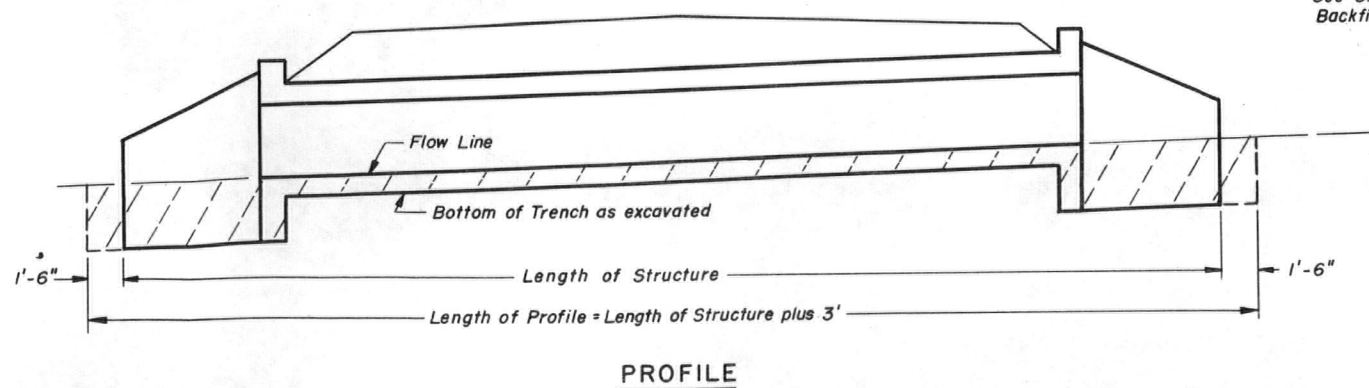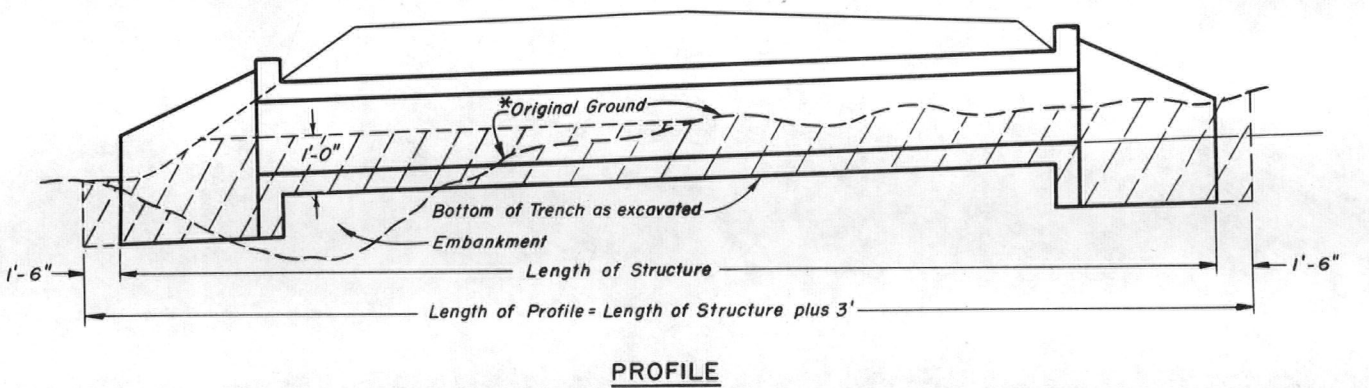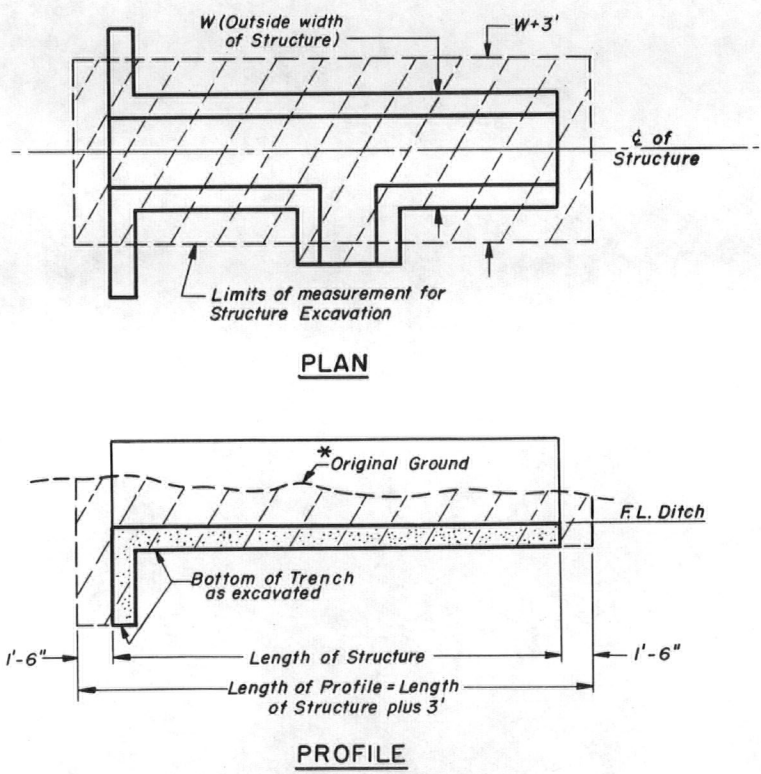

* Along CL of Structure

Areas to be used for Structure Excavation computations.

NOTE:
See Sheet 1 for General Notes and Backfilling Details.

DEPARTMENT OF HIGHWAYS
STATE OF COLORADO
DIVISION OF HIGHWAYS

EXCAVATION AND BACKFILL FOR STRUCTURES

Designed by: M.R.H. Approved by: *[Signature]*
Made by: H.P.B. Staff Design Eng.
Checked by: Date: March 1, 1971

STANDARD M-500-A

(JULY 1, 1965)

FED. ROAD REG. NO.	DIVISION	PROJECT NO.	SHEET NO.
9	COLO.		



abcdefghijklmnopqrstuvwxyz

SAMPLE YEAR NUMBER

SAMPLE BRIDGE NUMBER

GENERAL NOTES

ALL WORK SHALL BE DONE IN ACCORDANCE WITH THE STANDARD SPECIFICATIONS APPLICABLE TO THE PROJECT. THE SIZE, SHAPE AND SPACING OF THE LETTERS AND FIGURES SHALL BE IN ACCORDANCE WITH THE FULL SIZE SHOWN ON THIS SHEET. ADDITIONAL COPIES OF THIS FULL SIZE SHEET CAN BE OBTAINED FROM THE DEPARTMENT WITHOUT CHARGE.

THE YEAR NUMBERS ARE RECESSED IN CONCRETE 3/8" MINIMUM AS SHOWN IN THE PANEL OF THE ENDPOST ON THE RIGHT HAND SIDE OF EACH BRIDGE END AND INTO THE FACE OF THE DOWNSTREAM HEADWALL OF CULVERTS AS SHOWN ON PLAN DETAILS. NUMBERS TO BE MADE OF WOOD, METAL OR OTHER SUITABLE MATERIAL AND ATTACHED TO THE FORMS BEFORE CONCRETE IS POURED. THE YEAR NUMBER OF EACH STRUCTURE SHALL CORRESPOND WITH THE YEAR IN WHICH THE CONCRETE IS POURED.

THE STRUCTURE NUMBER SHALL BE STENCILED ON THE RIGHT HAND SIDE OF EACH BRIDGE END AS SHOWN ON THIS STANDARD AND AS SPECIFIED, WHERE THE STRUCTURE HAS NO END POSTS THE NUMBER SHALL BE PLACED ON A POST ON THE RIGHT HAND SIDE OF THE ROAD AS SHOWN. FOR SIGNS THE NUMBER SHALL BE PLACED ON SIGN POSTS ON THE RIGHT HAND SIDE OF THE ROADWAY.

THE CORRECT NUMBER FOR EACH BRIDGE OR SIGN IS SHOWN ON THE PLANS.

THE NUMBERS FOR MAJOR STRUCTURES OF OVER 20 FEET CLEAR SPAN SHALL BE UPPER CASE LETTERS. THE NUMBERS FOR MINOR STRUCTURES OF 12 TO 20 FEET CLEAR SPAN SHALL BE LOWER CASE LETTERS. SIGN BRIDGES SHALL BE CONSIDERED AS MAJOR STRUCTURES.

A PROPER WHITE BACKGROUND RECTANGULAR IN SHAPE AND EXTENDING THREE INCHES BEYOND THE LIMITS OF THE NUMBER SHALL BE PAINTED WITH TWO COATS OF ACCEPTABLE WHITE PAINT UNLESS AN APPROVED WHITE CONCRETE PAINT IS USED. BEFORE PAINTING THE SURFACE MUST BE THOROUGHLY DRIED, CLEANED AND PROPERLY SIZED. ON TIMBER HANDRAILS THE WHITE PAINT USED ON THE BRIDGE WILL BE SATISFACTORY.

AFTER THE WHITE BACKGROUND HAS DRIED SUFFICIENTLY, THE CORRECT STRUCTURE NUMBER SHALL BE CAREFULLY STENCILED WITH "EXTERIOR BLACK PAINT" AS SPECIFIED IN SECTION 708 - PAINTS, OR AN ACCEPTABLE EQUIVALENT. THE BRACES OF THE STENCILED LETTERS AND FIGURES SHALL BE CAREFULLY FILLED IN BY HAND TO MAKE SOLID FIGURES.

SUFFICIENT TIME BETWEEN SUCCESSIVE COATS SHALL BE ALLOWED TO PERMIT THOROUGH DRYING.





THE COST OF PAINTING OF STRUCTURE NUMBERS AND FURNISHING AND PLACING POSTS FOR STRUCTURE NUMBERS SHALL BE CONSIDERED SUBSIDIARY WORK AND SHALL BE INCLUDED IN THE ORIGINAL CONTRACT ITEMS AND WILL NOT PAID FOR AS SEPARATE ITEMS.

* THE LENGTH OF SPAN OF STRUCTURE SHALL BE MEASURED ALONG CENTER LINE OF ROADWAY. IN CASE OF DOUBLE OR MULTIPLE BOX CULVERTS THE CENTER WALL OR WALLS SHALL BE DISREGARDED AND CLEAR SPAN MEASURED FROM INSIDE OF END WALLS.

IN ADDITION TO THE REQUIREMENTS STATED ABOVE, STRUCTURE NUMBERS FOR HIGHWAYS PASSING UNDER CROSSROADS ARE TO BE PLACED AT THE FOLLOWING POINTS:

(A) FOR STRUCTURES OF 3 OR MORE SPANS, THE STRUCTURE NUMBER SHALL BE STENCILED, FACING TRAFFIC, ON THE OUTSIDE FACE OF THE END COLUMN OF THE RIGHT-HAND PIER.

(B) FOR 2-SPAN STRUCTURES, THE STRUCTURE NUMBER SHALL BE STENCILED, FACING TRAFFIC, ON THE OUTSIDE FACE OF EACH END COLUMN IN THE CENTER PIER.

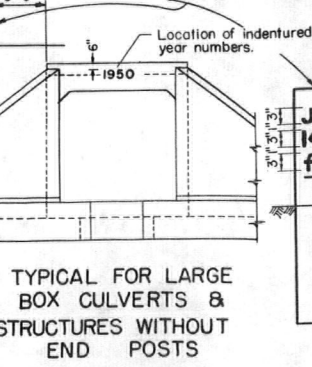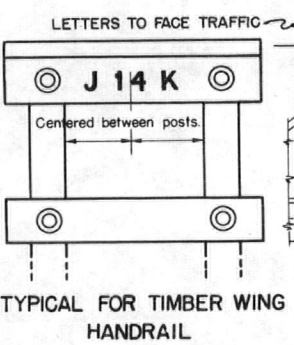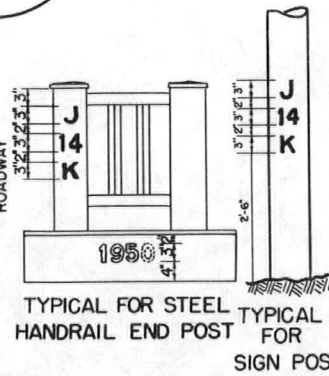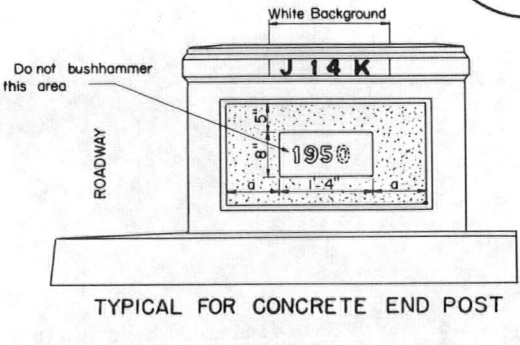

REVISIONS	

DEPARTMENT OF HIGHWAYS
STATE OF COLORADO

LETTERS AND FIGURES
FOR
STRUCTURE NUMBERS


Designed by
Made by
Checked by

Approved by *A. D. Newbold*
Bridge Engineer
Date: July 1, 1965

STANDARD M-60I-C

(SHEET 1 OF 2 SHEETS)
(JULY 1, 1965)


FED. ROAD REG. NO.	DIVISION	PROJECT. NO.	SHEET NO.
9	COLO.		

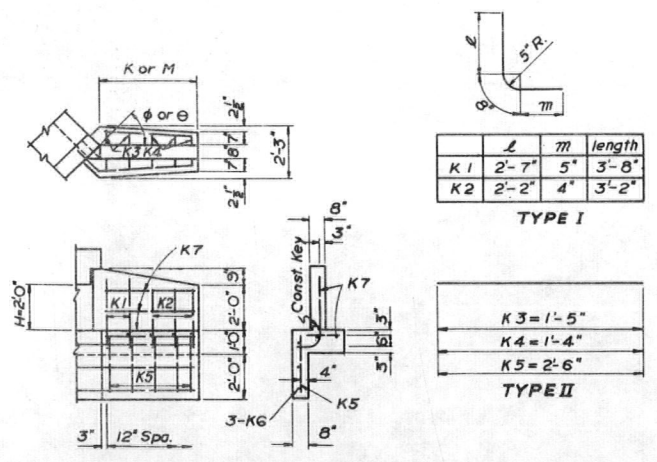

BAR LIST & QUANTITIES FOR ONE WING WHEN H=2'-0"

When φ or θ equals	Number of bars required								Length of bars		Quantities for One Wing	
	K1	K2	K3	K4	K5	3-K6	4-K7	1-K8	Concrete Cu.Yd.	Steel Lb.		
22°30'	4	4	4	4	8	9'-10"	7'-8"	1.47	80			
30°	3	3	3	3	6	7'-4"	5'-8"	1.10	59			
37°30'	3	2	3	2	5	6'-1"	4'-8"	0.92	50			
45°	2	3	2	3	5	5'-2"	3'-11"	0.78	45			
52°30'	2	2	2	2	4	5'-1"	3'-5"	0.69	39			
60°	2	2	2	2	4	4'-6"	3'-2"	0.64	37			
67°30'	2	2	2	2	4	4'-0"	2'-11"	0.60	36			

WING DETAIL WHEN H=2'-0"

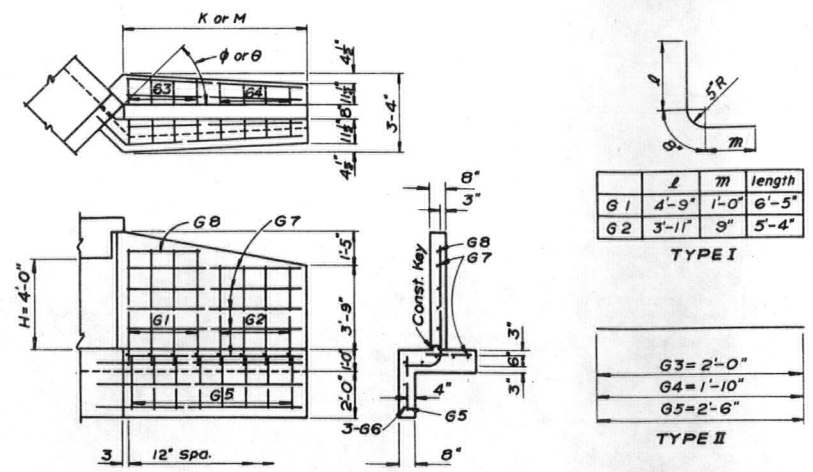

BAR LIST & QUANTITIES FOR ONE WING WHEN H=4'-0"


When φ or θ equals	Number of bars required								Length of bars		Quantities for One Wing	
	G1	G2	G3	G4	G5	3-G6	8-G7	1-G8	Concrete Cu.Yd.	Steel Lb.		
22°30'	6	9	6	9	15	17'-4"	14'-5"	5'-2"	3.97	219		
30°	5	7	5	7	12	13'-2"	10'-11"	4'-2"	3.03	170		
37°30'	4	6	4	6	10	10'-10"	8'-11"	3'-2"	2.49	141		
45°	4	4	4	4	8	9'-4"	7'-8"	3'-2"	2.15	118		
52°30'	3	5	3	5	8	9'-0"	6'-11"	2'-2"	1.95	112		
60°	3	4	3	4	7	7'-10"	6'-2"	2'-2"	1.75	99		
67°30'	3	3	3	3	6	7'-0"	5'-8"	2'-2"	1.61	88		

WING DETAIL WHEN H=4'-0"

TABLE SHOWING VALUES OF K & M WHEN β & θ ARE GIVEN

β	α	φ	θ	H=2'-0"		H=3'-0"		H=4'-0"		H=5'-0"		H=6'-0"	
				K	M	K	M	K	M	K	M	K	M
45°	45°	67°30'	22°30'	3'-3"	8'-0"	4'-6"	11'-0"	6'-0"	14'-9"	7'-6"	18'-0"	8'-9"	21'-0"
60°	30°	60°	30°	3'-6"	6'-0"	5'-0"	8'-6"	6'-8"	11'-3"	8'-0"	14'-0"	9'-3"	16'-0"
75°	15°	52°30'	37°30'	3'-9"	5'-0"	5'-6"	7'-0"	7'-3"	9'-3"	8'-9"	11'-6"	10'-0"	13'-3"
90°	0°	45°	45°	4'-3"	4'-3"	6'-0"	6'-0"	8'-0"	8'-0"	10'-0"	10'-0"	11'-6"	11'-6"
105°	15°	37°30'	52°30'	5'-0"	3'-9"	7'-0"	5'-6"	9'-3"	7'-3"	11'-6"	8'-9"	13'-3"	10'-0"
120°	30°	30°	60°	6'-0"	3'-6"	8'-6"	5'-0"	11'-3"	6'-6"	14'-0"	8'-0"	16'-0"	9'-3"
135°	45°	22°30'	67°30'	8'-0"	3'-3"	11'-0"	4'-6"	14'-9"	6'-0"	18'-0"	7'-6"	21'-0"	8'-9"


β equals the angle between φ of culvert & of roadway. α equals the angle between φ of culvert and a line normal to φ of roadway. (R-3)
φ and θ are angles between the wingwall and a line parallel with the φ of roadway.
EXAMPLE FOR USING THE ABOVE TABLE: Suppose a stream makes an angle of β=65° with the φ of roadway, then from the table, select the nearest angle, β=60°, then α, φ, θ equal 30°, 60° & 30° respectively. If the desired height "H" of culvert is 6'-0", then K & M will be 9'-3" and 16'-0". Locate the WING DETAIL WHEN H=6'-0" on this sheet.

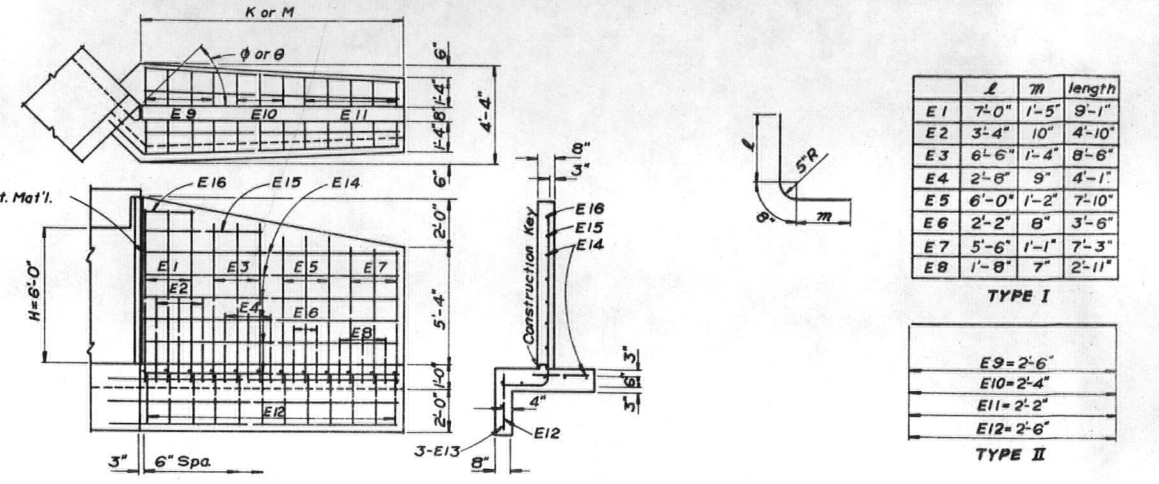

BAR LIST & QUANTITIES FOR ONE WING WHEN H=6'-0"

When φ or θ equals	Number of bars required												Length of bars				Quantities for One Wing	
	E1	E2	E3	E4	E5	E6	E7	E8	E9	E10	E11	E12	3-E13	9-E14	1-E15	1-E16	Concrete Cu.Yd.	Steel Lb.
22°30'	6	5	5	5	5	5	5	6	7	8	21	24'-3"	20'-8"	10'-2"	5'-2"	7.30	430	
30°	4	4	4	4	4	4	4	3	5	5	16	18'-5"	15'-8"	7'-2"	3'-2"	5.58	326	
37°30'	4	3	3	3	3	3	3	4	4	5	14	15'-3"	12'-11"	6'-2"	3'-2"	4.60	278	
45°	3	3	3	3	3	3	2	3	4	3	12	13'-2"	11'-2"	5'-2"	2'-2"	3.99	240	
52°30'	3	2	2	2	2	2	2	2	3	4	3	10	12'-1"	9'-8"	4'-2"	2'-2"	3.47	202
60°	3	2	2	2	2	2	2	3	3	3	4	10	10'-10"	8'-11"	4'-2"	2'-2"	3.21	194
67°30'	3	2	2	2	2	2	2	2	3	3	3	9	9'-11"	8'-5"	4'-2"	2'-2"	3.04	180


WING DETAIL WHEN H=6'-0"

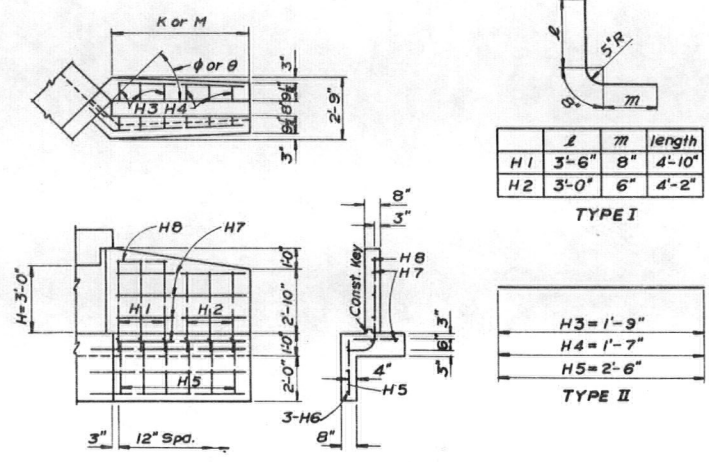

BAR LIST & QUANTITIES FOR ONE WING WHEN H=3'-0"

When φ or θ equals	Number of bars required					Length of bars			Quantities for One Wing	
	H1	H2	H3	H4	H5	3-H6	5-H7	1-H8	Concrete Cu.Yd.	Steel Lb.
22°30'	6	5	6	5	11	13'-2"	10'-8"	5'-2"	2.47	131
30°	5	4	5	4	9	10'-2"	8'-2"	4'-2"	1.91	104
37°30'	4	3	4	3	7	8'-4"	6'-8"	3'-2"	1.57	82
45°	3	3	3	3	6	7'-1"	5'-8"	2'-2"	1.35	70
52°30'	3	3	3	3	5	7'-0"	5'-2"	2'-2"	1.23	68
60°	3	2	3	2	5	6'-2"	4'-8"	2'-2"	1.12	59
67°30'	3	2	3	2	5	5'-4"	4'-2"	2'-2"	1.01	56

WING DETAIL WHEN H=3'-0"

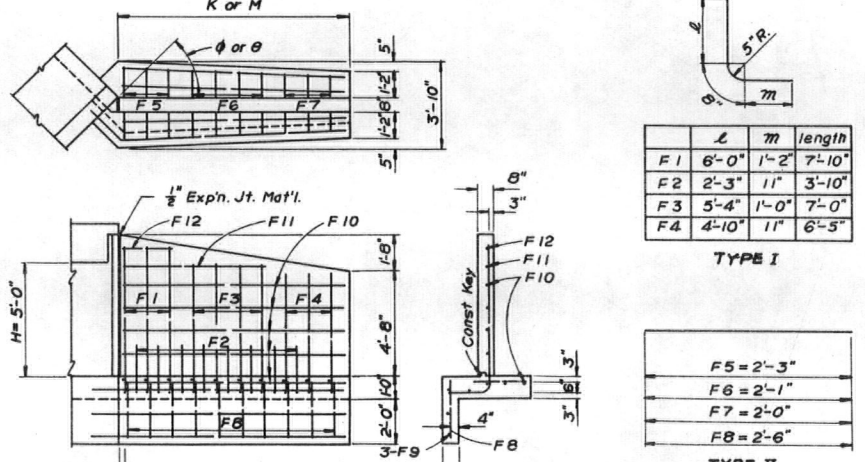

BAR LIST & QUANTITIES FOR ONE WING WHEN H=5'-0"

When φ or θ equals	Number of bars required								Length of bars				Quantities for One Wing	
	F1	F2	F3	F4	F5	F6	F7	F8	3-F9	8-F10	1-F11	1-F12	Concrete Cu.Yd.	Steel Lb.
22°30'	6	14	7	5	6	7	5	18	20'-11"	17'-8"	12'-2"	5'-2"	5.61	328
30°	5	11	5	4	5	5	4	14	18'-2"	13'-8"	9'-2"	4'-2"	4.36	254
37°30'	4	9	4	4	4	4	4	12	13'-3"	11'-2"	7'-2"	3'-2"	3.58	211
45°	3	8	4	3	3	4	3	10	11'-6"	9'-8"	6'-2"	2'-2"	3.11	180
52°30'	3	7	3	3	3	3	3	9	10'-8"	8'-5"	5'-2"	2'-2"	2.72	160
60°	3	6	2	3	3	2	3	8	9'-6"	7'-8"	4'-2"	2'-2"	2.49	143
67°30'	3	6	3	2	3	2	3	8	8'-7"	7'-2"	5'-2"	2'-2"	2.33	140

WING DETAIL WHEN H=5'-0"

LOADING DATA INTERSTATE ALTERNATE
LIVE LOAD: A.A.S.H.O. (HS 20-44)
DEAD LOAD: CONCRETE 150 POUNDS PER CUBIC FOOT
EARTH 84 POUNDS PER CUBIC FOOT

(R-2) DESIGNING DATA
A.A.S.H.O. 1965 UNIT STRESS, EXCEPT AS NOTED
Reinforcing Steel fs 20000 lbs. per sq. in.
Structural Steel fs 18000 lbs. per sq. in.
fc 1200 lbs. per sq. in.
n 10

REVISIONS

NO.	DATE	DESCRIPTION	BY
(R-1)	7-17-67	General Note	M.R.H.
(R-2)	7-15-68	General Note & Dept. Name	M.R.H.
(R-3)	10-25-68	General Note & Table Note	M.R.H.

GENERAL NOTES

ALL WORK SHALL BE DONE ACCORDING TO THE STANDARD SPECIFICATIONS APPLICABLE TO THE PROJECT.

ALL CONCRETE SHALL BE CLASS "A".
ALL WING SURFACES TO RECEIVE CLASS I FINISH.
WING FOOTINGS & FLOOR OF BOX SHALL BE POURED MONOLITHICALLY.
FOOTINGS IN ROCK SHALL BE POURED OUT TO ROCK AND NOT FORMED.
SOUNDING AND DEPTH OF FOOTING SHOWN ARE IN ACCORDANCE WITH THE BEST AVAILABLE DATA AND WHEN DIFFERENT CONDITIONS ARE ENCOUNTERED THE BRIDGE ENGINEER WILL INSPECT AND DETERMINE IF RE-DESIGN IS NECESSARY.

(R-3) EACH REINFORCING STEEL BAR SHALL BE TAGGED WITH THE NUMBER DESIGNATION AND THE STATION NUMBER OF THE PROJECT. SECONDARY BARS WHEN SPLICED SHALL LAP 24 DIAMETERS OF THE BAR. DIMENSIONS FOR REINFORCING STEEL NOT SHOWN AS CLEAR SHALL BE TO THE CENTER LINE OF THE BAR. OUT TO OUT DIMENSIONS SHALL BE USED ON BAR BENDING DETAILS.

SUPPORTING SOILS FOR ALL CULVERTS MUST BE COMPOSED OF FIRM AND UNIFORM MATERIAL THROUGHOUT. HORIZONTAL CONSTRUCTION KEYS ARE NOT REQUIRED WHEN FOOTING AND WALL ARE POURED MONOLITHICALLY. ALL CONSTRUCTION KEYS SHOWN BETWEEN FOOTINGS AND WALLS ARE 3" X 3".

STEEL WEIGHTS INCLUDE 1% ± FOR OVERTURN.
EXPANSION JOINT MATERIAL IS TO BE INCLUDED IN THE PRICE OF CLASS "A" CONCRETE AND SHALL CONFORM TO A.A.S.H.O. DESIGNATION M-213.
FOR CULVERTS REQUIRED AND GOVERNING DIMENSIONS SEE "LIST OF STRUCTURES".

(R-1) WHEN EXCAVATING FOR FOOTINGS THE FINAL SURFACE ELEVATION SHALL BE UNDISTURBED NATURAL OR COMPACTED SOIL.

STRUCTURE NO. _____

DEPARTMENT OF HIGHWAYS
STATE OF COLORADO
DIVISION OF HIGHWAYS

WINGWALLS FOR
CONCRETE BOX CULVERTS
4:1 SIDE SLOPES

Designed by L.D.P.
Made by J.W.M.E.R.L.S.
Checked by A.T.F. 254

Approved by *[Signature]*
Bridge Engineer
Date: July 1, 1965

STANDARD M-601-C

(SHEET 2)
(JULY 1, 1965)


FED. ROAD REG. NO.	DIVISION	PROJECT NO.	SHEET NO.
9	COLO.		

TABLE SHOWING VALUES OF K & M WHEN β & H ARE GIVEN

β	α	ϕ	θ	H=7'-0"		H=8'-0"		H=9'-0"		H=10'-0"	
				K	M	K	M	K	M	K	M
45°	45°	67°30'	22°30'	10'-0"	23'-9"	11'-0"	26'-9"	12'-3"	29'-6"	13'-6"	32'-3"
60°	30°	60°	30°	10'-6"	18'-3"	11'-9"	20'-6"	13'-0"	23'-9"	14'-3"	24'-9"
75°	15°	52°30'	37°30'	11'-6"	15'-0"	13'-0"	16'-9"	14'-3"	18'-6"	15'-9"	20'-3"
90°	0°	45°	45°	13'-0"	13'-0"	14'-6"	14'-6"	16'-0"	16'-0"	17'-6"	17'-6"
105°	15°	37°30'	52°30'	15'-0"	11'-6"	16'-9"	13'-0"	18'-6"	14'-3"	20'-3"	15'-9"
120°	30°	30°	60°	18'-3"	10'-6"	20'-6"	11'-9"	23'-9"	13'-0"	24'-9"	14'-3"
135°	45°	22°30'	67°30'	23'-9"	10'-0"	26'-9"	11'-0"	29'-6"	12'-3"	32'-3"	13'-6"

β equals the angle between ϵ of culvert and ϵ of roadway. α equals the angle between ϵ of culvert and a line normal to ϵ of roadway. ϕ and θ are angles between the wingwall and a line parallel with the ϵ of roadway.

EXAMPLE FOR USING THE ABOVE TABLE. Suppose a stream makes an angle of $\beta=65^\circ$ with ϵ of roadway, then, from the table, select the nearest angle $\beta=60^\circ$; then α, ϕ, θ equal $30^\circ, 60^\circ, \theta=30^\circ$ respectively. If the desired height "H" of culvert is 8'-0", then "K" & "M" will be 11'-9" & 20'-6". Locate the WING DETAIL WHEN H=8'-0" on this sheet.

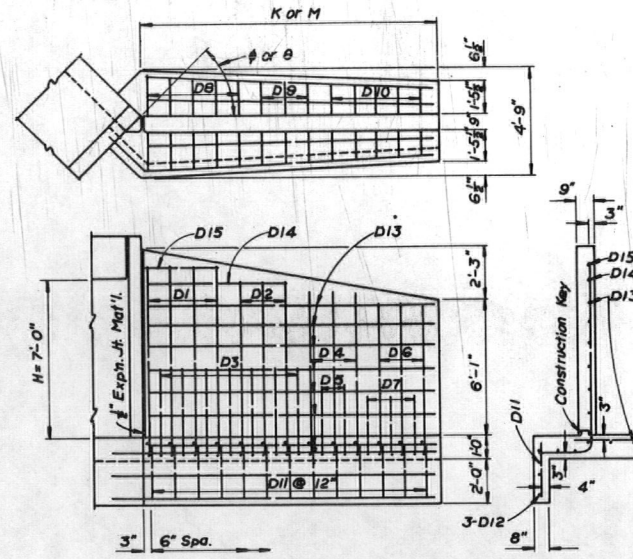

D	ℓ	m	length
D1	7'-11"	1'-8"	10'-3"
D2	7'-4"	1'-6"	9'-6"
D3	3'-4"	1'-0"	5'-0"
D4	6'-9"	1'-5"	8'-10"
D5	2'-8"	1'-0"	4'-2"
D6	6'-3"	1'-3"	8'-2"
D7	2'-2"	9"	3'-7"


TYPE I

D8	2'-8"
D9	2'-6"
D10	2'-4"
D11	2'-6"

TYPE II

When β or θ equals	Number of bars required											Length of bars				Quantities for One Wing	
	D1	D2	D3	D4	D5	D6	D7	D8	D9	D10	D11	3-D12	1-D13	1-D14	1-D15	Concrete Cu.Yd.	Steel Lb.
22°30'	7	6	12	6	6	5	5	8	7	9	24	27'-4"	23'-5"	12'-2"	6'-2"	9.62	592
30°	5	5	9	5	4	4	6	7	19	20'-11"	17'-11"	9'-2"	4'-2"	7.39	457		
37°30'	4	4	8	4	3	3	5	5	15	17'-2"	14'-8"	7'-2"	3'-2"	6.07	368		
45°	4	3	7	3	2	3	3	5	13	14'-10"	12'-8"	6'-2"	3'-2"	5.26	321		
52°30'	3	3	6	3	2	3	3	4	12	13'-10"	11'-2"	5'-2"	2'-2"	4.66	287		
60°	3	3	5	3	3	2	2	4	11	12'-3"	10'-2"	5'-2"	2'-2"	4.25	262		
67°30'	3	3	5	2	3	2	2	4	10	11'-4"	9'-8"	5'-2"	2'-2"	4.05	245		

BAR LIST & QUANTITIES FOR ONE WING WHEN H=7'-0"

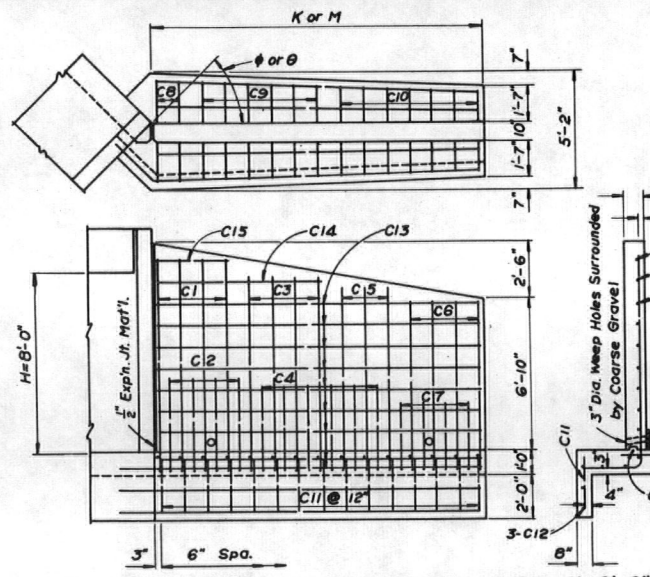

C	ℓ	m	length
C1	8'-10"	1'-11"	11'-5"
C2	3'-8"	1'-2"	5'-6"
C3	8'-3"	1'-9"	10'-8"
C4	3'-4"	1'-1"	5'-1"
C5	7'-8"	1'-8"	10'-0"
C6	7'-0"	1'-6"	9'-2"
C7	2'-7"	11"	4'-2"

TYPE I

C8	3'-0"
C9	2'-9"
C10	2'-6"
C11	2'-6"


TYPE II

When β or θ equals	Number of bars required										Length of bars				Quantities for One Wing	
	A1	A2	A3	A4	A5	A6	A7	A8	A9	A10	3-A11	1-A12	1-A13	1-A14	Concrete Cu.Yd.	Steel Lb.
22°30'	9	16	8	8	16	8	10	12	11	33	36'-10"	31'-11"	16'-2"	8'-2"	19.74	1224
30°	7	12	6	6	12	6	7	10	8	25	28'-2"	24'-5"	12'-2"	6'-2"	15.14	930
37°30'	6	10	5	5	10	5	6	8	7	21	23'-4"	19'-11"	10'-2"	5'-2"	12.39	775
45°	5	9	4	4	8	4	5	7	6	18	19'-9"	17'-2"	8'-2"	4'-2"	10.71	665
52°30'	5	8	3	4	7	4	5	6	5	16	18'-9"	15'-5"	7'-2"	4'-2"	9.63	597
60°	4	7	4	3	7	4	4	6	5	15	16'-6"	13'-11"	7'-2"	3'-2"	8.72	543
67°30'	4	7	3	4	6	3	4	5	5	14	15'-2"	13'-2"	6'-2"	3'-2"	8.26	515

BAR LIST & QUANTITIES FOR ONE WING WHEN H=10'-0"

When β or θ equals	Number of bars required											Length of bars				Quantities for One Wing	
	C1	C2	C3	C4	C5	C6	C7	C8	C9	C10	C11	3-C12	1-C13	1-C14	1-C15	Concrete Cu.Yd.	Steel Lb.
22°30'	8	7	6	12	6	7	7	5	10	12	27	30'-8"	26'-5"	13'-2"	7'-2"	12.53	779
30°	6	5	5	10	4	6	5	4	7	10	21	23'-5"	20'-2"	10'-2"	5'-2"	9.60	601
37°30'	5	4	4	8	4	4	4	3	6	8	17	19'-11"	16'-5"	8'-2"	4'-2"	7.84	487
45°	4	4	4	6	3	4	4	2	6	7	15	16'-6"	14'-2"	7'-2"	3'-2"	6.79	424
52°30'	4	3	3	6	3	3	3	2	5	6	13	15'-6"	12'-8"	6'-2"	3'-2"	6.08	374
60°	4	3	2	6	3	3	2	2	4	6	12	13'-8"	11'-5"	5'-2"	3'-2"	5.50	341
67°30'	3	3	3	5	2	3	2	2	4	5	11	12'-5"	10'-8"	5'-2"	2'-2"	5.15	315

BAR LIST & QUANTITIES FOR ONE WING WHEN H=8'-0"

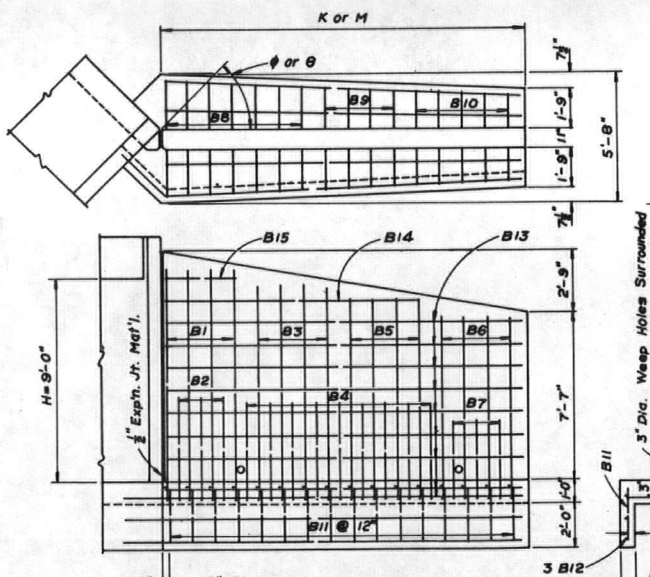

B	ℓ	m	length
B1	9'-11"	2'-3"	12'-10"
B2	4'-2"	1'-4"	6'-2"
B3	9'-2"	2'-11"	11'-11"
B4	3'-11"	1'-5"	5'-10"
B5	8'-5"	1'-10"	10'-11"
B6	7'-9"	1'-9"	10'-2"
B7	3'-1"	1'-1"	4'-10"


TYPE I

B8	3'-3"
B9	2'-9"
B10	2'-7"
B11	2'-6"

TYPE II

When β or θ equals	Number of bars required											Length of bars				Quantities for One Wing	
	B1	B2	B3	B4	B5	B6	B7	B8	B9	B10	B11	3-B12	1-B13	1-B14	1-B15	Concrete Cu.Yd.	Steel Lb.
22°30'	7	6	8	16	8	7	7	13	8	9	30	33'-9"	29'-2"	22'-2"	6'-2"	15.93	930
30°	5	5	7	13	6	6	5	10	7	7	24	27'-0"	23'-5"	17'-2"	4'-2"	12.82	742
37°30'	4	4	5	10	5	5	4	8	5	6	19	21'-11"	18'-2"	13'-2"	3'-2"	9.98	580
45°	4	3	4	9	4	4	3	7	4	5	16	18'-2"	15'-8"	11'-2"	3'-2"	8.63	495
52°30'	3	3	4	8	4	4	3	6	4	5	15	17'-0"	13'-11"	10'-2"	2'-2"	7.69	453
60°	3	3	4	7	3	3	2	6	3	4	13	15'-11"	12'-8"	9'-2"	2'-2"	7.01	406
67°30'	3	2	3	7	4	3	3	5	3	5	13	13'-9"	11'-11"	9'-2"	2'-2"	6.61	385

BAR LIST & QUANTITIES FOR ONE WING WHEN H=9'-0"

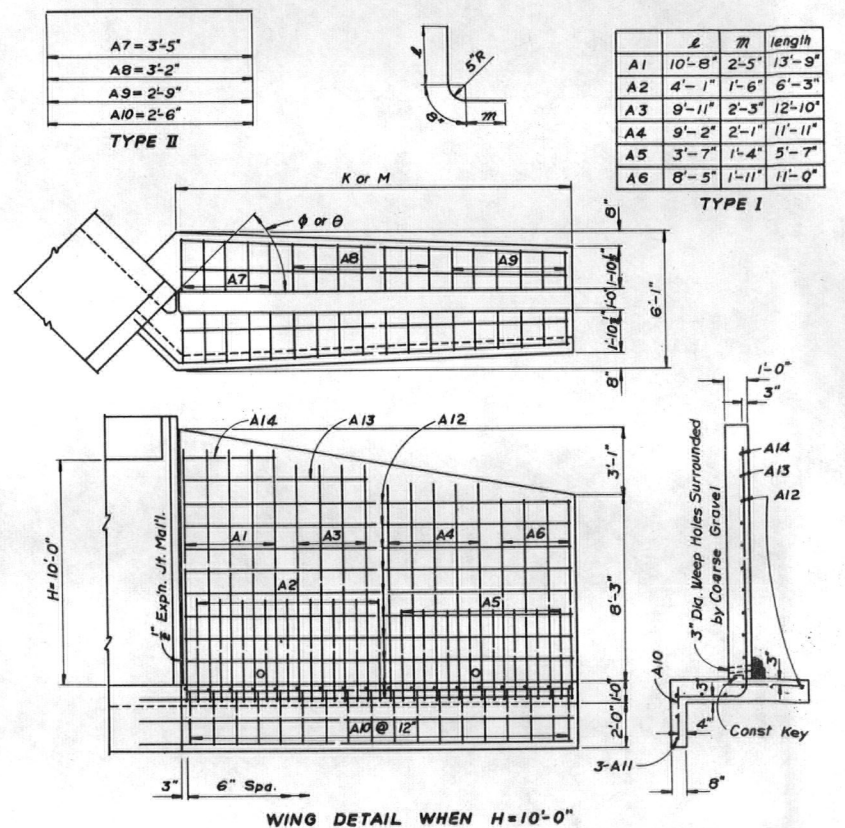

REVISIONS

Rev.	Date	Description	By
R-2	7-15-68	Dept. Name	M.R.H.
R-3	10-25-68	Table Note	M.R.H.

DEPARTMENT OF HIGHWAYS
STATE OF COLORADO
DIVISION OF HIGHWAYS
WINGWALLS FOR
CONCRETE BOX CULVERT
4:1 SIDE SLOPES

Designed by L.D.P. Approved by J.W.M.R.L.S.
Made by J.W.M.R.L.S. Bridge Engineer
Checked by A.T.F.D.S.A. Date: July 1, 1965

STRUCTURE NO.

STANDARD M-603-RC

(MARCH 20, 1967)

FEDERAL ROAD REGION NO.	DIVISION	PROJ. NO.	SHEET NO.	T. SHEETS
9	COLORADO			

REVISIONS

REVISION	DATE	DESCRIPTION	BY
(R-1)	4-19-68	Added Arch and Elliptical Pipe. Gen. Notes.	M.R.H.
(R-2)	7-23-68	Dept. Name.	M.R.H.
(R-3)	3-1-71	GN's for B bed and NRCP. Cl. 2 bed mat'l.	M.R.H.


DIMENSIONS FOR REINFORCED CONCRETE PIPE

(For Information Only)


PIPE SIZE-B _o (In. I.D.)	Wall Thickness (Inches)	0.3 B _c Outside Dia. (Feet)	CIRCULAR				ARCH				VERTICAL ELLIPTICAL (VE)				HORIZONTAL ELLIPTICAL (HE)			
			Span (Inches)	Rise (Inches)	Wall Thickness (Inches)	0.3 Outside Rise (Feet)	Span (Inches)	Rise (Inches)	Wall Thickness (Inches)	0.3 Outside Rise (Feet)	Span (Inches)	Rise (Inches)	Wall Thickness (Inches)	0.3 Outside Rise (Feet)	Span (Inches)	Rise (Inches)	Wall Thickness (Inches)	0.3 Outside Rise (Feet)
12	2	0.40																
15	2-1/4	0.49																
18	2-1/2	0.58																
21	2-3/4	0.66																
24	3	0.75																
27	3-1/4	0.84																
30	3-1/2	0.92																
33	3-3/4	1.01																
36	4	1.10																
39	4-1/2	1.18																
42	5	1.26																
48	6	1.44																
54	7	1.75																
60	8	2.00																
66	9	2.25																
72	10	2.50																
78	11	2.75																
84	12	3.00																
90	13	3.25																
96	14	3.50																
102	15	3.75																
108	16	4.00																

▲ Also equivalent round dimension for Arch and Elliptical pipe.
 ϕ Sizes shown are for identification purposes only. Actual sizes shall conform to those listed in Fig. 1 of ASTM Spec. C506.

(R-1) NOTE: B_c is the outside dimension for diameter, span or rise.

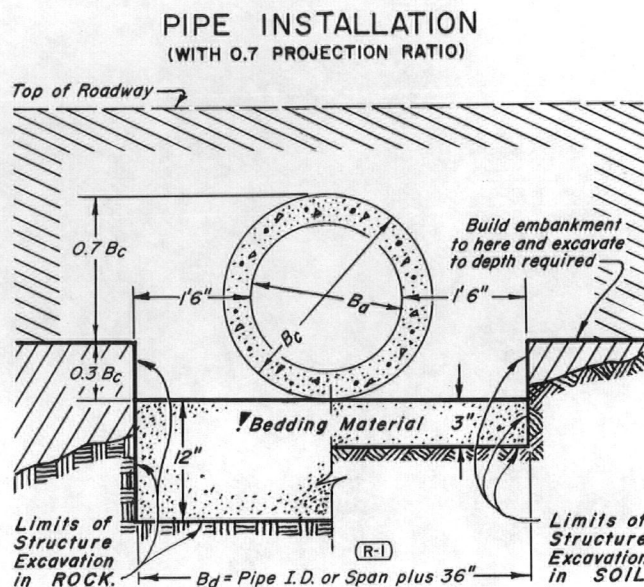

IMPERFECT TRENCH PIPE INSTALLATION (WITH 0.7 PROJECTION RATIO)

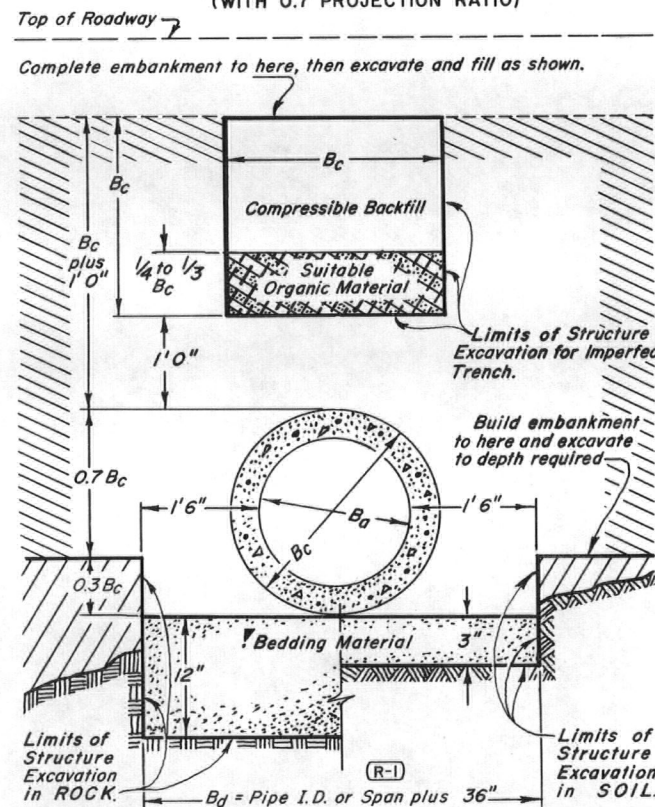

Bedding Material for SOIL shall be 3" loose thickness Structure Backfill Class 2. (R-3)
 Bedding Material for ROCK shall be 12" loose thickness Structure Backfill Class 1.



HEIGHTS OF FILL OVER REINFORCED CONCRETE PIPE

— ALL SIZES —

TYPE OF PIPE	HEIGHT OF FILL OVER TOP OF PIPE IN FEET				
	CLASS OF PIPE (0.01" Crack D-Load)				
	Class II	Class III	Class IV	Class V	Class VI
	1000 D	1350 D	2000 D	3000 D	4000 D
PIPE INSTALLATION WITH 0.7 PROJECTION RATIO					
CIRCULAR	Min. to 18	Min. to 25	25+ to 37	37+ to 45	
ARCH	Min. to 18	Min. to 25	25+ to 37	37+ to 45	45+ to 62
VERTICAL ELLIPTICAL	Min. to 18	Min. to 25	25+ to 37	37+ to 45	
HORIZONTAL ELLIPTICAL	Min. to 18	Min. to 25	25+ to 37		
PIPE INSTALLATION WITH IMPERFECT TRENCH					
ALL TYPES	up to 35	up to 48	48+ to 75	75+ to 96	

GENERAL NOTES

All work shall be done in accordance with the Standard Specifications applicable to the project.
 Minimum cover excluding pavement shall be 1 foot.
 Fill heights greater than maximum allowed in the Heights of Fill Table on this sheet will require special design of structure.
 Pipe design is based on safety factor of 1.33 on ultimate strength.
 The heights of fill over top of pipe are based on unit weight of soil at 120 lbs. per cubic foot.
 Pipe Class is determined from .01 inch crack D-load.
 Bedding is Class B (Modified) with Settlement Ratio R_{sd} = 0.0 (Yielding Bed).
 Changes in design factors will require compensating change in pipe design.
 Minimum wall thickness dimensions are based on AASHTO Designation M170 (Wall B) for Circular Pipe, AASHTO Designation M206 for Arch Pipe and AASHTO Designation M207 for Elliptical Pipe.
 Spacing for multiple pipe installations shall conform to the details shown on M Standard for Excavation and Backfill for Structures.
 When a culvert is to be extended with pipe of different material, the connection shall conform to the detail on plans or be approved.
NONREINFORCED CONCRETE PIPE
 Nonreinforced Concrete Pipe is required to meet the same D-Load to produce the ultimate load under the three-edge-bearing method as specified for Reinforced Concrete Pipe in accordance with AASHTO M-170. Wall thickness of pipe may be increased as required to meet D-Load requirement.
 All requirements for Reinforced Concrete Pipe, except those referring to reinforcement shall apply to Nonreinforced Concrete Pipe.

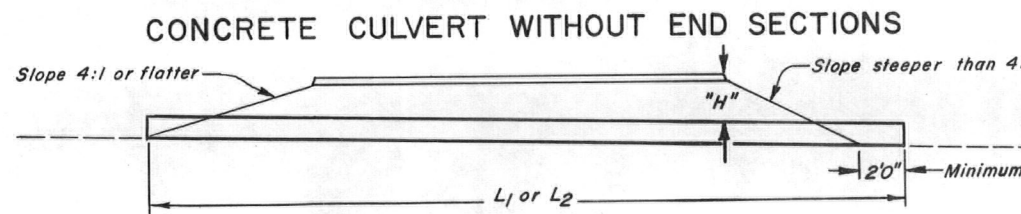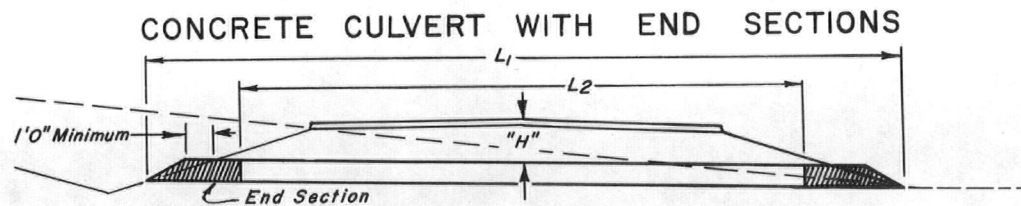

"H" = Maximum height of fill over top of Culvert, including pavement.
 L₁ = Length of Culvert to be measured when placed in accordance with Section 617.
 L₂ = Length of Pipe to be measured when placed in accordance with Section 603.

(R-1) Length of extension, when placed in accordance with Section 617, shall be the actual number of feet of new culvert required.

(R-2) DEPARTMENT OF HIGHWAYS
 STATE OF COLORADO
 DIVISION OF HIGHWAYS

REINFORCED CONCRETE PIPE

Designed by M. R. H. Approved by J. R. B. Staff Design Eng'r.
 Made by J. R. B. Checked by R. S. M. Date: 4-19-68

STANDARD M-606-AB

(MARCH 1, 1968)
(SHEET 1 OF 3)


FEDERAL ROAD REGION NO.	DIVISION	PROJ. NO.	SHEET NO.	SHEETS
9	COLORADO			

REVISIONS				
R-1	7-10-68	Add typical post & obstr.		M.R.H.
R-2	4-1-69	Widening, Bevel, Gen. notes.		M.R.H.
R-3	2-18-70	Pay length, Blocks, Gen. Notes.		M.R.H.
R-4	11-25-70	Timber, Hole and Gen. Notes.		M.R.H.


TABLE OF OFFSETS FOR 75' PARABOLIC FLARES

x	y					
	W=4'	W=5'	W=10'	W=12'	W=14'	W=16'
12'-6"	0.11	0.14	0.28	0.33	0.39	0.44
25'-0"	0.44	0.55	1.11	1.33	1.56	1.78
37'-6"	1.00	1.25	2.50	3.00	3.50	4.00
50'-0"	1.78	2.22	4.44	5.33	6.23	7.11
62'-6"	2.78	3.48	6.95	8.34	9.73	11.11
75'-0"	4.00	5.00	10.00	12.00	14.00	16.00


LEGEND
W = Full parabolic offset.
L = Length of parabolic transition.
X = Longitudinal dist. from beginning of flare.
Y = Offset = $W \cdot \frac{x^2}{L^2}$

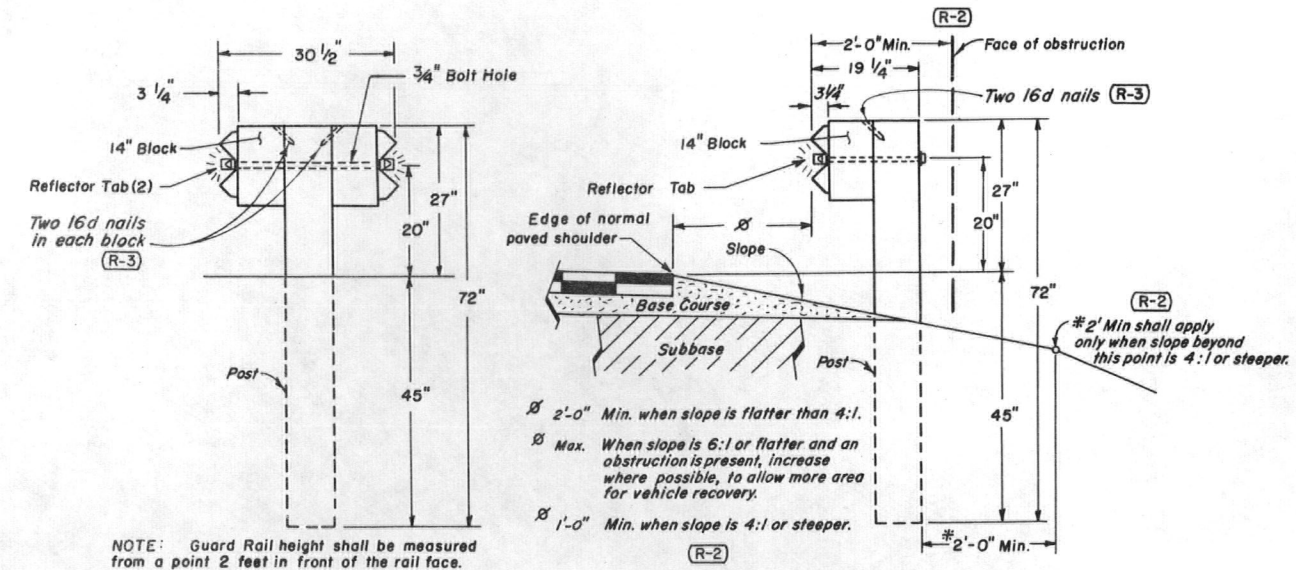


TYPICAL POST INSTALLATIONS
(See Table for Post & Block Cross Section)

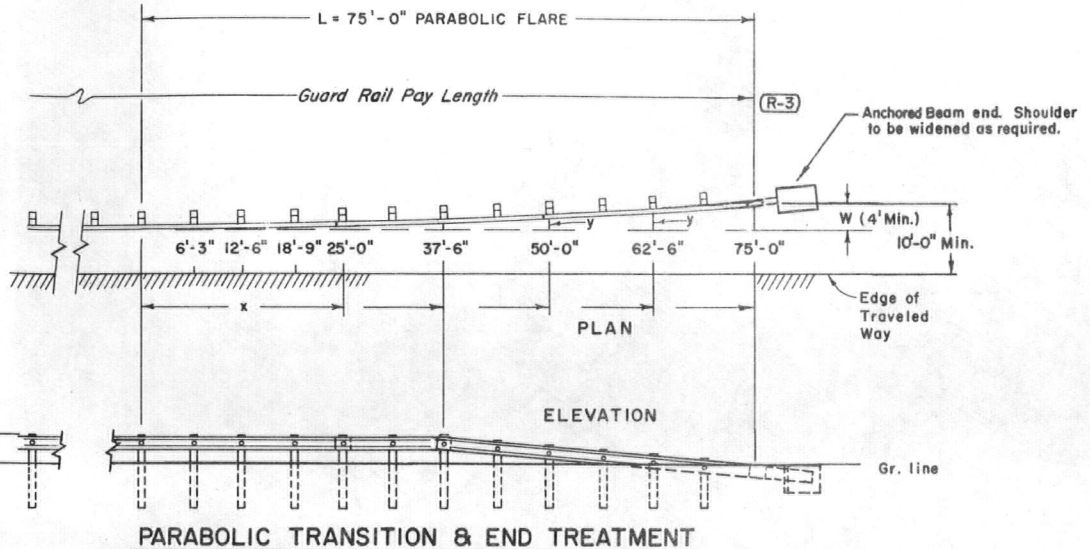

PARABOLIC TRANSITION & END TREATMENT

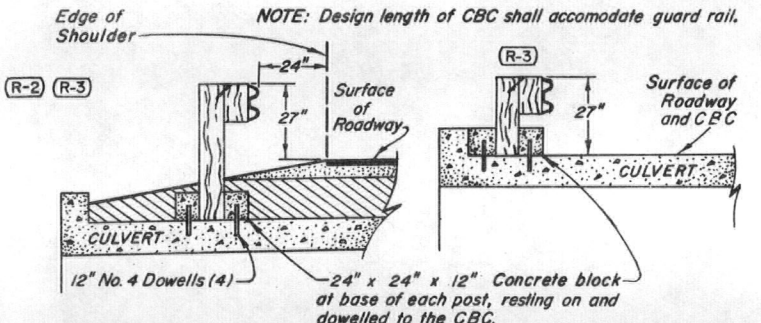


GUARD RAIL ACROSS CONCRETE BOX CULVERT

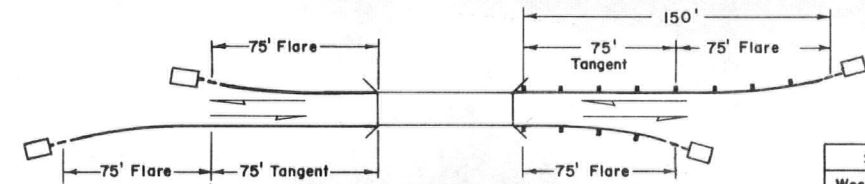


2-LANE HIGHWAY BRIDGE APPROACH GUARD RAIL
NOTE: For divided highways see Sheet No. 2.

SPECIES	POST CROSS SECTION	FOHC	GRADING RULES
West Coast D. F.	6" x 8"	Yes	WCLA Par. 125 b
West Coast Hemlock	6" x 8"	Yes	WCLA Par. 225 b
Larch	6" x 8"	Yes	WWPA Par. 80.11
Southern Pine	6" x 8"	No	SPA Par. 253
Lodgepole Pine	8" x 8"	No	WWPA Par. 80.11
Ponderosa Pine	8" x 8"	No	WWPA Par. 80.11


WCLA - Standard Grading Rule 15, Grading and Dressing rules of West Coast Douglas Fir, issued by the West Coast Lumber Inspection Bureau.
WWPA - Standard Grading Rules, published by Western Wood Products Association.
SPA - Standard Grading Rules for Southern Pine Lumber, issued by the Southern Pine Inspection Bureau.
FOHC - Free of Heart Centers. See paragraph 612 c of WCLA.
NOTE - 6" x 8" Posts and Blocks shall be installed with the 6" dimension parallel to the roadway.

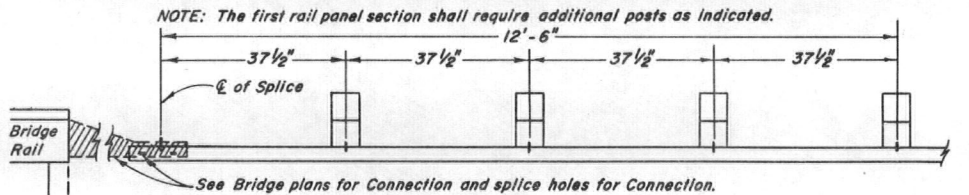

GUARD RAIL AT BRIDGES

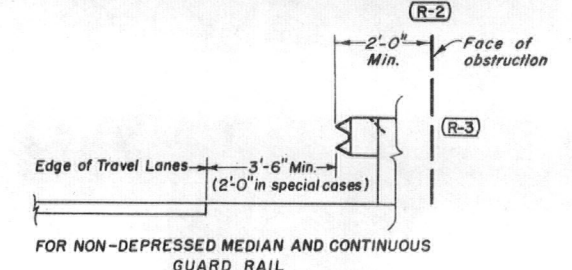

GUARD RAIL FOR OBSTRUCTIONS IN MEDIAN
(See Sheet No. 3)

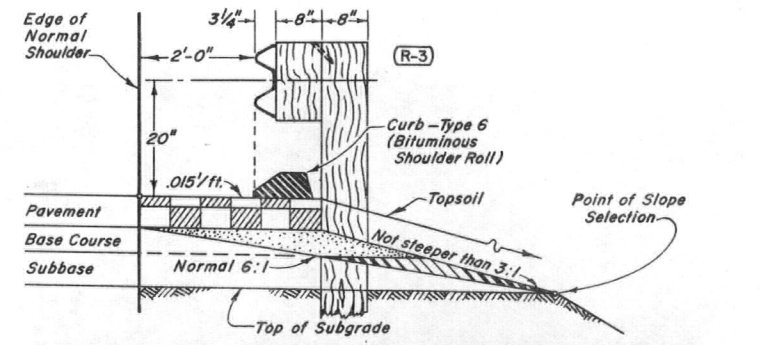

GUARD RAIL WITH BITUMINOUS CURB
(Showing Typical Shoulder Widening)

GENERAL NOTES

All work shall be done in accordance with the Standard Specifications applicable to the project.
All timber shall be close grained Douglas Fir of the Coast Region, Dense Longleaf or Shortleaf Southern Pine, Lodgepole Pine, Ponderosa Pine, Western Hemlock, or Larch, and shall conform to the following grading specifications and requirements:

All timber shall be rough, square cut and full sawn.
At the time the post or block is installed, any seasoning check which extends the full length of the piece shall not exceed one-quarter inch in width at its maximum width.
Blocks shall be cut from timber of the same cross section and species as the posts.
Timber shall be incised and pressure treated in accordance with AASHTO Designation M133, except that blocks need not be incised. Post bolt holes are to be drilled before treatment is applied.
The preservative shall be either (a) Creosote or (b) Pentachlorophenol in a petroleum carrier (liquid or L.P. gas).
Posts shall be spaced at 6'-3" center-to-center except when otherwise designated on this Standard or in the guardrail tabulation on the plans.
Where pedestrian hazard exists and sidewalk is constructed on the roadway shoulder, guard rail shall be placed between the sidewalk and the edge of traffic lanes.
Guard rail plate shall not be lighter than No. 12 U.S. Standard Gage. 25' length of rail panels will be permitted.
Metal plate guard rail shall be painted in accordance with standard specifications or shall be galvanized in accordance with AASHTO Designation M-111 or with ASTM Designation A 525, Coating Class 2.50.
Posts used for vertical transition shall be adjusted in length so that a minimum of 45" will be buried.
Standard galvanized wrought steel washers shall be used under all bolt heads or nuts coming in contact with wood posts.
Concrete shall be Class "A" or Class "B".
Blocks shall be toenailed to posts with two 16 penny galvanized nails in the top of each block.
If posts are cut in the field, cut ends shall receive 2 coats of hot creosote.

DEPARTMENT OF HIGHWAYS
STATE OF COLORADO
DIVISION OF HIGHWAYS
GUARD RAIL TYPE 3


Designed by M.R.H.
Made by R.B. Staff Design Engineer
Checked by R.S.W. Date: March 1, 1968

STANDARD M-606-AB

(MARCH 1, 1968)
(SHEET 2)


FEDERAL ROAD REGION NO.	DIVISION	PROJ. NO.	SHEET NO.	TOTAL SHEETS
9	COLORADO			

REVISIONS				
(R-1)	7-10-68	Add end anchorage	M.R.H.	
(R-2)	4-1-69	Bridge exit guard rail note	M.R.H.	
(R-3)	2-18-70	Pay length	M.R.H.	
(R-4)	11-25-70	Timber dimension.	M.R.H.	

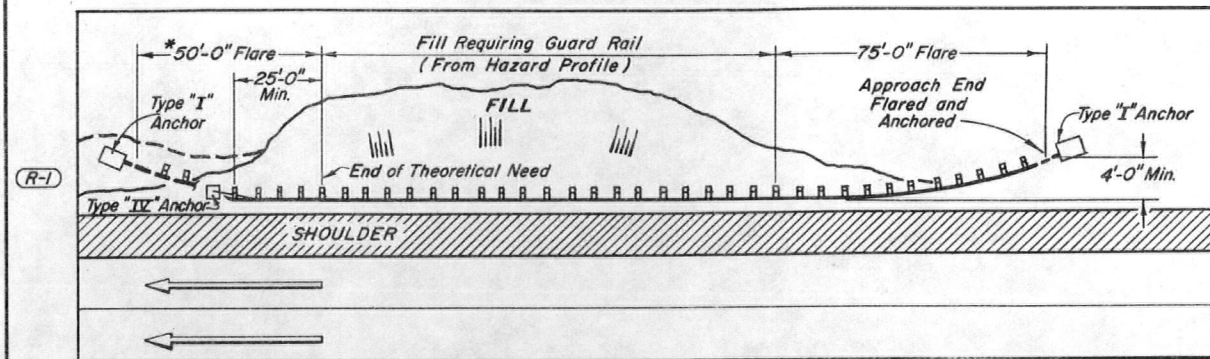


GUARD RAIL INSTALLATION ——— ROADSIDE FILL CONDITION

NOTES:
* 2-Lane Highways — The exit end of Guard Rail shall extend 50 feet past the end of theoretical need and shall be flared and anchored.

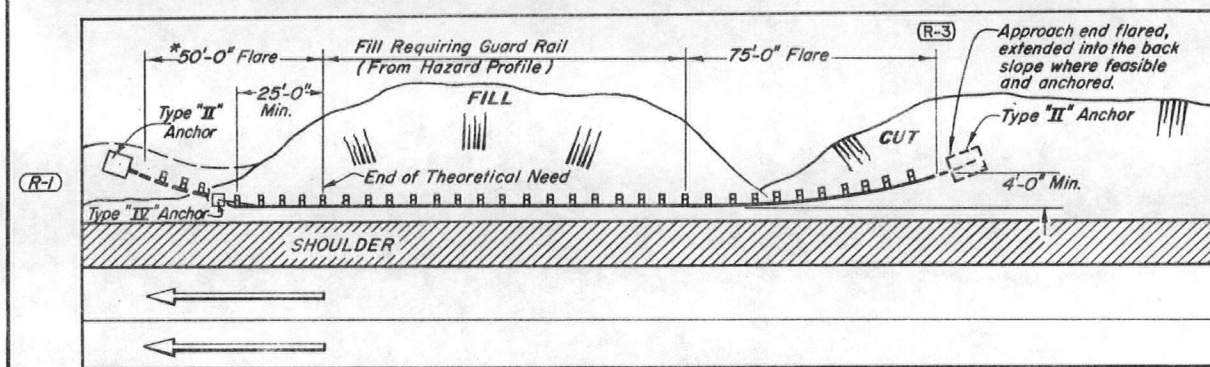


GUARD RAIL INSTALLATION ——— ROADSIDE CUT TO FILL CONDITION

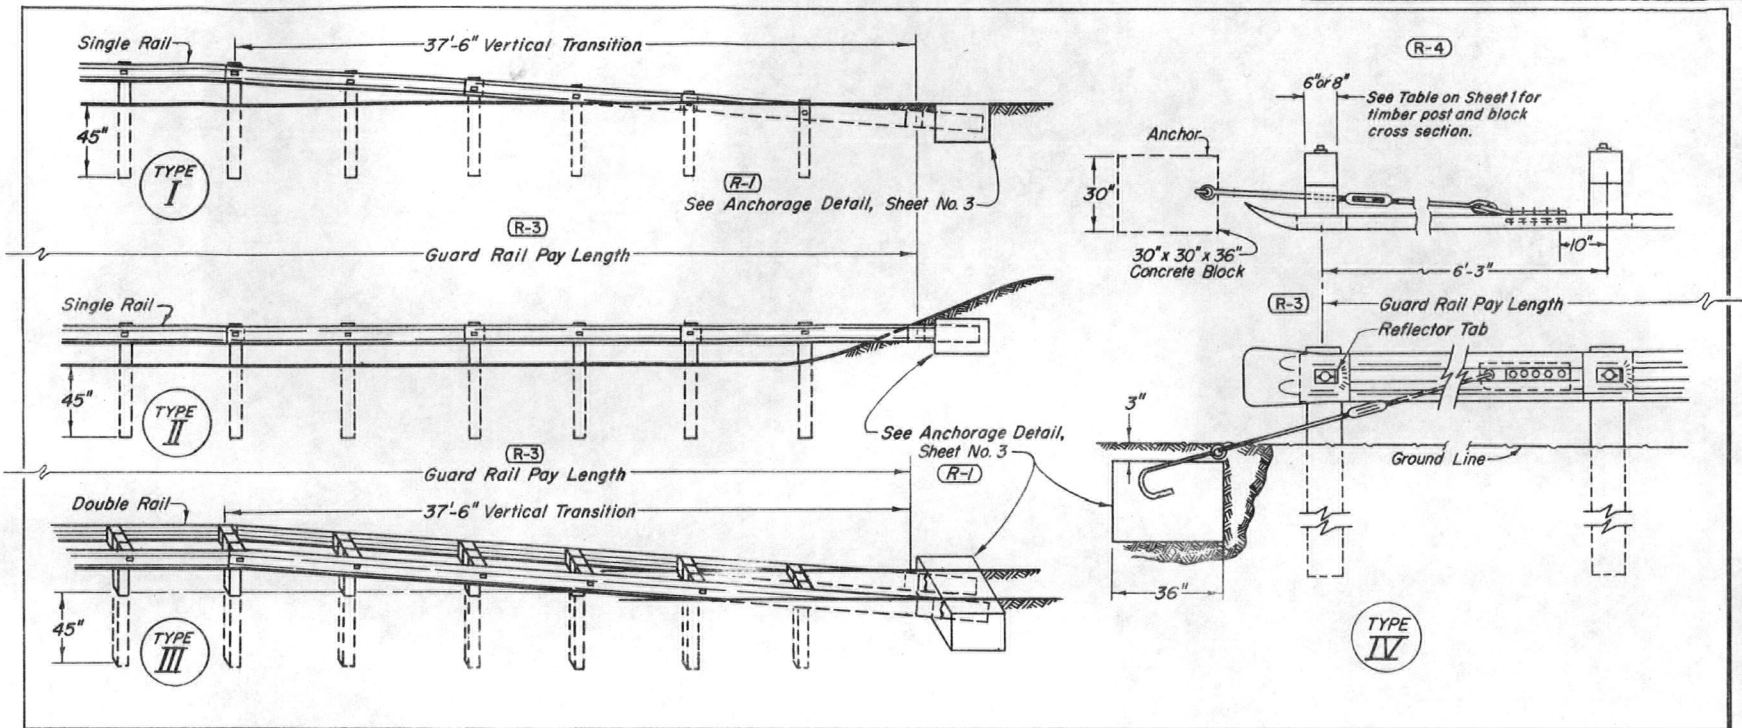

TYPICAL END ANCHORAGE

- (R-2) Note: EXIT FROM BRIDGES:
- Guard rail for OUTSIDE shoulders at exit end of bridges on divided highways to be determined from hazard profile.
 - Guard rail for INSIDE shoulders at exit end of bridges on divided highways with medians 60' and over to be determined from hazard profile.

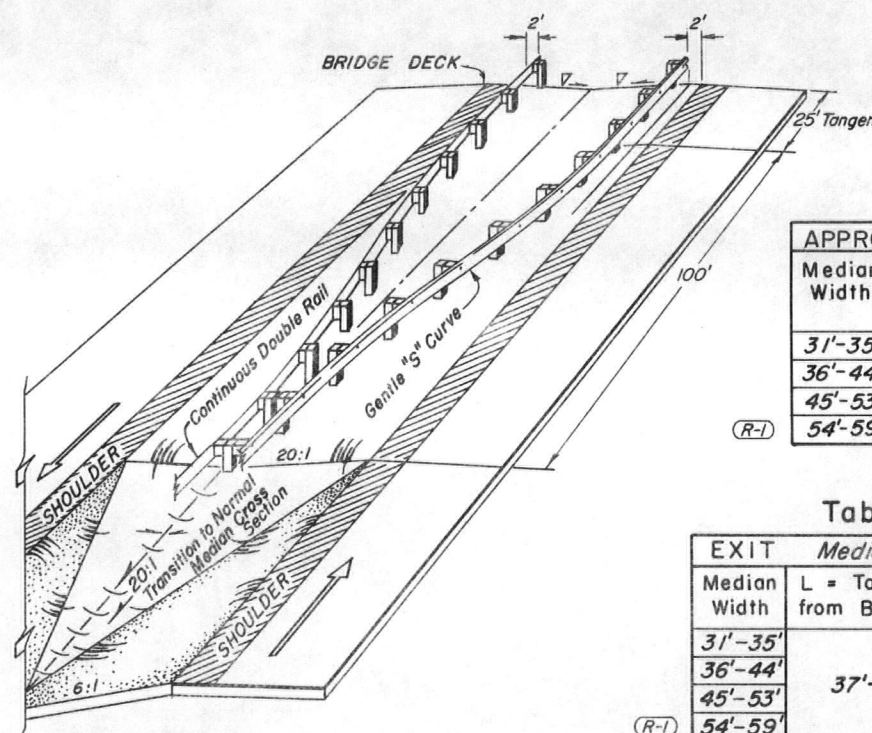


21' to 30' MEDIAN

Table 1


APPROACH Median Guard Rail			
Median Width'	L_1 = Tangent from Bridge	75' Parabolic Flare	L_2 = 150' Radius Arc
31'-35'	50'-0"	then	then 25'-0"
36'-44'	25'-0"	W = 5'	50'-0"
45'-53'	12'-6"		62'-6"
54'-59'	0'-0"		75'-0"

Table 2

EXIT Median Guard Rail		
Median Width	L = Tangent from Bridge	75' Parabolic Flare, W =
31'-35'	37'-6"	10'
36'-44'		12'
45'-53'		14'
54'-59'		16'

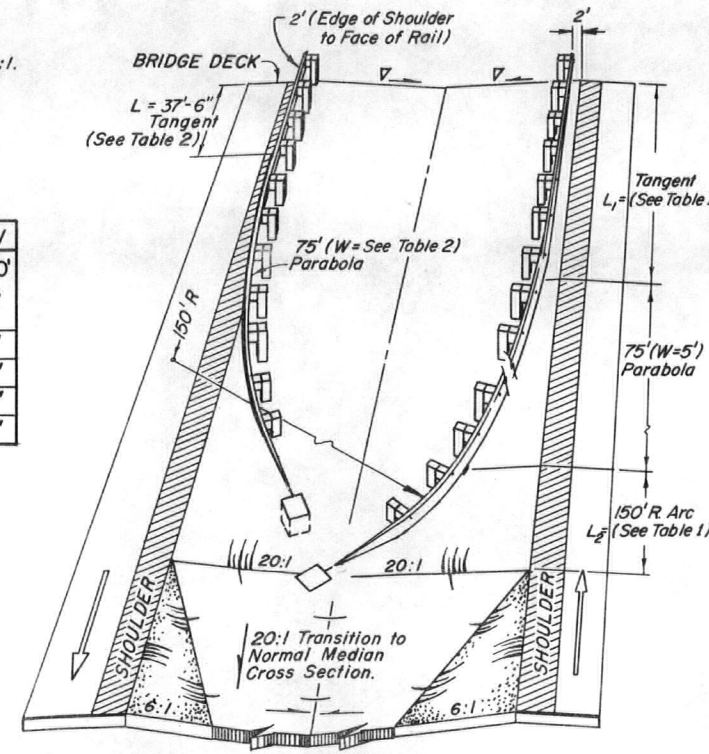

(R-1) 31' to 59' MEDIAN

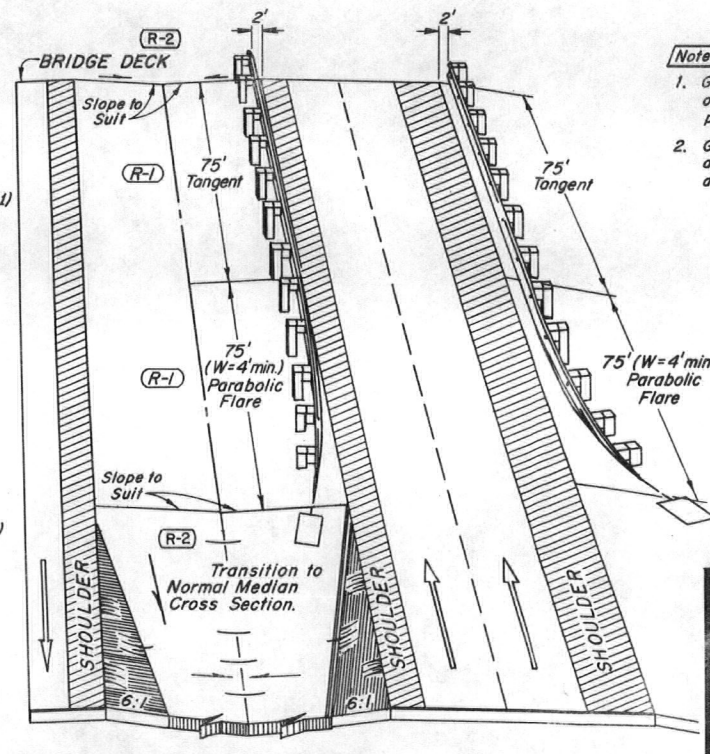

(R-1) MEDIAN 60' AND OVER

DEPARTMENT OF HIGHWAYS
STATE OF COLORADO
DIVISION OF HIGHWAYS

GUARD RAIL TYPE 3


Designed by M.R.H. Approved by J.R.B.
Made by J.R.B. Staff Design Engineer
Checked by R.S.M. Date: March 1, 1968

STANDARD M-606-AB



(MARCH 1, 1968)
(SHEET 3)

FEDERAL ROAD REGION NO.	DIVISION	PROJ. NO.	SHEET NO.	TOTAL SHEETS
9	COLORADO			



REVISIONS			
R-1	7-10-68	Entire sheet redone.	M.R.H.
R-2	4-1-69	Recovery area. Delete timber bevel. Refl. tab.	M.R.H.
R-3	2-18-70	Pay Length.	M.R.H.
R-4	11-25-70	Block at pier.	M.R.H.

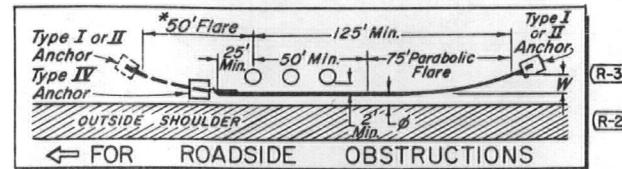

*2-Lane Highways — The exit end of Guard Rail shall extend 50 ft. past the end of theoretical need and shall be flared and anchored.

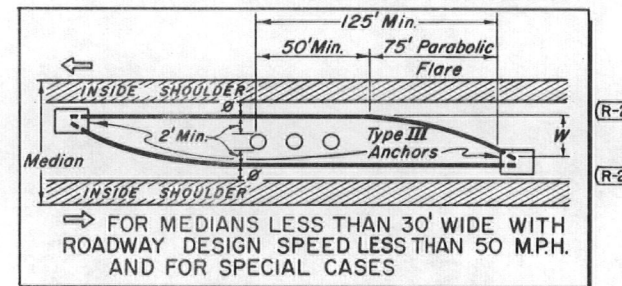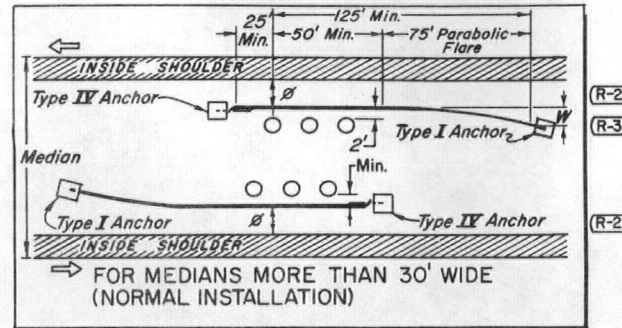


NON-CONTINUOUS RAIL

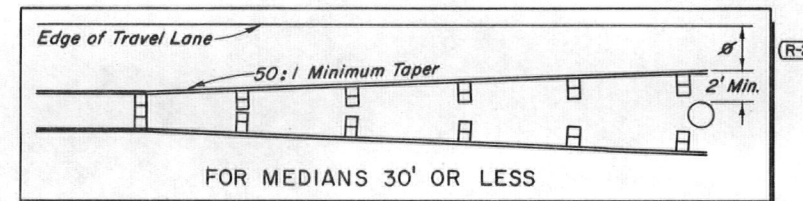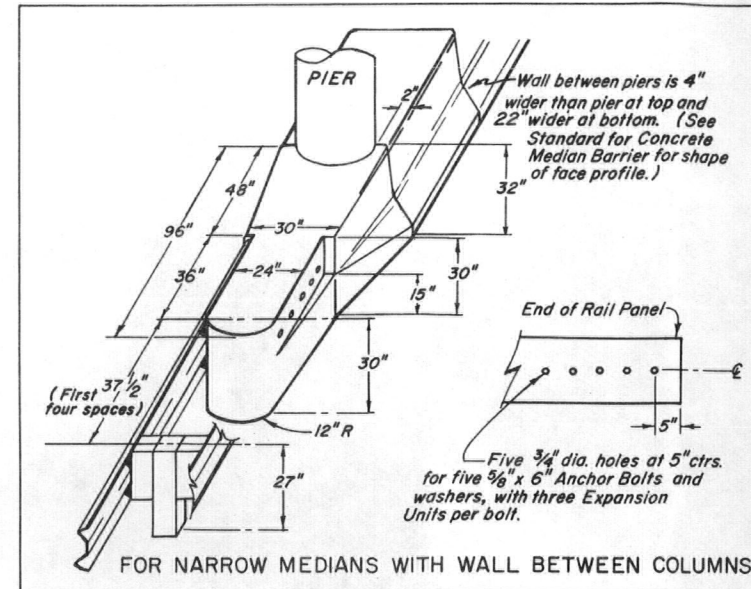



CONTINUOUS RAIL

When slope is 6:1 or flatter and an obstruction is present, increase where possible, to allow more area for vehicle recovery.


TYPICAL GUARD RAIL FOR OBSTRUCTIONS

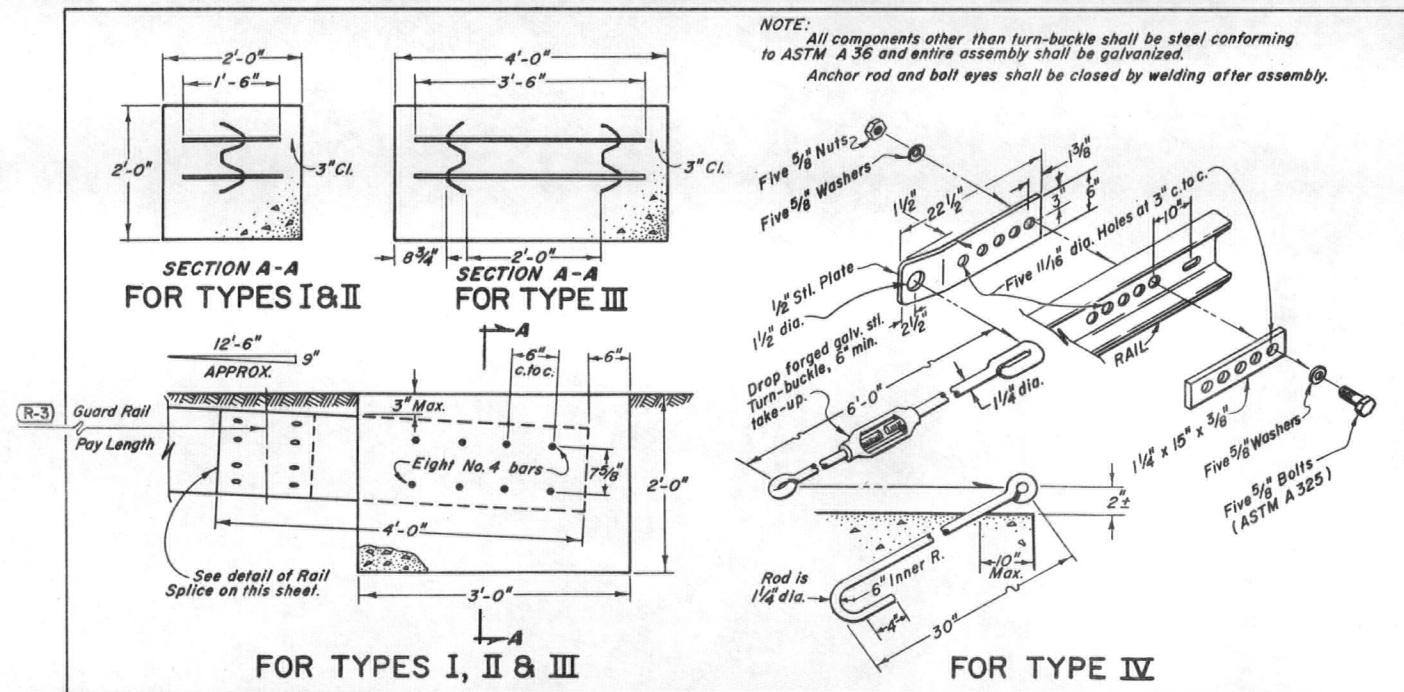

DETAILS FOR TYPICAL END ANCHORAGE

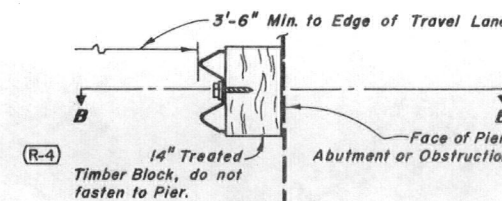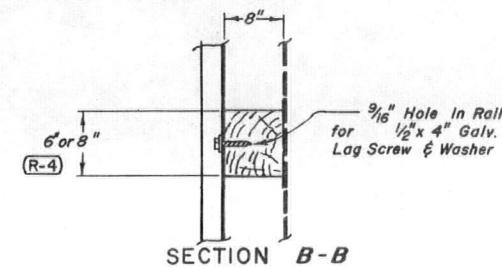


SEE TABLE ON SHEET 1 FOR TIMBER CROSS SECTION

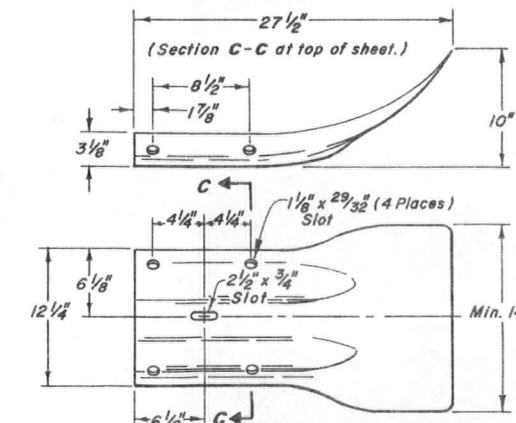


NOTE: Slots shown shall match outer 4 and center Rail-end slots.

DETAIL OF RAIL AND SPLICE

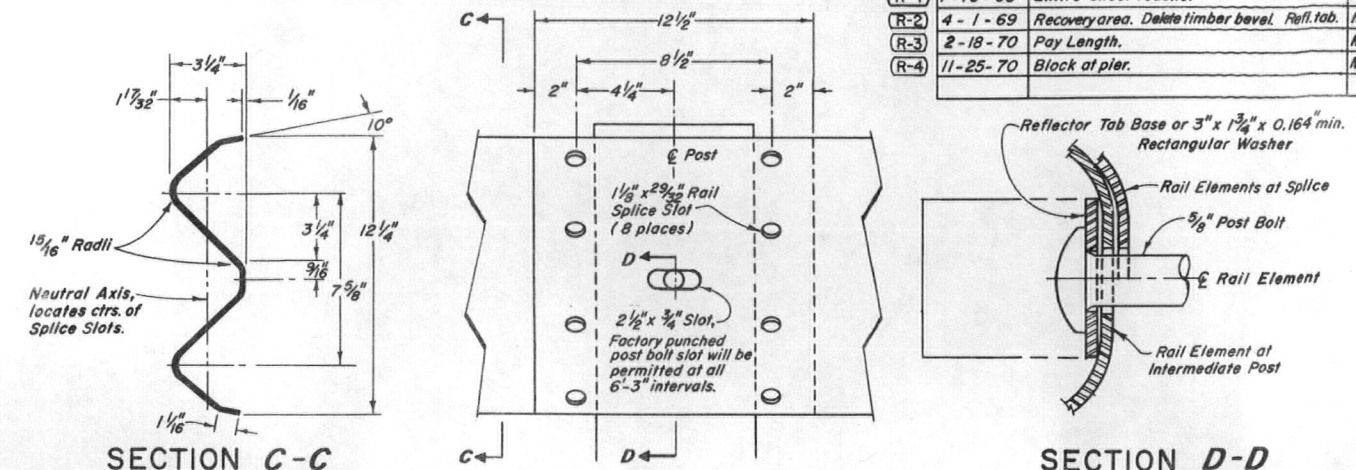

RECTANGULAR WASHER DETAIL

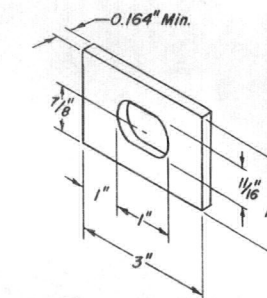

REFLECTOR TAB DETAIL

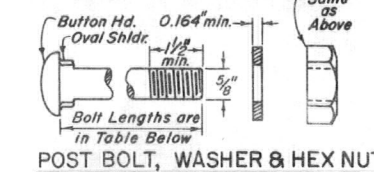
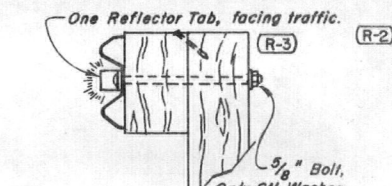
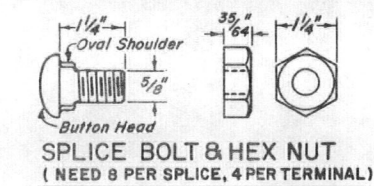
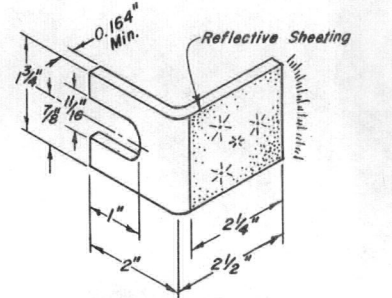


TABLE OF POST BOLT SIZES

Block	Post	RAIL	BOLT SIZE
6" x 8" x 8"	Double	5/8" x 25 3/4"	
8" x 8"	Single	5/8" x 17 1/2"	

NOTE: When 6" x 8" timber is used, the 8" dimension shall be perpendicular to the roadway.

DEPARTMENT OF HIGHWAYS
STATE OF COLORADO
DIVISION OF HIGHWAYS



GUARD RAIL TYPE 3

Designed by M.R.H. Approved by J.R.B.
Made by J.R.B. Staff Design Engineer
Checked by R.S.M. Date: March 1, 1968

STANDARD M-607-A




(SHEET 1 OF 2 SHEETS)
(JULY 1, 1965)

FED. ROAD REG. NO.	DIVISION	PROJECT NO.	SHEET NO.
9	COLORADO		

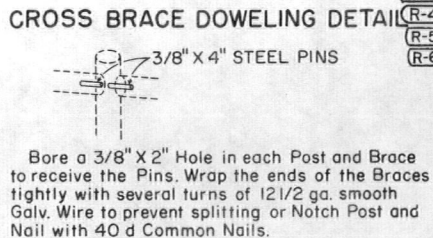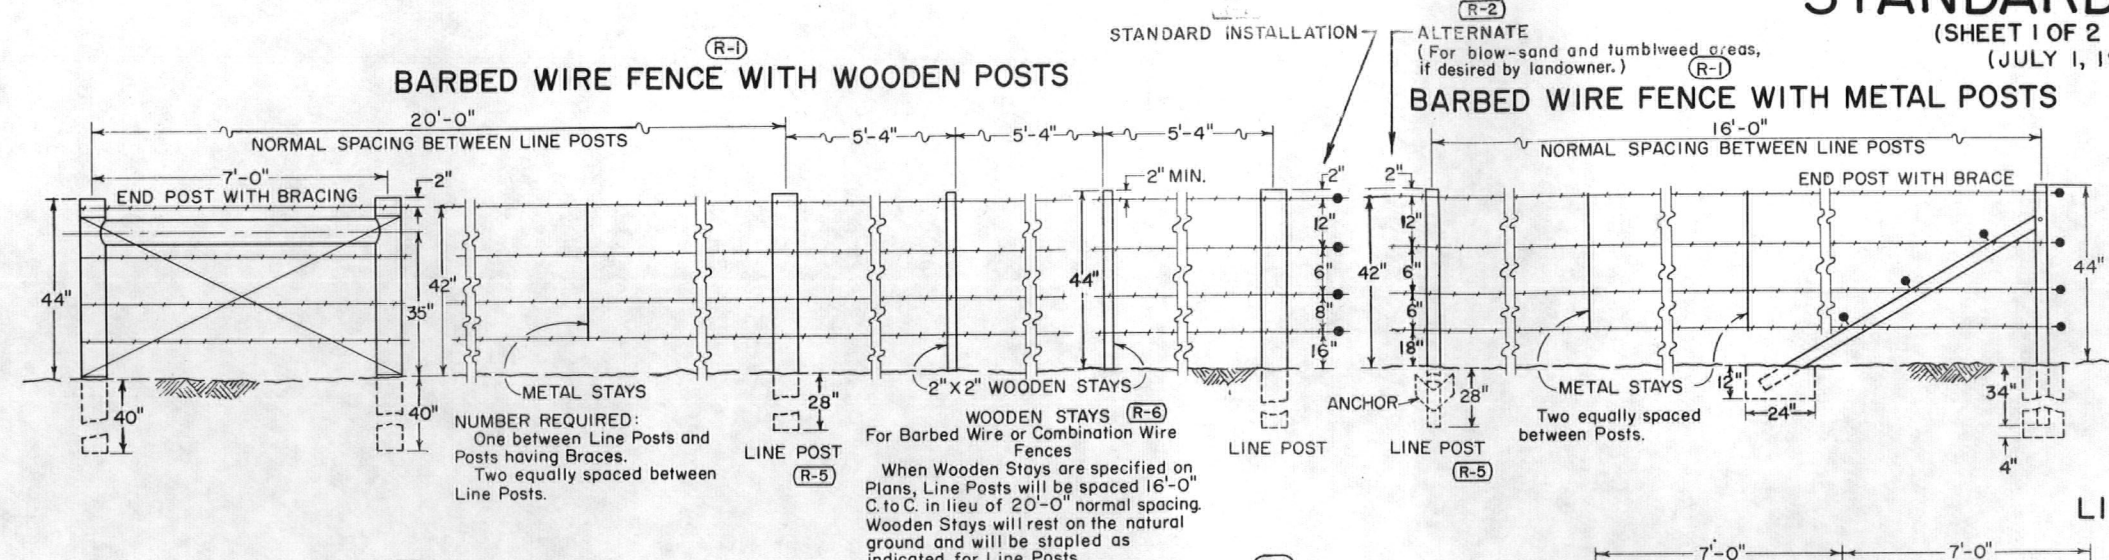


REVISIONS			
(R-1)	8-2-66	Vertical Dimensions and Note	M.R.H.
(R-2)	12-8-66	Vert. Dims., Std. and Alternate	M.R.H.
(R-4)	5-6-68	Eyebolt Note and Title Block	M.R.H.
(R-5)	7-25-69	Revise post lengths	M.R.H.
(R-8)	9-15-69	Stays	M.R.H.




(R-1) NOTE:
See Sheet 2 for General Notes.

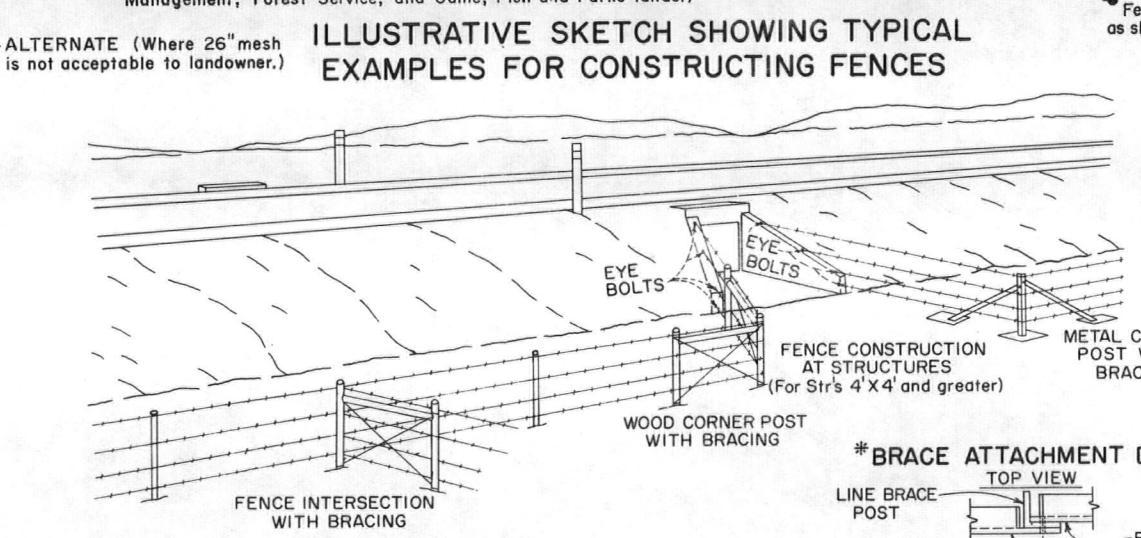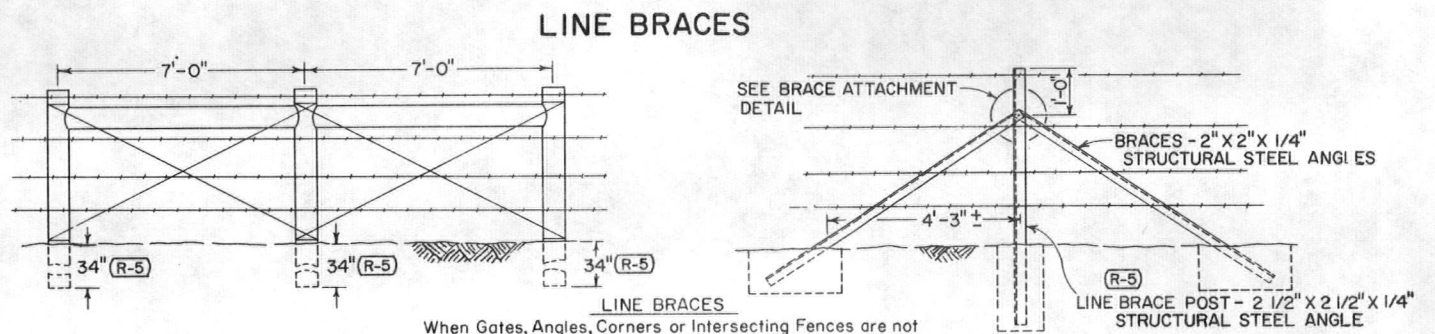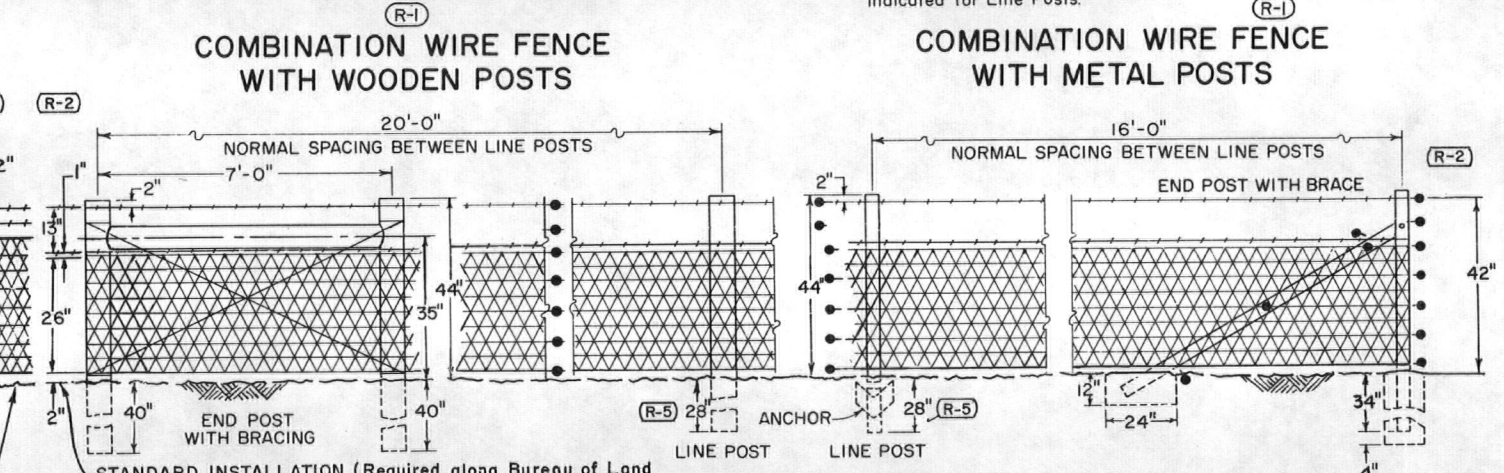

Fence wire will be stapled to wooden posts or tied to metal posts as shown marked ● on barbed wire or combination wire fence details.

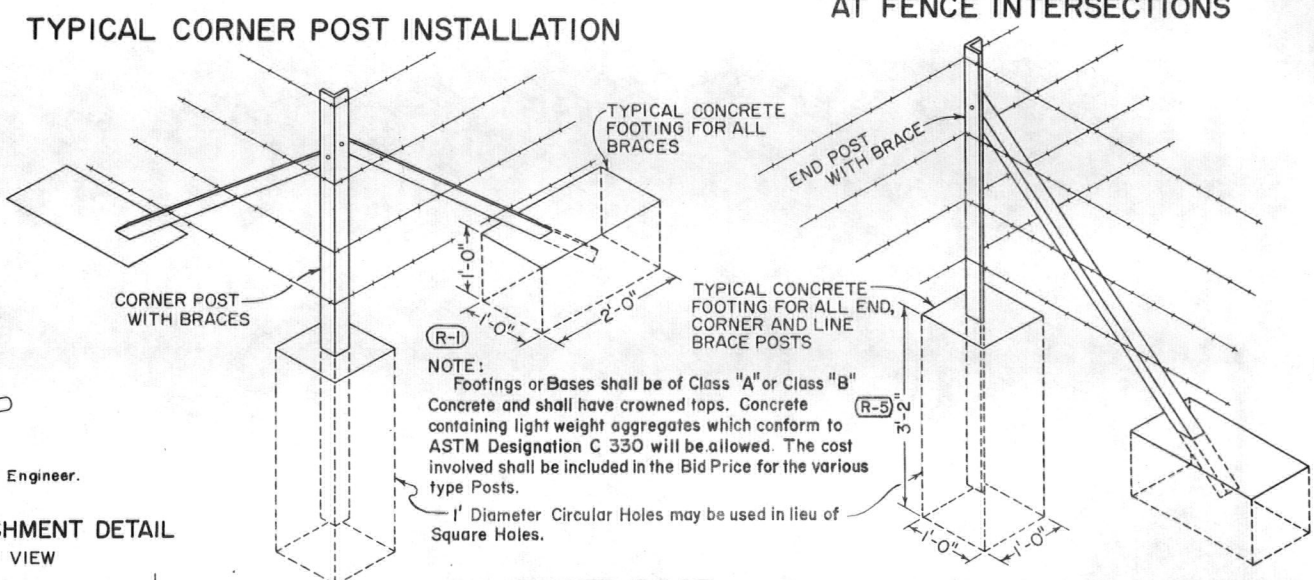

NOTE:
Footings or Bases shall be of Class "A" or Class "B" Concrete and shall have crowned tops. Concrete containing light weight aggregates which conform to ASTM Designation C 330 will be allowed. The cost involved shall be included in the Bid Price for the various type Posts.
1" Diameter Circular Holes may be used in lieu of Square Holes.

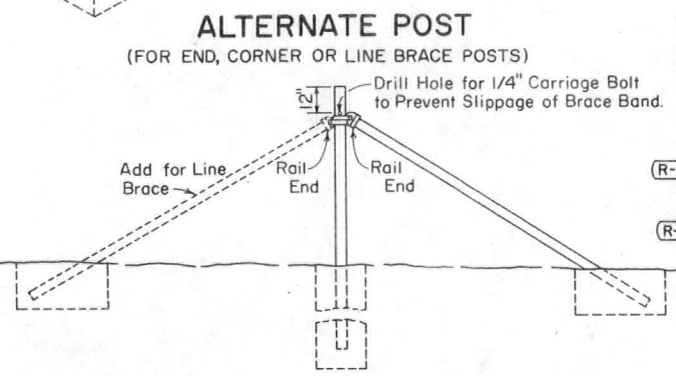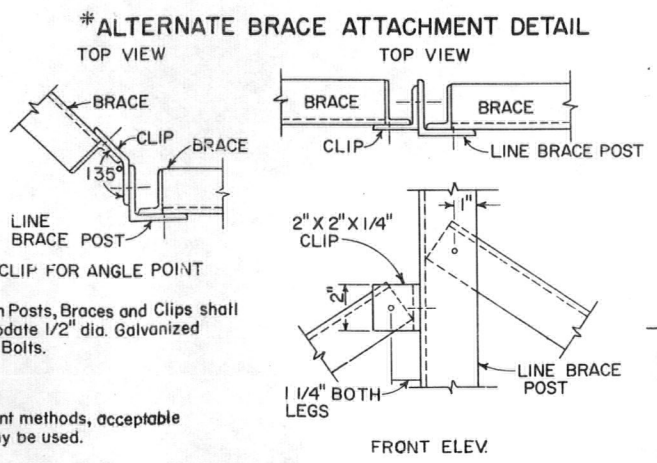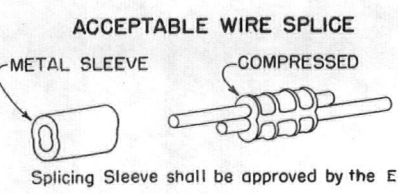

NOTE:
At all structures of 4' x 4' and over, the fence shall be ended at eye-bolts in the wings of the structure. Where the type of structure prohibits the use of eye-bolts, an end post with brace shall be used. Eye-bolts shall be made of 1/2" round bars with a minimum of six (6) inches of body length embedded in the concrete (hooked or bent) and a minimum of 1" inside eye diameter.
Eye-bolts shall be furnished and installed by the Contractor. Cost of eye bolts will be included in the contract price for fencing.

DEPARTMENT OF HIGHWAYS
STATE OF COLORADO
DIVISION OF HIGHWAYS

WIRE FENCES AND GATES


Designed by L.E.O. Approved by T.E.F. Staff Des. Eng.
Made by T.E.F. Staff Des. Eng.
Checked by E.E.O. Date: July 1, 1965

STANDARD M-607-A


(SHEET 2)
(JULY 1, 1965)

FED. ROAD REG. NO.	DIVISION	PROJECT NO.	SHEET NO.
9	COLO.		


REVISIONS			
(R-1)	8-2-66	Vert. Dims. & Gen'l. Notes	M.R.N.
(R-2)	12-8-66	Vert. Dims., Std. and Alternate	M.R.H.
(R-3)	2-6-67	Gate and General Notes	M.R.H.
(R-4)	5-6-68	General Notes and Title Block	M.R.H.
(R-5)	7-25-69	Revise post lengths, Gen. notes	M.R.H.
(R-6)	9-15-69	General Notes	M.R.H.

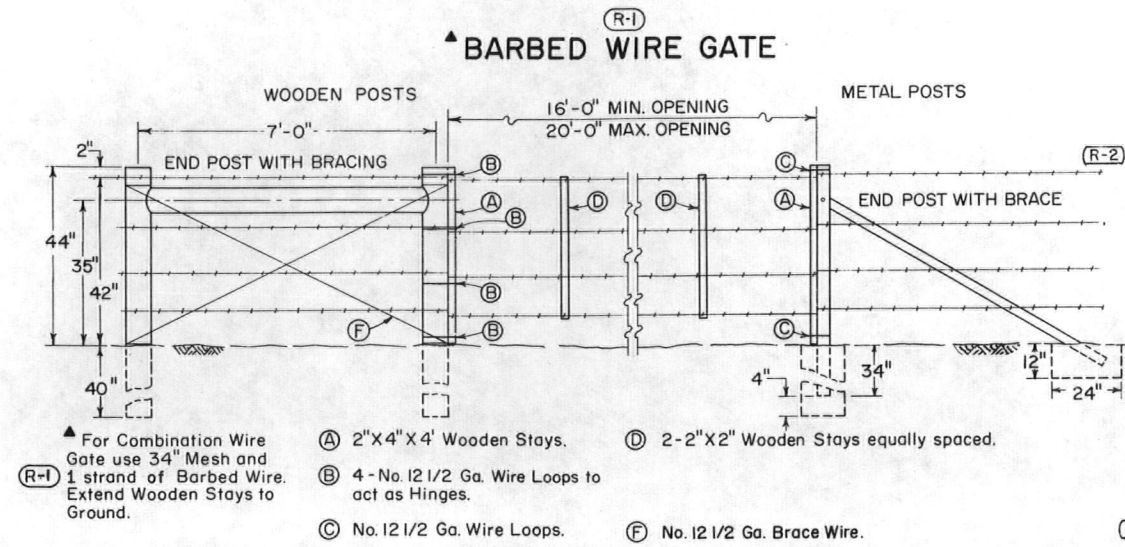



FENCE WIRE TIES

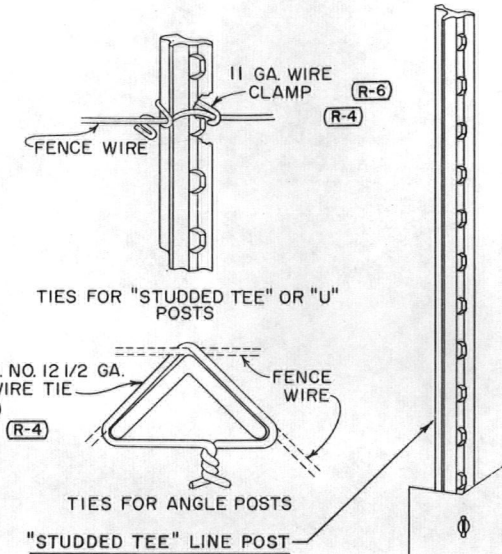

TYPICAL METAL POSTS


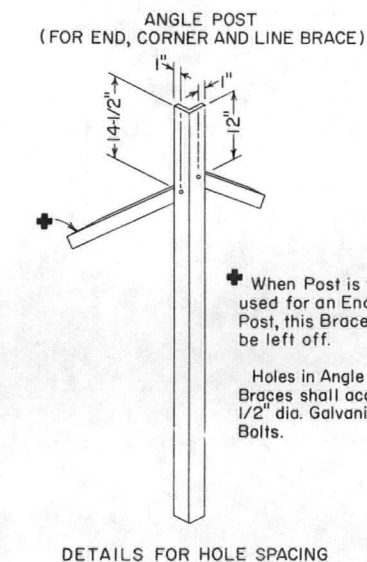


POST POINTING DETAILS

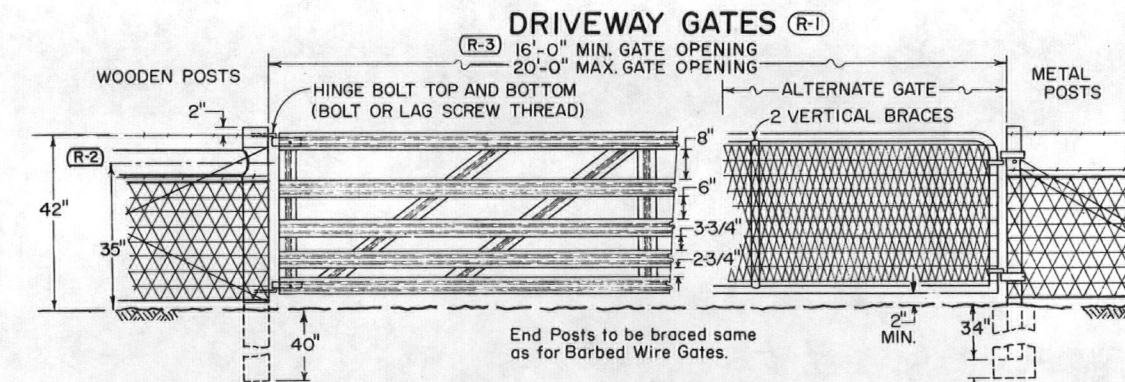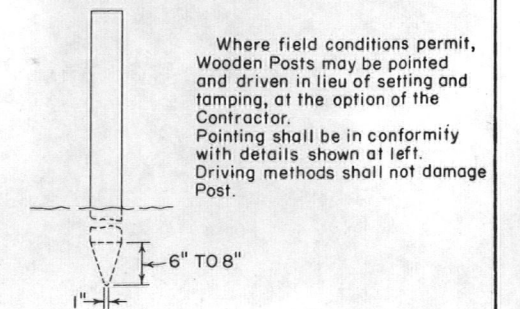

GENERAL NOTES

- (R-5) All work shall be done in accordance with the Standard Specifications applicable to the Project. All material dimensions and weights on this standard are nominal unless otherwise indicated.
- (R-1) At each location where an electric transmission, distribution or secondary line crosses a wood post fence the Contractor shall furnish and install a ground conforming to Section 9 of the National Electric Safety Code.
- (R-2) Dimensions shown for "Standard" and "Alternate" apply for both wooden and metal post fence.
- Fence wire shall be ended, double wrapped and tied off at end posts, angle posts and line brace posts. Fence to be continued shall then be restarted in like manner.
- Fence wire to be placed on either road or field side of posts depending on local conditions, i.e. on curves the wire should be placed on the side of the post which would prevent tension on fence ties. This will also apply where wind drift, tumble weeds or other conditions would exert unusual pressure against the wire.
- (R-6) WOOD POSTS:
All line posts shall have a min. dia. of four (4) inches & be 6'-0" long. Min. All end, corner, intersection and brace posts shall have a minimum diameter of five (5) inches and be 7'-0" long.
Fence wire will be stapled to wooden posts or tied to metal posts as shown marked on barbed wire or combination wire fence details. Staples shall be No. 9 wire min., at least 1 1/2 inches long.
- METAL POSTS:
All posts and braces shall be of the types and weights shown or acceptable equivalents.
Holes to be provided in end, corner and gate posts as detailed.
- (R-5) CORNER AND LINE BRACE POSTS:
Type - 2 1/2" X 2 1/2" X 1/4" Structural Steel Angles.
Weight - 3.81 lbs./lin. ft.
Length - 6'-6" Min.
No. of Braces - 2
- (R-5) LINE POSTS:
Type - "Studded Tee" or "U".
Weight - 1.28 lbs./lin. ft. (without Anchor)
Length - 6'-0" Min.
Anchor - Securely fastened, with bearing surface sufficient to resist movement of post. Weight - 0.57 lb. Min.
- (R-5) END POSTS:
Type - 2 1/2" X 2 1/2" X 1/4" Structural Steel Angles.
Weight - 3.81 lbs./lin. ft.
Length - 6'-6" Min.
No. of Braces - 1
- (R-5) BRACES: (For Corner, End or Line Brace Posts)
Type - 2" X 2" X 1/4" Structural Steel Angles.
Weight - 3.08 lbs./lin. ft.
Length - Same as corner and end posts used.
Posts shall meet requirements of Par. 4.5 of U.S. Dept. of Commerce Commercial Standard 184-51. Acceptable material includes re-rolled railroad rails.

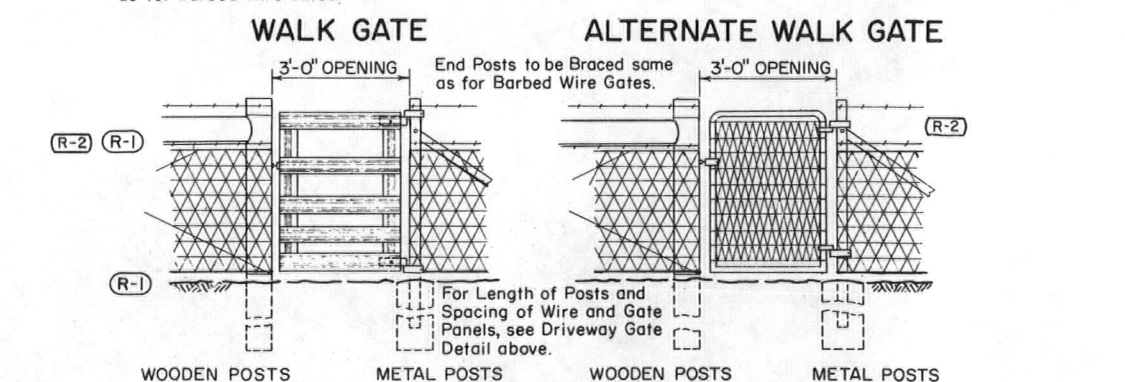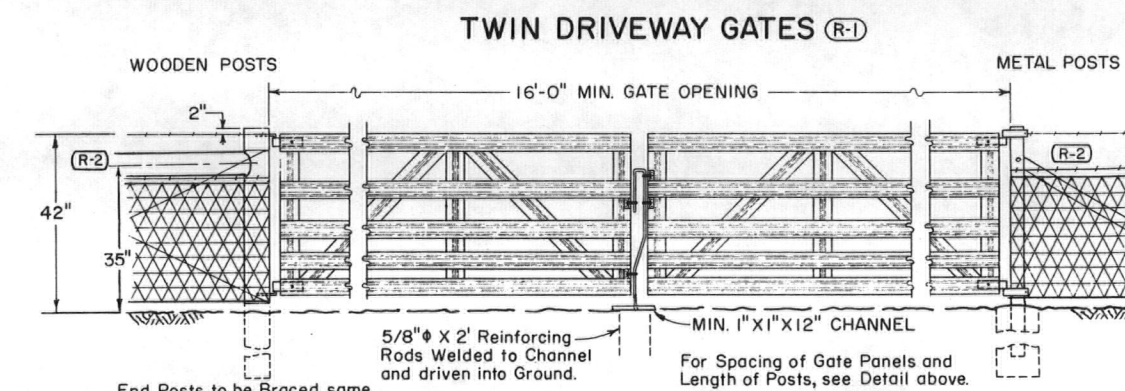

ALTERNATES:

- (R-4) END, CORNER AND LINE BRACE POSTS
Type - 2 1/2" Std. Galvanized Pipe.
Weight - 5.79 lbs./lin. ft. ± 5%

- (R-4) BRACES:
Type - 1 3/8" O.D. Tubular Steel with 2 1/2" Brace Band, Hinge Bolt and 1 3/8" I.D. Rail End; all Galvanized.
Weight - 1.6 lbs./lin. ft. ± 5%
Length - 6'-6" Min.

BARBED WIRE:

- (R-1) Steel barbed wire shall conform to ASTM Designation A 121, 12 1/2 Gauge with Class I coating.
Aluminum barbed wire shall conform to ASTM Designation B 211, with alloy 5052-0 for the line wire and alloy 5052-H38 for the barbs.

WIRE MESH:

- (R-5) 4 x 4" WIRE MESH
Wire mesh used in combination wire fence as shown shall be galvanized and conform to the following:

	STANDARD	ALTERNATE
Width	26"	34"
Weight - Lbs./Lin. Ft.	0.54	0.76
Horizontal Wires	2 Strands, No. 12 1/2 gage.	
Cross Wires	1 Strand, No. 14 1/2 gage Min.	

- Fabrication: cross wires to be woven with horizontal wires making a one piece fabric.

GATES:

- (R-5) DRIVEWAY GATES:
Height - approximately 42" (5 panels) --- Width of gate opening - 16'-0" Min.
Weight - Galvanized Steel, 75 lbs. --- Tempered Aluminum, 45 lbs.
Gates to be of Riveted construction as follows: Min. 4 No. 10 rivets at each right angle connection and where diagonal braces connect to horizontal panels; Min. 3 No. 10 rivets where diagonal braces connect to top and bottom panels.
- (R-5) ALTERNATE DRIVEWAY GATES:
Height - 42"
Weight - Not less than 90 lbs. complete with latch and hinges.
Width of gate opening - 16'-0"
Gate Frame - 1" I.D. Standard Galvanized Pipe or acceptable equivalent and shall be of all welded construction.
Mesh to be of same construction as shown for 4" x 4" wire mesh except it shall be 2" x 4" mesh.

WALK GATES:

- (R-5) WALK GATES:
Height - approx. 42" (5 panels)
Weight - Galvanized Steel, 16 lbs.
Tempered Aluminum, 10 lbs.
Width of gate opening - 3'-0"

- (R-6) All fence wire ties, clips, clamps, staples and other wire appurtenances shall be galvanized in accordance with ASTM Designation A 116, Class 1.

ALTERNATE WALK GATES:

- (R-1) ALTERNATE WALK GATES:
Height - 42"
Weight - Not less than 18 lbs. complete with latch and hinges.
Width of gate opening - 3'-0"
Gate Frame - 3/4" I.D. Standard Galvanized Pipe or acceptable equivalent and shall be of all welded construction.
Mesh to be of same construction as shown for Driveway Gate.

Alternate equivalent standard metal gates other than shown will be acceptable subject to the Engineer's approval.

In lieu of galvanized finish on gate frames, Cadmium Plated pipe or Aluminum painting will be considered to be equivalent.

LATCHES AND HINGES:

- Galvanized steel or Aluminum of standard make.
Hinges shall be placed as shown, to prevent theft.
In lieu of standard make latches it will be permissible to use an electro-galvanized chain, eyebolt and snaphook type latch. Eyebolt, chain and snaphook assembly to be secured to latch side of gate. Gate closure effected by wrapping chain around end post and snapping hook into chain.

WOODEN STAYS

Wooden stays shall be untreated native timber. Stay dimensions, including length, shall have a tolerance of ± 1/4".

DEPARTMENT OF HIGHWAYS
STATE OF COLORADO
DIVISION OF HIGHWAYS

WIRE FENCES AND GATES

Designed by L.E.O. Approved by T.E.F. Staff Des. Engr.
Made by T.E.F. Staff Des. Engr.
Checked by E.E.O. Date: July 1, 1965


CLASS I BARRICADES (3 RAILS)

STANDARD M-614-A

(JULY 1, 1965)

FEDERAL ROAD REGION NO.	DISTRICT	PROJECT NO.	SHEET NO.
9	COLORADO		




REVISIONS			
(R-1)	11-15-68	Rev. Dept. Name & Code Nos.	JLS
(R-2)	4-23-69	Rev. Code No. & Notes	JLS

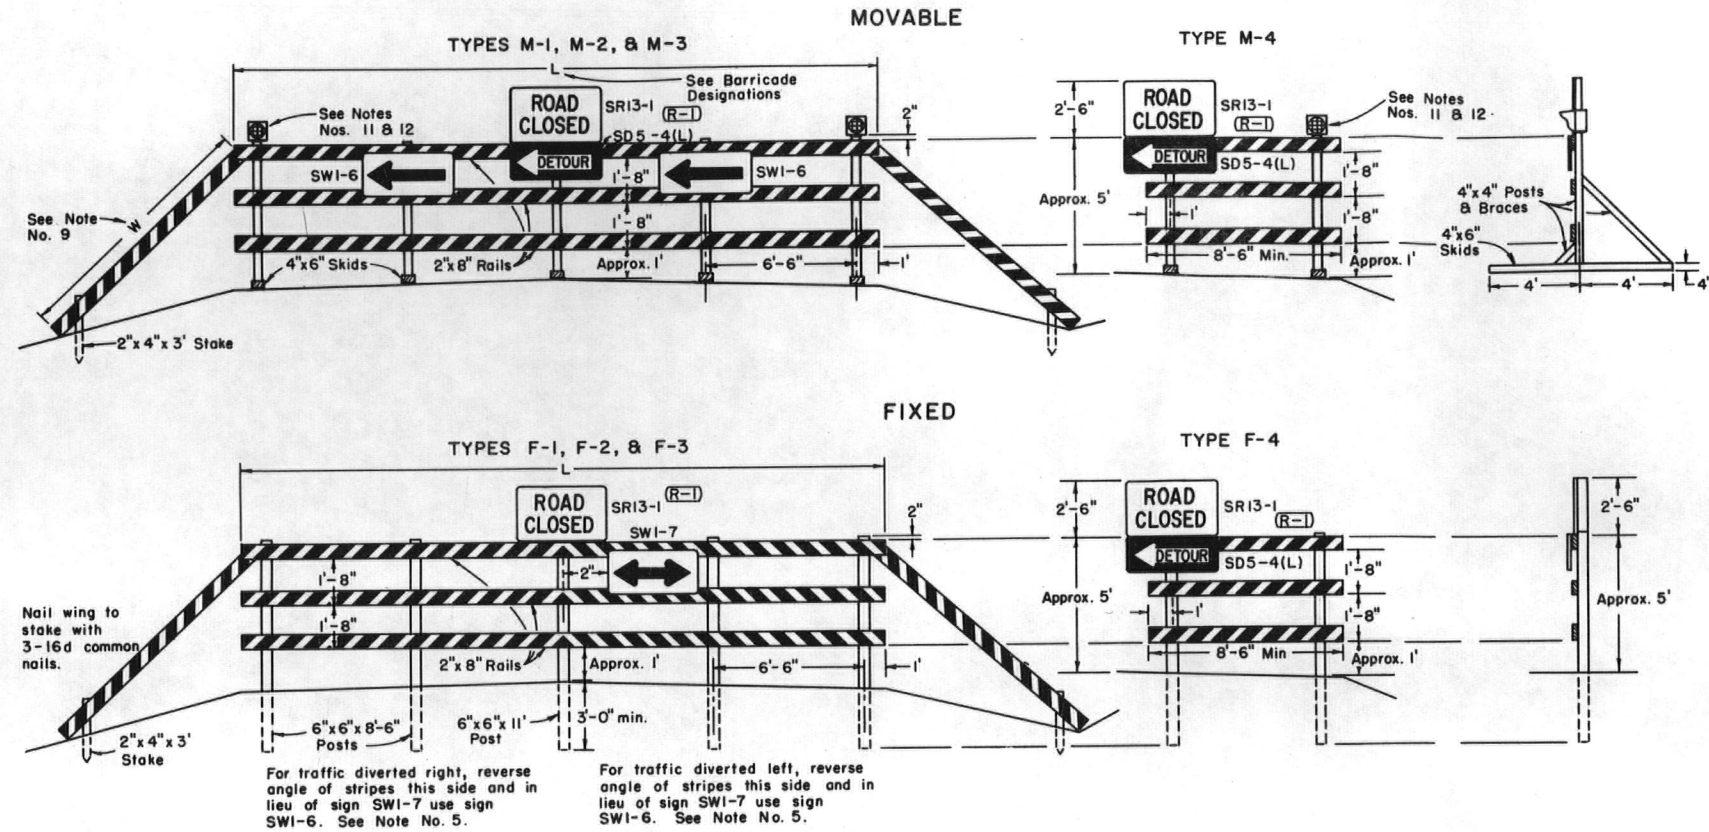



GENERAL NOTES

- All work shall be done in accordance with the Standard Specifications applicable to the Project.
- All signs and sign materials shall conform to the standards set forth in the "Manual on Uniform Traffic Control Devices for All Classes of Streets and Highways" published by the Division of Highways and this standard.
- The various types and combinations of approved Signs and Beacons for Barricades required for each project shall be governed by field conditions and subject to approval by the Engineer. All traffic controls shall be placed for best visibility and legibility and maintained in good condition at all times. Oversigning is to be avoided.
- Painting shall conform with Subsection 508.08 of the Standard Specifications. All skids, braces, and posts shall be painted with 2 coats of "Exterior Black Paint." Planking and wings on all barricades shall be painted with 2 coats of "Exterior Black Paint" on all sides before adding reflective strips. Reflective strips shall be "cut from smooth surface yellow reflective sheeting" of a type approved by the Division.
- Each barricade rail shall be striped on the face side only with reflective yellow strips slanting downward at a 45° angle toward the side to which traffic is to turn or pass. See "DETAIL OF RAIL AND WING STRIPING."
- When barricades are designated on plans the portion of the posts below ground line shall either be dipped in or painted with hot creosote oil. The portion of the post above ground line shall be painted with 2 coats of "Exterior Black Paint."
- All skids, braces, and posts shall be nailed together with No. 20d nails. All screws, bolts, nuts, and washers shall be galvanized or cadmium plated. Skids (bases) of movable barricades shall be weighted where necessary to provide stability.
- All timber shall be Standard Grade or better, S4S, Douglas Fir or Larch, as described in the 1965 Standard Grading Rules published by the Western Wood Products Association, and shall conform to paragraph 123 c for the rails and paragraphs 122 c and 125 c for the posts.
- Detachable extension wings for bypassing of construction equipment are permitted. "W" is variable, length shall be adequate to provide closing of borrow pit and/or shoulder as required.
- Alternate materials or other reflective elements on Traffic signs or Barricades will be permitted only after approval of such material by the Division in writing.
- A Flashing Beacon for use on Barricades is a section of a standard traffic signal head or a similar-type device having a yellow lens in the face, which is illuminated by intermittent flashes. Where commercial power is not available, the beacon may be adapted to operate from storage batteries. Each signal unit lens shall have a visible diameter of not less than 8 inches. Each unit complete shall be of such design as to render the lens when illuminated clearly visible to traffic facing the signal at all distances up to 1000 feet under all atmospheric conditions except dense fog. The color of the yellow lens for caution shall be in accordance with Technical Report No. 1 of the Institute of Traffic Engineers. All beacon flashers shall be equipped with filters for suppression of radio interference. The illuminating element in a flashing yellow beacon shall be flashed at a rate of not less than 50 times nor more than 60 times per minute. The illuminated period of each flash shall be not less than half and not more than two-thirds of the total cycle. The use of Flashing Beacons will be governed by field conditions. Flashing Beacons when warranted generally should be operated continuously throughout the 24 hours of the day. Warrant for Flashing Beacons may be found in Sec. 3G of the "Manual on Uniform Traffic Control Devices for Streets and Highways" published by the U.S. Department of Commerce, Bureau of Public Roads, June, 1961 (or latest revision).
- Flashers are portable, power-operated, lens-directed, enclosed lights, illuminated by rapid intermittent flashes of short duration. Flashers may be used in connection with barricades when approved by the Engineer. An array of random flashers which tends to obscure rather than delineate the traveled way will not be permitted. The use of flashers on a job will be governed by Sec. 5D of the "Manual on Uniform Traffic Control Devices for Streets and Highways" published by the U.S. Department of Commerce, Bureau of Public Roads, June, 1961 (or latest revision). The color of the light emitted by a flasher shall be yellow.
- Flashing Beacons and Flashers, when used, shall be positioned above the top rail of the barricades to produce the most effective results.
- Barricades used as "Traffic Controls for Highway Construction" are not to be paid for separately.
- Barricades will be paid for separately when designated on plans as bid items.
- For additional general information on control of traffic through work areas refer to the "Manual on Uniform Traffic Control Devices for Streets and Highway", Part V, published by the U.S. Department of Commerce, Bureau of Public Roads, June, 1961 (or latest revision).

CLASS II BARRICADE (1 RAIL)

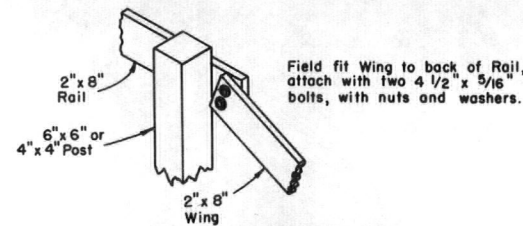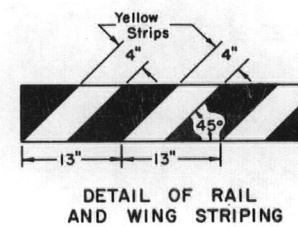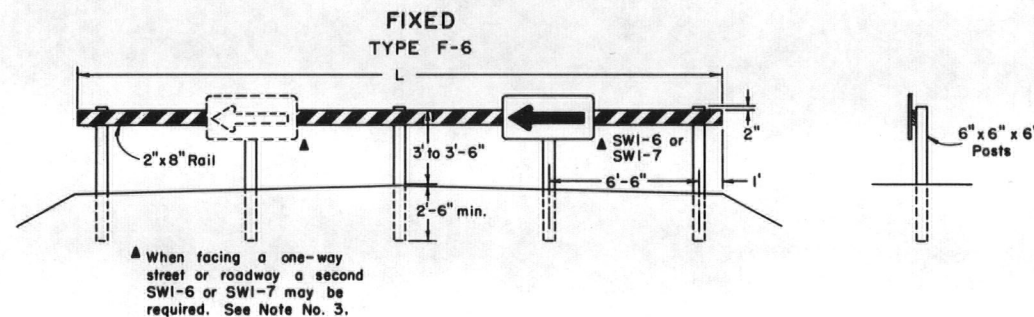

REAR VIEW OF BARRICADE SHOWING WING ATTACHED (See Note No. 9)

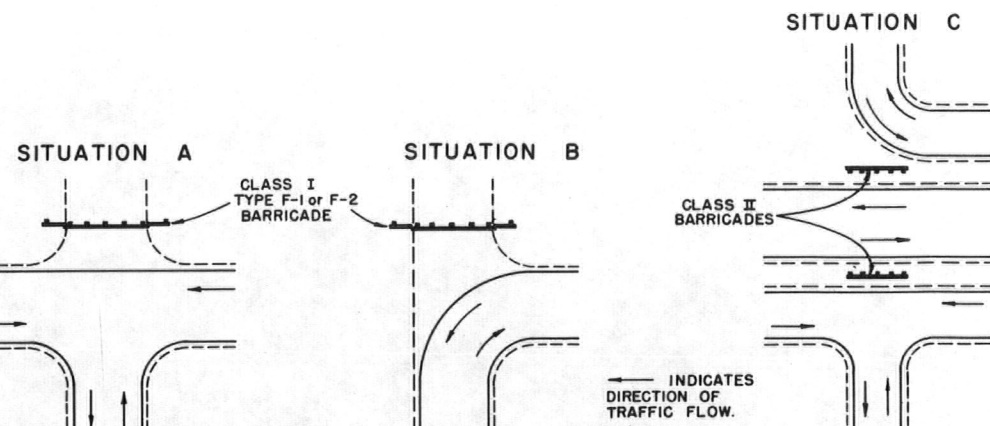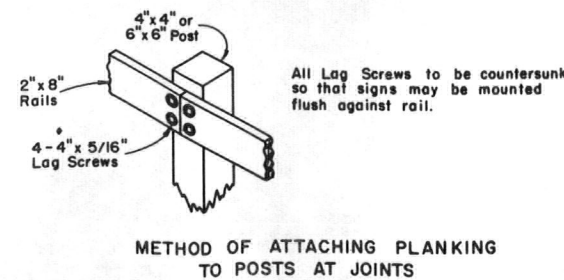

Class	Type		Roadway Width	L	Description	
	Movable	Fixed				
(R-1)	I	M-1	F-1	26'-34'	28'	Barricade complete with SR13-1 sign and SWI-6 or SWI-7 signs as required.
(R-2)	I	M-2	F-2	35'-44'	41'	Barricade complete with SR13-1 sign and SWI-6 or SWI-7 signs as required.
(R-1)	I	M-3	F-3	Variable	28'	Barricade (without extension wings) complete with SR13-1 sign and SWI-6 or SWI-7 signs as required.
	I	M-4	F-4	Variable	Variable 8'-6" min.	Wing Barricade (signs only as appropriate).
	II	-	F-6	Variable	28'	Barricade complete with appropriate signs.

DEPARTMENT OF HIGHWAYS
STATE OF COLORADO
DIVISION OF HIGHWAYS

TIMBER BARRICADES

Designed By: D.R.W.
Made By: JLS
Checked By: J.B.



Approved By: *[Signature]*
Date: JULY 1, 1965

STANDARD M-614-IC

JULY 5, 1968
(SHEET 1 OF 2 SHEETS)


FEDERAL ROAD REGION NO.	DISTRICT	PROJ. NO.	SHEET NO.	TOT. SHEETS
9	COLORADO			

REVISIONS				
(R-1)	7-26-68	Rev. Legend and Notes	G.W.F.	
(R-2)	5-20-69	Rev. Lateral Placement	J.J.B.	
(R-3)	9-25-70	Rev. Legend	J.J.B.	

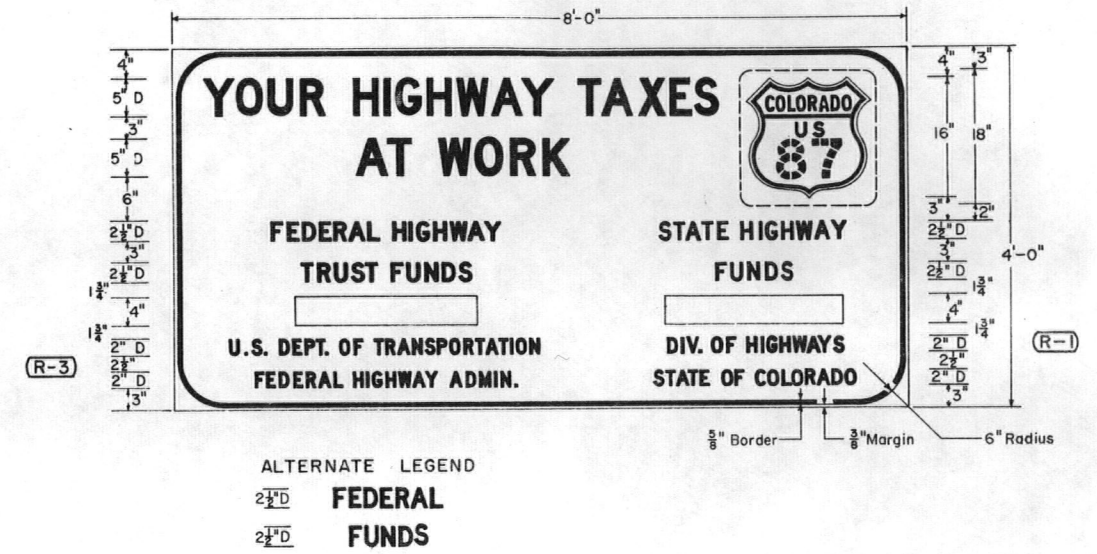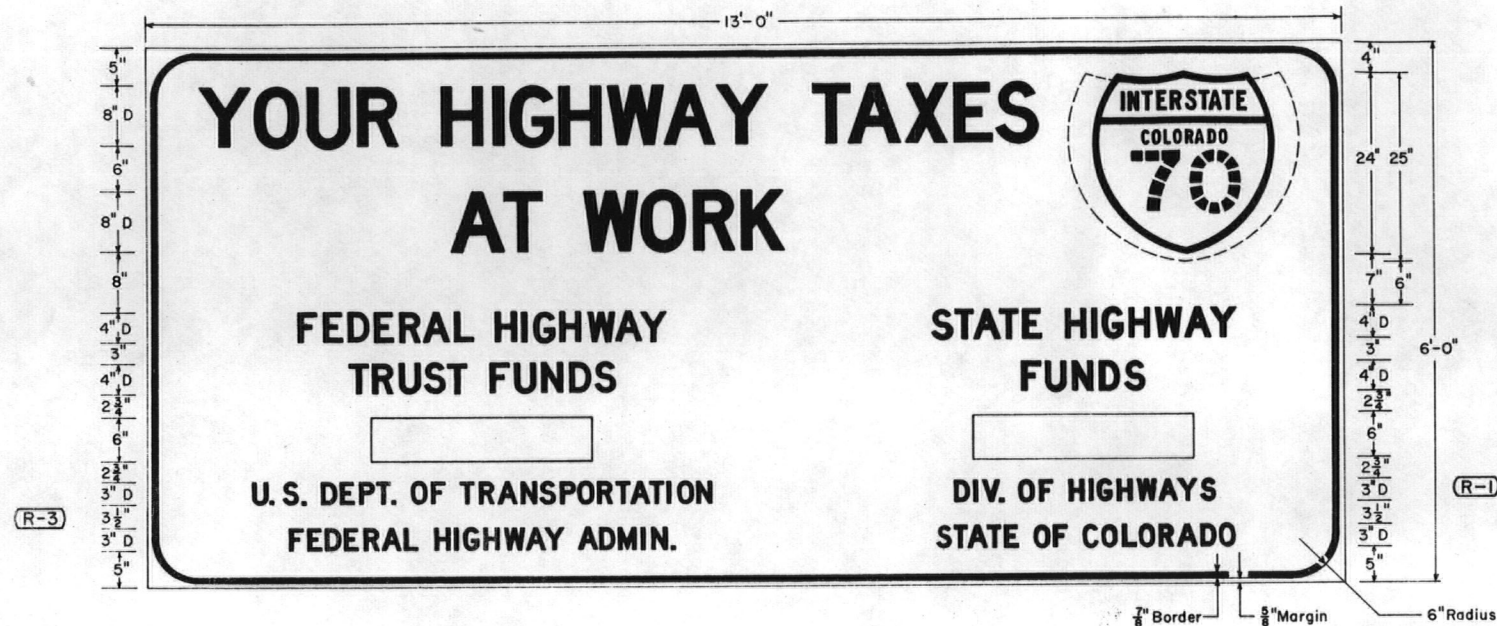


ALTERNATE LEGEND
4" D FEDERAL FUNDS

FABRICATION DETAILS

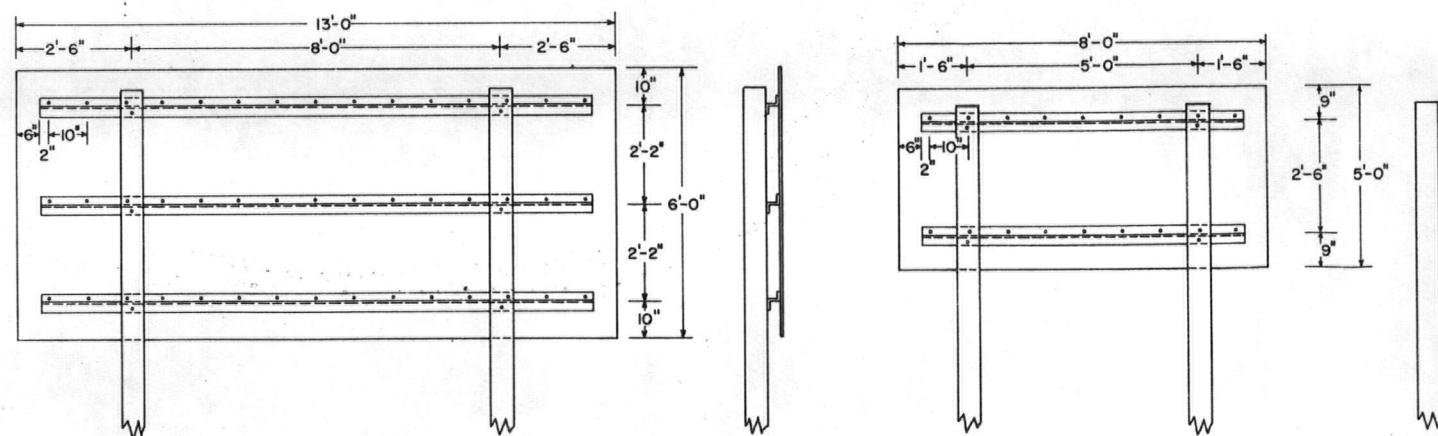


"AMOUNT OF FUNDS" PLAQUE DETAILS

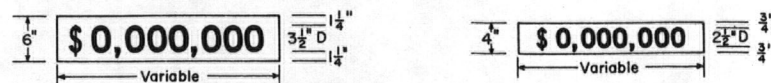

GENERAL NOTES

- These signs shall be furnished and installed by state forces.
- All work shall be done in accordance with Standard Specifications applicable to the Project.
- Signs are to be placed facing traffic approaching the Project. They shall be installed at a location where they will not obscure or detract from the effectiveness of other official signs.
- The lateral placement may be reduced to a minimum of 2 ft. outside of the shoulder edge where necessary to fit field conditions.
- When these signs are used on Beautification Projects, the words "HIGHWAY" and "TRUST" in lines 3 and 4 shall be deleted and the words "FEDERAL" and "FUNDS" shall be used in accordance with the spacing as shown under "Alternate Legend".
- Sign panel shall be fabricated with 3/4" plywood.
- Route Marker plaques and "Amount of Funds" plaques shall be sheet aluminum 0.080" min. thickness.
- Signs shall have a screen processed black legend and border on a plain white background. "Amount of Funds" plaques shall have a screen processed black legend on a plain white background.
- Route Marker plaques shall be plain as indicated on the applicable standards.
- Backing zees shall be 3" x 2 3/4" x 1/4". Steel zees shall weigh 6.7 lbs. per ft. and aluminum zees shall be of 6061-T6 alloy weighing 2.33 lbs. per ft.
- Posts shall be 6"x6", S4S timber, painted white.
- Each timber post shall be provided with two 2" diameter holes through the neutral axis, one at 6" and one at 18" above the ground level. The inside portion of each 2" diameter hole shall be painted white.
- Panels shall be fastened to backing zees with 1/4" thrust head lockbolt fasteners.
- Backing zees shall be fastened to posts with 3/8" machine bolts.
- Route Marker plaques and "Amount of Funds" plaques shall be fastened to the sign panels with 5/8" #9 round head wood screws.
- Exposed lockbolt fastener heads and wood screw heads on the face of the sign shall be dipped or painted to match the surrounding color.
- The underground portion of each timber post shall be treated with creosote.
- Where a third governmental agency is shown as participating, its official name should be included centrally in lines 6, 7, and 8.
- (R-1) It will not be necessary to change DEPT. to DIV. on any existing signs.

INSTALLATION DETAIL

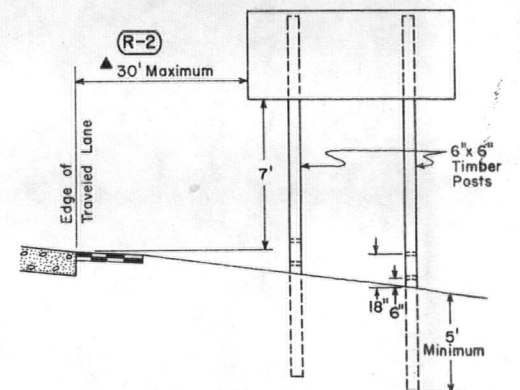

DEPARTMENT OF HIGHWAYS
STATE OF COLORADO
DIVISION OF HIGHWAYS

STANDARD
CONSTRUCTION
IDENTIFICATION
SIGNS


Designed By: J.L.S. Approved By: *[Signature]*
Made By: F.J.B. Traffic Engineer
Checked By: G.W.F. Date: July 5, 1968

STANDARD M-614-IC

JULY 5, 1968
(SHEET 2 OF 2 SHEETS)

FEDERAL ROAD REGION NO.	DISTRICT	PROJ. NO.	SHEET NO.	TOTAL SHEETS
9	COLORADO			

REVISIONS			
(R-1)	7-26-68	Rev. Legend	G.W.F.
(R-2)	5-20-69	Rev. Lateral Placement	J.J.B.
(R-3)	9-25-70	Rev. Legend	J.J.B.

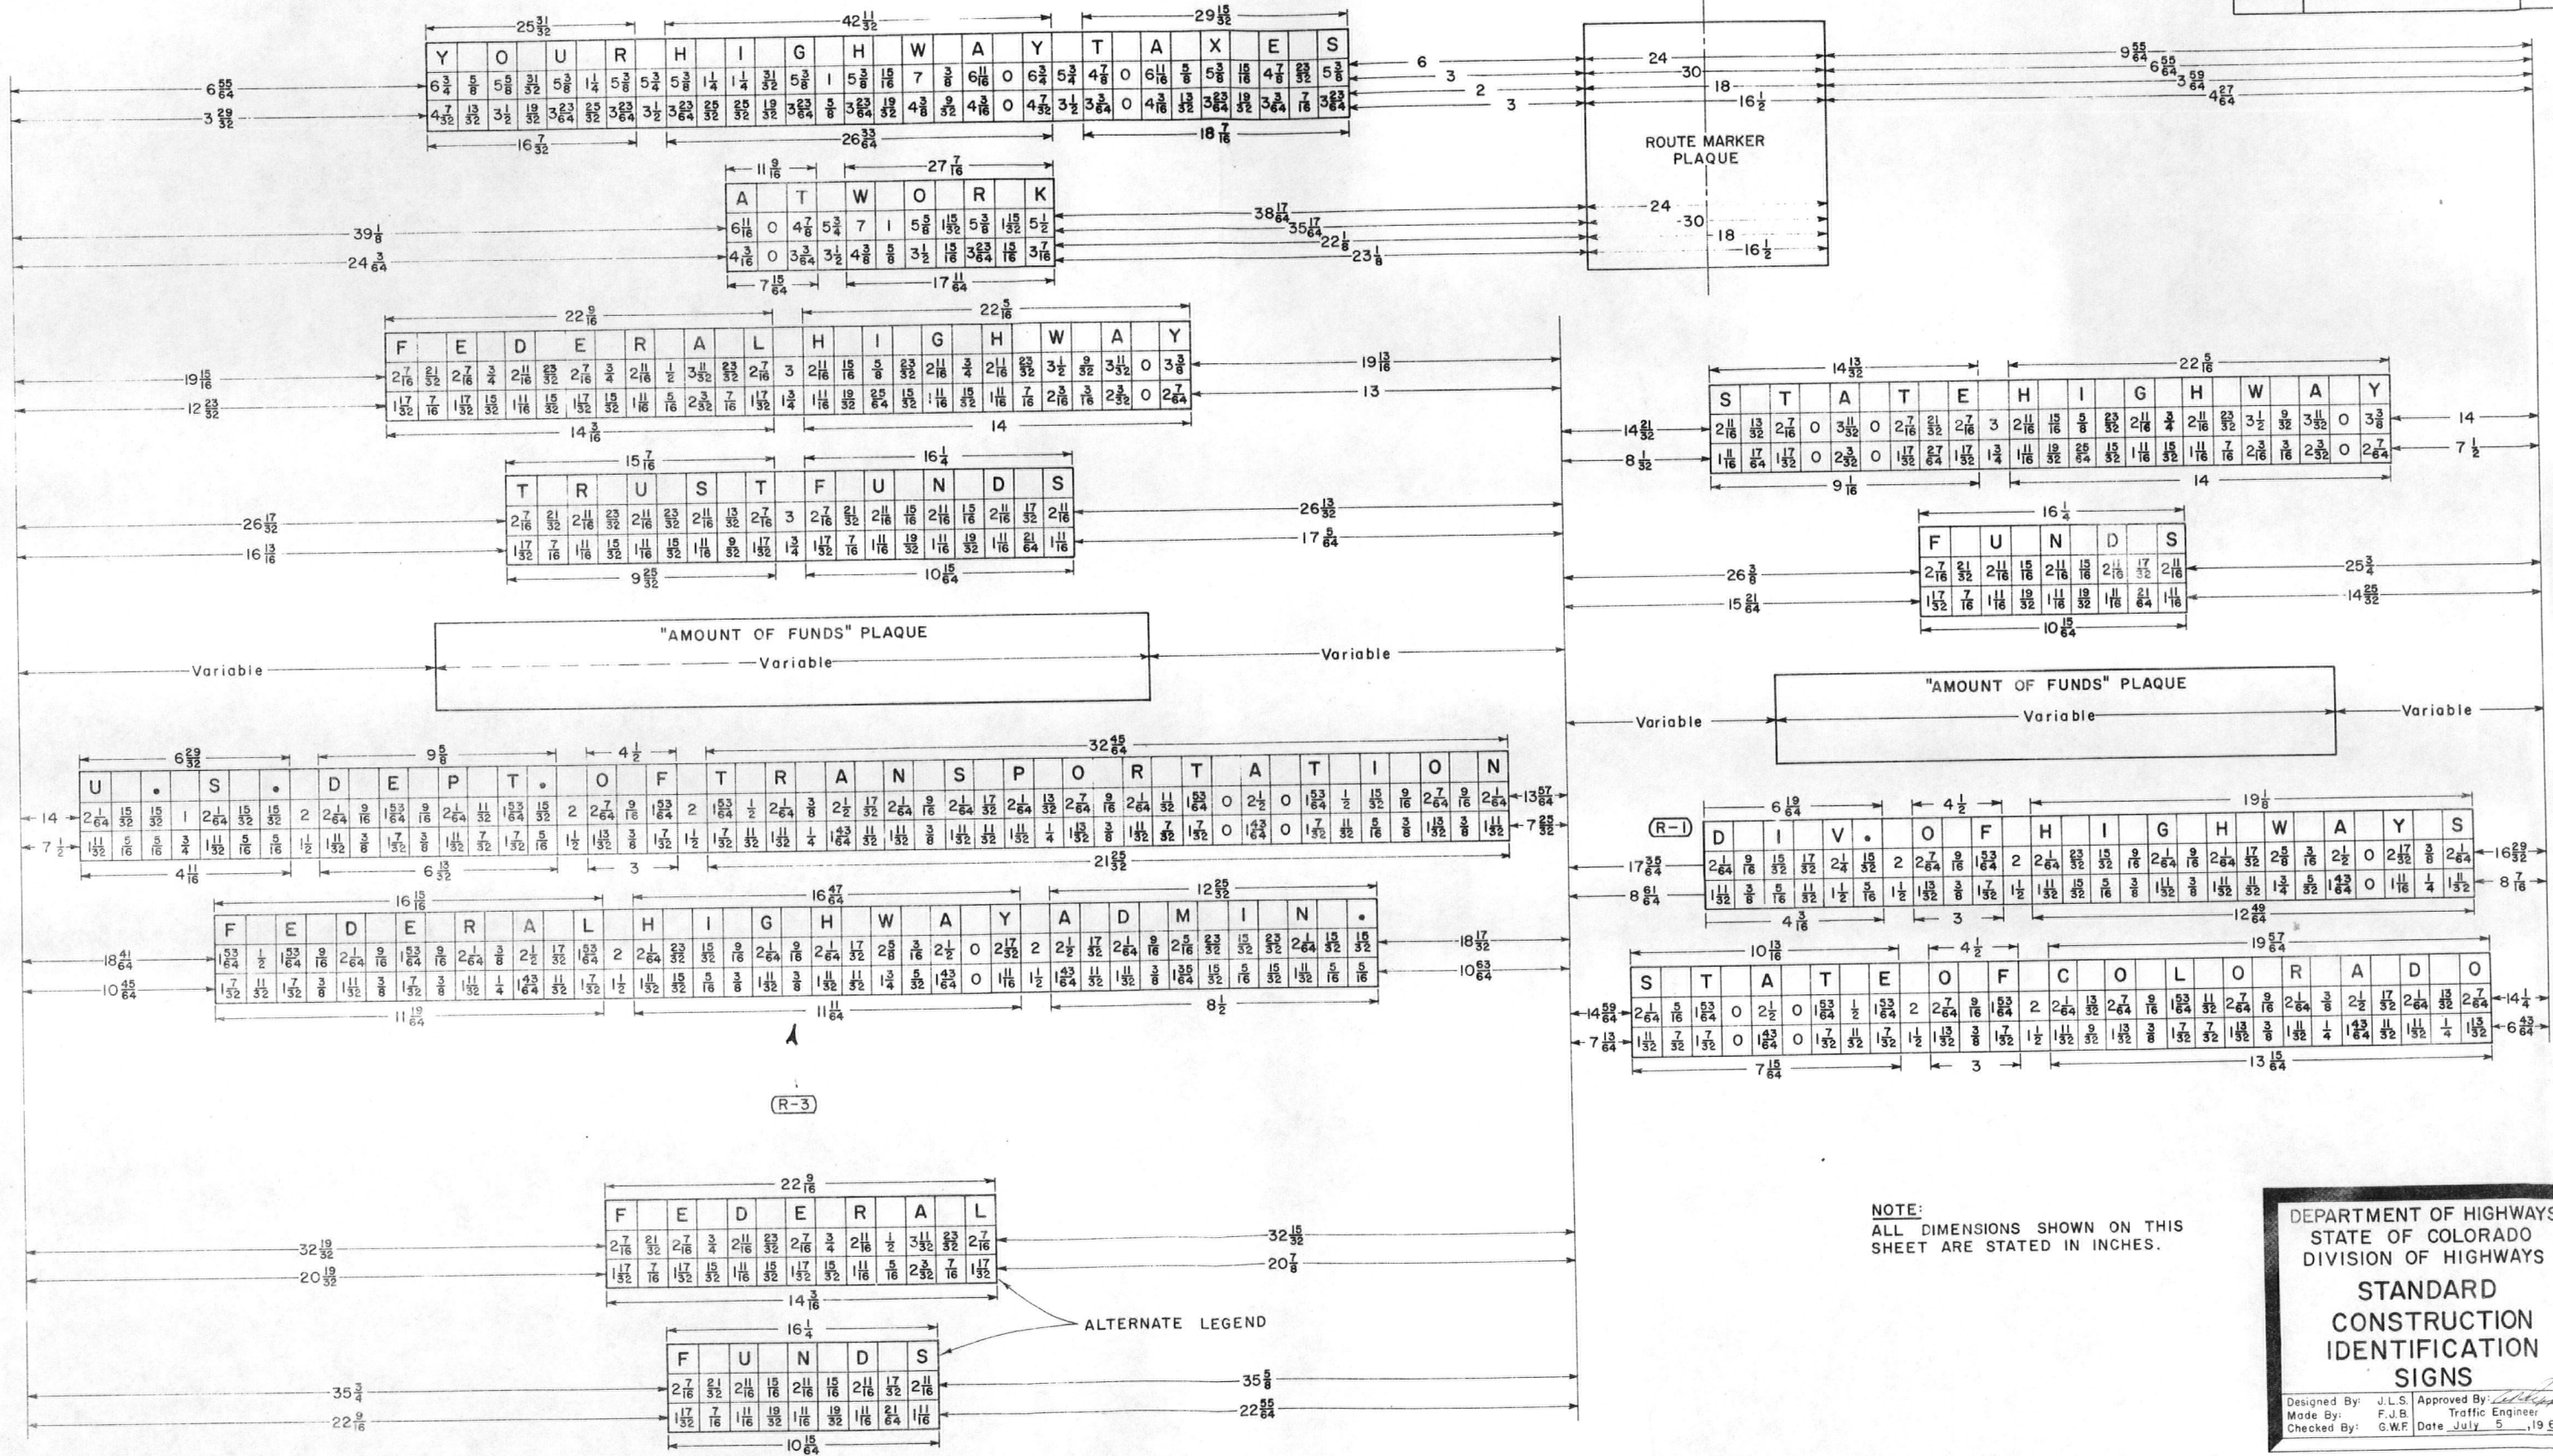

NOTE:
ALL DIMENSIONS SHOWN ON THIS SHEET ARE STATED IN INCHES.

DEPARTMENT OF HIGHWAYS
STATE OF COLORADO
DIVISION OF HIGHWAYS
STANDARD CONSTRUCTION IDENTIFICATION SIGNS
Designed By: J.L.S. Approved By: *[Signature]*
Made By: F.J.B. Traffic Engineer
Checked By: G.W.F. Date: July 5, 1968

STANDARD M-614-TB


(SHEET 1 OF 3 SHEETS)

(JULY 1, 1965)

FEDERAL ROAD REGION NO.	DIVISION	PROJECT NO.	SHEET NO.
9	COLORADO		



REVISIONS			
(R-1)	7-12-67	Note 23	G.W.F.
(R-2)	7-8-68	Rev. Break-away, Placement,	G.W.F.
(R-3)	12-24-68	Code No.s, & Dept. Name	J.L.S.
		Rev. U.S. Shields	J.L.S.

Typical Signing Where Traffic Is Prohibited Along Construction

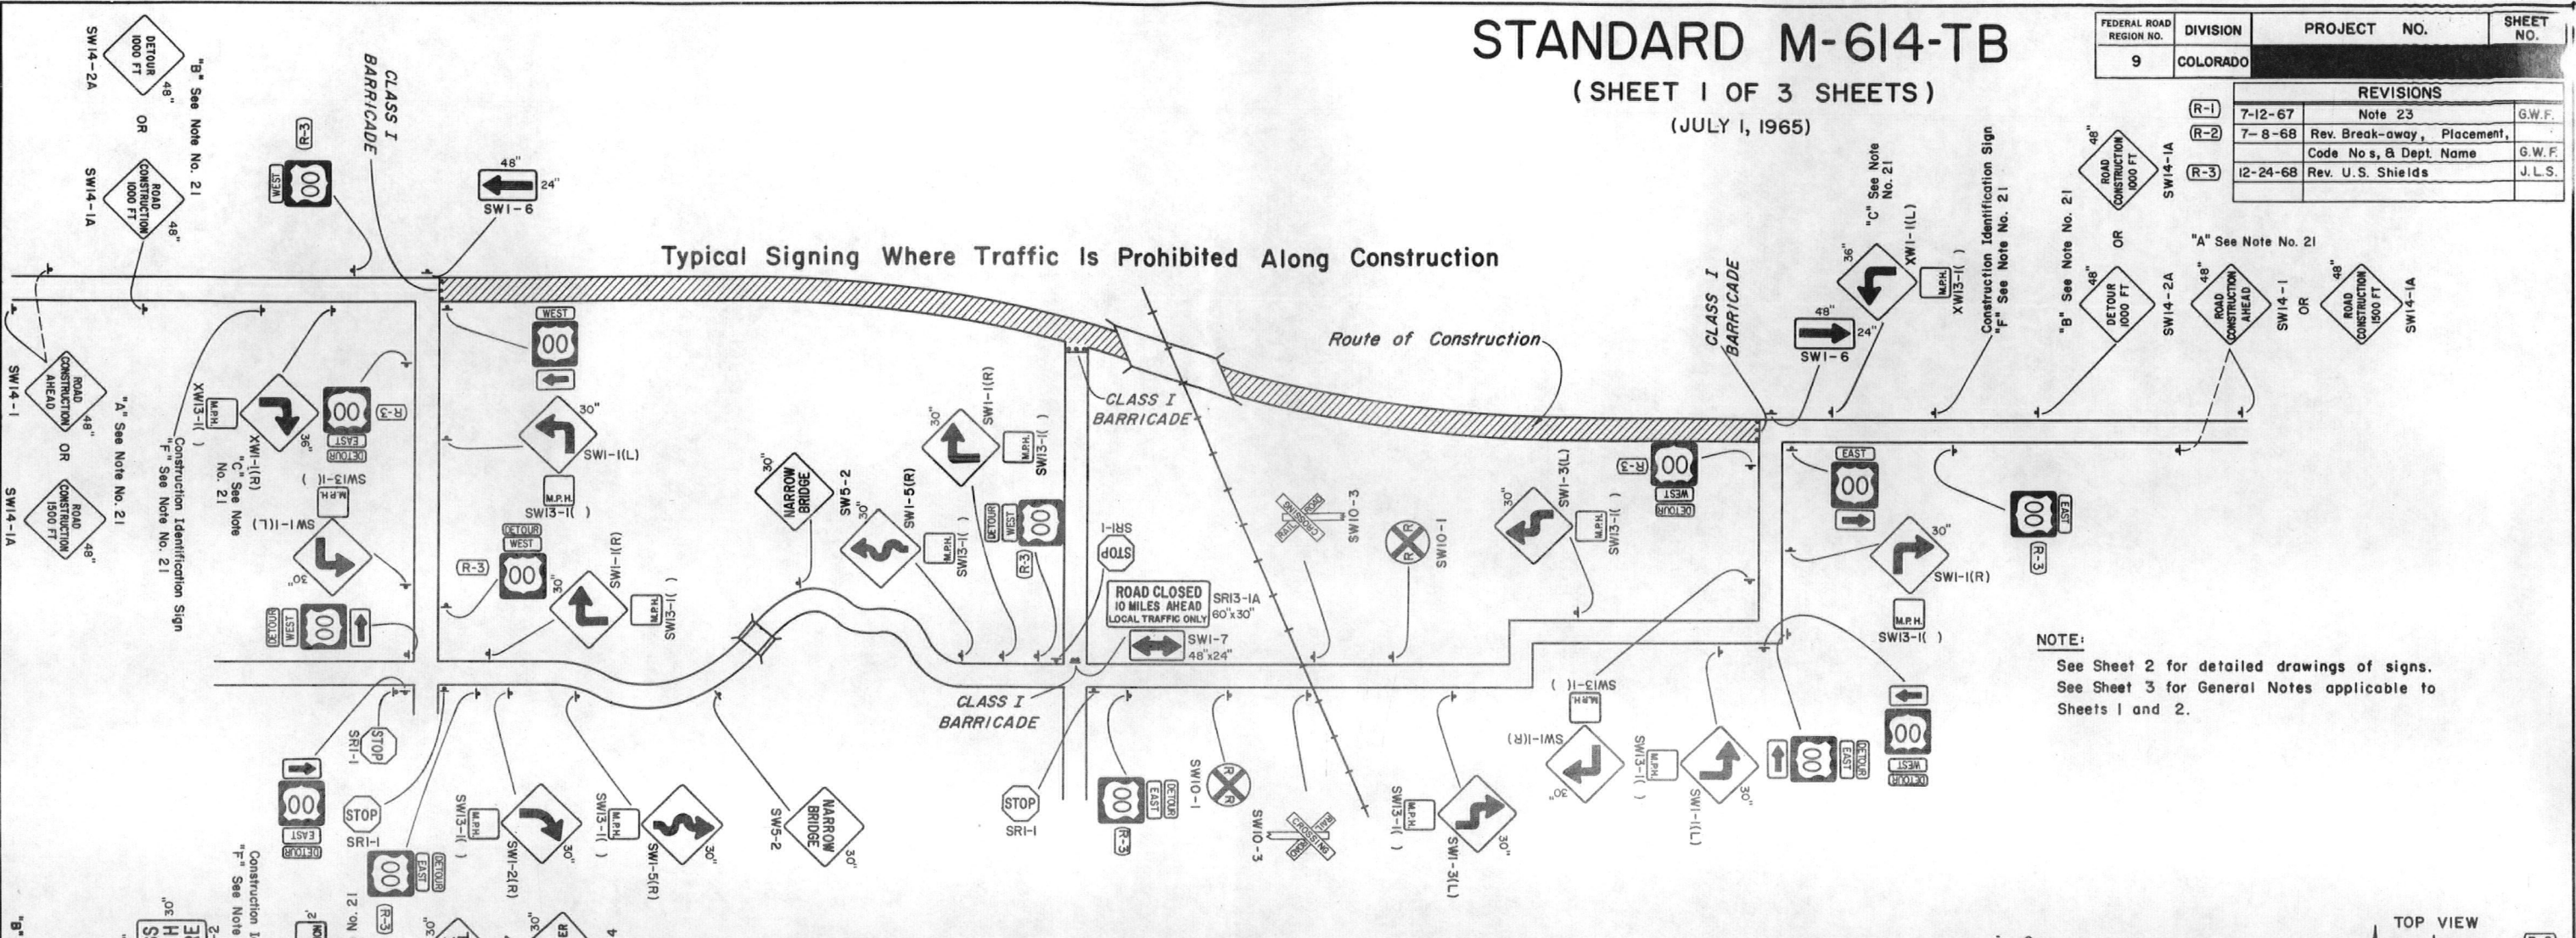

NOTE:
See Sheet 2 for detailed drawings of signs.
See Sheet 3 for General Notes applicable to Sheets 1 and 2.

Typical Signing Where Traffic Is Permitted Along Construction

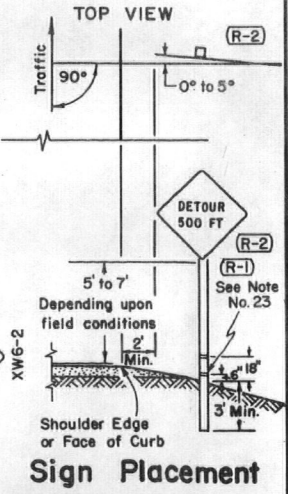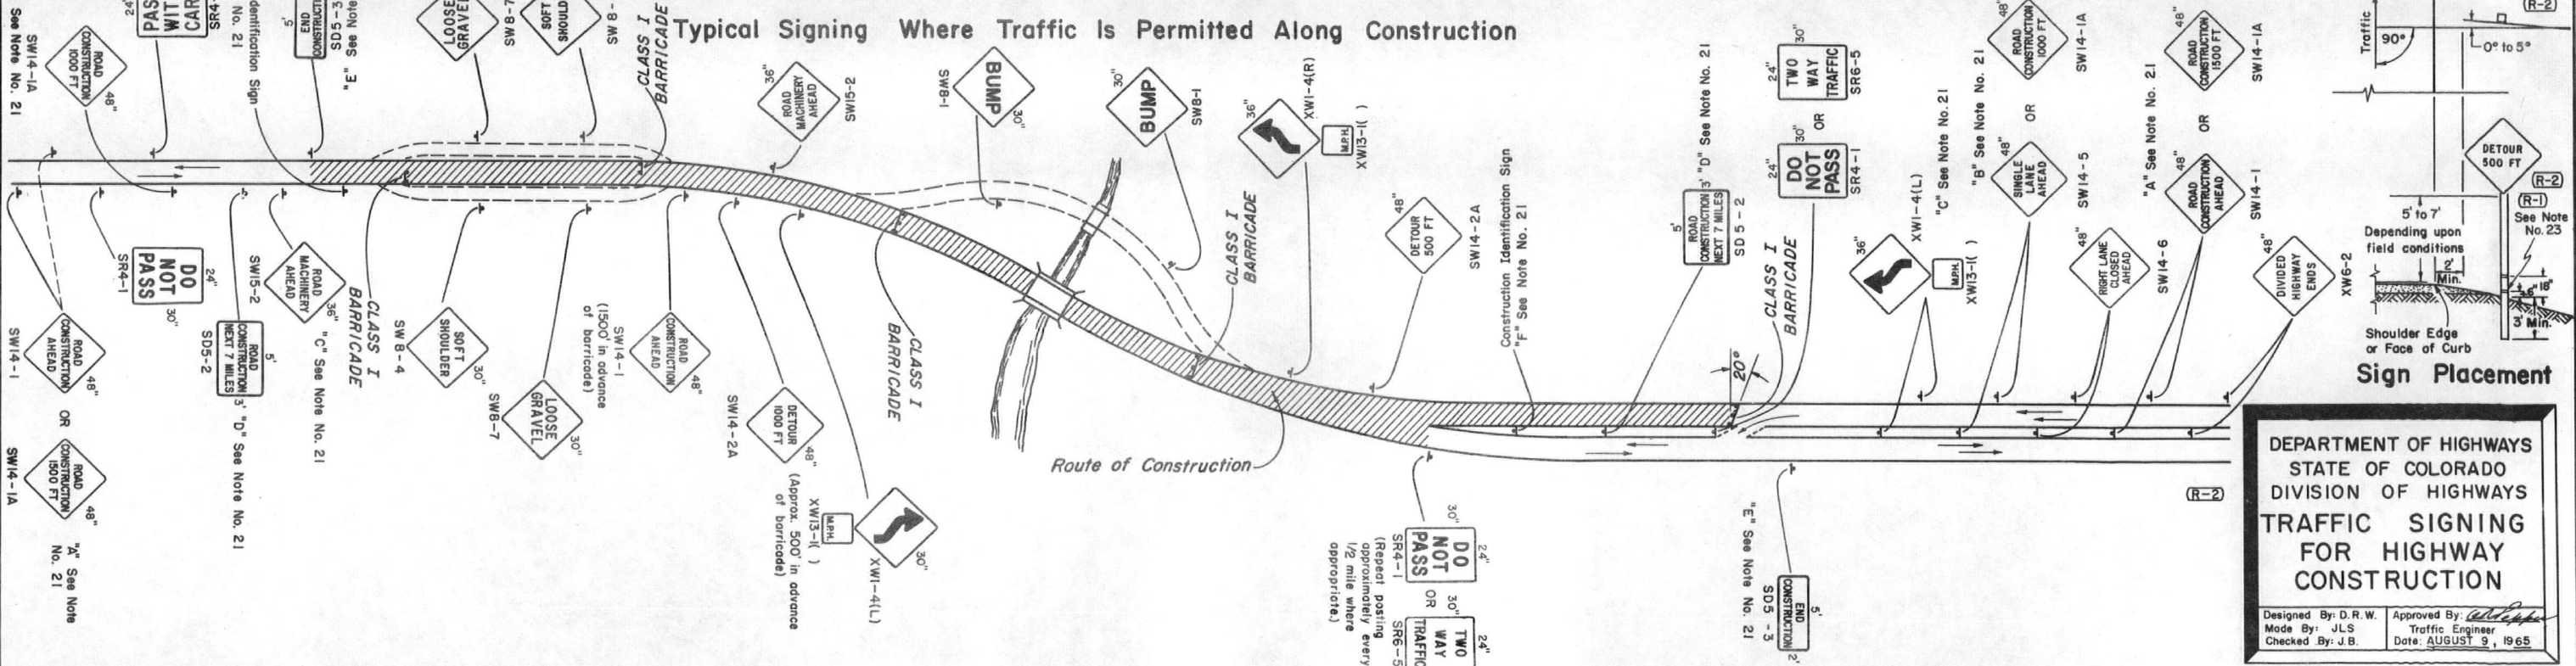

DEPARTMENT OF HIGHWAYS
STATE OF COLORADO
DIVISION OF HIGHWAYS
**TRAFFIC SIGNING
FOR HIGHWAY
CONSTRUCTION**

Designed By: D.R.W.
Made By: J.L.S.
Checked By: J.B.

Approved By: *[Signature]*
Traffic Engineer
Date: AUGUST 9, 1965

STANDARD M-614-TB

(SHEET 2 OF 3 SHEETS)


(JULY 1, 1965)

FEDERAL ROAD REGION NO.	DIVISION	PROJECT NO.	SHEET NO.
9	COLORADO		

REVISIONS			
(R-1)	7-12-67		M.R.H.
(R-2)	7-8-68	Rev. Code No. & Dept. Name	G.W.F.
(R-3)	12-24-68	Added Notes	J.L.S.


REGULATORY SIGNS

See Note No. 9

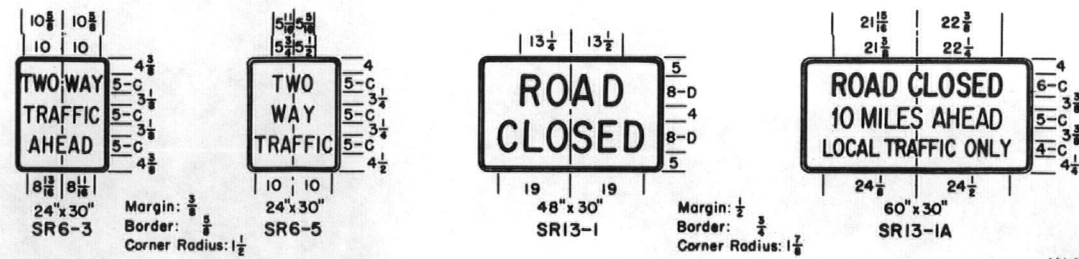



WARNING SIGNS

See Note No. 10

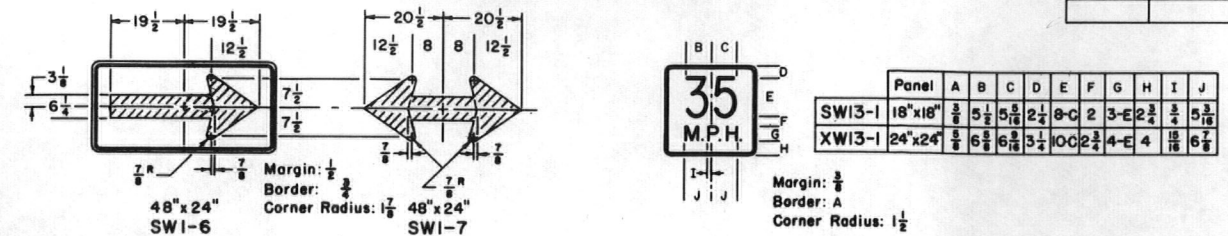

WARNING SIGNS

See Note No. 10

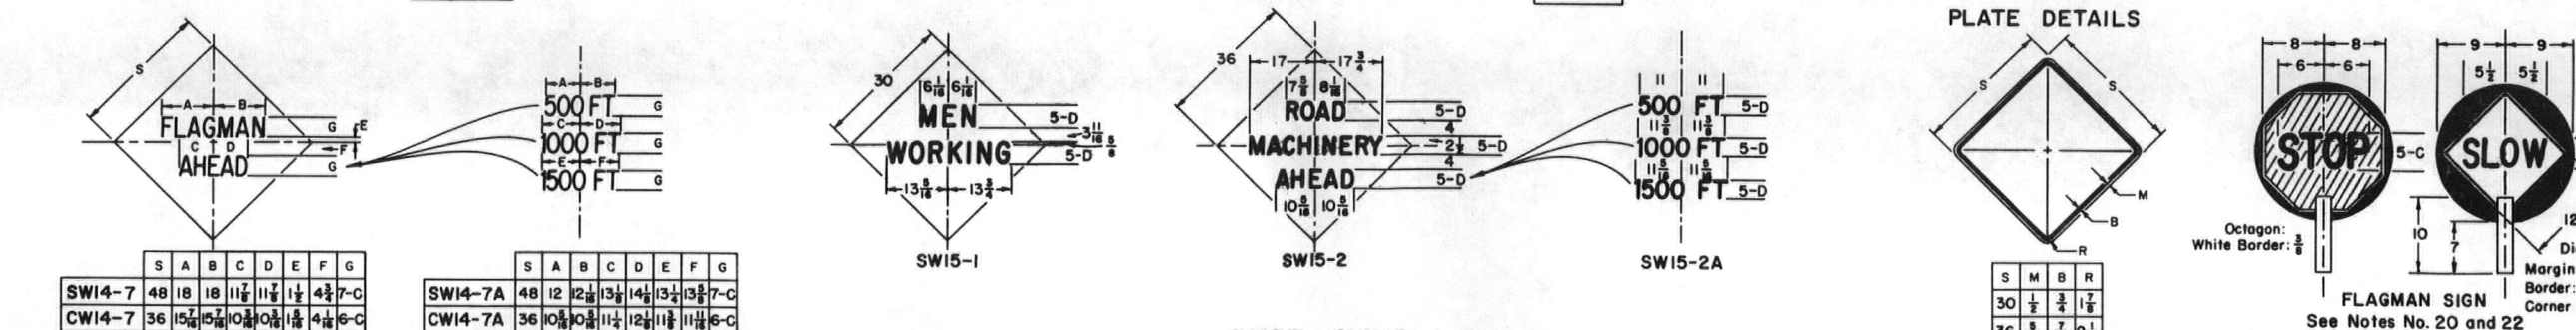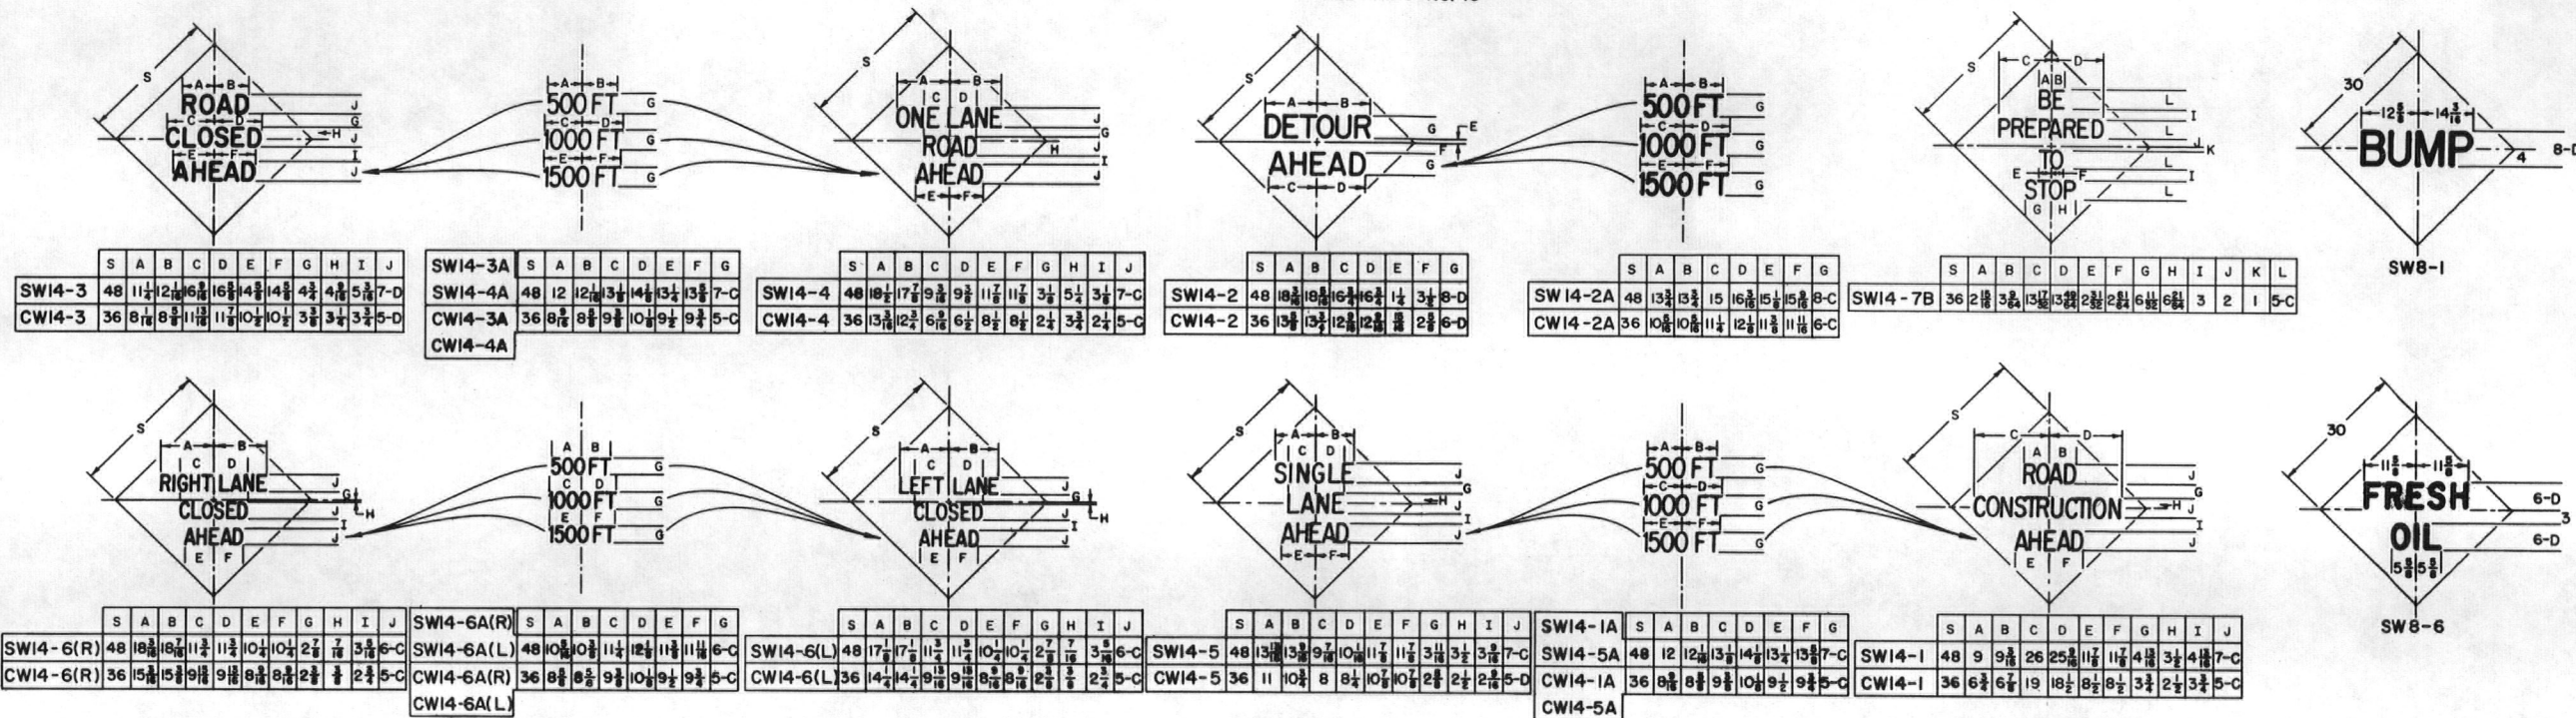

GUIDE SIGNS

See Note No. 11



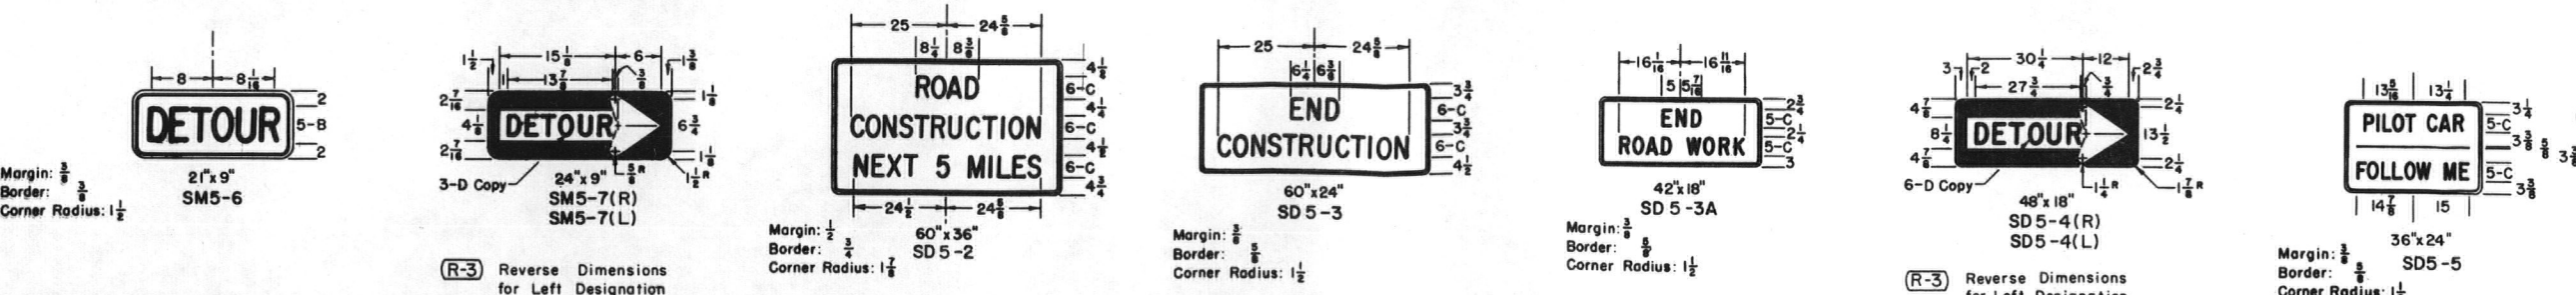


PLATE DETAILS

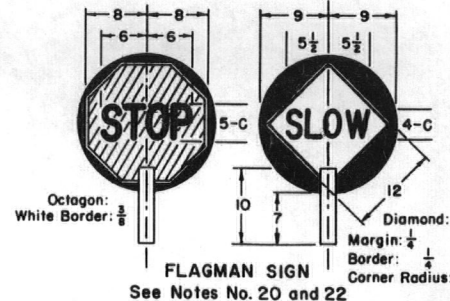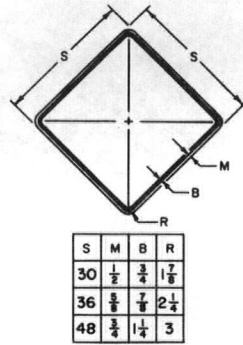

NOTES:
SEE SHEET 1 FOR TYPICAL SIGNING AND SIGN PLACEMENT.
SEE SHEET 3 FOR GENERAL NOTES APPLICABLE TO SHEETS 1 AND 2.
ALL DIMENSIONS THAT ARE NOT LABELED ARE IN INCHES.

DEPARTMENT OF HIGHWAYS
STATE OF COLORADO
DIVISION OF HIGHWAYS
TRAFFIC SIGNING
FOR HIGHWAY CONSTRUCTION

Designed By: D.R.W.
Made By: H.B.D.
Checked By: J.B.

Approved By: [Signature]
Traffic Engineer
Date: AUGUST 9, 1965

STANDARD M-614-TB

(SHEET 3 OF 3 SHEETS)

(JULY 1, 1965)

FEDERAL ROAD REGION NO.	DIVISION	PROJECT NO.	SHEET NO.
9	COLORADO		

REVISIONS			
(R-1)	7-12-67	Added Note 23	G.W.F.
(R-2)	7-8-68	Rev. Note 23 & Dept. Name - Deleted Note	G.W.F.
(R-3)	12-24-68	Rev. Note No. 18	J.L.S.

GENERAL NOTES

- All work shall be done in accordance with: (a) the Standard Specifications applicable to the Project, and (b) the "Manual on Uniform Traffic Control Devices for all Classes of Streets and Highways" published by the Department of Highways.
- Where traffic is maintained through or over any part of the Project the Contractor will be required to mark all hazards within the limits of the Project (including connecting roads) with well-maintained Barricades, Warning, and Guide Signs. All Barricades and Signs shall be moved, added to, changed or removed as required during the progress of construction and removed entirely when the Project is completed.
- Where traffic is prohibited from the Project the Detour will be marked by the Department except that the Contractor shall provide, erect and maintain Barricades, complete, (when required) at the ends of the Project, ends of the Detour and connecting roads. All U.S. or State Route Markers required for the Project will be furnished and installed by the Department. The location and positioning of Warning Signs, Barricades, and Regulatory Signs shall be as recommended by the appropriate District Engineering Forces of the Department.
- Work on the Project shall not be started until all required signs are in place and approved by the Engineer. Where speed control appears necessary such speed control shall be requested from the Engineer by the Contractor. Control of speed through a construction zone may be achieved by Advisory Speed plates in conjunction with Warning Signs (SW13-1 for use with 30" Warning Signs and XW13-1 for use with 36" and 48" Warning Signs). The Advisory Speed plate is to be posted only at those locations where the safe speed is lower than the imposed Regulatory speed limit.
- All Signs and Barricades shall be placed for best visibility and legibility, maintained in good condition and kept clean and free of dirt at all times. Contractor's and Engineer's vehicles and equipment must be parked so that signs and barricades are visible to approaching traffic at all times.
- Where two identical signs are used for dual posting they are to be staggered on the two sides of the roadway for a minimum distance of 75' to avoid a tunneling effect.
- Examples for marking Projects, as shown on Sheet 1, are typical of signs required and are subject to alteration to fit actual conditions encountered in the field. Locations for control devices are to be staked by the Engineer. In all cases Warning signs are to be placed well in advance of the hazard, the distance depending on topography and existing approach speeds. Additional markings and any special signs required for the guidance and protection of traffic will be placed as required on the Project at the Contractor's expense.
- Desirable sizes for signs are shown on Sheet 1 of this Standard. Larger or smaller signs shall be used where warranted. Detailed dimensions for signs normally used in connection with construction are shown on Sheet 2 of this Standard. For information on standard roadway signs not detailed on this Standard see the "Manual on Uniform Traffic Control Devices for all Classes of Streets and Highways" published by the Department of Highways.
- Signs with the prefix "R" in the sign code are Regulatory signs and as such impose legal compulsions or restrictions on drivers and should only be used as authorized by the Engineer.
- Signs with the prefix "W" in the sign code are Warning signs and are used to alert traffic to existing or potentially hazardous conditions.
- Signs with the prefix "D" or "M" in the sign code are Guide signs. Those with the prefix "D" convey general information and those with the prefix "M" are used for marking the traffic route.
- All signs shall be reflectorized unless otherwise specified on plans. Regulatory and Guide signs (unless otherwise specified) shall have a screen processed black legend and border on a white flexible reflective sheeting, non-exposed lens background. The back side of Regulatory and Guide signs shall be painted with two coats of "Exterior Sign White Paint." Warning signs shall have a screen processed black legend and border on a highway yellow flexible reflective sheeting, non-exposed lens background. The back side of Warning signs shall be painted with two coats of "Federal Yellow Synthetic Sign Enamel."
- Painting for wood surfaces shall conform with Section 508 of the Standard Specifications.
- Posts for regulatory, warning, and guide signs will normally be 4" x 4" or 6" x 6" and shall conform to the Standard Specifications for Untreated Timber-S4S. Timber shall conform to Construction grade Paragraph 123B or 125B of Standard No. 15 Grading & Dressing Rules for West Coast Douglas Fir (1956) or Dense Structural 58 and LL Structural 58 Paragraph 284 or 285 of 1956 Grading Rules for Southern Pine. Posts shall be painted with one coat of "White Wood Primer" and one coat of "Outside White Paint."
- Sign panels furnished by the Contractor for use only during construction may be fabricated from plywood, aluminum, steel or other suitable material but shall be stable and durable enough to meet other requirements of this Standard.
- All material shall be sound and durable. Barricades, signs, symbols, and lettering shall be of good workmanship. Uneven lettering will not be accepted.
- Alternate methods of processing signs or the substitution of symbols or other reflecting elements for painted symbols will be permitted only after approval by the Department.
- (R-3) Lanterns and Torches - Lanterns, with red globes, shall be used only in low speed urban areas. Open-flame torches shall not be used under any circumstances.
- Barricades, Flashing Beacons and Flashers - Refer to appropriate "M" Standard (Timber Barricades) for details.
- Flagman Sign - This sign shall have a black painted background on both sides to form a contrast for the octagonal Stop sign and the diamond Warning sign. The "STOP" sign shall be fabricated by reverse screen process using transparent red paint on smooth surface silver reflective sheeting. The "SLOW" side of the Flagman Sign shall be black process point on smooth surface yellow reflective sheeting. Handle to be grooved on one side to indicate reading of sign to Flagman.
- Sign "A": This is the first advance warning sign and shall be placed 1,500 feet ahead of Barricade or project terminal. Postings are required on both sides of the roadway on divided highways. Dual posting is required where warranted on two-lane, two-way highways.
Sign "B": This is the second advance warning sign and shall be placed 1,000 feet ahead of barricade or project terminal. Postings are required on both sides of the roadway on divided highways and singly on two-lane, two-way highways.
Sign "C": This is the third advance warning sign in cases where barricades are used and shall be placed 500 to 750 feet ahead of barricade or potentially hazardous condition. Postings are required on both sides of the roadway on divided highways and singly on two-lane, two-way highways.
Sign "D": SD5-2 - This sign shall be placed to mark the beginning of a Project of more than 2 miles in extent, where traffic is maintained through the project. It shall be placed singly and near the beginning of construction.
Sign "E": SD5-3 - This sign shall be placed to mark the end of the Project. It shall be placed singly and may be placed opposite barricade if desirable.
Sign "F": Construction identification signs shall be furnished and installed by the Department on all Federal-Aid and Forest Highway Projects where actual construction is in progress and visible to highway users. These signs should be located so as not to obscure or detract from the effectiveness of other official signs. Where two or more projects are contiguous the appropriate data may be included in one set of signs. Refer to appropriate "M" Standard (Identification Signs) for sign details.
Signs A through F shall be furnished, installed and maintained by the Department.
- When Flags are used in lieu of the Flagman Sign, they shall be a minimum of 18"x18", made of a good grade of bright red material, and fastened securely to a staff of approximately 3 foot length. The free edge should be weighted to insure that the flag will hang vertically, even in heavy winds.
- (R-1) (R-2) Each 6"x6" timber sign post shall be provided with two 2" diameter holes through the neutral axis normal to the roadway, one hole at 6" and one hole at 18" above the ground level. The 4"x4" timber posts shall not be provided with any type of break-away device. The inside portion of each 2" diameter hole shall be painted white. The underground portion of each timber post shall be treated with creosote.

(R-2)

(R-2)

DEPARTMENT OF HIGHWAYS
STATE OF COLORADO
DIVISION OF HIGHWAYS
**TRAFFIC SIGNING
FOR HIGHWAY
CONSTRUCTION**

Designed By: D.R.W. Approved By:
Made By: J.L.S. Traffic Engineer
Checked By: J.B. Date: AUGUST 9, 1965