

Design


E SHEET

THE STATE DEPARTMENT OF HIGHWAYS DIVISION OF HIGHWAYS—STATE OF COLORADO

FEDERAL ROAD REGION NO.	DIVISION	PROJECT NO.	SHEET NO.
9	COLORADO	S 0125 (13)	1

REVISIONS			
2-17-70	Change	End Station	GF
5-8-70	Rev. Index of Sheets		GM

RIGHT OF WAY
DELTA - EAST

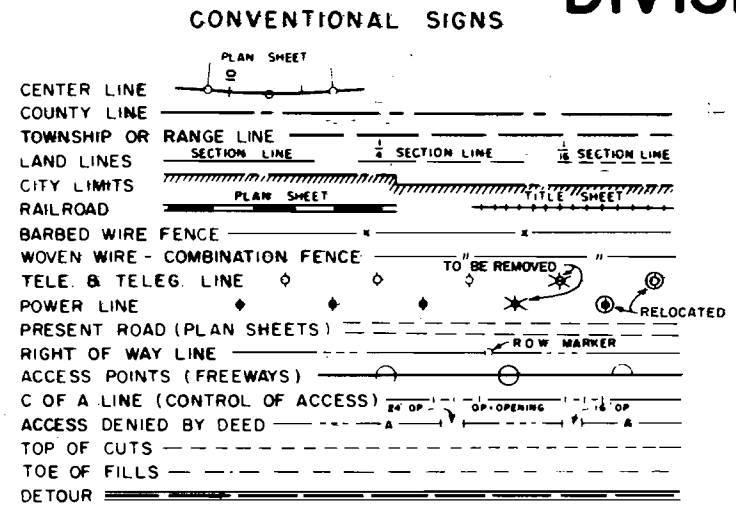


PLAN AND PROFILE OF PROPOSED FEDERAL AID PROJECT NO. S 0125 (13) STATE HIGHWAY NO. 92 DELTA COUNTY RIGHT OF WAY

SCALE OF ORIGINAL DRAWINGS
PLAN SHEETS 1" = 100'
OWNERSHIP MAPS 1" = 400'
R.O.W. LENGTH OF PROJECT = 3.950 Miles

INDEX OF SHEETS	
SHEET NO.	TITLE SHEET
1	TABULATION OF PROPERTIES
2 - 5A	ALIGNMENT PLANS
6 - 13	OWNERSHIP MAPS
14 - 15	

BEGIN R.O.W. PROJ. S0125 (13) STA. 16 + 23.6
STA. 11 + 26.7, PROJ. S 0125 (3)

BEGIN CONST. PROJ. S0125 (16) STA. 13 + 00 =
STA. 8 + 00 PROJ. S 0125 (3)

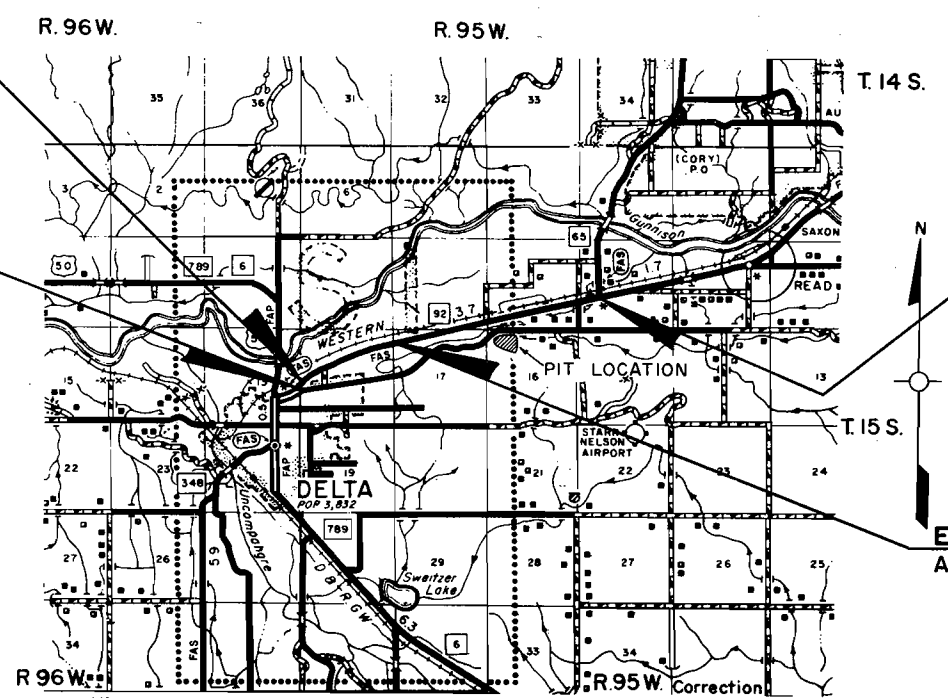

AS CONSTRUCTED
REVISED DATE 1/14/70

1-27-69 - C.K.M.

SUMMARY OF EARTHWORK QUANTITIES

St. No	AS Constructed	Plan
16-40	UNCLASSIFIED EXCAVATION	
	* Roadway (From Cross Sections)	5,072
	Estimated for Subsidence	3,175
	Structure Quantities as Embankment	318
	Structure Quantities as Excavation	2,230
	Structure Quantities as Ditch Excavation	5,200
	Stripping (Removing Overburden)	2,315
	16,475	6,000
	(C) TOTAL FOR PAY QUANTITY	19,238 Cu. Yds.
	MUCK EXCAVATION	
127-A	Roadway	26,521
(1st Shells)	TOTAL FOR PAY QUANTITY	13,280 Cu. Yds.
	BORROW	
127-A	From Pit	135,491
(At Tabulation)	Estimated for Subsidence	102,873
	TOTAL FOR PAY QUANTITY	10,287
	TOTAL FOR PAY QUANTITY	113,160 Cu. Yds.
	EMBANKMENTS (MODIFIED) (Moisture and Density Control)	
127-A-57	Embankment (Net)	110,489
	Base of Cuts and Fills	92,216
	15,790	15,790
	TOTAL FOR PAY QUANTITY	108,006 Cu. Yds.
	HAUL	
127-A	From Mass Diagram	231,726
	Estimated for Subsidence	185,087
	TOTAL FOR PAY QUANTITY	18,509
	TOTAL FOR PAY QUANTITY	203,596 Yd. MI.
	ROADWAY QUANTITIES BALANCE (For Information Only)	
	EXCAVATION	
127-A	Unclassified	5,072
	Borrow	3,175
	135,491	102,873
	TOTAL	106,048 Cu. Yds.
	EMBANKMENT	
127-A	Roadway (From Cross Sections)	109,457
	EMBANKMENT X FACTOR	92,216 Cu. Yds.
	140,563	106,048 Cu. Yds.

* Includes Quantity for Cut Slope Treatment

TABULATION OF ROW MARKERS

STATION	SIDE	NUMBER
S.T. 63+43.77	Rt.	1
81+00	Rt.	1
PROJECT TOTALS		2

TABULATION OF DELINEATORS

STATION	SIDE	SPACING	TYPE I EACH	TYPE II EACH
49+09	Rt. & Lt.	Transition	2	
53+09	Rt. & Lt.	Transition	2	
S.C. 56+91.3 to C.S. 60+93.8	Rt. & Lt.	2° Curve	6	
64+76	Rt. & Lt.	Transition	2	
68+76	Rt. & Lt.	Transition	2	
56+67	Lt.	Median		1
69+90	Rt. & Lt.	Med. Crossover		2
83+00	Rt.	Transition	1	
87+00 to 91+93	Rt.	1° Curve	3	
91+55	Lt.	Median		1
95+02 to 99+95	Rt.	1° Curve	3	
PROJECT TOTALS			21	4

FENCING REQUIREMENTS

STATION	SIDE	REMOVE FENCE LIN. FT.	BUILD FENCE	BATES
			B. WIRE LIN. FT.	B. WIRE EACH
37+00 to 39+90	Rt.	315	302	
48+50 to 50+60	Rt.	265	266	
51+70 to 52+95	Rt.	175	60	
56+00 to 68+10	Rt.	1,195	1,124	
70+00 to 99+00	Rt.	3,290	3,467	
37+00 to 39+85	Rt.		285	281
48+50 to 50+50	Rt.			200 197
51+65 to 52+65-81	Rt.			100 164
57+00 to 68+10	Rt.		1,095	1,068
69+87 to 98+34	Rt.		2,770	2,850
77+00 to 98+34	Rt.			119
PROJECT TOTALS		5,240	5,219	4,150 4,318

ø 34" Mesh Height
(C) ~~It is estimated~~ End Posts and 15 Corner and Line Brace Posts (24.5 ft. x 9 ft.) will be required.

FILE #	LOC + CASE	DOC. COUNT	PAGE	ADD'L PAGE
03	401		5	

R. O. W. TABULATION OF PROPERTIES IN DELTA COUNTY S.H.No. 92 PROJ. S 0125 (13)

FEDERAL ROAD DIVISION NO.	DISTRICT	PROJECT NO.	SHEET NO.
8	COLORADO	S 0125 (13)	2

RIGHT OF WAY DELTA - EAST

PARCEL NO.	OWNER	ADDRESS	LOCATION	AREA IN ACRES			PURCHASE DATA					REMARKS	NO.
				PARCEL	TO BE ACQUIRED	REMAINDER	LAND	IMPROV'M'TS	DAMAGE	MISC.	TOTAL		
			T.15 S., R. 96 W., 6th PM.			LT. RT.							
1	DELETED												
1A	OLIN BRUTON		NE1/4 SE1/4 SEC. 13 LOTS 1 & 2	0.325	0.325	3.139							
2 Rev.	GILBERT BUTCHER & DOROTHY L BUTCHER J.T.		T.15 S., R. 95 W., 6th PM. SE1/4 NW1/4 SEC. 18	0.096	0.096	1.752							
3	ROBERT R. PORTER & JACQUELINE B. PORTER J.T.	660 LEON ST. DELTA, COLORADO	SE1/4 NW1/4 SEC. 18	0.212	0.212	2.876							
4 Rev.	FRANCES G. HANSON, JAMES L. HANSON, & THOMAS M. HANSON, J.T.	BOX 553 DELTA, COLORADO	SE1/4 NW1/4 SEC. 18	0.129	0.129	2.621							
			BRUCE & JOHNSON SUBD.										
5 Rev.	DELETED												
6	EDGAR C. JONES		LOT 5, BLK. 4	1.221	1.221	38.971							
7	FLANK OIL COMPANY		NW1/4 NE1/4 SEC. 18	0.204	0.204	0.480							
8	FLORIAN LOVATO, BERNARDITA L. LOVATO, FILIMON LOVATO, BERTINA LOVATO J.T.	R. R. 1, BOX 117-D DELTA, COLORADO	NE1/4 NE1/4 SEC. 18	0.375	0.347	2.925							
9	VIVIAN W BARNES A.K.A. VIVIAN BARNES TRIMBLE		NE1/4 NE1/4 SEC. 18	1.563	1.563	13.32							
10	ELIZABETH G. ENSLEY	R. R. 1, BOX 116 DELTA, COLORADO	N1/2 NW1/4 SEC. 17	2.875	2.875	23.13							
11	BEMA DEVELOPMENT CORPORATION a Colorado corporation	C/O RAYMOND MAXWELL 10 HILLMAN BLDG. DELTA, COLORADO	NE1/4 NW1/4 SEC. 17	0.354	0.354	22.45							
12	BEMA DEVELOPMENT CORP., A Colo. Corp.	BOX 369 DELTA, COLORADO	NE1/4 NW1/4 SEC. 17	1.147	1.147	8.9							
13	DOUGLAS G. COLLINS & ROBERTA KAY COLLINS aka KAY COLLINS	R. R. 1, BOX 38 DELTA, COLORADO	NW1/4 NE1/4 SEC. 17 SW1/4 SE1/4 SEC. 8	1.846	1.846	38.2							
14	TOM RYAN & EMMA RYAN J.T.		SE1/4 SE1/4 SEC. 8	2.780	2.727	19.30 10.659							
14-A	TOM RYAN & EMMA RYAN J.T.		SE1/4 SE1/4 SEC. 8	0.311	0.311								
15	MARY C. JEFFERS (Estate of J. Welland Jeffers)	603 PALMER	S1/2 SW1/4 SEC. 9	5.594	5.541	128.814							
15-A	MARY C. JEFFERS (Estate of J. Welland Jeffers)	603 PALMER	S1/2 SW1/4 SEC. 9	0.626	0.626								
16	CLARENCE E. GALLUP	3rd & PALMER, DELTA, COLORADO	SE1/4 SEC. 9, NW1/4 SW1/4 SEC. 10	6.303	6.303	144.50 85.039							
16-A	CLARENCE E. GALLUP	3rd & PALMER, DELTA, COLORADO	SE1/4 SEC. 9, NW1/4 SW1/4 SEC. 10	0.661	0.661								

REVISIONS		
0-7-68	Delete 1 & 5 Rev.	LB
11-8-68	Change name par. 9	LB
10-15-68	Add 14-A, 15-A, 16-A	GF
4-1-70	Name change Par. 13	KC
5-8-70	Name Chg. Par 12	GM

R. O. W. TABULATION OF PROPERTIES IN DELTA COUNTY S.H.No. 92 PROJ. S 0125(13)

FEDERAL ROAD DIVISION NO.	DISTRICT	PROJECT NO.	SHEET NO.
9	COLORADO	S 0125(13)	4

RIGHT OF WAY DELTA - EAST

PARCEL NO.	OWNER	ADDRESS	LOCATION	AREA IN ACRES			PURCHASE DATA					REMARKS	NO.
				PARCEL	TO BE ACQUIRED	REMAINDER	LAND	IMPROV'M'TS	DAMAGE	MISC.	TOTAL		
			T.15 S. R. 95 W. 6thRM.										
E-5Rev.	ANDY MALLETT	Under contract of sale to Robert T. Grunwald	BRUCE & JOHNSON SUBD.										
			LOT 12 BLK. 3	0.143	0.143							CHANNEL CHANGE	
E-5A	ANDY MALLETT	Under contract of sale to Robert T. Grunwald	LOT 12 BLK. 3	0.015	0.015							DRAIN DITCH	E-5-A
E-6Rev.	EDGAR C. JONES		LOTS 1,2, & 5 BLK. 4	1.085	1.085								
E-7.	FLANK OIL COMPANY		LOT 5 BLK. 4	0.069	0.069								
E-8	FILIMON LOVATO, BERTINA LOVATO, FLORIAN LOVATO & BERNARDITA L. LOVATO J.T.		NE1/4 NE1/4 SEC. 18	0.131	0.131								
E-9	VIVIAN BARNES A.K.A. VIVIAN BARNES TRIMBLE		NE1/4 NE1/4 SEC. 18	0.494	0.494								
E-9A	W.R. WILLIAMS		NE1/4 NE1/4 SEC. 18	0.431	0.431							DRAIN DITCH	E-9A
E-10	ELIZABETH G. ENSLEY		N1/2 NW1/4 SEC. 17	0.697	0.697								
E-10A	ELIZABETH G. ENSLEY		N1/2 NW1/4 SEC. 17	0.218	0.218							DRAIN DITCH	E-10A
E-11	BEMA DEVELOPMENT CORPORATION a Colorado corporation		NE1/4 NW1/4 SEC. 17	0.126	0.126								
E-12	BEMA DEVELOPMENT CORP, A Colo. Corp.		NE1/4 NW1/4 SEC. 17	0.387	0.387								
E-13Rev.	DOUGLAS G. COLLINS & ROBERTA KAY COLLINS aka KAY COLLINS		NW1/4 NE1/4 SEC. 17 & SW1/4 SE1/4 SEC. 8	0.622	0.622								
E-16	CLARENCE E. GALLUP		N1/2 SE1/4 SEC. 9	2.022	2.022								
E-16-A	DELETED												
E-16-B	CLARENCE E. GALLUP		N1/2 SE1/4 SEC. 9	0.340	0.340								
E-18	DELETED												
E-18-A	DELETED												
E-19Rev.	OTTO U. PITTSINGER & LORAIN E. PITTSINGER J.T.		LOT 13 BLK. 2 BRUCE & JOHNSON SUBD.	0.237	0.237								
E-20Rev.	BYRON L. BENSON, CLARENCE T. BENSON, & URGAL L. BENSON J.T.		NW1/4 SW1/4 SEC. 10	1.350	1.350								
E-2	GILBERT BUTCHER & DOROTHY L. BUTCHER, J.T.		SE1/4 NW1/4 SEC. 18	0.057	0.057							Constructing & maintaining a drainage ditch	E-2
E-3	ROBERT R. PORTER & JACQUELINE B. PORTER, J.T.		SE1/4 NW1/4 SEC. 18	0.076	0.076							" " " "	E-3
E-4	FRANCES G. HANSON, JAMES L. HANSON, & THOMAS M. HANSON, J.T.		SE1/4 NW1/4 SEC. 18	0.049	0.049							" " " "	E-4
E-29	DALE P. BLUMBERG & FAY OLA BLUMBERG, J.T.		SE1/4 NW1/4 SEC. 18	0.068	0.068							" " " "	E-29
E-30	DELETED												

REVISIONS		
10-7-68	Rev. E-5	LB
10-30-68	Add E-2, E-3, E-4, E-9A, E-29, E-30	LB
11-18-68	Change name E-9	LB
12-20-68	Delete Par. E-30	XC
10-15-69	Rev. E-5	Rev.
10-15-69	DELETE E-16-A, E-18	---
---	Add E-16-B, E-18-A	GF
2-17-70	Revise E-18-A, E-20	GF
4-1-70	Name change Par. E-13 Rev.	XC
5-8-70	Name Chg. Par. E-12	GM
9-1-70	DELETED E-18A Rev.	SAM
7-25-72	Add E-9A & E-10A	XC

34567891011121314151617181920
1972
DESIGN
O. H.

S 0125 (13)


RIGHT OF WAY DELTA - EAST

PARCEL NO.	OWNER	ADDRESS	LOCATION	AREA IN ACRES			PURCHASE DATA					REMARKS	NO.
				PARCEL	TO BE ACQUIRED	REMAINDER	LAND	IMPROV'M'TS	DAMAGE	MISC.	TOTAL		
TE-1A	OLIN BRUTON		T.15 S. R.96 W. 6th P.M.	0.021	0.021								
TE-2Rev.	DELETED		T.15 S. R.95 W. 6th P.M.										
TE-2A	GILBERT BUTCHER & DOROTHY L. BUTCHER J.T.			0.023	0.023							ROAD APPROACH	TE-2A
TE-3	DELETED												
TE-3A	ROBERT R. PORTER & JACQUELINE B. PORTER J.T.			0.018	0.018							ROAD APPROACH	TE-3A
TE-4	DELETED												
TE-13A	A.M. MORGAN			0.028	0.028							IRRIG. DITCH	TE-13A
TE-13B	A.M. MORGAN			0.069	0.069							IRRIG. DITCH	
TE-5Rev.	DELETED												
TE-5ARev.	ANDY MALLETT	Under contract of sale to Robert T. Grunwald		0.023	0.023							ROAD APPROACH	TE-5ARev.
TE-6	EDGAR C. JONES			0.092	0.092							IRRIG. DITCH CHANGE	TE-6
TE-9A	VIVIAN BARNES A.K.A. VIVIAN BARNES TRIMBLE			0.009	0.009							CROSS CULVERT OUTLET	TE-9A
TE-10A	ELIZABETH G. ENSLEY			0.533	0.533							IRRIG. DITCH CHANGE	TE-10A
TE-9B	VIVIAN BARNES A.K.A. VIVIAN BARNES TRIMBLE			0.037	0.037							ROAD APPROACH	TE-9B
TE-14	DELETED												
TE-14-A	TOM RYAN & EMMA RYAN J.T.			0.622	0.622								
TE-15Rev.	MARY C. JEFFERS (Estate of J. WELLAND JEFFERS)			0.999	0.999								
TE-15-A	MARY C. JEFFERS (Estate of J. WELLAND JEFFERS)			0.254	0.254								
TE-15-B	DELETED												
TE-16A	CLARENCE E. GALLUP			0.610	0.610							IRRIG. DITCH CHANGE	TE-16A
TE-16C	CLARENCE E. GALLUP	For BONA FIDE DITCH CO.		0.092	0.092							DITCH RELOCATION	TE-16C
TE-20Rev.	BYRON L. BENSON, CLARENCE T. BENSON, & URGAL L. BENSON J.T.			0.416	0.416							IRRIG. DITCH CHANGE	TE-20
TE-17	JOHN L. HALLOCK & ANNA LENA HALLOCK	FOR BONA FIDE DITCH CO.		0.183	0.183							DITCH RELOCATION	TE-17
TE-29Rev.	DELETED												
TE-16B	CLARENCE E. GALLUP			0.018	0.018							ROAD APPROACH	TE-16B
TE-30Rev.	DELETED												
TE-30A	CONTINENTAL OIL COMPANY			0.018	0.018							ROAD APPROACH	TE-30A
TE-R31	DENVER AND RIO GRANDE WESTERN R.R. COMPANY		T.15 S. R.95 W. & T.15 S. R.96 W.	1.123	1.123							IRRIG. DITCH CHANGE	TE-R31
TE-4A	FRANCES G. HANSON, JAMES L. HANSON & THOMAS M. HANSON J.T.		T.15 S. R.95 W.	0.018	0.018							ROAD APPROACH	TE-4A
TE-4B	FRANCES G. HANSON, JAMES L. HANSON & THOMAS M. HANSON J.T.			0.009	0.009							CROSS CULVERT INLET	TE-4B
TE-18A	GERALD D. & EILEEN E. GOLDSMITH J.T.		T.15 S. R.95 W.	0.879	0.879								
TE-5BRev.	ANDY MALLETT	Under contract of sale to Robert T. Grunwald		0.020	0.020							ROAD APPROACH	TE-5BRev.
TE-7	DELETED												
TE-8	DELETED												
TE-9	DELETED												
TE-10	DELETED												
TE-11	DELETED												
TE-12	DELETED												
TE-13	DELETED												
TE-16	DELETED												
TE-18	DELETED												
TE-R31A	DENVER AND RIO GRANDE WESTERN R.R. COMPANY			0.023	0.023							ROAD APPROACH	TE-R31A
TE-R31B	" " " " " " " "			0.032	0.032							" "	TE-R31B
TE-R31C	" " " " " " " "			0.032	0.032							" "	TE-R31C
TE-R31D	" " " " " " " "			0.014	0.014							" "	TE-R31D

PROJ. S0125(13)

RIGHT OF WAY DELTA-EAST



[illegible]

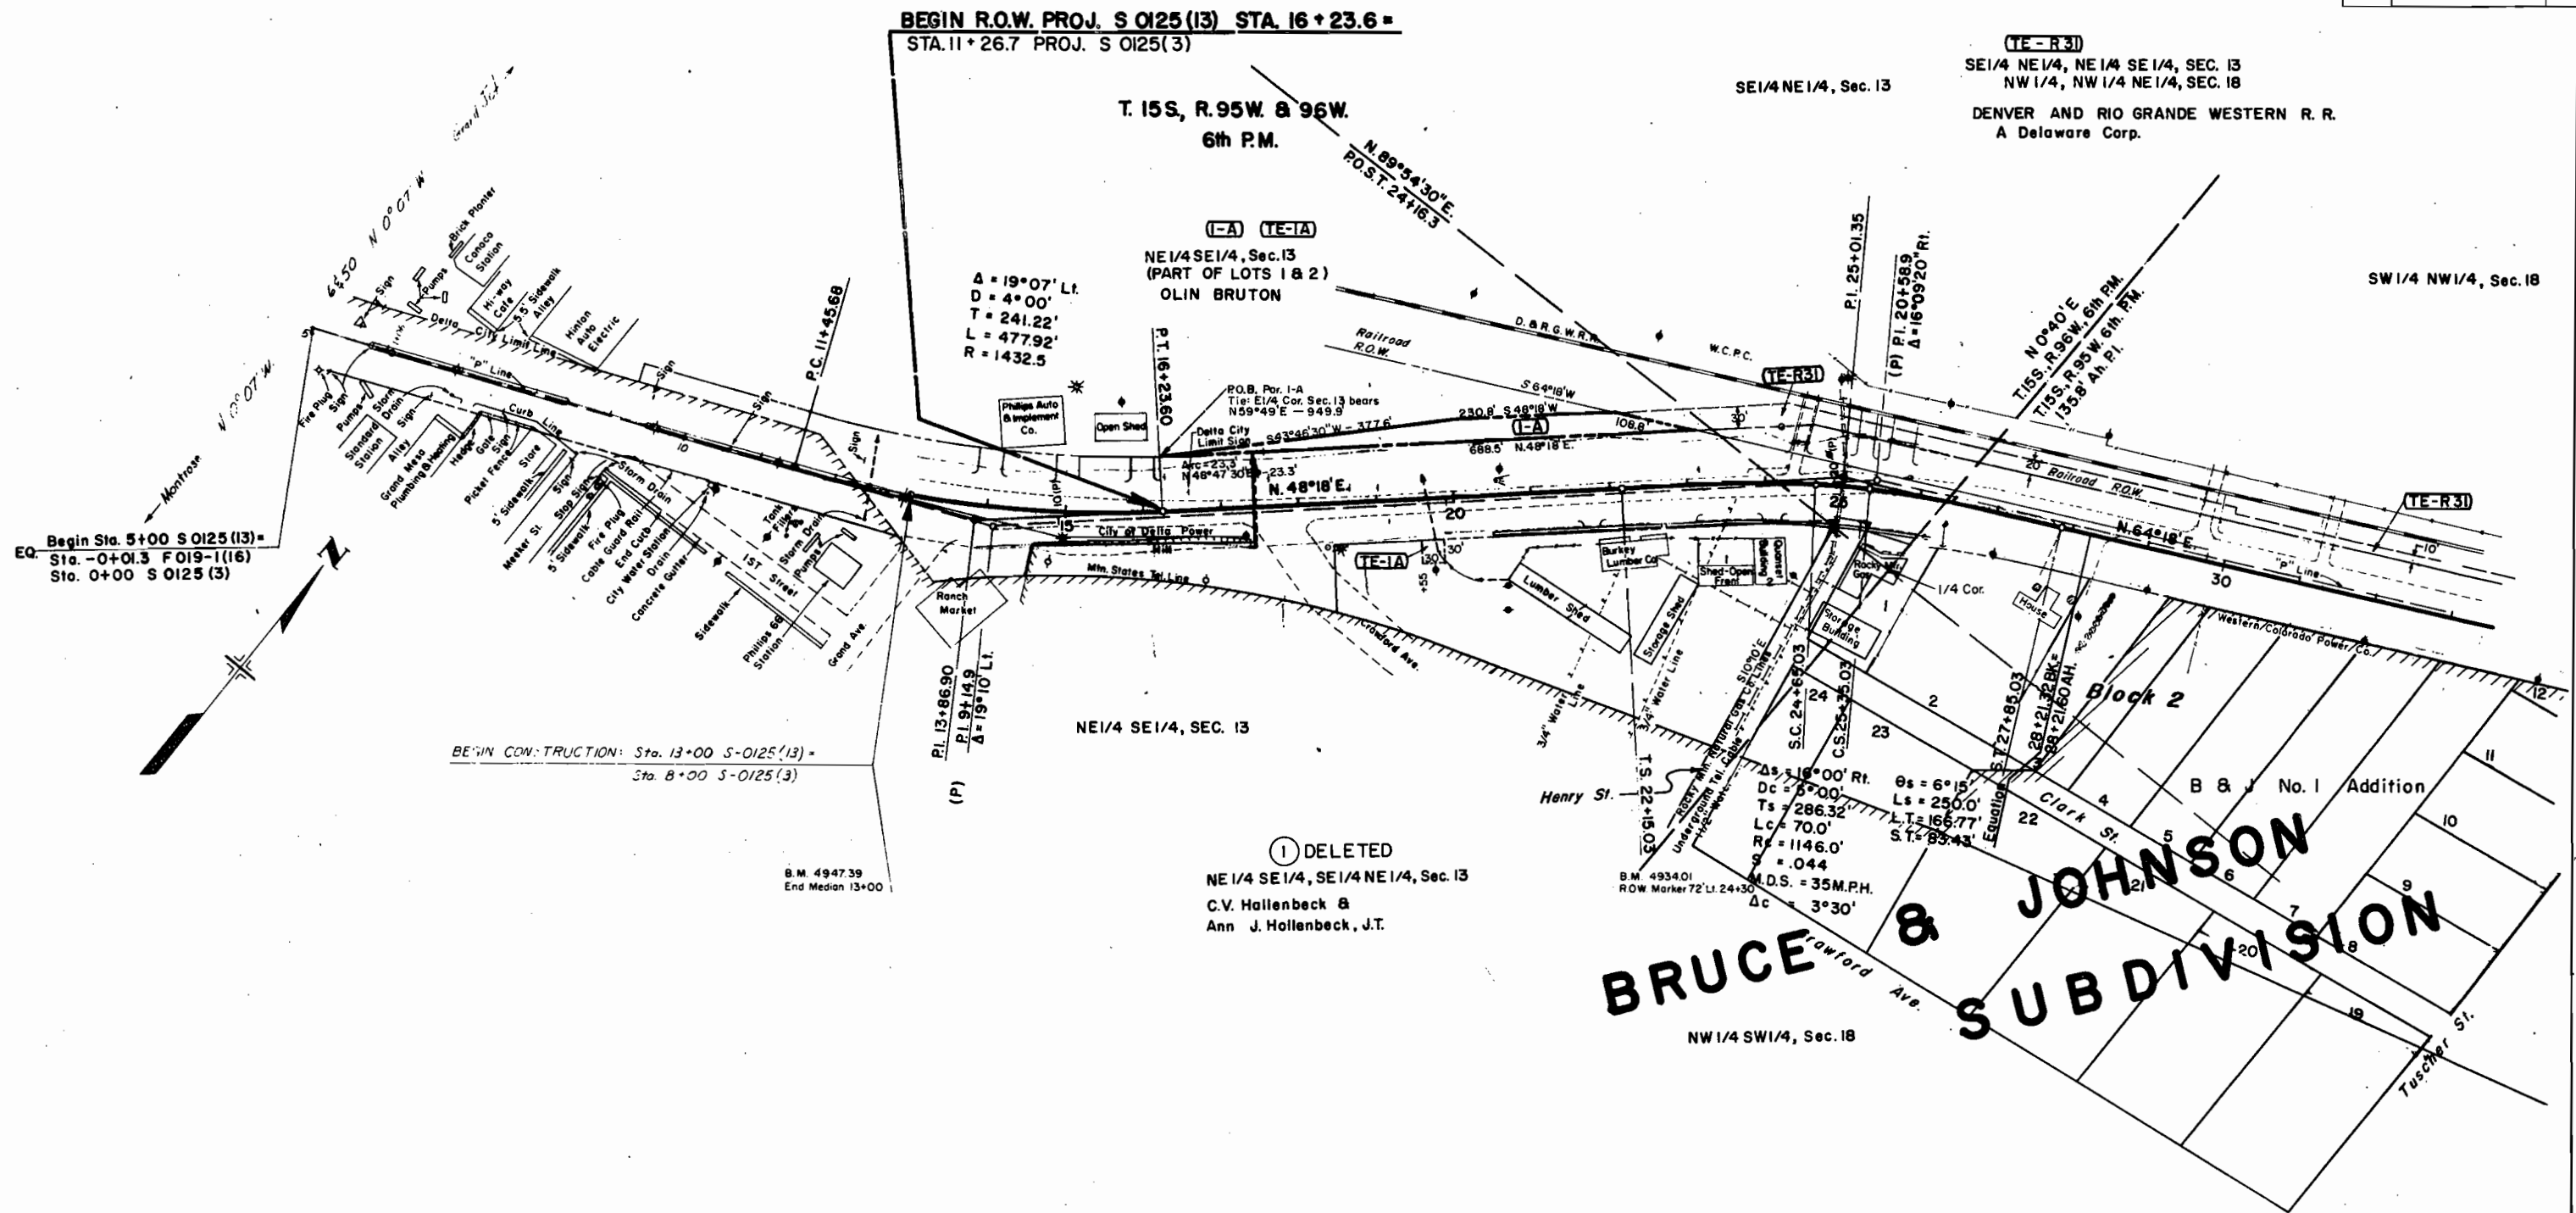[illegible]


FEDERAL ROAD DIVISION NO.	DISTRICT	PROJ. NO.	SHEET NO.	TOTAL SHEETS
9	COLORADO	S 0125 (13)	7	

RIGHT OF WAY DELTA-EAST

REVISIONS		
9-25-68	Add TE-1-R31A thru D	LB
10-7-68	Del. 5 Rev. Rev. TE-5, TE-5A	—
—	TE-5B, E-5	LB
10-30-68	Delete TE-2 Rev. TE-3, TE-4	—
—	TE-5 Rev. TE-29 Rev. TE-30 Rev.	—
—	Add E-2, E-3, E-4, E-5A, E-5B, E-5C	KC
12-20-68	Rev. Par. 30, Delete E-30	KC

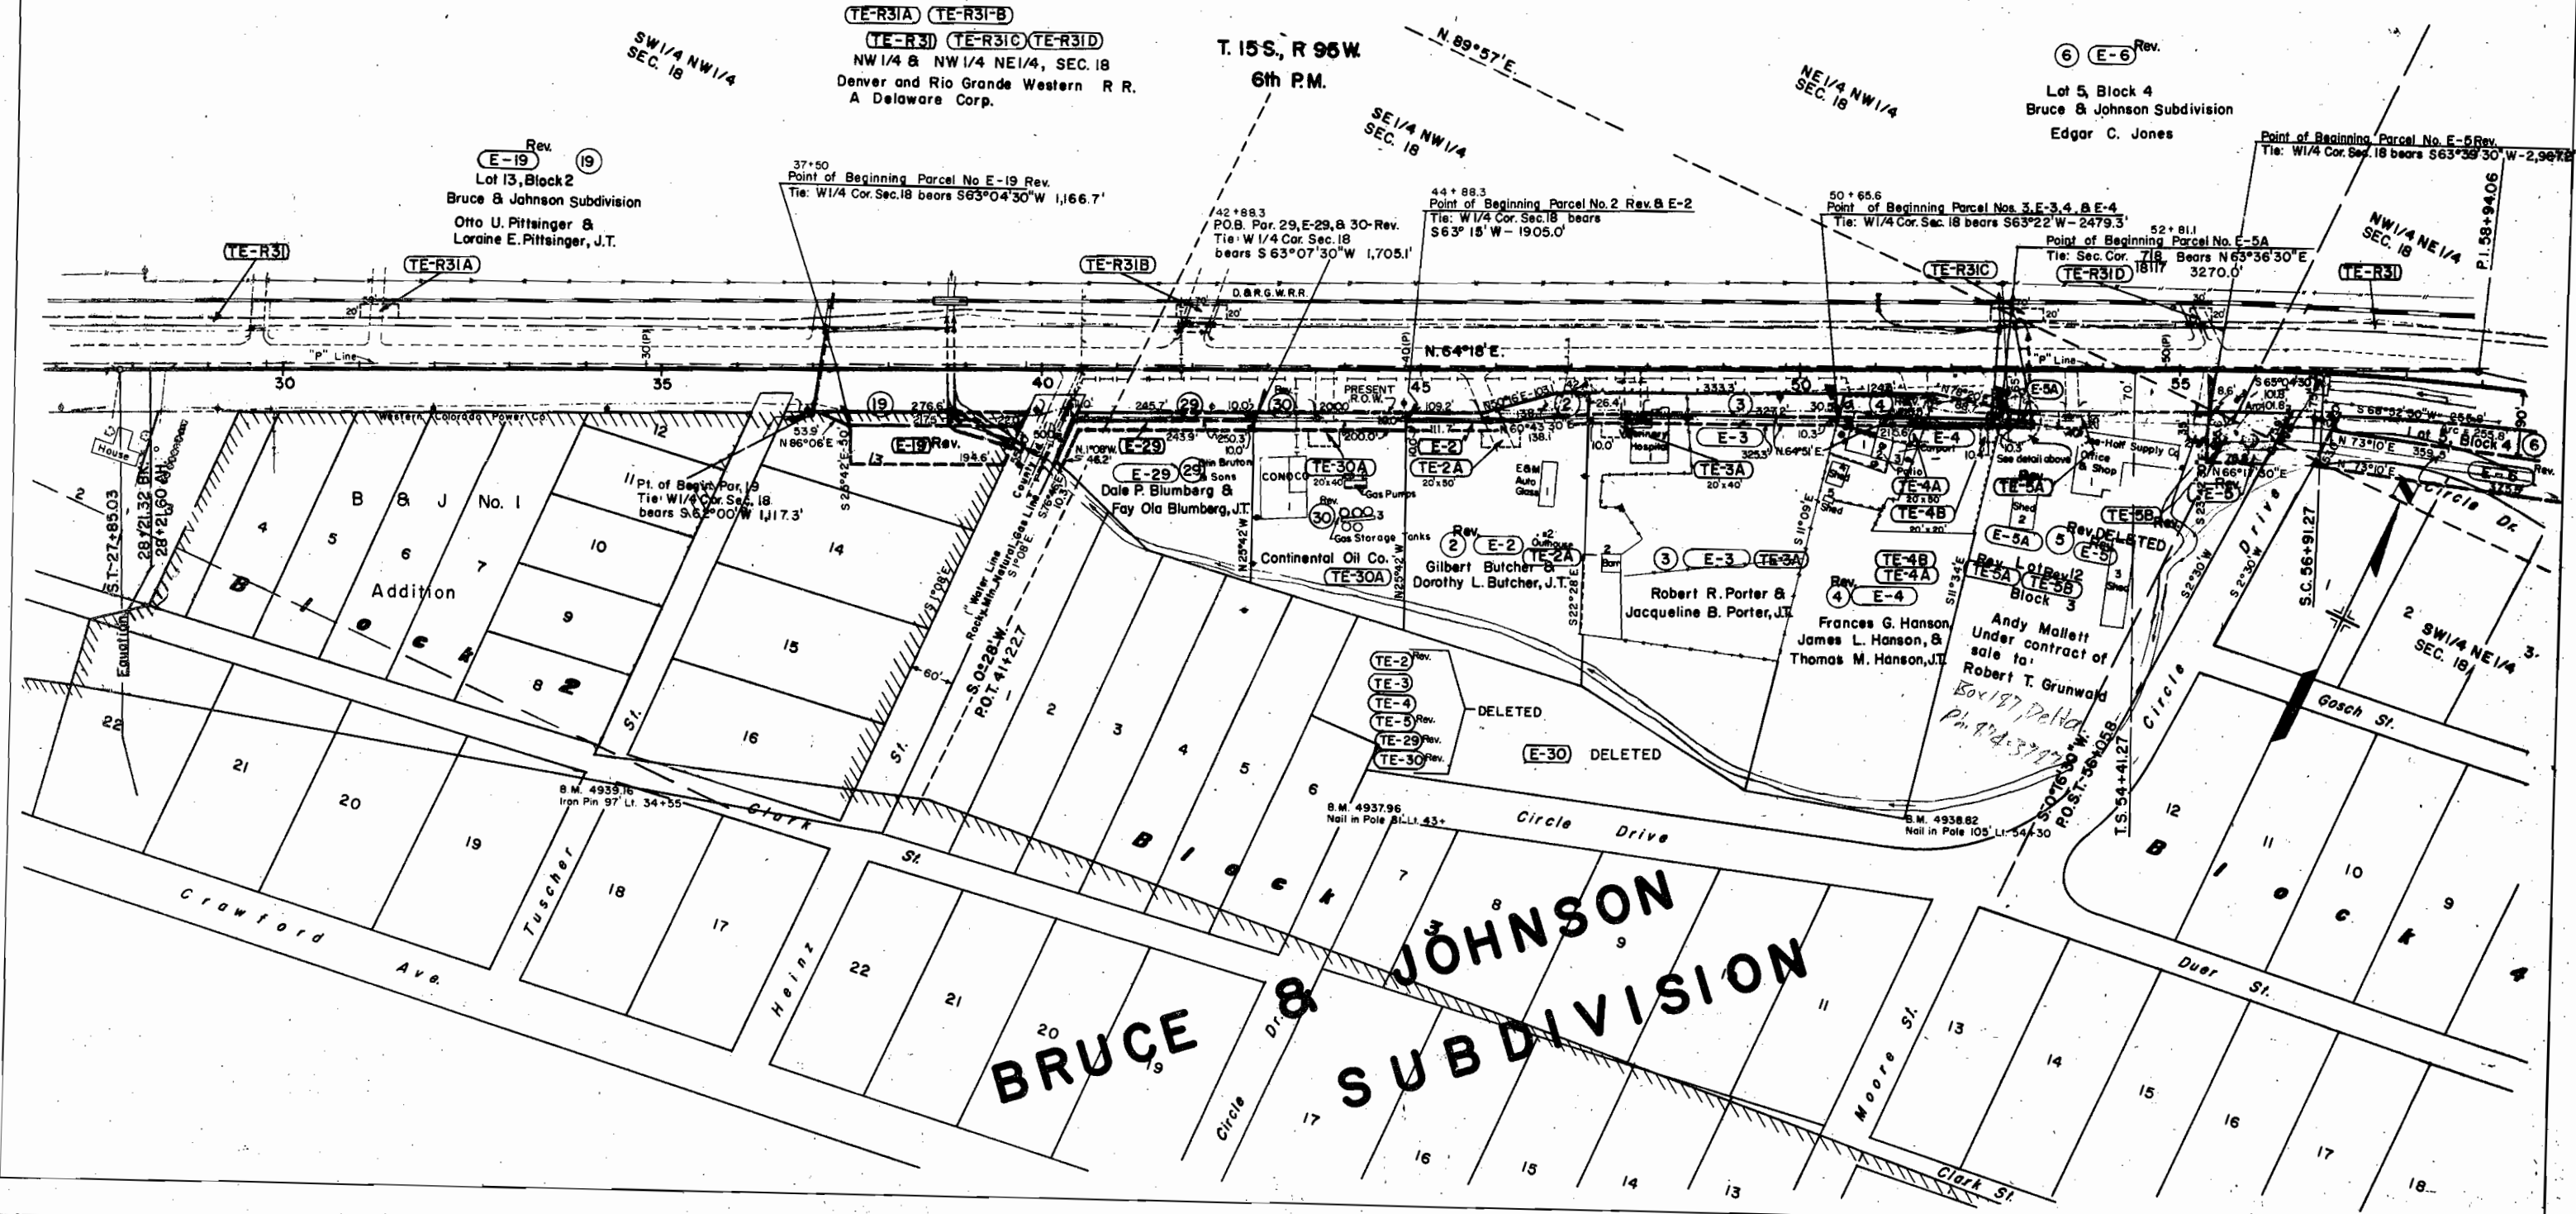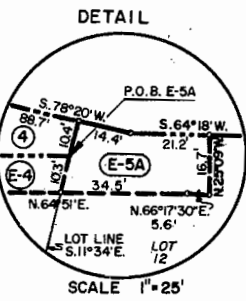


REVISIONS		
11-18-68	Change name par 9; Add	--
---	TE-9B	LB
7-25-72	Add E-9A & E-10A	KC

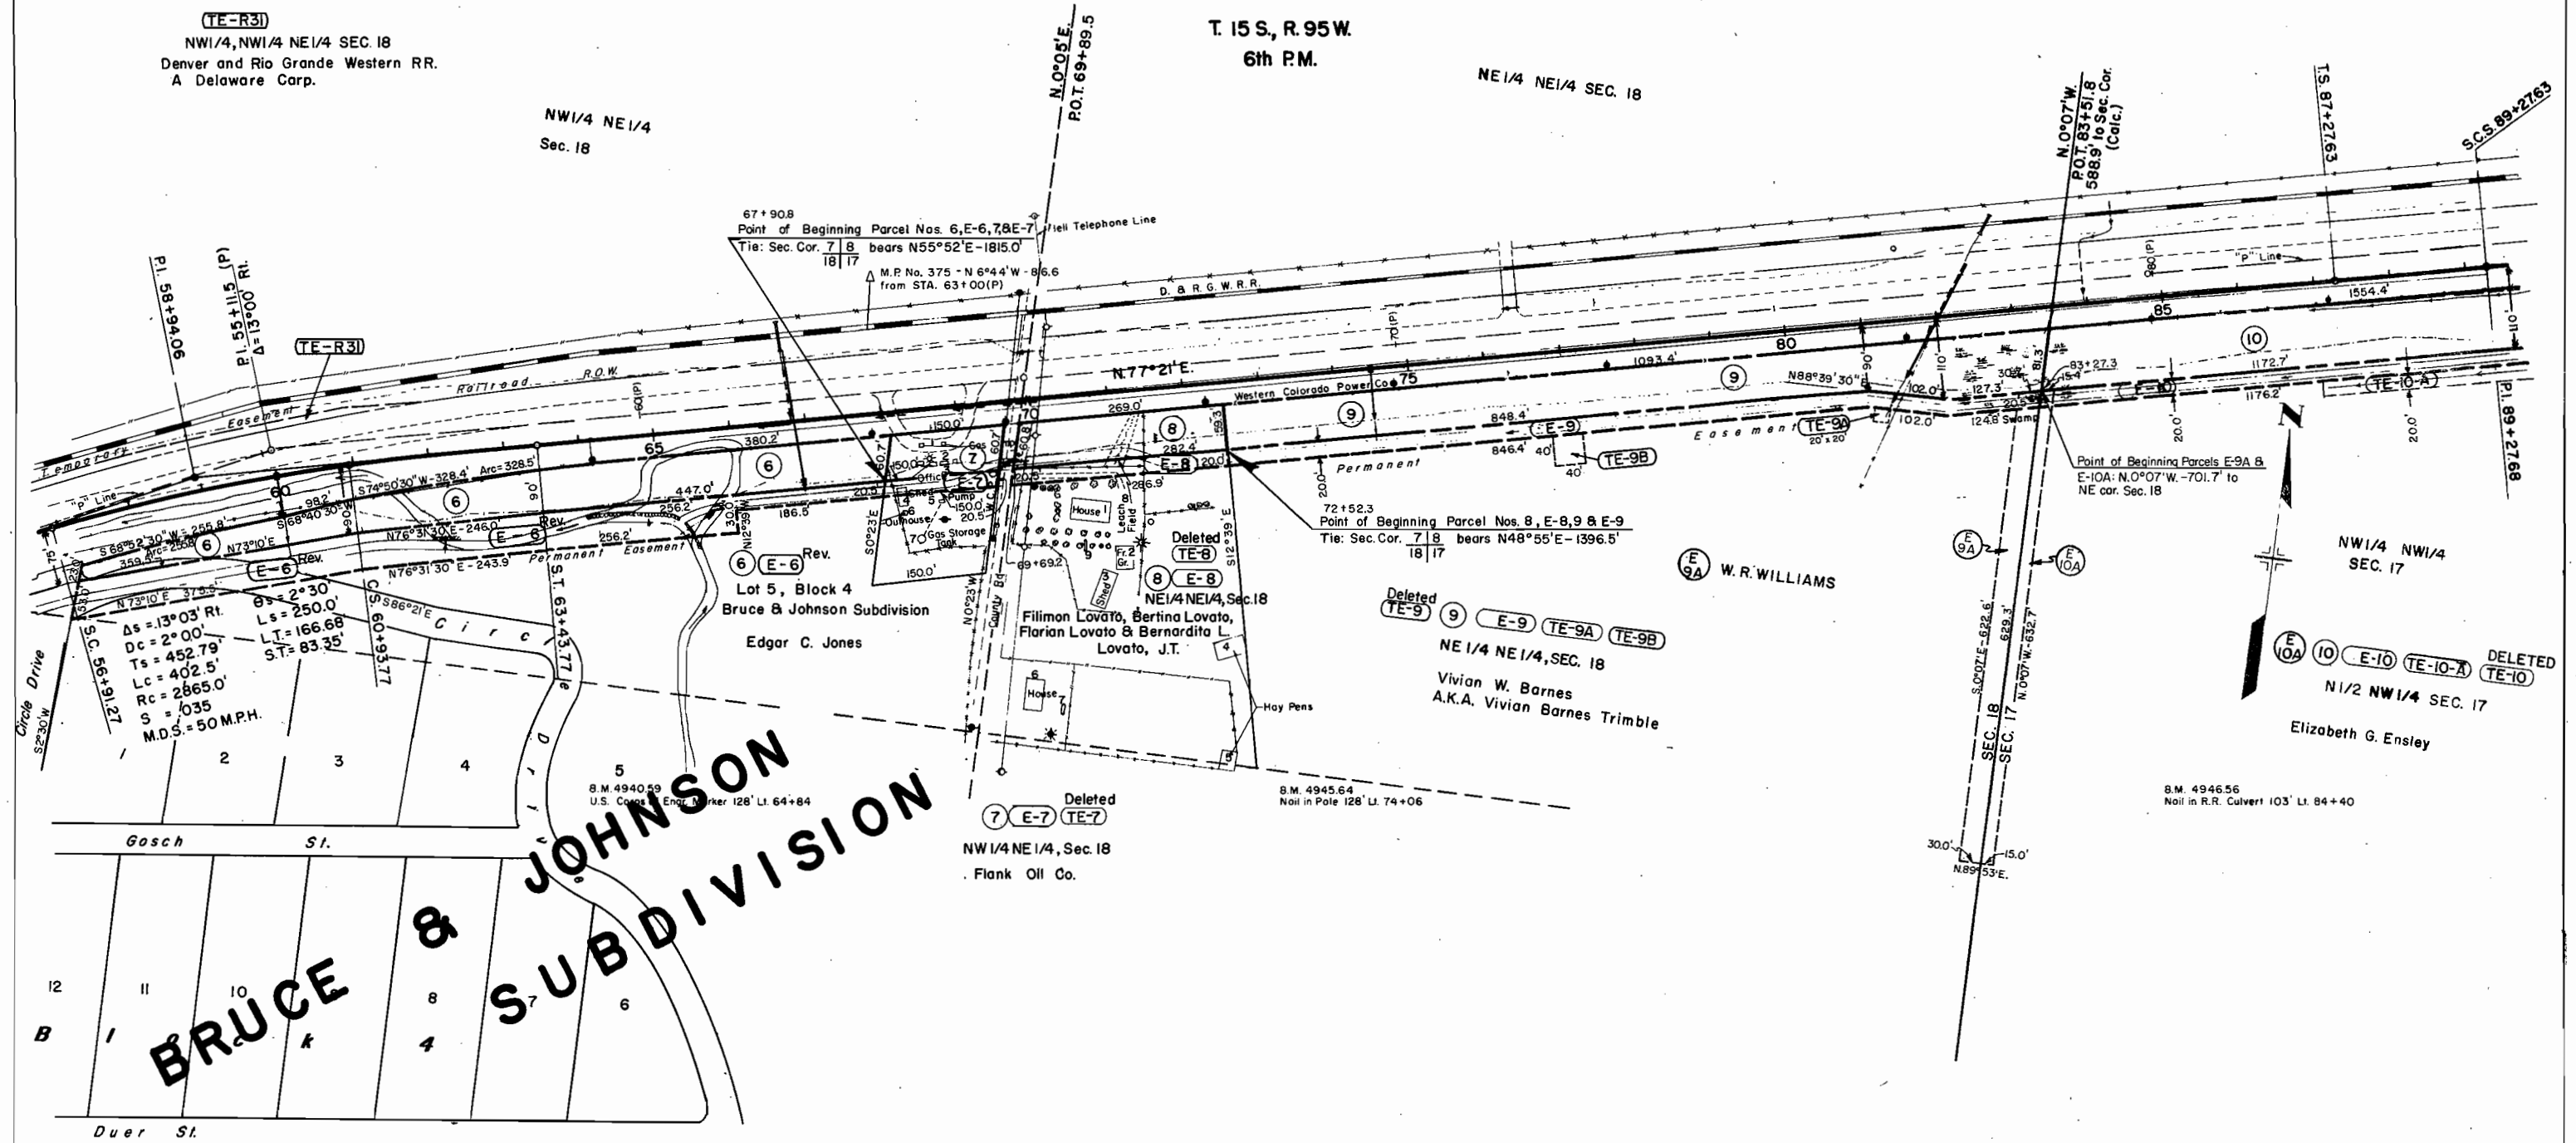

RIGHT OF WAY DELTA - EAST

REVISIONS	
10-15-69	Deleted TE-14
3-11-70	ADD YE-13A & TE-13B
4-1-70	Name change Par.13 et al
5-8-70	ADD E-NA,E-12A,E-13A
	TE-13C,TE-11A,TE-12A,TE-13B
	Name Chg. Par 12
10-28-70	Add Struct 90+,115+85,117+

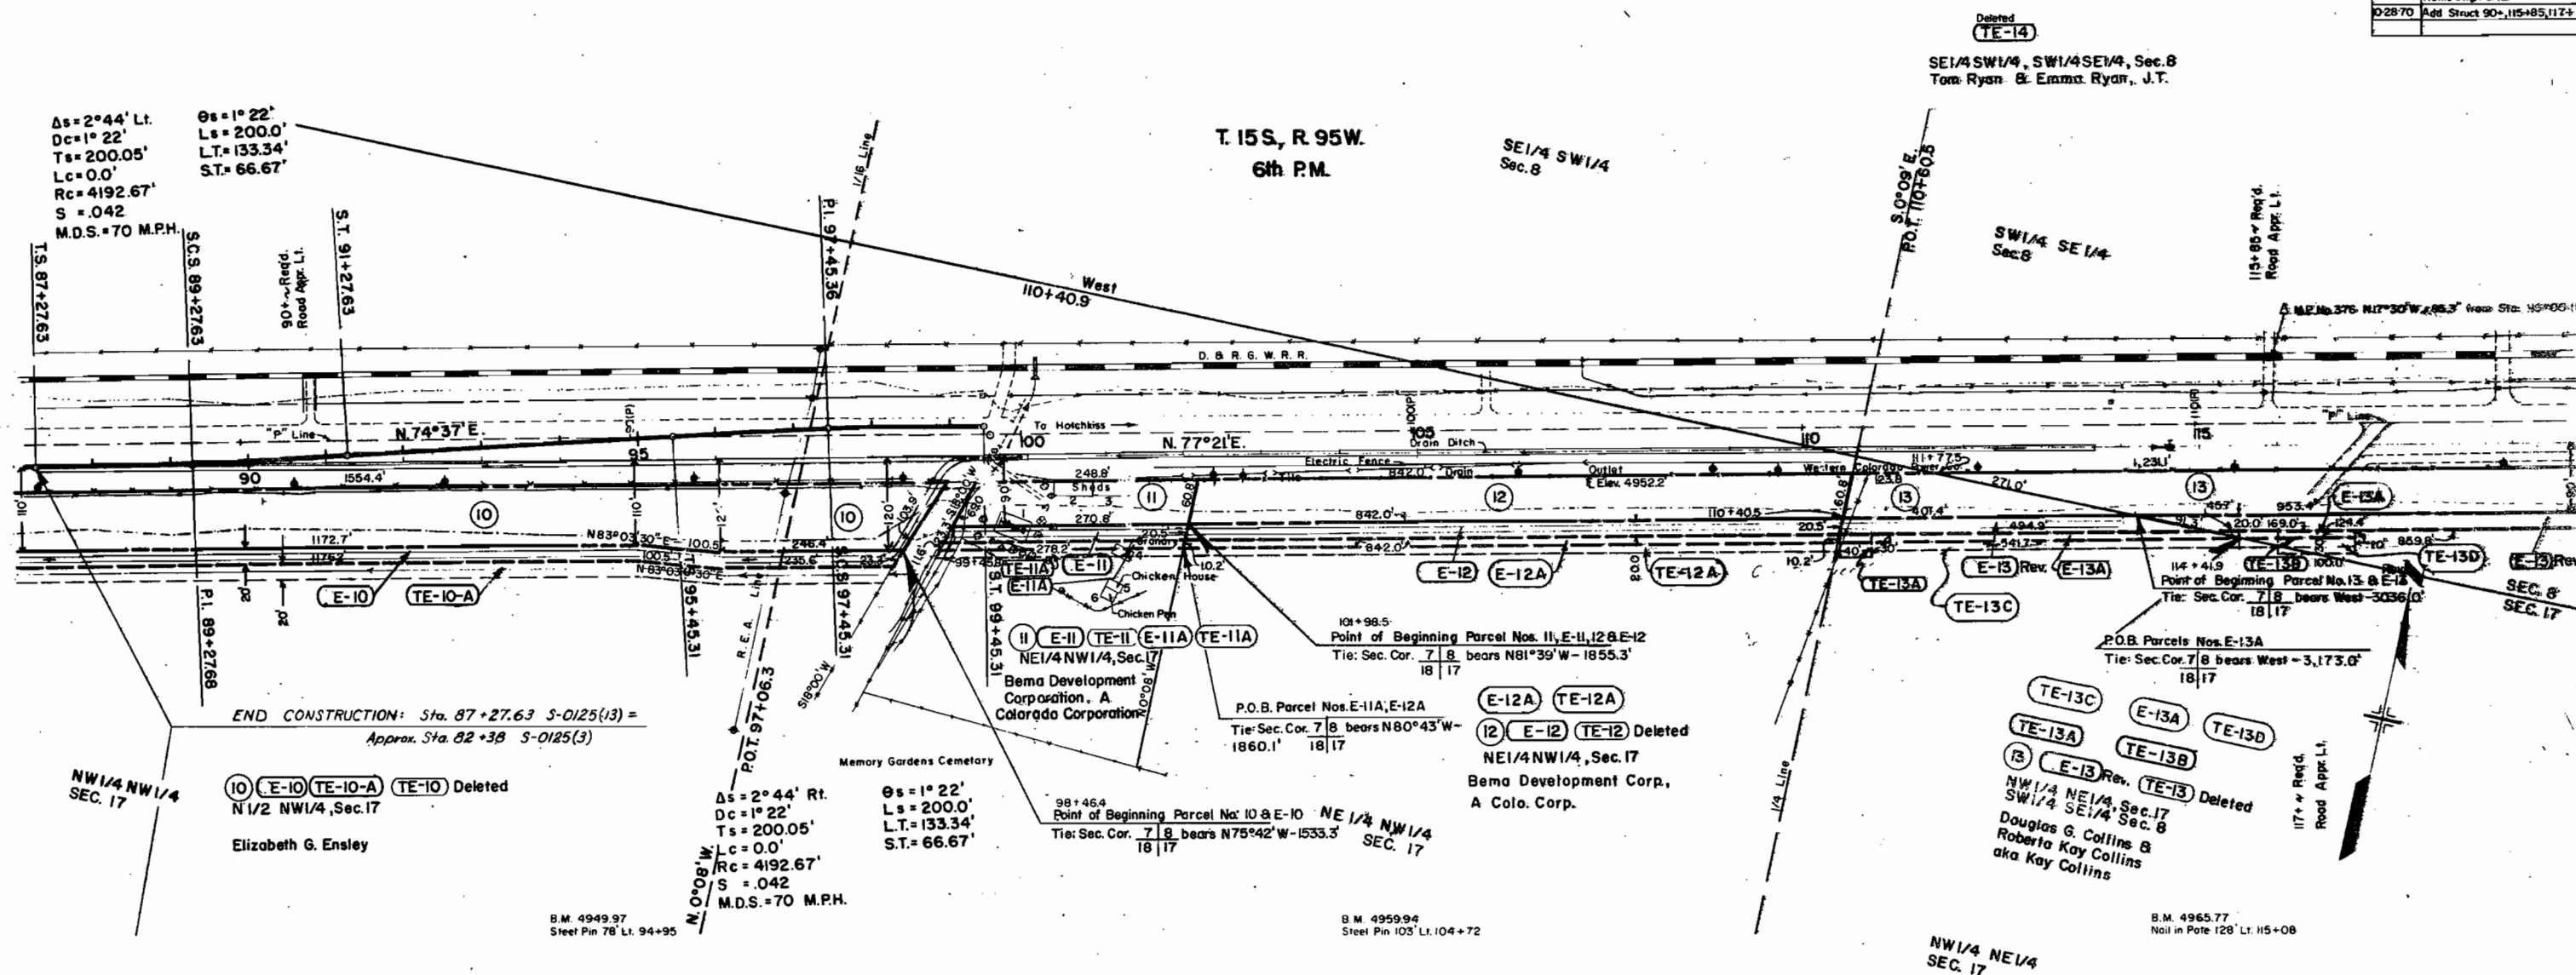

RIGHT OF WAY DELTA-EAST

REVISIONS		
10-15-98	DELETE TE-15, TE-55, Add TE-44	6
	TE-11, TE-12, TE-56, TE-110	6
1-2-70	Delete TE-10, B, Add TE-130	6
4-1-70	Name Change 13 B E-13 Rev.	6
7-21-70	Add TE-32, TE-33	6
10-29-70	Add Street 123-90124-50,	6
	20-90132-20, 144-14000, 144-5	6

Tam Ryan &
Emma Ryan, JT

TE-R-32

TE-R-33

DENVER RIO GRANDE WESTERN RAILROAD

157 + 70 = Reg. d.
Co Road April 4, 1911
891 Molluscs entering

44-0000 Reg. d
Road Apr. 14

SW 1/4 SE 1/4, Sec. 8

Douglas G. Collins &
Roberta Kay Collins aka.
Kay Collins

(13) (E-13) Rev. (TE-13) Deleted

SW 1/4 SE 1/4, Sec 8

(14-A) (14) (TE-14-A)

SE1/4 SE1/4, Sec. 8
Tom Ryan &
Emma Ryan, J.T.

28+90 Req'd.
Good Appt. Lt

TE-R-32

TE-R-33

TE-15-A Deleted
TE-15-B
15-A 15 TE-15

SW1/4 SW1/4, Sec. 9
Mary C. Jeffers
(Estate of J. Welland Jeffers)

Δ M.P. No. 376 N 17° 30' W - 85.3'
from Sta. H 6 + 00 (P)

20° TEMP. EASEMENT

D. & R. G. W. R. R.

N. 77° 21' E.

Fruit Stand
1 1/2 Gunnison Valley
Domestic Water
House

P.O.B. 14-A & 15-A
The SW Cor. SEC. 8
beers. S 84° 39' W
5.311.6'

137+50.3
P&B No. 14819
Tie: NW Cor. Sec. 17
beers S. 84° 32' W
5,312.6'

(T.E-15-A)

43+00.0
43+10 ~ Req'd.
Road Appx. R1.

44-357 Req'd.
Road Appr. Rt.

SW 1/4 SW 1/4
SEC. 9


SE 1/4 SE 1/4, Sec. 8

SEC. 8
SEC. 17

FEDERAL ROAD DIVISION NO.	DISTRICT	PROJ. NO.	SHEET NO.	TOTAL SHEETS
9	COLORADO	S 0125 (13)	13	

RIGHT OF WAY DELTA - EAST

REVISIONS		
10-15-69	Delete E-18, Add E-18-A, E-18-B	GF
2-18-70	Revise E-18-A, E-18-B	GF
7-21-70	Add E-18-B	GF
9-2-70	Delete E-18-B, Rev Add TE-18-A	GAM
10-28-70	Add Station 272+	GAM

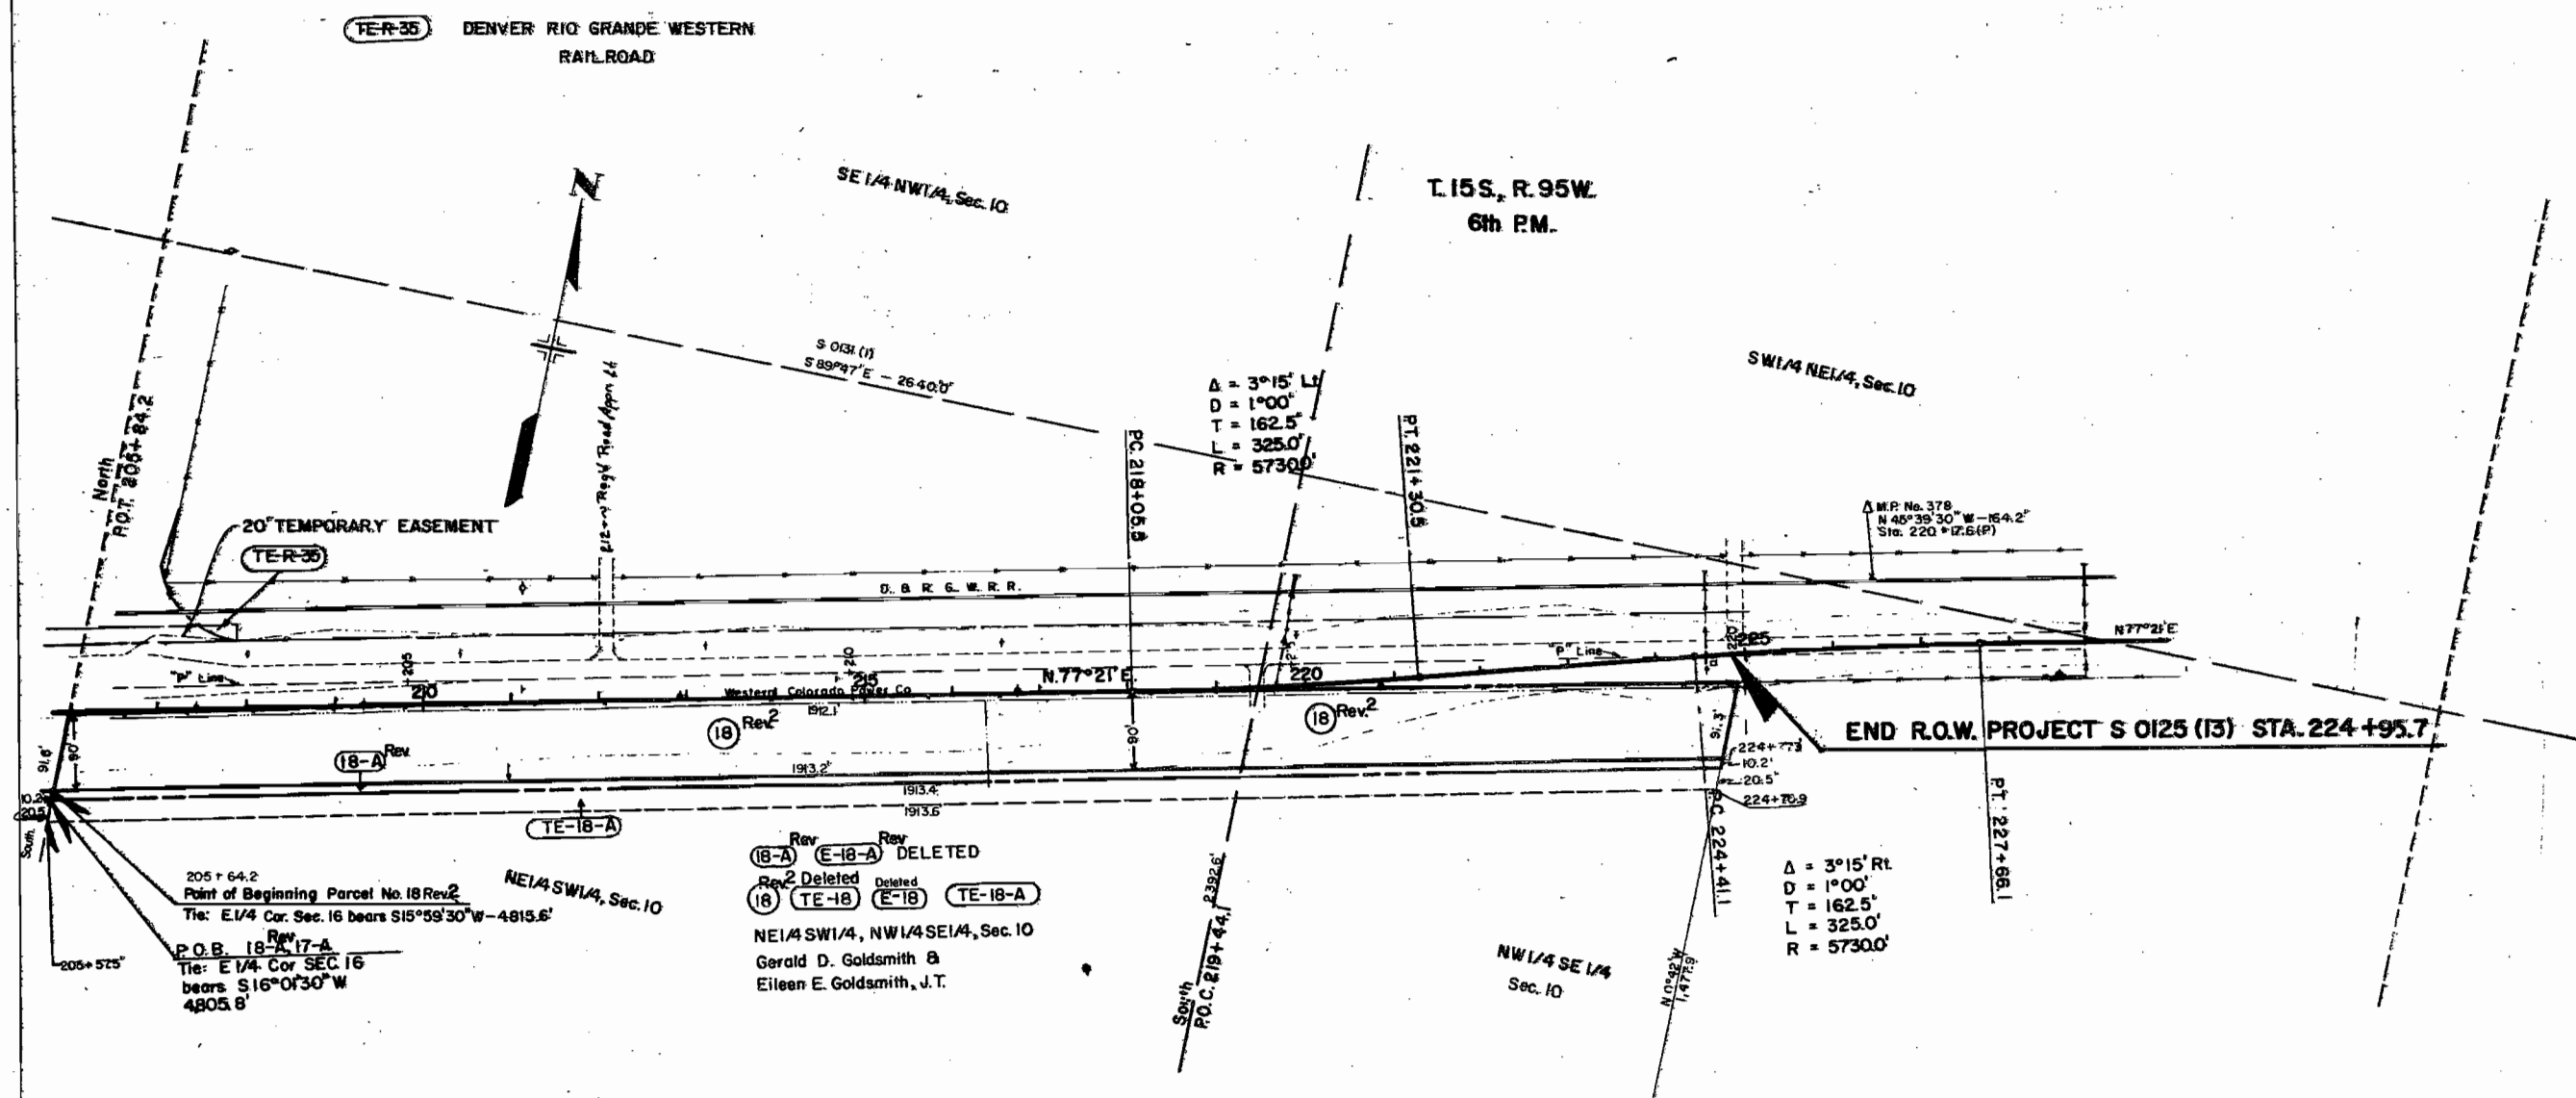


DEPARTMENT OF HIGHWAYS
STATE OF COLORADO
PROJECT S 0125 (13)
R.O.W. OWNERSHIP MAP
DELTA COUNTY
T.15S., R.95W. & 96W., 6th P.M.
Scale : 1" = 400'

FEDERAL ROAD REGION NO.	DIVISION	PROJ. NO.	SHEET NO.	TOTAL SHEETS
9	COLORADO	S 0125 (13)	14	

RIGHT OF WAY DELTA - EAST

REVISIONS		
9-25-68	Add TE's R31A thru D	LB
10-7-68	Del. 18 & 5 Rev.; Add TE-1A; Rev.	LB
—	TE-5, TE-5A, TE-5B, & E-6	LB
10-30-68	Delete TE-2 Rev., TE-3, TE-4,	—
—	TE-5 Rev., TE-29 Rev., TE-30 Rev.	—
—	Add E-2, E-3, E-4, E-5A, E-29 Rev.	KC
11-18-68	Add TE-9B	LB
2-20-68	Rev. Par. 30, Delete E-30	KC
3-11-70	Add TE-13A & TE-13B	KC
4-1-70	Name change Par. 13 et al	KC
5-8-70	Add E-13A, E-11A, E-12A	—
—	TE's 11A, 12A, 13C, 13D	—
—	Name Chg. Par. 12	GM
7-25-72	Add E-9A & E-10A	KC

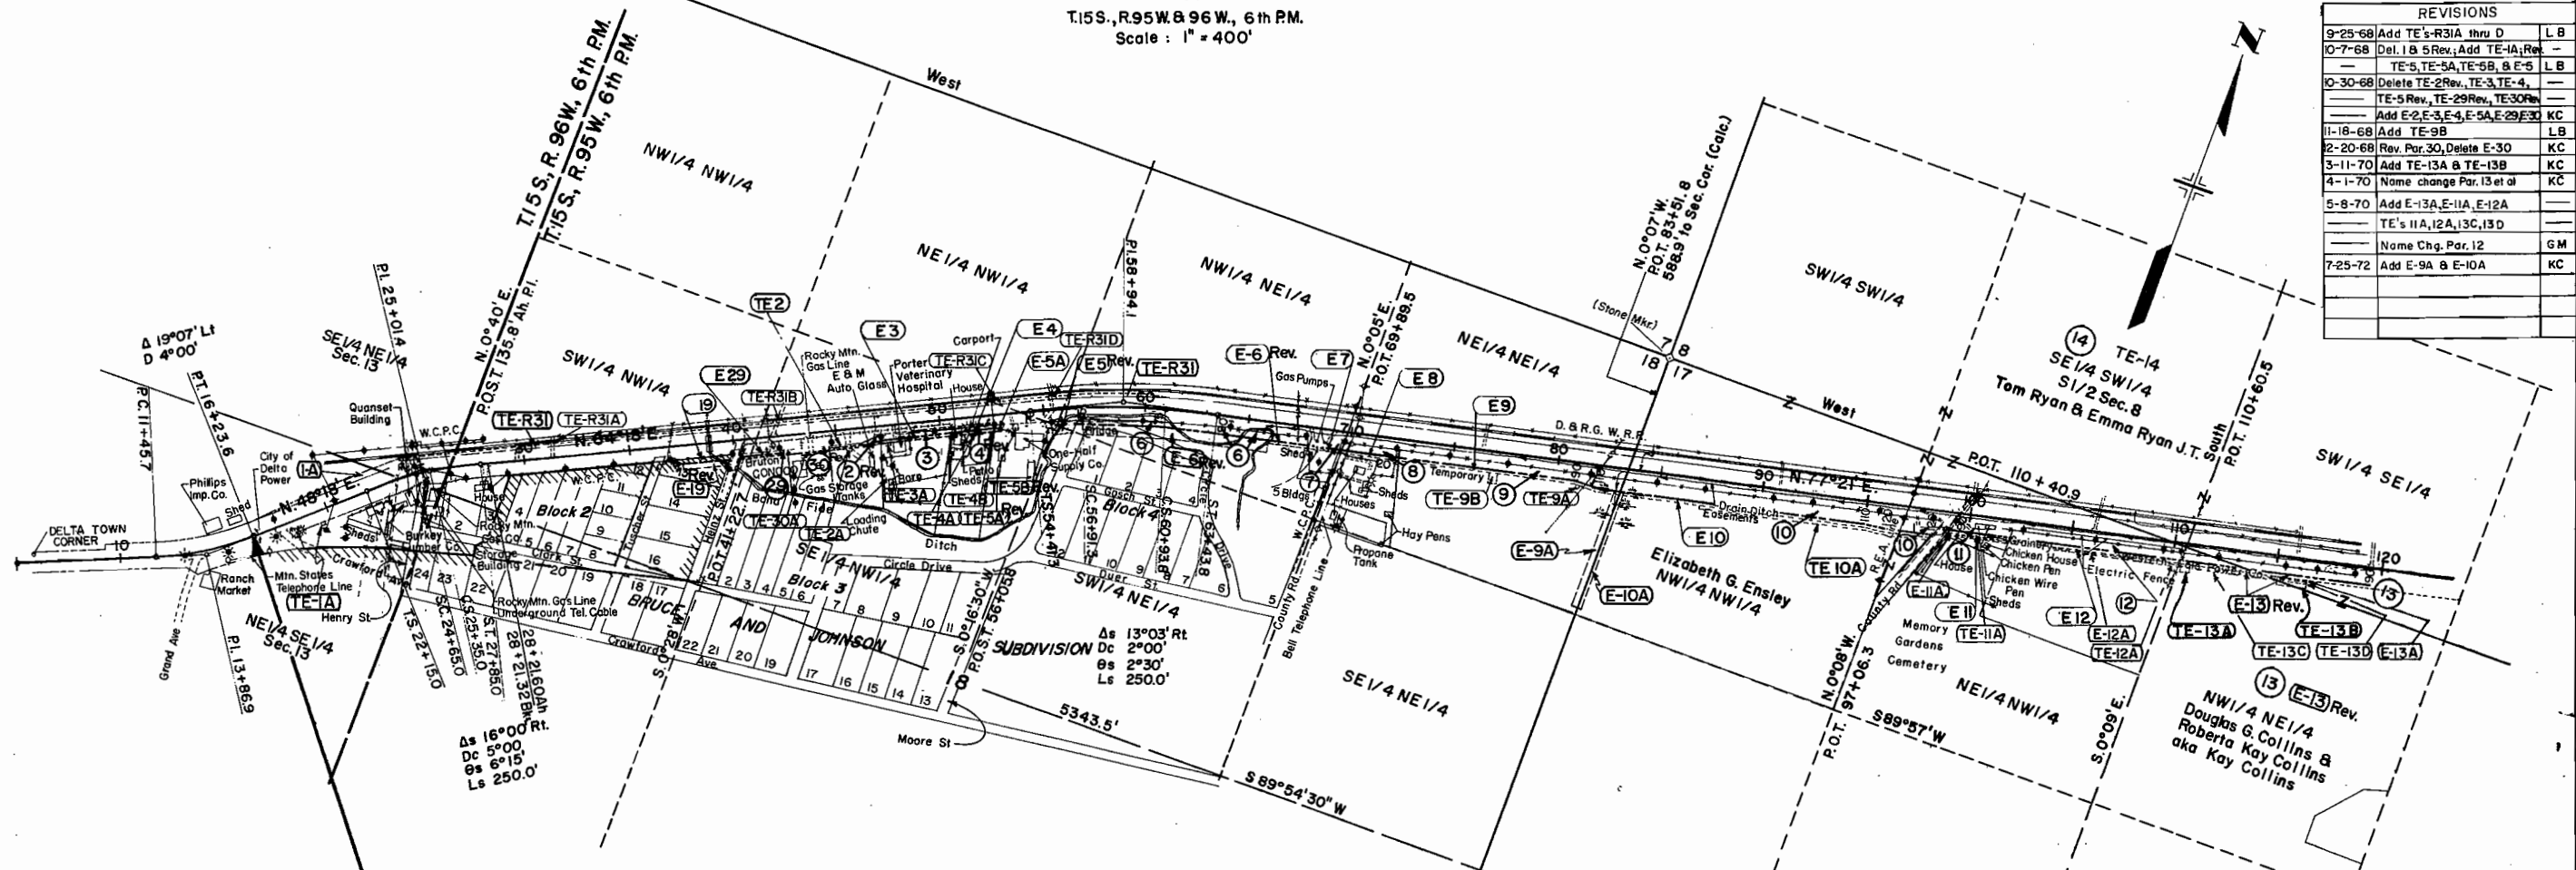

BEGIN R.O.W. PROJ. S 0125 (13) STA. 16 + 23.6 =
STA. 11 + 26.7 PROJ. S 0125 (3)

(I-A) (TE-1A)
Part NE 1/4 SE 1/4, Sec. 13
Olin Bruton
(TE-R31A) (TE-R31B) (TE-R31C)
(TE-R31) (TE-R31D)
Pt. NW 1/4 & NW 1/4 NE 1/4 Sec. 18
Denver & Rio Grande Western R.R. Co.
A Delaware Corp.

Parcel No.	Owners	Description
DELETED ①	C.V. Hallenbeck & Ann J. Hallenbeck, J.T.	NE 1/4 SE 1/4 & SE 1/4 NE 1/4, Sec. 13
TE-2A E-2 ②	Gilbert Butcher & Dorothy L. Butcher, J.T.	SE 1/4 NW 1/4, Sec. 18
TE-3A E-3 ③	Robert R. Porter & Jacqueline B. Porter, J.T.	SE 1/4 NW 1/4, Sec. 18
TE-4A E-4 ④	Frances G. Hanson, James L. Hanson, & Thomas M. Hanson, J.T.	SE 1/4 NW 1/4, Sec. 18
TE-5A E-5 ⑤	Andy Mallett Under contract of sale to Robt. T. Grunwald	Lot 12, Block 3
TE-6A E-6 ⑥	Edgar C. Jones	Lot 5, Block 4
TE-19A E-19 ⑨	Otto U. Pittsinger & Loraine E. Pittsinger, J.T.	Lot 13, Block 2
TE-29A E-29 ②	Dale P. Blumberg & Fay Ola Blumberg, J.T.	SE 1/4 NW 1/4, Sec. 18
TE-30A E-30 ③	Continental Oil Co.	SE 1/4 NW 1/4, Sec. 18

NOTE: Temporary easements TE-2 Rev., TE-3, TE-4, TE-5 Rev., TE-29 Rev., TE-30 Rev. have been deleted.

⑦ (E-7) (TE-7) Deleted
Part NW 1/4 NE 1/4, Sec. 18
Flank Oil Co.
dba. Oriental Refinery Co.

⑧ (E-8) (TE-8) Deleted
Part NE 1/4 NE 1/4, Sec. 18
Filimon Lovato,
Bertina Lovato,
Florian Lovato &
Bernardita L. Lovato, J.T.

⑨ Deleted (E-9) (TE-9A) (TE-9B)
Part NE 1/4 NE 1/4, Sec. 18
Vivian W. Barnes
a.k.a. Vivian Barnes Trimble

(E-9A) W.R. WILLIAMS

(TE-10) Deleted
(E-10A) ⑩ (E-10) (TE-10A)
Part N 1/2 NW 1/4, Sec. 17
Elizabeth G. Ensley

(E-11A) (TE-11A)
⑪ (E-11) (TE-11) Deleted
Part NE 1/4 NW 1/4, Sec. 17
Bema Development Corp.,
a Colorado corporation.

(TE-13C) (TE-13D) (E-13A)
(TE-13A) (TE-13B)
Deleted (TE-13) ⑬ (E-13) Rev.
Part of SW 1/4 SE 1/4, Sec. 8
NW 1/4 NE 1/4, Sec. 17
Douglas G. Collins &
Roberta Kay Collins
aka Kay Collins

(E-12A) (TE-12A)
⑫ (E-12) (TE-12) Deleted
NE 1/4 NW 1/4, Sec. 17
Bema Development Corp.,
a Colo. Corp.

DEPARTMENT OF HIGHWAYS
STATE OF COLORADO
PROJECT S 0125 (13)
R.O.W. OWNERSHIP MAP

DELTA COUNTY
TJ5S., R.95 W. & 96 W., 6th P.M.
Scale: 1" = 400'

FEDERAL ROAD REGION NO.	DIVISION	PROJ. NO.	SHEET NO.	TOTAL SHEETS
9	COLORADO	S 0125 (13)	13	

RIGHT OF WAY DELTA-EAST

TE-R-32 THRU TE-R-35 DENVER RIO GRANDE WESTERN
RAILROAD

REVISIONS	
10-15-69	Delete TE-14, TE-15, E-18, E-16-A
	Add H-A, TE-14-A, E-15-A, E-16-A
	TE-15-A, E-16-A, E-17-A
	18-A, E-18-A
1-2-70	Delete TE-15-B, Add TE-15 Rev
2-17-70	Revise 18 Rev, 18-A, E-18-A
	TE-20, E-20, Add TE-16-C
	TE-17
3-11-70	Add TE-13A, TE-13B, TE-16B
4-1-70	Name change Par. 13 et al
7-21-70	Add TE-R-32 thru TE-R-35
9-2-70	Delete E-18-A Rev, Add TE-18-A

