

DEPARTMENT OF HIGHWAYS
STATE OF COLORADO


R.O.W. ACQUIRED UNDER PROJECT
NOS. S0133(1) & S0133(2).

AS CONSTRUCTED
REVISED DATE OCT 12 1967

INDEX OF SHEETS

PLAN AND PROFILE OF PROPOSED CONSTRUCTED
FEDERAL AID PROJECT NO. S 0133 (2)
STATE HIGHWAY NO. 42
BOULDER COUNTY

CONVENTIONAL SIGNS

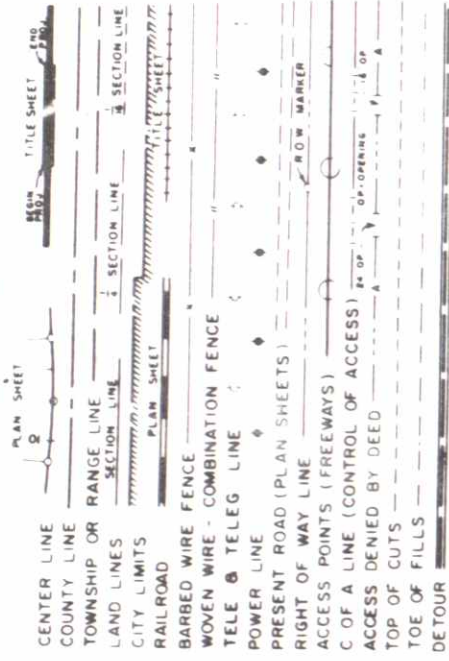

TABULATION OF LENGTH AND DESIGN DATA

STATION	R.O.W.		ROADWAY		MAJOR STRUCTURES	
	LINE	FT.	LINE	FT.	LINE	FT.
126+00 BEGIN CONST. S0133(2) 126+00 END CONST. S0133(1)			1315.7			42.0
139+15.7 BEGIN ROW. S0133(2)						
S.T. 164+13.8 Bk (PROV.) 164+23.8 Ah (SURV) EQUATION	2,498.1		2,498.1			
168+54.0	430.2		430.2			
168+96.0	42.0		2,191.6			
RT. 190+87.6 Bk EQUATION 190+87.5 Ah	1243.2		1243.2			
203+30.7 Bk EQUATION 203+36.7 Ah	526.13		526.13			
255+98.0 END CONST S0133(2) 8.9' LT. APPROX. STA. 831+20 ON C07-0001-06	8.9					
256+06.9 END ROW S0133(2)						
TOTALS	11,675.3		12,940.1		42.0	
SUMMARY			LINE	FT.	MILES	
Roadway - Net Length			12,940.1		2.451	
Structure			42.0		0.008	
ROW			11,675.3		2.211	
Net & Gross Length of Construction			12,982.1		2.459	
DESIGN DATA						
MAXIMUM DEGREE OF CURVE					5° 00'	
MAXIMUM GRADE					6%	
MINIMUM S.S.D. HORIZONTAL					635'	
MINIMUM S.S.D. VERTICAL					495'	
MAXIMUM DESIGN SPEED					60 MPH.	

STA. 126+00 BEGIN CONST. S0133(2)
STA. 126+00 END CONST. S0133(1)

STA. 255+98.0 END CONST. S0133(2)=
8.9' LT. APPROX. STA. 831+20 ON C07-0001-06

ON PLAN, 1 IN. = 100 FT.

ON PROFILE, 1 IN. = 10 FT. VERTICAL

GRADE LINE ON PROFILE IS SHOWN AS GRADE OF FINISHED ROAD

PROJ. BEGAN MARCH 6, 1967


PROJ. COMPLETED OCTOBER 12, 1967

CONTRACTOR FLATIRON PAVING CO.

RESIDENT ENGR. GEO. DANFORTH JR.

PROJECT ENGR. JAMES D. HUTCHISON

These Sheets
Not Revised

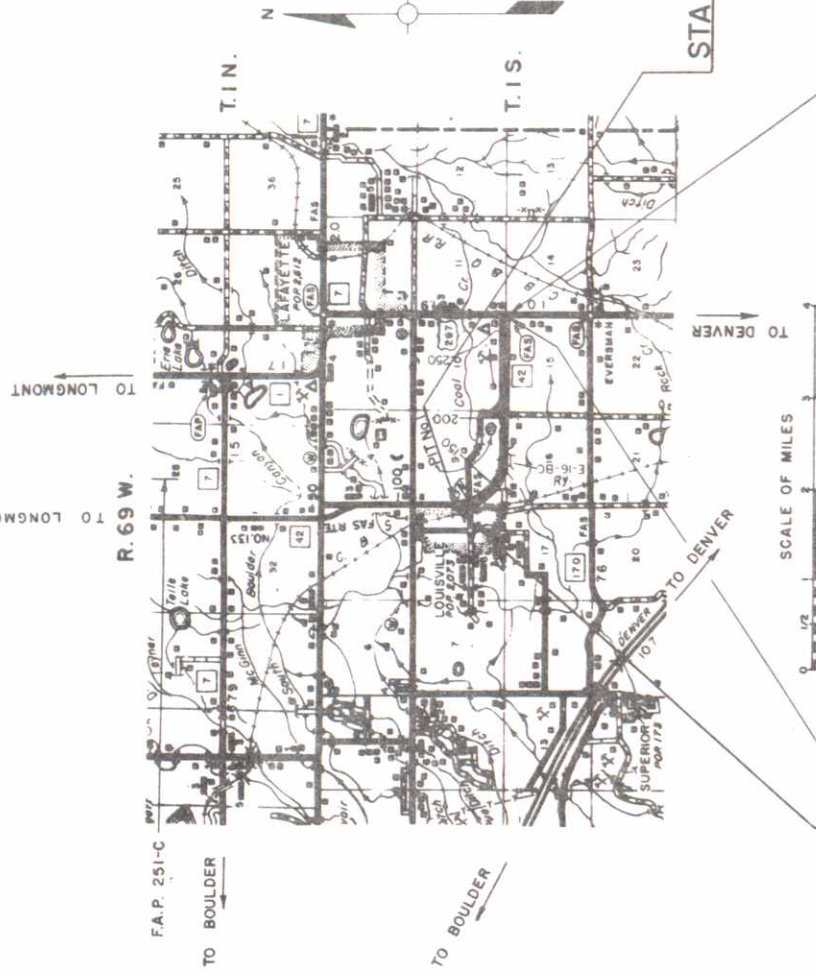

STA. 139+15.7 BEGIN R.O.W. S0133(2)

STA. 256+06.9 END R.O.W. S0133(2)

APPROVED *Albert S. Stone* 12/15/67
DISTRICT FOUR

FEDERAL ROAD DISTRICT NO.	DIVISION	PROJECT NO.	SHEET NO.
9	COLORADO	S 0133 (2)	93
TOTAL SHEETS			93

DEPARTMENT OF HIGHWAYS
STATE OF COLORADO

APPROVED

Chas. F. Shumate 2-2-67
CHIEF ENGINEER

By *L. L. Benson* 12/15/67
DEPARTMENT OF COMMERCE
BUREAU OF PUBLIC ROADS

APPROVED

DATE

DIVISION ENGINEER

Oct. 12, 1967

TAL

Oct 12, 1967

NW 1/4 Sec. 9
T.15. R.69W


* Line to be Relocated

AS NOTED
DATE: Oct 12, 1967


Cut Slope
Fill Slope


TO LONGMONT

Louisville City Limit
line is along centerline
of Survey Sta. 103+ to
Sta. 139+

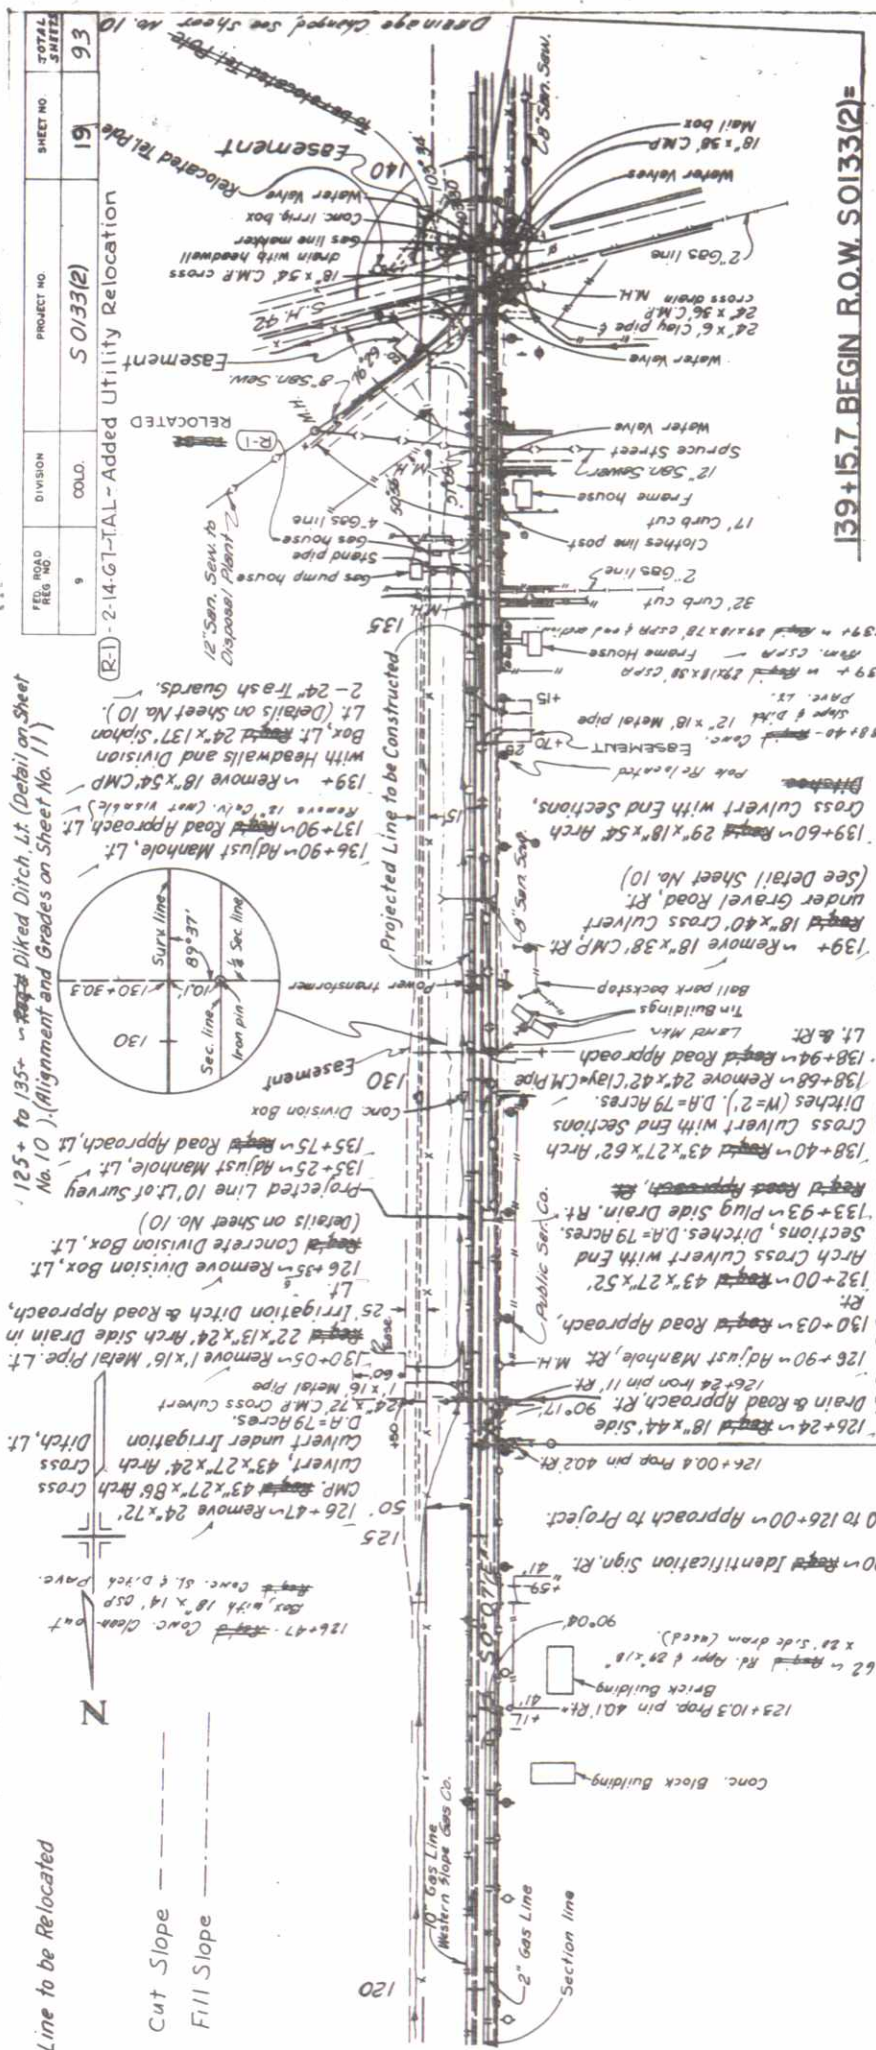



NE 1/4 Sec. 8
T.15. R.69W

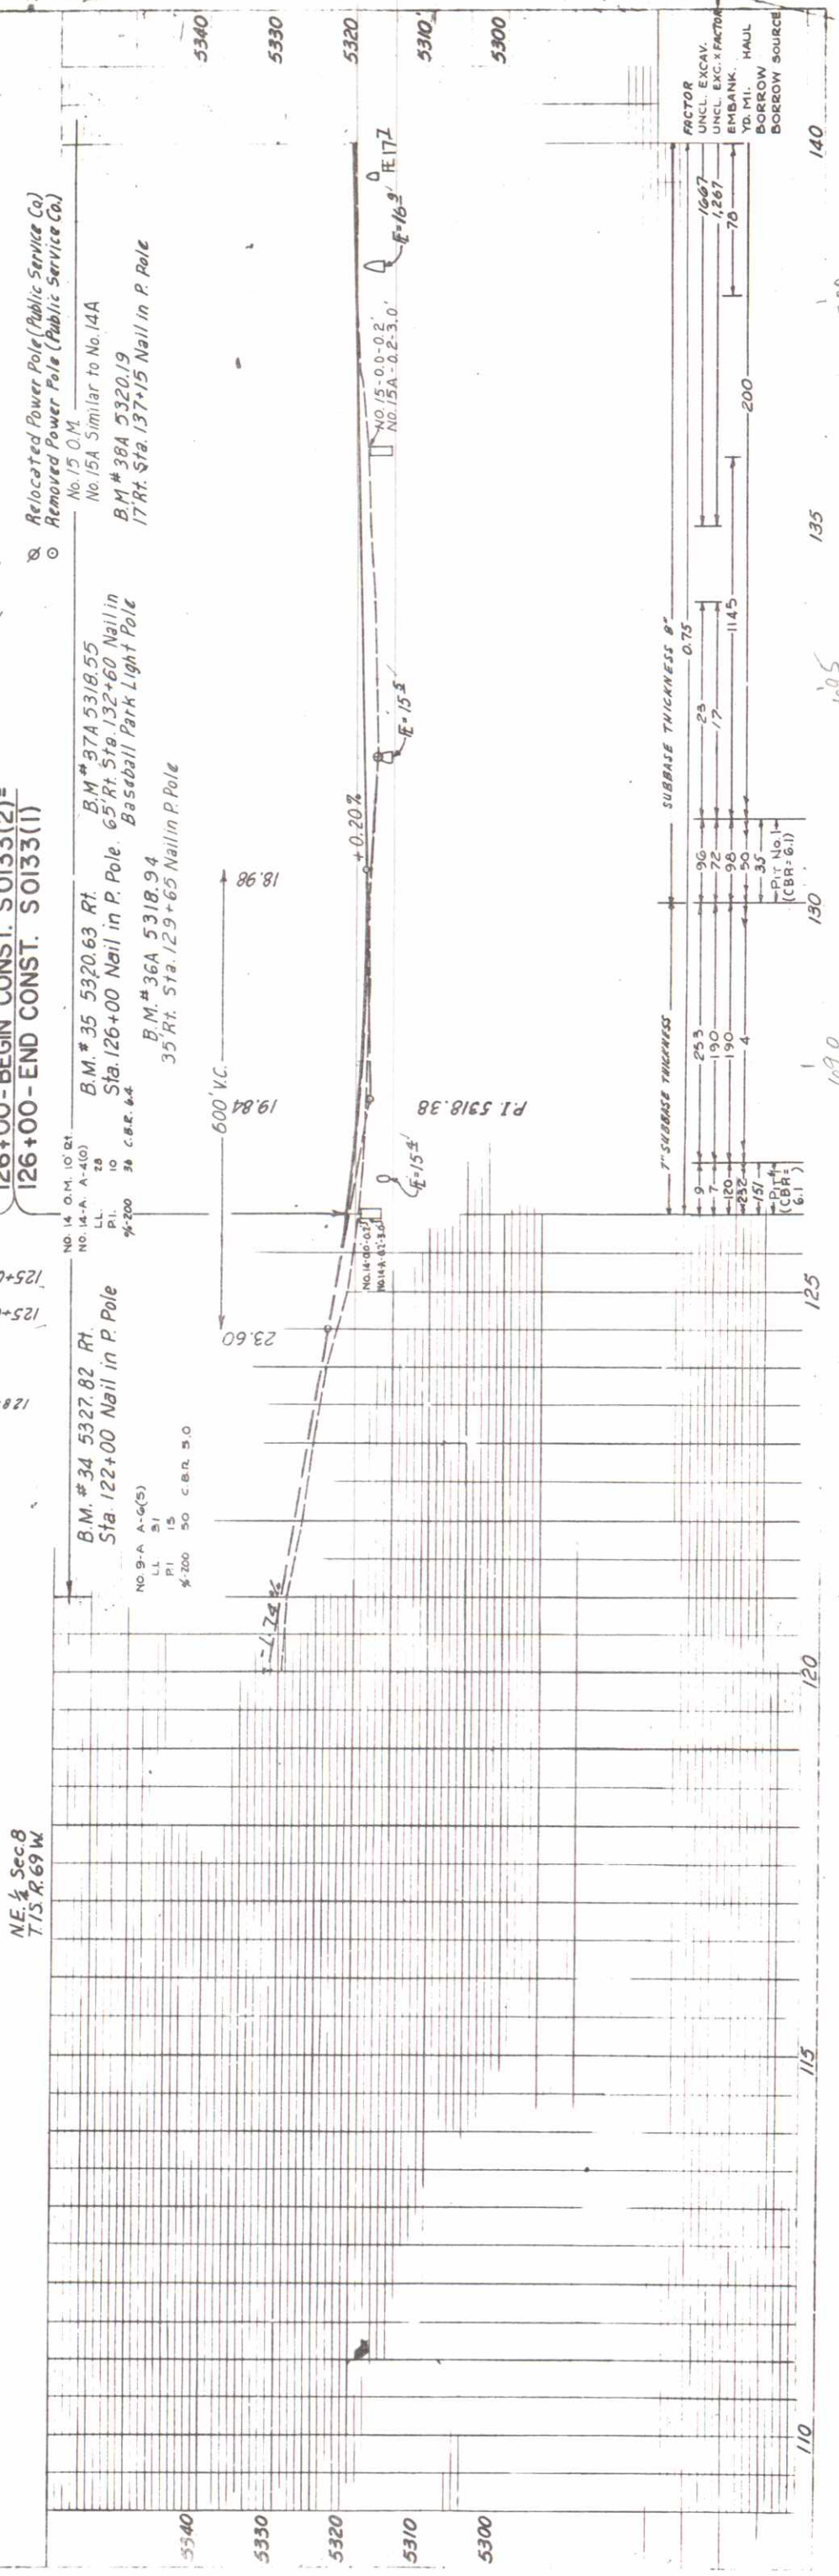

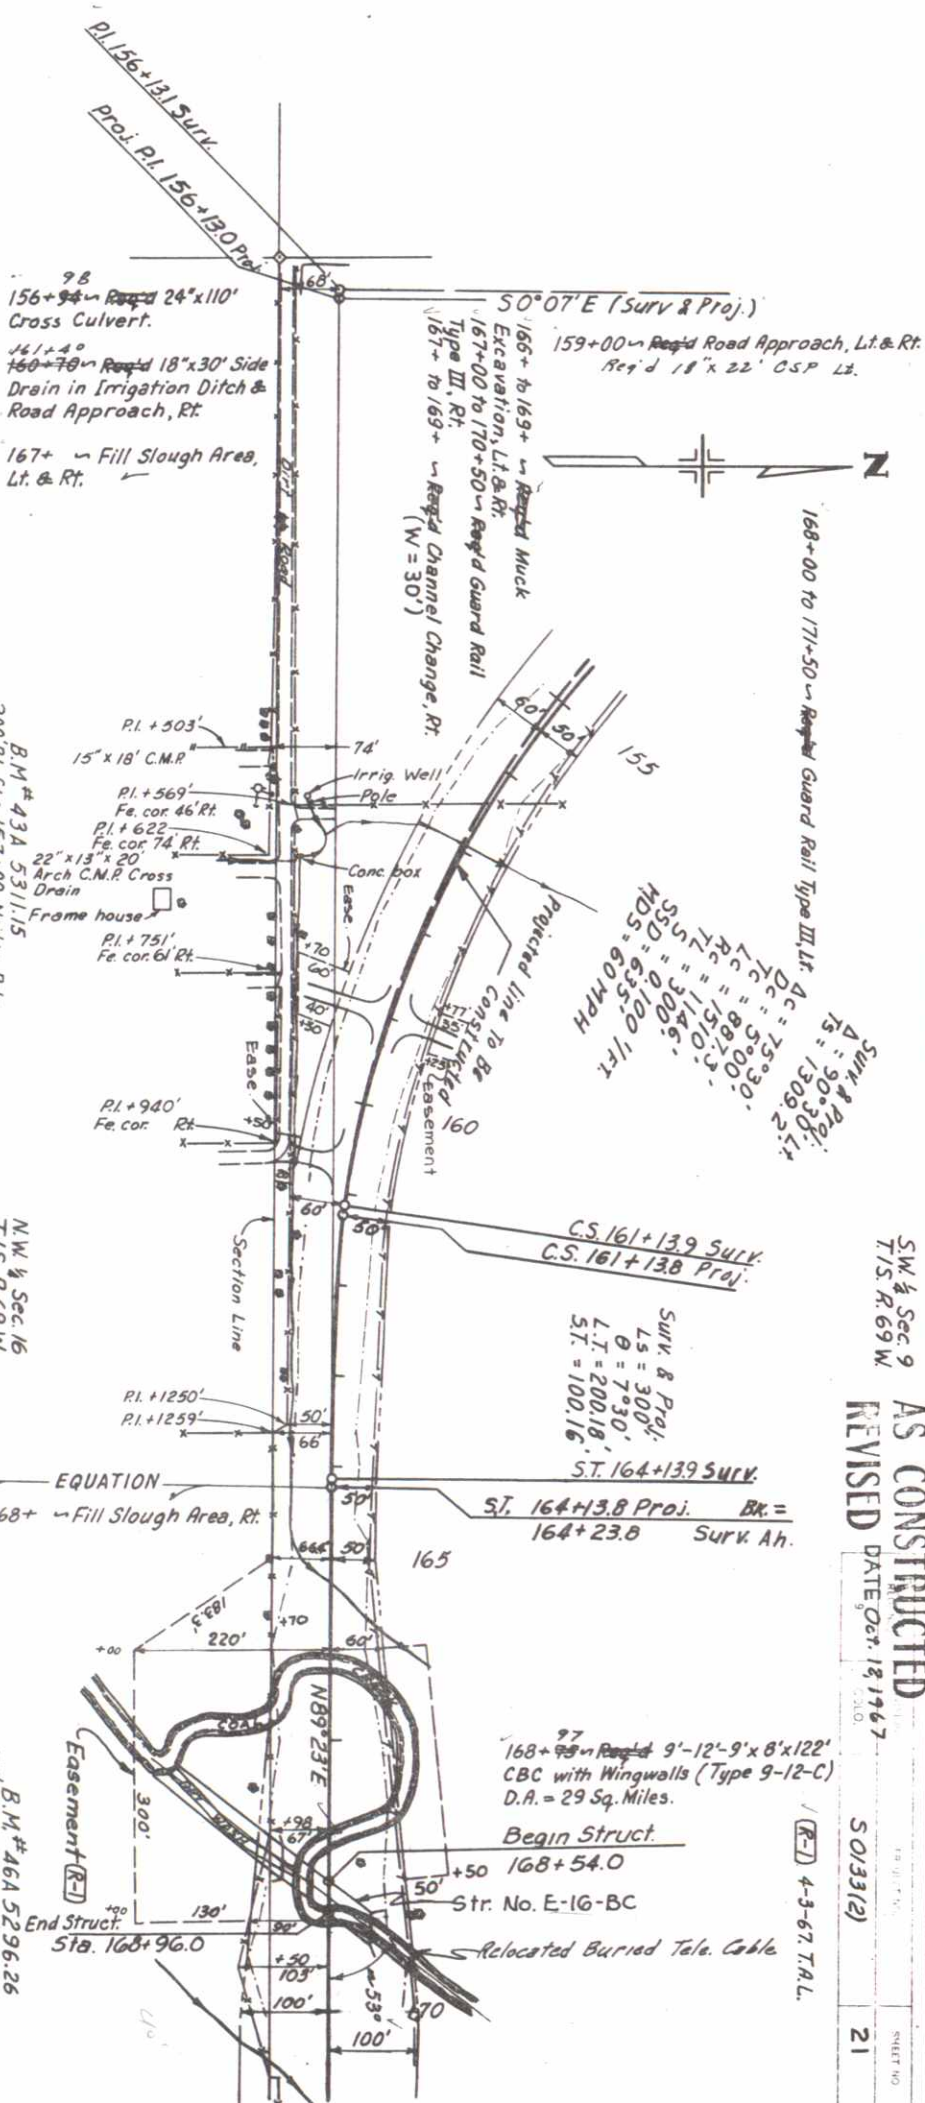

S.W. & Sec. 9 T. 15. R. 69 W.		AS CONSTRUCTED		SHEET NO.		TOTAL SHEETS 93
REVISED		DATE Oct. 8, 1967		21		
REVISED		DATE		SO. 33(2)		

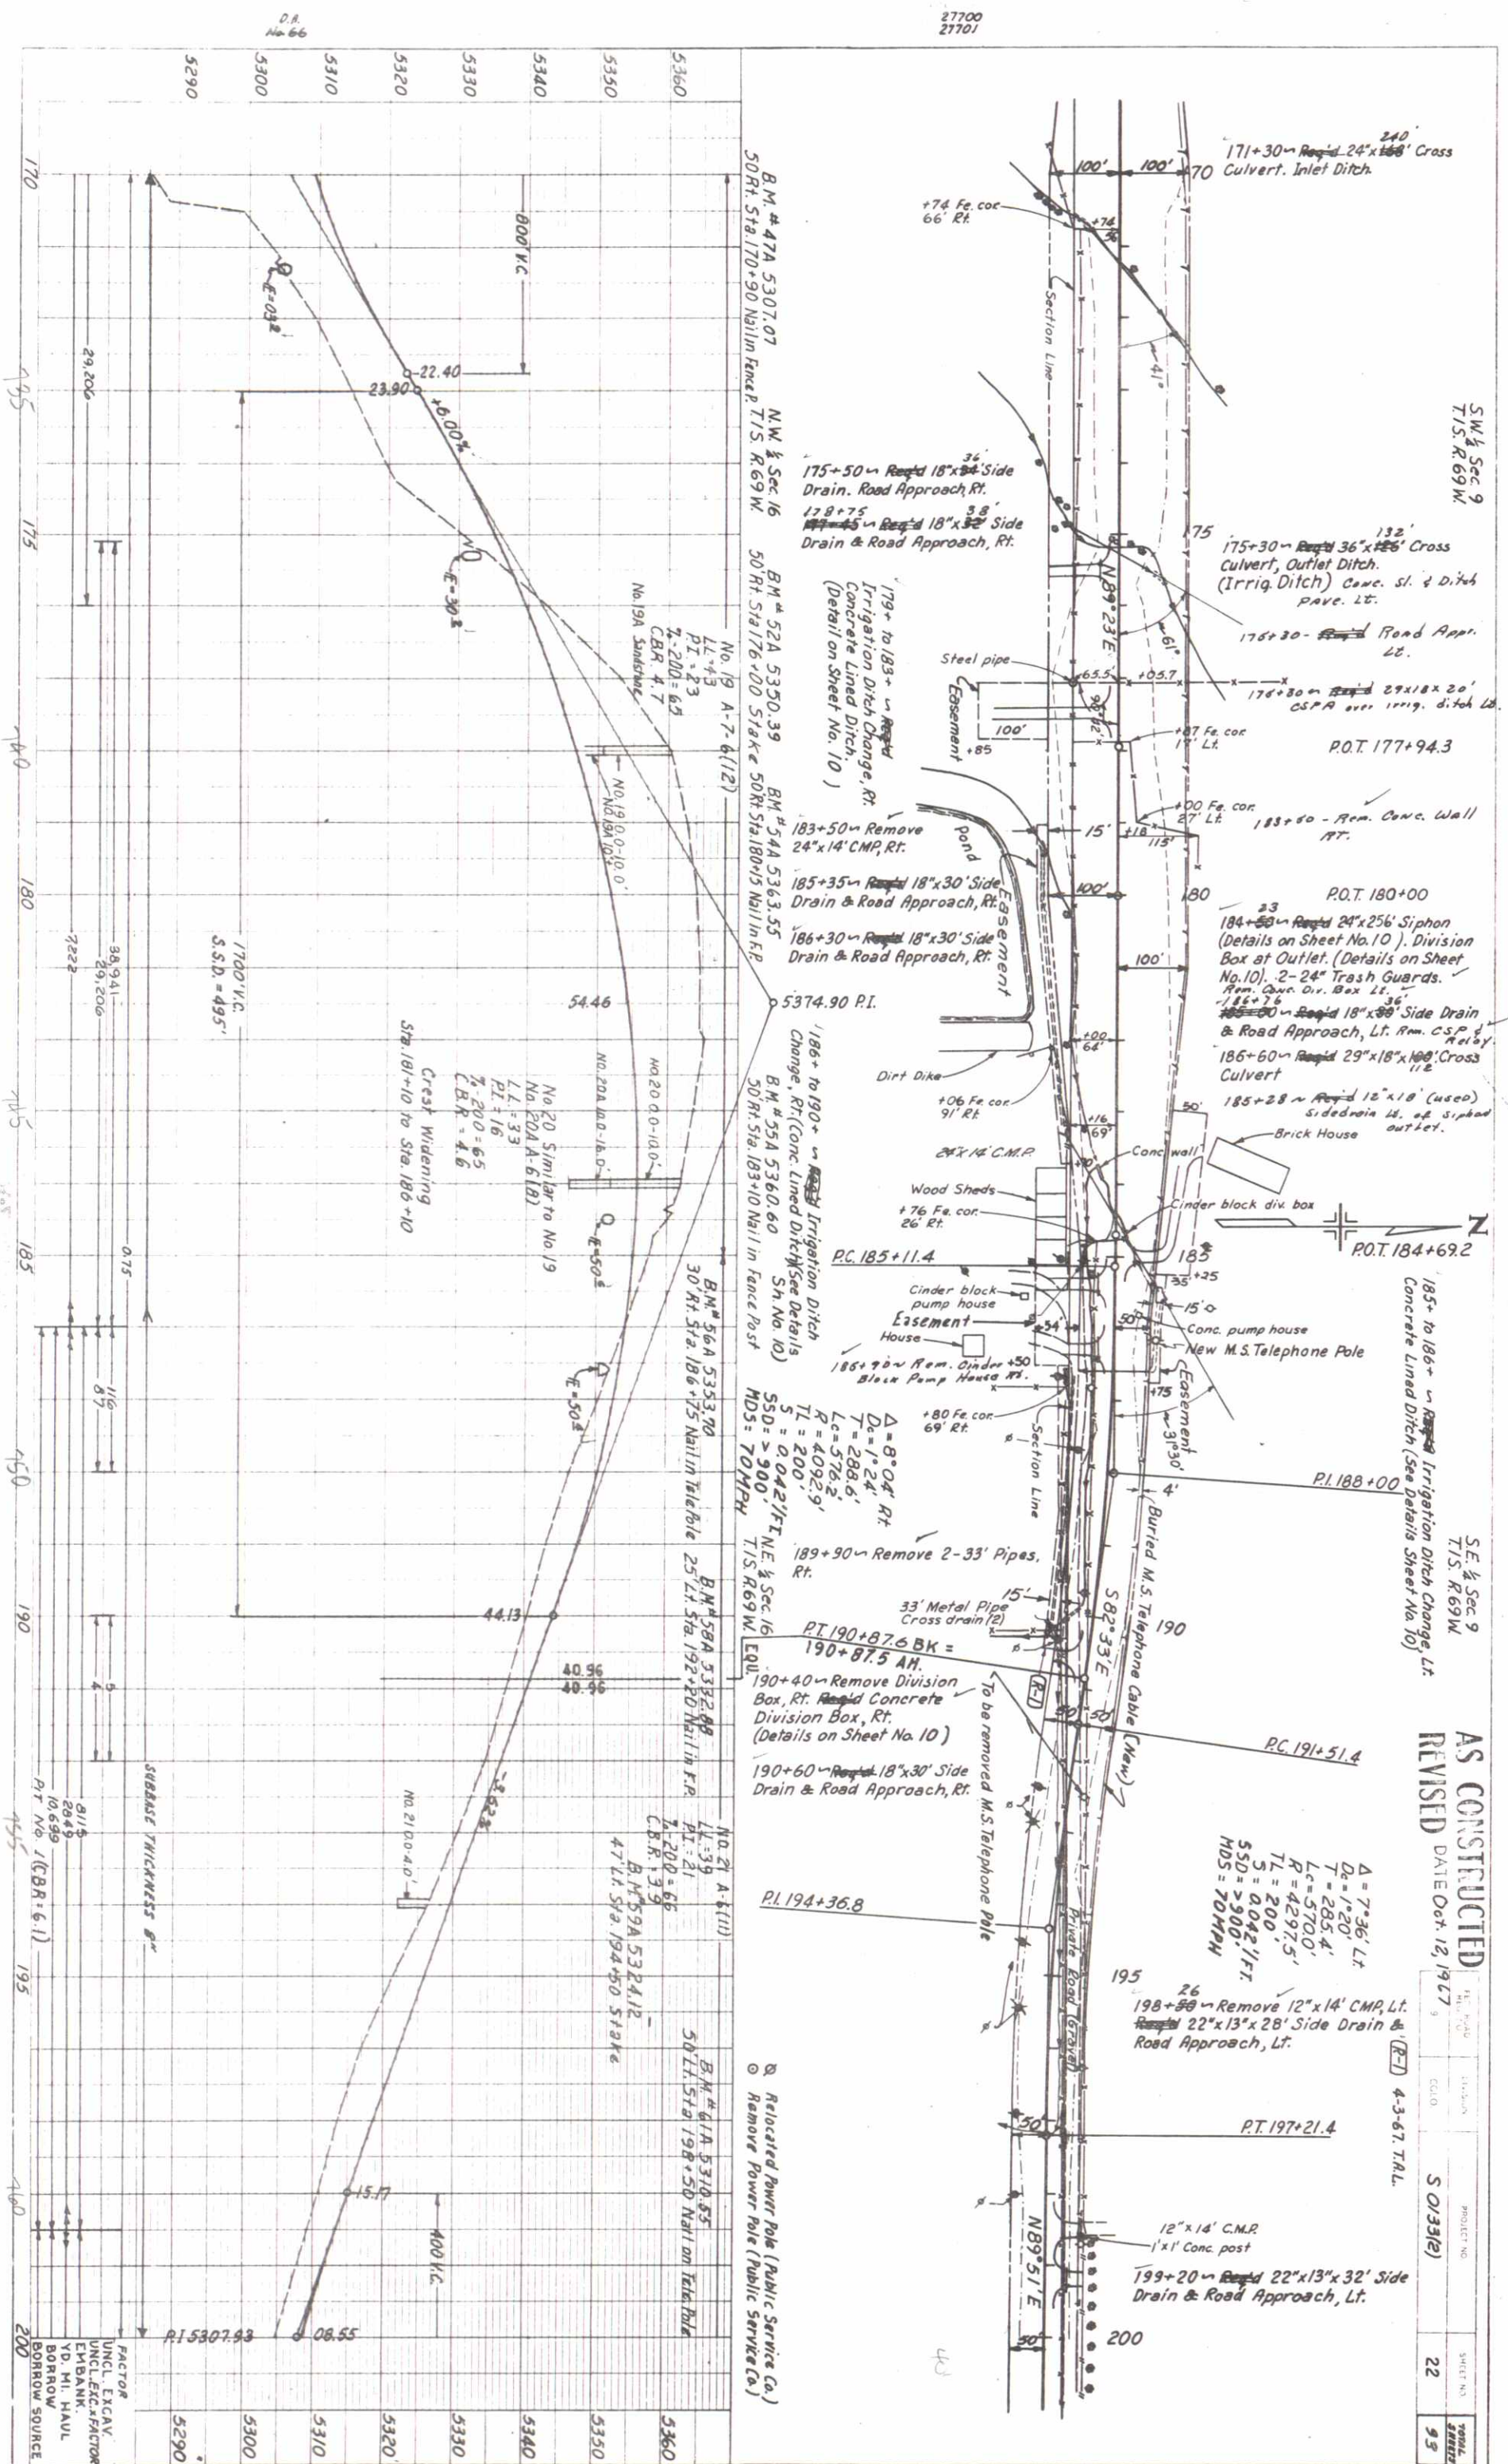

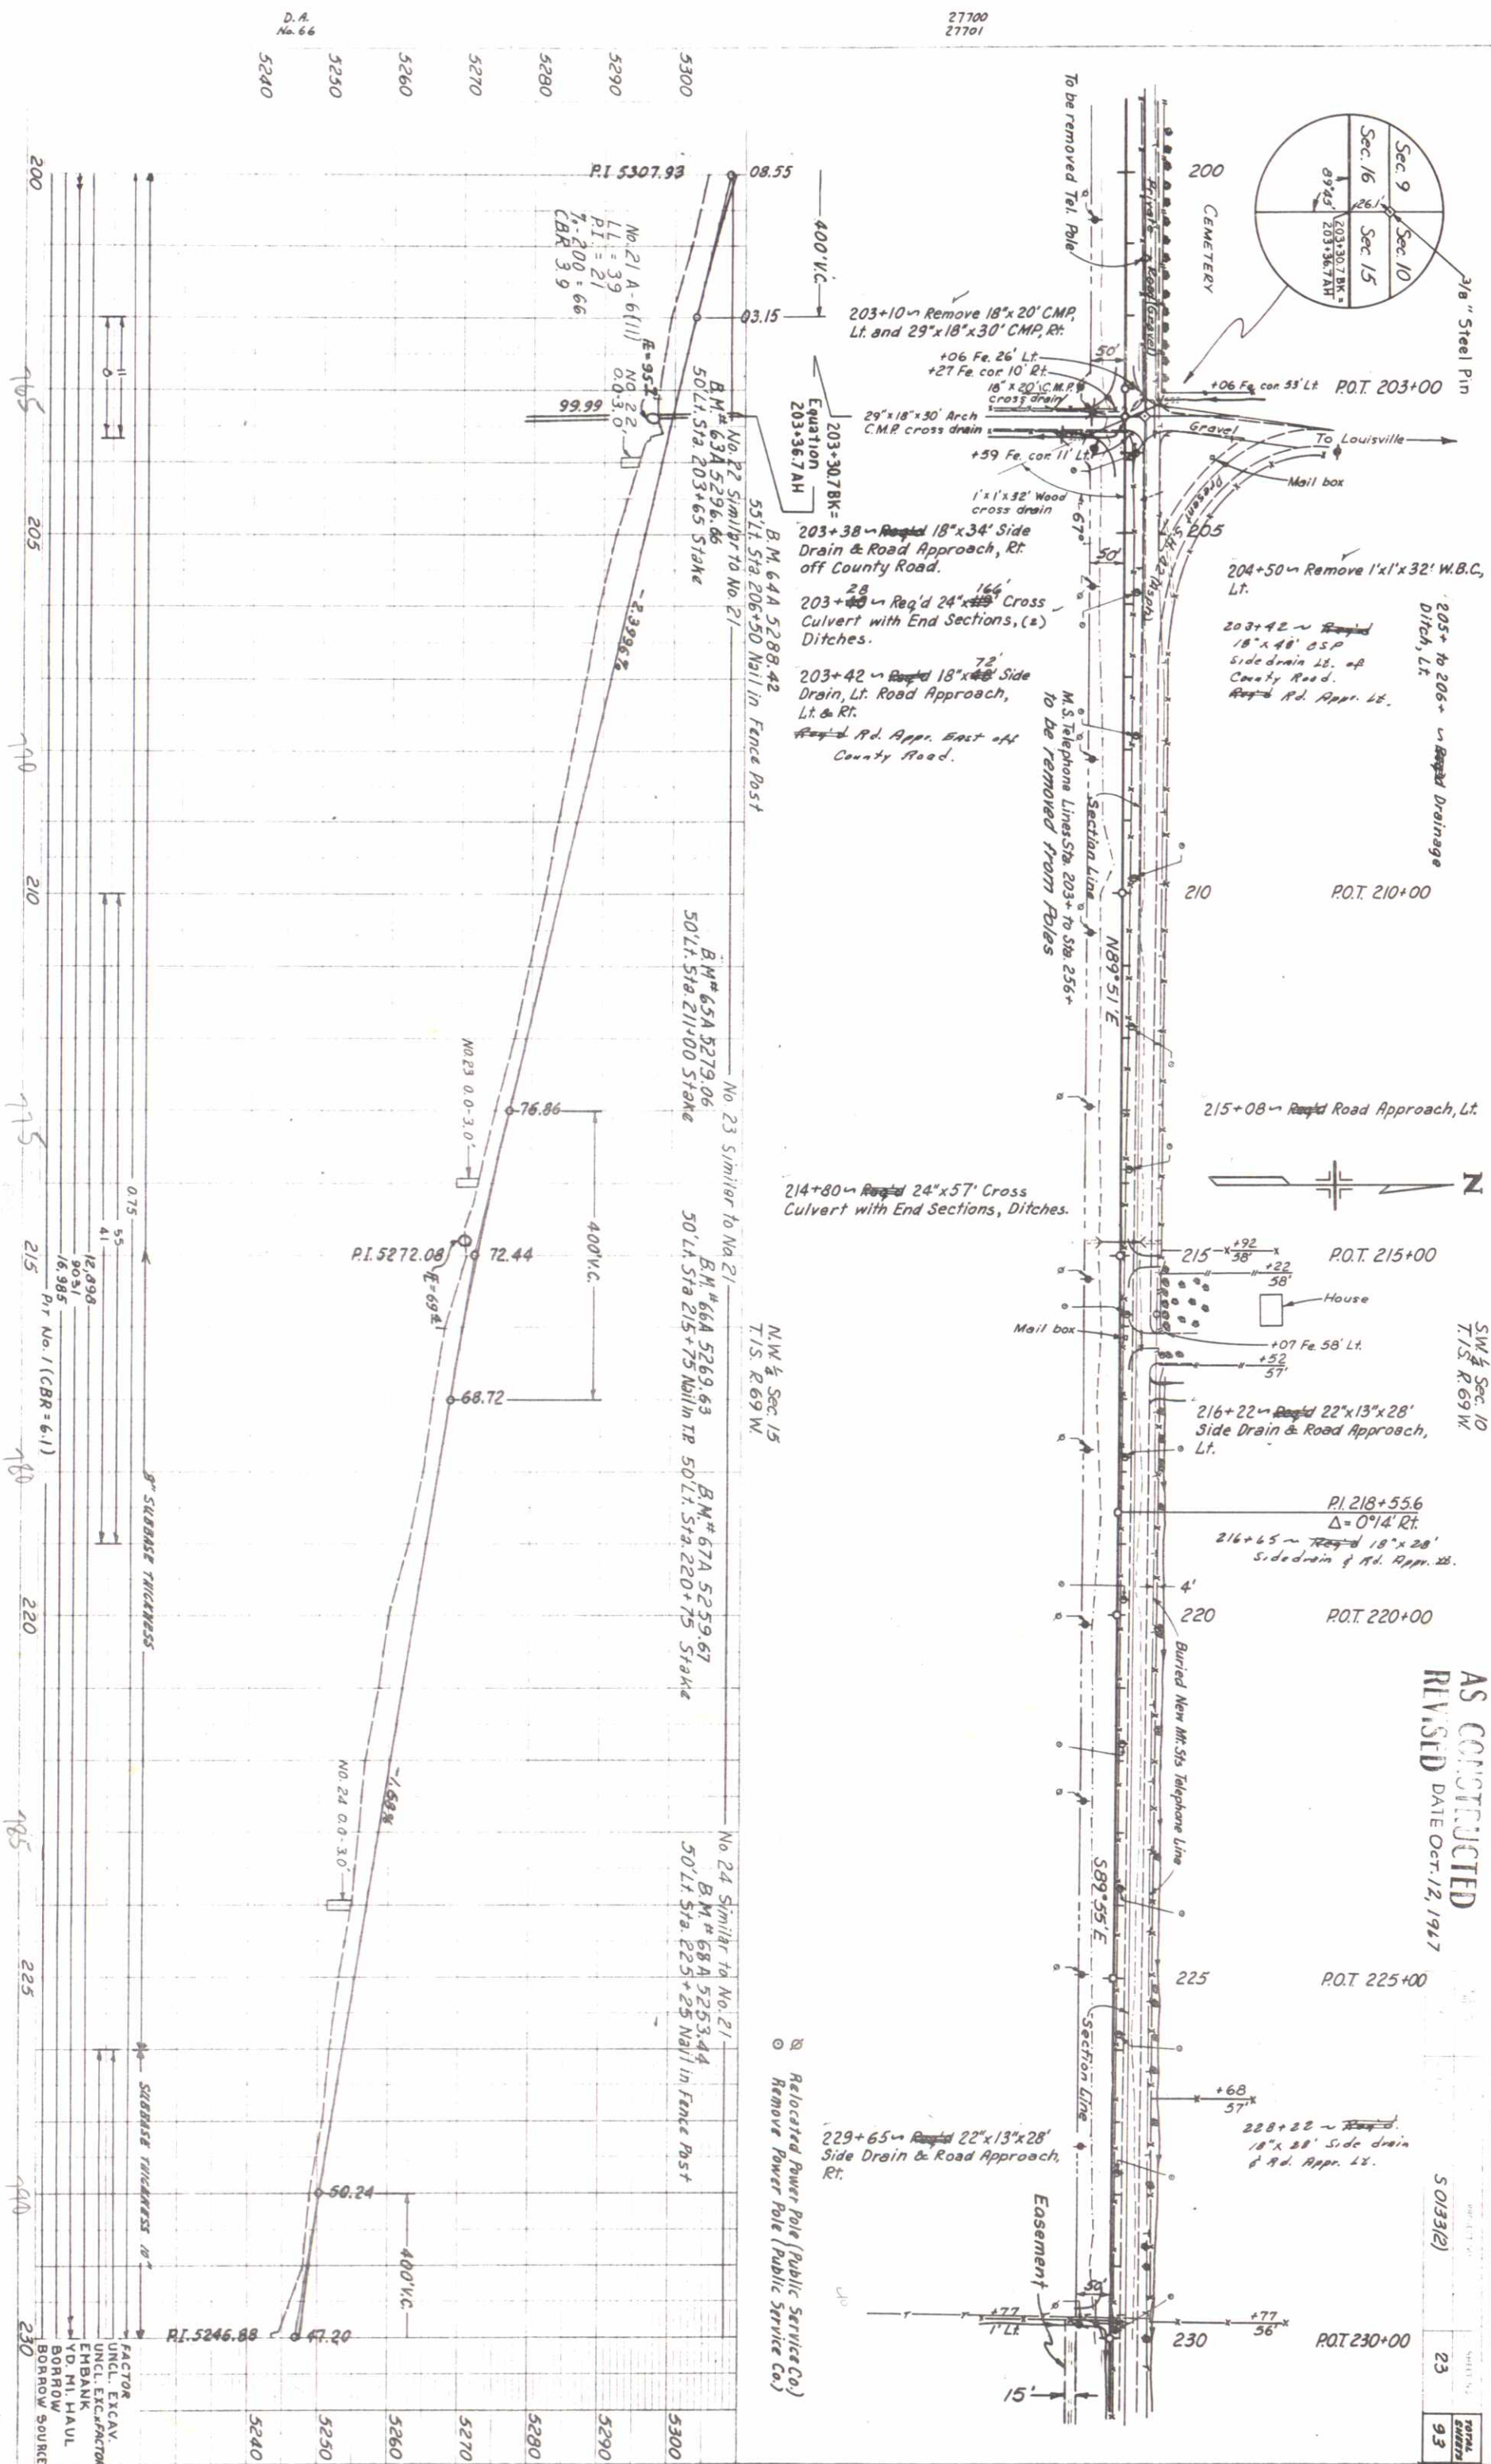

AS CONSTRUCTED
REVISED DATE Oct. 12, 1967





501333(2)

23

93

STANDARD M-203-A
(JULY 1, 1965)

FEDERAL ROAD DISTRICT NO. 9	COLORADO	PROJECT NO.	SHEET NO.
--------------------------------	----------	-------------	-----------

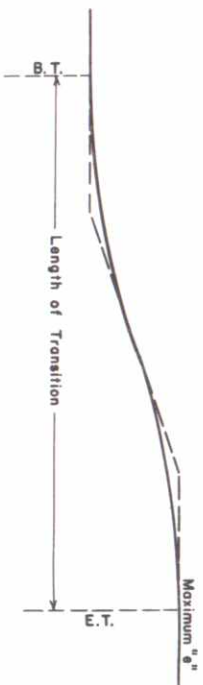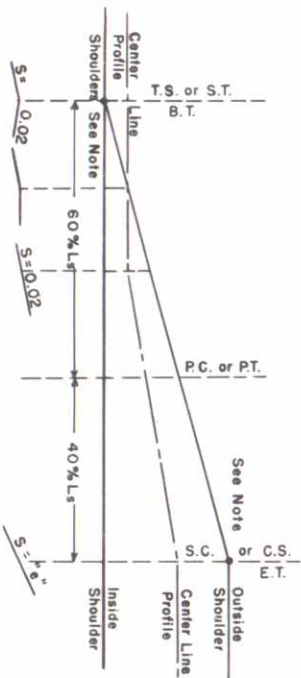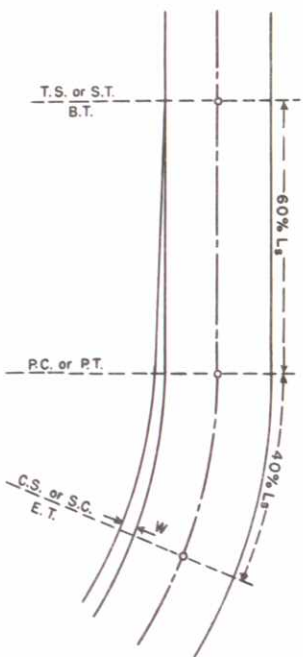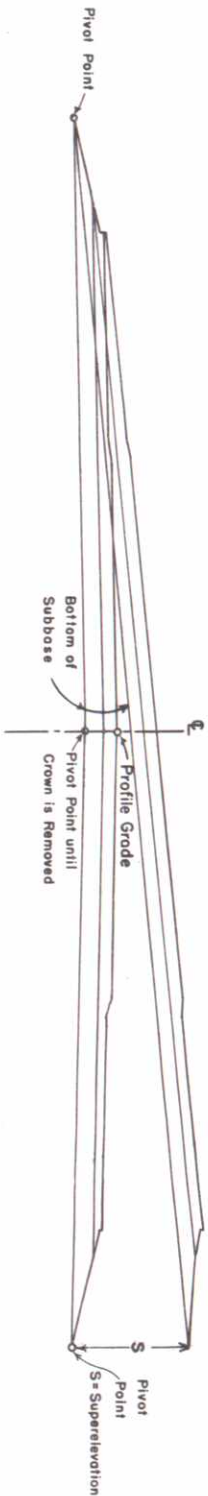

NOTE-
For obtaining smooth profiles on pavement edges, vertical curves can be inserted between the angular breaks at the beginning and the end of the superelevation transition.

Pavement Width	20 Ft.	22 Ft.	24 Ft.
Degree of Curve	0° - 3°	0° - 3°	0° - 3°
4° - 6°	2.0 Ft.	0 Ft.	0 Ft.
7° - 10°	2.5 Ft.	0 Ft.	0 Ft.
11° - 17°	3.0 Ft.	2.0 Ft.	0 Ft.
18° - 21°	3.5 Ft.	2.5 Ft.	0 Ft.
22° - Up	4.0 Ft.	3.0 Ft.	2.0 Ft.

Widening is to be on the inside edge of the pavement and the transition is to extend over the same transition length as the superelevation.

SUPERELEVATION RATES
FOR TWO LANE CROWNED SECTION
TABLE 1

Degree of Curve	Maximum Superelevation = 0.08			Maximum Superelevation = 0.10		
	Super. Rate Ft./Ft.	Maximum Design Speed M.P.H.	Minimum Transition or Spiral Length	Super. Rate Ft./Ft.	Maximum Design Speed M.P.H.	Minimum Transition or Spiral Length
0°15'	R C	70	200'	R C	70	200'
0°30'	R C	70	200'	R C	70	200'
0°45'	R C	70	200'	R C	70	200'
1°00'	.028	70	200'	.028	70	200'
1°30'	.042	70	200'	.042	70	200'
2°00'	.056	70	200'	.055	70	200'
2°30'	.069	70	200'	.069	70	200'
3°00'	.076	70	250'	.083	70	250'
3°30'	.080	70	250'	.096	70	300'
4°	.080	65	250'	.100	65	300'
5°	.080	60	250'	.100	60	300'
6°	.080	55	250'	.100	55	250'
7°	.080	50	200'	.100	50	250'
8°	.080	45	200'	.100	45	250'
9°	.080	40	200'	.100	45	250'
10°	.080	40	200'	.100	45	250'
11°	.080	40	200'	.100	40	200'
12°	.080	35	150'	.100	40	200'
13°	.080	35	150'	.100	35	200'
14°	.080	35	150'	.100	35	200'
15°	.080	35	150'	.100	35	200'
16°	.080	35	150'	.100	35	200'
17°	.080	30	150'	.100	30	200'
18°	.080	30	150'	.100	30	200'
19°	.080	30	150'	.100	30	200'
20°	.080	30	150'	.100	30	200'
21°	.080	30	150'	.100	30	200'
22°	.080	30	150'	.100	30	200'
23°	.080	30	150'	.100	30	200'
24°	.080	30	150'	.100	30	200'
25°	.080	30	150'	.100	30	200'

NOTES-Plains Areas use 0.10 Maximum Superelevation Rate.
Mountainous Areas & areas where icing conditions frequently exist, use 0.08 Maximum Superelevation Rate.

SUPERELEVATION RATES
FOR SPECIAL CASES
TABLE 2

Degree of Curve	30 M.P.H.		35 M.P.H.		40 M.P.H.		45 M.P.H.		50 M.P.H.		55 M.P.H.		60 M.P.H.		Degree of Curve
	Required Superelevation Rate Ft./Ft.	Minimum Length of Transition or Spiral	Required Superelevation Rate Ft./Ft.	Minimum Length of Transition or Spiral	Required Superelevation Rate Ft./Ft.	Minimum Length of Transition or Spiral	Required Superelevation Rate Ft./Ft.	Minimum Length of Transition or Spiral	Required Superelevation Rate Ft./Ft.	Minimum Length of Transition or Spiral	Required Superelevation Rate Ft./Ft.	Minimum Length of Transition or Spiral	Required Superelevation Rate Ft./Ft.	Minimum Length of Transition or Spiral	
0°15'	N C	0	N C	0	N C	0	N C	0	N C	0	N C	0	N C	0	0°15'
0°30'	N C	0	N C	0	N C	0	N C	0	N C	0	N C	0	N C	0	0°30'
0°45'	N C	0	N C	0	N C	0	N C	0	N C	0	N C	0	N C	0	0°45'
1°00'	N C	0	N C	0	N C	0	N C	0	N C	0	N C	0	N C	0	1°00'
1°30'	R C	100'	R C	100'	R C	150'	R C	150'	R C	150'	R C	150'	R C	150'	1°30'
2°00'	R C	100'	R C	100'	R C	150'	R C	150'	R C	150'	R C	150'	R C	150'	2°00'
2°30'	R C	100'	R C	100'	R C	150'	R C	150'	R C	150'	R C	150'	R C	150'	2°30'
3°00'	R C	100'	R C	100'	R C	150'	R C	150'	R C	150'	R C	150'	R C	150'	3°00'
3°30'	.026	100'	.027	100'	.033	150'	.040	150'	.048	150'	.053	150'	.064	200'	3°30'
4°	.029	100'	.030	100'	.037	150'	.044	150'	.053	150'	.062	150'	.072	200'	4°
5°	.035	100'	.038	100'	.044	150'	.053	150'	.062	150'	.071	150'	.076	200'	5°
6°	.041	100'	.044	100'	.050	150'	.060	150'	.069	150'	.080	150'	.080	200'	6°
7°	.045	100'	.050	100'	.056	150'	.066	150'	.074	150'	.088	150'	.097	250'	7°
8°	.050	100'	.055	100'	.061	150'	.071	150'	.078	150'	.097	150'	.100	250'	8°
9°	.054	100'	.061	100'	.065	150'	.074	150'	.080	150'	.097	150'	.100	250'	9°
10°	.058	150'	.065	150'	.069	150'	.077	150'	.080	150'	.097	150'	.100	250'	10°
11°	.061	150'	.070	150'	.072	150'	.079	150'	.079	150'	.097	150'	.100	250'	11°
12°	.065	150'	.074	150'	.075	150'	.083	150'	.083	150'	.097	150'	.100	250'	12°
13°	.067	150'	.078	150'	.077	150'	.089	150'	.089	150'	.097	150'	.100	250'	13°
14°	.070	150'	.082	150'	.078	150'	.095	150'	.095	150'	.097	150'	.100	250'	14°
15°	.072	150'	.085	150'	.079	150'	.097	150'	.097	150'	.097	150'	.100	250'	15°
16°	.074	150'	.087	150'	.080	150'	.099	150'	.099	150'	.097	150'	.100	250'	16°
17°	.076	150'	.090	150'	.082	150'	.100	150'	.100	150'	.097	150'	.100	250'	17°
18°	.077	150'	.093	150'	.083	150'	.100	150'	.100	150'	.097	150'	.100	250'	18°
19°	.078	150'	.095	150'	.085	150'	.100	150'	.100	150'	.097	150'	.100	250'	19°
20°	.079	150'	.096	150'	.086	150'	.100	150'	.100	150'	.097	150'	.100	250'	20°
21°	.080	150'	.098	150'	.089	150'	.100	150'	.100	150'	.097	150'	.100	250'	21°
22°	.080	150'	.099	150'	.090	150'	.100	150'	.100	150'	.097	150'	.100	250'	22°
23°	.080	150'	.099	150'	.090	150'	.100	150'	.100	150'	.097	150'	.100	250'	23°
24°	.080	150'	.099	150'	.090	150'	.100	150'	.100	150'	.097	150'	.100	250'	24°
25°	.080	150'	.099	150'	.090	150'	.100	150'	.100	150'	.097	150'	.100	250'	25°

Table 2 data may be used for City Streets & Interchanges.
NC=Normal Crown section.
RC=Remove adverse crown, superelevate at normal crown slope.

DEPARTMENT OF HIGHWAYS
STATE OF COLORADO
SUPERELEVATION &
WIDENING OF CURVES
CROWNED HIGHWAYS

Designed by S.B.L. Approved by
Made by S.B.L. Staff Design Engr
Checked by L.E.O. Date