# **COLORADO DEPARTMENT OF HIGHWAYS**

PLAN AND PROFILE OF PROPOSED

## FEDERAL AID PROJECT NO. S 0163(1)

STATE HIGHWAY NO. 133 GARFIELD COUNTY

RIGHT OF WAY

SCALE OF MILES


INDEX OF SHEETS I. TITLE SHEET

2. TABULATION OF PROPERTIES

RIGHT OF WAY OWNERSHIP MAP

3-6. PLAN AND PROFILE - showing R.O.W. REQUIREMENTS:

STA.593+95.2 ON W.P.S.S. 366-C

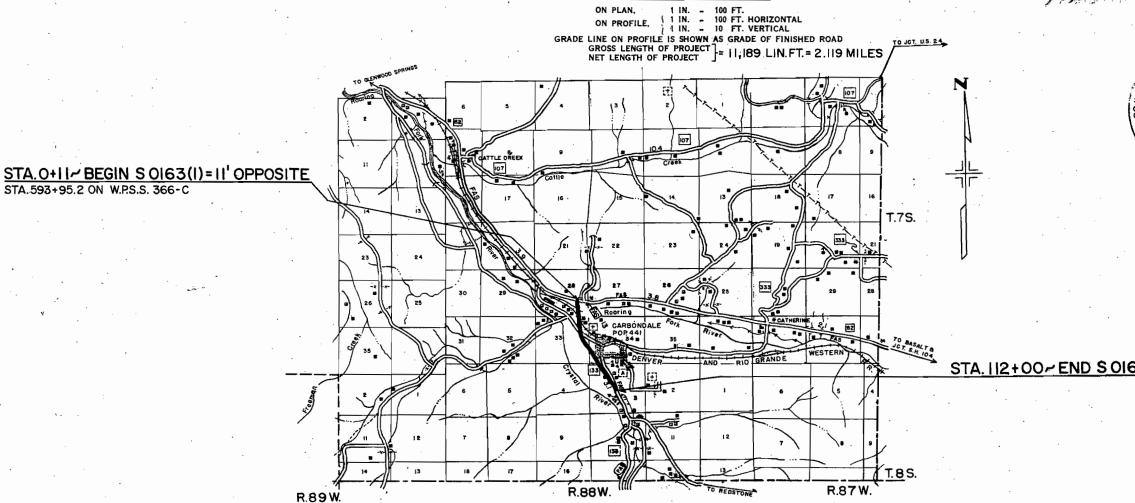

FEDERAL ROAD DISTRICT COLORADO S 0163 (1)

### RIGHT OF WAY

### CONVENTIONAL SIGNS

TOWNSHIP OR RANGE LINE  LAND LINES  SECTION LINE  I/A SECTION L  RAILROAD  TITLE SHEET		1/16 SE	
LAND LINES SECTION LINE 1/4 SECTION L		1/16 SE	
	PLAN :	SHEET	CTION LINE
BARBED WIRE FENCE		«——-·	
COMBINATION WIRE FENCE		<del>*</del> _	·
TELEPHONE & TELEGRAPH LINES O	φ.		φ
POWER LINE   ETOUR		<u> </u>	

STA. 112+00~END \$ 0163(1)

#### FENCING REQUIREMENTS

	STATION	SIDE	REMOVE FENCE		REMOVE & RESET GUARD FENCE		BUILD COMB. WIRE FENCE		DRIVEWAY GATES
			LIN. FT.	*	LIN. FT.		LIN. FT.		EACH
	5+18 C+38 TO 2+55 89+00 TO 102+00	LT. LT. LT.	85 652 1,300						,
	10 1+50 TO 102+20 0+111 0+38 12+40 22+85	LT. X X X X	360 60 230		75				
	24+35 22+20 49+35 53+85	x x x	235 35 175 345						
	54+25 69+65 84+40 35+00	x x x x x	350 205 170 170		· .				
	93+3C 5+12 TO 22+2C 24+37 TO 32+0C 1+75 TO 2+90	X G RT,	710 1,702 763 410						
•	32+00 TO 39+90 102+00 TO 112+00 BK+ 0+38 TO 2+90 5+40 TO 5+70	RT. RT. LT.	790 1, <b>0</b> 00				<b>. 48</b> 0 85		
	5+70 10 6+70 6+70 10 23+90 25+30 10 54+50 54+95 10 83+90	LT. LT. LT.			,		110 1,720 2,950 3,005		
•	89+00 TO 112+CO C+55 TO 2+9C 5+UC TO 5+7C 5+7C TO 6+7C	LT. RT, RT.					2,300 510 85 110		
	6+70 TO 21+80 23+35 TO 53+15 53+55 TO 84+90 85+60 TO 112+00 BK.	RT, RT, RT,					1,510 - 3,040 3,105 2,640		
	12+50 20+3550 2 <b>7+3</b> 0 UZACG 48763	LT.							, i
	58+00	LT. LT. LT.					:		1 1 1
- 1	₩101440	LT,							1
	12+50 20+75 \$ %	RT,				. ,			1
•	47+00	RT.						1	'
	1+00 1+05 12+00 16+00 20-00 30+19	RT, RT, RT, LT. & RT. LT. LT. & RT. RT. LT. & RT.							2 1 2 2 2 2 2 2 2 2 2 2 2 2 2 2 2 2 2 2
•	65+00 × 82+00 × 102+50 ×	LT. & RT. LT. & RT. LT.							2 2 I
	TOTALS		9,250	}	75	,	. 1, 710°		ر 27

#### TIMBER GUARD POSTS

NOVTATE	SIDE	SPACING	NO
1+05 10 1+39	LT.	20° FILL	2
1+05 1+50 1+50 7 2+00	LT. & RT.	20' FILL	
2+39 17 3+03+0	LT. & RT.	BRIDGE	12
5+20.5 TO 5+84.5	LT. & RT.	BRIDGE	12
5+20.5 10 5+64.5		CULVERT	
22+9C	LT. & RT.	CULVERT	
24+2C	LI. & KI.	COLVERT	'
39+34	LT. & RT.	CULVERT	
42+75	LT. & RT.	CULVERT	
45+1C	LT. & RT.	CULVERT	2
u7+58	LT. & RT.	CULVERT	,
ц9+62	LT. & RT.	CULVERT	2
52+40	LT. & RT.	CULVERT	2
53+80	LT. & RT.	CULVERT .	
55+CC TO 57+73	RT,	I° CURVE	
56+91	LT.	CULVERT	NO.  2 3 12 2 2 2 2 2 2 2 2 2 2 2 2 2 2 2 2 2
6C+4B	LT. & RT.	CULVERT	7
65+0C	LT. & RT.	CULVERT	
66+85	LT, & RT,	CULVERT	7
€7+C0	LT. & RT.	CULVERT	;
75+6C	LT. & RT.	CULVERT	
77+00	RT,	CULVERT	
75+67 TO E2+11	LT.	5° CURVE	•
96+6C	LT, & RT.	CULVÉRT	2
TOTAL			7

### R.O. W. MARKERS

STATION	SIDE	NO.
2+00	RT,	. 1
15+00 31+78-1	LT. & R.T.	2 .
43+00	LT.	i i
56+CC 66+75+C	RT., LT. & RT.	2
76+7C	LT. & RT.	2
77+64.7 89+41.4	LT. & RT. LT. & RT.	2 2 2
106+57-6	LT. & RT.	2 2
108+75-9	LT. & RT.	5
TOTAL		18 ×

TOTAL SHEETS FEDERAL ROAD REGION NO. DIVISION 9 COLORADO 5 0163(1)

• REV. NOV. 15, 1957 0 R.L.M.

### SURFACING AND SUBBASE MATERIAL PLANS

IT IS ESTIMATED THAT SURFACING AND SUB-BASE MATERIAL FOR THE PROJECT IS AVAILABLE IN THE VICINITY OF THE PIT INDICATED IN THE FOLLOWING TABULATIONS. ESTIMATED QUANTITIES INVOLVED IN THESE OPERATIONS ARE SHOWN

ALTERATION OF THE PLANS, AS HERE OUTLINED WILL BE ALLOWED ONLY ON WRITTEN PERMISSION FROM THE DEPARTMENT

#### SURFACING

	SOURCE	GRADIN	G C TONS	TON MILE OVERHAUL		
MATERIAL TO BE PLACED	AVAILABLE & "R" VALUE	TOP COURSE	BASE COURSE	TOP	BASE COURSE	
1+CC TO 3+03.C -BRIDGE- 5+20.4 TO 7+CO.C 7+CO.C TO 111+19.3	PIT NO. 2 (GIANINETTI) 50.CQC CU. YDS.	69 61 3.604	143 126 7,420	6 3,857	23 [[ 7,940	
ESTIMATED FOR:  APPR. G+11 TO 1+CC  APPR'S., 54+C(2),  68+CC & 65+4D	HAUL DISTANCE = 350 FT. FROM	. 55 225	0 ic7	і і 283	21	
MINOR ROAD APPROACHES	STA. 7+00  "R" = [2]  BASE COURSE ONLY		613		694	
TOTALS		4,014 2	8.849	4,169	9,242	

- INCLUDES APPROACH TO PROJECT.
   Ø FROM LIST OF STRUCTURES

	SOURCE		QUANTITY	OVERHAU
MATERIAL TO BE PLACED	AVAILABLE &	THICKNESS	CLASS I	
TATEMAL TO BE TENGED	"R"	"T"△	7015	TON
	VALUE		TONS	MILES
1+00 TO 3+03+0	PIT NO. 2	u~	155	35
-BRIDGE-	(GIANINETTI)	"	155	25
5+2C.4 TO 7+CC.C	50,000	4-	137	i2
7+CC TO 111+19.3 *	CU. YDS.	E.	8.C56	8,621
ESTIMATED FOR:	HAUL DISTANCE	'		
APPR., 0+11 TO 1+00	= 350 FT.FRCM	<sub>4"</sub>	iΪε	22
	STA. 7+00	1		
IRREGULARITIES		]. [	846	870
	"R" = 83 /			
		[		
TOTALS	<del> </del>		9,310 >	9,550

- △ DESIGN CURVE NOT APPLICABLE (LEVELING COURSE)
   INCLUDES APPROACH TO PROJECT.

AC PROPERTY OF THE PROPERTY NAMED IN THE PROPERTY OF THE PROPE

R.O.W. TABULATION OF PROPERTIES IN


GARFIELD


COUNTY S. H. No.133 PROJ. S 0163(1)


Rev. 10-10-57 (S.H. No.) DWS Rev. 11-21-57 (L. Rev.) B.R. M. Rev. 6-17-58 cdd E-1 Jr., S Rev. 1-14-59 (14 Rev.) DWB. Rev. 9-11-75 Pev. Par. 7 & 9 J.B.


RIGHT OF WAY

				rakiri dialah karinga agamatan sayang masa ayay pada sa sasasan masa ana sagar masa aya			· ;	RIGHT OF WAY	Omersialista suusukkassa kasta ja
PARCEL	OWNER	ADDRESS	LOCATION	AREA IN A				REMARKS	N
NO.	OWITCH	MUDICESS	LOCATION	PARCEL	TO BE ACQUIRED			REMARKS	N
		- :	T. 75, R.88W., 6th P.M.						,
iRev	John L. Heuschkel	Carbondale, Colorado.	Lots 8 & 9, Sec. 28.	1.399	1.399				
2	Ben Glaninetti & Alphonsine Glaninetti		Lots 16 & 17, Sec. 28.	3.286	3.286				
3	Katherine L. Gowen		Lot 17, Sec. 28	1.038	1.038 -				
4	Ben Gianinetti & Alphonsine Gianinetti		Lots I & 2, Sec. 33	1.459	1.459				
5	Rocky Mountain Schools		Lots 1,2 8 7, Sec. 33	2.126	2.126			·	
6	A.E.Kinsall & Sophie Kinsall		Lots 8,9 & 16, Sec. 33	a.679	6.357			<del></del>	
7 Rav.	Elmer O. Bair & Ida L. Bair		Lot 16, Sec. 33.	1.338	1.338				
8	Harry E. Prott & Myrna Raye Pratt		Lot 13, Sec. 34	0.014	0.014				
9 Rev.	Elmer O. Bair & Ida L. Bair		Lot 13, Sec. 34	7,160	7.160		·		
10	Arthur C. Hackbarth & Marie K. Hackbarth		Town of Carbondale Lots !! 8 !2, Block 26, Sec 34	0.011	0.011				
	Gus Darien		Lot 18, Sec. 34	0.525	0.525				
			T.85, R.88W., 6th P.M.						
12.	Elmer O. Bair & Ida L. Bair	·	Lot 4, Sec. 3	0.070	0.070				
13	Lewis R. Thompson		Lots 3, 6,8 7, Sec. 3	5.975	4.897	,			
14 Rev	Harold A. Roberts & Thelma T. Roberts		Lots 6 87, Sec. 3	3.164	3.164				14
	EASEMENTS		T. 7 S., R. 88 W., 6th P.M.						
E-R-I	Denver & Rio Grande Western Railroad		Lots 182, Sec. 33	0.782	0.782	·		EASEMENT	Ε.
	Ben Gianinetti & Alphonsine Gianinetti		Lot 16, Sec. 28	0.287	0.287			Void after Construction	E
	Ben Gianinetti & Alphonsine Gianinetti		Lot 17, Sec. 28	, 0.025	0.025			NF 10 M	ε٠
E-2-B	Ben Glaninetti & Aiphonsine Glaninetti		Lot 17, Sec. 28	0.093	0.093			н ш и	E-
	Katherine L. Cowen		Lot 17, Sec. 28	0.164	0.164			er to at	E
	Ben Gianinetti & Alphonsine Gianinetti		Lot 2, Sec. 33	0.089	0.089			д и в	E
E-4-A	Ben Gianinetti & Alphansine Gianinetti		Lot I, Sec. 33	0.154	Qi54			11 fs Et	E-
	Rocky Mountain Schaols	·	Lot I, Sec. 33	0.062	0.062			н в в	· E
E-5-A	Rocky Mountain Schools			0.120	0.120			r 4 B	
£-5-8 E-6	Rocky Mountain Schools A.E.Kinsall & Scophie Kinsall		Lot 7, Sec. 33 Lot 2, Sec. 33 Lot 8, Sec. 33	0.103 0.326	0103			ii u u	E-1 E-1 E
	A.E. Kinsall & Sophie Kinsall		Lot 8, Sec. 33	0.023	0.023				E-
E-7	Eimer O. Bair & Ida L. Bair	`	Lot 16, Sec. 33	0.036	0.036			15 to 81	E
~	Elmer O. Boir & Ida L. Bair		Lot 16, Sec. 33	0.049	0.049				E-1
E-7-B	Elmer O. Bair & Ida L. Bair		Lot 16, Sec. 33	0.047	0.047			u u w	E-
E-8	Harry E. Pratt & Myrna Raye Pratt		Lot 13, Sec. 34	0.013	0.013			• . •	E
	Elmer O. Bair & Ida L. Bair		Lot 13, Sec. 34	0.014	0.014			42 30 M.	E
E-9-A	Elmer O. Bair & Ida L. Bair		Lot 13, Sec. 34	0.044	0.044	·		и и "	E-9
	Elmer O. Bair & Ida L. Bair		Lot 13, Sec. 34	0.110	CH.0			и и :	E-
	Elmer O. Bair & Ida L. Bair		Lot 13, Sec. 34	0.013	0.013				E-4
	Elmer O. Bair & Ida L. Bair		Lot 13, Sec. 34	0.010	0.010			1 N N	E-:
	Elmer O. Bair S. Ida L. Bair		Lot 13, Sec. 34 Town of Carbondale	0.039	0.039			u 4 k	E-1
E-10	Arthur A. Hackbarth & Marie K. Hackbarth		Town of Carbondale Lats 10, 11, 812, 81ock 26, Sec. 34	0.010	0.010		_		E-
			T.8S.,R.88W., 6 th. P. M.	-					
E-13	Lewis R. Thompson		Lots 3,6 & 7, Sec. 3	0.560	0.560			4 4 4	E-
E I	John L. Heuschkel		T.75., R.88W., 6th P.M.	0.053	0.053			EDMANCENT FACTORY	
.5.7.!	JUIN L. RESCURE							ERMANENT EASEMENT	E-
		1					-		
AND ASSESSMENT OF THE PARTY OF	AND THE RESIDENCE OF THE PROPERTY OF THE PROPE	and the state of t	andrille principal region to the contract of t	STATE OF THE PARTY	and the same of th	The second secon	Charles and the second of the		

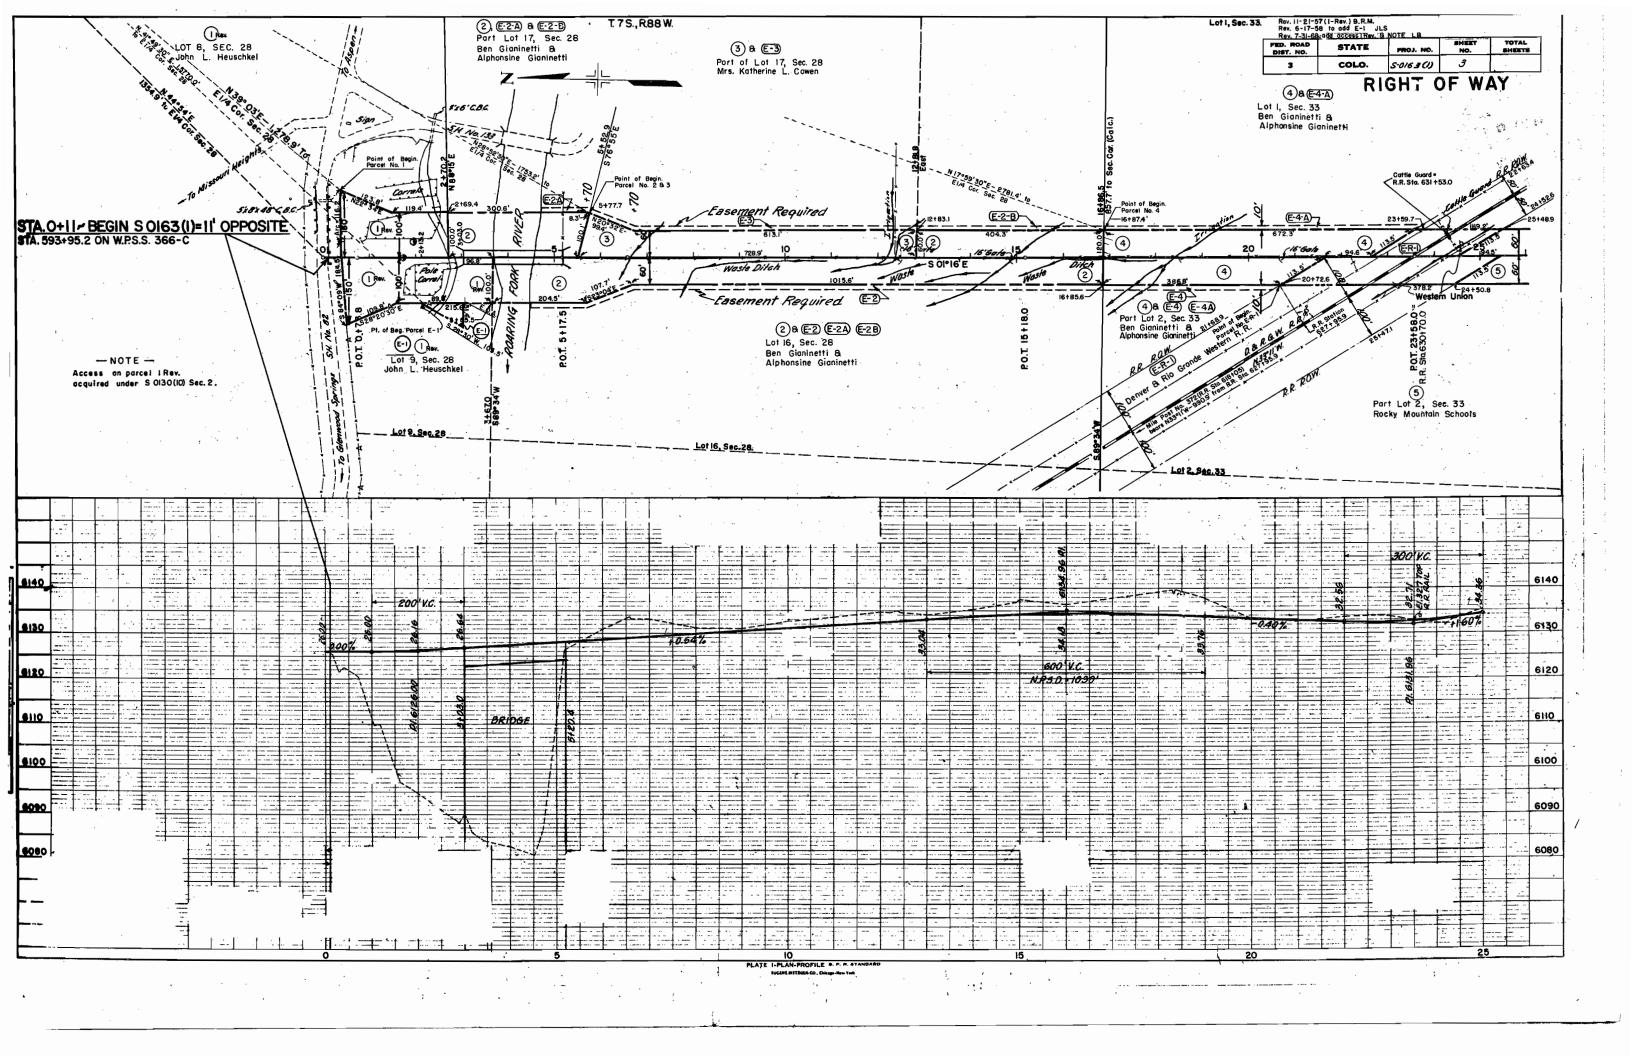

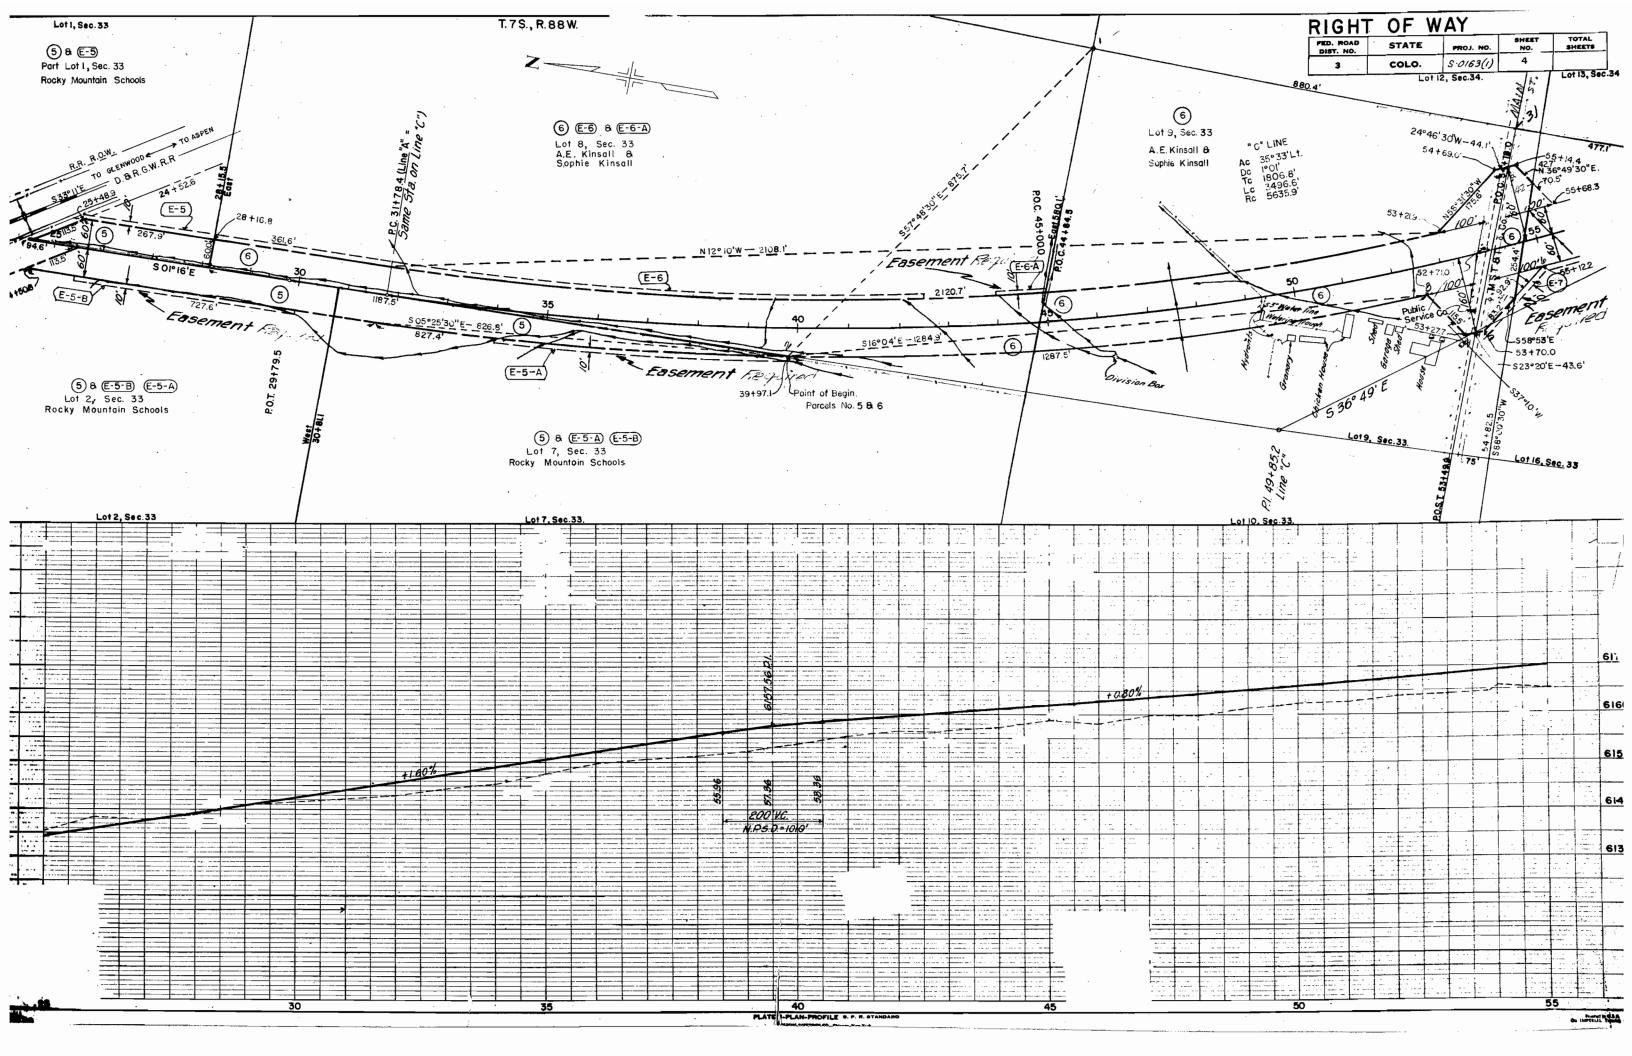

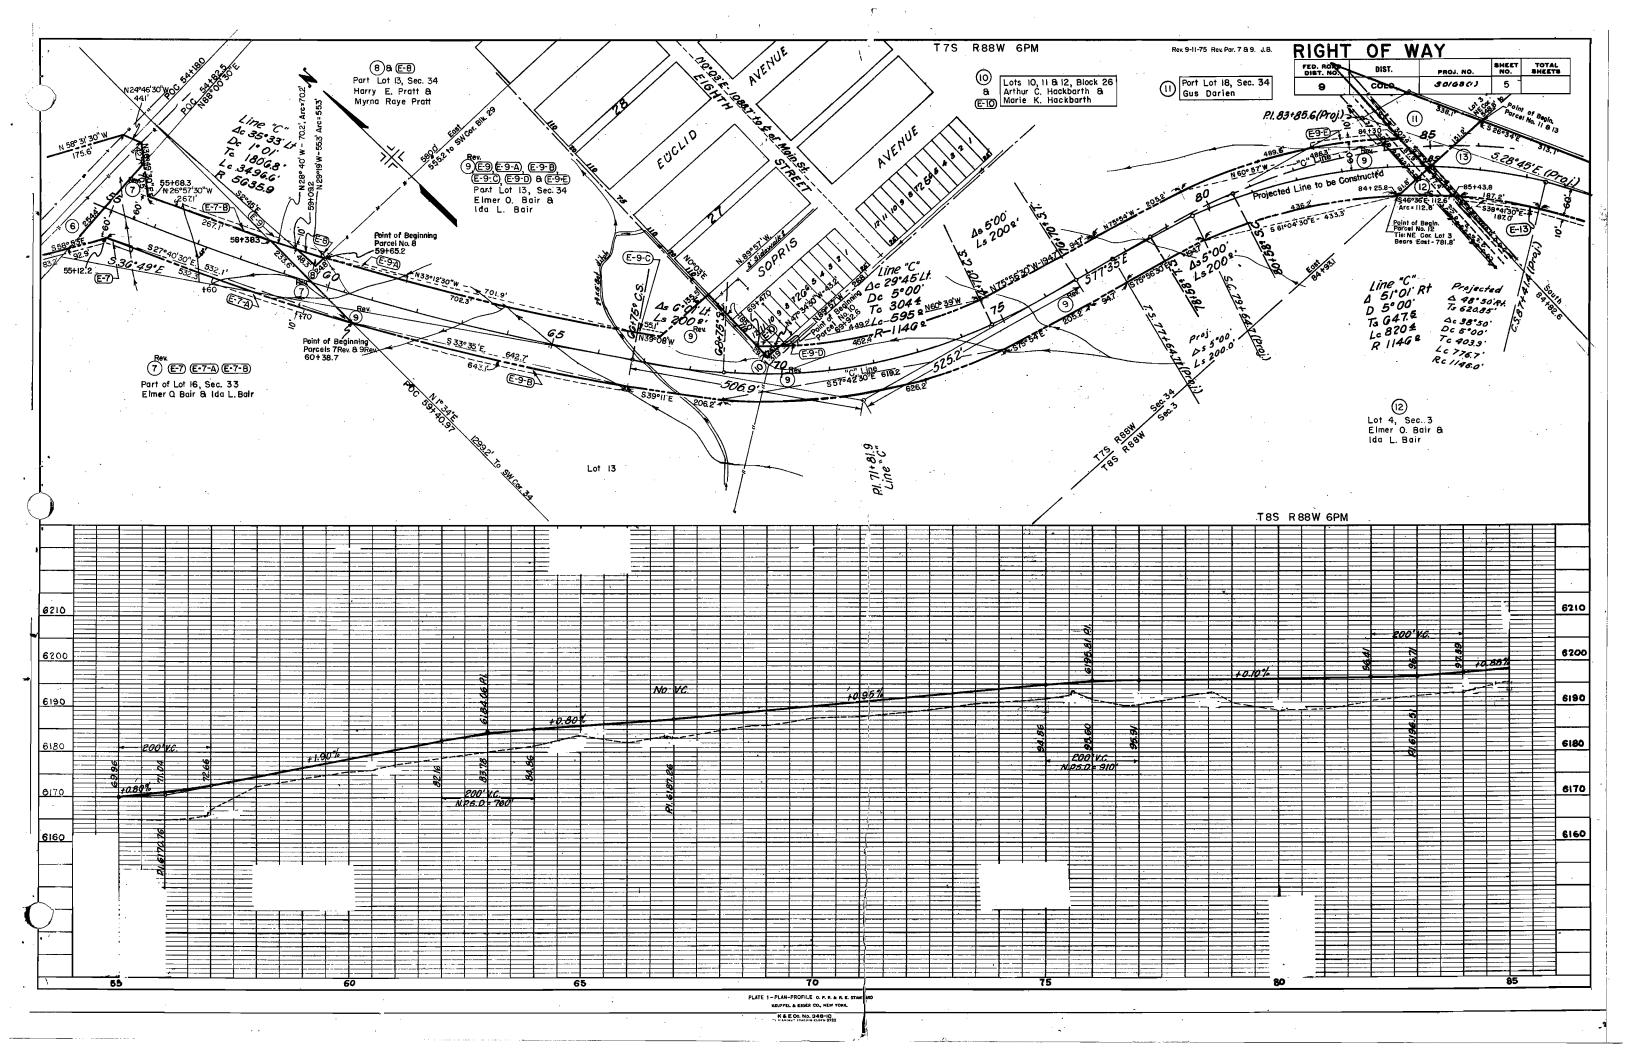

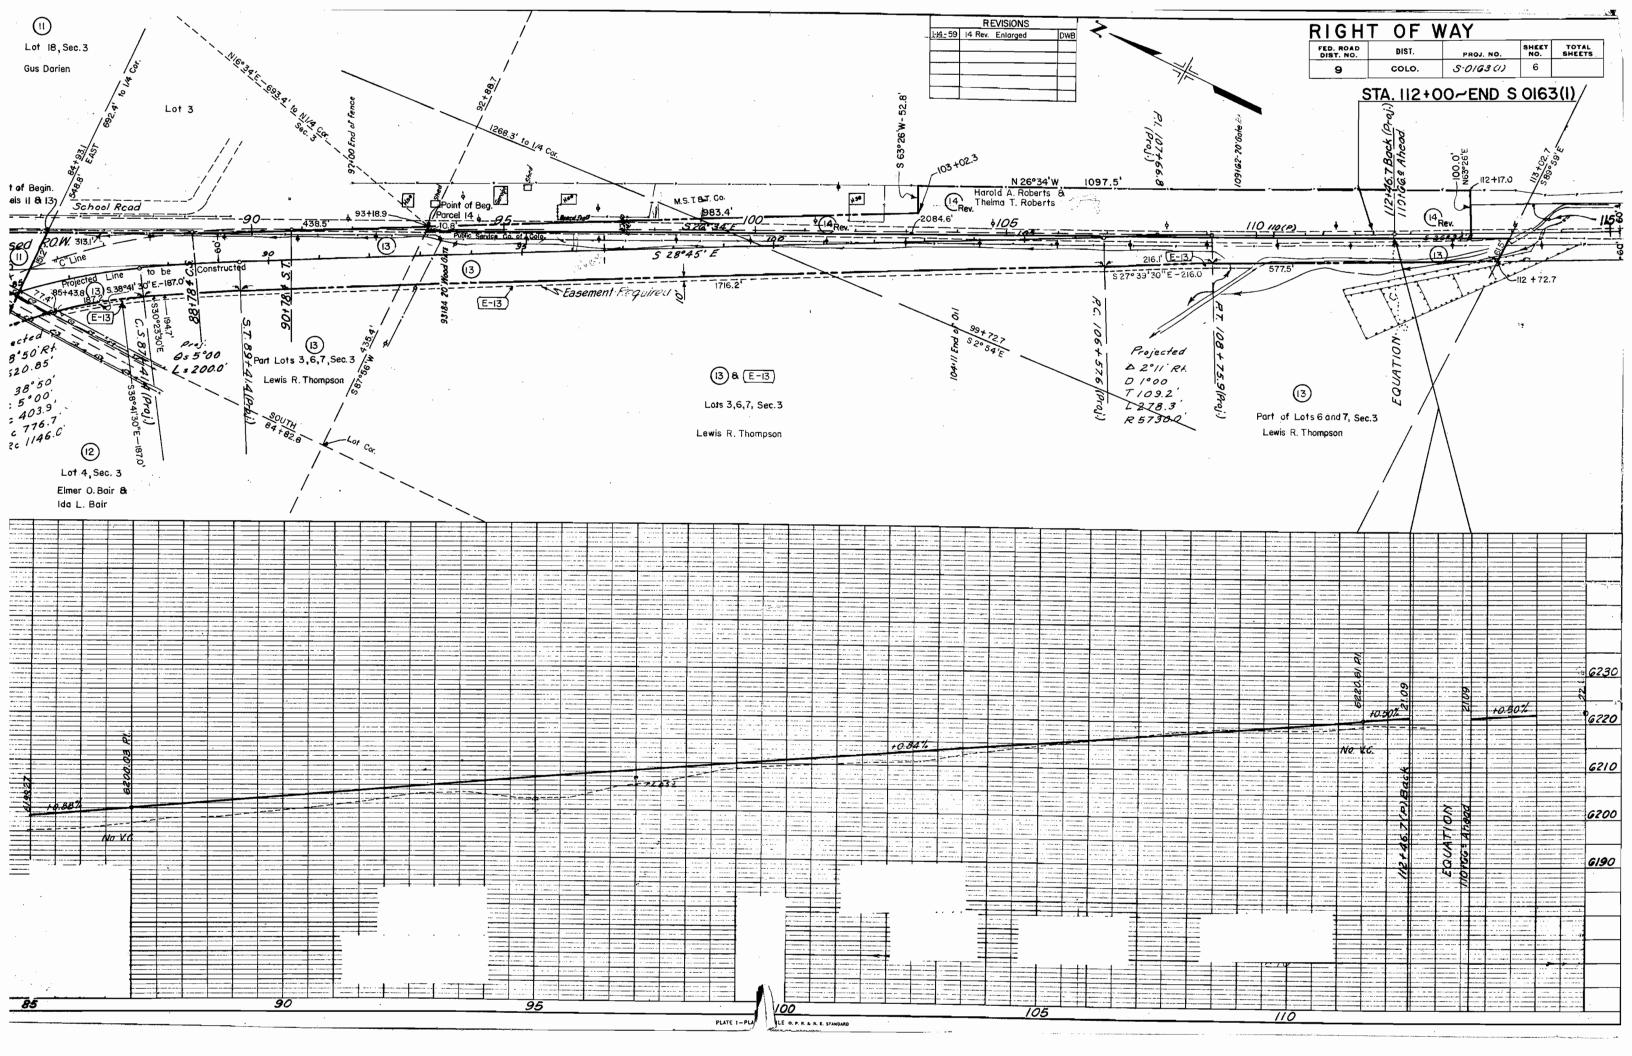

498928 FS of 12

A tract of land situate in Sections 3,4, and 10 Township 8 South, Range 88 West

of the 6th Principal Meridian being more particularly described as follows:

Beginning at a point whence the southwest corner of said Section 3
bears S 1643\*22" W 3882.06 feet; thence N 71'32'55" E 394.70 feet; thence
thence S 2705'56" E 80.50 feet; thence 60.33 feet along the arc of a
nontangent curve to the right, having a radius of 185.00 feet, a central angle
of 18'40'59", and subtending a chard bearing N 65'25'24" E 60.06 feet;
thence N 27'05'56" W 183.82 feet; thence 329.20 feet along the arc of a
curve to the left, having a radius of 475.00 feet, a central angle of
33'42'31", and subtending a chord bearing N 46'49'09" W 32.25 feet; thence
N 66'40'24' W 58.99 feet; thence N 435'15'2'F 75.21 feet; thence S
55'14'39" E 713.73 feet; thence N 0'36'46" E 1000.04 feet; thence S
53'02'13" E 72.13 feet; thence S 28'44'08" E 1775.47 feet; thence S
27'41'51" E 126.26 feet; thence S 6'144'18" W 784.34 feet; thence S
33'33'56" E 133.07 feet; thence S 30'35'57", and subtending a chord bearing S
33'33'56" E 123.07 feet; thence S 30'35'57". E 145.26 feet; thence 86.76
feet along the arc of a curve to the left, having a radius of 670.00 feet, a
central angle of 725'11", and subtending a chord bearing S
36.70 feet; thence S 61'44'18" E 622.74 feet; thence S 28'15'42"E 14.68
feet; thence N 61'44'18" E 622.74 feet; thence S 28'15'42"E 14.68
feet; thence N 61'44'18" E 525.90 feet; thence S 11'58'10" W 67.80 feet;

central angle of 72511", and subtending a chord bearing S 34:18:33" E
86.70 feet; thence N 61'44'18" E 02:74 feet; thence S 28:1542"E 14:68
feet; thence N 61'44'18" E 12:13
feet; thence N 61'44'18" E 12:13
feet; thence N 61'44'18" E 12:13
feet; thence S 26'34'13" E 785.90 feet; thence S 11'58'10" W 67:80 feet;
thence S 64'755" E 136:26 feet; thence S 7'45'46" W 99:73 feet; thence S
87'47'47" W 544:21 feet; thence S 25'19'55" E 44:58 feet along the east
bank of the Crystal River; thence S 86'27'09" W 94.31 feet to the center of
the Crystal River; thence along the center of the Crystal River the following
courses: S 16'02'31" E 116:12 feet; thence S 27'48'07" E 235.74 feet;
thence S 44'54'14" E 90.66 feet; thence S 56'56'24" E 331.75 feet;
thence S 43'51'57" E 243.66 feet; thence S 56'56'24" E 331.75 feet;
thence S 43'51'57" E 243.66 feet; thence S 34'57'12" E 399.30 feet; thence
leaving said river center on a course bearing N 87'44'00" E 175.35 feet thence
leaving said river center on a course bearing N 87'44'00" E 175.35 feet; thence
s 29'45'00" E 122:32 feet; thence N 87'44'00" E 59.08 feet to the west
right-of-way line of Colorado State Highway No. 133; thence 495.05 feet along
the arc of a nontragent curve to the right, hoving a radius of 5'149.10 feet, a
central angle of 5'23'50", and subtending a chord bearing S 12'13'08" E
484.87 feet; thence 440.03 feet along the arc of a curve to the right, hoving
radius of 5'149.10 feet, a central angle of 4'53'47", and subtending a chord
bearing S 0'70'4'0" E 439.90 feet; thence N 88'39'4" W 113.84 feet to a
point on the center of the Carbondale Town Ditch; thence N 16'30'22" W 37.93
feet along the center of said ditch to the southeast corner of a tract of land
described in Book 457 at Page 552 of the records of the Clerk and Recorder
Garfield County, Colorado; thence along the east and north boundaries of said
parcel the following courses: N 19'42'32" W 53.32 feet; thence N 33'14'25' E
6'7.34 feet; thence N 8'58'13" W 133.41 feet
feet; thence N 8'158'15" W 138.10 fee thence S 20'09'48" W 108.39 feet; thence S 38'49'59" E 121.56 feet; thence \$7.36 feet along the arc of a nontangent curve to the left, having a radius of 335.00 feet, a central angle of 6'23'24", and subtending a chord bearing \$5.5742'46" W 37.34 feet; thence \$5.0'31'04" W 54.10 feet; thence \$21.11 feet along the arc of a curve to the left, having a radius of 235.00 feet, a central angle of 53'55'30", and subtending a chord bearing \$23'33'19" W 213.10 feet; thence \$82'05'3" W 40.81 feet; thence \$5.29'24'31" W 239.42 feet; thence \$3.86'16'32" W 552.19 feet; thence \$252'05'43" W 609.49 feet; thence \$3.85'16'32" W 509.49 feet; thence \$3.85'16'32" W 509.49 feet; thence \$3.86'16'32" Of feet a central angle of \$1.80'0 feet a centr \$ 2924'31" W 239.42 feet; thence \$ 3676'32" W 552.19 feet; thence \$ 23705'43" W 609.49 feet; thence \$ 3.8.51 feet along the arc of a nontangent curve to the left, having a radius of 18.000 feet, a central angle of 12'15'30", and subtending a chord bearing \$ 895'158" W 38.44 feet; thence \$ 1575'13" W 170.407 feet; thence \$ 149'26'33" W 132.16 feet; thence \$ 35'15'18" W 496.29 feet; thence \$ 15'32'20" E 64.18 feet; thence \$ 35'15'8" W 38.44 feet; thence \$ 35'15'8" W 38.44 feet; thence \$ 35'15'8" W 38.45 feet; thence \$ 35'15'8" E 33.67 feet; thence \$ 15'32'20" E 64.18 feet; thence \$ 35'15'8" E 714'32" E 33.87 feet; thence \$ 3.00 feet, a central angle of 30'59'41", and subtending a chard bearing \$ 75'04'58" E 33.67 feet; thence \$ 35'35'08" E 147.98 feet; thence \$ 95.72 feet along the arc of a curve to the right, having a radius of 120.00 feet, a central angle of 45'42'14", and subtending a chard bearing \$ 82'65'15" E 93.20 feet; thence \$ 74'42'39" E 19.14 feet; thence \$ 18'01'07" \$ 82.50 feet; thence \$ 74'32'39" E 19.14 feet; thence \$ 5'43'35" W 39'4.01 feet; thence \$ 18'20'107" \$ 86.38 feet; thence \$ 73'17'35" \$ 7'74.10 feet; thence \$ 18'20'107" \$ 86.38 feet; thence \$ 13'17'35" \$ 7'74.10 feet; thence \$ 13'12'20'0" \$ 193.33 feet; thence \$ 13'17'35" \$ 13'13 feet; thence \$ 13'12'20'0" \$ 193.33 feet; thence \$ 13'12'20'0" \$ 193 TOGETHER WITH
A tract of land situate in Sections 3,4 and 10 Township 8 South, Range 88 West
of the 6th Principal Meridian being more particularly described as follows:

A tract of land situate in Sections 3.4 and 10 Township 8 South, Range 88 Wes of the 6th Principal Meridian being more particularly described as follows:

Beginning at a point whence the southwest corner of said Section 3 bears

\$ 1402135" E 2921.38 feet; thence N 702043" E 39.74 feet; thence
N 771875" E 115.64 feet; thence 8 8106139" E 114.86 feet; thence
N 771875" E 115.64 feet; thence 8 8106139" E 114.86 feet; thence 240.68
feet along the arc of a curve to the left, having a radius of 210.00 feet, a capture of the left, having a radius of 210.00 feet, a capture to the left, having a radius of 210.00 feet, a feet; thence 8 73735" E 88.24 feet; thence N 803055" E 6.46
feet; thence 38.88 feet along the arc of a curve to the left, having a radius of 227.00 feet, one of 270.00 feet, a capture of the left, having a radius of 227.00 feet, certain angle of 533113" and subtending a chord bearing
\$ 4827138" E 30.87 feet; thence \$ 815912" W 172.07 feet; thence
\$ 5702139" W 20.79 feet; thence \$ 8143444" E 30.63 feet; thence
\$ 5702139" W 20.79 feet; thence \$ 212656" E 164.75 feet; thence
\$ 431022" E 156.32 feet; thence \$ 2290444" E 55.66 feet; thence
\$ 431022" E 156.32 feet; thence \$ 2290444" E 55.66 feet; thence
\$ 431022" E 156.32 feet; thence \$ 2290444" E 55.66 feet; thence
\$ 431022" E 156.32 feet; thence \$ 12656" E 164.75 feet; thence
\$ 43302 feet; thence \$ 154322" E 44.30 feet; thence \$ 412415" E
403.25 feet; thence \$ 154322" E 44.30 feet; thence \$ 412415" E
9.39 feet; thence \$ 154322" E 44.30 feet; thence \$ 412415" E
9.39 feet; thence \$ 154322" E 44.30 feet; thence \$ 412415" E
9.39 feet; thence \$ 154322" E 44.30 feet; thence \$ 87822" E
161.07 feet; thence \$ 154322" E 164.00 feet; a central angle of 4520141", and subtending a chord bearing \$ 1020218 feet; thence \$ 87822" E
161.07 feet; thence \$ 154221" E 186.21 feet; thence \$ 87822" E
16

## A tract of land situate in Sections 3 and 4 Township 8 South, Range 88 West of the 6th Principal Meridian being more particularly described as follows:

Beginning at a point whence the southwest corner of said Section 3 bears 5 5:37:16" E 4065.64 feet, thence 402.41 feet along the arc of a to the right, having a radius of 565.00 feet, a central angle of 40'48'27, and subtending a chard bearing N 76'17'52" W 333.96 feet, thence N 5553:38" N 207.42 feet, thence N 00'00'00'0" N 156.63 feet; thence N 00'00'28" E 140.76 feet, thence S 74' 31'17" E 472.99 feet; thence N 88'10'32" E 114.29 feet; thence S 6'40'53" E 57.80 feet; thence S 15'19'33" E 32.72 feet; thence S 20'33'27" E 95.74 feet; thence S 15'19'33" E 131.98 feet; thence S 4'27'12" W 7.731 feet; thence S 83'17'55" W 131.64 feet to the point of beginning, eaid parcel contains

### TOWN OF CARBONDALE, GARFIELD COUNTY. COLORADO

A tract of land situate in Section 3, Township 8 South, Range 88 West of the 6th

Beginning at a point shence the southwest corner of said Section 3 bears \$28\*43'34" W 3405.41 feet; thence \$ 42'38'19" E 435.27 feet; thence \$25'58'15" E 496.47 feet; thence \$7.39'54" E 68.80 feet; thence \$68'50'11" E 92.10 feet; thence N 38'19'05" E 209.20 feet; thence 337.53 feet along the arc of a curve to the right, having a radius of 735.00 feet, a central angle of 26'18'42", and subtending a chord bearing N 43'45'18" W 334.57 feet; thence N 30'35'57"W 145.26 feet; thence 477.48 feet along the arc of a curve to the left, having a radius of 1365.00 feet, a central angle of 20'02'32", and subtending a chord bearing N 40'37'13" W 475.05 feet; thence N 50'38'30" W 93.15 feet; thence \$39'21'30" W 127.73 feet to the point of beginning, said parcel contains 3.834 acres more or less.

TOTAL AREA 279,728 ACRES MORE OR LESS.

The aforesaid Owner has by these presents laid out, platted and subdivided the above described real property into lots and blocks as shown hereon, and designates the same as River Valley Ranch, Phase I, in the Town of Carbondale, County of Garfield, State of Colorado, and does hereby

1. All streets, avenues, drives, courts, places, lanes, alleys and pedestrian paths shown on the within Plat are hereby dedicated and set apart to the Town of Carbondale for public use, and for drainage and underground utility purposes. No bridge or pedestrian path shall be used for drainage purposes. That portion of the within Plat identified as Colorado Department of Transportation Right—of-Way Easement is hereby dedicated and set apart to the Colorado Department of Transportation for public highway purposes.

2. The parcels of property identified and depicted on the within Plat as River Front Park No. 1, River Front Park No. 2, River Front Park No. 3, River Front Park No. 4, River Front Park No. 5, River Front Park No. 6, the Crystal River Corridor, Triangle Park, and Orchard Park are hereby dedicated and set apart to the Town of Carbondale as public parks for public use, subject, however, to the terms and conditions set forth in that certain Warranty Deed between Crystal River Limited Partnership as Grantor and the Town of Carbondale as Granter recorded on September 12. 1996 in the records of the Clerk and Recorder of Garfield County as Reception No. 499921

3. Except for the "Resident Village Area," all parcels of real property identified and depicted on the within Plat as "Master Common Area" or "M.C.A." or "Limited Cammon Area" or "L.C.A." are hereby dedicated and set apart to the River Valley Ranch Master Association, a Colorado non-profit corporation, for the use and benefit of the Members thereof, subject to the applicable terms and conditions of the Master Declaration of Protective Coverants for River Valley Ranch recorded on September, 24, 1996 in the records of the Clerk and Recorder of Carfield County as Reception No. 456,944. As set forth in the Master Declaration, the "Resident Village Area" is also a Master Common Area all or parts of which may in the future be conveyed to the Master Association by separate instrument(s) of conveyance.

4. All parcels of real properly identified and depicted within Block G on the within Plat as "Thompson Corner Parks" or Block G Master Common Area are hereby dedicated and set apart to the Thompson Corner Homeowners Association, a Colorado non-profit corporation, for the use and benefit of the Members thereof, subject to the applicable terms and conditions of the Deciaration of Protective Covenants for Thompson Corner recorded on September 12. 1996 in the records of the Clerk and Recorder of Garfield County, Colorado, as Reception No. 1998 1994. and subject further to the terms and conditions set forth in that certain Deed of Easement between Crystal River Limited Partnership as Grantor and the Town of Carbondale as Grantee recorded on September 1996 in the records of the Clerk and Recorder of Garrield County, Colorado, as Reception No.

5. All portions of the real property identified and depicted on the within Plat as utility easements are hereby reserved, dedicated and set apart as perpetual, non-exclusive utility easements for the use and benefit of the Town of Carbondale or other appropriate utility companies for public use, and the River Vulley Ranch Master Association, for the purpose of installation, maintenance, repair and replacement of utility lines and facilities, together with the perpetual right of ingress and egress thereto for the aforesaid purposes; upon the condition that such easements and rights be utilized by the beneficiaries in a reasonable and prudent manner. There are hereby reserved, dedicated and set apart the following additional utility easements for the aforesaid beneficiaries and purposes:

(i) a ten (10) foot wide easement along all lot lines adjacent to public roadways all lots depicted on the within Plat, except for those lots where such ten (10) foot easement would conflict with a building envelope, in which cases the easement shall be only so wide as to avoid encroachment into the building envelope; and (ii) a five (5) foot wide easement along the side lot lines of all lots in Block Capolited on the within Plat being five (5) feet in width on each side of the side tof line and extending twenty (20) feet from the lot line adjacent to the public roadway. That portion of the within Plat identified as Easement to Public Service Company of Colorado is hereby dedicated and set apart to said Public Service Company of Colorado for the purpose of installation, maintenance, repair and replacement of underground electric utility lines.

6. All portions of the real property identified and depicted on the within Plat as drainage and/or irrigation easements are hereby reserved, dedicated and set apart for the joint use and benefit of the undersigned Owner and its successors, including, without limitation, the owner of the Golf Course Parcels as depicted on the within Plat, the River Valley Ranch Master Association, a Colorado non-profit corporation, for the use and benefit of its Members, and the Town of Carbondale. The interests of the aforesaid parties in and to the said irrigation easements, and the parties' rights and obligations with respect to the operation, maintenance and repair thereof, and the payment of costs therefor, are as set forth in the Water Rights Operating Agreement between Crystal River Limited Partnership and the Town of Carbondale recorded on September 1996, in the records of the Clerk and Recorder of Carfield County as Reception No. 1994 1996, in the records as being for a specific, identified irrigation dictor are dedicated and set apart for the use and benefit of the owners of said ditches and the water rights decreed thereto.

7. All portions of the real property identified and depicted on the within Plat as untreated 7. All portions of the real property identified and depicted on the within Plat as untreated water irrigation line easements are hereby reserved, dedicated and set apart for the joint use and benefit of the undersigned Owner, and its successors, including, without limitation, the owner of the Colf Course Parcels as depicted on the within Plat, and the River Valley Ranch Master Association, for the use and benefit of the members thereof; provided, however, the untreated water line easements located within Block C of the within Plat are dedicated and set apart to the Thompson Corner Homeowners Association, for the use and benefit of its Members. The interests of the aforesaid parties in and to the said untreated irrigation water line easements and the facilities installed and located therein, and the parties' rights and obligations with respect to the operation, maintenance and repair of said facilities, and the payment of the cost therefor, are as set forth in the Water Rights Operating Agreement between Crystal River Limited Partnership and the Town of Carbondale recorded on September 27, 1996, in the records of the Clerk and Recorder of Garfield County as Reception No. 8. All portions of the real property identified and depicted on the within Plat as Secondary drainage collection assements are hereby reserved, dedicated and set apart for the joint use and benefit of the undersigned Owner and the River Valley Ranch Moster Association, a Colorado nonprofit corporation, for the use and benefit of its Members and for the use and benefit of the owners of the Lowline Ditch and the water rights decreed thereto. It is declared and acknowledged that the Secondary drainage collection easements may lie beneath public rights of way as dedicated herein. The beneficiaries of the Secondary drainage collection easements shall be responsible for the maintenance and repair of any drainage facilities constructed and installed within the Secondary drainage collection easements, including the repair and restoration of any public right of way which may be disturbed or damaged as a result of such maintenance and repair.

The Owner further states that portions of the within Subdivision are subject to the terms and conditions of the Master Declaration of Protective Covenants for River Valley Ranch recorded on September 2.1. 1996 in the records of the Clerk and Recorder of Carfield County as Reception No. 1995 in the records of the Clerk and Recorder of Carfield County as Reception No. 1996 in the Peclaration of Protective Covenants for Thompson Corner recorded on September 2.1. 1996 in the records of the Clerk and Recorder of Carfield County, Colorada, as Reception No. 1995 in the the within Subdivision is subject to that certain Master Subdivision Improvements Agreement and Development Covenants for Phase I, River Valley Ranch Subdivision between Crystal River Limited Partnership and the Town of Carbonalde, Colorado, recorded on September 2.1. 1996, in the records of the Clerk and Recorder of Garfield County, Colorado, as Reception No. 1995 in

EXECUTED this 25th day of September , A.D., 1996. Crystal River Limited Partnership, a Delaware Limited Partnership

By:JCH Investments, Inc., a Texas corporation, General Partner

1110.00 Its: Vice Presioant

The foregoing dedication was acknowledged before me this 25 day of 90 ptember A.D., 1996, by Clayten T. Showe as VILE President

My commission expires: August 17, 1997
WITNESS MY HAND AND SEAL: 785 Eu-

Surveyor's Certificate:

I, Kenneth R. Wilson, do hereby certify that I am a Professional Land Surveyor licensed under the law of the State of Colorado, that this plat is a true, correct and complete plat of River Valley Ranch, Phase I as laid out, lotted, dedicated and shown Instrum, that such plat was made by me from an accurate survey of said property by me, and under my supervision and correctly shows the location and dimensions of the boundary and easements of said subdivision as the same are staked upon the ground in compliance with applicable regulations governing the subdivision of land.

IN WITNESS WHEREOF I have set my hand and professional Land Surveyor TISTIO Professional Land Surveyor TISTIO Reproductives.

Planning Commission Certificate:

This Plat was approved by the Planning and Zoning to the Town of Carbondale, Garfield County, Colorado, this of Capail, 1996. this 4th day

This plat was filed for record in the Office of the Clerk and Recorder of Garfield County, Colorado, at 1:11 o'clock P.M., this 17 day of September , 1996 in Book \_\_\_\_\_\_, a \_\_\_\_\_, Reception No. 49222

Paid 12100 Drawer 3-A Mildred alador! Clerk & Recorder

By: Chr. Line Honek

Board of Trustees Certificate:

This plat approved by the Board of Trustees of the Town of Carboadde, County of Garfield, State of Colorado, this Ltd. day of Ltd., A.D. 1996, for filing with the Clerk and Recorder of Garfield County, State of Colorado, and for the conveyance to the Town of the public dedications shown hereon, subject to the provision that the approval in no way obligates the Town of Carbondale for financing or constructing improvements on land, streets or easements dedicated to the public except as specifically agreed to by the Board of Trustees.

Major



00 J



SCHMUESER GORDON MEYER INC. 118 W. 6th Street. Suite 200 Clenwood Springs, Colorado 81601 (303) 945-1004 (FAX.) 945-5948 4spen, Colorado (303) 925-6727

RIVER VALLEY RANCH

RFVISION

FINAL PLAT PHASE I

ate: SEPT 96 KW

