


# STATE DEPARTMENT OF HIGHWAYS DIVISION OF HIGHWAYS—STATE OF COLORADO

|                         |          |             |           |
|-------------------------|----------|-------------|-----------|
| FEDERAL ROAD REGION NO. | DIVISION | PROJECT NO. | SHEET NO. |
| 9                       | COLORADO | T 7300(3)   | 1         |

(R-1) 7-22-71 ADDED M-STD. T.A.L.  
INDEX OF SHEETS  
**AS CONSTRUCTED**  
**REVISED 11-19-71**  
FINAL CONSTRUCTION

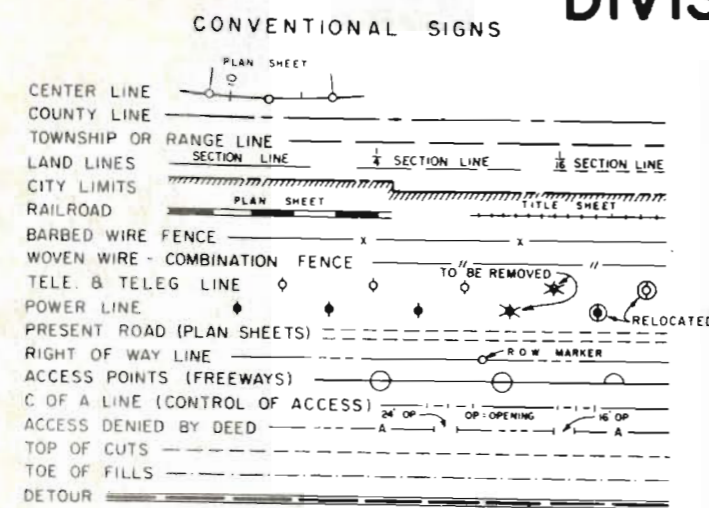


## PLAN AND PROFILE OF ~~PROPOSED~~ COMPLETED FEDERAL AID PROJECT NO. T 7300(3) STATE HIGHWAY NO. 96 PUEBLO COUNTY

SCALES OF ORIGINAL DRAWINGS  
ON PLAN, 1 IN = 20 FT.  
ON PROFILE { 1 IN = 50 FT. HORIZONTAL  
1 IN = 5 FT. VERTICAL  
GRADE LINE ON PROFILE IS SHOWN AS GRADE OF FINISHED ROAD

| SHEET NO | DESCRIPTION  |
|----------|--|
| 1        | TITLE PAGE, SKETCH MAP, TABULATION OF LENGTH AND DESIGN DATA   |
| 2        | TYPICAL SECTION, GENERAL NOTES, DETAIL OF GUTTER TYPE 2 (8 FOOT)   |
| 3-4      | SUMMARY OF APPROXIMATE QUANTITIES  |
| 5        | STRUCTURE QUANTITIES   |
| 6        | SUMMARY OF EARTHWORK QUANTITIES, SURFACING PLAN, REMOVAL OF TREE, ADJUST MANHOLES AND VALVE BOXES TABULATIONS. |
| 7        | CURB, GUTTER AND SIDEWALK TABULATION   |
| 8-9      | PLAN SHEETS  |
| 10       | PROFILES OF CURB & GUTTER  |
| 11       | DRAINAGE PLAN AND PROFILE  |
| 12       | DETAILS OF CHAIN LINK FENCE AND ADJUST VALVE BOX   |
| 13-22    | CROSS SECTIONS   |

### TABULATION OF LENGTH AND DESIGN DATA

| STATION  | LIN. FT.  |               |              |       |       |
|--|---|---------------|--------------|-------|-------|
| 0 + 00.0 (PROJ.) BEGIN T7300(3)=<br>12.0' RT. 0+00.0 (SURV.) | 885.8   |               |              |       |       |
| 8 + 81.4 W.B. }<br>8 + 90.2 E.B. } 8 + 85.8 AVG. (PROJ.)     | 9.2   |               |              |       |       |
| 8 + 95.0 (PROJ.) END T7300(3)=<br>27.3' LT. 9+22.4 (SURV.)   |   |               |              |       |       |
| <b>TOTAL</b>   | <b>895.0</b>  |               |              |       |       |
| <b>SUMMARY</b>   |   |               |              |       |       |
| T7300(3) NET & GROSS LENGTH                                  | <table style="width: 100%; border-collapse: collapse;"> <tr> <td style="width: 50%;">LIN. FT.</td> <td style="width: 50%;">MILES</td> </tr> <tr> <td style="text-align: center;">895.0</td> <td style="text-align: center;">0.170</td> </tr> </table> | LIN. FT.      | MILES        | 895.0 | 0.170 |
| LIN. FT.   | MILES   |               |              |       |       |
| 895.0  | 0.170   |               |              |       |       |
| <b>DESIGN DATA</b>   |   |               |              |       |       |
| MAXIMUM DEGREE OF CURVE                                      | 16°00'  |               |              |       |       |
| MAXIMUM GRADE  | 1% ±  |               |              |       |       |
| MINIMUM S.S.D. HORIZONTAL                                    | >900'   |               |              |       |       |
| MINIMUM S.S.D. VERTICAL                                      | >1300'  |               |              |       |       |
| MAXIMUM DESIGN SPEED   | 35 M.P.H.   |               |              |       |       |
| 1991 DESIGN TRAFFIC VOLUME                                   | <table style="width: 100%; border-collapse: collapse;"> <tr> <td style="width: 50%;">28,600 A.D.T.</td> <td style="width: 50%;">3,150 D.H.V.</td> </tr> </table>  | 28,600 A.D.T. | 3,150 D.H.V. |       |       |
| 28,600 A.D.T.  | 3,150 D.H.V.  |               |              |       |       |

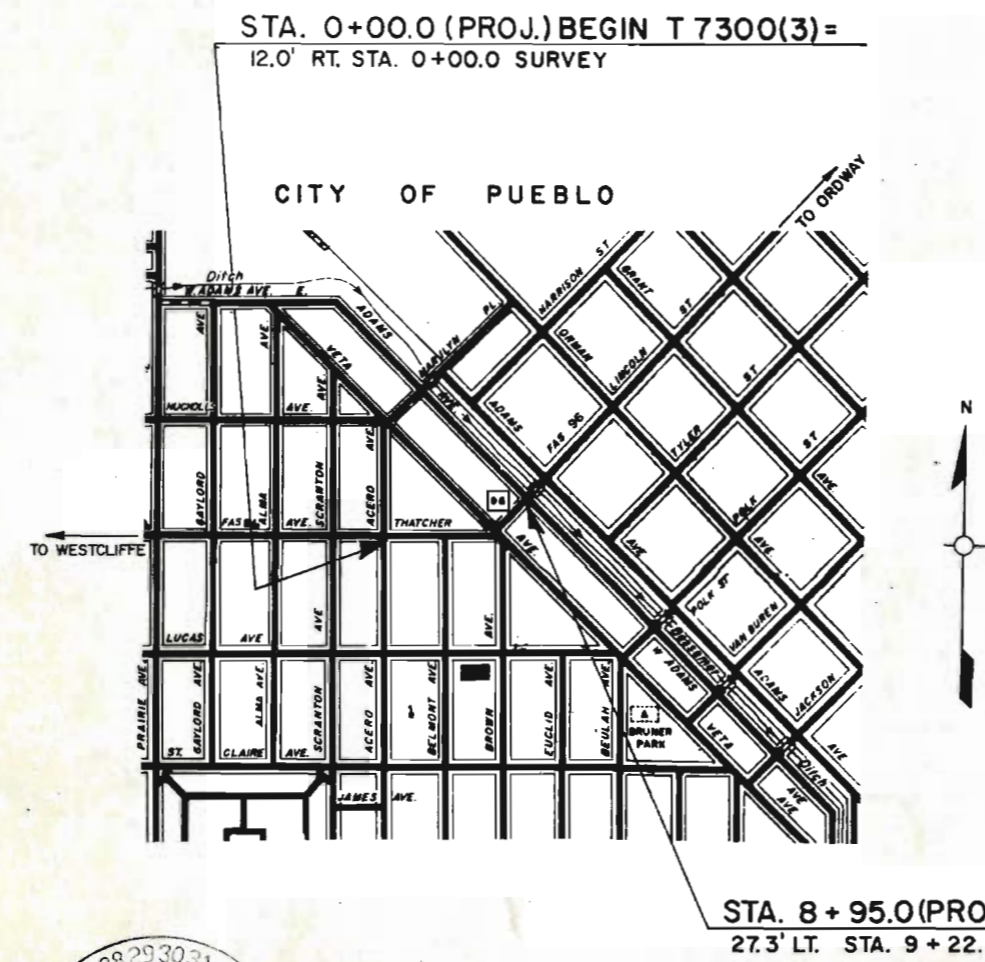

|                  |  |            |          |
|------------------|--|------------|----------|
| M-206-AA         | EXCAVATION AND BACKFILL FOR STRUCTURES     | (2 SHEETS) | 3-1-71   |
| (R-1) * M-603-M  | METAL CULVERT PIPE - H-20 LOADING          |            | 2-11-71  |
| M-604-AA         | CONCRETE INLETS - TYPES 3 AND 3 DOUBLE     |            | 12-2-68  |
| M-604-D          | STEPS FOR MANHOLES AND INLETS              |            | 7-23-68  |
| M-604-E          | MANHOLES                                   |            | 4-20-71  |
| M-607-B          | CHAIN LINK FENCE                           | (2 SHEETS) | 4-20-71  |
| M-609-A          | CURBS AND GUTTERS                          |            | 5-7-71   |
| M-614-A          | TIMBER BARRICADES                          |            | 4-23-69  |
| M-614-IC         | STANDARD CONSTRUCTION IDENTIFICATION SIGNS | (2 SHEETS) | 9-25-70  |
| M-614-TB         | TRAFFIC SIGNING FOR HIGHWAY CONSTRUCTION   | (3 SHEETS) | 12-24-68 |
| (R-1) * H-603-RC | REINFORCED CONCRETE PIPE                   |            | 3-1-71   |

*"As Constructed No Revisions"  
Sheets 10 and 12*

SEE SPECIAL PROVISIONS FOR  
NOTICE TO BIDDERS

DIVISION OF HIGHWAYS

FINAL APPROVAL AS  
CONSTRUCTED PLANS  
*[Signature]*  
DISTRICT CONSTRUCTION ENGR DATE 1-24-72


DIVISION OF HIGHWAYS

APPROVED  
*[Signature]* 6-8-71  
CHIEF ENGINEER DATE

CONTRACTOR: BRODERICK & BERBONS  
RESIDENT ENGR: V.E. WILLIAMS  
PROJECT ENGR: R.J. QUAYLE  
PROJECT STARTED: 8-30-71  
PROJECT COMPLETED: 11-19-71

DEPARTMENT OF TRANSPORTATION  
FEDERAL HIGHWAY ADMINISTRATION

APPROVED \_\_\_\_\_ DATE \_\_\_\_\_  
DIVISION ENGINEER

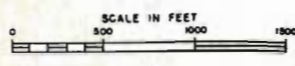

### TYPICAL SECTION

| FEDERAL ROAD REGION NO. | DIVISION | PROJ. NO.  | SHEET NO. | TOTAL SHEETS |
|-------------------------|----------|------------|-----------|--------------|
| 9                       | COLORADO | T 7300 (3) | 2         |              |


(R-1) 7-8-71 Sheet Nos. T.A.L.

AS CONSTRUCTED

REVISED DATE 11-18-71

#### GENERAL NOTES

FINAL CONSTRUCTION

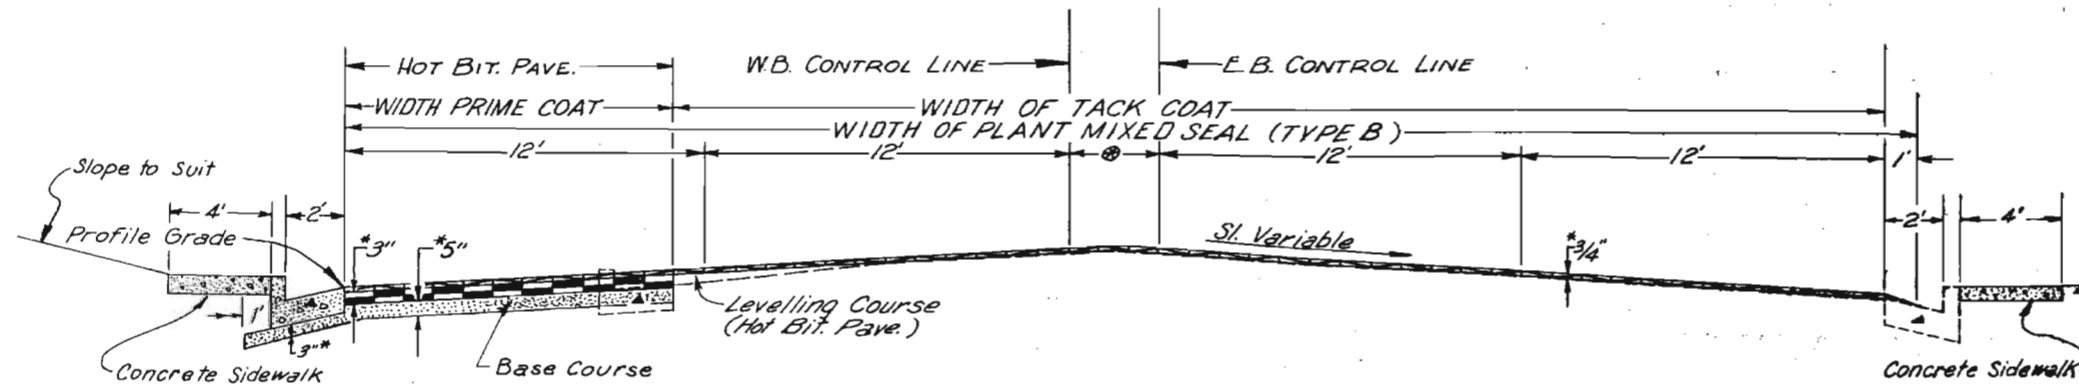

- (R-1) \* Approximate Thickness
- ⊕ Varies - See Sheet No. 8 & 9
- ▲ For locations of curb & gutter removal & construction see Sheet No. 7

For preliminary plan quantities of Bituminous Materials the following rates of application were used:

|                        |                                    |
|------------------------|------------------------------------|
| Prime Coat MC          | @ 0.40 Gals. per Sq. Yd.           |
| Tack Coat (SS-1h)      | @ 0.10 Gals. per Sq. Yd. (1:1 Mix) |
| Seal Coat & Bit. Pave. | @ 110 Lb/Sq. Yd. per inch          |

Rates of application shall be as determined by the Engineer at the time of application.

Any layer of bituminous pavement that is to have a succeeding layer placed thereon shall be completed full width before succeeding layer is placed.


Moisture-Density control <sup>will</sup> be required to a depth of 1/2 Foot on the subgrade in the areas where base course and Hot Bituminous Pavement are required. The type of compaction shall be AASHTO T-99. The cost of wetting and compacting the subgrade ~~will~~ be included in the unit price for "Hot Bituminous Pavement."

~~It is estimated that 600~~ <sup>477</sup> Hours of Flagging for controlling traffic ~~will be required for this project.~~

The Force Account Item, "Clearing of Building Sites, etc.," shall include removal of all foundations, wells, buildings and other appurtenances not removed by the owner, and any necessary backfilling of cellars, cesspools, wells, etc., to provide neat roadside conditions. ~~It is estimated that this item applies at the following locations: Sta. 4± Lt., Sta. 6± Lt.~~

Signs interfering with construction ~~will be removed by State Forces.~~

#### DETAIL OF GUTTER TYPE 2 (8 FOOT)

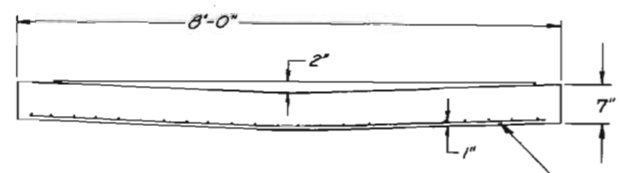

Welded wire fabric will not be paid for separately, but shall be included in the unit price bid for Gutter Type 2 (8 Foot)

FINAL SUMMARY OF APPROXIMATE QUANTITIES

AS CONSTRUCTED  
REVISED 11-19-71

RD 7-22-71 Rev Pipe Type T.A.L.  
CONSTRUCTION

|                           |          |            |           |              |
|---------------------------|----------|------------|-----------|--------------|
| FEDERAL ROAD DISTRICT NO. | DIVISION | PROJ. NO.  | SHEET NO. | TOTAL SHEETS |
| 1                         | COLORADO | T 7300 (3) | 3         |              |

| INDEX | CONTRACT ITEM NO. | CONTRACT ITEM | UNIT   | CHANGE ORDER #19252 | ADJUSTED TOTALS | PROJECT TOTALS | FINAL TOTALS | UNRECONCILED QUANTITIES |
|-------|-------------------|---------------|--|---------------------|-----------------|----------------|--------------|-------------------------|
|       |                   |               |  |                     |                 |                |              |                         |
| 7     | 5                 | 202           | Removal of Structure                         |                     |                 | 2              | 2            | 0                       |
| 7     | 6                 | 202           | Removal of Tree                              |                     |                 | 15             | 16           | +1                      |
| 8     | 7                 | 202           | Removal of Sidewalk                          |                     |                 | 220            | 351          | +131                    |
| 8     | 7                 | 202           | Removal of Gutter                            |                     |                 | 72             | 93           | +21                     |
| 9     | 7                 | 202           | Removal of Curb and Gutter                   |                     |                 | 1340           | 1300         | -40                     |
| 9     | 5                 | 202           | Plug Culvert                                 |                     |                 | 2              | 2            | 0                       |
| 10    | 5-21              | 203           | Unclassified Excavation (Haul)               |                     |                 | 1000           | 769          | -232                    |
|       |                   |               |  |                     |                 |                |              |                         |
| 11    | 5-22              | 206           | Structure Excavation                         |                     |                 | 1220           | 1260         | +40                     |
| 11    | 5-22              | 206           | Structure Backfill (Class 2)                 |                     |                 | 230            | 216          | -14                     |
| 12    |                   | 209           | Wetting                                      |                     |                 | 10             | 12           | +2                      |
| 13    | 6                 | 210           | Adjust Manhole                               |                     |                 | 3              | 3            | 0                       |
| 13    | 6                 | 210           | Adjust Valve Box                             |                     |                 | 9              | 8            | -1                      |
| 14    | 6                 | 304           | Aggregate Base Course (Class 6) (Haul)       |                     |                 | 400            | 411          | +11                     |
| 15    | 6                 | 403           | Hot Bituminous Pavement (Grading E)          |                     |                 |                |              |                         |
|       |                   |               | (Haul and Asphalt)                           |                     |                 |                |              |                         |
| 16    | 6                 | 410           | Plant Mixed Seal (Type B) (Haul and Asphalt) |                     | +175            | 300            | 485.1        | +0.1                    |
| 17    |                   | 411           | Emulsified Asphalt (SS-1 H)                  |                     |                 | 300            | 331.8        | +31.8                   |
| 17    |                   | 411           | Liquid Asphaltic Material (MC-70)            |                     |                 | 100            | 325          | +125                    |
|       |                   |               |  |                     |                 | 300            | 290          | -10                     |
| 18    | 7                 | 412           | Concrete Pavement (6 Inch)                   |                     | +93             | 53             | 146          | +93                     |
| 19    | 5                 | 604           | Inlet Type 3 (5 Foot)                        |                     |                 | 2              | 2            | 0                       |
| 19    | 5                 | 604           | Inlet Type 3 (10 Foot)                       |                     |                 | 2              | 2            | 0                       |
| 20    | 5                 | 604           | Manhole Slab Base (10 Foot)                  |                     |                 | 2              | 2            | 0                       |
| 21    | 5                 | 608           | Concrete Sidewalk                            |                     |                 | 554            | 553          | -1                      |
| 22    | 7                 | 609           | Curb and Gutter Type 2 (Section II-B)        |                     |                 | 1163           | 1232.5       | +69.5                   |
| 22    | 7                 | 609           | Gutter Type 2 (8 Foot)                       |                     |                 | 52             | 50           | -2                      |
| 23    | 2                 | 614           | Flagging                                     |                     |                 | 600            | 477          | -123                    |
| 24    | 5                 | 617           | 24 Inch Culvert Pipe                         |                     |                 | 1,002          | 983          | -19                     |
| 25    |                   | 626           | Mobilization                                 |                     |                 | 0              | 100%         |                         |

SEE BOOK No 2

RD

RD

RD

## SUMMARY OF APPROXIMATE QUANTITIES

FINAL CONSTRUCTION  
**AS CONSTRUCTED**  
**REVISED** DATE 11-19-71

|                           |          |           |           |              |
|---------------------------|----------|-----------|-----------|--------------|
| FEDERAL ROAD DISTRICT NO. | DIVISION | PROJ. NO. | SHEET NO. | TOTAL SHEETS |
| 1                         | COLORADO | T7300(3)  | 4         |              |

| INDEX |      |       | CONTRACT ITEM NO. | CONTRACT ITEM  | UNIT  |          |                   |          |             |         |             |          |           |          |  |  | PROJECT TOTALS | FINAL TOTAL | OVERRUN    |          |
|-------|------|-------|-------------------|--|-------|----------|-------------------|----------|-------------|---------|-------------|----------|-----------|----------|--|--|----------------|-------------|------------|----------|
| BOOK  | PAGE | SHEET |                   |  |       |          |                   |          |             |         |             |          |           |          |  |  |                |             |            |          |
|       |      |       |                   | <u>FORCE ACCOUNT</u>   |       |          |                   |          |             |         |             |          |           |          |  |  |                |             |            |          |
|       |      |       |                   | Clearing of Building Sites Etc.                              | L.S.  |          |                   |          |             |         |             |          |           |          |  |  | •              |             |            |          |
|       |      |       |                   | Work Order No. 1515B   | LABOR | \$312.05 | PLUS 35% OF LABOR | \$109.22 | PLUS FRINGE | \$24.10 | TOTAL LABOR | \$445.37 | EQUIPMENT | \$801.15 |  |  | •              | \$1,000.00  | \$1,246.52 | \$246.52 |
|       |      |       |                   | <u>STATE FORCES</u>  |       |          |                   |          |             |         |             |          |           |          |  |  |                |             |            |          |
| 1     | 111  |       |                   | Furnishing and Installing Identification Sign (State Forces) | Each  |          |                   |          |             |         |             |          |           |          |  |  | •              | 2           |            |          |
|       |      |       |                   | <u>RIGHT OF WAY</u>  |       |          |                   |          |             |         |             |          |           |          |  |  |                |             |            |          |
|       |      |       |                   | Right of Way Entire Project                                  | L.S.  |          |                   |          |             |         |             |          |           |          |  |  | •              |             |            |          |
|       |      |       |                   | <u>RIGHT OF WAY (RELOCATION)</u>                             |       |          |                   |          |             |         |             |          |           |          |  |  |                |             |            |          |
|       |      |       |                   | Relocation Payments  | L.S.  |          |                   |          |             |         |             |          |           |          |  |  | •              |             |            |          |
|       |      |       |                   | <u>NON-FEDERAL AID</u>                                       |       |          |                   |          |             |         |             |          |           |          |  |  |                |             |            |          |
|       |      |       |                   | Signing and Striping Entire Project (State Forces)           | L.S.  |          |                   |          |             |         |             |          |           |          |  |  | •              |             |            |          |

FINAL

STRUCTURE QUANTITIES

(R-1) 7-22-71 Rev. Pipe Type T.A.L.

|                         |          |             |           |
|-------------------------|----------|-------------|-----------|
| FEDERAL ROAD REGION NO. | DIVISION | PROJECT NO. | SHEET NO. |
| 9                       | COLORADO | T 7300(3)   | 5         |

| INDEX      | LOCATION                       | REMOVE STRUCTURE | PLUG GULVERT | STRUCTURE EXCAVATION | STRUCTURE BACKFILL | AGGREGATE BASE COURSE SURFACING (CLASS 6) | HOT BITUMINOUS PAVEMENT (GRADING E.) | INLET TYPE 3 |        | MANHOLE BOX BASE | "H" FT. | ELEVATIONS   |                | BIT. COAT. CORR. STEEL PIPE SEWER OR REIN. CONC. PIPE SEWER LIN. FT. | PIPE INVERT ELEVATION |       | LINE FROM TO      | "H" OVER CULV. FT. | % GRADE         | MISCELLANEDUS                           |     |
|------------|--------------------------------|------------------|--------------|----------------------|--------------------|---|--------------------------------------|--------------|--------|------------------|---------|--------------|----------------|--|-----------------------|-------|-------------------|--------------------|-----------------|---|-----|
|            |                                |                  |              | CUBIC YARD           | CUBIC YARD         |   |                                      | 5 FT.        | 10 FT. |                  |         | RIM OR GRATE | INVERT         |  | OUT                   | IN    |                   |                    |                 |   |     |
|            |                                |                  |              | EACH                 | EACH               |   |                                      | CL 2         | TON    |                  |         | TON          | FT.            |  | FT.                   | 24"   |                   |                    |                 |   | FT. |
| 1 10       | 0+02 (Surv.) 15' Lt. Inlet # 1 | 1                | 1            | 8.6<br>33            | 3<br>9             |   |                                      | 1            |        |                  | 4'-6"   | 95.53        | 92.03<br>91.70 | 15<br>40   | 92.03<br>91.70        | -     | Inlet #1 M.H. A   | 4.7                | -1.30<br>-0.33  | AS CONSTRUCTED<br>REVISED DATE 11-19-71 |     |
| 1 11       | 0+02 (Surv.) 3' Rt. M.H. A     |                  |              | 376.5<br>375         | 90                 |   |                                      |              | 1      |                  | 5'-6"   | 96.46        | 91.83<br>91.57 | 392  | 91.83<br>91.57        | 91.83 | M.H. A M.H. B     | 5.2                | -0.24<br>-0.17  |   |     |
| 1 12       | 0+20 (Surv.) 34' Rt. Inlet # 2 |                  |              | 16.9<br>27           | 7<br>9             |   |                                      | 1            |        |                  | 5'-0"   | 96.40        | 93.68<br>92.07 | 34<br>36   | 93.63<br>92.07        | -     | Inlet #2 M.H. A   | 4                  | -0.59<br>-1.39  |   |     |
| 1 13       | 3+98 (Surv.) 5' Lt. M.H. B     |                  |              | 193<br>197<br>178    | 27                 |   |                                      |              | 1      |                  | 9'-0"   | 95.94        | 87.55          | 120  | 9080<br>87.55 9093    |       | M.H. B Inlet #3   | 8                  | -0.258          |   |     |
| (R-1) 1 14 | 5+14 (Surv.) 45' Lt. Inlet # 3 |                  |              | 85<br>91             | 9                  |   |                                      | 1            |        |                  | 9'-0"   | 95.57        | 87.24          | 55   | 87.24 87.24           |       | Inlet #3 Inlet #4 | 7                  | -0.04           |   |     |
| 1 15       | 5+29 (Surv.) 35' Lt.           | 1                | 1            |                      |                    |   |                                      |              |        |                  |         |              |                |  |                       |       |                   |                    |                 |   |     |
| 1 16       | 5+65 (Surv.) 70' Lt. Inlet # 4 |                  |              | 380<br>514           | 80                 |   |                                      | 1            |        |                  | 9'-0"   | 95.55        | 87.22          | 366<br>358   | 87.22 87.22           |       | Inlet #2 Outlet B | 8                  | -0.49<br>-0.837 |   |     |
| (R-1)      | PROJECT TOTALS                 | 2                | 2            | 1858<br>1318<br>1260 | 214<br>324         |   |                                      | 2            | 2      | 2                |         |              |                | 983<br>1002  |                       |       |                   |                    |                 |   |     |

From Inlet #1 & Inlet #2.  $\phi$  To be cantilevered 6 Ft. Minimum at Outlet.

(R-1)

Remove and Rebuild Fence Rt. of Sta. 9+68 to be included in cost of 24" Pipe.

\* INCLUDED IN ROADWAY QUANTITIES



AS CONSTRUCTED  
 REVISED DATE 11-19-71  
 FINAL CONSTRUCTION

|                         |          |            |           |              |
|-------------------------|----------|------------|-----------|--------------|
| FEDERAL ROAD REGION NO. | DIVISION | PROJ. NO.  | SHEET NO. | TOTAL SHEETS |
| 1                       | COLORADO | T 7500 (3) | 7         |              |

FINAL CURB, GUTTER & SIDEWALK TABULATION




| STATION                                | SIDE             | REMOVE                          |           |               |       |                |       | BUILD                             |                                 |                   |                |                            |       |               |                             |                         |       |
|--|------------------|---------------------------------|-----------|---------------|-------|----------------|-------|-----------------------------------|---------------------------------|-------------------|----------------|----------------------------|-------|---------------|-----------------------------|-------------------------|-------|
|  |                  | CURB & GUTTER                   |           | GUTTER        |       | SIDEWALK       |       | CURB & GUTTER TYPE-2 SECTION II-B |                                 | CONCRETE SIDEWALK |                | CONCRETE PAVEMENT (6 INCH) |       | CURB CUTS*    |                             | GUTTER TYPE 2* (8 FOOT) |       |
|  |                  | LIN. FT.                        | FINAL     | LIN. FT.      | FINAL | SQ. YD.        | FINAL | LIN. FT.                          | FINAL                           | SQ. YD.           | FINAL          | SQ. YD.                    | FINAL | WIDTH         | FINAL                       | LIN. FT.                | FINAL |
| 0±                                     | Lt. & Rt.        |                                 | 78        | 32            | 53    |                | 40    |                                   | 61.5                            |                   |                |                            |       |               |                             | 32                      | 30    |
| 0+07 to 1+44                           | Lt.              |                                 |           |               |       |                |       |                                   |                                 | 60                | 60             |                            |       |               |                             |                         |       |
| 1+64 to 2+22                           | Lt.              | <del>50</del>                   | 58        |               |       | <del>20</del>  | 27    |                                   | 58                              | 58                | 20             | 20                         |       |               |                             |                         |       |
| 2+22 to 3+42 <sup>47</sup>             | Lt.              | <del>124</del>                  | 126       |               |       |                |       |                                   | <del>124</del>                  | 118               | 53             | 53                         |       |               |                             |                         |       |
| 3+42 to 3+62 <sup>67</sup>             | Lt.              |                                 |           | <del>20</del> | 20    |                |       |                                   |                                 |                   |                |                            | 12    | 2.61          |                             | <del>20</del>           | 20    |
| 3+62 to 5+36 <sup>67</sup>             | Lt.              | <del>330</del>                  | 254       |               |       | 34             | 122   |                                   | <del>186</del>                  | 221               | 80             | 80                         |       | 3.00          |                             |                         |       |
| 5+83 <sup>φ</sup> to 7+25 <sup>φ</sup> | Lt.              | <del>159</del>                  | 154       | <del>20</del> | 20    | <del>22</del>  | 29    |                                   | <del>166</del>                  | 147               | 83             | 83                         |       |               |                             |                         |       |
| 7+25 <sup>φ</sup> to 8+82 <sup>φ</sup> | Lt.              |                                 |           |               |       |                |       |                                   |                                 | 70                | 69             |                            |       |               |                             |                         |       |
| 3+32 to 4+72                           | Rt.              | <del>186</del>                  | 153       |               |       |                |       |                                   | <del>175</del>                  | 156               | <del>50</del>  | 56                         |       | 6             | 10.30                       |                         |       |
| 6+23 <sup>□</sup> to 7+45 <sup>□</sup> | Rt.              | <del>163</del>                  | 152       |               |       | 58             | 62    |                                   | <del>155</del>                  | 160               | <del>60</del>  | 60                         |       |               |                             |                         |       |
| 7+45 <sup>□</sup> to 7+65 <sup>□</sup> | Rt.              | <del>25</del>                   | 20        |               |       | 11             | 11    |                                   |                                 |                   |                |                            |       | 9             | 8.89<br>10.68               |                         |       |
| 7+65 <sup>□</sup> to 9+00 <sup>φ</sup> | Rt.              | <del>146</del>                  | 145       |               |       | 58             | 56    |                                   | <del>145</del>                  | 150               | 58             | 58                         |       | 5             | 10.0                        |                         |       |
| 9+29 Brown Ave.                        | Rt.<br>Lt. & Rt. | <del>10</del><br><del>140</del> | 10<br>150 |               |       | 4              | 4     |                                   | <del>10</del><br><del>144</del> | 10<br>151         | 14             | 14                         |       | 6             | 60.70                       |                         |       |
| 2±                                     | Lt.              |                                 |           |               |       |                |       |                                   |                                 |                   |                |                            |       |               |                             | 12'                     | 12'   |
| 4±                                     | Rt.              |                                 |           |               |       |                |       |                                   |                                 |                   |                |                            |       |               |                             | 12'                     | 12'   |
| 7±                                     | Lt. & Rt.        |                                 |           |               |       |                |       |                                   |                                 |                   |                |                            |       |               |                             | 20'                     | 20'   |
| Brown Ave. West                        | West             |                                 |           |               |       |                |       |                                   |                                 |                   |                |                            |       |               |                             | 24'                     | 24'   |
| Project Total                          |                  | <del>1340</del>                 | 1300'     | <del>72</del> | 93'   | <del>213</del> | 351'  |                                   | <del>1163</del>                 | 1232.5'           | <del>554</del> | 553'                       |       | <del>53</del> | 123.58<br><del>145.36</del> | <del>52</del>           | 50'   |
|  |                  | BK 2 P 9                        |           | BK 2 P 8      |       | BK 2 P 8       |       | BK 2 P 22                         |                                 | BK 2 P 21         |                | BK 2 P 18                  |       | BK 1, P 42-45 |                             | BK 2 P 22               |       |

- For Information Only.
- \* Detail on Sheet No. 2
- φ W.B. Stationing
- E.B. Stationing
- ⊕ Proj. Stationing


Preliminary Soil Survey:  
 Sample No. A 599  
 Project No. T 7300(3)

| FEDERAL ROAD REGION NO. | DIVISION | PROJ. NO. | SHEET NO. | TOTAL SHEETS |
|-------------------------|----------|-----------|-----------|--------------|
| 9                       | Highways | T 7300(3) | 8         |              |

Scale: 1" = 20'

 New Sidewalk  
 Curb & Gutter  
 Painted Median

Survey Book No.s 31430 & 31467

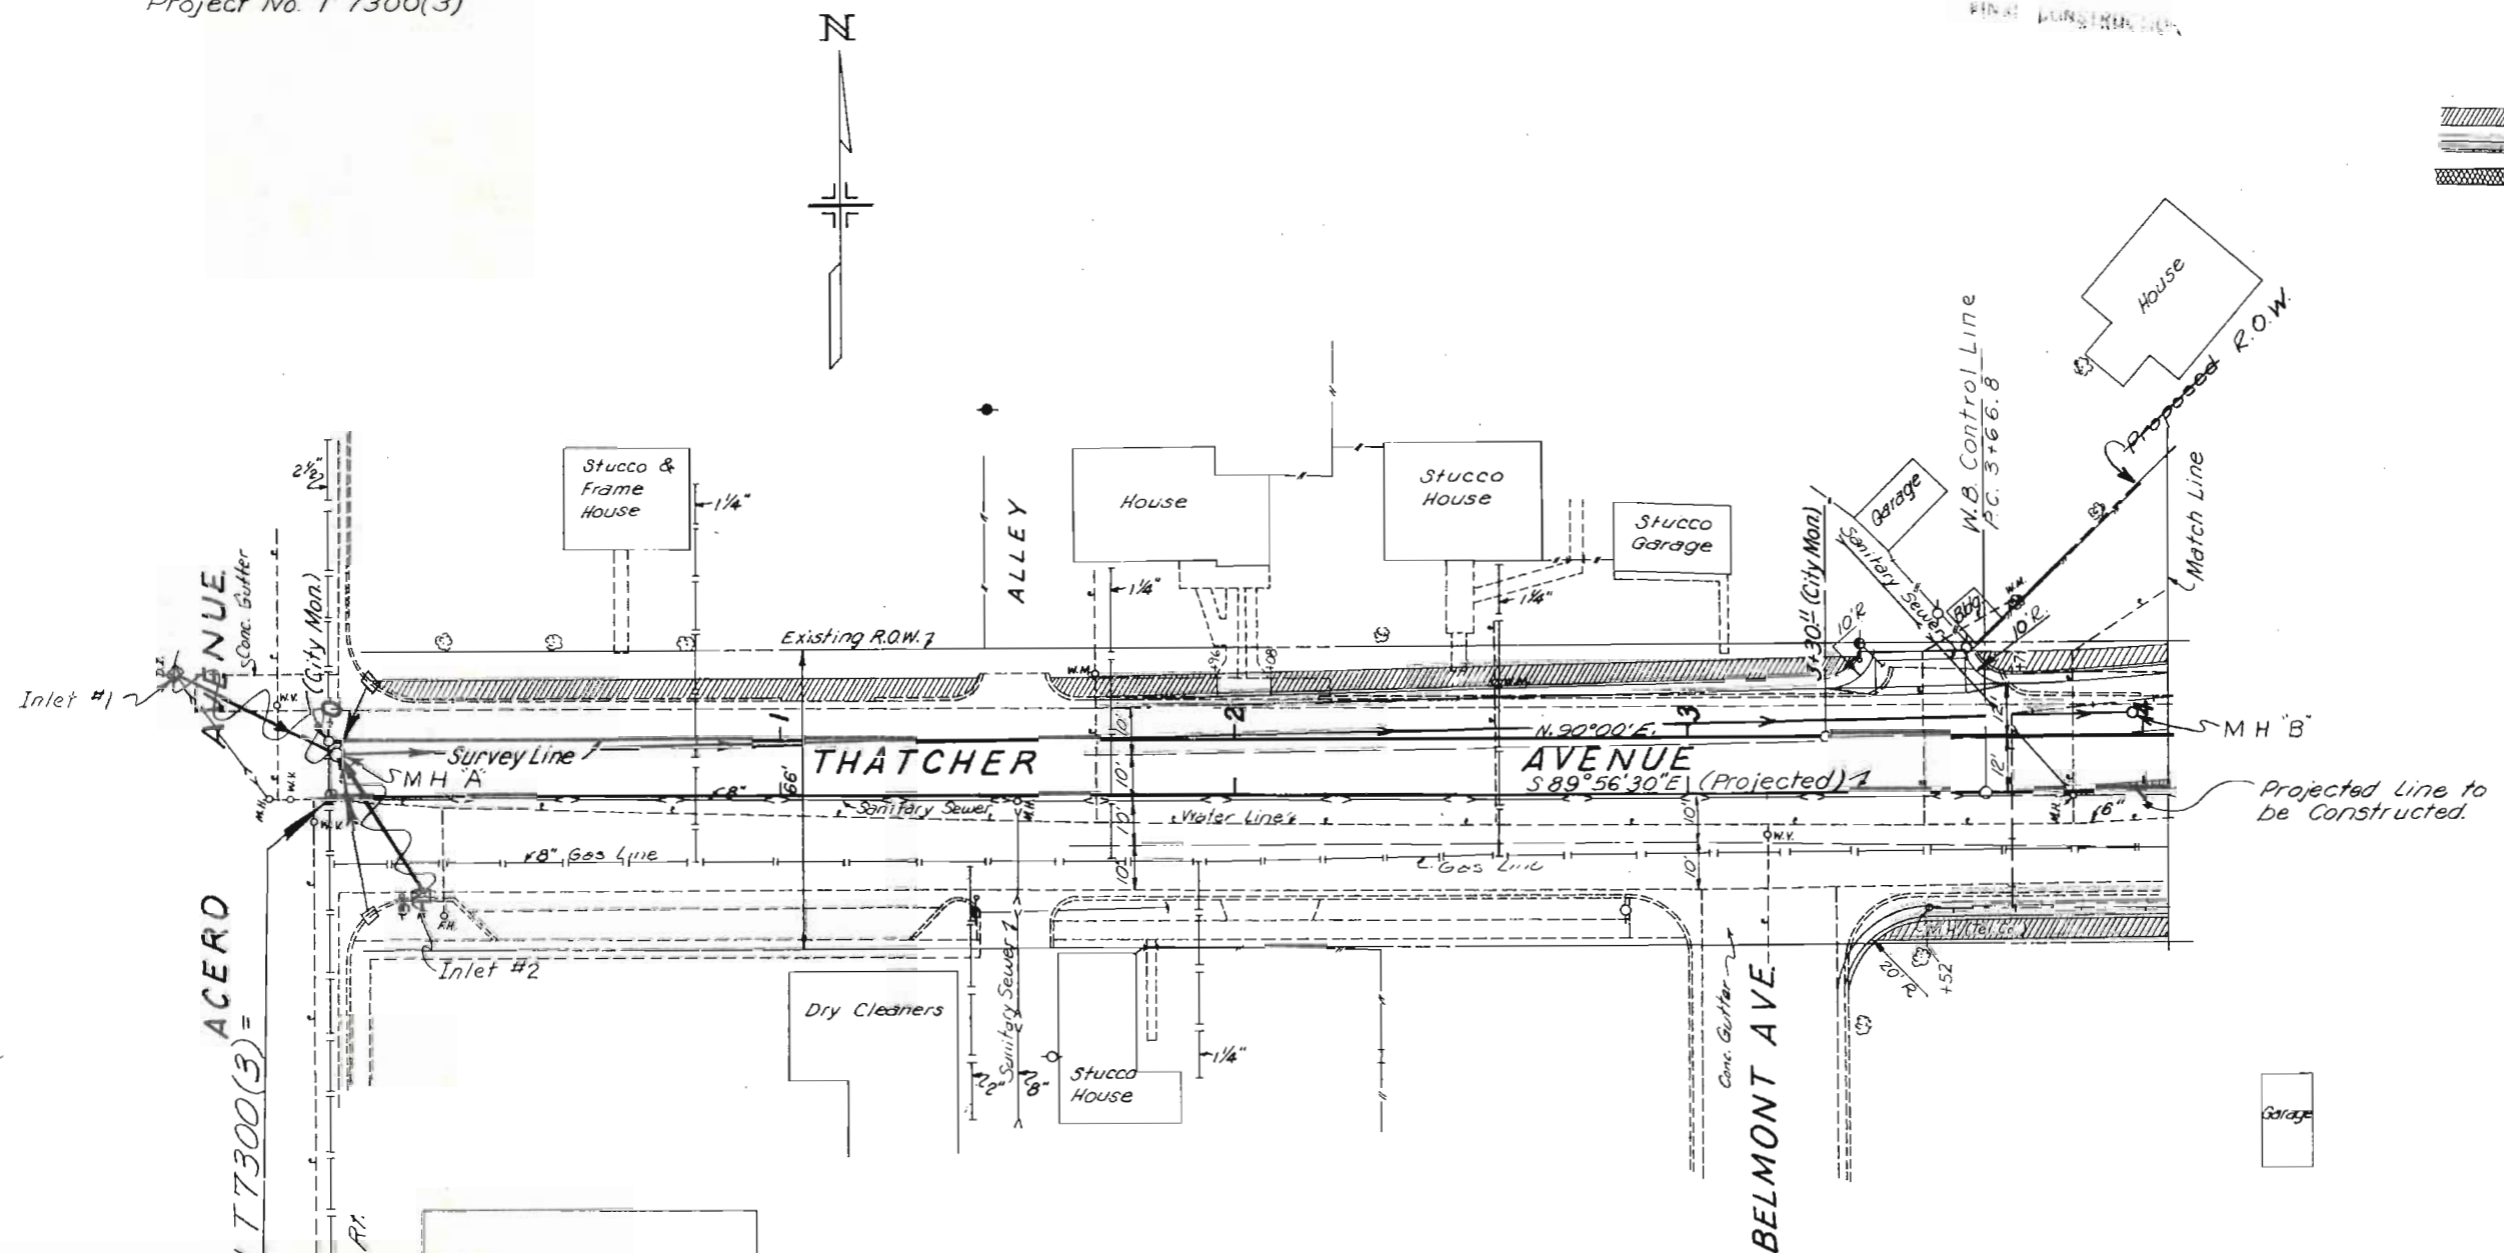




UTILITY OWNERSHIP

- City of Pueblo - Sanitary Sewer Lines  
 Water Lines
- Mountain Bell - Telephone Poles and  
 Buried Cable
- Southern Colorado Power Co. - Power Poles
- Pueblo Gas & Fuel Co. - Gas Lines

STA. 0+00.0 (PROJ.) BEGIN T 7300(3) =  
 12.0' Rt. Sta. 0+00.0 Surv.  
 0+00 ~ Reg'd Identification Sign, Rt.  
 (State Forces)


DATE  
 11-19-71  
 FINAL INSTRUMENT

| FEDERAL ROAD REGION NO. | DIVISION | PROJ. NO. | SHEET NO. | TOTAL SHEETS |
|-------------------------|----------|-----------|-----------|--------------|
| 9                       | COLORADO | T 7300(3) | 9         |              |

Scale: 1" = 20'  
 New Sidewalk  
 Curb & Gutter  
 Painted Median

AS CONSTRUCTED  
 REVIEWED BY 11-19-71  
 FINAL CONSTRUCTION

STA. 8+95.0 (Proj.) END T 7300(3) =  
 27.3' Lt. Sta. 9+22.4 Survey

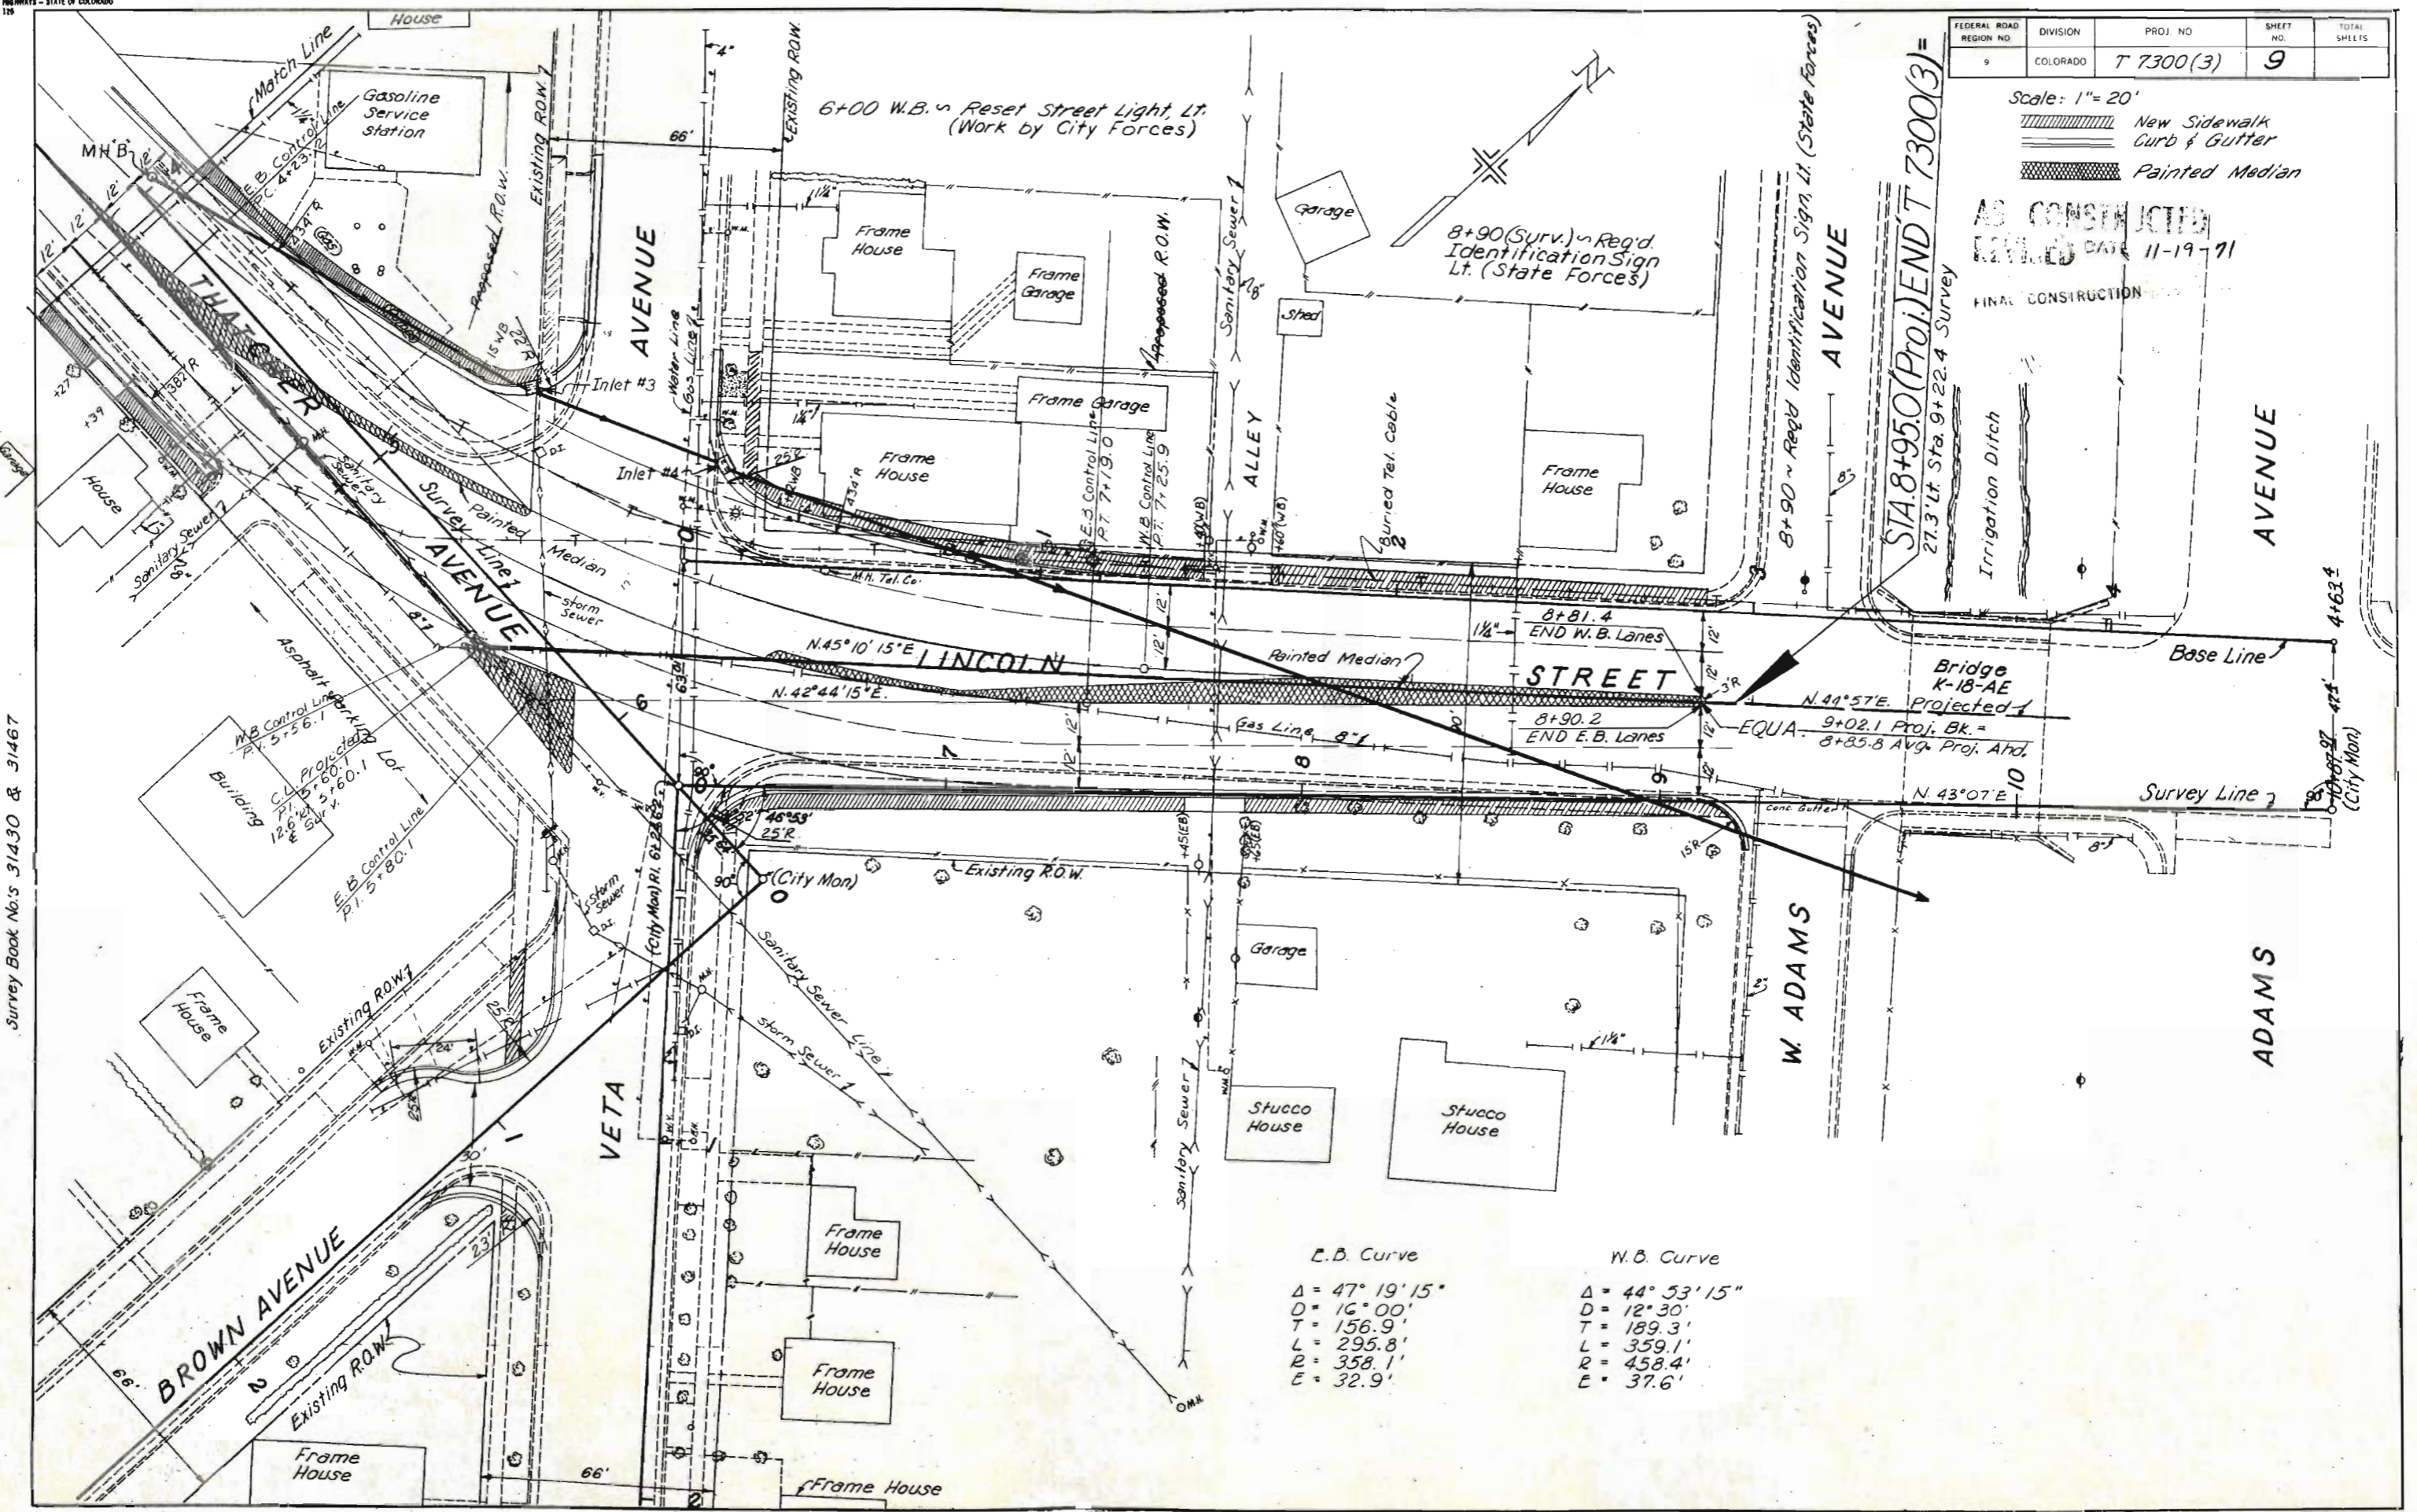

| E.B. Curve      | W.B. Curve      |
|-----------------|-----------------|
| Δ = 47° 19' 15" | Δ = 44° 53' 15" |
| D = 16' 00"     | D = 12' 30"     |
| T = 156.9'      | T = 189.3'      |
| L = 295.8'      | L = 359.1'      |
| R = 358.1'      | R = 458.4'      |
| E = 32.9'       | E = 37.6'       |

Survey Book No.s 31430 & 31467




|                           |          |           |          |              |
|---------------------------|----------|-----------|----------|--------------|
| FEDERAL ROAD DISTRICT NO. | DIVISION | PROJ NO   | SHEET NO | TOTAL SHEETS |
|                           | COLORADO | T 7300(3) | 11       |              |

(R-1) 7-22-71 Rev. Pipe T.A.L.  
**AS CONSTRUCTED**  
 REVISED DATE 11-19-71  
 FINAL CONSTRUCTION

**DRAINAGE PLAN & PROFILE**

|             |      |
|-------------|------|
| PLAN        | DATE |
| NOV 20 1971 |      |
| NOV 20 1971 |      |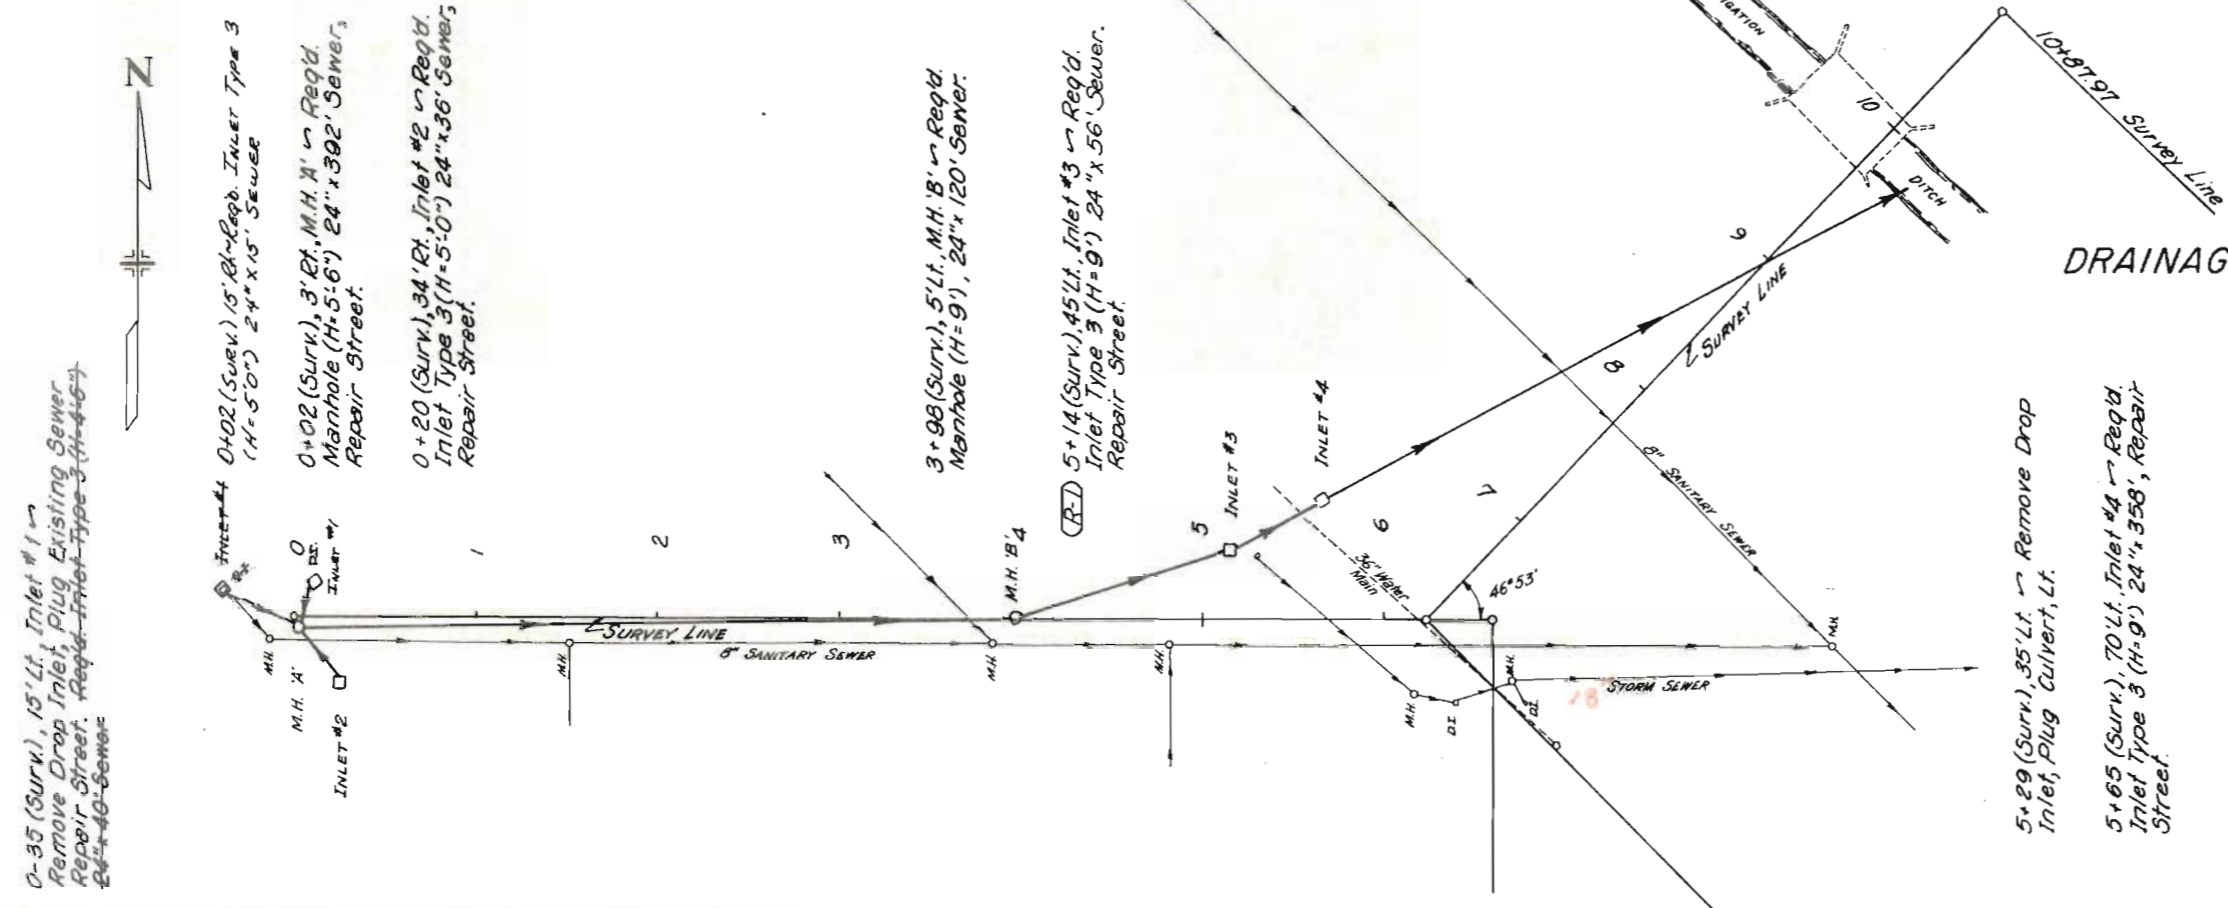
0-35 (SURV.) 15' Lt. Inlet #1 - Remove Drop Inlet, Plug Existing Sewer Repair Street. Reg'd. Inlet Type 3 (H=4'-6") 24" x 48' Sewer


5+29 (SURV.) 35' Lt. - Remove Drop Inlet, Plug Culvert, Lt.  
 5+65 (SURV.) 70' Lt. Inlet #4 - Reg'd. Inlet Type 3 (H=9') 24" x 358', Repair Street.

|             |      |
|-------------|------|
| PROFILE     | DATE |
| NOV 20 1971 |      |
| NOV 20 1971 |      |
**NEW STORM SEWER PROFILE**

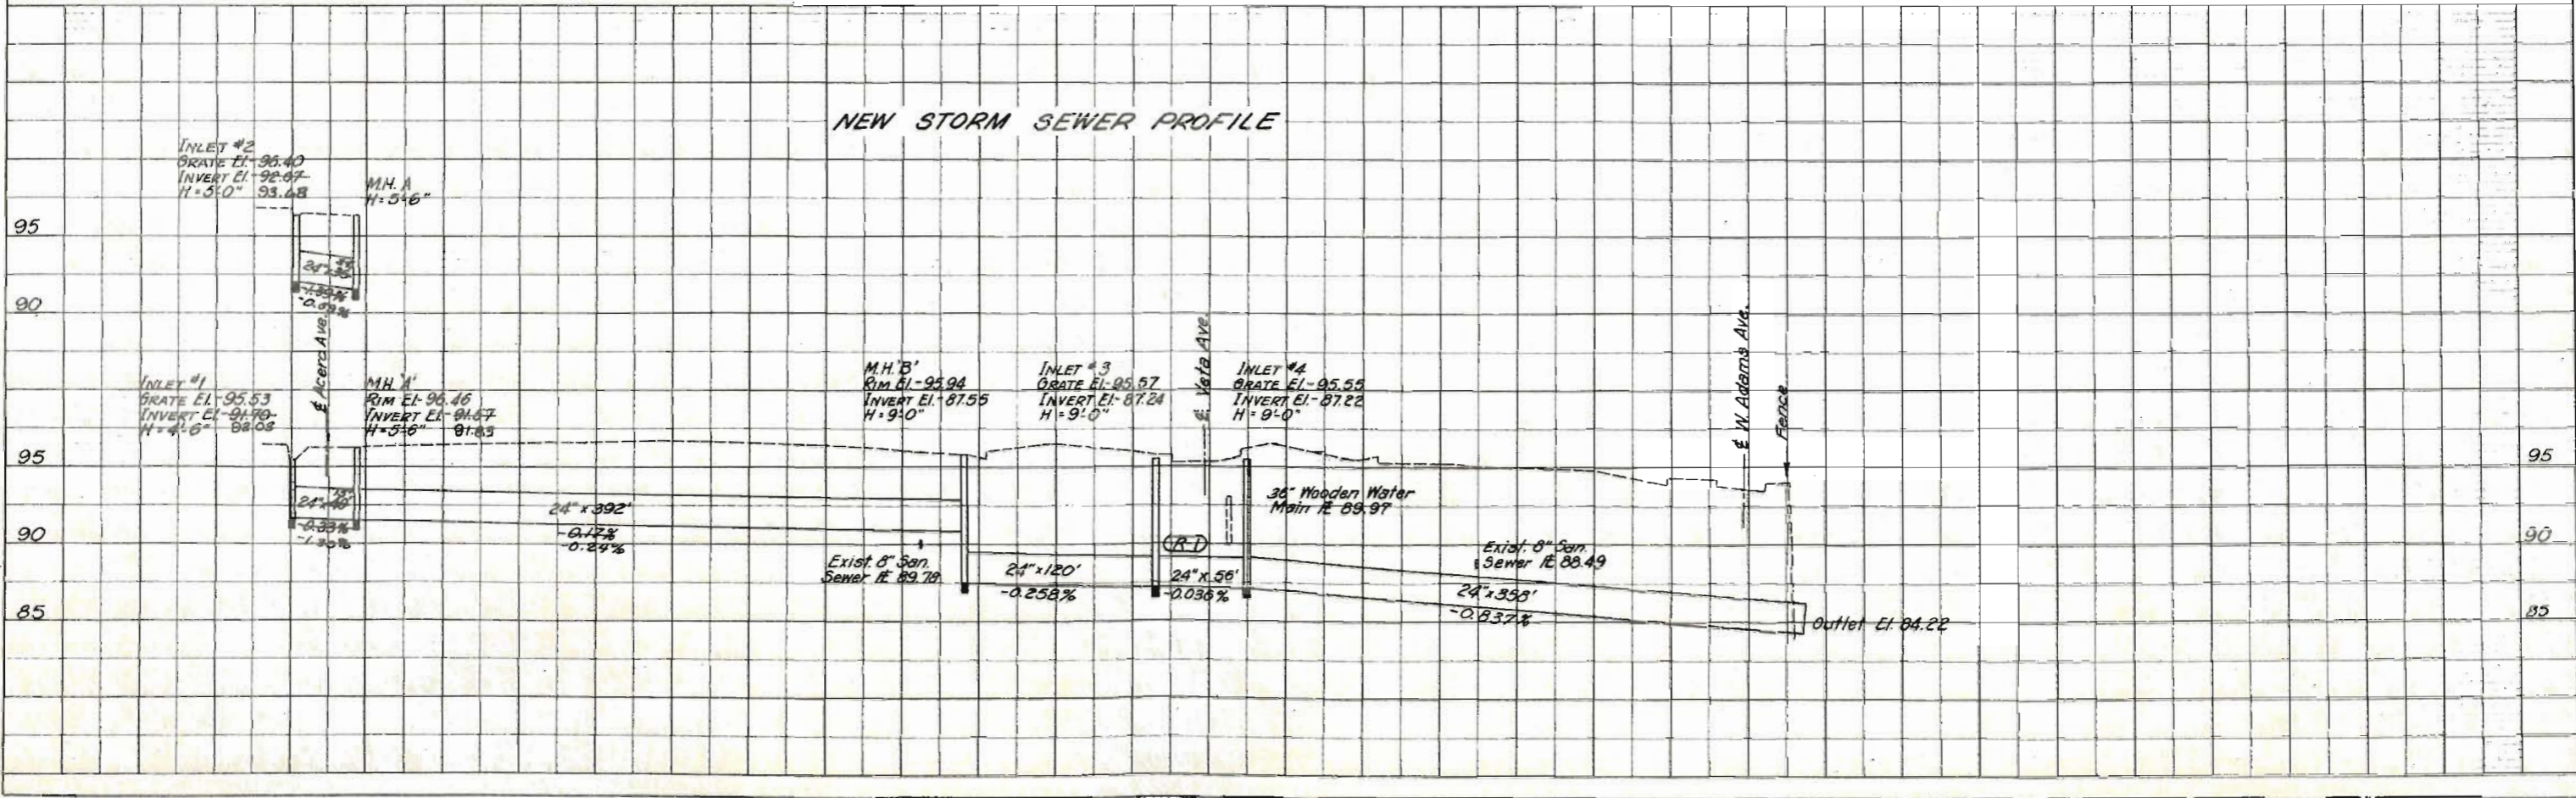

| REGION NO. | DIVISION | PROJECT NO. | SHEET NO. | TOTAL SHEETS |
|------------|----------|-------------|-----------|--------------|
| 8          | COLORADO | F 7300(3)   | 12        |              |

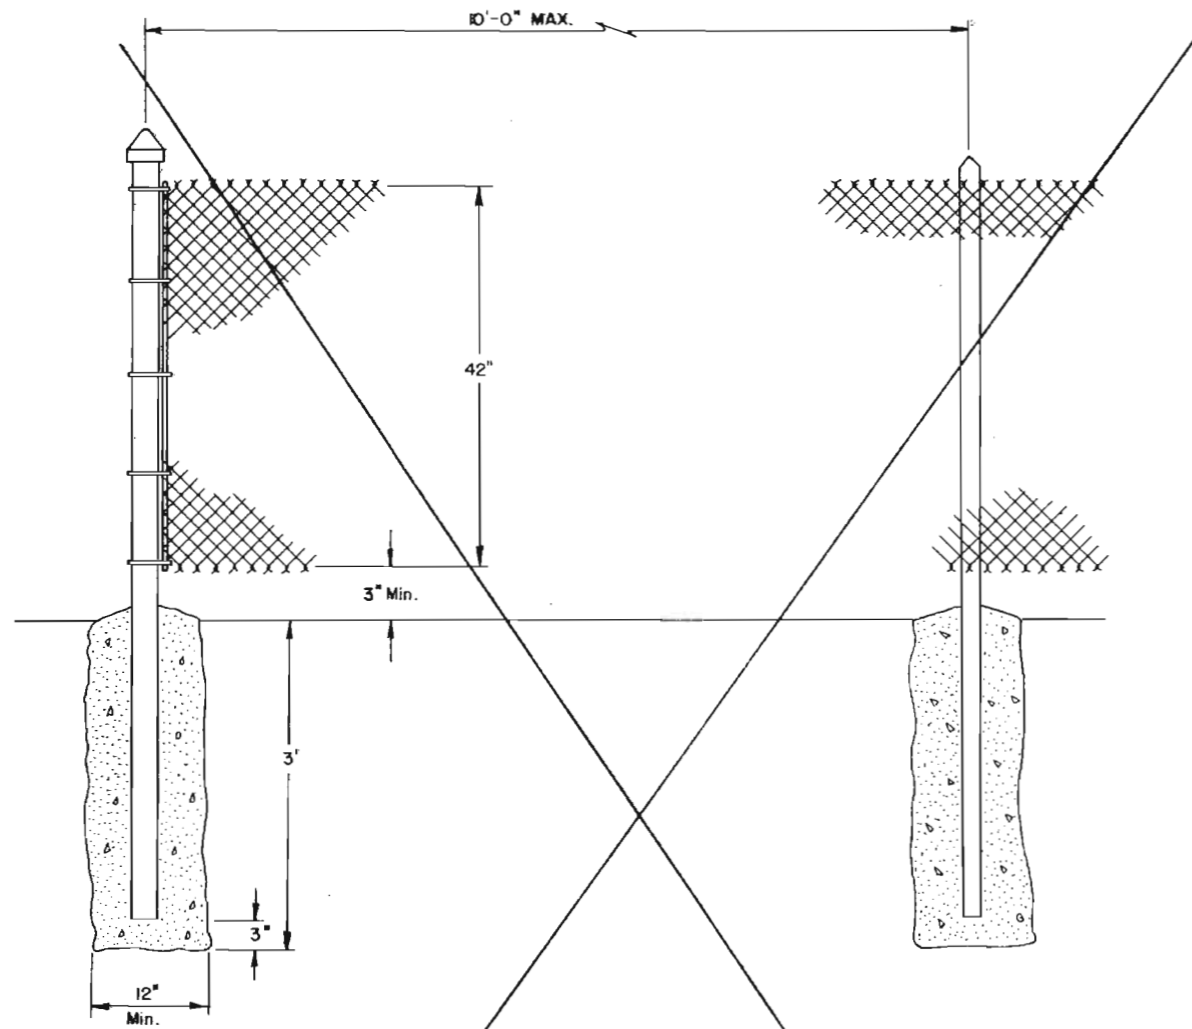

DETAIL OF CHAIN LINK FENCE

GENERAL NOTES


CHAIN LINK FABRIC SHALL BE NO. 9 GAGE WIRE SECURELY FASTENED TO ALL LINE POSTS WITH NO. 7 (B & S) GAGE ALUMINUM WIRE AND/OR NO. 12-1/2 (W & R) GAGE GALVANIZED STEEL WIRE SPACED AT A MINIMUM OF ONE PER FOOT VERTICALLY. SUITABLE ATTACHMENT BANDS SHALL BE USED ON ALL END POSTS AND STRETCHER BARS.

CONCRETE FOOTINGS:

(ALL POSTS) TO BE CONSTRUCTED OF CLASS "A" OR CLASS "B" CONCRETE WITH CROWNED TOPS.


LINE POSTS:

TO BE CONSTRUCTED OF 2.25" BY 1.95" H-BEAM WEIGHING 4.0 LBS. PER LIN. FT. MINIMUM OR 2" I.D. STANDARD GALVANIZED PIPE, 3.65 LBS. PER LIN. FT.

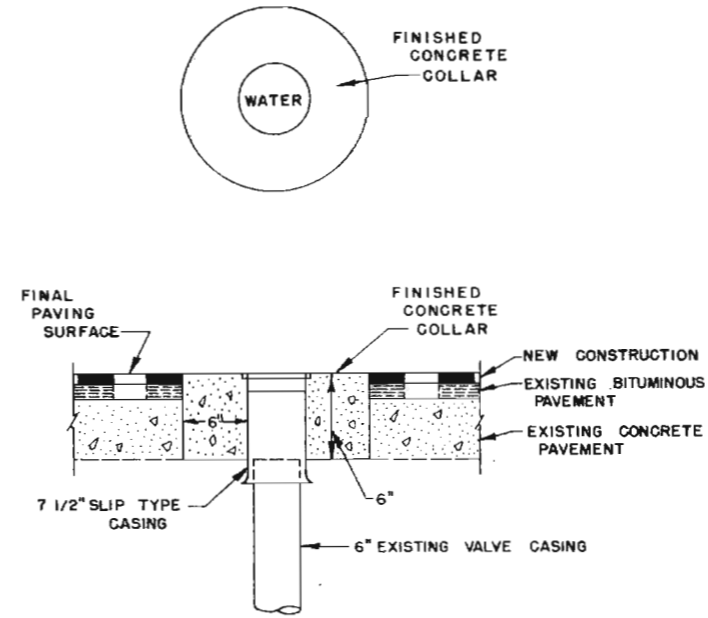


DETAIL OF  
 ADJUST VALVE BOX

CONCRETE BOX CULVERTS & WINGWALLS

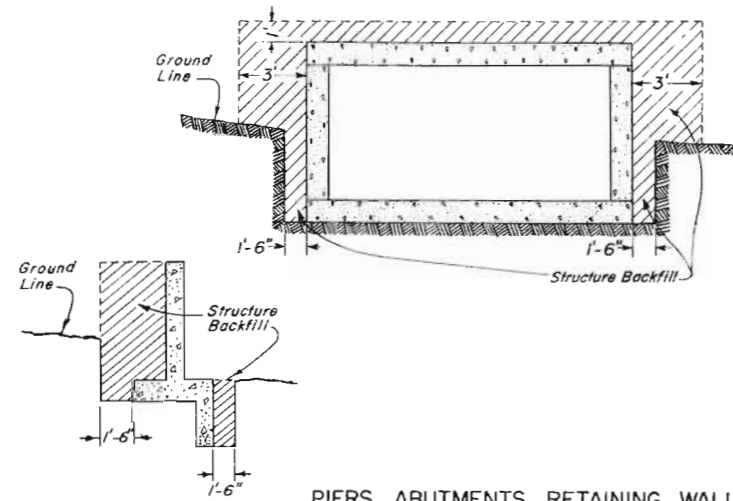


PIERS, ABUTMENTS, RETAINING WALLS ETC.

All material that is to be compacted shall be placed in horizontal layers not more than 6 inches in depth and compacted before the next layer is placed. For Arches, Rigid Frames and Box Culverts the fill shall be brought up uniformly on both sides of the center of structure to avoid stresses in the structure caused by unsymmetrical loading.

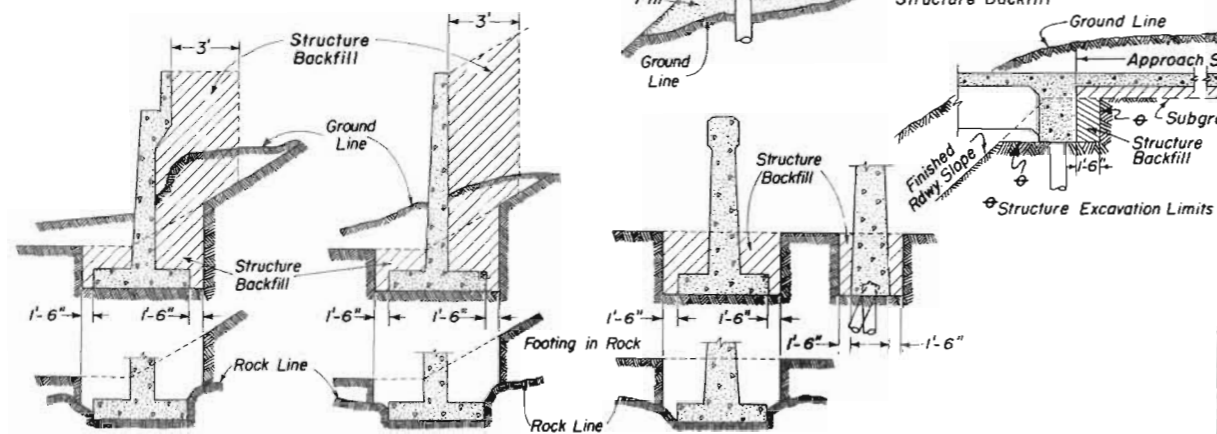


DROP INLETS, DIVISION BOXES, INTERCEPTING HEADWALLS, ETC.

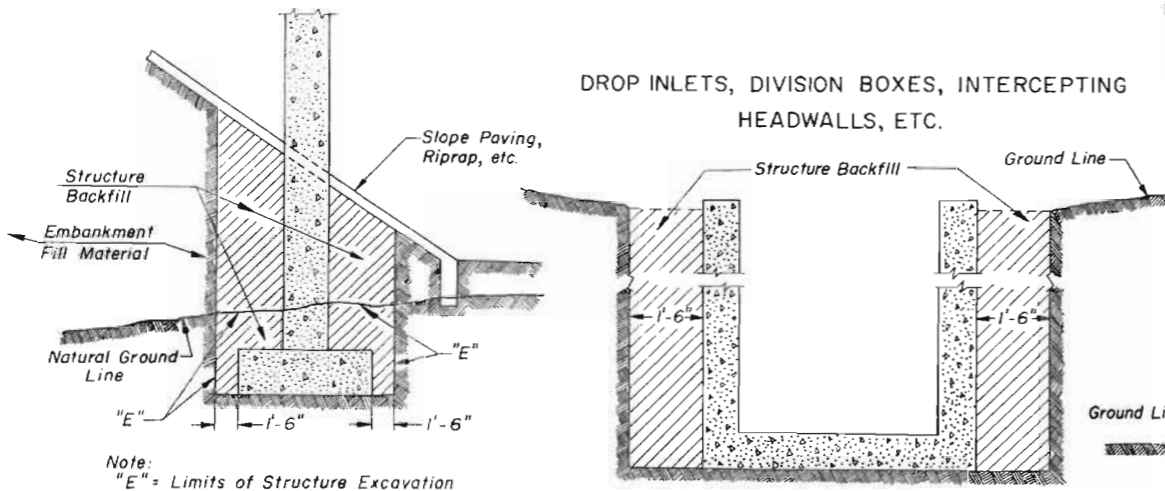

Note: "E" = Limits of Structure Excavation

CAST IN PLACE CONDUIT

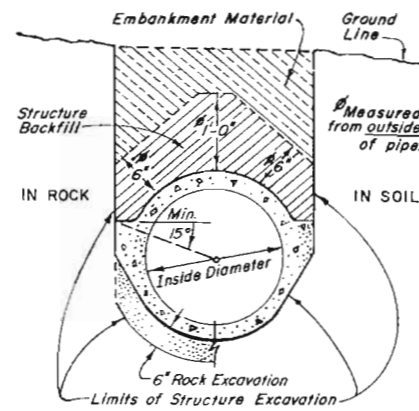


STANDARD M-206-AA

(MARCH 1, 1971)  
(SHEET 1 OF 2)


|                      |          |             |           |
|----------------------|----------|-------------|-----------|
| FED. ROAD REGION NO. | DIVISION | PROJECT NO. | SHEET NO. |
| 9                    | COLO.    |             |           |

| REVISION |  |
|----------|--|
|          |  |
|          |  |

CIRCULAR CONDUIT

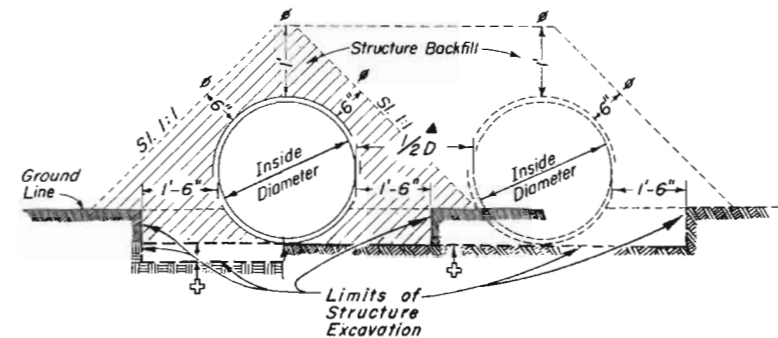

ELLIPTICAL OR ARCH CONDUIT

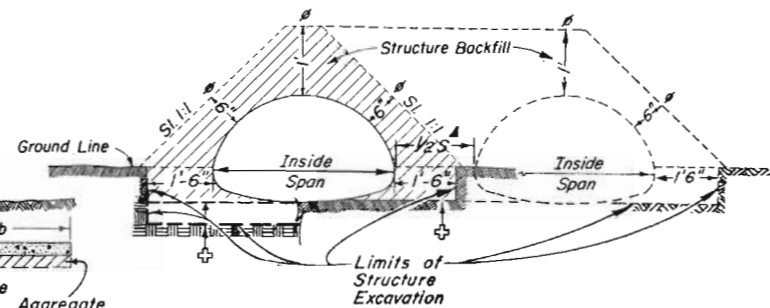

SIPHONS OR CONDUIT IN TRENCH

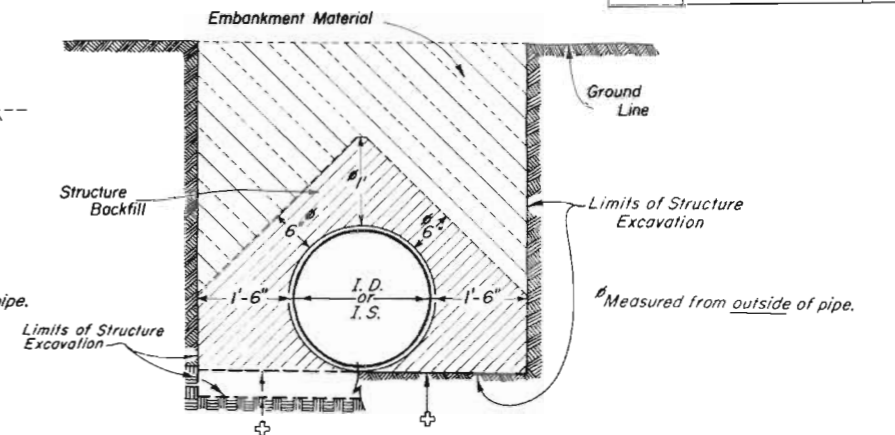

NOTES:

- ▲ When two or more conduits are laid side by side they shall be spaced so that the adjacent pipes will be 1/2 I.D., 1/2 I.S. or 3 feet apart (including wall thickness, whichever is less. Minimum spacing shall be not less than 1 foot between outside walls of pipe. For additional conduit installation details see M Standards for metal, concrete, or structural plate pipe culverts.
- ⊕ Bottom of trench as excavated. For applicable limits of Structure Excavation, see bedding details on standards for culverts.

GENERAL NOTES

All work shall be done according to the Standard Specifications applicable to the Project.


Where the roadway cross section is in fill, excavation for concrete footings (except those in rock or those on piles) and for box culverts shall be done according to the following:

Embankment shall be built up and compacted to a point one foot above the bottom of the box or one foot above the bottom of the footing. The trench shall then be excavated to accommodate construction of the box or footing.


Excavation and backfill patterns different from those indicated on these sheets will be shown elsewhere on the plans.

Excavation for structure installation shall be classified as "Structure Excavation" unless otherwise shown on plans.

HEADWALLS AND END OF CULVERTS

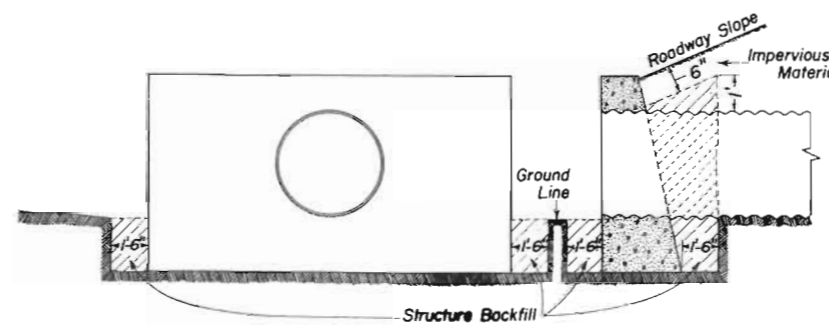

TRENCH FOR PIPE UNDERDRAIN

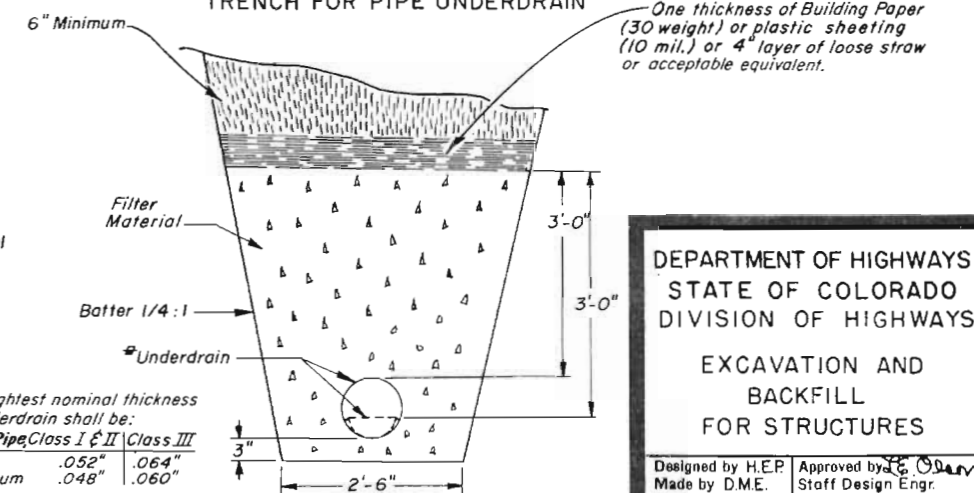

The lightest nominal thickness for underdrain shall be:  
Type III Pipe Class I & II Class III  
Steel .052" .064"  
Aluminum .048" .060"

DEPARTMENT OF HIGHWAYS  
STATE OF COLORADO  
DIVISION OF HIGHWAYS

EXCAVATION AND  
BACKFILL  
FOR STRUCTURES

Designed by H.E.P. Approved by E.C. Odum  
Made by D.M.E. Staff Design Engr.  
Checked by L.E.O. Date: March 1, 1971


# STANDARD M-206-AA

(MARCH 1, 1971)  
(SHEET 2)


| FEDERAL ROAD REGION NO. | DIVISION | PROJ. NO. | SHEET NO. | TOTAL SHEETS |
|-------------------------|----------|-----------|-----------|--------------|
| 9                       | COLORADO |           |           |              |

| REVISIONS: |  |
|------------|--|
|            |  |
|            |  |
|            |  |
|            |  |



## STRUCTURE EXCAVATION MEASUREMENT FOR PIPE CULVERTS

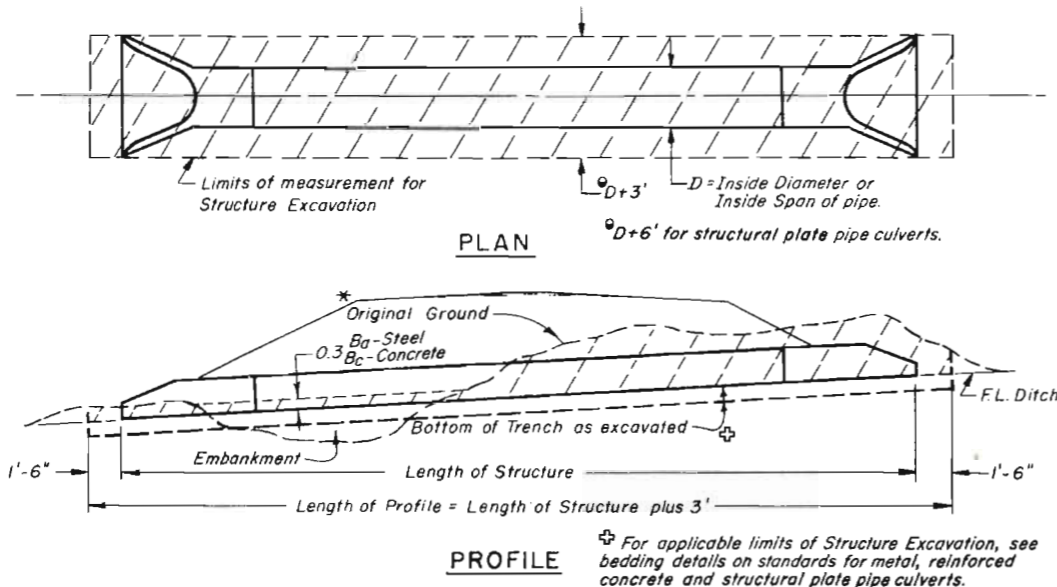

## STRUCTURE EXCAVATION MEASUREMENT FOR CONCRETE BOX CULVERTS

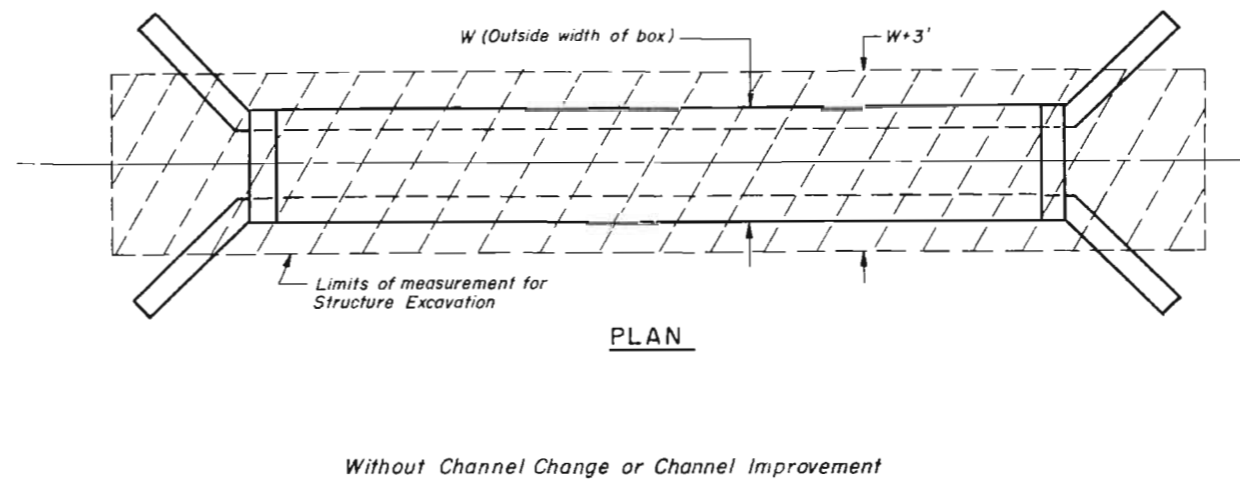

## STRUCTURE EXCAVATION MEASUREMENT FOR DIVERSION OR DIVISION BOXES

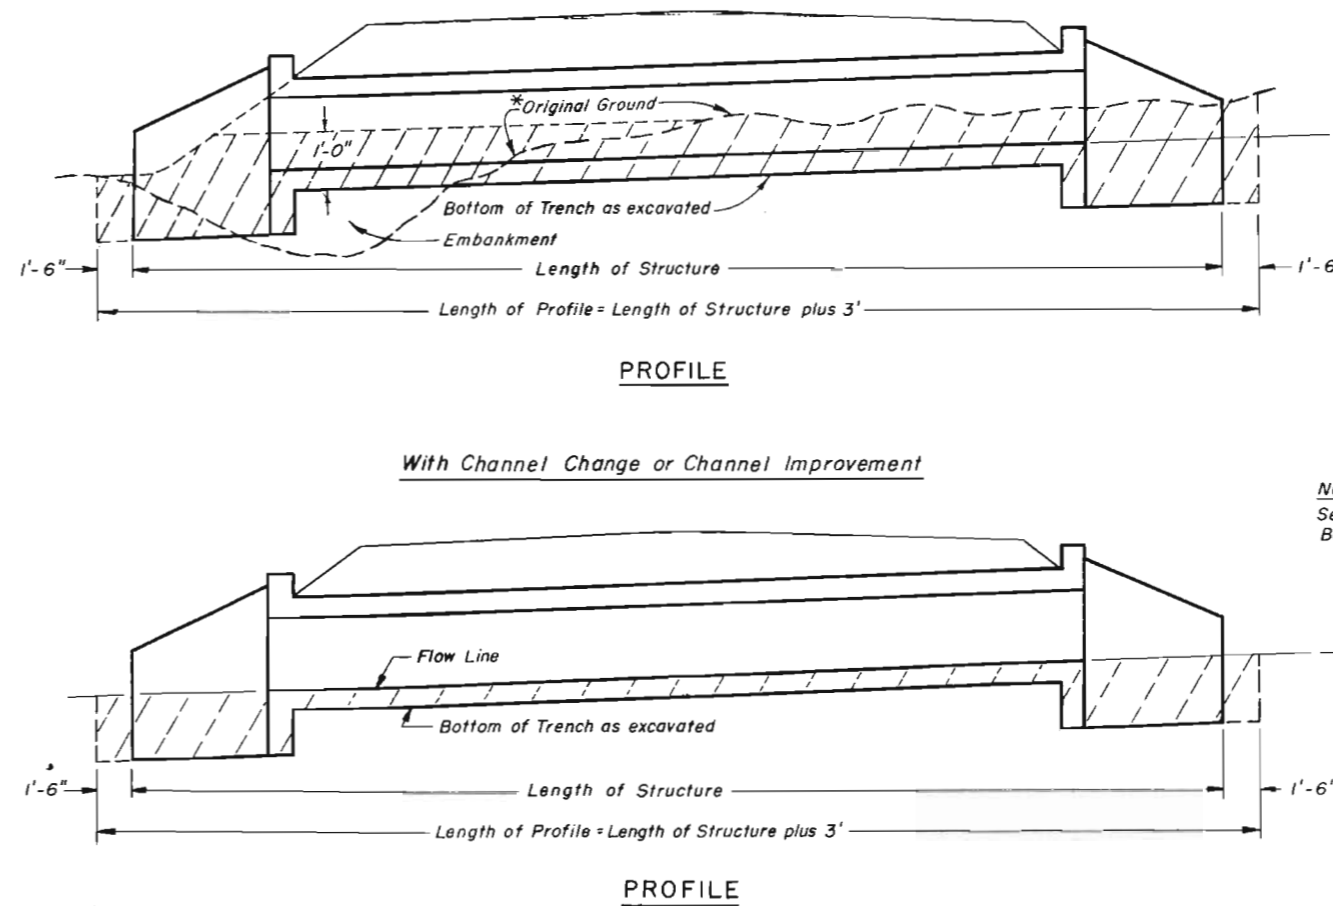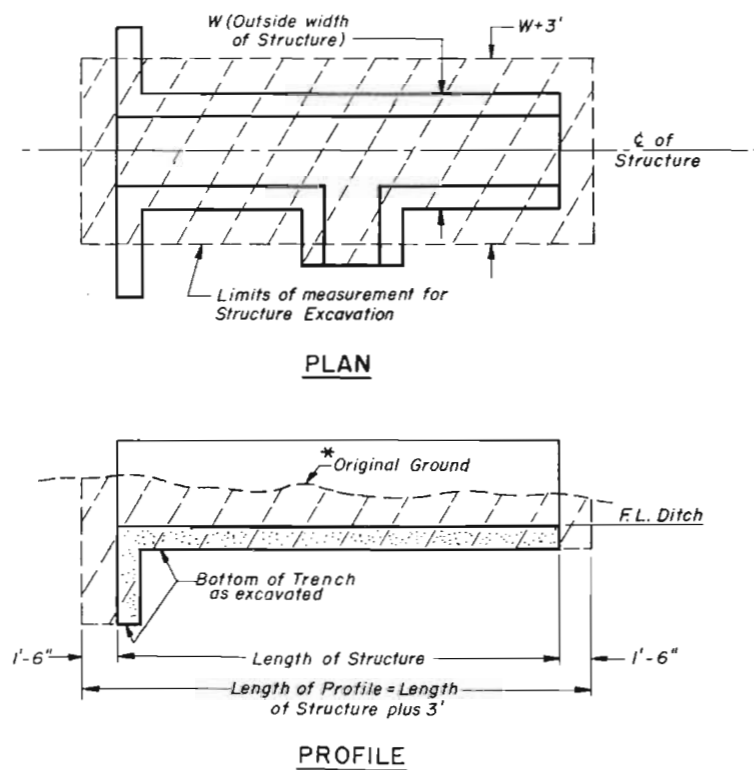

\* Along  $\bar{C}$  of Structure  
 Areas to be used for Structure Excavation computations.

NOTE:  
See Sheet 1 for General Notes and Backfilling Details.

DEPARTMENT OF HIGHWAYS  
 STATE OF COLORADO  
 DIVISION OF HIGHWAYS  
 EXCAVATION AND BACKFILL FOR STRUCTURES

Designed by: M.R.H. Approved by: *[Signature]*  
 Made by: H.P.B. Staff Design Engr.  
 Checked by: Date: March 1, 1971

# STANDARD M-603-M

(MARCH 20, 1967)

| FEDERAL ROAD REGION NO. | DIVISION | PROJ. NO. | SHEET NO. | TOTAL SHEETS |
|-------------------------|----------|-----------|-----------|--------------|
| 9                       | COLORADO |           |           |              |

| REVISIONS |         |                                  |  |        |
|-----------|---------|----------------------------------|--|--------|
| (R-1)     | 4-5-68  | Added notes.                     |  | M.R.H. |
| (R-2)     | 7-23-68 | Dept. Name & Ø Note              |  | M.R.H. |
| (R-3)     | 2-11-71 | Thickness Tables, General Notes. |  | M.R.H. |

## FILL HEIGHT & THICKNESS TABLES FOR METAL CULVERT PIPE (RIVETED, WELDED OR HELICAL FABRICATION)

**TABLE I**  
CORRUGATED STEEL PIPE

(2" x 1/2") OR (2-2/3" x 1/2") CORRUGATIONS


| PIPE SIZE (B <sub>0</sub> ) Inches | AREA (Sq.Ft.) | HEIGHT OF FILL OVER TOP OF PIPE IN FEET |           |           |           |           |           |           |           |           |           |           |           |           |           |            |      |      |  |
|------------------------------------|---------------|---|-----------|-----------|-----------|-----------|-----------|-----------|-----------|-----------|-----------|-----------|-----------|-----------|-----------|------------|------|------|--|
|                                    |               | 1 to 10                                 | 10+ to 15 | 15+ to 20 | 20+ to 25 | 25+ to 30 | 30+ to 35 | 35+ to 40 | 40+ to 45 | 45+ to 50 | 50+ to 55 | 55+ to 60 | 60+ to 70 | 70+ to 80 | 80+ to 90 | 90+ to 100 |      |      |  |
| 12                                 | 0.8           | THICKNESS IN INCHES                     |           |           |           |           |           |           |           |           |           |           |           |           |           |            |      |      |  |
| 15                                 | 1.2           | .064                                    | .064      | .064      | .064      | .064      | .064      | .064      | .064      | .064      | .064      | .064      | .064      | .064      | .064      | .064       | .064 | .064 |  |
| 18                                 | 1.8           | .064                                    | .064      | .064      | .064      | .064      | .064      | .064      | .064      | .064      | .064      | .064      | .064      | .064      | .064      | .064       | .064 | .064 |  |
| 24                                 | 3.1           | .064                                    | .064      | .064      | .064      | .064      | .064      | .064      | .064      | .064      | .064      | .064      | .064      | .064      | .064      | .064       | .064 | .064 |  |
| 30                                 | 4.9           | .064                                    | .064      | .064      | .064      | .064      | .064      | .064      | .064      | .064      | .064      | .064      | .064      | .064      | .064      | .064       | .064 | .064 |  |
| 36                                 | 7.1           | .064                                    | .064      | .064      | .064      | .064      | .064      | .064      | .064      | .064      | .064      | .064      | .064      | .064      | .064      | .064       | .064 | .064 |  |
| 42                                 | 9.6           | .064                                    | .064      | .064      | .064      | .064      | .064      | .064      | .064      | .064      | .064      | .064      | .064      | .064      | .064      | .064       | .064 | .064 |  |
| 48                                 | 12.6          | .064                                    | .064      | .064      | .064      | .064      | .064      | .064      | .064      | .064      | .064      | .064      | .064      | .064      | .064      | .064       | .064 | .064 |  |
| 54                                 | 15.9          | .064                                    | .064      | .064      | .064      | .064      | .064      | .064      | .064      | .064      | .064      | .064      | .064      | .064      | .064      | .064       | .064 | .064 |  |
| 60                                 | 19.6          | .064                                    | .064      | .064      | .064      | .064      | .064      | .064      | .064      | .064      | .064      | .064      | .064      | .064      | .064      | .064       | .064 | .064 |  |
| 66                                 | 23.8          | .064                                    | .064      | .064      | .064      | .064      | .064      | .064      | .064      | .064      | .064      | .064      | .064      | .064      | .064      | .064       | .064 | .064 |  |
| 72                                 | 28.3          | .064                                    | .064      | .064      | .064      | .064      | .064      | .064      | .064      | .064      | .064      | .064      | .064      | .064      | .064      | .064       | .064 | .064 |  |
| 78                                 | 33.0          | .064                                    | .064      | .064      | .064      | .064      | .064      | .064      | .064      | .064      | .064      | .064      | .064      | .064      | .064      | .064       | .064 | .064 |  |
| 84                                 | 38.0          | .064                                    | .064      | .064      | .064      | .064      | .064      | .064      | .064      | .064      | .064      | .064      | .064      | .064      | .064      | .064       | .064 | .064 |  |

**TABLE II**  
CORRUGATED STEEL PIPE ARCH


(2" x 1/2") OR (2-2/3" x 1/2") CORRUGATIONS

| PIPE SIZE (B <sub>0</sub> ) Inches | AREA (Sq.Ft.) | CORNER RADIUS (Inches) | HEIGHT OF FILL OVER TOP OF PIPE IN FEET |         |         |          |           |           |      |      |      |  |
|------------------------------------|---------------|------------------------|---|---------|---------|----------|-----------|-----------|------|------|------|--|
|                                    |               |                        | 1.5 to 7                                | 7+ to 8 | 8+ to 9 | 9+ to 10 | 10+ to 12 | 12+ to 13 |      |      |      |  |
| 18 x 11                            | 1.1           | 3 1/2                  | .064                                    | .064    | .064    | .064     | .064      | .064      | .064 | .064 | .064 |  |
| 22 x 13                            | 1.6           | 4                      | .064                                    | .064    | .064    | .064     | .064      | .064      | .064 | .064 | .064 |  |
| 25 x 16                            | 2.2           | 4                      | .064                                    | .064    | .064    | .064     | .064      | .064      | .064 | .064 | .064 |  |
| 29 x 18                            | 2.8           | 4 1/2                  | .064                                    | .064    | .064    | .064     | .064      | .064      | .064 | .064 | .064 |  |
| 36 x 22                            | 4.4           | 5                      | .064                                    | .064    | .064    | .064     | .064      | .064      | .064 | .064 | .064 |  |
| 43 x 27                            | 6.4           | 5 1/2                  | .064                                    | .064    | .064    | .064     | .064      | .064      | .064 | .064 | .064 |  |
| 50 x 31                            | 8.7           | 6                      | .064                                    | .064    | .064    | .064     | .064      | .064      | .064 | .064 | .064 |  |
| 58 x 36                            | 11.4          | 7                      | .064                                    | .064    | .064    | .064     | .064      | .064      | .064 | .064 | .064 |  |
| 65 x 40                            | 14.3          | 8                      | .064                                    | .064    | .064    | .064     | .064      | .064      | .064 | .064 | .064 |  |
| 72 x 44                            | 17.6          | 9                      | .064                                    | .064    | .064    | .064     | .064      | .064      | .064 | .064 | .064 |  |

**METAL CULVERT WITH END SECTIONS**

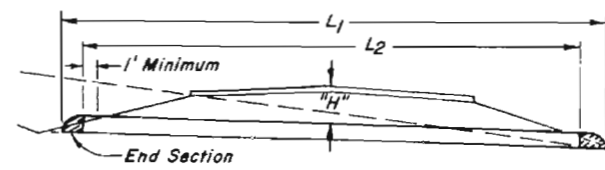

**METAL CULVERT WITHOUT END SECTIONS**

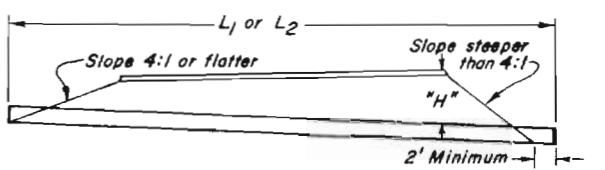

"H" = Maximum height of fill over top of Culvert, including pavement.

L<sub>1</sub> = Length of Culvert to be measured when placed in accordance with Section 617.

L<sub>2</sub> = Length of pipe to be measured when placed in accordance with Section 603.

(R-1) Length of extension, when placed in accordance with Section 617, shall be the actual number of feet of new culvert required.

**TABLE III**  
CORRUGATED STEEL PIPE

3" x 1" CORRUGATIONS  
RIVETED OR HELICAL FABRICATION

| PIPE SIZE (B <sub>0</sub> ) Inches | AREA (Sq.Ft.) | HEIGHT OF FILL OVER TOP OF PIPE IN FEET |           |           |           |           |           |           |           |           |           |           |           |           |  |
|------------------------------------|---------------|---|-----------|-----------|-----------|-----------|-----------|-----------|-----------|-----------|-----------|-----------|-----------|-----------|--|
|                                    |               | 1 to 10                                 | 10+ to 15 | 15+ to 20 | 20+ to 25 | 25+ to 30 | 30+ to 35 | 35+ to 40 | 40+ to 45 | 45+ to 50 | 50+ to 55 | 55+ to 60 | 60+ to 70 | 70+ to 80 |  |
| 36                                 | 7.1           | .064                                    | .064      | .064      | .064      | .064      | .064      | .064      | .064      | .064      | .064      | .064      | .064      | .064      |  |
| 42                                 | 9.6           | .064                                    | .064      | .064      | .064      | .064      | .064      | .064      | .064      | .064      | .064      | .064      | .064      | .064      |  |
| 48                                 | 12.6          | .064                                    | .064      | .064      | .064      | .064      | .064      | .064      | .064      | .064      | .064      | .064      | .064      | .064      |  |
| 54                                 | 15.9          | .064                                    | .064      | .064      | .064      | .064      | .064      | .064      | .064      | .064      | .064      | .064      | .064      | .064      |  |
| 60                                 | 19.6          | .064                                    | .064      | .064      | .064      | .064      | .064      | .064      | .064      | .064      | .064      | .064      | .064      | .064      |  |
| 66                                 | 23.8          | .064                                    | .064      | .064      | .064      | .064      | .064      | .064      | .064      | .064      | .064      | .064      | .064      | .064      |  |
| 72                                 | 28.3          | .064                                    | .064      | .064      | .064      | .064      | .064      | .064      | .064      | .064      | .064      | .064      | .064      | .064      |  |
| 78                                 | 33.0          | .064                                    | .064      | .064      | .064      | .064      | .064      | .064      | .064      | .064      | .064      | .064      | .064      | .064      |  |
| 84                                 | 38.0          | .064                                    | .064      | .064      | .064      | .064      | .064      | .064      | .064      | .064      | .064      | .064      | .064      | .064      |  |
| 90                                 | 44.0          | .064                                    | .064      | .064      | .064      | .064      | .064      | .064      | .064      | .064      | .064      | .064      | .064      | .064      |  |
| 96                                 | 50.3          | .064                                    | .064      | .064      | .064      | .064      | .064      | .064      | .064      | .064      | .064      | .064      | .064      | .064      |  |
| 102                                | 57.0          | .064                                    | .064      | .064      | .064      | .064      | .064      | .064      | .064      | .064      | .064      | .064      | .064      | .064      |  |
| 108                                | 64.0          | .064                                    | .064      | .064      | .064      | .064      | .064      | .064      | .064      | .064      | .064      | .064      | .064      | .064      |  |
| 114                                | 70.9          | .064                                    | .064      | .064      | .064      | .064      | .064      | .064      | .064      | .064      | .064      | .064      | .064      | .064      |  |
| 120                                | 78.6          | .064                                    | .064      | .064      | .064      | .064      | .064      | .064      | .064      | .064      | .064      | .064      | .064      | .064      |  |

**TABLE IV**  
CORRUGATED STEEL PIPE

3" x 1" CORRUGATIONS  
\* SPOT WELDED OR BOLTED (1/2" ASTM A 325 BOLTS) FABRICATION


| PIPE SIZE (B <sub>0</sub> ) Inches | AREA (Sq.Ft.) | HEIGHT OF FILL OVER TOP OF PIPE IN FEET |           |           |           |           |           |           |           |           |           |           |           |           |           |
|------------------------------------|---------------|---|-----------|-----------|-----------|-----------|-----------|-----------|-----------|-----------|-----------|-----------|-----------|-----------|-----------|
|                                    |               | 1 to 10                                 | 10+ to 15 | 15+ to 20 | 20+ to 25 | 25+ to 30 | 30+ to 35 | 35+ to 40 | 40+ to 45 | 45+ to 50 | 50+ to 55 | 55+ to 60 | 60+ to 70 | 70+ to 80 | 80+ to 90 |
| 36                                 | 7.1           | .064                                    | .064      | .064      | .064      | .064      | .064      | .064      | .064      | .064      | .064      | .064      | .064      | .064      | .064      |
| 42                                 | 9.6           | .064                                    | .064      | .064      | .064      | .064      | .064      | .064      | .064      | .064      | .064      | .064      | .064      | .064      | .064      |
| 48                                 | 12.6          | .064                                    | .064      | .064      | .064      | .064      | .064      | .064      | .064      | .064      | .064      | .064      | .064      | .064      | .064      |
| 54                                 | 15.9          | .064                                    | .064      | .064      | .064      | .064      | .064      | .064      | .064      | .064      | .064      | .064      | .064      | .064      | .064      |
| 60                                 | 19.6          | .064                                    | .064      | .064      | .064      | .064      | .064      | .064      | .064      | .064      | .064      | .064      | .064      | .064      | .064      |
| 66                                 | 23.8          | .064                                    | .064      | .064      | .064      | .064      | .064      | .064      | .064      | .064      | .064      | .064      | .064      | .064      | .064      |
| 72                                 | 28.3          | .064                                    | .064      | .064      | .064      | .064      | .064      | .064      | .064      | .064      | .064      | .064      | .064      | .064      | .064      |
| 78                                 | 33.0          | .064                                    | .064      | .064      | .064      | .064      | .064      | .064      | .064      | .064      | .064      | .064      | .064      | .064      | .064      |
| 84                                 | 38.0          | .064                                    | .064      | .064      | .064      | .064      | .064      | .064      | .064      | .064      | .064      | .064      | .064      | .064      | .064      |
| 90                                 | 44.0          | .064                                    | .064      | .064      | .064      | .064      | .064      | .064      | .064      | .064      | .064      | .064      | .064      | .064      | .064      |
| 96                                 | 50.3          | .064                                    | .064      | .064      | .064      | .064      | .064      | .064      | .064      | .064      | .064      | .064      | .064      | .064      | .064      |
| 102                                | 57.0          | .064                                    | .064      | .064      | .064      | .064      | .064      | .064      | .064      | .064      | .064      | .064      | .064      | .064      | .064      |
| 108                                | 64.0          | .064                                    | .064      | .064      | .064      | .064      | .064      | .064      | .064      | .064      | .064      | .064      | .064      | .064      | .064      |
| 114                                | 70.9          | .064                                    | .064      | .064      | .064      | .064      | .064      | .064      | .064      | .064      | .064      | .064      | .064      | .064      | .064      |
| 120                                | 78.6          | .064                                    | .064      | .064      | .064      | .064      | .064      | .064      | .064      | .064      | .064      | .064      | .064      | .064      | .064      |

**TABLE V**  
CORRUGATED STEEL PIPE ARCH

3" x 1" CORRUGATIONS

| PIPE SIZE (B <sub>0</sub> ) Inches | AREA (Sq.Ft.) | CORNER RADIUS (Inches) | HEIGHT OF FILL OVER TOP OF PIPE IN FEET |           |           |           |           |      |      |      |  |  |
|------------------------------------|---------------|------------------------|---|-----------|-----------|-----------|-----------|------|------|------|--|--|
|                                    |               |                        | 1.5 to 10                               | 10+ to 11 | 11+ to 12 | 12+ to 14 | 14+ to 15 |      |      |      |  |  |
| 43 x 27                            | 6.4           | 7 3/4                  | .064                                    | .064      | .064      | .064      | .064      | .064 | .064 | .064 |  |  |
| 50 x 31                            | 8.7           | 9                      | .064                                    | .064      | .064      | .064      | .064      | .064 | .064 | .064 |  |  |
| 58 x 36                            | 11.4          | 10 1/2                 | .064                                    | .064      | .064      | .064      | .064      | .064 | .064 | .064 |  |  |
| 65 x 40                            | 14.3          | 12                     | .064                                    | .064      | .064      | .064      | .064      | .064 | .064 | .064 |  |  |
| 72 x 44                            | 17.6          | 13 1/4                 | .064                                    | .064      | .064      | .064      | .064      | .064 | .064 | .064 |  |  |
| 73 x 55                            | 22.0          | 18                     | .064                                    | .064      | .064      | .064      | .064      | .064 | .064 | .064 |  |  |
| 81 x 59                            | 26.0          | 18                     | .064                                    | .064      | .064      | .064      | .064      | .064 | .064 | .064 |  |  |
| 87 x 63                            | 31.0          | 18                     | .064                                    | .064      | .064      | .064      | .064      | .064 | .064 | .064 |  |  |
| 95 x 67                            | 35.0          | 18                     | .064                                    | .064      | .064      | .064      | .064      | .064 | .064 | .064 |  |  |
| 103 x 71                           | 41.0          | 18                     | .064                                    | .064      | .064      | .064      | .064      | .064 | .064 | .064 |  |  |

**INSTALLATION OF METAL CULVERT PIPE**

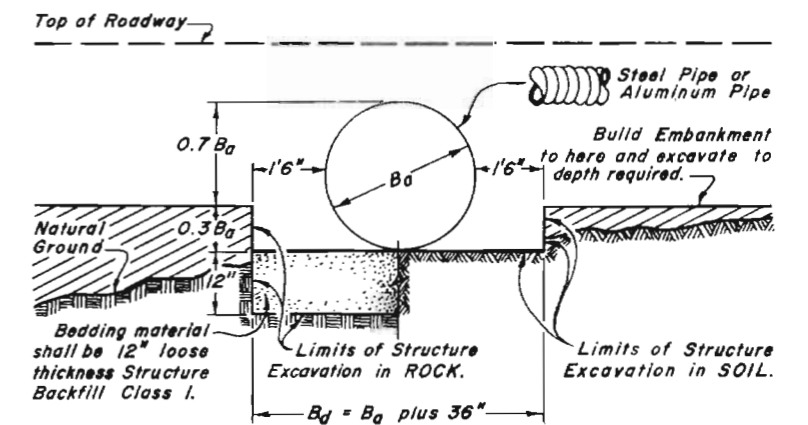

NOTE: Spacing for multiple pipe installations shall conform to the details shown on M Standard for Excavation and Backfill for Structures.

5/16" rivets or helical fabrication shall be used on pipes with thickness to the left of or above the heavy solid line.

3/8" rivets or helical fabrication shall be used on pipes with thickness to the right of or below the heavy solid line.

3/8" rivets may be used on pipes with thickness to left of or above the heavy solid line.

7/16" rivets may be used on pipes with thickness to right of or below the heavy solid line.

**TABLE VI**  
CORRUGATED ALUMINUM PIPE

2-2/3" x 1/2" CORRUGATIONS

| PIPE SIZE (B <sub>0</sub> ) Inches | AREA (Sq.Ft.) | HEIGHT OF FILL OVER TOP OF PIPE IN FEET |           |           |           |           |           |           |           |           |           |           |           |           |  |
|------------------------------------|---------------|---|-----------|-----------|-----------|-----------|-----------|-----------|-----------|-----------|-----------|-----------|-----------|-----------|--|
|                                    |               | 1 to 10                                 | 10+ to 15 | 15+ to 20 | 20+ to 25 | 25+ to 30 | 30+ to 35 | 35+ to 40 | 40+ to 45 | 45+ to 50 | 50+ to 55 | 55+ to 60 | 60+ to 70 | 70+ to 80 |  |
| 12                                 | 0.8           | .060                                    | .060      | .060      | .060      | .060      | .060      | .060      | .060      | .060      | .060      | .060      | .060      | .060      |  |
| 18                                 | 1.8           | .060                                    | .060      | .060      | .060      | .060      | .060      | .060      | .060      | .060      | .060      | .060      | .060      | .060      |  |
| 24                                 | 3.1           | .060                                    | .060      | .060      | .060      | .060      | .060      | .060      | .060      | .060      | .060      | .060      | .060      | .060      |  |
| 30                                 | 4.9           | .060                                    | .060      | .060      | .060      | .060      | .060      | .060      | .060      | .060      | .060      | .060      | .060      | .060      |  |
| 36                                 | 7.1           | .060                                    | .060      | .060      | .060      |           |           |           |           |           |           |           |           |           |  |

# STANDARD M-603-RC

(MARCH 20, 1967)


|                           |          |   |           |              |
|---------------------------|----------|---|-----------|--------------|
| FEDERAL ROAD DISTRICT NO. | DIVISION | PRG. NO.                                    | SHEET NO. | TOTAL SHEETS |
|                           | COLORADO |   |           |              |
| REVISIONS                 |          |   |           |              |
| (R-1)                     | 4-19-68  | Added Arch and Elliptical Pipe. Gen. Notes. |           | M.R.H.       |
| (R-2)                     | 7-23-68  | Revised Notes.                              |           | M.R.H.       |
| (R-3)                     | 3-1-71   | GN's for Bed and NROP. Cl. 2 bed mat.       |           | M.R.H.       |

## DIMENSIONS FOR REINFORCED CONCRETE PIPE (For Information Only)


| PIPE SIZE B <sub>d</sub> (In. I.D.) | CIRCULAR                |  |               |               | ARCH                    |                         |               |               | VERTICAL ELLIPTICAL (VE) |                         |               |               | HORIZONTAL ELLIPTICAL (HE) |                         |  |  |
|-------------------------------------|-------------------------|--|---------------|---------------|-------------------------|-------------------------|---------------|---------------|--------------------------|-------------------------|---------------|---------------|----------------------------|-------------------------|--|--|
|                                     | Wall Thickness (Inches) | 0.3 B <sub>c</sub> (Outside Dia.) (Feet) | Span (Inches) | Rise (Inches) | Wall Thickness (Inches) | 0.3 Outside Rise (Feet) | Span (Inches) | Rise (Inches) | Wall Thickness (Inches)  | 0.3 Outside Rise (Feet) | Span (Inches) | Rise (Inches) | Wall Thickness (Inches)    | 0.3 Outside Rise (Feet) |  |  |
| 12                                  | 2                       | 0.40                                     |               |               |                         |                         |               |               |                          |                         |               |               |                            |                         |  |  |
| 15                                  | 2-1/4                   | 0.49                                     |               |               |                         |                         |               |               |                          |                         |               |               |                            |                         |  |  |
| 18                                  | 2-1/2                   | 0.58                                     | 18            | 11            | 2-1/4                   | 0.39                    |               |               |                          |                         |               |               | 23                         | 14                      |  |  |
| 21                                  | 2-3/4                   | 0.66                                     | 25            | 16            | 2-3/4                   | 0.54                    |               |               |                          |                         |               |               | 30                         | 19                      |  |  |
| 24                                  | 3                       | 0.75                                     | 29            | 18            | 3                       | 0.60                    |               |               |                          |                         |               |               | 34                         | 22                      |  |  |
| 27                                  | 3-1/4                   | 0.84                                     |               |               |                         |                         |               |               |                          |                         |               |               | 38                         | 24                      |  |  |
| 30                                  | 3-1/2                   | 0.92                                     | 36            | 22            | 3-1/2                   | 0.73                    |               |               |                          |                         |               |               | 42                         | 27                      |  |  |
| 33                                  | 3-3/4                   | 1.01                                     |               |               |                         |                         |               |               |                          |                         |               |               | 45                         | 29                      |  |  |
| 36                                  | 4                       | 1.10                                     | 43            | 27            | 4                       | 0.88                    | 29            | 45            | 4-1/2                    | 1.35                    |               |               | 49                         | 32                      |  |  |
| 39                                  | 4-1/2                   | 1.28                                     |               |               |                         |                         |               |               |                          |                         |               |               | 53                         | 34                      |  |  |
| 42                                  | 5                       | 1.45                                     | 50            | 31            | 4-1/2                   | 1.00                    | 32            | 49            | 4-3/4                    | 1.46                    |               |               | 57                         | 36                      |  |  |
| 48                                  | 5-1/2                   | 1.62                                     | 58            | 36            | 5                       | 1.15                    | 34            | 53            | 5                        | 1.58                    |               |               | 60                         | 38                      |  |  |
| 54                                  | 6                       | 1.80                                     | 65            | 40            | 5-1/2                   | 1.28                    | 38            | 60            | 5-1/2                    | 1.78                    |               |               | 63                         | 40                      |  |  |
| 60                                  | 6-1/2                   | 1.97                                     | 72            | 44            | 6                       | 1.40                    | 43            | 68            | 6                        | 2.00                    |               |               | 66                         | 42                      |  |  |
| 66                                  | 7                       | 2.15                                     | 88            | 54            | 7                       | 1.70                    | 48            | 76            | 6-1/2                    | 2.23                    |               |               | 69                         | 44                      |  |  |
| 72                                  | 7-1/2                   | 2.32                                     | 102           | 62            | 8                       | 1.95                    | 53            | 83            | 7                        | 2.43                    |               |               | 72                         | 46                      |  |  |
| 78                                  | 8                       | 2.50                                     | 115           | 72            | 8-1/2                   | 2.23                    | 58            | 91            | 7-1/2                    | 2.65                    |               |               | 75                         | 48                      |  |  |
| 84                                  | 8-1/2                   | 2.68                                     | 122           | 77            | 9                       | 2.38                    | 63            | 98            | 8                        | 2.85                    |               |               | 78                         | 50                      |  |  |
| 90                                  | 9                       | 2.85                                     | 138           | 87            | 10                      | 2.68                    | 68            | 106           | 8-1/2                    | 3.08                    |               |               | 81                         | 52                      |  |  |
| 96                                  | 9-1/2                   | 3.02                                     |               |               |                         |                         | 72            | 113           | 9                        | 3.28                    |               |               | 83                         | 53                      |  |  |
| 102                                 | 10                      | 3.20                                     |               |               |                         |                         | 77            | 121           | 9-1/2                    | 3.50                    |               |               | 85                         | 54                      |  |  |
| 108                                 |                         |  |               |               |                         |                         | 82            | 128           | 9-3/4                    | 3.69                    |               |               | 87                         | 55                      |  |  |
|                                     |                         |  |               |               |                         |                         | 87            | 136           | 10                       | 3.90                    |               |               | 89                         | 56                      |  |  |

▲ Also equivalent round dimension for Arch and Elliptical pipe.  
 ϕ Sizes shown are for identification purposes only. Actual sizes shall conform to those listed in Fig. 1 of ASTM Spec. C506.

(R-1) NOTE: B<sub>c</sub> is the outside dimension for diameter, span or rise.

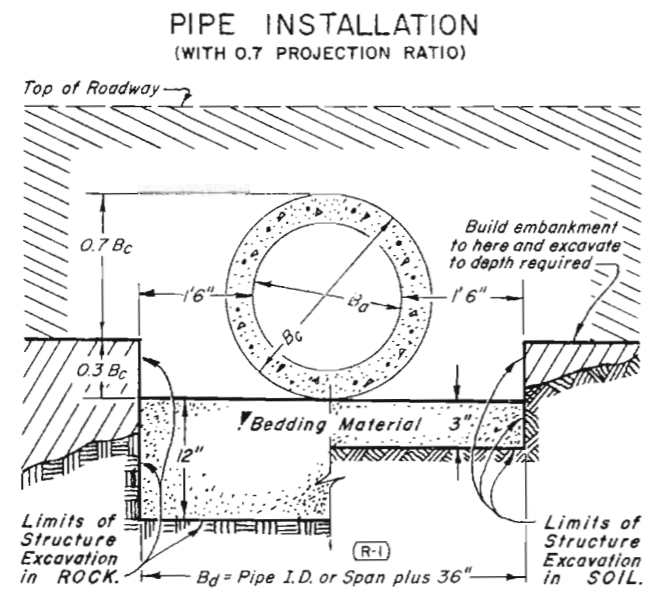

### IMPERFECT TRENCH PIPE INSTALLATION (WITH 0.7 PROJECTION RATIO)

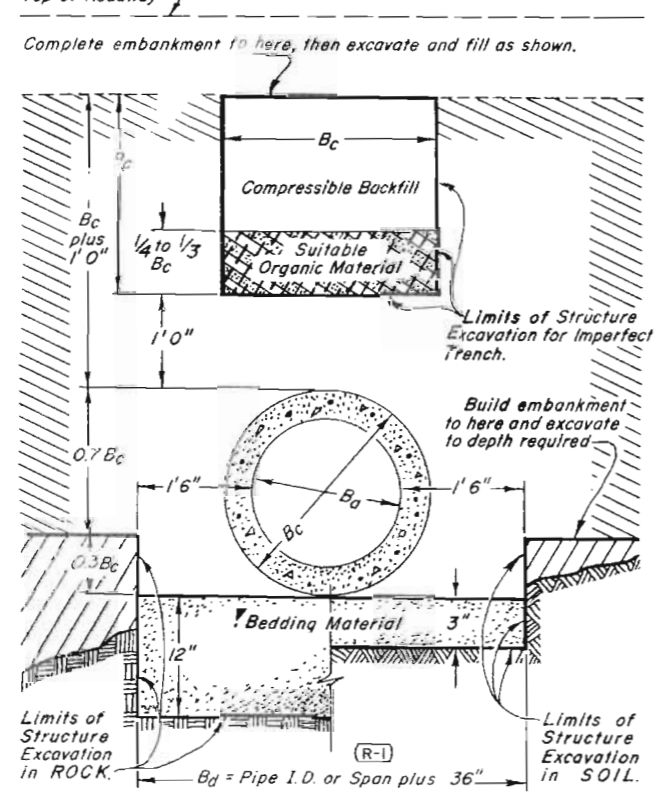

▲ Bedding Material for SOIL shall be 3" loose thickness Structure Backfill Class 2. (R-3)  
 Bedding Material for ROCK shall be 12" loose thickness Structure Backfill Class 1.


### HEIGHTS OF FILL OVER REINFORCED CONCRETE PIPE — ALL SIZES —

| TYPE OF PIPE                                | HEIGHT OF FILL OVER TOP OF PIPE IN FEET |            |           |           |           |           |
|---|---|------------|-----------|-----------|-----------|-----------|
|   | CLASS OF PIPE (0.01" Crack R-load)      |            |           |           |           |           |
|   | Class II                                | Class III  | Class IV  | Class V   | Class VI  | Class VII |
|   | 1000 D                                  | 1350 D     | 2000 D    | 3000 D    | 4000 D    | 5000 D    |
| PIPE INSTALLATION WITH 0.7 PROJECTION RATIO |   |            |           |           |           |           |
| CIRCULAR                                    | Min. to 18                              | Min. to 25 | 25+ to 37 | 37+ to 45 |           |           |
| ARCH  | Min. to 18                              | Min. to 25 | 25+ to 37 |           |           |           |
| VERTICAL ELLIPTICAL                         | Min. to 18                              | Min. to 25 | 25+ to 37 | 37+ to 45 | 45+ to 62 |           |
| HORIZONTAL ELLIPTICAL                       | Min. to 18                              | Min. to 25 | 25+ to 37 |           |           |           |
| PIPE INSTALLATION WITH IMPERFECT TRENCH     |   |            |           |           |           |           |
| ALL TYPES                                   | 45 to 35                                | up to 48   | 48+ to 75 | 75+ to 96 |           |           |


### GENERAL NOTES

All work shall be done in accordance with the Standard Specifications applicable to the project.  
 Minimum cover excluding pavement shall be 1 foot.  
 Fill heights greater than maximum allowed in the Heights of Fill Table on this sheet will require special design of structure.  
 Pipe design is based on safety factor of 1.33 on ultimate strength.  
 The heights of fill over top of pipe are based on unit weight of soil at 120 lbs. per cubic foot.  
 Pipe Class is determined from .01 inch crack D-load.  
 Bedding is Class B (Modified) with Settlement Ratio R<sub>sd</sub> = 0.0 (Yielding Bed).  
 Changes in design factors will require compensating change in pipe design.  
 Minimum wall thickness dimensions are based on AASHTO Designation M 170 (Wall B) for Circular Pipe, AASHTO Designation M 206 for Arch Pipe and AASHTO Designation M 207 for Elliptical Pipe.  
 Spacing for multiple pipe installations shall conform to the details shown on M Standard for Excavation and Backfill for Structures.  
 When a culvert is to be extended with pipe of different material, the connection shall conform to the detail on plans or be approved.  
**NONREINFORCED CONCRETE PIPE**  
 Nonreinforced Concrete Pipe is required to meet the same D-Load to produce the ultimate load under the three-edge-bearing method as specified for Reinforced Concrete Pipe in accordance with AASHTO M-170. Wall thickness of pipe may be increased as required to meet D-Load requirement.  
 All requirements for Reinforced Concrete Pipe, except those referring to reinforcement shall apply to Nonreinforced Concrete Pipe.

### CONCRETE CULVERT WITH END SECTIONS

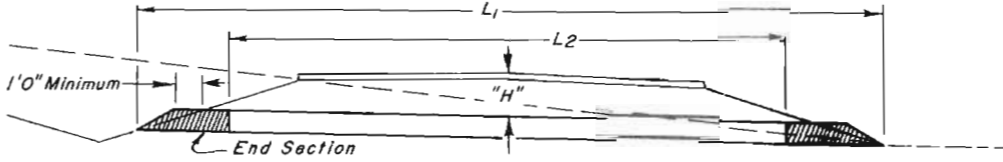

### CONCRETE CULVERT WITHOUT END SECTIONS

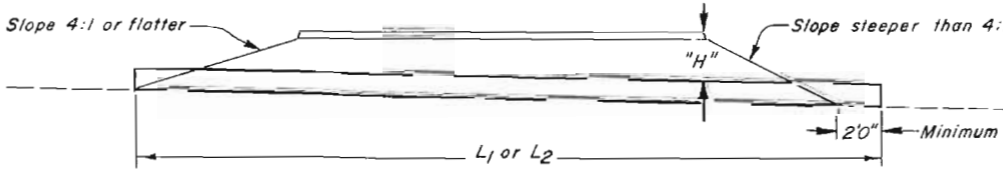

"H" = Maximum height of fill over top of Culvert, including pavement.  
 L<sub>1</sub> = Length of Culvert to be measured when placed in accordance with Section 617.  
 L<sub>2</sub> = Length of Pipe to be measured when placed in accordance with Section 603.  
 (R-1) Length of extension, when placed in accordance with Section 617, shall be the actual number of feet of new culvert required.

DEPARTMENT OF HIGHWAYS  
STATE OF COLORADO  
DIVISION OF HIGHWAYS

REINFORCED CONCRETE PIPE

Designed by M.R.H. Approved by J.C. Staff Design Eng'r.  
 Made by J.R.B. Checked by R.S.M. Date: 4-19-68




# STANDARD M-604-D

(JULY 1, 1965)


| FEDERAL ROAD REGION NO. | DIVISION | PROJ. NO. | SHEET NO. | TOTAL SHEETS |
|-------------------------|----------|-----------|-----------|--------------|
| 9                       | COLORADO |           |           |              |

| REVISIONS |         |             |        |
|-----------|---------|-------------|--------|
| (R-1)     | 7-23-68 | Dept. Name. | M.R.H. |
|           |         |             |        |
|           |         |             |        |
|           |         |             |        |

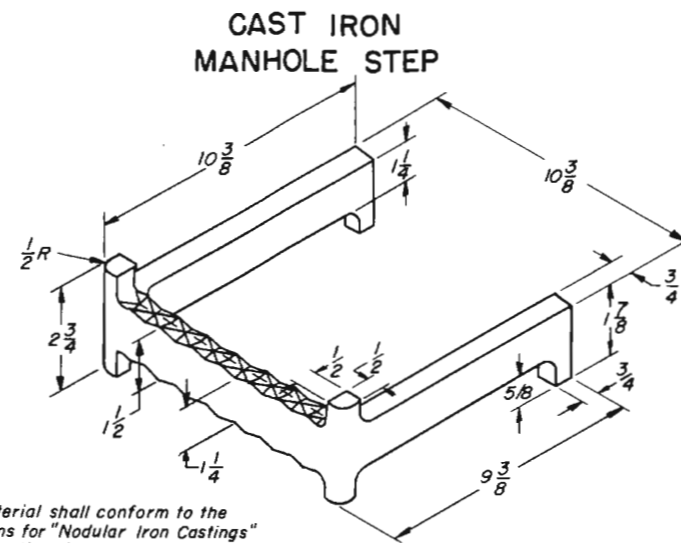


This material shall conform to the Specifications for "Nodular Iron Castings" ASTM Designation A 339 Grade 60-45-10

## MILD STEEL MANHOLE OR INLET STEP

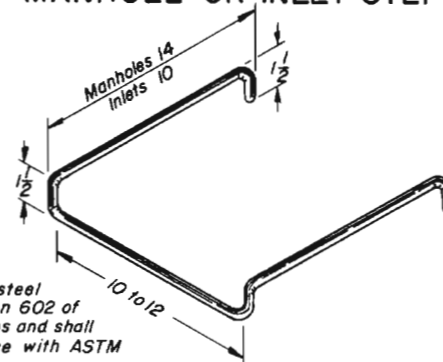

Step shall be 3/4 Dia. steel bars conforming to Section 602 of the Standard Specifications and shall be galvanized in accordance with ASTM Designation A 123.

## CAST IRON MANHOLE STEP

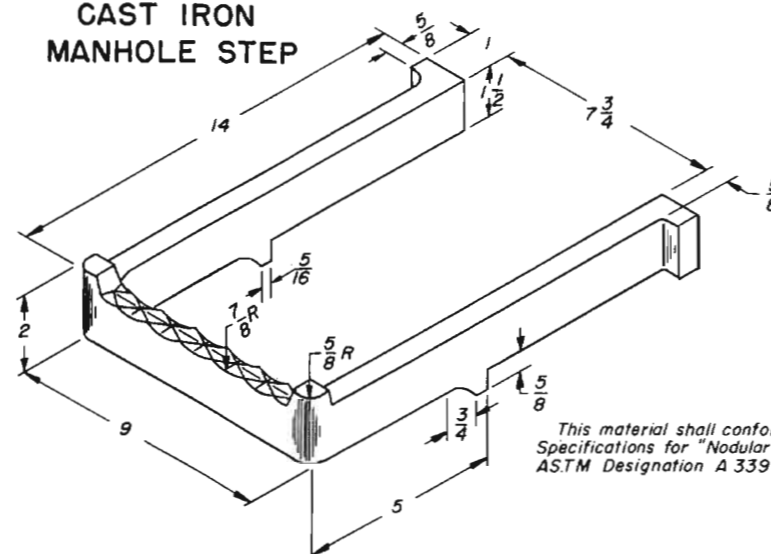

This material shall conform to the Specifications for "Nodular Iron Castings" ASTM Designation A 339 Grade 60-45-10.

## GENERAL NOTES

All work shall be done according to the Standard Specifications applicable to the project.

Steps shall be included in the cost of "Manholes" or "Inlets".

All dimensions shown in inches.

(R-1) DEPARTMENT OF HIGHWAYS  
 STATE OF COLORADO  
 DIVISION OF HIGHWAYS

### STEPS FOR MANHOLES AND INLETS


Designed by: M.R.H. Approved by: *[Signature]*  
 Made by: H.P.B. Staff Design Engr.  
 Checked by: Date: July 1, 1965

# STANDARD M-604-E


(OCTOBER 11, 1967)

| FEDERAL ROAD REGION NO. | DIVISION | PROJ. NO. | SHEET NO. | TOTAL SHEETS |
|-------------------------|----------|-----------|-----------|--------------|
| 9                       | COLORADO |           |           |              |

| REVISIONS |         |                       |        |
|-----------|---------|-----------------------|--------|
| (R-1)     | 7-24-68 | Dept. Name.           | M.R.H. |
| (R-2)     | 4-20-71 | Concrete in Gen Note. | M.R.H. |

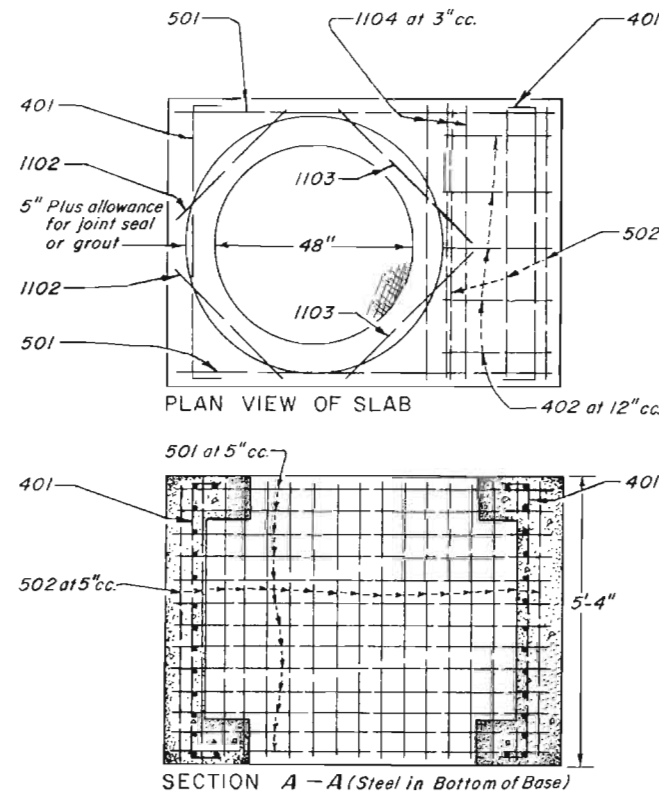

NOTE: Manhole Ring and Cover shall be dipped or painted with Asphalt or Coal Tar and Oil.

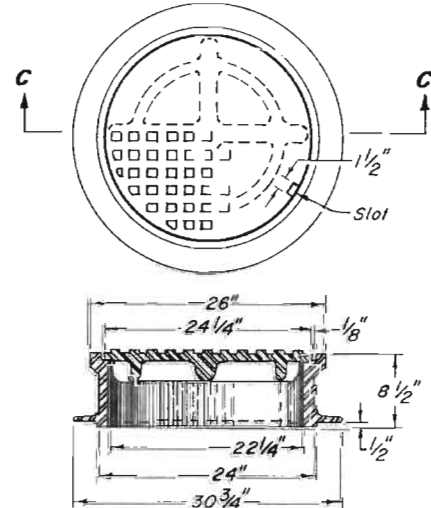



TOTAL WEIGHT: Approximately 400 lbs.

## MANHOLE RING AND COVER

## QUANTITIES FOR CONCRETE MANHOLE BOX BASE

| MARK                               | SIZE | TYPE | Lb./Ft. | BARS                                   | I.D. $\phi$ | 36"                  | 48"                   | 60"                  | 72"                  | 84"                    | 96"                   | FORMULAS  |
|------------------------------------|------|------|---------|--|-------------|----------------------|-----------------------|----------------------|----------------------|------------------------|-----------------------|---|
| 401                                | 4    | II   | 0.67    | { NO. REQ'D.<br>LENGTH<br>WEIGHT, lbs. |             | 16<br>6'-7"<br>70.4  | 18<br>6'-7"<br>79.2   | 20<br>6'-7"<br>88.0  | 22<br>6'-7"<br>96.8  | 25<br>6'-7"<br>110.0   | 27<br>6'-7"<br>118.8  | 401<br>Number Bars Required = $(\frac{12 + I.D. + 2W}{6}) + 6$                        |
| 402                                | 4    | III  | 0.67    | { NO. REQ'D.<br>LENGTH<br>WEIGHT, lbs. |             | 0<br>0<br>0          | 5<br>4'-10"<br>16.2   | 5<br>5'-0"<br>20.0   | 5<br>7'-2"<br>23.9   | 5<br>8'-4"<br>27.8     | 5<br>9'-6"<br>31.7    | 402<br>Bar Length = I.D. + 2W   |
| 501                                | 5    | I    | 1.04    | { NO. REQ'D.<br>LENGTH<br>WEIGHT, lbs. |             | 17<br>5'-8"<br>100.5 | 17<br>6'-10"<br>121.2 | 17<br>8'-0"<br>141.9 | 17<br>9'-2"<br>162.5 | 17<br>10'-4"<br>183.2  | 17<br>11'-6"<br>203.9 | 501<br>Bar Length = 24" + I.D. + 2W   |
| 502                                | 5    | I    | 1.04    | { NO. REQ'D.<br>LENGTH<br>WEIGHT, lbs. |             | 15<br>5'-0"<br>78.2  | 19<br>5'-0"<br>99.1   | 23<br>5'-0"<br>120.0 | 27<br>5'-0"<br>140.8 | 31<br>5'-0"<br>161.7   | 34<br>5'-0"<br>177.3  | 502<br>Number Bars Req'd. = $(\frac{17 + I.D. + 2W}{5}) + (\frac{I.D. - 36}{12}) + 3$ |
| 503                                | 5    | I    | 1.04    | { NO. REQ'D.<br>LENGTH<br>WEIGHT, lbs. |             | 30<br>6'-2"<br>193.0 | 30<br>7'-4"<br>229.5  | 30<br>8'-6"<br>266.0 | 30<br>9'-8"<br>302.5 | 30<br>10'-10"<br>339.5 | 30<br>12'-0"<br>375.5 | 503<br>Bar Length = 30" + I.D. + 2W   |
| 1101                               | 11   | I    | 5.31    | { NO. REQ'D.<br>LENGTH<br>WEIGHT, lbs. |             | 4<br>5'-8"<br>120.5  | 4<br>6'-10"<br>145.2  | 4<br>8'-0"<br>170.0  | 4<br>9'-2"<br>194.8  | 4<br>10'-4"<br>219.6   | 4<br>11'-6"<br>244.4  | 1101<br>Bar Length = 24" + I.D. + 2W  |
| 1102                               | 11   | I    | 5.31    | { NO. REQ'D.<br>LENGTH<br>WEIGHT, lbs. |             | 2<br>2'-6"<br>26.6   | 2<br>2'-6"<br>26.6    | 2<br>2'-6"<br>26.6   | 2<br>2'-6"<br>26.6   | 2<br>2'-6"<br>26.6     | 2<br>2'-6"<br>26.6    | BENDING<br>TYPE I<br>Straight<br>TYPE II<br>59" x 10"<br>TYPE III<br>7" x 12" x 12"   |
| 1103                               | 11   | I    | 5.31    | { NO. REQ'D.<br>LENGTH<br>WEIGHT, lbs. |             | 2<br>3'-6"<br>37.2   | 2<br>3'-6"<br>37.2    | 2<br>3'-6"<br>37.2   | 2<br>3'-6"<br>37.2   | 2<br>3'-6"<br>37.2     | 2<br>3'-6"<br>37.2    |   |
| 1104                               | 11   | I    | 5.31    | { NO. REQ'D.<br>LENGTH<br>WEIGHT, lbs. |             | 3<br>5'-0"<br>79.7   | 3<br>5'-0"<br>79.7    | 3<br>5'-0"<br>79.7   | 3<br>5'-0"<br>79.7   | 3<br>5'-0"<br>79.7     | 3<br>5'-0"<br>79.7    |   |
| REINFORCING STEEL - Pounds - Total |      |      |         |  |             | 706.1                | 833.9                 | 949.1                | 1064.8               | 1185.3                 | 1295.1                |   |
| CONCRETE - Cubic Yards - Total     |      |      |         |  |             | 4.2                  | 5.3                   | 6.6                  | 8.0                  | 9.5                    | 11.1                  |   |

NOTE: Quantities are based on same size pipe entrance to and exit from base and a 4 ft. manhole entrance into top slab of base.

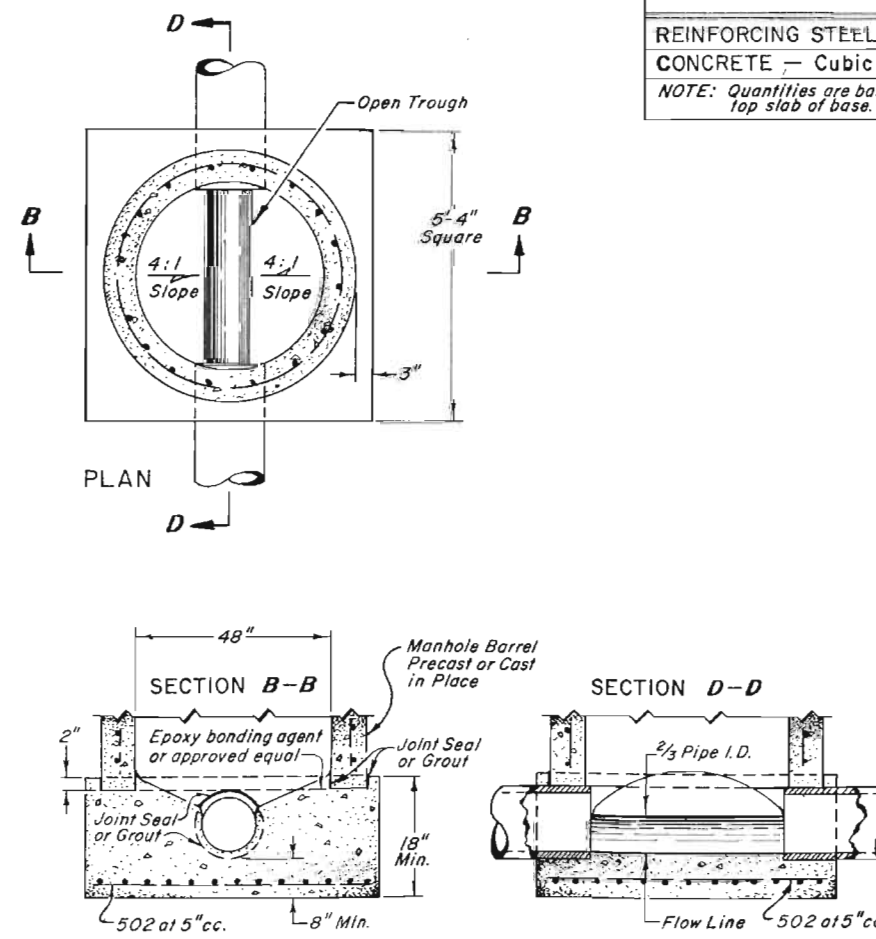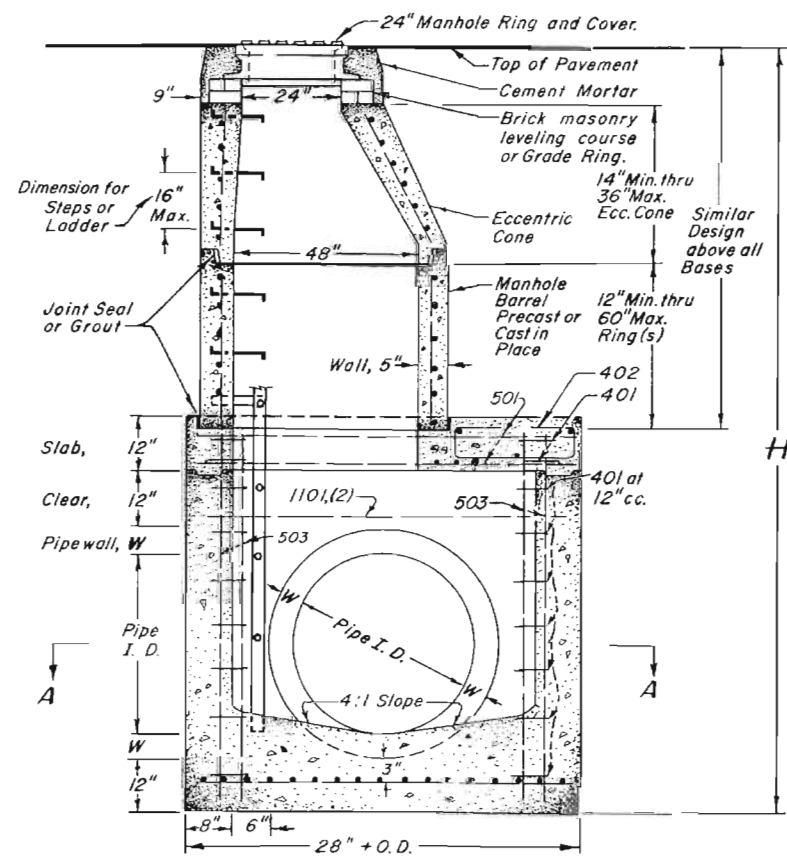

## GENERAL NOTES (R-2)

- All work shall be done in accordance with the Standard Specifications applicable to the project.
  - Since all pipe entries into the base are variable, the dimensions shown are typical. Actual dimensions and quantities for concrete and reinforcement shall be as required in the work.
  - Design is based on straight runs of conduit or change in direction under 45°.
  - All bars shall be a minimum 2" clear.
  - Precast Manholes shall conform to ASTM Designation C 478.
  - Cast in place Manholes shall be Class A, B or D concrete.
  - The following alternate materials for Manholes may be used when design details for construction are included in the plans:
- | MATERIAL               | CONFORMANCE-DESIGNATION                |
|------------------------|--|
| Clay or Shale Brick    | AASHO . . . . . M 91                   |
| Concrete Brick         | ASTM . . . . . C 55, Grade P-I or P-II |
| Concrete Masonry Block | ASTM . . . . . C 139                   |
| Corrugated Steel Unit  | AASHO . . . . . M 36                   |
- All pipe entries into the base of Manhole shall be connected by open gutter adjusted for pipe size, shape, slope and direction of flow.
  - Alternate designs will be permitted after approval by the Division
  - Steps or Ladder will be required when Manhole depth exceeds 3'-6".

(R-1)

DEPARTMENT OF HIGHWAYS  
STATE OF COLORADO  
DIVISION OF HIGHWAYS






# MANHOLES

Designed by M.R.H. Approved by J.R.B.  
Made by J.R.B. Staff Design Engineer  
Checked by R.S.M. Date: October 11, 1967


# STANDARD M-607-B

(JULY 1, 1965)  
(SHEET 1 OF 2)

| FED. ROAD REG. NO. | DIVISION | PROJECT NO. | SHEET NO. |
|--------------------|----------|-------------|-----------|
| 9                  | COLORADO |             |           |

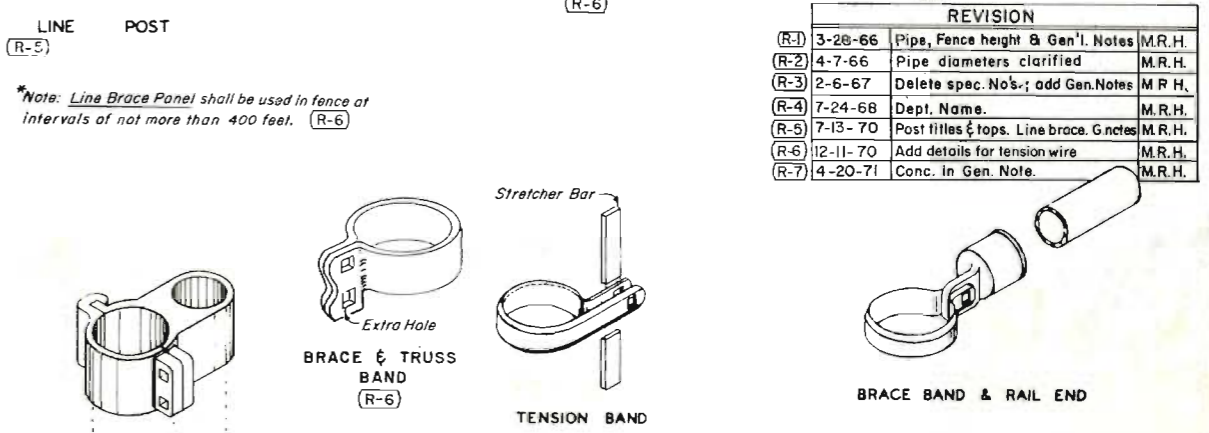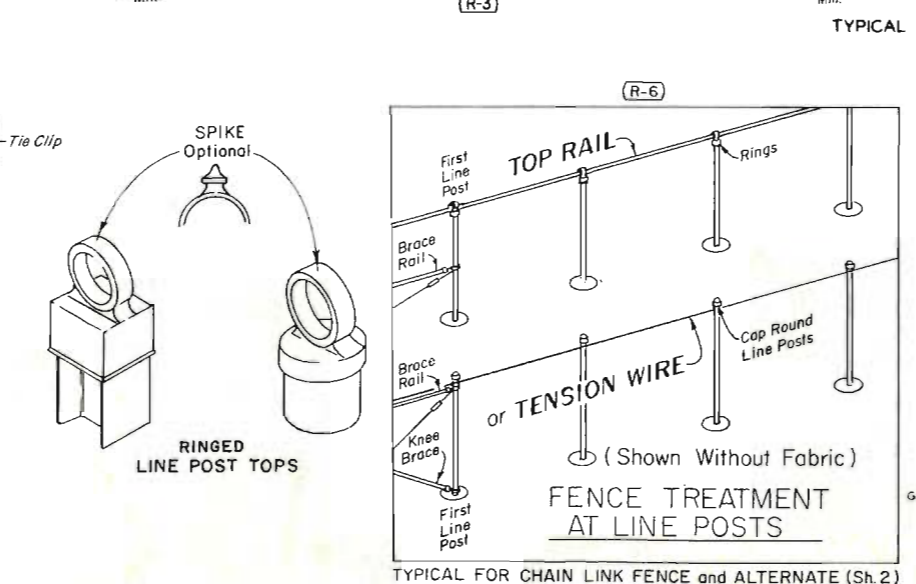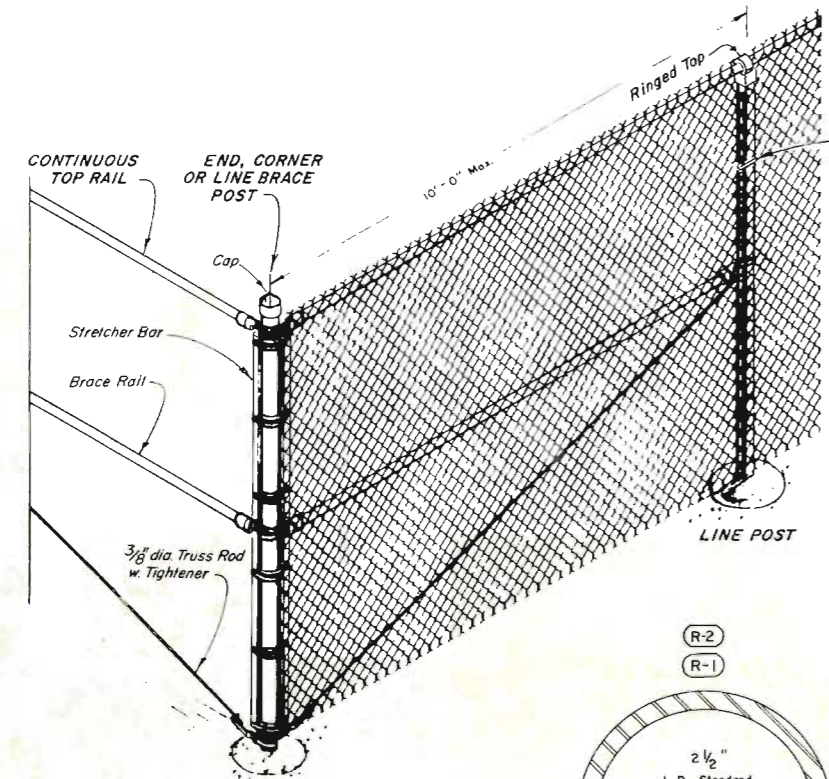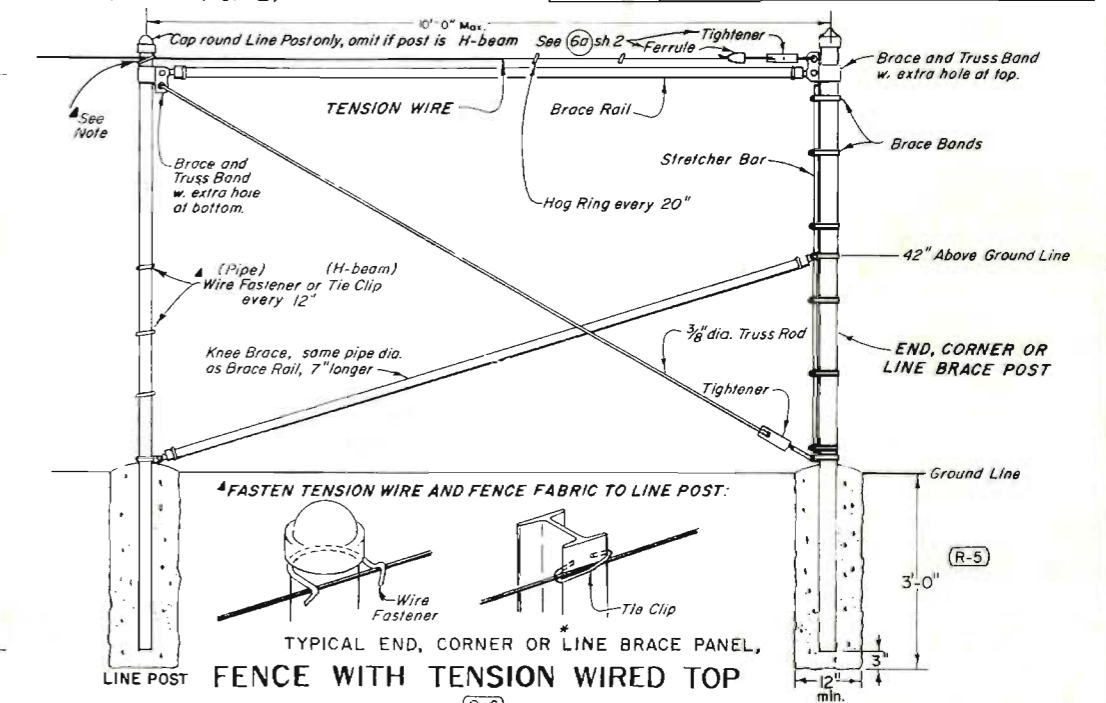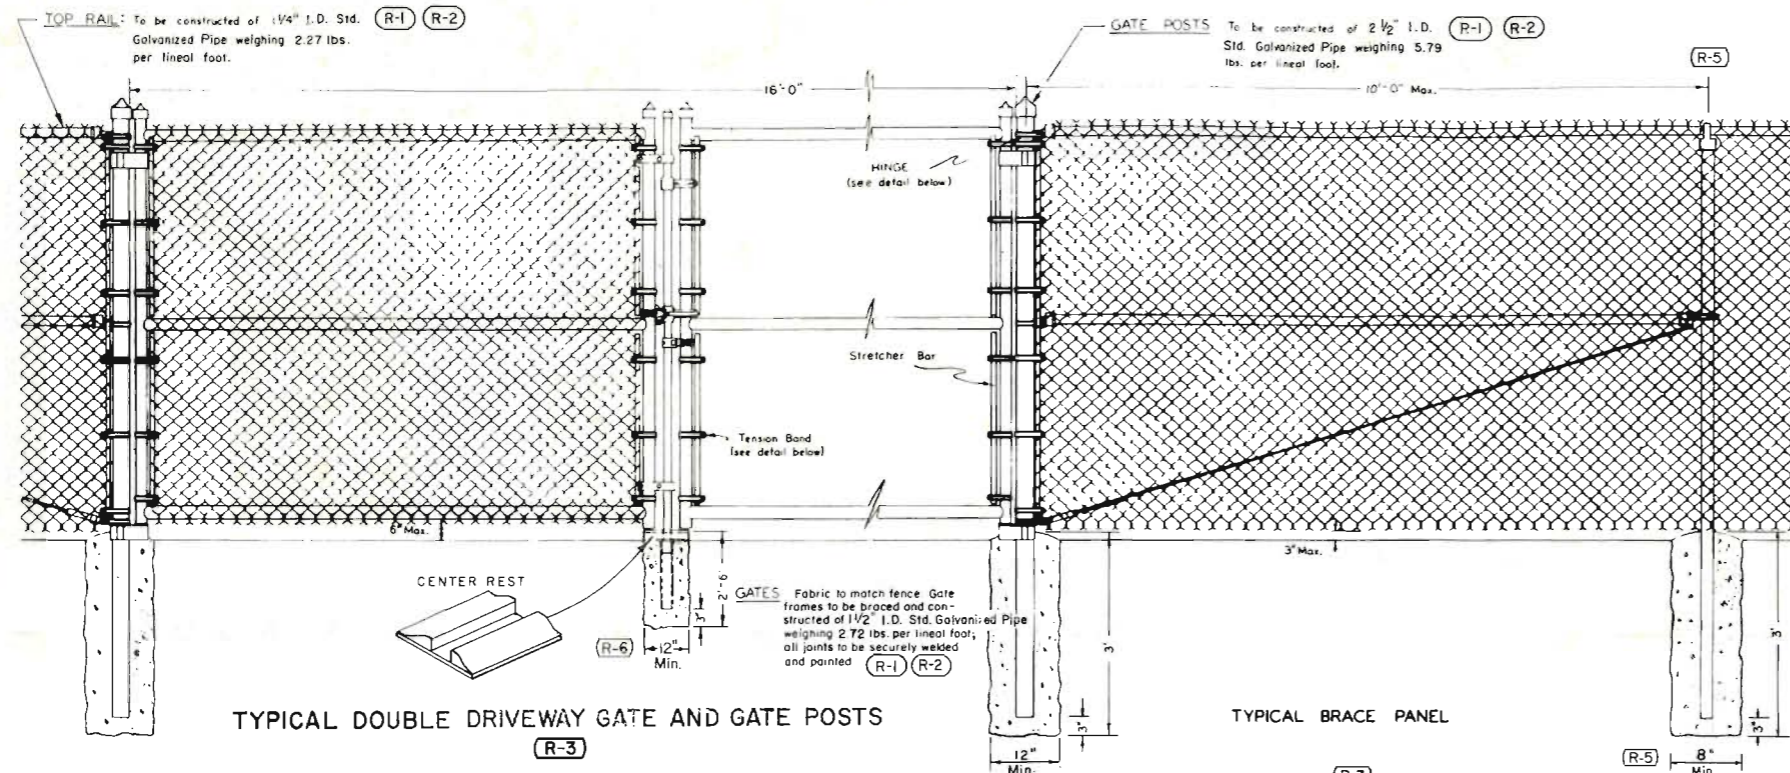

| REVISION |          |                                      |        |
|----------|----------|--------------------------------------|--------|
| (R-1)    | 3-28-66  | Pipe, Fence height & Gen'l. Notes    | M.R.H. |
| (R-2)    | 4-7-66   | Pipe diameters clarified             | M.R.H. |
| (R-3)    | 2-6-67   | Delete spec. No's.; add Gen. Notes   | M.P.H. |
| (R-4)    | 7-24-68  | Dept. Name.                          | M.R.H. |
| (R-5)    | 7-13-70  | Post fills & tops. Line brace. Gates | M.R.H. |
| (R-6)    | 12-11-70 | Add details for tension wire         | M.R.H. |
| (R-7)    | 4-20-71  | Conc. in Gen. Note.                  | M.R.H. |

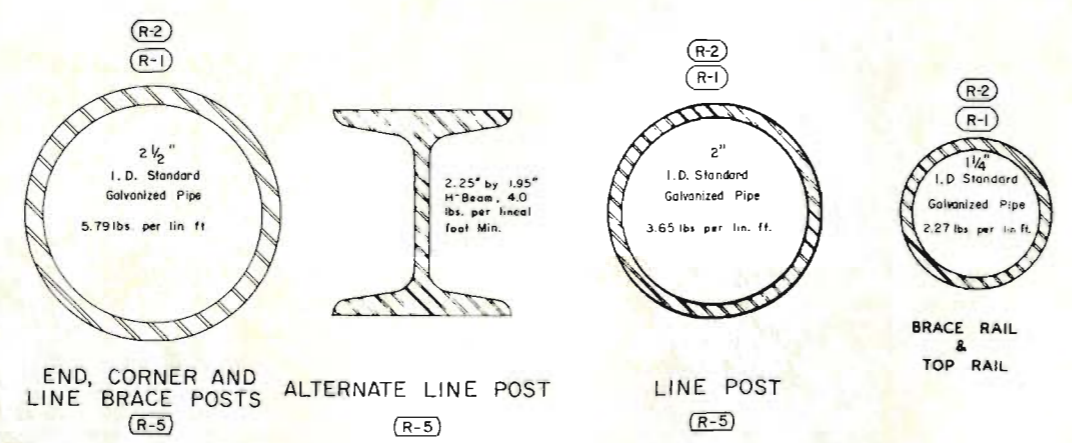

**(R-7) GENERAL NOTES**

All work shall be done in accordance with the Standard Specifications applicable to the Project.

Weights of pipe as shown are nominal for the diameter designated. Pipe for posts shall conform to ASTM Designation A 120, Series 40.

Alternate equivalent standard fittings, gates, posts, and rails other than as shown may be used subject to approval by the Engineer.

Chain Link Fabric shall be No. 9 gage wire securely fastened to all Line Posts, Rails and Braces with No. 7 (B&S) gage aluminum wire and/or No. 12 1/2 (W&M) gage galvanized steel wire spaced at a minimum of 6 per 10 feet horizontally and one per foot vertically. Suitable attachment bands shall be used on all gate posts, End Posts, Braces, and stretcher bars.

Chain Link Fabric for use on rock slopes or in conjunction with rock bolts shall be No 6 gage wire.

Maximum Line Post spacing shall be 10' (c to c). Concrete shall be Class A, B or D.

Lightweight aggregate conforming to ASTM C 330 will be allowed in concrete.

Concrete footings shall have crowned tops. Toprail or tension wire shall be used as shown on the plans.

Tension wire shall be continuous between end or corner post and line brace post. A turnbuckle or other approved tightening device shall be used for each continuous span of tension wire. (R-4)

Tension wire shall be 7 gage galvanized coil spring steel, or approved equal.

Termination of fence at bridges or other structures shall be as shown on the plans.

**DEPARTMENT OF HIGHWAYS**  
**STATE OF COLORADO**  
**DIVISION OF HIGHWAYS**  
**CHAIN LINK FENCE**

Designed by: V.L.A. Approved by: E.L.H.  
Made by: E.L.H. Staff Design Engr.  
Checked by: Date: July 1, 1965


# STANDARD M-607-B

(SHEET 2)  
(JULY 13, 1970)

| FEDERAL ROAD DISTRICT NO. | DIVISION | PROJECT NO. | DATE | BY |
|---------------------------|----------|-------------|------|----|
| 9                         | COLORADO |             |      |    |


  

| REVISIONS |          |                                      |  |        |
|-----------|----------|--------------------------------------|--|--------|
| (R-5)     | 7-13-70  | Entire sheet                         |  | M.R.H. |
| (R-6)     | 12-11-70 | Add details for knee brace           |  | M.R.H. |
| (R-7)     | 4-20-71  | Line brace title, tension wire clamp |  | M.R.H. |

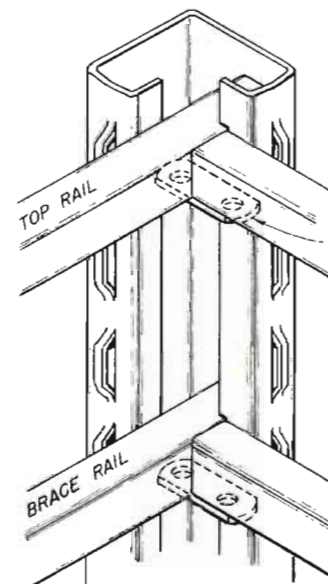


**CORNER POST TREATMENT**

1

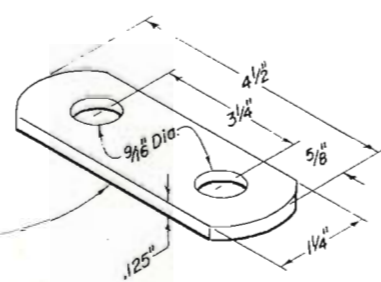

**CONNECTOR PLATE**

2

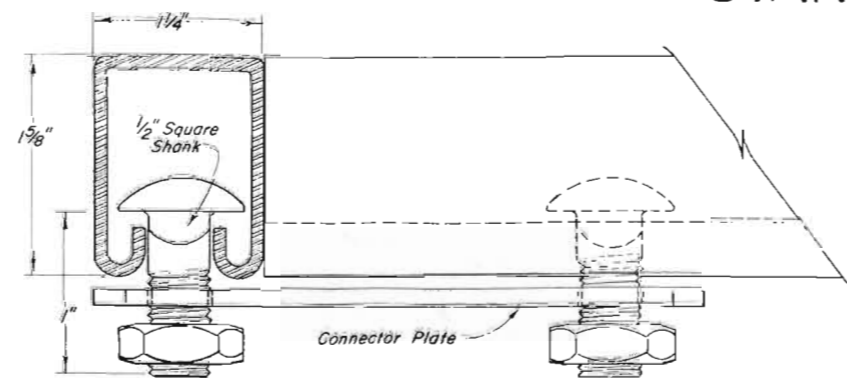

**RAIL (Showing Corner Assembly)**


14 GAGE ROLL FORMED STEEL, 20' LENGTHS, 1.35 LB. PER LIN. FT.

3



**BARBED SELVAGE**

8

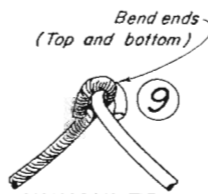

**KNUCKLED SELVAGE**

Alternate, use only when called for on plans.


9



**VIEW C**


**RAIL SPLICE INSERT**

12

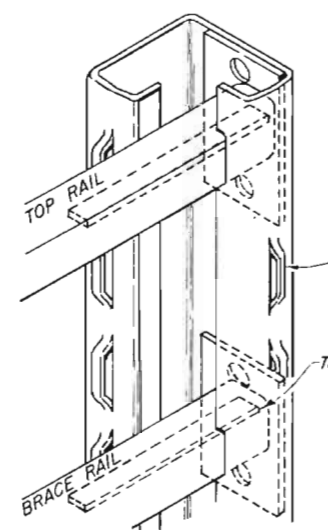


**END POST TREATMENT**

4

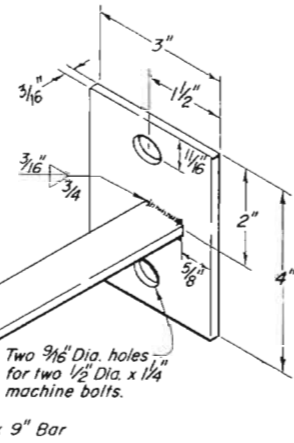

**TORQUE BAR**


5

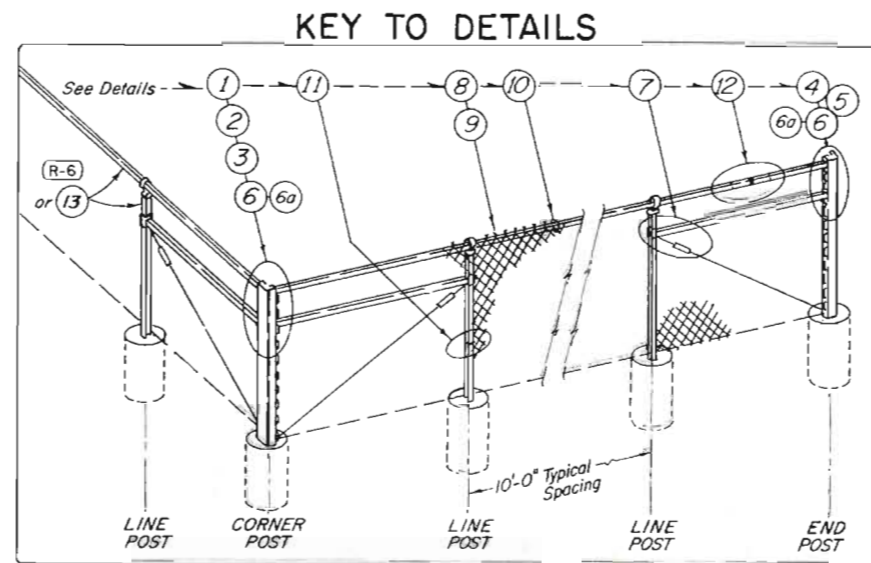

**KEY TO DETAILS**


(R-6)

Every 20' horizontally, on Top Rail

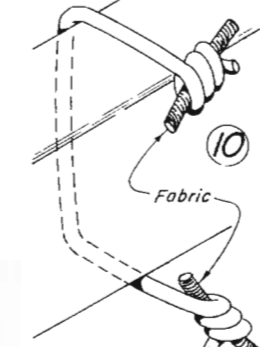

**WIRE FASTENER**


10

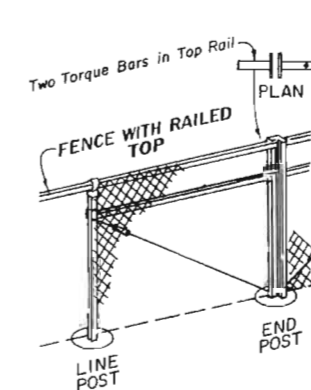

**LINE BRACE (1/2 shown)**


400 FT. INTERVALS (R-6)

13

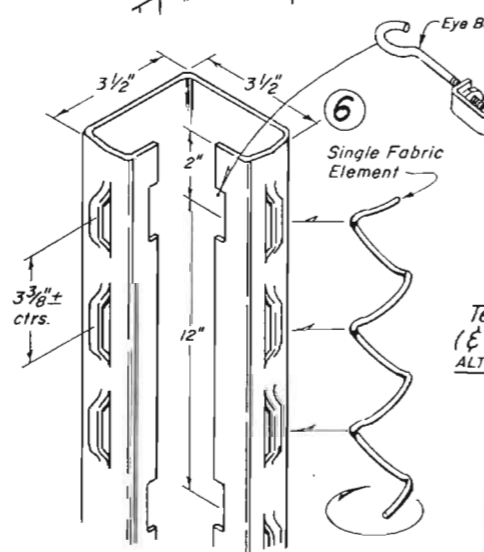


**END POST OR CORNER POST**

10 GAGE ROLL FORMED STEEL, 5.14 LB. PER LINEAR FOOT

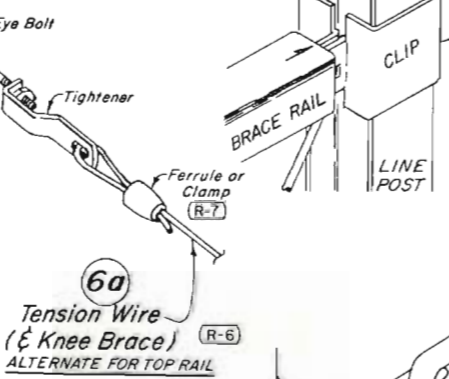


**6a Tension Wire (& Knee Brace)**

ALTERNATE FOR TOP RAIL

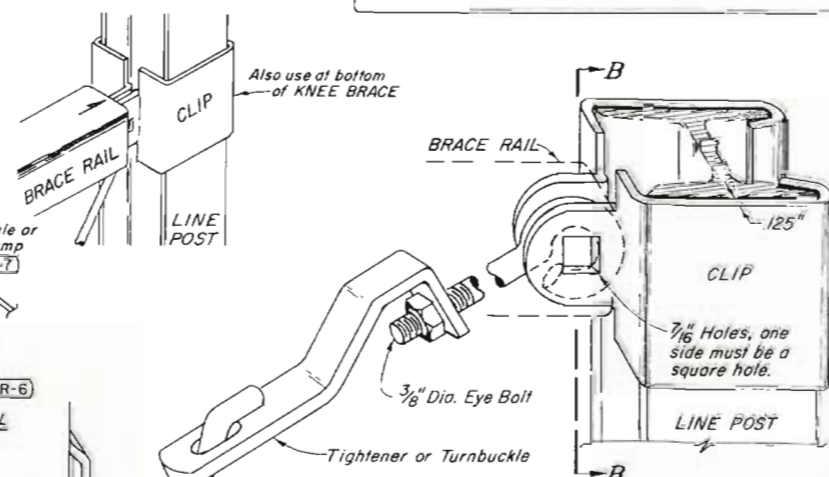


**TYPICAL BRACING**

7

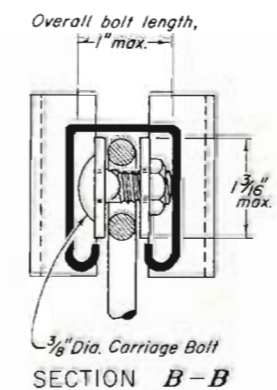

**SECTION B-B**

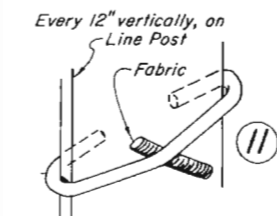

**TIE CLIP**

11

**WIRE WORK**

DEPARTMENT OF HIGHWAYS  
 STATE OF COLORADO  
 DIVISION OF HIGHWAYS  
**CHAIN LINK FENCE**  
 (ALTERNATE)

Designed by M.R.H. Approved by J.R.B.  
 Made by J.R.B. Staff Design Engineer  
 Checked by R.S.M. Date: July 13, 1970



# STANDARD CURBS AND GUTTERS

# STANDARD M-609-A


(JULY 1, 1965)

| FED. ROAD REG. NO. | DIVISION | PROJECT NO. | SHEET NO. |
|--------------------|----------|-------------|-----------|
| 9                  | COLC.    |             |           |

| REVISIONS |          |                                     |        |
|-----------|----------|-------------------------------------|--------|
| (R-1)     | 11-16-65 | Subtitles                           | M.R.H. |
| (R-2)     | 2-14-66  | General Notes                       | M.R.H. |
| (R-3)     | 7-19-68  | Dept. Name and Rev. Gen. Note       | M.R.H. |
| (R-4)     | 5-21-69  | Provide variable width on conc. gr. | M.R.H. |
| (R-5)     | 5-7-71   | Add class B to conc. in Gen. Note   | M.R.H. |

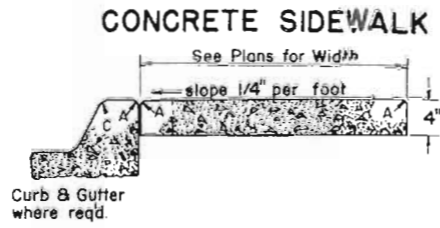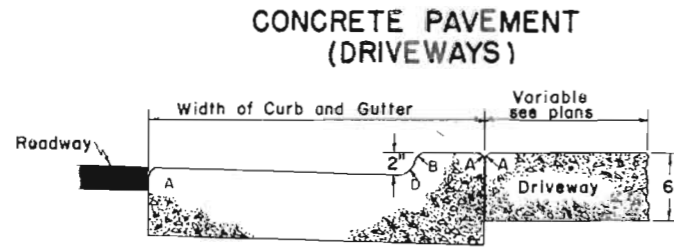




**CURB AND GUTTER Type 2**  
(6" Barrier - 1' Gutter) (Section IB)

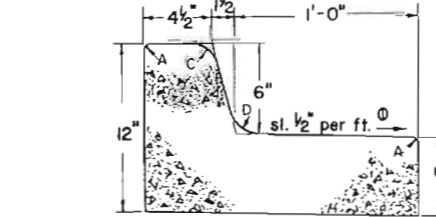


**LEGEND FOR RADII**

|   |                |
|---|----------------|
| A | = 1/8"         |
| B | = 1"           |
| C | = 1 1/2"       |
| D | = 1 1/2" to 2" |



**CURB AND GUTTER (Type 2)**  
(4" Mountable with Sidewalk) (Section MS)

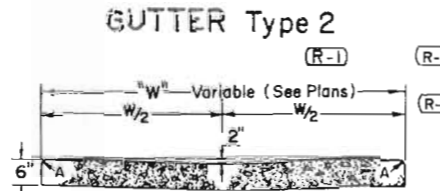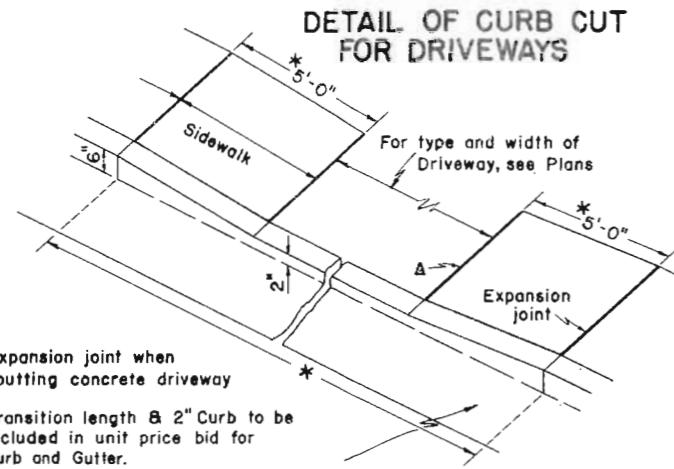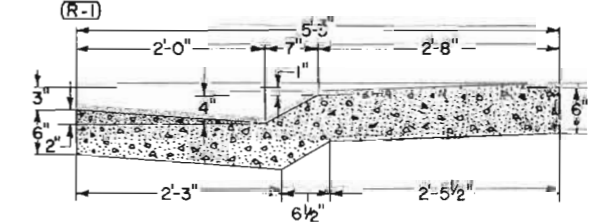


**CURB Type 4** (6" Barrier) (Section B) **CURB Type 4** (6" Mountable) (Section M)

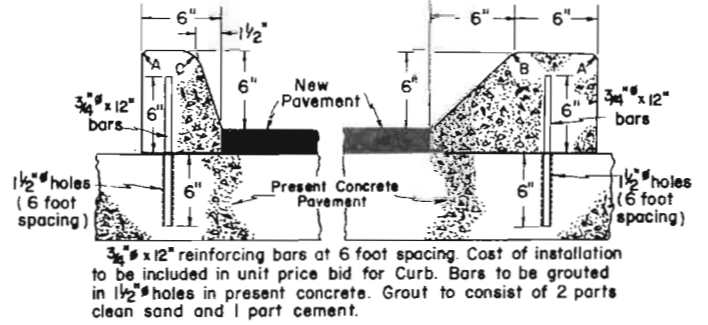

**CURB AND GUTTER Type 2**  
(6" Mountable - 1' Gutter) (Section IM)

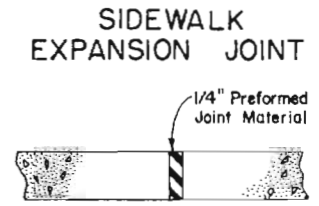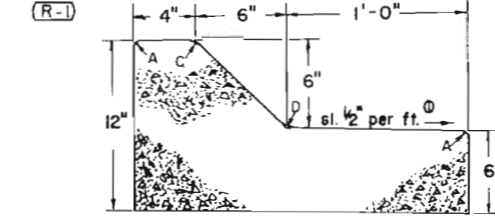


**TRANSVERSE CONTRACTION JOINT FOR CONCRETE PAVEMENT (DRIVEWAYS)**

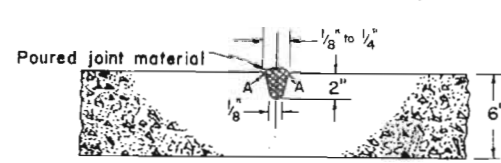


This joint required where length of slab exceeds 15 feet.


**CURB Type 2** (6" Barrier) (Section B) **CURB Type 2** (6" Mountable) (Section M)

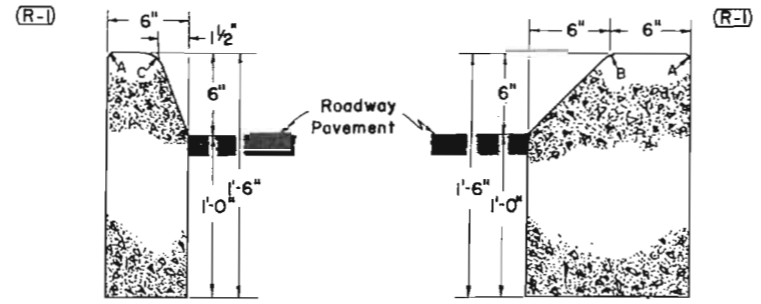

**CURB AND GUTTER Type 2**  
(6" Barrier - 2' Gutter) (Section IB)

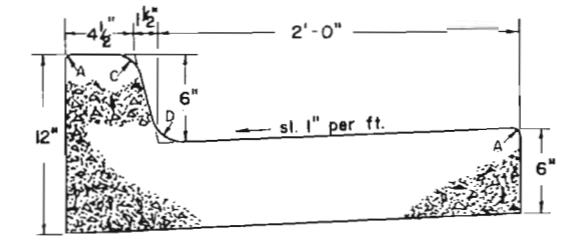


**CONSTRUCTION OF CONCRETE GUTTERS AT INTERSECTIONS**

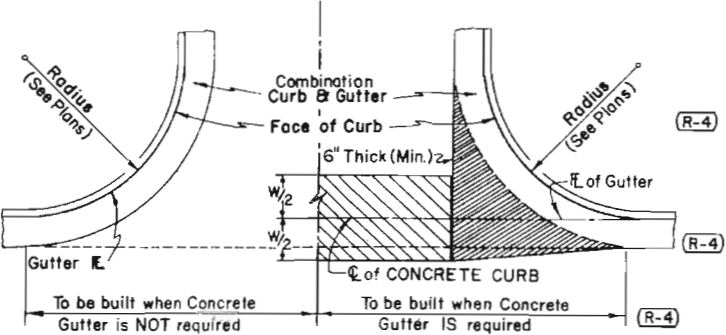


This area shall be poured monolithically with curb and gutter and paid for as Concrete Pavement of specified thickness.

**CURB Type 6** (4" Mountable) (Section M)

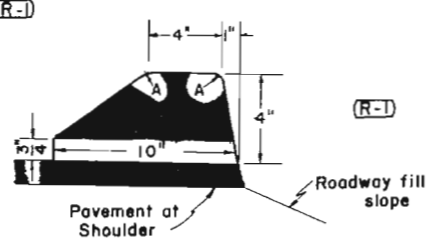

**CURB AND GUTTER Type 2**  
(6" Mountable - 2' Gutter) (Section IM)

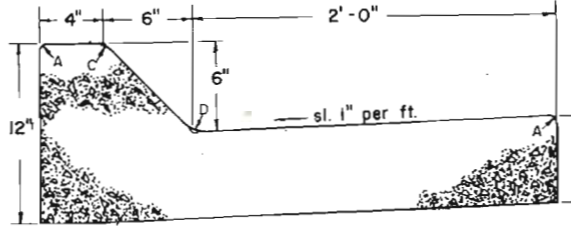

**GENERAL NOTES**

All work shall be done in accordance with the Standard Specifications applicable to the project.

On Curves 3 degrees and sharper, Curbs and/or Gutters are to be placed on the Arc of the Curve unless otherwise noted on plans. A maximum chord length of 10 feet may be used when the degree of curve is less than 3 degrees.

Expansion joints shall be installed between concrete curb and any fixed structure, sidewalk or bridge. Expansion joint material shall be 1/2" thick and shall extend the full depth of contact surface.

Concrete shall be Class A, B or D.

DEPARTMENT OF HIGHWAYS  
STATE OF COLORADO  
DIVISION OF HIGHWAYS

**CURBS AND GUTTERS**

Designed by *[Signature]*  
Made by *[Signature]*  
Checked by *[Signature]*

Approved by *[Signature]*  
Staff Design Engr.  
Date: July 1, 1969

# CLASS I BARRICADES (3 RAILS)


# STANDARD M-614-A

(JULY 1, 1965)

|                         |          |             |           |
|-------------------------|----------|-------------|-----------|
| FEDERAL ROAD REGION NO. | DISTRICT | PROJECT NO. | SHEET NO. |
| 9                       | COLORADO |             |           |






| REVISIONS |          |                             |     |
|-----------|----------|-----------------------------|-----|
| (R-1)     | 11-15-68 | Rev. Dept. Name & Code Nos. | JLS |
| (R-2)     | 4-23-69  | Rev. Code No. & Notes       | JLS |
|           |          |                             |     |
|           |          |                             |     |

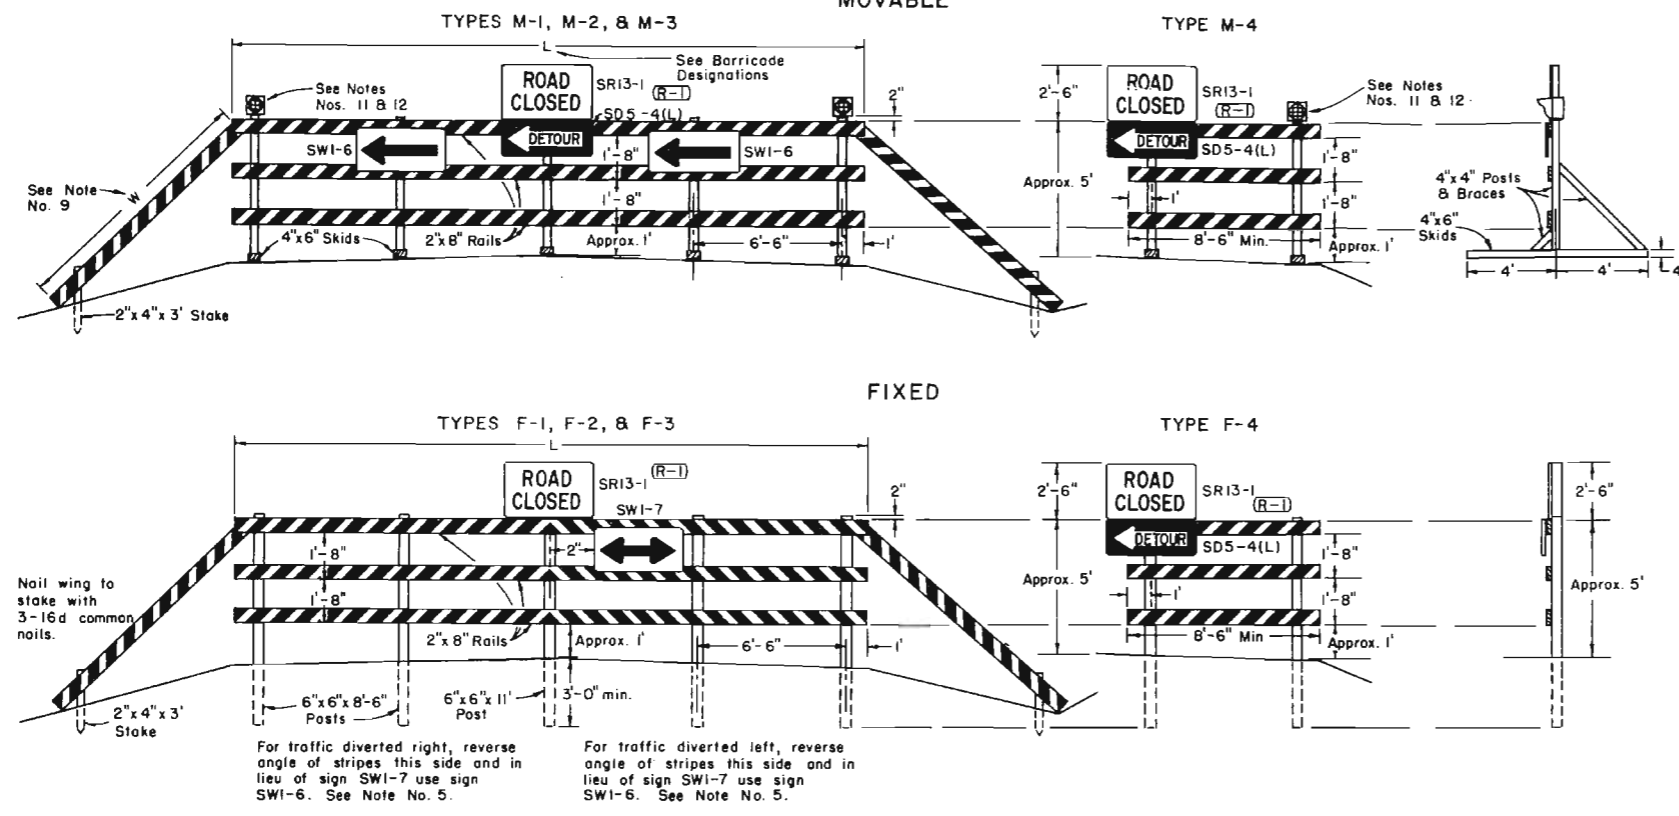

## GENERAL NOTES

- All work shall be done in accordance with the Standard Specifications applicable to the Project.
- All signs and sign materials shall conform to the standards set forth in the "Manual on Uniform Traffic Control Devices for All Classes of Streets and Highways" published by the Division of Highways and this standard.
- The various types and combinations of approved Signs and Beacons for Barricades required for each project shall be governed by field conditions and subject to approval by the Engineer. All traffic controls shall be placed for best visibility and legibility and maintained in good condition at all times. Oversigning is to be avoided.
- Painting shall conform with Subsection 508.08 of the Standard Specifications. All skids, braces, and posts shall be painted with 2 coats of "Exterior Black Paint." Planking and wings on all barricades shall be painted with 2 coats of "Exterior Black Paint" on all sides before adding reflective strips. Reflective strips shall be "cut from smooth surface yellow reflective sheeting" of a type approved by the Division.
- Each barricade rail shall be striped on the face side only with reflective yellow strips slanting downward at a 45° angle toward the side to which traffic is to turn or pass. See "DETAIL OF RAIL AND WING STRIPING."
- When barricades are designated on plans the portion of the posts below ground line shall either be dipped in or painted with hot creosote oil. The portion of the post above ground line shall be painted with 2 coats of "Exterior Black Paint."
- All skids, braces, and posts shall be nailed together with No. 20d nails. All screws, bolts, nuts, and washers shall be galvanized or cadmium plated. Skids (bases) of movable barricades shall be weighted where necessary to provide stability.
- All timber shall be Standard Grade or better, S4S, Douglas Fir or Larch, as described in the 1965 Standard Grading Rules published by the Western Wood Products Association, and shall conform to paragraph 123c for the rails and paragraphs 122c and 125c for the posts.
- Detachable extension wings for bypassing of construction equipment are permitted. "W" is variable, length shall be adequate to provide closing of borrow pit and/or shoulder as required.
- Alternate materials or other reflective elements on Traffic signs or Barricades will be permitted only after approval of such material by the Division in writing.
- A Flashing Beacon for use on Barricades is a section of a standard traffic signal head or a similar-type device having a yellow lens in the face, which is illuminated by intermittent flashes. Where commercial power is not available, the beacon may be adapted to operate from storage batteries. Each signal unit lens shall have a visible diameter of not less than 8 inches. Each unit complete shall be of such design as to render the lens when illuminated clearly visible to traffic facing the signal at all distances up to 1000 feet under all atmospheric conditions except dense fog. The color of the yellow lens for caution shall be in accordance with Technical Report No. 1 of the Institute of Traffic Engineers. All beacon flashers shall be equipped with filters for suppression of radio interference. The illuminating element in a flashing yellow beacon shall be flashed at a rate of not less than 50 times nor more than 60 times per minute. The illuminated period of each flash shall be not less than half and not more than two-thirds of the total cycle. The use of Flashing Beacons will be governed by field conditions. Flashing Beacons when warranted generally should be operated continuously throughout the 24 hours of the day. Warrant for Flashing Beacons may be found in Sec. 3G of the "Manual on Uniform Traffic Control Devices for Streets and Highways" published by the U.S. Department of Commerce, Bureau of Public Roads, June, 1961 (or latest revision).
- Flashers are portable, power-operated, lens-directed, enclosed lights, illuminated by rapid intermittent flashes of short duration. Flashers may be used in connection with barricades when approved by the Engineer. An array of random flashers which tends to obscure rather than delineate the traveled way will not be permitted. The use of flashers on a job will be governed by Sec. 5D of the "Manual on Uniform Traffic Control Devices for Streets and Highways" published by the U.S. Department of Commerce, Bureau of Public Roads, June, 1961 (or latest revision). The color of the light emitted by a flasher shall be yellow.
- Flashing Beacons and Flashers, when used, shall be positioned above the top rail of the barricades to produce the most effective results.
- Barricades used as "Traffic Controls for Highway Construction" are not to be paid for separately.
- Barricades will be paid for separately when designated on plans as bid items.
- For additional general information on control of traffic through work areas refer to the "Manual on Uniform Traffic Control Devices for Streets and Highway", Part V, published by the U.S. Department of Commerce, Bureau of Public Roads, June, 1961 (or latest revision).

## CLASS II BARRICADE (1 RAIL)

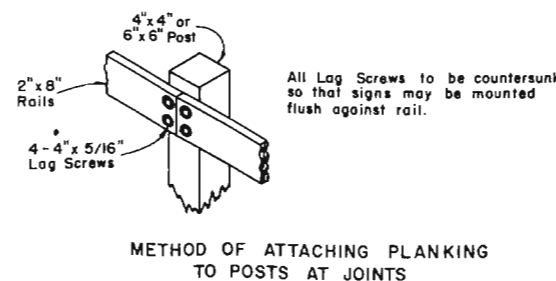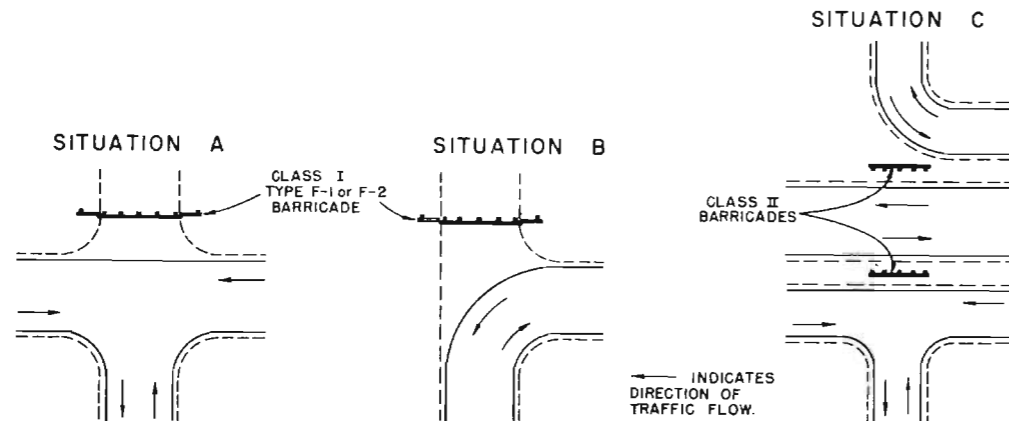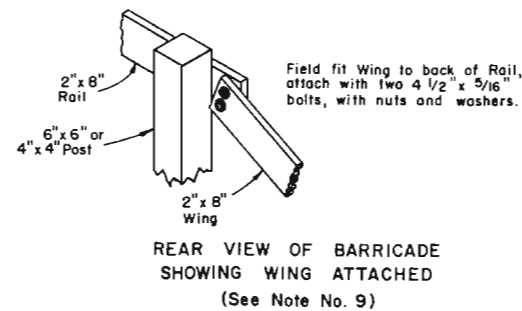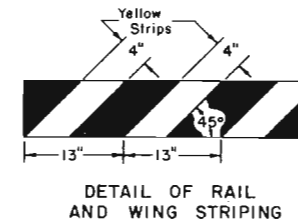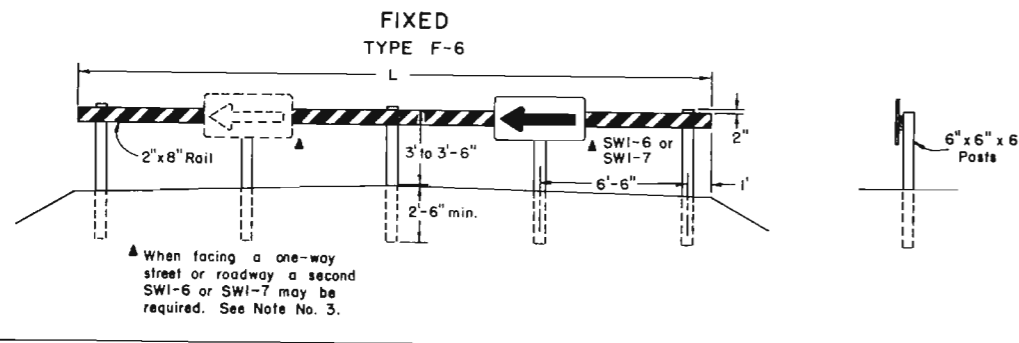

| Class | Type    |         | Roadway Width | L                   | Description   |
|-------|---------|---------|---------------|---------------------|---|
|       | Movable | Fixed   |               |                     |   |
| (R-1) | I       | M-1 F-1 | 26'-34'       | 28'                 | Barricade complete with SR13-1 sign and SWI-6 or SWI-7 signs as required.                           |
| (R-2) | I       | M-2 F-2 | 35'-44'       | 41'                 | Barricade complete with SR13-1 sign and SWI-6 or SWI-7 signs as required.                           |
| (R-1) | I       | M-3 F-3 | Variable      | 28'                 | Barricade (without extension wings) complete with SR13-1 sign and SWI-6 or SWI-7 signs as required. |
|       | I       | M-4 F-4 | Variable      | Variable 8'-6" min. | Wing Barricade (signs only as appropriate).   |
|       | II      | - F-6   | Variable      | 28'                 | Barricade complete with appropriate signs.  |

DEPARTMENT OF HIGHWAYS  
STATE OF COLORADO  
DIVISION OF HIGHWAYS

**TIMBER BARRICADES**

Designed By: D.R.W.  
Made By: JLS  
Checked By: J.B.

Approved By: *[Signature]*  
Date: JULY 1, 1965



# STANDARD M-614-IC

JULY 5, 1968  
(SHEET 1 OF 2 SHEETS)

| FEDERAL ROAD REGION NO. | DISTRICT | PROJ. NO. | SHEET NO. | TOTAL SHEETS |
|-------------------------|----------|-----------|-----------|--------------|
| 9                       | COLORADO |           |           |              |


| REVISIONS |         |                        |          |
|-----------|---------|------------------------|----------|
| (R-1)     | 7-26-68 | Rev. Legend and Notes  | G.W.F.   |
| (R-2)     | 5-20-69 | Rev. Lateral Placement | J. J. B. |
| (R-3)     | 9-25-70 | Rev. Legend            | J. J. B. |

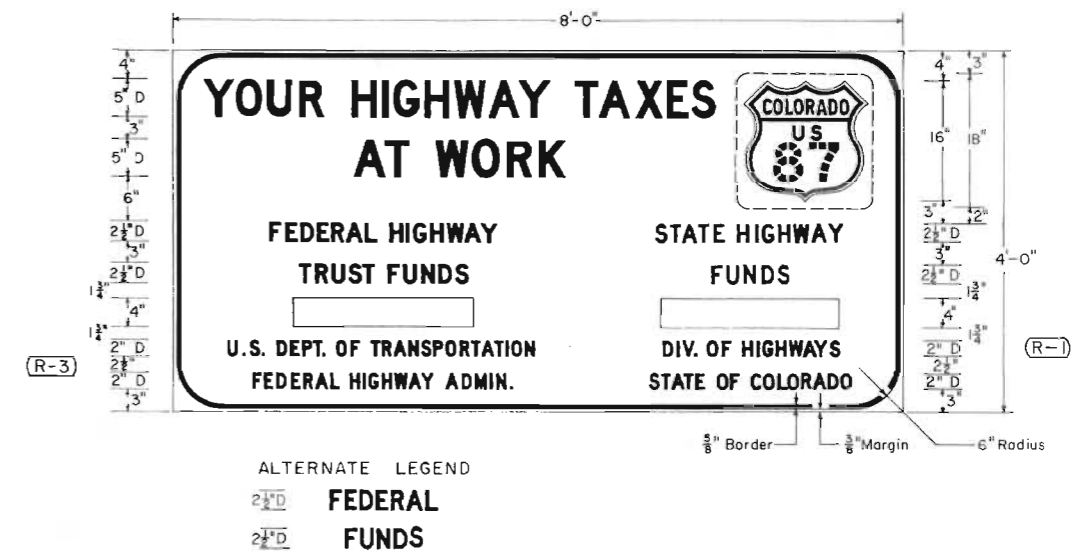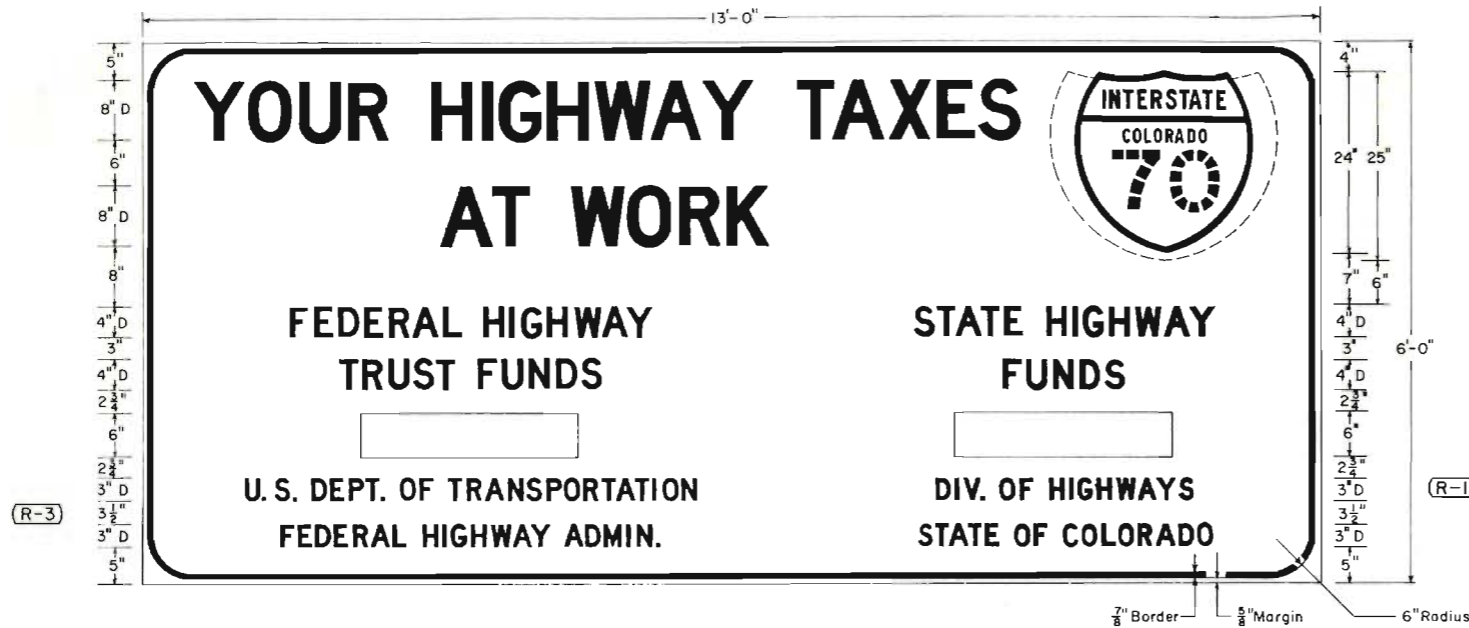

ALTERNATE LEGEND  
4" D FEDERAL FUNDS

ALTERNATE LEGEND  
2 1/2" D FEDERAL FUNDS

### FABRICATION DETAILS

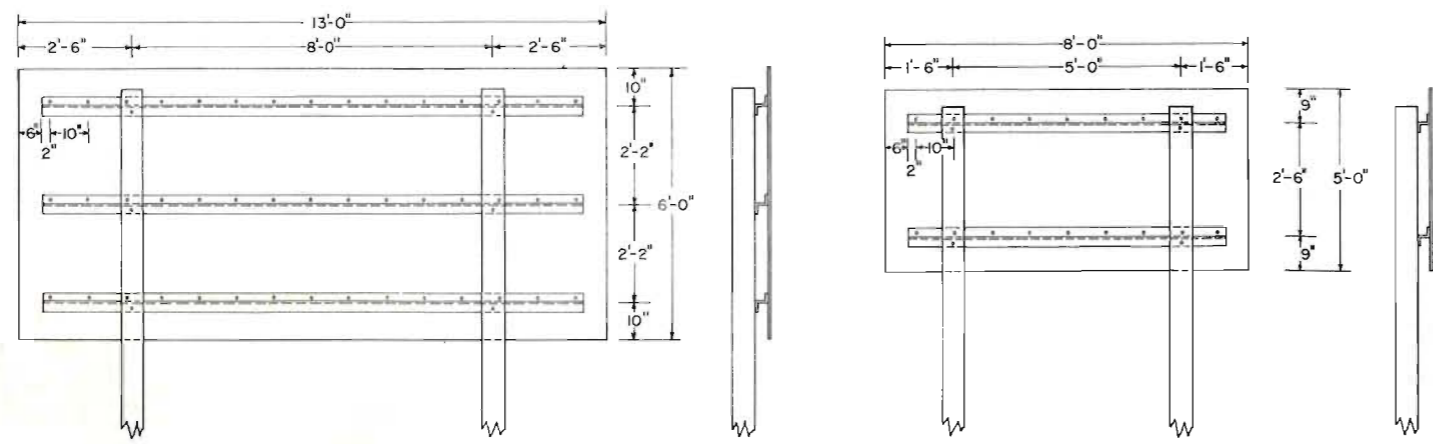


### "AMOUNT OF FUNDS" PLAQUE DETAILS



### GENERAL NOTES

- These signs shall be furnished and installed by state forces.
- All work shall be done in accordance with Standard Specifications applicable to the Project.
- Signs are to be placed facing traffic approaching the Project. They shall be installed at a location where they will not obscure or detract from the effectiveness of other official signs.
- The lateral placement may be reduced to a minimum of 2 ft. outside of the shoulder edge where necessary to fit field conditions.
- When these signs are used on Beautification Projects, the words "HIGHWAY" and "TRUST" in lines 3 and 4 shall be deleted and the words "FEDERAL" and "FUNDS" shall be used in accordance with the spacing as shown under "Alternate Legend".
- Sign panel shall be fabricated with 3/4" plywood.
- Route Marker plaques and "Amount of Funds" plaques shall be sheet aluminum 0.080" min. thickness.
- Signs shall have a screen processed black legend and border on a plain white background. "Amount of Funds" plaques shall have a screen processed black legend on a plain white background.
- Route Marker plaques shall be plain as indicated on the applicable standards.
- Backing zees shall be 3" x 2 3/4" x 1/4". Steel zees shall weigh 6.7 lbs. per ft. and aluminum zees shall be of 6061-T6 alloy weighing 2.33 lbs. per ft.
- Posts shall be 6"x6", S4S timber, painted white.
- Each timber post shall be provided with two 2" diameter holes through the neutral axis, one at 6" and one at 18" above the ground level. The inside portion of each 2" diameter hole shall be painted white.
- Panels shall be fastened to backing zees with 1/4" thrust head lockbolt fasteners.
- Backing zees shall be fastened to posts with 3/8" machine bolts.
- Route Marker plaques and "Amount of Funds" plaques shall be fastened to the sign panels with 5/8" #9 round head wood screws.
- Exposed lockbolt fastener heads and wood screw heads on the face of the sign shall be dipped or painted to match the surrounding color.
- The underground portion of each timber post shall be treated with creosote.
- Where a third governmental agency is shown as participating, its official name should be included centrally in lines 6, 7, and 8.
- It will not be necessary to change DEPT. to DIV. on any existing signs.

### INSTALLATION DETAIL

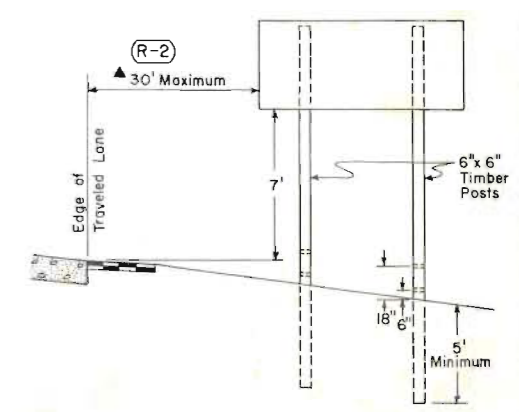

DEPARTMENT OF HIGHWAYS  
STATE OF COLORADO  
DIVISION OF HIGHWAYS

**STANDARD CONSTRUCTION IDENTIFICATION SIGNS**

Designed By: J.L.S. Approved By: *[Signature]*  
Made By: F.J.B. Traffic Engineer  
Checked By: G.W.F. Date: July 5, 1968




# STANDARD M-614-TB

(SHEET 1 OF 3 SHEETS)  
(JULY 1, 1965)

| FEDERAL ROAD REGION NO. | DIVISION  | PROJECT NO. | SHEET NO. |
|-------------------------|-----------|-------------|-----------|
| 9                       | 681-5RADD |             |           |

| REVISIONS |          |   |        |
|-----------|----------|---|--------|
| (R-1)     | 7-12-57  | Note 23   | G.W.F. |
| (R-2)     | 7-8-68   | Rev. Break-away, Placement, Code No. 5, B. Dept. Name | G.W.F. |
| (R-3)     | 12-24-68 | Rev. U.S. Shields                                     | J.L.S. |

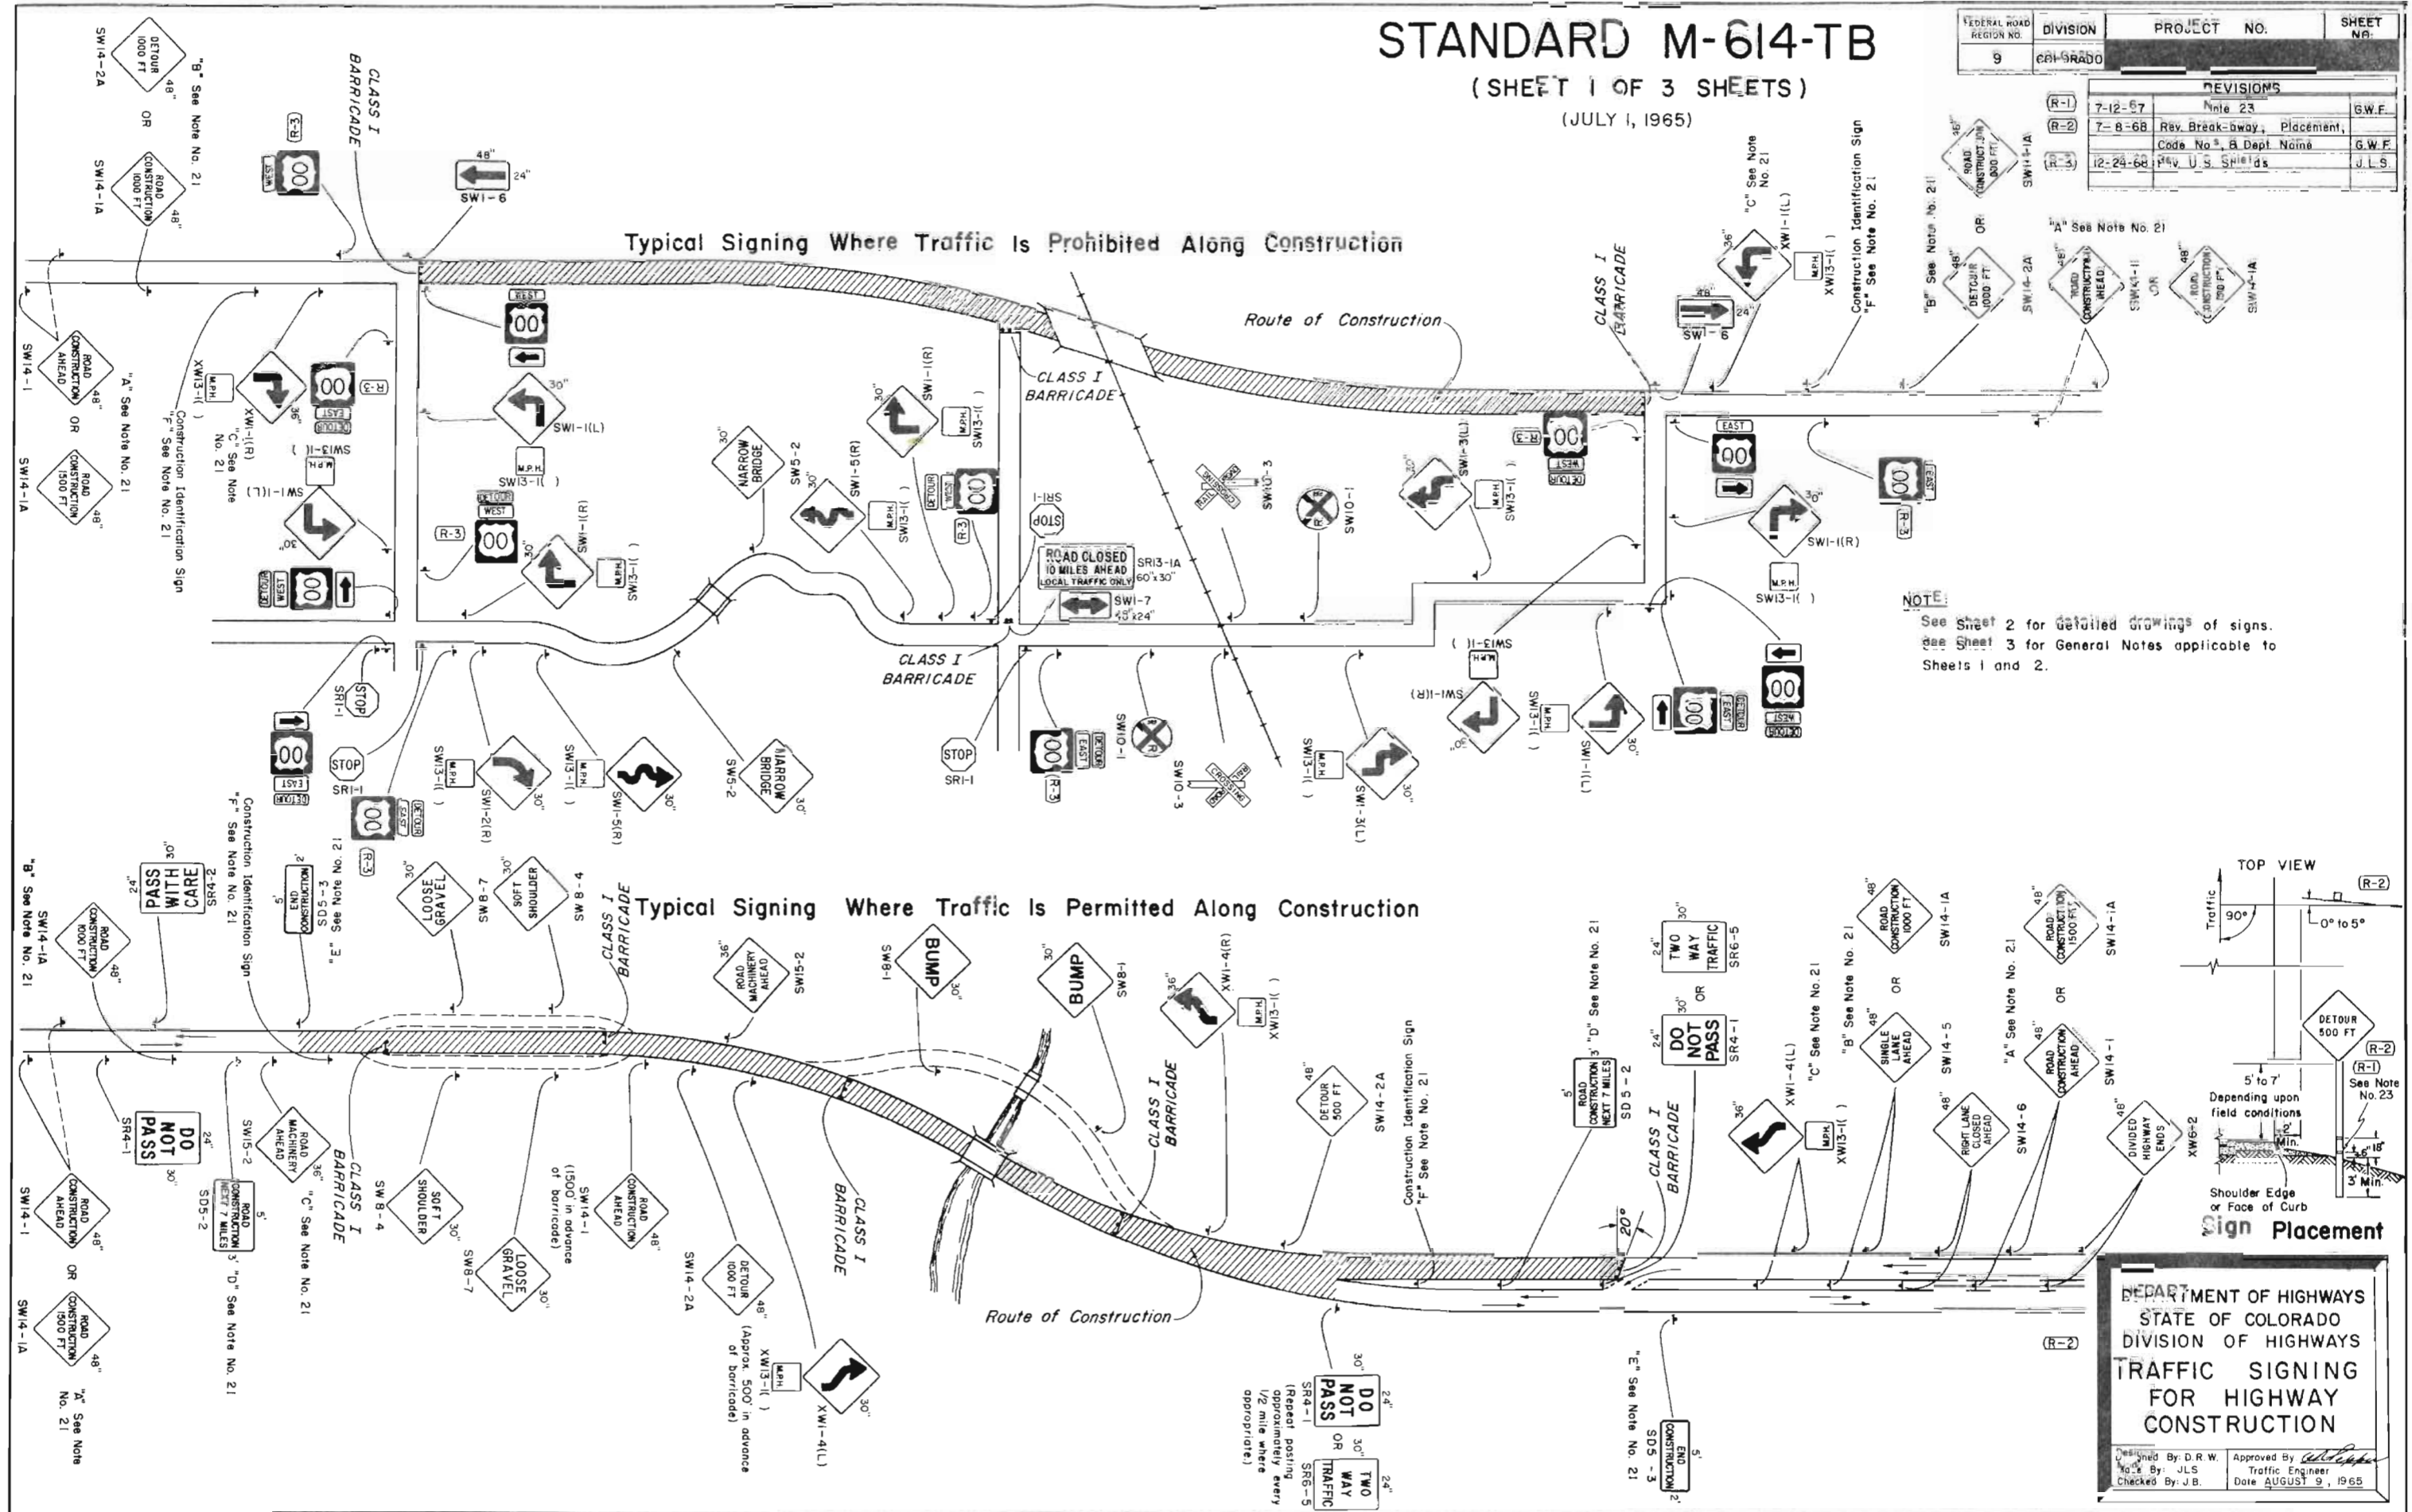

**NOTE:**  
See Sheet 2 for detailed drawings of signs.  
See Sheet 3 for General Notes applicable to Sheets 1 and 2.

**DEPARTMENT OF HIGHWAYS**  
**STATE OF COLORADO**  
**DIVISION OF HIGHWAYS**  
**TRAFFIC SIGNING**  
**FOR HIGHWAY**  
**CONSTRUCTION**

Designed By: D.R.W.  
Checked By: J.B.

Approved By: [Signature]  
Traffic Engineer  
Date: AUGUST 9, 1965

# STANDARD M-614-TB

(SHEET 2 OF 3 SHEETS)


(JULY 1, 1965)

| FEDERAL ROAD REGION NO. | DIVISION | PROJECT NO. | SHEET NO. |
|-------------------------|----------|-------------|-----------|
| 8                       | COLORADO |             |           |

| REVISIONS |          |                            |        |
|-----------|----------|----------------------------|--------|
| (R-1)     | 7-12-67  |                            | M.R.H. |
| (R-2)     | 7-8-68   | Rev. Code No. & Dept. Name | G.W.F. |
| (R-3)     | 12-24-68 | Added Notes                | J.L.S. |


## REGULATORY SIGNS

See Note No. 9

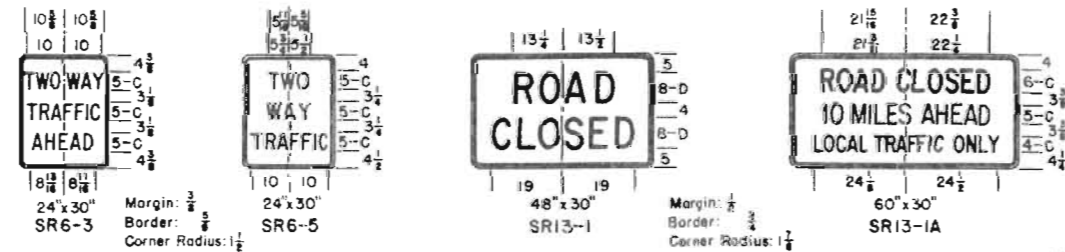




## WARNING SIGNS

See Note No. 10


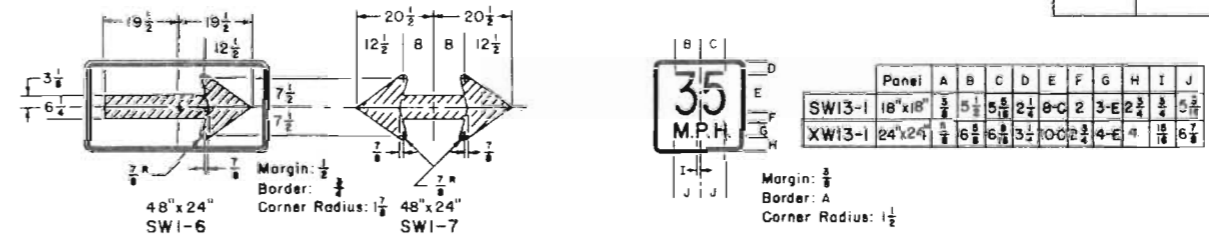


## WARNING SIGNS

See Note No. 10

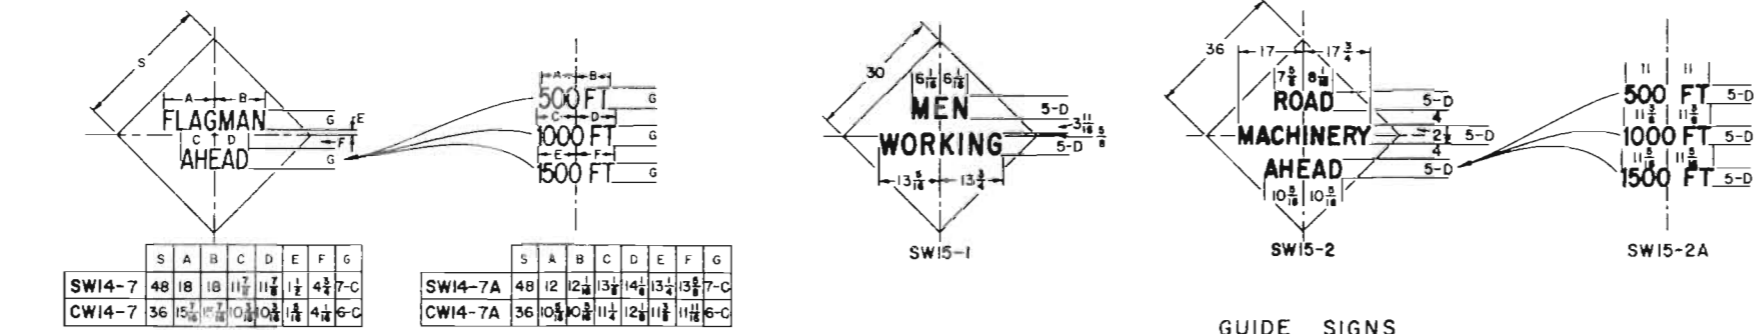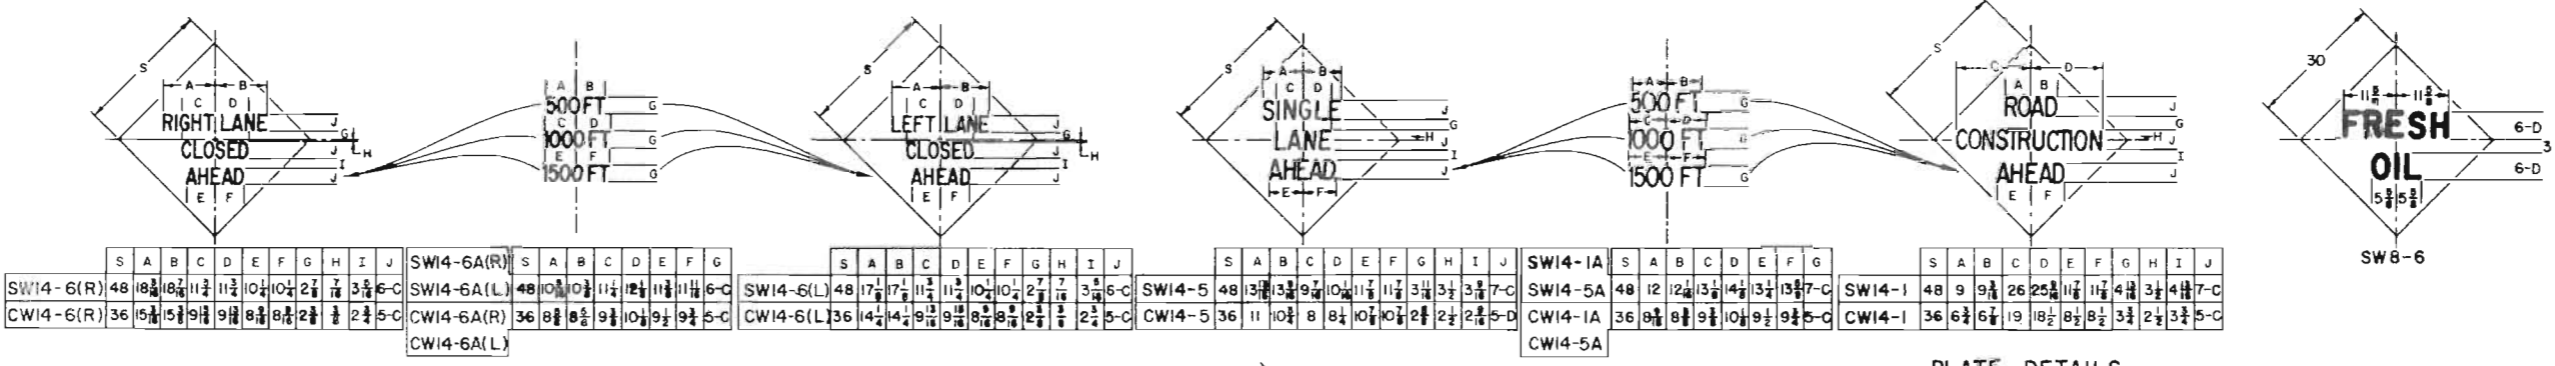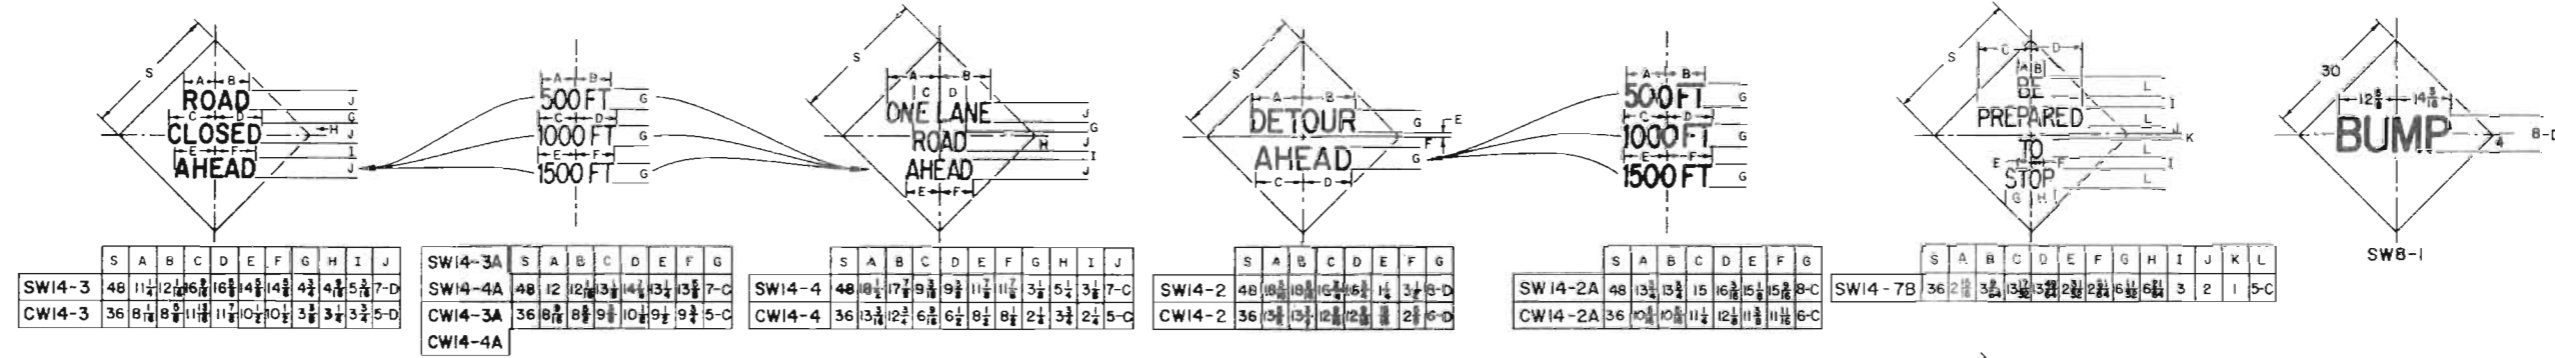


## PLATE DETAILS

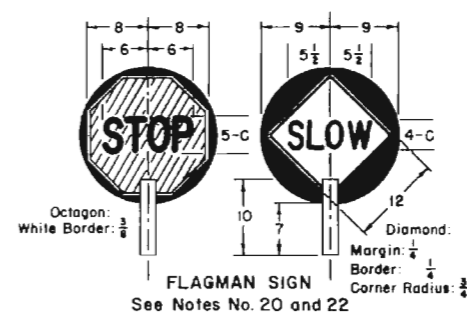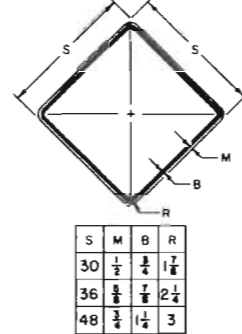

## GUIDE SIGNS

See Note No. 11

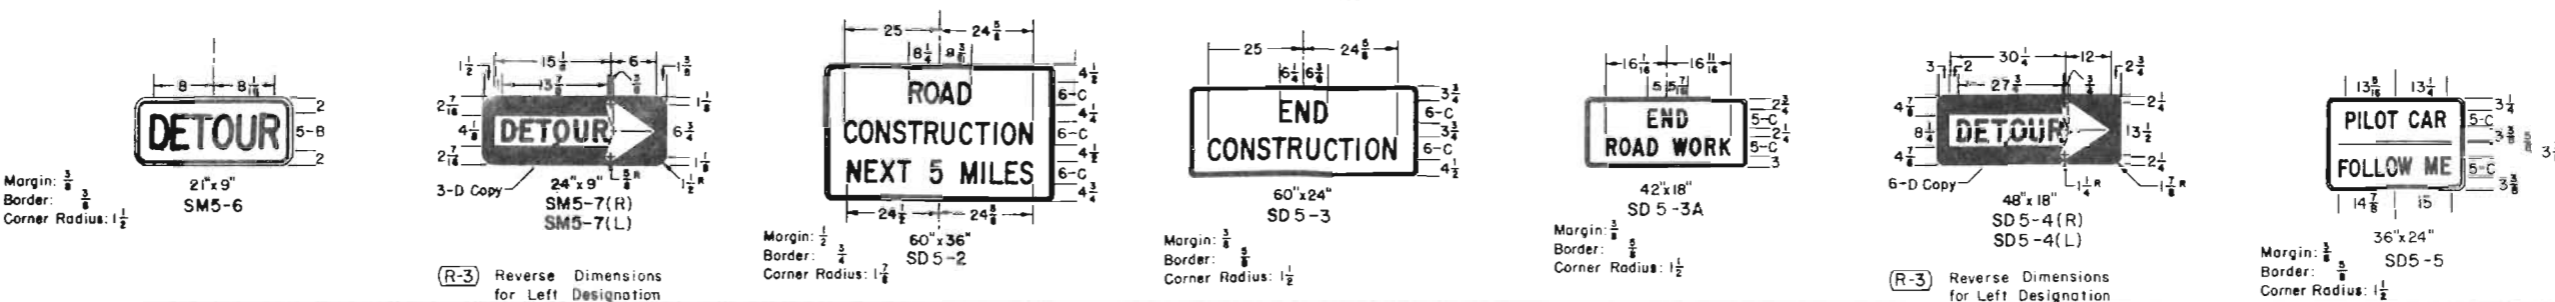

**NOTES:**  
SEE SHEET 1 FOR TYPICAL SIGNING AND SIGN PLACEMENT.  
SEE SHEET 3 FOR GENERAL NOTES APPLICABLE TO SHEETS 1 AND 2.

ALL DIMENSIONS THAT ARE NOT LABELED ARE IN INCHES.

DEPARTMENT OF HIGHWAYS  
STATE OF COLORADO  
DIVISION OF HIGHWAYS  
TRAFFIC SIGNING FOR HIGHWAY CONSTRUCTION

Designed By: D.R.W. Approved By: [Signature]  
Made By: H.B.D. Traffic Engineer  
Checked By: J.B. Date: AUGUST 9, 1965

# STANDARD M-614-TB

(SHEET 3 OF 3 SHEETS)

(JULY 1, 1965)

|                         |          |             |           |
|-------------------------|----------|-------------|-----------|
| FEDERAL ROAD REGION NO. | DIVISION | PROJECT NO. | SHEET NO. |
| 9                       | COLORADO |             |           |

| REVISIONS |          |  |        |
|-----------|----------|--|--------|
| (R-1)     | 7-12-67  | Added Note 23                            | G.W.F. |
| (R-2)     | 7-8-68   | Rev. Note 23 & Dept. Name - Deleted Note | G.W.F. |
| (R-3)     | 12-24-68 | Rev. Note No. 18                         | J.L.S. |

## GENERAL NOTES

1. All work shall be done in accordance with: (a) the Standard Specifications applicable to the Project, and (b) the "Manual on Uniform Traffic Control Devices for all Classes of Streets and Highways" published by the Department of Highways.
2. Where traffic is maintained through or over any part of the Project the Contractor will be required to mark all hazards within the limits of the Project (including connecting roads) with well-maintained Barricades, Warning, and Guide Signs. All Barricades and Signs shall be moved, added to, changed or removed as required during the progress of construction and removed entirely when the Project is completed.
3. Where traffic is prohibited from the Project the Detour will be marked by the Department except that the Contractor shall provide, erect and maintain Barricades, complete, (when required) at the ends of the Project, ends of the Detour and connecting roads. All U.S. or State Route Markers required for the Project will be furnished and installed by the Department. The location and positioning of Warning Signs, Barricades, and Regulatory Signs shall be as recommended by the appropriate District Engineering Forces of the Department.
4. Work on the Project shall not be started until all required signs are in place and approved by the Engineer. Where speed control appears necessary such speed control shall be requested from the Engineer by the Contractor. Control of speed through a construction zone may be achieved by Advisory Speed plates in conjunction with Warning Signs (SW13-1 for use with 30" Warning Signs and XW13-1 for use with 36" and 48" Warning Signs). The Advisory Speed plate is to be posted only at those locations where the safe speed is lower than the imposed Regulatory speed limit.
5. All Signs and Barricades shall be placed for best visibility and legibility, maintained in good condition and kept clean and free of dirt at all times. Contractor's and Engineer's vehicles and equipment must be parked so that signs and barricades are visible to approaching traffic at all times.
6. Where two identical signs are used for dual posting they are to be staggered on the two sides of the roadway for a minimum distance of 75' to avoid a tunneling effect.
7. Examples for marking Projects, as shown on Sheet 1, are typical of signs required and are subject to alteration to fit actual conditions encountered in the field. Locations for control devices are to be staked by the Engineer. In all cases Warning signs are to be placed well in advance of the hazard, the distance depending on topography and existing approach speeds. Additional markings and any special signs required for the guidance and protection of traffic will be placed as required on the Project at the Contractor's expense.
8. Desirable sizes for signs are shown on Sheet 1 of this Standard. Larger or smaller signs shall be used where warranted. Detailed dimensions for signs normally used in connection with construction are shown on Sheet 2 of this Standard. For information on standard roadway signs not detailed on this Standard see the "Manual on Uniform Traffic Control Devices for all Classes of Streets and Highways" published by the Department of Highways.
9. Signs with the prefix "R" in the sign code are Regulatory signs and as such impose legal compulsions or restrictions on drivers and should only be used as authorized by the Engineer.
10. Signs with the prefix "W" in the sign code are Warning signs and are used to alert traffic to existing or potentially hazardous conditions.
11. Signs with the prefix "D" or "M" in the sign code are Guide signs. Those with the prefix "D" convey general information and those with the prefix "M" are used for marking the traffic route.
12. All signs shall be reflectorized unless otherwise specified on plans. Regulatory and Guide signs (unless otherwise specified) shall have a screen processed black legend and border on a white flexible reflective sheeting, non-exposed lens background. The back side of Regulatory and Guide signs shall be painted with two coats of "Exterior Sign White Paint." Warning signs shall have a screen processed black legend and border on a highway yellow flexible reflective sheeting, non-exposed lens background. The back side of Warning signs shall be painted with two coats of "Federal Yellow Synthetic Sign Enamel."
13. Painting for wood surfaces shall conform with Section 508 of the Standard Specifications.
14. Posts for regulatory, warning, and guide signs will normally be 4"x4" or 6"x6" and shall conform to the Standard Specifications for Untreated Timber-S4S. Timber shall conform to Construction grade Paragraph 123B or 125B of Standard No. 15 Grading & Dressing Rules for West Coast Douglas Fir (1956) or Dense Structural 58 and LL Structural 58 Paragraph 284 or 285 of 1956 Grading Rules for Southern Pine. Posts shall be painted with one coat of "White Wood Primer" and one coat of "Outside White Paint."
15. Sign panels furnished by the Contractor for use only during construction may be fabricated from plywood, aluminum, steel or other suitable material but shall be stable and durable enough to meet other requirements of this Standard.
16. All material shall be sound and durable. Barricades, signs, symbols, and lettering shall be of good workmanship. Uneven lettering will not be accepted.
17. Alternate methods of processing signs or the substitution of symbols or other reflecting elements for painted symbols will be permitted only after approval by the Department.
- (R-3) 18. Lanterns and Torches - Lanterns, with red globes, shall be used only in low speed urban areas. Open-flame torches shall not be used under any circumstances.
19. Barricades, Flashing Beacons and Flashers - Refer to appropriate "M" Standard (Timber Barricades) for details.
20. Flagman Sign - This sign shall have a black painted background on both sides to form a contrast for the octagonal Stop sign and the diamond Warning sign. The "STOP" sign shall be fabricated by reverse screen process using transparent red paint on smooth surface silver reflective sheeting. The "SLOW" side of the Flagman Sign shall be black process paint on smooth surface yellow reflective sheeting. Handle to be grooved on one side to indicate reading of sign to Flagman.
21. Sign "A": This is the first advance warning sign and shall be placed 1,500 feet ahead of Barricade or project terminal. Postings are required on both sides of the roadway on divided highways. Dual posting is required where warranted on two-lane, two-way highways.  
Sign "B": This is the second advance warning sign and shall be placed 1,000 feet ahead of barricade or project terminal. Postings are required on both sides of the roadway on divided highways and singly on two-lane, two-way highways.  
Sign "C": This is the third advance warning sign in cases where barricades are used and shall be placed 500 to 750 feet ahead of barricade or potentially hazardous condition. Postings are required on both sides of the roadway on divided highways and singly on two-lane, two-way highways.  
Sign "D": SD5-2 - This sign shall be placed to mark the beginning of a Project of more than 2 miles in extent, where traffic is maintained through the project. It shall be placed singly and near the beginning of construction.  
Sign "E": SD5-3 - This sign shall be placed to mark the end of the Project. It shall be placed singly and may be placed opposite barricade if desirable.  
Sign "F": Construction identification signs shall be furnished and installed by the Department on all Federal-Aid and Forest Highway Projects where actual construction is in progress and visible to highway users. These signs should be located so as not to obscure or detract from the effectiveness of other official signs. Where two or more projects are contiguous the appropriate data may be included in one set of signs. Refer to appropriate "M" Standard (Identification Signs) for sign details.  
Signs A through F shall be furnished, installed and maintained by the Department.
22. When Flags are used in lieu of the Flagman Sign, they shall be a minimum of 18"x18", made of a good grade of bright red material, and fastened securely to a staff of approximately 3 foot length. The free edge should be weighted to insure that the flag will hang vertically, even in heavy winds.
- (R-1) 23. Each 6"x6" timber sign post shall be provided with two 2" diameter holes through the neutral axis normal to the roadway, one hole at 6" and one hole at 18" above the ground level. The 4"x4" timber posts shall not be provided with any type of break-away device. The inside portion of each 2" diameter hole shall be painted white. The underground portion of each timber post shall be treated with creosote.

(R-2)

(R-2)

DEPARTMENT OF HIGHWAYS  
STATE OF COLORADO  
DIVISION OF HIGHWAYS  
TRAFFIC SIGNING  
FOR HIGHWAY  
CONSTRUCTION

Designed By: D.R.W.      Approved By: *[Signature]*  
Made By: J.L.S.              Traffic Engineer  
Checked By: J.F.              Date: AUGUST 9, 1965


# STATE DEPARTMENT OF HIGHWAYS DIVISION OF HIGHWAYS—STATE OF COLORADO

RE & UTILITIES UNDER PROJECT  
NO. T 7300(3)  
ROW UNDER PROJECT NOS.  
C 02-0096-23 & T 7300(3)

|                         |          |             |           |
|-------------------------|----------|-------------|-----------|
| FEDERAL ROAD REGION NO. | DIVISION | PROJECT NO. | SHEET NO. |
| 9                       | COLORADO | T 7300(3)   | 1         |

RIGHT OF WAY  
LINCOLN, VETA, & THATCHER  
INDEX OF SHEETS

| REVISIONS |  |
|-----------|--|
|           |  |
|           |  |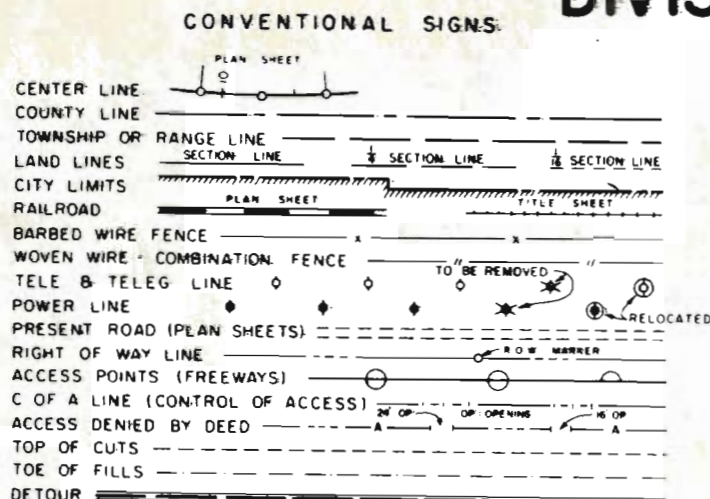
## PLAN AND PROFILE OF PROPOSED FEDERAL AID PROJECT NO. T 7300(3) STATE HIGHWAY NO. 96 PUEBLO COUNTY

SHEET NO.  
1  
2  
3-4

TITLE SHEET  
TABULATION OF PROPERTIES  
LINE SHEETS

SCALES OF ORIGINAL DRAWINGS  
ON PLAN 1 IN = 20 FT  
ON PROFILE 1 IN = 50 FT HORIZONTAL  
1 IN = 5 FT VERTICAL  
GRADE LINE ON PROFILE IS SHOWN AS GRADE OF FINISHED ROAD

**RIGHT OF WAY**  
LENGTH OF PROJECT IN R.O.W. = 0.078 Mile

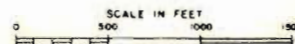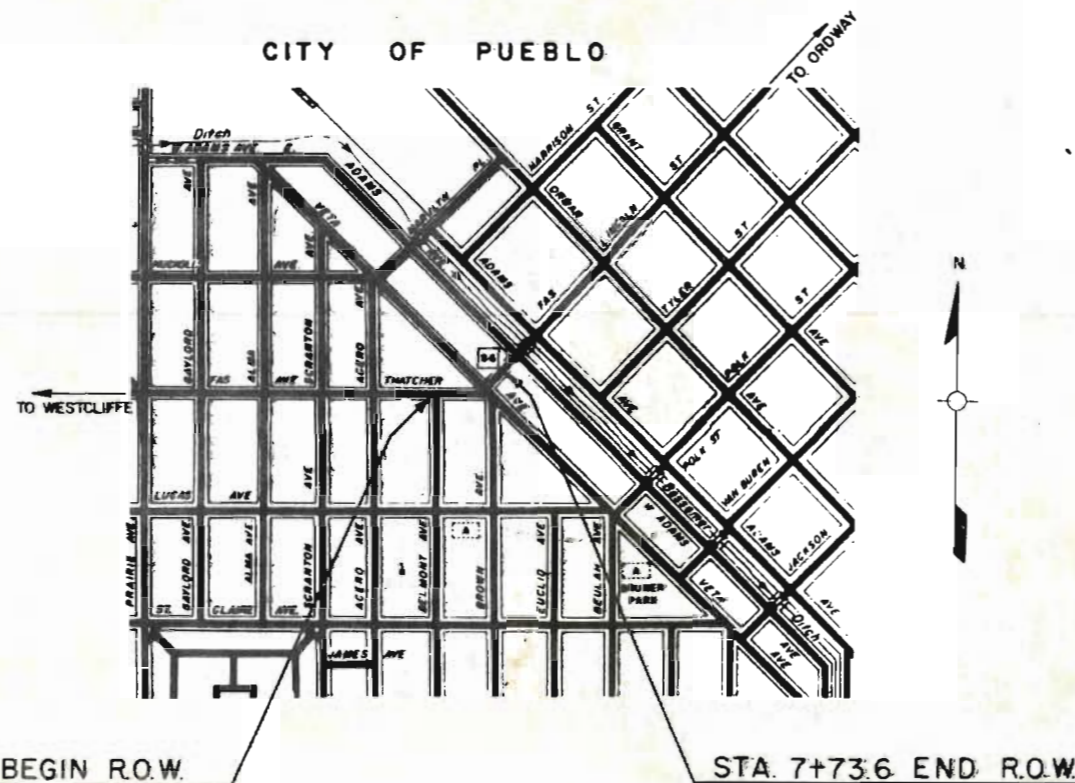

FILE COPY  
DO NOT REMOVE



SW 1/4 SEC. 35  
T20S., R.65 W

|                           |          |           |           |              |
|---------------------------|----------|-----------|-----------|--------------|
| FEDERAL ROAD DISTRICT NO. | DIVISION | PROJ. NO. | SHEET NO. | TOTAL SHEETS |
|                           | CORRIDOR | T 7300(3) | 3         |              |

RIGHT OF WAY  
LINCOLN, VETA, & THATCHER

| REVISIONS |  |
|-----------|--|
|           |  |
|           |  |
|           |  |
|           |  |

ORIGINAL SCALE 1"=20'

ARVONIA

8 ALLEY

ACERO AVENUE

ACERO AVENUE

THATCHER AVENUE


THATCHER AVENUE

BELMONT AVE.

STA. 3+62.8 BEGIN R.O.W.

Sta. 0+00.0 Projected =  
120' Rt. Sta. 0+00.0 Survey

Survey Book No.s 31430 & 31467

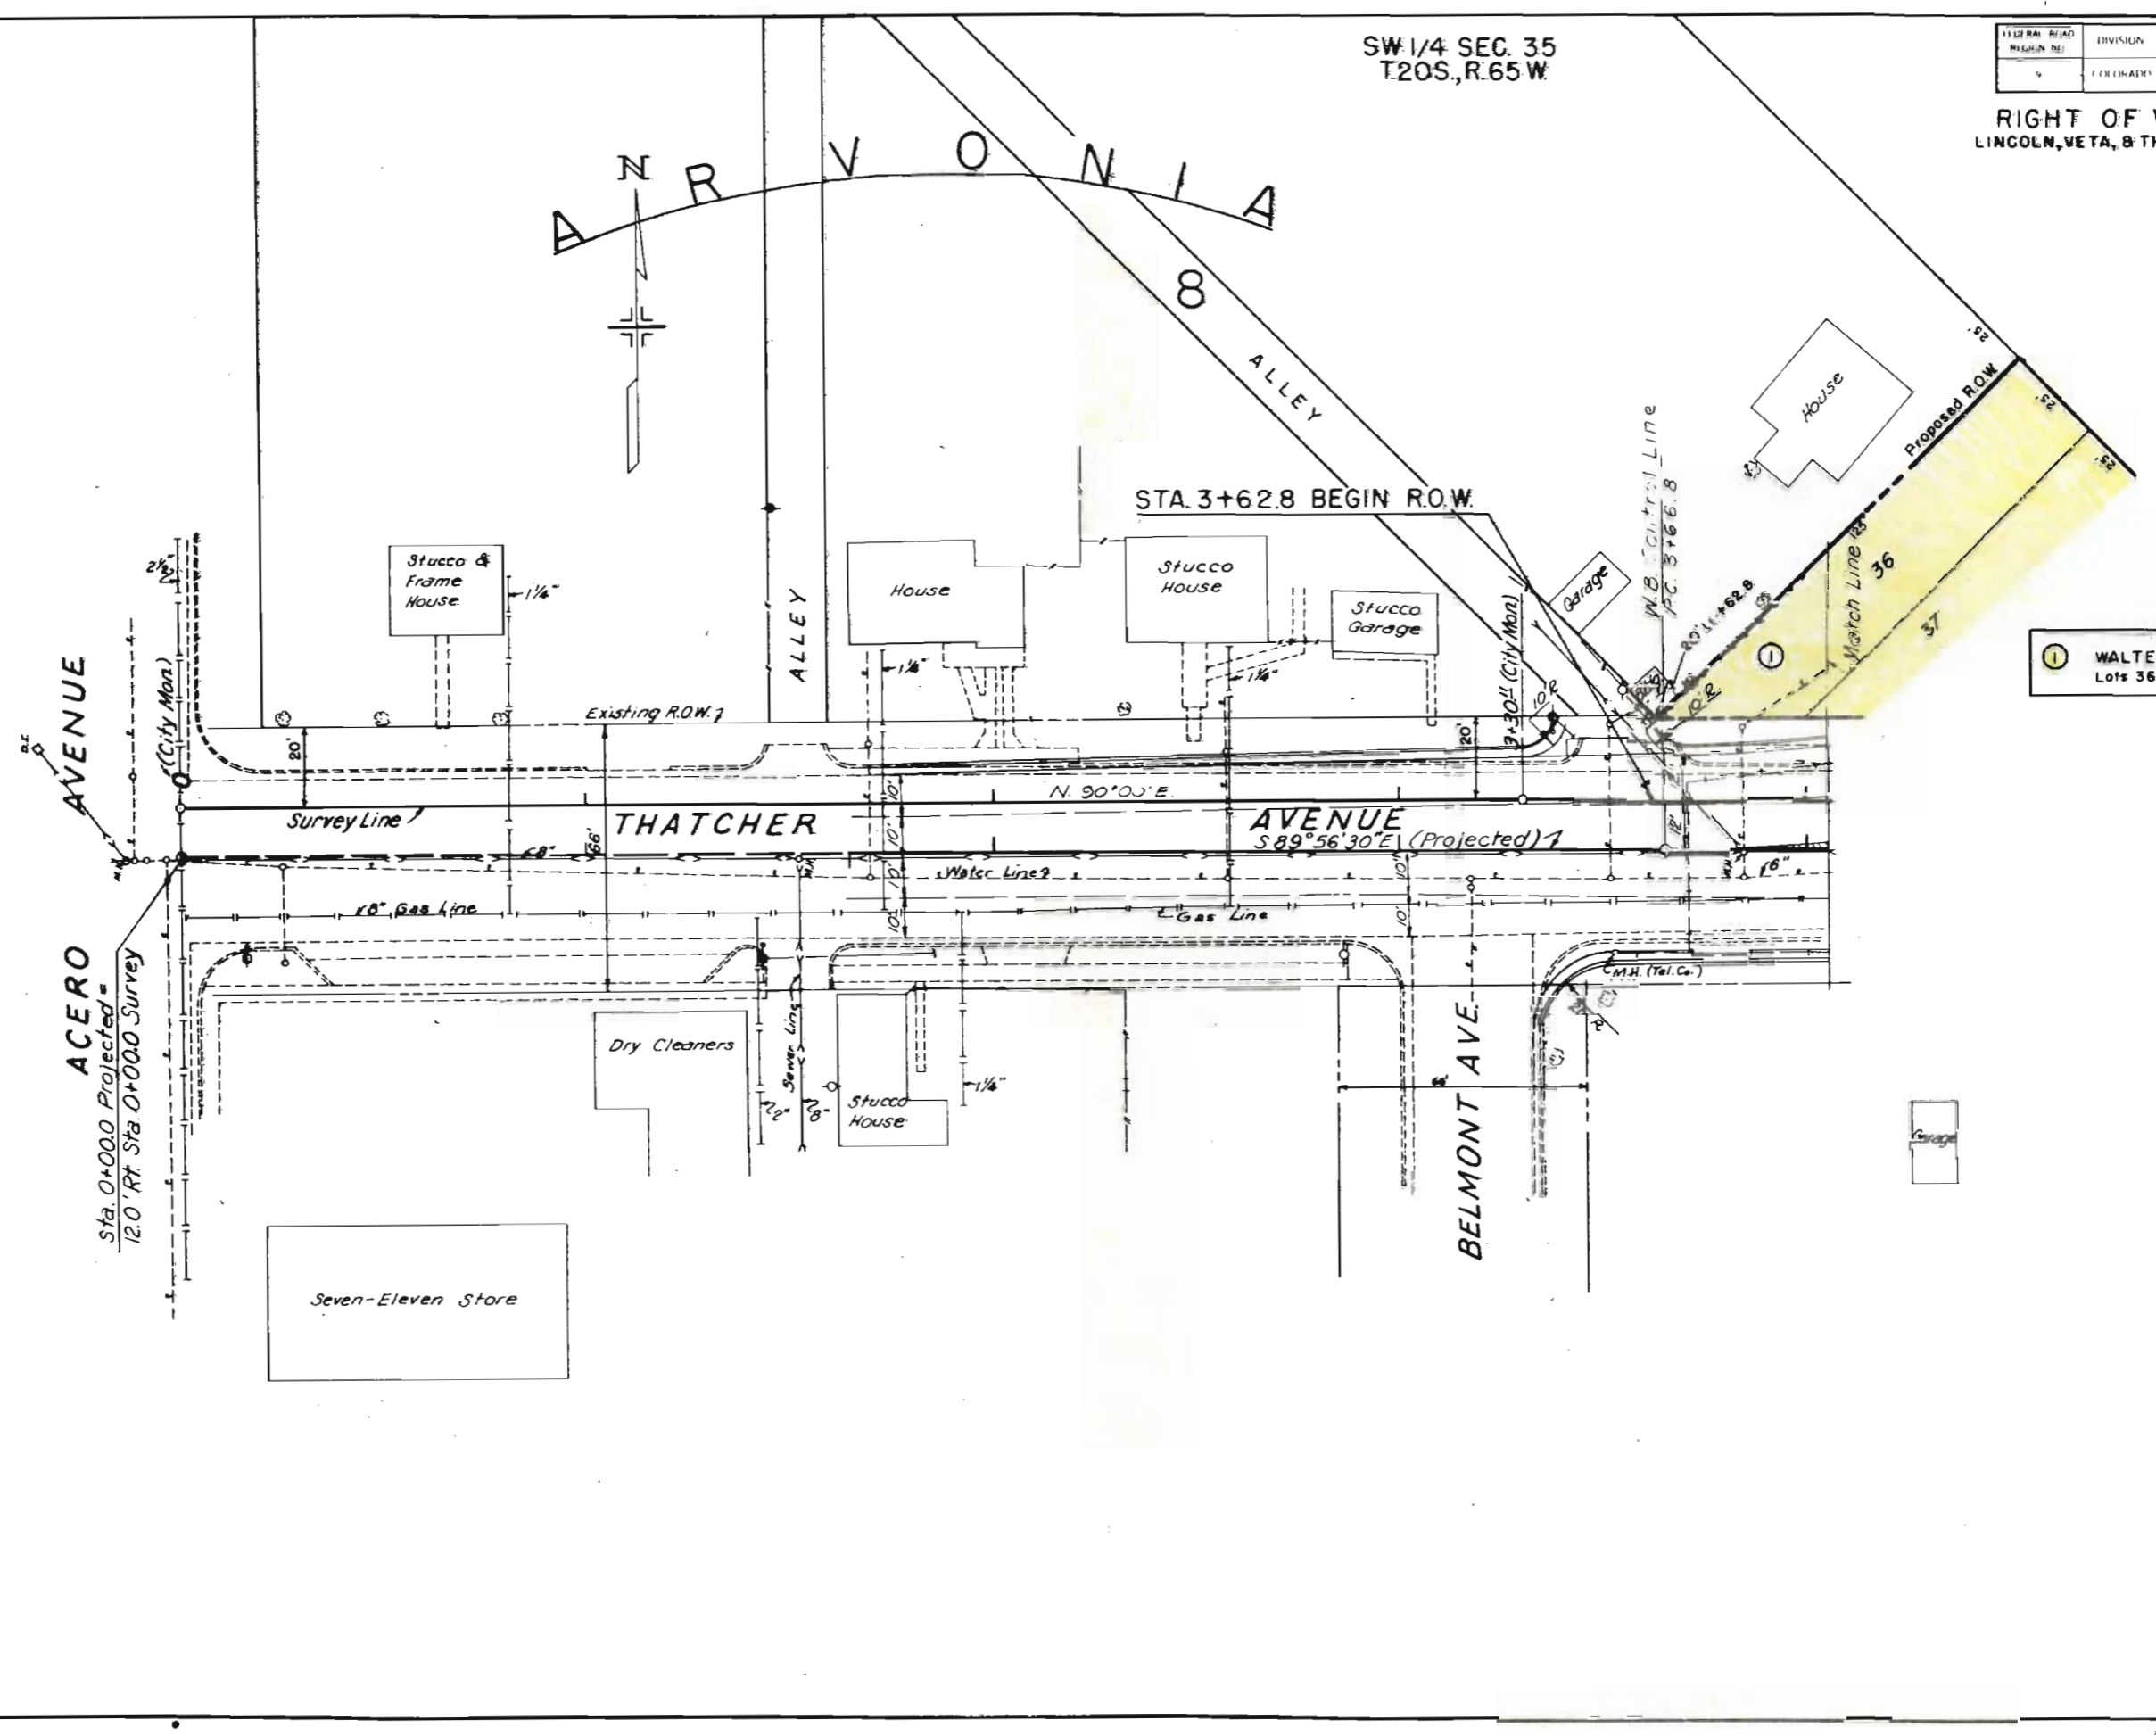

① WALTER K. MURD (Dec.)  
Lots 36, 37, 38 and 39 of Block 8, in Arvonie

|                           |          |             |           |              |
|---------------------------|----------|-------------|-----------|--------------|
| FEDERAL ROAD DISTRICT NO. | DIVISION | PROJECT NO. | SHEET NO. | TOTAL SHEETS |
|                           | 1014-609 | T 7300(3)   | 4         |              |


| REVISIONS |  |
|-----------|--|
|           |  |
|           |  |
|           |  |
|           |  |

ORIGINAL SCALE 1"=20'

RIGHT OF WAY  
 LINCOLN, VETA, & THATCHER

**ARVONIA**  
 Recorded in Book 6, Page 19

SW 1/4 SEC 30  
 T20S, R.65W

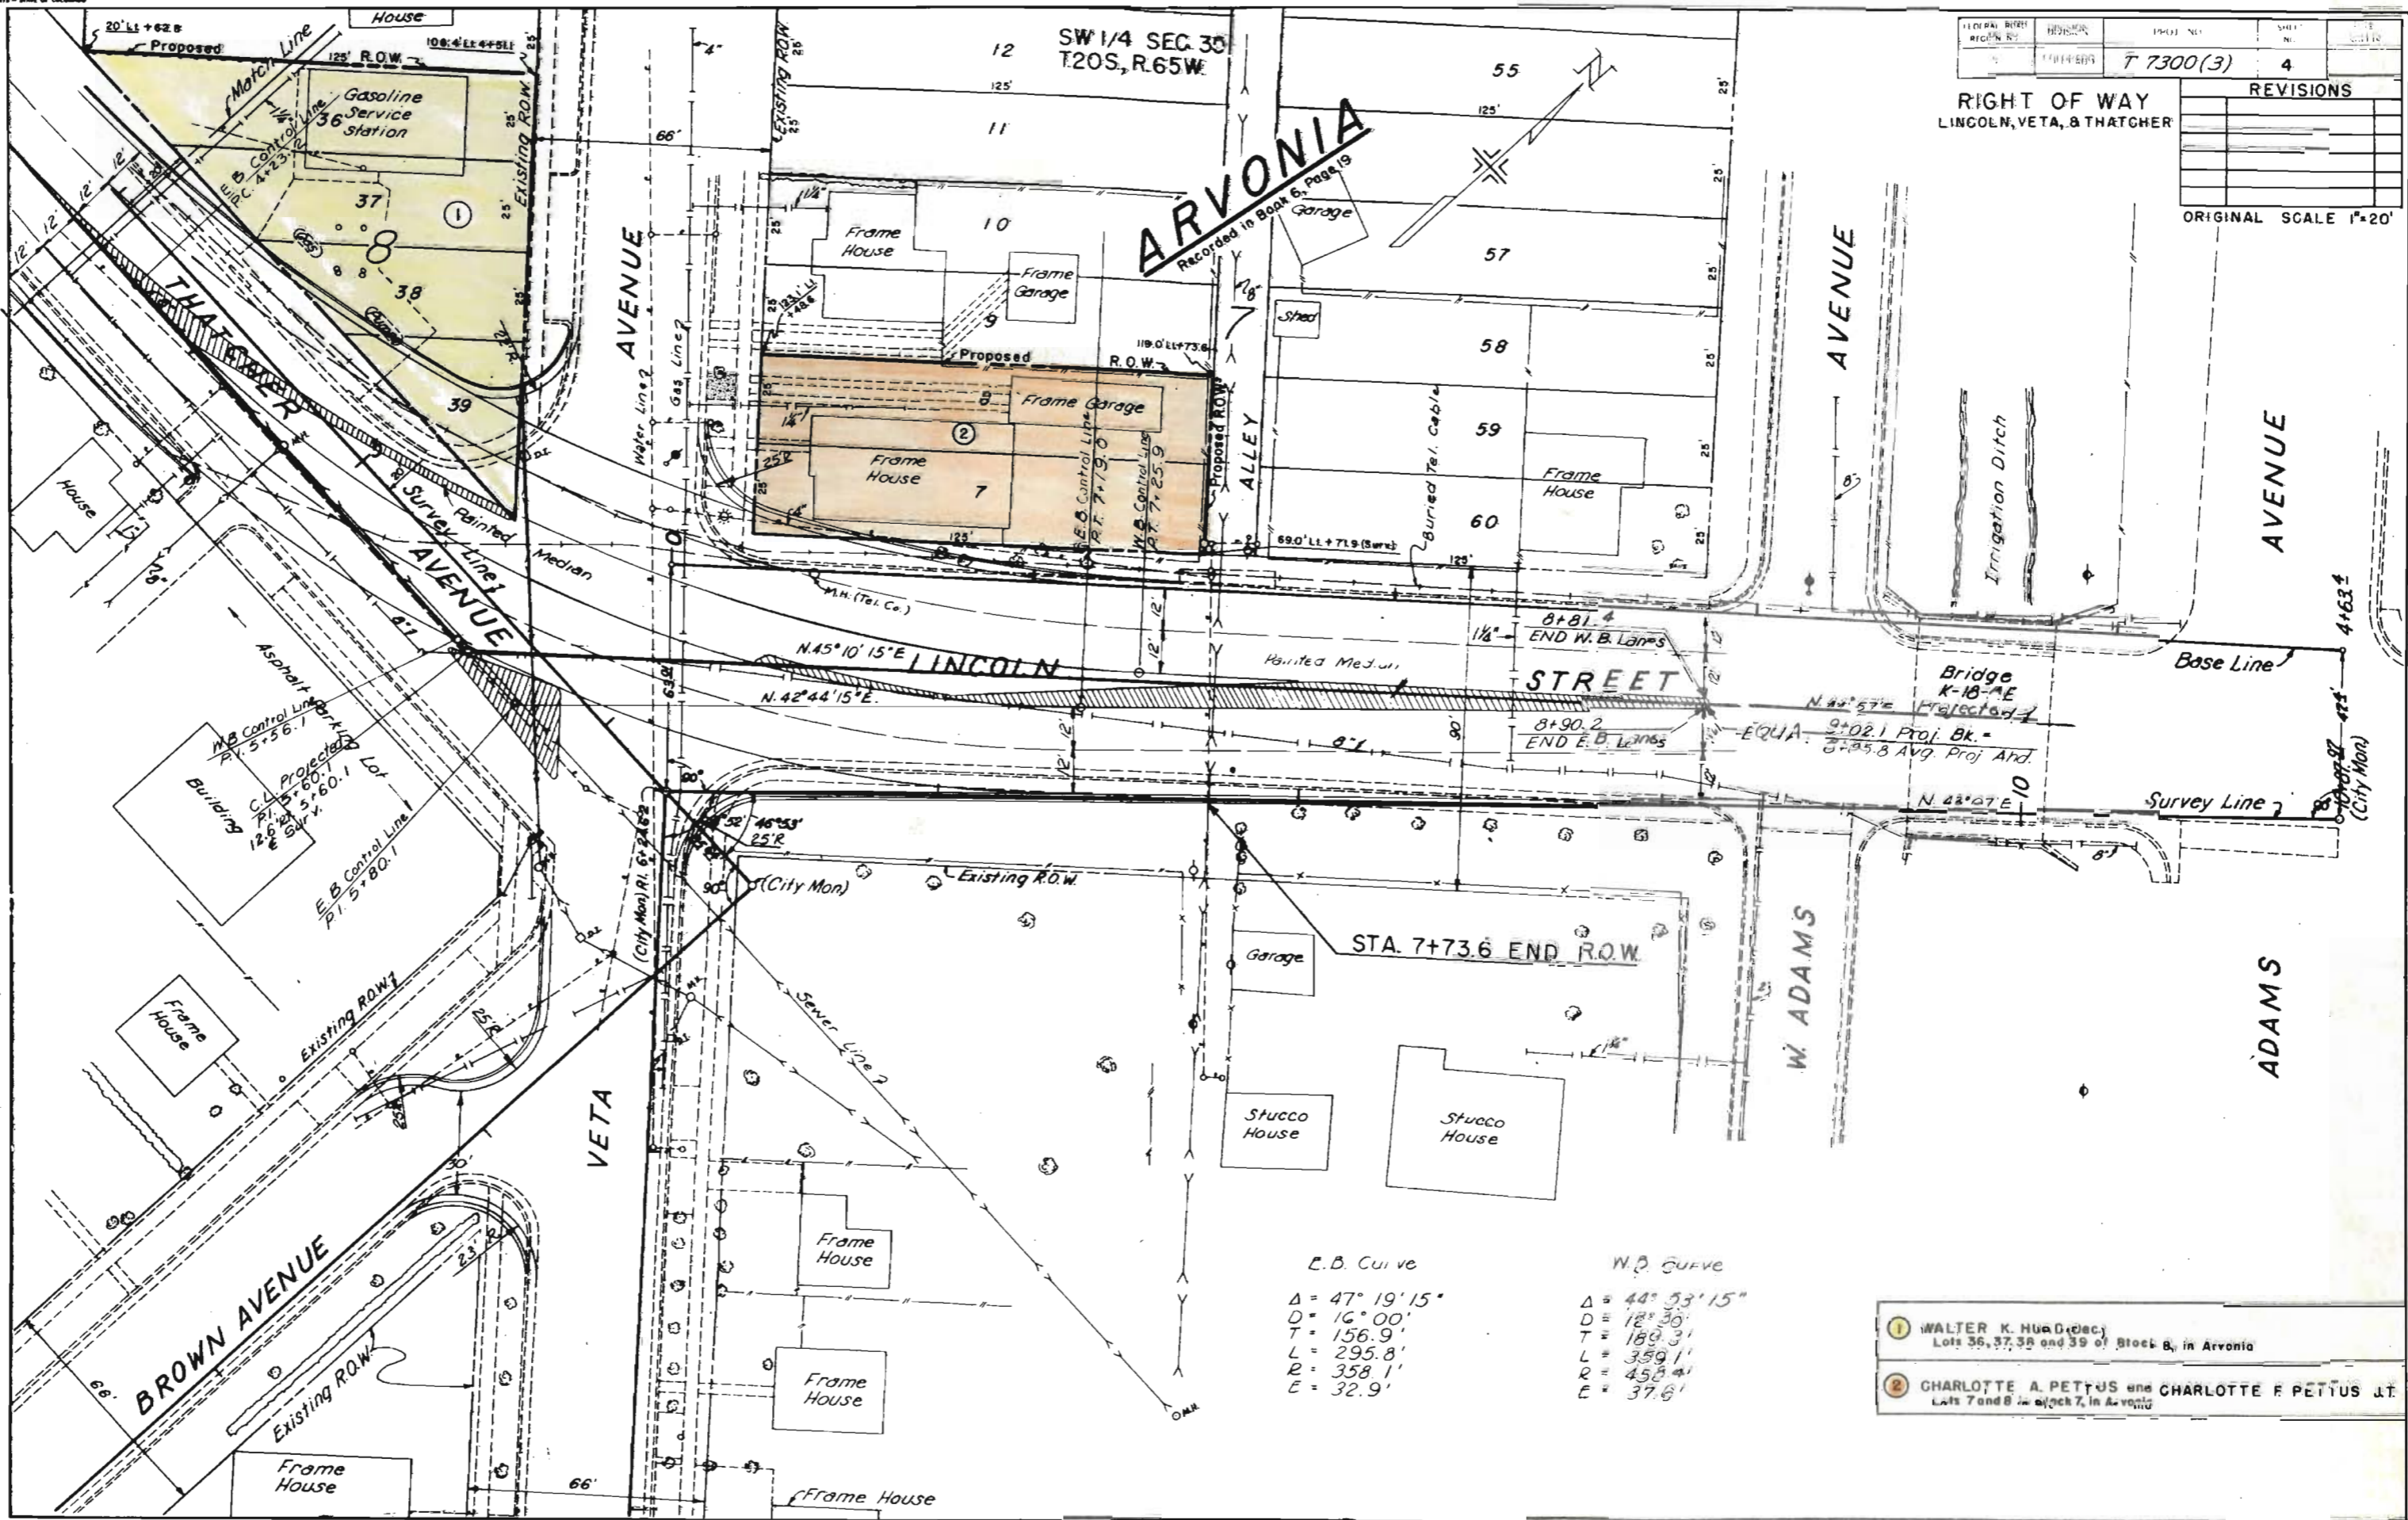

Survey Book Nos 31430 & 31467

**E.B. Curve**  
 Δ = 47° 19' 15"  
 D = 16' 00"  
 T = 156.9'  
 L = 295.8'  
 R = 358.1'  
 E = 32.9'

**W.D. Curve**  
 Δ = 44° 53' 15"  
 D = 12' 30"  
 T = 189.3'  
 L = 359.1'  
 R = 458.4'  
 E = 37.6'

- ① WALTER K. HUBBARD, Dec.  
 Lots 36, 37, 38 and 39 of Block B, in Arvonia
- ② CHARLOTTE A. PETTUS and CHARLOTTE F. PETTUS, JT.  
 Lots 7 and 8 in Block 7, in Arvonia