

SHEET NO.

INDEX OF SHEETS

- 1 SKETCH MAP & TITLE PAGE
2-3 TYPICAL SECTIONS & GENERAL NOTES
4 SUMMARY OF APPROXIMATE QUANTITIES, SKETCH OF INTERSECTION OF 16 TH. ST. & CENTRAL ST., TABULATION OF LENGTH, DETAILS OF CURB & TRENCH FOR UNDERDRAIN.
5-6 DETAILS OF DETOUR & DETOUR STRUCTURES AT 16 TH. ST. VIADUCT
-17 DETAILS OF 16 TH. ST. VIADUCT MODIFICATIONS.
18 DETAILS OF ABUTMENT OF PRESENT 16 TH. ST. VIADUCT
19 DELETED
20 BRIDGE STANDARD - BRIDGE DRAIN GRATES & FRAMES.
21 DETAILS OF TYPE I MANHOLES.
22 STANDARD LETTERS & FIGURES FOR YEAR NUMBERS & STRUCTURE NUMBERS.
23 UNREINFORCED & REINFORCED CONCRETE CULVERT PIPE.
24 STANDARD NO.12 & NO.13 CONCRETE INLETS.
25 DELETED
CURVES.
26 STANDARD SIDE APPROACH ROADS, FLARING, CUT SLOPE TREATMENT & WIDENING AT BRIDGES & AT CREST OF GRADES.
27 STANDARD ROADWAY CONSTRUCTION TRAFFIC SIGNS
28 PROPERTY MAP
29 ALIGNMENT PLAN & PROFILE.

M-10-B
M-112-D
M-12-D-13

M-2-DM
M-2-DS

COLORADO STATE HIGHWAY DEPARTMENT PLAN AND PROFILE OF PROPOSED PROJECT NO. U 1 002-2(23) UNIT No. 1 STATE HIGHWAY NO.185 CITY & COUNTY OF DENVER

ALL SCALES SHOWN ARE

FOR ORIGINAL DRAWINGS

GRADE LINE ON PROFILE IS SHOWN AS GRADE OF FINISHED ROAD
TOTAL LENGTH OF PROJECT NO. U 1 002-2(23) = 3490.0 FT = 0.661 MILES
NO. & LENGTH INVOLVED IN UNIT NO. 1

FED. ROAD DIV. NO.	DISTRICT	PAGE NO.	SHEET NO.	TOTAL SHEETS
8	COLG.	U 1 002-2(23) UNIT NO. 1	1	

Rev. 12-21-51 Index of Sheets - E.L.K.

2,022301


CONVENTIONAL SIGNS

CENTER LINE OF SURVEY
RIGHT OF WAY LINE
SECTION LINE
ONE-QUARTER SECTION LINE
ONE-SIXTEENTH SECTION LINE
PROPERTY LINES & TRACTS
CITY LIMITS LINE
RAILROAD TRACKS (L)
STREET CAR TRACKS (L)

NOTICE TO BIDDERS

IT IS RECOMMENDED THAT BIDDERS ON THE PROJECT GO OVER THE PLAN DETAILS WITH ONE OF THE FOLLOWING FIELD REPRESENTATIVES OF THIS DEPARTMENT.

D.W. ORMSGEE URBAN ENGINEER DENVER
FRED K. MERTEN CONSTRUCTION ENGINEER, DENVER
W. BOYD WHITE RESIDENT ENGINEER DENVER

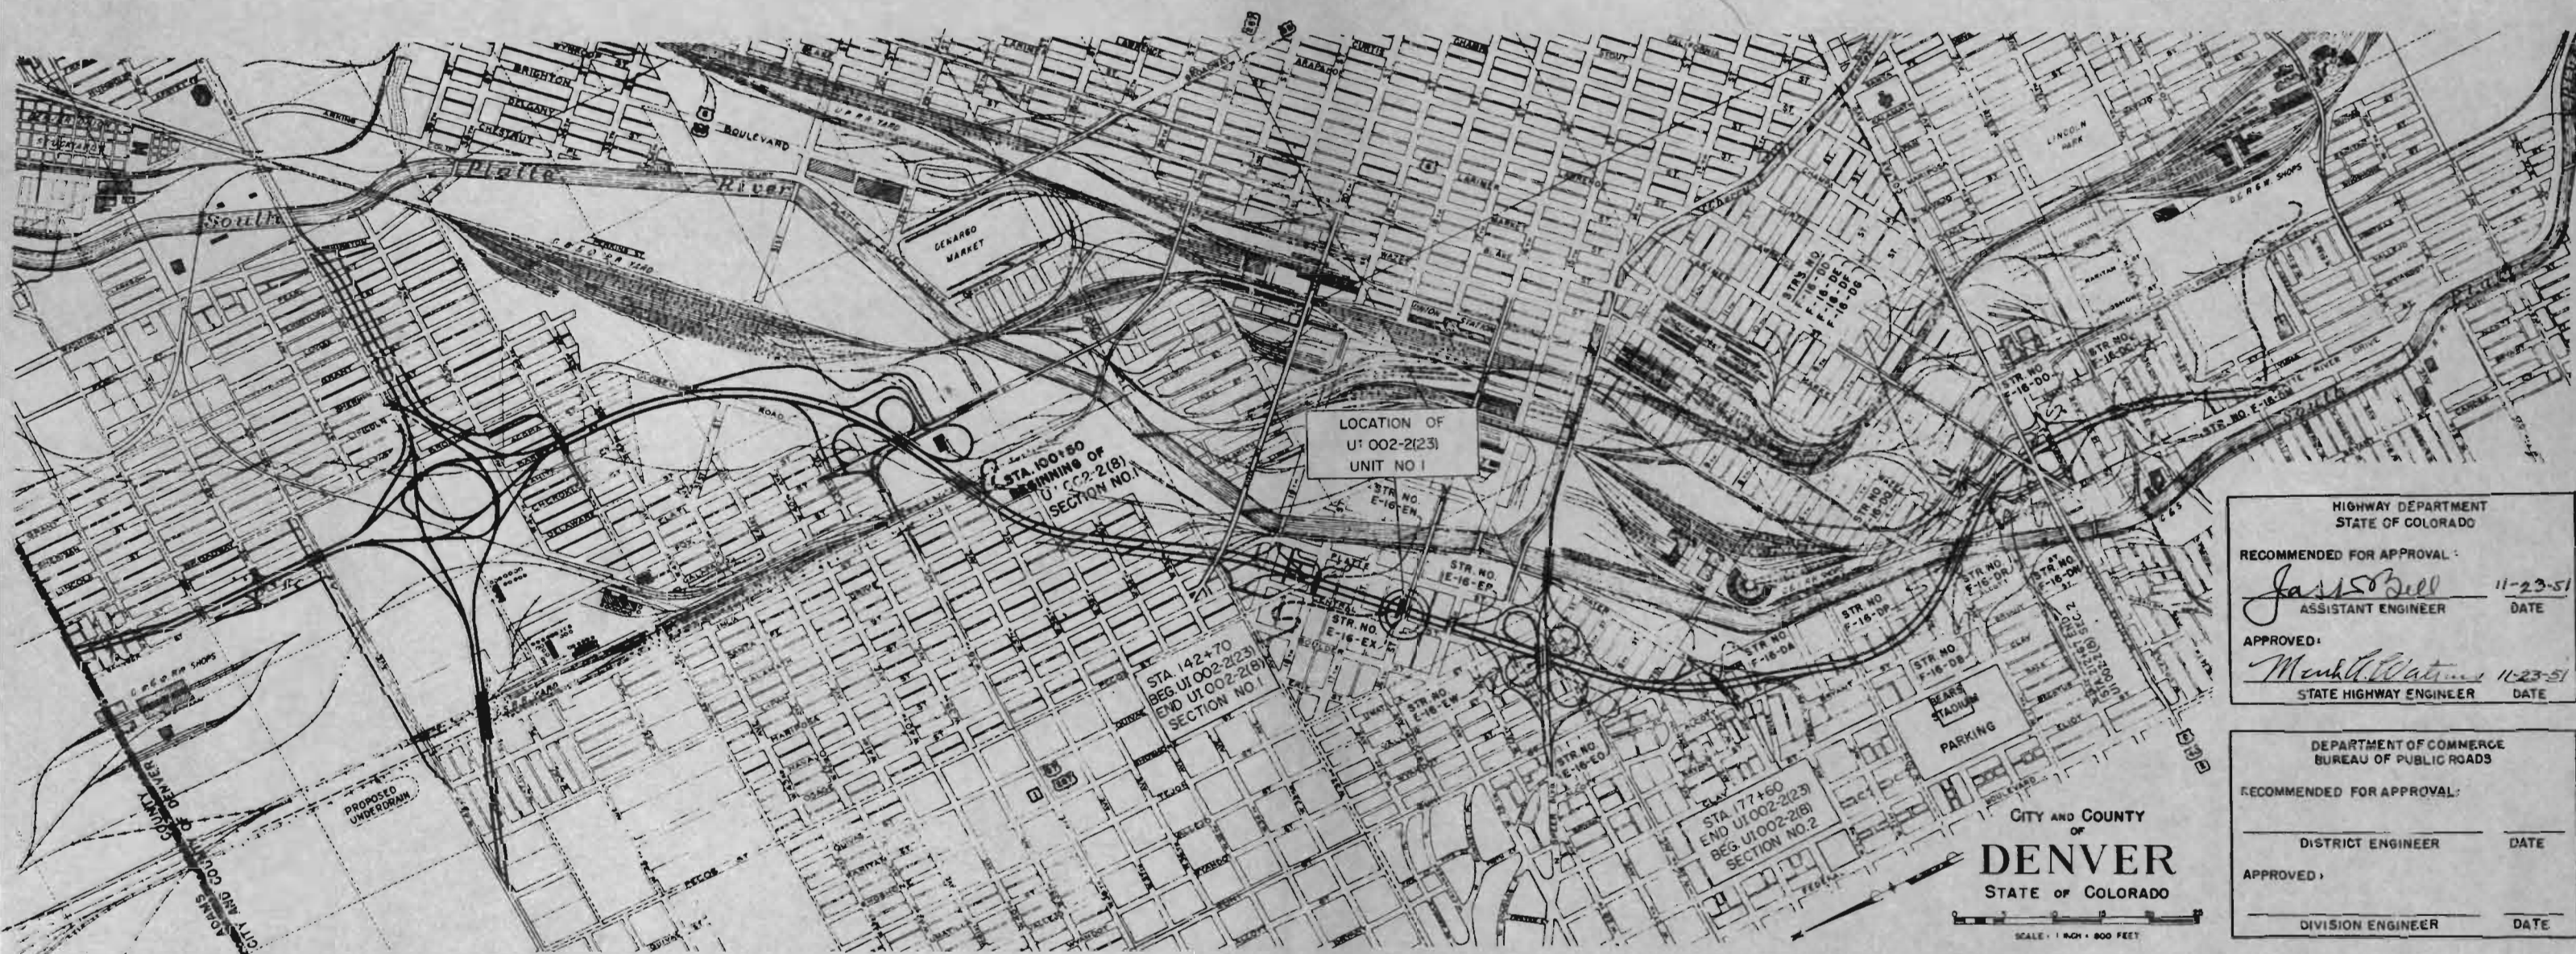


HIGHWAY DEPARTMENT STATE OF COLORADO	
RECOMMENDED FOR APPROVAL:	
<i>Jas. S. Bell</i> ASSISTANT ENGINEER	11-23-51 DATE
APPROVED:	
<i>Monte H. Watson</i> STATE HIGHWAY ENGINEER	11-23-51 DATE

DEPARTMENT OF COMMERCE BUREAU OF PUBLIC ROADS	
RECOMMENDED FOR APPROVAL:	
DISTRICT ENGINEER	DATE
APPROVED:	
DIVISION ENGINEER	DATE


TYPICAL SECTIONS

SECTION I


FED. ROAD DIST. NO.	STATE	PROJ. NO.	SHEET NO.	TOTAL SHEETS
8	CALIF.	UI 002-2(23) UNIT NO. 1	2	

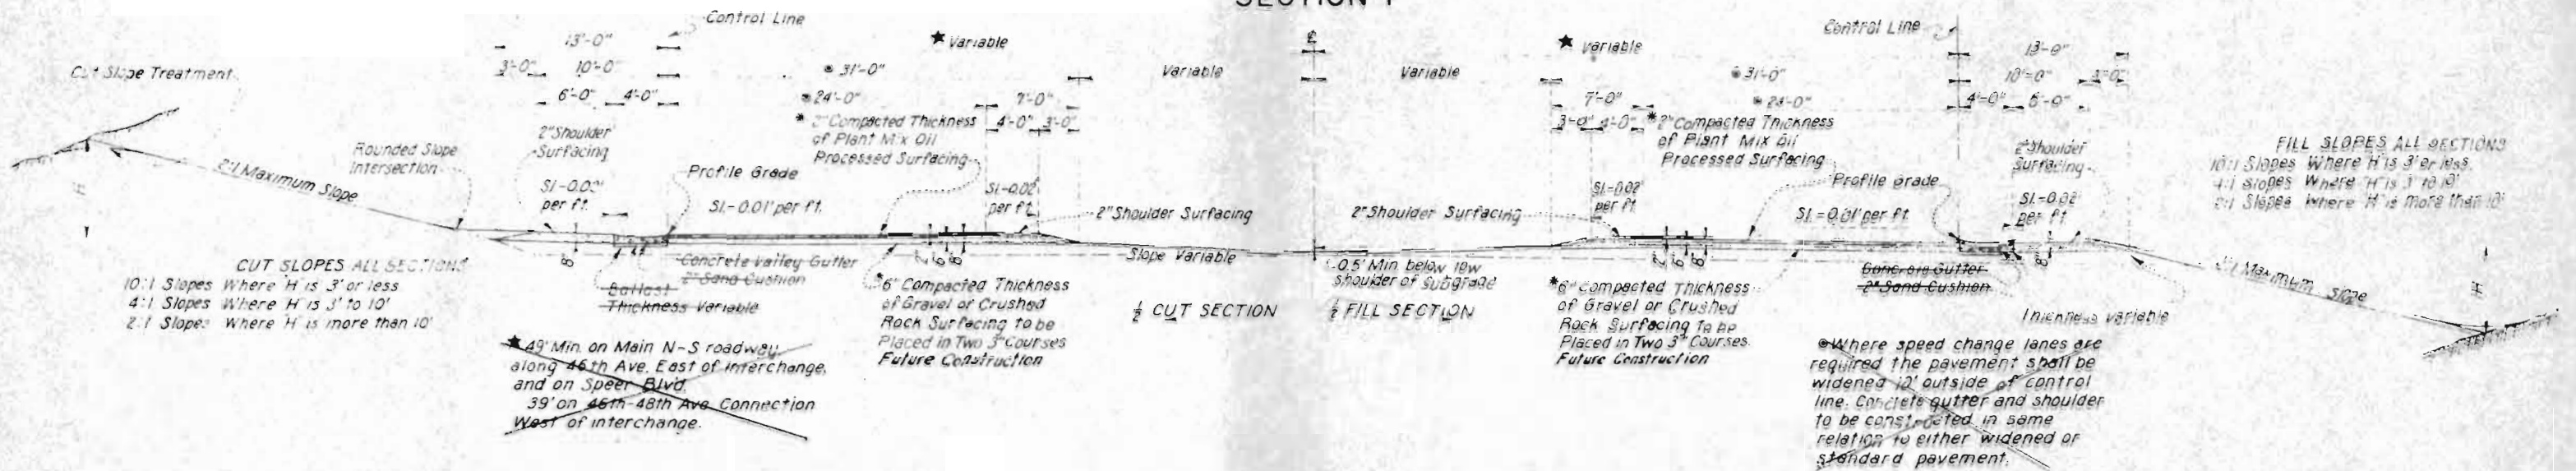


SECTION 2-A

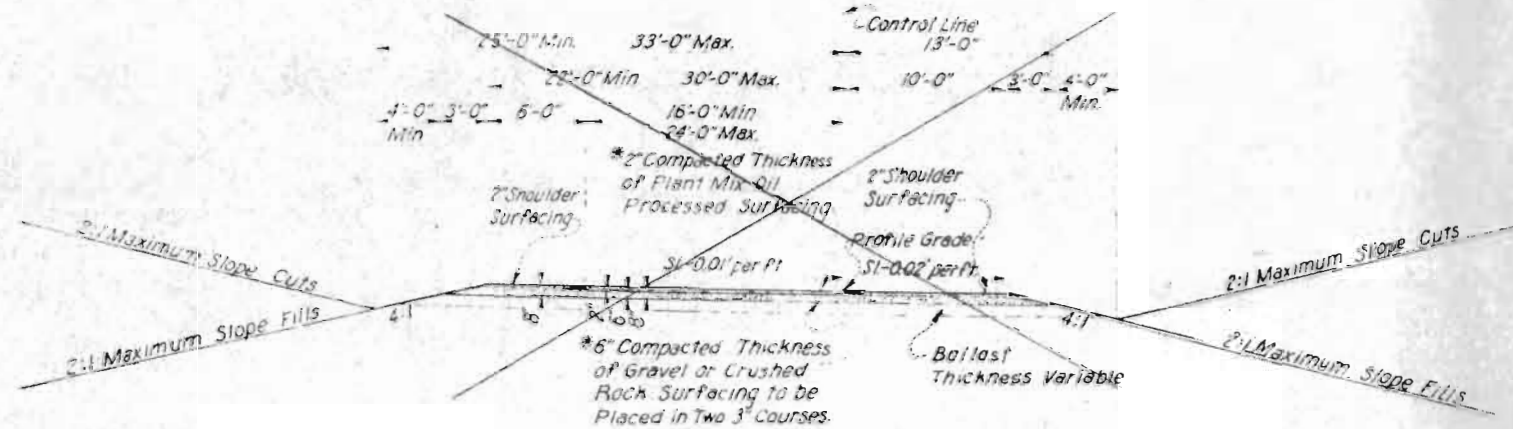

SECTION 2-B

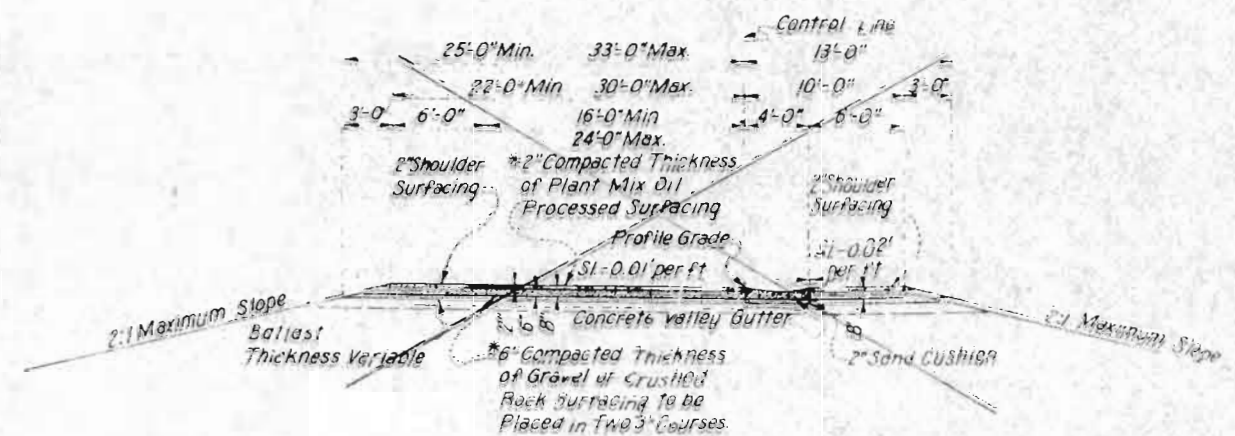

SECTION 3

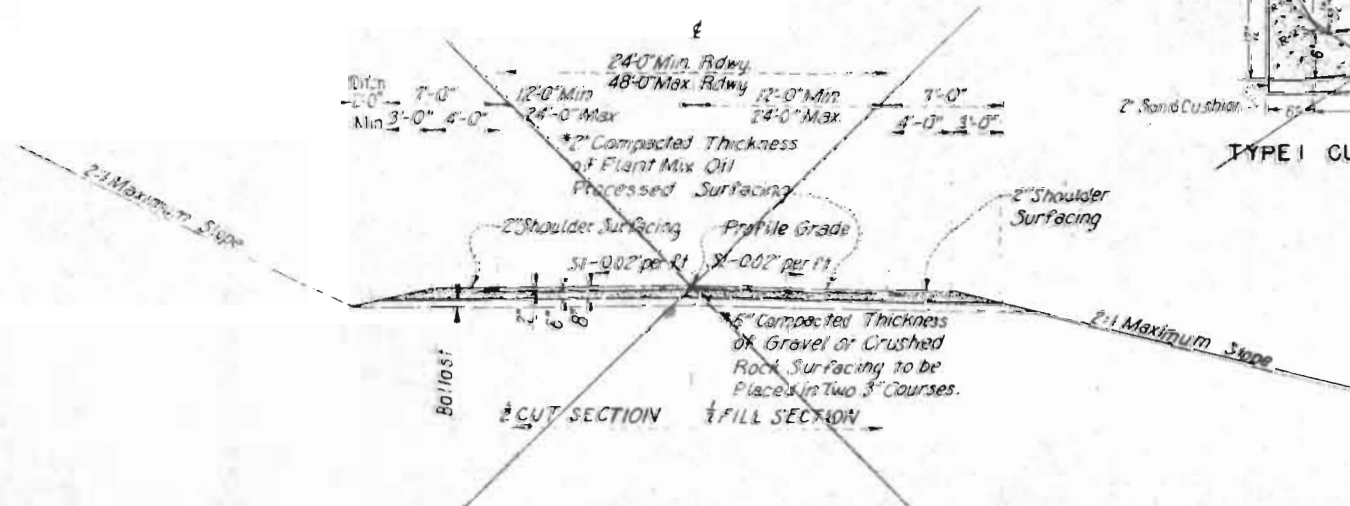


TYPE 1 CURB & GUTTER

TYPE 2 CURB & GUTTER

To be used on nosing of exit Ramps from Main Highway or Intersecting Streets

CURB TRANSITION DETAIL

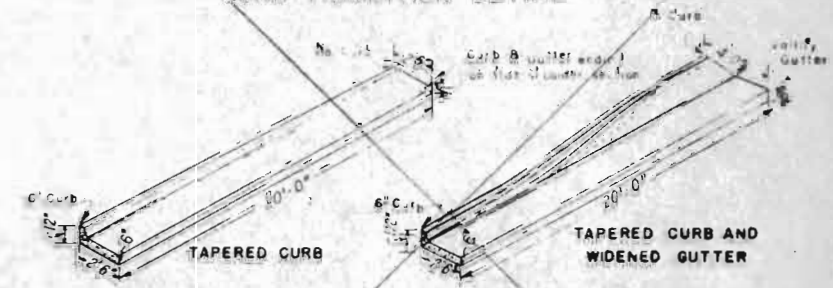


Curbs shall not end abruptly but shall be tapered to Zero height over a distance of 20 ft. as shown above.
 On High Side of Superelevated Curves the Gutter shall have the same slope as the Pavement.
 All Transitions are to be included and paid for as Concrete Combination Curb and Gutter.

DETAIL OF CONCRETE GUTTER


TYPICAL SECTIONS

FED. ROAD DIV. NO.	STATE	PROJ. NO.	SHEET NO.	TOTAL SHEETS
	COLO.	DI 002-2(23) UNIT NO. 1	3	

SECTION 4

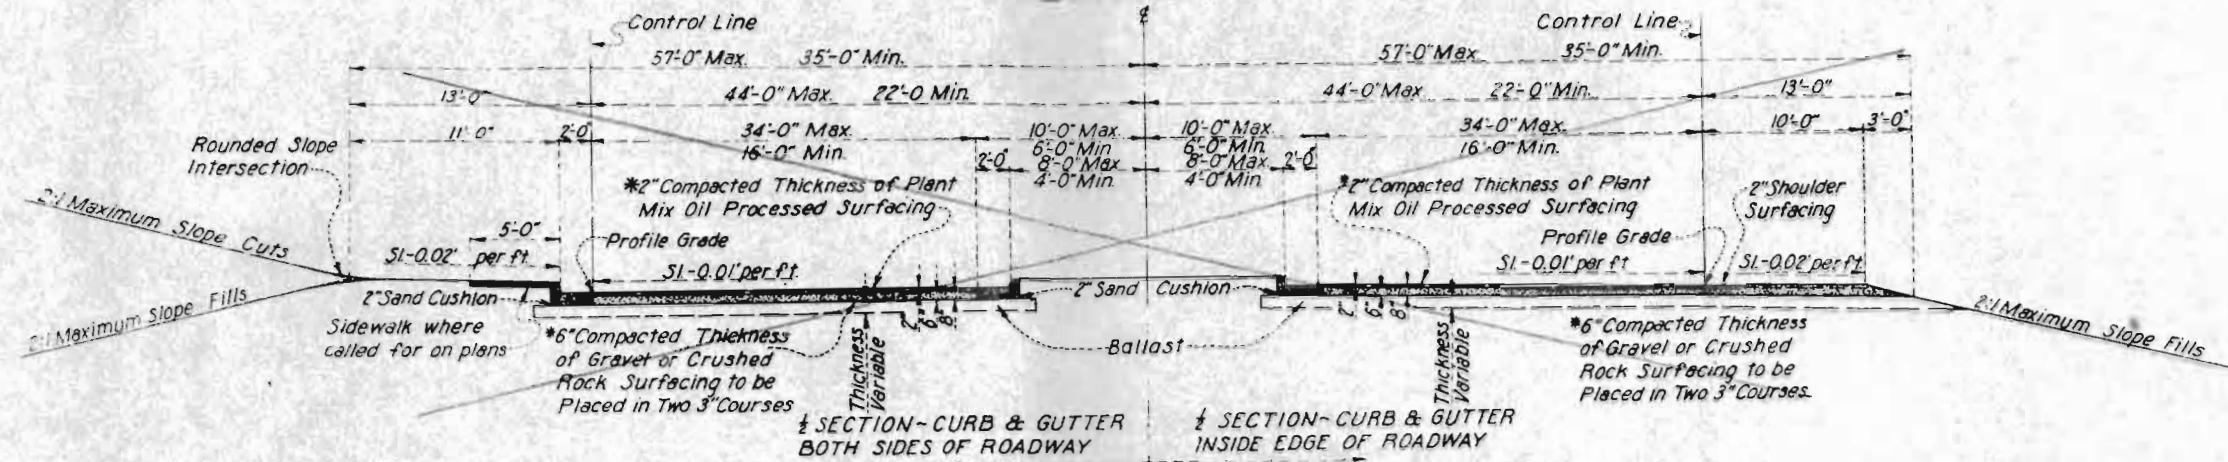

SECTION 5

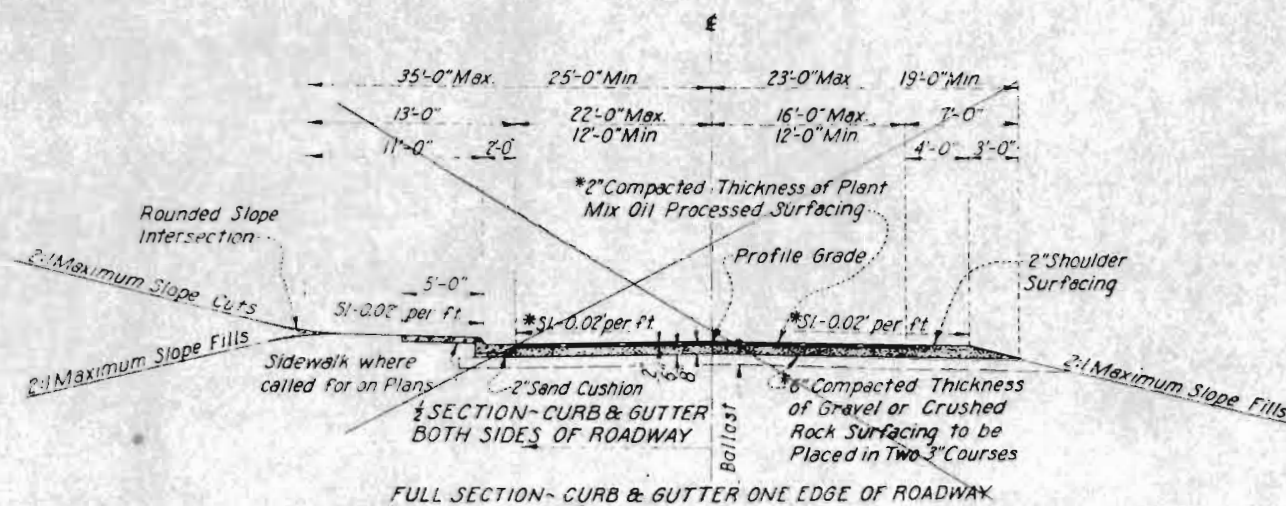


FULL SECTION- CURB & GUTTER ONE EDGE OF ROADWAY

* Any change in the crown to meet existing streets shall take place gradually over sufficient distance to provide a smooth riding connection.

* 6" Concrete Pavement shall be used in lieu of the 6" thickness of Gravel or Crushed Rock Surfacing and the 2" thickness of Oil Processed Surfacing at the locations indicated in the Tabulation of Concrete Pavement on Sheet No. 56. Width of concrete pavement shall, in all cases, conform to the pavement width indicated in the Tabulation of Sections on Sheet No. 3. See Sheet No. 4 for details of concrete pavement.

SECTION 6

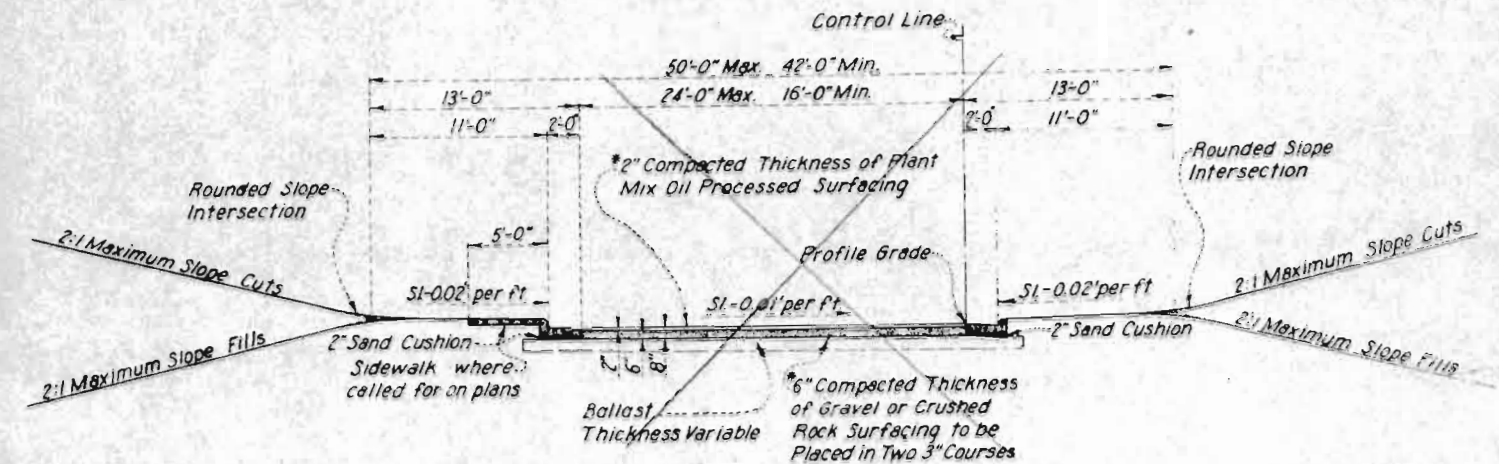

SECTION 6: As detailed above.
SECTION 6A: Same as Section 6 except that right hand shoulder shall be as indicated on Section 2A.
SECTION 6B: Same as Section 6 except that right hand shoulder shall be as indicated on Section 2B.
SECTION 6C: Same as Section 6 except that left hand shoulder shall be as indicated on Section 2A or 2B.

TABULATION OF SECTIONS

TYPICAL SECTION NO.	LOCATION	Station to Station	Pavement Width	REMARKS
1	Main Highway	100+50 142+70	2-24	38' Min. distance between control lines
	" "	142+70 177+60	2-24	38' " " " " "
	Speer Boulevard		2-24	38' " " " " "

GENERAL NOTES

This project is to be constructed in conformity with the Standard Specifications of the Colorado State Highway Department adopted January 1, 1948.
All quantities on preliminary plans are to be considered approximate only.
All concrete used on this project shall be "Air-Entrained Concrete".
For preliminary plan quantities of asphaltic road materials, plant mixed oil processed surfacing & asphalt the following rates of application were used:
Prime Coat (over concrete) RC at .15 gal. per Sq. Yd.
Prime Coat (over other areas) MC at .30 gal. per Sq. Yd.
Plant Mixed Oil Processed Surfacing at 108 lbs. per Sq. Yd. per 1" thickness
Asphalt (120-150 Penetration) at 6.5 lbs. per Sq. Yd. per 1" thickness

Rate of application and grade of oil shall be as determined by the Engineer at the time of application.

A 2" thickness of Plant Mixed Oil Processed Surfacing shall be placed over the curbed width of the 16th St. Viaduct and on the fill portion of Detour over a 30 ft. width. Plant Mixed Oil Processed Surfacing placed on Detour Trestle shall be 2" thick at edges and crowned to 3" thickness at centerline.

SUMMARY OF APPROXIMATE QUANTITIES

ITEM NO.	ITEM	UNIT	ROADWAY	DETOUR	BRIDGE		PROJECT TOTALS
10a	Clearing and Grubbing Entire Project	Lump Sum	•	•	•		•
11a	Removal of Portions of Old Structure (16th Street Viaduct)	Lump Sum	•	•	•		•
11b	Wrecking of Detour Trestle	Lump Sum	•	•	•		•
11x	Removal of Obstructions	Lump Sum	•	•	•		•
11d	Transport and Set 8" Trolley Poles	Each			6		6
11c	Remove and Reset Handrail	Lin. Ft.		55	360		415
13c	Unclassified Excavation	Cu. Yd.	12,000				12,000
14a	Dry Rock Excavation (Str.)	Cu. Yd.		10	20		30
14b	Dry Common Excavation (Str.)	Cu. Yd.	5	40	415		460
14c	Wet Rock Excavation (Str.)	Cu. Yd.			10		10
14d	Wet Common Excavation (Str.)	Cu. Yd.			10		10
16a	Structure Backfill (Class 1)	Cu. Yd.	5	40	235		280
16d	Mechanical Tamping	Hour	1	5	24		30
17ax	Rolling with Tamping Roller (2 Unit)	Hour	40	40			80
17b	Rolling with Flat Wheeled Roller	Hour		15	15		30
17c	Rolling with Rubber Tired Roller	Hour		5	5		10
17dx	Furnishing Tamping Roller (2 Unit)	Each	0.5	0.5			1
17e	Furnishing Flat Wheeled Roller	Each		0.5	0.5		1
17f	Furnishing Rubber Tired Roller	Each		0.5	0.5		1
17g	Wetting	M Gal.	40	50			90
18a	Station Yard Overhaul	Sta. Yd.	85,000				85,000
18b	Yard Mile Overhaul	Yd. Mi.	3,000				3,000
26c	Gravel or Crushed Rock Surfacing (Grading C)	Ton		500			500
29c	Asphalt (120-150 Penetration)	Ton		13	7		20
30x	Asphaltic Road Material MC (Prime)	Gal.		500			500
30y	Asphaltic Road Material RC	Gal.		40	260		300
32a	Plant Mixed Oil Processed Surfacing	Ton		223	117		340
42a	Untreated Bridge Timber	M ft. bm		35.7			35.7
46a	Class "A" Concrete	Cu. Yd.	1		623		624
47x	Reinforcing Steel - Transport and Place	Lb.			43,600		43,600
47y	Transporting, Altering and Placing Reinforcing Steel	Lb.	100		43,900		44,000
48x	Structural Steel - Transport and Erect	Lb.			221,000		221,000
60b	Untreated Timber Piling	Lin. Ft.		367			367
61x	Steel Piling - Transporting and Driving	Lin. Ft.			392		392
71a(8)	8" Perforated Corrugated Metal Pipe Underdrain (8" Trench)	Lin. Ft.	160				160
84c	Concrete Combination Curb and Gutter	Lin. Ft.	70				70
89a	Drain Pipe (Concrete Floor) (3"x20')	Each			2		2
90b	1 1/2" Electrical Conduit with Junction Boxes	Lin. Ft.			30		30
132ca	12" Reinforced Concrete Pipe Storm Sewer (2' to 4' deep) φ	Lin. Ft.	30				30
132ma	Manholes, Type 1 (7' deep)	Each	1				1
132ga	No. 12 Inlet Grating and Frame	Each	1				1
140	Fireproof Steel Doors	Each			1		1
FORCE ACCOUNT							
	Rerouting Trolley Coach Lines and Relocating in Final Position (Work by Denver Tramway Corp.)	Lump Sum	•				•
STATE FURNISHED MATERIAL							
47	Reinforcing Steel	Lb.			43,600		43,600
47	Reinforcing Steel	Lb.	100		43,900		44,000
48	Structural Steel	Lb.			221,000		221,000
61a	Steel Piling (12 BP-53)	Lin. Ft.			392		392
φ Depth shown is informational only.							


CENTRAL STREET

Existing 15" Storm Sewer
Req'd. Manhole

Req'd. Storm Sewer

Req'd. No. 12 Inlet

END 16TH. STREET VIADUCT

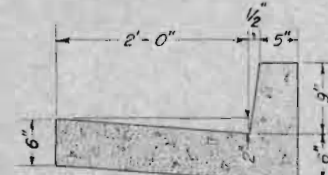


DETAILS OF COMB. CURB & GUTTER

REQUIRED

65 lin ft. Comb. Conc. Curb & Gutter
1 Type 1 Manhole (7' deep)
30'-12" Reinf. Conc. Pipe Storm Sewer (2' - 4' deep)
Glass 1/2" Conc. 0.51 Cu. Yds.
Reinf. Steel 70 Lbs.
1 No. 12 Inlet Grating & Frame

TABULATION OF LENGTH


STATION	ROADWAY		
	LIN. FT.		
Sta. 142+70 Begin UI 002-2(23) End UI 002-2(8) Section No. 1			
Sta. 177+60 End UI 002-2(23) Begin UI 002-2(8) Section No. 2	3490.0		
TOTAL	3490.0		
SUMMARY	LIN. FT.	MILES	
Total length of Proj. No. UI 002-2(23)	3490.0	0.661	

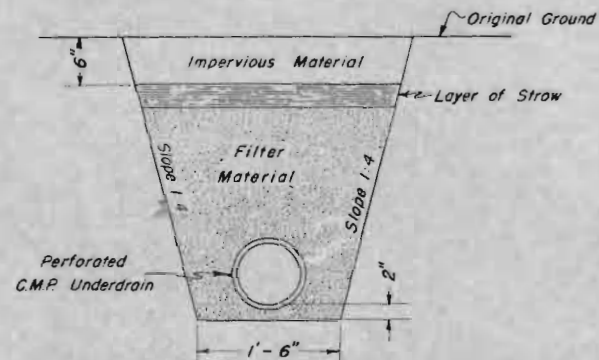

TYPICAL CROSS SECTION OF UNDERDRAIN

REV. AS CONSTRUCTED WD 14663
5-19-52 A.B.H.

FED. ROAD DIST. NO.	STATE	PROJ. NO.	SHEET NO.	TOTAL SHEETS
3	COLO.	UI 002-2(23) UNIT NO. 1	6	

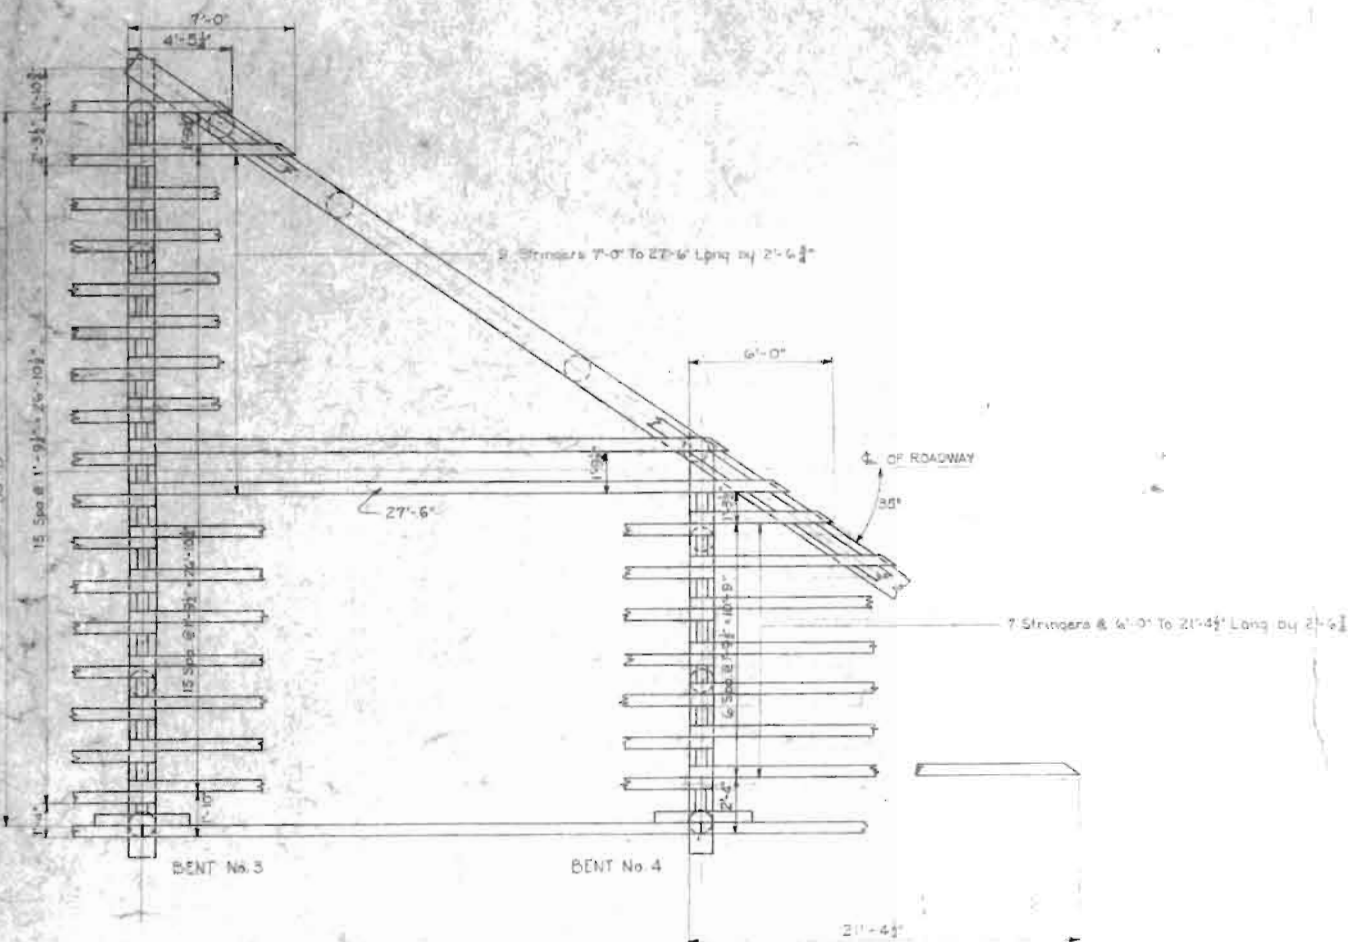

This sketch shall apply if Contractor elects to use 6"x18" stringers in lieu of 6"x20" shown in bill of material to the right.

Note: Stringers must not be spliced.

UNTREATED TIMBER

Description	Size	No.	Length	Bd. Ft.
Guardrails on Embankment	3"x8"	12	10'-0"	1440
Guardrail Posts on Embankment	6"x6"	12	6'-0"	1296
Handrails S4S	3"x8"	12	24'-0"	576
Handrail Posts S4S (at Caps)	6"x8"	6	6'-0"	144
Handrail Posts S4S	6"x8"	20	5'-0"	400
Flooring S1S to 3" Hit or Miss	3"x6"	288	3'-0"	13160
Timber Header	6"x10"	1	31'-0"	155
Bulkhead Planks	3"x8"	3	34'-0"	204
Blocking	6"x20"	5	24'-0"	1200
Bridging	3"x6"	21	22'-0"	693
Wheelguards	6"x10"	6	24'-0"	720
Stringers - Outside-End Span	6"x20"	2	23'-6"	470
" " Interm. "	6"x20"	2	23'-0"	460
" " Skew "	6"x20"	2	27'-0"	540
" " Inside Span 1, 2 & 5 in Spans	6"x20"	29	24'-0"	6960
" " " 3 Skewed	6"x20"	1ea. of 7	23'-0"	1234
" " " 4 "	6"x20"	1ea. of 5	23'-0"	788
Cap Bent ① ② ③	12"x12"	3	34'-0"	1224
Cap Bent ④	12"x12"	1	17'-6"	210
Cap Bent ⑤	12"x12"	1	36'-0"	432
Cap Bent ⑤ (includes 4' for splice)	12"x12"	1	30'-0"	360
Mud Sill Bents ① ② ③	6"x20"	3	34'-0"	1020
Mud Sill Bent ④	6"x20"	1	18'-0"	180
Mud Sill Bent ⑤	6"x20"	2	30'-0"	600
Sway Braces - Bents ① ② ③	3"x12"	6	36'-0"	648
Sway Braces Bent ④	3"x12"	2	23'-0"	138
Sway Braces Bent ⑤	3"x12"	4	34'-0"	408
Total Bd. Ft. Untreated Timber				35640
Piling Bent ①	12"x	6	10'-0"	60 Lin. Ft.
Piling Bent ②	12"x	6	11'-0"	66 " "
Piling Bent ③	12"x	6	12'-0"	72 " "
Piling Bent ④ & ⑤	12"x	13	13'-0"	163 " "
Total Lin. Ft. Piling				367

This bill of material to be used as a basis for payment except if 6"x18" stringers and blocking are substituted for 6"x20". This bill of material shall be reduced accordingly.

HARDWARE


Location	Item	Size	No. Req'd.	Length	Weight
Boils and Washers					
Posts to Rails	Bolts	5/8"	28	10"	28
Posts to Wheelguards	"	3/4"	26	14"	56
Posts to Stringers	"	3/4"	44	16"	101
Wheelguards to Stringers	"	3/4"	26	38"	131
Posts to Caps to Sway Braces	"	5/8"	6	23"	13
Posts to Stringers to Stringer Splice	"	3/4"	8	22"	24
Timber Header to Stringers	Lag Screws	5/8"	14	16"	22
Cap to Piles	Drift Bolts	3/4"	31	24"	102
Mud Sill to Piles	Drift Bolts	3/4"	31	18"	79
Splices to Outside Stringers	Bolts	5/8"	24	14"	34
Sway Braces to Cap	"	5/8"	10	17"	17
Sway Braces to Piles	"	5/8"	68	17"	114
Sway to Filler to Sway at E Bent	"	5/8"	6	20"	12
Cap to Cap, Bent 3 to 5 & 4 to 5	"	3/4"	2	36"	10
Cap to Viaduct Conc. Beam	"	3/4"	4	48"	24
Cap Splice	"	3/4"	4	14"	8
Cap Splice	"	3/4"	2	26"	7
Washers Std. C.I.O.G.	Washers	3/4"	232		250
Washers Std. C.I.O.G.	Washers	3/4"	294		215
Total	Bolts & Washers				1244
Nails					
Location	30d	40d	7 Spikes		
2 Nails/Rail/Post, Bridge		5"			
2 Nails/Rail/Post, Embankment Rail		16"			
4 Nails/Stringer Block to Stringer		18"			
4 Nails/Stn. Bridging Piece to Str.		37"			
2 Nails/Stringer to Cap		11"			
2 Spikes/Sway Brace/Pile			19"		
2 Spikes/Bulkhead Plank/Str.			12"		
2 Spikes/Sway Brace to Cap			3"		
Floor Plank to Floor Plank 1-40d nail					
at 12"rs & toenail planks to stringers					
with 1-30d nail/Str. every other plank	52"	482"			
Totals	82"	565"	34"		

COLORADO STATE
HIGHWAY DEPARTMENT
DETOUR AT 16TH ST. VIADUCT
30' ROWY.
QUANTITIES

Design by: G.H.W. Approved by: *Ed. R. R. R.*
Made by: L.W.F. Bridge Engineer
Check by: Date: June 6, 1951.

FED. ROAD DIV. NO.	STATE	PROJ. NO.	SHEET NO.	TOTAL SHEETS
9	COLO.	U: 002-2(23) UNIT NO. 1	7	

Rev 12-21-51 Summary & Notes - J.C.R.

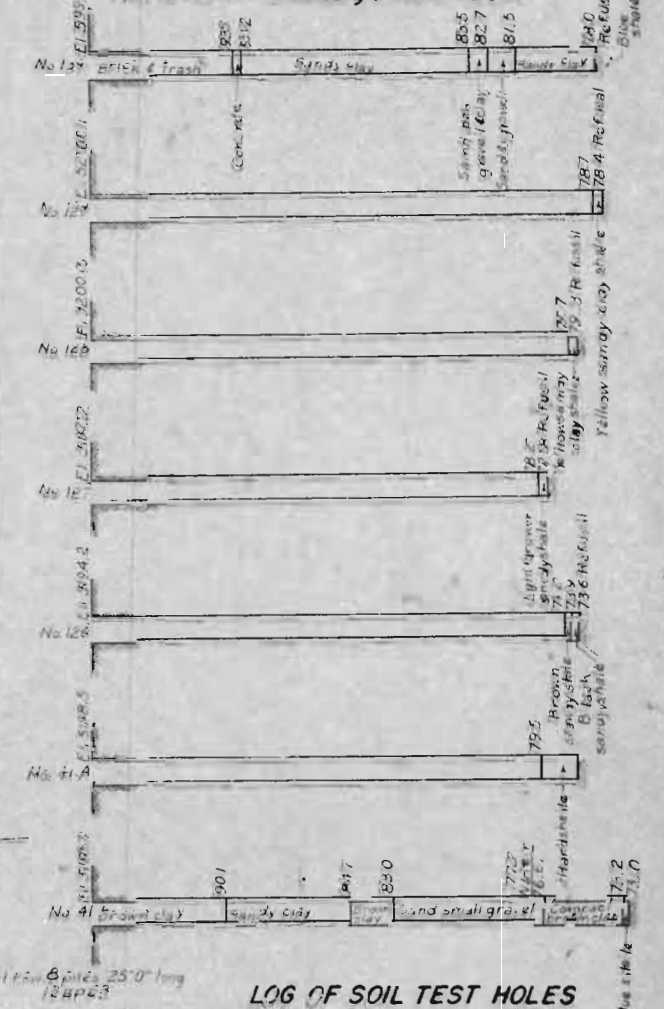

LOG OF SOIL TEST HOLES

SHEET NO.	DESCRIPTION
1 OF 11 (7)	GEN. PLAN & ELEV. & SUMMARY OF QUANTITIES
2 OF 11 (8)	BAR LISTS FOR REINF. STEEL ITEM 47
3 OF 11 (9)	BAR LISTS FOR REINF. STEEL FURNISHED BY STATE
4 OF 11 (10)	SOUTH PIER
5 OF 11 (11)	CENTER PIER
6 OF 11 (12)	NORTH ABUTMENT DECK
7 OF 11 (13)	NORTH ABUTMENT WALLS AND FOOTING
8 OF 11 (14)	BEAMS AND BEARINGS
9 OF 11 (15)	DECK
10 OF 11 (16)	RECONSTRUCTION AT CUTOFF OF EXISTING STRUCTURE
11 OF 11 (17)	EXPANSION JOINTS

SUMMARY OF QUANTITIES						
No.	Item	Unit	No. Abut.	So. Pier	Gen. Pier	Super. Struc.
1	Remove & Refill of Old Structure	Cu. Yds.				
2	Remove & Refill of Old Structure	Cu. Yds.				
3	Transport & Set 8" Trolley Poles	Each	2			
4	Dry Rock Excavation	Cu. Yds.				
5	Dry Common Excavation	Cu. Yds.				
6	Wet Rock Excavation	Cu. Yds.				
7	Wet Common Excavation	Cu. Yds.				
8	Structure Backfill	Cu. Yds.				
9	Mechanical Tampering	Sq. Yds.				
10	Class A Concrete	Cu. Yds.				
11	Reinforcing Steel (See Note A)	Lbs.				
12	Structural Steel (See Note B)	Lbs.				
13	Steel Piling (See Note C)	Lbs.				
14	Elect. Conduit & Jet Boxes	Lin. Ft.				
15	Fireproof Door & Frame	Each				
16	Drain Pipe (Concrete Floor)	Each				
17	Transporting Material	Lb.				
18	Reinforcing Steel	Lb.				


Design Specifications 1942 & 1943
Existing Structure
Max. allowable soil pressure:
40 tons per pile and 5 tons per sq. ft. for
shale; 25 tons per sq. ft. for wearing surface included in
foot load.
10,000 lbs. (10,000)
10,000 lbs. (10,000)
10,000 lbs. (10,000)

COLORADO STATE HIGHWAY DEPT.
THE VALLEY HIGHWAY DENVER, COLORADO
SIXTEENTH ST. VIADUCT MODIFICATION

GENERAL PLAN
AND ELEVATION

STRUCTURE NO. E-16-EX
CROCKER AND RYAN
CONSULTING ENGINEERS
DENVER, COLORADO

DATE SHEET 1 OF 11 DWG. NO.

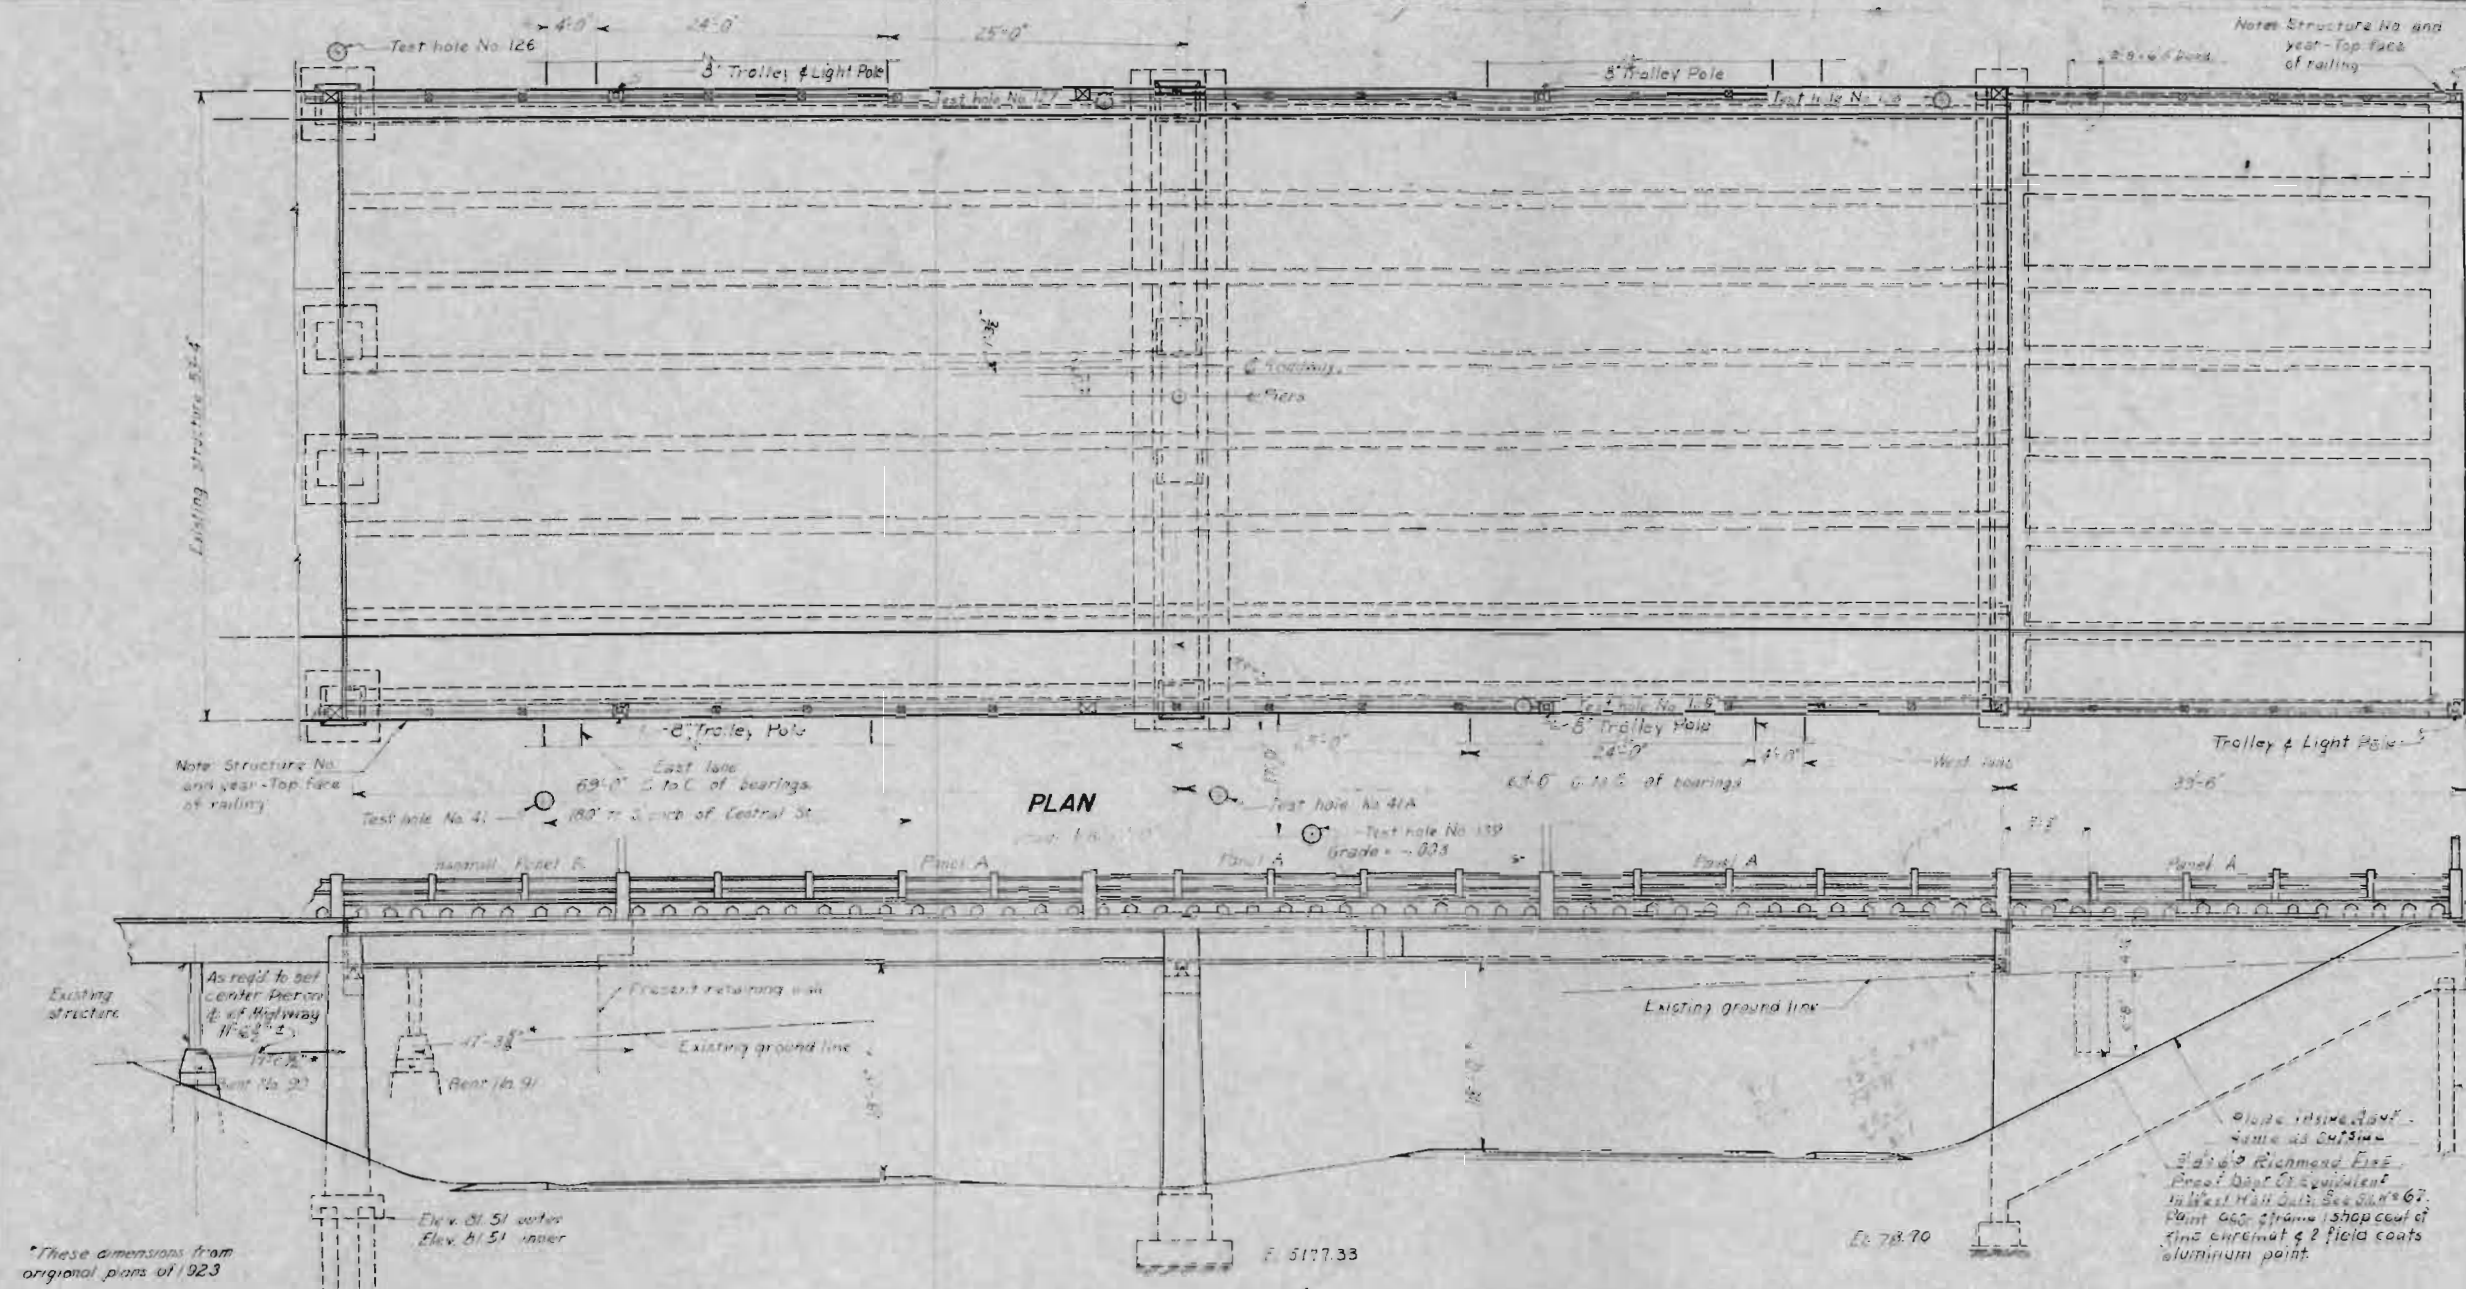

ELEVATION

FOOTING PLAN

*These dimensions from original plans of 1923

Does not include any steel items in connection with concrete & steel handrail.
Includes all concrete handrail as shown in section Z-Z', and railing posts as shown in section X-X' and Y-Y' and resetting cast iron post & pipe railing.
Includes Approx. 12 Cu. Yds. concrete.
A 2 Drain Pipes - Includes 4" & 3" dia. pipe & 2" & 1" dia. elbows.
B 43,806 lbs. Reinf. Steel furnished by the Highway Department without cost to the Contractor, from storage yard, 35th Ave. and Galapago St., Denver, Co.
C 43,806 lbs. Reinf. Steel furnished by the Highway Department without cost to the Contractor, from storage yard, 35th Ave. and Galapago St., Denver, Co.

SEE NOTE A THIS SHEET

SEE NOTE B THIS SHEET

FED. ROAD DIST. NO.	STATE	PROJ. NO.	SHEET NO.	TOTAL SHEETS
3	COLO.	U-102-2(23)	8	

BAR LIST FOR NORTH ABUTMENT									
MARK	SIZE	Nº	LENGTH	TYPE	O	A	B	C	J
S4T 7-0	1/2"	4	7'-0"	STR					
B10S 40-7	1 1/4"	20	40'-7"	II	38'-3"				
B10S 31-4	1 1/4"	10	31'-4"	II	29'-0"				
B10S 23-4	1 1/4"	10	23'-4"	II	21'-0"				
B9S 40-5	1 1/8"	4	40'-5"	II	38'-3"				
B9S 30-2	1 1/8"	2	30'-2"	II	28'-0"				
B9S 21-2	1 1/8"	2	21'-2"	II	19'-0"				
B6T 39-7	3/4"	12	39'-7"	II	38'-3"				
Ba 8T 28-7	1"	16	28'-7"	I	27'-8"				10'
La 4T 5-6	1/2"	6	5'-6"	III		2'-6"	0'-8"	2'-6"	
Ad 9S 48-10	1 1/8"	4	48'-10"	XIII		43'-0"	3'-8"	1'-6"	
Ag 9S 47-8	1 1/8"	2	47'-8"	XIV		39'-11"	5'-7"	3'-8"	
H4T 15-9	1/2"	43	15'-9"	XII		5'-0"	2'-8"	1'-8"	
H4T 8-7	1/2"	140	8'-7"	XII		2'-11"	1'-2"	0'-11"	
H4T 8-3	1/2"	28	8'-3"	XII		2'-9"	1'-2"	0'-11"	

BAR LIST FOR CENTER PIER									
MARK	SIZE	Nº	LENGTH	TYPE	O	A	B	C	J
S8T 17-9	1"	48	17'-9"	STR					
S8T 9-9	1"	48	9'-9"	STR					
S4T 7-0	1/2"	12	7'-0"	STR					
B10S 57-10	1 1/4"	12	57'-10"	II	55'-6"				
B9S 24-4	1 1/8"	2	24'-4"	II	22'-0"				
B10S 14-4	1 1/4"	6	14'-4"	II	12'-0"				
B9S 55-4	1 1/8"	4	55'-4"	II	53'-2"				
B8S 22-2	1"	4	22'-2"	II	20'-0"				
B4T 6-6	1/2"	67	6'-6"	II	5'-6"				
La 9S 58-6	1 1/4"	2	58'-6"	III		3'-0"	53'-1"	3'-0"	
Aa 4T 11-3	1/2"	8	11'-3"	XV		8'-6"	2'-9"	0'-8"	2'-8"
A4T 30-0	1/2"	4	30'-0"	VI		14'-0"	8'-0"	1'-11"	7'-9"
He 4T 13-0	1/2"	2	13'-0"	XVI			3'-4"	3'-0"	
He 4T 12-10	1/2"	2	12'-10"	XVI			3'-3 1/2"	2'-11 1/2"	
He 4T 12-9	1/2"	2	12'-9"	XVI			3'-3"	2'-11"	
He 4T 12-7	1/2"	2	12'-7"	XVI			3'-2"	2'-11"	
He 4T 12-6	1/2"	2	12'-6"	XVI			3'-2"	2'-11"	
He 4T 12-4	1/2"	2	12'-4"	XVI			3'-1 1/2"	2'-10 1/2"	
He 4T 12-3	1/2"	2	12'-3"	XVI			3'-1"	2'-10 1/2"	
He 4T 12-2	1/2"	2	12'-2"	XVI			3'-0 1/2"	2'-10 1/2"	
He 4T 12-1	1/2"	2	12'-1"	XVI			3'-0"	2'-10 1/2"	
He 4T 12-0	1/2"	2	12'-0"	XVI			3'-0"	2'-10 1/2"	
He 4T 11-10	1/2"	2	11'-10"	XVI			2'-9 1/2"	2'-11 1/2"	
He 4T 11-9	1/2"	2	11'-9"	XVI			2'-9"	2'-11"	
He 4T 11-8	1/2"	2	11'-8"	XVI			2'-8 1/2"	2'-11"	
He 4T 11-7	1/2"	2	11'-7"	XVI			2'-8 1/2"	2'-10 1/2"	
He 4T 11-6	1/2"	2	11'-6"	XVI			2'-8 1/2"	2'-11"	
He 4T 11-5	1/2"	2	11'-5"	XVI			2'-8 1/2"	2'-10 1/2"	
H4T 15-1	1/2"	7	15'-1"	XII		4'-8"	2'-8"	1'-8"	
H4T 14-11	1/2"	4	14'-11"	XII		4'-7"	2'-8"	1'-8"	
H4T 14-3	1/2"	4	14'-3"	XII		4'-3"	2'-8"	1'-8"	
H4T 13-7	1/2"	4	13'-7"	XII		3'-11"	2'-8"	1'-8"	
H4T 13-1	1/2"	16	13'-1"	XII		3'-8"	2'-8"	1'-8"	
H4T 6-11	1/2"	8	6'-11"	XII		0'-6"	2'-7"	1'-7"	

BAR LIST FOR SOUTH PIER									
MARK	SIZE	Nº	LENGTH	TYPE	O	A	B	C	J
S8T 17-9	1"	48	17'-9"	STR					
S4T 7-0	1/2"	8	7'-0"	STR					
B10S 56-0	1 1/4"	2	56'-0"	II	53'-8"				
B10S 24-4	1 1/4"	2	24'-4"	II	22'-0"				
B10S 14-8	1 1/4"	4	14'-8"	II	12'-6"				
B7T 7-2	1/2"	28	7'-2"	II	5'-6"				
B6T 54-10	3/4"	2	54'-10"	II	53'-6"				
La 10S 58-9	1 1/4"	2	58'-9"	III		2'-10"	53'-8"	2'-10"	
La 8T 6-6	1"	48	6'-6"	IV		5'-6"	1'-3"		
Aa 4T 9-0	1/2"	8	9'-0"	XV		6'-3"	2'-9"	0'-8"	2'-8"
Aa 4T 26-0	1/2"	4	26'-0"	XI		14'-0"	6'-0"	1'-5"	5'-10"
HK 4T 6-7	1/2"	35	6'-7"	XVII					
He 4T 13-0	1/2"	2	13'-0"	XVI			3'-0"	3'-4"	
He 4T 12-10	1/2"	2	12'-10"	XVI			2'-11 1/2"	3'-3 1/2"	
He 4T 12-9	1/2"	2	12'-9"	XVI			2'-11 1/2"	3'-3"	
He 4T 12-7	1/2"	2	12'-7"	XVI			2'-11"	3'-2 1/2"	
He 4T 12-6	1/2"	2	12'-6"	XVI			2'-11"	3'-2"	
He 4T 12-4	1/2"	2	12'-4"	XVI			2'-10 1/2"	3'-1 1/2"	
He 4T 12-3	1/2"	2	12'-3"	XVI			2'-10 1/2"	3'-1"	
He 4T 12-2	1/2"	2	12'-2"	XVI			2'-8"	3'-3 1/2"	
He 4T 12-1	1/2"	2	12'-1"	XVI			2'-8"	3'-3"	
He 4T 12-0	1/2"	2	12'-0"	XVI			2'-8"	3'-3"	
He 4T 11-10	1/2"	2	11'-10"	XVI			2'-9 1/2"	2'-11 1/2"	
He 4T 11-9	1/2"	2	11'-9"	XVI			2'-9"	2'-11"	
He 4T 11-8	1/2"	2	11'-8"	XVI			2'-8 1/2"	2'-11"	
He 4T 11-7	1/2"	2	11'-7"	XVI			2'-9"	2'-10 1/2"	
He 4T 11-6	1/2"	2	11'-6"	XVI			2'-8 1/2"	2'-11"	
He 4T 11-5	1/2"	2	11'-5"	XVI			2'-8 1/2"	2'-10 1/2"	
H4T 15-1	1/2"	7	15'-1"	XII		4'-8"	2'-8"	1'-8"	
H4T 14-11	1/2"	4	14'-11"	XII		4'-7"	2'-8"	1'-8"	
H4T 14-3	1/2"	4	14'-3"	XII		4'-3"	2'-8"	1'-8"	
H4T 13-7	1/2"	4	13'-7"	XII		3'-11"	2'-8"	1'-8"	
H4T 13-1	1/2"	16	13'-1"	XII		3'-8"	2'-8"	1'-8"	
H4T 6-11	1/2"	8	6'-11"	XII		0'-6"	2'-7"	1'-7"	

BAR LIST FOR SUPERSTRUCTURE									
MARK	SIZE	Nº	LENGTH	TYPE	O	A	B	C	J
S4T 37-6	1/2"	32	37'-6"	STR					
S4T 22-2	1/2"	8	22'-2"	STR					
S4T 6-0	1/2"	2	6'-0"	STR					
S4T 4-0	1/2"	32	4'-0"	STR					
S4T 2-6	1/2"	18	2'-6"	STR					
S4T 2-4	1/2"	15	2'-4"	STR					
B8T 24-4	1"	2	24'-4"	II	22'-6"				
B8T 23-6	1"	2	23'-6"	II	21'-8"				
B8T 14-2	1"	6	14'-2"	II	12'-4"				
B8T 10-5	1"	1	10'-5"	II	8'-7"				
B8T 9-5	1"	1	9'-5"	II	7'-8"				
Ba 8T 9-6	1"	2	9'-6"	I	8'-7"				10'
Ba 8T 8-7	1"	2	8'-7"	I	7'-8"				10'
Ba 5T 32-8	3/8"	10	32'-8"	I	32'-7"				5'
Ba 5T 15-3	3/8"	148	15'-3"	I	14'-8"				5'
La 4T 5-1	1/2"	276	5'-1"	III		2'-5"	0'-5"	2'-5"	
E6T 7-2	3/4"	8	7'-2"	XVIII		3'-0"			
AF 5T 18-7	3/8"	73	18'-7"	XIX			16'-11"	1'-7"	
AF 5T 18-2	3/8"	75	18'-2"	XX			16'-6"	1'-7"	
H4T 10-9	1/2"	24	10'-9"	XII		0'-8"	4'-6"	2'-7"	
H3T 3-9	1/2"	48	3'-9"	XII		0'-10"	0'-10"	4'-9"	
H4T 3-8	1/2"	43	3'-8"	XX					
T5T 25-5	5/8"	75	25'-5"	IX		23'-1"	3'-5"		
T5T 26-3	5/8"	75	26'-3"	IX		24'-3"	4'-3"		
S6T 8-0	1/4"	2	8'-0"	STR					


BAR SUMMARY FOR NORTH ABUTMENT
 2171 LIN. FT. 1/2" BARS @ 0.668 LBS. PER LIN. FT. = 1450 LBS.
 475 " " 3/4" " @ 1.502 " " " = 714 " "
 458 " " 1" " @ 2.670 " " " = 1223 " "
 555 " " 1 1/4" " @ 4.303 " " " = 2388 " "
 1358 " " 1 1/2" " @ 5.313 " " " = 7215 " "
 PLUS 1% OVERRUN = 130 LBS.
TOTAL = 13,120 LBS.

BAR SUMMARY FOR CENTER PIER
 1913 LIN. FT. 1/2" BARS @ 0.668 LBS. PER LIN. FT. = 1273 LBS.
 1310 " " 1" " @ 2.670 " " " = 3524 " "
 387 " " 1 1/8" " @ 4.303 " " " = 1665 " "
 781 " " 1 1/4" " @ 5.313 " " " = 4150 " "
 89 " " 1 1/2" " @ 5.313 " " " = 303 " "
 PLUS 1% OVERRUN = 100 LBS.
TOTAL = 11,020 LBS.

BAR SUMMARY FOR SOUTH PIER
 1584 LIN. FT. 1/2" BARS @ 0.668 LBS. PER LIN. FT. = 1058 LBS.
 110 " " 1" " @ 2.670 " " " = 293 " "
 201 " " 1 1/8" " @ 4.303 " " " = 865 " "
 1165 " " 1 1/4" " @ 5.313 " " " = 6185 " "
 338 " " 1 1/2" " @ 5.313 " " " = 1785 " "
 PLUS 1% OVERRUN = 70 LBS.
TOTAL = 6,600 LBS.

BAR SUMMARY FOR SUPERSTRUCTURE
 180 LIN. FT. 3/8" BARS @ 0.376 LBS. PER LIN. FT. = 68 LBS.
 3420 " " 1/2" " @ 0.668 " " " = 2285 " "
 9178 " " 3/4" " @ 1.043 " " " = 9573 " "
 237 " " 1" " @ 2.670 " " " = 632 " "
 74 " " 1 1/4" " @ 4.303 " " " = 319 " "
 PLUS 1% OVERRUN = 131 LBS.
TOTAL = 12,590 LBS.

TOTAL REINFORCING STEEL ON THIS SHEET = 43,540 LBS. (WHICH INCLUDES 7050 LBS. OF STRAIGHT BARS)

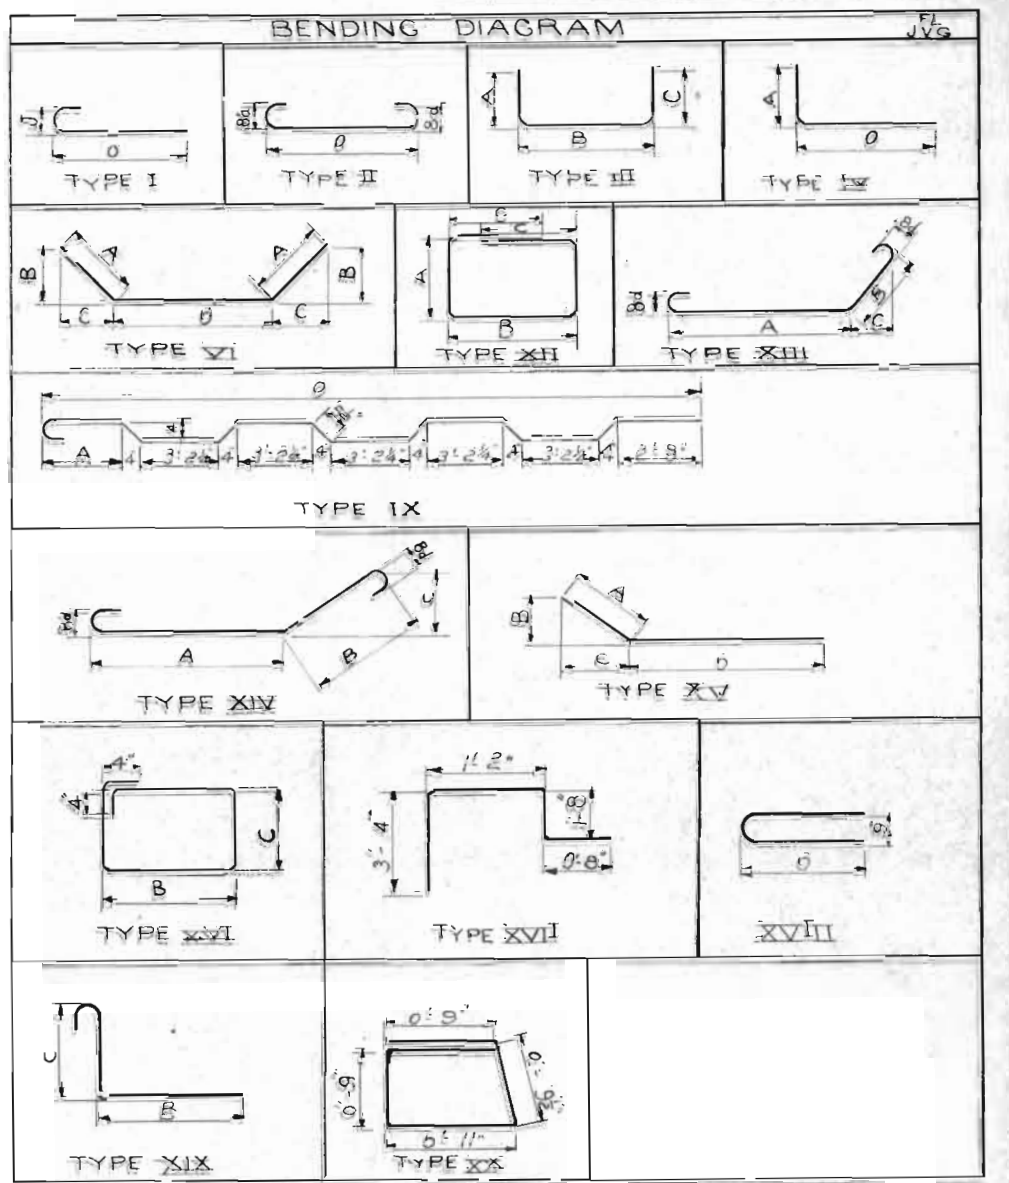

NOTE:
 See Sp. # 9 for bar list for reinforcing steel furnished by the Colo. State Highway Dept.

SHEET NO. 2 OF 11

COLORADO STATE HIGHWAY DEPARTMENT
 SIXTEENTH ST.
 VIADUCT MODIFICATION
 REINFORCING STEEL

Designed by _____
 Checked by _____
 Approved by _____
 Date _____

STRUCTURE NO. E-16-EX

FED. ROAD DIST. NO.	STATE	PROJ. NO.	SHEET NO.	TOTAL SHEETS
3	COLO.	UI 002-2(23) UNIT NO. 1	9	

BAR LIST FOR NORTH ABUTMENT

MARK	SIZE	NO.	LENGTH	TYPE	DIMENSIONS
S5r 35'-8"	5/8"	4	35'-8"	STR.	
S5r 21'-8"	5/8"	4	21'-8"	STR.	
S5r 35'-8"	5/8"	2	35'-8"	STR.	
S5r 18'-10"	5/8"	2	18'-10"	STR.	
S5r 35'-8"	5/8"	8	35'-8"	STR.	
S5r 7'-0"	5/8"	8	7'-0"	STR.	
S5r 35'-8"	5/8"	4	35'-8"	STR.	
S5r 4'-8"	5/8"	4	4'-8"	STR.	
S5r 35'-8"	5/8"	63	35'-8"	STR.	
S5r 4'-5"	5/8"	63	4'-5"	STR.	
S5r 34'-8"	5/8"	4	34'-8"	STR.	
S5r 31'-0"	5/8"	4	31'-0"	STR.	
S5r 28'-5"	5/8"	6	28'-5"	STR.	
S5r 27'-3"	5/8"	4	27'-3"	STR.	
S5r 25'-11"	5/8"	6	25'-11"	STR.	
S5r 23'-6"	5/8"	4	23'-6"	STR.	
S5r 21'-2"	5/8"	36	21'-2"	STR.	
S5r 19'-9"	5/8"	4	19'-9"	STR.	
S5r 16'-2"	5/8"	4	16'-2"	STR.	
S5r 12'-5"	5/8"	4	12'-5"	STR.	
S5r 8'-8"	5/8"	4	8'-8"	STR.	
S5r 8'-0"	5/8"	4	8'-0"	STR.	
S5r 5'-0"	5/8"	6	5'-0"	STR.	
S5r 10'-0"	5/8"	2	10'-0"	STR.	
B5r 4'-8"	5/8"	103	4'-8"	II	3'-6"
Ba5r 4'-7"	5/8"	72	4'-7"	I	4'-0" 8d
Ba5r 21'-0"	5/8"	23	21'-0"	I	20'-5" 6d
Ba5r 32'-4"	5/8"	23	32'-4"	I	31'-9" 6d
La5r 35'-8"	5/8"	15	35'-8"	IV	34'-11" 11"
La5r 20'-4"	5/8"	15	20'-4"	IV	19'-7" 11"
La5r 9'-9"	5/8"	7	9'-9"	III	9" 7'-4" 2'-0"
La5r 9'-1"	5/8"	10	9'-1"	III	9" 6'-8" 2'-0"
La5r 8'-11"	5/8"	8	8'-11"	III	9" 6'-6" 2'-0"
La5r 9'-2"	5/8"	11	9'-2"	III	9" 6'-9" 2'-0"
L5r 32'-4"	5/8"	28	32'-4"	IV	27'-6" 5'-0"
L5r 23'-0"	5/8"	4	23'-0"	IV	22'-5" 9"
L5r 22'-6"	5/8"	4	22'-6"	IV	21'-11" 9"
L5r 22'-0"	5/8"	4	22'-0"	IV	21'-5" 9"
L5r 21'-3"	5/8"	4	21'-3"	IV	20'-8" 9"
L5r 20'-6"	5/8"	4	20'-6"	IV	19'-11" 9"
L5r 19'-9"	5/8"	4	19'-9"	IV	19'-2" 9"
L5r 19'-0"	5/8"	4	19'-0"	IV	18'-5" 9"
L5r 18'-3"	5/8"	4	18'-3"	IV	17'-8" 9"
L5r 17'-5"	5/8"	4	17'-5"	IV	16'-10" 9"
L5r 16'-8"	5/8"	4	16'-8"	IV	16'-0" 9"
L5r 15'-11"	5/8"	4	15'-11"	IV	15'-4" 9"
L5r 15'-2"	5/8"	4	15'-2"	IV	14'-7" 9"
L5r 14'-5"	5/8"	4	14'-5"	IV	13'-10" 9"
L5r 13'-8"	5/8"	4	13'-8"	IV	13'-1" 9"
L5r 13'-0"	5/8"	4	13'-0"	IV	12'-5" 9"
L5r 12'-3"	5/8"	4	12'-3"	IV	11'-8" 9"
L5r 11'-6"	5/8"	4	11'-6"	IV	10'-11" 9"
L5r 10'-9"	5/8"	4	10'-9"	IV	10'-2" 9"
L5r 10'-0"	5/8"	4	10'-0"	IV	9'-5" 9"
L5r 9'-3"	5/8"	4	9'-3"	IV	8'-8" 9"
L5r 7'-11"	5/8"	7	7'-11"	IV	7'-4" 9"
L5r 7'-6"	5/8"	4	7'-6"	IV	7'-11" 9"
L5r 7'-3"	5/8"	10	7'-3"	IV	6'-8" 9"
L5r 7'-1"	5/8"	8	7'-1"	IV	6'-6" 9"
L5r 7'-9"	5/8"	4	7'-9"	IV	7'-2" 9"
L5r 7'-4"	5/8"	11	7'-4"	IV	6'-9" 9"
L5r 7'-0"	5/8"	4	7'-0"	IV	6'-5" 9"
L5r 6'-3"	5/8"	4	6'-3"	IV	5'-8" 9"
L5r 5'-9"	5/8"	28	5'-9"	IV	5'-0" 11"
L5r 4'-4"	5/8"	34	4'-4"	IV	2'-6" 2'-0"
L5r 8'-4"	5/8"	3	8'-4"	IV	6'-6" 2'-0"

BAR LIST FOR NORTH ABUTMENT CONT.

MARK	SIZE	NO.	LENGTH	TYPE	DIMENSIONS
Bc5r 23'-9"	5/8"	36	23'-9"	V	21'-2"
A5r 6'-8"	5/8"	24	6'-8"	VI	1'-3" 10' 10' 4'-4" 10' 10' 1'-3"
A5r 6'-5"	5/8"	24	6'-5"	VI	1'-3" 10' 10' 4'-1" 10' 10' 1'-3"
Bd5r 23'-8"	5/8"	29	23'-8"	VII	6'-4" 1'-0" 16'-6"
Hp5r 5'-6"	5/8"	20	5'-6"	VIII	1'-9" 2'-1" 2'-0" 10"
T5r 25'-6"	5/8"	28	25'-6"	IX	24'-2"
T5r 31'-2"	5/8"	28	31'-2"	X	30'-4"
T5r 34'-3"	5/8"	29	34'-3"	XI	34'-2"

BAR LIST FOR CENTER PIER

MARK	SIZE	NO.	LENGTH	TYPE	DIMENSIONS
S5r 35'-8"	5/8"	4	35'-8"	STR.	
S5r 21'-8"	5/8"	4	21'-8"	STR.	
S5r 35'-8"	5/8"	4	35'-8"	STR.	
S5r 19'-5"	5/8"	4	19'-5"	STR.	
H5r 18'-0"	5/8"	7	18'-0"	XII	6'-2" 2'-8" 1'-8"
H5r 17'-10"	5/8"	2	17'-10"	XII	6'-1" 2'-8" 1'-8"
H5r 17'-2"	5/8"	2	17'-2"	XII	5'-9" 2'-8" 1'-8"
H5r 16'-7"	5/8"	2	16'-7"	XII	5'-5" 2'-8" 1'-8"
H5r 16'-0"	5/8"	4	16'-0"	XII	6'-1" 1'-9" 1'-2"
H25r 16'-0"	5/8"	2	16'-0"	XII	5'-2" 2'-8" 1'-8"
H5r 15'-8"	5/8"	4	15'-8"	XII	5'-11" 1'-9" 1'-2"
H5r 15'-5"	5/8"	4	15'-5"	XII	5'-9" 1'-9" 1'-2"
H5r 15'-4"	5/8"	4	15'-4"	XII	4'-10" 2'-8" 1'-8"
H5r 15'-1"	5/8"	4	15'-1"	XII	5'-7" 1'-9" 1'-2"
H5r 15'-0"	5/8"	8	15'-0"	XII	4'-8" 2'-8" 1'-8"
H5r 14'-10"	5/8"	4	14'-10"	XII	5'-6" 1'-9" 1'-2"
H5r 14'-6"	5/8"	4	14'-6"	XII	5'-4" 1'-9" 1'-2"
H5r 14'-3"	5/8"	4	14'-3"	XII	5'-2" 1'-9" 1'-2"
H5r 13'-11"	5/8"	4	13'-11"	XII	5'-0" 1'-9" 1'-2"

BAR LIST FOR SOUTH PIER

MARK	SIZE	NO.	LENGTH	TYPE	DIMENSIONS
S5r 35'-8"	5/8"	4	35'-8"	STR.	
S5r 19'-10"	5/8"	4	19'-10"	STR.	
B5r 6'-8"	5/8"	28	6'-8"	II	5'-6"

BAR LIST FOR SUPERSTRUCTURE


MARK	SIZE	NO.	LENGTH	TYPE	DIMENSIONS
S5r 35'-8"	5/8"	267	35'-8"	STR.	
S5r 11'-10 1/2"	5/8"	267	11'-10 1/2"	STR.	
B5r 7'-9"	5/8"	144	7'-9"	II	6'-7"
H5r 7'-1"	5/8"	71	7'-1"	XII	1'-3 1/2" 2'-1" 1'-4 1/2"
Ba5r 34'-11"	5/8"	145	34'-11"	I	34'-4"
Ba5r 32'-8"	5/8"	138	32'-8"	I	32'-1"

SUMMARY OF 5/8" BARS REQUIRED*

42,000 LIN. FT. @ 1.043 LBS. PER LIN. FT. = 43,306 LBS.

* 43,806 LBS. = NET WT. OF FABRICATED STEEL (NO OVERRUN INCLUDED) TO BE MADE FROM FURNISHED STEEL.

BENDING DIAGRAM

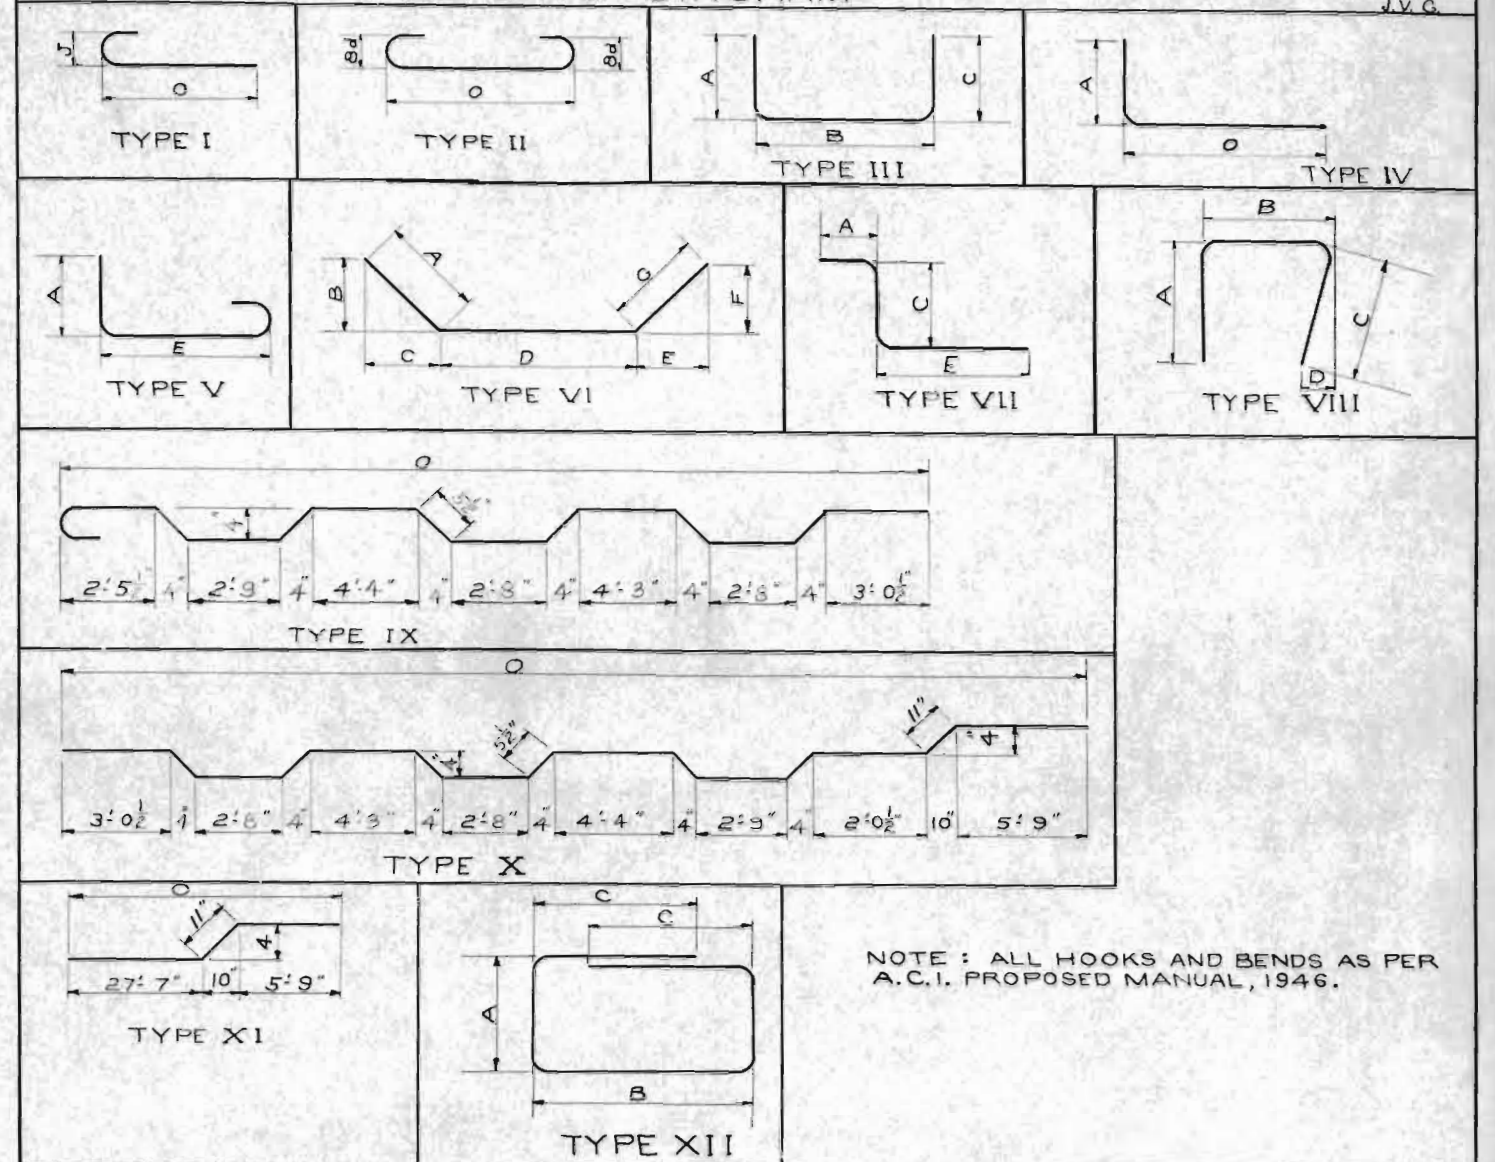

ALL REINFORCING BARS ON THIS SHEET TO BE FABRICATED FROM REINFORCING STEEL FURNISHED BY THE COLO. STATE HIGHWAY DEPT. THE FURNISHED STEEL IS IN THE AMOUNT AND AS TAGGED AS SHOWN BELOW.

MARK	NUMBER OF PIECES	SIZE	LENGTH	DESCRIPTION
S5r 35'-8"	608	5/8"	35'-8"	35'-8"
B5r 36'-10"	608	5/8"	36'-10"	STANDARD HOOKS PER A.C.I. 35'-8"
TOTAL WEIGHT = 45,975 LBS. (GROSS WT. OF FURNISHED STEEL)				

NOTE:


See sh. # 8 for bar lists for new Reinforcing Steel furnished by the Colo State Highway Dept.

SHEET NO 3 OF 11

COLORADO
STATE HIGHWAY DEPARTMENT
SIXTEENTH ST.
VIADUCT MODIFICATION
REINFORCING BARS MADE
FROM FURNISHED STEEL

Across Sta. _____
Near _____
Designed by _____
Made by _____
Checked by _____
Approved by _____
Bridge Engineer
Date: _____

FED. ROAD DIV. NO.	STATE	PROJ. NO.	SHEET NO.	TOTAL SHEETS
9	COLO.	UI 002-2(23) UNIT NO. 1	10	

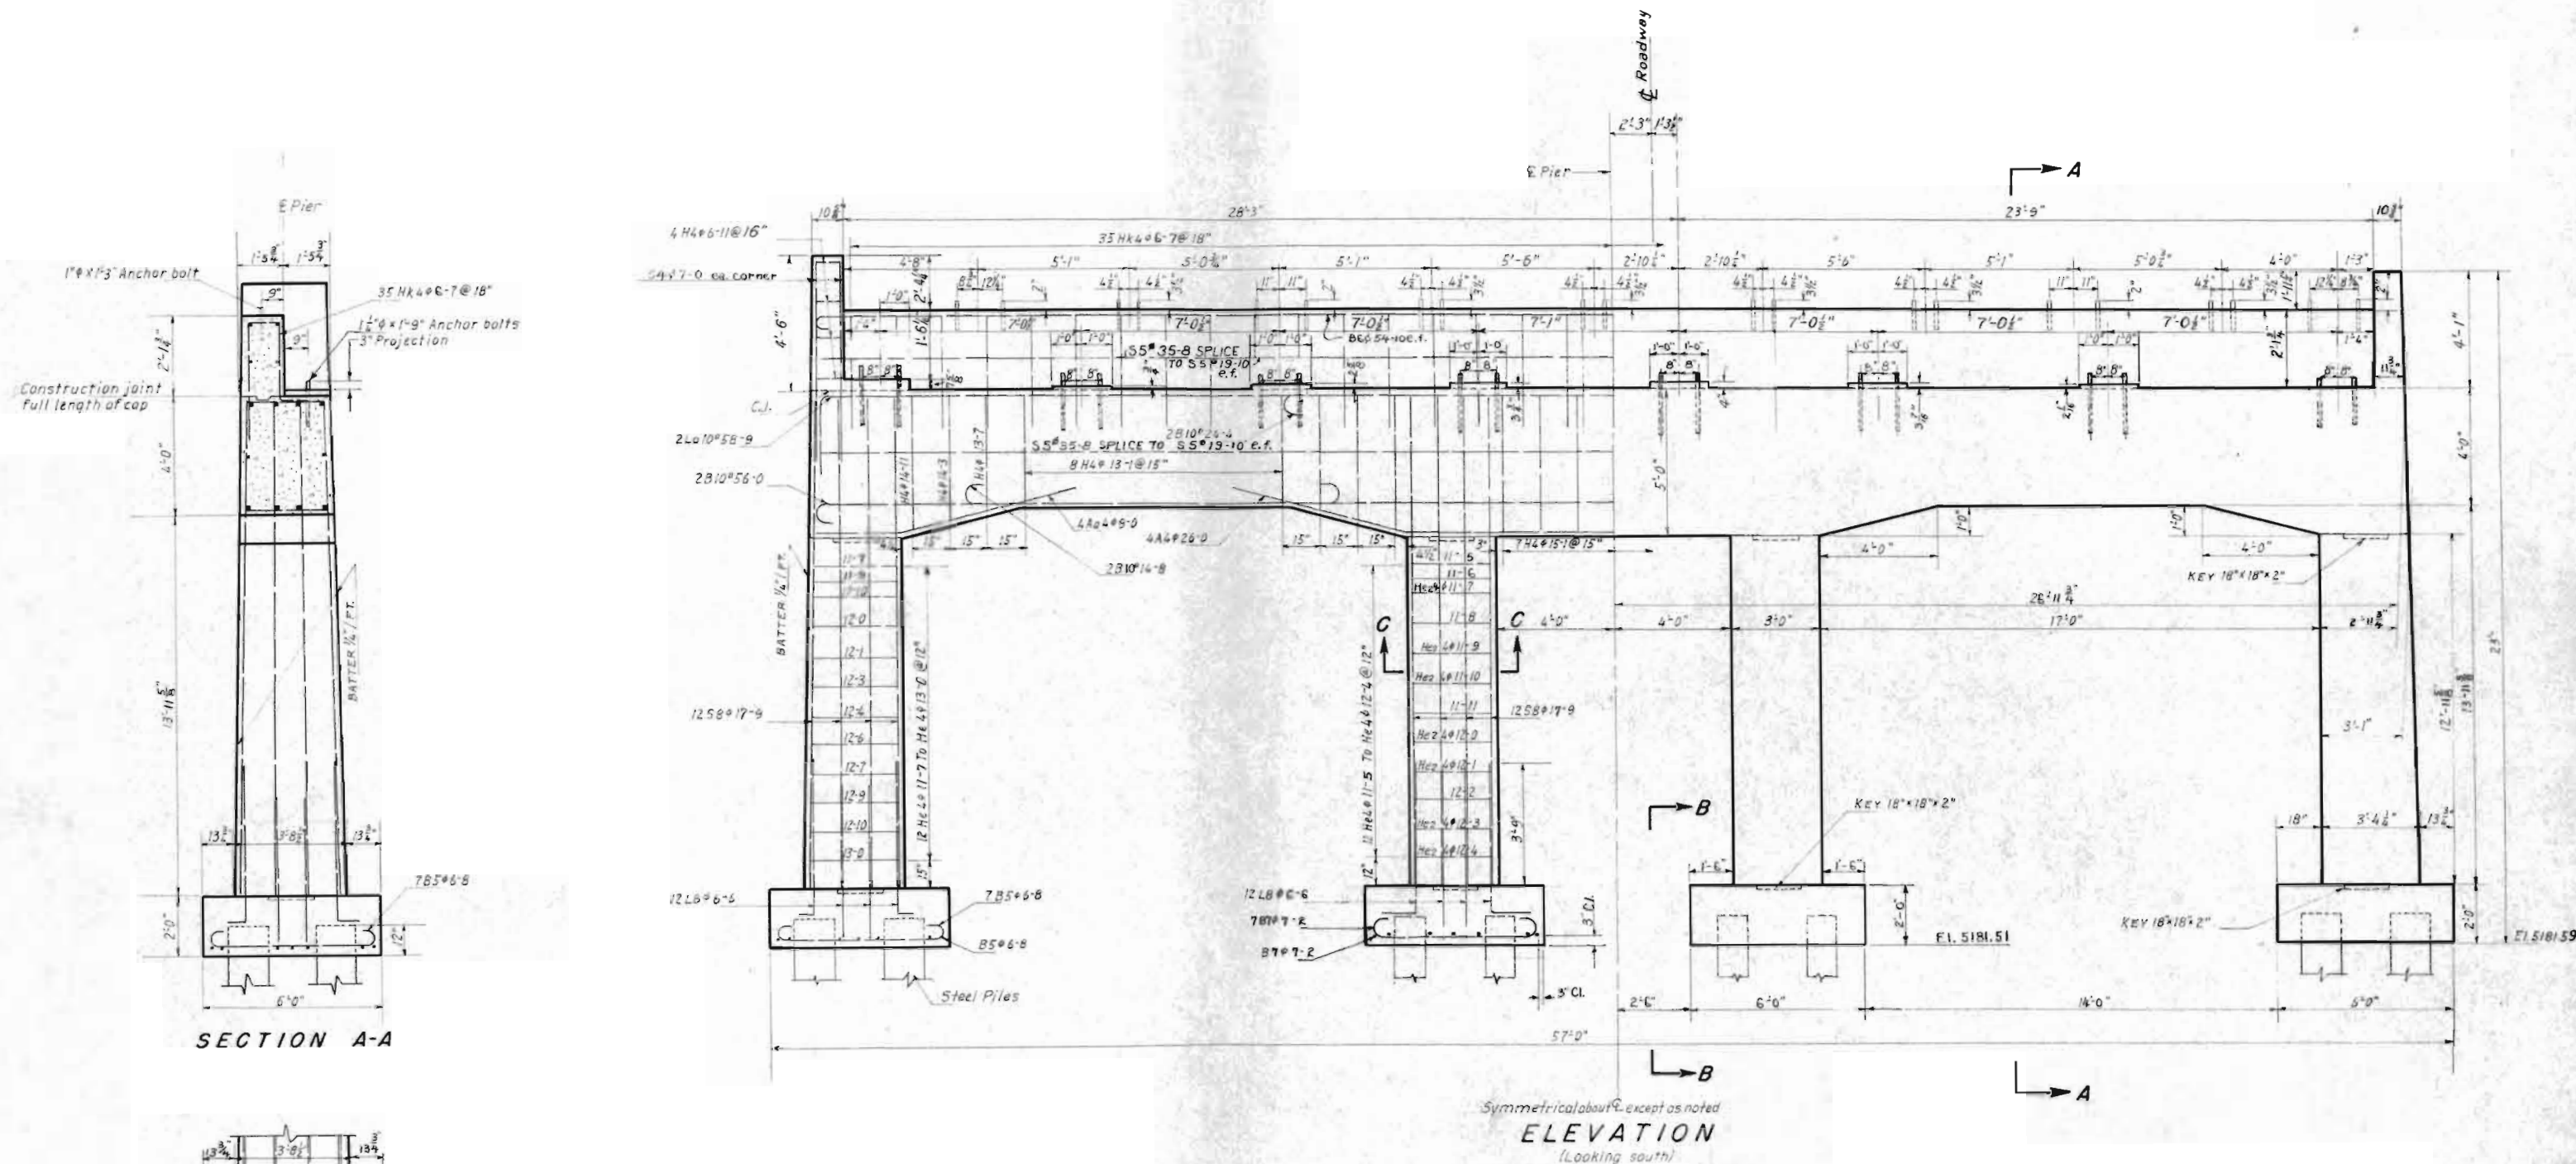


Scale 3/8" = 1'-0"

COLORADO STATE HIGHWAY DEPT. THE VALLEY HIGHWAY DENVER, COLORADO		
SIXTEENTH ST. VIADUCT MODIFICATION		
SOUTH PIER		
STRUCTURE NO. E-16-EX		
CROCKER AND RYAN CONSULTING ENGINEERS DENVER, COLORADO		
DATE	SHEET 4 OF 11	DWG. NO.


Chamfer all exposed corners 3/4"
2" Min clear to steel except as noted.
Max. pile load = 70 kips

FED. ROAD DIV. NO.	STATE	PROJ. NO.	SHEET NO.	TOTAL SHEETS
9	COLO.	UI 002-2(23) UNIT NO 1	11	

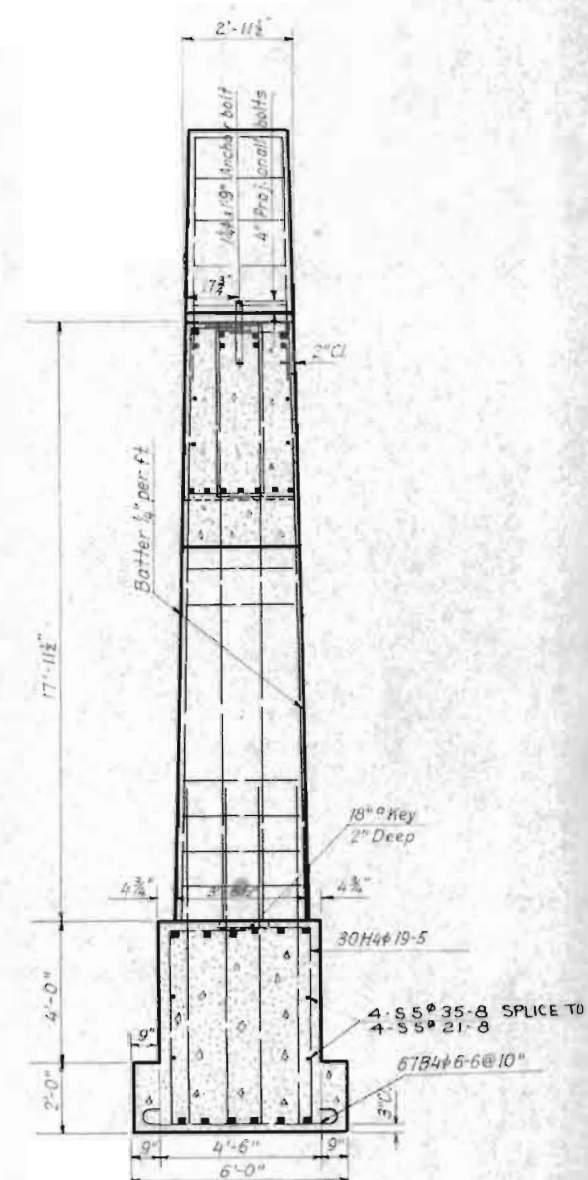

SECTION A-A

Looking South
Scale $3/8" = 1'-0"$

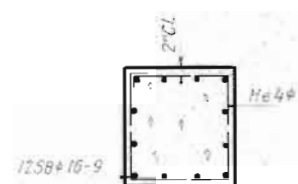

SECTION B-B

Chamfer all exposed corners, $\frac{3}{4}$ "
2" Min. clear to steel except as noted
Soil pressure = 4600 #/sq'

COLORADO STATE HIGHWAY DEPT.
THE VALLEY HIGHWAY DENVER, COLORADO

SIXTEENTH ST. VIADUCT MODIFICATION

CENTER PIER

STRUCTURE NO. E-16-EX




CROCKER AND RYAN
CONSULTING ENGINEERS
DENVER, COLORADO

RATE

SHEET 5 OF 11

DWG. NO.

FED. ROAD DIV. NO.	STATE	PROJ. NO.	SHEET NO.	TOTAL SHEETS
9	COLO.	UI 002-2(23) LIMIT NO. 1	12	

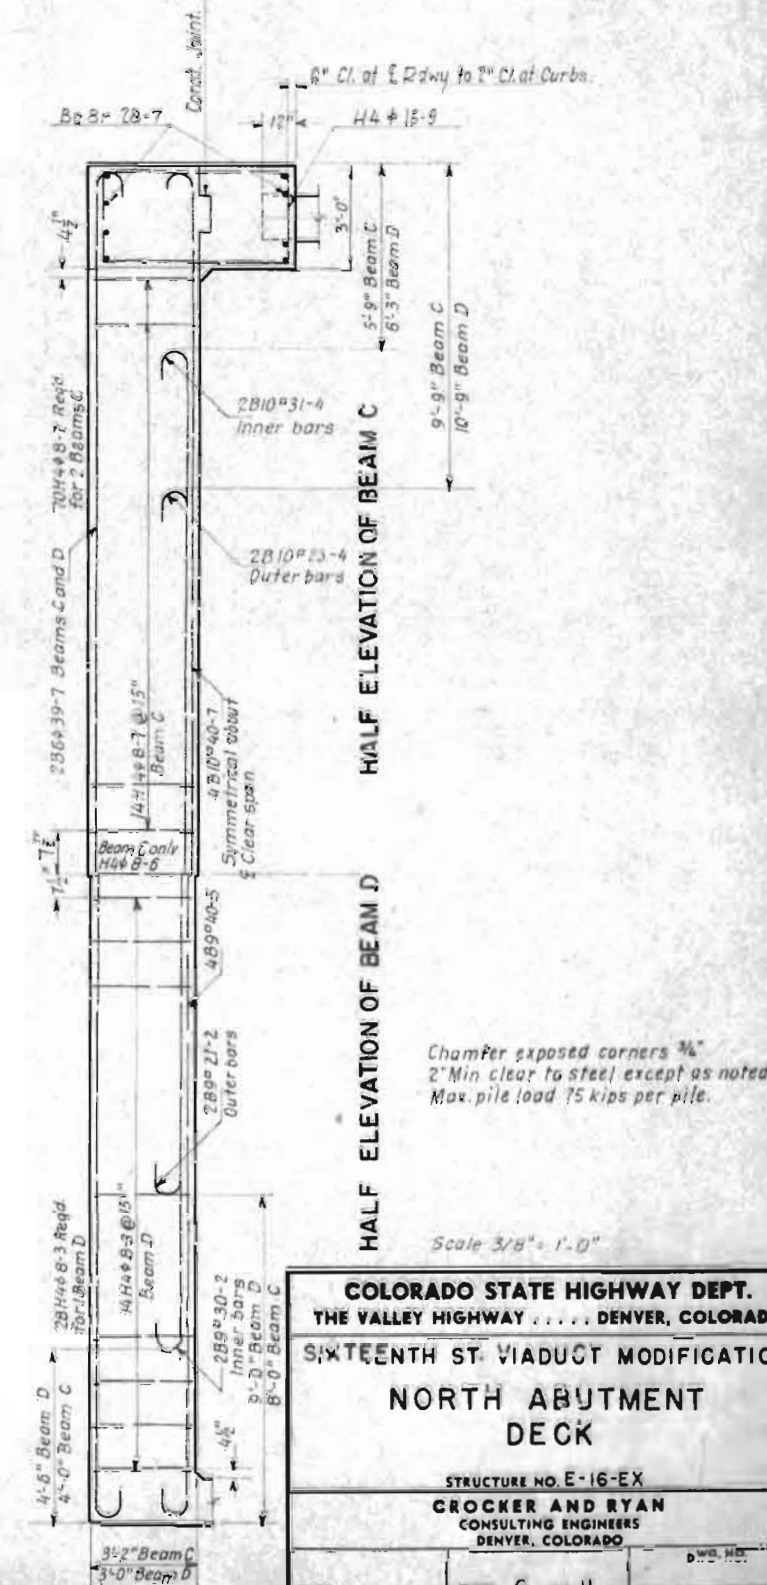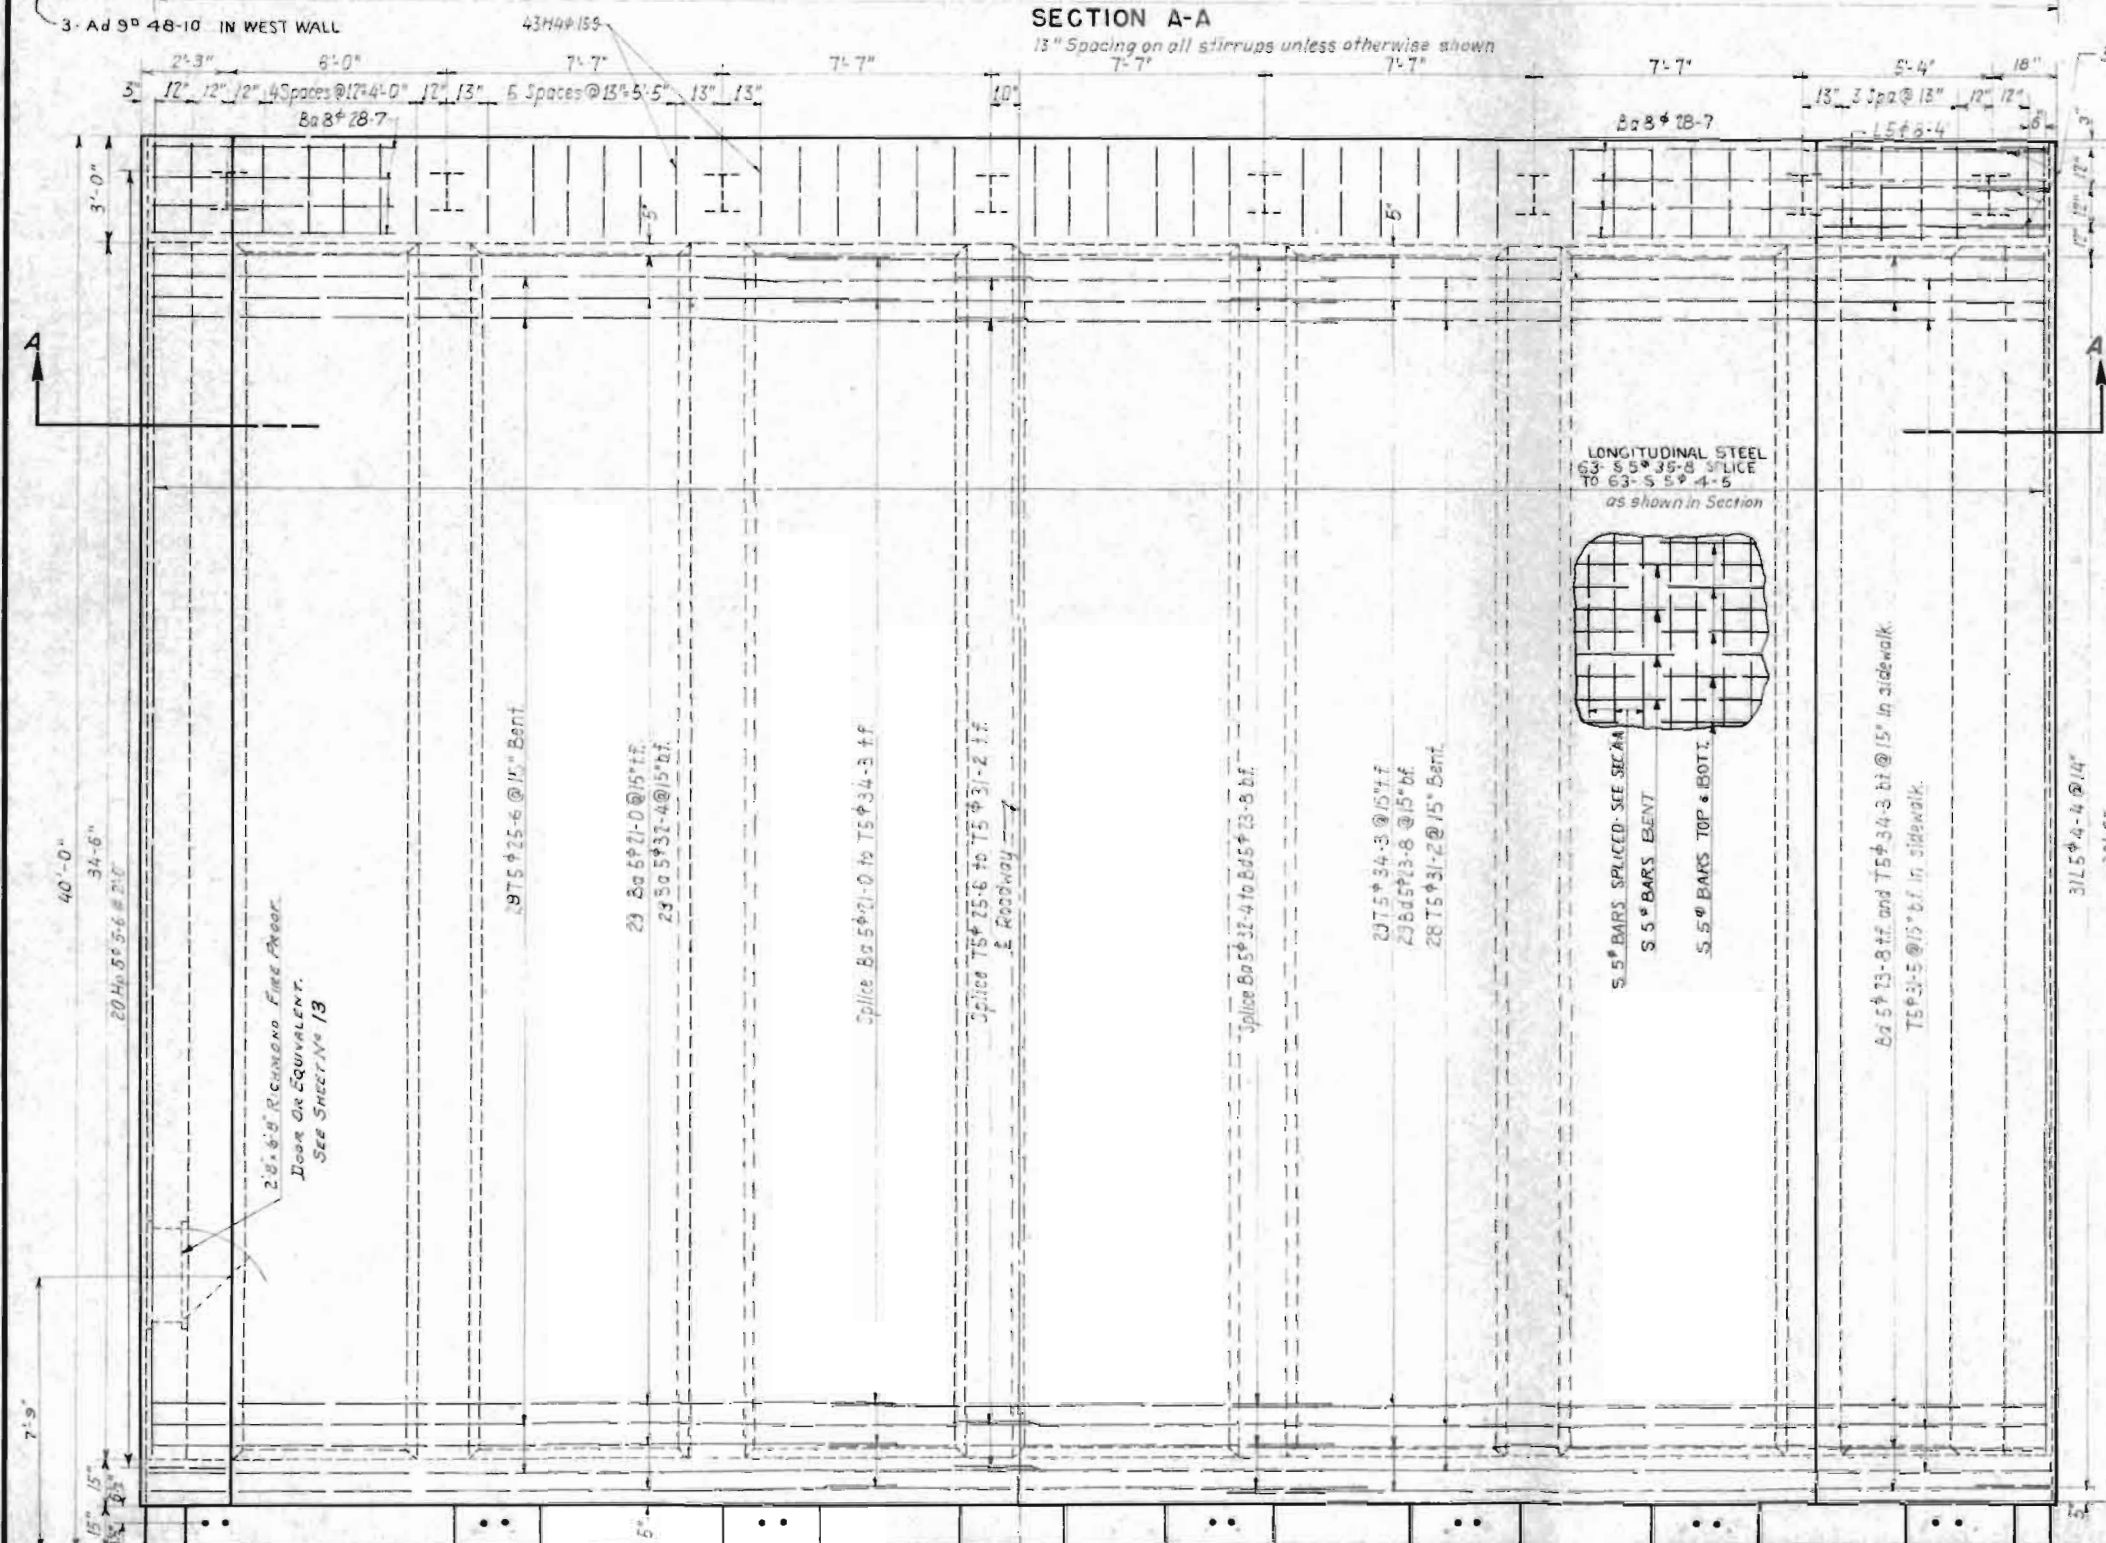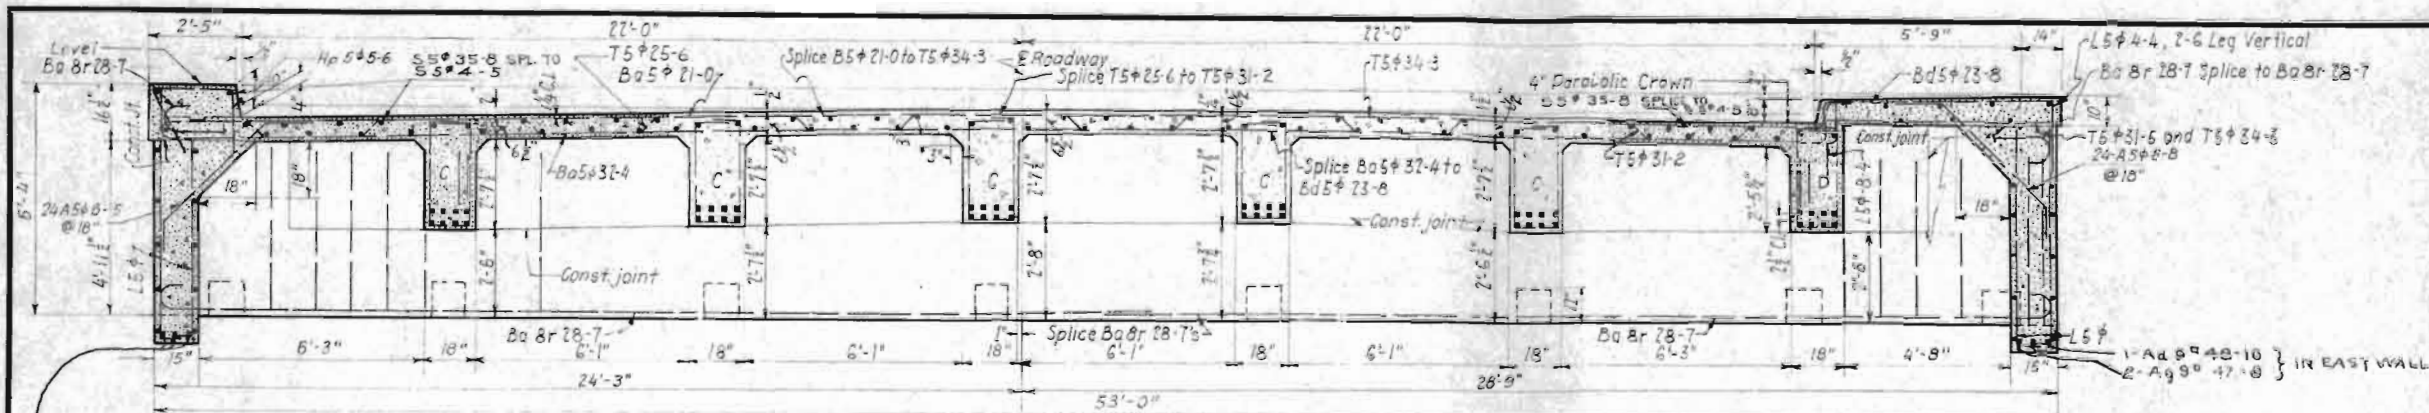

COLORADO STATE HIGHWAY DEPT.
THE VALLEY HIGHWAY DENVER, COLORADO

SIXTEENTH ST. VIADUCT MODIFICATION

**NORTH ABUTMENT
 DECK**


STRUCTURE NO. E-16-EX

GROCKER AND RYAN
CONSULTING ENGINEERS
DENVER, COLORADO


DATE _____ SHEET 6 OF 11 DRAWING NO. _____

Rev 5-15-51 C.I.S. Replace Stringers.


FED. ROAD DIV. NO.	STATE	PROJ. NO.	SHEET NO.	TOTAL SHEETS
9	COLO.	UI 002-2(23) UNIT NO. 1	13	

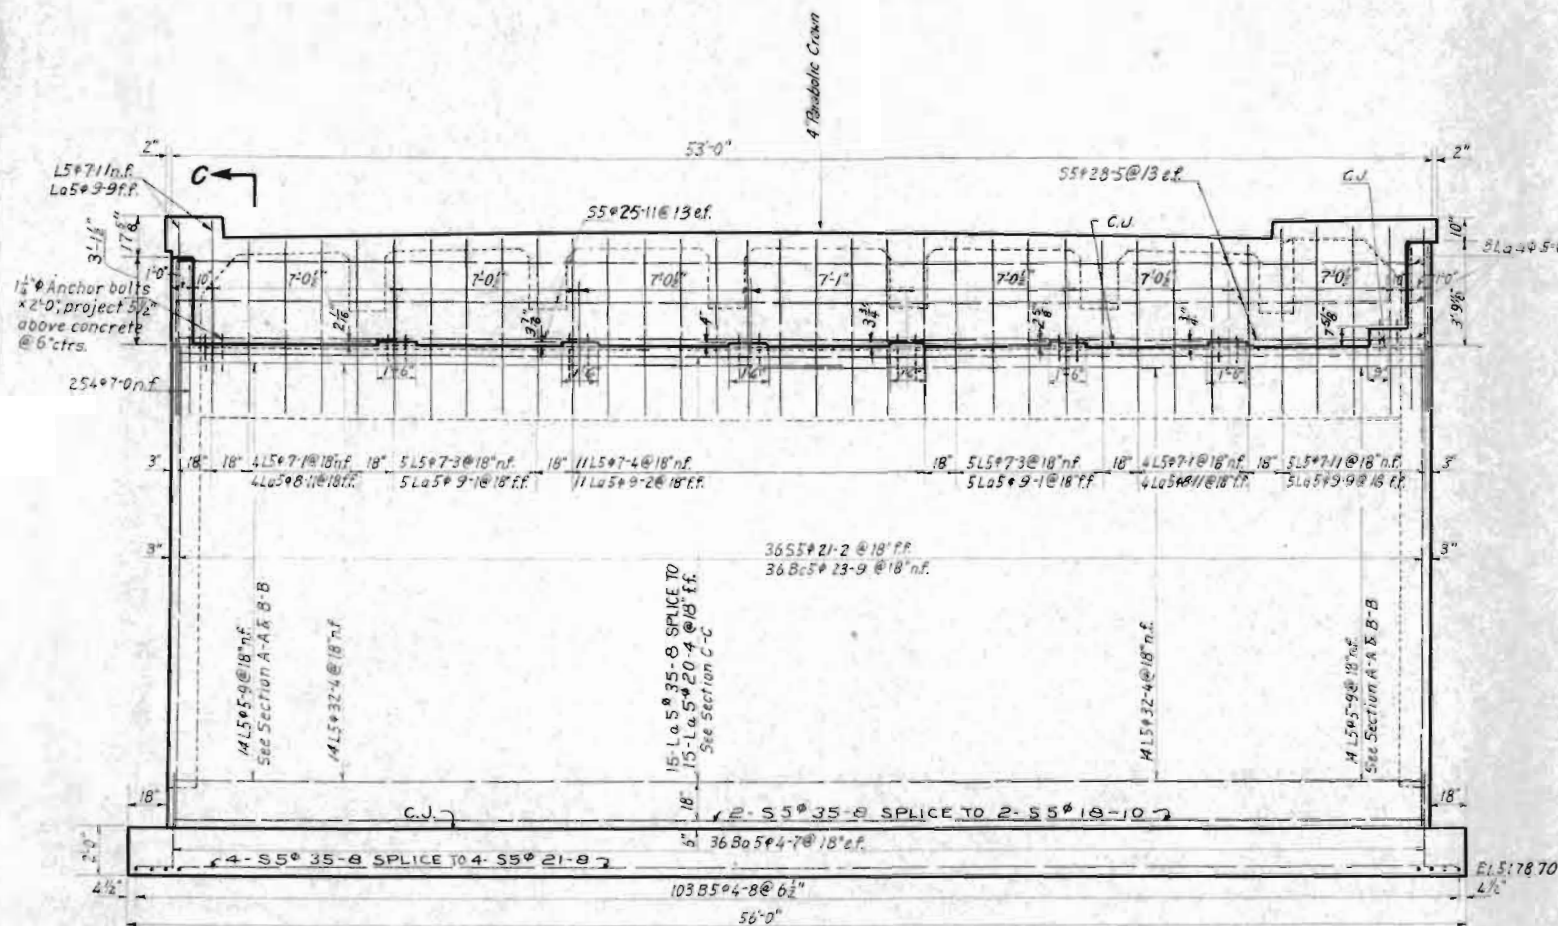

ELEVATION
Scale 1/4" = 1'-0"

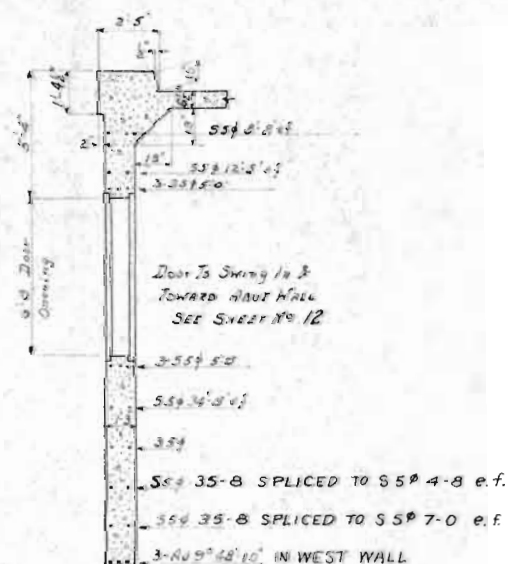


SECTION D-D.

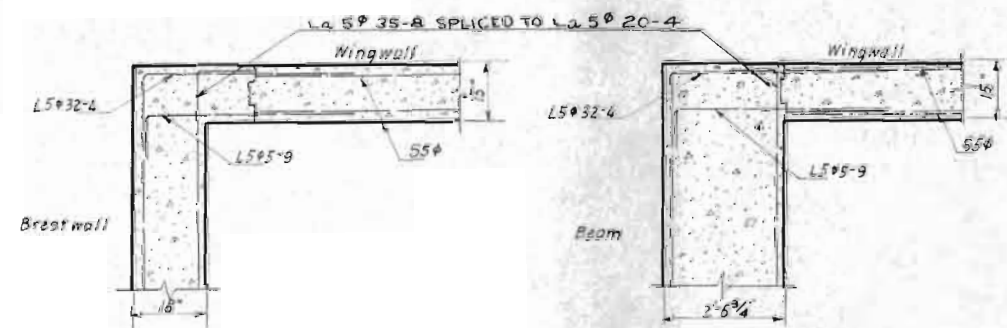

SECTION A-A
Scale 1/2" = 1'-0"

SECTION B-B
Scale 1/2" = 1'-0"

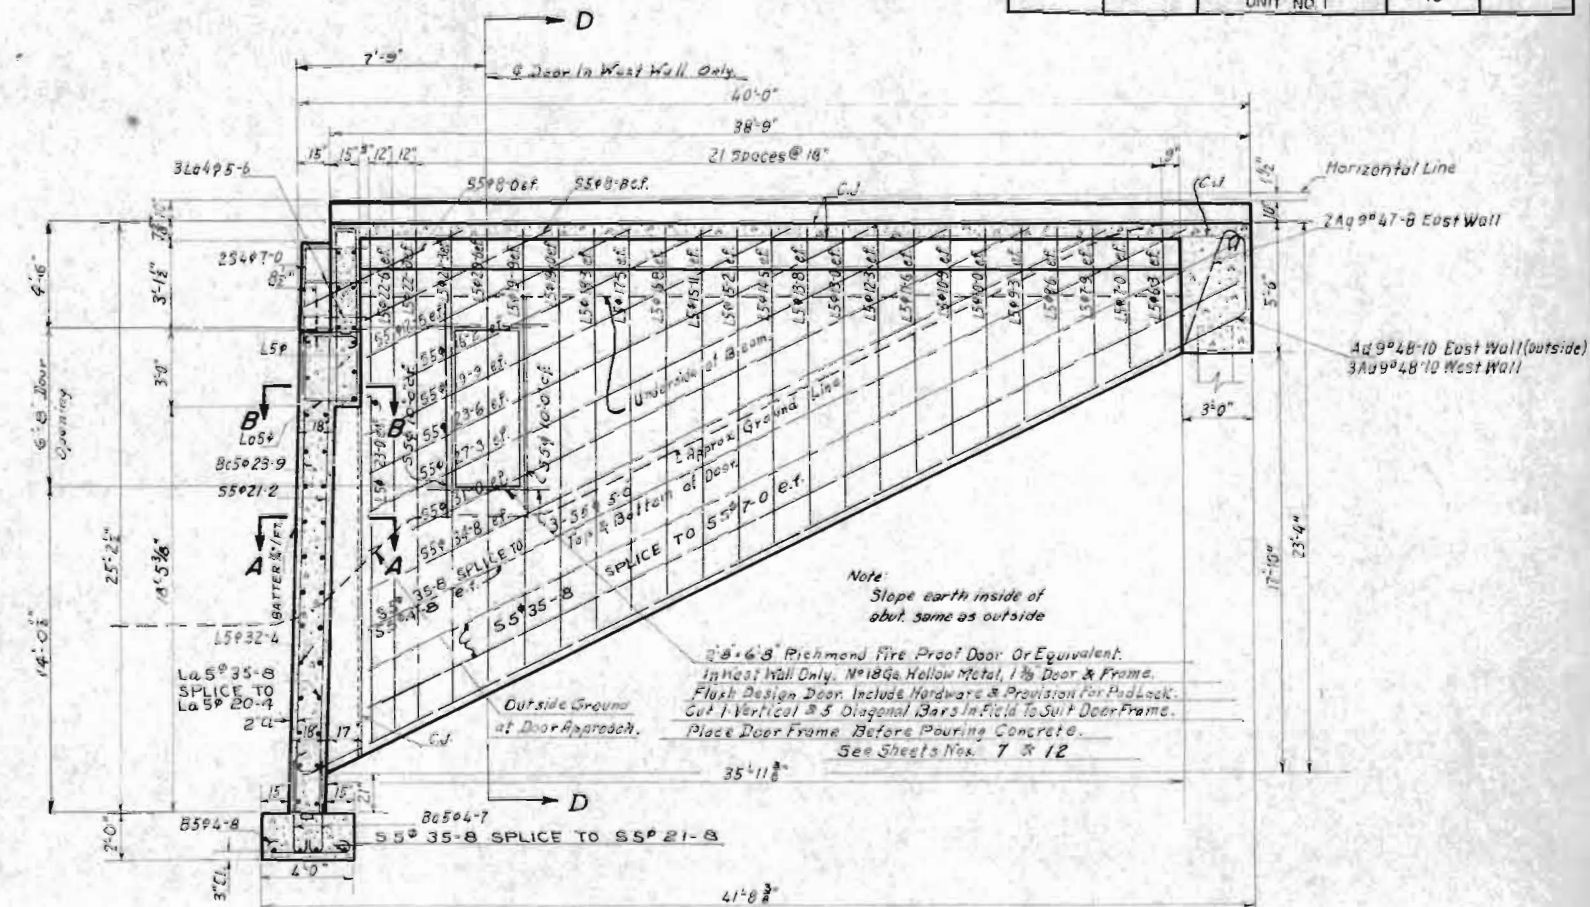


SECTION C-C
Scale 1/4" = 1'-0"

Chamfer exposed corners 3/4"
2" Min. clear to steel except as noted.
Max. soil pressure 5700#/sq.

COLORADO STATE HIGHWAY DEPT. THE VALLEY HIGHWAY DENVER, COLORADO			
SIXTEENTH ST. VIADUCT MODIFICATION NORTH ABUTMENT WALLS AND FOOTINGS			
STRUCTURE NO. E-16-EX CROCKER AND RYAN CONSULTING ENGINEERS DENVER, COLORADO			
DATE	SHEET 7 OF 11	DWG. NO.	


FED. ROAD DIV. NO.	STATE	PROJ. NO.	SHEET NO.	TOTAL SHEETS
9	COLO.	UI 002-2(23) UNIT NO. 1	14	

Rev. 5-15-51 C.L.S. Replace Stringers
Rev. 12-7-51 B.D.E. Revised End Diaphragm

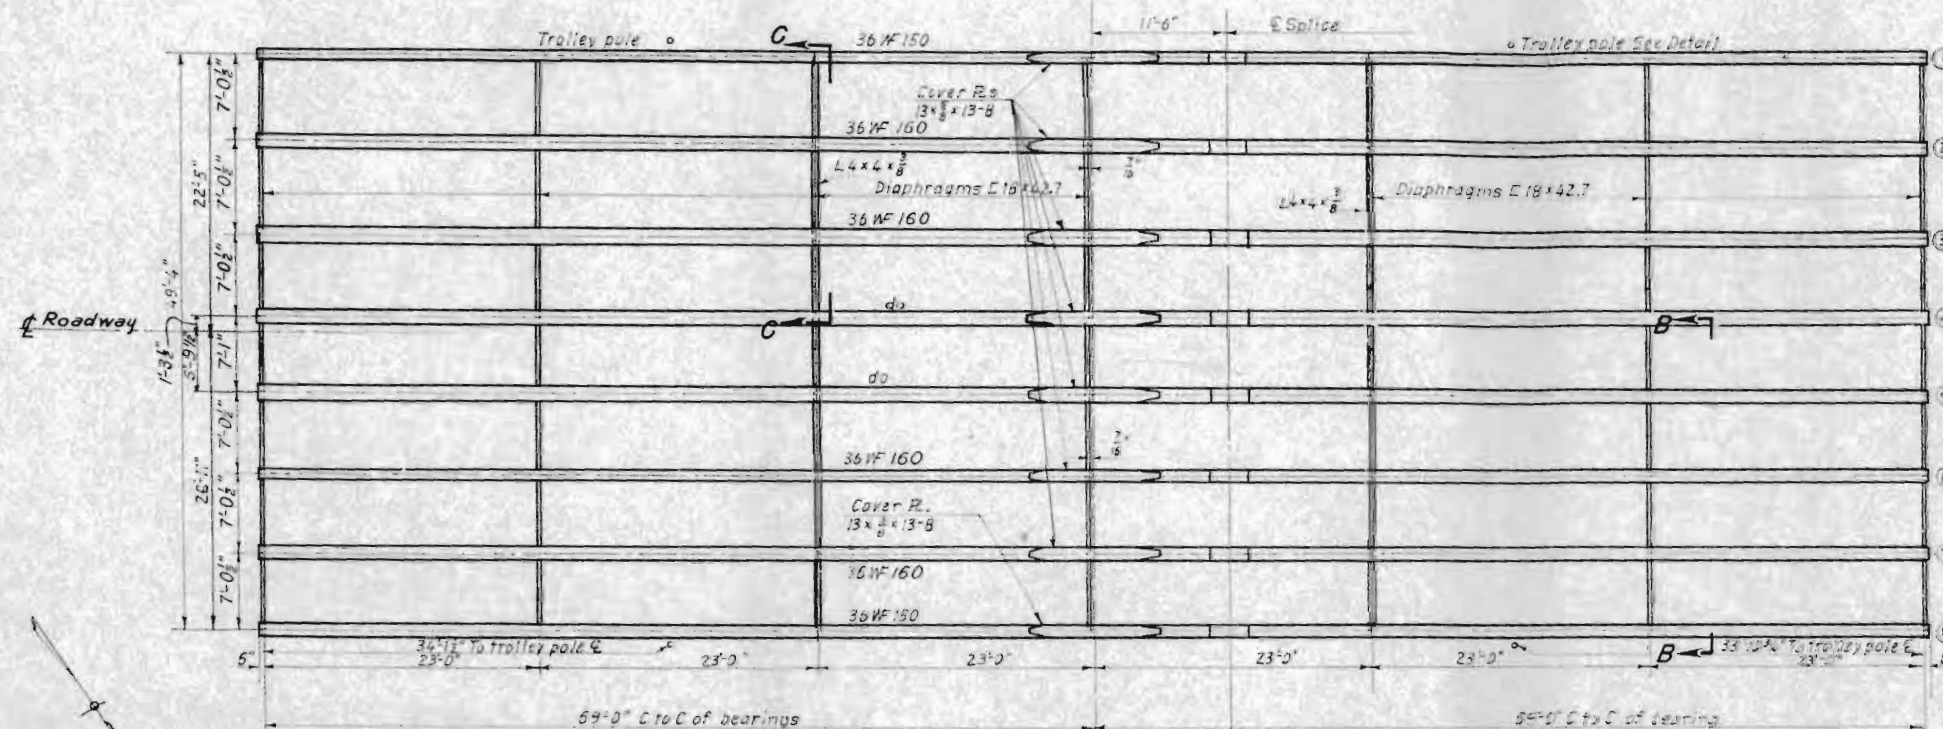


PLAN

Scale 1/8" = 1'-0"

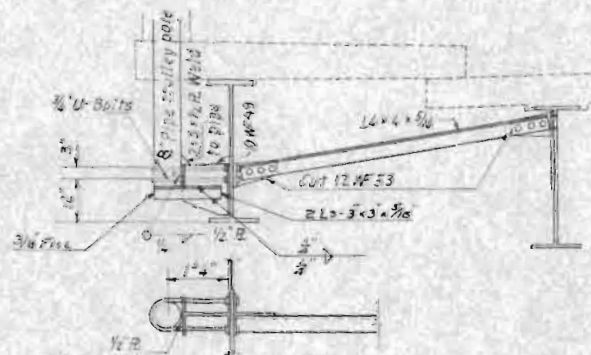

TROLLEY POLE SUPPORT
SIDEWALK SIDE

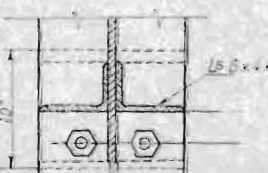

SPLICE DETAIL
36 WF 150 OR 36 WF 160

Scale 3/4" = 1'-0"

END DETAIL

Scale 3/4" = 1'-0"

DETAIL THRU DIAPHRAGM
AT CONSTRUCTION JOINT

Scale 3/4" = 1'-0"

DETAIL A

Scale 3" = 1'-0"

DETAIL OF FIXED END BEARING

Identical for all bearings

Scale 1 1/2" = 1'-0"

DETAIL OF
CENTER BEARINGS

South end Bearing Same

Scale 1 1/2" = 1'-0"

DETAIL OF COVER PLATES

COLORADO STATE HIGHWAY DEPT.
THE VALLEY HIGHWAY DENVER, COLORADO

SIXTEENTH ST. VIADUCT MODIFICATION
BEAMS & BEARINGS

STRUCTURE NO. E-16-EX

CROCKER AND RYAN
CONSULTING ENGINEERS
DENVER, COLORADO

DATE SHEET 9 OF 11 DWG. NO.

SECTION B-B

No. Scale



SECTION C-C

No. Scale


All rivets 7/8" Dia.

FED. ROAD DIV. NO.	STATE	PROJ. NO.	SHEET NO.	TOTAL SHEETS
9	COLORADO	U1 002-a(23) UNIT NO. 1	16	

Rev. 12-10-51 BDE Revised End Diaphragm.

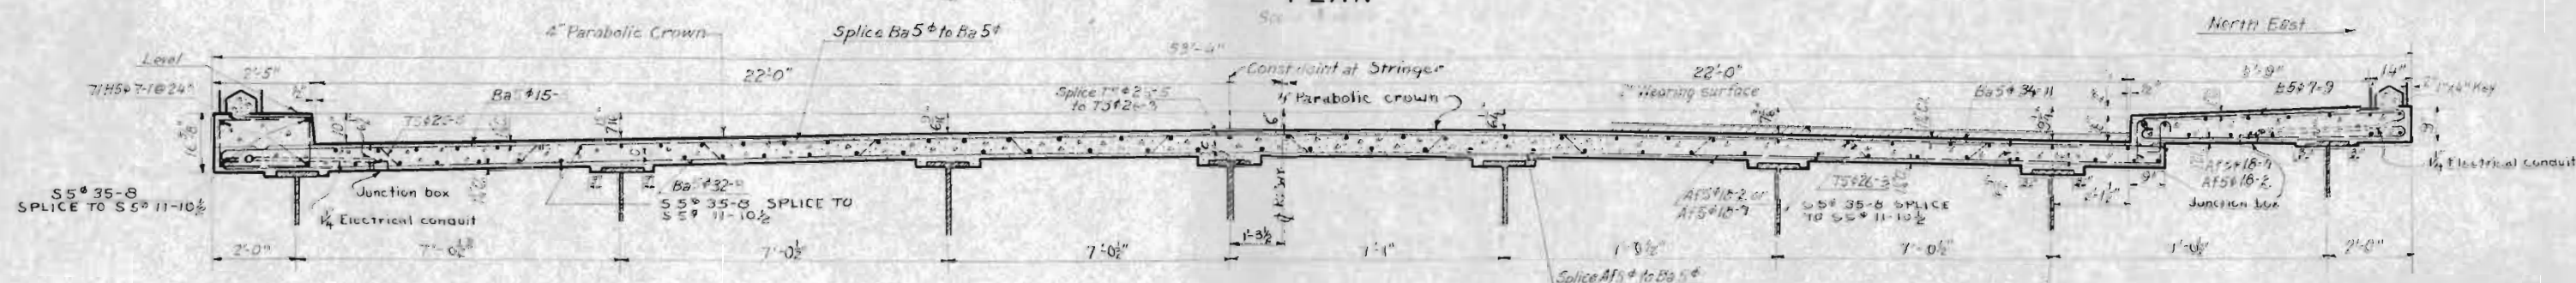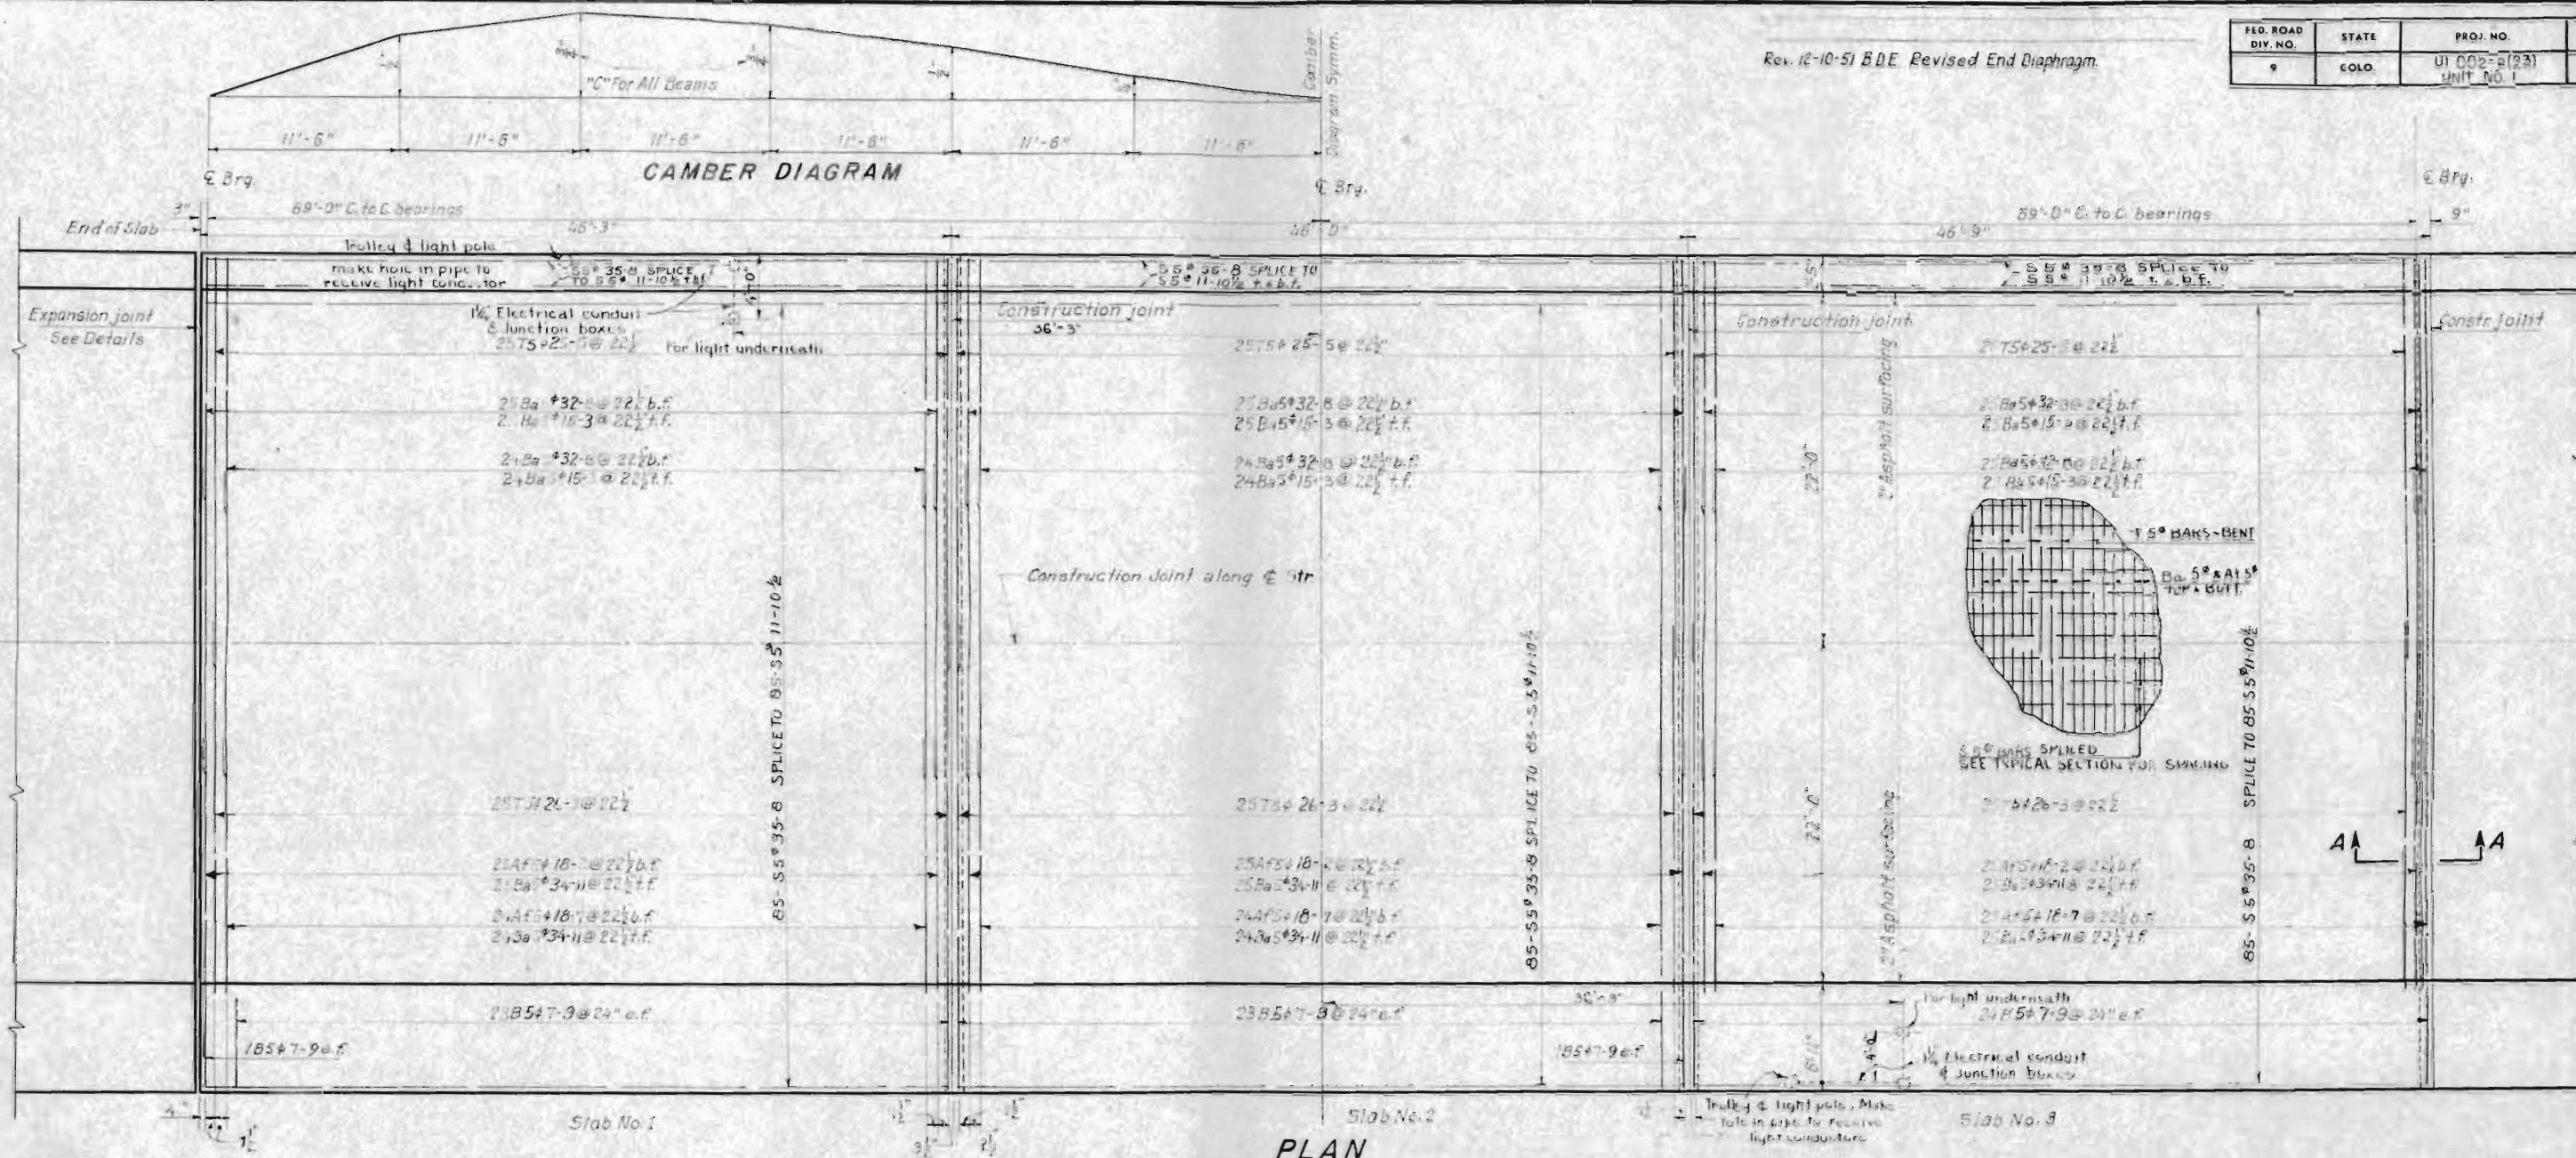

TYPICAL SECTION

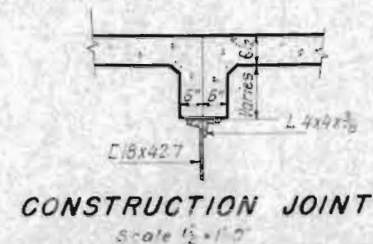

GENERAL NOTES
Pouring Sequence:

Pour slabs No. 1 and No. 3 first.
Pour slab No. 2 next.
Pour sidewalk last.
Chamfer exposed corners $\frac{3}{4}$ ".
2" Min. clear to steel except as noted.

COLORADO STATE HIGHWAY DEPT.
THE VALLEY HIGHWAY DENVER, COLORADO

SIXTEENTH ST. VIADUCT MODIFICATION








DECK

STRUCTURE NO. E-16-EX
CROCKER AND RYAN
CONSULTING ENGINEERS
DENVER, COLORADO

DATE SHEET 9 OF 11

Rev. WLR 10-2-50 Remove Tram Tracks.
Rev. BDE 5-15-51 Change Stringer Spacing

FED. ROAD DIV. NO.	STATE	PROJ. NO.	SHEET NO.	TOTAL SHEETS
9	COLO.	UI 002-2(23) UNIT NO. 1	17	

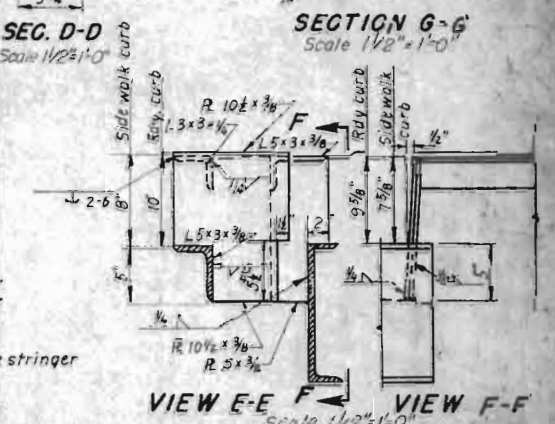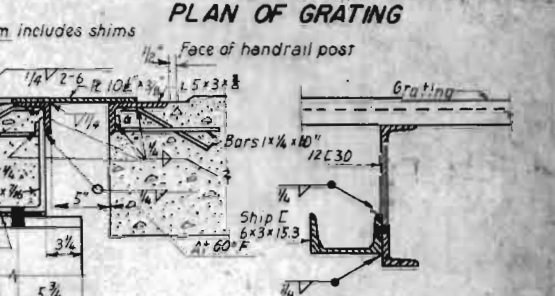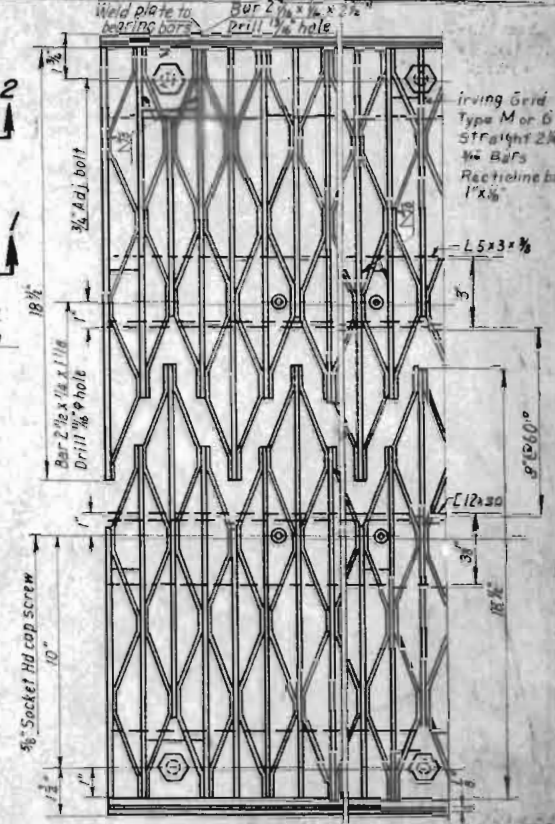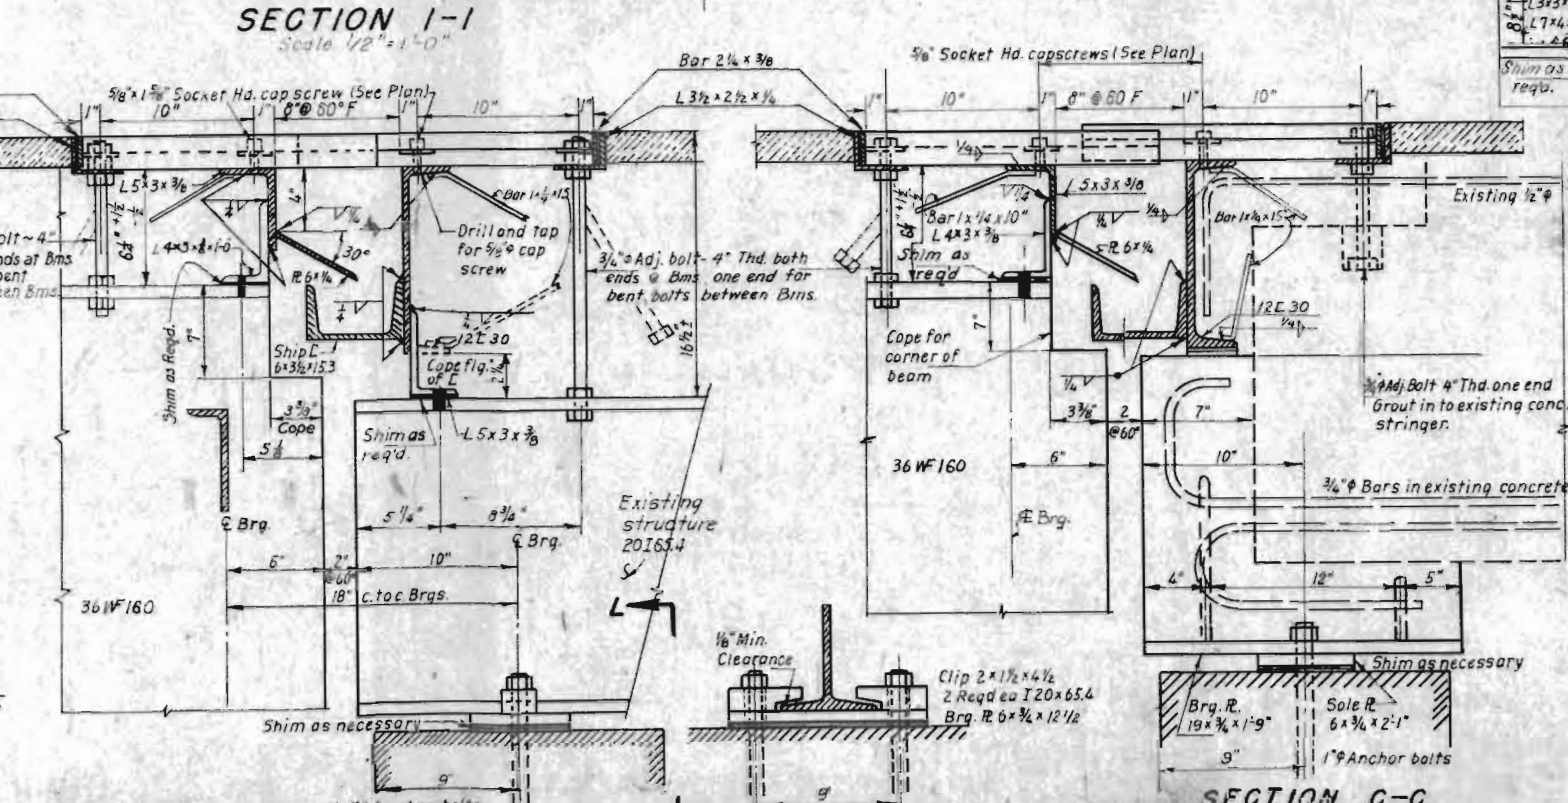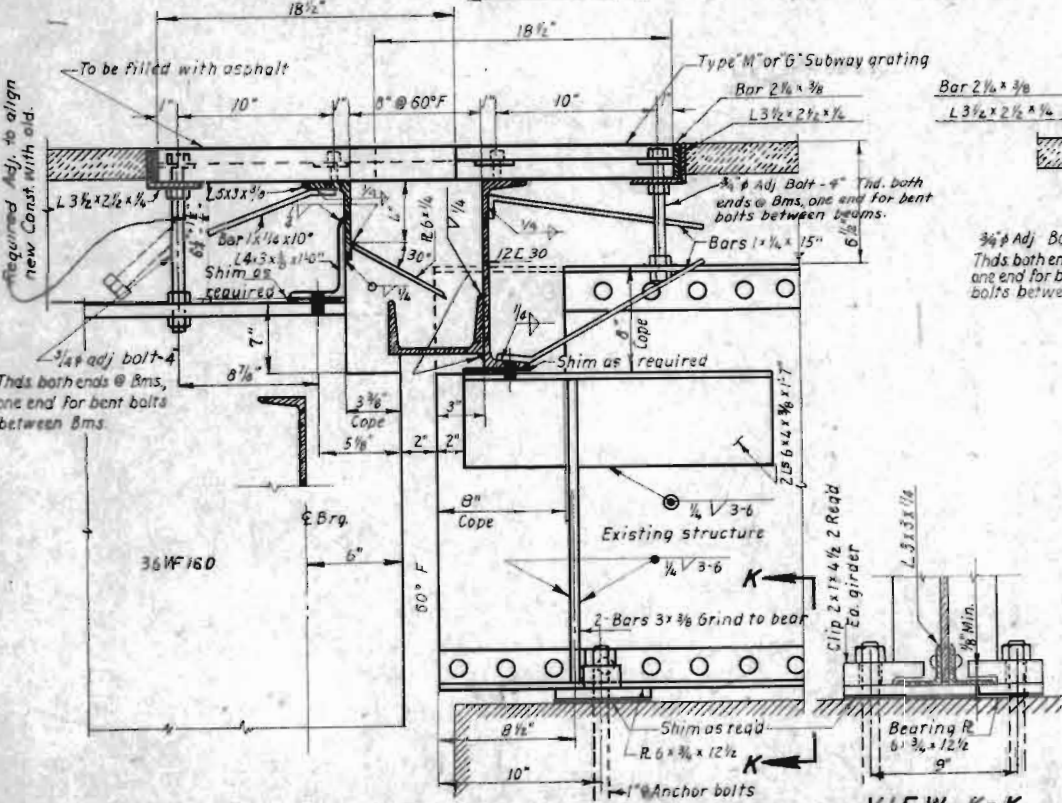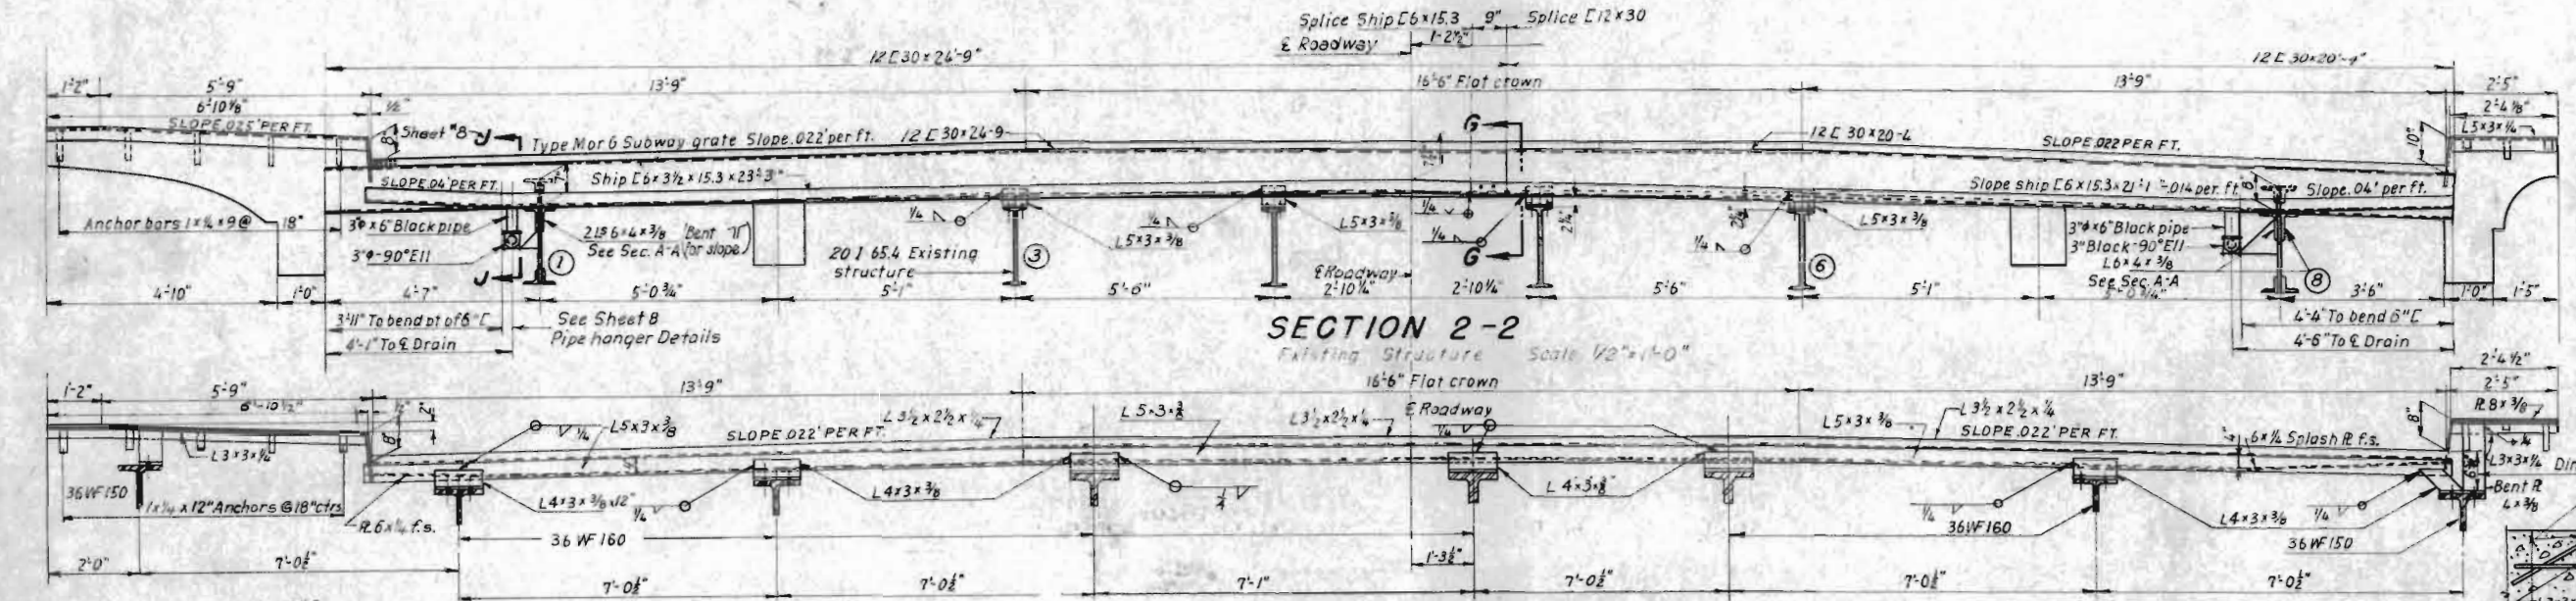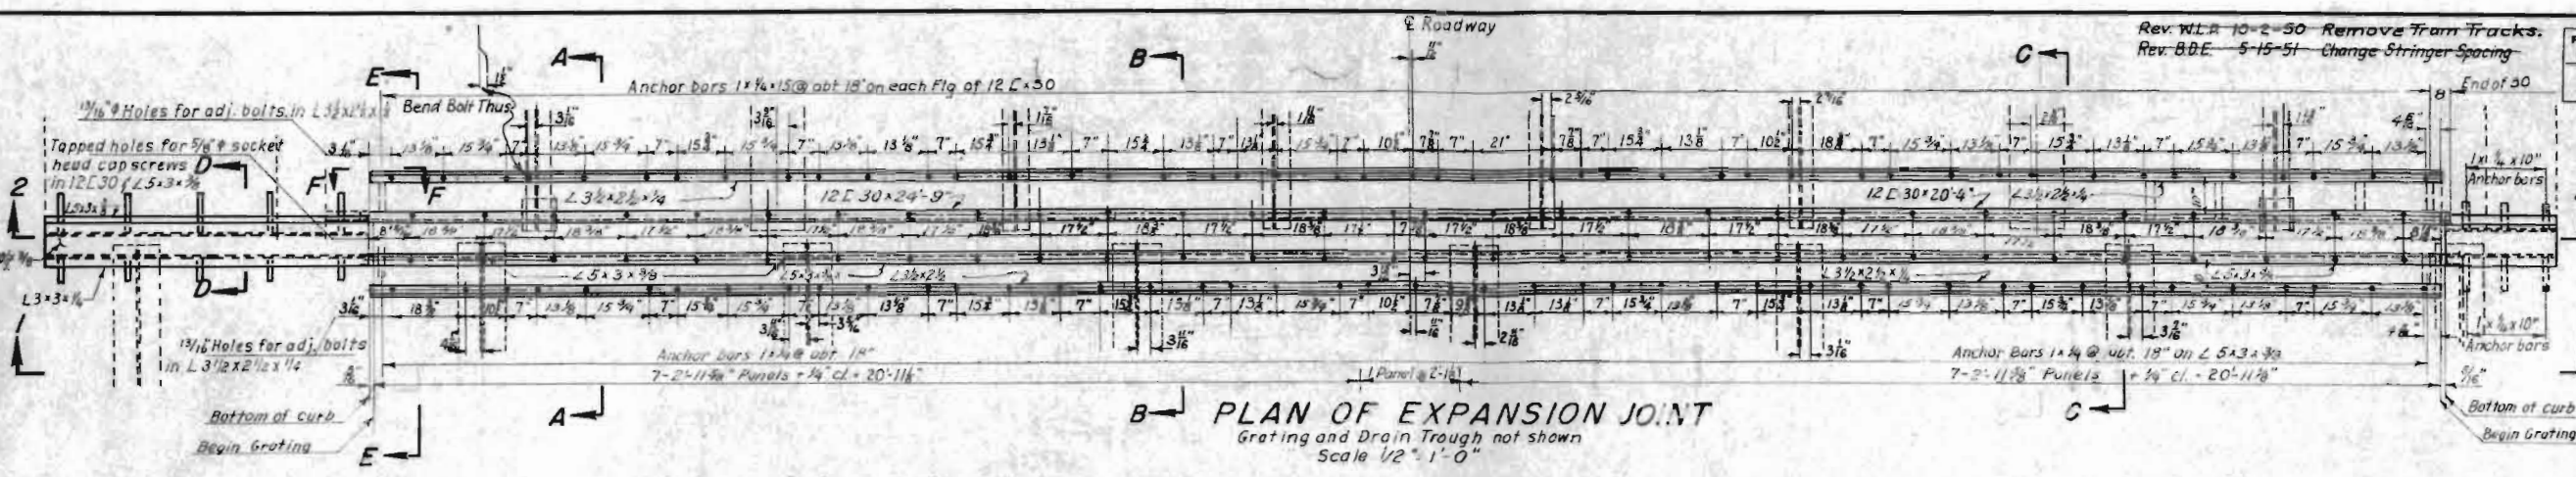

COLORADO STATE HIGHWAY DEPT.
THE VALLEY HIGHWAY.....DENVER, COLORADO

SIXTEENTH ST. VIADUCT MODIFICATION


EXPANSION JOINT

STRUCTURE NO. E-16-EX

CROCKER AND RYAN
CONSULTING ENGINEERS
DENVER, COLORADO

DATE SHEET 17 OF 17


FED. ROAD DIV. NO.	STATE	PROJ. NO.	SHEET NO.	TOTAL SHEETS
9	COLO.	UI 002-2(23) UNIT NO. 1	19	

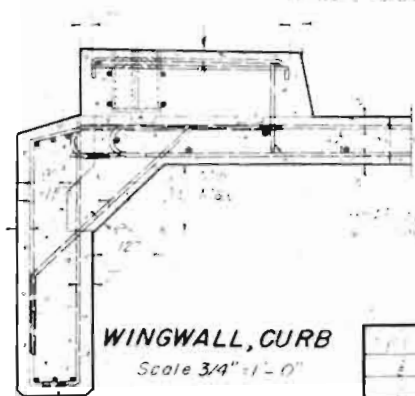


WINGWALL, CURB
Scale 3/4" = 1'-0"




WINGWALL, CURB
AND WALL BEAM
Scale 3/4" = 1'-0"

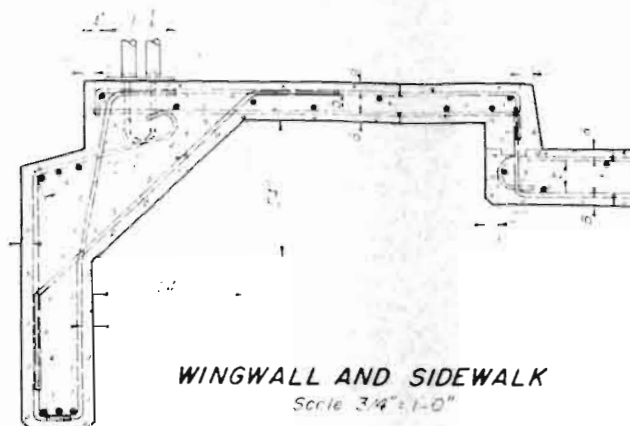


WINGWALL AND SIDEWALK
Scale 3/4" = 1'-0"

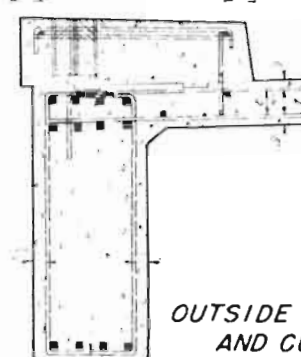


OUTSIDE GIRDER
AND CURB
Scale 3/4" = 1'-0"

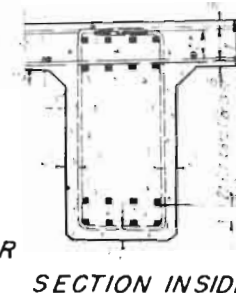


SECTION INSIDE
GIRDER
Scale 3/4" = 1'-0"

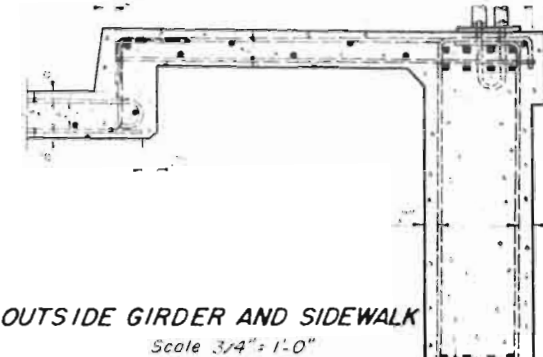


OUTSIDE GIRDER AND SIDEWALK
Scale 3/4" = 1'-0"

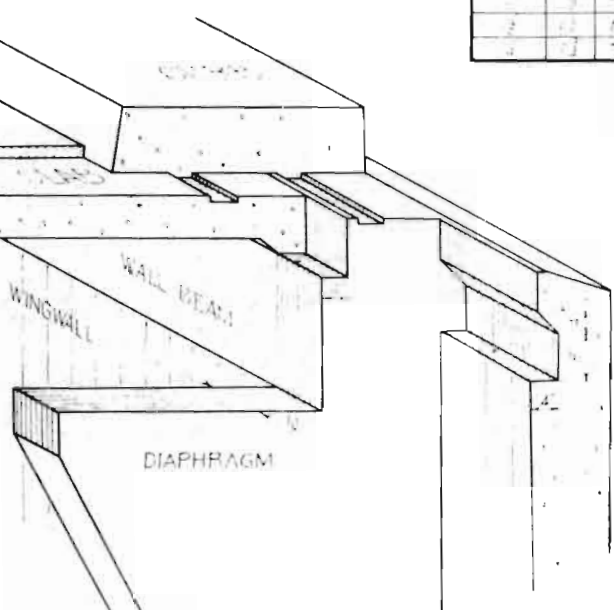


CONSTRUCTION JOINT
TYPE I
Scale 3/4" = 1'-0"

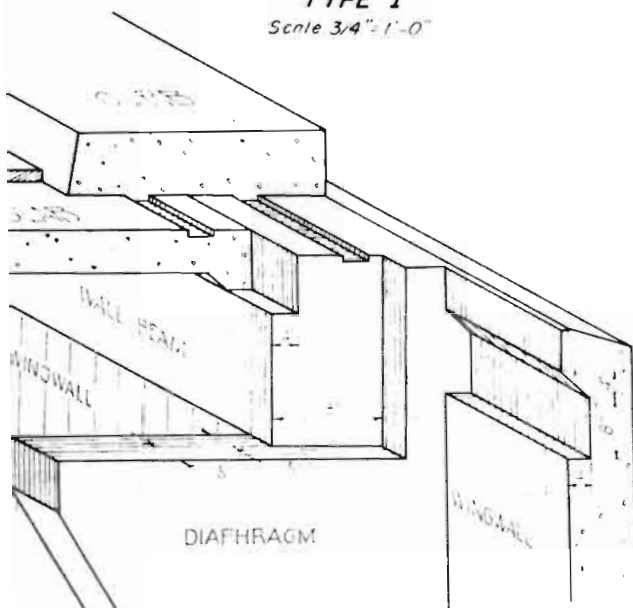


CONSTRUCTION JOINT
TYPE II
Scale 3/4" = 1'-0"

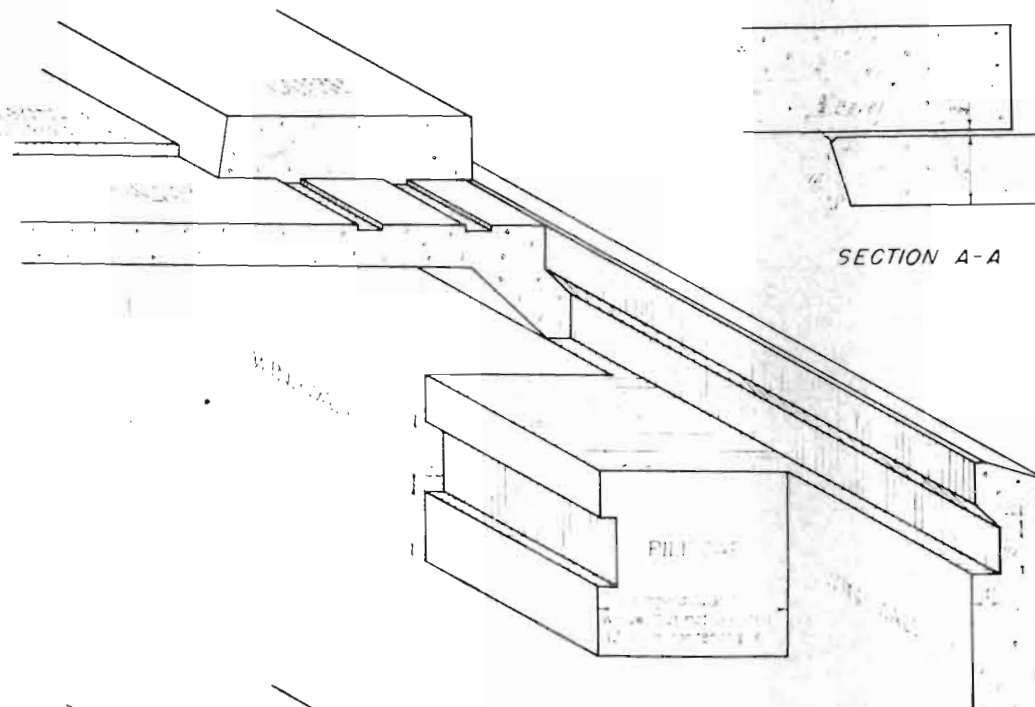


CONSTRUCTION JOINT
TYPE III
Scale 3/4" = 1'-0"

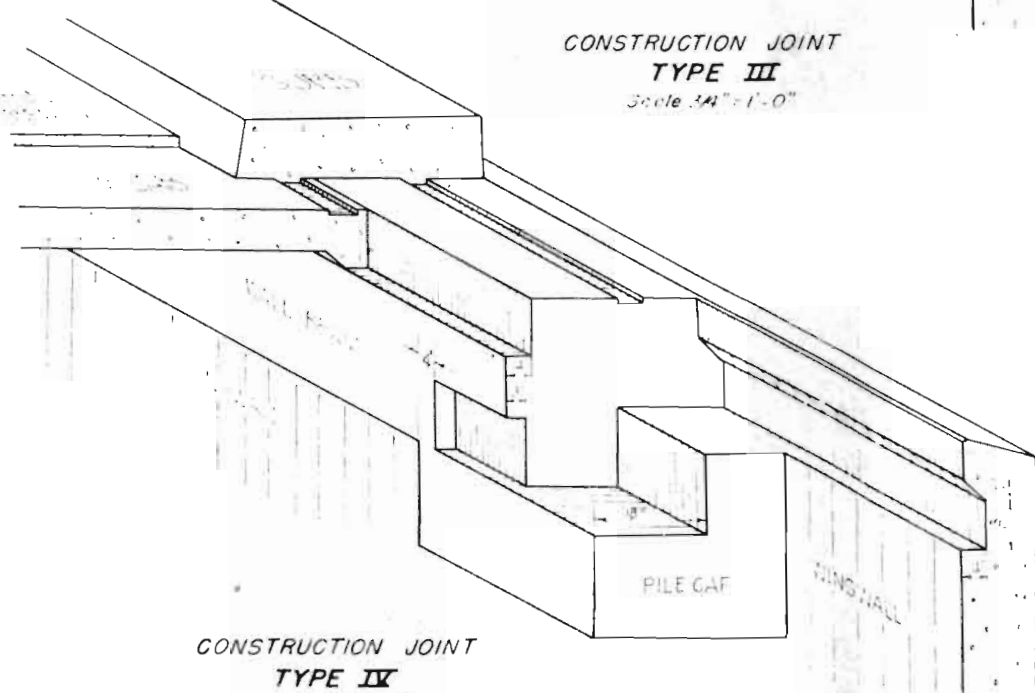


CONSTRUCTION JOINT
TYPE IV
Scale 3/4" = 1'-0"

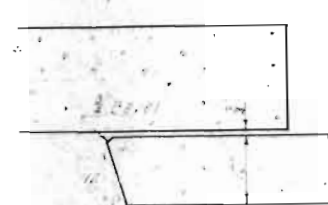


SECTION A-A

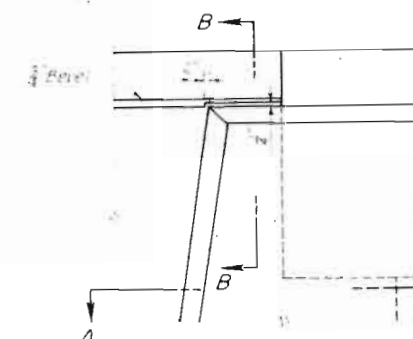


B

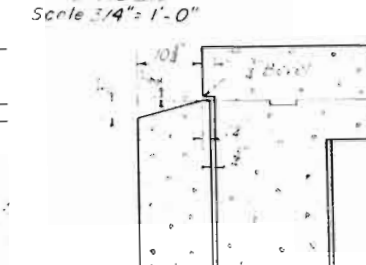


SECTION B-B

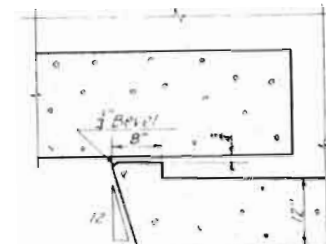


SECTION C-C

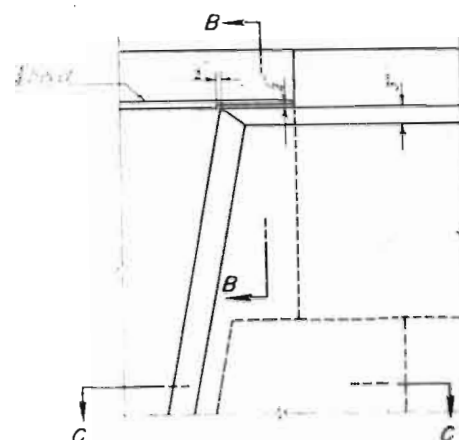

JUNCTURE OF WINGWALL
AND FRAME
Scale 3/4" = 1'-0"

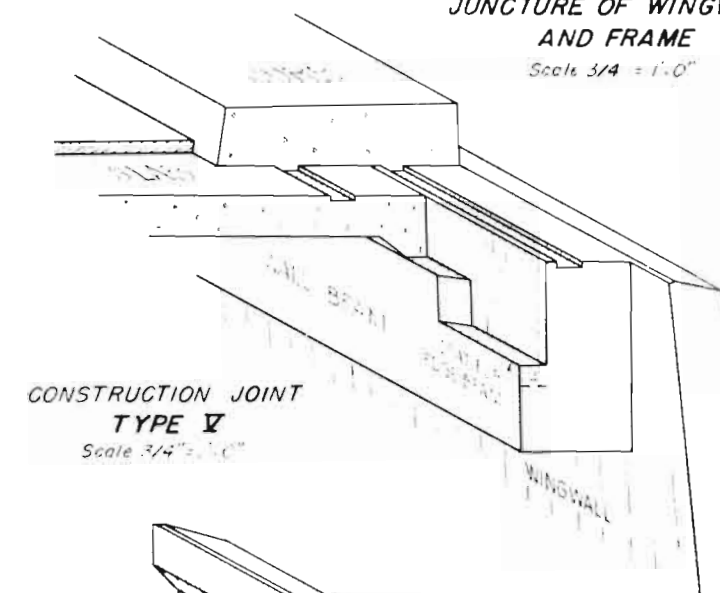

CONSTRUCTION JOINT
TYPE V
Scale 3/4" = 1'-0"

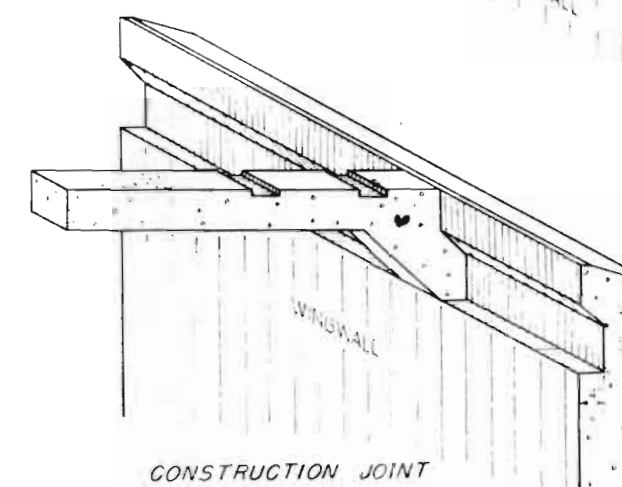

CONSTRUCTION JOINT
TYPE VI
Scale 3/4" = 1'-0"

COLORADO STATE HIGHWAY DEPT.
THE VALLEY HIGHWAY DENVER, COLORADO



BRIDGE STANDARDS
DETAILS FOR
RIGID FRAME BRIDGES

CROCKER AND RYAN
CONSULTING ENGINEERS
DENVER, COLORADO

DATE SHEET 1 OF 3 DIV. NO.

Technical drawing of a grate assembly. The drawing shows a rectangular grate with a grid pattern. Dimensions and labels are as follows:

- Top dimension: $2'-11\frac{1}{2}"$ (South Plate only)
- Second dimension from top: $5'-4\frac{1}{2}"$
- Label: End bar
- Text inside the grate: GRATE, IRVING TYPE II, OR EQUIVALENT
- Right side dimension: $5\frac{1}{2}' \times 8" N^{\circ} 5\frac{1}{2}"$ Grate bars
- Bottom right dimension: $1\frac{1}{2}' \times 1\frac{1}{2}"$ Lattice bar

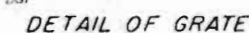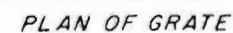

BRIDGE DRAIN GRATES AND FRAMES

Scale 1/2" = 1'-0"

COLORADO STATE HIGHWAY DEPT.
THE VALLEY HIGHWAY DENVER, COLORADO

BRIDGE STANDARDS
RAILING DATA
BRIDGE DATA, NUMBER POSITION

CROCKER AND RYAN
CONSULTING ENGINEERS
DENVER, COLORADO

DATE _____ SHEET 2 OF 3




Deck expansion joints
between 21st and 22nd panels

† Deck expansion joint
between 22nd and 23rd panels

‡ Deck expansion joint at each
end of these 4 panels



Scale 3/4" = 1'-0"

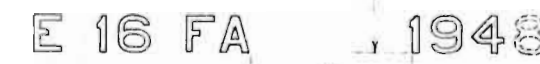

NOTE: For structure and year numbers use STANDARD M-N-B.
COLORADO STATE HIGHWAY DEPARTMENT

YEAR AND BRIDGE NO. POSITIONS

DWG. NO. _____

REVISIONS
Rev. 12-13-47 J.P.K.
Rev. 7-1-49 J.R.E.
Rev. 9-14-50 J.E.R.

STANDARD M-10-B.

FED. ROAD DIST. NO.	STATE	261	SHEET NO.	TOTAL SHEETS
3	COLO.	002-2(23)	22	

1 2 3 4 5 6 7 8 9 0.

A B C D E F G H I J K L




M N O P Q R S T U V W

a b c d e f g h i j k l m n o p q r s t u v w x y z

SAMPLE BRIDGE NUMBER

SAMPLE YEAR NUMBER

Scale in inches
0 1 2 3

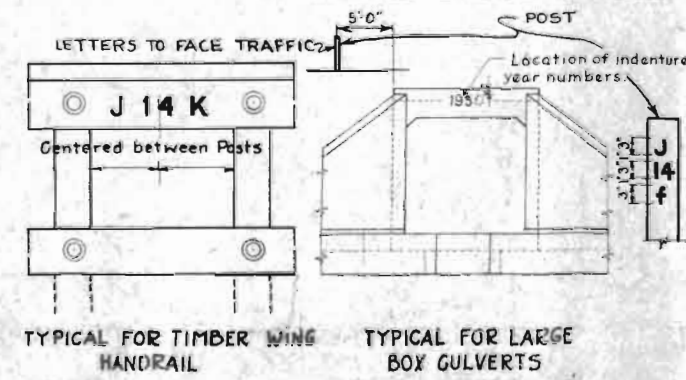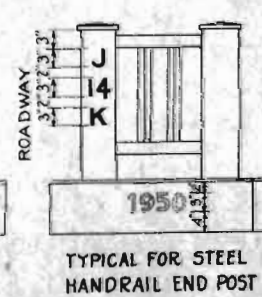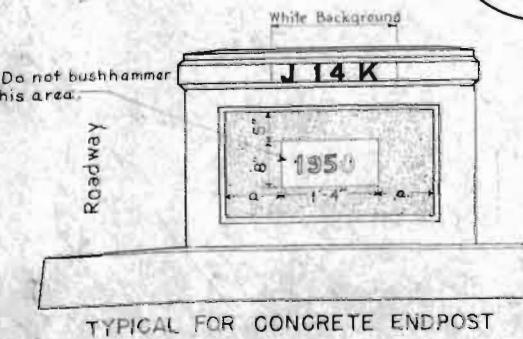

GENERAL NOTES

ALL WORK SHALL BE DONE IN ACCORDANCE WITH THE STANDARD SPECIFICATIONS OF THE COLORADO STATE HIGHWAY DEPARTMENT, ADOPTED JANUARY 1ST 1948.

COMPENSATION FOR THIS WORK SHALL BE INCLUDED IN THE ORIGINAL CONTRACT ITEMS AND WILL NOT BE PAID FOR AS A SEPARATE ITEM. THE SIZE, SHAPE AND SPACING OF THE LETTERS AND FIGURES SHALL BE IN ACCORDANCE WITH THE FULL SIZE SHOWN ON THIS SHEET. ADDITIONAL COPIES OF THIS FULL SIZE SHEET CAN BE OBTAINED FROM THE DEPARTMENT WITHOUT CHARGE.

THE YEAR NUMBERS ARE RECESSED IN CONCRETE 3/8" MINIMUM AS SHOWN, INTO THE PANEL OF THE ENDPST ON THE RIGHT HAND SIDE OF EACH BRIDGE END AND INTO THE FACE OF THE DOWNSTREAM HEADWALL OF CULVERTS AS SHOWN ON PLAN DETAILS. NUMBERS TO BE MADE OF WOOD, METAL OR OTHER SUITABLE MATERIAL AND ATTACHED TO THE FORMS BEFORE CONCRETE IS POURED. THE YEAR NUMBER OF EACH STRUCTURE SHALL CORRESPOND WITH THE YEAR IN WHICH THE CONCRETE IS POURED.

THE STRUCTURE NUMBER SHALL BE STENCILED ON THE RIGHT HAND SIDE OF EACH BRIDGE END AS SHOWN ON THIS STANDARD AND AS SPECIFIED. FOR MAJOR STRUCTURES OVER 20'-0" CLEAR SPAN.

THE CORRECT NUMBER FOR EACH BRIDGE IS SHOWN IN THE LOWER RIGHT HAND CORNER OF THE DETAIL SHEETS FOR THAT BRIDGE. A PROPER WHITE BACKGROUND RECTANGULAR IN SHAPE AND EXTENDING THREE INCHES BEYOND THE LIMITS OF THE NUMBER SHALL BE PAINTED WITH TWO COATS OF ACCEPTABLE WHITE PAINT UNLESS AN APPROVED WHITE CONCRETE PAINT IS USED. BEFORE PAINTING THE SURFACE MUST BE THOROUGHLY DRIED, CLEANED AND PROPERLY SIZED. ON TIMBER HANDRAILS THE WHITE PAINT USED ON THE BRIDGE WILL BE SATISFACTORY.

AFTER THE WHITE BACKGROUND HAS DRIED SUFFICIENTLY, THE CORRECT STRUCTURE NUMBER SHALL BE CAREFULLY STENCILED ON IT, WITH TWO COATS OF SECOND FIELD COAT-DARK OR EXTERIOR BLACK PAINT (PAINT) AS SPECIFIED UNDER ITEM 38 PAINTS AND PAINTING THE BRACES OF THE STENCILED LETTERS AND FIGURES SHALL BE CAREFULLY FILLED IN BY HAND TO MAKE SOLID FIGURES.

SUFFICIENT TIME BETWEEN SUCCESSIVE COATS SHALL BE ALLOWED TO PERMIT THORO DRYING.


MINOR STRUCTURES WITH CLEAR SPANS 12 TO 20 FEET INCLUSIVE SHALL BE STENCILED WITH STRUCTURE NUMBER THUS "W-18-2" ON 3" STEEL MARKER POSTS WHERE PROVIDED AND AS SHOWN ON STATE HIGHWAY STD. M-23-A

COLORADO
STATE HIGHWAY DEPARTMENT
STANDARD
LETTERS AND FIGURES
FOR
YEAR NUMBERS AND
STRUCTURE NUMBERS

Designed by G.H.D.
Made by W.P.M.
Checked by Bridge Eng.
Date: June 1, 1948


TYPES OF BEDDING

NOTE: Backfill layers for all Types of Bedding must be placed simultaneously on each side of the pipe to maintain equal lateral pressures.

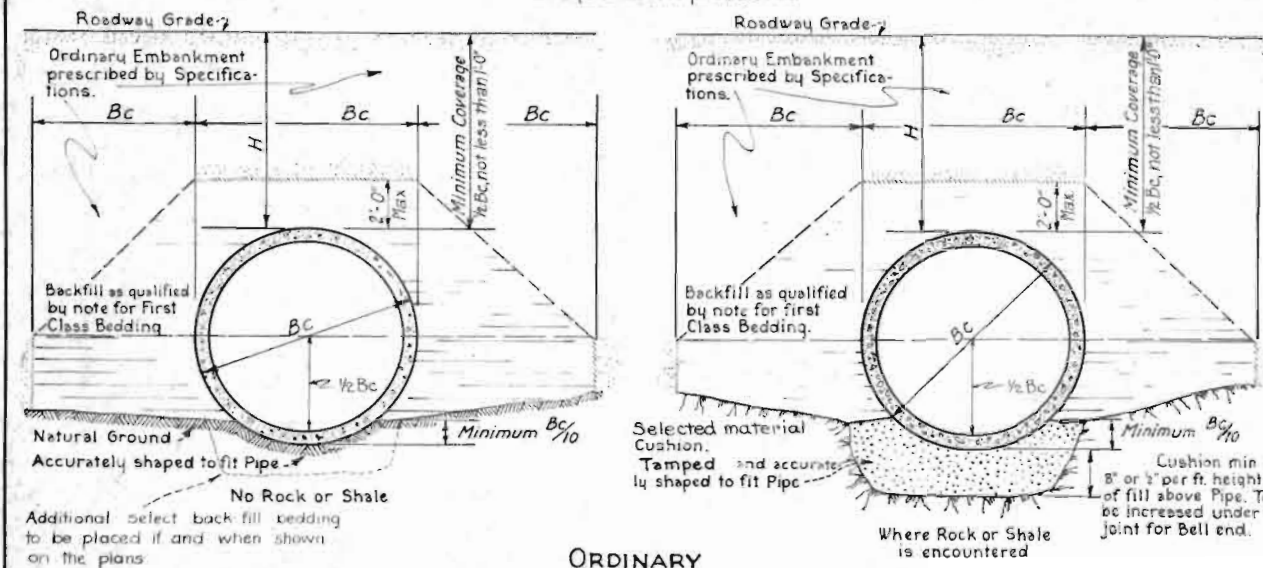

ORDINARY

FIRST CLASS

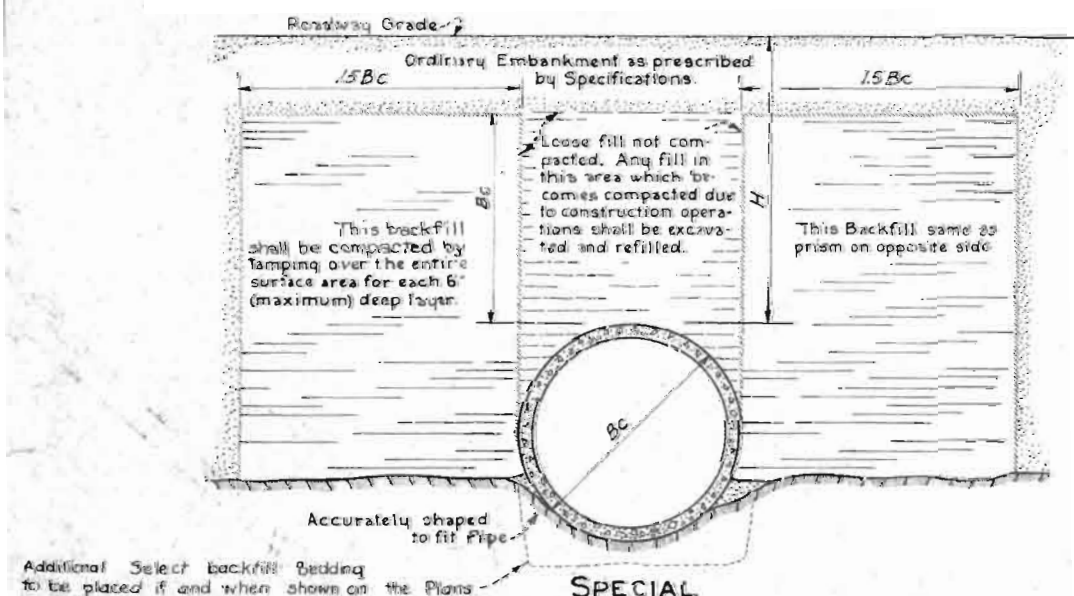



SPECIAL

A construction which consists of Ordinary Bedding or First Class Bedding combined with Special Backfilling, as noted above, to be used when height "H" exceeds limits noted in Table for Ordinary or First Class Bedding.



NOTE: When Special Bedding is called for or is implied by the maximum fill height limits the placement of the pipe and the backfill shall not be done except in the presence of the Engr.

PIPE CROSS SECTIONS

With Two Lines of Circular Reinforcement

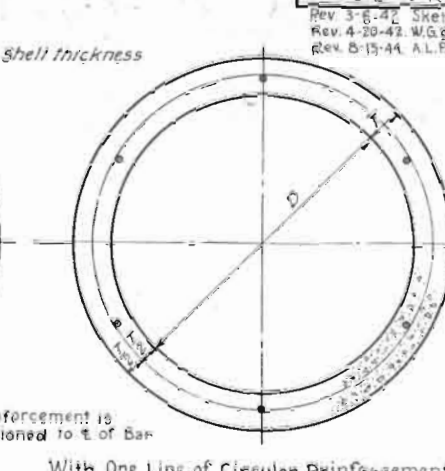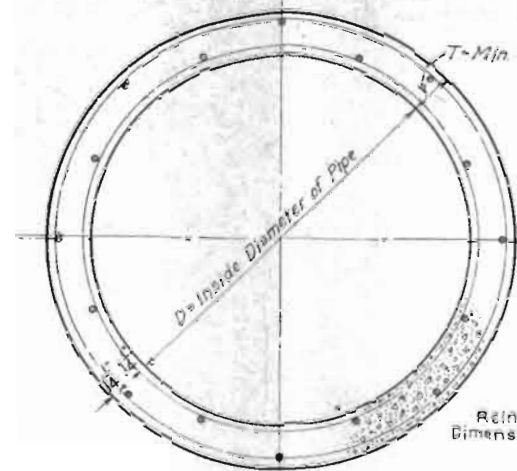

With One Line of Circular Reinforcement

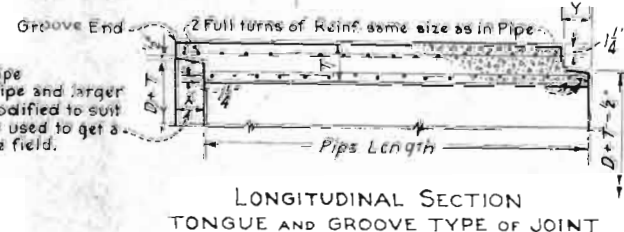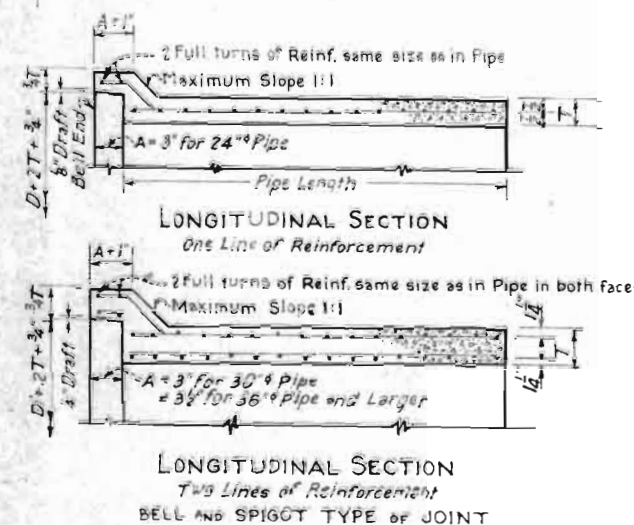

GENERAL NOTES

All work shall be done in accordance with the Standard Specifications of the Colorado State Highway Department adopted January 1st 1948.

Circular Reinforcement shall be Cold Drawn Steel Wire. If Billet Steel of Hard or Intermediate Grade is used the steel area shall be increased by 37.5 percent. Longitudinal Reinforcement shall be Billet Steel of Intermediate Grade.

The type of Pipe joint used and the field construction shall be submitted to the Department for approval.

Unless otherwise noted the Type of Bedding shall be Ordinary Bedding. When the maximum fill height as noted herein for this type of Bedding is exceeded then that type of bedding which is indicated by the allowable fill height shall be used.

All Culverts shall have concrete roadways if and as shown on the plans in accordance with the Department's Stand. Dwg. M-102.

Supporting soils shall be composed of firm and uniform material throughout the entire length of Culvert. The soil shall be accurately shaped to fit the Pipe in accordance with the bedding conditions shown here-on.

Special attention is directed to the Laying Requirements noted where rock or rock projections are encountered in the Pipe bed.

The Pipe shall be laid with the Bell or Groove end placed upstream.

All excavation and work required for bedding and shaping, except for the volume of selected material, shall be included in Contract Unit Price for Reinforced Conc. Pipe.

UNREINFORCED CONCRETE PIPE

Unreinforced Concrete Pipe will be accepted in the following sizes: 12", 15", 18", 24", 30", 36", 42", 48", 54", 60", 66", 72", 78", 84".

Unreinforced Concrete Pipe shall meet the same specifications and may be of the same minimum thickness as shown for Reinforced Concrete Pipe. It will be noted however, that Unreinforced Concrete Pipe is required to meet the same Three-edged Bearing Tests as specified for Reinforced Concrete Pipe. Thickness of pipe may be increased as required in order to satisfy the three-edged bearing tests.

The same General Notes, Specifications, bedding details, etc. shall apply to Unreinforced Concrete Pipe as is noted for Reinforced concrete pipe, excepting only those details and requirements which refer specifically to reinforcement.

Special bedding as specified not included in structural exc.

STANDARD M-112-D

Rev. 2-2-42. Add notes H.C.C.
Rev. 3-6-42. Sketch for calc. str. exc. in cut. G.R.P.
Rev. 4-20-42. W.G.S. Unreinforced Concrete Pipe notes.
Rev. 5-15-44. A.L.P. Replaced Mechanical Tamping with Selected Mat'l.

STANDARD STRENGTH REINFORCED CONCRETE CULVERT PIPE


Based on Concrete with an ultimate compressive strength of 3500 p.s.i. and the Three-edged Bearing Tests in Table I, A.A.S.H.O. Specification M-41-46.

(Fill height not limited for 12", 15" & 18" dia. pipes.)	12	2	1 Line	0.07	0.13 SQ IN
	15	2 1/2	1 Line	0.09	0.18 " "
	18	2 1/2	1 Line	0.12	0.24 " "
Type of Bedding Ordinary H = 11 feet First Class H = 13 feet	24	3	1 Line	0.17	0.38 " "
	30	3 1/2	1 Line each	0.22	0.55 " "
	36	4	2 Lines	0.18	0.75 " "
	42	4 1/2	2 " "	0.21	0.98 " "
	48	5	2 " "	0.25	1.25 " "
	54	5 1/2	2 " "	0.30	1.57 " "
	60	6	2 " "	0.33	1.92 " "
	66	6 1/2	2 " "	0.37	2.21 " "
	72	7	2 " "	0.40	2.67 " "
	78	7 1/2	2 " "	0.43	3.03 " "
	84	8	2 " "	0.46	3.64 " "

EXTRA STRENGTH REINFORCED CONCRETE CULVERT PIPE

Based on Concrete with an ultimate compressive strength of 4500 p.s.i. and the Three-edged Bearing Tests in Table II, A.A.S.H.O. Specification M-41-46.

Extra Strength Pipe	Inches	Inches	Sq. Ins. per Lin. Ft. of Pipe	Total Area Req'd.
Type of Bedding Ordinary H = 16 feet First Class H = 19 feet Ordin. + 4 } H = 24 ft. Special } First Class } H = 30 ft. Special }	24	3	1 Line 0.26	0.35 sq. in.
	30	3½	1 Line each 0.31	0.55 " "
	36	4	2 Lines " 0.28	0.75 " "
	42	4½	2 " " 0.33	0.98 " "
	48	5	2 " " 0.38	1.25 " "
	54	5½	2 " " 0.44	1.57 " "
	60	6	2 " " 0.50	1.92 " "
	66	6½	2 " " 0.56	2.21 " "
	72	7	2 " " 0.60	2.67 " "
	78	7½	2 " " 0.65	3.03 " "
84	8	2 " " 0.72	3.64 " "	

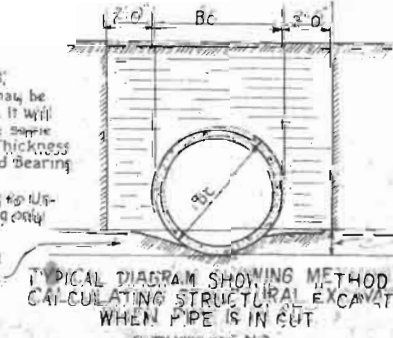

COLORADO
STATE HIGHWAY DEPARTMENT
UNREINFORCED CONCRETE PIPE
SIZES: 12", 15", 18", 24", 30", 36", 42", 48", 54", 60", 66", 72", 78", 84"
REINFORCED CONCRETE PIPE
STANDARD & EXTRA STRENGTH
SIZES: 12", 15", 18", 24", 30", 36", 42", 48", 54", 60", 66", 72", 78", 84"
Designed by: *W. A. S.*
Made by: *W. A. S.*
Checked by: *A. L. C.*
Approved by: *Bridge Engineer*
Date: June 1, 1944

NO. 12 CONCRETE INLET

STANDARD M-12-D-13

NO. 13 CONCRETE INLET



FED. ROAD DIV. NO.	DISTRICT	SHEET NO.	TOTAL SHEETS
9	COLO.	202-2(27)24	

BAR LIST FOR H = 3' 0"

MARK	SIZE	NO. REQD.	LENGTH	TYPE	DIMENSIONS	BENDING DIAGRAM
601	3/4"	Note	2' 6"	I	1'-0" 0'-10"	
401	1/2"	3	11'-10"	III	2'-6" 2'-6"	
402	1/2"	5	3'-6"	II	2'-5" 1'-7"	
403	1/2"	5	7'-1"	I	2'-7" 1'-8"	
404	1/2"	2	2'-7"	STR	—	

- * Omit 601 when H is 4'-0" or less.
- * These dimensions to be increased in increments of 6" for H above 3'-0".
- Add 1-401 for each 6" additional height above 3'-0".
- * 601 required as follows:
- H = 4'-6" to 5'-6" - 1 bar;
- H = 6'-0" to 7'-0" - 2 bars;
- H = 7'-6" to 8'-6" - 3 bars;
- Cut or bend bars around pipes as required.


See Plans for size and locations of outlets.

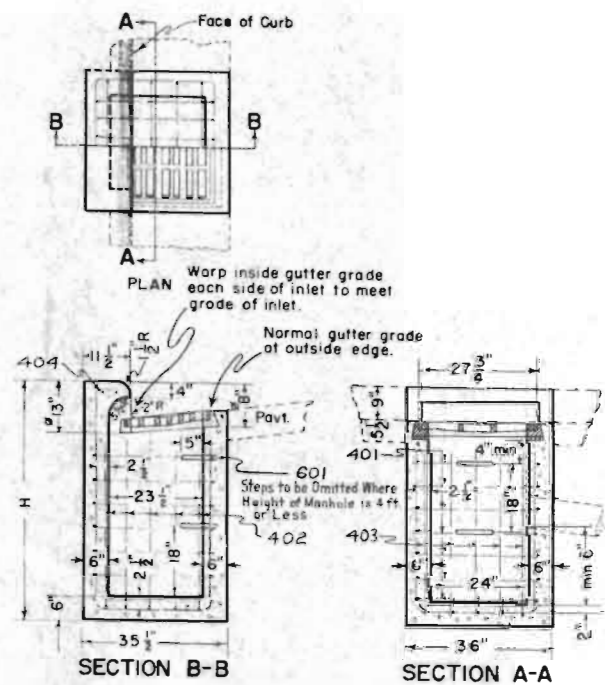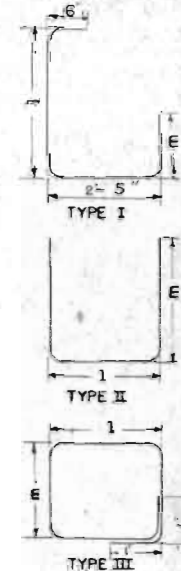


* These dimensions for 6" curb. Dimensions to be modified as required for other heights of curb.

NO. 12 INLET GRATING & FRAME


Approx. Weight 340 lbs.

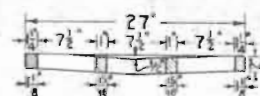

SECTION C-C

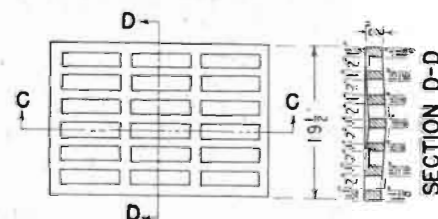

SECTION D-D

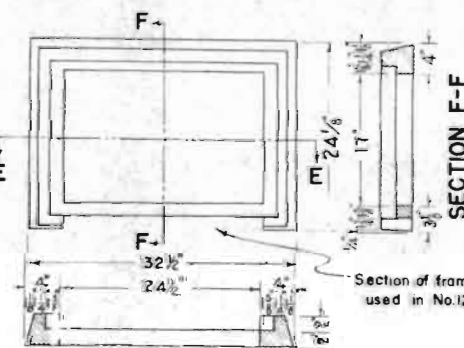

SECTION E-E

Section of frame to be cut out when used in No. 12 Concrete Inlet.

QUANTITIES

H	CLASS "A" CONCRETE *CU. YDS.	* REINFORCING STEEL
3' 0"	0.54	70 lbs.
3' 6"	0.63	85 "
4' 0"	0.72	100 "
4' 6"	0.81	119 "
5' 0"	0.90	137 "
5' 6"	0.99	152 "
6' 0"	1.08	166 "
6' 6"	1.17	185 "
7' 0"	1.27	200 "
7' 6"	1.36	215 "
8' 0"	1.45	233 "
8' 6"	1.54	248 "
9' 0"	1.63	263 "
9' 6"	1.73	282 "
10' 0"	1.82	297 "

* Volume for inlet - volume occupied by pipes to be deducted for pay quantity of concrete.

* Includes 1% allowance for overrun.

GENERAL NOTES


- All work shall be done in accordance with the Standard Specifications of the Colorado State Highway Department, adopted January 1st 1948.
- All reinforced concrete shall be class "A", AND AS REINFORCED AS SPECIFIED.
- All concrete walls shall be formed on both sides.
- All exposed concrete corners shall be beveled to a 1" face.
- All reinforcing bars shall be deformed, of intermediate grade, and shall be tagged with BAR designation and station number.
- All castings shall be painted with two coats of asphalt or coal tar and oil.
- All surfaces exposed to view on the box shall receive class 1 surface finish.
- ALL DIMENSIONS NOT SHOWN AS CLEAR ARE TO 1/2" OF BAR.
- ALL REINFORCING STEEL BARS SHALL CONFORM TO A.S.T.M. SPECIFICATION A-305-50T OR LATEST REVISION THEREOF.

BAR LIST FOR H = 3' 0"


MARK	SIZE	NO. REQD.	LENGTH	TYPE	DIMENSIONS	BENDING DIAGRAM
601	3/4"	Note	2' 6"	I	1'-0" 0'-10"	
401	1/2"	4	12'-10"	III	3'-5" 2'-1"	
402	1/2"	7	6'-1"	I	2'-0" 2'-1"	
403	1/2"	4	7'-5"	I	3'-4" 2'-1"	

- * Omit 601 when H is 4'-0" or less.
- * These dimensions to be increased in increments of 6" for H above 3'-0".
- Add 1-401 for each 6" additional height above 3'-0".
- * 601 required as follows:
- H = 4'-6" to 5'-6" - 1 bar;
- H = 6'-0" to 7'-6" - 2 bars;
- H = 7'-6" to 8'-6" - 3 bars;
- Cut or bend bars around pipes as required.

See Plans for size and locations of outlets.

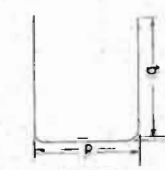

TYPE I

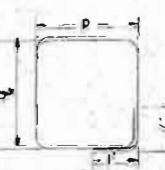

TYPE II

QUANTITIES


H	CLASS "A" CONCRETE *CU. YDS.	* REINFORCING STEEL
3' 0"	.86	84 lbs.
3' 6"	.96	100 "
4' 0"	1.06	116 "
4' 6"	1.16	136 "
5' 0"	1.26	156 "
5' 6"	1.36	172 "
6' 0"	1.46	192 "
6' 6"	1.57	208 "
7' 0"	1.67	225 "
7' 6"	1.77	245 "
8' 0"	1.87	261 "
8' 6"	1.97	277 "
9' 0"	2.07	297 "
9' 6"	2.17	313 "
10' 0"	2.28	329 "

* Volume for inlet - volume occupied by pipes to be deducted for pay quantity of concrete.


* Includes 1% allowance for overrun.

NO. 13 INLET GRATING & FRAME


Approx. Weight 680 lbs.

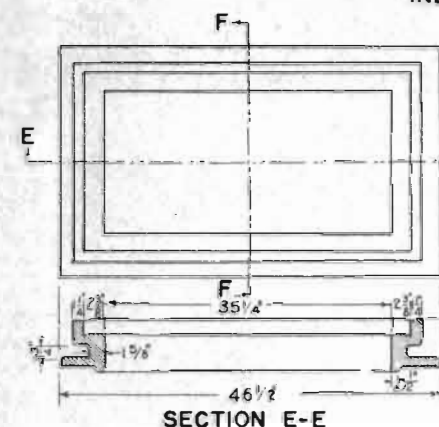

SECTION E-E

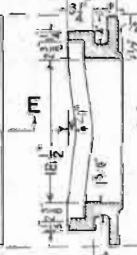

SECTION F-F

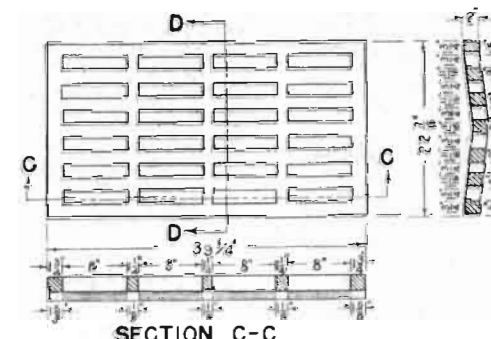

SECTION C-C

SECTION D-D

* VOLUME TO BE DEDUCTED FOR EACH OPENING


	C.M.P.	R.C.P.
18"	0.03	0.05
24"	0.06	0.09
30"	0.09	0.14
36"	0.13	—

COLORADO
STATE HIGHWAY DEPARTMENT
STANDARD
NO. 12 AND NO. 13
CONCRETE INLETS

Designed by A.R.G.
Made by A.R.G.
Check by A.Z.
Check Detail C.A.S.
Approved by J. Bailey
Bridge Engineer
Date



SUPERELEVATION AND WIDENING TABLES										
DISTANCE FROM B.T. (PROPORTION)	0.1	0.2	0.3	0.4	0.5	0.6	0.7	0.8	0.9	Max. 1.0
Degree of Curvature	RATE OF SUPERELEVATION (IN FEET) PER FOOT WIDTH OF ROADWAY									
2° and Under	0.00044	0.00175	0.00394	0.00700	0.01050	0.01400	0.01706	0.01925	0.02056	0.02100
3°	0.00066	0.00263	0.00591	0.01050	0.01575	0.02100	0.02559	0.02988	0.03384	0.03750
4°	0.00088	0.00350	0.00788	0.01400	0.02100	0.02800	0.03413	0.03850	0.04113	0.04200
5°	0.00109	0.00438	0.00984	0.01750	0.02625	0.03500	0.04266	0.04813	0.05141	0.05250
6°	0.00131	0.00525	0.01181	0.02100	0.03150	0.04200	0.05119	0.05775	0.06169	0.06300
7°	0.00153	0.00613	0.01378	0.02450	0.03675	0.04900	0.05972	0.06738	0.07197	0.07350
8°	0.00175	0.00700	0.01575	0.02800	0.04200	0.05600	0.06825	0.07700	0.08225	0.08400
9°	0.00197	0.00788	0.01772	0.03150	0.04725	0.06300	0.07678	0.08663	0.09253	0.09450
10° and Over	0.00208	0.00833	0.01875	0.03333	0.05000	0.06667	0.08125	0.09166	0.09792	0.10000
	OFFSETS FOR WIDENING - W' - (IN FEET)									
Over 10° - Under 12°	0.03	0.12	0.27	0.48	0.75	1.08	1.47	1.92	2.43	3.00
12° - " 15°	0.04	0.16	0.36	0.64	1.00	1.44	1.96	2.56	3.24	4.00
15° - " 20°	0.05	0.20	0.45	0.80	1.25	1.80	2.45	3.20	4.05	5.00
20° and Over	0.06	0.24	0.54	0.96	1.50	2.16	2.94	3.84	4.86	6.00

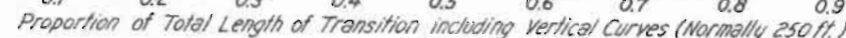

The transition in this case, from crowned section to superelevated section, shall proceed uniformly by raising the outside shoulder, over a distance of 250 ft. as shown, beginning at a point on the tangent 150 ft. from the end of the curve and acquiring full super-elevation at a point 100 ft. inside the curve.



Superelevation transitions at the outside ends of compound curves shall be constructed in accordance with rules given under CASE 1.

Superelevation transition between the arcs of different radii shall be made as in CASE 1, except that the entire transition shall lie within the limits of the curve of the longer radius.

In cases where curves in the same direction have a tangent distance of less than 300 ft. between points of curve, the intervening tangent shall be superelevated an amount equal to that of the curve of greater radius and the transition shall be made as in the case of a true compound curve.



Transitions between true reverse curves shall be accomplished as shown on the above diagram.


Transition tangents shall be directly proportional to the amount of superelevation of the respective curves.

EXAMPLE: Let a represent the amount of superelevation on 1st curve;

" b	"	"	"	"	"	" 2 nd	" ;
" x	"	"	"	"	"	transition tangent on 1 st	" ;
" y	"	"	"	"	"	" 2 nd	" ;

then, $a:b = x:y$.

The transition tangent of the curve having the shorter radius shall be set at 100 Ft. A normal crowned section 20 ft. long, 10 ft on each side of the P.R.C. shall be used. In cases where curves in opposite directions are in such proximity that a standard transition can not be had, the practice outlined for true reversing curves shall be used. The total distance between the P.T. of the first curve and the P.C. of the succeeding curve shall be prorated into the transition distance of the respective curves until a maximum of 150 ft. of transition tangent for each curve is achieved.

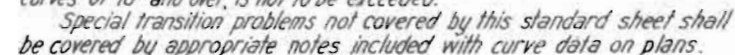

tion) Curves of over 10" are to have the inside portion of the pavement slab and shoulder, or the inside portion and shoulder in a graded or surfaced section, widened in accordance with the plan, offsets for widening, and cross sections.

STANDARD ROADWAY CONSTRUCTION TRAFFIC SIGNS


STANDARD M-2-DS

DISTRICT	SHEET NO.	TOTAL SHEETS
COLO.	002-212-27	


REV. 8/16/49 - E.E.D.
REV. 2/3/50 - E.A.R.

Typical Methods Of Marking Highways & Detours

Detour Condition Where Traffic Is Prohibited Along Construction

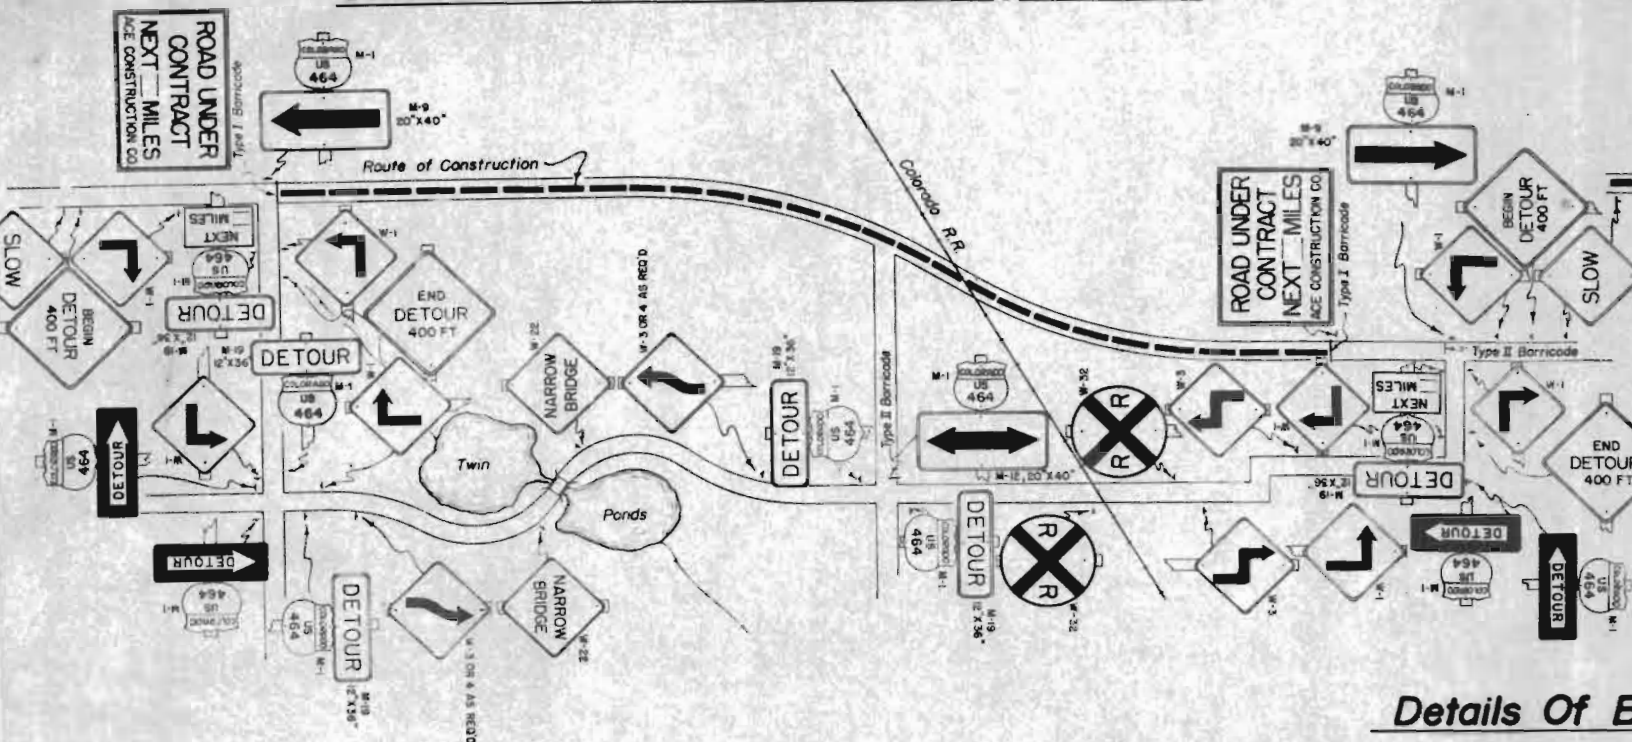


Condition Where Traffic Is Permitted Along Construction

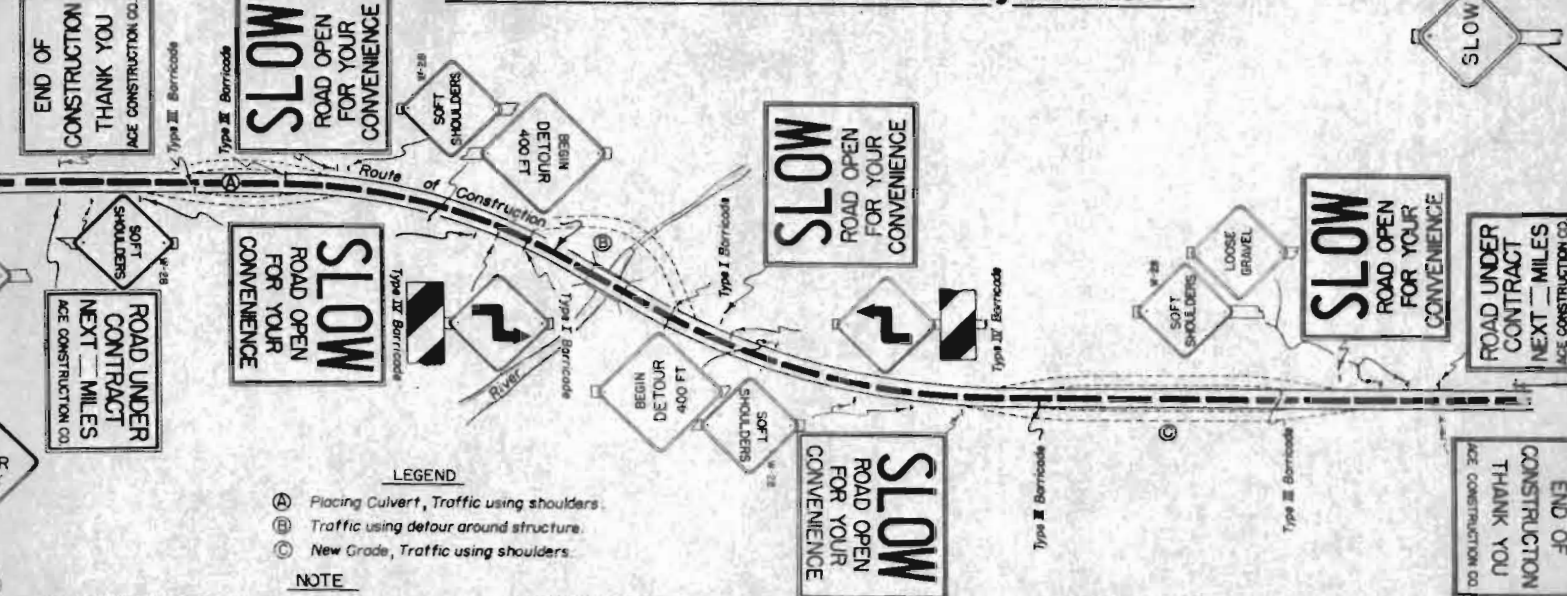


- LEGEND**
- (A) Placing Culvert, Traffic using shoulders.
 - (B) Traffic using detour around structure.
 - (C) New Grade, Traffic using shoulders.
- NOTE**
- Typical examples for marking Projects as shown above constitute a minimum of signs required. Additional markings & any special signs required for the guidance and protection of traffic will be done under the direction of the Engineer. Contractor's & Engineer's equipment must be parked so that signs & barricades are visible to traffic at all times.


Details Of Barricades

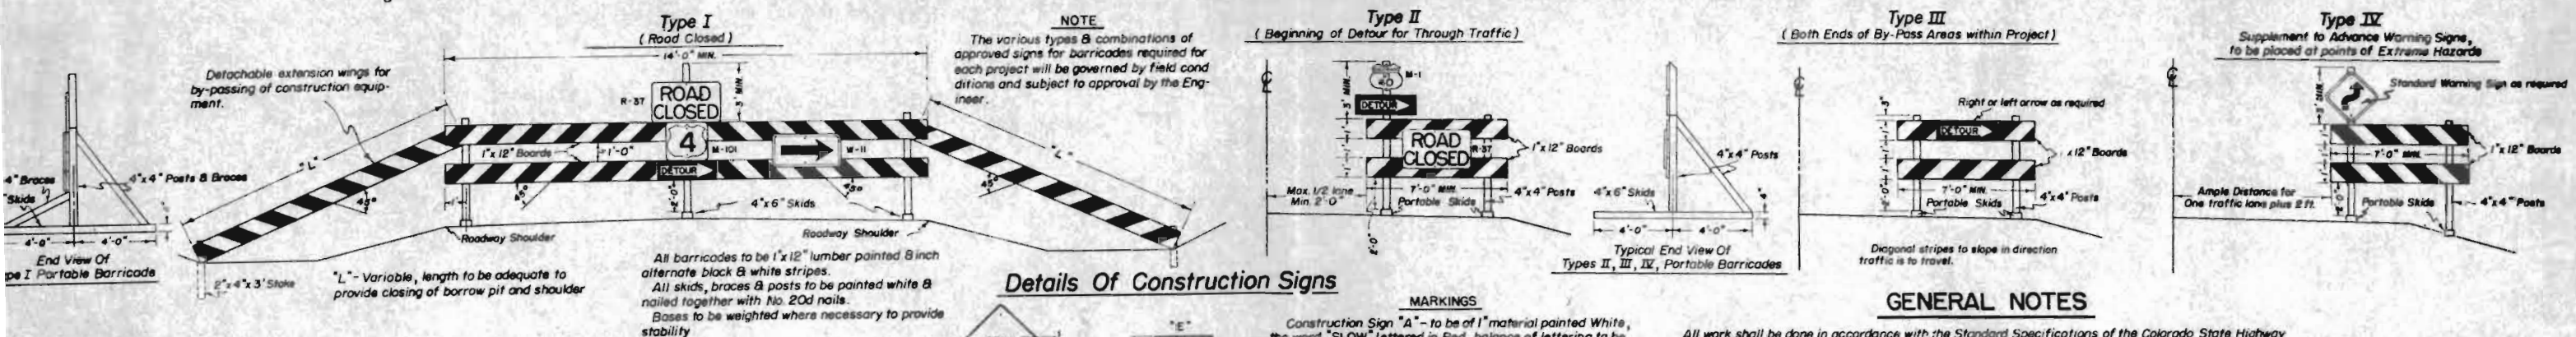


Position Of Signs Relative To Roadbed & Hazards

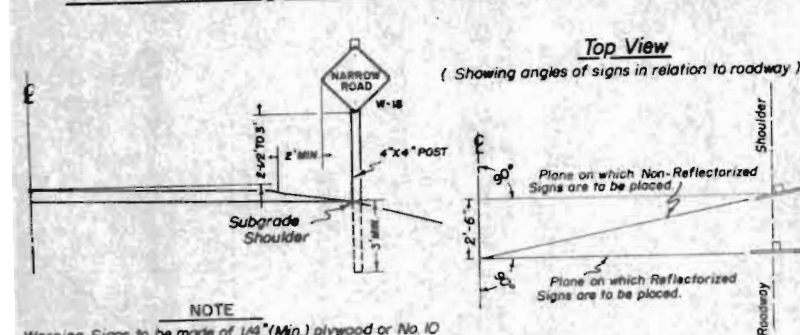

Details Of Construction Signs

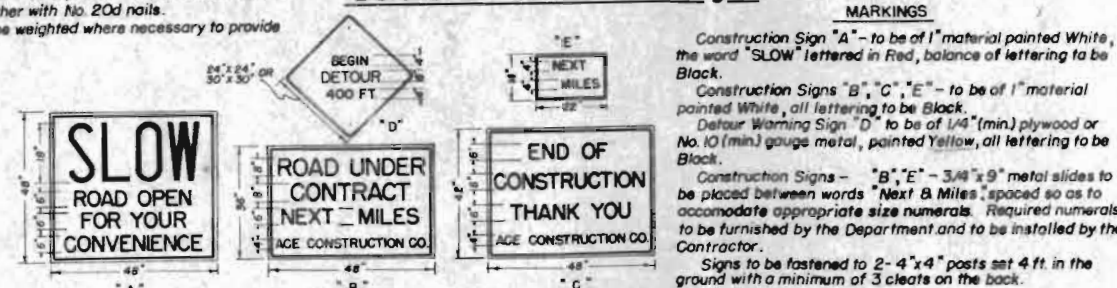

Details Of ReflectORIZED Arrows

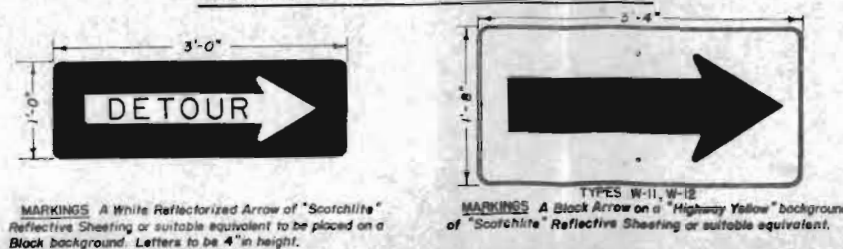

COLORADO
STATE HIGHWAY DEPARTMENT


Standard Roadway
Construction Traffic Signs

Designed by
Made by CGM
Checked by

Approved
Engineer
Date: 7-25-1949

Scale 1 inch = 100 feet

FED. ROAD DIV. NO.	STATE	PROJ. NO.	SHEET NO.	TOTAL SHEET
9	COLO.	UI 002-2(23) UNIT NO. 1	28	

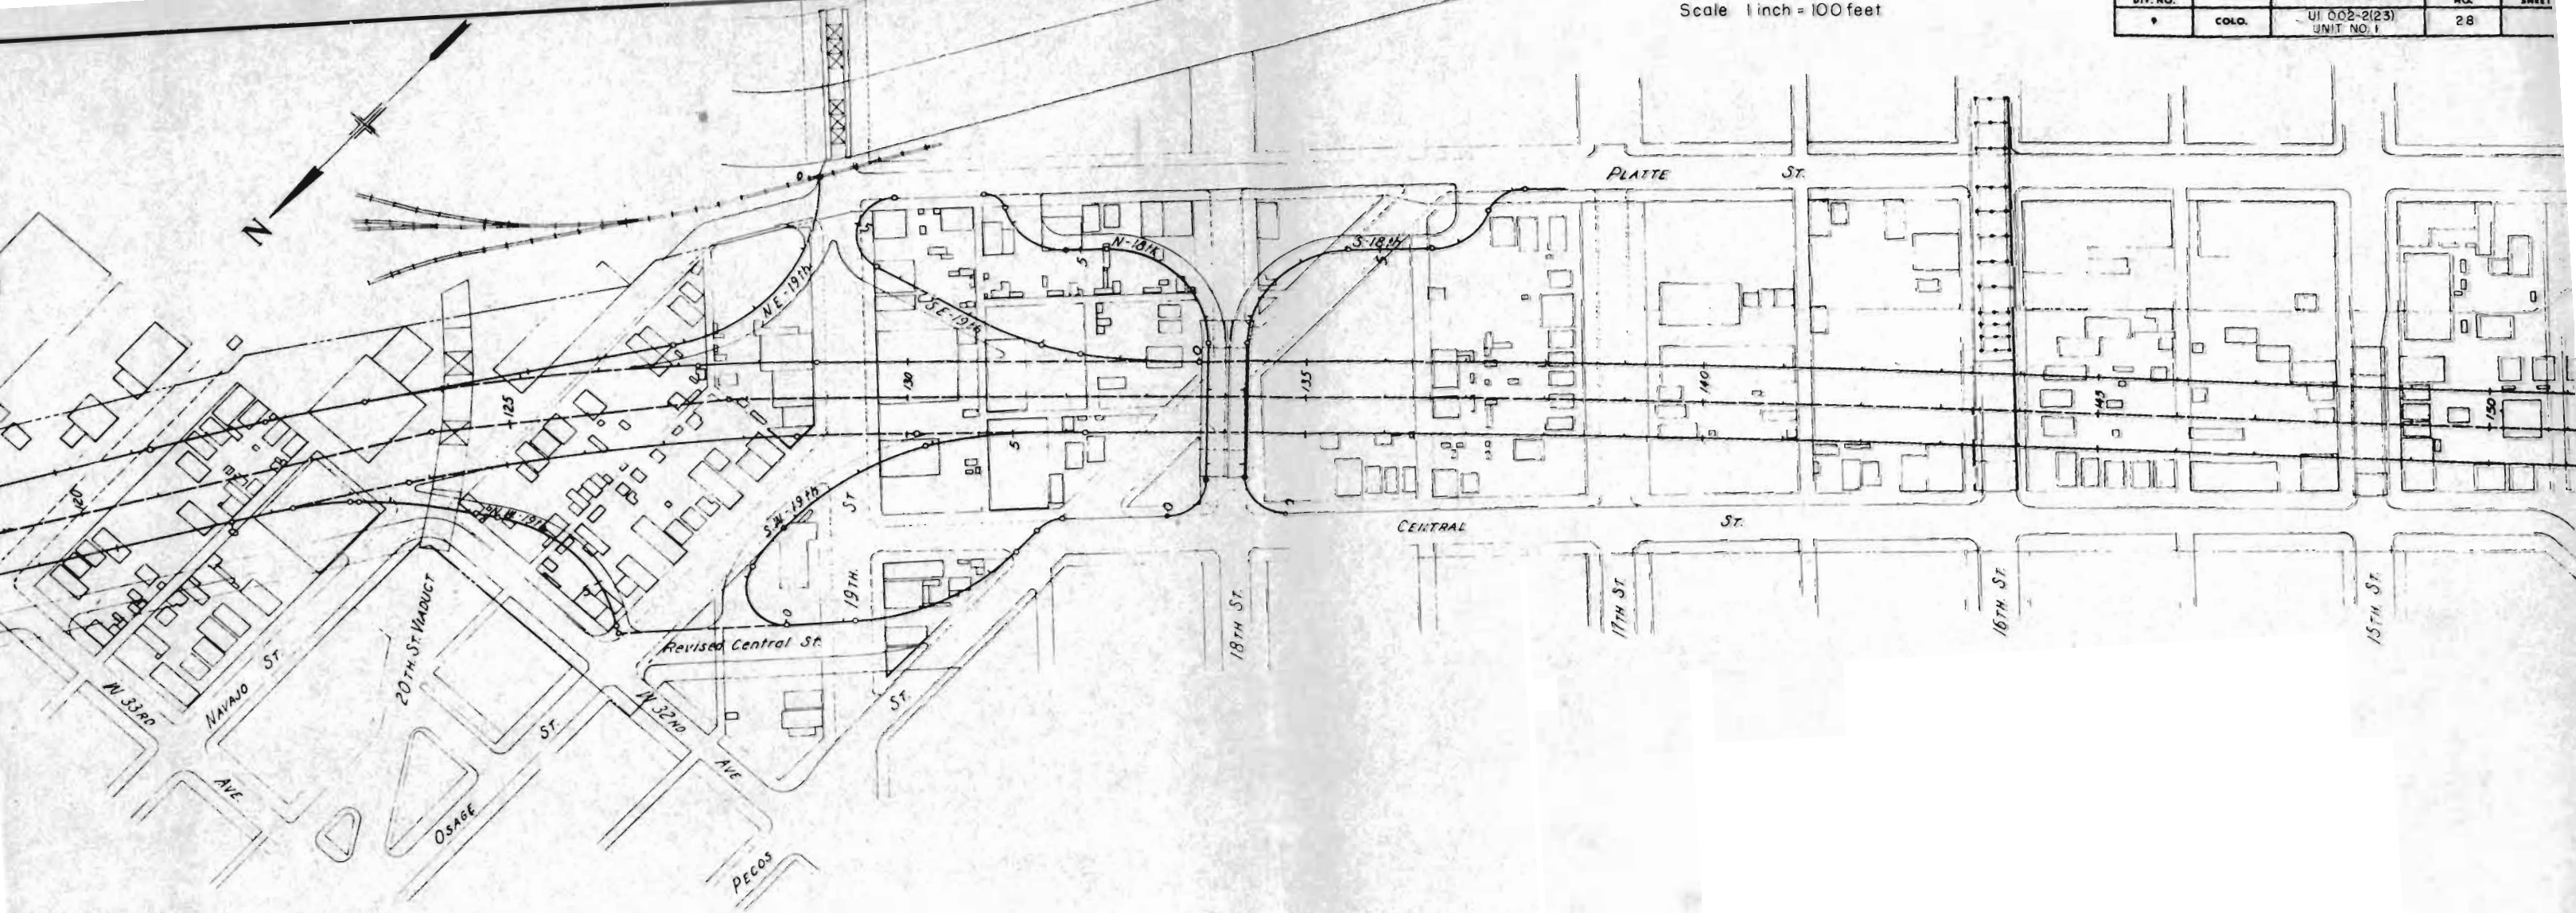

COLORADO STATE HIGHWAY DEPT.
THE VALLEY HIGHWAY DENVER, COLORADO

PROPERTY MAP

CROCKER AND RYAN
CONSULTING ENGINEERS
DENVER, COLORADO

DATE

SHEET 10 of 14

BWG. NO.

