


FEDERAL ROAD REGION NO.	DIVISION	PROJ. NO.	SHEET NO.	TOTAL SHEETS
VIII	COLORADO	U 034-1(12)	2	110

AS CONSTRUCTED
NO REVISIONS DATE *JUNE*

TYPICAL CROSS SECTIONS

SECTION A

STA 355+50 TO STA. 357+00
(APPR. TO PROJ.)

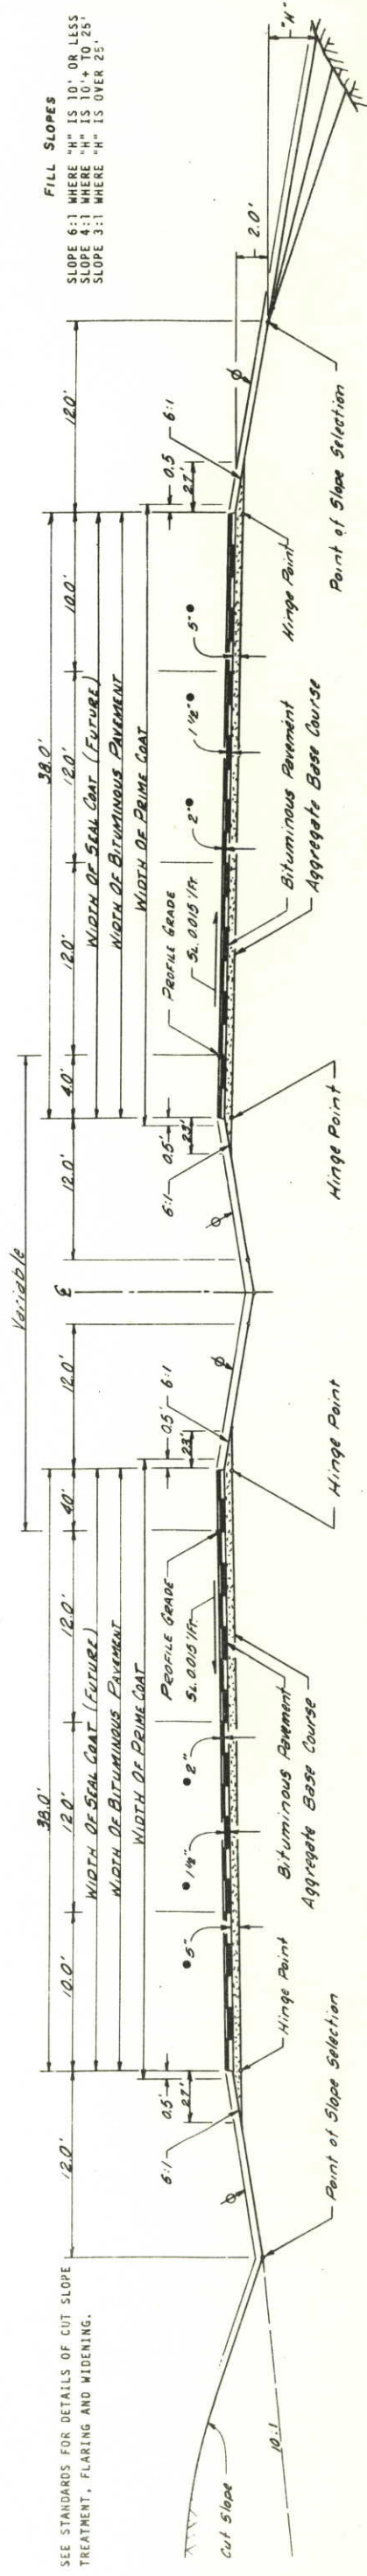

● APPROXIMATE THICKNESS (THICKNESS OF DIFFERENT LAYERS MAY BE ADJUSTED AT THE DISCRETION OF THE ENGINEER)


THE CONTRACTOR WILL BE REQUIRED TO PLACE TOPSOIL TO THIS LINE AFTER COMPLETION OF PAVING OPERATION.

THE DEPTH AND WIDTH OF THE SIDE DITCH SHALL
BE VARIED WHERE NECESSARY IN ORDER TO
PROVIDE PROPER DRAINAGE.

BREAK POINTS ON SLOPES AND IN BOTTOMS OF DITCHES SHALL BE ROUNDED ON CONSTRUCTION FOR A PLEASING APPEARANCE.

SECTION B

STA. 330+00 To STA. 355+50

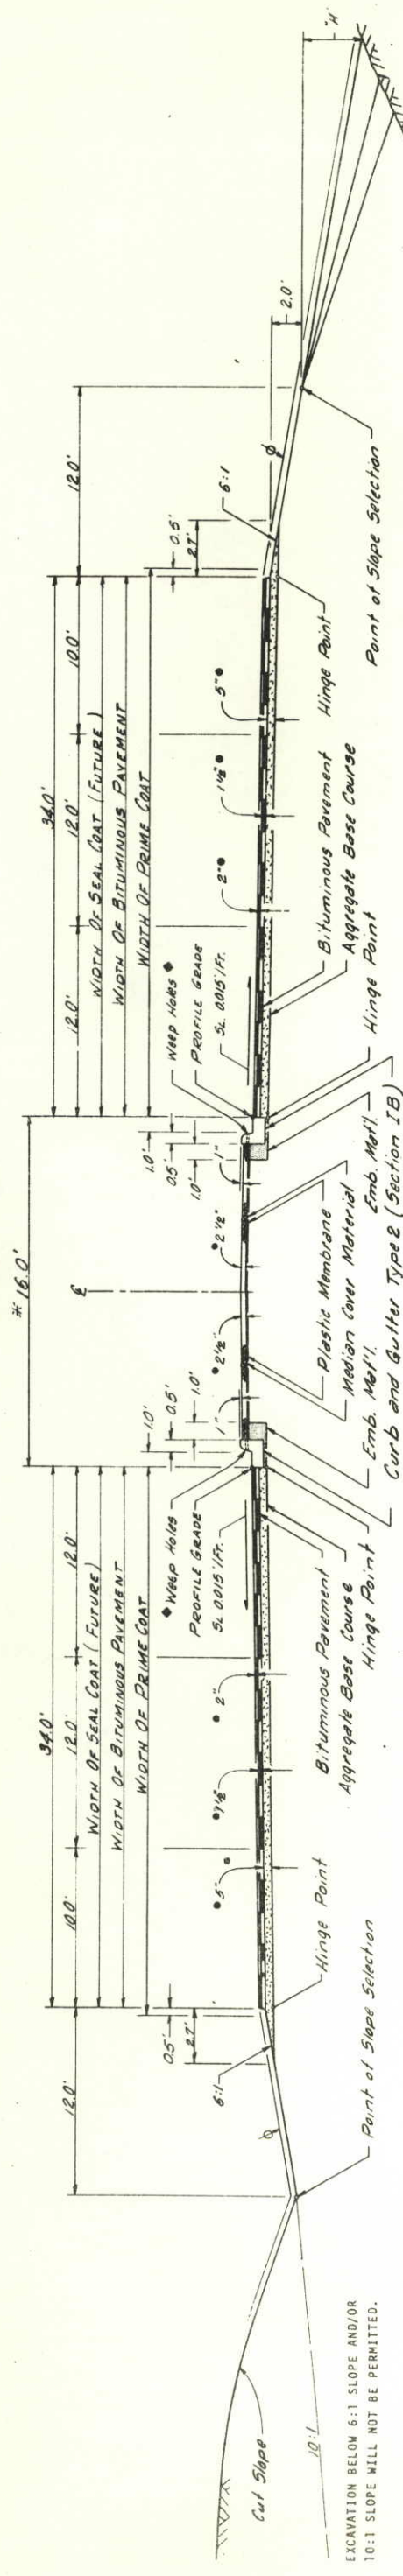

* Variable from sta. 351+25 to 355+50.

- Spacing at 20' intervals.

MATERIAL SHALL BE PLACED IN SEPARATE COURSES AT THE FOLLOWING RATES PER 100 LIN. FT. OF ROADWAY:

BITUMINOUS PAVEMENT	TOP LAYER	83 TON
	BOTTOM LAYER	63 TON
AGGREGATE BASE COURSE		197 TON

AS CONSTRUCTED
NO REVISIONS DATE
JUNE 3, 1974

FEDERAL ROAD DISTRICT NO.	DIVISION	PROJ. NO.	SHEET NO.	TOTAL SHEETS
VIII	COLORADO	U034-11(2)	3	110

TYPICAL SECTIONS

GENERAL NOTES


FOR PRELIMINARY PLAN QUANTITIES OF BITUMINOUS MATERIALS THE FOLLOWING RATES OF APPLICATION WERE USED:
PRIME COAT MC @ 0.40 GALS. PER SQ. YD.
TACK COAT SS-1H @ 0.10 GAL. OF MIXTURE PER SQ. YD.

FILL SLOPES:

SLOPE 6:1 WHERE "H" IS 10' OR LESS
SLOPE 4:1 WHERE "H" IS 10' TO 25'
SLOPE 3:1 WHERE "H" IS OVER 25'

23RD. AVE. TRANSITIONS FROM WIDTH OF EXISTING STREET AT STA. 8+75 TO 84' WIDE AT STA. 9+35. 100' TRANSITION FROM 84' WIDTH TO 72' WIDTH, STA. 12+55 TO STA. 13+55.

STA 9+35 TO STA. 12+55

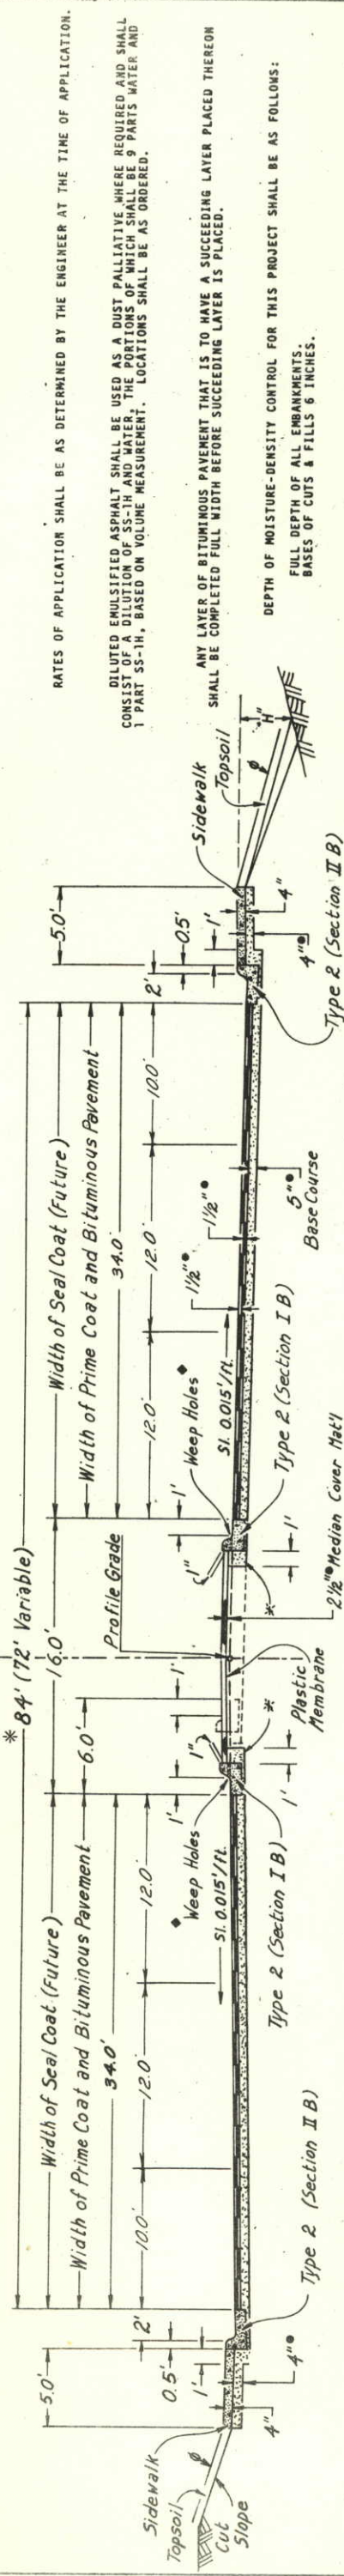


* Approximate Thickness (Thickness of different layers may be adjusted at the discretion of the Eng.)

* Embankment material

* Spacing at 20' intervals

FRONTAGE ROAD

STA. 5+28 TO STA. 10+00

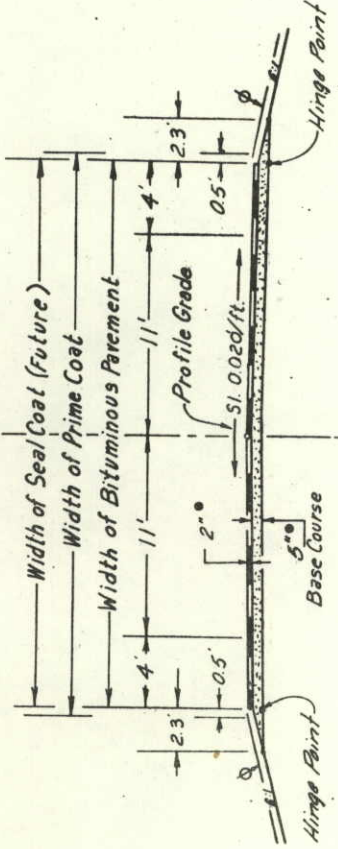


SEE STANDARDS FOR DETAILS OF CUT SLOPE TREATMENT, FLARING AND WIDENING.

BREAK POINTS ON SLOPES AND IN BOTTOMS OF DITCHES SHALL BE ROUNDED ON CONSTRUCTION FOR A PLEASING APPEARANCE.

SOUTH RAMPS (DETOUR)

STA. 10+20 TO 17+22 AND STA. 19+24 TO 26+25

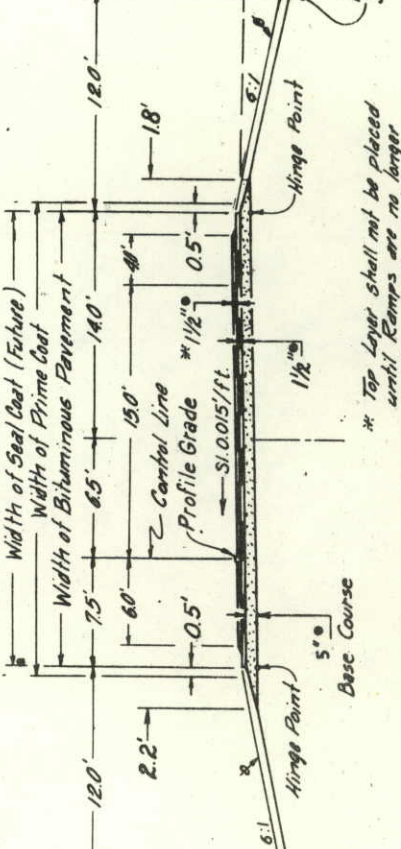

THE DEPTH AND WIDTH OF THE SIDE DITCH SHALL BE VARIED WHERE NECESSARY IN ORDER TO PROVIDE PROPER DRAINAGE.

EXCAVATION BELOW 6:1 SLOPE AND/OR 10:1 SLOPE WILL NOT BE PERMITTED.

* Top Layer shall not be placed until Ramps are no longer being used for Detour.

MATERIAL SHALL BE PLACED IN SEPARATE COURSES AT THE FOLLOWING RATES PER 100 LIN. FT. OF ROADWAY:

BITUMINOUS PAVEMENT	TOP LAYER	63 TONS
BITUMINOUS PAVEMENT	BOTTOM LAYER	63 TONS
BASE COURSE		189 TONS

A SKI TYPE DEVICE AT LEAST 30 FEET IN LENGTH AND SHORT SKI OR SHOE SHALL BE FURNISHED WITH EACH BITUMINOUS PAVEMENT EQUIPPED WITH AN AUTOMATIC CONTROL SYSTEM.

EXCAVATION REQUIRED FOR COMPACTION OF BASES OF CUTS AND FILLS WILL BE CONSIDERED AS SUBSIDIARY TO THAT OPERATION AND WILL NOT BE PAID FOR SEPARATELY.

THE MINIMUM THICKNESS OF TOPSOIL SHALL BE 4 INCHES.

EARTH SLOPES SHALL BE DISCED OR ROUGHENED BY OTHER APPROVED METHODS FOR MULCHING OR EROSION PROTECTION.

THE CONTRACTOR WILL BE REQUIRED TO PLACE TOPSOIL TO THIS LINE AFTER COMPLETION OF PAVING OPERATION.

MATERIAL SHALL BE PLACED IN SEPARATE COURSES AT THE FOLLOWING RATES PER 100 LIN. FT. OF ROADWAY:


BITUMINOUS PAVEMENT	37 TONS
BASE COURSE	90 TONS

IT IS ESTIMATED THAT 5,000 HOURS OF FLAGGING FOR CONTROLLING TRAFFIC WILL BE REQUIRED FOR THIS PROJECT.

TONAGES SHOWN IN RATES PER STATION ARE APPROXIMATE ONLY AND SHALL BE ADJUSTED WHERE NECESSARY TO INSURE OVERALL DESIGN THICKNESS.

NORTH RAMPS

STA. 5+40 TO 9+42 AND STA. 12+39 TO 17+22

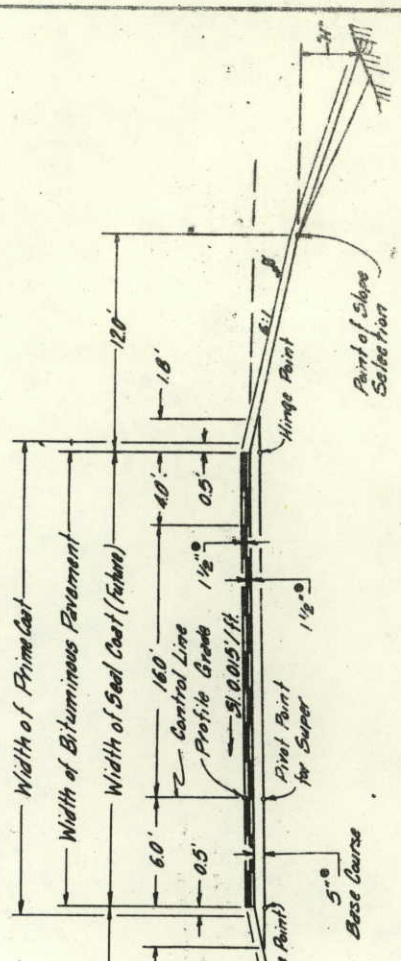

MATERIAL SHALL BE PLACED IN SEPARATE COURSES AT THE FOLLOWING RATES PER 100 LIN. FT. OF ROADWAY:

BITUMINOUS PAVEMENT	TOP LAYER	23 TONS
BITUMINOUS PAVEMENT	BOTTOM LAYER	26 TONS
BASE COURSE		84 TONS

NO RAMPS

23 TONS
26 TONS
84 TONS
7.8 TONS

FINAL
SUMMARY OF APPROXIMATE QUANTITIES

AS CONSTRUCTED
REVISED DATE
JUNE 3, 1974

FEDERAL ROAD DISTRICT NO.	DIVISION	PROJ. NO.	SHEET NO.	TOTAL SHEETS
177C	COLORADO	U 034-(1/2)	4	110

INDEX	CONTRACT ITEM NO.	CONTRACT ITEM	UNIT	PLAN ROADWAY	FINAL ROADWAY		PLAN MAJOR STR. NO. C-18-ER	FINAL MAJOR STR. NO. C-18-ER	PLAN PROJECT TOTALS	FINAL PROJECT TOTALS
	10 202	Removal of Structure	Each	6	5				6	5
	10 202	Removal of Slope & Ditch Paving	Sq. Yd.	600	1,282.5				600	1,282.5
	9 202	Removal of Curb	Lin. Ft.	650	665				650	665
	9 202	Removal of Curb & Gutter	Lin. Ft.	1500	1,515				1500	1,515
	78 202	Removal of Ground Sign	Each	13	13				13	13
	9 202	Removal of Fence	Lin. Ft.	2,400	2,017				2,400	2,017
	1 36 202	Plug Structure	Each	1	1				1	1
	10 202	Plug Culvert	Each	2	1				2	1
	8 203	Unclassified Excavation (Haul)	Cu. Yd.	111,000	91,618				111,000	91,618
	8 203	Borrow (Haul) c.a. 08252	Cu. Yd.	119,000	76,822				119,000	76,822
					76,822					76,822
	8 203	Compaction (AASHTO T 180)	Cu. Yd.	172,000	169,391				172,000	169,391
	10 11 206	Structure Excavation c.a. 04785	Cu. Yd.	4,160	2,825		140	140	4,300	2,965
	10 11 206	Structure Backfill (Class 2) c.a. 04785	Cu. Yd.	4,855	4,794		135	135	4,990	4,929
	10 206	Filter Material (Class C) c.a. 08252	Cu. Yd.	190	0				190	0
	108 109 207	Topsoil (Haul)	Cu. Yd.	3,300	4,023				3,300	4,023
	209	Wetting	M Gal.	5,250	2,282				5,250	2,282
	210	Reset Ground Sign	Each	4	4				4	4
	210	Relay Pipe (12 Inch) c.a. 08252	Lin. Ft.	8	0				8	0
	217	Soil Sterilization	Sq. Yd.	4,430	4,370				4,430	4,370
	304	Aggregate Base Course (Class 6) (Haul)	Ton	11,000	8,300.25				11,000	8,300.25
	403	Hot Bituminous Pavement (Grading Bk) (Haul & Asphalt) c.a. 08260	Ton							
	403	Hot Bituminous Pavement (Grading E) (Haul & Asphalt)	Ton	7,600	8,153.90		107	107	7,600	8,153.90
	411	Emulsified Asphalt (SS-1H)	Gal.	400	590				400	590
	411	Liquid Asphaltic Material (MC-70)	Gal.	14,700	5,603				14,700	5,603
	502	Drilling Hole to Facilitate Pile Driving	Lin. Ft.	275	0		294	294	369	569
	502	Steel Piling (HP 10x42) c.a. 04788	Lin. Ft.	3,255	4,512.63				3,255	4,512.63
	502	Steel Piling (HP 10x42) Cut-off	Lin. Ft.	0	100.00				0	100.00
	502	Steel Piling (HP 12x74) c.a. 04788	Lin. Ft.				1,449	1,428.83	1,449	1,428.83
	502	Steel Piling (HP 12x74) Cut-off	Lin. Ft.				0	14.42	0	14.42
	507	Concrete Slope & Ditch Paving (Reinforced)	Cu. Yd.	12	9.10		95	95.00	107	104.10
	507	Bituminous Slope & Ditch Paving	Ton	18	6.00				18	6.00

SUMMARY OF APPROXIMATE QUANTITIES

AS CONSTRUCTED
REVISED DATE
JUNE 3, 1974

FEDERAL ROAD DISTRICT NO.	DIVISION	PROJ. NO.	SHEET NO.	TOTAL SHEETS
1111	COLORADO	U034-1112	5	112

INDEX	CONTRACT ITEM NO.	CONTRACT ITEM	UNIT	PLAN ROADWAY	FINAL ROADWAY	PLAN MAJOR STR. NO. C-18-ER	FINAL MAJOR STR. NO. C-18-ER	PLAN PROJECT TOTALS	FINAL PROJECT TOTALS
Form 266	509	Structural Steel (Galvanized)	Lb.	32,410	32,410	14,068	14,068	46,478	46,478
Form 266	515	Waterproofing (Membrane)	Sq. Yd.			1,364	1,364	1,364	1,364
Form 266	518	Waterslop (6 Inch)	Lin. Ft.	212	212			212	212
Form 266	601	Concrete Class A (Miscellaneous)	Cu. Yd.	1,275	1,281.23			1,275	1,281.23
Form 266	601	Concrete Class A (Bridge)	Cu. Yd.			121	121.00	121	121.00
Form 266	601	Concrete Class S (Bridge)	Cu. Yd.						
Form 266	602	Reinforcing Steel	Lb.	163,546	163,546	1,086	1,086.00	1,086	1,086.00
	603	18 Inch Reinforced Concrete Pipe	Lin. Ft.	632	578.5			632	578.5
	603	24 Inch Reinforced Concrete Pipe c.a. 04785	Lin. Ft.	478	302			478	302
	603	36 Inch Reinforced Concrete Pipe	Lin. Ft.	1,294	1,294			1,294	1,294
	603	24 Inch Reinforced Concrete End Section	Each	1	1			1	1
	603	36 Inch Reinforced Concrete End Section c.a. 08252	Each	1	0			1	0
	603	6 Inch Corrugated Steel Pipe	Lin. Ft.	134	134			134	134
	603	12 Inch Corrugated Steel Pipe	Lin. Ft.	40	40			40	40
	604	Inlet Type C (5 foot)	Each	9	8			9	8
	604	Inlet Type R L5 (5 foot)	Each	1	1			1	1
	604	Inlet Type R L5 (10 foot)	Each	1	1			1	1
	604	Manhole Box Base (10 foot)	Each	3	2			3	2
	605	8 Inch Perforated Corrugated Steel Pipe	Lin. Ft.	368	4.5			368	4.5
	606	Guard Rail Type S	Lin. Ft.	834	834			834	834
	606	End Anchorage Type 5A	Each	4	4			4	4
	607	End Post	Each	2	2			2	2
	607	Corner and Line Brace Post	Each	9	8			9	8
	607	Fence Barbed Wire with Metal Posts	Lin. Ft.	1,700	1,759.5			1,700	1,759.5
	607	End Post (Chain Link)	Each	5	4			5	4
	607	Corner & Line Brace Post (Chain Link)	Each	10	10			10	10
	607	Fence Chain Link (42 Inch)	Lin. Ft.	2,460	2,451			2,460	2,451
	608	Concrete Sidewalk	Sq. Yd.	553	516			553	516

FINAL
SUMMARY OF APPROXIMATE QUANTITIES

AS CONSTRUCTED
REVISED DATE
JUNE 3, 1974

(R) 12-13-72 - C.K.M.
Non Federal Aid

FEDERAL AID SECTION NO.	DIVISION	PROJ. NO.	SHEET NO.	TOTAL SHEETS
TYPE	COLORADO	U034-(112)	6	110

INDEX	CONTRACT ITEM NO.	CONTRACT ITEM	UNIT	PLAN ROADWAY	FINAL ROADWAY	PLAN MAJOR STR. NO. C-18-ER	FINAL MAJOR STR. NO. C-18-ER	PLAN PROJECT TOTALS	FINAL PROJECT TOTALS	
			Lin. Ft.	0	190			0	190	
	609	Gutter Type 2 (4 Foot) C.O. 06253	Lin. Ft.	6,415	6,483			6,415	6,483	
	609	Curb & Gutter Type 2 (Section I-B)	Lin. Ft.	96	106			96	106	
			Lin. Ft.							
	609	Curb & Gutter Type 2 (Section I-M)	Lin. Ft.	1,309	2,122			1,309	2,122	
			Lin. Ft.	965	3,467			965	3,467	
	610	Median Cover Material	Ton	590	580.45			590	580.45	
	612	Delineator (Type I)	Each	14	15			14	15	
	612	Delineator (Type II)	Each	36	35			36	35	
	612	Delineator (Type II)	Each	4	4			4	4	
	612	Delineator (Type II)	Each	8	8			8	8	
			Lin. Ft.							
	613	3/4 Inch Electrical Conduit	Lin. Ft.			90	80	90	80	
	613	1 1/2 Inch Electrical Conduit	Lin. Ft.			198	147	198	147	
	614	Flagging	Hour	3,000	3,248.5	2,000	1,270	3,000	4,518.5	
	614	Sign Panel (Class I)	Sq. Ft.	139	139			139	139	
	614	Sign Panel (Class II)	Sq. Ft.	377	377			377	377	
	614	Sign Panel (Class III)	Sq. Ft.	329	329			329	329	
	614	Timber Sign Post 9x4 Inch	Lin. Ft.	294	294			294	294	
			Lin. Ft.							
	614	Timber Sign Post 6x6 Inch	Lin. Ft.	485	485			485	485	
	614	Steel Sign Post (W6x20)	Lin. Ft.	136	136			136	136	
	614	Concrete Footing (Type I-C)	Each	10	10			10	10	
	614	Modification of Timber Sign Post	Each	4	4			4	4	
	615	Embankment Protector Type 3	Each	1	1			1	1	
			Lb.			93,502	93,502	93,502	93,502	
	618	Prestressing Steel Wire or Strand	Each	1	1			1	1	
	620	Field Laboratory	Each	1	1			1	1	
	620	Sanitary Facility	Each	1	1			1	1	
	626	Mobilization	L.S.	Prorated		Prorated				
			L.S.							
		FORCE ACCOUNT								
		Removal of Temporary Asphalt Pavement W.O. 04878	L.S.							
		Dampproofing & Sandblasting Str. Deot W.O. 07176	L.S.							
		On the Job Training W.O. 04778	Each	1	1			1	1	
		Furnishing & Applying Menure on Slopes W.O. 04877	Ton	0	239.10			0	239.10	
		Interchange Lighting (Work by Home Light and Power Co.)	L.S.							
		STATE FORCES								
		♦ Striping Entire Project	L.S.							
		♦ Seeding	L.S.							
		♦ Non Federal Aid								

(R)

(R)

(R)

(R)


AS CONSTRUCTED
REVISED DATE
JUNE 3, 1974

FEDERAL ROAD DISTRICT NO.	DIVISION	PROJ. NO.	SHEET NO.	TOTAL SHEETS
VIII	COLORADO	U 034-1 (12)	7	110

BASE COURSE AND SURFACE COURSE PLAN

STATION TO STATION	SOURCE	QUANTITY - TONS					
		BASE COURSE		SURFACE COURSE - HOT BITUMINOUS PAVEMENT		TOP LAYER	
		AGGREGATE BASE COURSE		BOTTOM LAYER		GRADING E	
		PLAN	FINAL	PLAN	FINAL	PLAN	FINAL
MAINLINE:			4,883.75		2,535.30		2,329.35
328+50 TO 330+00		49		48		105	
330+00 TO 342+32.5		2504		784		1029	
343+850 TO 355+50		2330		728		959	
355+50 TO 357+00		56		53		117	
SE ACCEL. LANE		245		77		172	
NE DECEL. LANE		140		47		62	
SW DECEL. LANE		240		79		106	
NW ACCEL. LANE		304		90		222	
RAMPS:	Source						
SE - 10+20 TO 17+22		654	681.45	204	362.70	182	196.00
SW - 19+24 TO 26+25		645	900.90	200	240.20	179	195.60
NE - 5+40 TO 9+42	UNDERSIATED	403	366.60	121	181.80	121	133.75
NW - 12+33 TO 17+22		436	404.70	135	184.05	135	176.30
23RD AVENUE			1,451.70		513.90		352.45
8+75 TO 9+35		138		46		46	
9+35 TO 12+55		605		202		202	
12+55 TO 13+55		201		66		66	
Miscellaneous (Mod. Cruss.)		239		20	14.50	20	
FRONTAGE ROAD							
5+28 TO 10+00		455	531.15	184	195.15	—	
From List of Structures		340		200		—	
Est. for Correcting Ineq. in Subgrade		997		—	542.85	500	
PROJECT TOTALS		10,981	9,300.25	3284	4,770.45	4223	3,383.45

Documentation Source - Form 87

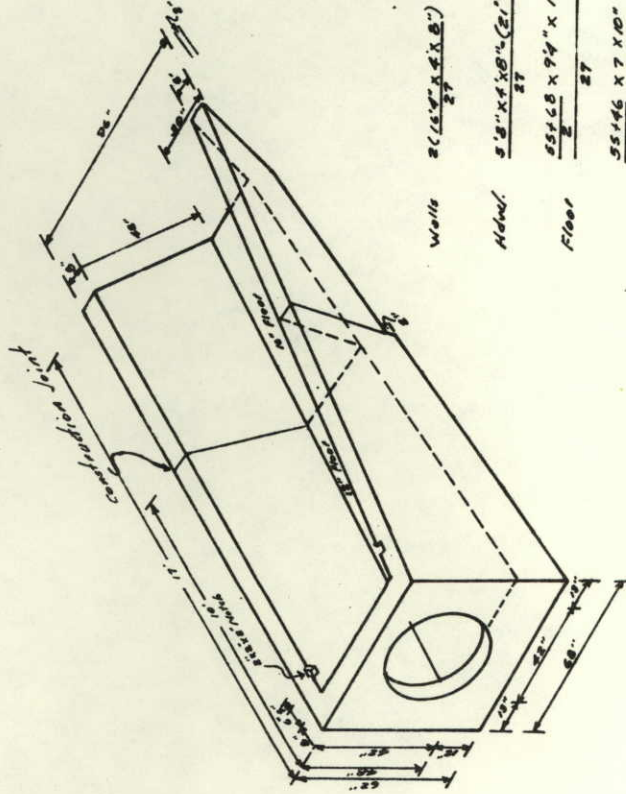

SPECIAL INLET STA. 359+00

Walls $2(14'4'' \times 4'4'') = 3.23$

Head $5'8'' \times 4'8'' (2'11'' \times 4'8'') = .32$

Floor $55'68'' \times 9'4'' \times 12'' = 1.77$

$55'46'' \times 7' \times 10'' = .91$

6.23 Cu Yd.

- Includes widening for Guard Rail Sta. 331+ to 335+ Rt.
- Est. for Correcting Ineq. in bottom layer of pavement used for Detour.

STABILIZATION BASED ON:
18" E.D.L.A. = 58
Regional Factor = 1.0
Serviceability Index = .25

STRENGTH COEFFICIENTS:
K.B.P. (24" x 24") = 0.40
A.B.C. (24" x 24") = 0.12
Barrow (24" x 30" Min)

AS CONSTRUCTED
REVISED DATE
JUNE 3, 1974

FEDERAL ROAD DISTRICT NO.	DIVISION	PROJ. NO.	SHEET NO.	TOTAL SHEETS
VIII	COLORADO	U 034 -1 (12)	8	110

TABULATION OF DELINEATORS

STATION	SIDE	SPACING	TYPE I		TYPE II		TYPE III		TYPE IV		TYPE V	
			EACH PLAN	FINAL	EACH PLAN	FINAL	EACH PLAN	FINAL	EACH PLAN	FINAL	EACH PLAN	FINAL
<u>South East Ramp</u>												
323+ to 331+(M.L. Sta.)	Lt.	Accel. Lane			5	3						
6+ to 17+	Lt.	Ramp			6	6						
10+	Rt.	Gore	1	/								
<u>South West Ramp</u>												
19+ to 21+	Lt. & Rt.	Ramp					4	4			8	8
22+ to 31+	Lt.	Ramp			5	5						
26+	Rt.	Gore	1	/								
<u>North East Ramp</u>												
345+ (M.L. Sta.)	Rt.	Decel. Lane			1	/						
3+	Rt.	Ramp			1	/						
5+	Lt.	Gore	1	/								
5+ to 7+	Lt.	25° Curve			5	6						
10+	Lt.	Island	3	4								
8+ to 10+	Lt.	Median	4	4								
<u>North West Ramp</u>												
12+ to 17+	Rt.	Ramp			7	7						
355 to 365+(M.L. Sta.)	Rt.	Accel Lane			6	6						
350+ (M.L. Sta.)	Rt.		1	/								
23 RD. AVENUE												
10+ to 11+	Lt. & Rt.	Median	3	3								
PROJECT TOTALS			14	15	36	35	4	4	4	8	8	8

Documentation Source - Book No. 3 p. 30 & 31

SUMMARY OF EARTHWORK QUANTITIES

INDEX		BOOK	PAGE	SHEET		CUBIC YARD	
PLAN	FINAL						
<u>UNCLASSIFIED EXCAVATION (HAUL)</u>							
Roadway (From Cross Sections) <i>Sub-Exc. SE Ramp</i>					107,233	2,712	
Structure Quantities as Excavation <i>Mem.ing. N. Ramp, Ft. Rd. 23rd Ave.</i>					250	21-205	
Structure Quantities as Ditch <i>Sub-Exc. Soft Sp. S.</i>					45	265	
*Excavation for Topsoil					3,284	889	
TOTAL FOR PAY QUANTITY					110,812	32	
						3,398	
						91,618	
<u>BORROW (HAUL)</u>							
For Topsoil					114,103	644	
For Roadway Embankment					150	26-168	
Structure Quantities as Embankment					4,598	~	
For Embankment to Replace Topsoil					118,851	~	
TOTAL FOR PAY QUANTITY (C.O. 0.8252)						76,804	
						76,822	
<u>COMPACTION (AASHTO T 180)</u>							
(Moisture and Density Control)							
Embankment (Net)					158,097	151,979	
Replacement of Sub-Exc.					10,413	3,601	
Base of Cuts and Fills					3,284	10,413	
Embankment to Replace Topsoil (Net)					171,794	3,398	
(Exc. from Roadway)						168,391	
TOTAL FOR PAY QUANTITY							
<u>ROADWAY QUANTITIES BALANCE</u>							
(For Information Only)							
Excavation					107,233	91,619	
Unclassified					114,103	76,804	
Borrow					221,336	168,423	
TOTAL							
Embankment Net (Roadway from Cross Sections)					158,097	151,979	
(Replacement of Sub-Exc.)					158,097	155,580	
TOTAL					221,336	168,423	
Embankment x Factor (1.08255)							
Embankment x Factor (1.40)							

* To be obtained from S.W. and North Ramp areas and stockpiled as directed by the Engineer.

TABULATION OF CURB, GUTTER & SIDEWALK

BOOK	PAGE	STATION	SIDE	MEDIAN COVER MATERIAL *		REMOVAL OF CURB		REMOVAL OF CURB & GUTTER		TYPE 2			TYPE 6		SIDEWALK (5 FOOT)	GUTTER TYPE & AMOUNT
				TDN	FINAL	LIN FT	FINAL	LIN FT	FINAL	SEC 1B	SEC 2B	SEC 1M	SEC 2M			
		MAINLINE														
3 26	328+00 to 334+50	Rt				650	665									
3 27	333+50 to 342+16	Lt						1,500	1,500							
3 26	327+00 to 334+50	Median														
3 27	328+00 to 333+00	Rt														
3 27	334+95 to 342+32.5	Median														
3 27	352+02 to 355+00	Median														
3 27	343+95 to 355+59	Median														
	23rd AVE.															
3 26	8+75 to 11+65	Rt														
3 26	8+85 to 9+37	Lt						0	15							
3 26	9+40 to 11+13	Median														
3 26	11+84 to 13+55	Rt														
3 26	11+90 to 13+55	Lt														
3 26	11+90 to 12+95	Median														
3 26	11+90 to 12+95	Median														
	N.E. RAMP															
3 24	0+95 to 5+69	Rt														
3 24	7+88 to 10+06	Median														
3 24	9+43 to 10+20	Rt														
3 24	9+70 to 10+17	Island														
3 24	10+															
	N.W. RAMP															
3 24	11+58 to 12+33	Rt														
3 27	330+10 to 10+34															
	FRONTAGE ROAD															
3 26	5+28 to 10+00	Rt														
3 26	4+92 to 5+28	Lt														
3 26	4+99 to 5+28	Lt														
3 26	331+20 to 342+60															
PROJECT TOTALS																

* 4-425 Soil Sterilization (Book No. 3 p. 24, 25, 26)
4,362

AS CONSTRUCTED
REVISED DATE
JUNE 5, 1974

FENCING REQUIREMENTS

FEDERAL ROAD NO. DIVISION PROJ. NO. SHEET NO. TOTAL SHEETS

110 9 110

BOOK	PAGE	STATION	SIDE	REMOVE FENCE		BUILD FENCE			
				Lin. Ft.	FINAL	B WIRE	Ø CH LINK (42")	Lin. Ft.	FINAL
MAINLINE									
3	9	328+00 to 333+34	Lt					535	536
3	7	338+20 to 342+65	Rt.	445	0				
SOUTHWEST RAMP									
3	7	343+95 to 353+30	Lt.	935	1,011				
		350+	Rt.		525				
3	7	349+50 to 353+32	Rt.	930	481				
SOUTHEAST RAMP									
3	9	343+65 (Mainline) to 10+03 to 13+55 (23rd Ave)	Lt					1050	1,042.5
SOUTHWEST RAMP									
3	8	13+55 (23rd Ave.) to 353+30 (Mainline) to 354+17.5	Lt.			1095	1,179.5		
NORTHEAST RAMP									
3	9	343+65 (Mainline) to 10+03 (N.E. Ramp)	Rt.					870	872.5
NORTHWEST RAMP									
3	8	11+73 to 10+04	Rt.			580	580		
PROJECT TOTALS				2,310	2,017	1,675	1,759.5	2,435	2,451

Est End Posts Req'd { 5 CH LINK
2 B. Wire
Est C. & L.B. Post Req'd { 10 CH LINK
9 B. Wire
Ø Use Top Rail 10 CH LINK
9 B. Wire

TABULATION OF GUARDRAIL

STATION	SIDE	TYPE 5		FLARE LENGTH		END ANCHOR	
		Lin. Ft.	FINAL	Lin. Ft.	FINAL	Each	FINAL
331+445 to 333+00	Rt	144	144	83'6"	83'6"	1-54	1-54
340+77 to 342+25	Lt	144	144	83'6"	83'6"	1-54	1-54
343+95 to 345+05	Lt	144	144	83'6"	83'6"	1-54	1-54
343+95 to 348+04	Rt	402	402	83'6"	83'6"	1-54	1-54
PROJECT TOTALS		834	834			4	4

(R-1) All Posts shall be driven on this project.

- Requires Concrete Collar

GENERAL NOTES

ALL WORK SHALL BE DONE ACCORDING TO THE STANDARD SPECIFICATIONS OF THE DIVISION OF HIGHWAYS, STATE OF COLORADO, APPLICABLE TO THE PROJECT.

USE GRADE 60 FOR ALL REINFORCING STEEL, EXCEPT TIES AND STIRRUPS UNLESS OTHERWISE NOTED. ALL TIES AND STIRRUPS ARE GRADE 40.

ALL CONCRETE SURFACES MARKED WITH THE SYMBOL σ AS SHOWN ON DRAWING NO. B-13 SHALL RECEIVE A CLASS 2 SURFACE FINISH.

ALL CONCRETE CHAMBERS SHALL BE 3/4 INCH UNLESS OTHERWISE NOTED.

EXPANSION JOINT MATERIAL SHALL MEET A.A.S.H.O. SPECIFICATION M 213-65 UNLESS OTHERWISE NOTED.

SOUNDINGS AND DEPTH OF FOOTINGS ARE IN ACCORDANCE WITH THE BEST AVAILABLE DATA. WHEN DIFFERENT CONDITIONS ARE ENCOUNTERED, THE BRIDGE ENGINEER WILL INSPECT AND DETERMINE IF REDSIGN IS NECESSARY.

WHEN EXCAVATING FOR FOOTINGS, THE FINAL SIX INCHES IN DEPTH SHALL BE DONE BY HAND LABOR METHODS.

FOOTINGS IN ROCK SHALL NOT BE FORMED BUT SHALL BE PLACED AGAINST UNDISTURBED ROCK.

FOR DETAILS OF STRUCTURE EXCAVATION AND STRUCTURE BACKFILL, SEE STANDARD M-206-4A.

ALL STRUCTURAL STEEL NOT OTHERWISE NOTED SHALL BE A.A.S.H.O. SPECIFICATION M-193.

ALL STRUCTURAL STEEL NOT OTHERWISE NOTED SHALL BE PAINTED IN ACCORDANCE WITH SECTION 509 FOR (ALUMINUM) PAINT.

ALL BOLTS SHALL BE 3/4" DIAMETER, HIGH STRENGTH, UNLESS OTHERWISE NOTED.

NO WELDING OF ANY KIND SHALL BE PERMITTED ON THE FLANGES OF STEEL GIRDERS UNLESS SPECIFICALLY CALLED FOR IN THE PLANS.

EACH REINFORCING BAR SHALL BE TAGGED WITH BAR DESIGNATION, STRUCTURE NUMBER AND STATION ON PROJECT. THE FIRST DIGIT OR DIGITS: 4-11 1103 = #11 BAR, ETC. ALL DIMENSIONS ON BRIDGE SECTIONS ARE OUT TO OUT. DIMENSIONS FOR REINFORCING BARS NOT SHOWN AS CLEAR SHALL BE TO THE CENTERLINE OF THE BAR.

THE FOLLOWING TABLE SHOWS THE MINIMUM LAP FOR COMMON BAR SIZES:

BAR SIZE NUMBER	4	5	6	7	8	9	10	11
SPLICE GRADE 40	1'-0"	1'-3"	1'-6"	1'-9"	2'-2"	2'-8"	3'-5"	4'-3"
LENGTH GRADE 60	1'-6"	1'-11"	2'-3"	2'-8"	3'-0"	3'-5"	4'-2"	5'-0"

E.F. = EACH FACE
N.F. = NEAR FACE
F.F. = FAR FACE
B.E.I. = BY EQUAL INCREMENTS

CROSS REFERENCE DRAWING NUMBER

SECTION OR DETAIL IDENTIFICATION



WHERE SPLICES CONTAIN BARS OF DIFFERENT DIAMETERS, THE SPLICE LENGTH SHALL BE GOVERNED BY THE SMALLEST BAR.

UNLESS OTHERWISE SHOWN ON THE PLANS OR APPROVED BY THE ENGINEER, SPLICES IN ADJACENT REINFORCING BARS SHALL BE STAGGERED. NO LAPRED SPLICES WILL BE PERMITTED AT LOCATIONS WHERE THE CONCRETE SECTION IS NOT SUFFICIENT TO PROVIDE A MINIMUM CLEAR DISTANCE OF 2 INCHES BETWEEN THE SPLICE AND THE NEAREST ADJACENT BAR.

HOOKS SHALL CONFORM TO THE PROVISIONS OF THE BUILDING CODE REQUIREMENTS FOR REINFORCING CONCRETE OF THE AMERICAN CONCRETE INSTITUTE UNLESS OTHERWISE NOTED. CLEARANCE FROM END OF BARS TO FORMED FACE SHALL BE 2" AND CLEARANCE TO ROUGH FACE SHALL BE 3".

LOADING DATA

LIVELOAD: A.A.S.H.O. HS-20-44 OR INTERSTATE ALTERNATE.
DEADLOAD: ASSUMES 25 LBS. PER SQ. FT. FOR BITUMINOUS PAVEMENT.

DESIGN DATA

A.A.S.H.O. UNIT STRESSES, EXCEPT AS NOTED.

REINFORCING STEEL:

F_s = 24,000 LBS. PER SQ. IN. EXCEPT
F_s = 20,000 LBS. PER SQ. IN. IN
TRANSVERSE DECK SLAB, STIRRUPS
AND TIES.

STRUCTURAL STEEL:

A36 F_s = 20,000 LBS. PER SQ. IN.
A572, GRADE 50 F_s = 27,000 LBS. PER SQ. IN.
F_c = 1,200 LBS. PER SQ. IN.

CONCRETE:

n = 10

AS CONSTRUCTED
REVISED DATE
JUNE 3, 1974

FEDERAL ROAD DISTRICT PROJ. NO. SHEET NO. TOTAL SHEETS	YEA	COLORADO	U 034-1 (12)	11	110
REVISIONS	12-27-72	Removed Note	MU		

INDEX OF DRAWINGS

DWG. NO. B-1	GENERAL INFORMATION SUMMARY OF QUANTITIES
DWG. NO. B-2	GENERAL LAYOUT
DWG. NO. B-3	ENGINEERING GEOLOGY
DWG. NO. B-4	ELEVATIONS
DWG. NO. B-5	BAR LIST
DWG. NO. B-6	CONSTRUCTION LAYOUT
DWG. NO. B-7	PILING LAYOUT
DWG. NO. B-8	ABUTMENT 1 AND 2 DETAILS
DWG. NO. B-9	TYPICAL SECTION
DWG. NO. B-10	SLAB REINFORCING
DWG. NO. B-11	GIRDER DETAILS
DWG. NO. B-12	DIAPHRAGM DETAILS GIRDER SECTIONS CAMBER DIAGRAM
DWG. NO. B-13	MISCELLANEOUS DETAILS
DWG. NO. B-14	SLOPE PAVING DETAILS
DWG. NO. B-15	BRIDGE RAIL TYPE 5
DWG. NO. B-16	STRUCTURE NUMBER STANDARD
DWG. NO. B-17	ENGINEERING GEOLOGY
DWG. NO. B-18	PILING LAYOUT - RETAINING WALL
DWG. NO. B-19	RETAINING WALL M-6'-0" TO 24'-0"
DWG. NO. B-20	RETAINING WALL DETAILS
DWG. NO. B-21	RETAINING WALL DETAILS
DWG. NO. B-22	RETAINING WALL DETAILS
DWG. NO. B-23	RETAINING WALL DETAILS

Item No.	Description	Unit	Structure No. C-18-ER			Retaining Wall #
			Super. struct.	Abut. 1	Abut. 2	Total
206	Structure Excavation	Cu. Yd.		65	75	140
206	Structure Backfill (Class 2)	Cu. Yd.		63	72	135
403	Hot Bituminous Pavement (Grading DX) (Haut and Asphalt)	Ton		107		107
502	Steel Piling (HP 10x42) C.A. 02789	Lin. Ft.		744.66	664.17	1408.83
502	Steel Piling (HP 12x74) C.A. 02789	Lin. Ft.		735	714	1449
502	Drilling Hole to Facilitate Pile Driving	Lin. Ft.		285.5	285.5	571
507	Concrete Slope & Dr. Paving (Reinforce d)	Cu. Yd.		447	442	889
507	Structural Steel (Galvanized)	Lb.		45	50	95
515	Waterproofing (Membrane)	Sq. Yd.		14,068		14,068
518	Waterstop (6 inch)	Sq. Yd.		1,364		1,364
601	Concrete Class A (Bridge)	Cu. Yd.		36	44	121
601	Concrete Class A (Miscellaneous)	Cu. Yd.				428.83
601	Concrete Class S (Bridge)	Cu. Yd.				427.75
602	Reinforcing Steel	Lb.		972.2	56.9	1086
613	3/4 inch Electrical Conduit	Lb.		179,916	4,917	5752
613	1 1/2 inch Electrical Conduit	Lin. Ft.		80 90-		190,577
613	1 1/2 inch Electrical Conduit	Lin. Ft.		80 90-		163,546
618	Prestressing Steel Wire or Strand	Lb.		147 188		147 198
618	1/2 inch Expansion Joint Material	Sq. Ft.		93,502		93,502
618	1 inch Expansion Joint Material	Sq. Ft.				270
502	Steel Piling (HP 10x42) C.A. 02789	Lin. Ft.				65
502	Steel Piling (HP 12x74) C.A. 02789	Lin. Ft.				100.00

- ① W10x45 or HPS 10x42 may be used in lieu of the HP 10x42
- ② This item includes furnishing, placing in the concrete and post-tensioning the prestressing steel. The Contractor shall furnish all stressing equipment and accessories required for installation and stressing operations. Weight shall not be remeasured, but shall be the quantity shown.
- ③ To be included in the bid price for Item No. 601 Concrete Class A (Miscellaneous)
- * To be included in Roadway Quantities.

DIVISION OF HIGHWAYS

GENERAL INFORMATION SUMMARY OF QUANTITIES

Station 342 + 32.450 TO 343 + 94.950

Drawn by: Creelley, Sec 18, 19, 24, 25, 26, 99, 100


Checked by: R. Stuckman, Structure, C-18-ER

Designed by: M. McMillan, Structure, C-18-ER

Drawing Number: 8 of 23 Drawings




Approved
Planned by: R.E. 10/24/72
Checked by: R.E. 10/24/72
Designed by: R.E. 10/24/72

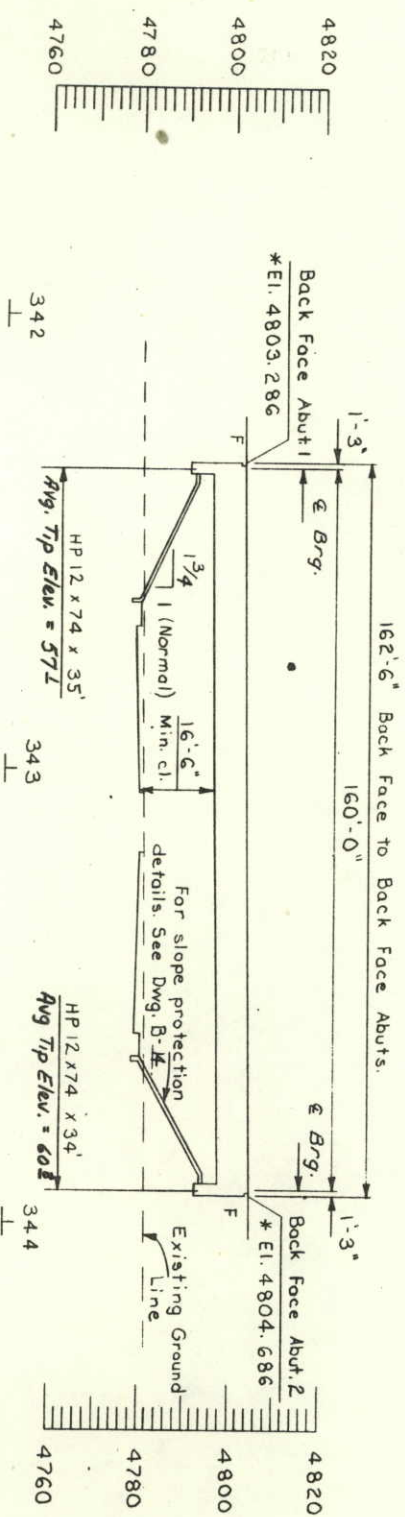

Note: All piling are end bearing. Pile lengths are estimated.

* Finished Roadway Elevations

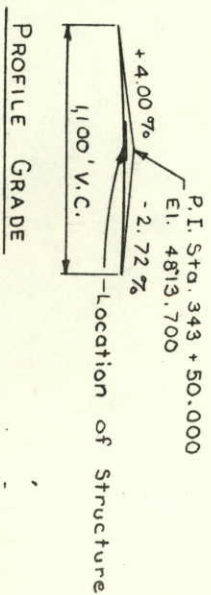

FEDERAL ROAD REVISION NO.	DISTRICT	PROJ. NO.	SHEET NO.	TOTAL SHEETS
XVII	COLORADO	UO34-1 (12)	12	110
REVISED SHEET				
REVISIONS				

GENERAL LAYOUT

Designer R. Struckman	Structure	C-18-ER
Detailer K. Sharpley	Numbers	
Drawing Number B 2	of 23	Drawings



SUMMARY OF TEST RESULTS

TYPE OF MATERIAL

LEGEND

	ASPHALT
	SAND & GRAVEL
	SAND
	SANDY SILTY CLAY
	SILTY CLAY
	GRAVEL

	SANDY CLAY & GRAVEL
	SILTY SAND
	SILTY SAND & GRAVEL
	SANDSTONE

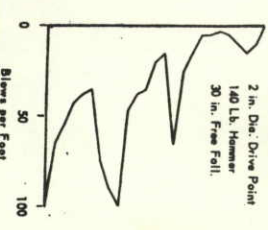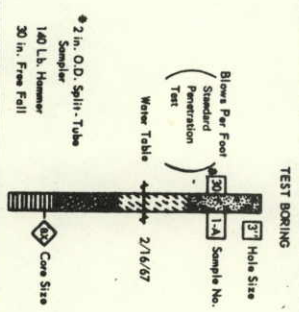

STRUCTURE NO C-10-ER
DWG. NO. 3 OF 23

ENGINEERING GEOLOGY

23rd	AVE	34.3 + 13.700	18.3134	5.5 N. 05.608
increased by	Site			
Designed by	Engineer	GREELEY		
Checked by	Geologist	K.W.H.		
Approved by				
Bridge Engineer				
Date:				
19				

11-11-77
11-11-77
11-11-77

PROJECT NO. UO34-1()
STR. NO. C-18-ER
U.S. 36 BY-PASS
OVER 23RD AVENUE
NEAR GREELEY-SOUTHWEST PORTION
DESIGNED BY R.W.S.
INPUT BY B.O.E.
ELEVATIONS ARE AT THE TOP OF
CONCRETE DECK

INPUT DATA FOR BRIDGE C-18-ER
POT = 343 + 13.7000 ALPHA = -1 0 0.00 RDWY = 88.0000 GR = 4.0000
PI = 343 + 50.0000 EPI = 4803.5750 VC = 1100.0000
TYPE = 2 SLOPE = .0150
CL BRGS.-ABUT. 1
CL BRGS.-ABUT. 2

SOUTH OUT
STA BACK
1 20TH
2 20TH
3 20TH
STA AHEAD

1	281M	342 + 40.9100	4802.5946
2	281M	342 + 48.9100	4802.5971
3	281M	342 + 56.9100	4802.5995
4	281M	342 + 64.9100	4802.6013
5	281M	342 + 72.9100	4802.6033
6	281M	342 + 80.9100	4802.6053
7	281M	342 + 88.9100	4802.6073
8	281M	342 + 96.9100	4802.6093
9	281M	342 + 104.9100	4802.6113
10	281M	342 + 112.9100	4802.6133
11	281M	342 + 120.9100	4802.6153
12	281M	342 + 128.9100	4802.6173
13	281M	342 + 136.9100	4802.6193
14	281M	342 + 144.9100	4802.6213
15	281M	342 + 152.9100	4802.6233
16	281M	342 + 160.9100	4802.6253
17	281M	342 + 168.9100	4802.6273
18	281M	342 + 176.9100	4802.6293
19	281M	342 + 184.9100	4802.6313
20	281M	342 + 192.9100	4802.6333
STA	AREAO	342 + 92.9103	4803.0746

DESIGNED BY	INITIAL	DATE	CHECKED BY	9-72
CHECKED BY	R.W.	7-72	QUANTITIES BY	J.T.W.
DETAILED BY	C.J.W.	8-72	CHECKED BY	H.H.M.

BAR LIST - ABUTMENTS 1 AND 2

Mark	No. Reqd.	Length	Type	h	Dimensions
404	11	2-9	II	0-11	0-11
410	2	4	19-9	XI	2-9
411		6-2	BEI	II	0-8
421	10	21-2	Str.		10-3
423	5	10-7	Str.		
424	2	17-6	Str.		
425	220	3-0	Str.		
510	15	40-0	Str.		
511	14	51-0	Str.		
512	4	24-7	Y	10-7 1/2	9-8 1/2
513	6	24-8 1/2	Y	10-8 1/4	9-9 1/4
514	6	24-10	Y	10-9	9-10
515	6	24-11 1/2	Y	10-9 3/4	9-10 3/4
516	6	25-1	Y	10-10 1/2	9-11 1/2
517	6	25-2 1/2	Y	10-11 1/4	10-0 1/4
518	6	25-4	Y	11-0	10-1
519	6	25-5 1/2	Y	11-0 3/4	10-1 3/4
520	6	25-7	Y	11-1 1/2	10-2 1/2
521	6	25-8 1/2	Y	11-2 1/4	10-3 1/4
522	6	25-10	Y	11-3	10-4
523	1	18-2	Str.		
524		17-0	Str.		
528	1	52-4	Str.		
529	1	7-0	Str.		
530	6	7-0	Str.		
610	2	40-0	Str.		
611	2	52-6	Str.		
612	4	45-9	Str.		
613	4	46-5	Str.		
710	3	19-2	VII	18-2	1-0
711		18-0	BEI	17-0	
720	1	4-8	VII	3-8	1-0
901	2	20-4	Str.		

SUMMARY - ABUTMENT 1

No. Lin. Ft.	Bar Size	Lbs./Lin. Ft.	Weight
968	4	0.668	647
3,096	5	1.043	3,229
368	6	1.502	553
171	7	2.044	349
41	9	3.400	139
Total			4,917

SUMMARY - ABUTMENT 2

No. Lin. Ft.	Bar Size	Lbs./Lin. Ft.	Weight
1,276	4	0.668	852
3,230	5	1.043	3,369
371	6	1.502	557
342	7	2.044	699
81	9	3.400	275
Total			5,752

BAR LIST - SUPERSTRUCTURE

Mark	No. Reqd.	Length	Type	h	Dimensions
401	295	60-0	Str.		
402	287	24-11	Str.		
403	4	45-6	Str.		
404	218	2-9	II	0-11	0-11
405	48	4-8	I	1-2	0-10
406	140	14-8	VI	0-6	6-9
407	238	1-0	Str.		
501	814	60-0	Str.		
502	378	32-4	Str.		
503	218	45-8	Str.		
504	2940	7-5	II	6-9	0-4
505	294	7-5	XIII	6-9	
506	378	52-4	Str.		
507	378	40-0	Str.		
601	124	60-0	Str.		
602	62	47-2	Str.		
603	12	8-0	Str.		
801	44	60-0	Str.		
802	22	48-10	Str.		

SUMMARY


No. Lin. Ft.	Bar Size	Lbs./Lin. Ft.	Weight
28,140	4	0.668	18,798
129,905	5	1.043	135,491
10,460	6	1.502	15,711
3,714	8	2.670	9,916
Total			179,916

Note: Bar List for bridge only.
No bar list provided for Retaining wall.

AS CONSTRUCTED
NO REVISIONS
DATE JUNE 3, 1974

PROJECT NO.	DISTRICT	PROJ. NO.	SHEET NO.	TOTAL SHEETS
VIII	COLORADO	U 034-1(12)	15	110
REVISIONS				

BENDING DIAGRAMS

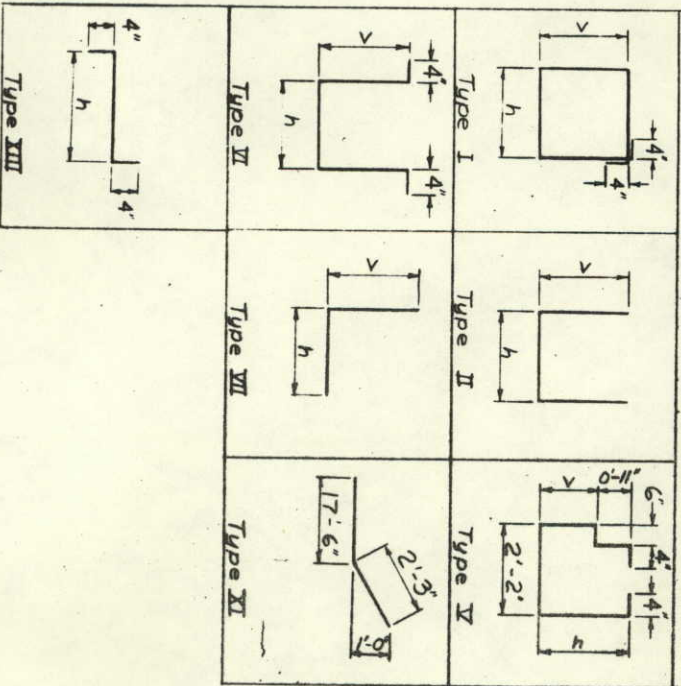


DIVISION OF HIGHWAYS

BAR LIST

Designer	R. Struckman	Checker	C-18-ER
Detailer	J. Watson	Number	23
Drawing Number	8	of	23

AS CONSTRUCTED
REVISED DATE
JUNE 3, 1974

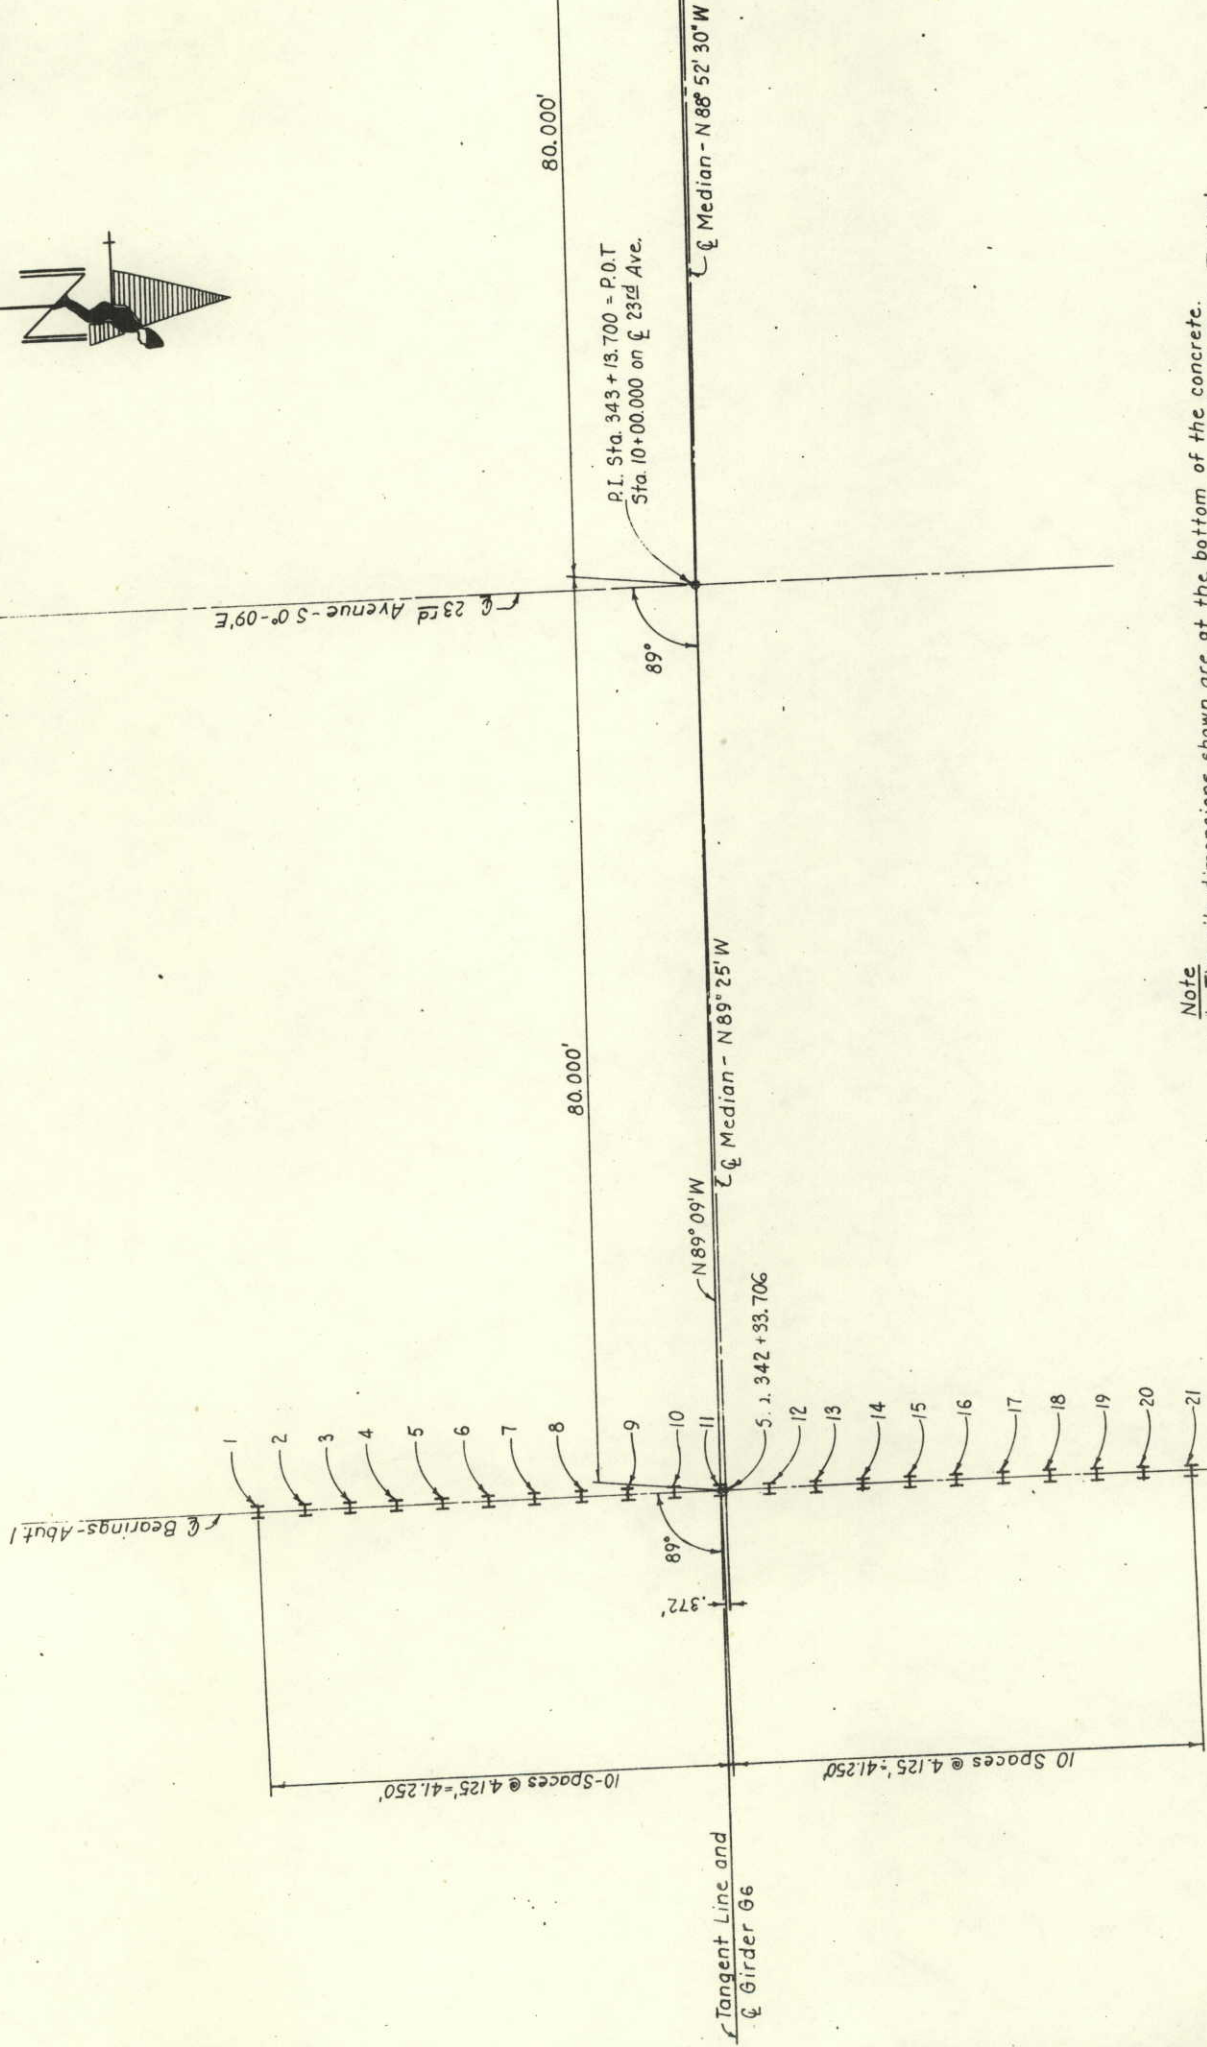

- Note
- The pile dimensions shown are at the bottom of the concrete.
 - All piling shall be HP12 x 74 with a Maximum Pile Load = 94 Tons. - Typical
 - The cut off elevations of the piling are as follows:
Abut. 1 (Piles No. 1 thru 21) - El. 4792.50
Abut. 2 (Piles No. 22 thru 42) - El. 4793.90
 - All piles to be driven in predrilled 18" diameter holes through the compacted fill. Holes to be filled with sand after pile driving is completed. All work necessary to accomplish this shall be included in the bid price for Item No. 502 Drilling Hole to Facilitate Pile Driving.

PILING LAYOUT

AVERAGE PILING TIP ELEVATIONS

ABUT. 1 - 4756.09

ABUT. 2 - 4762.27

DIVISION OF HIGHWAYS

PILING LAYOUT

Designer R. Struckman	Structures	C-18-ER
Detailer B. Einspahr	Numbers	
Drawing Number B 7	of	23 Drawings

DESIGNED BY	DATE	INITIAL
CHECKED BY	6-72	R.W.S.
QUANTITIES BY		
CHECKED BY	7-72	B.D.E.
DETAILED BY		

FEDERAL ROAD DISTRICT	PROJ. NO.	SHEET NO.	TOTAL SHEETS
VIII	U034-1(12)	16	110
COLORADO			
REVISIONS			


FEDERAL ROAD DISTRICT	PROJ. NO.	SHEET NO.	TOTAL SHEETS
XIII	U034-1(12)	17	110
REVISIONS			



AS CONSTRUCTED
REVISED DATE
JUNE 9, 1974

Note:
All elevations shown are at top of concrete deck.
"J" = 6" x 6" x 4" Junction Box flush with bottom of slab. Drain for interior condensation. Typ.

This line tangent @ P.I. Sta. 343+13.700

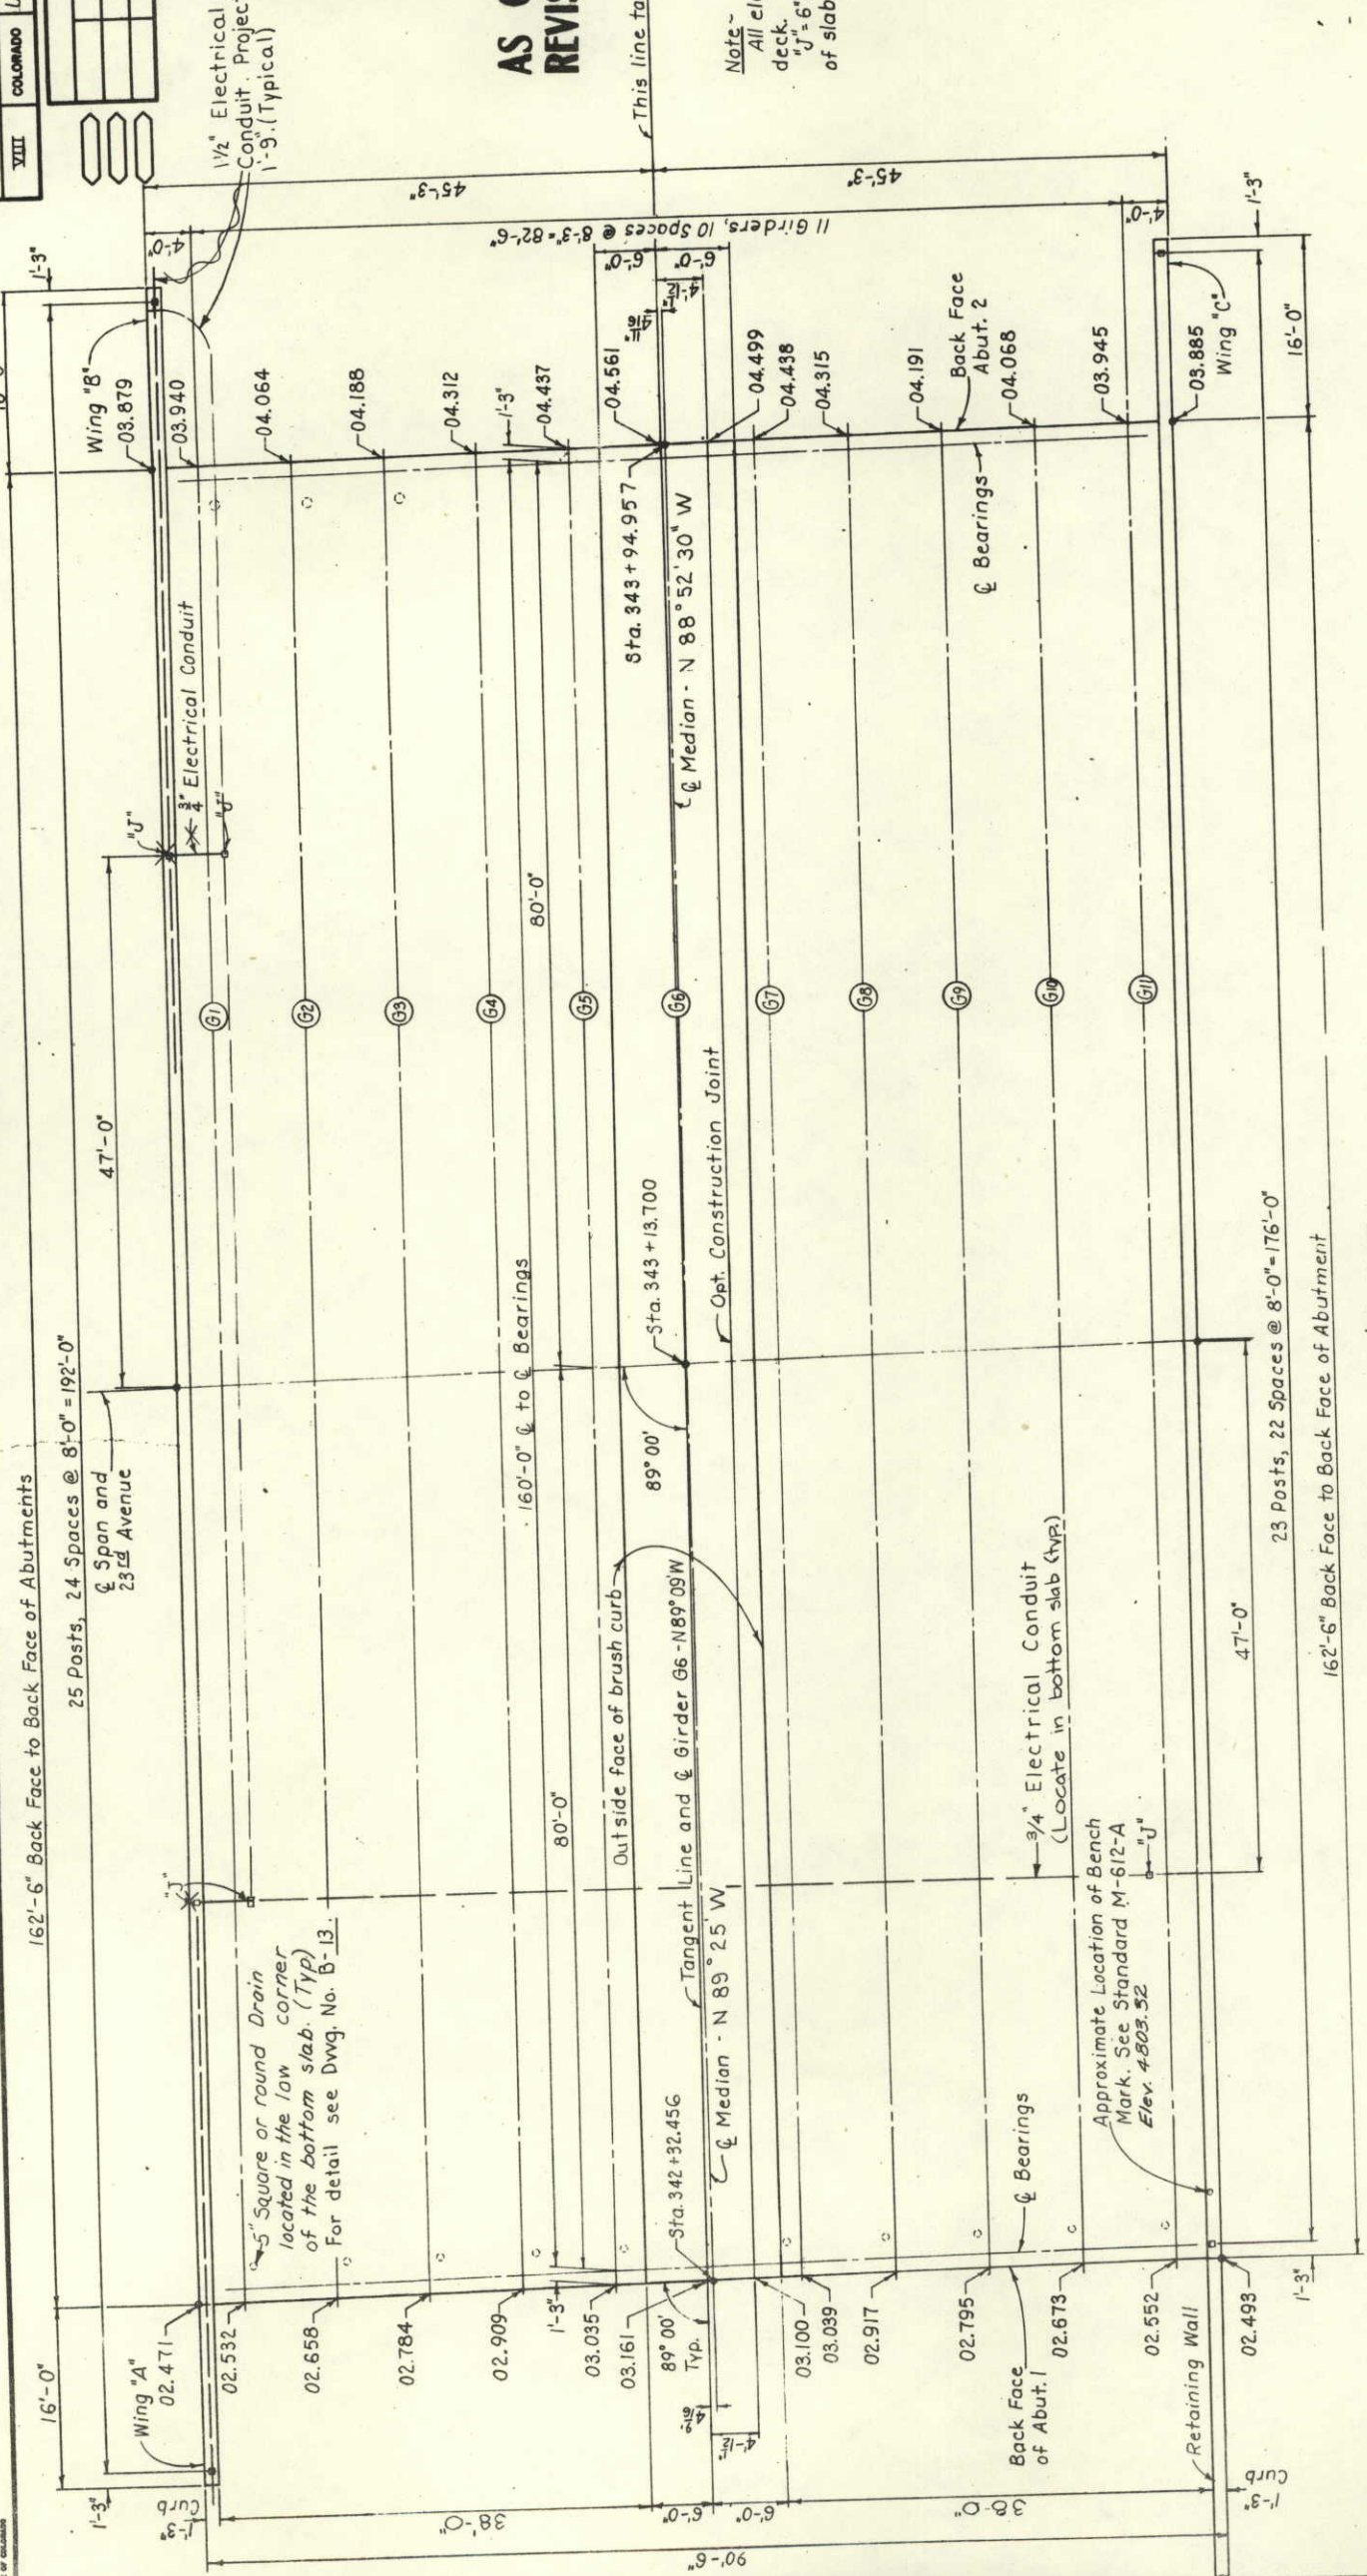

CONSTRUCTION LAYOUT

DIVISION OF HIGHWAYS
CONSTRUCTION LAYOUT

Designer R. Struckman	Structure Numbers	C-18-ER
Detailer B. Einspahr	6	of 23
Drawing Number B	6	Drawings

DESIGNED BY	DATE	INITIAL	DATE	QUANTITIES BY	CHECKED BY
R.W.S.	5-72			J.W.	H.M.
DETAILED BY	7-72	B.D.E.	7-72	CHECKED BY	9-72

AS CONSTRUCTED
NO REVISIONS DATE *JUNE*

Const. Joint
Leave Rough
610 - spliced
to 611

510 or 529

Varies (11'-0" Min.)

510 or 511 Abut. 1, 510 or 529
Abut. 2 spaced as shown

2" CL

2" CL

3" CL

1'-9"

1'-8"

1'-8"

1'-2"

1'-2"

2'-6"

1'-3" 1'-3"

HP 12 x 74

See note Dwg
No. B-7.

1'-0" TYP

5 Stirrups

425 ea. way

Note - No backfill is to
be placed in front of
wall until after pre-
stressing

Typ

1 Const.


* 3pc Manufacturers Shop Plans.
for these dimensions. Bar reinforcing
interfering with the anchorage shall be
adjusted as directed by the engineer.

TYPICAL ABUTMENT SECTION

DIVISION OF HIGHWAYS

ABUTMENT 1 AND 2 DETAILS

Designer R. Struckman	Structure Numbers	C-18-ER
Detailer B. Einspahr		
Drawing Number B 8	of 23	Drawings

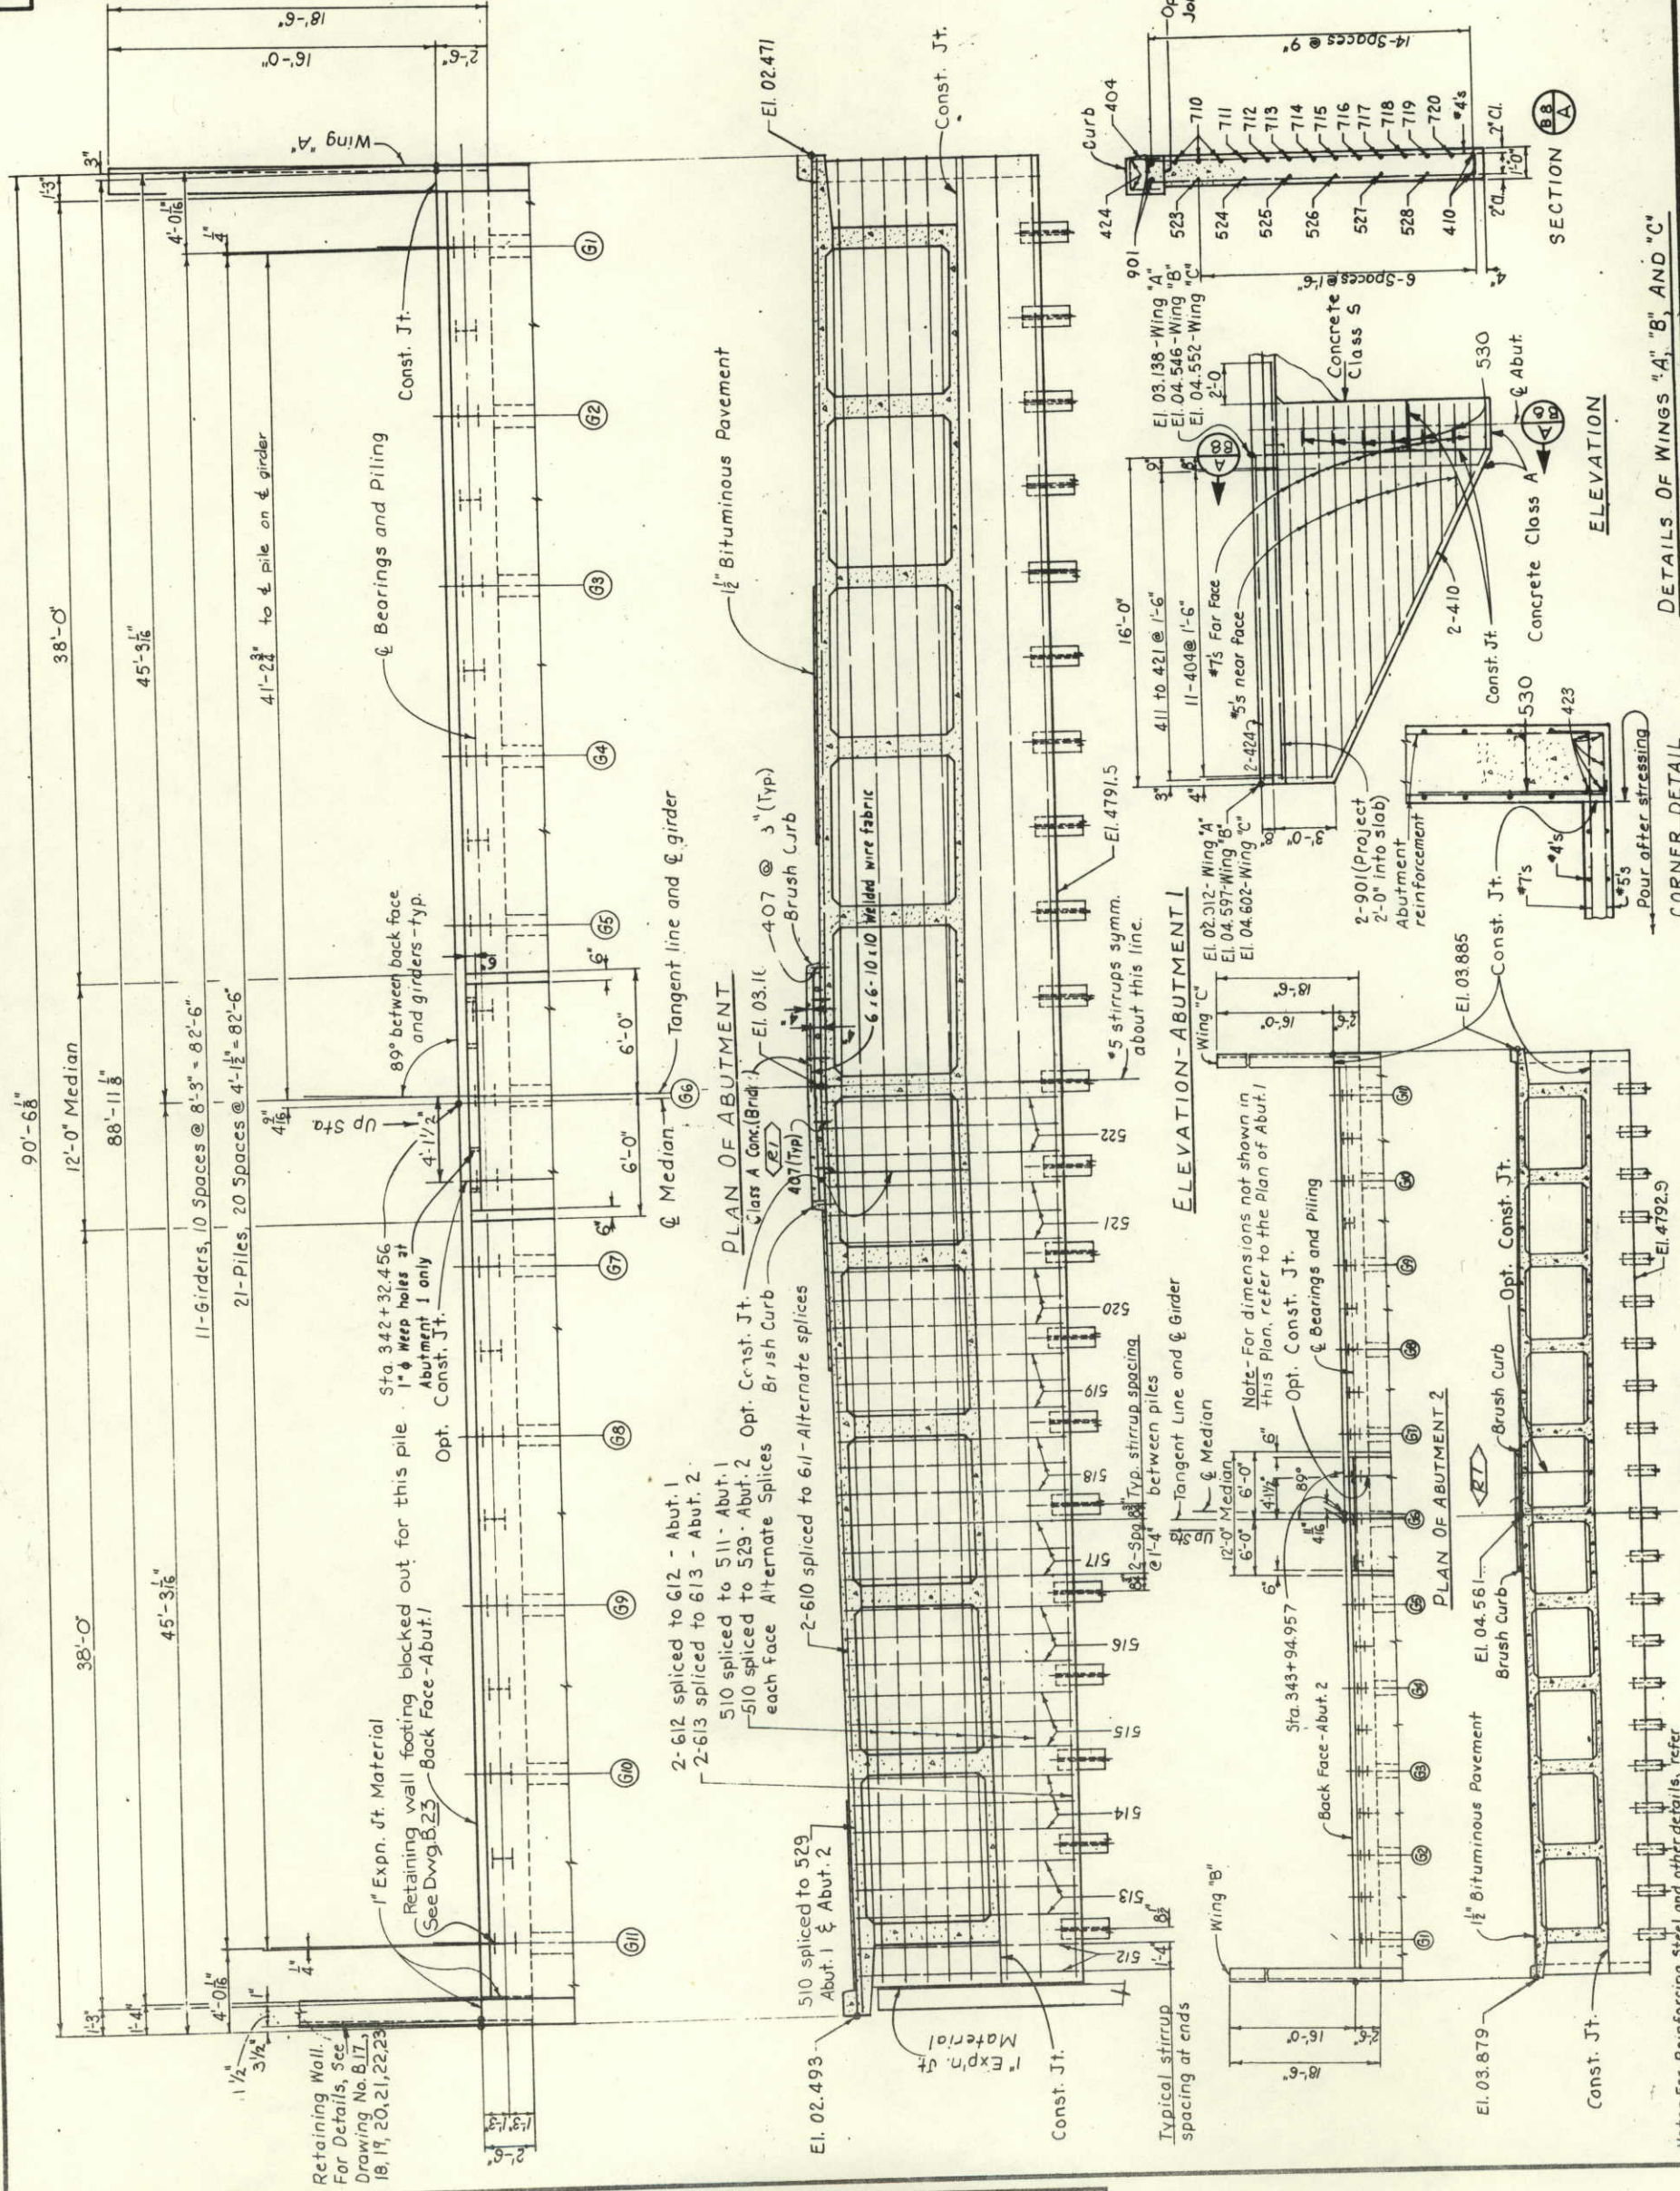

DETAILS OF WINGS "A," "B," AND "C"


CORNER DETAIL

NOTE: FOR REINFORCING STEEL AND OTHER DETAILS SEE "ELEVATION-ABUTMENT 1" AND "TYPICAL ABUTMENT SECTION" SHOWN ON THIS DRAWING.

DESIGNED BY	INITIAL	DATE	CHECKED BY	DATE
	RWS	5-72		
CHECKED BY	QUANTITIES BY			
	HHH	7-72		
DETAILED BY				
	TDB	7-72		

FEDERAL ROAD DISTRICT NO.	DISTRICT	PROJ. NO.	SHEET NO.	TOTAL SHEETS
VIII	COLORADO	U 034-1 (12)	10	110
REVISIONS				

AS CONSTRUCTED
NO REVISIONS
DATE JUNE 3, 1974

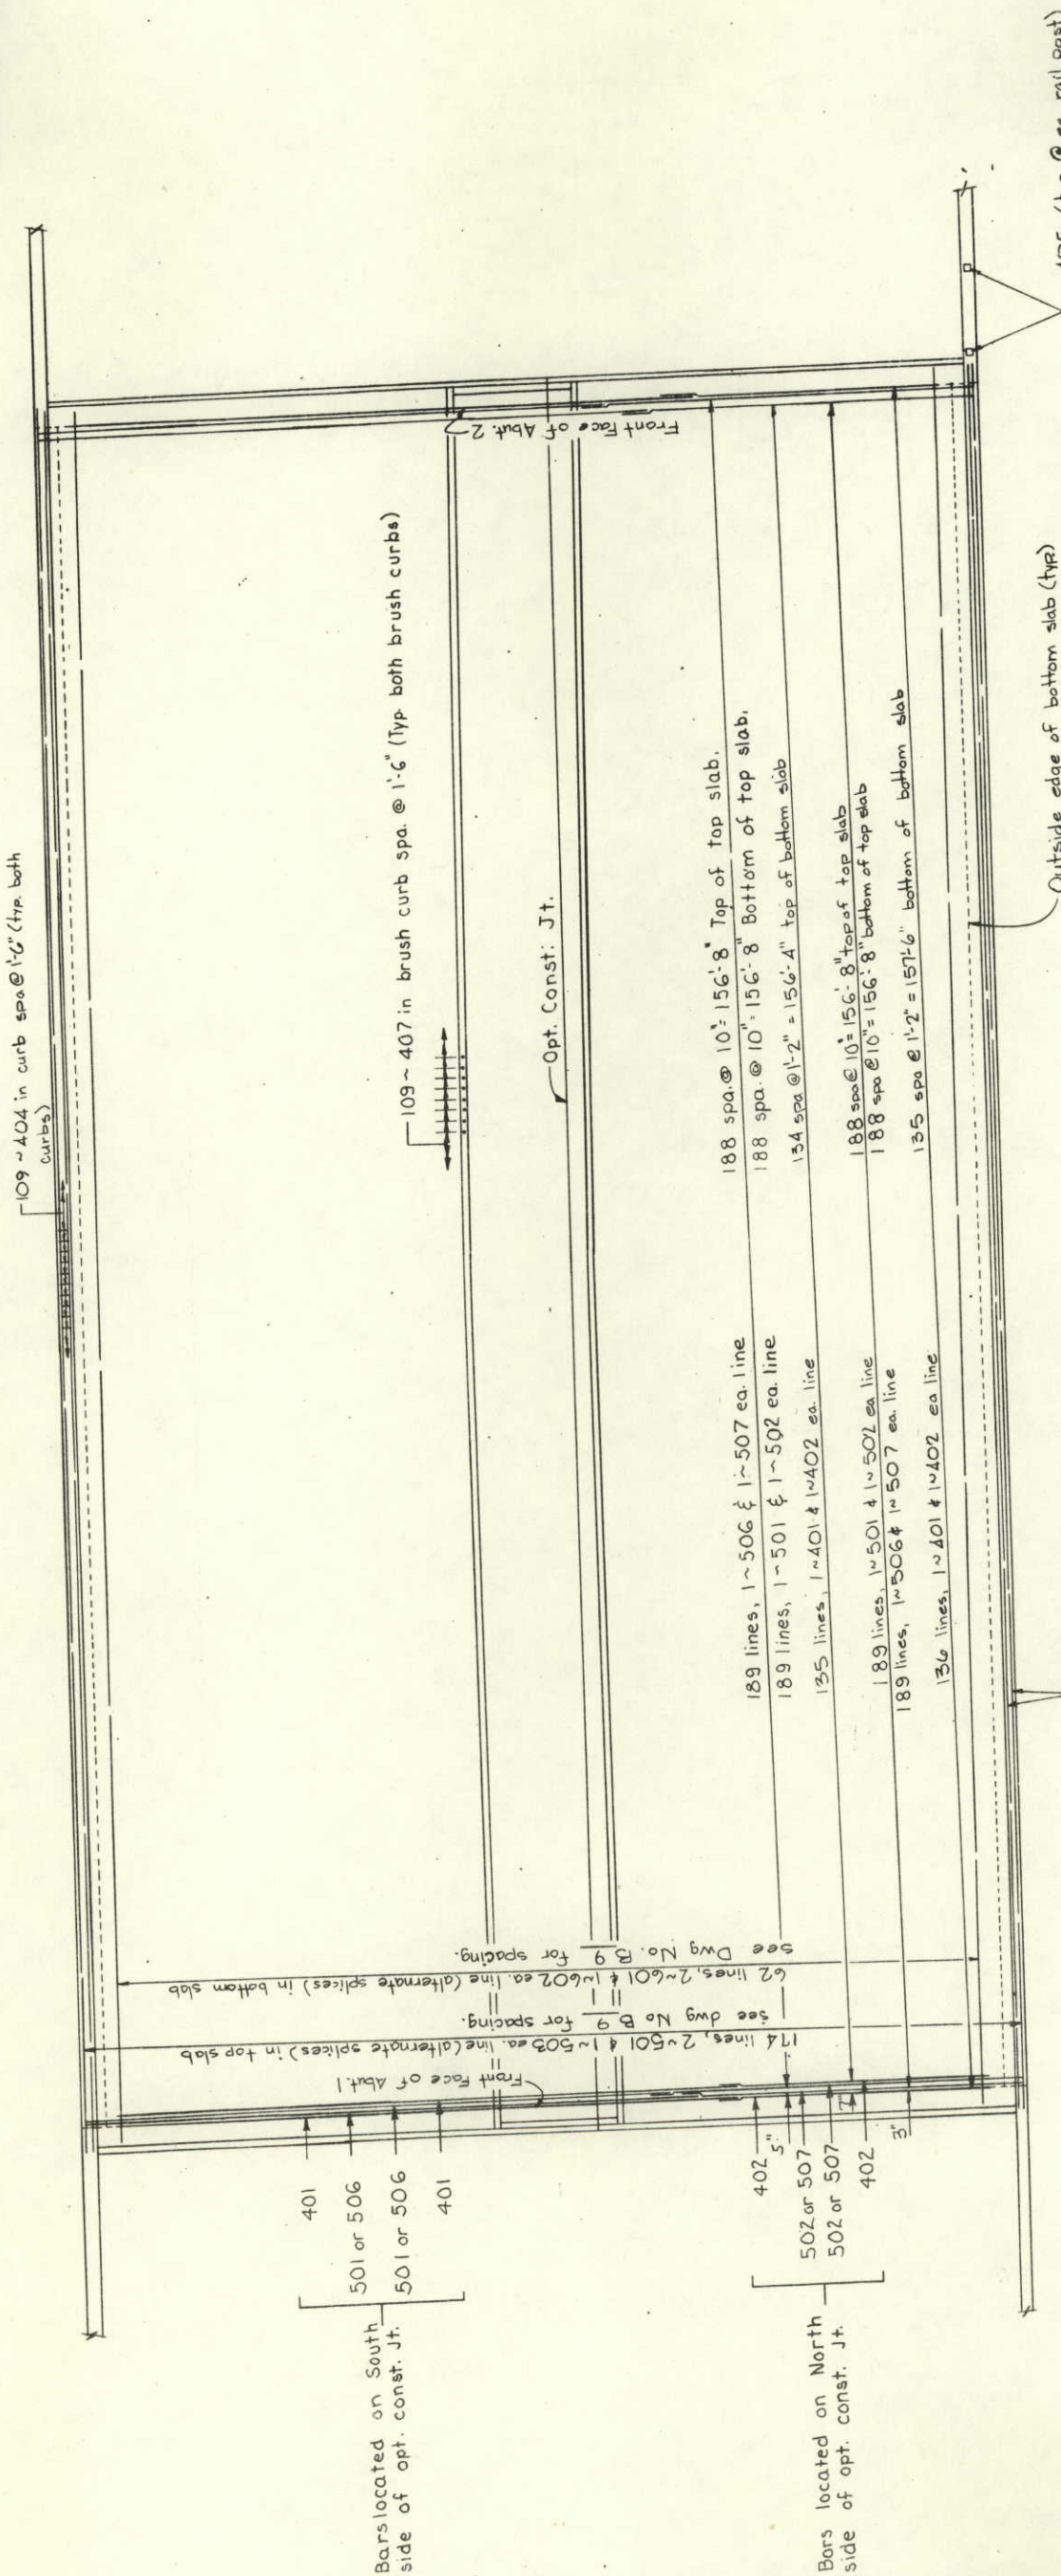

Note: If optional const. joint is used, south side of structure shall be constructed first.

SLAB REINFORCING

DIVISION OF HIGHWAYS

SLAB REINFORCING


Designer R. Struckman	Structure Numbers	C-10-ER
Detailer T. Breder	Drawing Number B 10	of 23 Drawings

FEDERAL ROAD DISTRICT NO.	DISTRICT	PROJ. NO.	SHEET NO.	TOTAL SHEETS
VIII	COLORADO	U034-1 (12)	20	110

REVISIONS
12-13-72 Added "Coarse Agg. For Conc. #407" JRE

NOTE: Asphalt Roll Roofing was placed over the Membrane.
C.O. No. 06260

AS CONSTRUCTED
REVISED DATE
JUNE 3, 1974

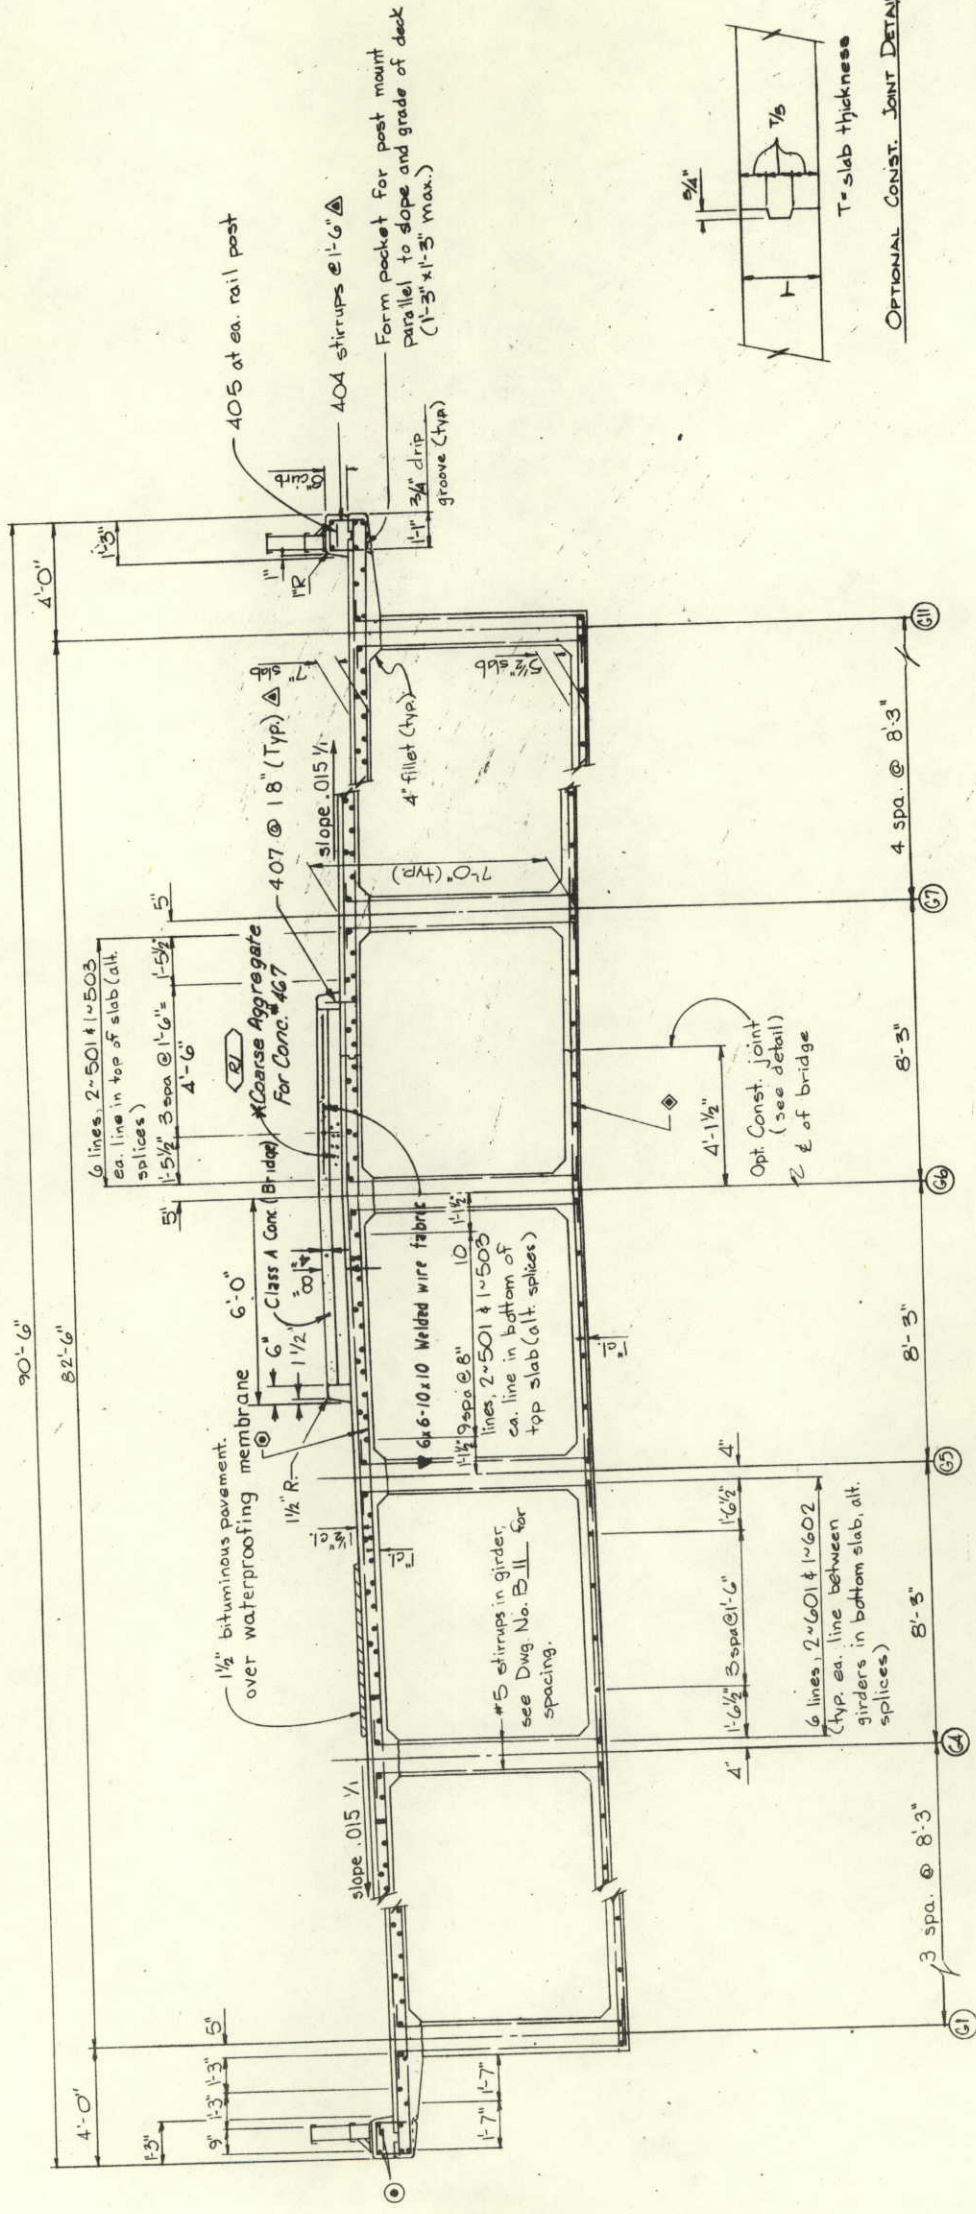

NOTES

- For girder details see Dwg. No. B.11.
For diaphragm details see Dwg. No. B.12.
▲ 404 & 407 bars may be placed after slab is poured, but before initial set takes place.
● 189 lines top of slab & 189 lines bottom of slab, 1-501 & 1-502, or 1-506 & 1-507 ea. line, typ. in curb, alternate splices.
● 2-401 & 1-402 ea. line, typ. in curb, alternate splices.
● 1-401 & 1-402 ea. line, typ. in curb, alternate splices.
* To be included in bid price for Concrete, Class A (Bridge).
▼ To be included in bid price for Concrete, Class A (Bridge).

TYPICAL SECTION AT & OF SPAN

DIVISION OF HIGHWAYS



TYPICAL SECTION

Designer R. Struckman	Signature	C-18-ER
Detailer T. Breder	Number	9
Drawing Number 8	of	23
		Drawings

FEDERAL ROAD DISTRICT	PROJ. NO.	SHEET NO.	TOTAL SHEETS
VIII	COLORADO	U034-1(12)	22
110			


REVISIONS	

AS CONSTRUCTED
NO REVISIONS
DATE JUNE 3, 1974

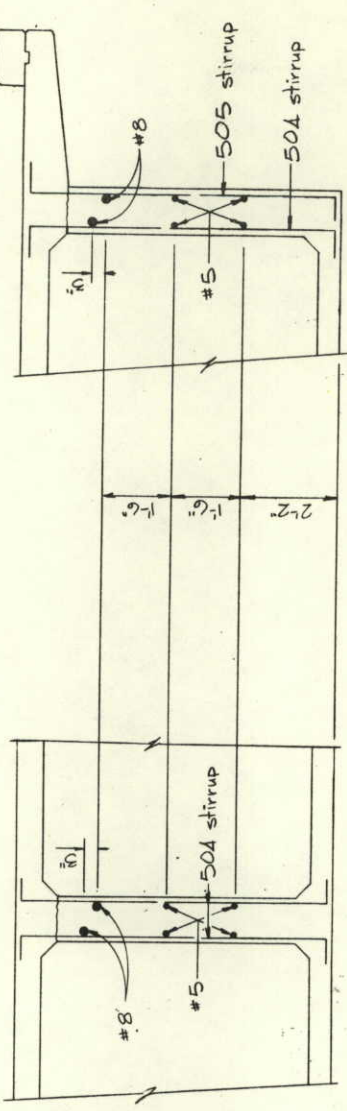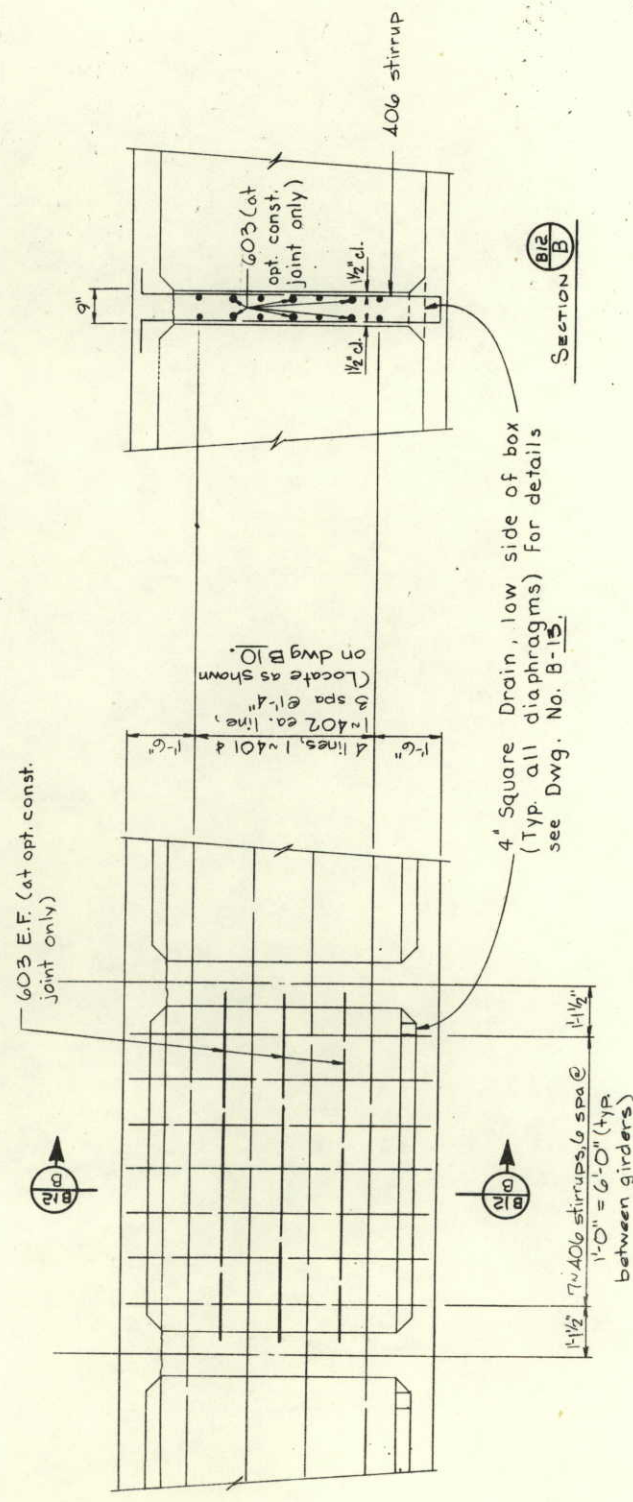

SECTION A
(at interior girder)

SECTION B
(at exterior girder)

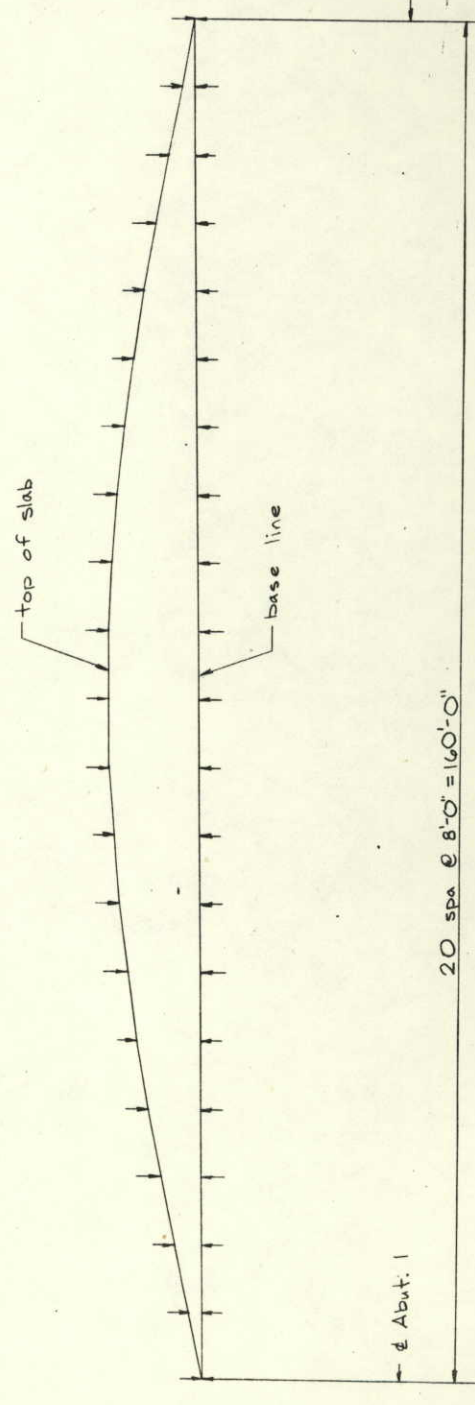

V.C. Correction
D.L. Deflection + Prestressing Camber
Total Camber

.000	.037	.070	.099	.124	.146	.163	.177	.187	.194	.192	.187	.177	.163	.145	.124	.098	.069	.036	.000
.000	.011	.028	.047	.067	.087	.105	.120	.132	.141	.139	.132	.120	.105	.087	.067	.047	.028	.011	.000
.000	.048	.098	.146	.191	.233	.268	.297	.319	.332	.335	.331	.319	.297	.268	.232	.191	.145	.097	.047

CAMBER DIAGRAM
(Given in decimals of a foot)

DIVISION OF HIGHWAYS

DIAPHRAGM DETAILS
GIRDER SECTIONS
CAMBER DIAGRAM


Designer R. Struckman	Structure Numbers	C-18-ER
Detailer T. Breder	Drawing Number B	12
of		23
Drawings		

DESIGNED BY	INITIAL	DATE	CHECKED BY	DATE


QUANTITIES BY	DATE	CHECKED BY	DATE

FEDERAL ROAD DISTRICT	PROJ. NO.	SHEET NO.	TOTAL SHEETS
VIII	U 034-1(12)	28	110
REVISIONS			

AS CONSTRUCTED
NO REVISIONS DATE
JUNE 3, 1974

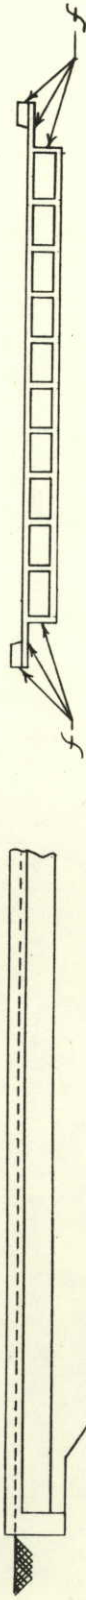


SUPERSTRUCTURE

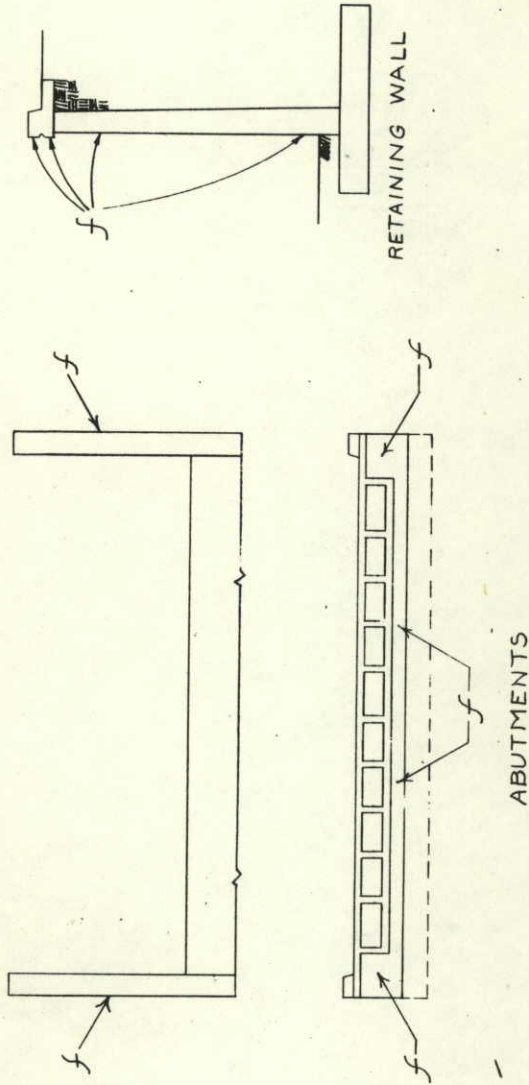

RETAINING WALL


ABUTMENTS

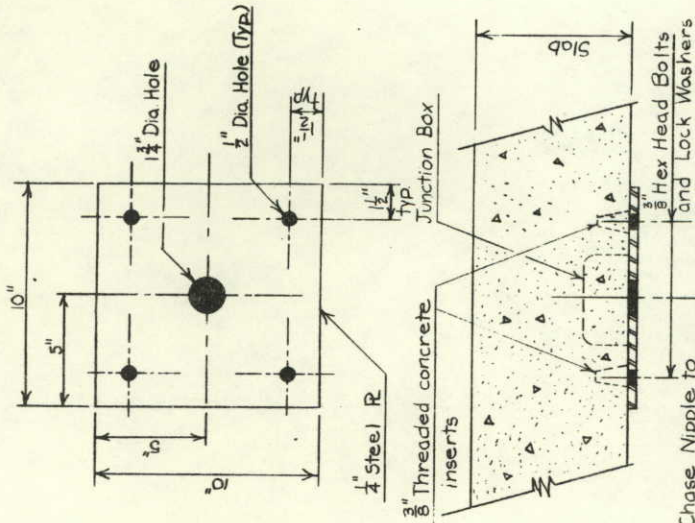


Use 1/4" Chase Nipple to attach Light Fixture to R

LIGHT FIXTURE HANGER PLATE 2 Reg'd
All work necessary to accomplish the above shall be included in the bid price of Item No. 613 Electrical Conduit. "J" = 6" x 6" x 4" Junction Box flush with bottom of slab. Drain for interior condensation.

DETAILS SHOWING PORTIONS OF STRUCTURE TO RECEIVE
CLASS 2 SURFACE FINISH

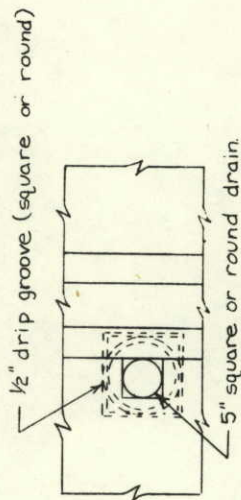


PLAN

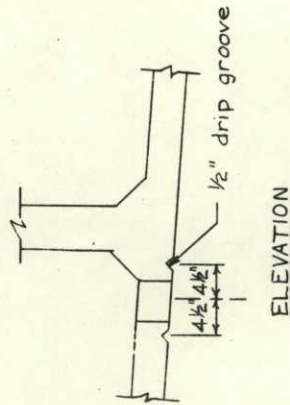

ELEVATION

BOTTOM SLAB DRAIN DETAIL

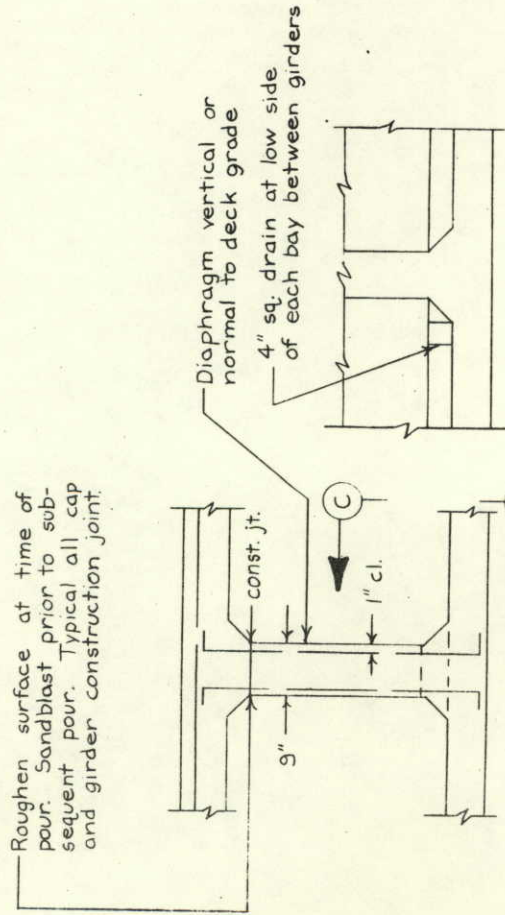

ELEVATION

SECTION C

INTERMEDIATE DIAPHRAGM SECTION

DIVISION OF HIGHWAYS

MISCELLANEOUS DETAILS

Designer R. Struckman	Structure Numbers	C-18-ER
Detailer M. Roseberry	of	23
Drawing Number B	13	Drawings

AS CONSTRUCTED
NO REVISIONS DATE *JUNE 3, 1974*

FEDERAL ROAD REGION NO.	DISTRICT	PROJ. NO.	SHEET NO.	TOTAL SHEETS
VIII	COLORADO	U034-1 (12)	24	110

REVISIONS	

NOTES


SLOPE PAVING SHALL BE POURED IN 10-FT. TRANSVERSE SECTIONS WITH A TOOLED CONSTRUCTION JOINT AT EACH SECTION.

WIRE FABRIC SHALL BE 2" FROM THE END OF JOINTS AND SHALL LAP 4" AT SPLICES.

WHERE SLOPE OR BERM PAVING BUTTS AGAINST STRUCTURAL CONCRETE, SEPARATE WITH 1/2" EXPANSION JOINT MATERIAL. (INCLUDE IN BID PRICE FOR ITEM 507).

TRANSITION ENDS OF SLOPE PAVING MAY BE MODIFIED BY THE ENGINEER TO FIT CONDITIONS ENCOUNTERED IN THE FIELD.

ALL WORK NECESSARY BY THESE REQUIREMENTS SHALL BE INCLUDED IN THE BID PRICE FOR ITEM NUMBER 507.

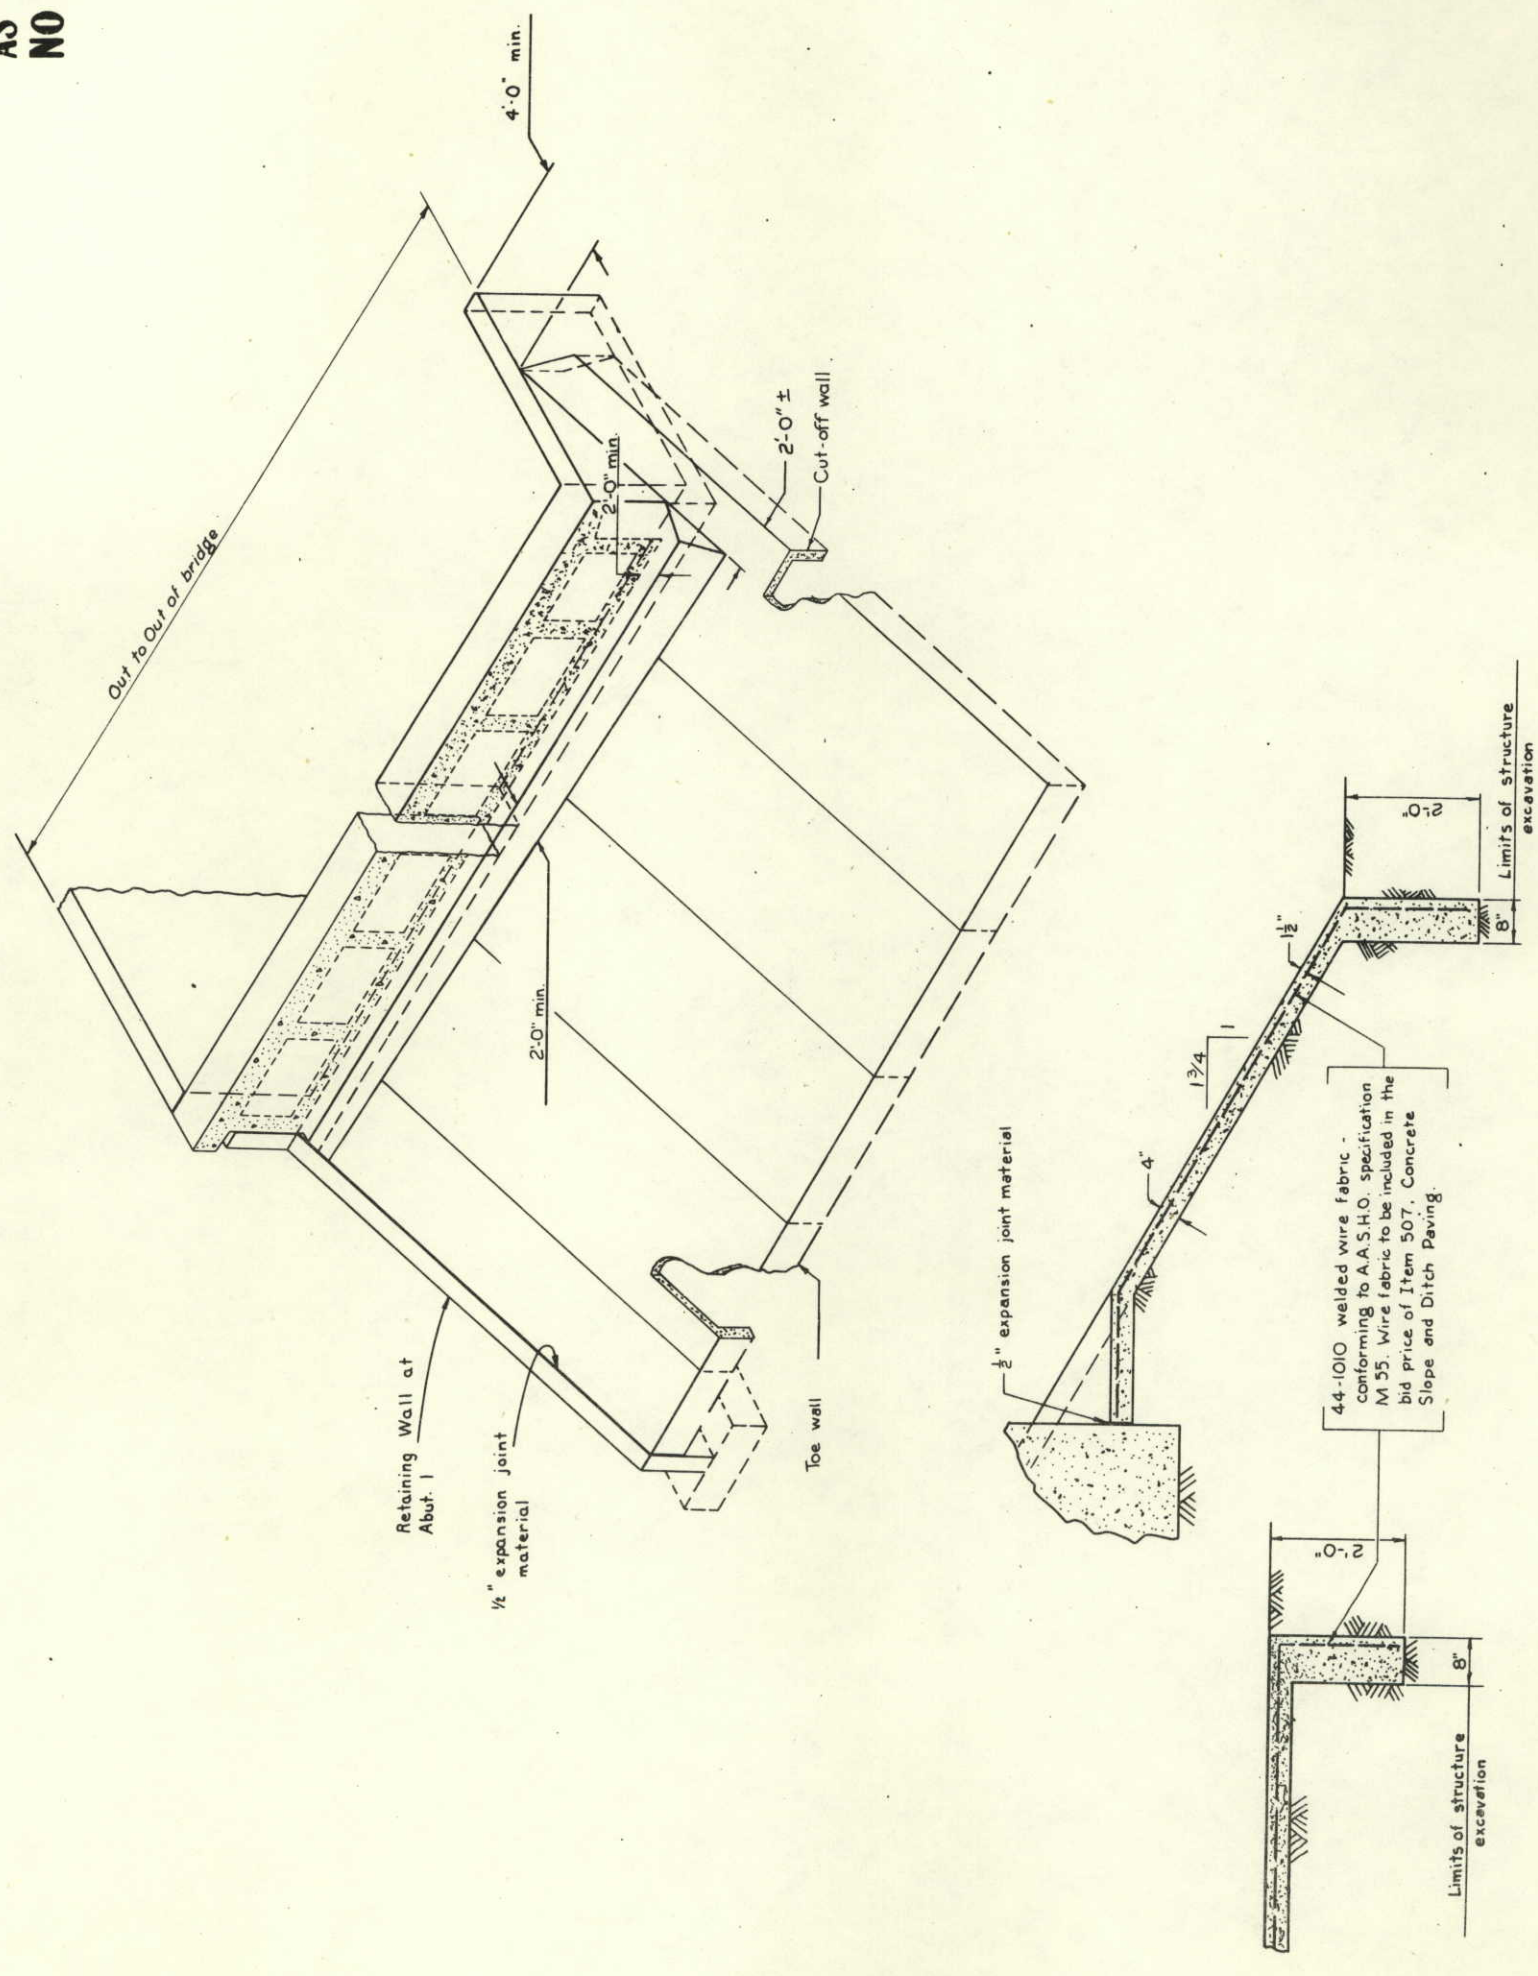


SECTION THRU CUT-OFF WALL

SECTION THRU SLOPE PAVING


DIVISION OF HIGHWAYS	
SLOPE PAVING DETAILS	
Approved:	Designer: R. Struckman
Bridge Engineer	Structure Numbers: C-18-ER
Date:	Detailer: K. Sharpley
DWG. No. B 14 OF 23	

AS CONSTRUCTED
NO REVISIONS DATE
JUNE 3, 1974

FEDERAL ROAD DISTRICT	PROJ. NO.	SHEET NO.	TOTAL SHEETS
VIII	U034-1 (12)	26	110
REVISIONS			

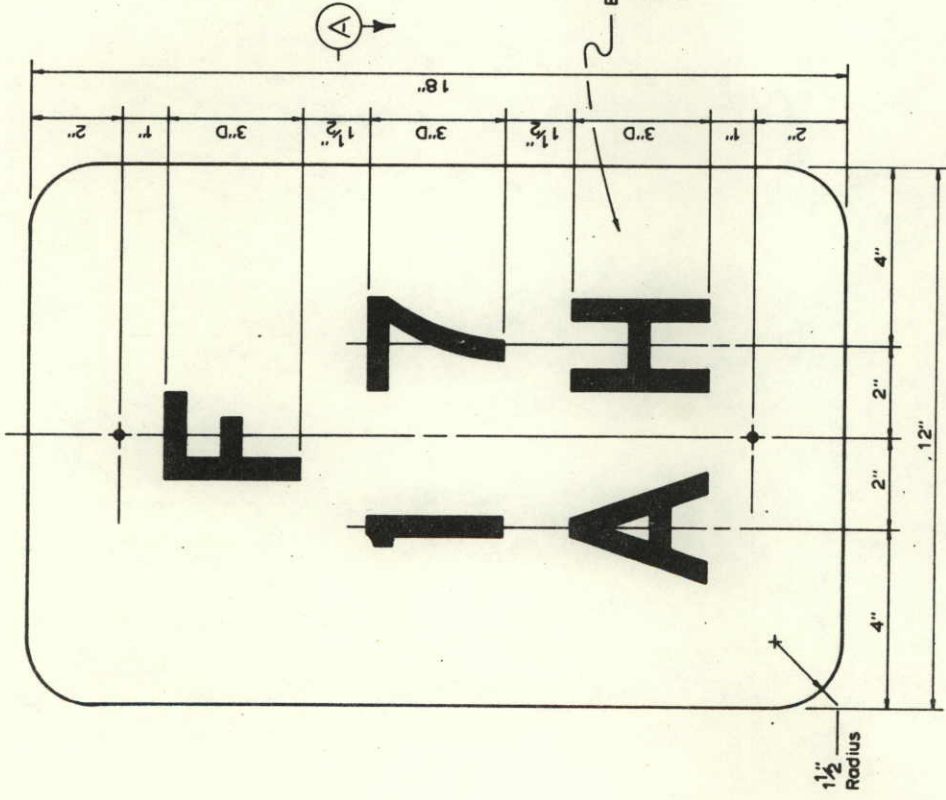


STRUCTURE IDENTIFICATION PANEL
(SAMPLE NUMBERS & LETTERS)

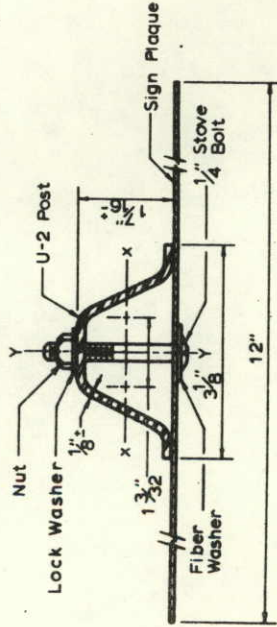


SECTION A


STRUCTURE NUMBER LOCATION
ON PIERS

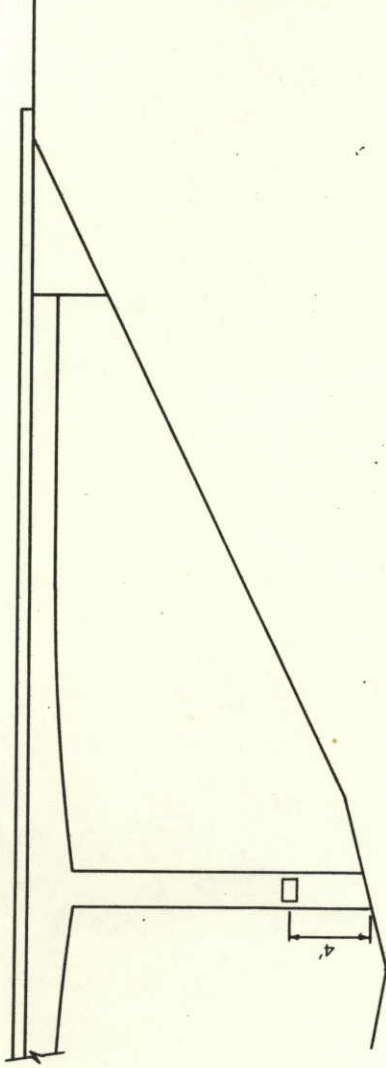

Black letters and
numbers on white
background.

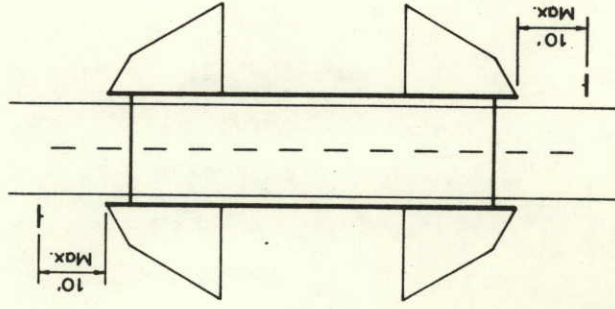

① STANDARD LOCATION DETAIL

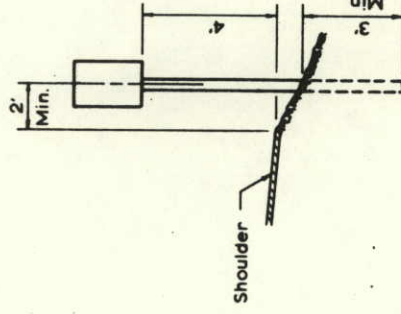

U-2 POST IN GROUND

ALL WORK SHALL BE DONE IN ACCORDANCE WITH THE STANDARD SPECIFICATIONS APPLICABLE TO THE PROJECT.

SIGN PANEL SHALL BE FABRICATED FROM EITHER SHEET STEEL 0.0598 MIN. THICKNESS OR SHEET ALUMINUM 0.080 MIN. THICKNESS.

SIGN PANEL SHALL BE GROUND MOUNTED.

U-2 POST SHALL MEET REQUIREMENTS OF PAR. 4.5 U.S. DEPT. OF COMMERCE, COMMERCIAL STANDARD 184-51. ACCEPTABLE MATERIAL INCLUDES ROLLED RAILROAD RAILS. U-2 POST SHALL WEIGH 2 LBS. PER LINEAL FOOT. EXCEPT THAT A MILL TOLERANCE OF MINUS 3-1/23 OF THE WEIGHT OF ANY GIVEN POST WILL BE ALLOWED. ALTERNATE METAL POST WILL BE ACCEPTABLE IF IT MEETS THE FOLLOWING REQUIREMENTS: AT LEAST 0.200 IN. 3 ABOUT THE X-X AXIS AND AT LEAST 0.250 IN. 3 ABOUT THE Y-Y AXIS.

SIGN PANEL SHALL BE FASTENED DIRECTLY TO THE POST WITH TWO 1/4" GALVANIZED OR CADMIUM PLATED STOVE BOLTS. A PLASTIC FIBER WASHER SHALL BE PLACED BETWEEN THE BOLTS HEAD AND THE FACE OF THE PANEL. A GALVANIZED OR CADMIUM PLATED LOCK WASHER SHALL BE PLACED UNDER THE NUT ON THE BACK OF THE POST. EXPOSED BOLT HEADS AND FIBER WASHERS ON THE FACE OF THE SIGN PANEL SHALL BE PAINTED TO MATCH THE SURROUNDING COLOR.

LETTERS AND NUMBERS SHALL BE SERIES "D". THEY SHALL BE 3" HIGH.

THE CORRECT STRUCTURE NUMBER IS SHOWN ON THE PLANS.

① OMIT STRUCTURE NUMBER STANDARDS WHERE A RAILROAD TRACK CROSSES OVER THE ROADWAY.

STRUCTURE NUMBER STANDARD SHALL NOT BE PAID FOR SEPARATELY BUT INCLUDED IN THE WORK.

IN ADDITION TO THE REQUIREMENTS STATED ABOVE, STRUCTURE NUMBERS FOR HIGHWAYS PASSING UNDER CROSSROADS ARE TO BE PLACED AT THE FOLLOWING POINTS:

(A) FOR STRUCTURES OF THREE OR MORE SPANS, THE STRUCTURE NUMBER SHALL BE STENCILED FACING TRAFFIC, ON THE OUTSIDE FACE OF THE END COLUMN OF THE RIGHT HAND PIER.

(B) FOR TWO SPAN STRUCTURES, THE STRUCTURE NUMBER SHALL BE STENCILED FACING TRAFFIC, ON THE OUTSIDE FACE OF EACH END COLUMN OF THE CENTER PIER.

DIVISION OF HIGHWAYS

STRUCTURE NUMBER
STANDARD

Designer R. Struckman	Structure Number	C-18-ER
Detailer K. Sharpley	Number	
Drawing Number B 16	of	23 Drawings

JUNE 3, 1974

REVISIONS

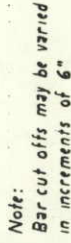


TABLE OF REINFORCING STEEL DIMENSIONS AND DATA

The following table shows the minimum lap for common bar sizes

[illegible]

PILE FOOTING SECTION H=6'-0" THRU H=16'-0"

TYPICAL FOOTING SECTION
See other sections for additional reinforcing

Note: Reinforcement detailed in pile footing section to be placed in addition to that shown for typical footing. All piles are HP 10x42.


DIVISION OF HIGHWAYS

RETAINING WALL $H = 6'-0"$ TO $24'-0"$

Designer <i>J. Graving</i>	Structure Numbers	of 23 Drawings
Detailer <i>R. Seylhouwer</i>		




AS CONSTRUCTED
NO REVISIONS
DATE
JUNE 3, 1974

FEDERAL ROAD DISTRICT NO.	PROJ. NO.	SHEET NO.	TOTAL SHEETS
VIII	U 034-1(12)	29	110
REVISIONS			

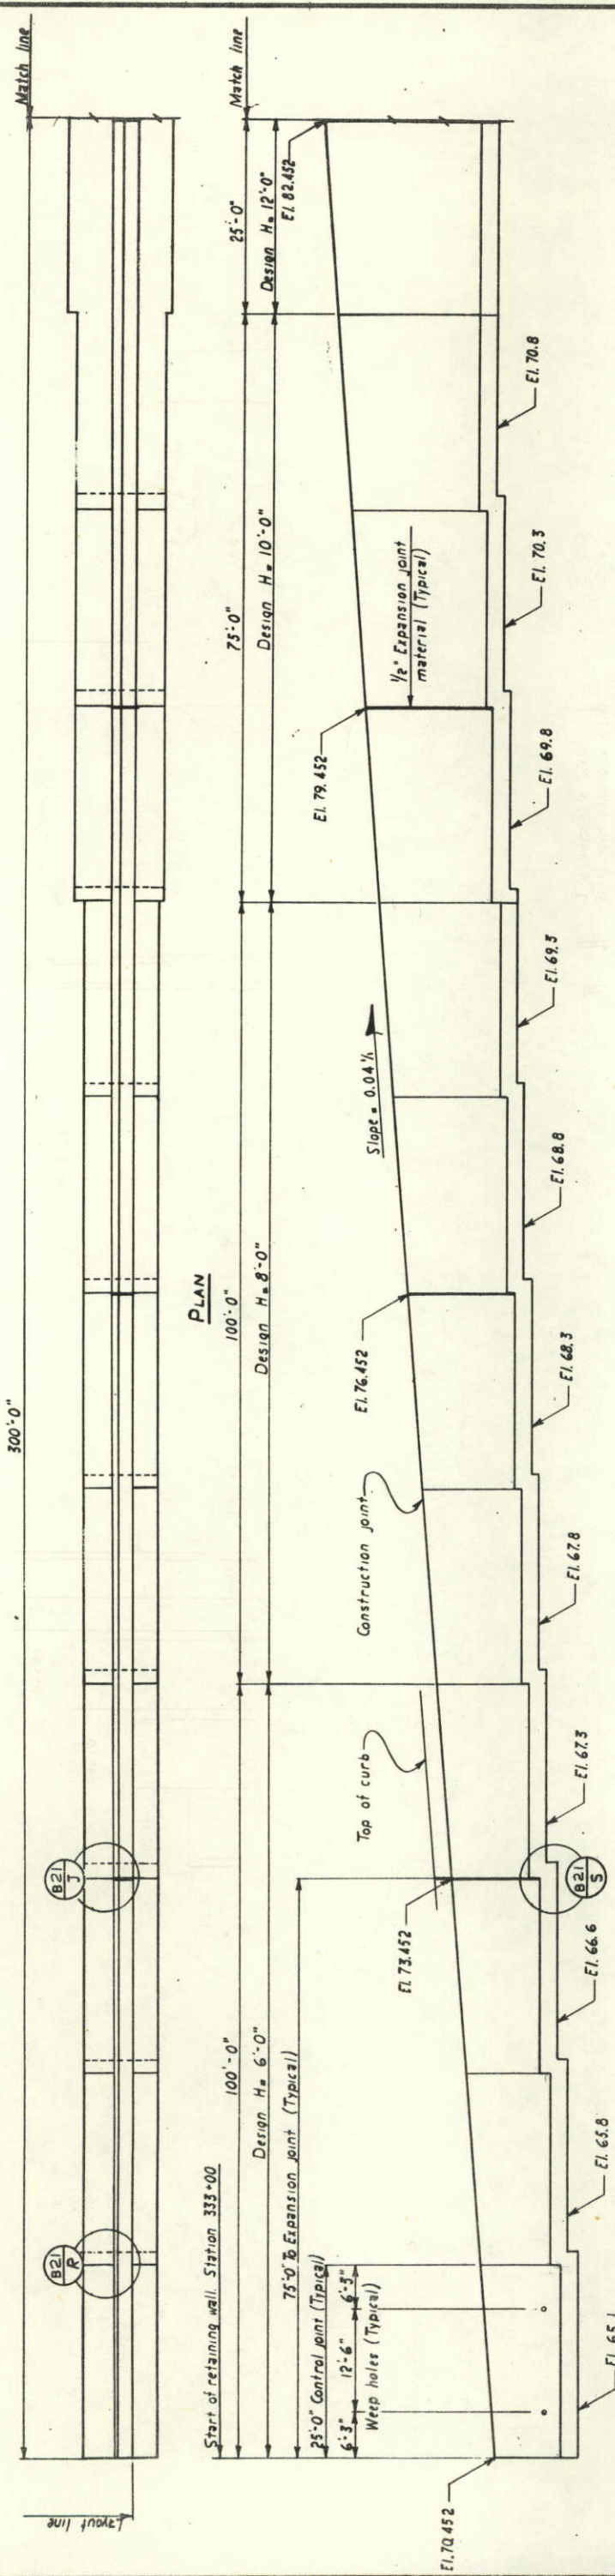

Station	Top of curb Elevation
333+00	71.66
333+75	71.66
334+50	77.66
335+25	80.66
336+00	83.66
336+75	86.66
337+50	89.66
338+00	91.66

Notes:
For typical section thru retaining wall see DWG. No. B. 19
For additional retaining wall details see DWG. No. B. 21
Base elevation 4700.00
Piles are not shown. For details see DWG. No. B. 18
Location of construction joints in footing are optional and shall be approved by the Engineer

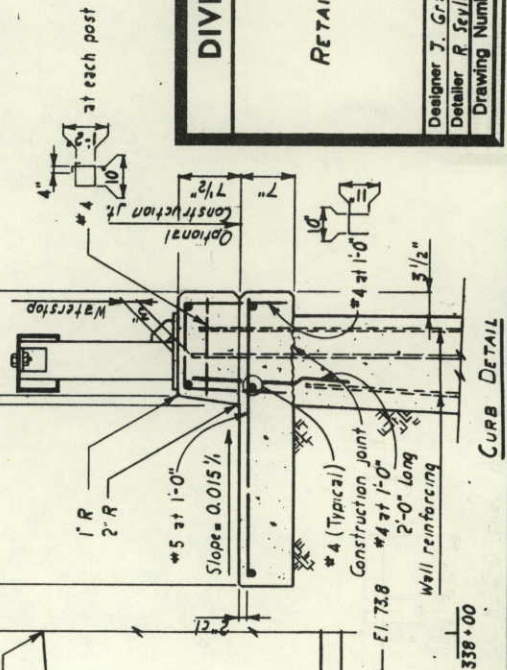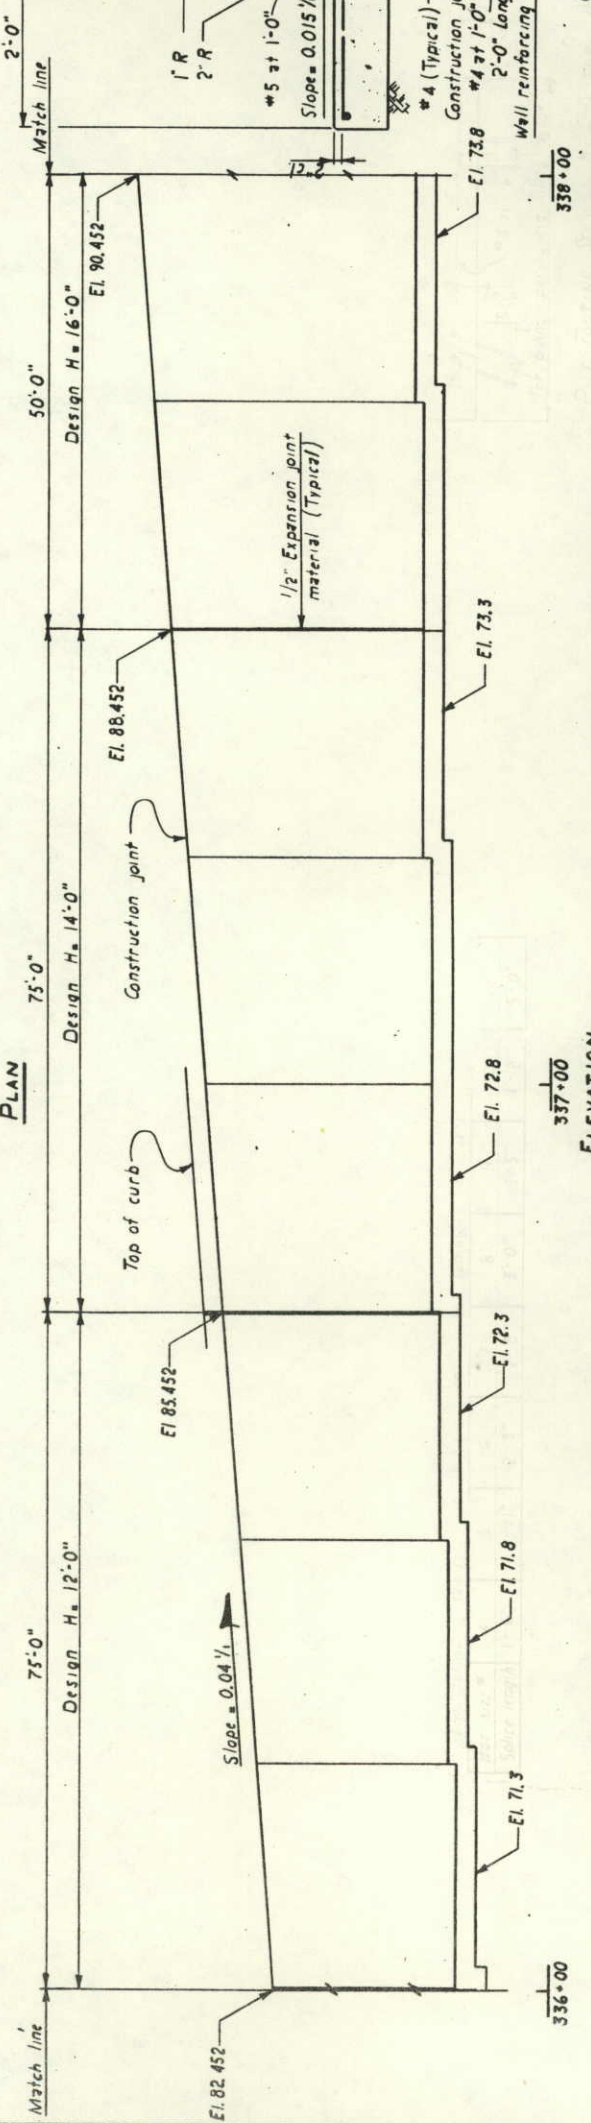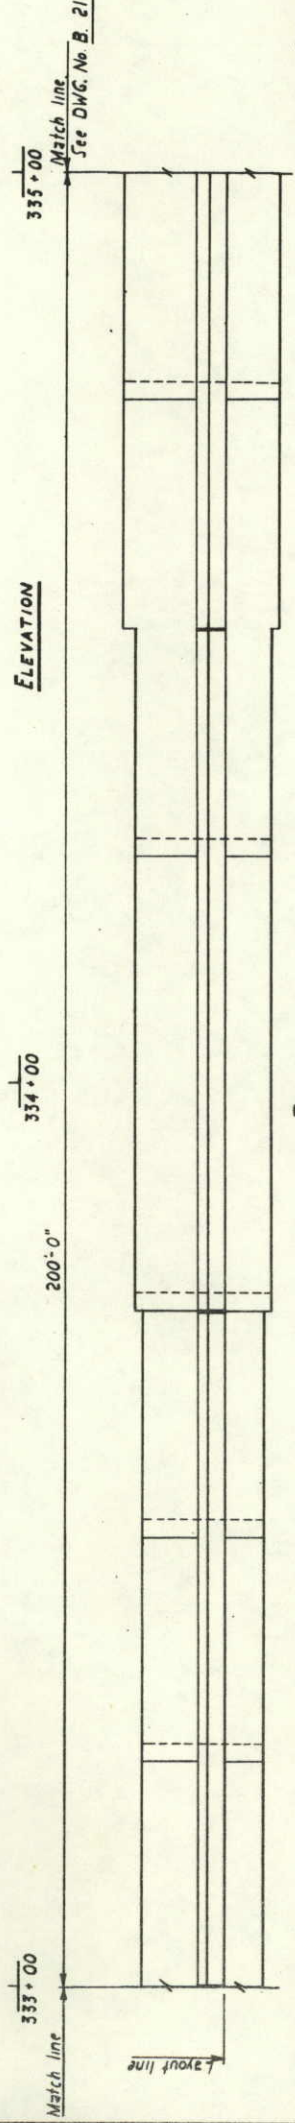

DIVISION OF HIGHWAYS

RETAINING WALL DETAILS


Designer J. Gray	Structure Number	of 23	Drawings
Detailer R. Seybolder			
Drawing Number B. 20			

AS CONSTRUCTED
NO REVISIONS DATE JUNE 3, 1974


FEDERAL ROAD DISTRICT	PROJ. NO.	SHEET NO.	TOTAL SHEETS
VIII	U 034-1(12)	30	110

REVISIONS


Notes:
For typical section thru retaining wall see DWG. No. B 19
For additional retaining wall details see DWG. No. B 19 & 23
For curb details see DWG. No. B 20
Base elevation 4700.00
Piles are not shown. For details see DWG. No. B 18 & 19

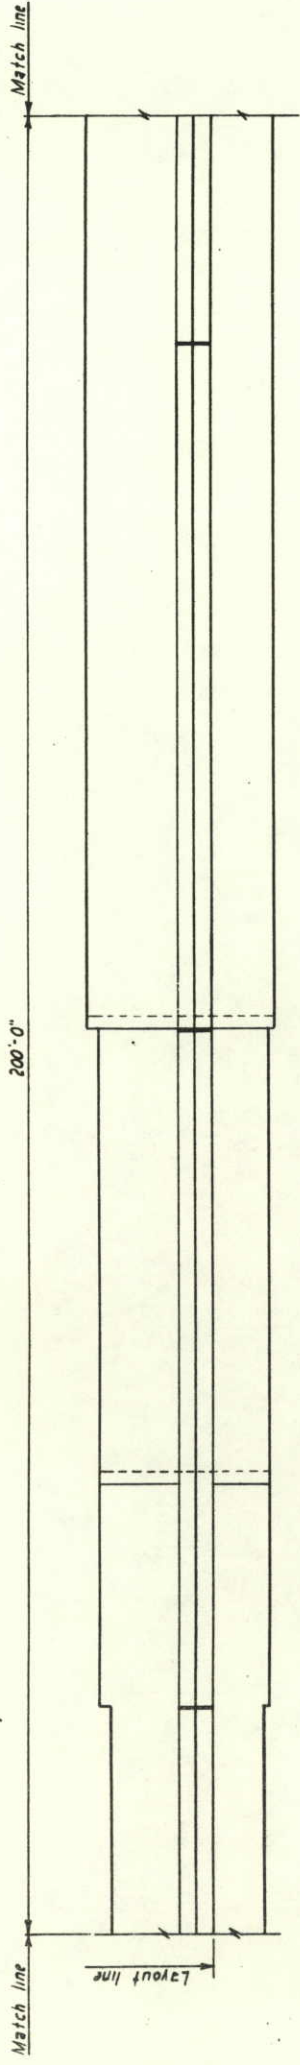


PLAN

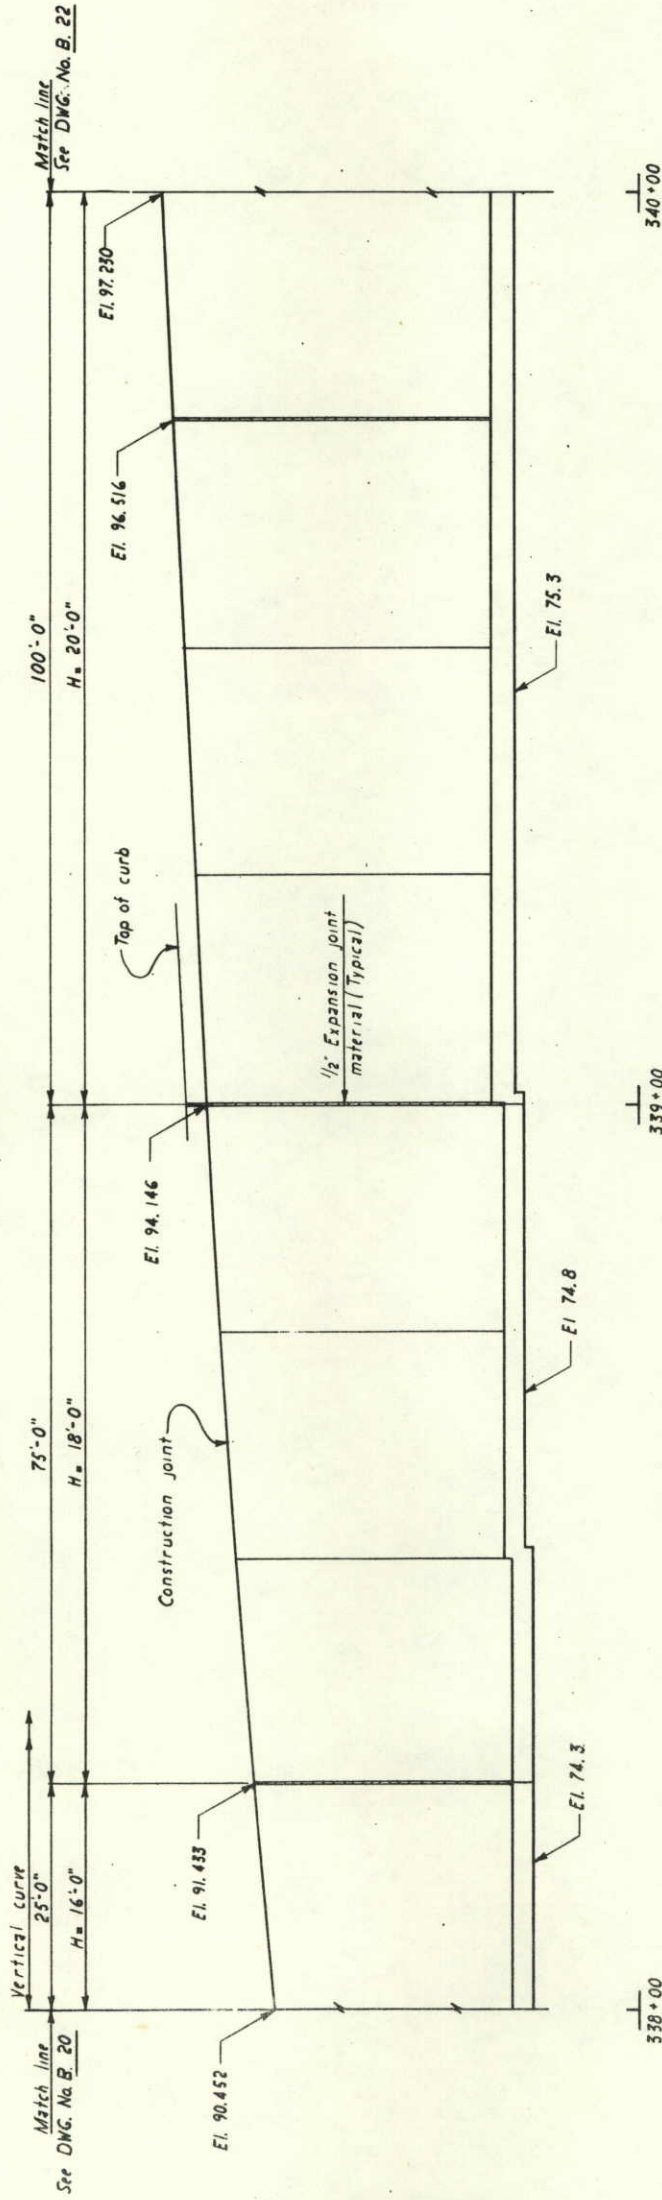

ELEVATION

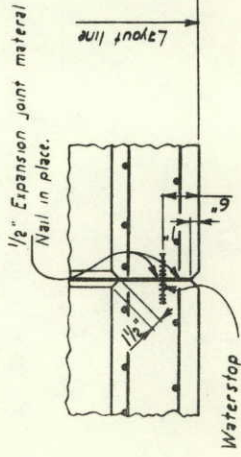


ENLARGED DETAIL (B20)

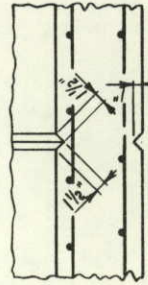

ENLARGED DETAIL (B20)


- H 6 = 3/8"
- H 8 = 1/2"
- H 10 = 5/8"
- H 12 = 3/4"
- H 14 = 1"
- H 16 = 1 1/4"
- H 18 = 1 1/2"
- H 20 = 1 3/4"
- H 22 = 2"
- H 24 = 2 1/4"

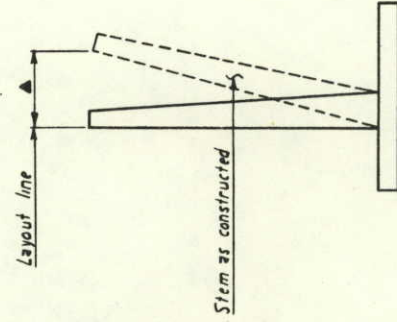

WATERSTOP DETAIL

Note:
Waterstop to have 5 or more pairs of raised ribs each half of waterstop. Height of ribs to be 3/32" minimum. Holes will be permitted in the outer 1/2" of the web for wire, rings, ect. Tie web to #4 bar at 12" maximum spacing to support the waterstop in proper position during concrete placement. Alternative details may be submitted for approval by the engineer.

RETAINING WALL OFFSETS

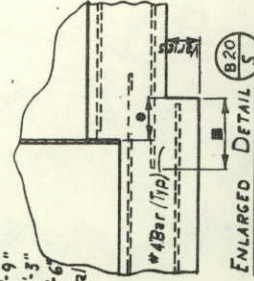

ENLARGED DETAIL (B20)



Notes:
• 1'-3" Typical extent Stations
333+75 - 2'-3", 335+25 - 1'-9"
336+50 - 3'-3", 337+00 - 2'-3"
338+00 - 2'-3", 338+50 - 1'-6"
Extend all longitudinal reinforcing in the footing the minimum splice length given whenever possible

Station	Top of retaining wall Elevation	Top of curb Elevation
338+00	90.452	91.660
338+10	90.849	92.057
338+20	91.240	92.448
338+30	91.624	92.833
338+40	92.003	93.211
338+50	92.375	93.584
338+60	92.742	93.950
338+70	93.102	94.310
338+80	93.456	94.665
338+90	93.804	95.013
339+00	94.146	95.355
339+10	94.482	95.690
339+20	94.812	96.020
339+30	95.156	96.344
339+40	95.453	96.661
339+50	95.764	96.973
339+60	96.070	97.278
339+70	96.369	97.577
339+80	96.662	97.870
339+90	96.949	98.157
340+00	97.230	98.438

DIVISION OF HIGHWAYS

RETAINING WALL DETAILS

Designer J. Gray	Structure Numbers	of 23	Drawings
Detailer R. S. Hower			

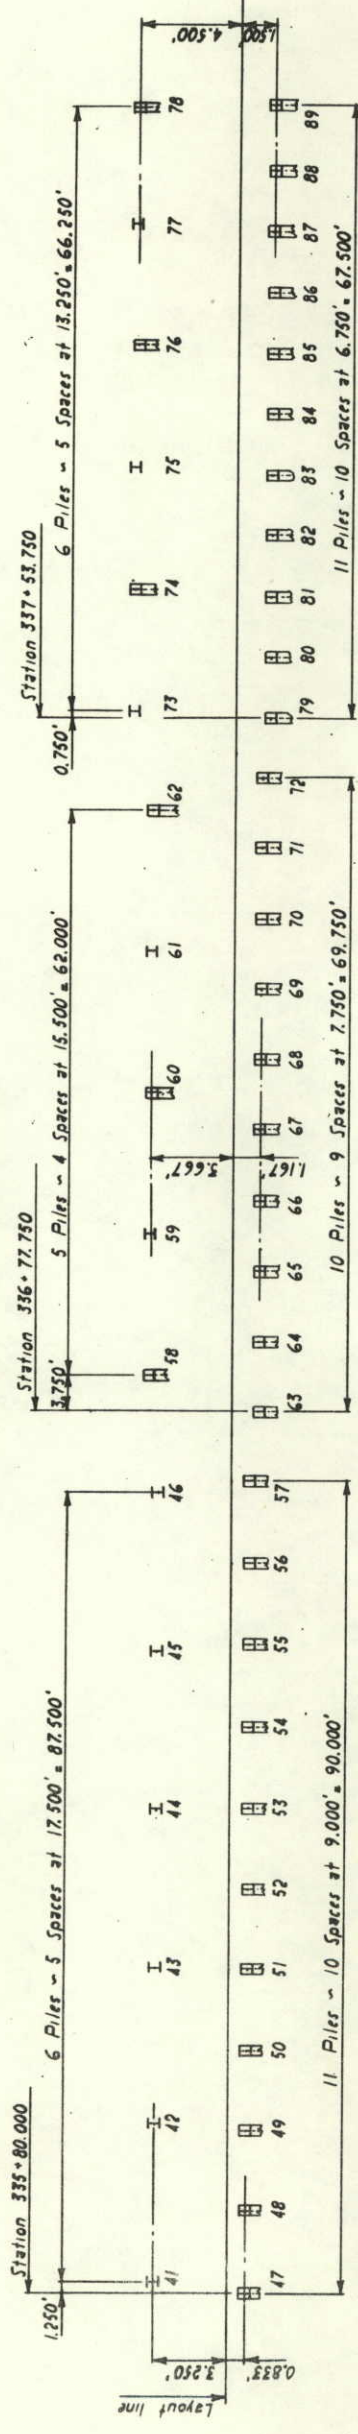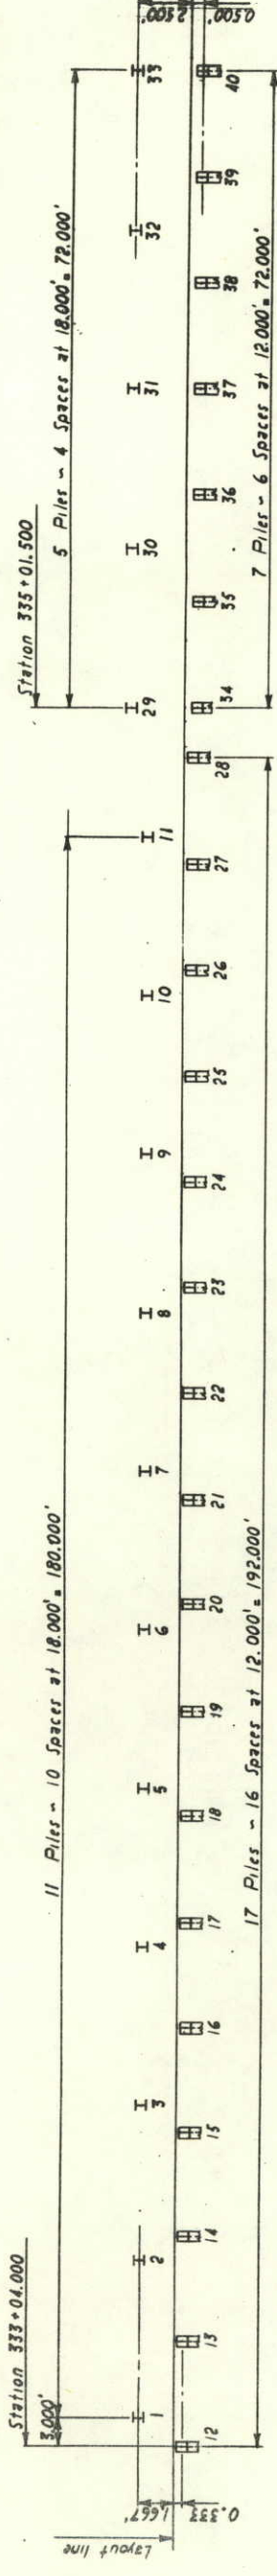[illegible]

PILING CUTOFF ELEVATIONS		
Number	Elevation	
1, 2, 12, 13	4765.6	61, 62, 70, 71, 72
3, 14, 15	4766.3	73, 74, 79, 80, 81, 82
4, 16, 17, 18	4767.1	75, 76, 83, 84, 85, 86
5, 6, 19, 20	4767.8	77, 78, 87, 88, 89, 90
7, 21, 22	4768.3	91, 92, 97, 98, 102, 103, 104, 105, 106
8, 9, 23, 24	4768.8	93, 94, 95, 96, 99, 100
10, 25, 26	4769.3	101, 107, 108, 109, 110, 111
11, 27, 28	4769.8	112, 113, 114
29, 30, 34, 35, 36	4770.3	115 thru 155
31, 37, 38	4770.8	
32, 33, 39, 40	4771.3	
41, 42, 47, 48, 49	4771.8	
43, 50, 51, 52	4772.3	
44, 45, 53, 54, 55	4772.8	
46, 56, 57	4772.8	
58, 59, 60, 63, 64	4773.3	
65, 66, 67, 68, 69	4773.8	

AVERAGE PILING TIP ELEVATIONS

PILES 1 THRU 28 - 4757.97
PILES 29 THRU 40 - 4760.19
PILES 41 THRU 57 - 4761.53
PILES 58 THRU 72 - 4762.89
PILES 73 THRU 89 - 4764.33
PILES 90 THRU 114 - 4765.34
PILES 115 THRU 155 - 4769.92

DIVISION OF HIGHWAYS

PILING LAYOUT ~ RETAINING WALL

Designer <i>J. Grayna</i>	Structure	
Detailer <i>R. Seyhauer</i>	Numbers	
Drawing Number B 18		of 23 Drawings

PILING LAYOUT ~ RETAINING WALL


Note: For additional piling layout see Drawing No B22 & B23

I Piles to be vertical

Piles to be battered 3:1

To locate layout line see Drawing No. B. 2 & B. 19.
All piles are HP 10x42 with maximum pile load of 46 tons.
Pile dimensions shown are at the bottom of the concrete.

bu07 "0-2 ~ 9 #

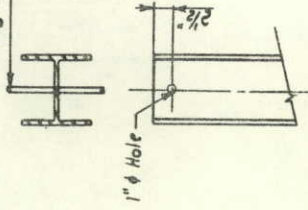

VERTICAL PILE DETAIL

STANDARD M-604-E

(OCTOBER 11, 1967)

AS CONSTRUCTED
NO REVISIONS

DATE
JUNE 3, 1974

FEDERAL ROAD DISTRICT NO.	DIVISION	PROJ. NO.	SHEET NO.	TOTAL SHEETS
332	COLORADO	U 034-1(12)	34	110

REVISIONS	
(R-1)	7-24-68 Dept. Name.
(R-2)	4-20-71 Concrete in Gen. Note.
(R-3)	11-2-72 Special this Project Only

MR.H.	MR.H.	C.K.M.

QUANTITIES FOR CONCRETE MANHOLE BOX BASE

MARK	SIZE	TYPE	TYPE I	TYPE II	TYPE III	42"	60"	72"	84"	96"	FORMULAS
401	4	II	17	20	22	6-7"	6-7"	6-7"	6-7"	6-7"	Number Bars Required = $(\frac{12 + L.D. + 2W}{6}) + 6$
402	4	III	0	0	0	0	0	0	0	0	
501	5	I	17	17	17	10-4"	10-4"	10-4"	10-4"	10-4"	Bar Length = L.D. + 2W + 2'-9"
502	5	I	15	23	27	5-0"	5-0"	5-0"	5-0"	5-0"	Bar Length = 24" + L.D. + 2W
503	5	I	30	30	30	5-0"	5-0"	5-0"	5-0"	5-0"	Number Bars Req'd. = $(\frac{17 + L.D. + 2W}{5}) + (\frac{L.D. - 36}{12}) + 3$
1101	11	I	4	4	4	8-10"	8-10"	8-10"	8-10"	8-10"	Bar Length = 30" + L.D. + 2W
1102	11	I	2	2	2	2'-0"	2'-0"	2'-0"	2'-0"	2'-0"	Bar Length = 24" + L.D. + 2W
1103	11	I	2	2	2	3'-0"	3'-0"	3'-0"	3'-0"	3'-0"	
1104	11	I	3	3	3	5'-0"	5'-0"	5'-0"	5'-0"	5'-0"	
REINFORCING STEEL - Pounds - Total			695.4	826.3	949.1	1064.8	1185.3	1295.1			
CONCRETE - Cubic Yards - Total			4.2	5.4	6.6	8.0	9.5	11.1			

NOTE: Quantities are based on same size pipe entrance to and exit from base and a 4 ft. manhole entrance into top slab of base.

GENERAL NOTES (R-2)

All work shall be done in accordance with the Standard Specifications applicable to the project.

Since all pipe entries into the base are variable, the dimensions shown are typical. Actual dimensions and quantities for concrete and reinforcement shall be as required in the work.

Design is based on straight runs of conduit or change in direction under 45°.

All bars shall be a minimum 2" clear.

Precast Manholes shall conform to ASTM Designation C 478.

Cast in place Manholes shall be Class A, B or D concrete.

The following alternate materials for Manholes may be used when design details for construction are included in the plans:



MATERIAL	CONFORMANCE-DESIGNATION
Clay or Shale Brick	AASHO M 91
Concrete Brick	ASTM C 35, Grade P-I or P-II
Concrete Masonry Block	ASTM C 139
Corrugated Steel Unit	AASHO M 36

All pipe entries into the base of Manhole shall be connected by open gutter adjusted for pipe size, shape, slope and direction of flow.



Alternate designs will be permitted after approval by the Division

Steps or Ladder will be required when Manhole depth exceeds 3'-6".

NOTE: Manhole Ring and Cover shall be dipped or painted with Asphalite or Coal Tar and Oil.

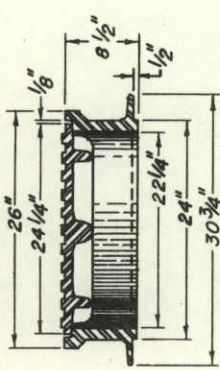
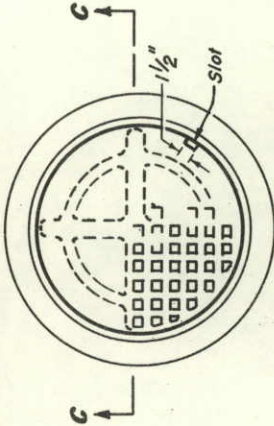


MANHOLE RING AND COVER

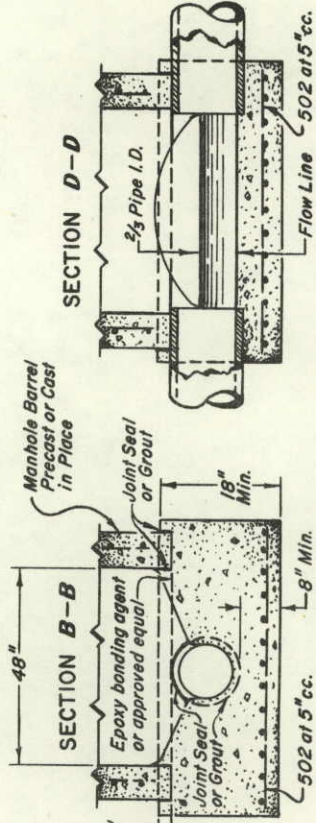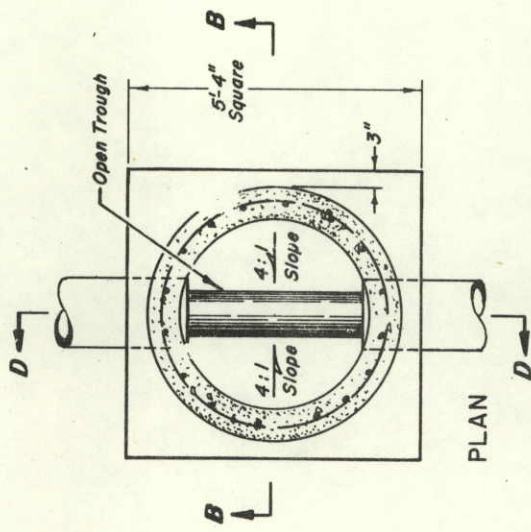


CONCRETE SLAB BASE

(Typical for Conduit Smaller than 36" I.D.)

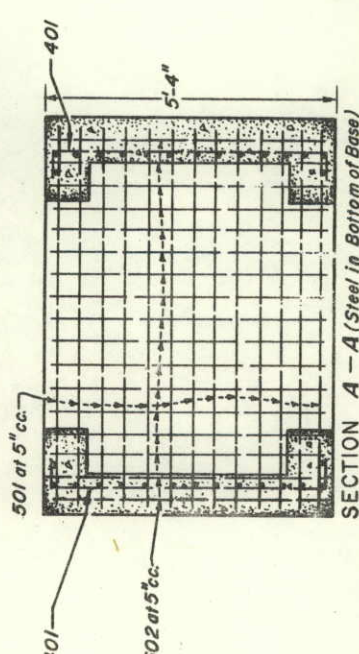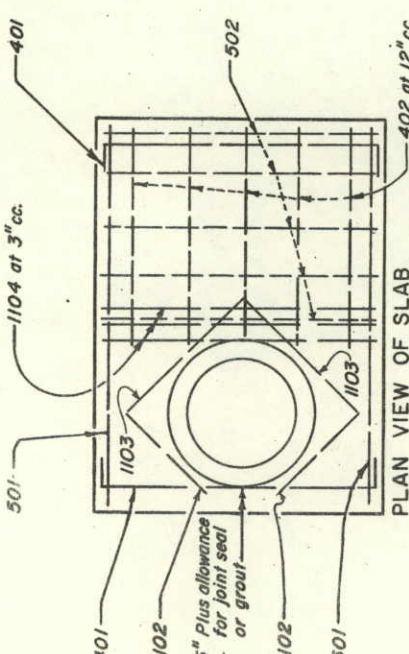

SECTION A - A (Steel in Bottom of Base)

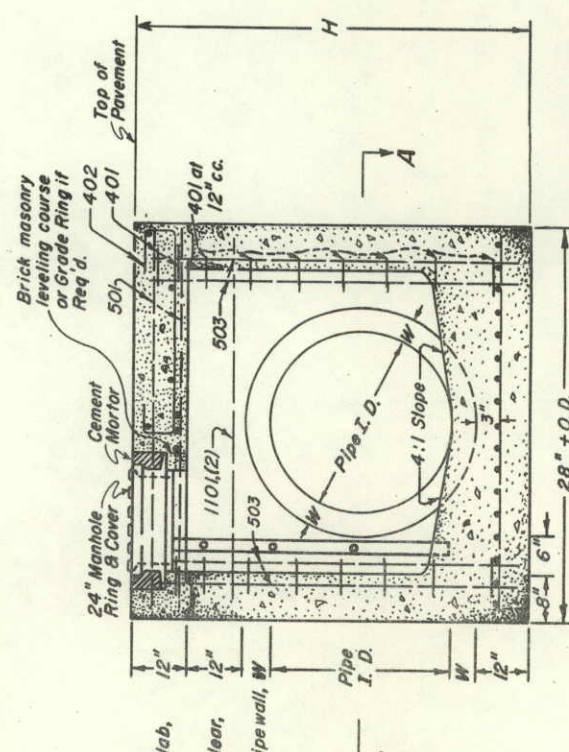


CONCRETE MANHOLE AND BOX BASE

(Typical for Conduit 36" I.D. and Larger.)

DEPARTMENT OF HIGHWAYS
STATE OF COLORADO
DIVISION OF HIGHWAYS
MANHOLES


Designed by M.R.H. Approved by R.S.B.
Made by J.R.B. Staff Design Engineer
Checked by R.S.M. Date: October 11, 1967

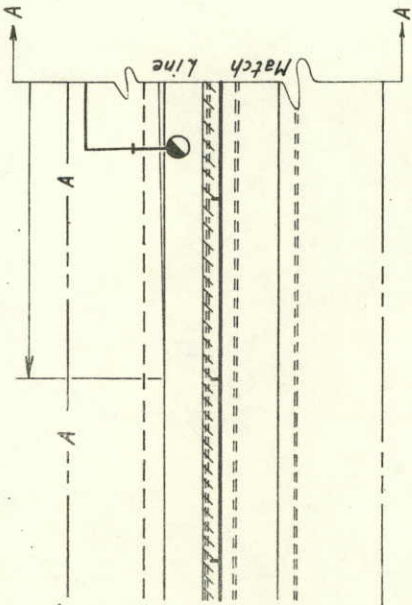

528+ to 532+ - Reg'd Temp.
Median Crossover.
Remove Temp. Median Crossover.
330+ - Reg'd Identification
Sign Rt. (State Forces).
330+ - Reg'd Approach
to Project.
331+ - Reg'd Embankment
Protector Type 5 Rt.
Note: Power Line Owned by
Home Light Power Co.

333+ to 342+ - Reg'd
Conc. Retaining Wall
Rt. (Details on
Sheet Nos. 27-33).

$\Delta = 10^{\circ}00'00''$ Lt.
 $19^{\circ}24'13''$
 $\Delta = 5^{\circ}30'00''$
 $\Delta = 3^{\circ}00'00''$
 $T_c = 91.74'$
 $L_c = 183.33'$
 $R_c = 1909.86'$
 $PL = 9+26.51$
 $44' LT. 512 334+26.51$
 $CS = 10+17.71$
 $ST = 11+67.71$
 $S = 80^{\circ}35'00'' W$

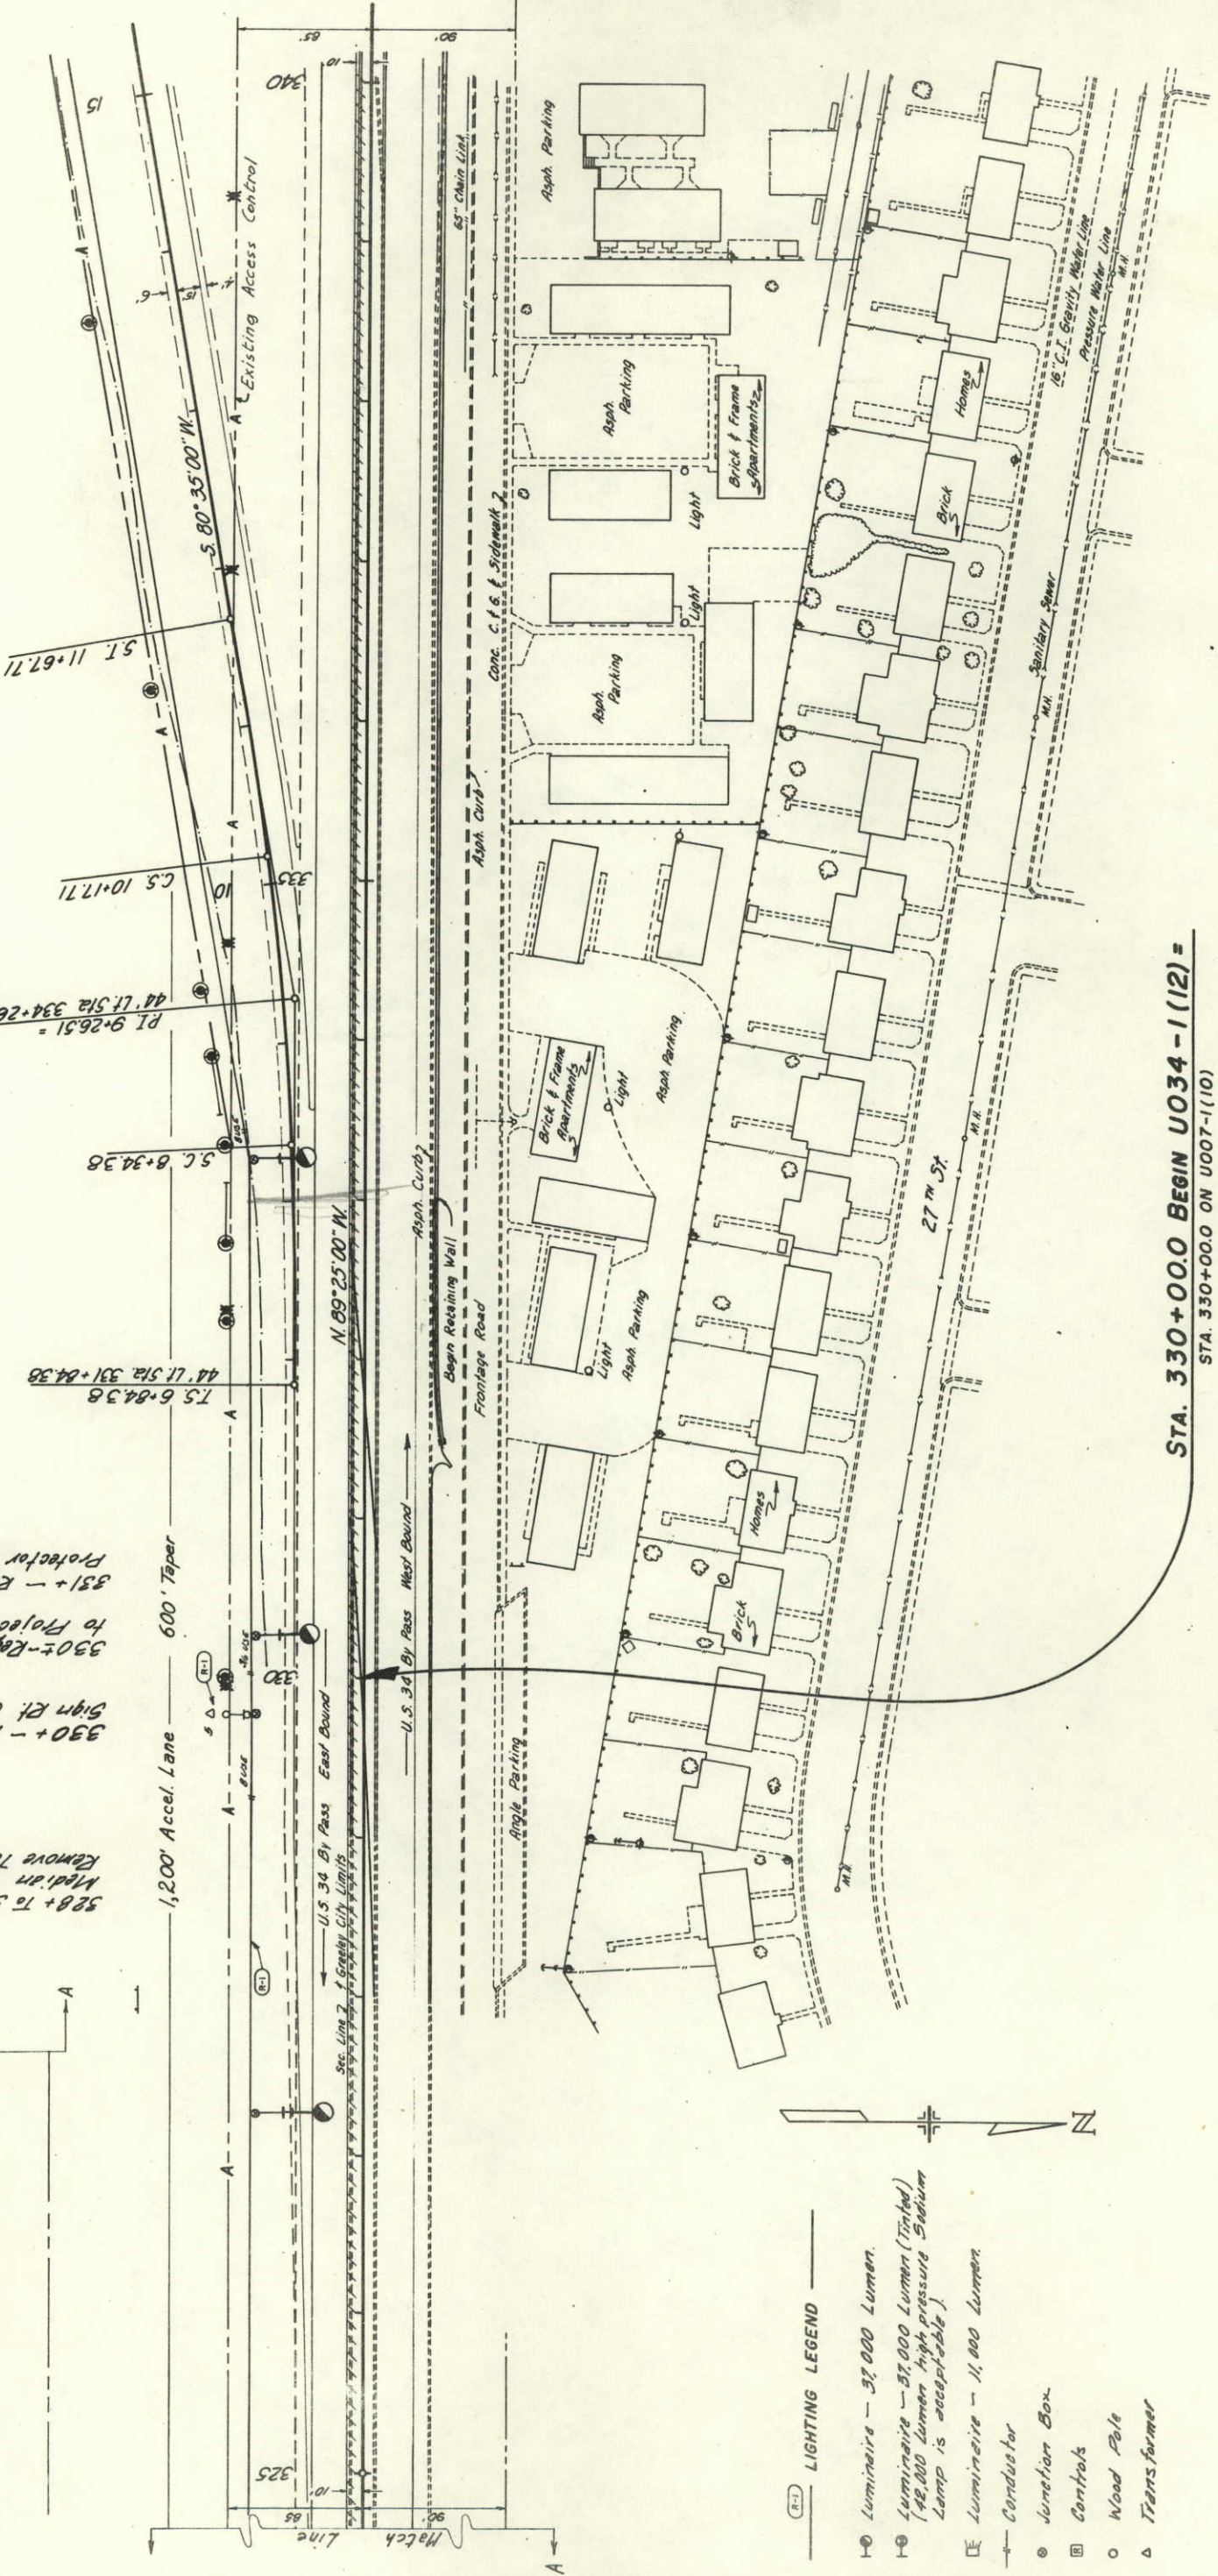

- LIGHTING LEGEND**
- Luminaire - 37,000 Lumen
 - Luminaire - 37,000 Lumen (Tilted)
(48,000 Lumen High Pressure Sodium
Lamp is acceptable)
 - Luminaire - 11,000 Lumen
 - Conductor
 - Junction Box
 - Controls
 - Wood Pole
 - △ Transformer


STA. 330+00.0 BEGIN U034-1(12) =
STA. 330+00.0 ON U007-1(10)

FEDERAL ROAD DISTRICT	PROJ. NO.	SHEET NO.	TOTAL SHEETS
U034-1(12)	0034-1(12)	35	110

AS CONSTRUCTED
NO REVISIONS
DATE JUNE 9, 1974
Shopping Center Under Construction

[illegible]

All Main Lane Reversing Curves
 $\Delta = 1^{\circ} 41' 33.5''$

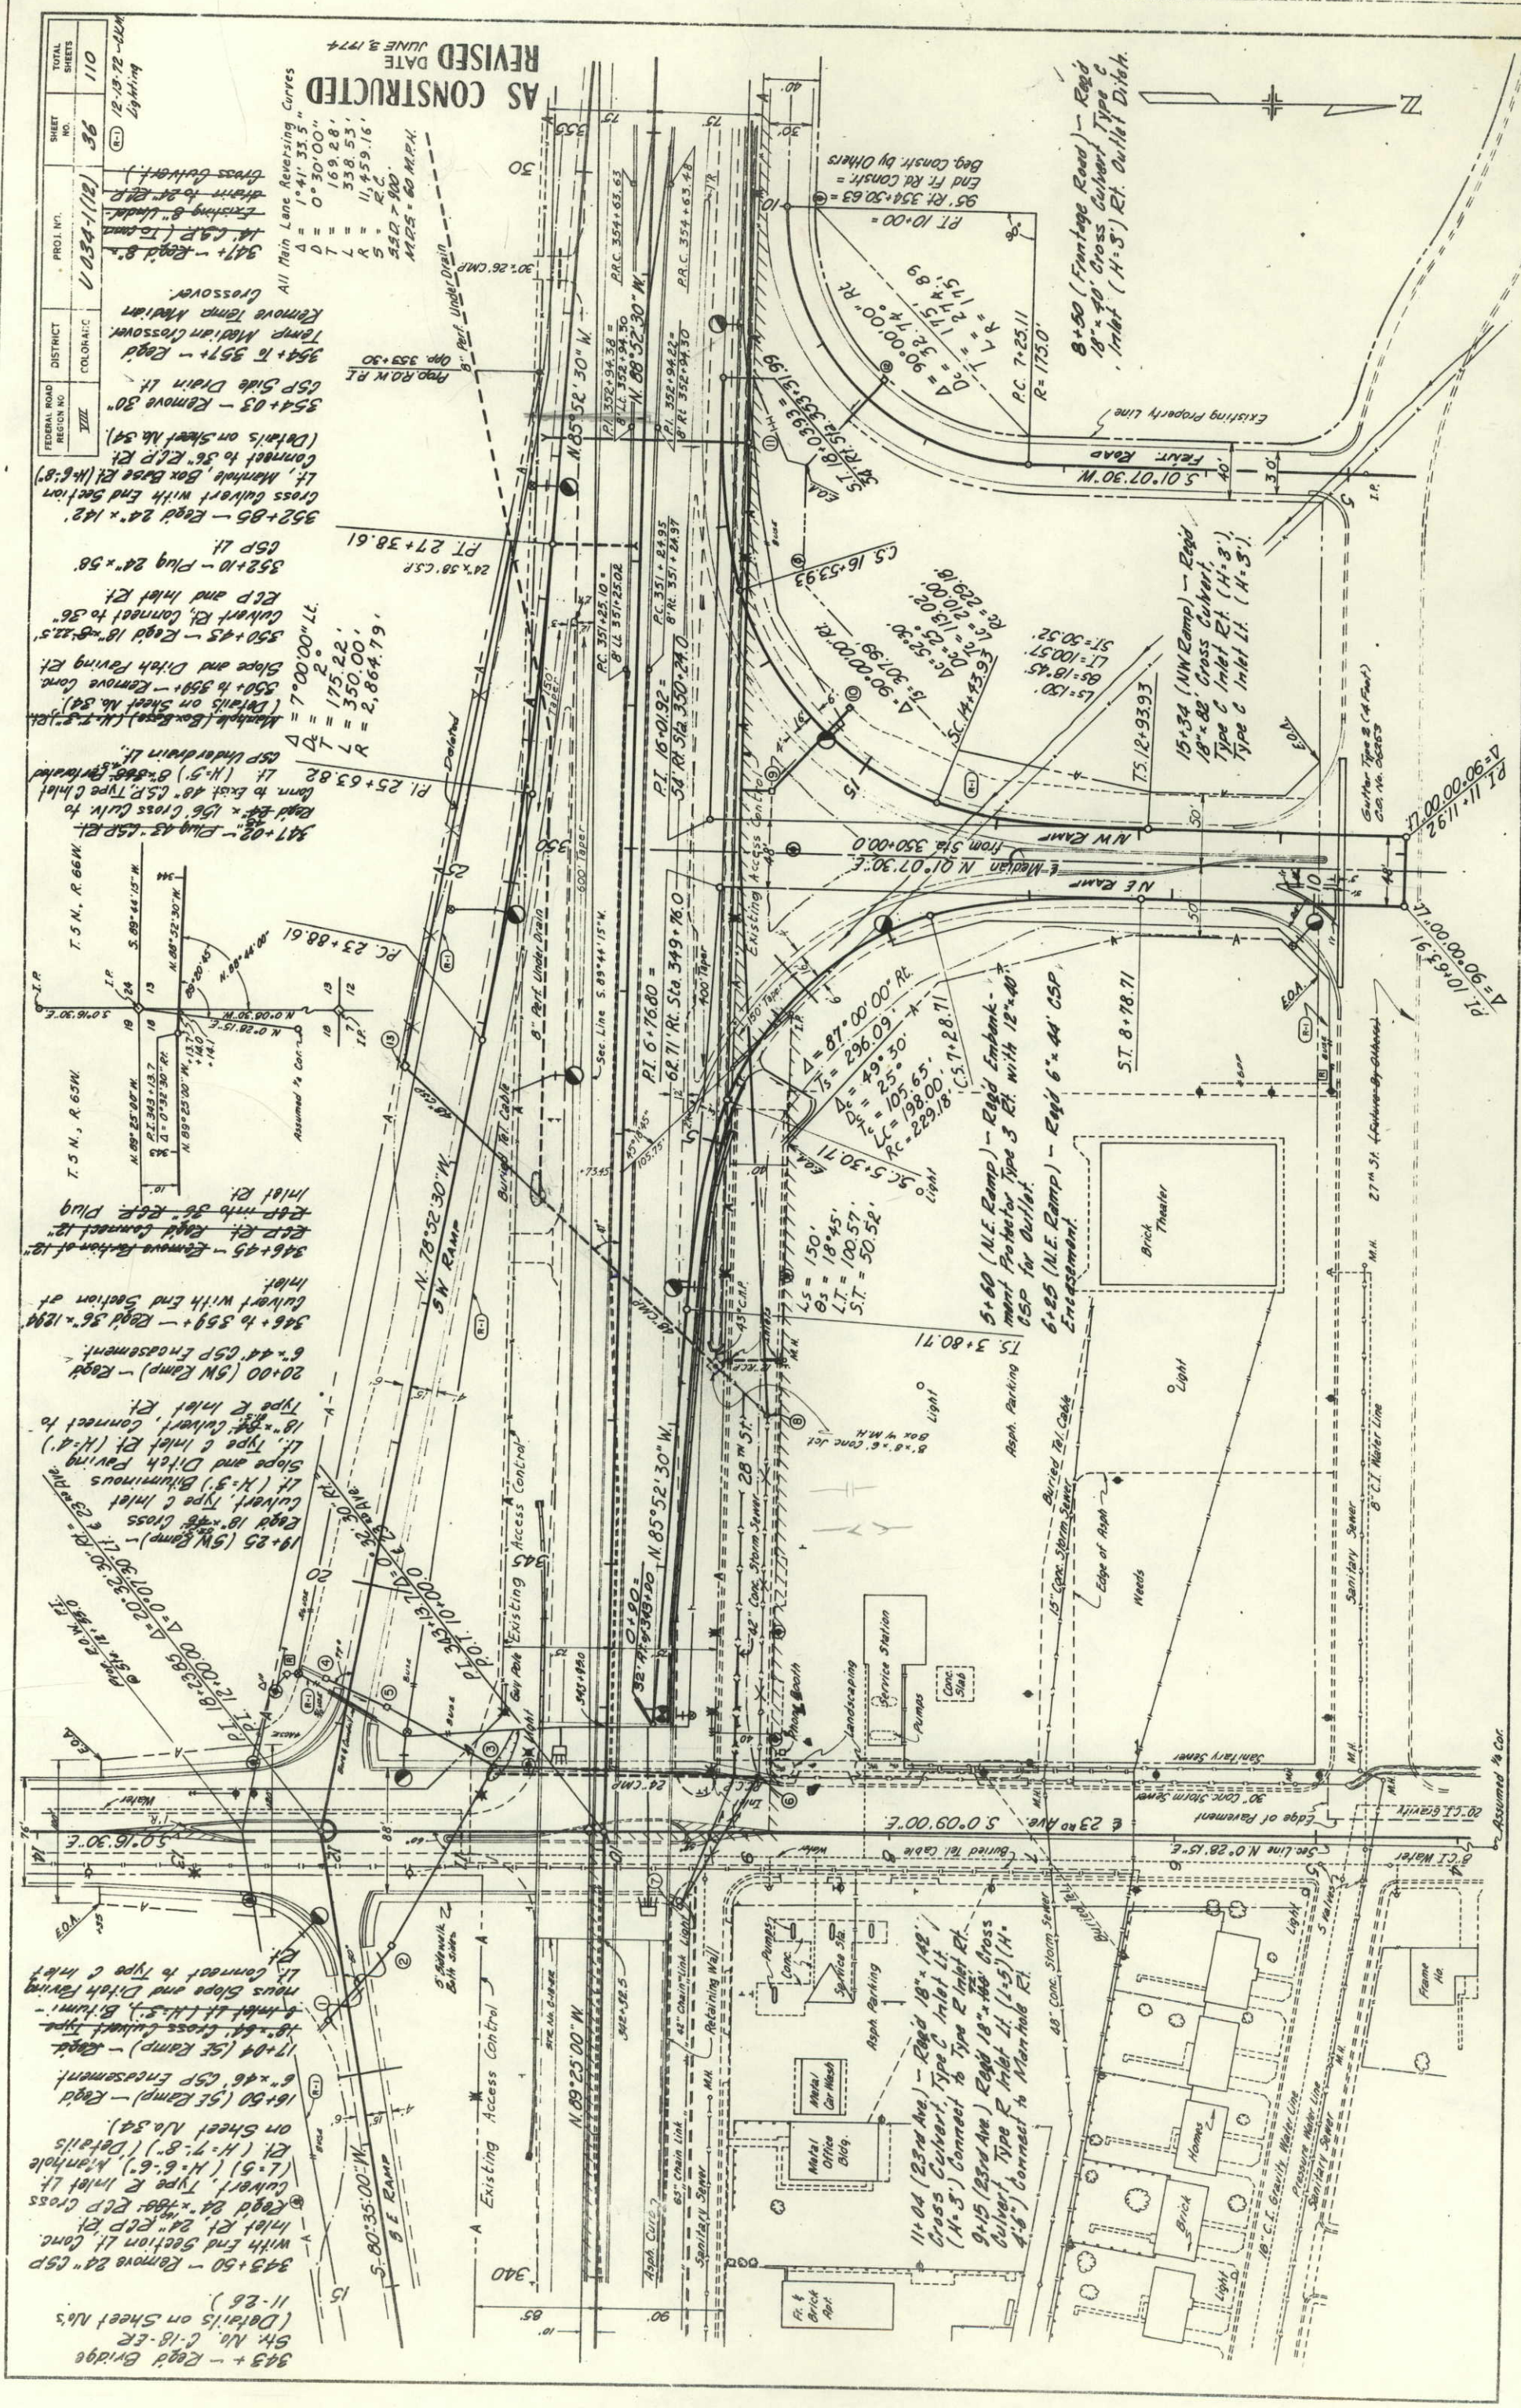

(R-1) 12-13-72 ~ C.K.M., Lighting

DATE JUNE 3, 1974

