

STD. ROAD DIST. NO.	STATE	PROJ. NO.	SHEET NO.	TOTAL SHEETS
3	COLO.	WPSS 401-B	1	

INDEX OF SHEETS

Sheet No.	Title Sheet
1	Typical Section of Improvement and Summary of Quantities
2	Tabulation of Structures and Selected Material
3	General Layout and Summary of Quantities Bridge D-15-N
4	Details of Superstructure
5	Details of Abutment #1
6	Details of Abutment #2
7	General Layout and Summary of Quantities Bridge D-15-M
8	Details of Superstructure
9	Details of Abutments nos. 1 & 2
10	Standard Temporary Detour Structure M-100-B
11	Standard Concrete Box Culverts M-103-D
12	Standard Headwalls for C.M.P. Culverts M-102-E
13	Standard Wire Cable and Metal Plate Guard Fence M-20-G
14	Standard Wire Fence (Tr-Wood Posts) and Marker Posts M-24-F
15	Standard Structure Number Lettering M-10-A
16	Standard Methods for Superelevation and Widening of Curves
17	Typical Side Approach Roads and Roadway Construction Traffic Signs
18	Plan & Profile
19-23	Plan & Profile
24-100	Cross Sections

COLORADO

STATE HIGHWAY DEPARTMENT


PLAN AND PROFILE OF PROPOSED

U.S. WORKS PROGRAM HIGHWAY PROJECT W.P.S.S. NO. 401-B.

STATE HIGHWAY NO. 66.

BOULDER COUNTY

SCALES OF ORIGINAL TRACINGS
ON PLAN, 1 IN. = 100 FT.
ON PROFILE, 1 IN. = 100 FT. HORIZONTAL
1 IN. = 10 FT. VERTICAL
GRADE LINE ON PROFILE IS SHOWN AS GRADE OF FINISHED ROAD
GROSS LENGTH OF PROJECT 12,615.7 FT. = 2.389 MI.
NET LENGTH OF PROJECT 12,615.7 FT. = 2.389 MI.

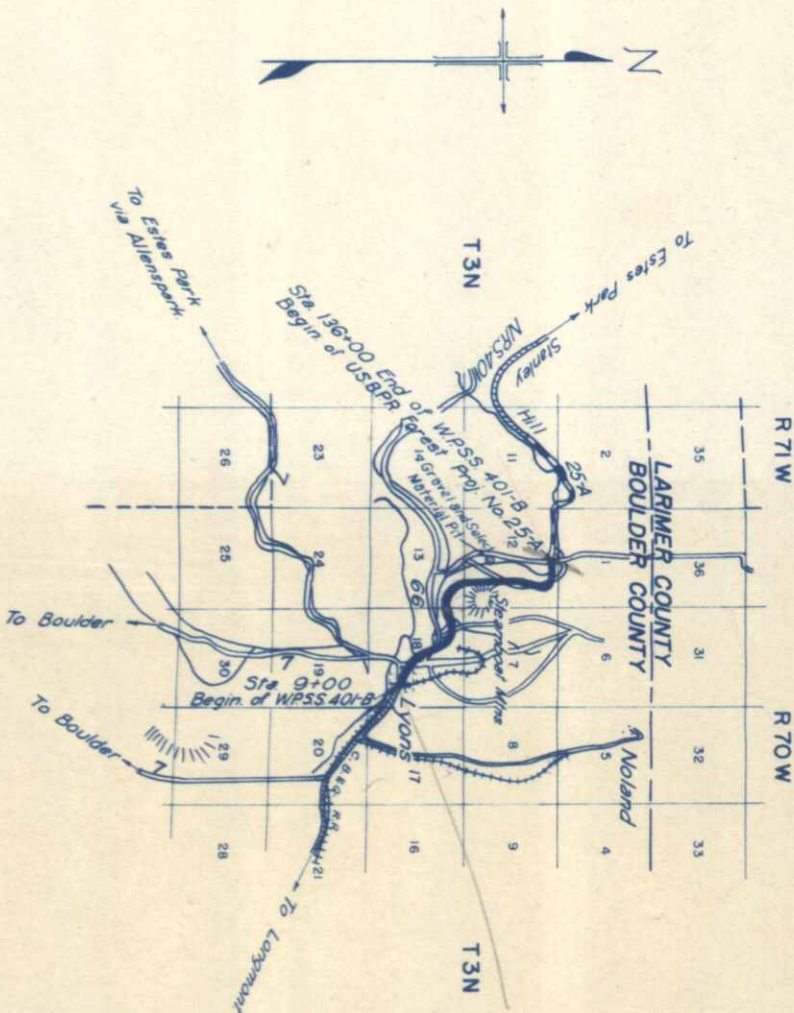

Scale in Miles

CONVENTIONAL SIGNS

Center Line	500
Right-of-Way Line	
Section Line	
1/4 Section Line	
Barbed Wire Fence	
W.C. Guard Fence	
Pole Line	
Present Road	
1/4 Section Line	








AS CONSTRUCTED PLANS
RETURN TO DIST. 4 DESIGN



Note:-
It is recommended that bidders on this project go over the plan details with one of the following field representatives of this Department:

A.B. Collins Division Engr. Greeley, Colo.
H.J. Winter Resident Engr. Greeley, Colo.

RECOMMENDED FOR APPROVAL 1/6/36
APPROVED
STATE HIGHWAY ENGINEER
RECOMMENDED FOR APPROVAL
DIST. ENG. BUREAU PUBLIC ROADS
RECOMMENDED FOR APPROVAL
CHIEF ENG. BUREAU PUBLIC ROADS
APPROVED
DIRECTOR BUREAU PUBLIC ROADS

FED. ROAD DIST. NO.	STATE	WPS PROJ. NO.	SHEET NO.	TOTAL SHEETS
3	COLO.	401 D	19	

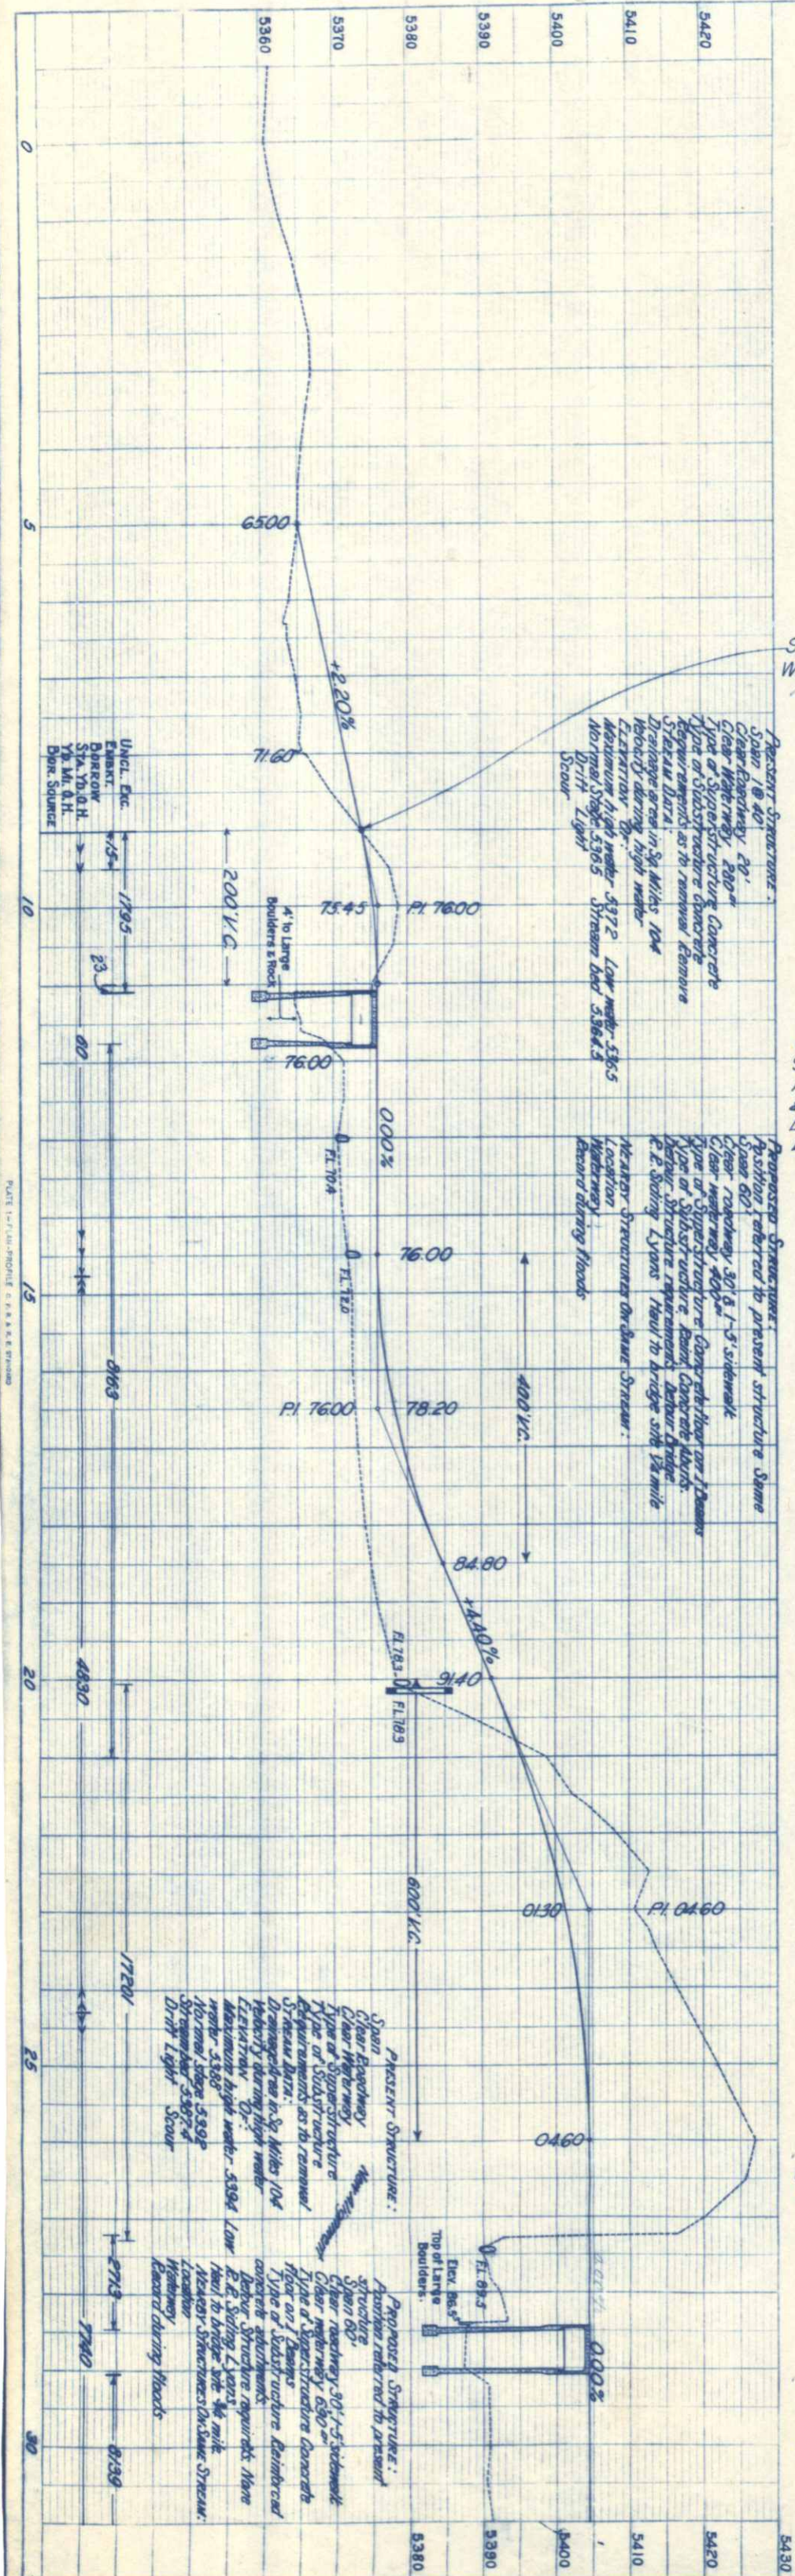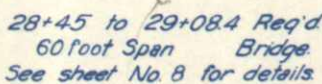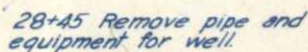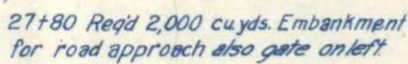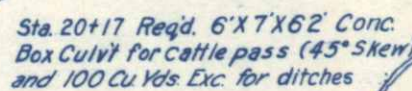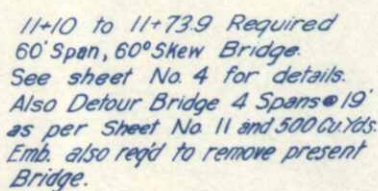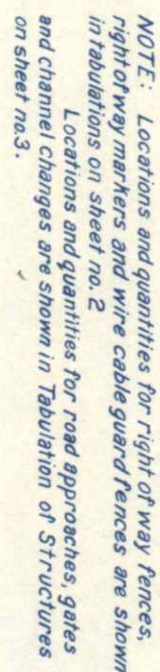

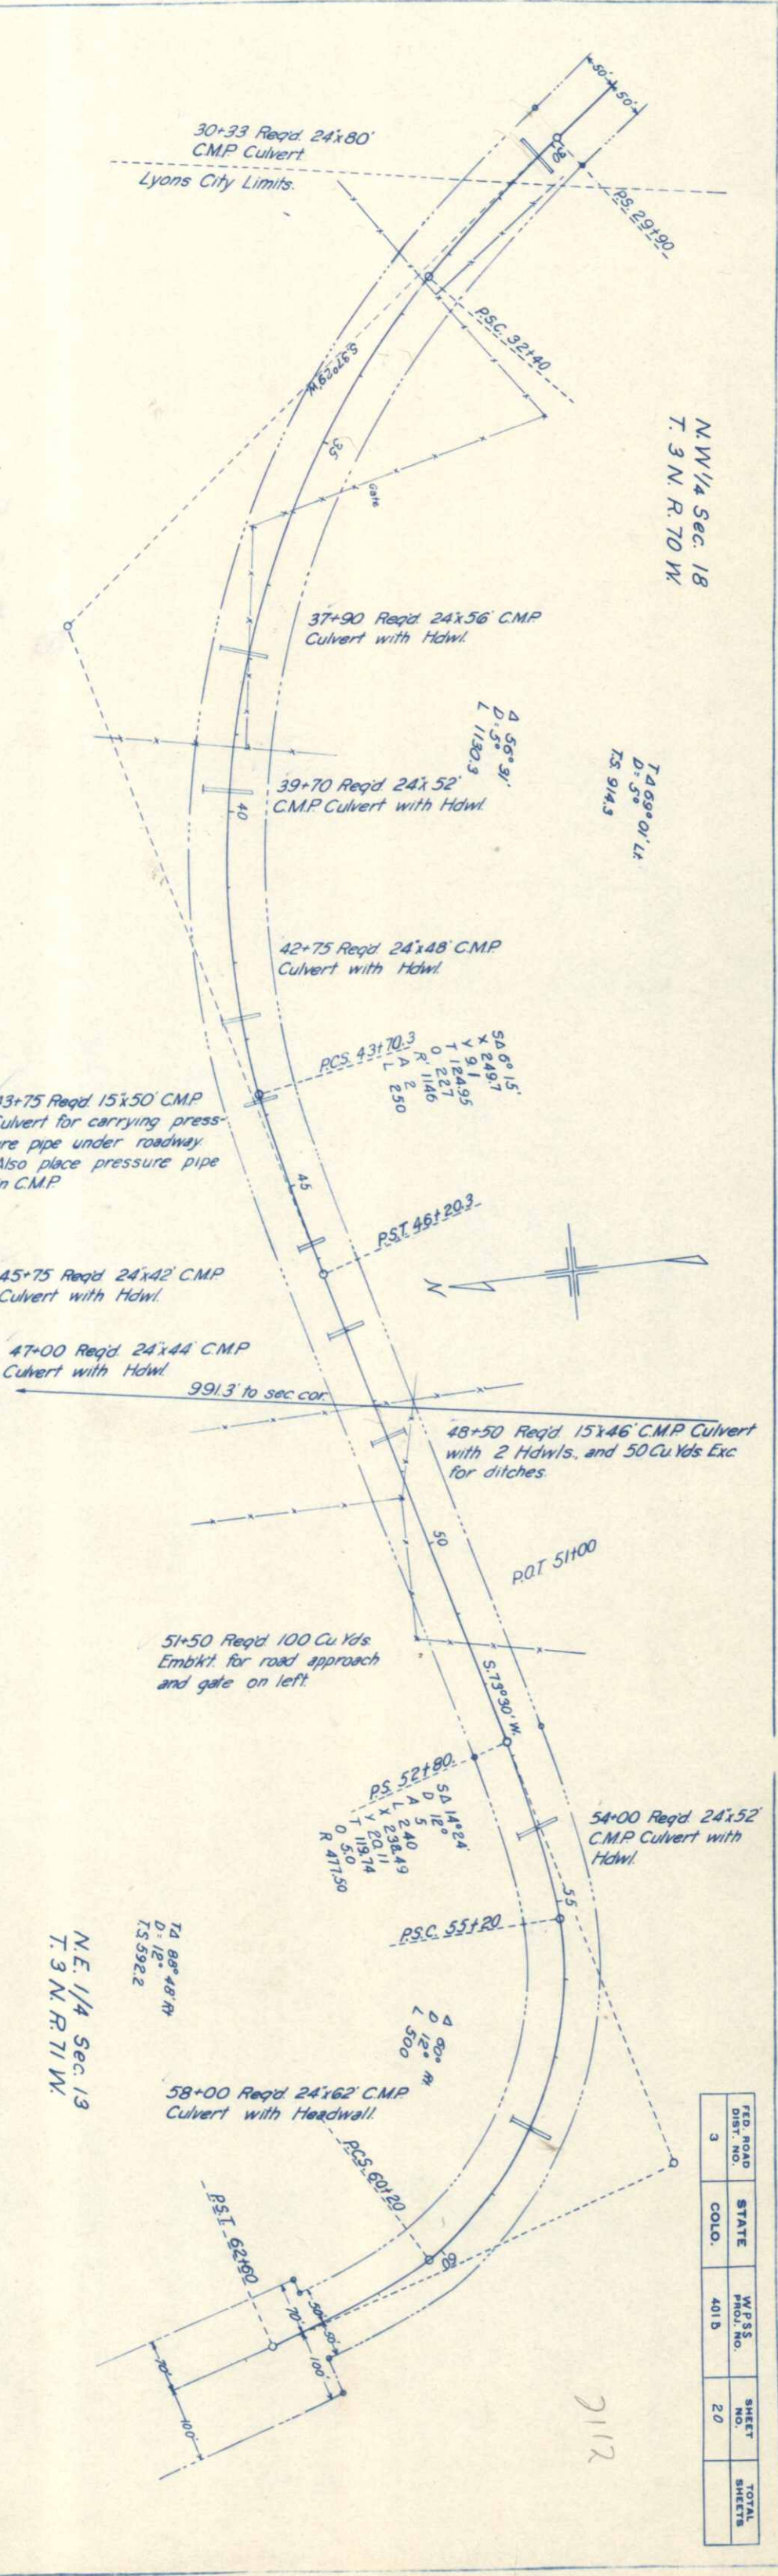
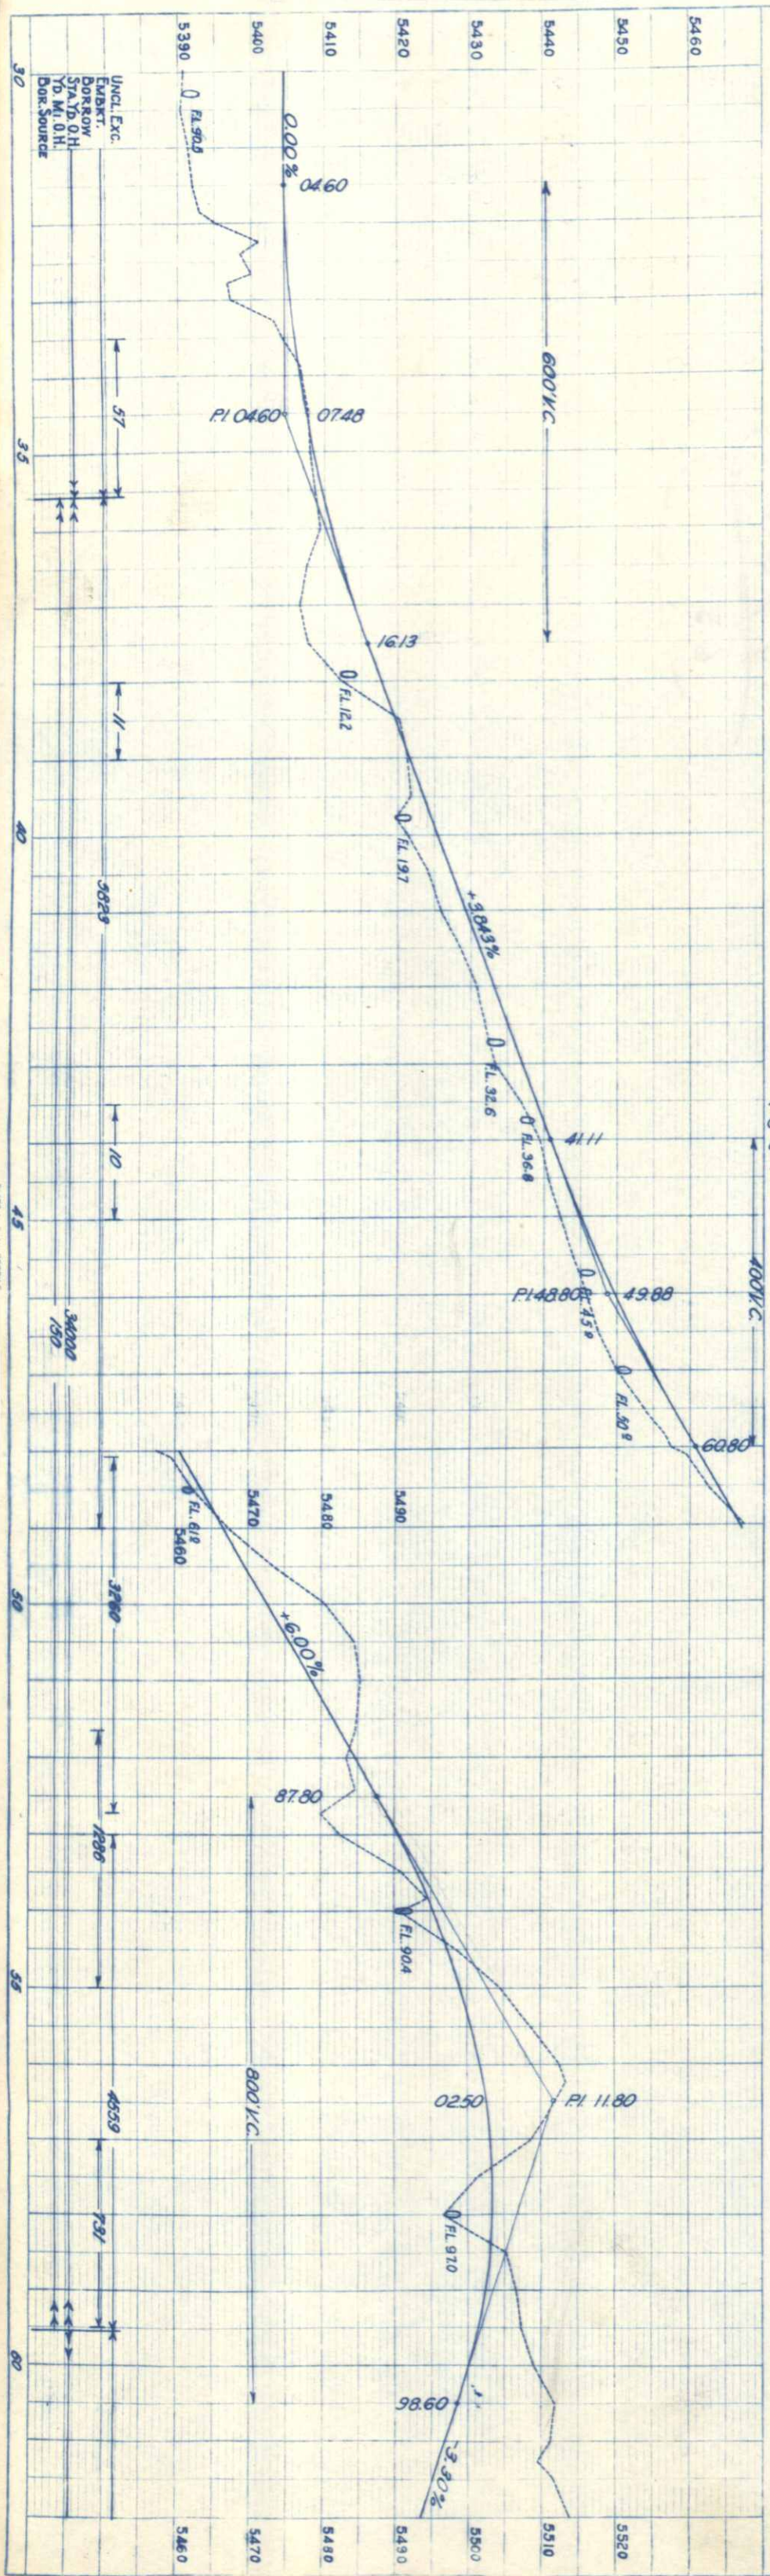


FED. ROAD DIST. NO.	STATE COLO.	W.P.S.S. PROJ. NO.	SHEET NO.	TOTAL SHEETS
3		401 B	20	

FED. ROAD DIST. NO.	STATE	W.P.S.S. PROJ. NO.	SHEET NO.	TOTAL SHEETS
3	COLO.	401 B	22	22

N.E. 1/4 Sec. 12.

S.E. 1/4 Sec. 12
T. 3 N. R. 71 W.

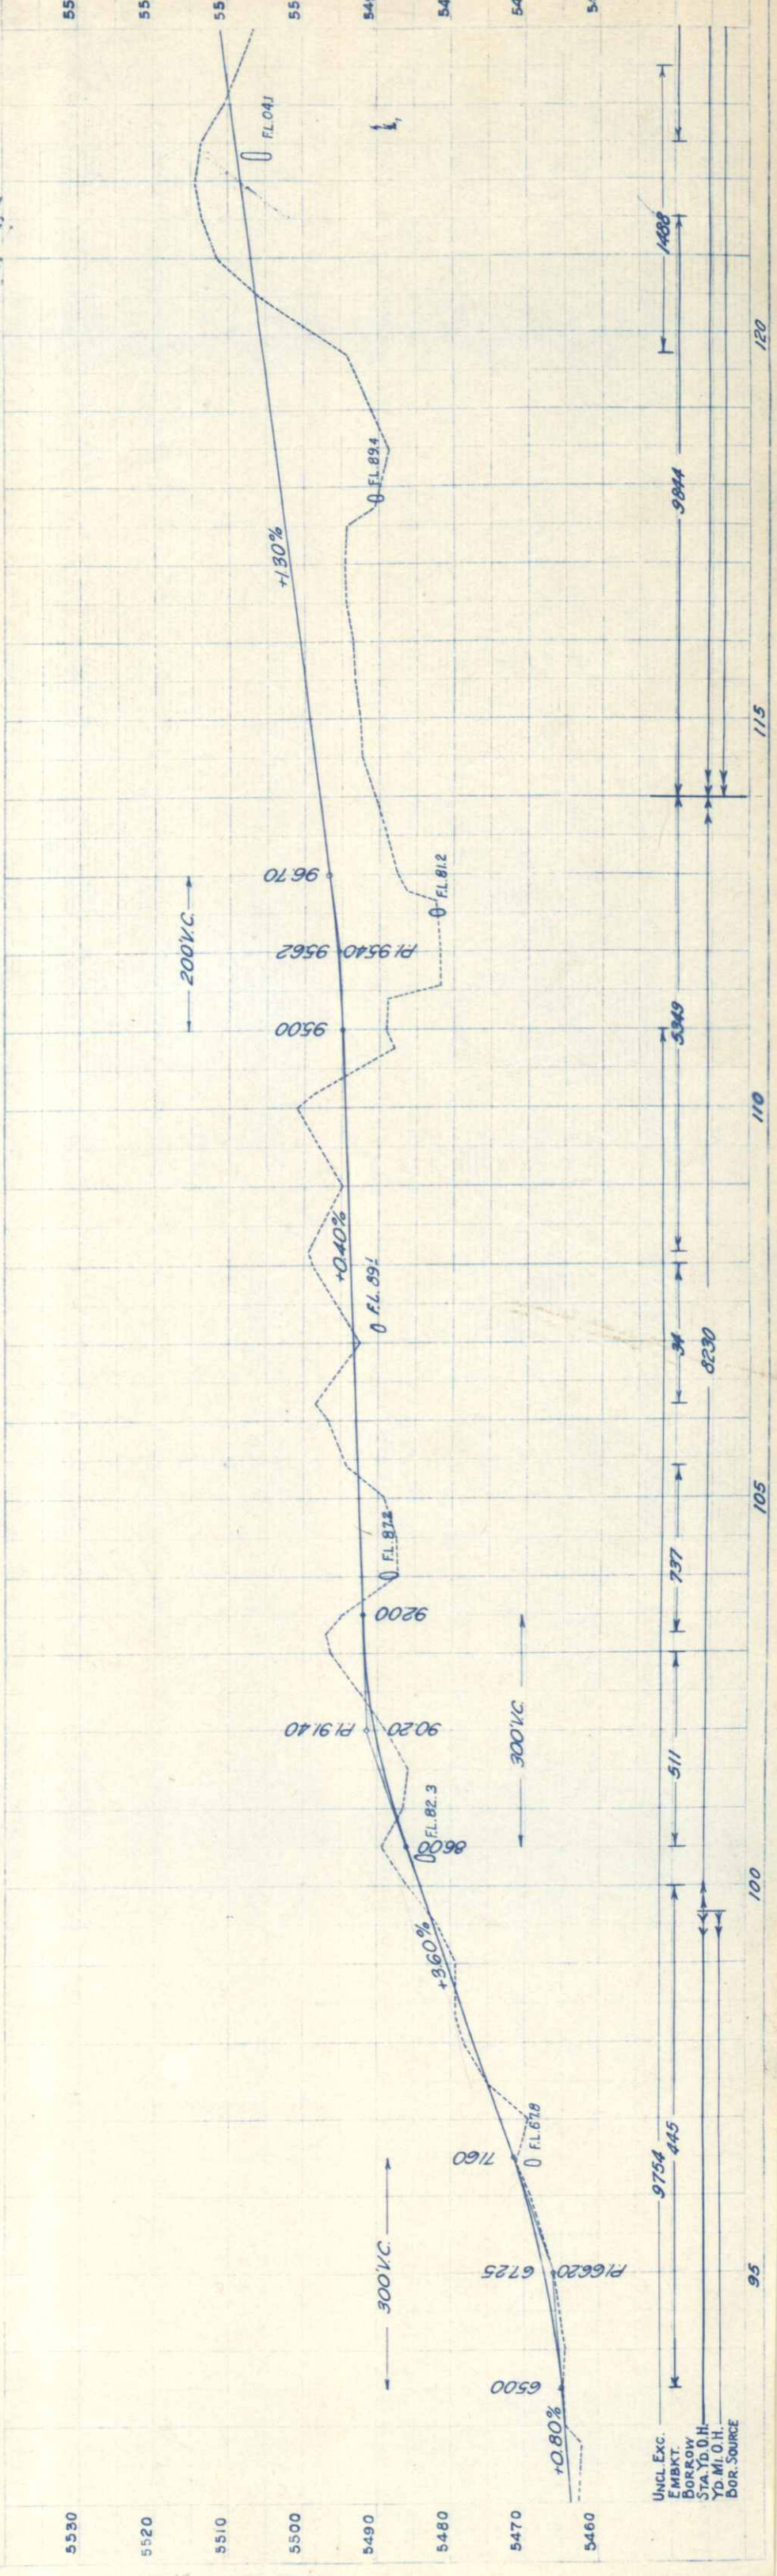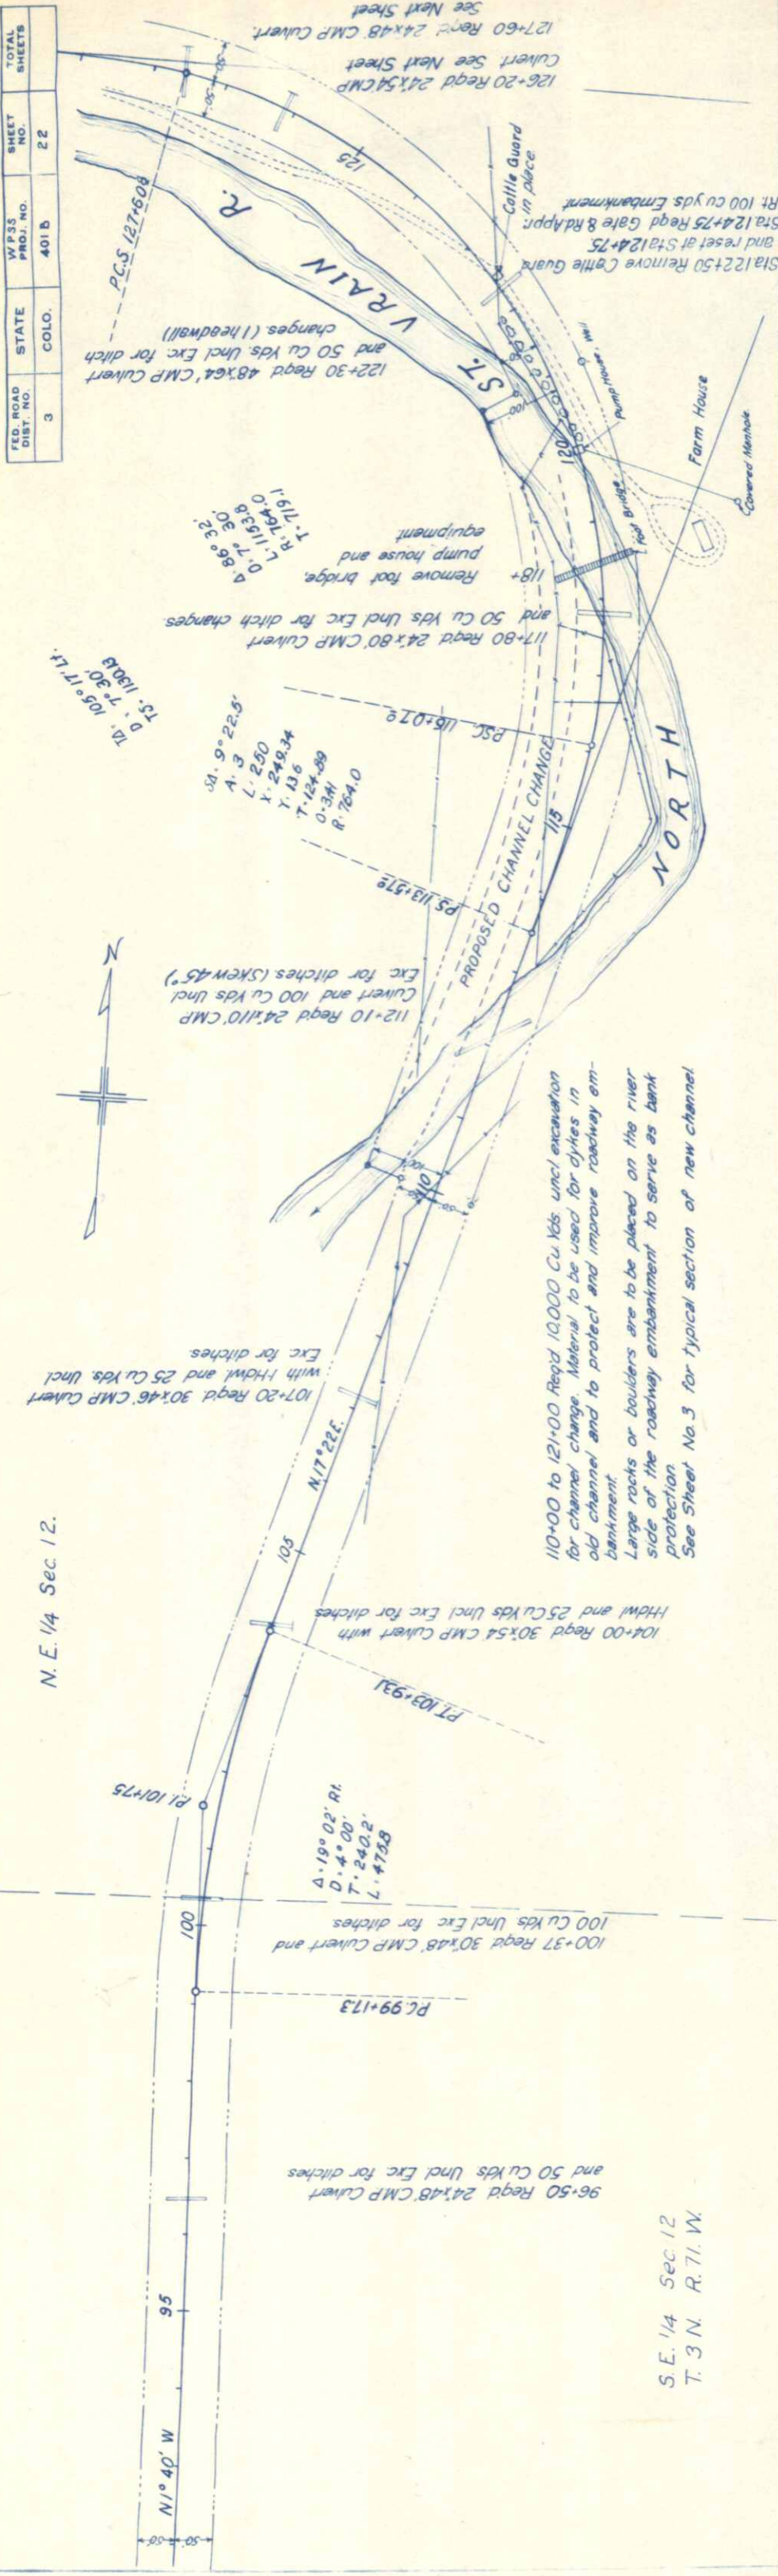

UNCL. EXC.
EMBKT.
BORROW
STA. YD. O.H.
YD. M.I. O.H.
BOR. SOURCE

